
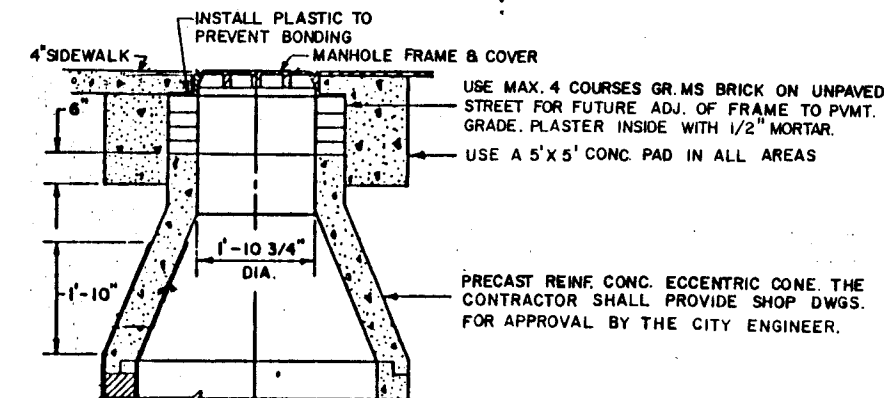


TRIANGLE
REALTY
TRACT B

TRIANGLE REALTY
TRACT A-I-A

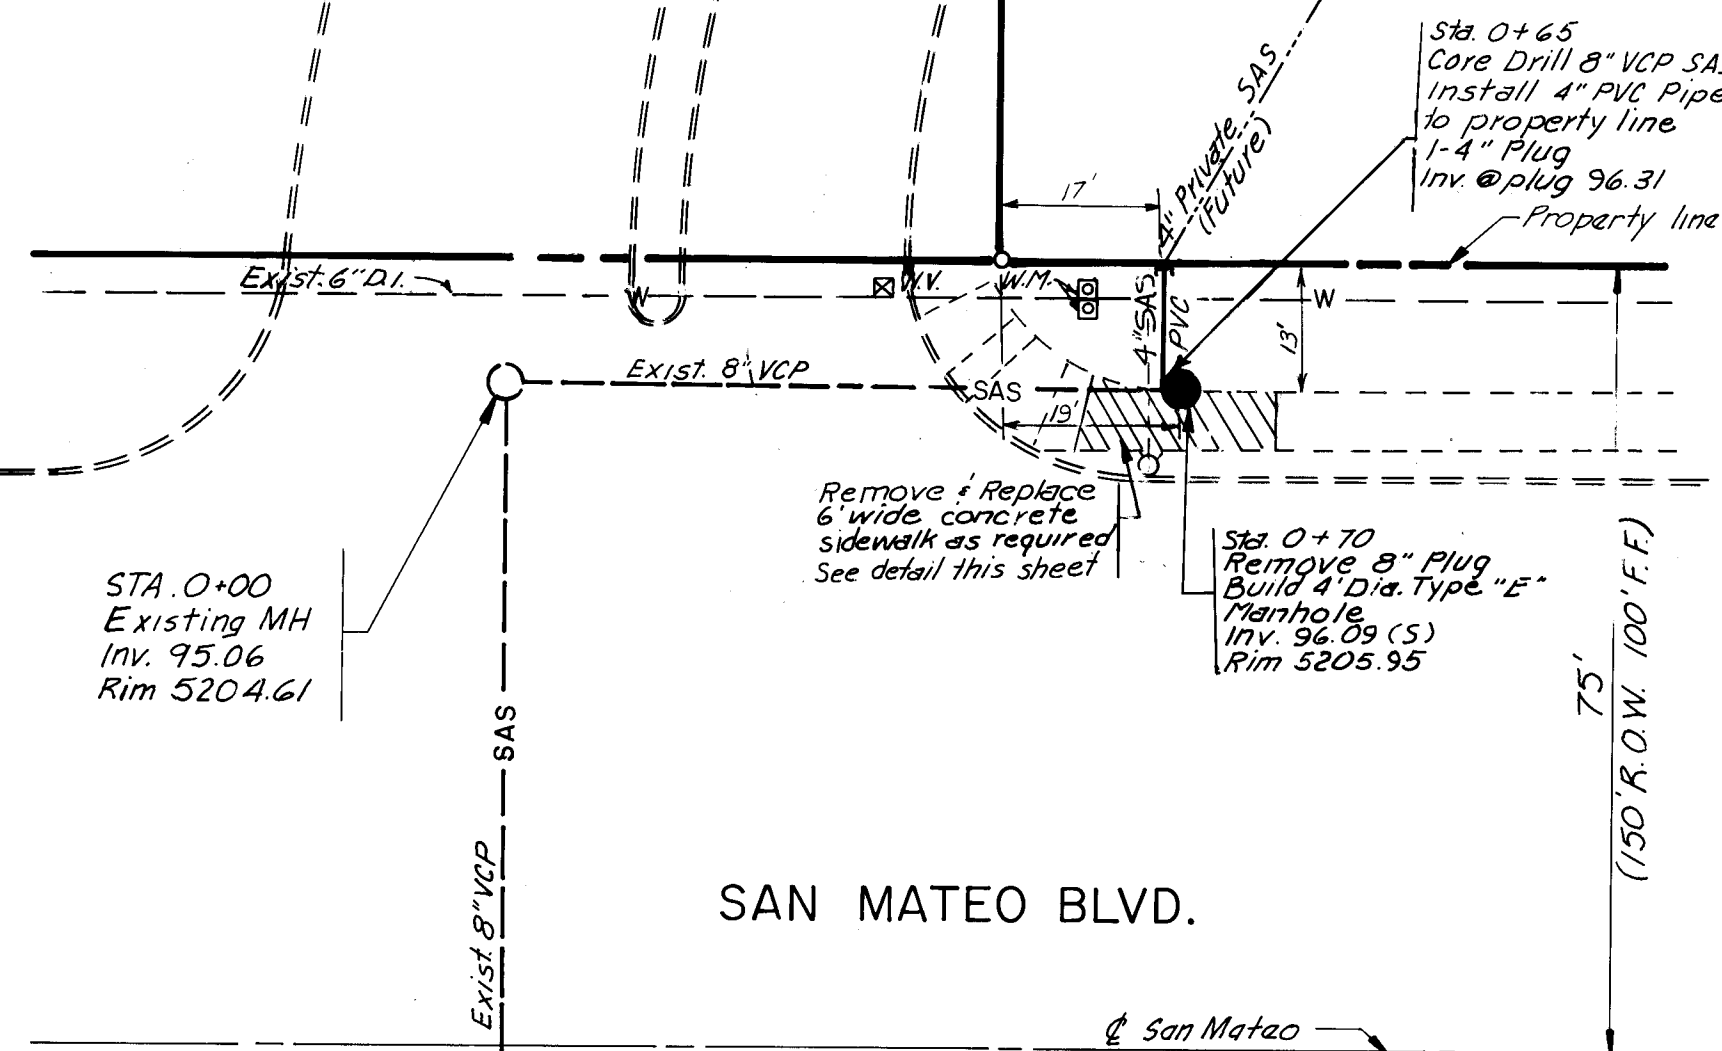

SIDEWALK-CONCRETE COLLAR DETAIL
NO. SCALE



HORIZONTAL SCALE: 1"=20'
VERTICAL SCALE: 1"=5'

HORIZONTAL SCALE: 1"=50'
VERTICAL SCALE: 1"=5'

BRENTWOOD
PARK SUBDIVISION

BEAR CANYON
ARROYO

TRIANGLE REALTY
TRACT A-I-A

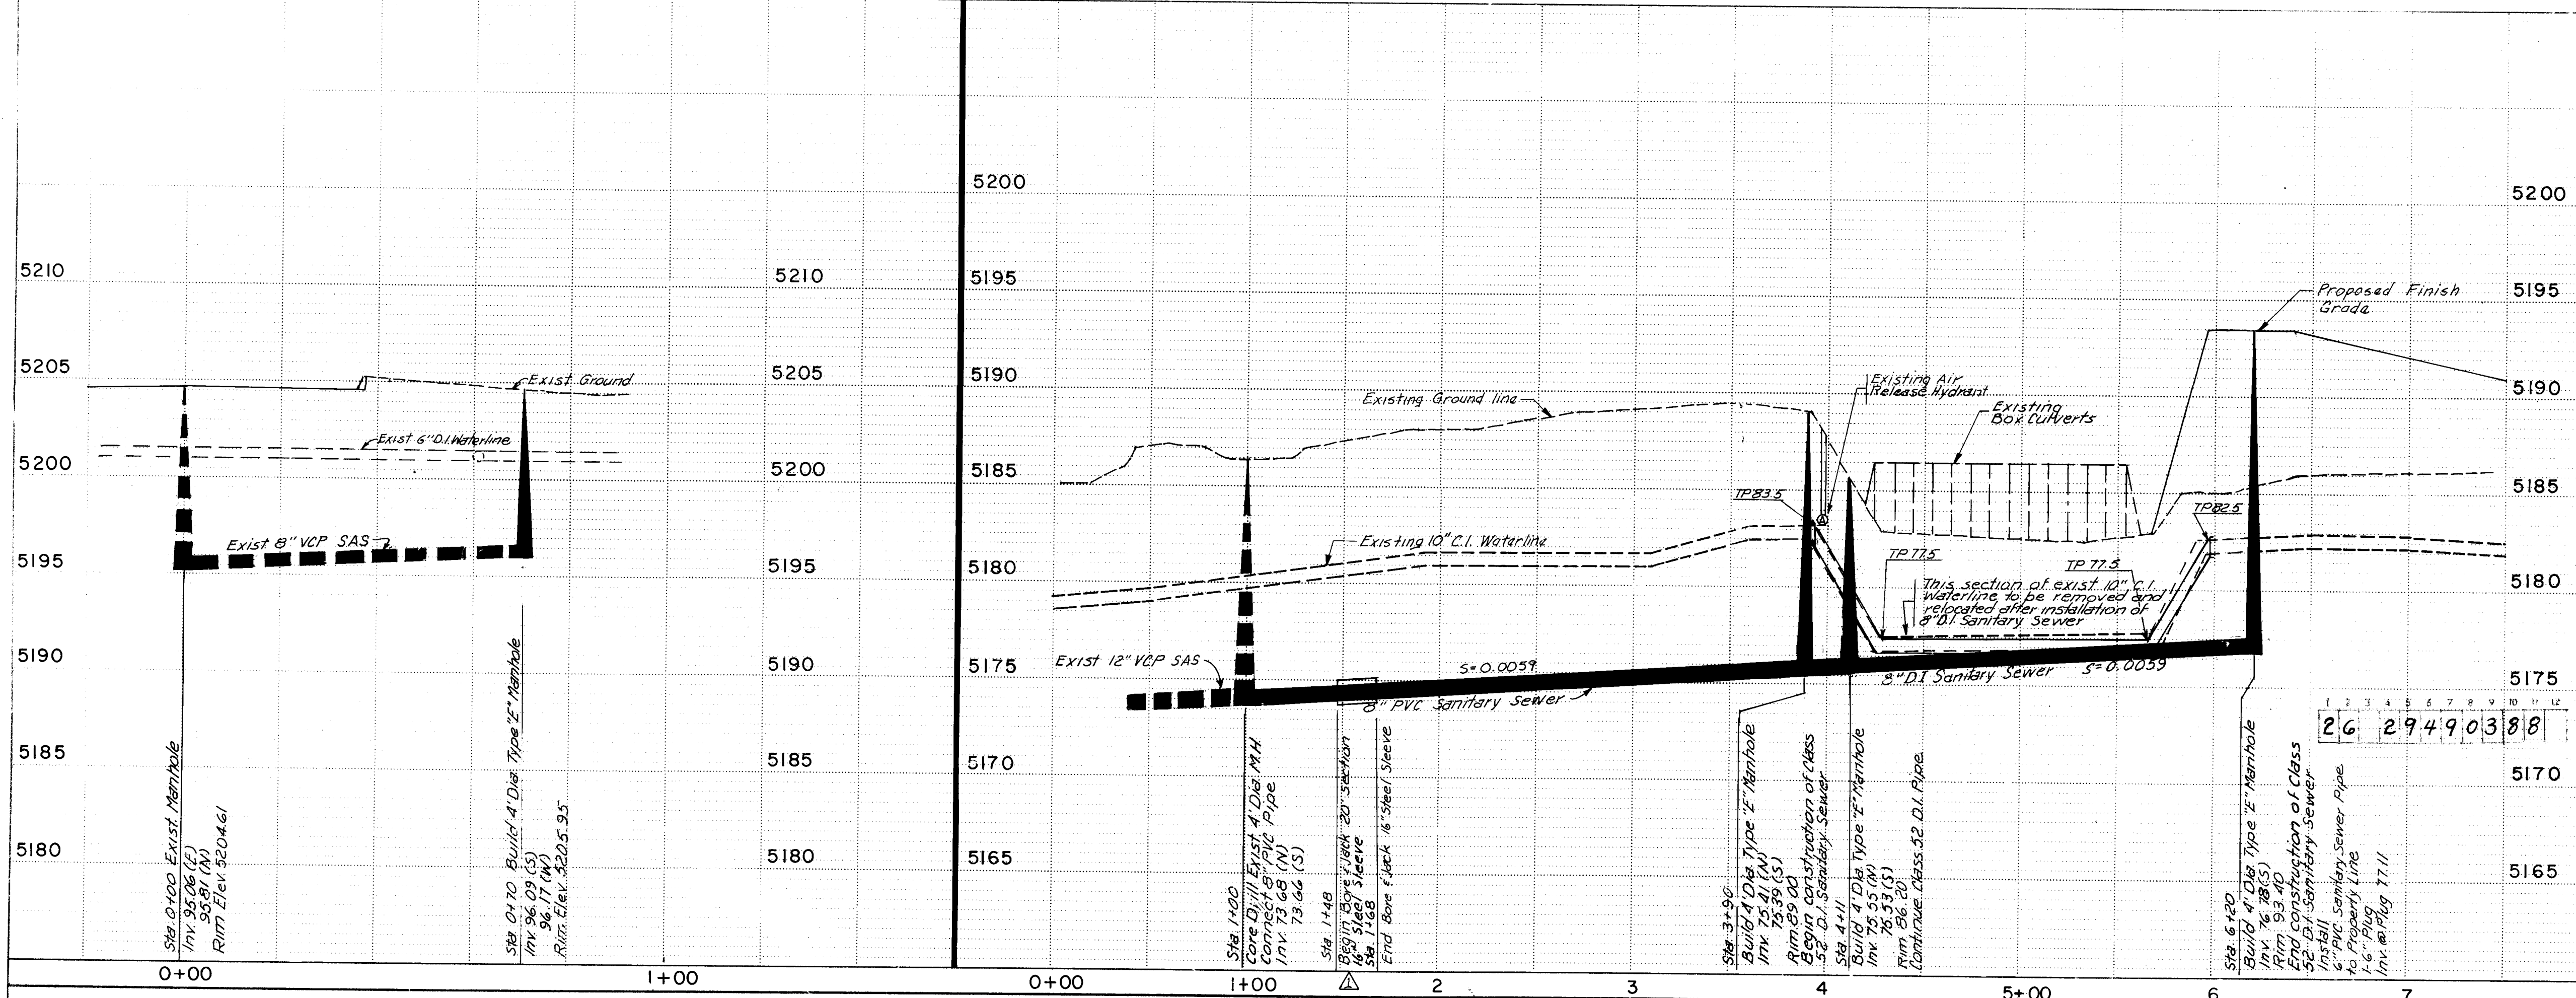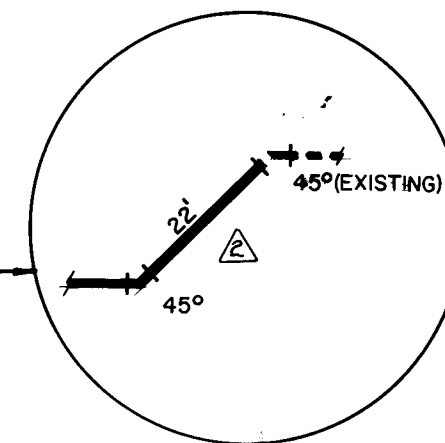

- NOTES**
- ALL 8" DUCTILE IRON PIPE SHALL BE CLASS 52 PRESSURE RATED WITH MJ FITTINGS AND RETAINING GLANDS.
 - ALL STATIONING IS CENTERLINE OF SANITARY SEWER PIPE
 - CONSTRUCTION OF 8" D.I. SANITARY SEWER PIPE THROUGH ARROYO SHALL FOLLOW THIS SEQUENCE OF EVENTS:
A. CUT AND CAP EXISTING 10" C.I. WATERLINE.
B. REMOVE AND SALVAGE WATERLINE.
C. INSTALL 8" D.I. SANITARY SEWER PIPE THROUGH ARROYO FROM STA. 3+90 TO 6+20.
D. REMOVE WATER CAPS AND RE-LOCATE SALVAGED 10" CAST IRON WATERLINE
 - TWO WEEKS PRIOR TO ANY EXCAVATION NEAR PNM POWER POLES, CONTRACTOR MUST CONTACT PNM DISPATCH, 848-4710.

DATE: 2-25-98
DRAWN BY: [Signature]
CHECKED BY: [Signature]

CITY OF ALBUQUERQUE
MUNICIPAL DEVELOPMENT DEPARTMENT

APPROVALS		ENGINEER	DATE	APPROVALS		ENGINEER	DATE
City Engineer		[Signature]	12/15/98	Liquid Waste		[Signature]	9/24/96
A.C.E.-Design		[Signature]	12/15/98	Traffic		[Signature]	9/24/96
A.C.E.-Hydrology		[Signature]	12/15/98	Water		[Signature]	9/24/96

DRAWING NO. 2949 MAP NO. E-17-Z SHEET 3 OF 4

AS BUILT INFORMATION
SPRING CONSTRUCTION
DATE: 12/15/98
DRAWN BY: [Signature]
CHECKED BY: [Signature]
DATE: 12/15/98
MICRO-FILM INFORMATION
DATE: 12/15/98
DRAWN BY: [Signature]
CHECKED BY: [Signature]
DATE: 12/15/98

BENCH MARKS
ACROSS BRASS TABLET STAMPED "9-E18W" N.M.
DATE: 12/15/98
BY: [Signature]
NO. 1
SAN MATEO BLVD. AND ACADEMY ROAD
ELEV = 5207.601

SURVEY INFORMATION
FIELD NOTES
DATE: 12/15/98
BY: [Signature]
NO. 1

ENGINEER'S SEAL
[Signature]
DATE: 12/15/98

REVISIONS		NO.	DATE	REMARKS
1		2/24/98	2-2-97	Revised from as built information
2		2-2-97	2-2-97	Bore and Jack 10" steel sleeve under existing PNM Power Pole

DESIGNED BY DBT DATE 6/86
DRAWN BY LAD DATE 6/86
CHECKED BY DBT DATE 6/86