
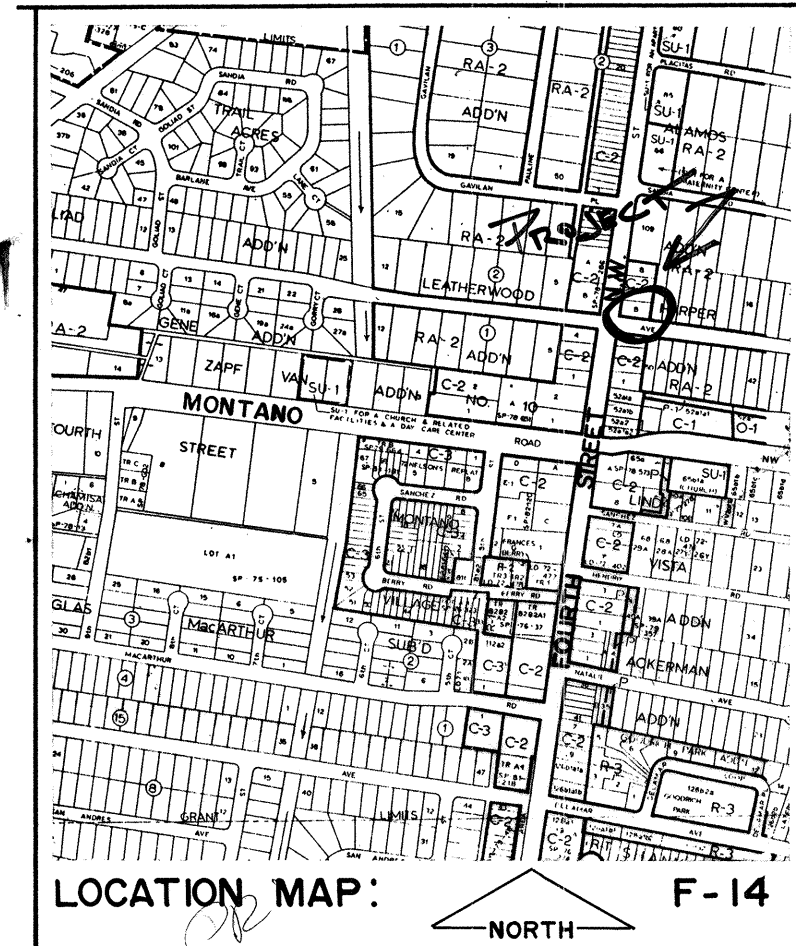


SCANNED BY LASAN

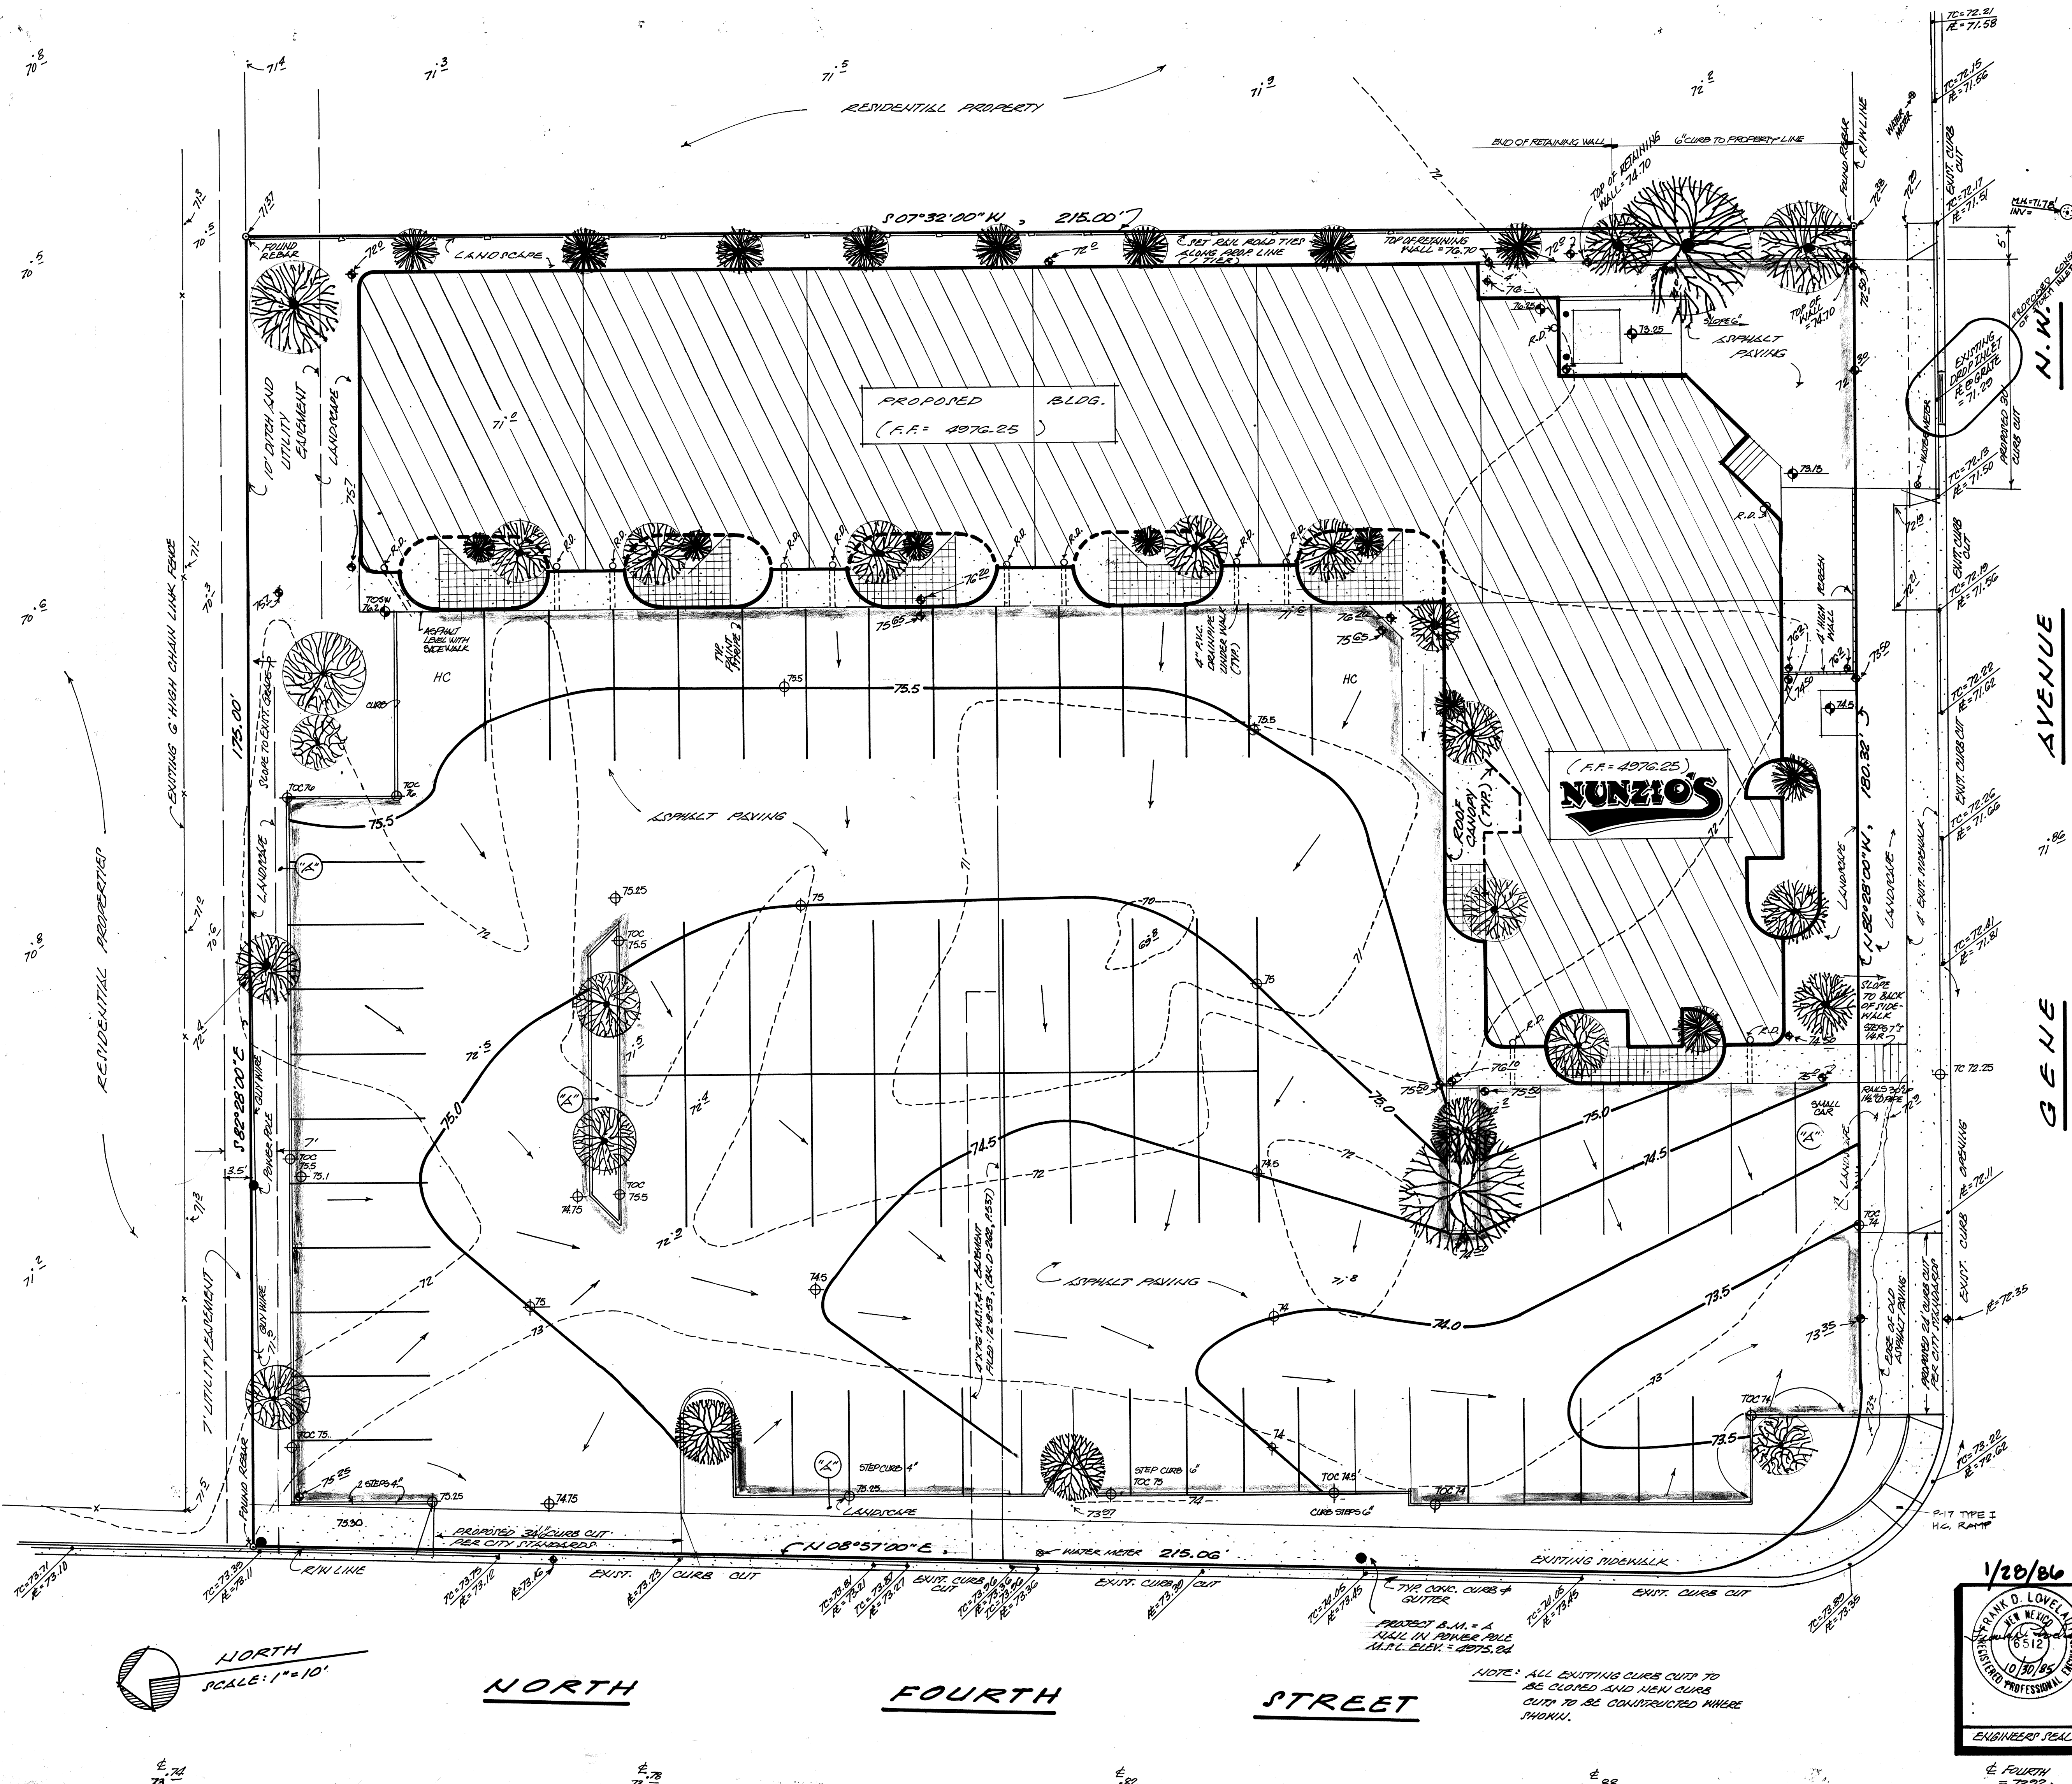


- NOTES:
1. ALL WORK DETAILED ON THIS PLAN TO BE PERFORMED UNDER CONTRACT SHALL, EXCEPT AS OTHERWISE STATED OR PROVIDED FOR HEREON, BE CONSTRUCTED IN ACCORDANCE WITH THE INTERIM SPECIFICATIONS FOR PUBLIC WORKS CONSTRUCTION, 1985, TOGETHER WITH THE STANDARD DRAWINGS CONTAINED THEREIN.
 2. TWO (2) WORKING DAYS PRIOR TO ANY EXCAVATION, CONTRACTOR MUST CONTACT LINE LOCATING SERVICE, 765-1234, FOR LOCATION OF EXISTING UTILITIES.
 3. PRIOR TO CONSTRUCTION, THE CONTRACTOR SHALL EXCAVATE AND VERIFY THE HORIZONTAL AND VERTICAL LOCATIONS OF ALL OBSTRUCTIONS. SHOULD A CONFLICT EXIST, THE CONTRACTOR SHALL NOTIFY THE ENGINEER OR SURVEYOR SO THAT THE CONFLICT CAN BE RESOLVED WITH A MINIMUM AMOUNT OF DELAY.
 4. BACKFILL COMPACTION SHALL BE ACCORDING TO RESIDENTIAL STREET USE.
 5. TACK COAT REQUIREMENTS SHALL BE DETERMINED BY THE CITY ENGINEER.
 6. IF CURB IS DEPRESSED FOR A DRIVE-PAD, THE DRIVEPAD SHALL BE CONSTRUCTED PRIOR TO ACCEPTANCE OF THE CURB AND GUTTER.
 7. ALL STORM DRAINAGE FACILITIES SHALL BE COMPLETED PRIOR TO FINAL ACCEPTANCE.


- LEGEND:
- 7.0' = 72.41 = TOP OF CURB ELEVATION
 - 7.1' = 71.51 = CURB FIN LINE ELEVATION
 - 7.2' = 71.51 = EXISTING OR PROPOSED CONCRETE
 - 7.3' = 71.51 = EXISTING CURB
 - 7.4' = 71.51 = PROPOSED CURB
 - 7.5' = 71.51 = EXISTING FENCE
 - 7.6' = 71.51 = PROPOSED FENCE
 - 7.7' = 71.51 = PROPOSED LIMIT OF NEW PAVING
 - 7.8' = 71.51 = ROAD DRAIN
 - 7.9' = 71.51 = 6" CONCRETE CURBS

APPROVAL OF AS BUILT DRAWINGS
DATE 1-22-87
26 29600187


CITY OF ALBUQUERQUE MUNICIPAL DEVELOPMENT DEPARTMENT ENGINEERING DIVISION			
TITLE: CONVERT EXISTING DOUBLE "C" STORM INLET TO DOUBLE "D" STORM INLET			
APPROVALS	ENGINEER	DATE	APPROVALS
City Engineer	Robert Lopez	7/15/86	Liquid Waste
A.C.E.-Design	Robert Lopez	7/15/86	Traffic
A.C.E.-Hydrology	Robert Lopez	7/15/86	Water
DESIGNED BY F. LOVELADY		DATE 10-12-85	
DRAWN BY F.L.		DATE 10-28-85	
CHECKED BY F.L.		DATE 10-30-85	
PROJECT NO. 2960		MAP NO. F-14	
SHEET 1		OF 2	

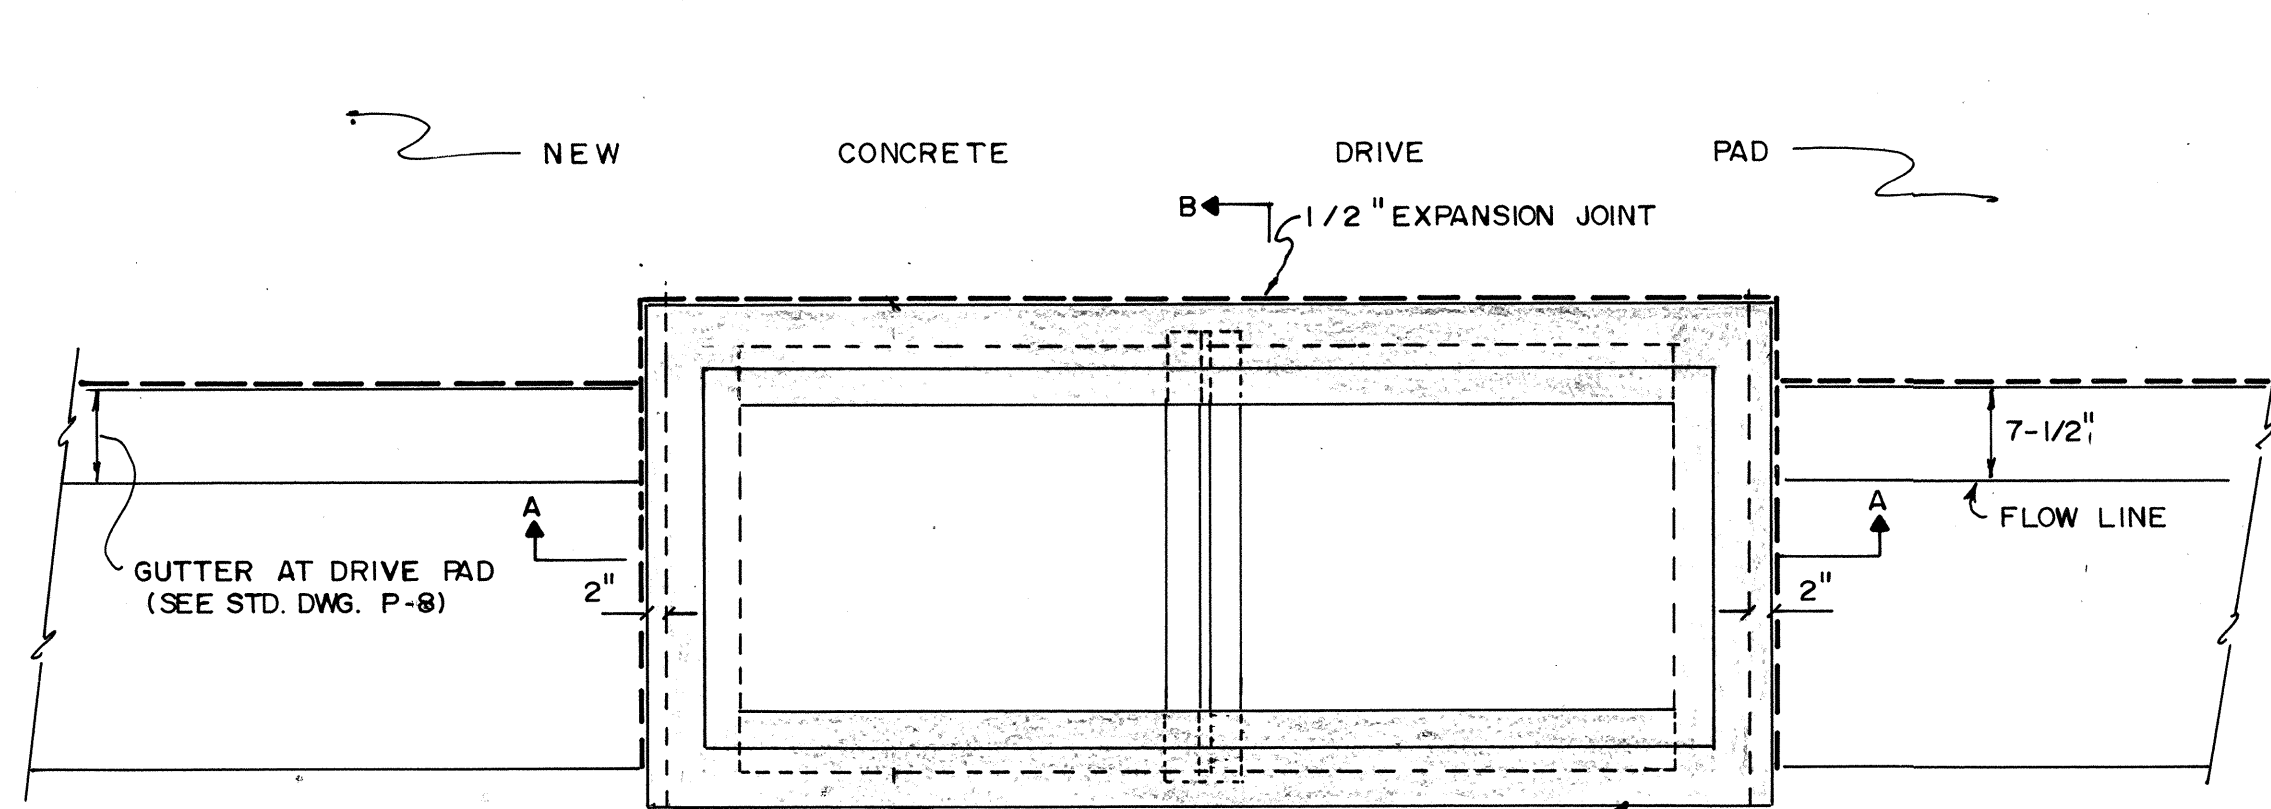

PLAN
3/4" = 1' - 0"

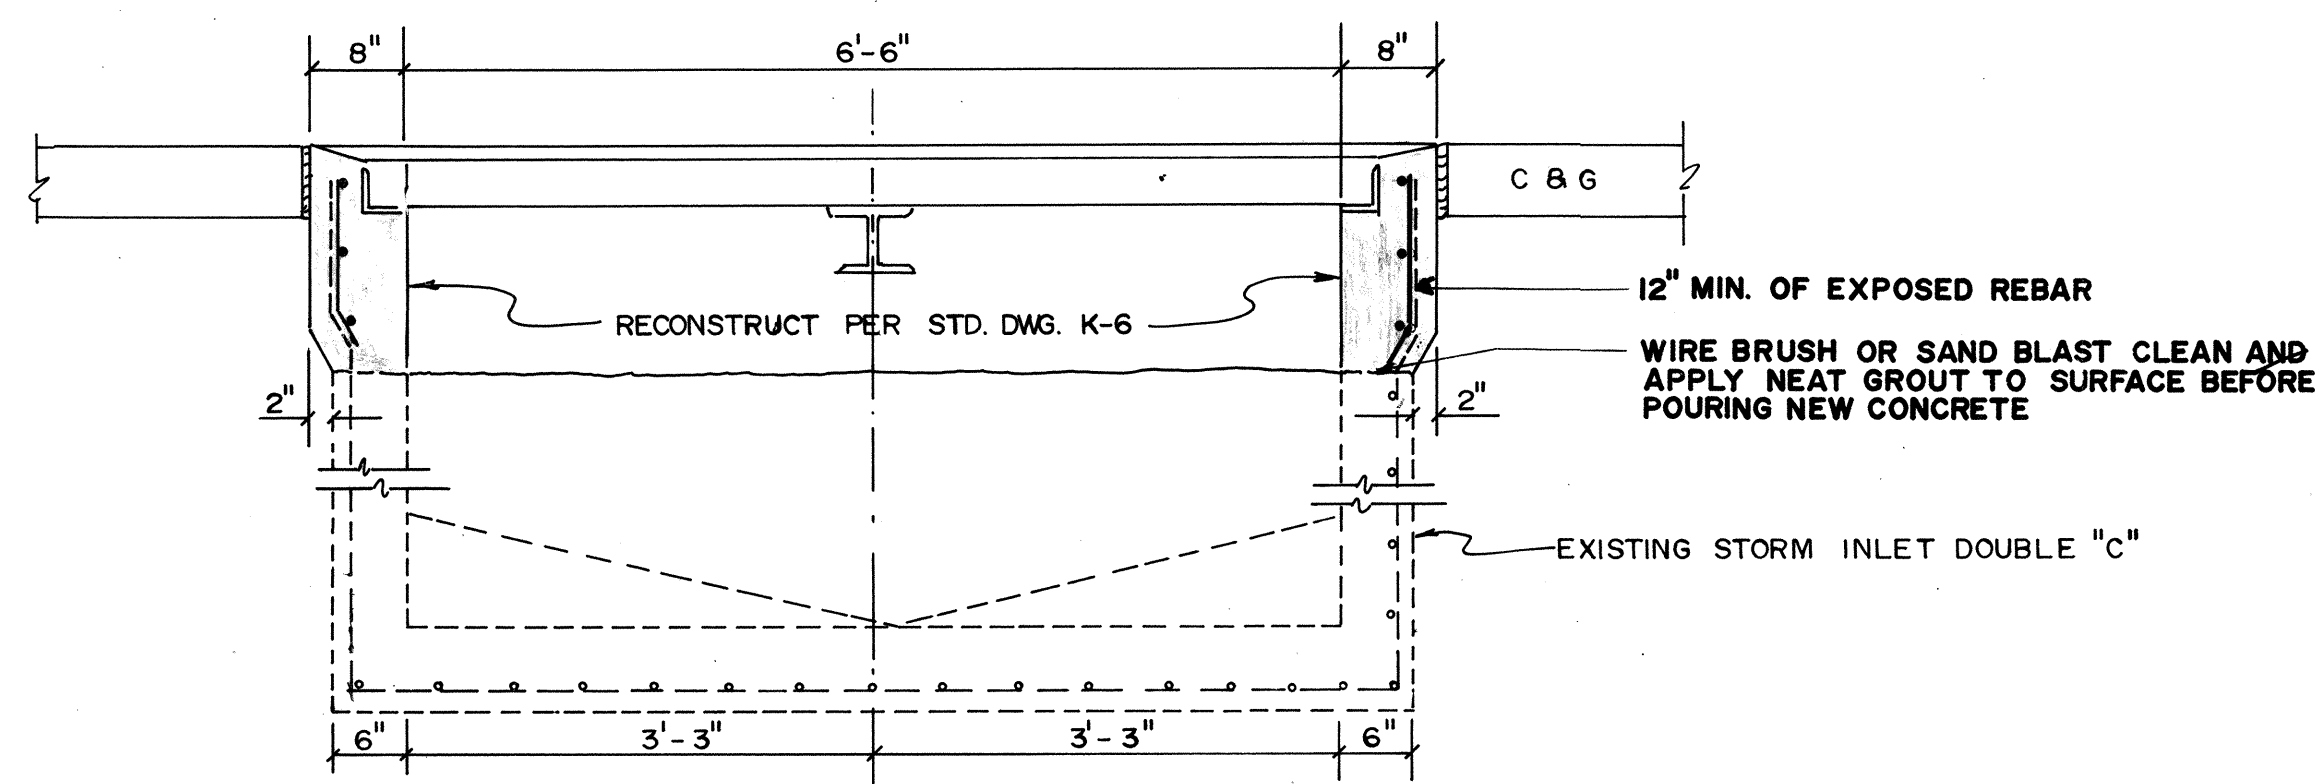


SECTION A-A
3/4" = 1' - 0"

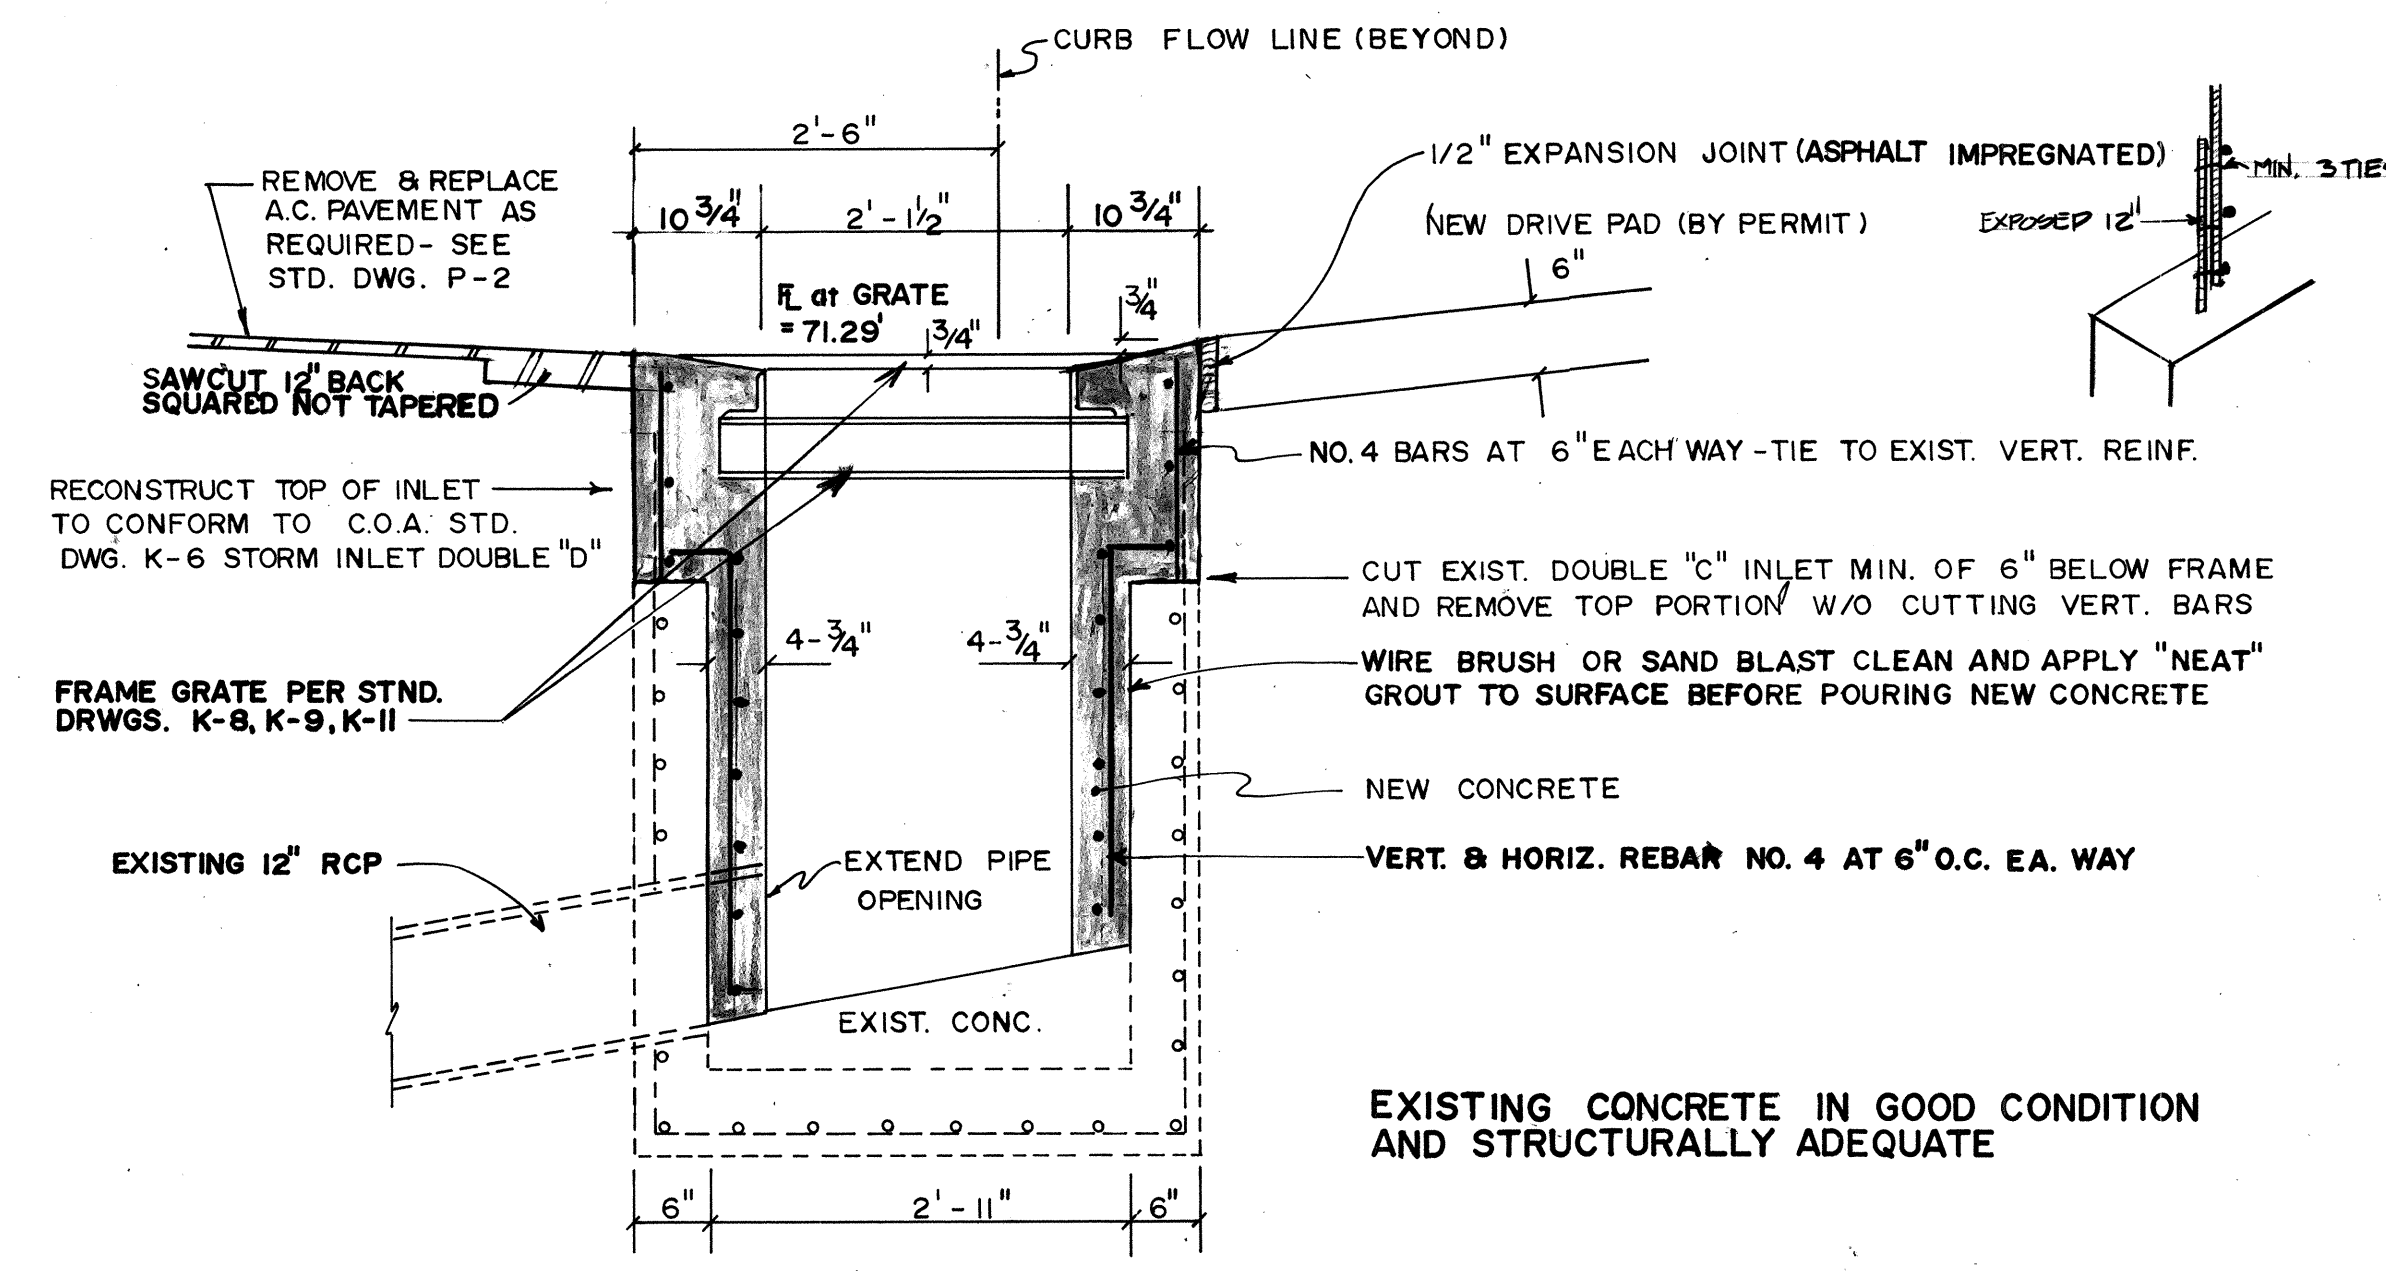

SECTION B - B
3/4" = 1' - 0"

EXISTING CONCRETE IN GOOD CONDITION AND STRUCTURALLY ADEQUATE

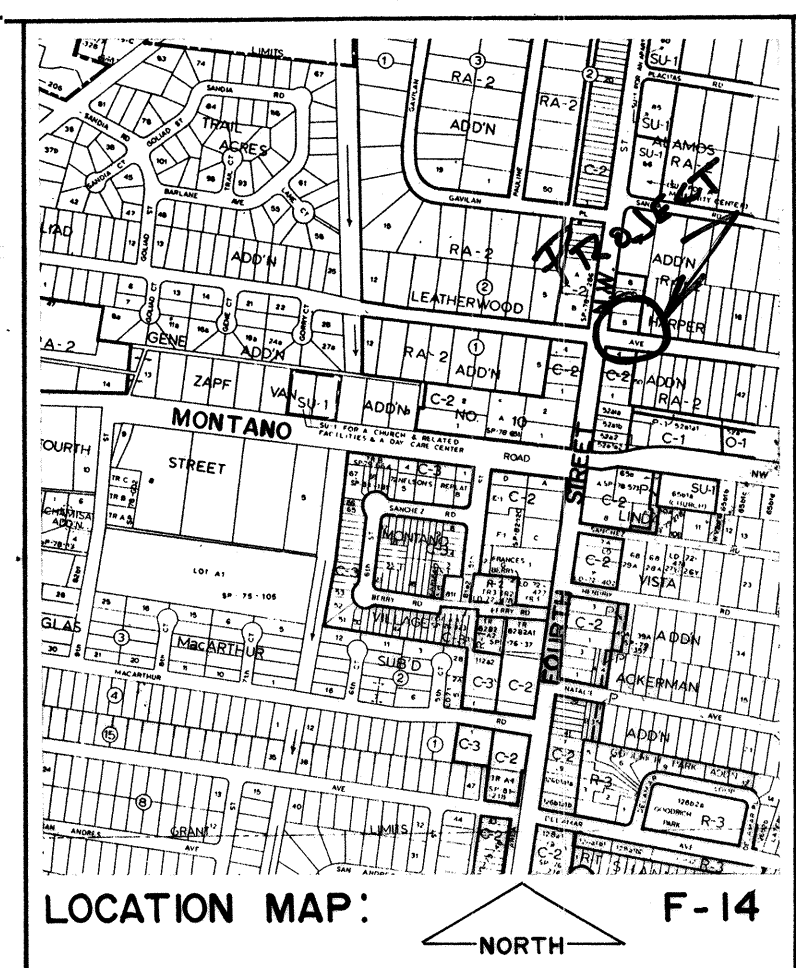

- NOTES:**
1. ALL WORK DETAILED ON THIS PLAN TO BE PERFORMED UNDER CONTRACT SHALL, EXCEPT AS OTHERWISE STATED OR PROVIDED FOR HEREON, BE CONSTRUCTED IN ACCORDANCE WITH THE INTERIM SPECIFICATIONS FOR PUBLIC WORKS CONSTRUCTION, 1985, TOGETHER WITH THE STANDARD DRAWINGS CONTAINED THEREIN.
 2. TWO (2) WORKING DAYS PRIOR TO ANY EXCAVATION, CONTRACTOR MUST CONTACT LINE LOCATING SERVICE, 765-1234, FOR LOCATION OF EXISTING UTILITIES.
 3. PRIOR TO CONSTRUCTION, THE CONTRACTOR SHALL EXCAVATE AND VERIFY THE HORIZONTAL AND VERTICAL LOCATIONS OF ALL OBSTRUCTIONS. SHOULD A CONFLICT EXIST, THE CONTRACTOR SHALL NOTIFY THE ENGINEER OR SURVEYOR SO THAT THE CONFLICT CAN BE RESOLVED WITH A MINIMUM AMOUNT OF DELAY.
 4. BACKFILL COMPACTION SHALL BE ACCORDING TO RESIDENTIAL STREET USE.
 5. TACK COAT REQUIREMENTS SHALL BE DETERMINED BY THE CITY ENGINEER.
 6. IF CURB IS DEPRESSSED FOR A DRIVE-PAD, THE DRIVEPAD SHALL BE CONSTRUCTED PRIOR TO ACCEPTANCE OF THE CURB AND GUTTER.
 7. ALL STORM DRAINAGE FACILITIES SHALL BE COMPLETED PRIOR TO FINAL ACCEPTANCE.

- LEGEND:**
- T.C. = 72.41 = TOP OF CURB ELEVATION
 - R.E. = 71.51 = CURB FINISH LINE ELEVATION
 - EXISTING OR PROPOSED CONCRETE
 - EXISTING CONTOUR
 - PROPOSED CONTOUR
 - EXISTING FENCE
 - PROPOSED FENCE ELEVATION
 - PROPOSED LIMIT OF NEW PAVING
 - R.D. = ROAD DRAIN
 - C = 6" CONCRETE CURBSIDE

1 2 3 4 5 6 7 8 9 10 11 12
26 29600287

CONSTRUCTION
CITY ENGINEER DATE

CITY OF ALBUQUERQUE MUNICIPAL DEVELOPMENT DEPARTMENT ENGINEERING DIVISION			
TITLE: CONVERT EXISTING DOUBLE "C" STORM INLET TO DOUBLE "D" STORM INLET			
APPROVALS	ENGINEER	DATE	APPROVALS
City Engineer	7/14/86	7/23/86	Liquid Waste
A.C.E. - Design	7/14/86	7/21/86	Traffic
A.C.E. - Hydrology	7/14/86	7/22/86	Water
DESIGNED BY F. LOVELADY	DATE 10-12-85	DATE 10-28-85	DATE 10-30-85
DRAWN BY F.L.	DATE 10-12-85	DATE 10-28-85	DATE 10-30-85
CHECKED BY F.L.	DATE 10-12-85	DATE 10-28-85	DATE 10-30-85
PROJECT NO. 2960	MAP NO. F-14	SHEET 2	OF 2