



PLAN	DATE	BY	REVIEWED
			PLOTTED
			ALIGNED
			NO.

PROFILE	DATE	BY	REVIEWED
			PLOTTED
			GRADES CHECKED
			STRUCTURE NOTATIONS CHK'D

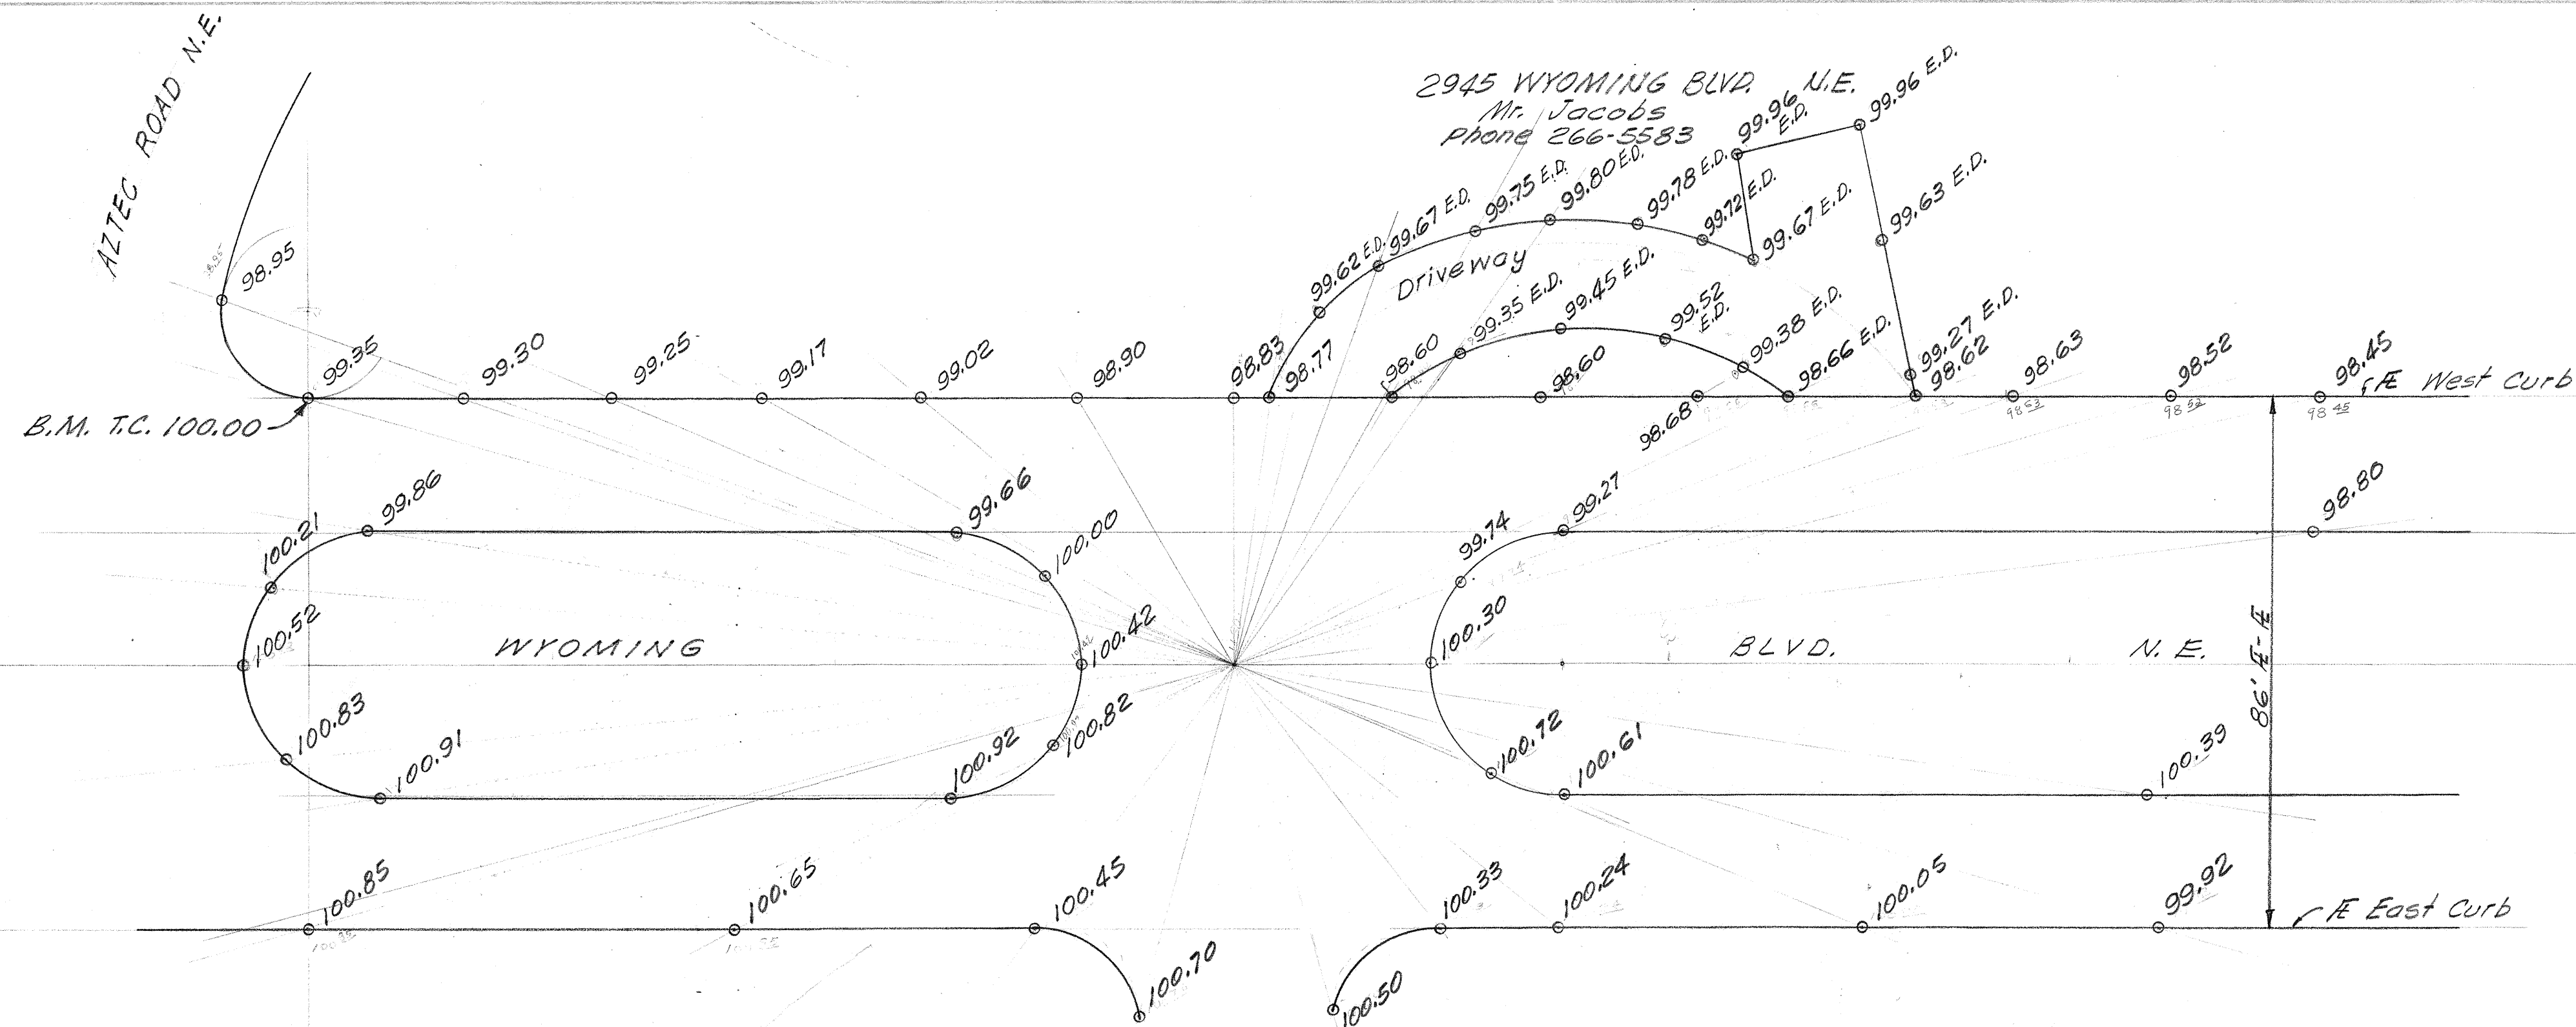

1	2	3	4	5	6	7	8	9	10	11	12	13	14	15	16	17	18	19	20	21	22	23	24	25	26	27	28	29
02	29											72																
													13															6019

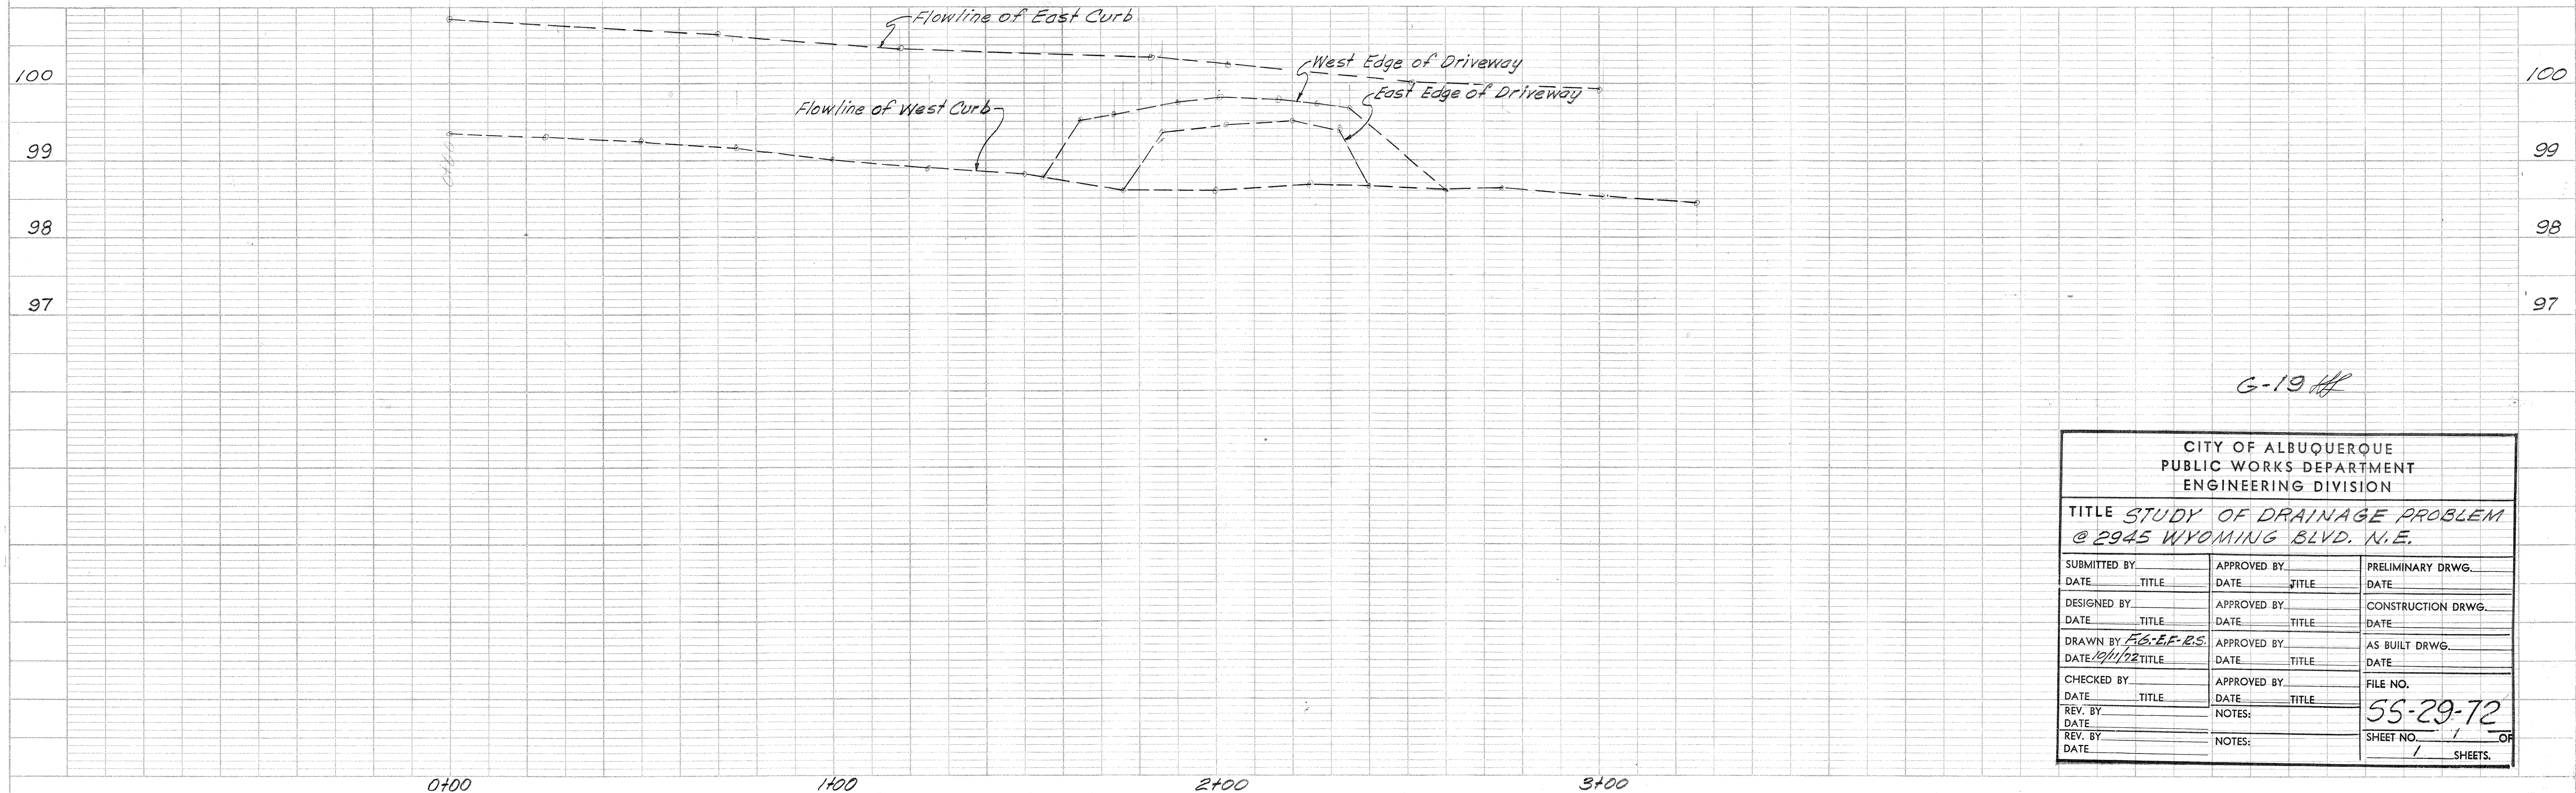

G-19

CITY OF ALBUQUERQUE PUBLIC WORKS DEPARTMENT ENGINEERING DIVISION		
TITLE STUDY OF DRAINAGE PROBLEM @ 2945 WYOMING BLVD. N.E.		
SUBMITTED BY	APPROVED BY	PRELIMINARY DRWG.
DATE	DATE	DATE
DESIGNED BY	APPROVED BY	CONSTRUCTION DRWG.
DATE	DATE	DATE
DRAWN BY FG-EP-RS	APPROVED BY	AS BUILT DRWG.
DATE 10/11/72	DATE	DATE
CHECKED BY	APPROVED BY	FILE NO.
DATE	DATE	DATE
REV. BY	NOTES	55-29-72
DATE	NOTES	SHEET NO. 1 OF 1
DATE	NOTES	SHEETS