
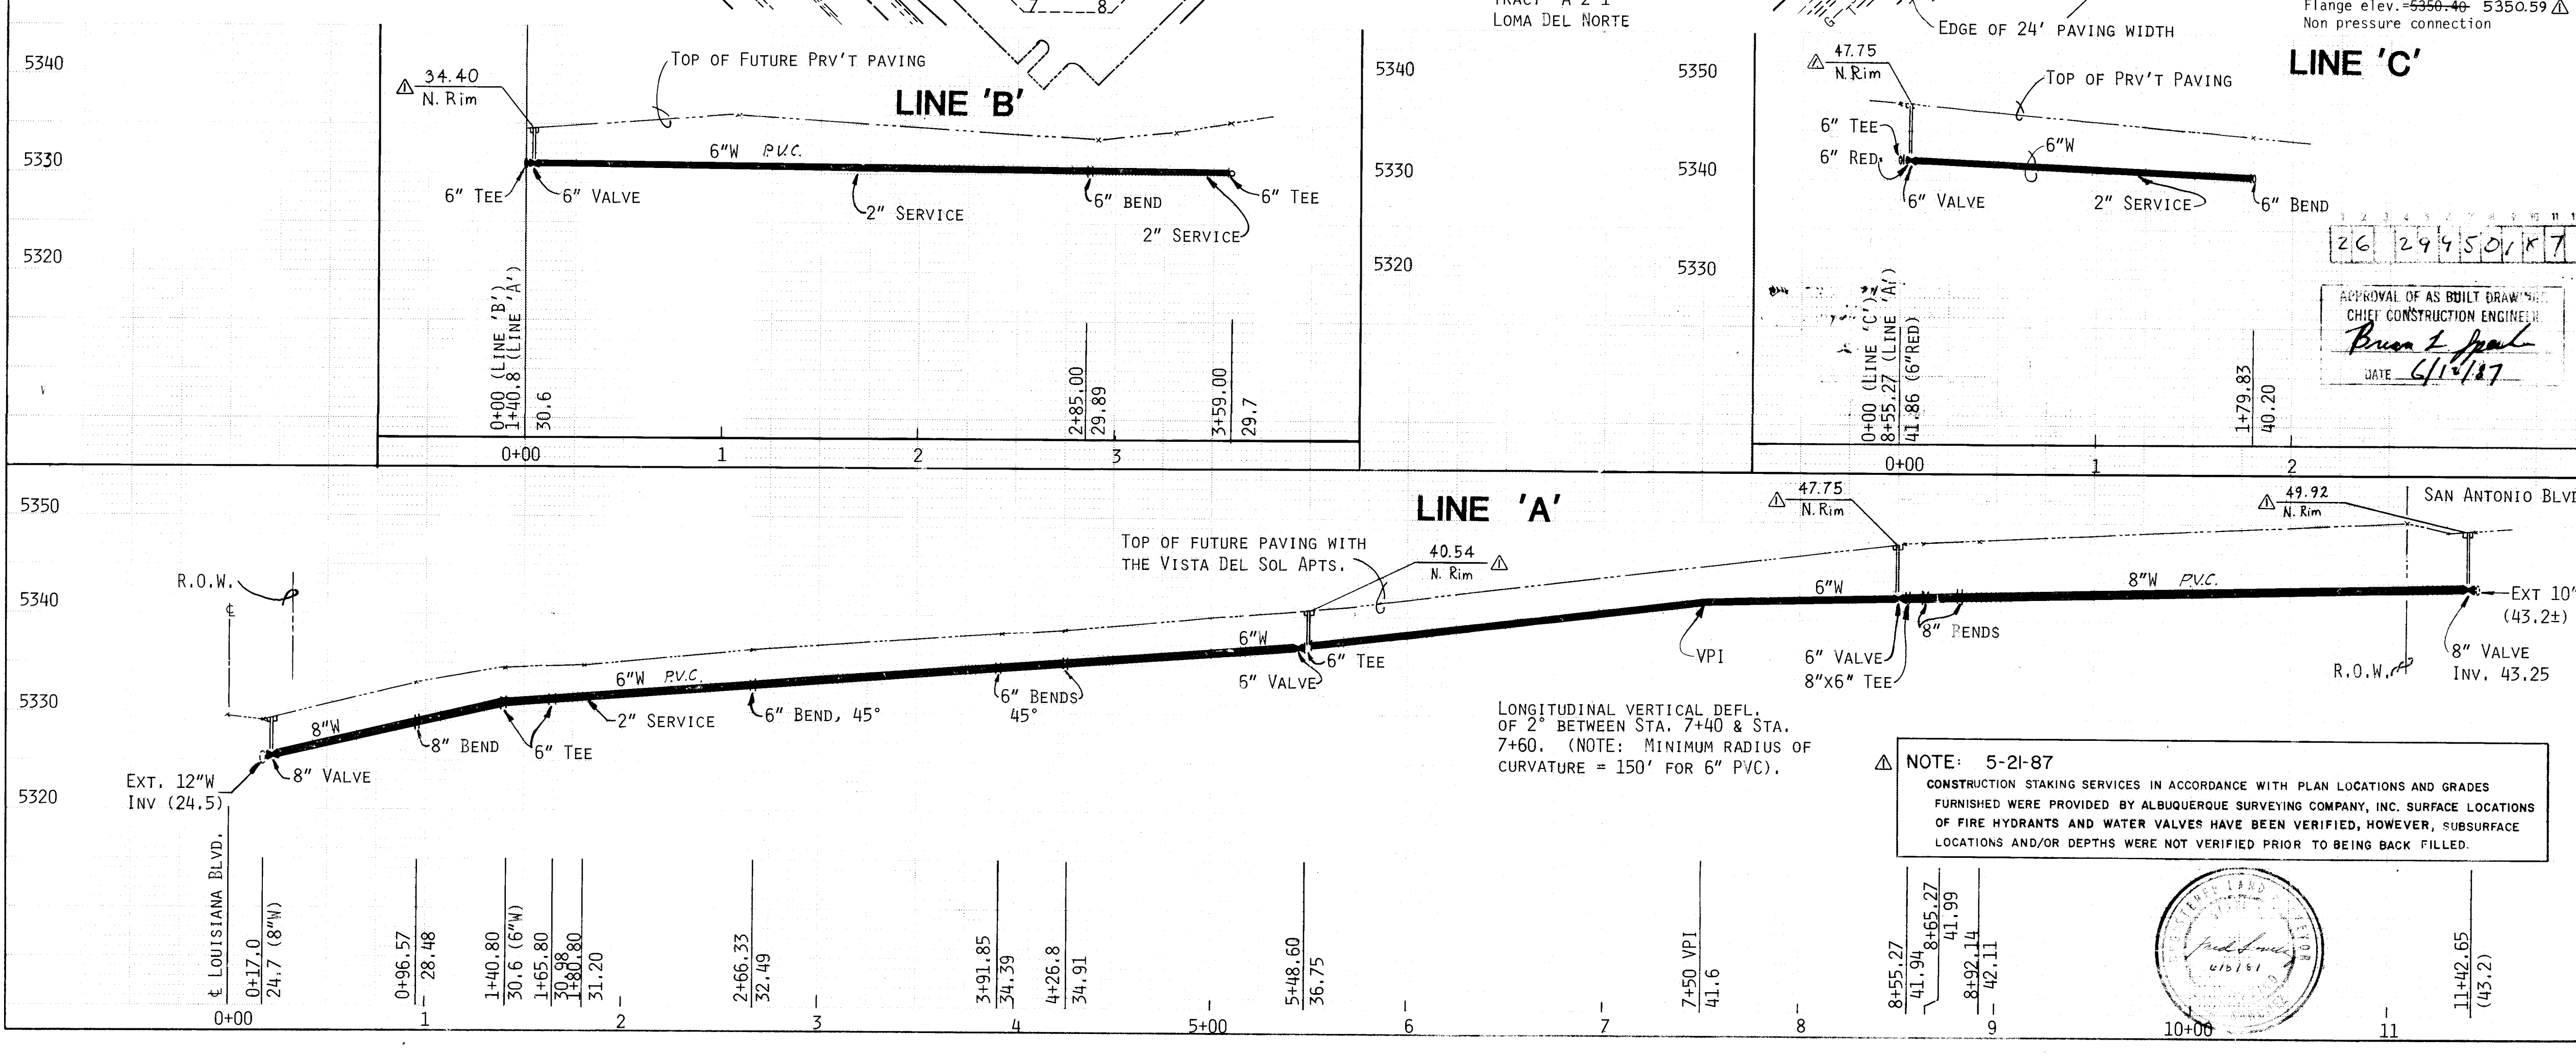


DALE J. BELLAMAH
LOMA DEL NORTE
UNIT 1

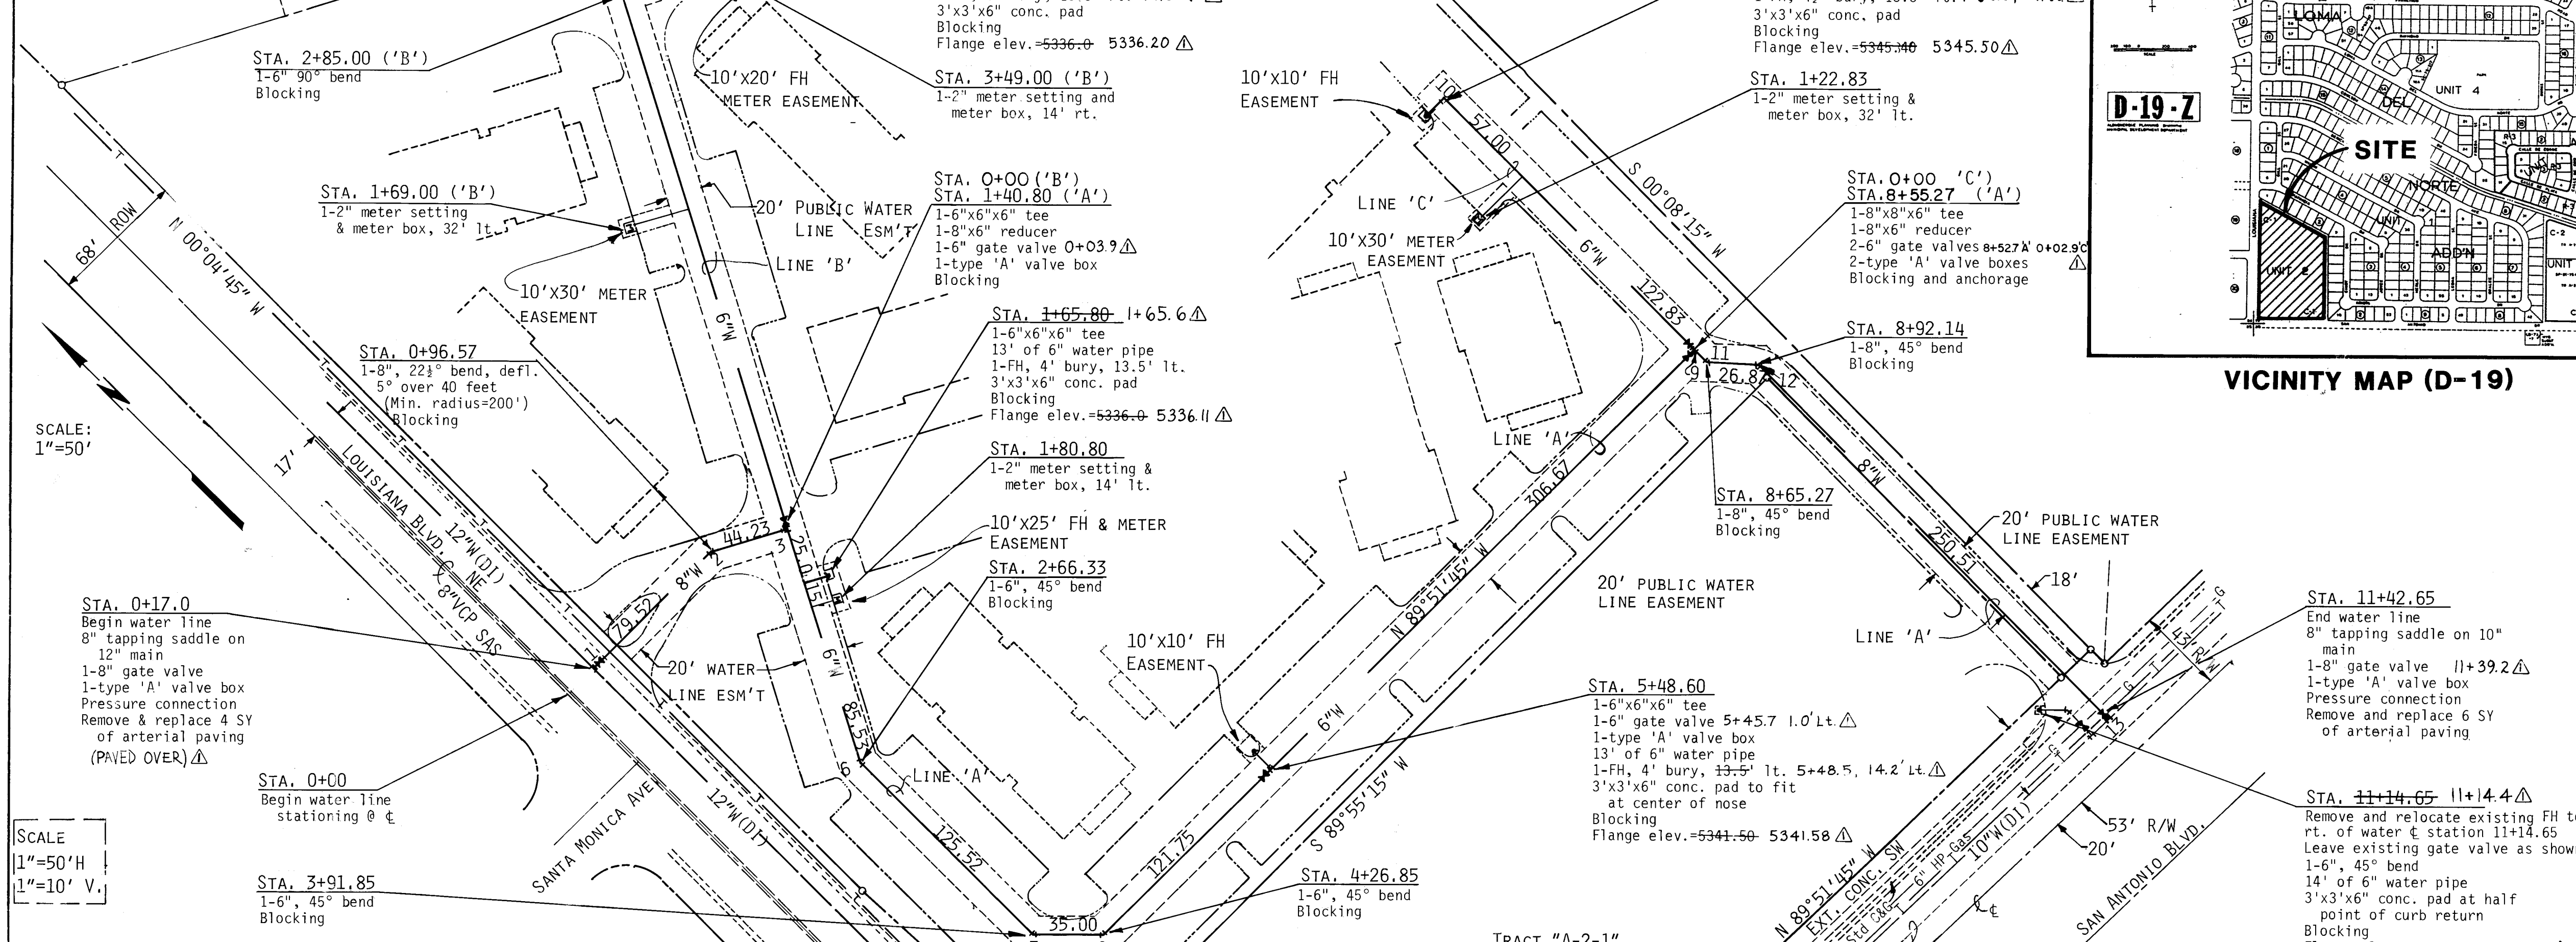

GENERAL NOTES

- ALL WORK DETAILED ON THESE PLANS TO BE PERFORMED UNDER CONTRACT SHALL, EXCEPT AS OTHERWISE STATED OR PROVIDED FOR HEREON, BE CONSTRUCTED IN ACCORDANCE WITH THE CITY OF ALBUQUERQUE INTERIM STANDARD SPECIFICATIONS FOR PUBLIC WORKS CONSTRUCTION, 1985.
- TWO (2) WORKING DAYS PRIOR TO ANY EXCAVATION, CONTRACTOR MUST CONTACT LINE LOCATING SERVICE, 765-1234, FOR LOCATION OF EXISTING UTILITIES.
- PRIOR TO CONSTRUCTION, THE CONTRACTOR SHALL EXCAVATE AND VERIFY THE HORIZONTAL AND VERTICAL LOCATIONS OF ALL OBSTRUCTIONS. SHOULD A CONFLICT EXIST, THE CONTRACTOR SHALL NOTIFY THE ENGINEER OR SURVEYOR SO THAT THE CONFLICT CAN BE RESOLVED WITH A MINIMUM AMOUNT OF DELAY.
- ALL UTILITIES AND UTILITY SERVICE LINES SHALL BE INSTALLED PRIOR TO PAVING.
- TACK COAT REQUIREMENTS SHALL BE DETERMINED BY THE CITY ENGINEER.
- BACKFILL COMPACTION SHALL BE ACCORDING TO SPECIFIED STREET USE.

WATERLINE COURSE TABLE

POINT FROM	TO	BEARINGS	DISTANCE
1	2	N 89°51'15" E	79.52
2	3	S 62°02'00" E	44.23
3	4	N 27°58'00" E	285.00
4	5	S 62°02'00" E	74.00
5	6	S 30°03'14" W	125.53
6	7	S 00°08'15" W	125.52
7	8	S 44°51'55" E	35.00
8	9	S 89°51'45" E	428.42
9	10	N 00°08'15" E	179.83
10	11	S 00°08'15" W	10.00
11	12	S 44°51'45" E	26.87
12	13	S 00°08'15" W	250.51

CONSTRUCTION NOTES:

- REMOVAL OF CONC. CURB & GUTTER AND SIDEWALKS ALONG BOTH LOUISIANA AND SAN ANTONIO IS NOT PART OF THIS CONTRACT. THAT WORK SHALL BE INCLUDED WITHIN THE SCOPE OF PROJECT OF THE VISTA DEL SOL APARTMENTS AND COORDINATED WITH THIS PUBLIC WORK ORDER.
- SHOWN EASEMENTS FOR WATER LINES, FIRE HYDRANTS & METERS SHALL BE PROVIDED TO THE CITY OF ALBUQUERQUE BY OWNER.
- BACKFILL REQUIREMENTS WITHIN THE R.O.W. OF SAN ANTONIO BLVD. & LOUISIANA BLVD. SHALL BE FOR ARTERIAL STREETS PER COA STD. DWGS. P-3 AND P-4.
- CONTRACTOR MUST SUBMIT A TRAFFIC CONTROL PLAN AND RECEIVE A BARRICADING PERMIT PRIOR TO CONSTRUCTION IN SAN ANTONIO BLVD. AND LOUISIANA BLVD.

LEGEND

- 10"W EXT. PUBLIC WATER MAIN
- 6"W WATER LINE THIS PROJECT
- EXT. GATE VALVE
- GATE VALVE
- FIRE HYDRANT W/FITTINGS
- 2" METER SERVICE
- EXT. CURB & GUTTER
- 20' WATER LINE EASEMENT

CITY OF ALBUQUERQUE
MUNICIPAL DEVELOPMENT DEPARTMENT
ENGINEERING DIVISION

TITLE
VISTA DEL SOL APARTMENTS
FIRE PROTECTION LINE

APPROVALS	ENGINEER	DATE	APPROVALS	ENGINEER	DATE
City Engineer	[Signature]	8/29/86	Liquid Waste	[Signature]	8/29/86
ACE - Design	[Signature]	8/29/86	Traffic	[Signature]	8/29/86
ACE - Hydrology	[Signature]	8/29/86	Water	[Signature]	8/29/86

DESIGNED BY	DRAWN BY	CHECKED BY
[Signature]	[Signature]	[Signature]

DRAWING NO. 2995 MAP NO. D-19 SHEET 1 OF 1

Handwritten signature and date: 8/29/86