


CONSTRUCTION PLANS
FOR
LEFT TURNBAY
INDIAN SCHOOL ROAD NE
EAST OF TRAMWAY BLVD NE
CITY OF ALBUQUERQUE
NEW MEXICO

INDEX OF DRAWINGS

SHEET	DESCRIPTION
1	COVER SHEET
2	PLAN & PROFILE
3	SECTIONS & DETAILS
4	SECTIONS & DETAILS

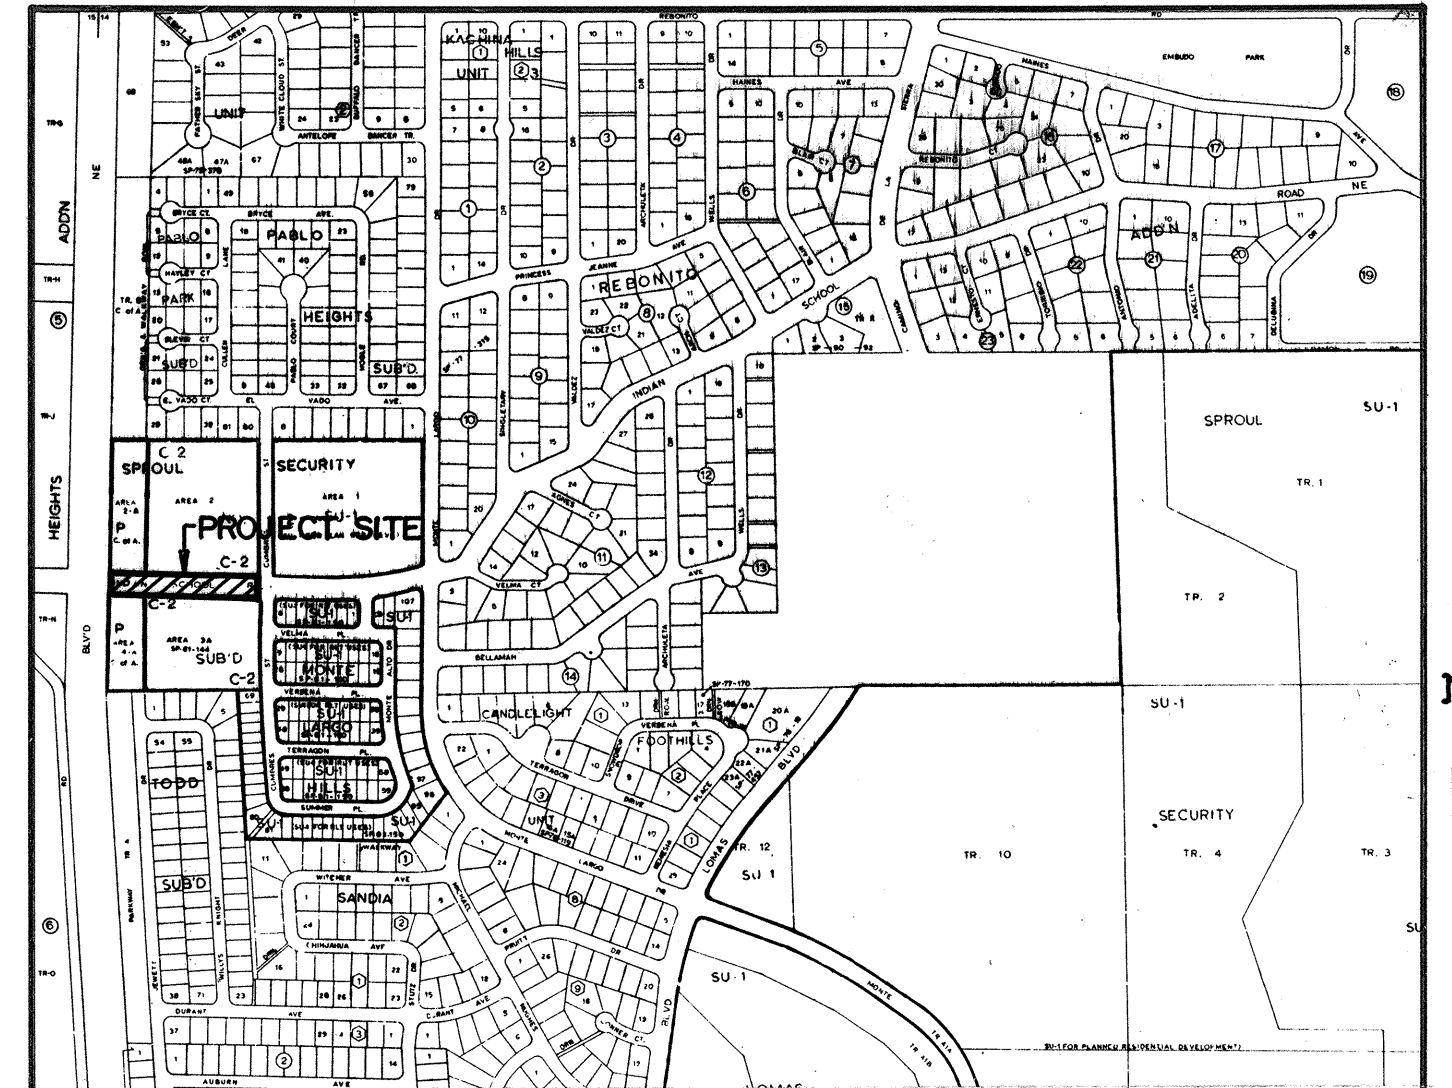


VICINITY MAP

J-23

GENERAL NOTES

- All work detailed on these plans to be performed under contract shall, except as otherwise stated or provided for herein, be constructed in accordance with "City of Albuquerque Interim Standard Specifications Public Works Construction, 1985".
- Two (2) working days prior to any excavation, Contractor shall contact Line Locating Service 765-1234, for location of existing lines.
- References made to Standard Drawings refer to City of Albuquerque Standard Detail Drawings.
- Dimensions shown are to the face of curb unless otherwise noted.
- Stations shown are centerline stations.
- Prior to construction, the Contractor shall excavate and verify the horizontal and vertical locations of all obstructions. Should a conflict exist, the Contractor shall notify the engineer or so that the conflict can be resolved with a minimum amount of delay.
- All utilities and utility service lines shall be installed prior to paving.
- Tack coat requirements shall be determined by the City Engineer.
- Backfill compaction shall be according to specified street use.
- Measurement for payment of subgrade preparation for roadway pavement will be made along the plane of the work and from lip of gutter to lip of gutter or edge of pavement as applicable.
- Subgrade preparation under curb and gutter including one (1) foot behind back of curb, under valley gutters, under median pavement and sidewalks shall be considered incidental to the construction of such and shall be included in the bid price for such items.
- A disposal site for all excess earth material and for removal items shall be obtained by the Contractor. The site shall be in compliance with applicable environmental regulations and approved by the City Engineering Department. All costs incurred in obtaining a disposal site and haul thereto shall be considered incidental to construction and no direct payment will be made therefor.
- All permanent pavement marking and traffic signing will be performed by the City of Albuquerque, Traffic Engineering Department.
- It will be the responsibility of the Contractor to support all gas main and service lines where they are within the area of excavation.
- The contractor shall prepare and submit a detailed traffic control plan, which is subject to the approval of the City Traffic Engineer, three (3) working days in advance of any required closures. See SECTION 19 of the General Conditions.

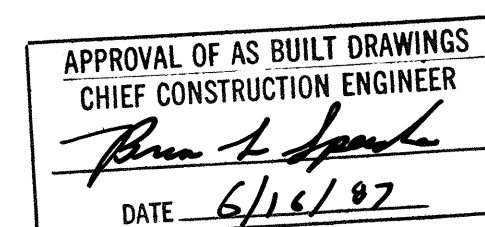

REV.	SHEETS	CITY ENGINEER	DATE	USER	DEPT.	DATE	USER	DEPT.	DATE
APPROVAL OF REVISIONS									



DMJM
Daniel, Mann, Johnson, & Mendenhall
5700 Harper Drive NE, Suite 280
Albuquerque, New Mexico 87109
(505) 822-7955


APPROVED FOR
CONSTRUCTION
[Signature]
C.E.

2996

SHEET 1 OF 4


1 2 3 4 5 6 7 8 9 10 11 12
26 29960187

SPROUL SECURITY SUBDIVISION NO. 2 AREA 2

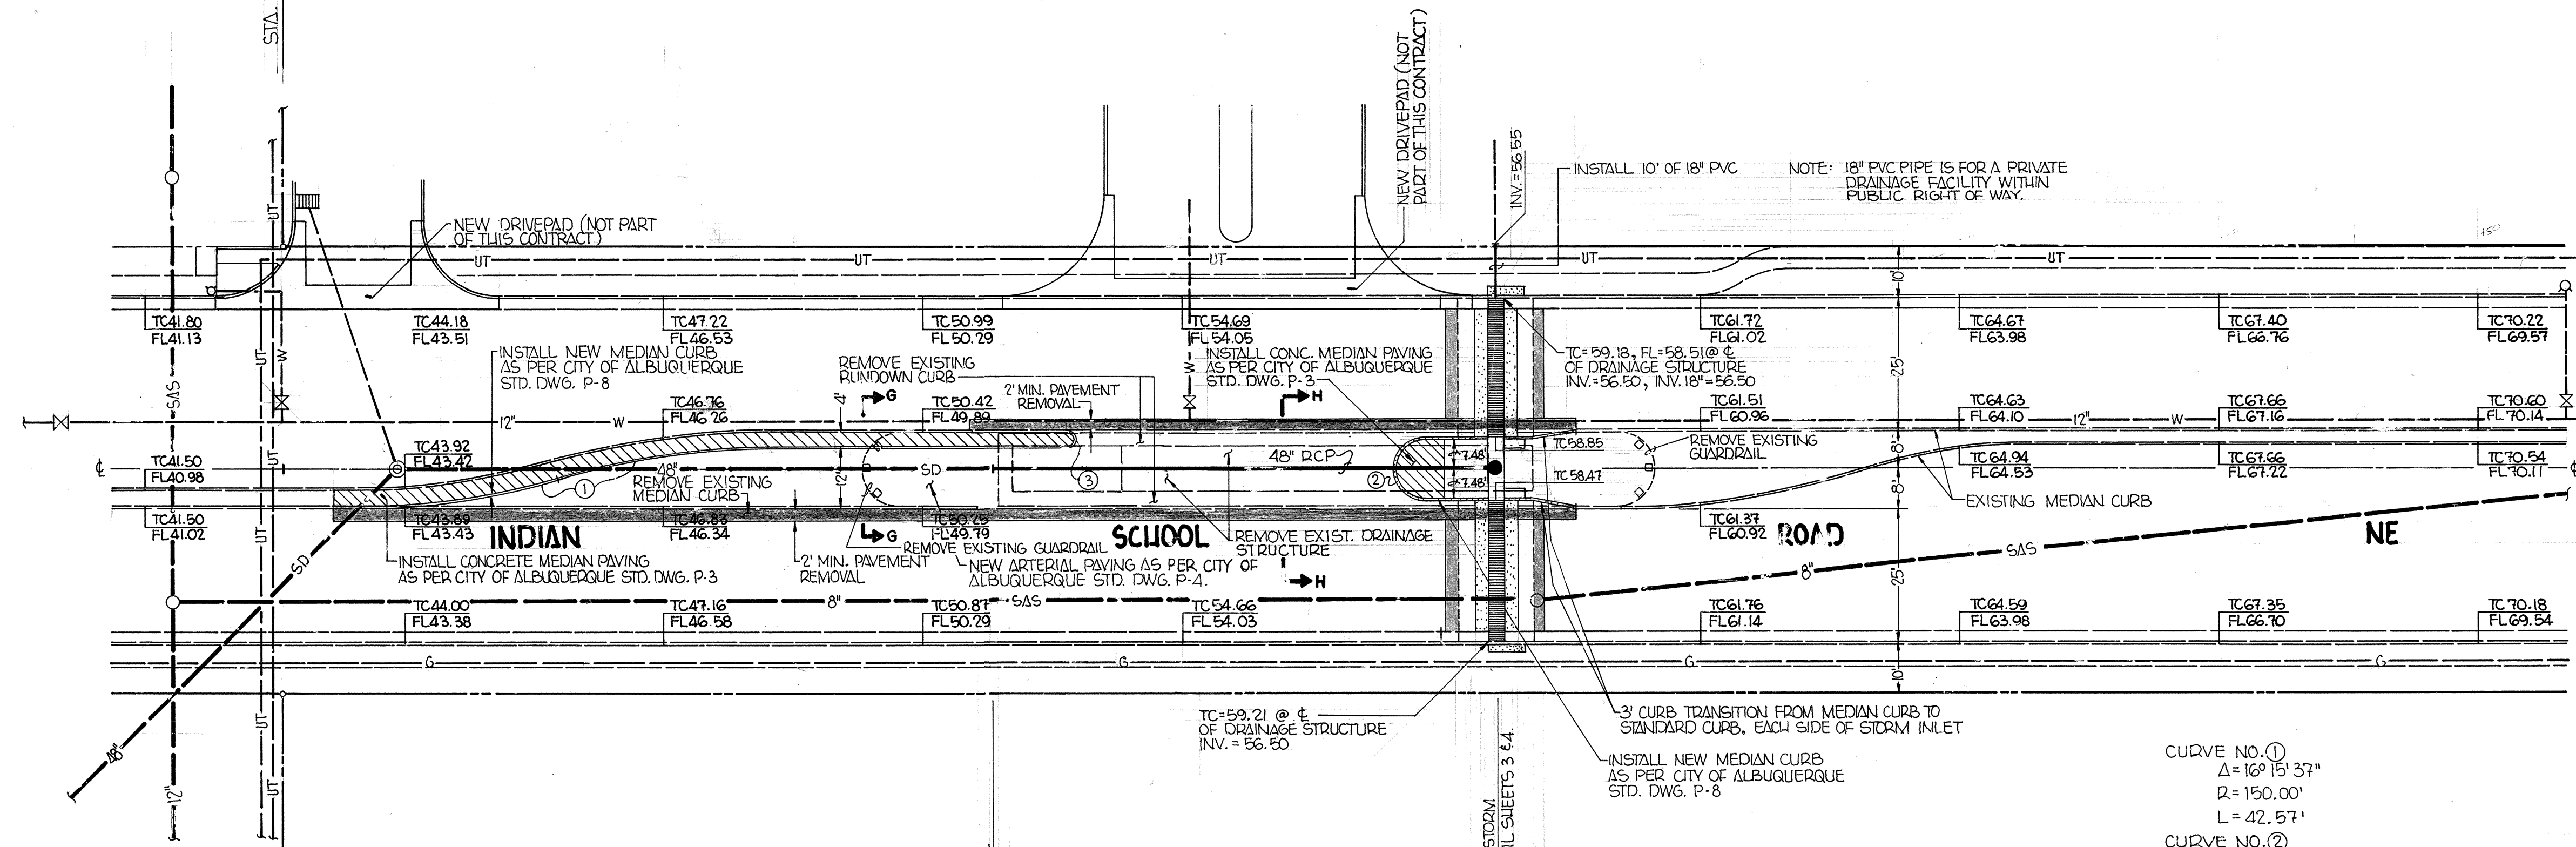

CURVE NO. ①
 $\Delta = 109^{\circ}15'37''$
 $R = 150.00'$
 $L = 42.57'$
 CURVE NO. ②
 $\Delta = 180^{\circ}00'00''$
 $R = 7.48'$
 $L = 23.50'$
 CURVE NO. ③
 $\Delta = 180^{\circ}00'00''$
 $R = 2.00'$
 $L = 6.28'$

HORIZONTAL: 1"=20'
 VERTICAL: 1"=10'

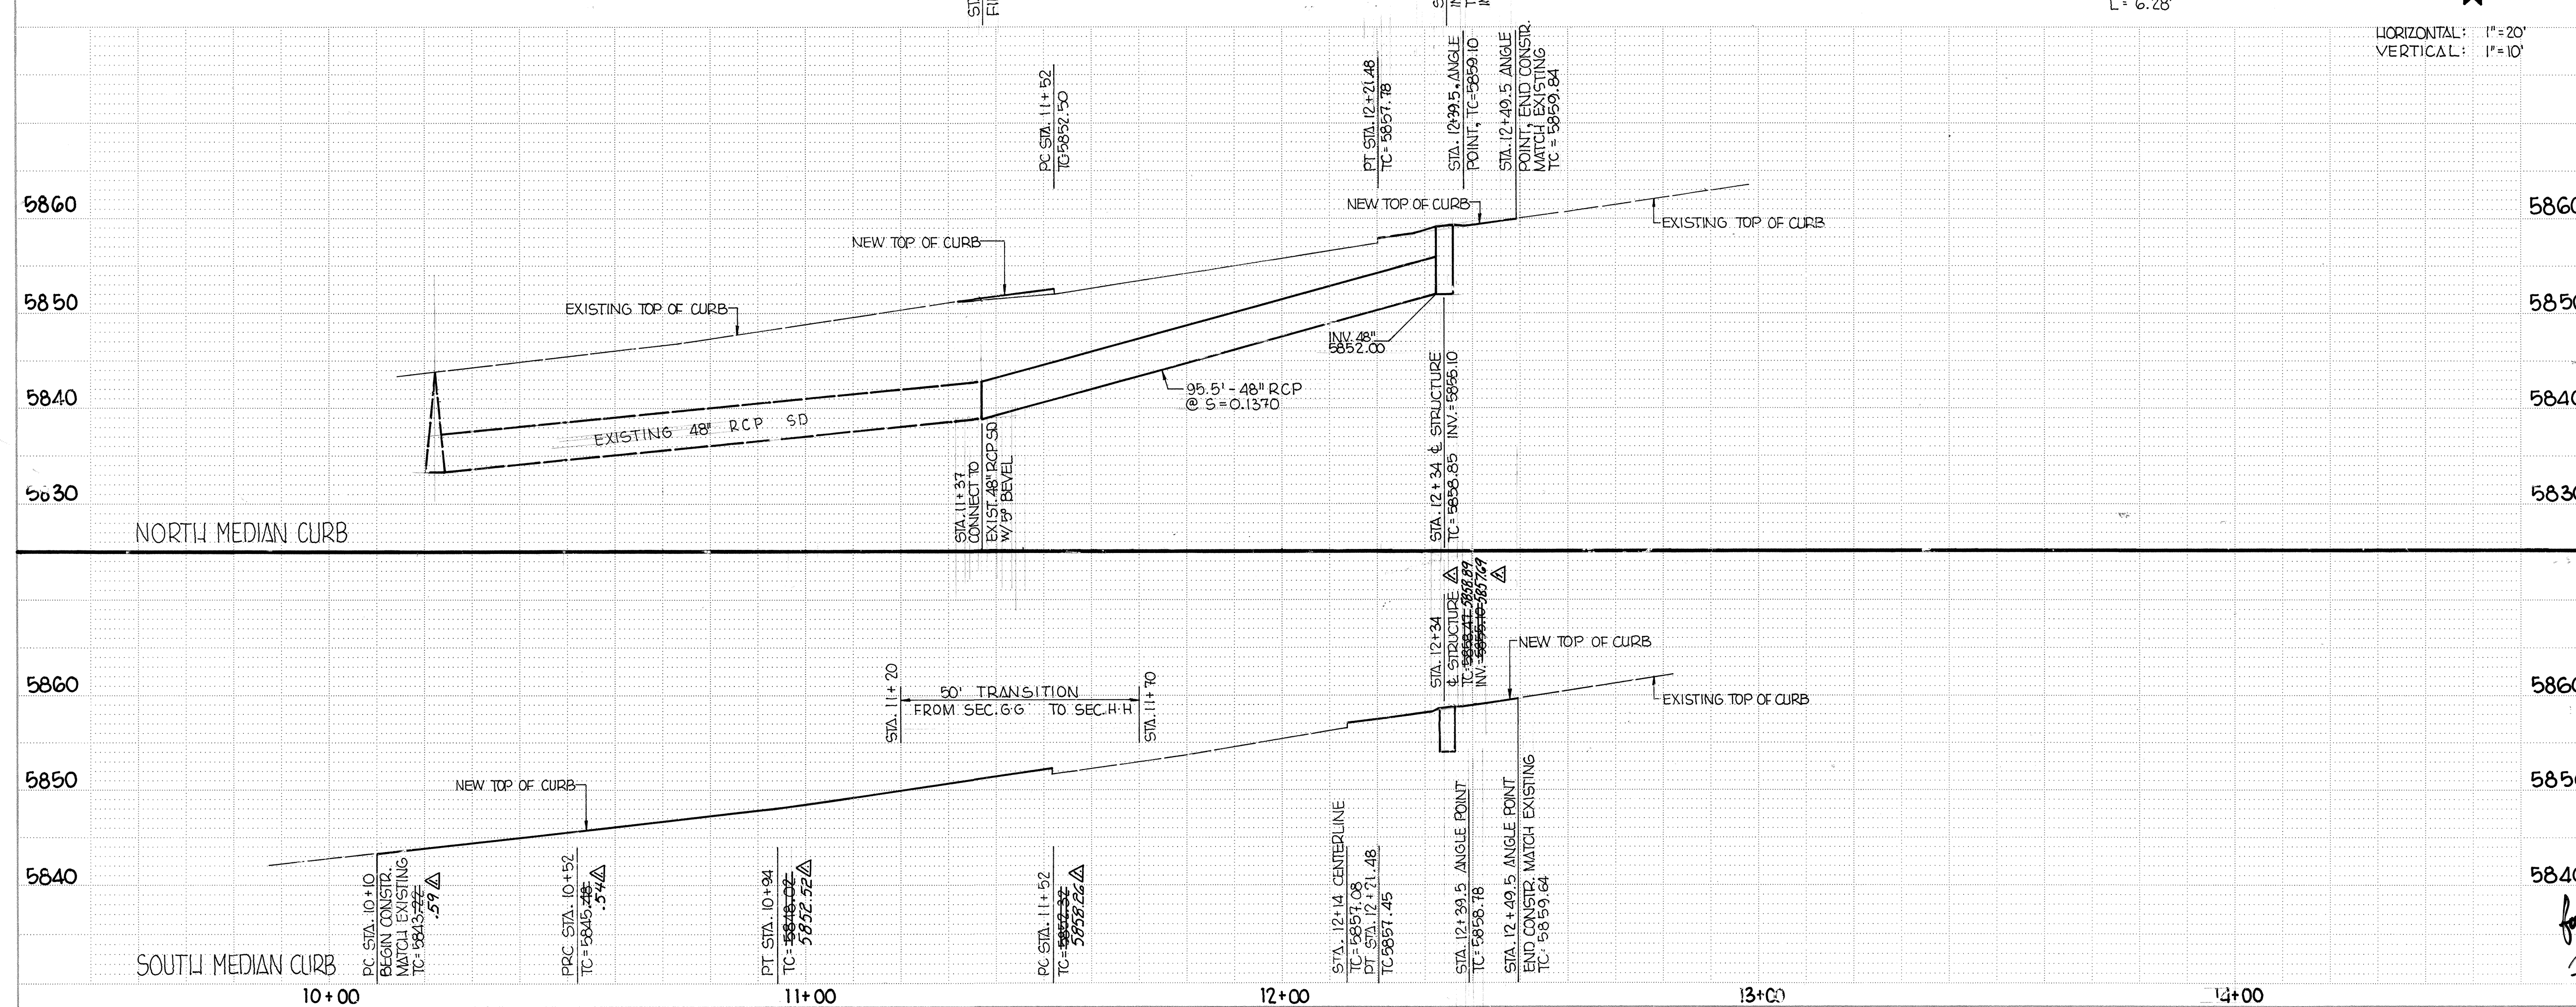

- NOTES:
- 1) ALL STORM DRAIN PIPE SHALL BE CLASS IV RCP, SIZE AS SHOWN.
 - 2) STA. 10+00 = OF INDIAN SCHOOL ROAD NE AT THE PROJECTION OF THE SW CORNER OF SPROUL SECURITY SUBDIVISION NO. 2, AREA 2.
 - 3) ALL REINFORCING STEEL SHALL BE ASTM A615 GRADE 60.
 - 4) CONCRETE SHALL ATTAIN A MINIMUM COMPRESSIVE STRENGTH $f_c = 3000$ PSI @ 28 DAYS, CONCRETE SHALL BE PER CITY STANDARD SPECIFICATIONS AND AIR ENTRAINED.


AS BUILT INFORMATION		BENCH MARKS		SURVEY INFORMATION		ENGINEER'S SEAL	
CONTRACTOR	DATE	AC5 BRASS TABLET	DATE	NO.	BY	NO.	BY
RUSS PINNEY <td>6/1/87 <td>1-23-A, 1982 <td>580.58 <td></td> <td></td> <td></td> <td></td> </td></td></td>	6/1/87 <td>1-23-A, 1982 <td>580.58 <td></td> <td></td> <td></td> <td></td> </td></td>	1-23-A, 1982 <td>580.58 <td></td> <td></td> <td></td> <td></td> </td>	580.58 <td></td> <td></td> <td></td> <td></td>				
CITY <td>6/1/87 <td>AC5 BOOK, PAGE C-609 <td>W/ REVISION NO. 7 <td></td> <td></td> <td></td> <td></td> </td></td></td>	6/1/87 <td>AC5 BOOK, PAGE C-609 <td>W/ REVISION NO. 7 <td></td> <td></td> <td></td> <td></td> </td></td>	AC5 BOOK, PAGE C-609 <td>W/ REVISION NO. 7 <td></td> <td></td> <td></td> <td></td> </td>	W/ REVISION NO. 7 <td></td> <td></td> <td></td> <td></td>				
INSPECTOR'S <td>DATE <td></td> <td></td> <td></td> <td></td> <td></td> <td></td> </td>	DATE <td></td> <td></td> <td></td> <td></td> <td></td> <td></td>						
FIELD ENGINEER <td>DATE <td></td> <td></td> <td></td> <td></td> <td></td> <td></td> </td>	DATE <td></td> <td></td> <td></td> <td></td> <td></td> <td></td>						
VERIFICATION BY <td>DATE <td></td> <td></td> <td></td> <td></td> <td></td> <td></td> </td>	DATE <td></td> <td></td> <td></td> <td></td> <td></td> <td></td>						
CORRECTED BY <td>DATE <td></td> <td></td> <td></td> <td></td> <td></td> <td></td> </td>	DATE <td></td> <td></td> <td></td> <td></td> <td></td> <td></td>						
MICRO-FILM <td>DATE <td></td> <td></td> <td></td> <td></td> <td></td> <td></td> </td>	DATE <td></td> <td></td> <td></td> <td></td> <td></td> <td></td>						
RECORDED BY <td>DATE <td></td> <td></td> <td></td> <td></td> <td></td> <td></td> </td>	DATE <td></td> <td></td> <td></td> <td></td> <td></td> <td></td>						
NO.							

REVISIONS			
NO.	DATE	REMARKS	BY
1	6/1/87	REVISED FROM AS-BUILT INFORMATION	EN

DESIGN			
DESIGNED BY	DATE	CHECKED BY	DATE
JM	07/86		


CITY OF ALBUQUERQUE MUNICIPAL DEVELOPMENT DEPARTMENT ENGINEERING DIVISION			
TITLE: INDIAN SCHOOL ROAD NE PAVING AND STORM DRAIN PLAN & PROFILE			
APPROVALS	ENGINEER	DATE	APPROVALS
City Engineer	John L. 9/1/86	9/1/86	Liquid Waste
A.C.E. - Design	Robert H. 9/1/86	9/1/86	Traffic
A.C.E. - Hydrology	Robert H. 9/1/86	9/1/86	Water

DRAWING NO.	MAP NO.	SHEET	OF
2996	J-23	2	4

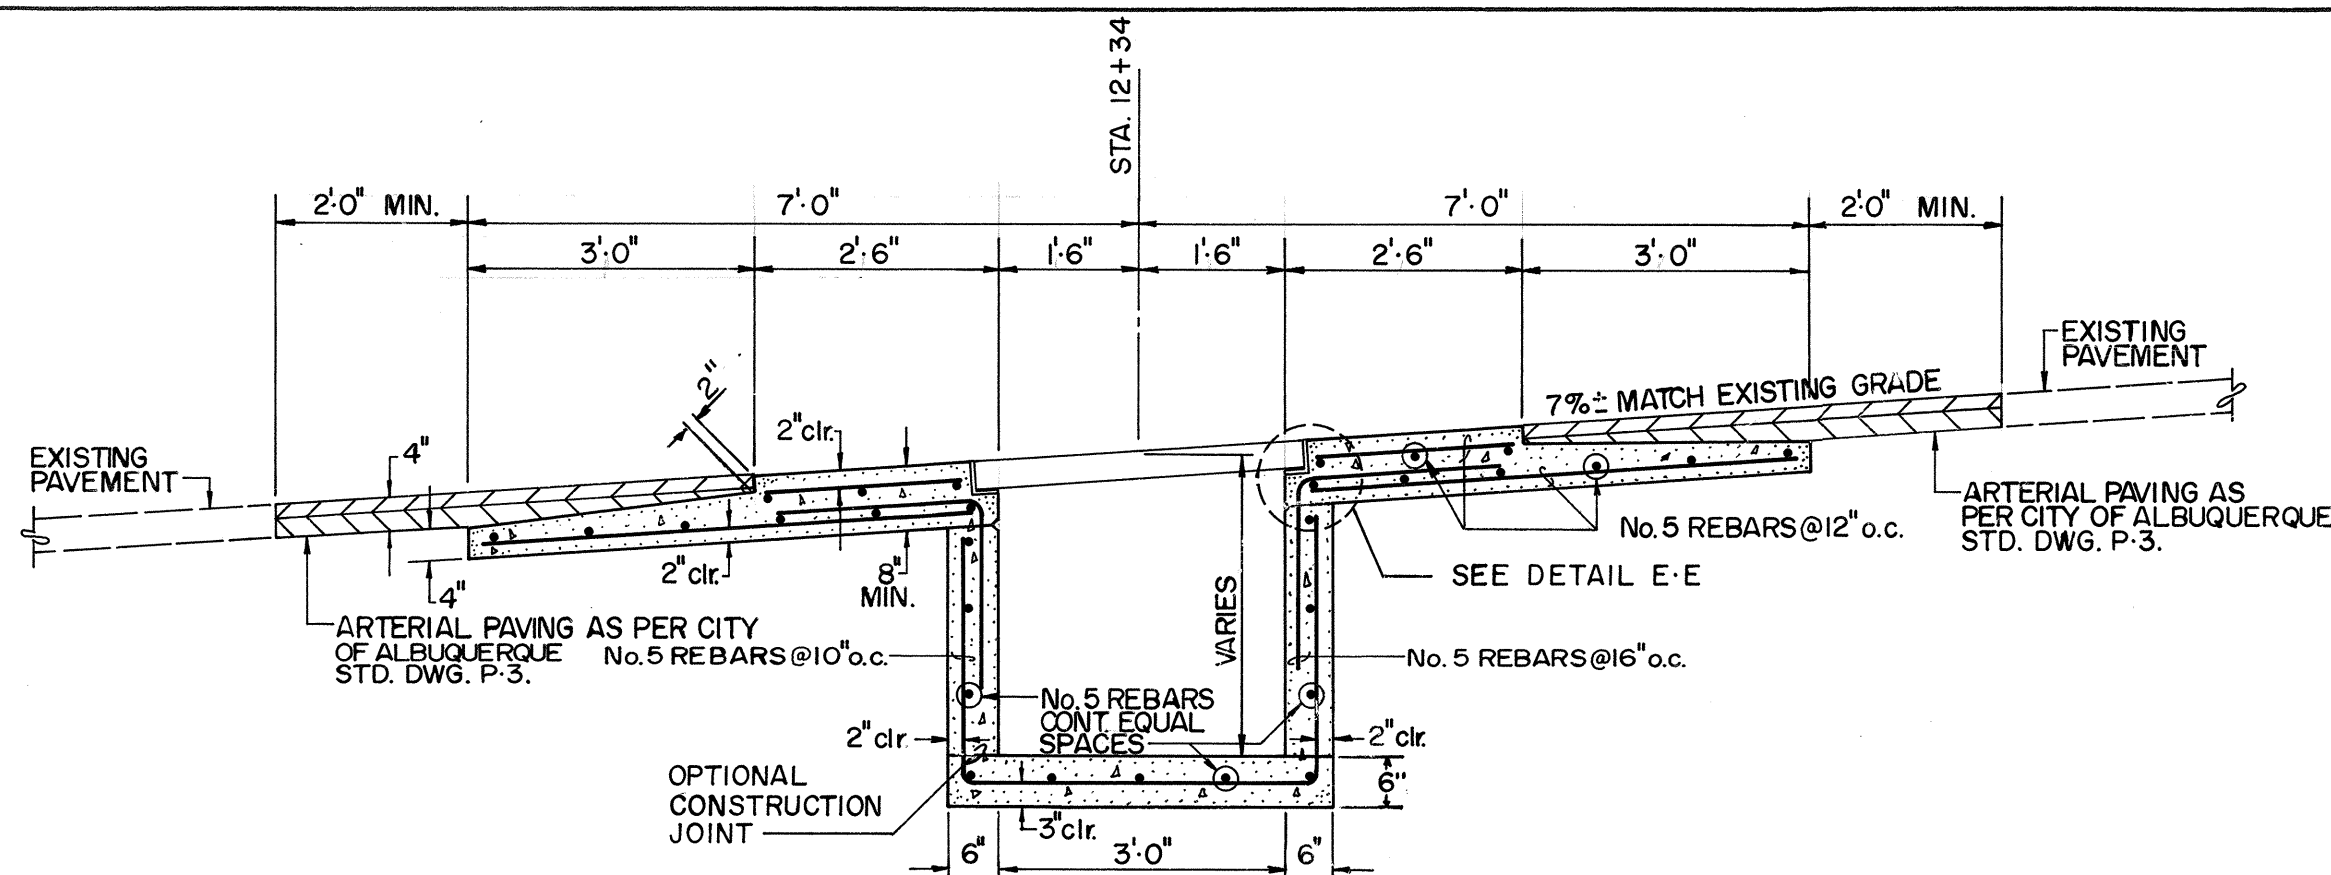


SECTION B-B

NO SCALE

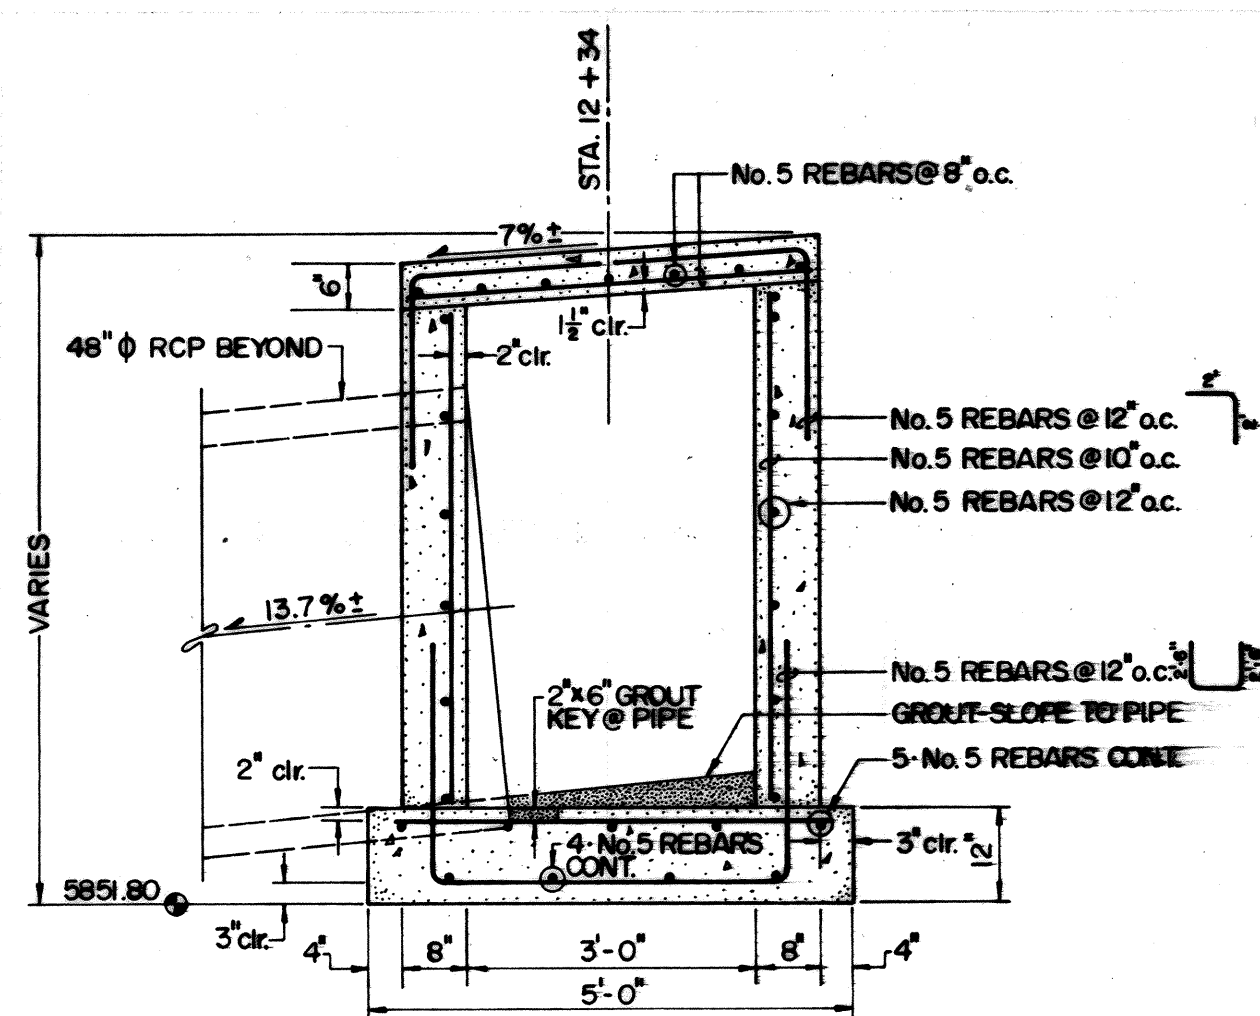


SECTION C-C

NO SCALE

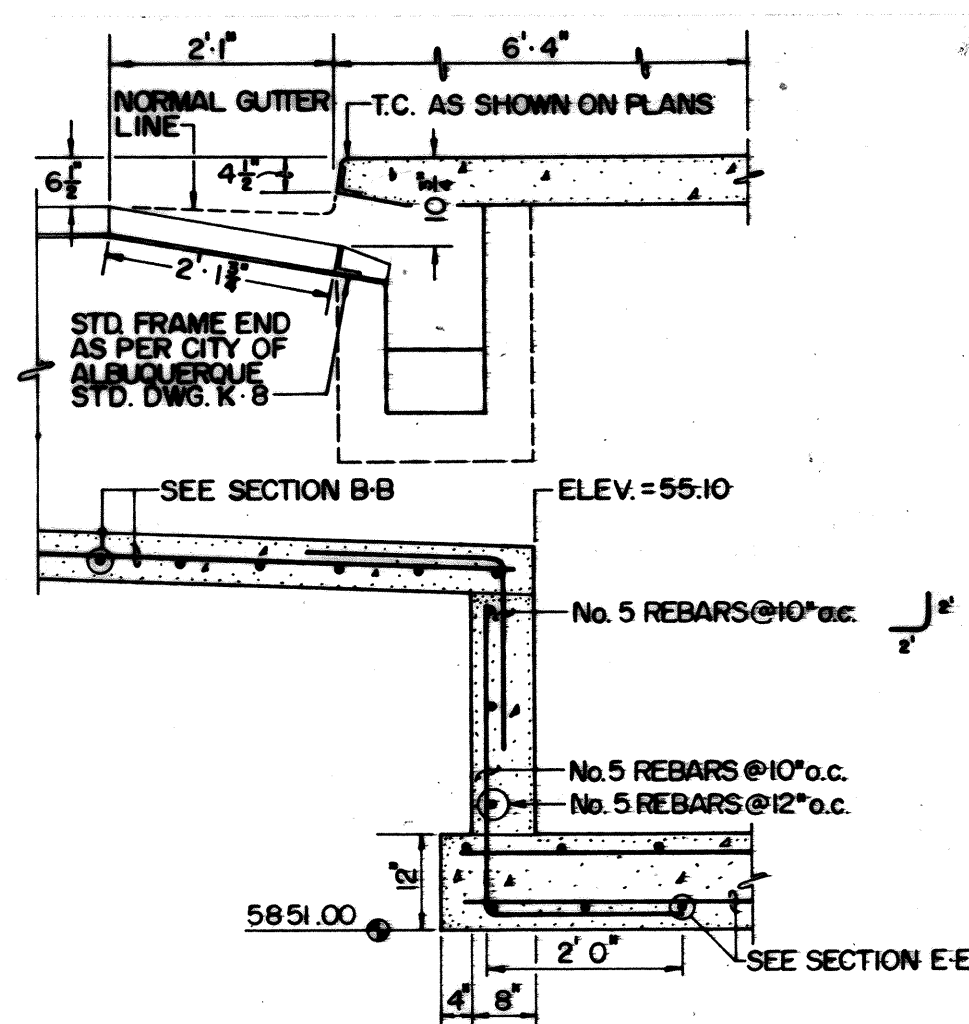


SECTION D-D

NO SCALE

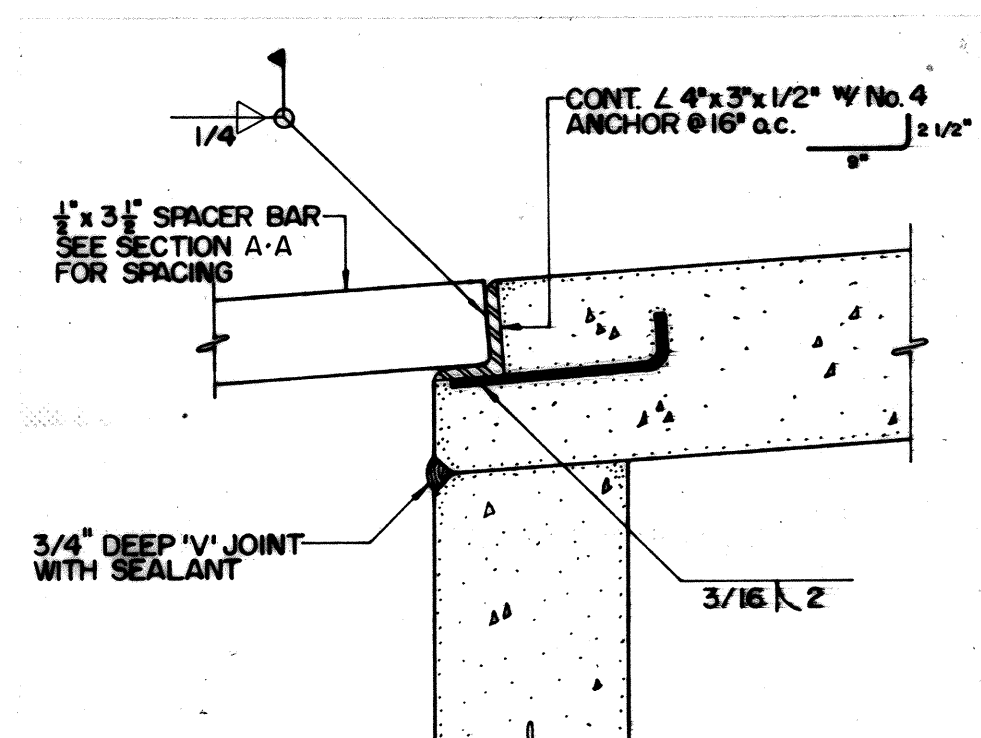


DETAIL E-E

NO SCALE

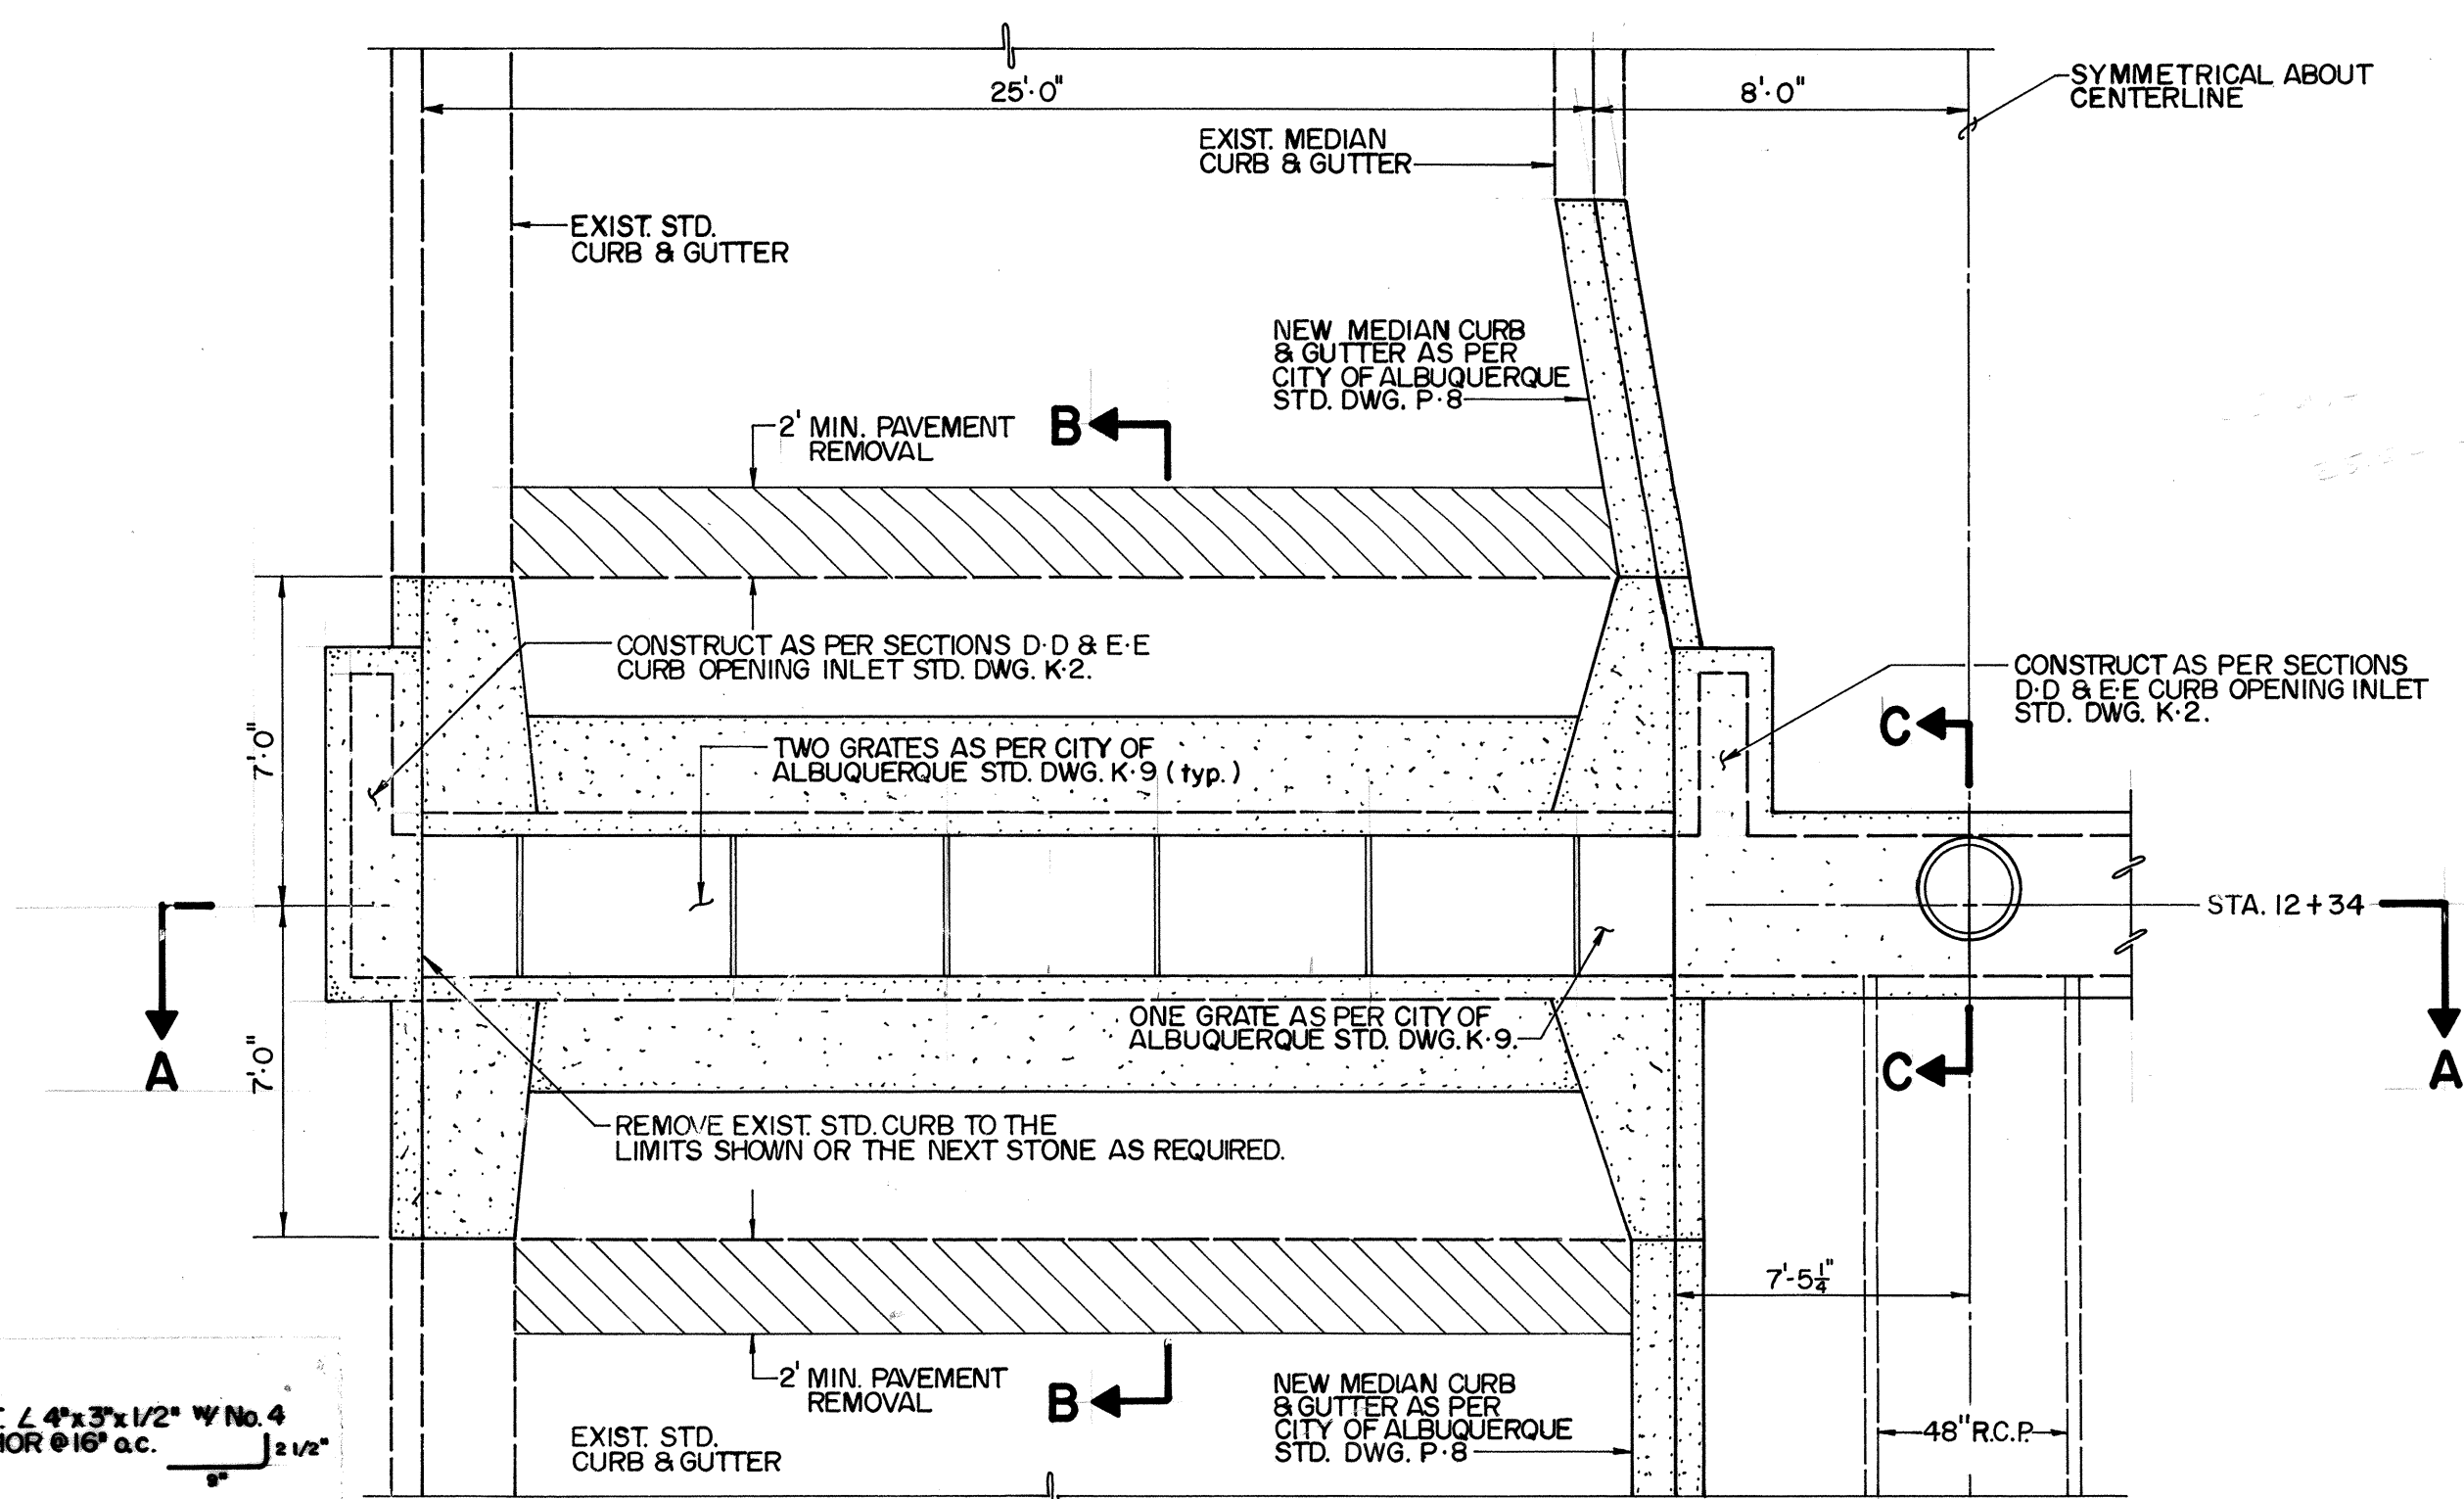


PLAN

1/4" = 1'-0"

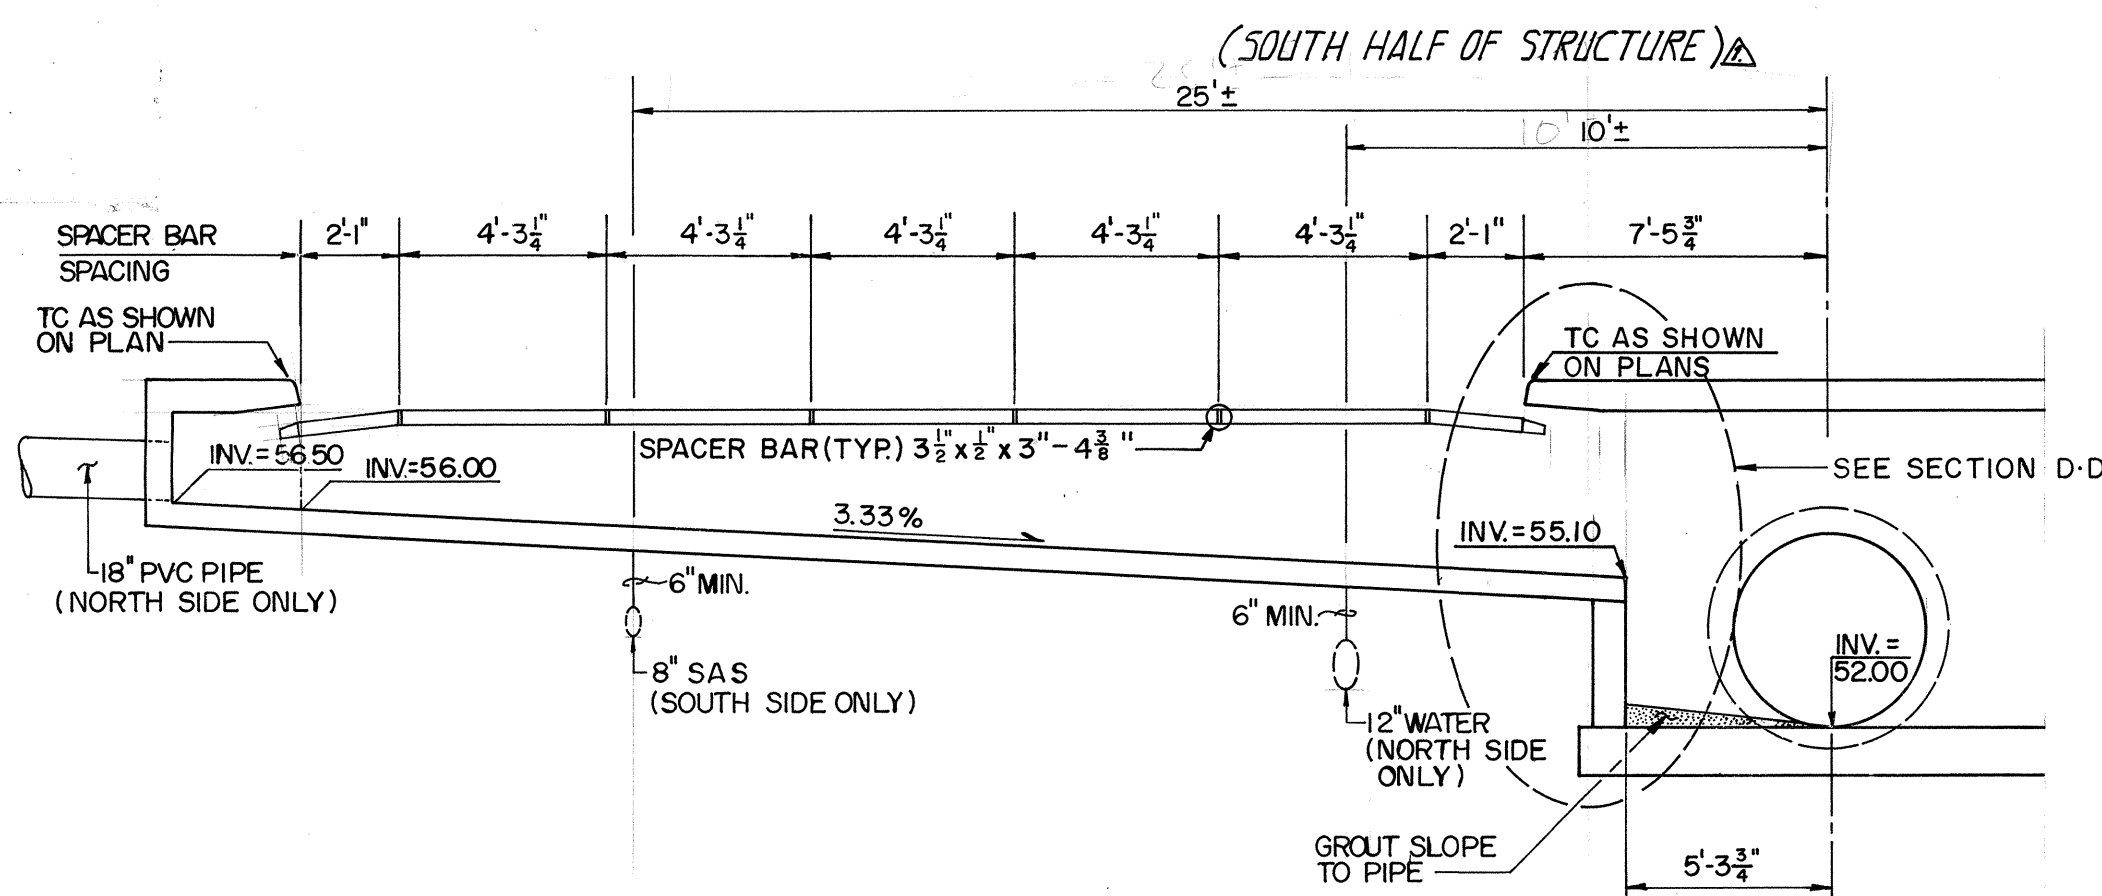

SECTION A-A


1/4" = 1'-0"

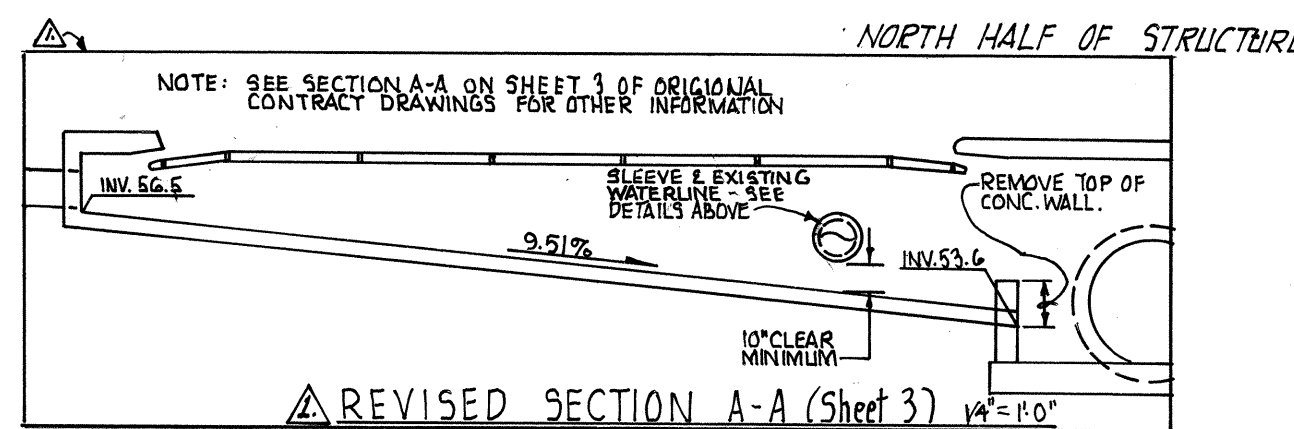



NOTES:

- 1) ALL STORM DRAIN PIPE SHALL BE CLASS IV RCP, SIZE AS SHOWN.
- 2) STA. 10+00 = OF INDIAN SCHOOL ROAD NE AT THE PROJECTION OF THE SW CORNER OF SPROUL SECURITY SUBDIVISION NO. 2, AREA 2.
- 3) ALL REINFORCING STEEL SHALL BE ASTM A615 GRADE 60.
- 4) CONCRETE SHALL ATTAIN A MINIMUM COMPRESSIVE STRENGTH $f_c = 3000$ PSI @ 28 DAYS, CONCRETE SHALL BE PER CITY STANDARD SPECIFICATIONS AND AIR ENTRAINMENT.

AS BUILT INFORMATION				BENCH MARKS				SURVEY INFORMATION				ENGINEER'S SEAL			
CONTRACTOR	DATE	WORK	INSPECTION	ACCS BRASS TABLET	STAMPED	1-23-A, 1092	ELEV. = 5840.58	NO.	BY	DATE	REVISION	NO.	BY	DATE	REVISION
RUSS PITNEY	6/1/87	CITY	DATE	5840.58	1-23-A, 1092	1092	5840.58	1-23-A, 1092	1-23-A, 1092	1-23-A, 1092	1-23-A, 1092	1-23-A, 1092	1-23-A, 1092	1-23-A, 1092	1-23-A, 1092
DATE	DATE	DATE	DATE	DATE	DATE	DATE	DATE	DATE	DATE	DATE	DATE	DATE	DATE	DATE	DATE
DATE	DATE	DATE	DATE	DATE	DATE	DATE	DATE	DATE	DATE	DATE	DATE	DATE	DATE	DATE	DATE

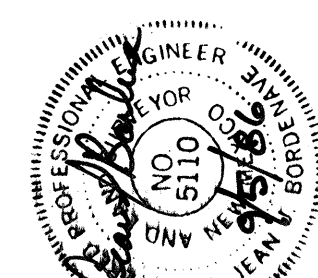

CITY OF ALBUQUERQUE MUNICIPAL DEVELOPMENT DEPARTMENT ENGINEERING DIVISION				TITLE: INDIAN SCHOOL ROAD NE SECTIONS AND DETAILS			
APPROVALS	ENGINEER	DATE	APPROVALS	ENGINEER	DATE	APPROVALS	ENGINEER
City Engineer	9/12/86	9/12/86	Liquid Waste	N/A	9/12/86	City Engineer	9/12/86
A.C.E. - Design	9/12/86	9/12/86	Traffic	N/A	9/12/86	A.C.E. - Design	9/12/86
A.C.E. - Hydrology	9/12/86	9/12/86	Water	N/A	9/12/86	A.C.E. - Hydrology	9/12/86
DRAWING NO.	2996	MAP NO.	J-23	SHEET	3	OF	4

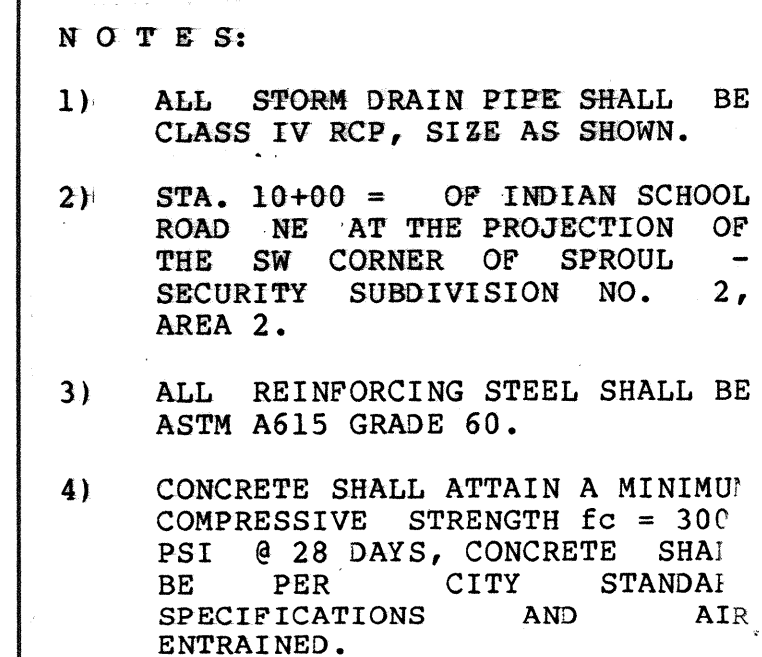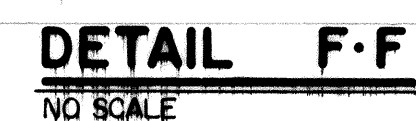[illegible]

CITY OF ALBUQUERQUE
MUNICIPAL DEVELOPMENT DEPARTMENT
ENGINEERING DIVISION

TITLE: INDIAN SCHOOL ROAD NE
SECTIONS AND DETAILS

APPROVALS	ENGINEER	DATE	APPROVALS	ENGINEER	DATE
City Engineer	<i>[Signature]</i>	9/12/86	Liquid Waste	N/A <i>[Signature]</i>	9/12/86
A.C.E - Design	<i>[Signature]</i>	9/17/86	Traffic	<i>[Signature]</i>	9/12/86
A.C.E - Hydrology	<i>[Signature]</i>	9/17/86	Water	N/A <i>[Signature]</i>	9/12/86

DRAWING NO.	2996	MAP NO.	J-23	SHEET	4	OF	4
-------------	------	---------	------	-------	---	----	---