


EMPLOYMENT SERVICE CENTER

FIRE HYDRANT IMPROVEMENTS

ALBUQUERQUE NEW MEXICO

INDEX	
SHEET	TITLE
1.	TITLE SHEET & VICINITY MAP.
2.	FIRE HYDRANT IMPROVEMENTS PLAN.

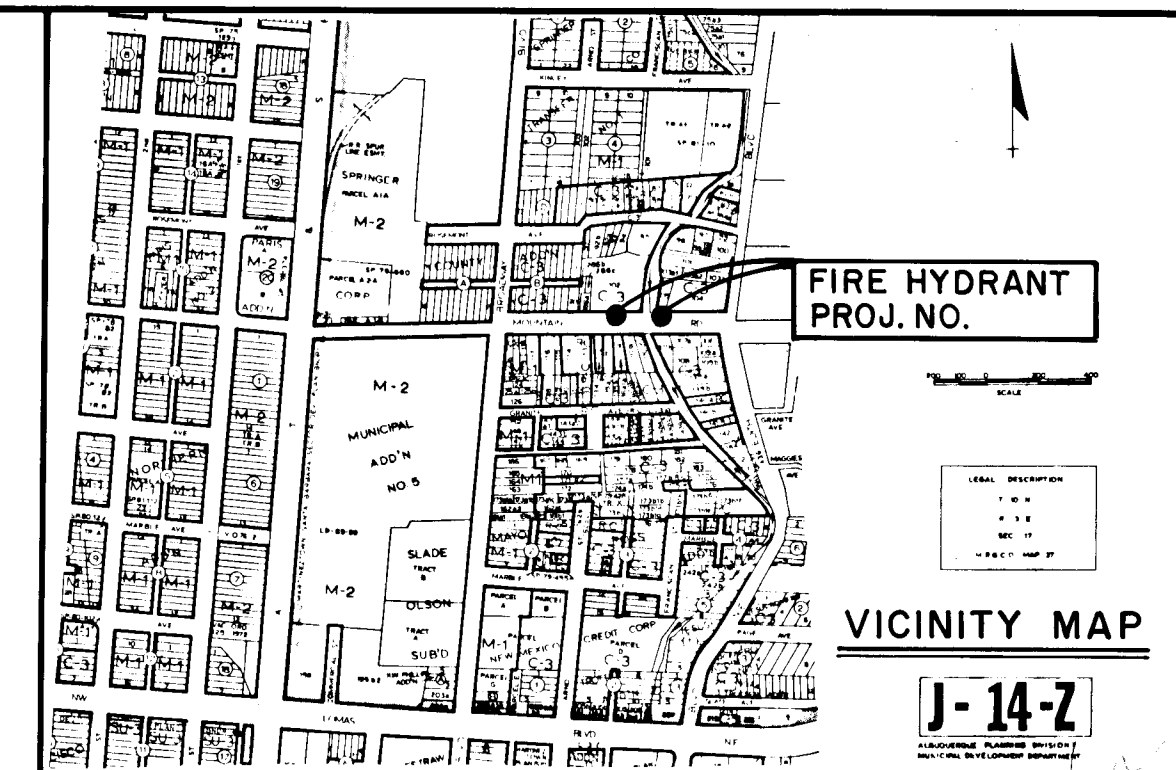

NOTICE TO CONTRACTORS

- ALL WORK DETAILED ON THESE PLANS TO BE PERFORMED UNDER CONTRACT SHALL, EXCEPT AS OTHERWISE STATED OR PROVIDED FOR HEREON, BE CONSTRUCTED IN ACCORDANCE WITH THE CITY OF ALBUQUERQUE, INTERIM STANDARD SPECIFICATIONS, PUBLIC WORK CONSTRUCTION, 1985.
- TWO (2) WORKING DAYS PRIOR TO ANY EXCAVATION, THE CONTRACTOR MUST CONTACT LINE LOCATING SERVICE, 765-1234 FOR LOCATION OF EXISTING UTILITIES.
- PRIOR TO CONSTRUCTION, THE CONTRACTOR SHALL EXCAVATE AND VERIFY THE HORIZONTAL AND VERTICAL LOCATIONS OF ALL OBSTRUCTIONS. SHOULD A CONFLICT EXIST, THE CONTRACTOR SHALL NOTIFY THE ENGINEER OR SURVEYOR SO THAT THE CONFLICT CAN BE RESOLVED WITH MINIMUM AMOUNT OF DELAY.

THE FOLLOWING NOTES ALSO APPLY WHEN CHECKED

- ☐ ALL UTILITIES AND UTILITY SERVICE LINES SHALL BE INSTALLED PRIOR TO PAVING.
- ☒ BACKFILL COMPACTION SHALL BE ACCORDING TO SPECIFIED STREET USE.
- ☐ TACK COAT REQUIREMENTS SHALL BE DETERMINED BY THE CITY ENGINEER.
- ☐ SIDEWALKS AND WHEELCHAIR RAMPS WITHIN THE CURB RETURN IS CONSTRUCTED.
- ☐ IF CURB IS DEPRESSED FOR A DRIVEPAD OR A HANDICAP RAMP, THE DRIVEPAD OR RAMP SHALL BE CONSTRUCTED PRIOR TO ACCEPTANCE OF THE CURB AND GUTTER.
- ☐ ALL STORM DRAINAGE FACILITIES SHALL BE COMPLETED PRIOR TO FINAL ACCEPTANCE.

NOTE: PRIOR TO CONSTRUCTION THE CONTRACTOR SHALL SECURE A CITY OF ALBUQUERQUE BARRICADING AND/OR DETOURING PERMIT AND AN EXCAVATION PERMIT.

26 30100187

Russell B. Lohr
4-2-87

REV	SHEETS	CITY ENGR.	DATE	USER DEPT.	DATE	USER DEPT.	DATE
APPROVAL OF REVISIONS							




BRIDGERS & PAXTON
CONSULTING ENGINEERS, INC.
4091-C Montquerry Blvd., N.E., Albuquerque, New Mexico

APPROVED FOR
CONSTRUCTION
Russell B. Lohr
CITY ENGINEER 3/2/87

PROJECT NO.
3010

SHEET **1** OF **2**

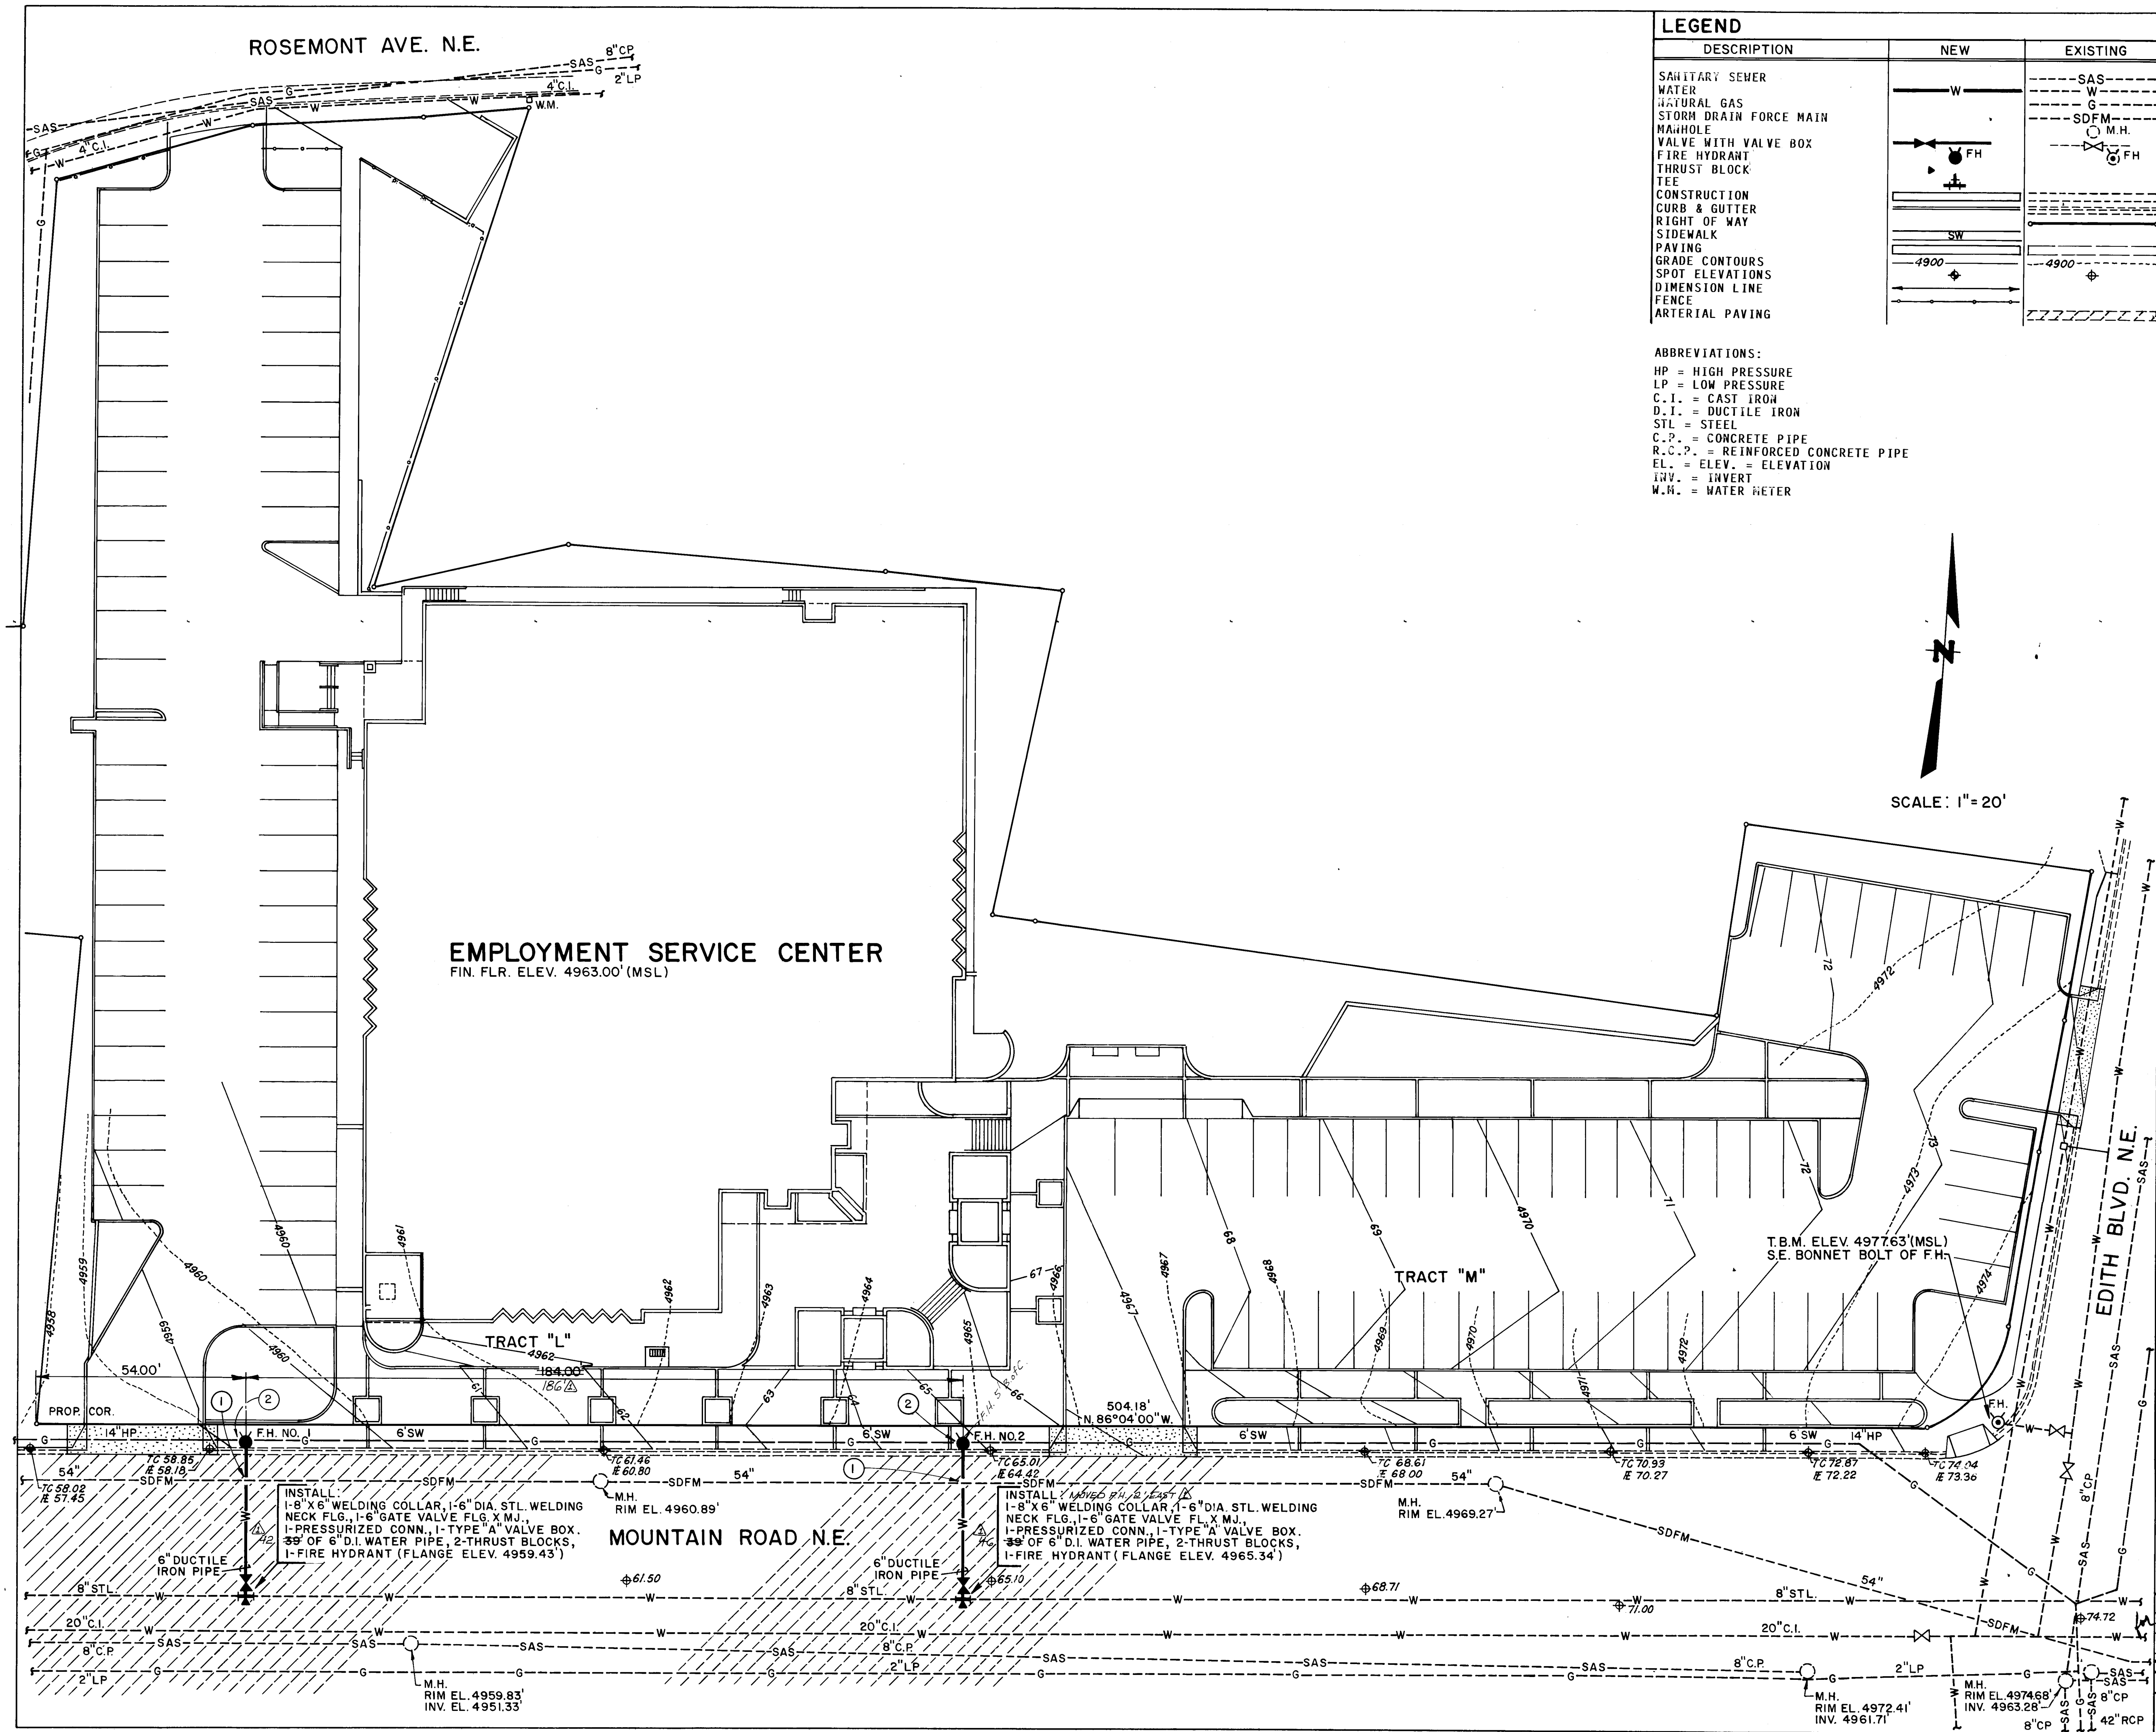

LEGEND

DESCRIPTION	NEW	EXISTING
SANITARY SEWER	---	---
WATER	---	---
NATURAL GAS	---	---
STORM DRAIN FORCE MAIN	---	---
MANHOLE	---	---
VALVE WITH VALVE BOX	---	---
FIRE HYDRANT	---	---
THRUST BLOCK	---	---
TEE	---	---
CONSTRUCTION	---	---
CURB & GUTTER	---	---
RIGHT OF WAY	---	---
PAVING	---	---
GRADE CONTOURS	---	---
SPOT ELEVATIONS	---	---
DIMENSION LINE	---	---
FENCE	---	---
ARTERIAL PAVING	---	---

ABBREVIATIONS:
HP = HIGH PRESSURE
LP = LOW PRESSURE
C.I. = CAST IRON
D.I. = DUCTILE IRON
STL = STEEL
C.P. = CONCRETE PIPE
R.C.P. = REINFORCED CONCRETE PIPE
EL. = ELEV. = ELEVATION
INV. = INVERT
W.M. = WATER METER

GENERAL NOTES

- ALL ITEMS TO BE REMOVED AND RE-PLACED, I.E. PAVEMENT, SIDEWALK, CONCRETE CURB AND GUTTER SHALL BE REPLACED TO MATCH EXISTING. REMOVE CONCRETE ITEMS TO THE NEAREST JOINT.
- FIRE HYDRANTS TO BE INSTALLED AS PER CITY OF ALBUQUERQUE STANDARD DRAWING W-20.

KEYED NOTES

- THE CONTRACTOR SHALL VERIFY THE LOCATION OF THE STORM DRAIN FORCE MAIN BEFORE THE INSTALLATION OF THE NEW FIRE HYDRANT. MINIMUM CLEARANCE OF NEW WATER LINE UNDER STORM DRAIN FORCE MAIN SHALL BE 12".
- THE CONTRACTOR SHALL VERIFY THE LOCATION OF THE EXISTING 14" HIGH PRESSURE GAS MAIN BEFORE INSTALLATION OF THE NEW FIRE HYDRANT. MINIMUM CLEARANCE BETWEEN HYDRANT AND GAS MAIN SHALL BE 12" HORIZONTAL OR VERTICAL OTHERWISE EXTEND THE HYDRANT TO THE NORTH EDGE OF THE 6' SIDEWALK.

AS BUILT INFORMATION		BENCH MARKS		SURVEY INFORMATION		ENGINEER'S SEAL		REVISIONS	
CONTRACTOR: FRED MYERS, INC.		A.C.S. BENCHMARK NO. 15-J14 LOCATED AT THE INTERSECTION OF BROADWAY BLVD. N.E. & MOUNTAIN RD. N.E. IN THE S.E. QUADRANT OF THE INTERSECTION. ELEV. 4955.824' (MSL).		BY: DT. MORRISON, SURVEYOR INC. ALBUQUERQUE, N.M. 5/85		STATE OF NEW MEXICO		DESIGN	
DATE: 3/27/87		DATE: 3/27/87		DATE: 5/85		DATE: 1986		DATE: 1986	
CORRECTED BY: [Signature]		CORRECTED BY: [Signature]		CORRECTED BY: [Signature]		CORRECTED BY: [Signature]		CORRECTED BY: [Signature]	
RECORDED BY: [Signature]		RECORDED BY: [Signature]		RECORDED BY: [Signature]		RECORDED BY: [Signature]		RECORDED BY: [Signature]	
NO. [Blank]		NO. [Blank]		NO. [Blank]		NO. [Blank]		NO. [Blank]	
DATE: [Blank]		DATE: [Blank]		DATE: [Blank]		DATE: [Blank]		DATE: [Blank]	
BY: [Blank]		BY: [Blank]		BY: [Blank]		BY: [Blank]		BY: [Blank]	
REMARKS: [Blank]		REMARKS: [Blank]		REMARKS: [Blank]		REMARKS: [Blank]		REMARKS: [Blank]	
DESIGNED BY: R.G. GIDDINGS		DESIGNED BY: R.G. GIDDINGS		DESIGNED BY: R.G. GIDDINGS		DESIGNED BY: R.G. GIDDINGS		DESIGNED BY: R.G. GIDDINGS	
DRAWN BY: R.G. GIDDINGS		DRAWN BY: R.G. GIDDINGS		DRAWN BY: R.G. GIDDINGS		DRAWN BY: R.G. GIDDINGS		DRAWN BY: R.G. GIDDINGS	
CHECKED BY: R.G. BROWN, P.E.		CHECKED BY: R.G. BROWN, P.E.		CHECKED BY: R.G. BROWN, P.E.		CHECKED BY: R.G. BROWN, P.E.		CHECKED BY: R.G. BROWN, P.E.	

26 30100287

CITY OF ALBUQUERQUE MUNICIPAL DEVELOPMENT DEPARTMENT ENGINEERING DIVISION			
TITLE: EMPLOYMENT SERVICE CENTER FIRE HYDRANT IMPROVEMENTS MOUNTAIN ROAD N.E.			
APPROVALS	ENGINEER	DATE	APPROVALS
City Engineer	[Signature]	9/10/86	Liquid Waste
A.C.E. Design	[Signature]	9/10/86	Traffic
Hydrology	[Signature]	9/10/86	Water
DRAWING NO. 3010		MAP NO. J-14	
SHEET 2		OF 2	