




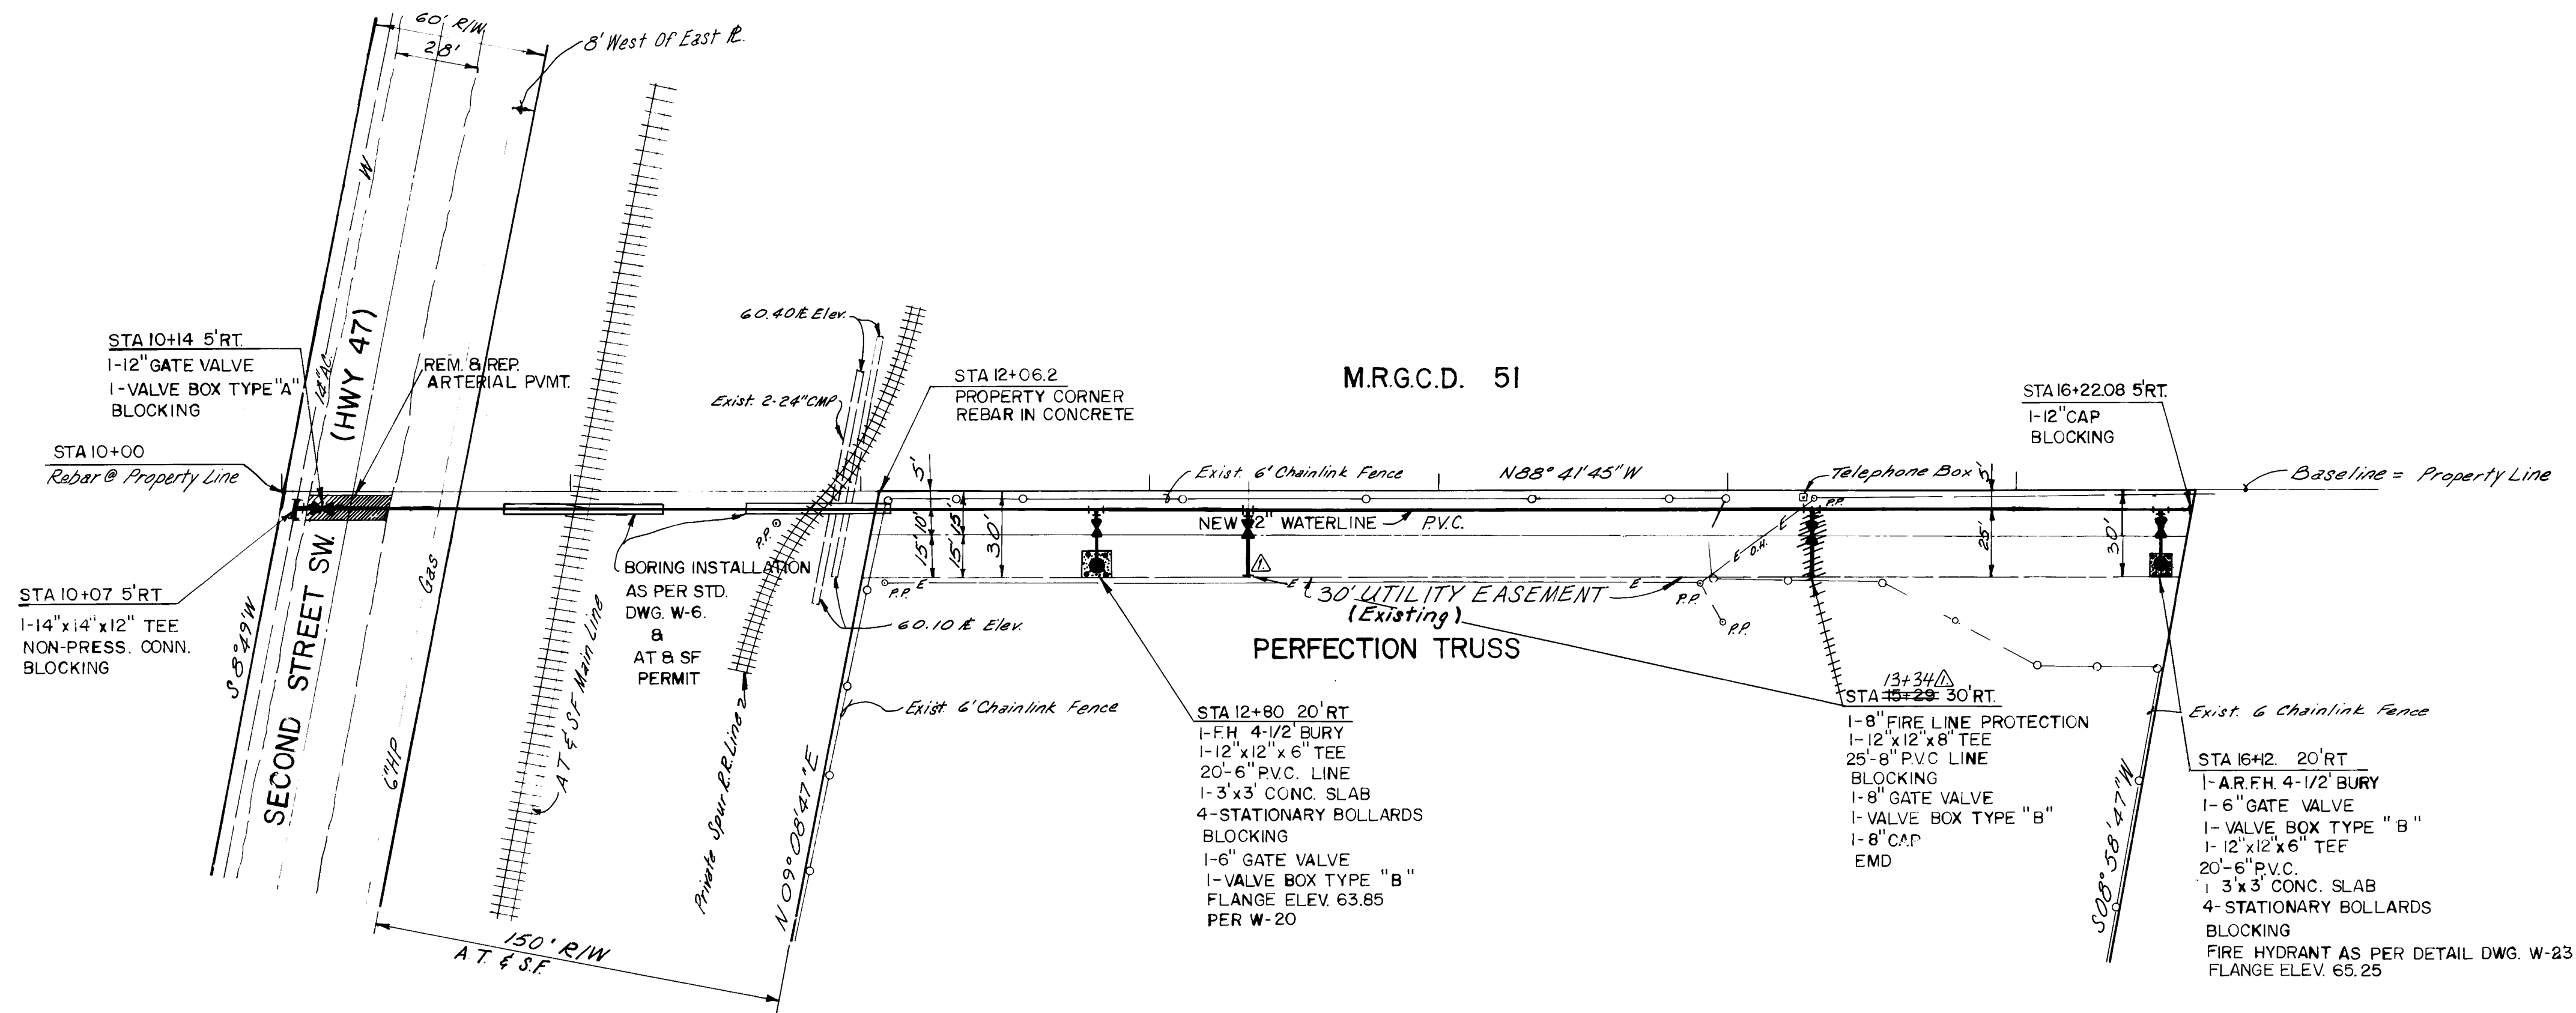

PLAN  
SCALE: 1"=40'

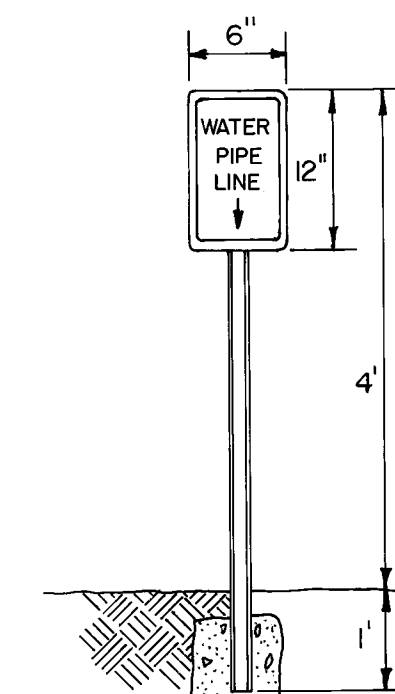


PIPE LINE MARKER DETAIL  
AS PER NMHSD STD. DWG.

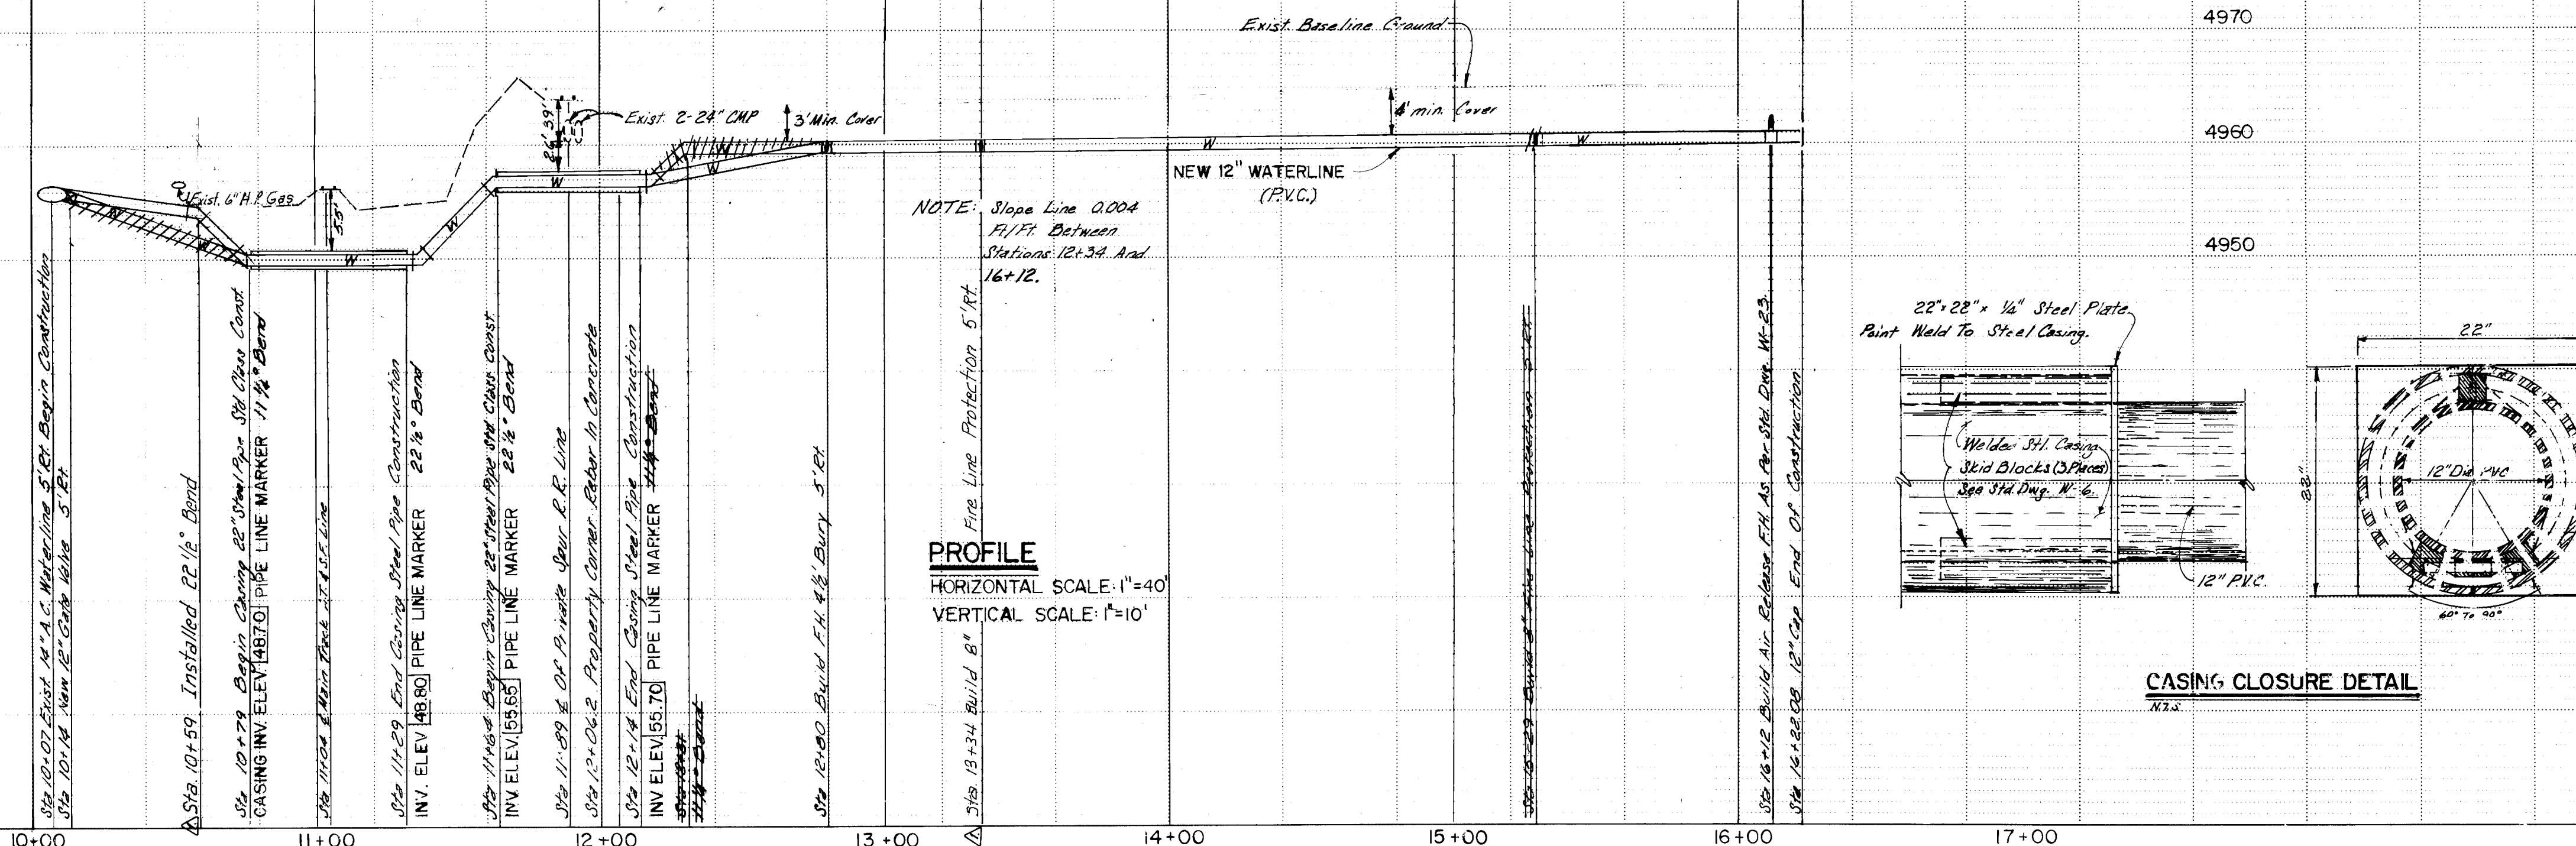


NOTE: Slope Line 0.004  
Ft/Ft Between  
Stations 12+34 And  
16+12.

PROFILE  
HORIZONTAL SCALE: 1"=40'  
VERTICAL SCALE: 1"=10'

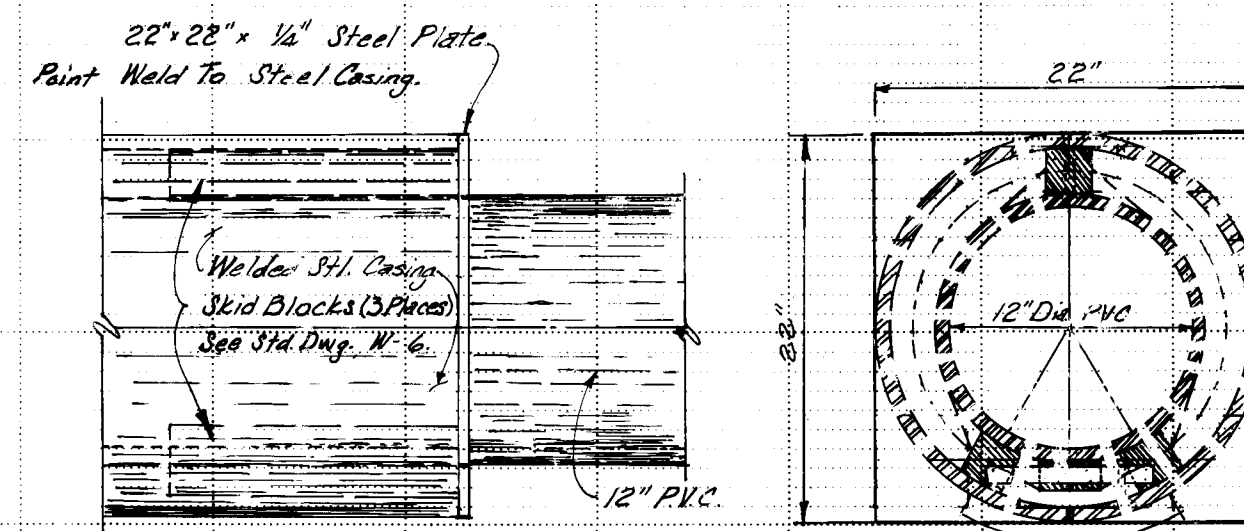

CASING CLOSURE DETAIL  
AS PER NMHSD STD. DWG.

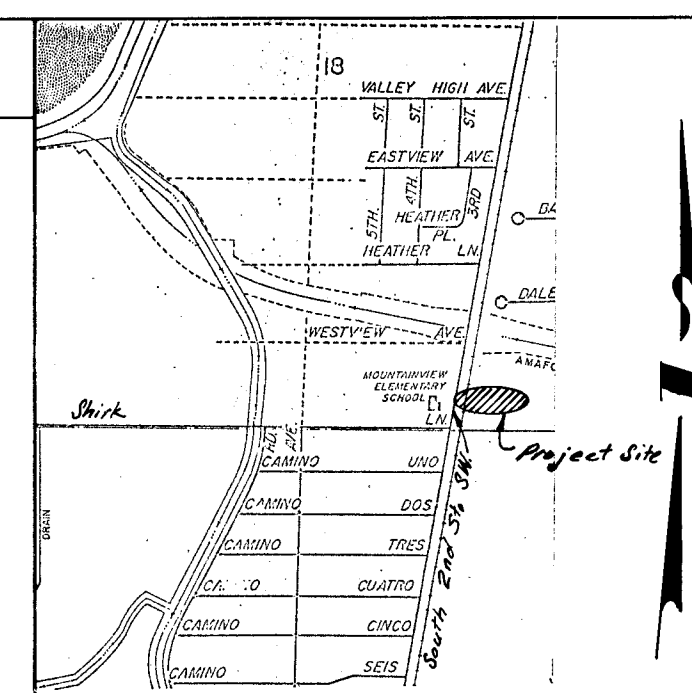

MAP LOCATION

NOTICE TO CONTRACTORS

- All work detailed on these plans to be performed under contract shall, except as otherwise stated or provided for hereon, be constructed in accordance with the City of Albuquerque Interim Standard Specifications for Construction 1985.
- Two (2) working days prior to any excavation, the contractor must contact Line Locating Service, 765-1234, for location of existing utilities.
- Prior to construction, the contractor shall excavate and verify the horizontal and vertical locations of all obstructions. Should a conflict exist, the contractor shall notify the engineer or surveyor so that the conflict can be resolved with minimum amount of delay.

THE FOLLOWING NOTES ALSO APPLY WHEN CHECKED

- ☒ All utilities and utility service lines shall be installed prior to paving.
- ☒ Backfill compaction shall be according to specified street use.
- ☒ Tack coat requirements shall be determined by the City Engineer.
- ☐ Sidewalks and wheelchair ramps within the curb returns shall be constructed wherever a new curb return is constructed.
- ☐ If curb is depressed for a driveway or a handicap ramp, the driveway or ramp shall be constructed prior to acceptance of the curb and gutter.

CONSTRUCTION NOTES:

- THE LOCATION OF ALL UNDERGROUND UTILITIES SHOWN IN THESE DRAWINGS IS BASED ON EXISTING RECORDS AND CAN ONLY BE CONSIDERED AS APPROXIMATE. IT SHALL BE THE CONTRACTOR'S RESPONSIBILITY TO ESTABLISH THE EXACT LOCATION OF THESE UTILITIES. ALL WORK RELATED TO THE UNDERGROUND UTILITIES PROTECTION, REMOVAL AND/OR RELOCATION AS NECESSARY FOR THE CONSTRUCTION OF THIS PROJECT SHALL BE CONSIDERED INCIDENTAL WORK.
- PRIOR TO INITIATING ANY WORK ON NMHSD RIGHT-OF-WAY, THE CONTRACTOR SHALL SUBMIT A COMPLETE TRAFFIC PLAN TO THE NMHSD DISTRICT 3 ENGINEER FOR APPROVAL.

|   |   |   |   |   |   |   |   |   |    |    |    |
|---|---|---|---|---|---|---|---|---|----|----|----|
| 1 | 2 | 3 | 4 | 5 | 6 | 7 | 8 | 9 | 10 | 11 | 12 |
| 2 | 6 | 3 | 0 | 1 | 1 | 0 | 1 | 8 | 7  |    |    |

APPROVAL OF AS-BUILT DRAWINGS  
CHIEF CONSTRUCTION ENGINEER  
DATE 3-3-87

APPROVALS

| APPROVALS          | ENGINEER            | DATE     | APPROVALS    | ENGINEER       | DATE     |
|--------------------|---------------------|----------|--------------|----------------|----------|
| City Engineer      | John J. [Signature] | 12/10/84 | Liquid Waste | W. [Signature] | 11/14/86 |
| A.C.E. - Design    | Robert [Signature]  | 12/10/84 | Traffic      | ADH            | 11/14/86 |
| A.C.E. - Hydrology | Robert [Signature]  | "        | Water        | W. [Signature] | 11/14/86 |

County Road Dept. [Signature] 11/14/86

CITY OF ALBUQUERQUE  
MUNICIPAL DEVELOPMENT DEPARTMENT  
ENGINEERING DIVISION

TITLE: SOUTH SECOND STREET 12" WATERLINE EXTENSION JUST EAST TO PERFECTION TRUSS, BORING ACROSS AT A SF MAINLINE & PRIVATE SPUR LINE TO PROPERTY TO BE SERVED

| APPROVALS          | ENGINEER            | DATE     | APPROVALS    | ENGINEER       | DATE     |
|--------------------|---------------------|----------|--------------|----------------|----------|
| City Engineer      | John J. [Signature] | 12/10/84 | Liquid Waste | W. [Signature] | 11/14/86 |
| A.C.E. - Design    | Robert [Signature]  | 12/10/84 | Traffic      | ADH            | 11/14/86 |
| A.C.E. - Hydrology | Robert [Signature]  | "        | Water        | W. [Signature] | 11/14/86 |

County Road Dept. [Signature] 11/14/86

DRAWING NO. 3011 MAP NO. Q-13 SHEET 1 OF 1

| AS BUILT INFORMATION |              |  | BENCH MARKS                               |      |  | SURVEY INFORMATION |    |  | ENGINEER'S SEAL |  |  |
|----------------------|--------------|--|-------------------------------------------|------|--|--------------------|----|--|-----------------|--|--|
| CONTRACT NO.         | NEW CONCEPTS |  | BM A Standard ACS Brass Tablet Stamped    | DATE |  | FIELD NOTES        | BY |  |                 |  |  |
| WORK ORDER NO.       | STATE BY     |  | 'MM 47-24.4' At The Intersection Of South | DATE |  |                    |    |  |                 |  |  |
| FIELD ACCEPTANCE BY  | DATE         |  | 2nd St. SW And Shirk Lane On Eastside Of  | DATE |  |                    |    |  |                 |  |  |
| FIELD CORRECTION BY  | DATE         |  | 2nd St. SW And Shirk Lane On Eastside Of  | DATE |  |                    |    |  |                 |  |  |
| FIELD CORRECTION BY  | DATE         |  | #123 AL                                   | DATE |  |                    |    |  |                 |  |  |
| FIELD CORRECTION BY  | DATE         |  | 21st                                      | DATE |  |                    |    |  |                 |  |  |
| FIELD CORRECTION BY  | DATE         |  | 4959.97                                   | DATE |  |                    |    |  |                 |  |  |
| FIELD CORRECTION BY  | DATE         |  |                                           | DATE |  |                    |    |  |                 |  |  |