


FOUR HILLS VILLAGE-INSTALLMENT 11-A

STAGECOACH ROAD & LA CABRA DRIVE EXTENSIONS

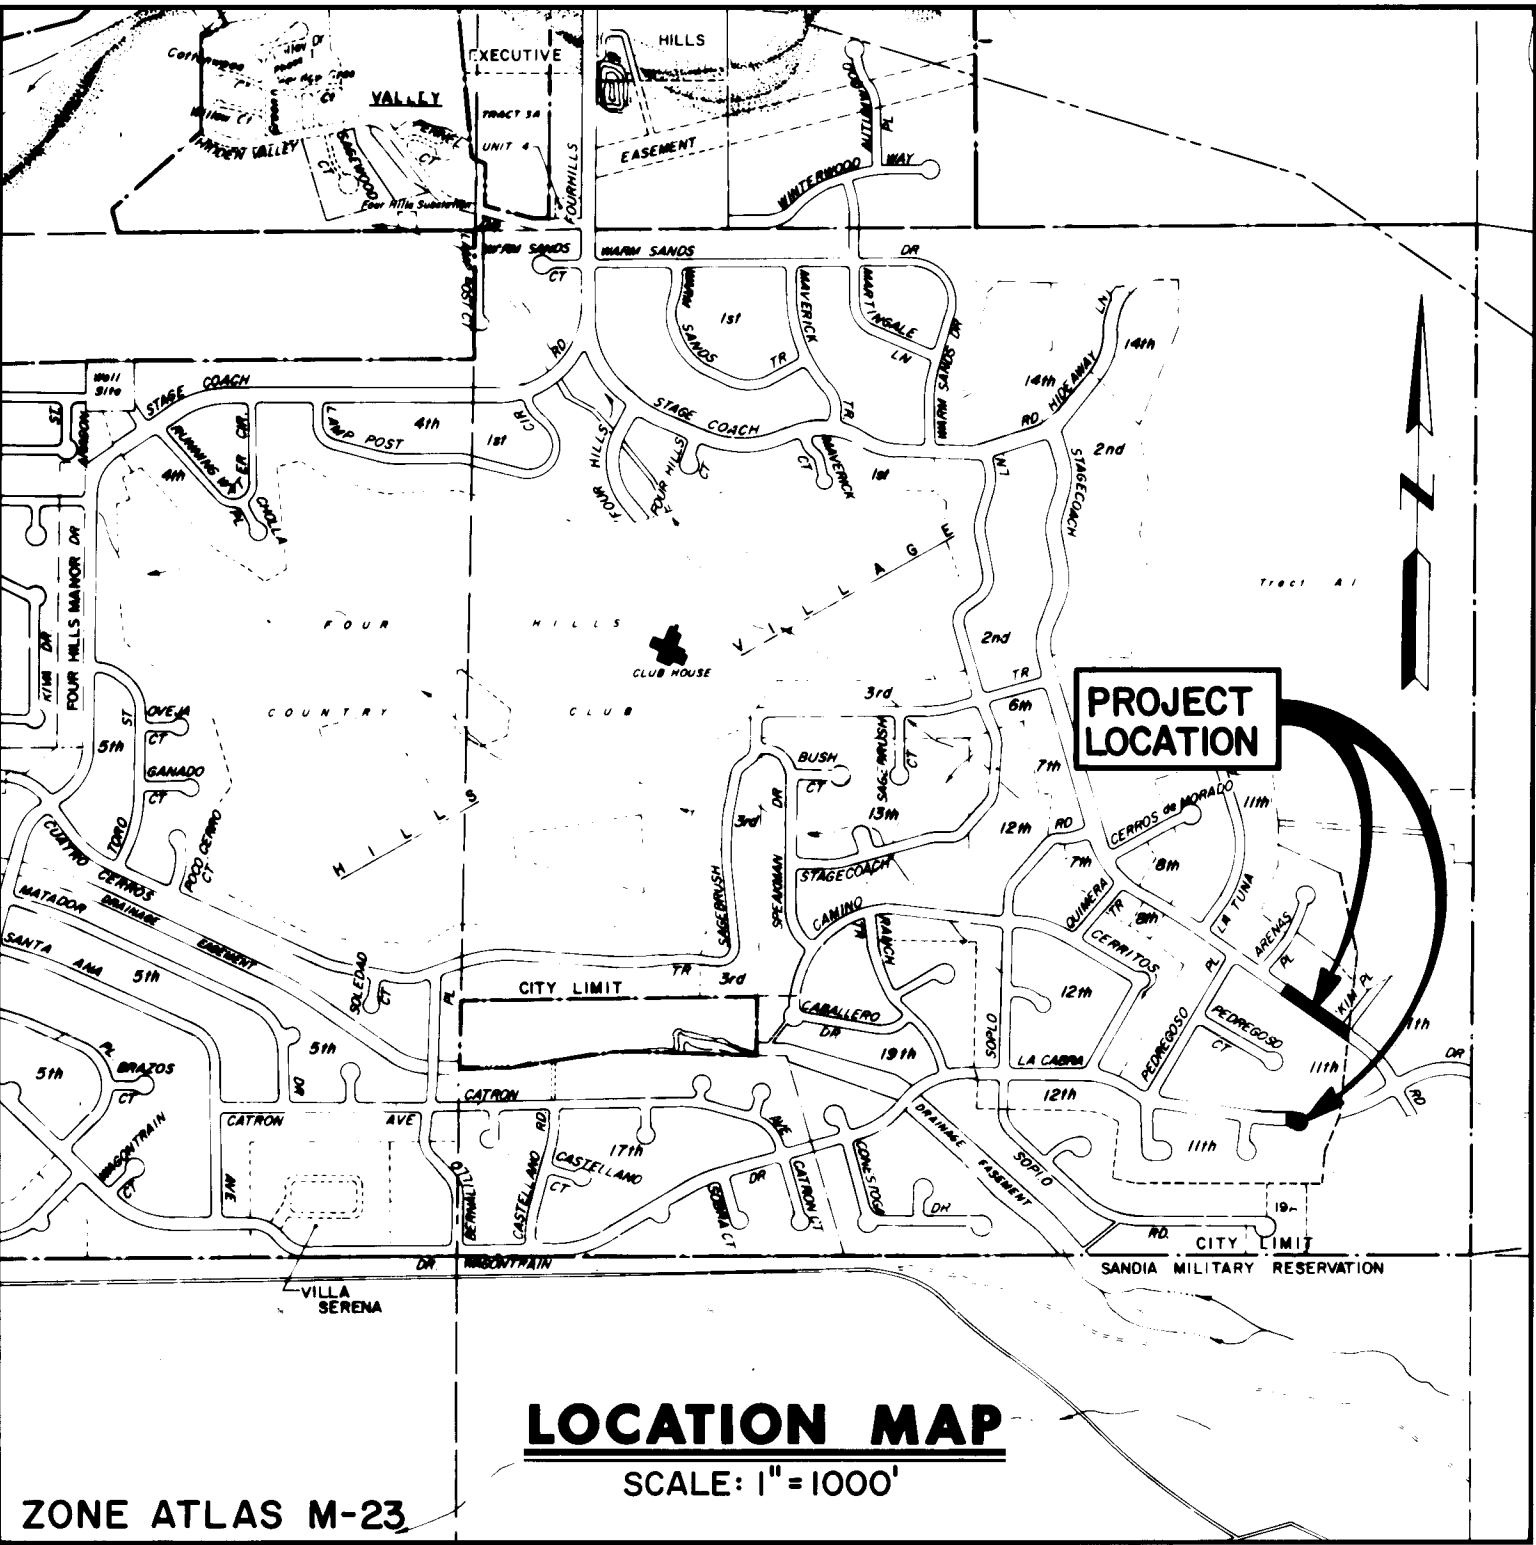

INDEX

DESCRIPTION	SHEET No.
TITLE SHEET & INDEX	1
SUBDIVISION PLAT.	2
SUBDIVISION PLAT.	3
PAVING PLAN & PROFILE - STAGECOACH ROAD SE.	4
PAVING PLAN & PROFILE - LA CABRA DRIVE SE.	5
SANITARY SEWER & WATERLINE PLAN & PROFILE - STAGECOACH ROAD SE.	6
SANITARY SEWER & WATERLINE PLAN & PROFILE - LA CABRA DRIVE SE.	7

GENERAL NOTES:

1. ALL WORK DETAILED ON THESE PLANS TO BE PERFORMED UNDER THIS CONTRACT SHALL, EXCEPT AS OTHERWISE STATED OR PROVIDED FOR HEREON, BE CONSTRUCTED IN ACCORDANCE WITH CITY OF ALBUQUERQUE, INTERIM STANDARD SPECIFICATIONS, PUBLIC WORKS CONSTRUCTION, 1985 EDITION.
2. REFERENCES MADE TO STANDARD DRAWINGS, CITY OF ALBUQUERQUE STANDARD DRAWINGS.
3. TWO WORKING DAYS PRIOR TO ANY EXCAVATION, CONTRACTOR MUST CONTACT LINE LOCATING SERVICE, 765-1234, FOR LOCATION OF EXISTING UTILITIES.
4. PRIOR TO CONSTRUCTION, THE CONTRACTOR SHALL EXCAVATE AND VERIFY THE HORIZONTAL AND VERTICAL LOCATIONS OF ALL OBSTRUCTIONS. SHOULD A CONFLICT EXIST, THE CONTRACTOR WILL NOTIFY THE ENGINEER OR SURVEYOR SO THAT THE CONFLICT CAN BE RESOLVED WITH A MINIMUM AMOUNT OF DELAY.
5. ALL UTILITIES AND UTILITY SERVICE LINES SHALL BE INSTALLED PRIOR TO PAVING.
6. BACKFILL COMPACTION SHALL BE ACCORDING TO SPECIFIED STREET USE.
7. TACK COAT REQUIREMENTS SHALL BE DETERMINED BY ENGINEER.
8. CONTRACTOR MUST SUBMIT A CONSTRUCTION SIGNING AND BARRACADING PLAN TO TRAFFIC ENGINEERING TO RECEIVE A BARRACADING PERMIT 48 HOURS PRIOR TO CONSTRUCTION.
9. CONTRACTOR SHALL PROVIDE 12" SUBGRADE PREPARATION UNDER ALL NEW PAVEMENT, CURBS & GUTTERS, VALLEY GUTTERS, AND CONCRETE FILLETS.
10. WHEN ABUTTING NEW PAVEMENT TO EXISTING, CUT BACK EXISTING PAVEMENT TO A NEAT STRAIGHT LINE AS REQUIRED TO REMOVE ANY BROKEN OR CRACKED PAVEMENT, AND PATCH NEW TO EXISTING. NO SEPARATE PAYMENT SHALL BE MADE FOR SUCH CUTTING OF EXISTING PAVEMENT BUT SHALL BE IN CONFORMANCE WITH THE SPECIFICATIONS.
11. WHERE REMOVAL OF EXISTING CURB & GUTTER IS REQUIRED, SUCH REMOVAL SHALL BE MADE BACK TO THE NEAREST JOINT BEYOND THE REMOVAL REQUIRED.
12. CURB & GUTTER SHOWN AS EXISTING AND NOT TO BE REMOVED UNDER THE CONTRACT WHICH IS DAMAGED OR DISPLACED BY THE CONTRACTOR SHALL BE REMOVED AND REPLACED BY THE CONTRACTOR AT HIS EXPENSE.
13. MATCH FLOWLINES OF GUTTER WHEN CONNECTING NEW CURB & GUTTER TO EXISTING.
14. ALL WATER VALVE BOXES AND SEWER MANHOLES IN THE CONSTRUCTION AREA ARE TO BE ADJUSTED TO FINISH GRADE UNDER THE CONTRACT. SEE STD. DWG. P-24.
15. CONTRACTOR SHALL REMOVE AND DISPOSE OF ALL OBJECTIONABLE MATERIAL FROM THE CONSTRUCTION SITE. A DISPOSAL SITE FOR ALL REMOVAL ITEMS SHALL BE OBTAINED BY THE CONTRACTOR. THE SITE SHALL BE IN COMPLIANCE WITH APPLICABLE ENVIRONMENTAL REGULATIONS AND APPROVED BY THE CITY ENGINEERING DEPARTMENT. ALL COSTS INCURRED IN OBTAINING AN ACCEPTABLE SITE AND HAUL THERETO SHALL BE CONSIDERED INCIDENTAL TO CONSTRUCTION OF THE PROJECT.
16. ALL PERMANENT PAVEMENT MARKING AND TRAFFIC SIGNING WILL BE PERFORMED BY THE CITY OF ALBUQUERQUE, TRAFFIC ENGINEERING DEPARTMENT.
17. MEASUREMENT AND PAYMENT FOR ROADWAY GRADING WILL BE MADE FROM OUTSIDE OF SIDEWALK WHERE NEW SIDEWALK IS BEING INSTALLED TO OUTSIDE OF MEDIAN CURB. SUCH PAYMENT WILL INCLUDE ALL REQUIRED EXCAVATION, DISPOSAL AND FILL. WHERE NO NEW SIDEWALK IS BEING INSTALLED MEASUREMENT AND PAYMENT WILL BE FROM BACK OF CURB TO BACK OF CURB.

CITY OF ALBUQUERQUE
NEW MEXICO



DATE 2-1-87

26 30150187


REV	SHEETS	CITY ENGR.	DATE	USER	DEPT.	DATE	USER	DEPT.	DATE
APPROVAL OF REVISIONS									


RECORD DRAWING

ANDREWS, ASBURY & ROBERT, INC.
CONSULTING ENGINEERS
ALBUQUERQUE 85-437 NEW MEXICO

APPROVED FOR CONSTRUCTION
CITY ENGINEER
DATE 10/16/86
SHEET 1 OF 7

APPROVALS City Engineer A.C.E. - Design A.C.E. - Hydrology	ENGINEER	DATE	APPROVALS	ENGINEER	DATE	MAP NO. 3015	SHEET 2 OF 7																												
	Liquid Waste Traffic Water	N/A N/A N/A	8/29/62 8/29/62 8/29/62																																
SUBDIVISION PLAT FOUR HILLS VILLAGE - INSTALLMENT II-A STAGECOACH RD. & LA CABRA DR. EXTENSIONS																																			
CITY OF ALBUQUERQUE DEPARTMENT OF PUBLIC WORKS																																			
<i>John D. Anderson</i> RECORD DRAWING <table border="1" style="width: 100%; border-collapse: collapse;"> <tr> <td colspan="2">ENGINEER'S SEAL</td> <td colspan="2"> ENGINEER JOHN A. ANDREWS REGISTERED PROFESSIONAL STATE OF NEW MEXICO 85-437 </td> </tr> <tr> <td colspan="2">SURVEY INFORMATION</td> <td colspan="2"> FIELD NOTES "STA. 10+M23" ELEVATION 5904.33 </td> </tr> <tr> <td colspan="2">BENCH MARKS</td> <td colspan="2"> CHISELED SQUARE, "X", ON TOP OF CURB AT THE SE CORNER OF STAGECOACH ROAD SE AND LA TUNA PLACE SE. </td> </tr> <tr> <td colspan="2">NO.</td> <td colspan="2">BY</td> </tr> <tr> <td colspan="2">DATE</td> <td colspan="2">DATE</td> </tr> <tr> <td colspan="2">CONTRACTOR</td> <td colspan="2"> WORK STAKED BY AAR INSPECTORS DATE 12-86 </td> </tr> <tr> <td colspan="2">AS BUILT INFORMATION</td> <td colspan="2"> MICRO-FILM INFORMATION DATE 2-87 CORRECTED BY AAR VERIFICATION BY DATE RECORDED BY DATE NO. </td> </tr> </table>								ENGINEER'S SEAL		ENGINEER JOHN A. ANDREWS REGISTERED PROFESSIONAL STATE OF NEW MEXICO 85-437		SURVEY INFORMATION		FIELD NOTES "STA. 10+M23" ELEVATION 5904.33		BENCH MARKS		CHISELED SQUARE, "X", ON TOP OF CURB AT THE SE CORNER OF STAGECOACH ROAD SE AND LA TUNA PLACE SE.		NO.		BY		DATE		DATE		CONTRACTOR		WORK STAKED BY AAR INSPECTORS DATE 12-86		AS BUILT INFORMATION		MICRO-FILM INFORMATION DATE 2-87 CORRECTED BY AAR VERIFICATION BY DATE RECORDED BY DATE NO.	
ENGINEER'S SEAL		ENGINEER JOHN A. ANDREWS REGISTERED PROFESSIONAL STATE OF NEW MEXICO 85-437																																	
SURVEY INFORMATION		FIELD NOTES "STA. 10+M23" ELEVATION 5904.33																																	
BENCH MARKS		CHISELED SQUARE, "X", ON TOP OF CURB AT THE SE CORNER OF STAGECOACH ROAD SE AND LA TUNA PLACE SE.																																	
NO.		BY																																	
DATE		DATE																																	
CONTRACTOR		WORK STAKED BY AAR INSPECTORS DATE 12-86																																	
AS BUILT INFORMATION		MICRO-FILM INFORMATION DATE 2-87 CORRECTED BY AAR VERIFICATION BY DATE RECORDED BY DATE NO.																																	

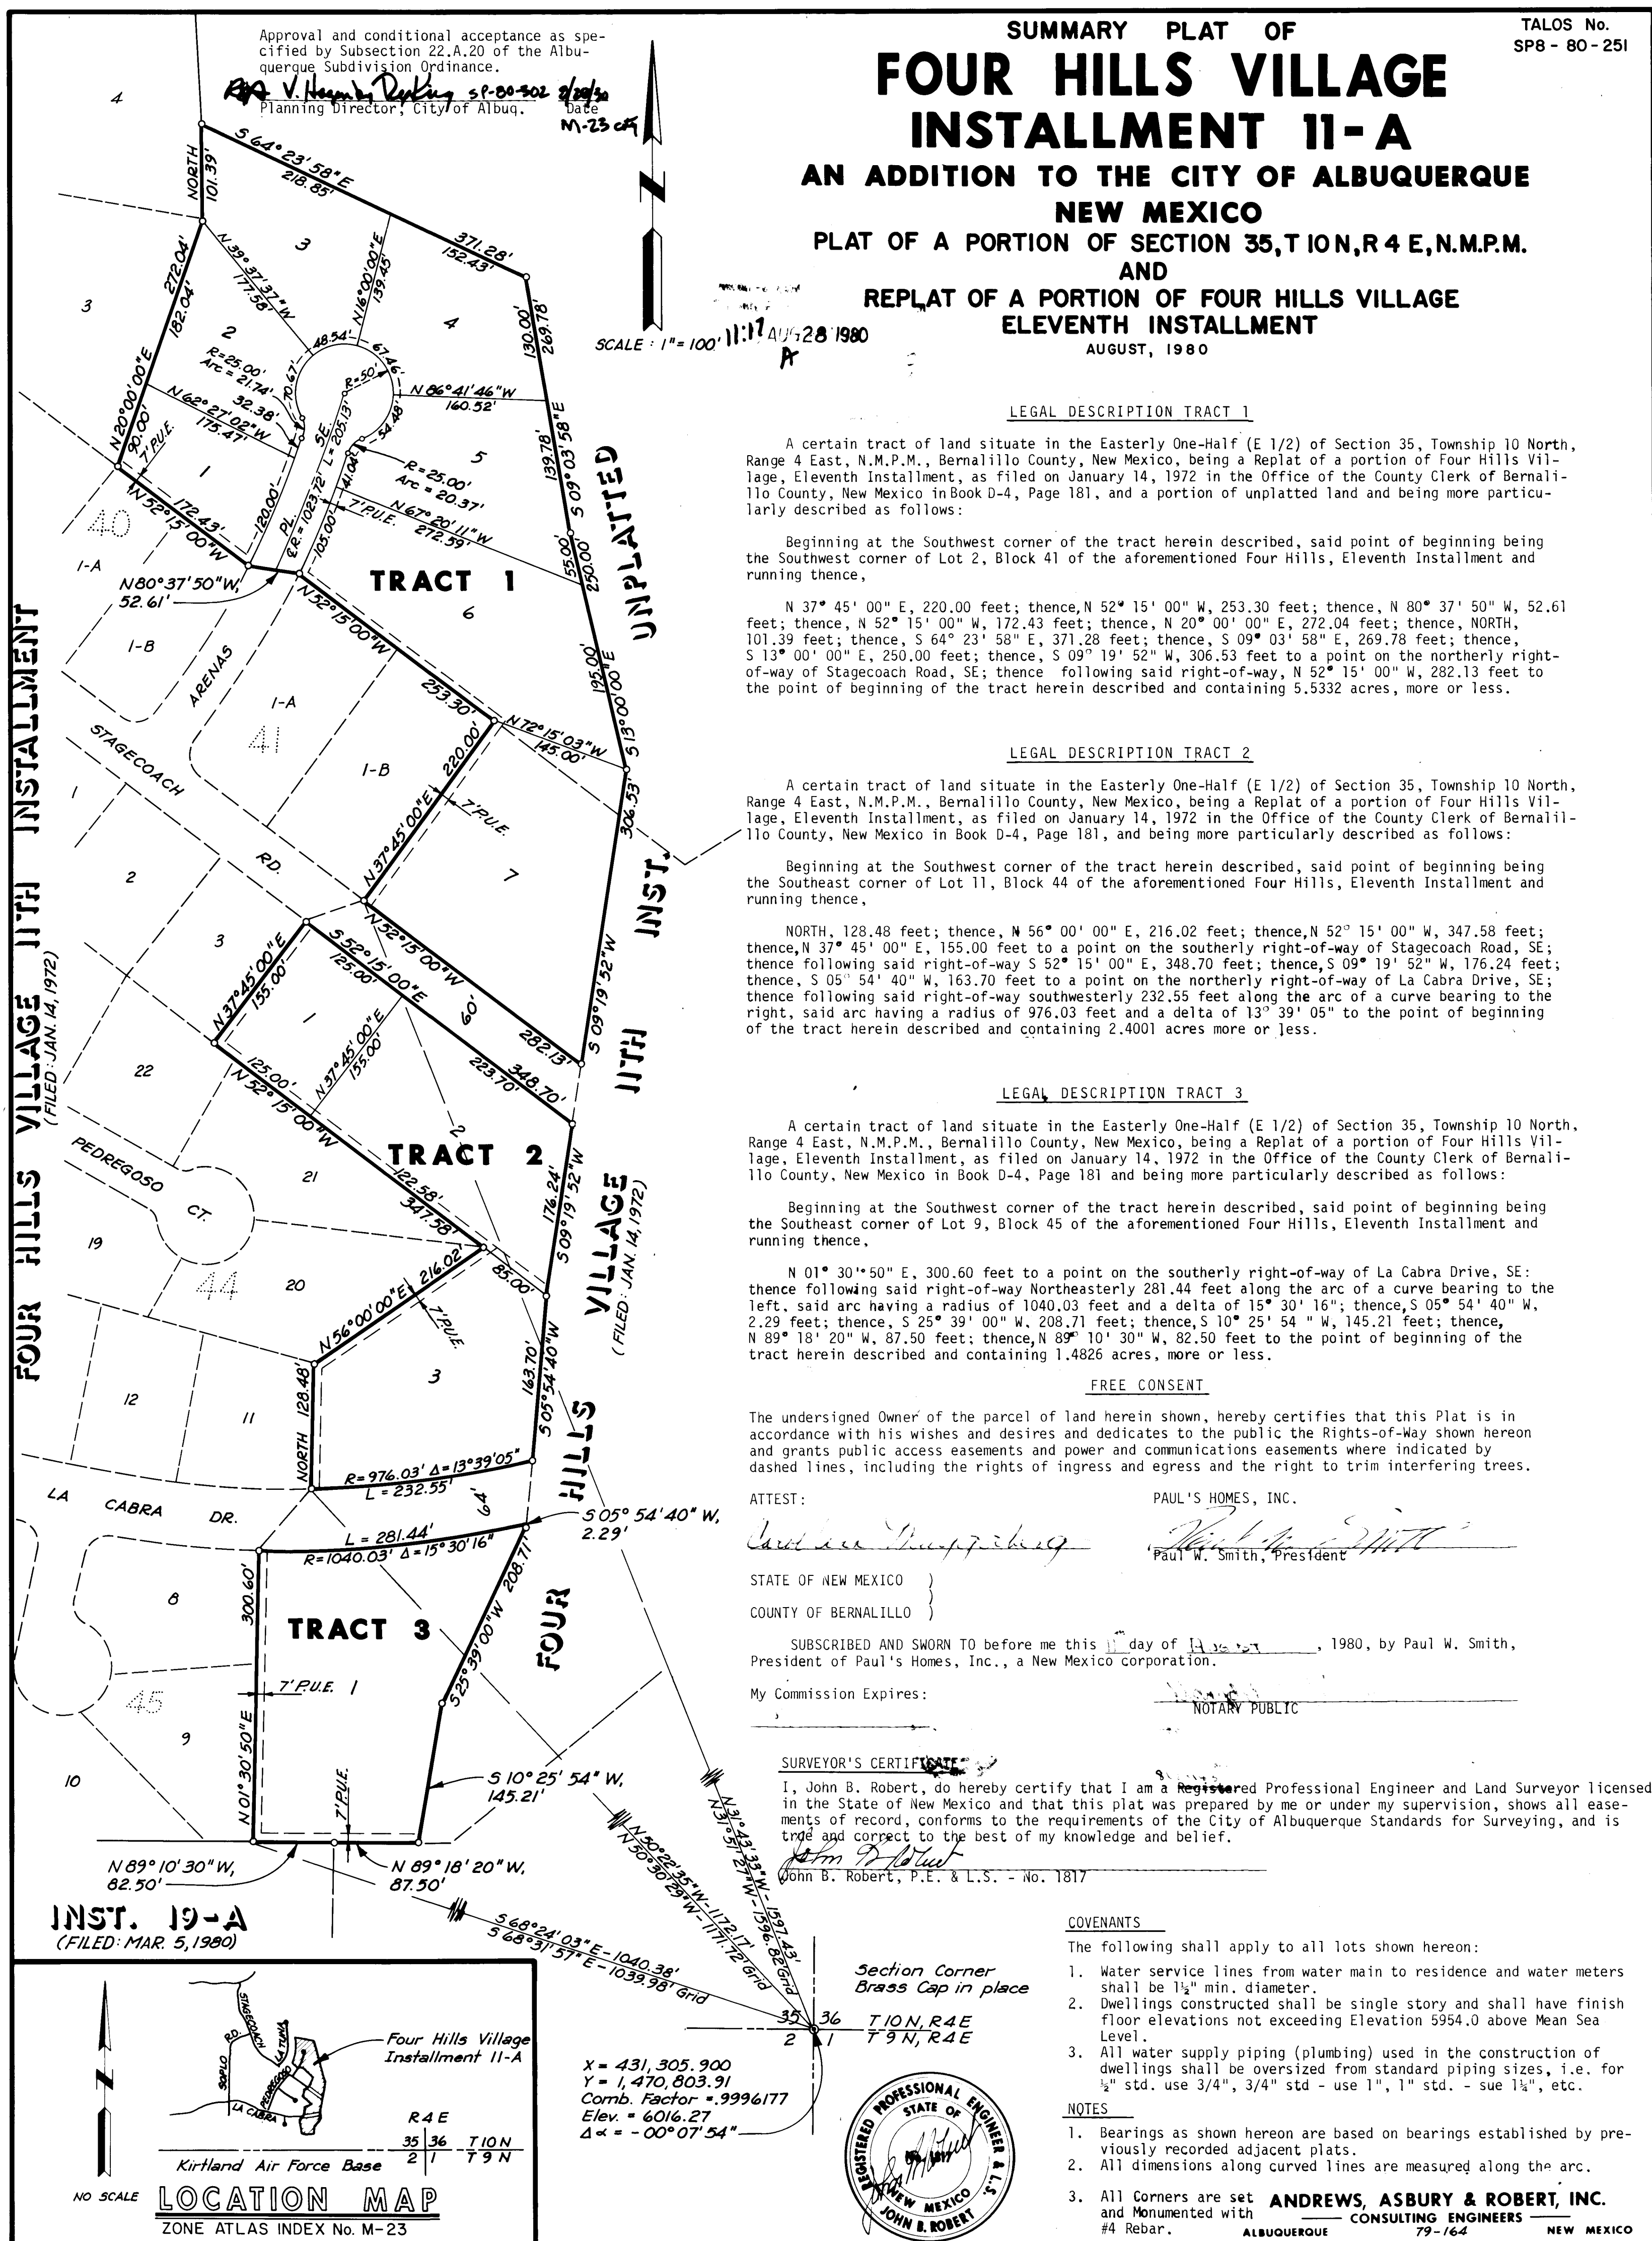

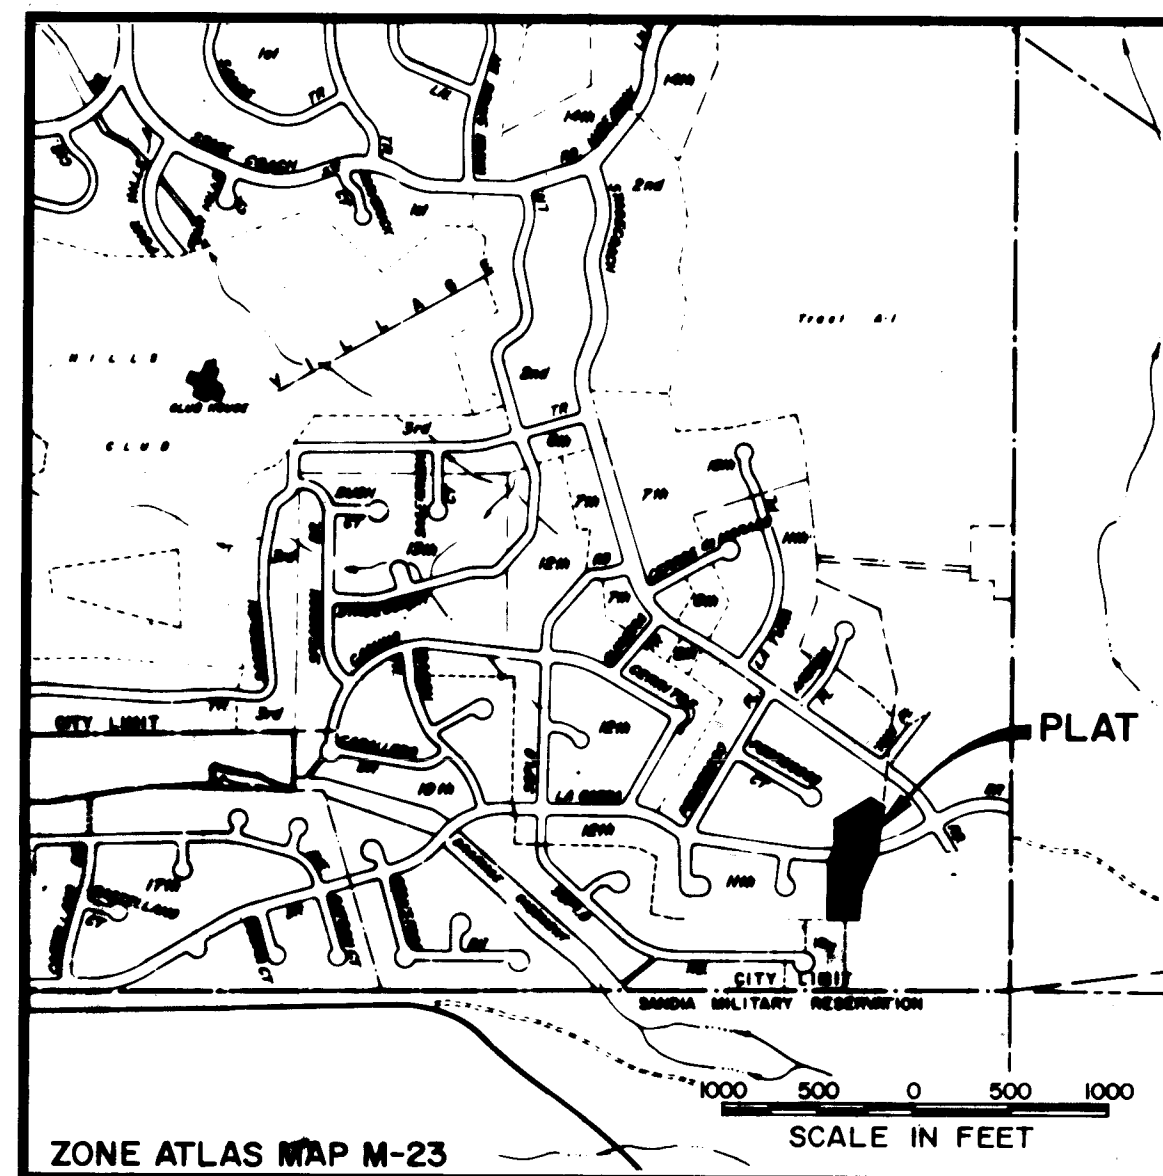

LOCATION MAP

CURVE DATA		
DELTA	RADIUS	LENGTH
① 00°13'39"	1040.03'	4.13'
② 49°34'08"	25.00'	21.63'
③ 126°41'55"	45.00'	99.51'
④ 105°51'23"	45.00'	83.14'

NOTES:

- THE PURPOSE OF THIS REPLAT IS TO INCORPORATE THE VACATED RIGHT-OF-WAY IN THE ADJACENT LOTS AND TO DEDICATE THE TURN AROUND AND THE ACCESS AND UTILITY EASEMENTS.
- THE BEARINGS AND DISTANCES ON THIS REPLAT ARE AS SHOWN ON THE RECORDED PLAT OF FOUR HILLS VILLAGE INSTALLMENT 11-A.
- THE ROTATION FACTOR TO GRID BEARING IS AS SHOWN ON THE PLAT OF FOUR HILLS VILLAGE INSTALLMENT 11-A.
- UNLESS OTHERWISE INDICATED, THE PROPERTY CORNERS SHOWN HEREON ARE MONUMENTED BY A REBAR WITH CAP MARKED "A.A.R. L.S. 4071."


COVENANTS

FROM PLAT OF FOUR HILLS VILLAGE INSTALLMENT 11-A FILED 8-28-80 IN BOOK C-17, PAGE 52.

THE FOLLOWING SHALL APPLY TO ALL LOTS SHOWN HEREON:

- WATER SERVICE LINES FROM WATER MAIN TO RESIDENCE AND WATER METERS SHALL BE 1-1/2" MINIMUM DIAMETER.
- DWELLINGS CONSTRUCTED SHALL BE SINGLE STORY AND SHALL HAVE FINISH FLOOR ELEVATIONS NOT EXCEEDING ELEVATION 5954.0 ABOVE MEAN SEA LEVEL.
- ALL WATER SUPPLY PIPING (PLUMBING) USED IN THE CONSTRUCTION OF DWELLINGS SHALL BE OVERSIZED FROM STANDARD PIPING SIZES, I.E. FOR 1/2" STD. USE 3/4", 3/4" STD. - USE 1", 1" STD. - USE 1-1/4", ETC.

TALOS LOG No: SP-08-08-737

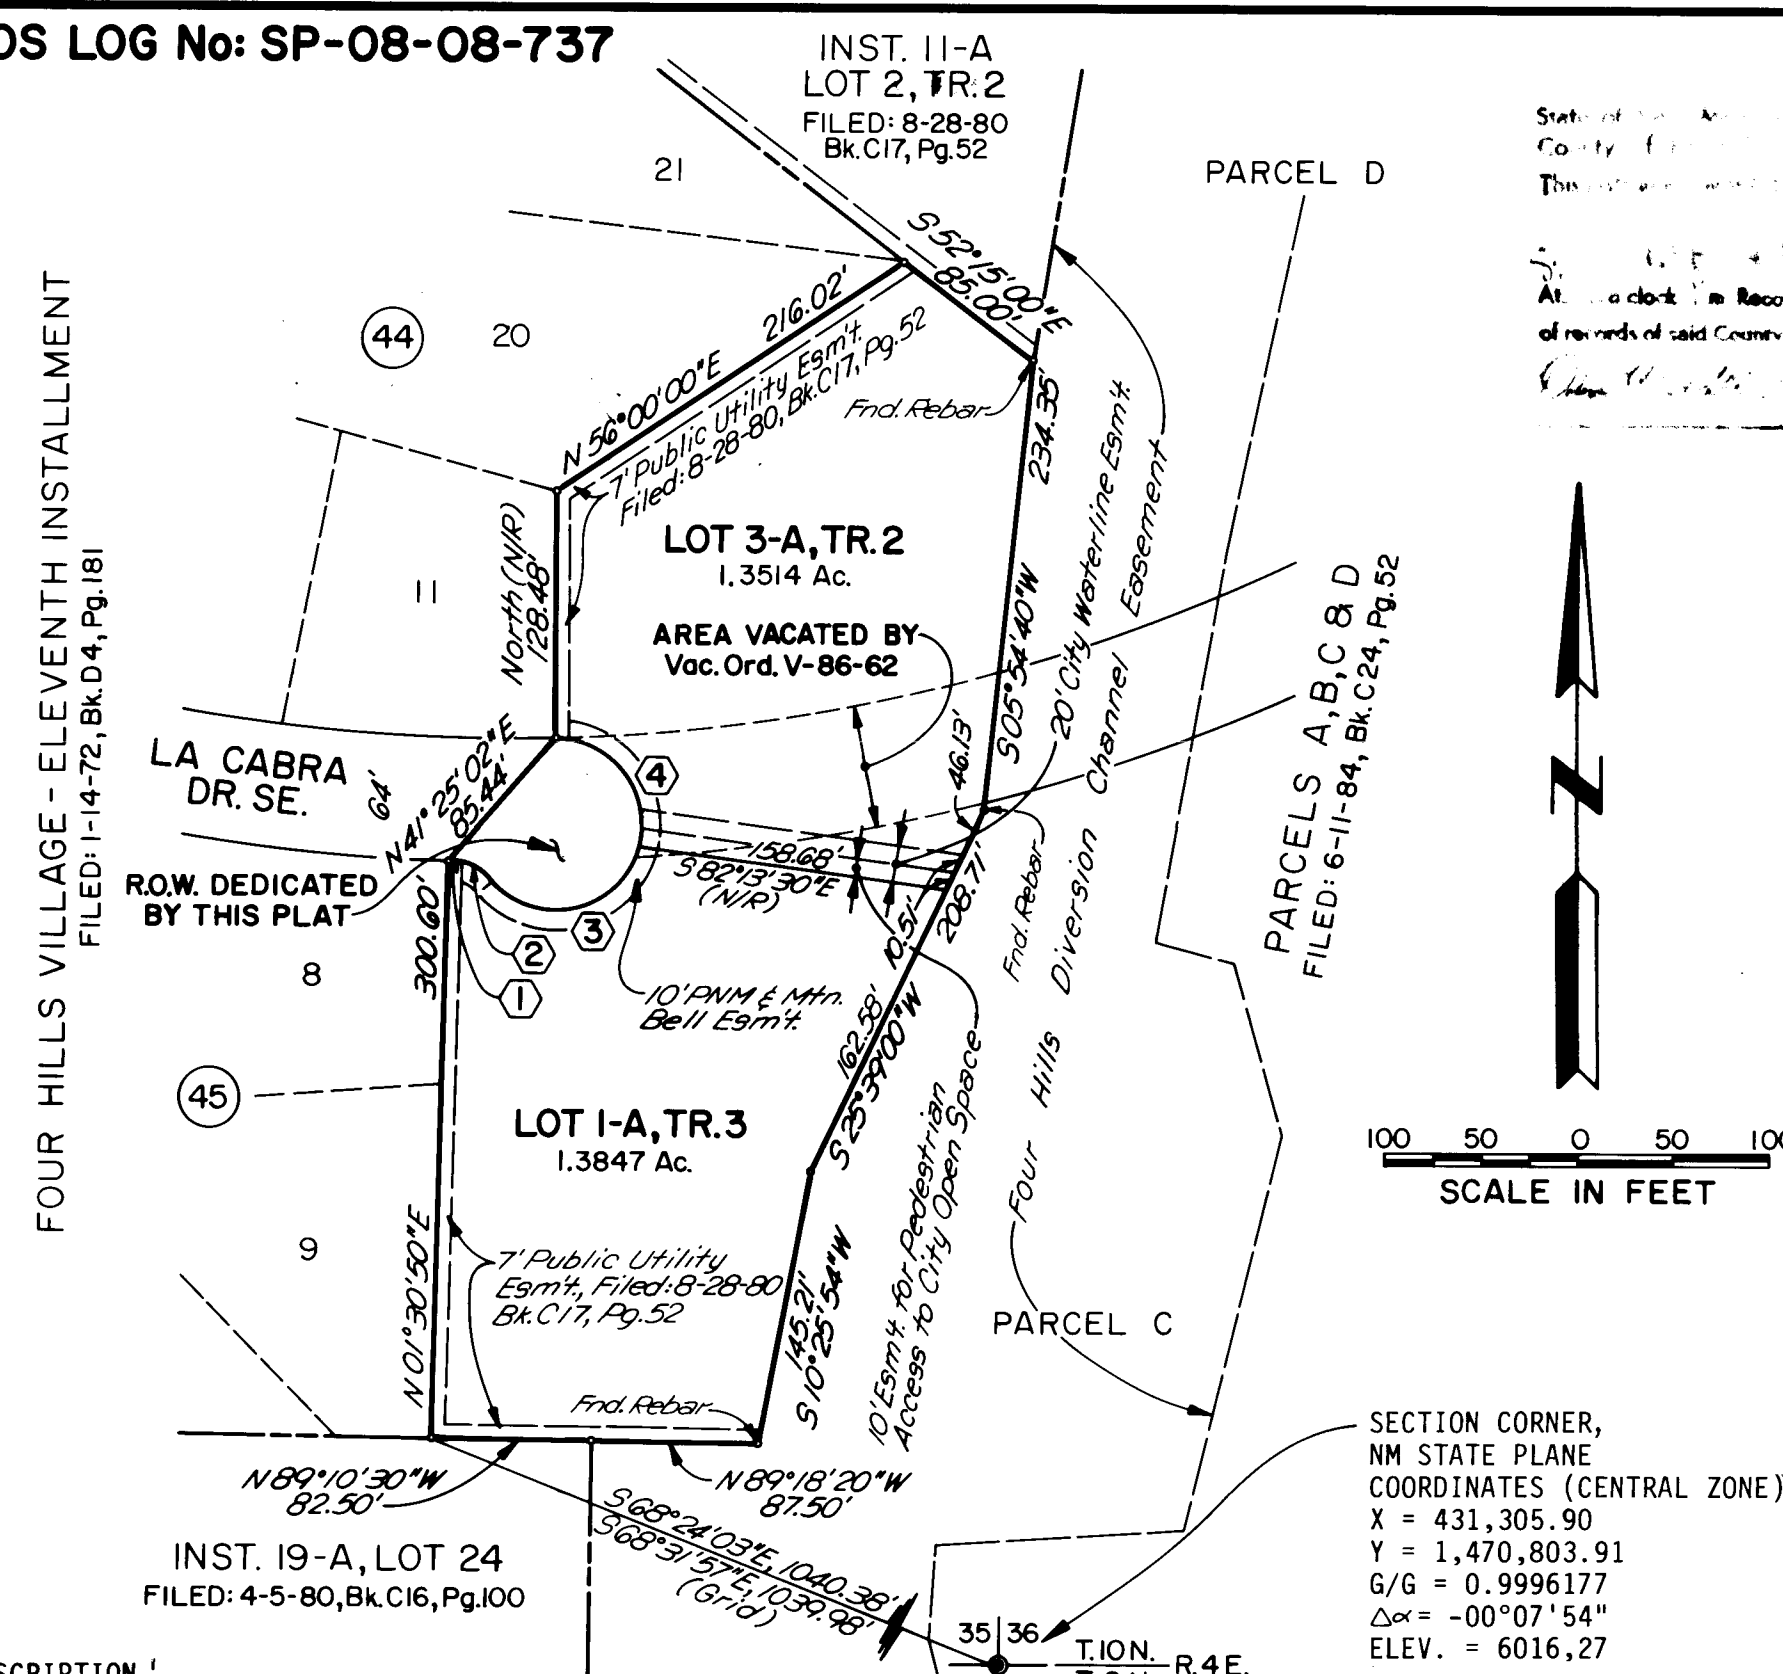

DESCRIPTION

A CERTAIN TRACT OF LAND SITUATE WITHIN THE SOUTHEAST QUARTER OF SECTION 35, TOWNSHIP 10 NORTH, RANGE 4 EAST, N.M.P.M., CITY OF ALBUQUERQUE, BERNALILLO COUNTY, NEW MEXICO, BEING AND COMPRISING ALL OF LOT 3, TRACT 2, LOT 1, TRACT 3, AND A VACATED PORTION OF LA CABRA DRIVE IN FOUR HILLS VILLAGE, INSTALLMENT 11-A AS THE SAME ARE SHOWN AND DESIGNATED ON THE PLAT THEREOF FILED IN THE OFFICE OF THE COUNTY CLERK OF BERNALILLO COUNTY, NEW MEXICO ON AUGUST 28, 1980 IN VOLUME C17, FOLIO 52 OF SAID COUNTY RECORDS, AND BEING MORE PARTICULARLY DESCRIBED AS FOLLOWS:

BEGINNING AT THE SOUTHWEST CORNER OF THE TRACT HEREIN DESCRIBED, BEING COMMON TO THE SOUTHWEST CORNER OF SAID TRACT 3, FOUR HILLS VILLAGE, INSTALLMENT 11-A, FROM WHENCE THE SOUTHEAST CORNER OF SAID SECTION 35 BEARS S 68°24'03" E, 1,040.38 FEET DISTANCE; THENCE, FROM SAID POINT OF BEGINNING,

N 01°30'50" E, 300.60 FEET TO THE NORTHWEST CORNER OF SAID TRACT 3; THENCE,

N 41°25'02" E, 85.44 FEET TO THE SOUTHWEST CORNER OF SAID LOT 3, TRACT 2; THENCE,

N 00°00'00" E, 128.48 FEET TO THE NORTHWEST CORNER OF SAID LOT 3; THENCE,

N 56°00'00" E, 216.02 FEET TO THE NORTHERLY CORNER OF SAID LOT 3; THENCE,

S 52°15'00" E, 85.00 FEET TO THE NORTHEASTLY CORNER OF SAID LOT 3; THENCE,

S 05°54'40" W, 234.35 FEET ALONG THE EASTERLY LINE OF SAID LOT 3 AND THE VACATED PORTION OF LA CABRA DRIVE TO THE NORTHEASTLY CORNER OF SAID TRACT 3; THENCE,

S 25°39'00" W, 208.71 FEET ALONG THE EASTERLY LINE OF SAID TRACT 3; THENCE,

S 10°25'54" W, 145.21 FEET TO THE SOUTHEAST CORNER OF SAID TRACT 3; THENCE,

N 89°18'20" W, 87.50 FEET ALONG THE SOUTH LINE OF SAID TRACT 3; THENCE,

N 89°10'30" W, 82.50 FEET TO THE SOUTHWEST CORNER AND POINT OF BEGINNING OF THE TRACT HEREIN DESCRIBED, CONTAINING 2.8707 ACRES (125,047 SQUARE FEET), MORE OR LESS.

FREE CONSENT & DEDICATION STATEMENT

THE PLAT AS SHOWN HEREON IS WITH THE FREE CONSENT OF, AND IN ACCORDANCE WITH THE WISHES AND DESIRES OF THE UNDERSIGNED OWNERS AND/OR PROPRIETORS THEREOF, AND SAID OWNERS AND/OR PROPRIETORS DO HEREBY DEDICATE THE PUBLIC RIGHTS-OF-WAY SHOWN HEREON TO THE CITY OF ALBUQUERQUE. THE UNDERSIGNED OWNERS AND/OR PROPRIETORS DO HEREBY GRANT ALL UTILITY EASEMENTS SHOWN HEREON BY DASHED LINES, INCLUDING THE RIGHT OF INGRESS AND EGRESS AND THE RIGHT TO TRIM INTERFERING TREES, AND DO GRANT TO THE CITY OF ALBUQUERQUE ALL WATERLINE, AND ACCESS EASEMENTS AS SHOWN HEREON. THE UNDERSIGNED OWNERS AND/OR PROPRIETORS DO HEREBY FREELY CONSENT TO ALL THE FOREGOING AND DO HEREBY REPRESENT THAT WE ARE AUTHORIZED TO SO ACT.

SMALL BUSINESS ADMINISTRATION, RECEIVER FOR NEW MEXICO CAPITAL CORP.

BY: *John C. Evans*
JOHN C. EVANS, AGENT FOR THE RECEIVER

STATE OF NEW MEXICO
COUNTY OF BERNALILLO } ss

THE FOREGOING INSTRUMENT WAS ACKNOWLEDGED BEFORE ME THIS 8th DAY OF August, 1986, BY JOHN C. EVANS, AGENT FOR SMALL BUSINESS ADMINISTRATION, RECEIVER FOR NEW MEXICO CAPITAL CORPORATION, ON BEHALF OF SAID CORPORATION.

MY COMMISSION EXPIRES: 7/26/89

86 53704

REPLAT OF
LOT 3, TRACT 2; LOT 1, TRACT 3 &
A VACATED PORTION OF LA CABRA DR. SE.
NOW COMPRISING
LOT 3-A, TRACT 2 & LOT 1-A, TRACT 3
FOUR HILLS VILLAGE
INSTALLMENT 11-A
ALBUQUERQUE, NEW MEXICO
AUGUST, 1986

APPROVALS

CHIEF CITY SURVEYOR

PROPERTY MANAGEMENT

TRAFFIC ENGINEER

PARKS AND RECREATION DIRECTOR

WATER RESOURCES DEPARTMENT

ALBUQUERQUE METROPOLITAN ARROYO FLOOD CONTROL AUTHORITY

CITY ENGINEER, ENGINEERING DIVISION

PLANNING DIRECTOR, CITY/COUNTY PLANNING DIVISION

08/19/86

9-3-86

8-26-86

8-26-86

8-28-86

8-29-86

8-29-86

9-3-86

DRB 86-302

SP-86-320

SURVEYOR'S CERTIFICATE

I, GAYLE JEWELL, A REGISTERED LAND SURVEYOR UNDER THE LAWS OF THE STATE OF NEW MEXICO, DO HEREBY CERTIFY THAT THIS PLAT WAS PREPARED BY ME OR UNDER MY SUPERVISION, SHOWS ALL EASEMENTS OF RECORD, MEETS THE MINIMUM REQUIREMENTS FOR MONUMENTATION AND SURVEYS OF THE ALBUQUERQUE SUBDIVISION ORDINANCE, AND IS TRUE AND CORRECT TO THE BEST OF MY KNOWLEDGE AND BELIEF.

BY: *Gayle Jewell* 8-11-86
GAYLE JEWELL, L.S. NO. 4071 DATE


ACKNOWLEDGEMENT

STATE OF NEW MEXICO } ss
COUNTY OF BERNALILLO }

THE FOREGOING INSTRUMENT WAS ACKNOWLEDGED BEFORE ME THIS 11th DAY OF August, 1986 BY GAYLE D. JEWELL, REGISTERED NEW MEXICO LAND SURVEYOR NO. 4071.


BY: *Susan Hubbard Jones*
NOTARY PUBLIC

MY COMMISSION EXPIRES: 7/26/89

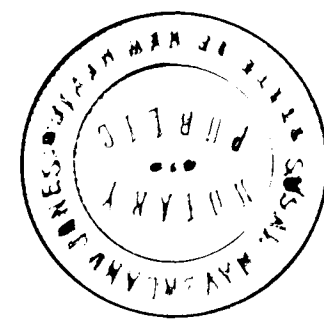

ANDREWS, ASBURY & ROBERT, INC.
CONSULTING ENGINEERS
ALBUQUERQUE 85-437 NEW MEXICO

AS BUILT INFORMATION				BENCH MARKS				SURVEY INFORMATION				ENGINEER'S SEAL			
CONTRACTOR	J.R. Hale Inc.	DATE	08/19/86	STA. 10+42.3"	ELEVATION 5904.33	DATE	9-3-86	NO	DATE	BY	DATE	NO	DATE	BY	DATE
WORK BY	AAAP	DATE	12-86	CHISELED SQUARE, 1/2", ON TOP OF CURB AT THE		DATE	8-26-86								
INSPECTION BY		DATE		SE CORNER OF STAGECOACH ROAD SE AND LA TUNA		DATE	8-26-86								
FIELD ACCEPTANCE BY		DATE		PLACE SE.		DATE	8-28-86								
FIELD ADJUSTMENT BY		DATE				DATE	8-29-86								
DRAWINGS CORRECTED BY	AAAP	DATE	8-27			DATE	8-29-86								
RECORDED BY		DATE				DATE	9-3-86								
NO		DATE				DATE									

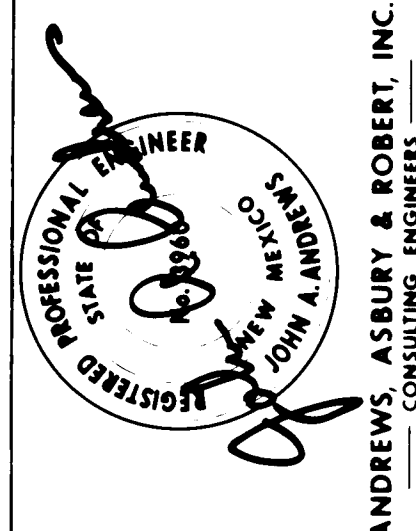



ANDREWS, ASBURY & ROBERT, INC.
CONSULTING ENGINEERS
ALBUQUERQUE 85-437 NEW MEXICO

John A. Anderson
RECORD DRAWING

CITY OF ALBUQUERQUE
DEPARTMENT OF PUBLIC WORKS
FOUR HILLS VILLAGE-INSTALLMENT 11-A
STAGECOACH RD. & LA CABRA DR. EXTENSIONS
SUBDIVISION PLAT

APPROVALS	ENGINEER	DATE	APPROVALS	ENGINEER	DATE
City Engineer	NA	8/29/86	Liquid Waste	N/A W/W	8/29/86
A.C.E.-Design	11		Traffic	N/A W/W	8/29/86
A.C.E.-Hydrology	11		Water	N/A W/W	8/29/86

DRAWING NO. 3015 MAP NO. M-23 SHEET 3 OF 7

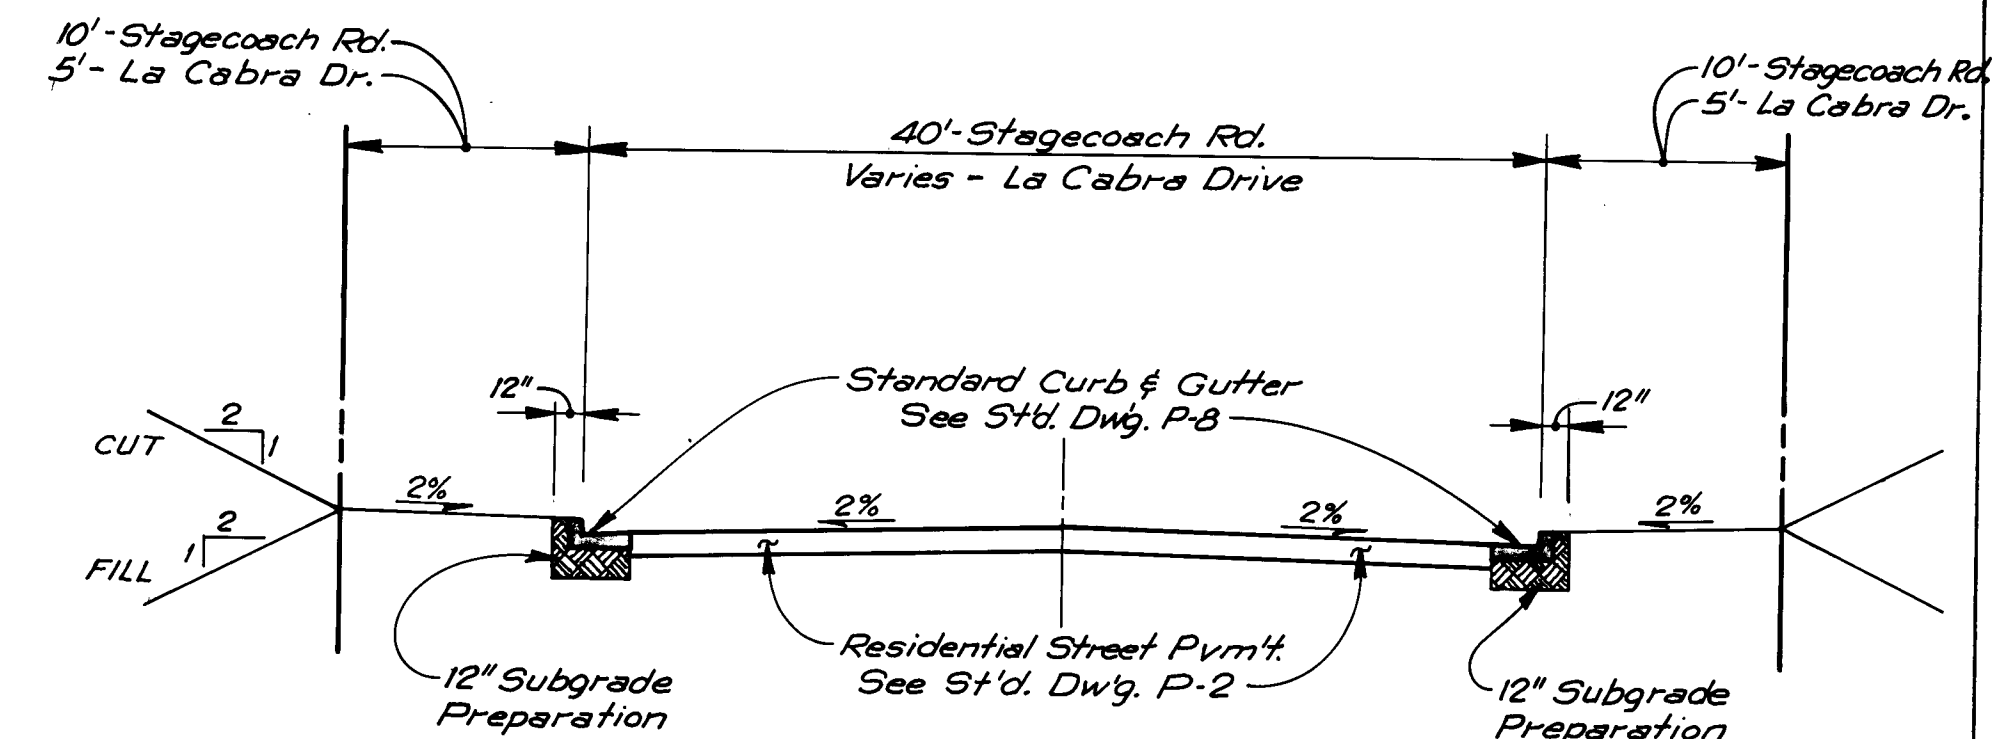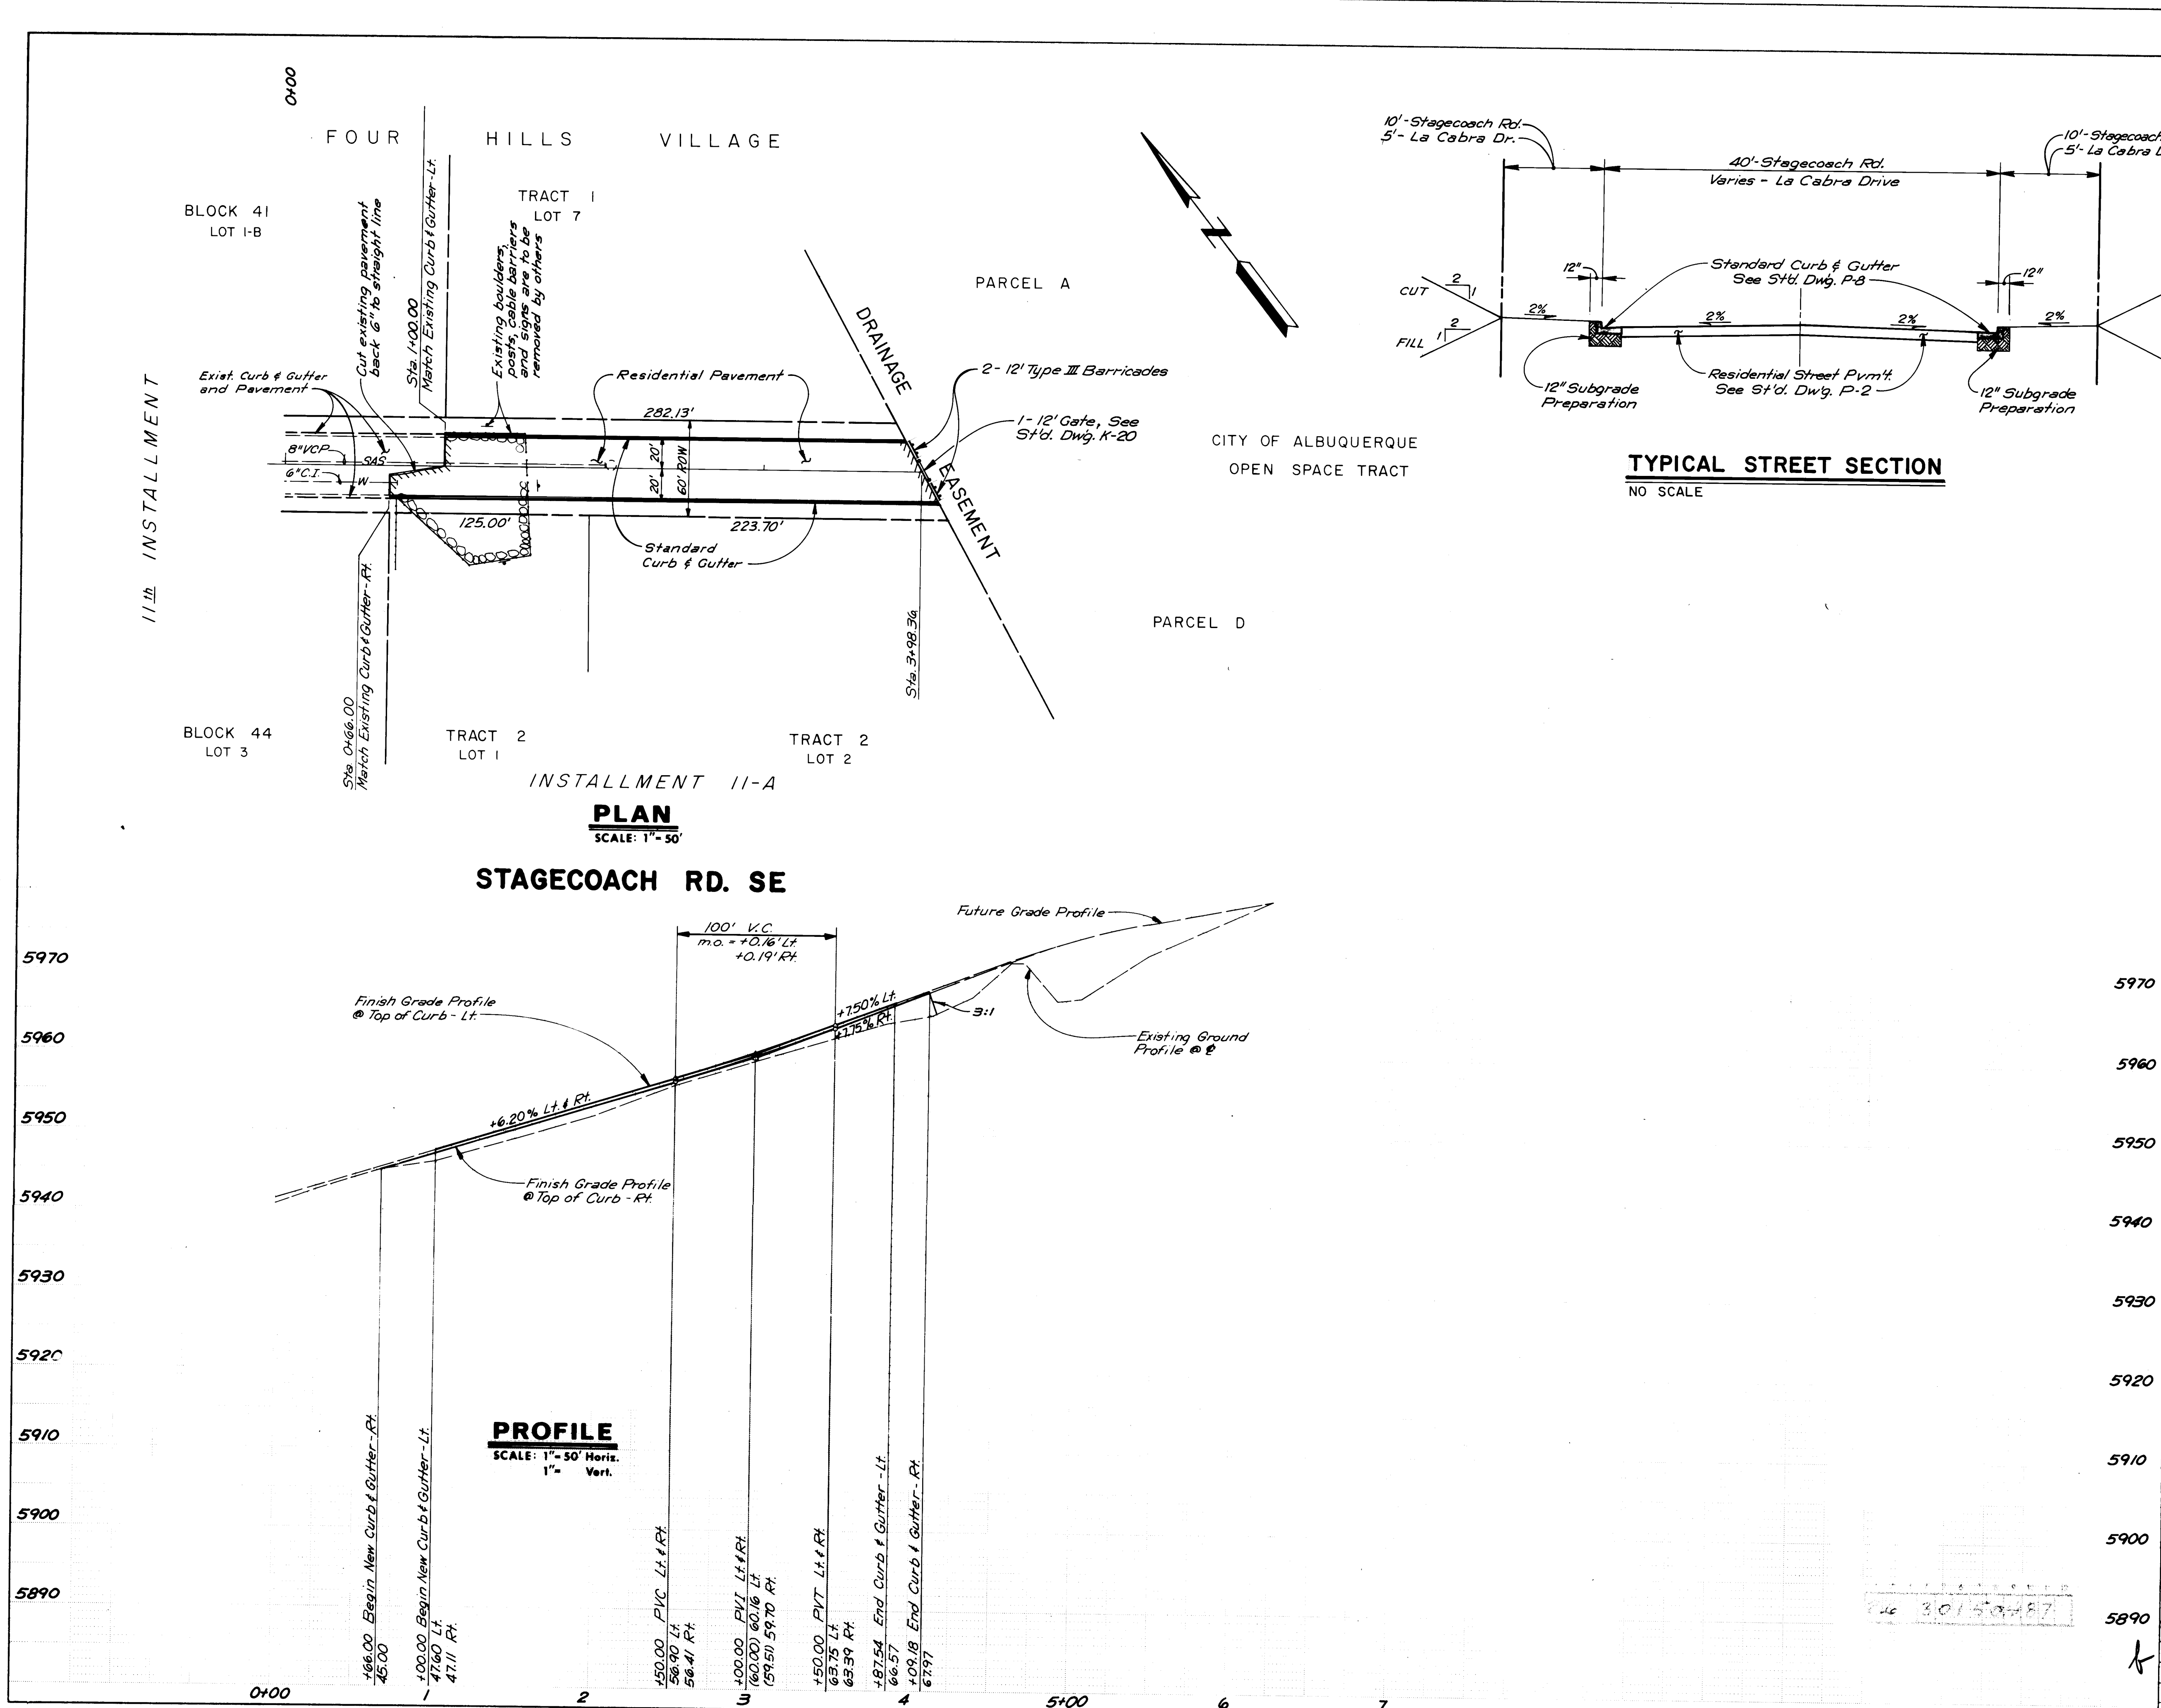

TYPICAL STREET SECTION
NO SCALE

AS BUILT INFORMATION			
CONTRACTOR	J.R. Hale Inc.	DATE	12-06
WORK BY	444R	DATE	12-06
INSPECTOR		DATE	
ACCURACY BY		DATE	
VERIFICATION BY		DATE	
DATE	12-07	DATE	12-07
RECORDED BY		DATE	
NO		DATE	

BENCH MARKS			
"STA. 10+23"	ELEVATION 5904.33	DATE	
CHISELED SQUARE, "12"	ON TOP OF CURB AT THE SE CORNER OF STAGECOACH ROAD SE AND LA CABRA PLACE SE.	DATE	

SURVEY INFORMATION			
NO.	BY	DATE	

ENGINEER'S SEAL			
DESIGNED BY	DATE	CHECKED BY	DATE
DRAWN BY	DATE		
CHECKED BY	DATE		

REVISIONS			
NO.	DATE	REMARKS	BY
		DESIGN	

RECORD DRAWING

CITY OF ALBUQUERQUE DEPARTMENT OF PUBLIC WORKS

FOUR HILLS VILLAGE-INSTALLMENT II-A


STAGECOACH RD. & LA CABRA DR. EXTENSIONS

PAVING PLAN & PROFILE


STAGECOACH ROAD SE.

APPROVALS	ENGINEER	DATE	APPROVALS	ENGINEER	DATE
City Engineer		9/5/06	Liquid Waste	N/A w/w	8/29/06
A.C.E.-Design			Traffic		8/29/06
A.C.E.-Hydrology			Water	N/A w/w	8/29/06

DRAWING NO.	MAP NO.	SHEET	OF
3015	M-23	4	7

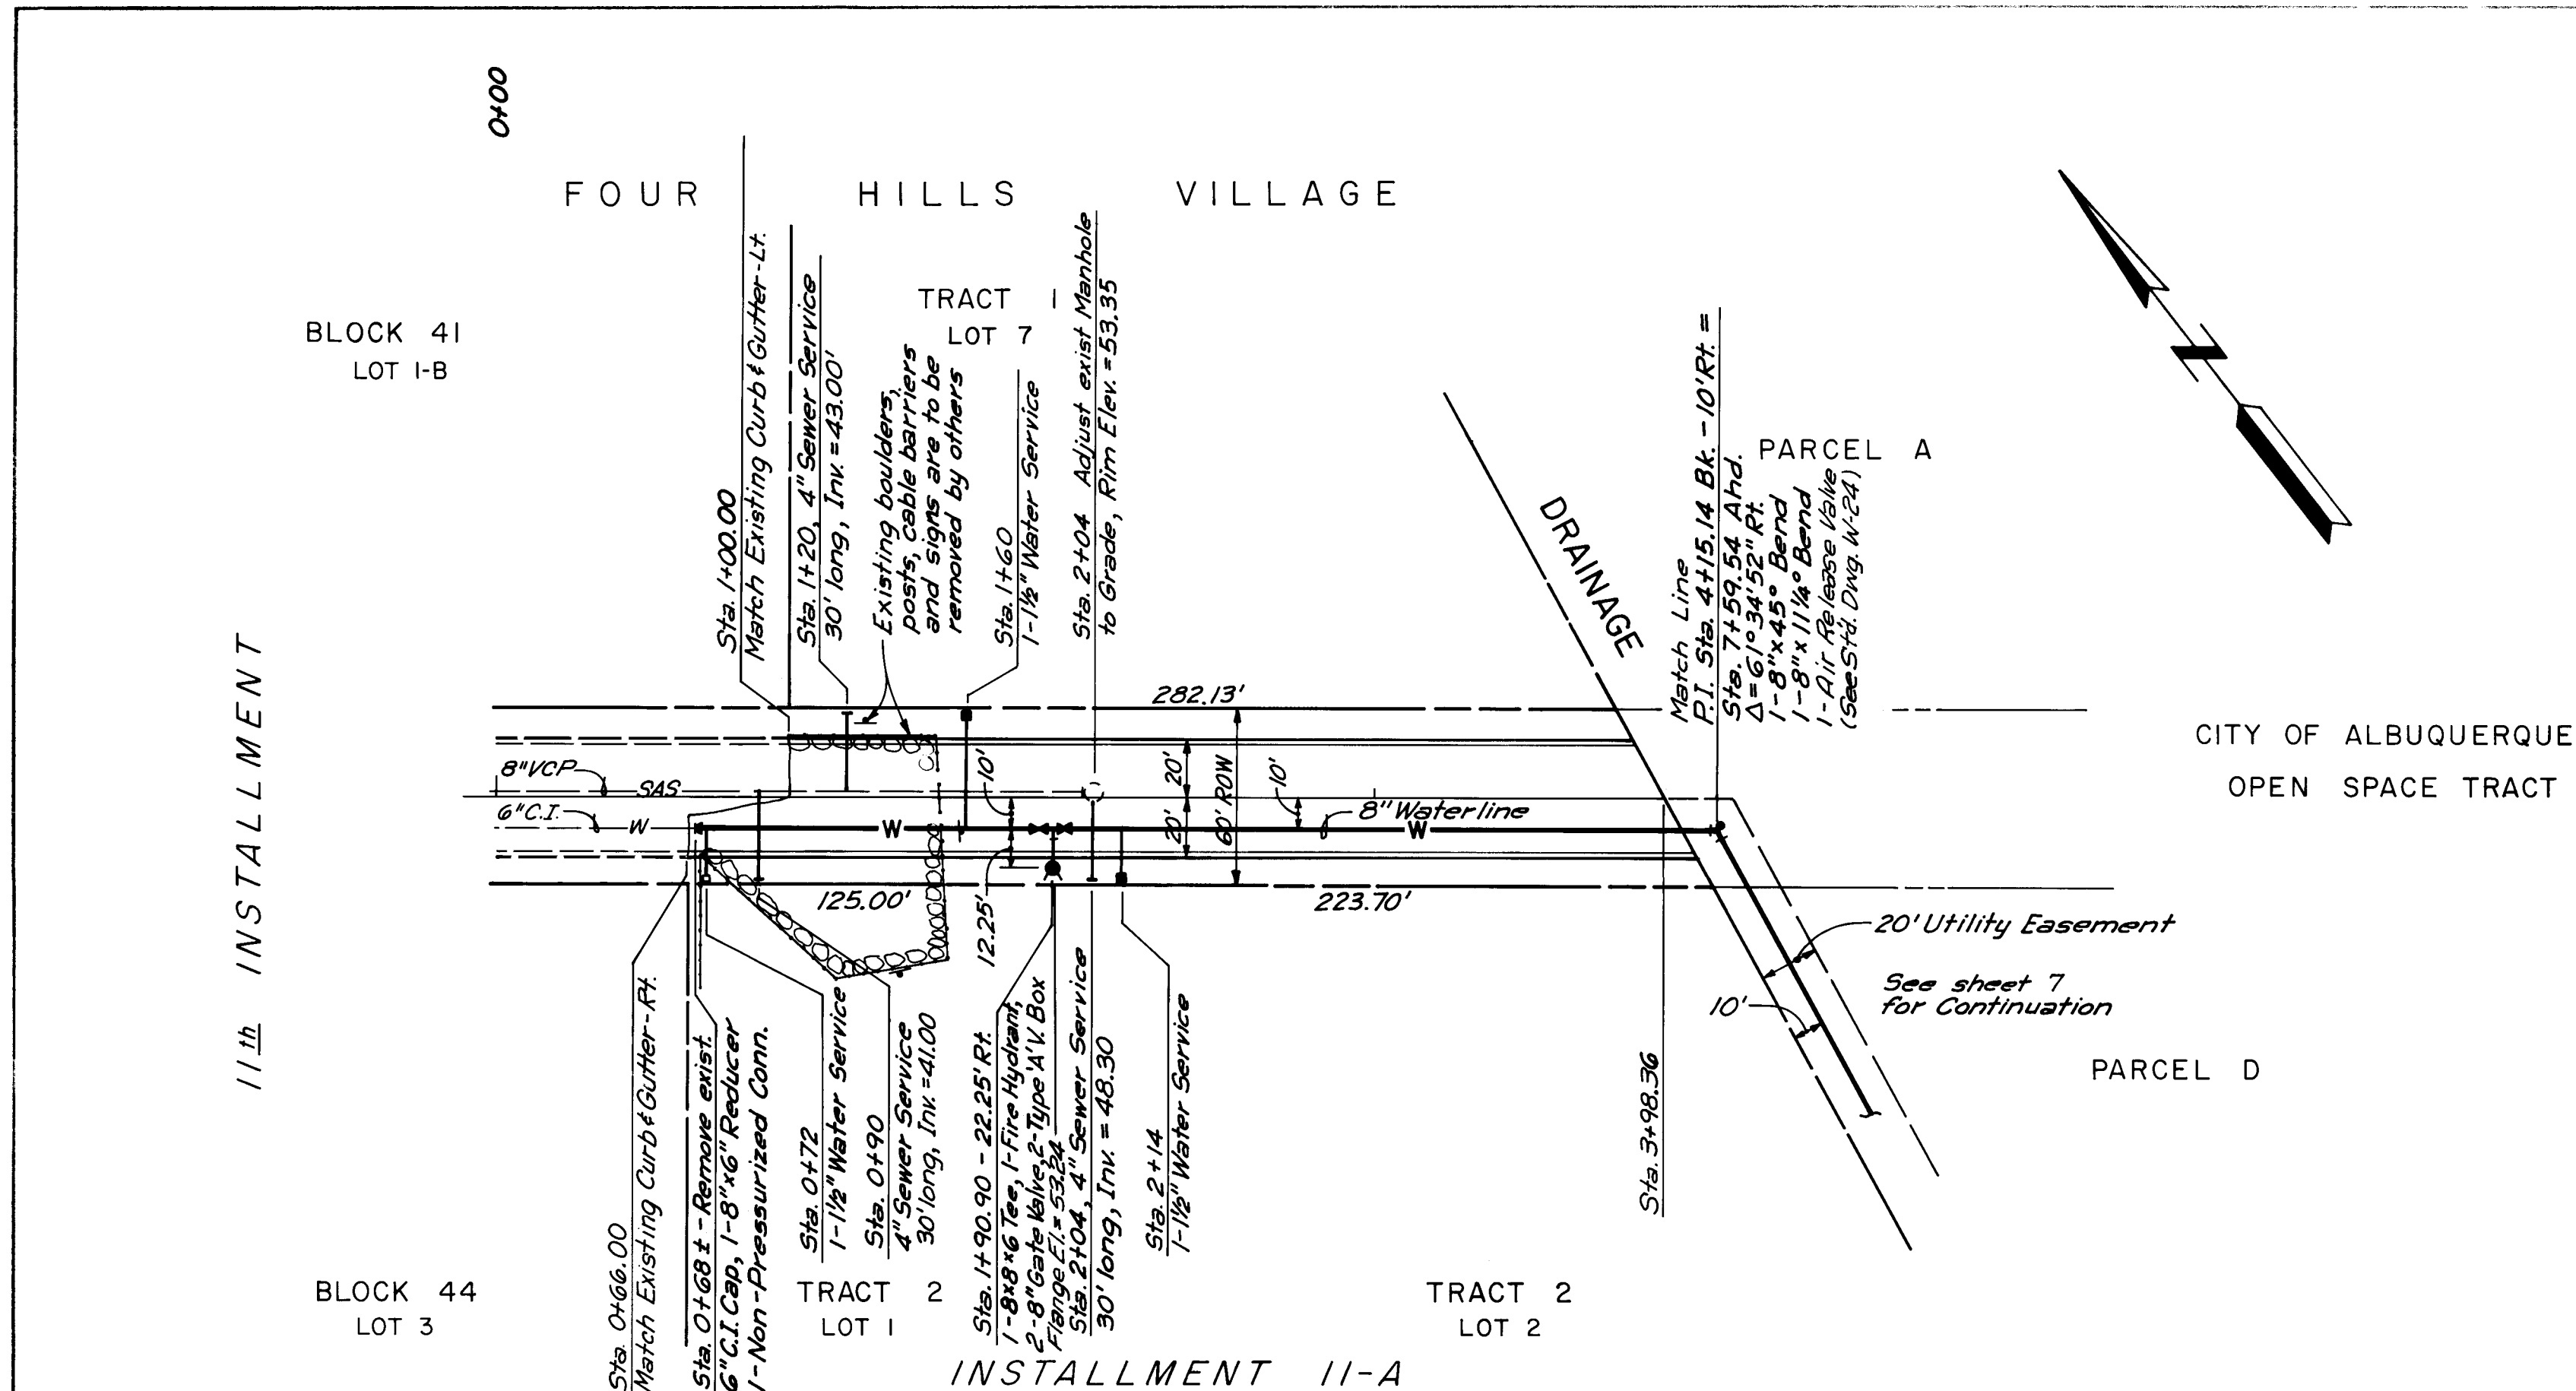

PLAN
SCALE: 1" = 50'

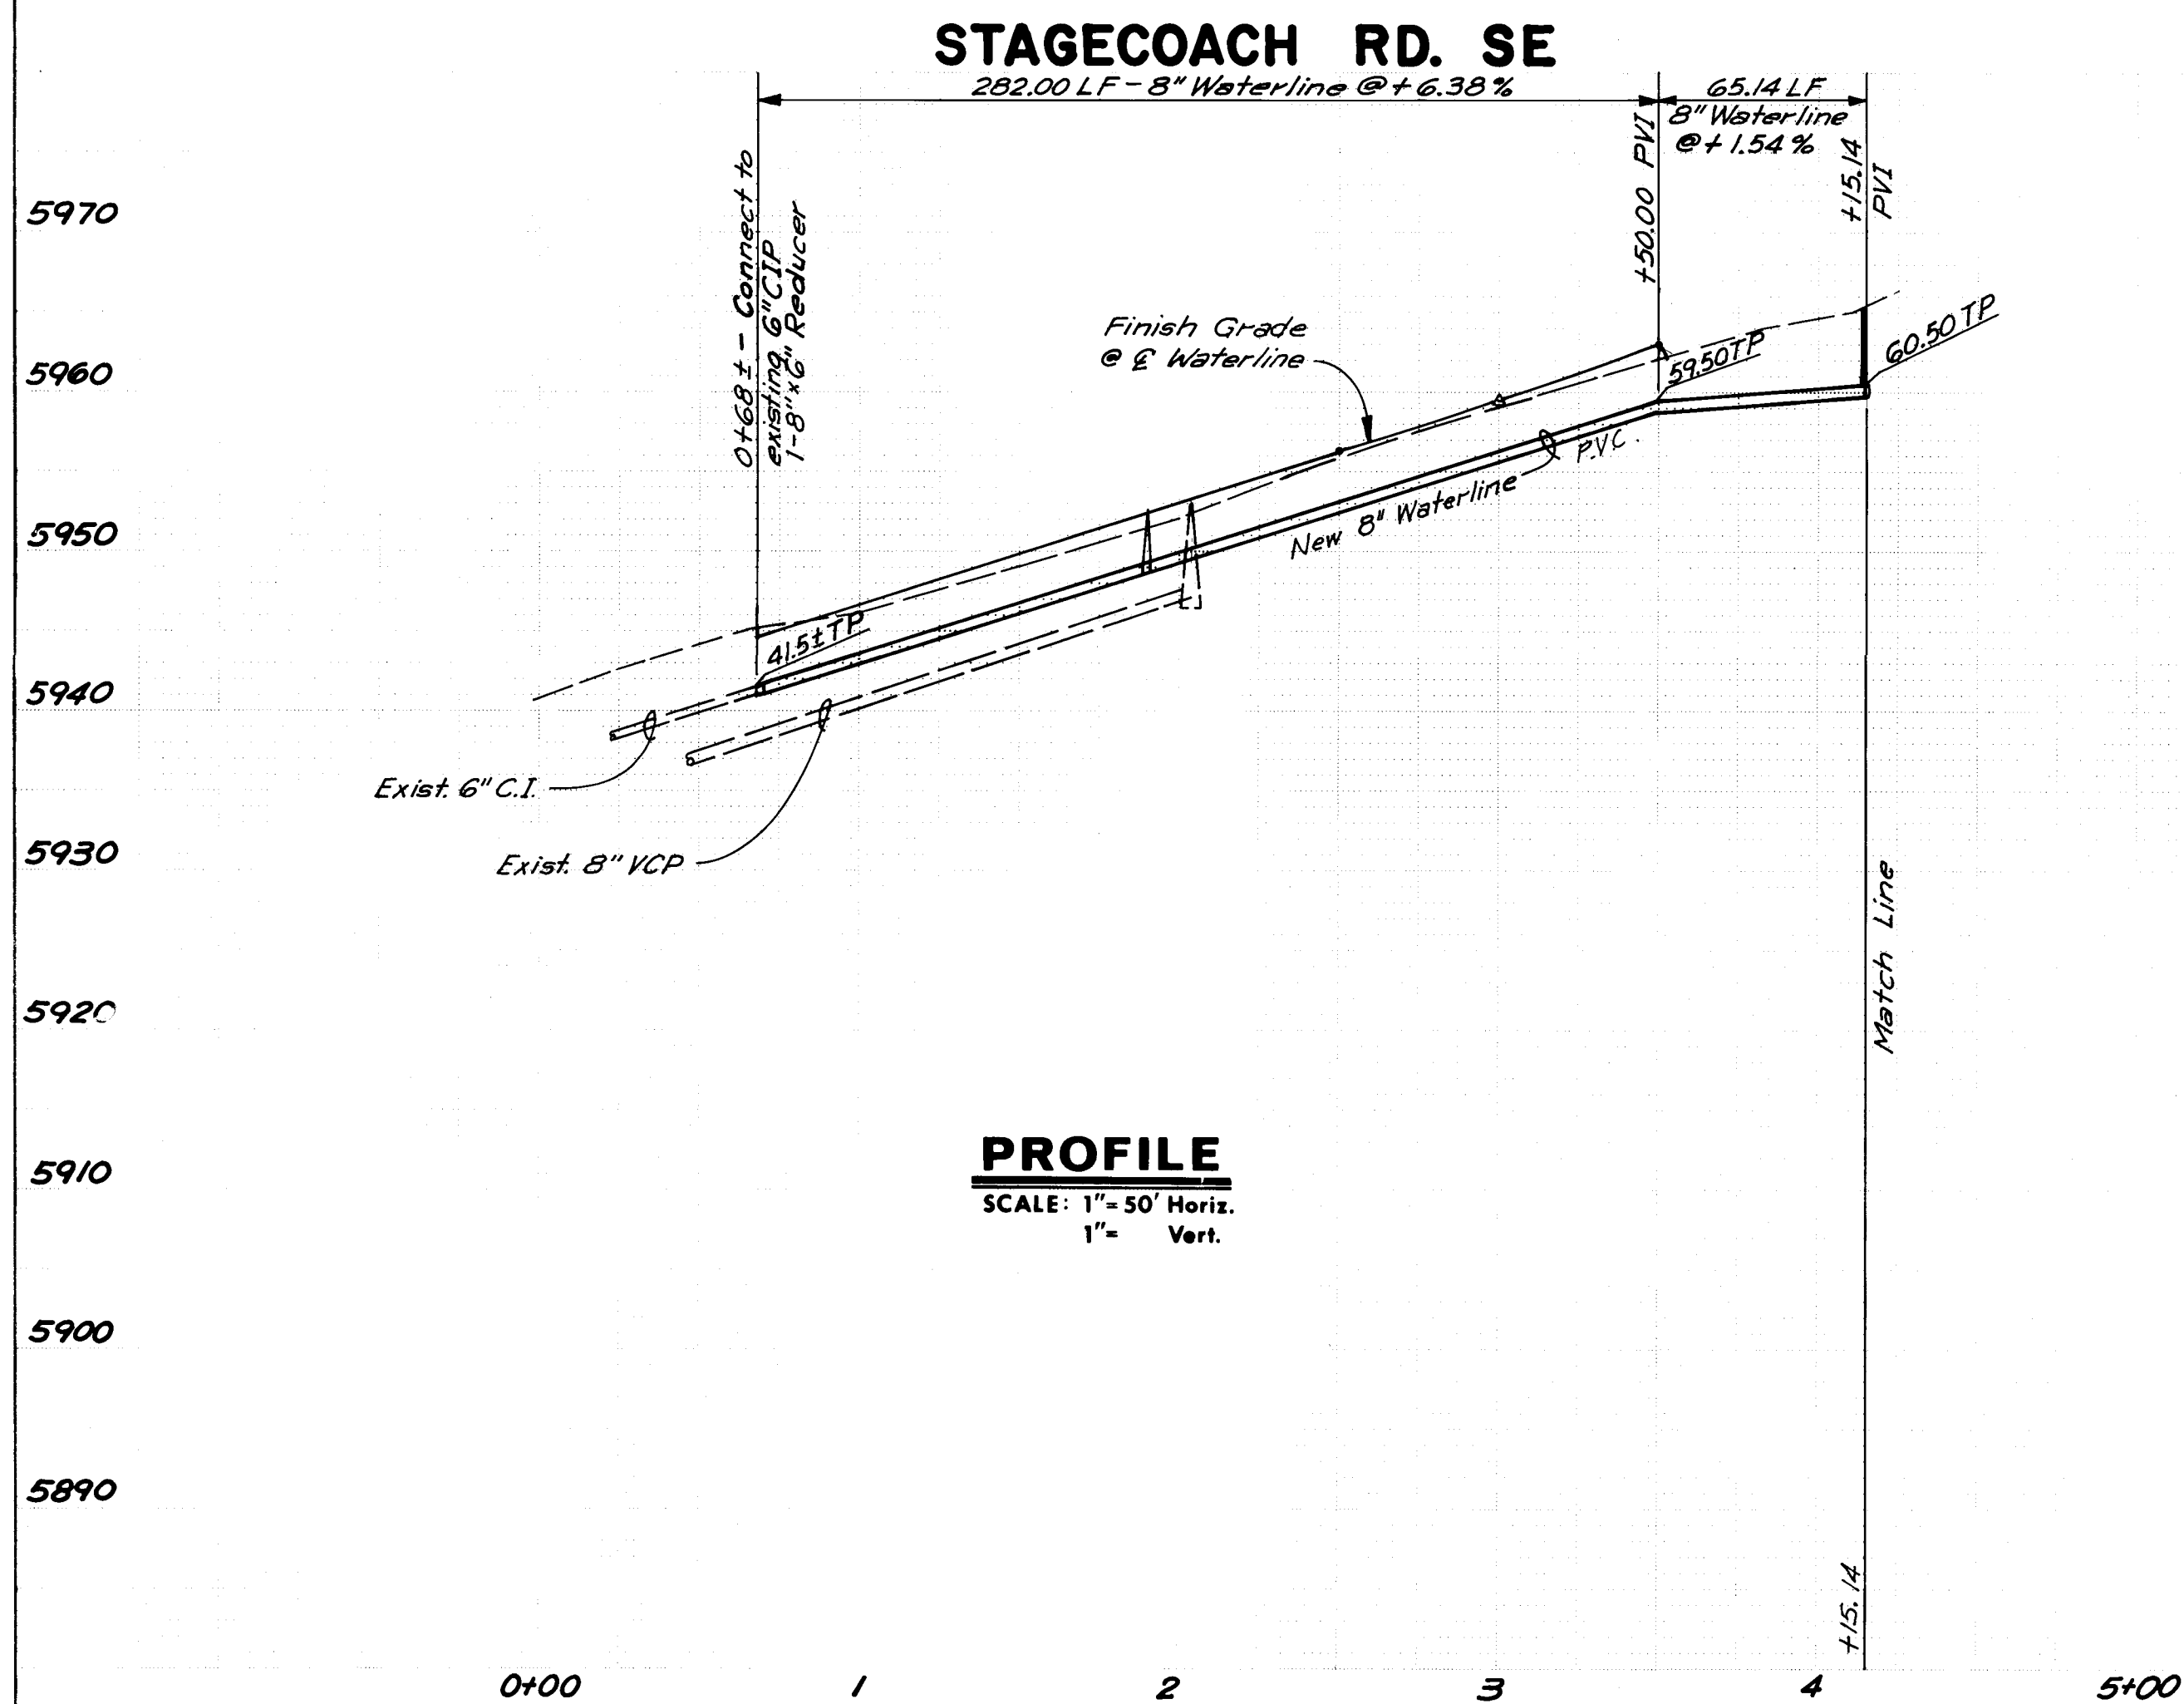


PROFILE
SCALE: 1" = 50' Horiz.
1" = Vert.

John D. Anderson
RECORD DRAWING

SURVEY INFORMATION		BENCH MARKS		AS BUILT INFORMATION	
NO.	BY	DATE	NO.	CONTRACTOR	DATE
			10-M23"	J.P. Hule Inc.	12-96
			CHISELED SQUARE, "X" ON TOP OF CURB AT THE SE CORNER OF STAGECOACH ROAD SE AND LA TUNA PLACE SE.	INSPECTED BY	DATE
				FIELD ENGINEER	DATE
				CHECKED BY	DATE
				CORRECTED BY	DATE
				MICRO-FILM	DATE
				RECORDED BY	DATE
				NO.	DATE

CITY OF ALBUQUERQUE DEPARTMENT OF PUBLIC WORKS					
FOUR HILLS VILLAGE-INSTALLMENT II-A					
STAGECOACH RD. & LA CABRA DR. EXTENSIONS					
SANITARY SEWER & WATERLINE PLAN & PROFILE					
STAGECOACH ROAD SE.					
APPROVALS	ENGINEER	DATE	APPROVALS	ENGINEER	DATE
City Engineer	<i>[Signature]</i>	9/5/86	City Engineer	<i>[Signature]</i>	8/29/86
ACE - Design	" "	" "	ACE - Design	<i>[Signature]</i>	8-29-86
ACE - Hydrology	" "	" "	ACE - Hydrology	<i>[Signature]</i>	8/29/86

DRAWING NO.	3015	MAP NO.	M-23	SHEET	6	OF	7
-------------	------	---------	------	-------	---	----	---

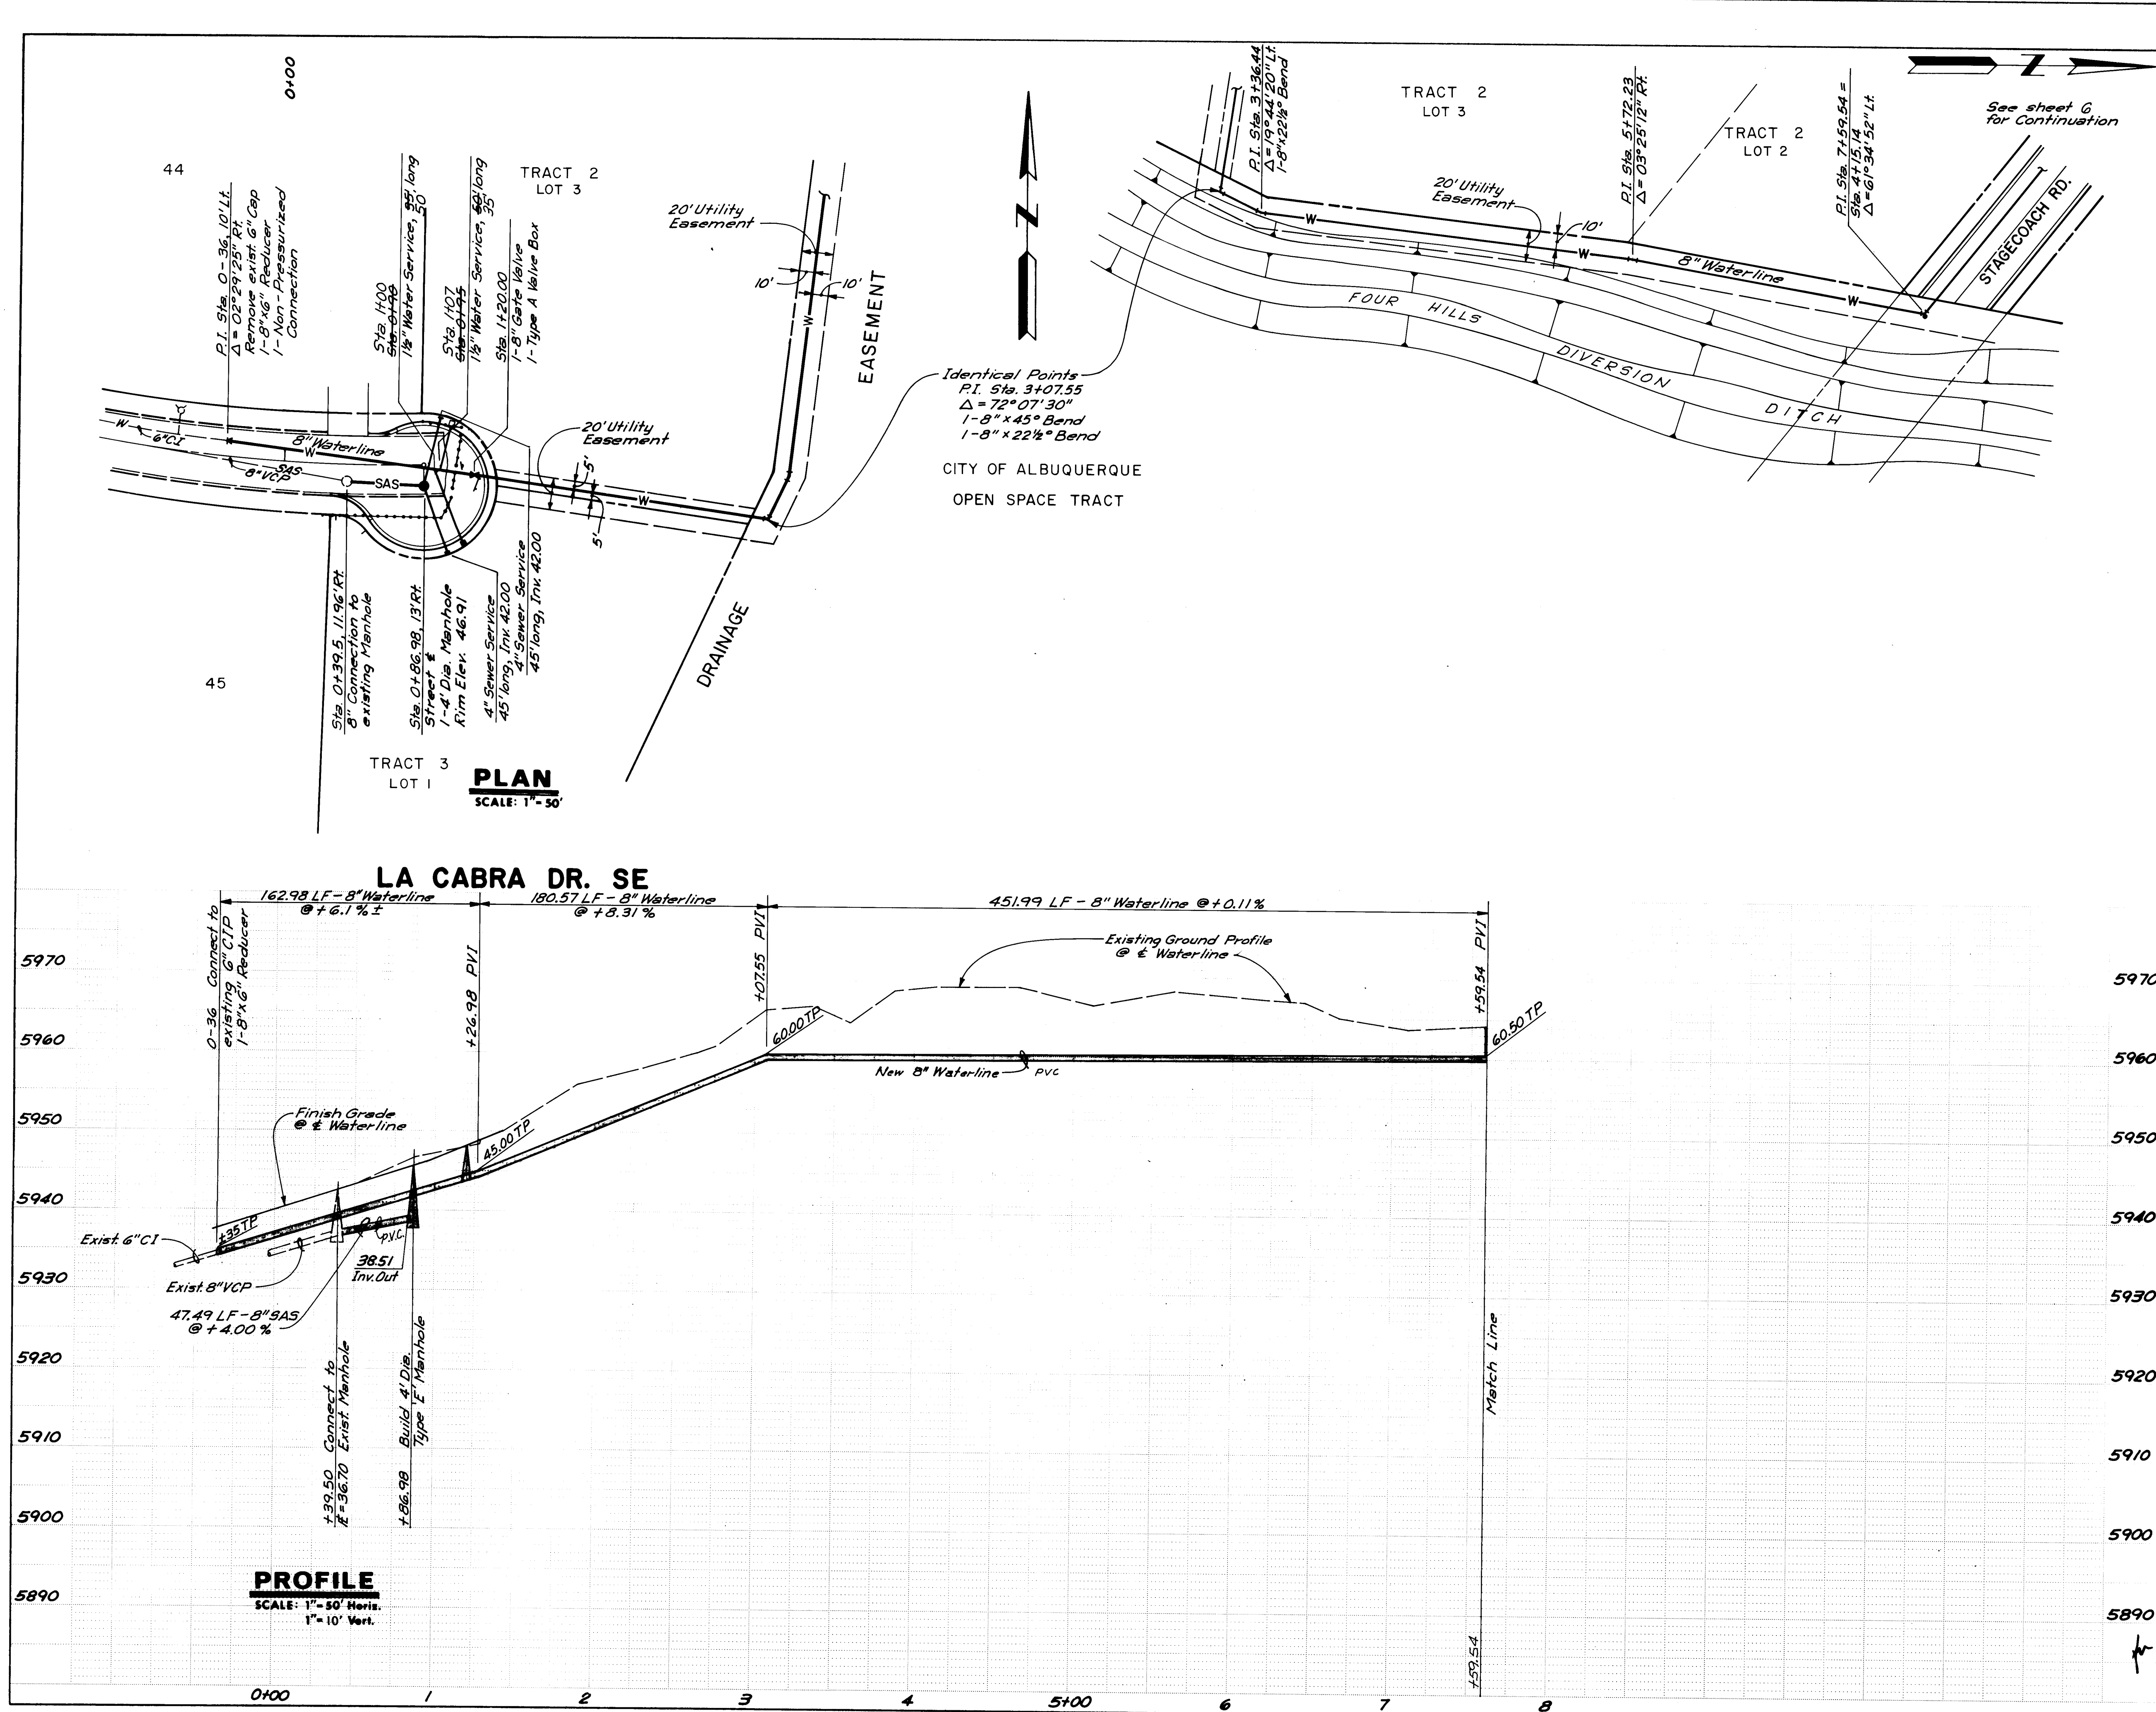

AS BUILT INFORMATION		BENCH MARKS		SURVEY INFORMATION		ENGINEER'S SEAL	
CONTRACTOR	J.R. Hale, Inc.	"STA. 10-M23"	ELEVATION 5904.33	NO.	DATE	NO.	DATE
WORK	SEWER BY A.I.P.	CHISELED SQUARE, "C"	ON TOP OF CURB AT THE SE CORNER OF STAGECOACH ROAD SE AND LA TUNA PLACE SE.	BY	DATE	BY	DATE
DATE	12-86	ACCEPTANCE BY		NO.	DATE	NO.	DATE
DATE		FIELD INSPECTION BY		DESIGNED BY	DATE	DRAWN BY	DATE
DATE		CORRECTED BY A.I.P.		CHECKED BY	DATE		DATE
MICRO-FILM INFORMATION							
RECORDED BY							
NO.							
26 30150787 <i>John D. Andrews</i> RECORD DRAWING							
CITY OF ALBUQUERQUE DEPARTMENT OF PUBLIC WORKS FOUR HILLS VILLAGE-INSTALLMENT II-A STAGECOACH RD. & LA CABRA DR. EXTENSIONS SANITARY SEWER & WATERLINE PLAN & PROFILE LA CABRA DRIVE SE.							
APPROVALS	ENGINEER	DATE	APPROVALS	ENGINEER	DATE		
City Engineer	<i>[Signature]</i>	2/2/86	Liquid Waste	<i>[Signature]</i>	8/29/86		
A.C.E. Design	" "	" "	Traffic	<i>[Signature]</i>	8-29-86		
A.C.E. Hydrology	" "	" "	Water	<i>[Signature]</i>	8/29/86		
DRAWING NO.	3015	MAP NO.	M-23	SHEET	7 OF 7		