


RELOCATION OF ALBUQUERQUE HIGH SCHOOL ENTRANCE, ODELIA RD., N.E.

- L E G E N D -


MATERIALS

CONCRETE
RIP-RAP

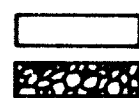


LINES

SUBDIVISION BOUNDARY
PROPERTY LINE (PLAN)
PROPERTY LINE (SECTION)
CENTERLINE
EASEMENT LINE
MATCH LINE
SECTION CUT LINE

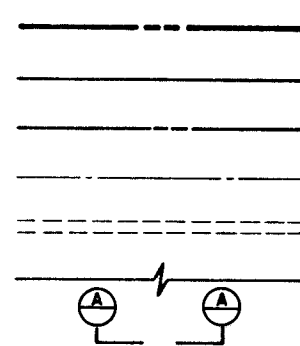


EARTHWORK

CONTOUR LINE
SPOT ELEVATION
PROJECT / PHASE BOUNDARY
SWALE
DIRECTION OF FLOW

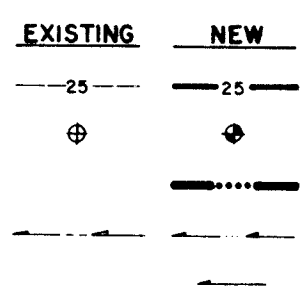


MISCELLANEOUS UTILITIES

GAS LINE
UNDERGROUND TELEPHONE
UNDERGROUND ELECTRICAL
STORM DRAIN
STORM DRAIN MANHOLE
STORM DRAIN INLET

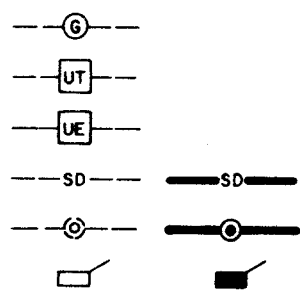


SANITARY SEWER

SANITARY SEWER LINE
SANITARY SEWER MANHOLE
SAS SERVICE CONNECTIONS
SAS CAP OR PLUG
ENCASEMENT

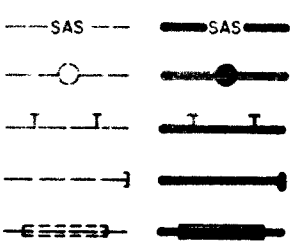


WATER

WATER LINE
WATER SERVICE CONNECTIONS
GATE VALVE
FIRE HYDRANT
BUTTERFLY VALVE
REDUCER
WATER PRESSURE ZONE BOUNDARY

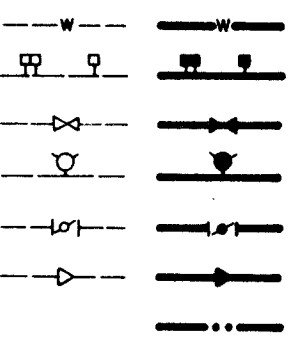


WATER FITTINGS

CAPS AND PLUGS
ELBOW
CROSS
TEE

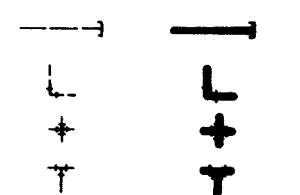


MISCELLANEOUS

CHAINLINK FENCE
FIELD FENCE
COMMON YARD WALL
RETAINING WALL
POWER OR TELEPHONE POLE

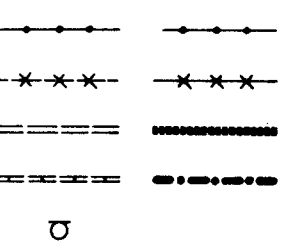

INDEX

SHEET 1 TITLE SHEET
SHEET 2 PLAN & PROFILE
SHEET 3 DETAILS

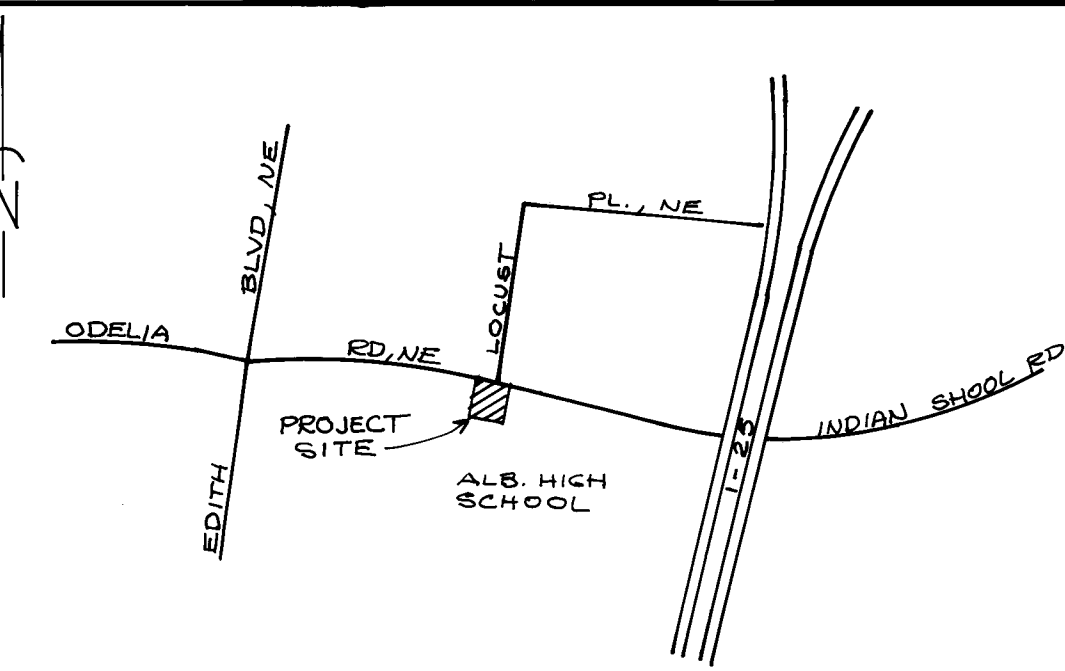


LOCATION MAP J-15

NOTICE TO CONTRACTORS

- All work detailed on these plans to be performed under contract shall, except as otherwise stated or provided for hereon, be constructed in accordance with the City of Albuquerque Interim Standard Specifications For Public Works Construction 1985.
- Two(2) working days prior to any excavation, the contractor must contact Line Locating Service, 765-1234 for location of existing utilities.
- Prior to construction, the contractor shall excavate and verify the horizontal and vertical locations of all obstructions. Should a conflict exist, the contractor shall notify the engineer or surveyor so that the conflict can be resolved with minimum amount of delay.

THE FOLLOWING NOTES ALSO APPLY WHEN CHECKED


- ☒ All utilities and utility service lines shall be installed prior to paving.
- ☒ Backfill compaction shall be according to specified street use.
- ☒ Tack coat requirements shall be determined by the City Engineer.
- ☒ Sidewalks and wheelchair ramps within the curb returns shall be constructed wherever a new curb return is constructed.
- ☒ If curb is depressed for a driveway or a handicap ramp, the driveway or ramp shall be constructed prior to acceptance of the curb and gutter.
- ☒ All storm drainage facilities shall be completed prior to final acceptance.

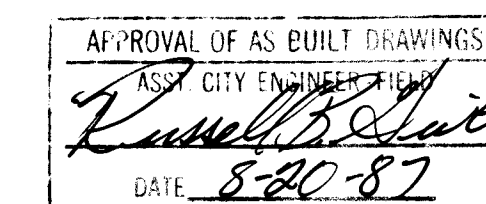

26 30220187

REV SHEETS	CITY ENGINEER	DATE	USER DEPT.	DATE	USER DEPT.	DATE
APPROVAL OF REVISIONS						

	CITY OF ALBUQUERQUE	APPROVED FOR CONSTRUCTION Principal Engineer Design 5/23/82
	DRAWING NO. 3022	SHEET 1 OF 3

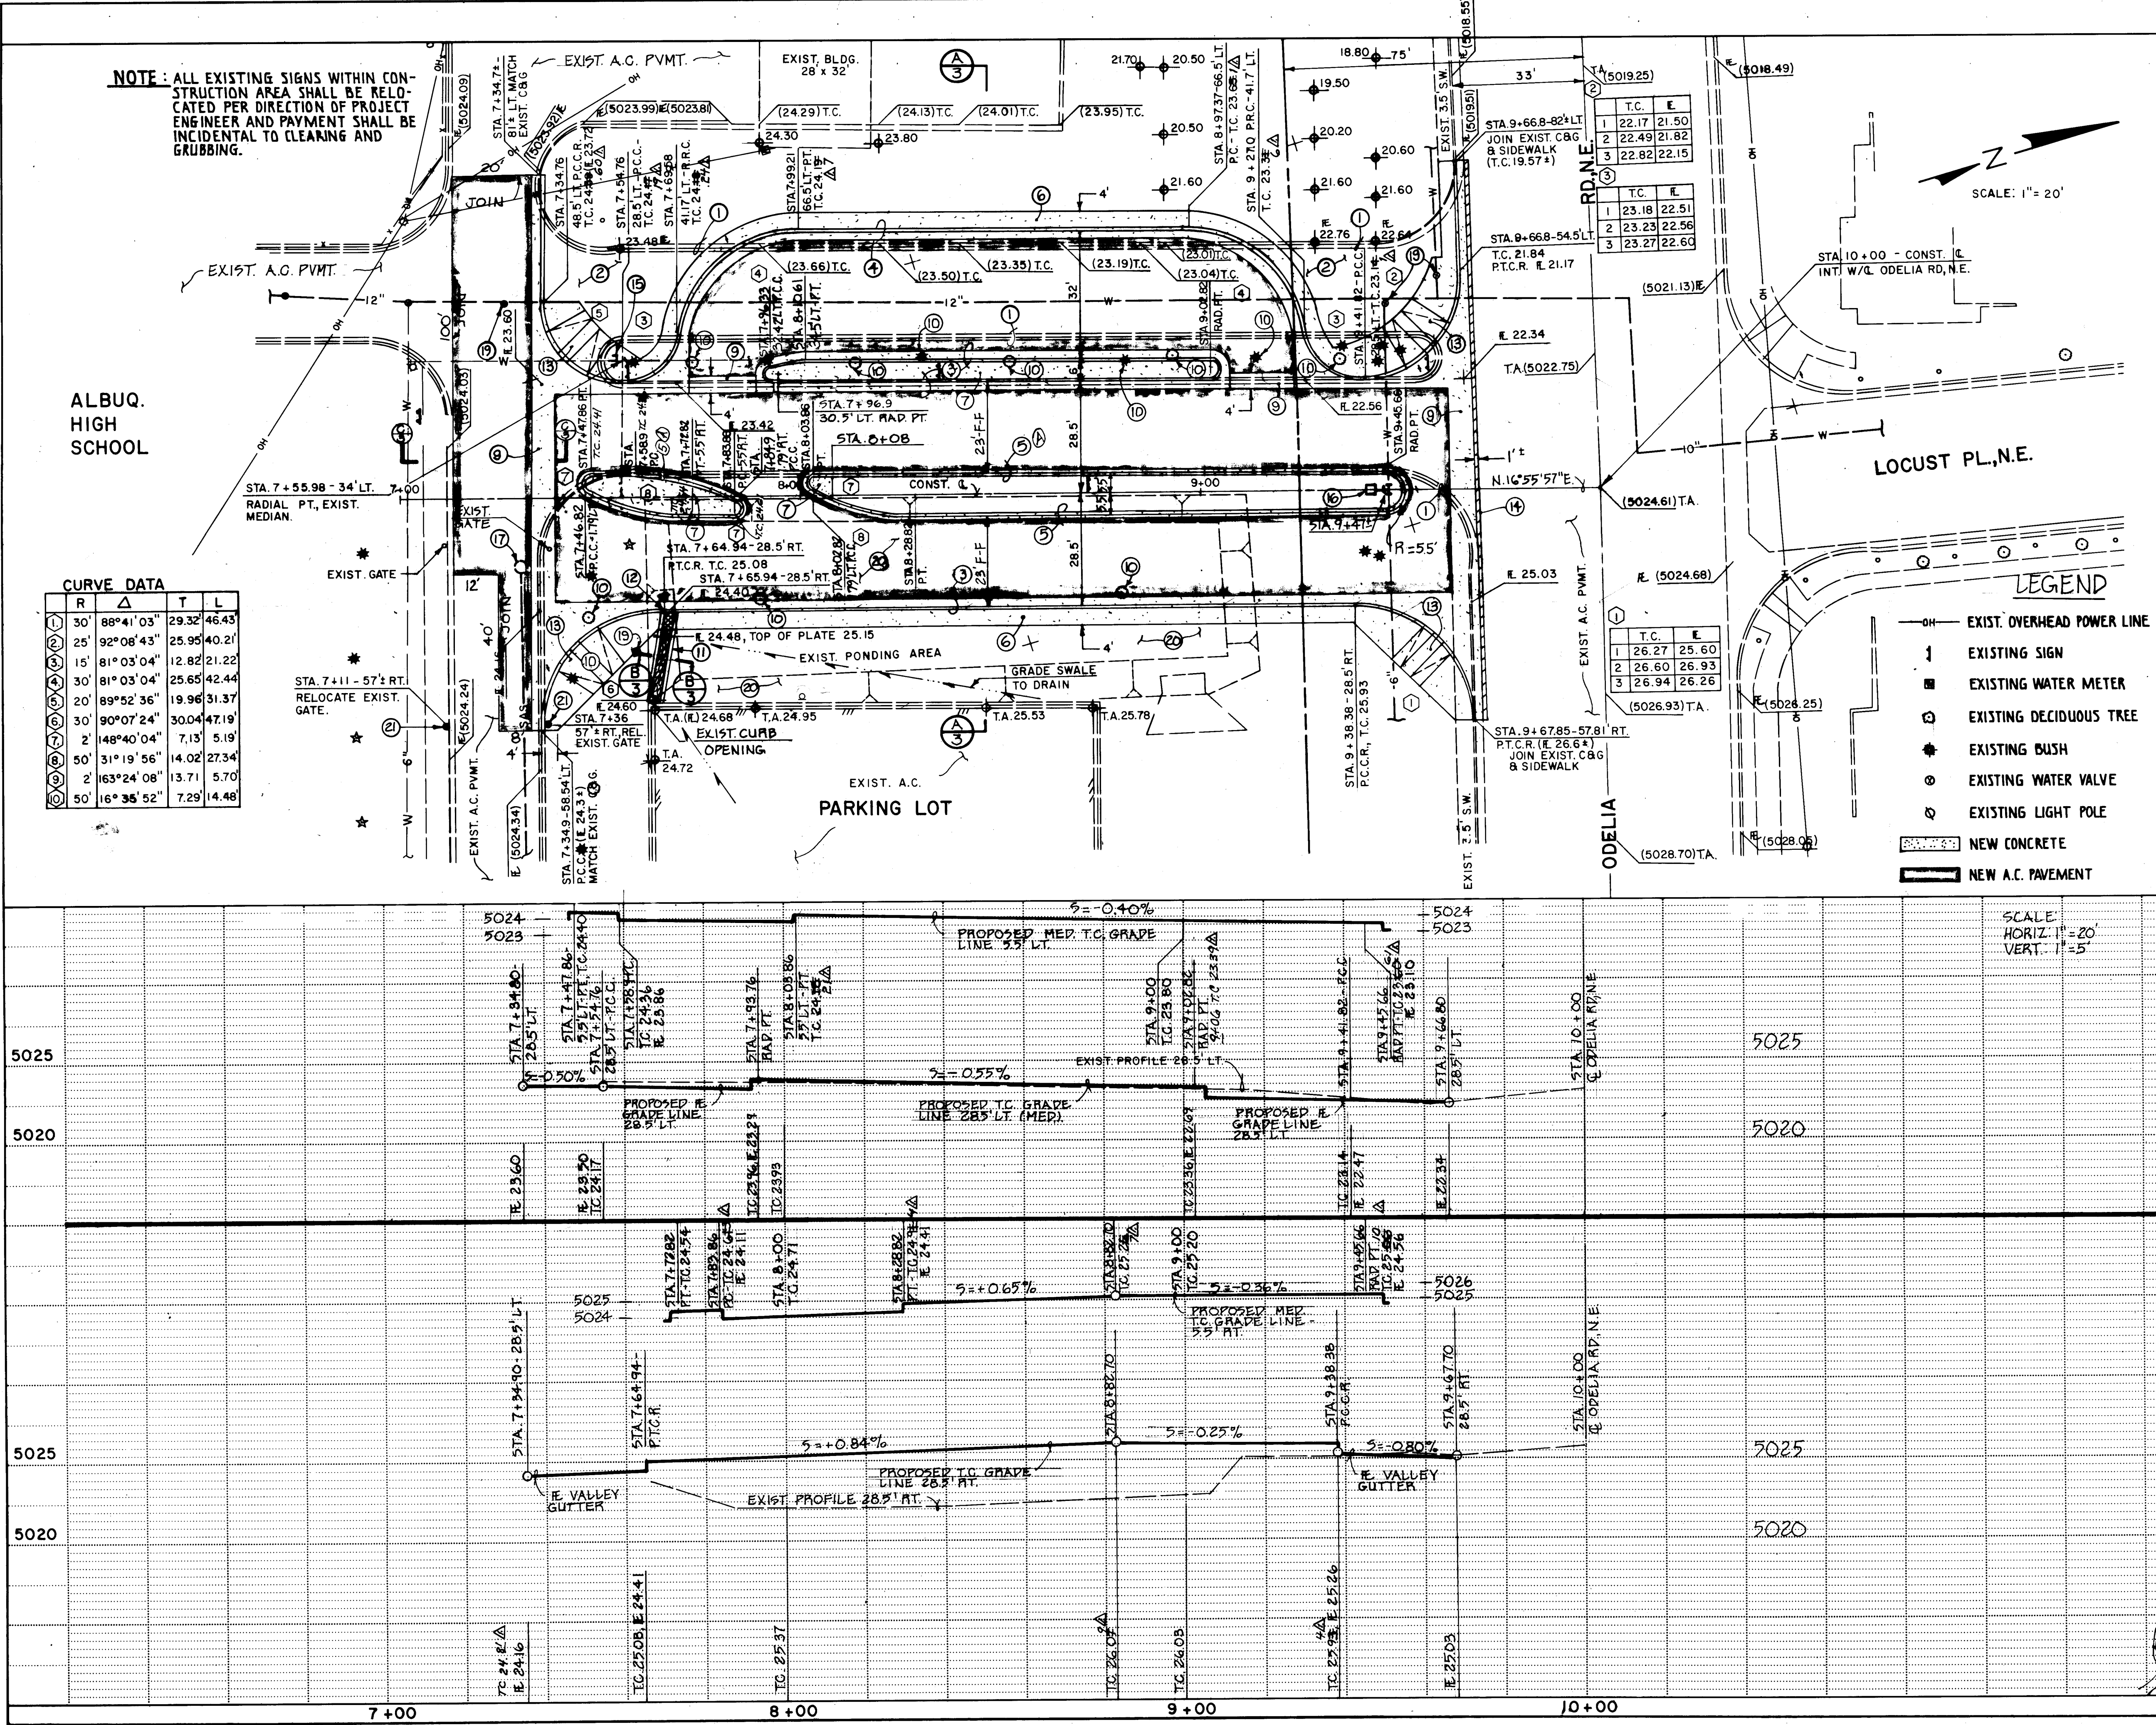

NOTE: ALL EXISTING SIGNS WITHIN CONSTRUCTION AREA SHALL BE RELOCATED PER DIRECTION OF PROJECT ENGINEER AND PAYMENT SHALL BE INCIDENTAL TO CLEANING AND GRUBBING.

CURVE DATA

R	Δ	T	L
30'	88°41'03"	29.32'	46.43'
25'	92°06'43"	25.95'	40.21'
15'	81°03'04"	12.82'	21.22'
30'	81°03'04"	25.65'	42.44'
20'	89°52'36"	19.96'	31.37'
30'	90°07'24"	30.04'	47.19'
2'	148°40'04"	7.13'	5.19'
50'	31°19'56"	14.02'	27.34'
2'	163°24'08"	13.71'	5.70'
50'	16°36'52"	7.29'	14.48'

- CONSTRUCTION NOTES
1. REMOVE AND DISPOSE OF EXISTING CONCRETE CURB AND GUTTER.
 2. REMOVE AND DISPOSE OF EXISTING A.C. PAVEMENT.
 3. CONSTRUCT STANDARD CURB AND GUTTER PER STD. DWG. P-8.
 4. CONSTRUCT DEPRESSED GUTTER PER STD. DWG. P-8.
 5. CONSTRUCT MEDIAN CURB AND GUTTER STD. DWG. P-8.
 6. CONSTRUCT 4" CONCRETE SIDEWALK.
 7. CONSTRUCT 4" MEDIAN CONCRETE PAVEMENT.
 8. CONSTRUCT ASPHALT PAVING PER PAVING SECTION A-A ON SHEET 3.
 9. CONSTRUCT CONCRETE VALLEY GUTTER PER STD. DWG. P-9.
 10. REMOVE AND DISPOSE OF EXISTING TREE-SHRUB. CUT & CAP EXISTING IRRIGATION BUBBLER.
 11. CONSTRUCT RIP-RAP CHANNEL PER SECTION B-B ON SHEET 3.
 12. CONSTRUCT 24" SIDEWALK CULVERT PER STD. DWG. K-16.
 13. CONSTRUCT WHEEL CHAIR RAMP PER STD. DWG. P-17.
 14. REMOVE AND REPLACE EXISTING ARTERIAL PAVEMENT PER STD. DWG. P-3. EXACT LIMITS OF REMOVAL TO BE DETERMINED BY FIELD ENGINEER.
 15. ABANDON AND PLUG EXISTING MEDIAN IRRIGATION LINE SALVAGE EXISTING INVERTED SYPHON.
 16. PROVIDE 3/4" METER BOX AND TAP WITH 5' STUB FROM MAIN.
 17. ADJUST EXISTING SAS MANHOLE FRAME AND COVER TO GRADE.
 18. ADJUST EXISTING WATER METER TO GRADE.
 19. ADJUST EXISTING WATER VALVE TO GRADE.
 20. REGRADE EXISTING POND AREA.
 21. RELOCATE EXISTING GATE.

TRAFFIC CONTROL DURING CONSTRUCTION

1. APPROPRIATE TRAFFIC CONTROL AND BARRICADING SHALL BE USED DURING CONSTRUCTION TO WARN MOTORISTS AND PEDESTRIANS OF CONSTRUCTION OPERATIONS.
2. ONE LANE IN EACH DIRECTION SHALL BE MAINTAINED OPEN ON ODELIA ROAD AT ALL TIMES.
3. ENTRANCE CLOSURE SIGNS AS SPECIFIED ON SHEET 3 SHALL BE INSTALLED ON ODELIA RD., ONE FOR EACH DIRECTION OF TRAFFIC AT LEAST 48 HOURS PRIOR TO COMMENCEMENT OF ANY CONSTRUCTION ACTIVITY. THESE SIGNS SHALL BE MAINTAINED BY THE CONTRACTOR THROUGHOUT THE CONSTRUCTION PERIOD.

26 30220287

CITY OF ALBUQUERQUE
MUNICIPAL DEVELOPMENT DEPARTMENT
ENGINEERING DIVISION

TITLE:
RELOCATION OF ENTRANCE TO ALBUQUERQUE
HIGH SCHOOL ON ODELIA ROAD.

APPROVALS	ENGINEER	DATE	APPROVALS	ENGINEER	DATE
City Engineer	[Signature]	1/16/86	Liquid Waste	W/W	1-15-87
A.C.E.-Design	[Signature]	1/15/87	Traffic	[Signature]	1-15-87
A.C.E.-Hydrology	[Signature]	1/15/87	Water	W/W	1-15-87

AS BUILT INFORMATION		BENCH MARKS		SURVEY INFORMATION		ENGINEER'S SEAL	
CONTRACTOR	UNIVERSAL	NO.	DATE	NO.	DATE	NO.	DATE
WORK BY		NO.	DATE	NO.	DATE	NO.	DATE
ACCEPTANCE BY	R. GARCIA	NO.	DATE	NO.	DATE	NO.	DATE
FIELD BY		NO.	DATE	NO.	DATE	NO.	DATE
REVISIONS		NO.	DATE	NO.	DATE	NO.	DATE
DESIGN		NO.	DATE	NO.	DATE	NO.	DATE
DESIGNED BY	P. FANG / P. BENNETT	NO.	DATE	NO.	DATE	NO.	DATE
DRAWN BY	P. HERNANDEZ	NO.	DATE	NO.	DATE	NO.	DATE
CHECKED BY	P. FANG	NO.	DATE	NO.	DATE	NO.	DATE

