


SUBDIVISION IMPROVEMENT PLAN
FOR
PRAIRIE RIDGE UNIT 2
AT
TAYLOR RANCH
ALBUQUERQUE, NEW MEXICO
FOR
BELLAMAH COMMUNITY DEVELOPMENT

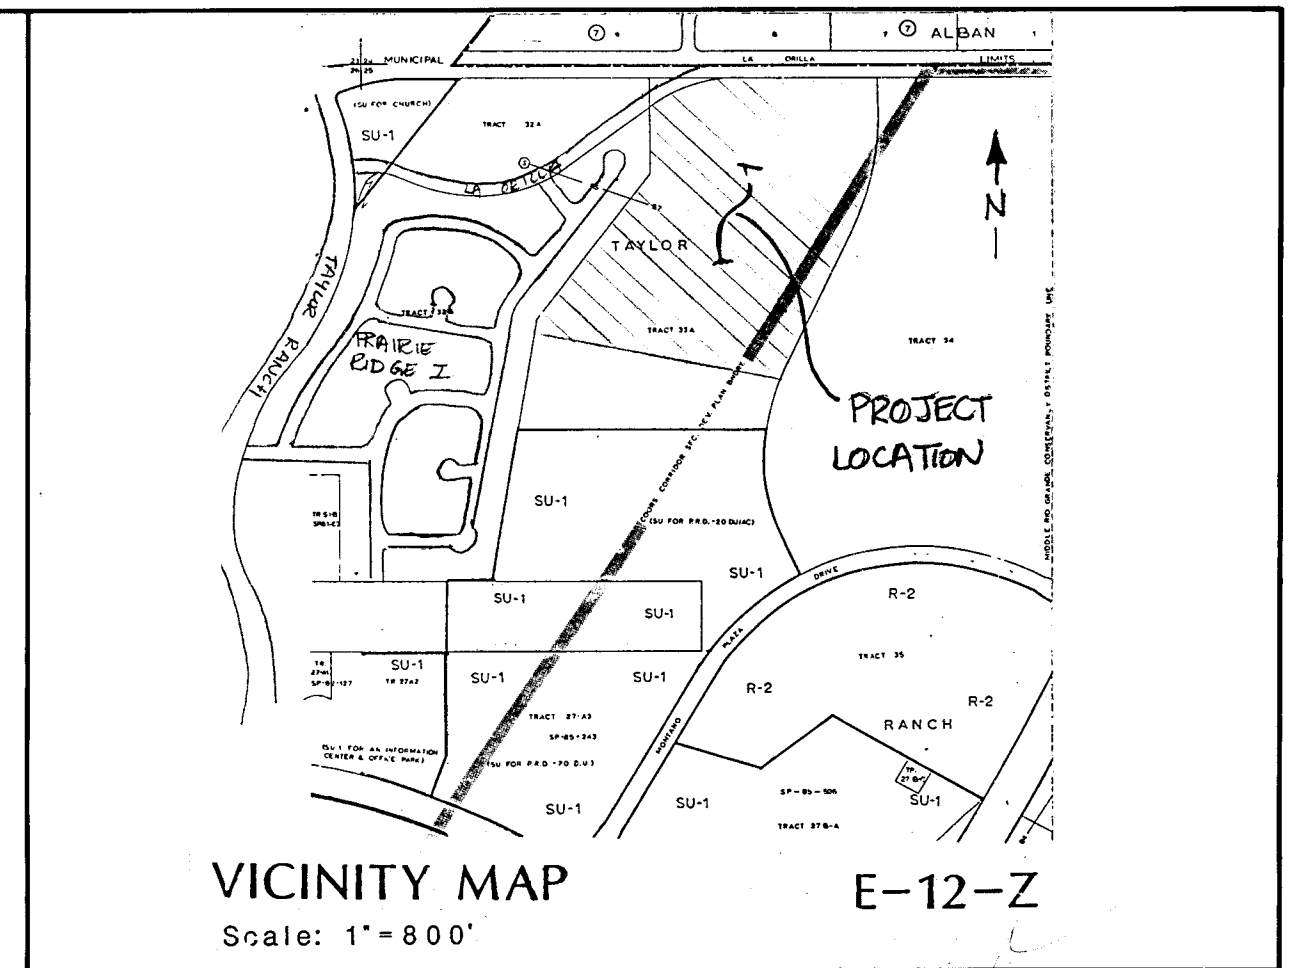

GENERAL NOTES

- ALL WORK DETAILED ON THESE PLANS TO BE PERFORMED UNDER THIS CONTRACT SHALL BE CONSTRUCTED IN ACCORDANCE WITH THE CITY OF ALBUQUERQUE INTERIM STANDARD SPECIFICATIONS FOR PUBLIC WORKS CONSTRUCTION - 1985 EDITION (REFERRED HEREIN AS THE STANDARD SPECIFICATION) AND THE EARTHWORK SPECIFICATION AS NOTED IN THE CONTRACT DOCUMENTS.
- TWO (2) WORKING DAYS PRIOR TO ANY EXCAVATION, CONTRACTOR MUST CONTRACT LINE LOCATING SERVICE, 765-1234, FOR LOCATION OF EXISTING UTILITIES.
- PRIOR TO CONSTRUCTION, THE CONTRACTOR SHALL EXCAVATE AND VERIFY THE HORIZONTAL AND VERTICAL LOCATIONS OF ALL POTENTIAL OBSTRUCTIONS. SHOULD A CONFLICT EXIST, THE CONTRACTOR SHALL NOTIFY THE ENGINEER SO THAT THE CONFLICT CAN BE RESOLVED WITH A MINIMUM AMOUNT OF DELAY.
- ALL WORK ON THIS PROJECT SHALL BE PERFORMED IN ACCORDANCE WITH APPLICABLE FEDERAL, STATE AND LOCAL LAWS, RULES, AND REGULATIONS CONCERNING CONSTRUCTION SAFETY AND HEALTH.
- CONTRACTOR SHALL MAINTAIN ACCESS TO ADJACENT PROPERTIES DURING CONSTRUCTION.
- ALL GAS, ELECTRIC, TELEPHONE LINES, CABLES, AND APPURTENANCES ENCOUNTERED DURING CONSTRUCTION THAT REQUIRE RELOCATION, SHALL BE DONE BY THE RESPONSIBLE UTILITY. CONTRACTOR SHALL BE RESPONSIBLE FOR COORDINATION OF ALL NECESSARY UTILITY ADJUSTMENTS.
- IT WILL BE THE CONTRACTOR'S RESPONSIBILITY TO PROTECT AND MAINTAIN IN SERVICE ALL EXISTING UTILITIES.
- THE CONTRACTOR WILL BE REQUIRED TO CONFINE HIS WORK WITHIN THE CONSTRUCTION LIMITS AND/OR PUBLIC RIGHT-OF-WAY TO PRESERVE EXISTING VEGETATION AND PRIVATE PROPERTY. OVERNIGHT PARKING OF CONSTRUCTION EQUIPMENT SHALL NOT OBSTRUCT DRIVEWAYS OR DESIGNATED TRAFFIC LANES.
- A DISPOSAL SITE FOR ALL EXCESS EXCAVATION MATERIAL, ASPHALTIC PAVING, CONCRETE CURBS AND SIDEWALKS, ETC., SHALL BE OBTAINED BY THE CONTRACTOR IN COMPLIANCE WITH APPLICABLE ENVIRONMENTAL REGULATIONS AND APPROVED BY THE FIELD ENGINEER. ALL COSTS INCURRED IN OBTAINING A DISPOSAL SITE AND HAUL THERE TO SHALL BE CONSIDERED INCIDENTAL TO THE PROJECT AND NO SEPARATE MEASUREMENT OR PAYMENT SHALL BE MADE.
- WHERE REMOVAL OF EXISTING CURBS AND GUTTERS, SIDEWALK OR PAVEMENT IS REQUIRED, CONTRACTOR SHALL SAWCUT AND/OR REMOVE TO THE NEAREST JOINT. CURB AND GUTTER SHOWN ON THESE PLANS AS EXISTING AND NOT TO BE REMOVED UNDER THIS CONTRACT, WHICH IS DAMAGED OR DISPLACED BY THE CONTRACTOR SHALL BE REMOVED AND REPLACED AT THE CONTRACTOR'S EXPENSE.
- WHEN ABUTTING NEW PAVEMENT TO EXISTING, SAWCUT EXISTING PAVEMENT TO A STRAIGHT EDGE AND AT A RIGHT ANGLE, OR AS APPROVED BY THE PROJECT ENGINEER, TO REMOVE ANY BROKEN OR CRACKED PAVEMENT.
- ALL STATIONING SHOWN ON THESE PLANS IS BASED ON STREET CENTERLINE OR CENTERLINE OF PIPE UNLESS NOTED OTHERWISE.
- THE CONTRACTOR MUST SUBMIT A CONSTRUCTION SIGNING AND BARRICADING PLAN TO TRAFFIC ENGINEERING PRIOR TO CONSTRUCTION TO RECEIVE A BARRICADING PERMIT.
- BACKFILL COMPACTION SHALL BE ACCORDING TO SPECIFIED STREET USE.
- ALL TRENCH BACKFILL SHALL BE COMPACTED AS PER CITY STANDARDS P-25.
- ANY EXISTING UTILITY SERVICE LINES THAT DO NOT REQUIRE RELOCATION AND ARE DAMAGED BY THE CONTRACTOR SHALL BE REMOVED AND REPLACED AT THE CONTRACTOR'S EXPENSE. THIS EXPENSE SHALL BE CONSIDERED INCIDENTAL TO THE PROJECT AND NO SEPARATE PAYMENT SHALL BE MADE.

DESCRIPTION	INDEX	SHEET NO.
Title Sheet		1
Plats		2-3
Site Plan and Street Layout		4
Utility Layout		5
Grading Plan		6
Santalina Drive, N.W.	Paving Plan and Profile	7-8
La Orilla Road	Paving Plan and Profile	9
Mesquite Drive	Paving Plan and Profile	10
Prairie Sage Avenue	Paving Plan and Profile	11
Prairie Sage Avenue	Paving & Utilities Plan & Profile	12
Rabbit Brush Avenue		
and Purple Sage Avenue	Paving Plan and Profile	13
Spanish Broom Court		
and Hillspire Court	Paving Plan and Profile	14
Santalina Drive, N.W.	Utilities Plan and Profile	15-16
La Orilla Road	Utilities Plan and Profile	17
Mesquite Drive	Utilities Plan and Profile	18
Prairie Sage Avenue	Utilities Plan and Profile	19
Rabbit Brush and		
Purple Sage Avenue	Utilities Plan and Profile	20
Spanish Broom Court		
and Hillspire Court	Utilities Plan and Profile	21
Lot Grading Details	Utilities Plan and Profile	22
Paving Details	Utilities Plan and Profile	23
La Orilla Road, N.W.	Storm Sewer Plan and Profile	23A-23B
La Orilla Road, N.W.	North Half Paving through Prairie Ridge I	23C

26 30420187

REV. SHEETS	9, 17, 23C	DATE	1/30/87
REV. SHEETS	23A, 23B	DATE	1/18/86

APPROVAL OF REVISIONS

3042	TEC TIERRA ENGINEERING CONSULTANTS INC. 632 Paseo De Peralta Santa Fe, New Mexico 87501 505/982-2845	APPROVED FOR CONSTRUCTION CITY ENGINEER DATE 10/26/86
	405 Sixth St. S.W. Suite 202 Albuquerque, New Mexico 87103 505/242-2270	SHEET 1 OF 23

LEGAL DESCRIPTION

THAT CERTAIN PARCEL OF LAND SITUATE WITHIN SECTIONS 25, 26 T. 11 N., R. 2 E., N.M.P.M. (BRASS CAP IN PLACE AND HAVING OF TRACT 33A-1, TAYLOR RANCH, AS THE SAME IS SHOWN AND DESIGNATED ON THE PLAT ENTITLED "CORRECTED PLAT OF REPLAT OF TRACTS 24, 32, 6 33, TAYLOR RANCH TO TRACTS 32A, 32B, 6 33A, TAYLOR RANCH" FILED FOR RECORD IN THE OFFICE OF THE COUNTY CLERK OF BERNALILLO COUNTY, NEW MEXICO ON JANUARY 16, 1986 IN VOLUME C29, FOLIO 79, TOGETHER WITH AN UNPLATTED PARCEL OF LAND, AND BEING MORE PARTICULARLY DESCRIBED BY METES AND BOUNDS SURVEY AS FOLLOWS:

BEGINNING AT THE SECTION CORNER COMMON TO SECTIONS 23, 24, 25, 26 T. 11 N., R. 2 E., N.M.P.M. (BRASS CAP IN PLACE AND HAVING NEW MEXICO STATE PLANE COORDINATES, CENTRAL ZONE OF X=367,964.77 FEET AND Y=1,513,731.59 FEET) THENCE; S 82°05'38.8" E, 1113.72 FEET TO A 5/8" REBAR BEING THE NORTHWEST CORNER AND THE TRUE PLACE OF BEGINNING OF PARCEL HEREIN DESCRIBED;

THENCE 334.26 FEET ALONG THE ARC OF A CURVE TO THE RIGHT HAVING A RADIUS OF 541.00 FEET, A CENTRAL ANGLE OF 35°24'01", AND A CHORD BEARING N 72°27'52.5" E, A DISTANCE OF 328.97 FEET TO A POINT OF TANGENCY;
THENCE S 89°50'07" E, 492.61 FEET TO A POINT OF CURVATURE;
THENCE 47.12 FEET ALONG THE ARC OF A CURVE TO THE RIGHT HAVING A RADIUS OF 30.00 FEET, A CENTRAL ANGLE OF 90°00'00", AND A CHORD BEARING S 44°50'07" E, A DISTANCE OF 42.43 FEET TO A POINT OF TANGENCY ON THE WESTERLY RIGHT-OF-WAY LINE OF SANTALINA DRIVE, N.M.;
THENCE S 00°09'53" W 120.00 FEET TO A POINT OF CURVATURE;
THENCE 440.17 FEET ALONG THE ARC OF A CURVE TO THE RIGHT HAVING A RADIUS OF 970.00 FEET, A CENTRAL ANGLE OF 26°00'00", AND A CHORD BEARING S 13°09'53" E, A DISTANCE OF 436.41 FEET TO A POINT OF TANGENCY;
THENCE S 26°09'53" W, 558.13 FEET TO A POINT OF CURVATURE;
THENCE 247.34 FEET ALONG THE ARC OF A CURVE TO THE LEFT HAVING A RADIUS OF 830.00 FEET, A CENTRAL ANGLE OF 17°04'26.9", AND A CHORD BEARING S 17°37'39.6" W, A DISTANCE OF 246.43 FEET TO A POINT OF TANGENCY AND BEING THE SOUTHEAST CORNER OF THE PARCEL HEREIN DESCRIBED;
THENCE N 80°54'33" W, 904.66 FEET TO A POINT AND BEING THE SOUTHWEST CORNER OF THE PARCEL HEREIN DESCRIBED;
THENCE N 10°43'58" E, 246.00 FEET TO A POINT;
THENCE N 38°00'00" E, 700.00 FEET TO A POINT;
THENCE N 00°09'53" E, 276.87 FEET TO THE 5/8" REBAR AND POINT OF BEGINNING AND CONTAINING 25.3303 ACRES MORE OR LESS.

SURVEYOR'S CERTIFICATE

I, THOMAS A. ORTIZ, A DULY QUALIFIED LAND SURVEYOR, REGISTERED UNDER THE LAWS OF THE STATE OF NEW MEXICO, HEREBY CERTIFY THAT THIS PLAT WAS PREPARED BY ME OR UNDER MY SUPERVISION, SHOWS ACCURATE DIMENSIONS, LAND AREAS, SHOWS ALL EASEMENTS SHOWN ON RECORDED PLAT OR MADE KNOWN TO ME BY THE OWNER, UTILITY COMPANIES, OR OTHER PARTIES EXPRESSING AN INTEREST, AND THAT THIS BOUNDARY SURVEY WAS PREPARED BY L.A. CARLETON JR. N.M.R.L.S. No. 7270 ON JANUARY 17, 1986 AND IS TRUE AND CORRECT TO THE BEST OF MY KNOWLEDGE AND BELIEF.

THOMAS A. ORTIZ
N.M.P.E.G.L.S. No. 4331

STATE OF NEW MEXICO)
COUNTY OF BERNALILLO) SS

THE FOREGOING INSTRUMENT WAS ACKNOWLEDGED BEFORE ME A NOTARY PUBLIC IN AND FOR SAID COUNTY AND STATE BY THE PERSON(S) NOTED IN THE AFFIDAVIT APPEARING HEREON ON THE 29th DAY OF OCTOBER, 1986.

MY COMMISSION EXPIRES: 10-13-87

NOTARY PUBLIC

DEDICATION AND CONSENT STATEMENT

THE SUBDIVISION HEREON DESCRIBED IS WITH THE FREE CONSENT AND IN ACCORDANCE WITH THE DESIRES OF THE UNDERSIGNED OWNERS AND/OR PROPRIETORS THEREOF AND SAID OWNERS AND/OR PROPRIETORS DO HEREBY DEDICATE ALL STREETS AND PUBLIC RIGHTS OF WAY SHOWN HEREON TO THE CITY OF ALBUQUERQUE IN FEE SIMPLE AND DO HEREBY GRANT ALL UTILITY EASEMENTS SHOWN HEREON TO THE PUBLIC USE FOREVER INCLUDING THE RIGHTS OF INGRESS AND EGRESS. THE UNDERSIGNED OWNERS AND/OR PROPRIETORS ALSO GRANT TO THE CITY OF ALBUQUERQUE IN PERPETUITY ALL SANITARY, WATERLINE, AND DRAINAGE EASEMENTS SHOWN HEREON INCLUDING THE RIGHT TO CONSTRUCT, OPERATE, INSPECT, AND MAINTAIN SANITARY SEWERS, WATERLINES, AND DRAINAGE UNLESS SPECIFICALLY LIMITED ELSEWHERE ON THIS PLAT, ALL EASEMENTS GRANTED TO THE CITY OF ALBUQUERQUE MAY BE USED FOR ANY OR ALL OF THE PURPOSES OF SANITARY SEWER, WATERLINE, OR DRAINAGE FACILITY EVEN THOUGH ONLY ONE OF THESE PURPOSES IS STATED ON THE EASEMENTS AS DRAWN ON THE PLAT.

BY: BELLAMAH COMMUNITY DEVELOPMENT
A NEW MEXICO GENERAL PARTNERSHIP

D.T. ROBERTSON
SENIOR VICE PRESIDENT AND REGIONAL MANAGER

ACKNOWLEDGEMENT:

STATE OF NEW MEXICO)
COUNTY OF BERNALILLO) SS

THE FOREGOING INSTRUMENT WAS ACKNOWLEDGED BEFORE ME THIS DAY OF OCTOBER, 1986 BY D.T. ROBERTSON, SENIOR VICE-PRESIDENT AND REGIONAL MANAGER OF BELLAMAH COMMUNITY DEVELOPMENT, A NEW MEXICO GENERAL PARTNERSHIP, ON BEHALF OF SAID PARTNERSHIP.

MY COMMISSION EXPIRES: 10-13-87

NOTARY PUBLIC

86128546

CORRECTED PLAT
A REPLAT OF TRACT 33A-1
TAYLOR RANCH TO
PRAIRIE RIDGE II, TAYLOR RANCH
Situates Within Section 25
T.11 N., R.2 E., N.M.P.M.
City of Albuquerque, Bernalillo County,
New Mexico
August, 1986

APPROVALS

5-86-27
SUBDIVISION PLAT NO.

E-12-Z
ZONE ATLAS MAP NO.

PLANNING DIRECTOR, CITY

CITY ENGINEER

A.M.A.F.C.A.

PARKS AND RECREATION

TRAFFIC ENGINEER

WATER RESOURCES

PROPERTY MANAGEMENT

CITY SURVEYOR

PUBLIC SERVICE CO. OF N.M.

THE MOUNTAIN STATES TELEPHONE
AND TELEGRAPH COMPANY

GAS COMPANY OF NEW MEXICO

86-317/86-608

ORB CASE NO.

10-26-86

DATE

10-24-86

DATE

10-24-86

DATE

10-7-86

DATE

10-7-86

DATE

10-7-86

DATE

10-3-86

DATE

10-3-86

DATE

9-29-86

DATE

9-29-86

DATE

9-29-86


DATE


SHEET 1 OF 3



TIERRA
ENGINEERING
CONSULTANTS
INC.
632 Paseo De Perilla
Santa Fe, New Mexico 87501
505/962-2845

105 Sixth St. S.W.
Suite 202
Albuquerque, New Mexico 87103
505/242-2270

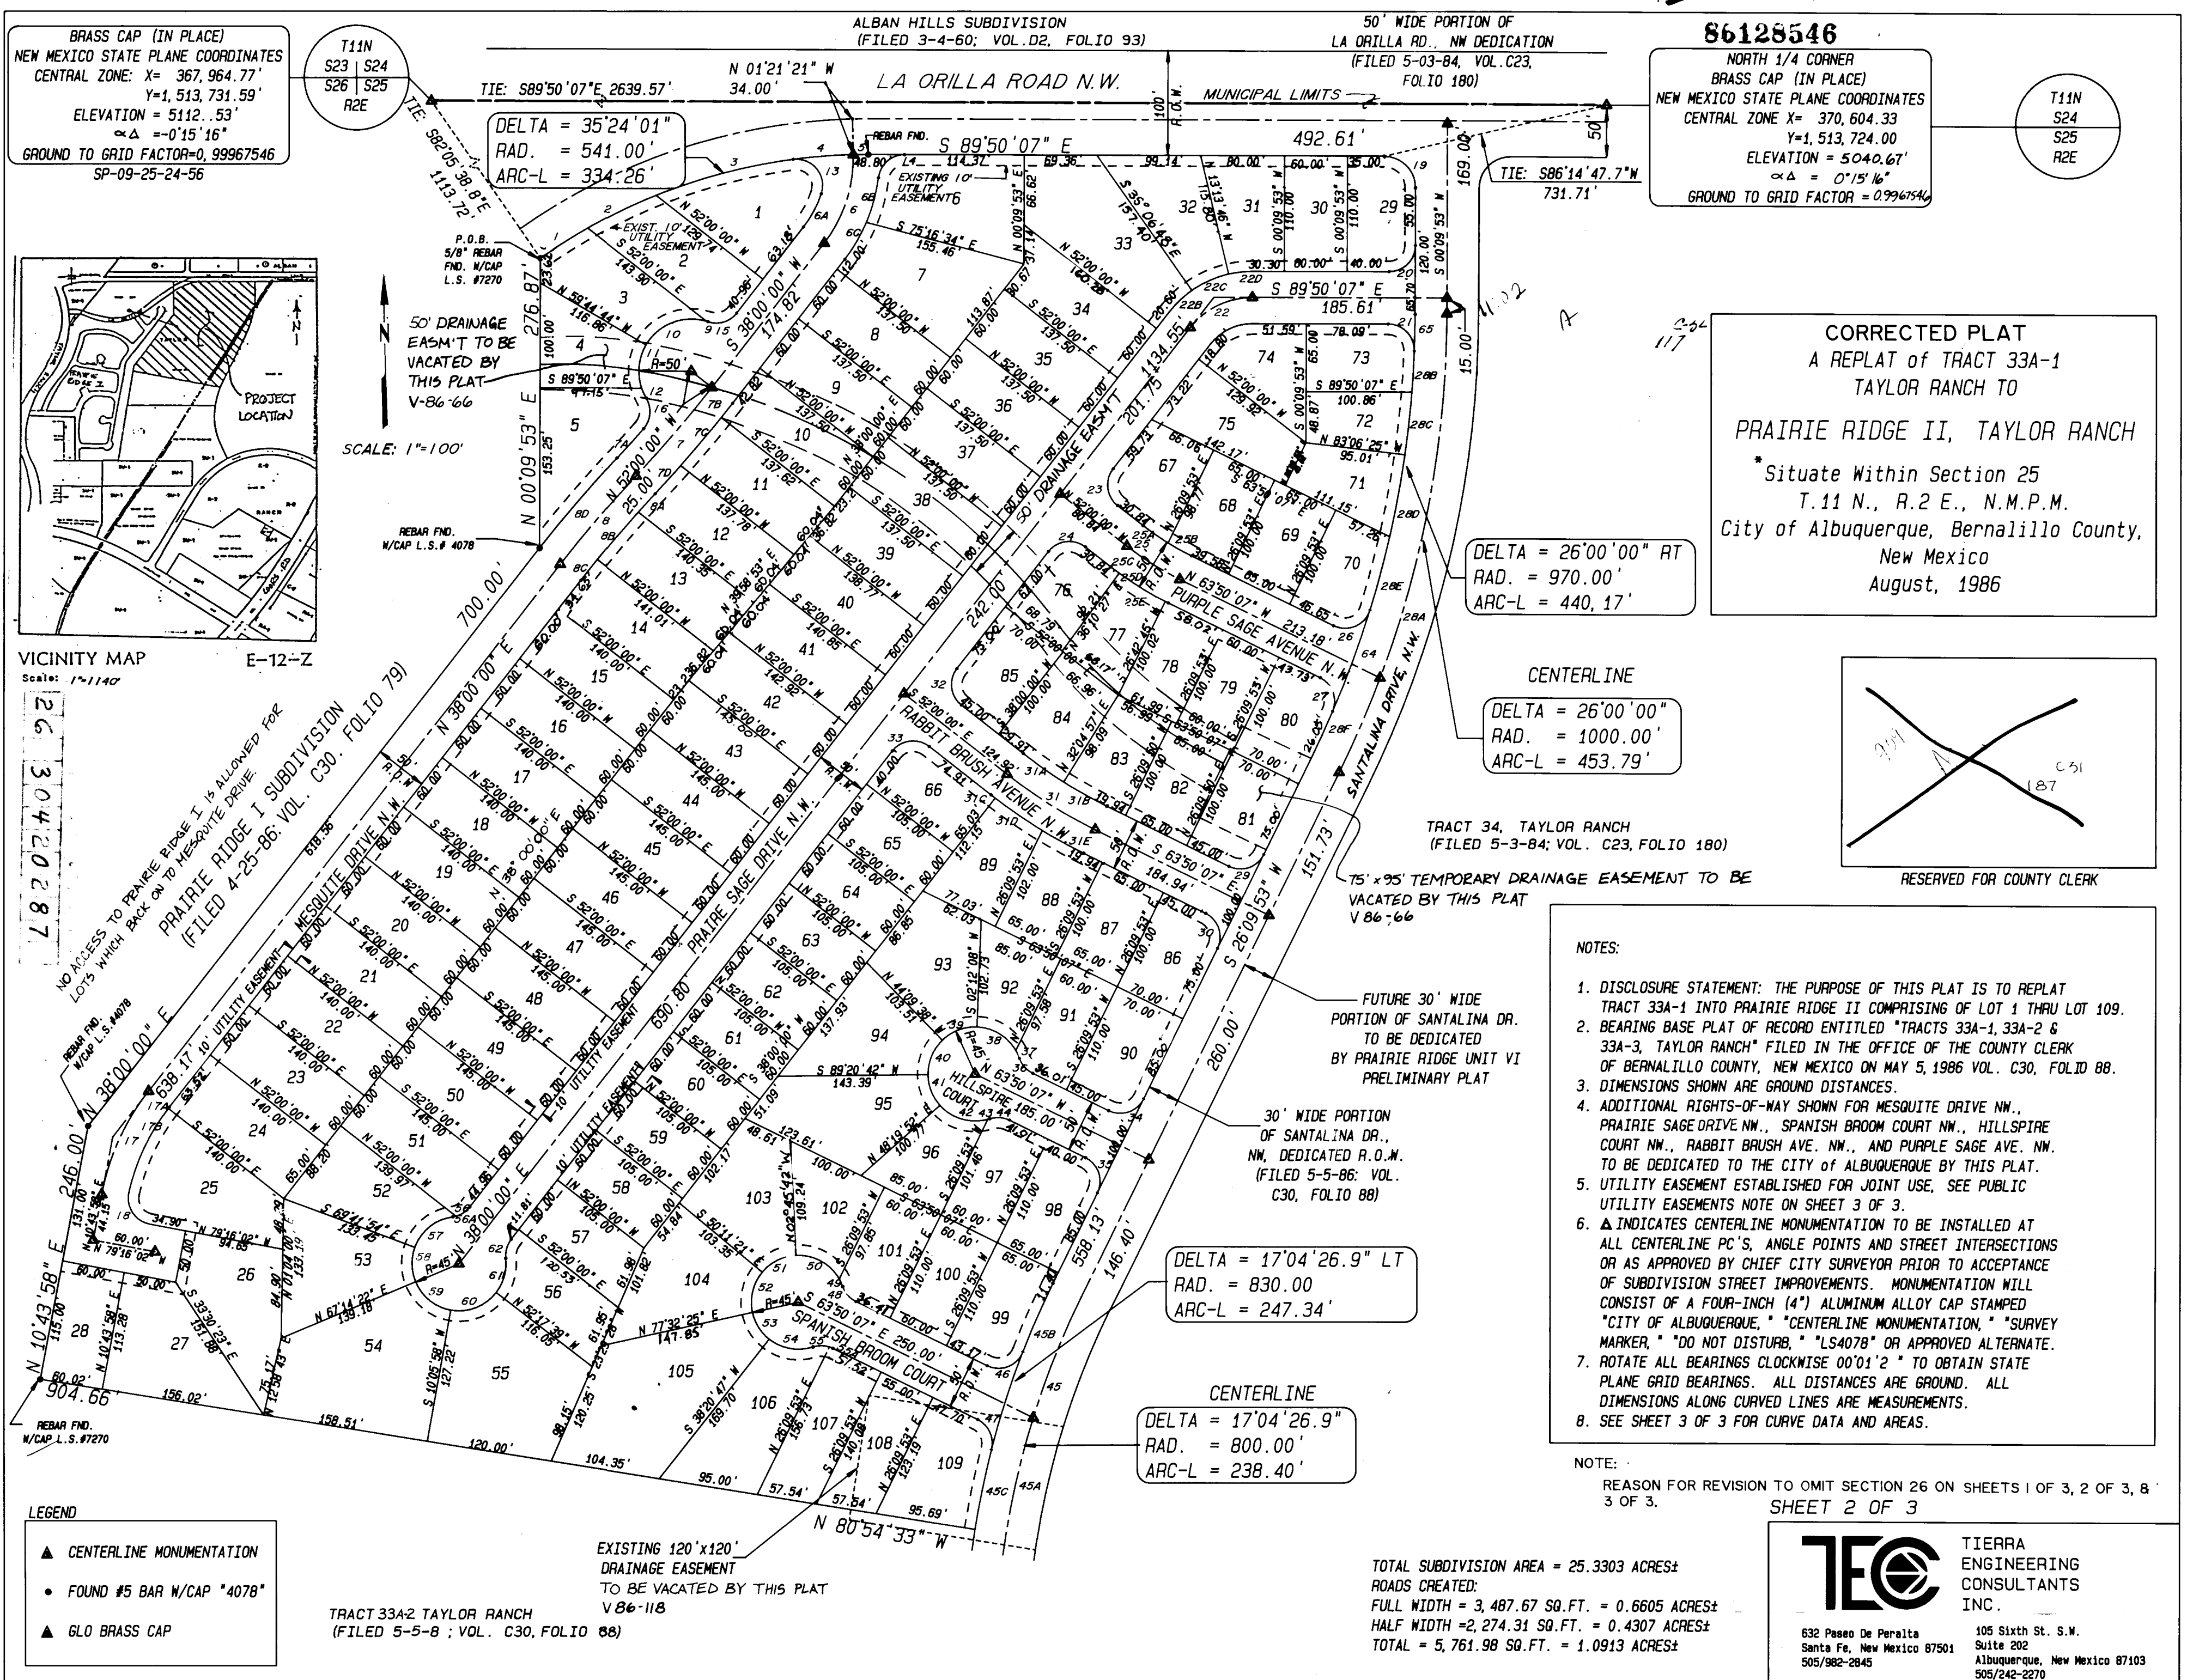

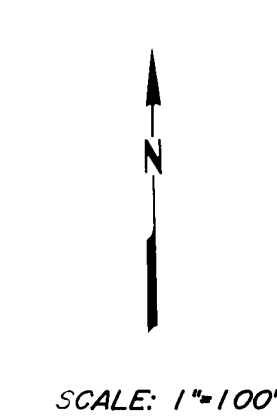


NOTES

1. REFERENCE CAN BE MADE TO SHEET 23 OF 23 FOR PAVEMENT DETAILS AND PAVING SECTIONS
2. SIDEWALK TO BE BUILT ONLY ON SOUTH SIDE OF LA ORILLA ROAD. ALL OTHER SIDEWALKS TO BE BUILT IN FUTURE AND HAVE BEEN DEFERRED BY SIDEWALK VARIANCE S-86-27
3. REFERENCE CAN BE MADE TO SHEETS 6 THROUGH 14 FOR SPECIFICATION OF TYPE OF CURB AND GUTTER, I.E., STANDARD, MOUNTABLE AND ASPHALT CURBING. DETAILS OF THESE CURBS ARE ON SHEET 23
4. THE STORM DRAIN SYSTEM ALONG LA ORILLA ROAD IS UNDER PRAIRIE RIDGE UNIT VI WORKORDER. REFERENCE TO THIS PROJECTS DESIGN PLAN CAN BE MADE FOR STORM DRAIN SIZING, CATCH BASINS, AND RELATED INFORMATION
5. ALL STREETS TO BE BUILT FULL WIDTH WITH THE EXCEPTION OF LA ORILLA ROAD WHICH WILL BE 34' WIDTH FROM FACE TO ASPHALT CURB
6. PLEASE NOTE TEMPORARY PAVEMENT IS SHADED (EAST OF LA ORILLA ROAD/SANTALINA DRIVE INTERSECTION)


[illegible]


APPROVALS	ENGINEER	DATE	APPROVALS	ENGINEER	DATE
City Engineer	<i>[Signature]</i>	10/21/86	Liquid Waste	<i>[Signature]</i>	10/21/86
A.C.E. Design	<i>[Signature]</i>	10/21/86	Traffic	<i>[Signature]</i>	10/21/86
A.C. E.-Hydrology	<i>[Signature]</i>	"	Water	<i>[Signature]</i>	10/21/86

DRAWING NO.	3042	MAP NO.	SHEET 4 OF 23
-------------	-------------	---------	-----------------------------

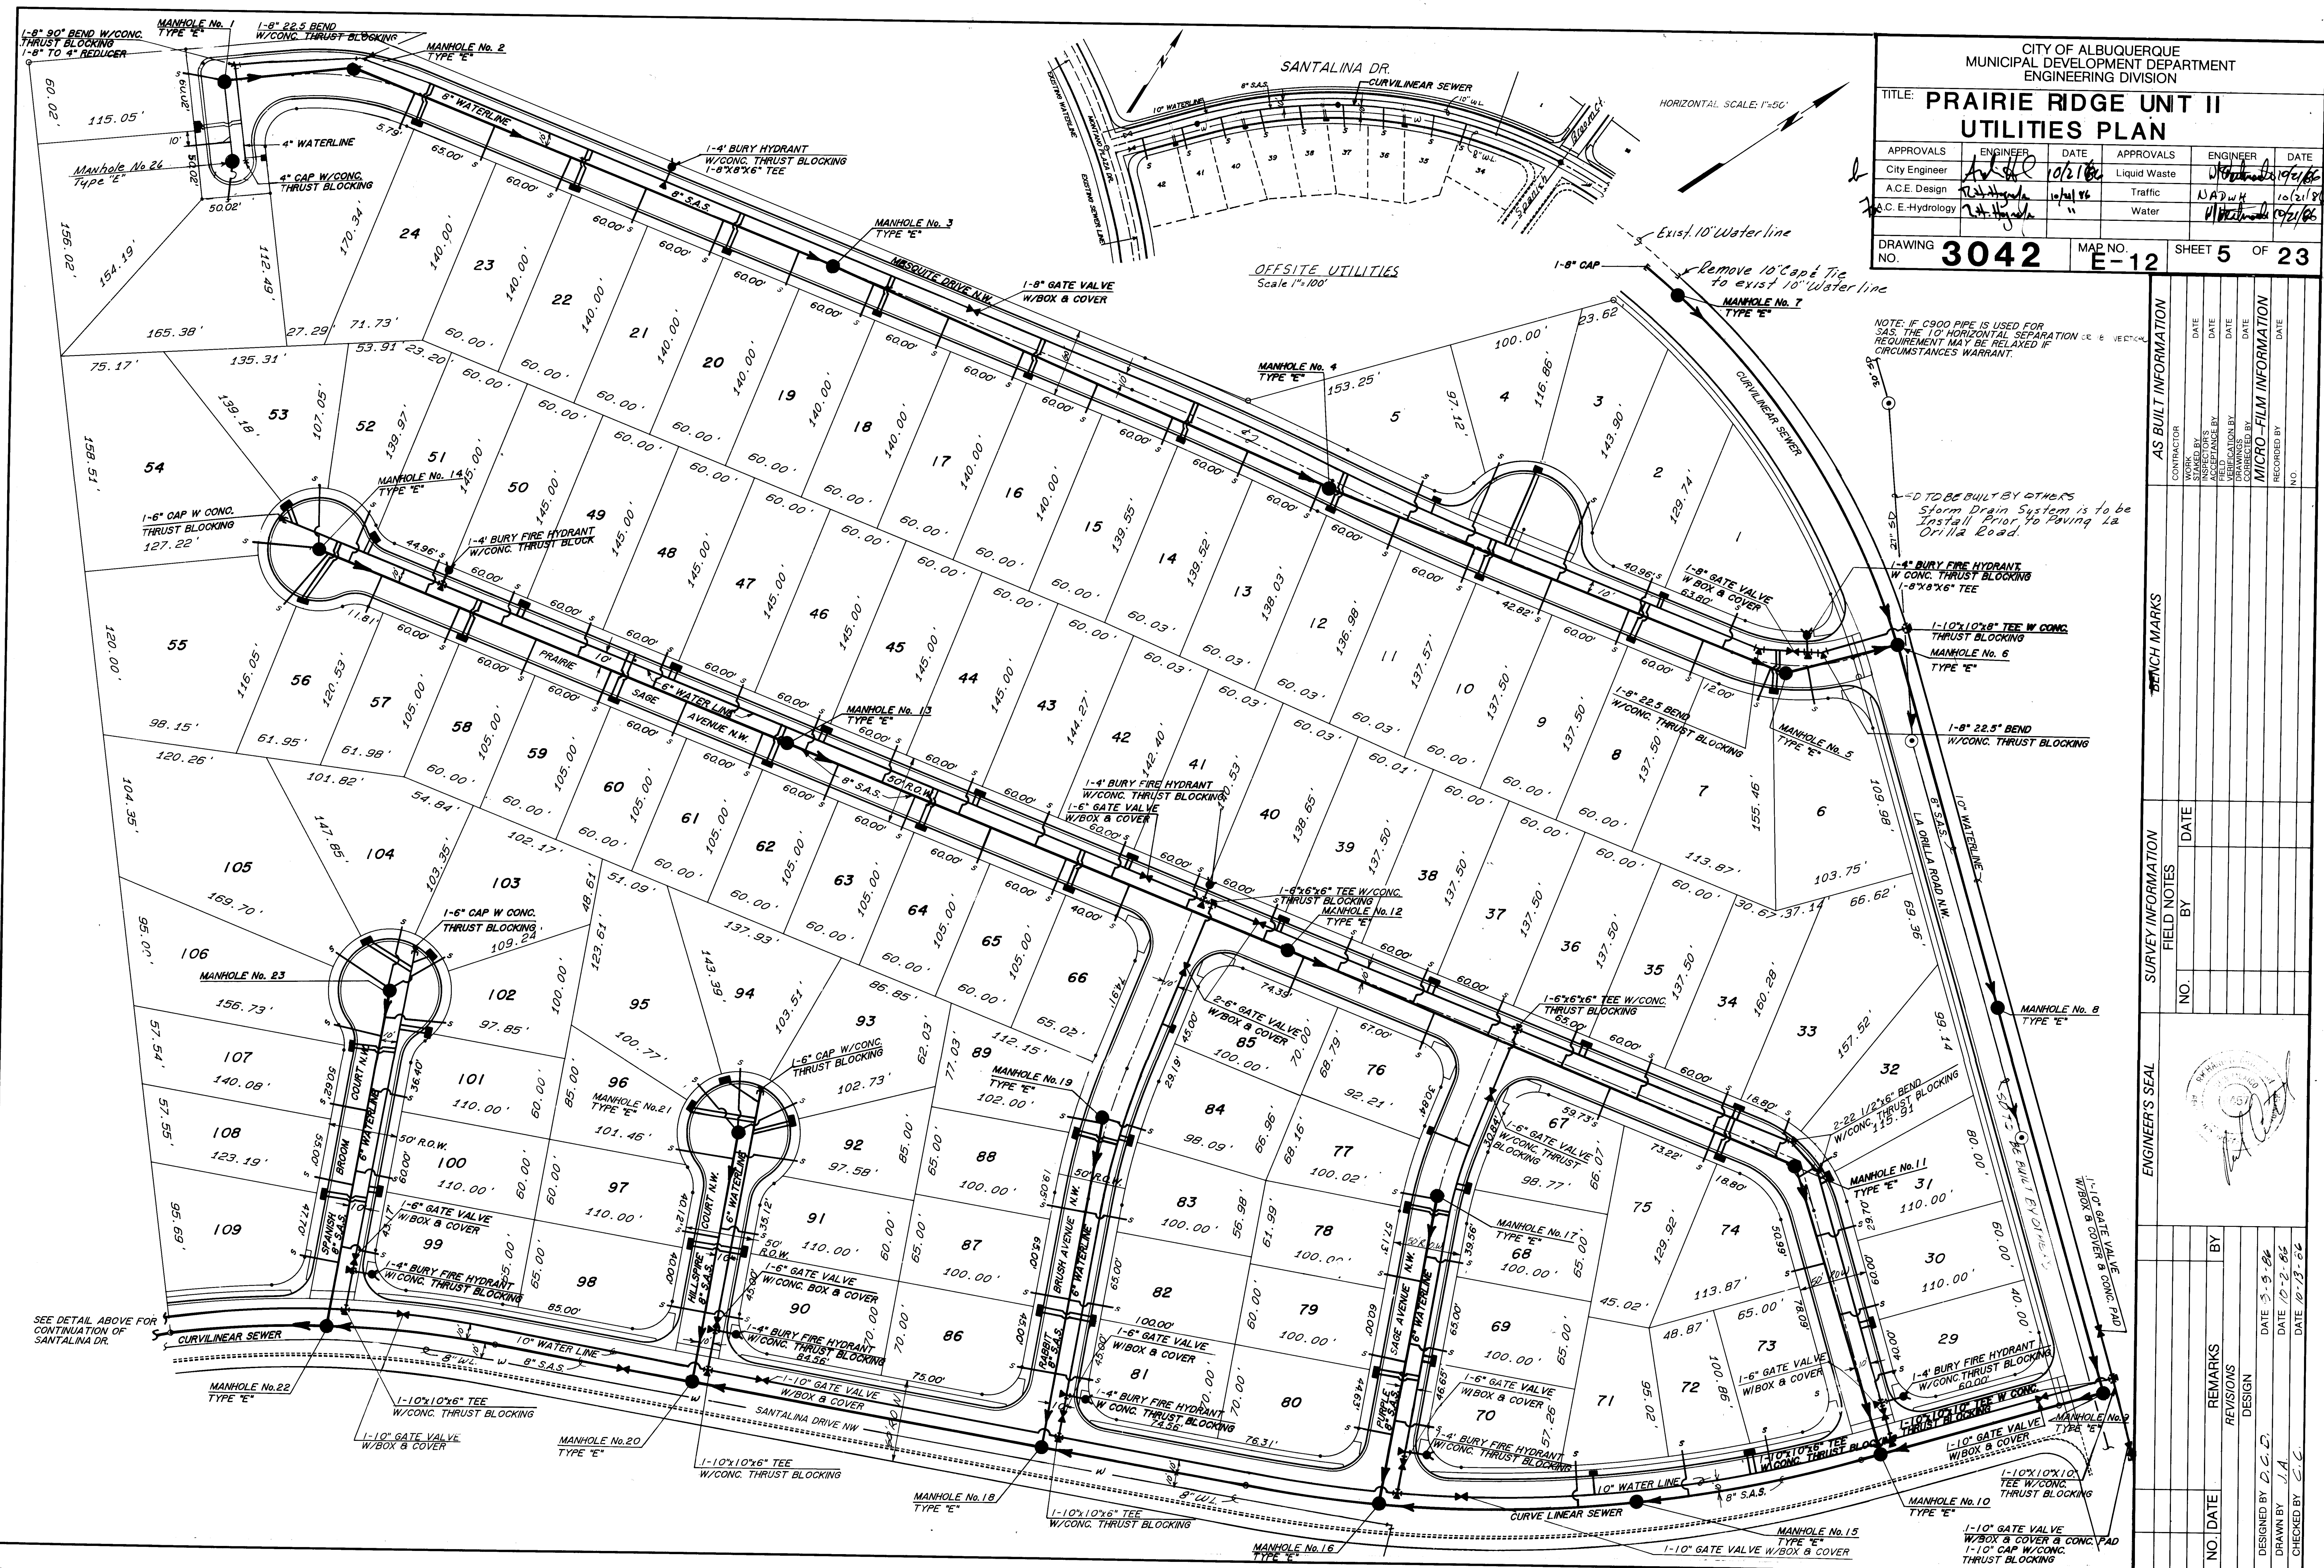

26	30	42	05	87
----	----	----	----	----

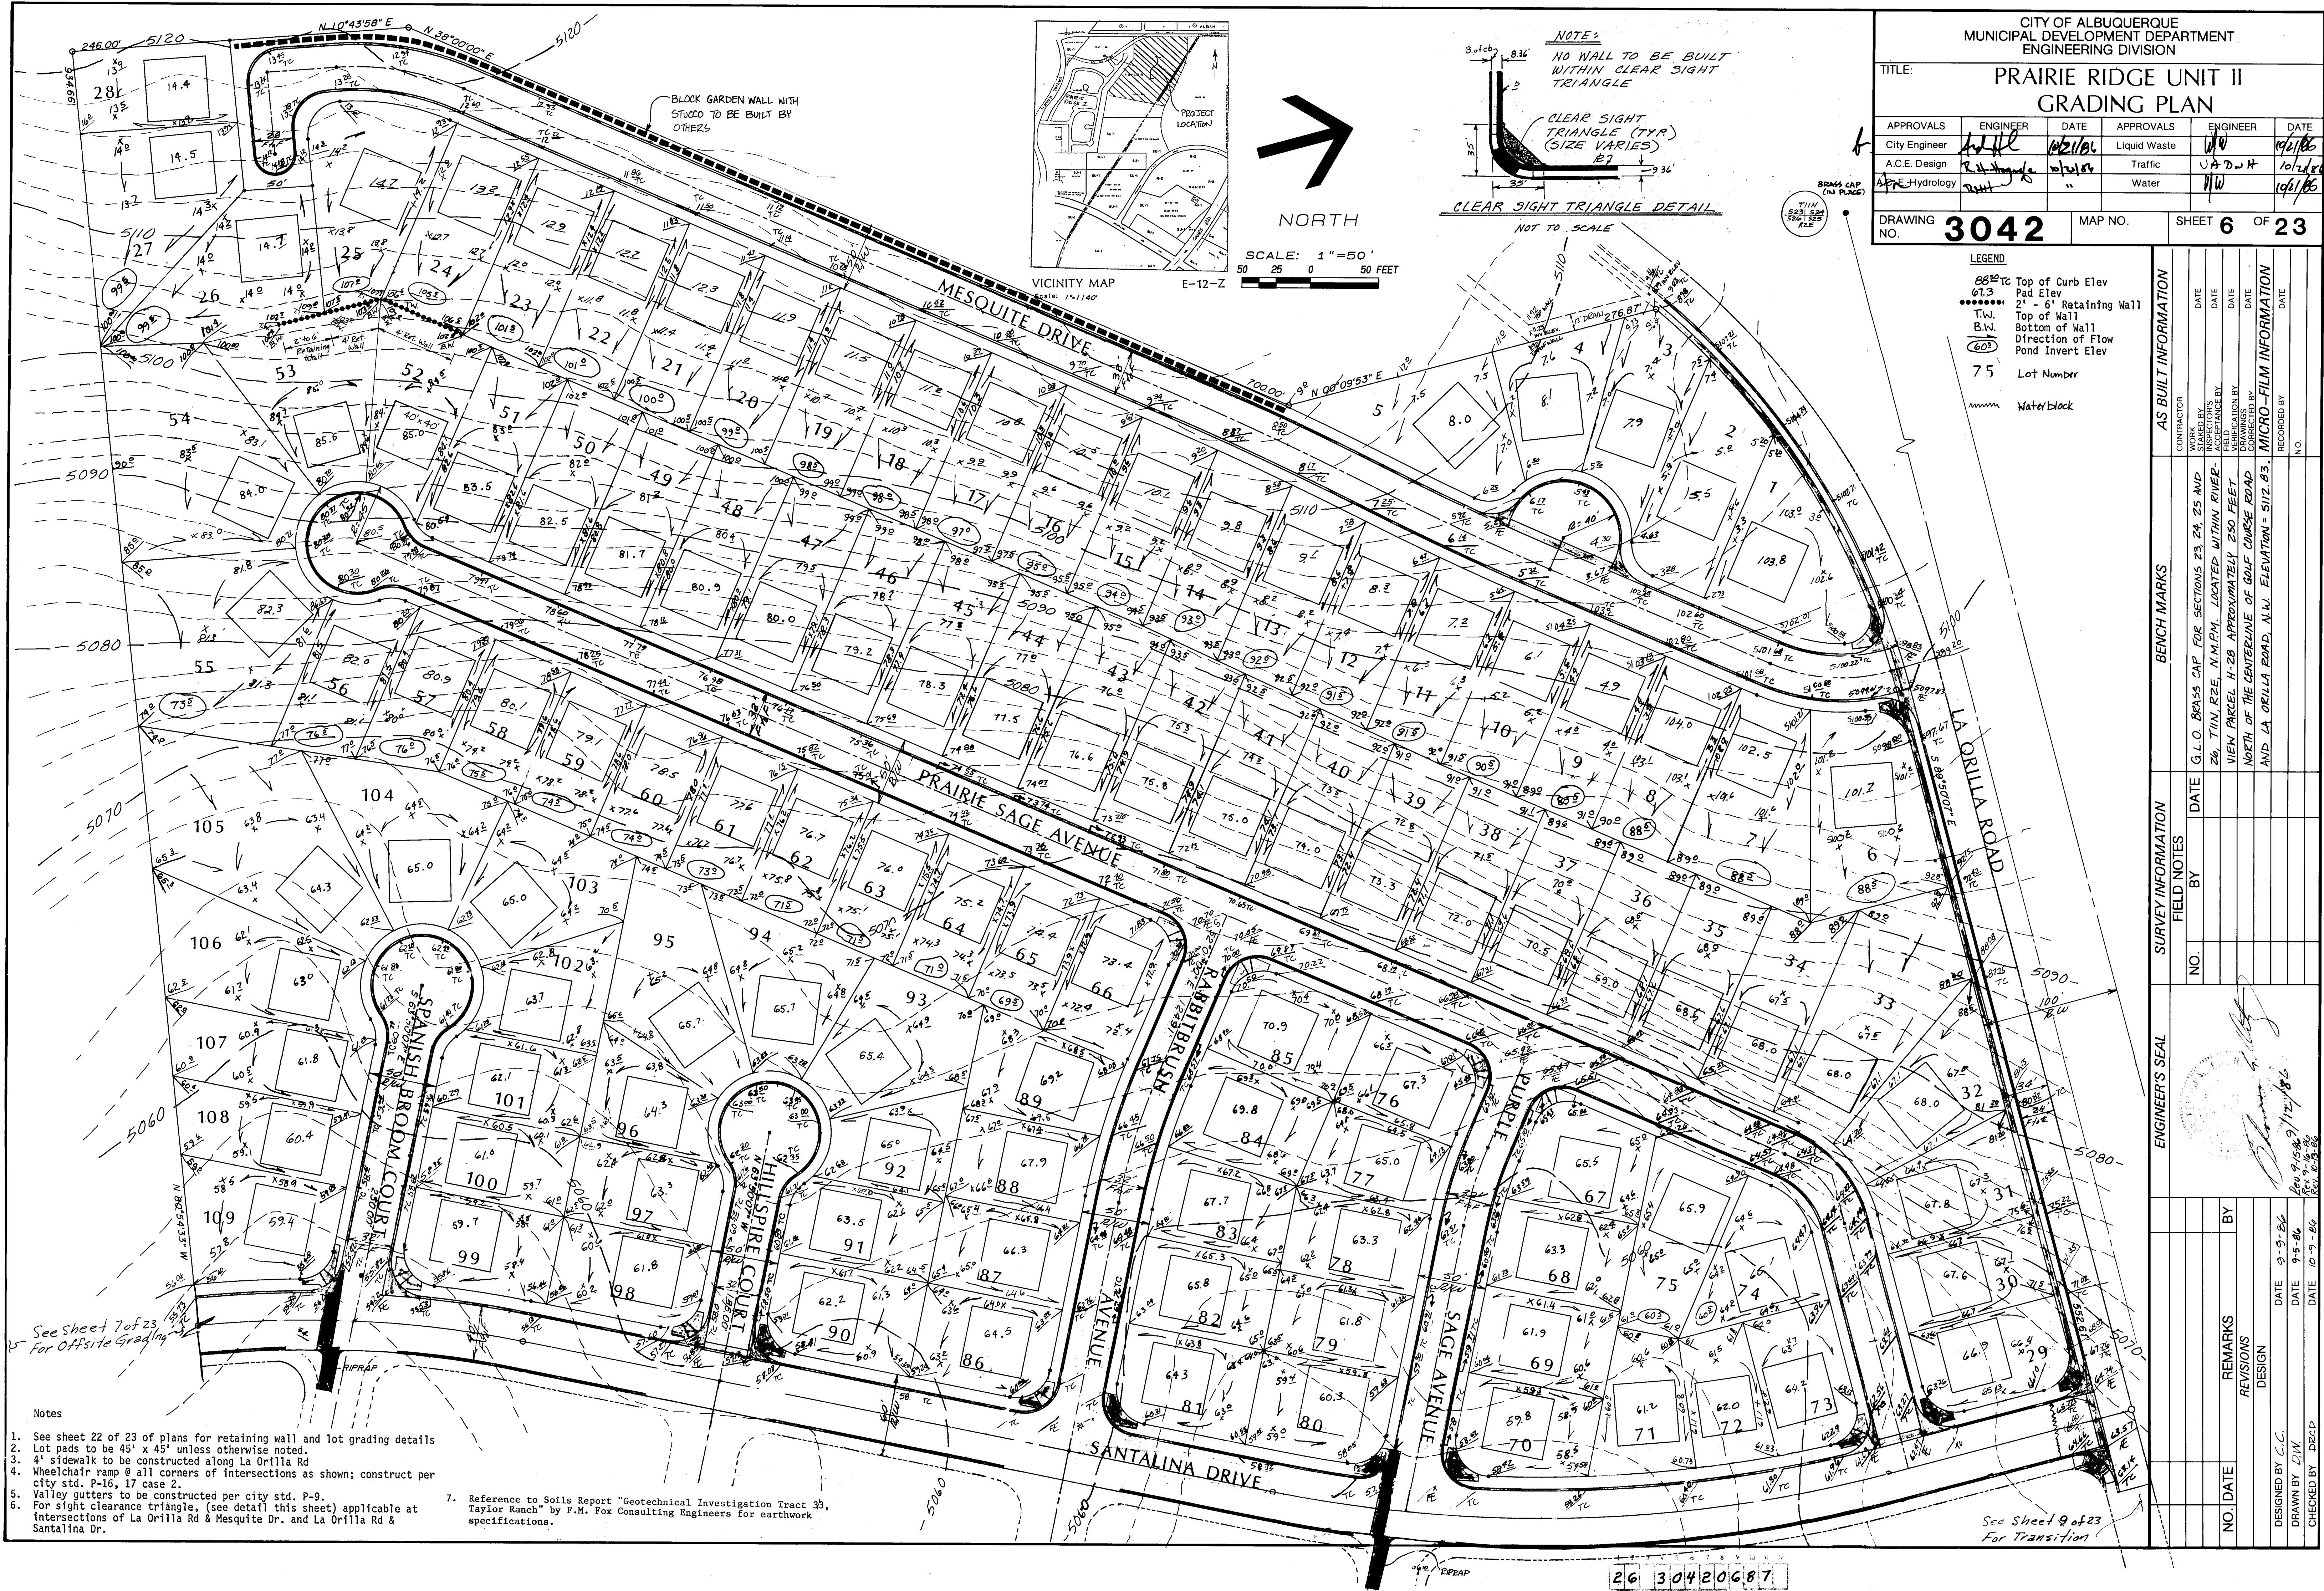

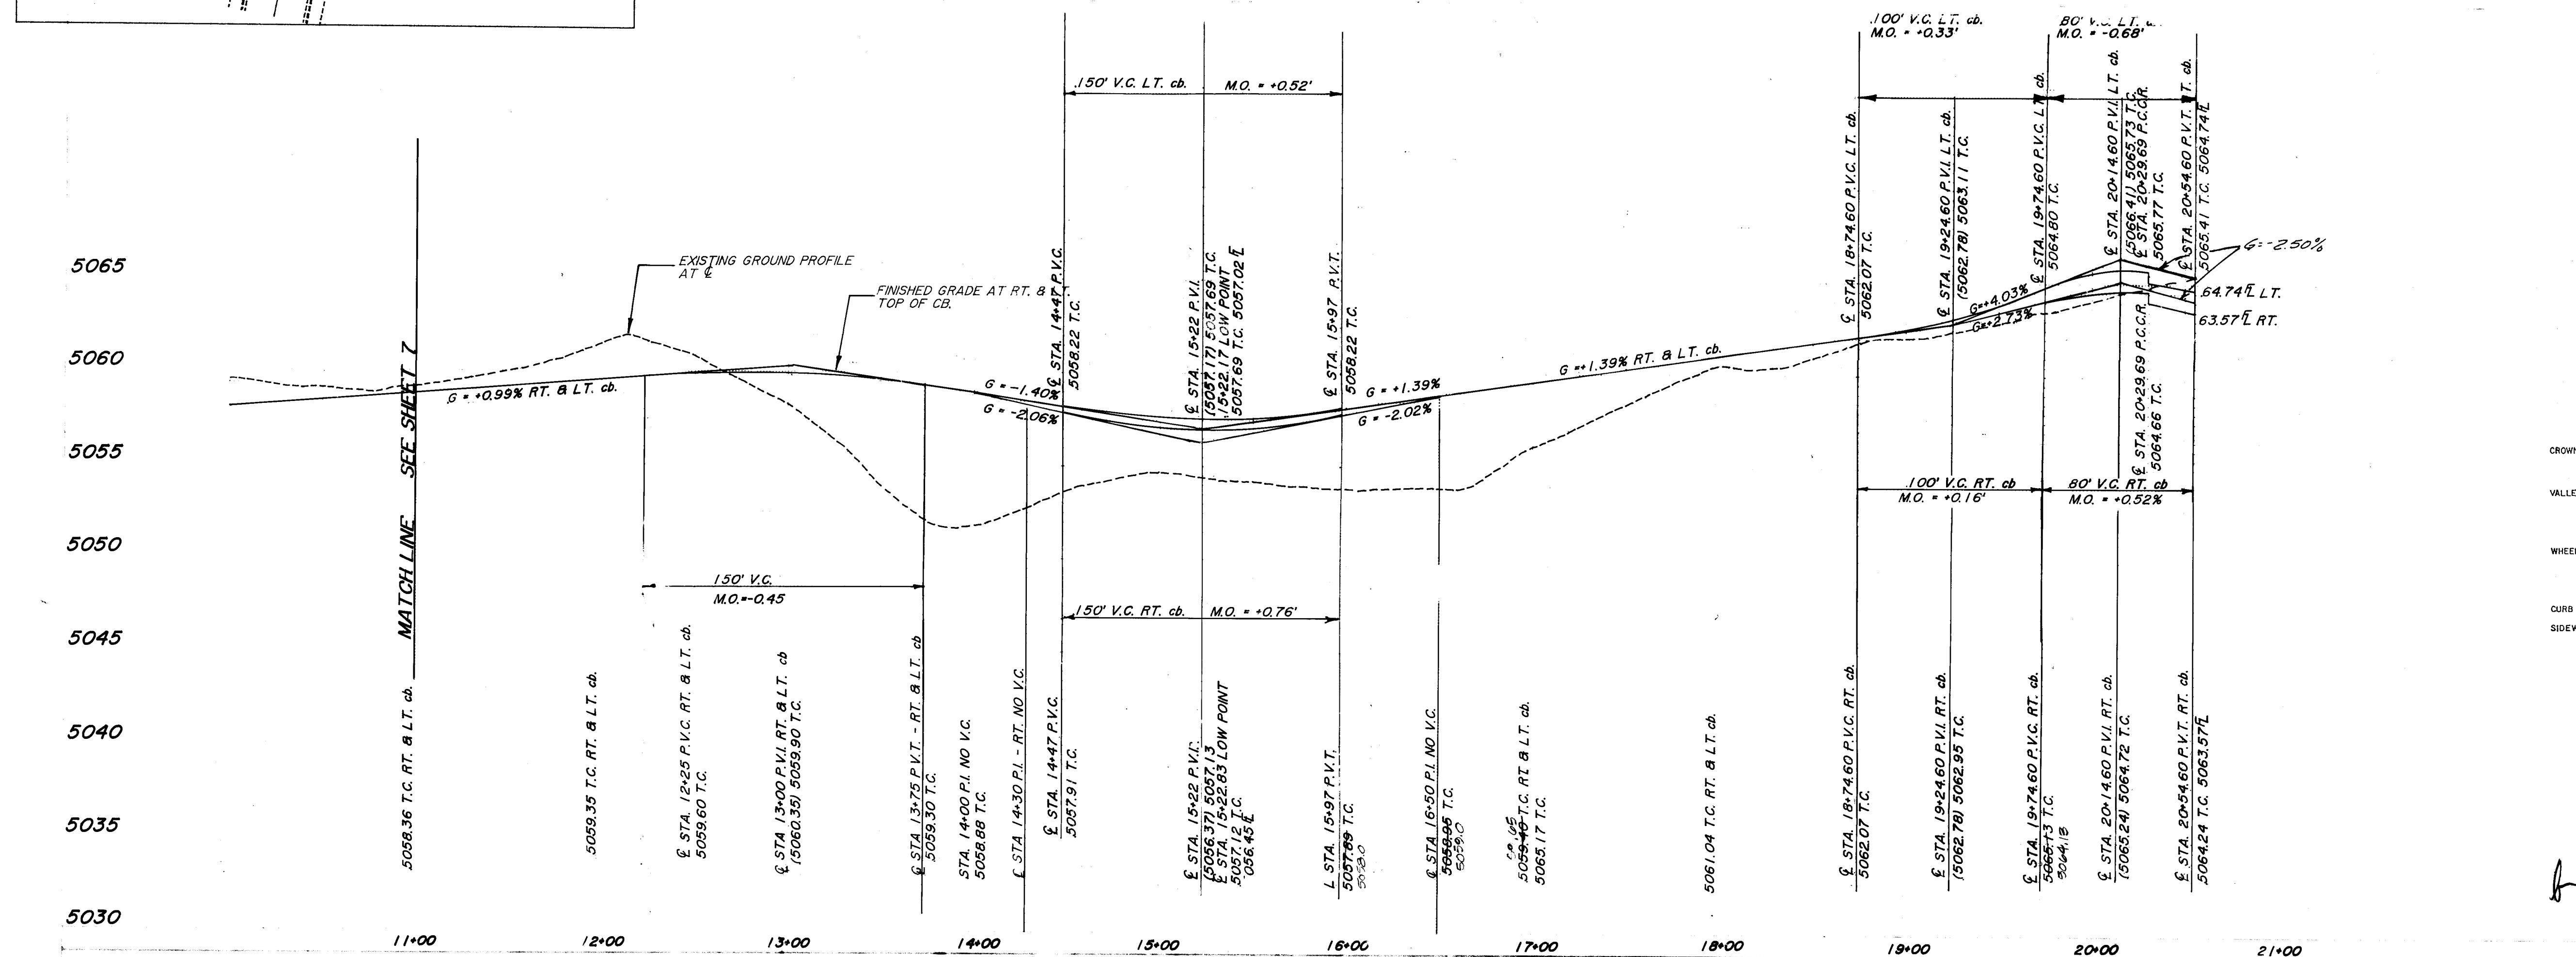

William F.

517181
• 5945

ENGINEER'S SEAL


NAME	DATE
<i>Dr. Hummer</i>	<i>10/21/86</i>
	<i>10/21/86</i>
	<i>10/21/86</i>

26	30420887
----	----------

CITY OF ALBUQUERQUE
MUNICIPAL DEVELOPMENT DEPARTMENT
ENGINEERING DIVISION
TITLE
**PRAIRIE RIDGE UNIT II PAVING
SANTALINA DRIVE**


ENGINEER	DATE	ENGINEER	DATE
City Engineer	10/21/86	City Engineer	10/21/86
C. E. Design	10/21/86	C. E. Design	10/21/86
APR Hydrology	"	APR Hydrology	"

DRAWING NO	3042	MAP NO.	E-12-Z	SHEET	8	OF	23
------------	-------------	---------	--------	-------	----------	----	-----------

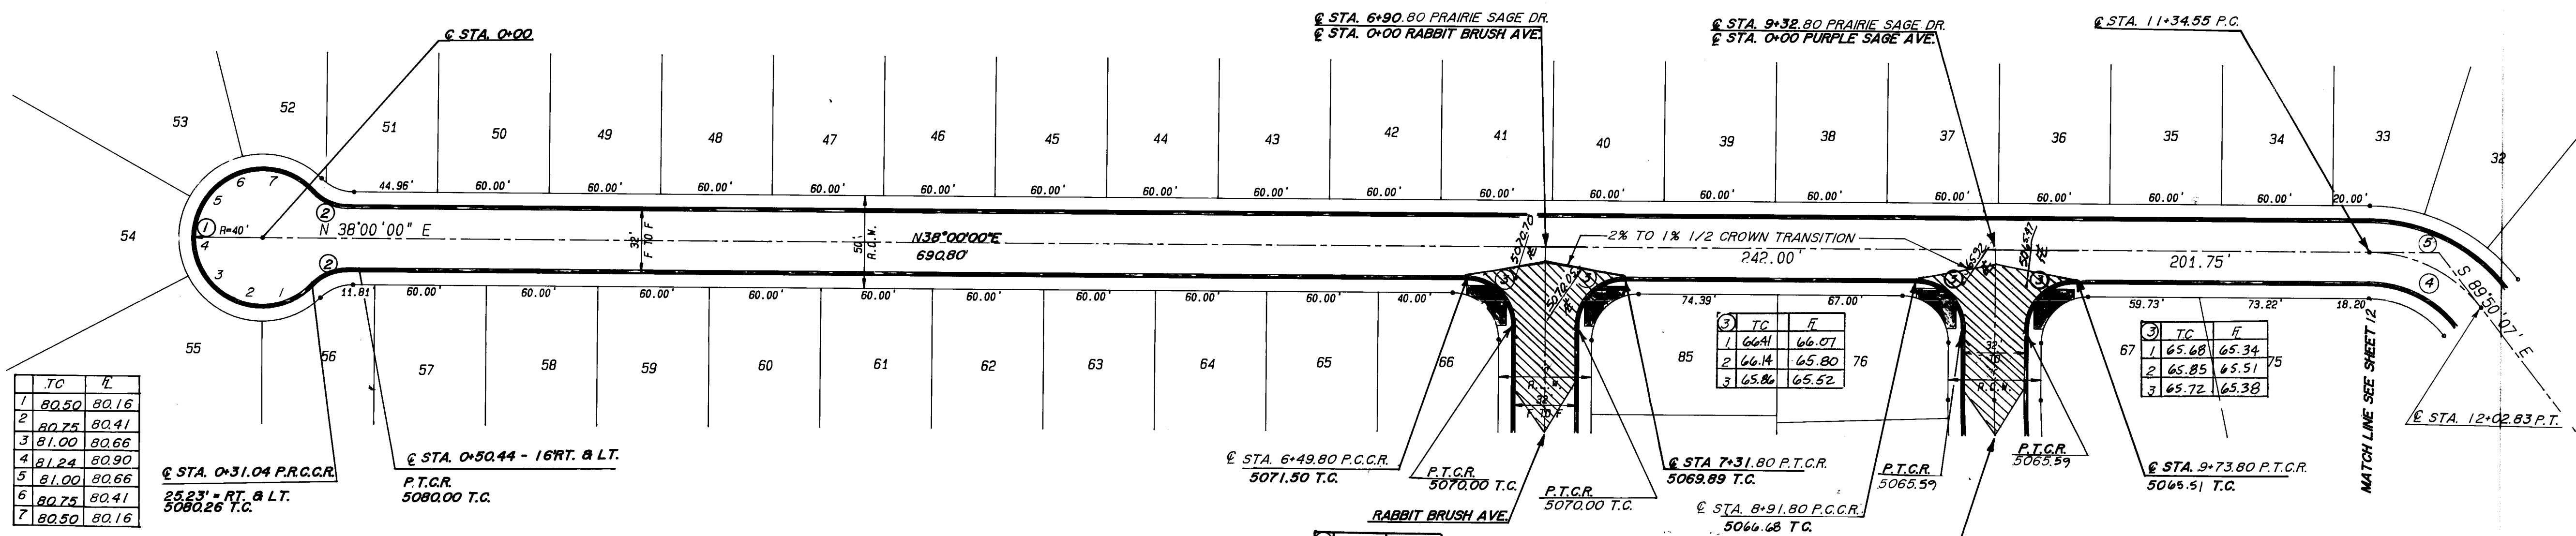


CURVE NO.	1	2	3	4	5
DELTA	258°12'50"	39°06'25"	90°00'00"	52°09'53"	52°09'53"
RADIUS	40.00'	25.00'	25.00'	59.00'	91.00'
LENGTH	180.27'	17.06'	39.27'	53.71'	82.85'
TANGENT	0-	8.88'	25.00'	28.88'	44.54'

PRAIRIE SAGE AVENUE

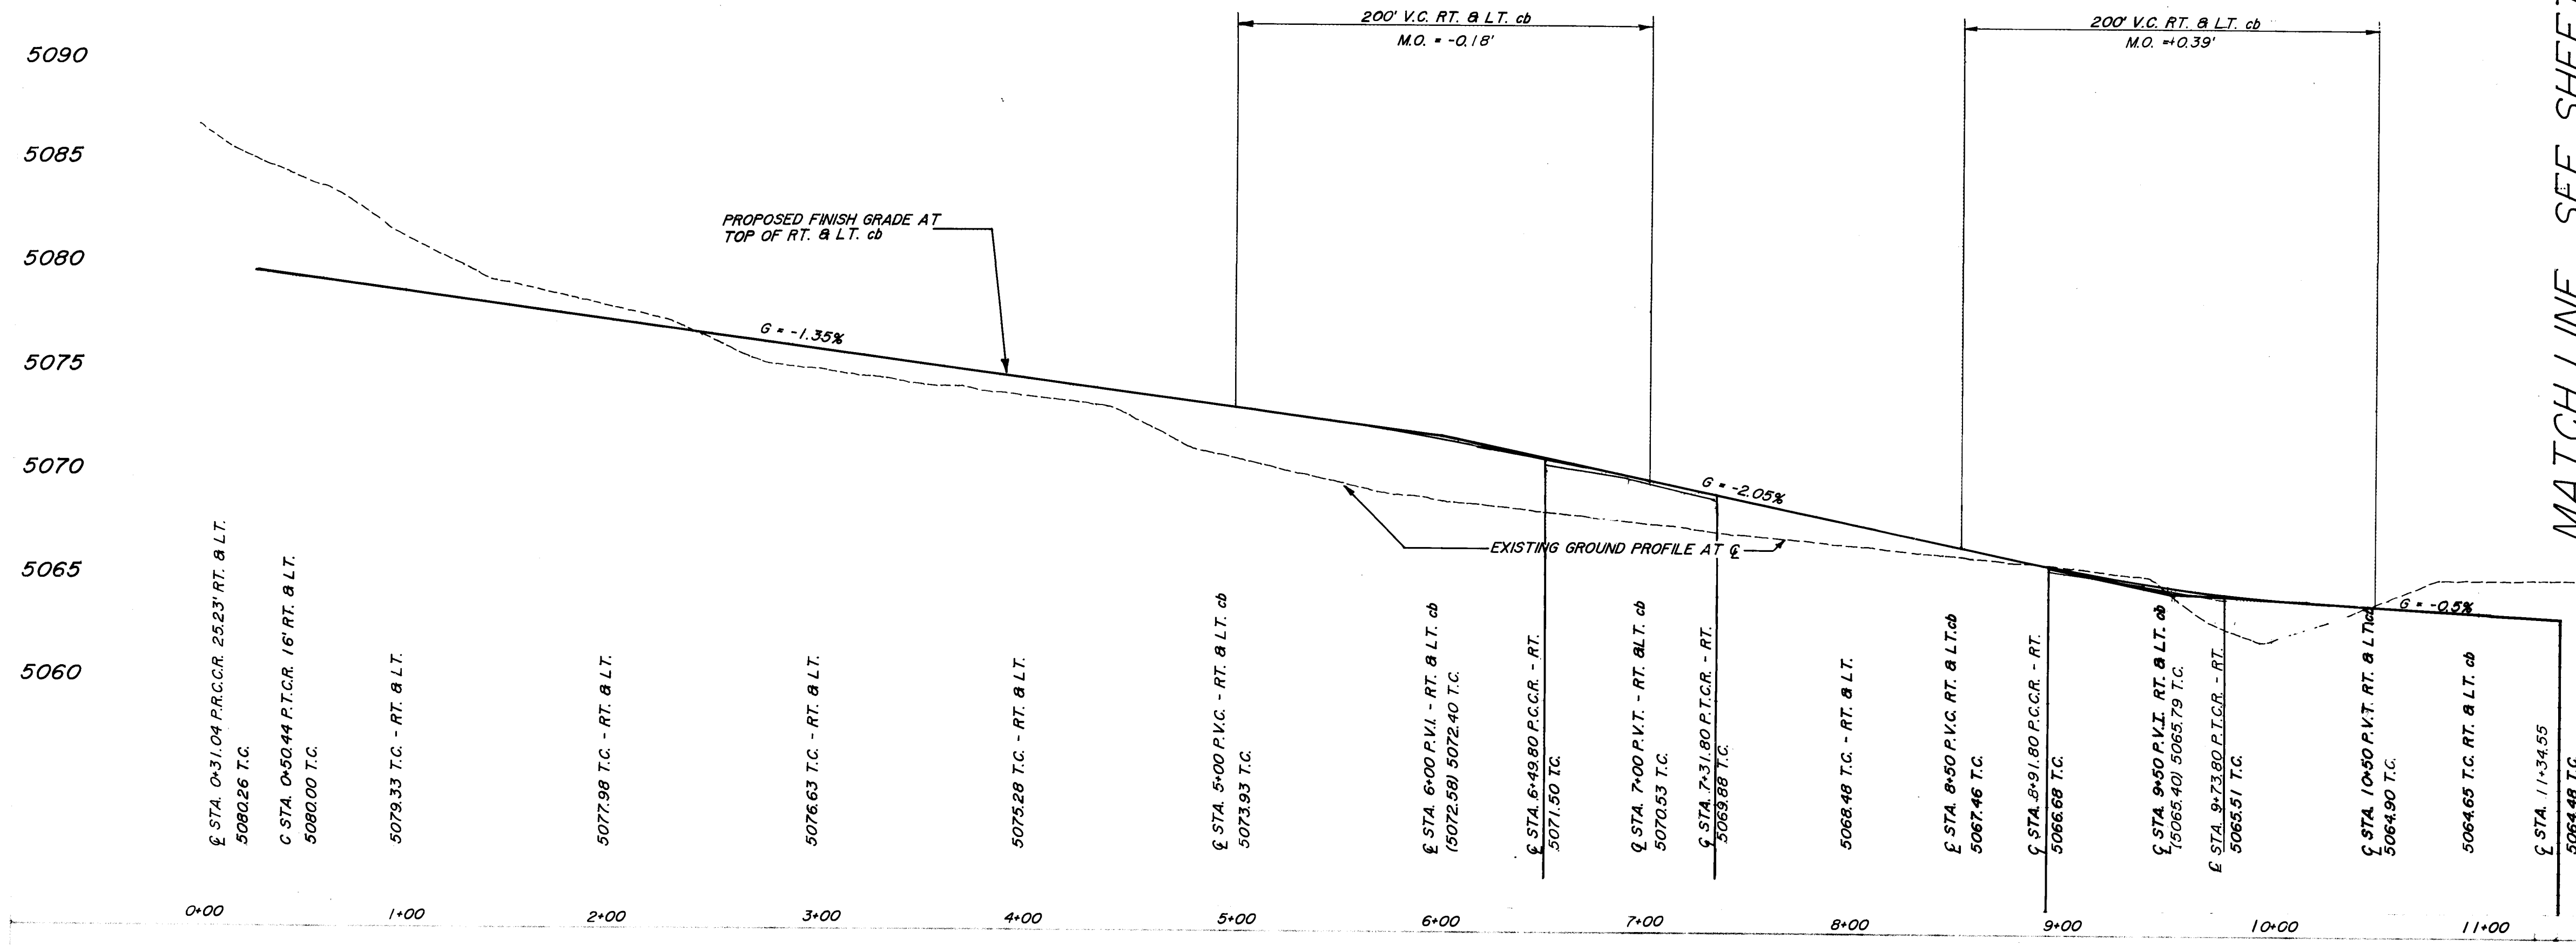


MATCH LINE SEE SHEET 12

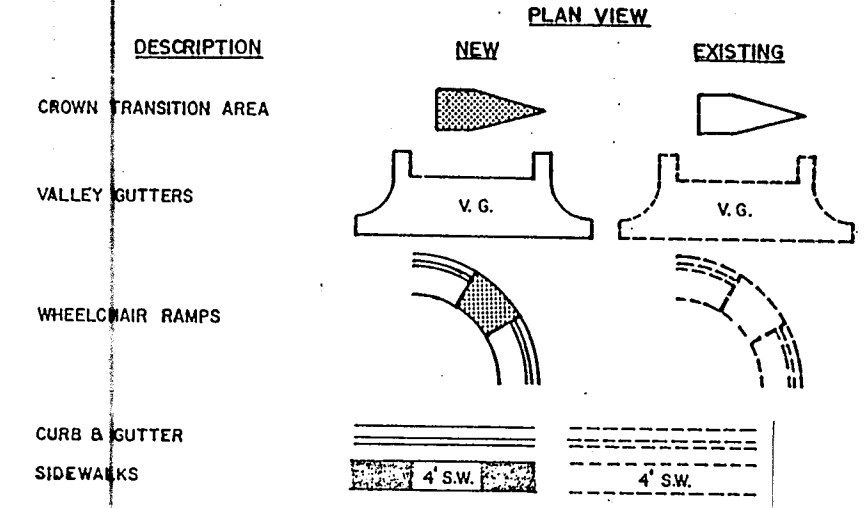

RECORD DRAWING
The improvements shown on this drawing have been as-built in accordance with field surveys performed by Espey, Huston and Associates, Inc. and information provided by Construction Contracting and Management Contractors to reflect the best of my knowledge and belief.

CITY OF ALBUQUERQUE
MUNICIPAL ENGINEERING DIVISION
ENGINEERING DIVISION
PRAIRIE RIDGE UNIT II PAVING
PRAIRIE SAGE AVENUE

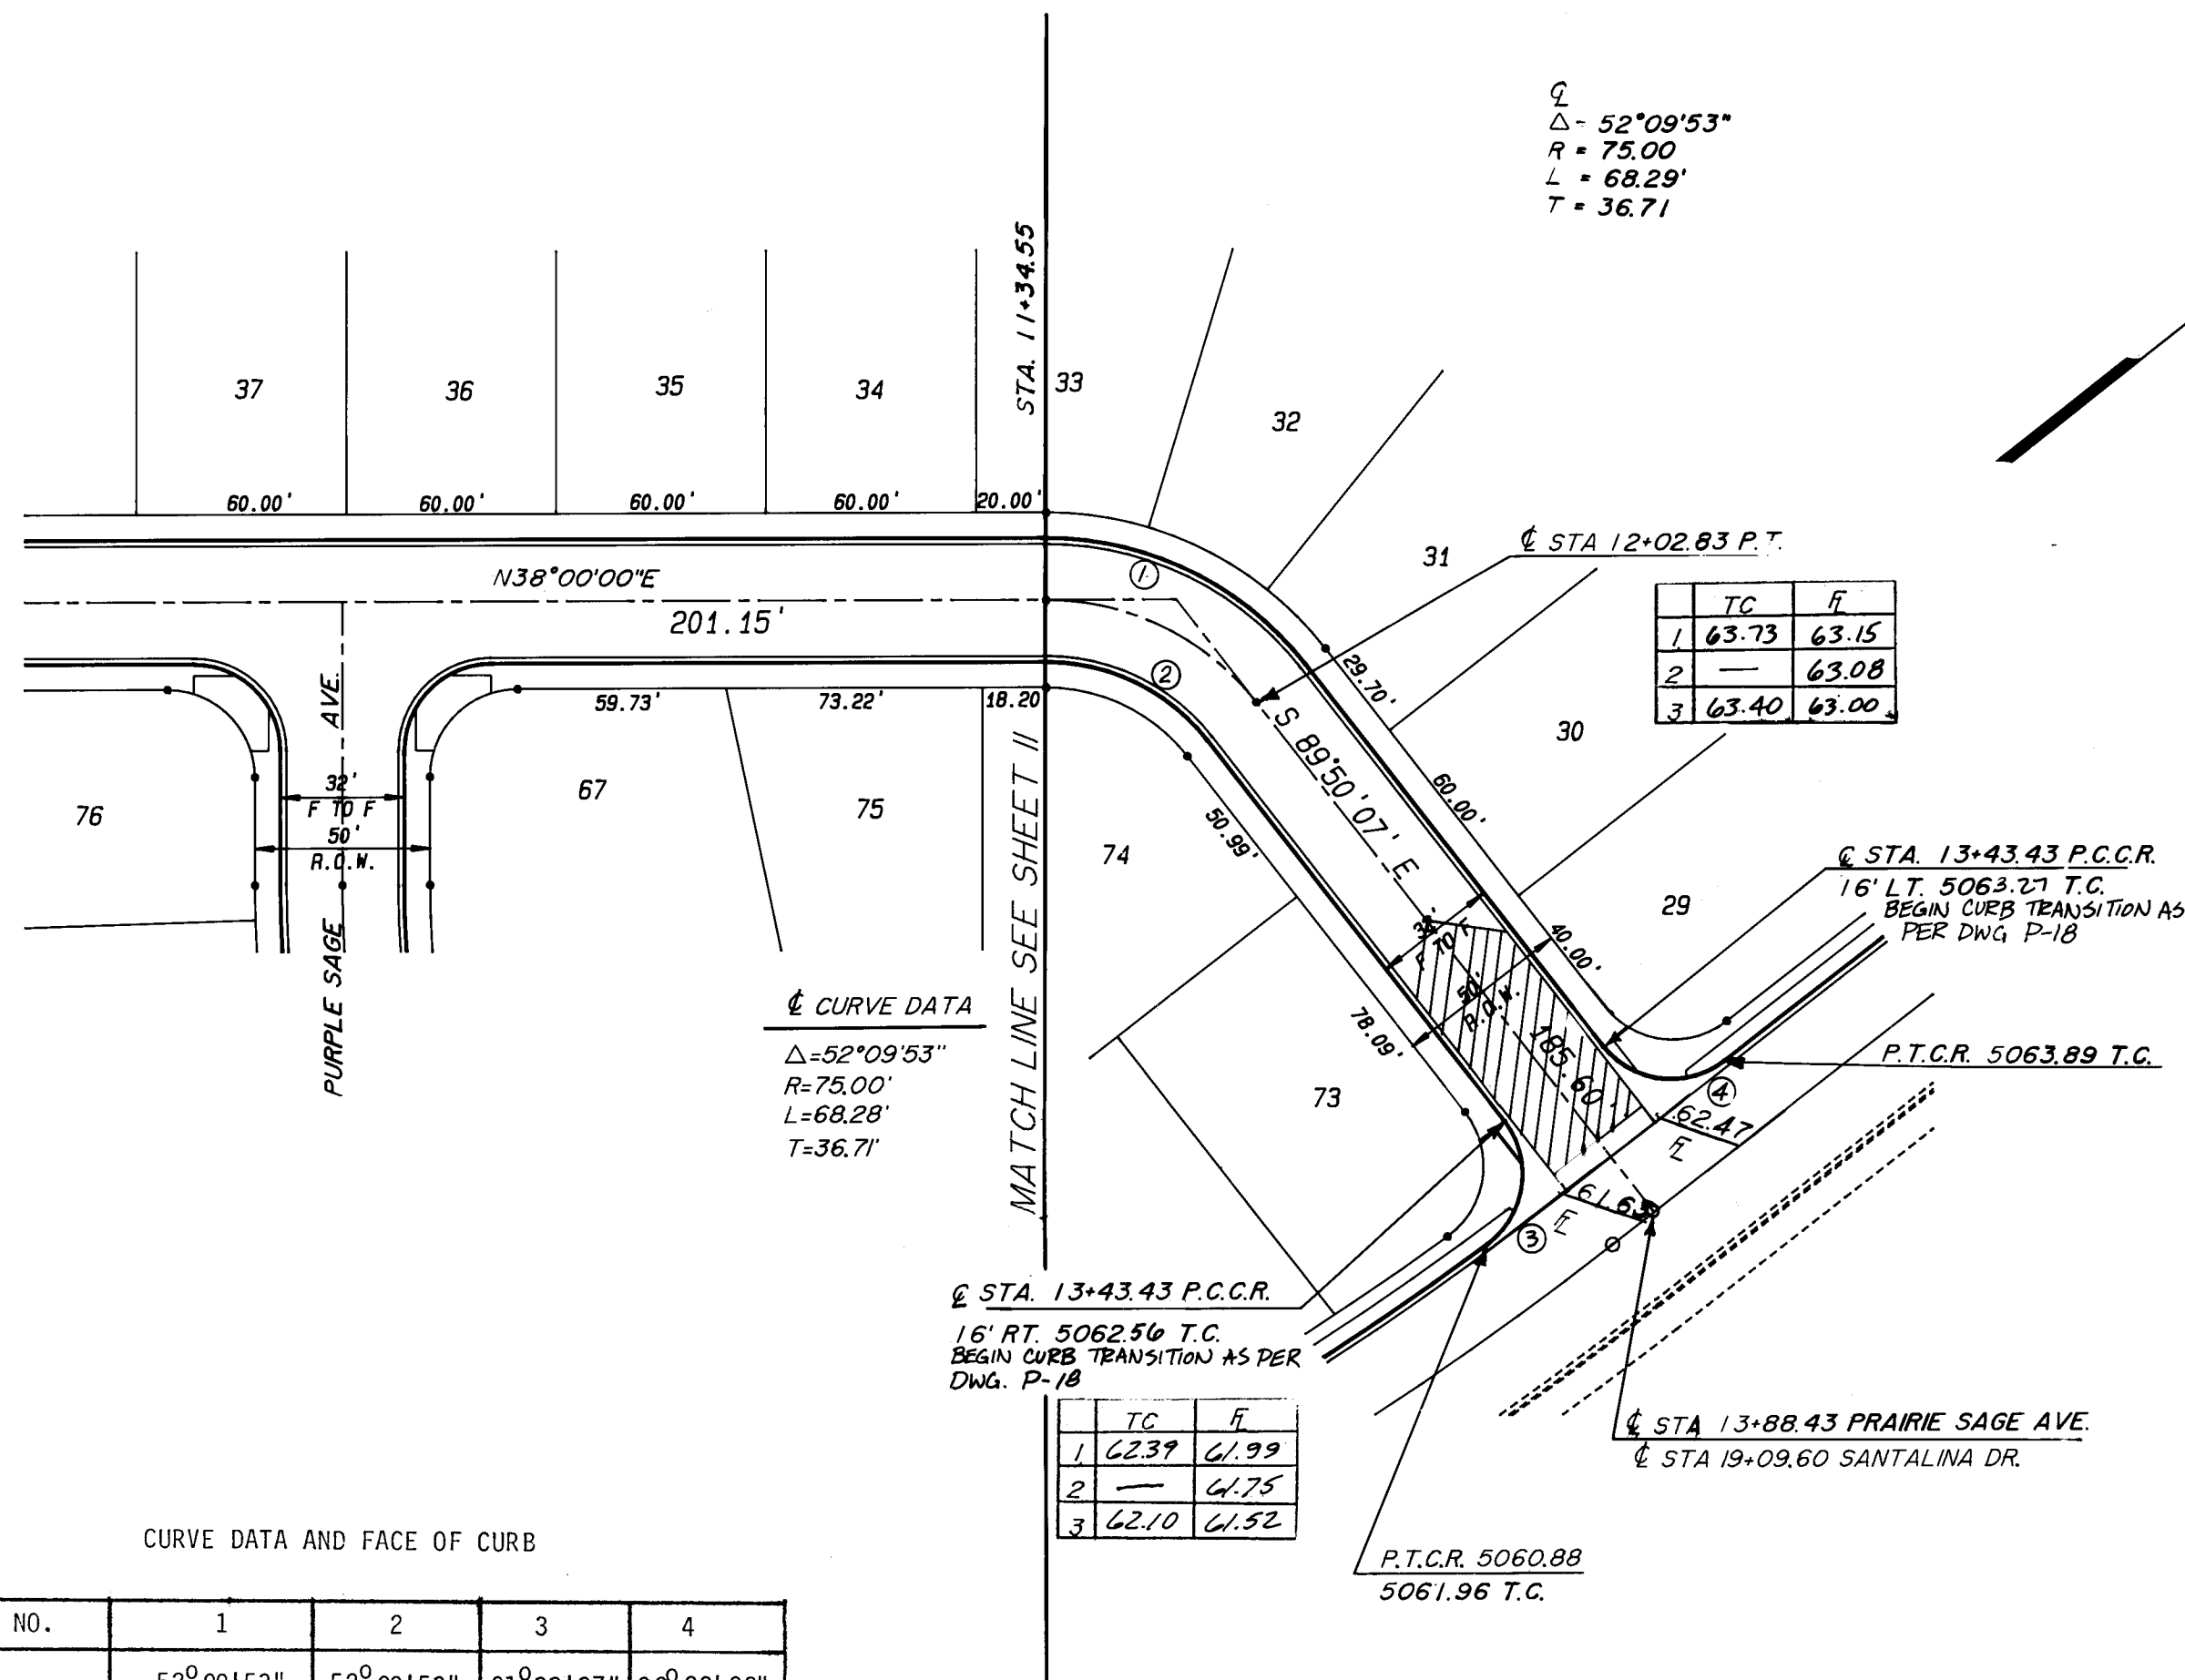


PRAIRIE SAGE AVENUE

RECORD DRAWING

The improvements shown on this drawing have been as-built in accordance with field surveys performed by Espey, Huston and Associates, Inc. and information provided by Construction Contracting and Management Inc. (contractors) to reflect construction actually accomplished as of this date, to the best of my knowledge and belief.

William F. Coleman P.E. 5945

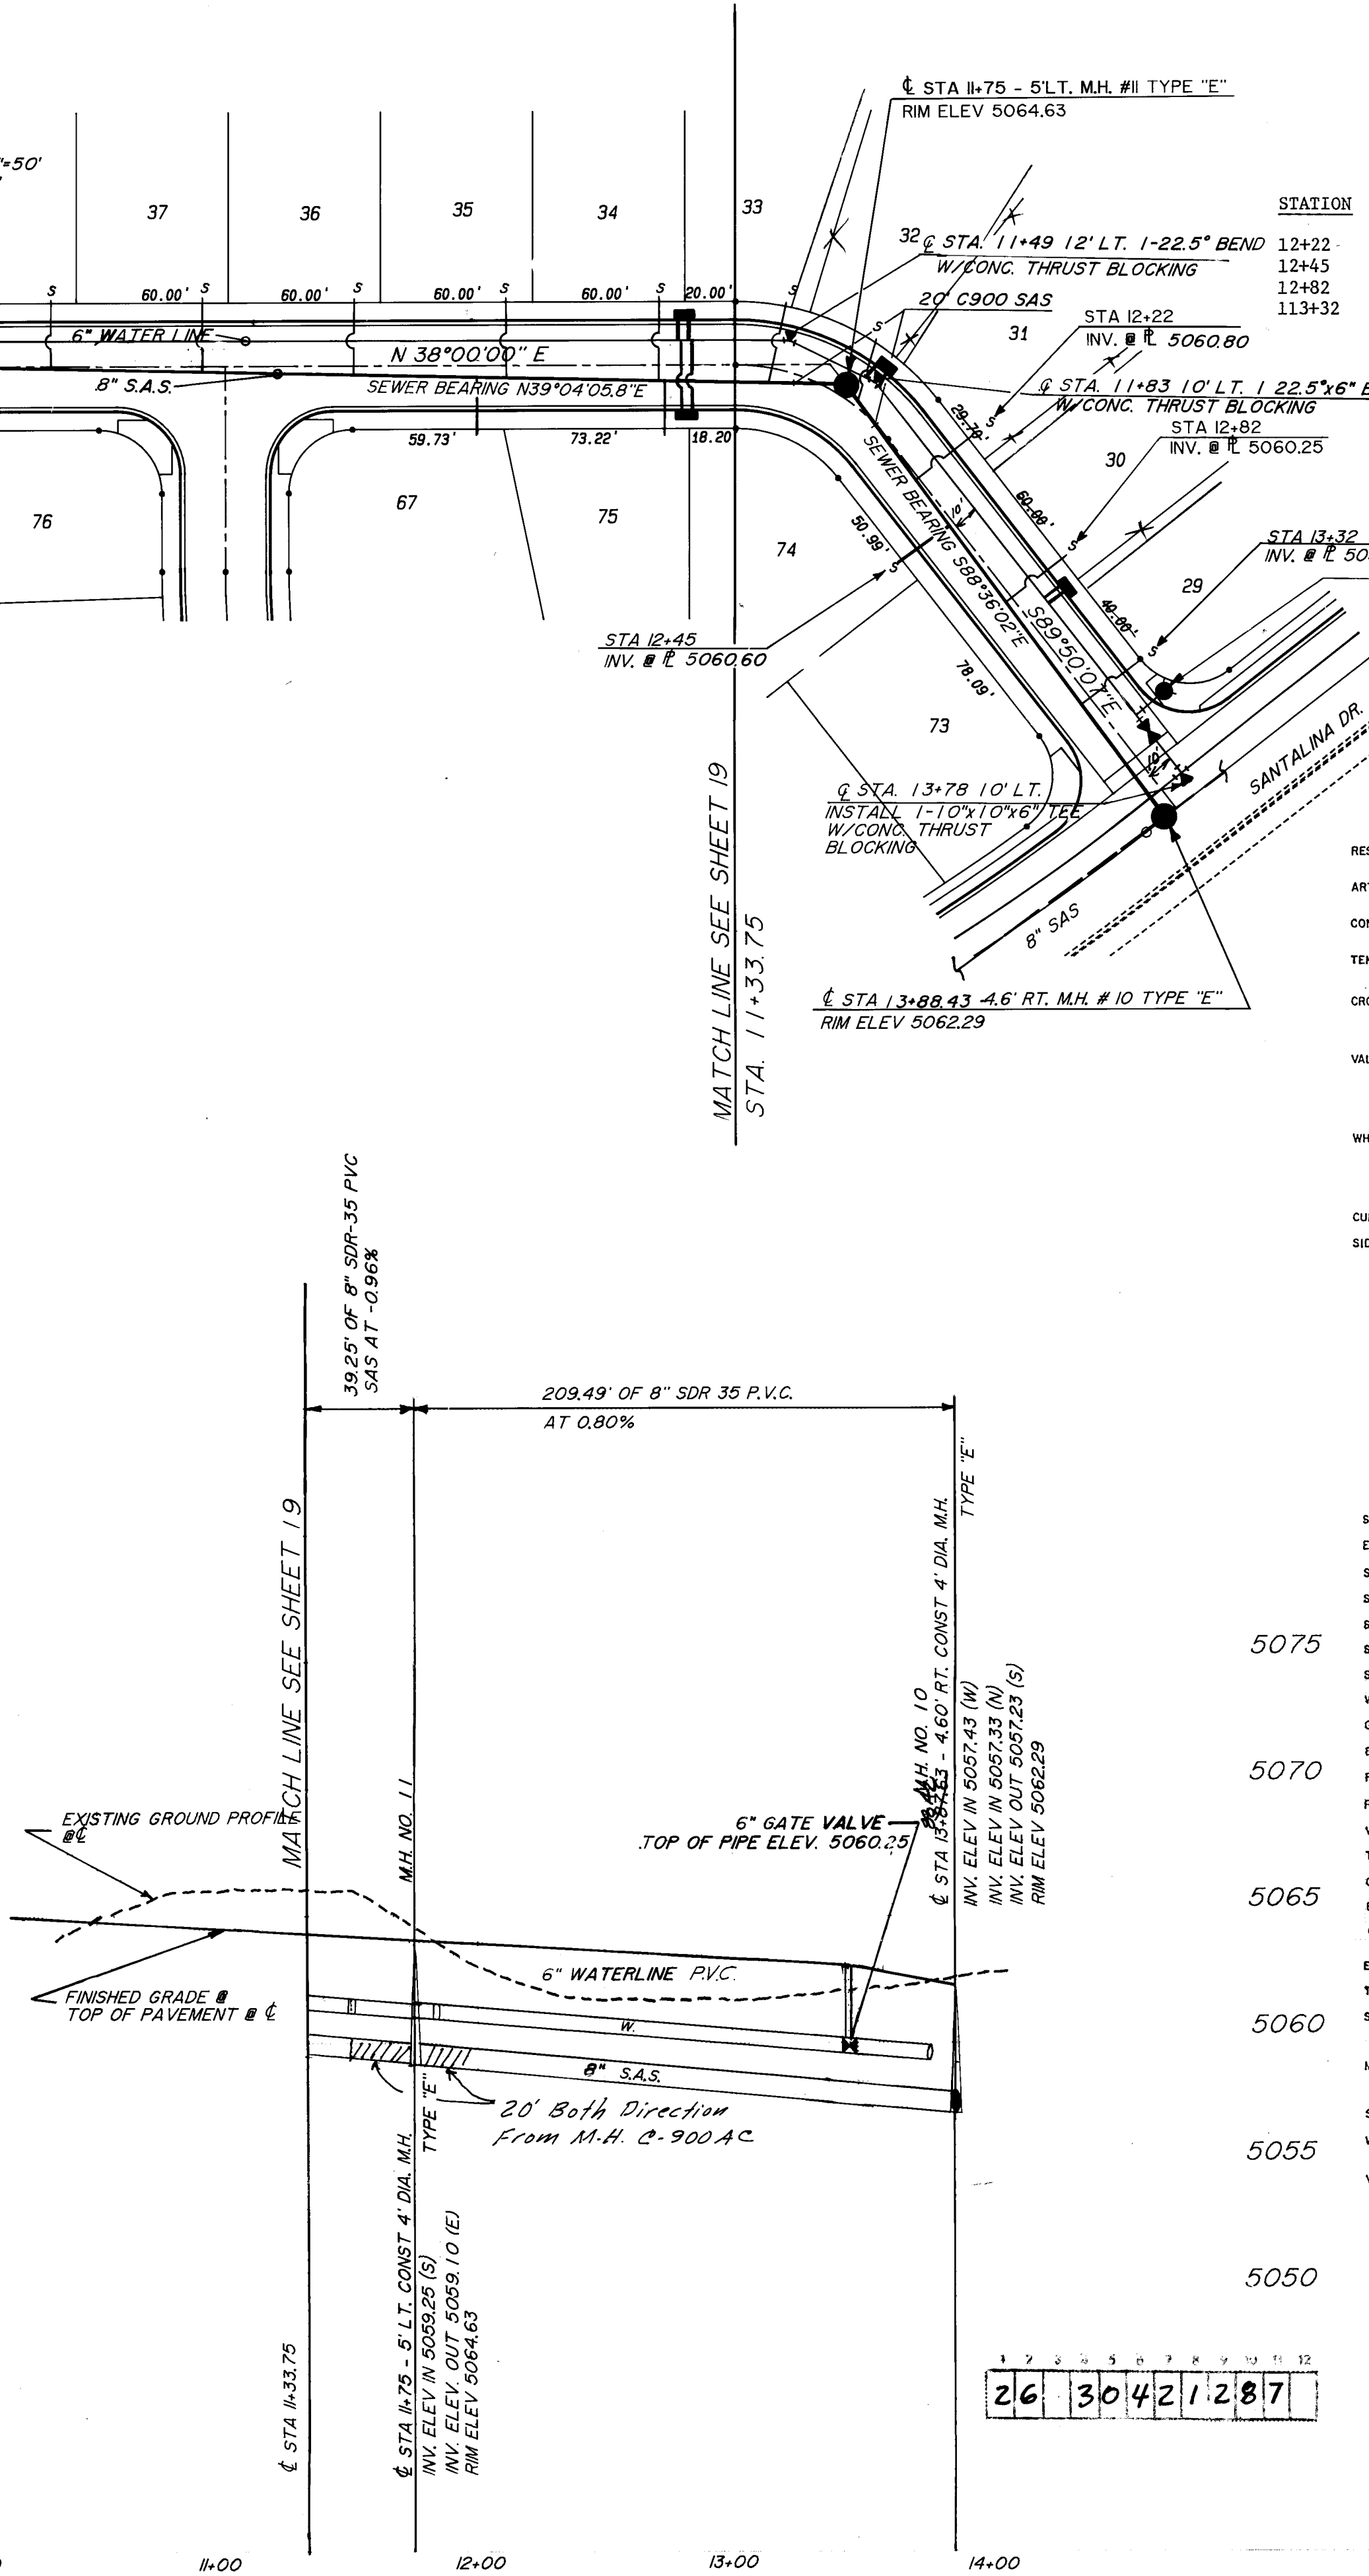

DESCRIPTION	NEW	EXISTING
RESIDENTIAL PAVING		
ARTERIAL PAVING		
CONCRETE PAVING		
TEMPORARY PAVING		
CROWN TRANSITION AREA		
VALLEY GUTTERS		
WHEELCHAIR RAMPS		
CURB & GUTTER SIDEWALKS		



DESCRIPTION	NEW	EXISTING
SANITARY SEWER LINE		
ENCASEMENT		
SANITARY SEWER MANHOLE		
SAS SERVICE CONNECTION		
STORM DRAIN LINE		
STORM DRAIN MANHOLE		
STORM DRAIN INLETS		
WATER LINE		
GATE VALVE		
BUTTERFLY VALVE		
FIRE HYDRANTS		
REDUCERS		
WATER SERVICE CONNECTION		
TEES		
CROSSES		
BENDS		
CAPS & PLUGS		
EXISTING GROUND		
TOP OF CURB		
SANITARY SEWER LINE		
MANHOLES (ALL)		
STORM DRAIN LINES		
WATER LINES		
VERTICAL BENDS		

CITY OF ALBUQUERQUE
 MUNICIPAL DEVELOPMENT DEPARTMENT
 ENGINEERING DIVISION

**TITLE PRAIRIE RIDGE UNIT II PAVING & UTILITIES
 PRAIRIE SAGE AVENUE**

APPROVAL	DATE	APPROVAL	DATE
City Engineer	10/21/86	City Engineer	10/21/86
City Designer	10/21/86	City Designer	10/21/86
City Hydrologist	10/21/86	City Hydrologist	10/21/86




DRAWING NO. **3042** MAP NO. E-12-Z SHEET **12** OF **23**

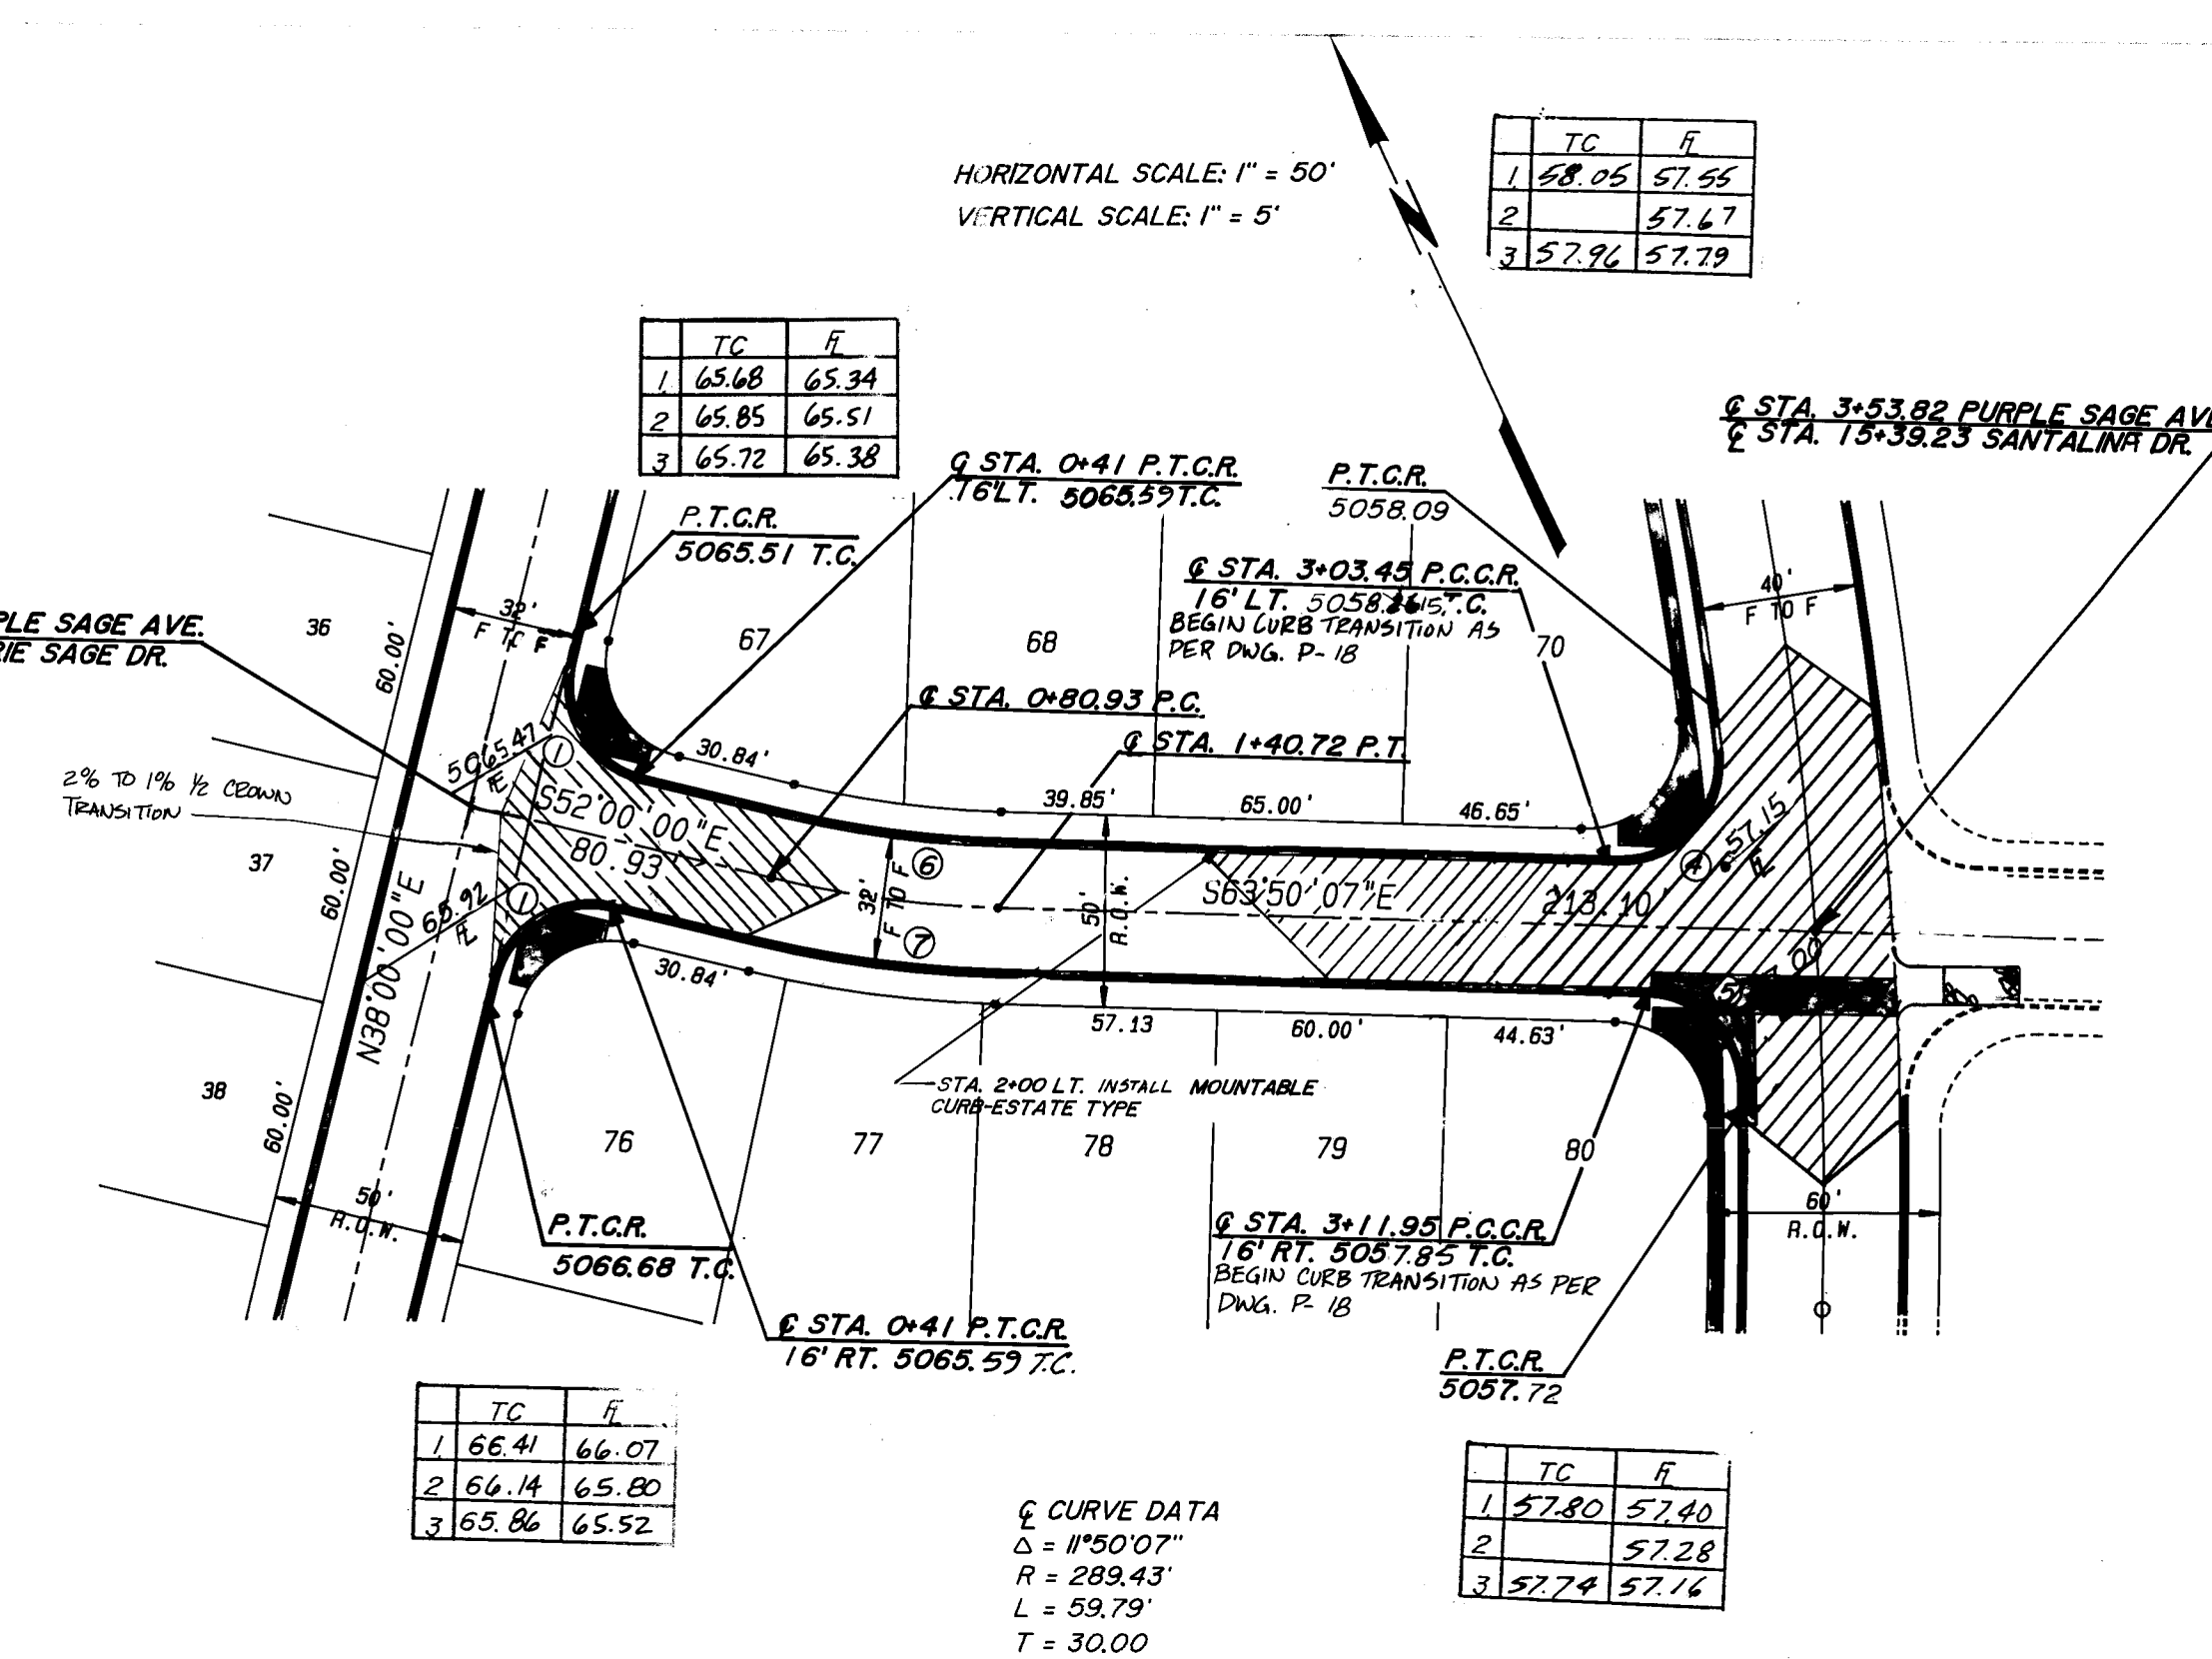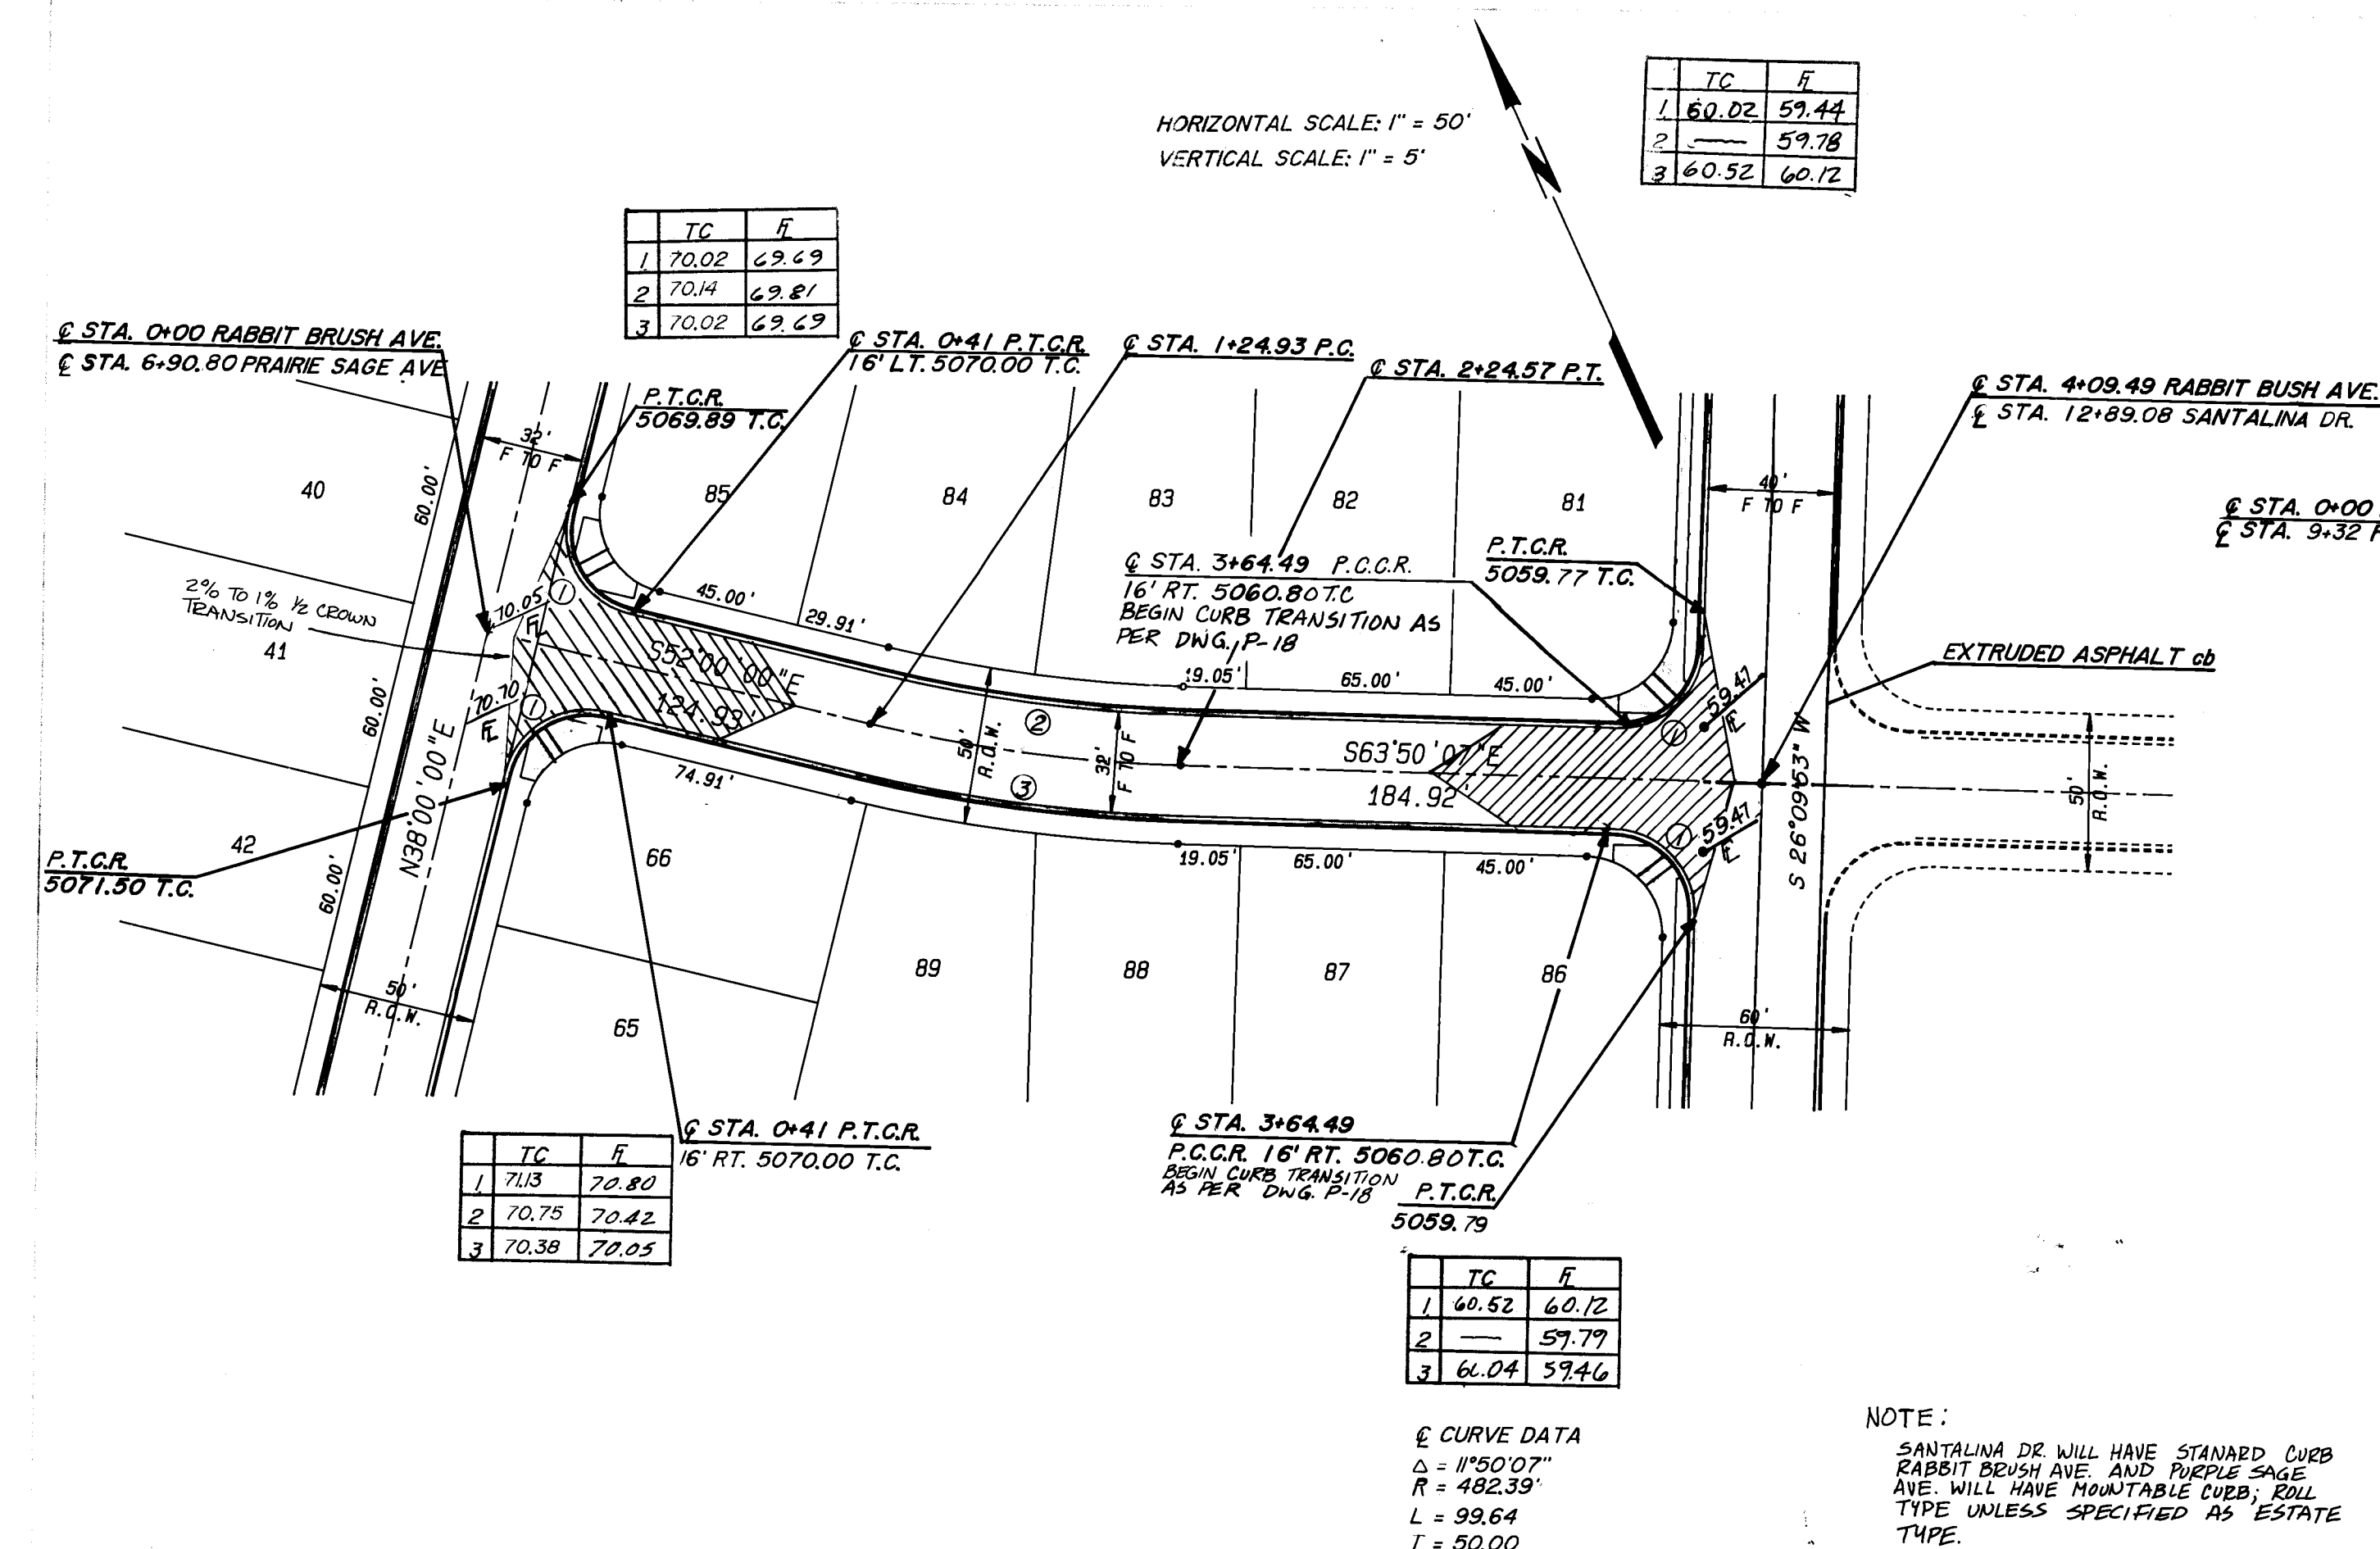

CURVE No.	1	2	3	4	5	6	7
DELTA	90°00'00"	11°50'07"	11°50'07"	98°23'04"	86°33'47"	11°50'07"	11°50'07"
RADIUS	25.00'	466.39'	498.39'	25.00'	25.00'	273.43'	305.43'
LENGTH	39.27'	96.34'	102.95'	42.93'	37.77'	56.48'	63.09'
TANGENT	25.00'	48.34'	51.66'	28.96'	23.54'	28.34'	31.66'

RABBIT BRUSH AVE.

PURPLE SAGE AVE.

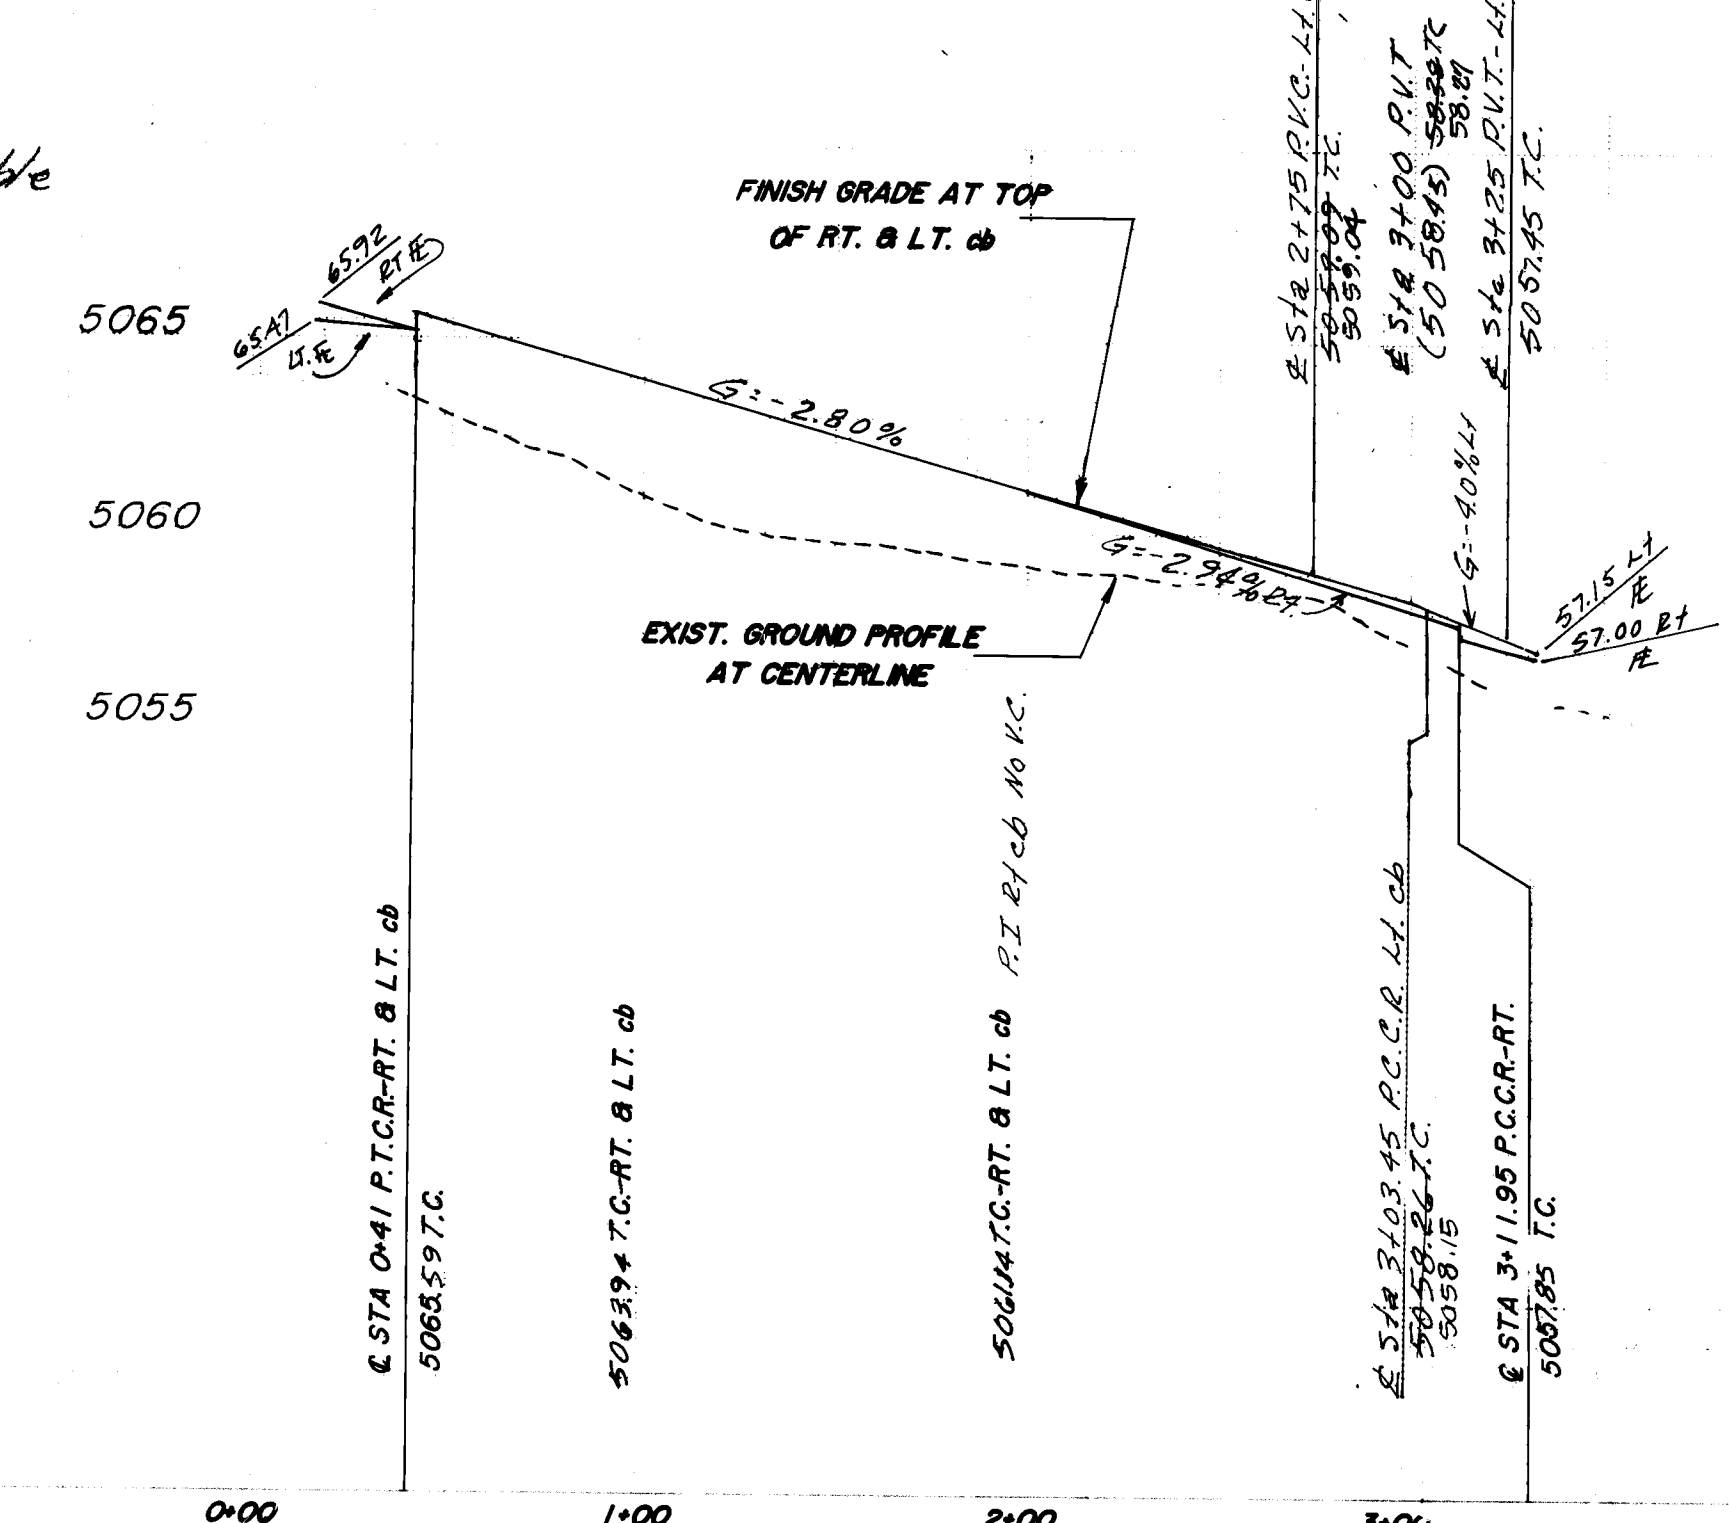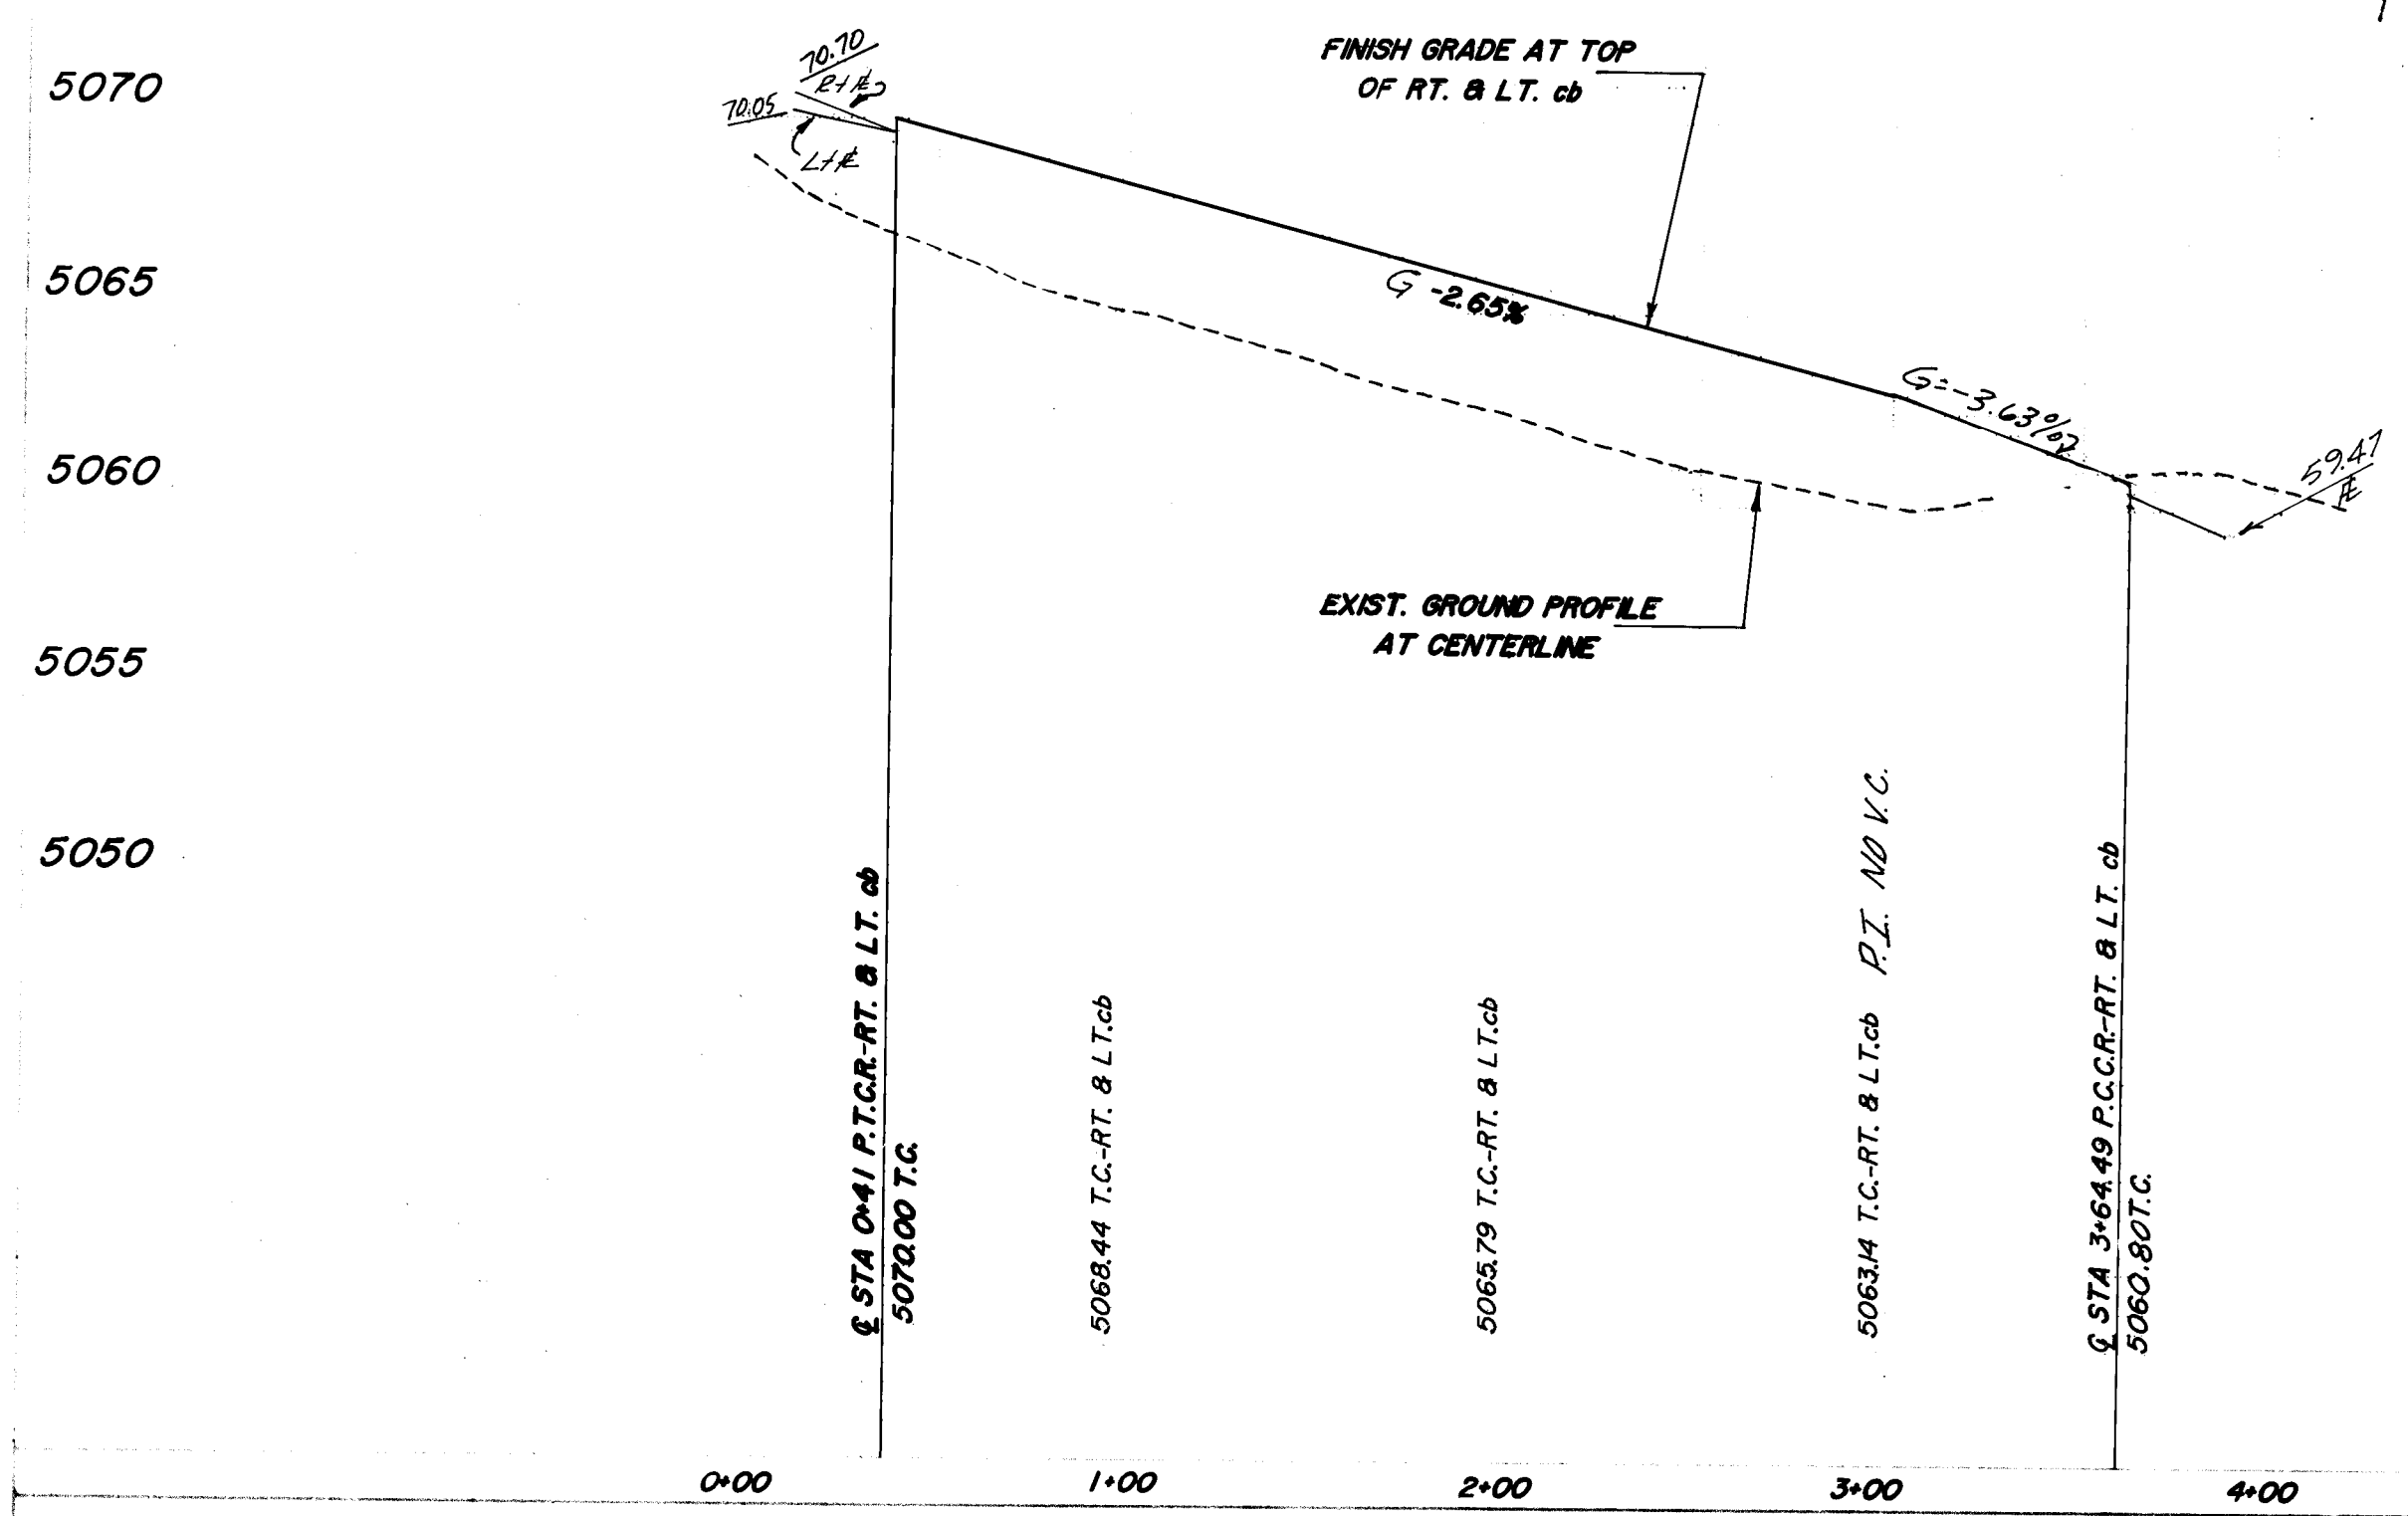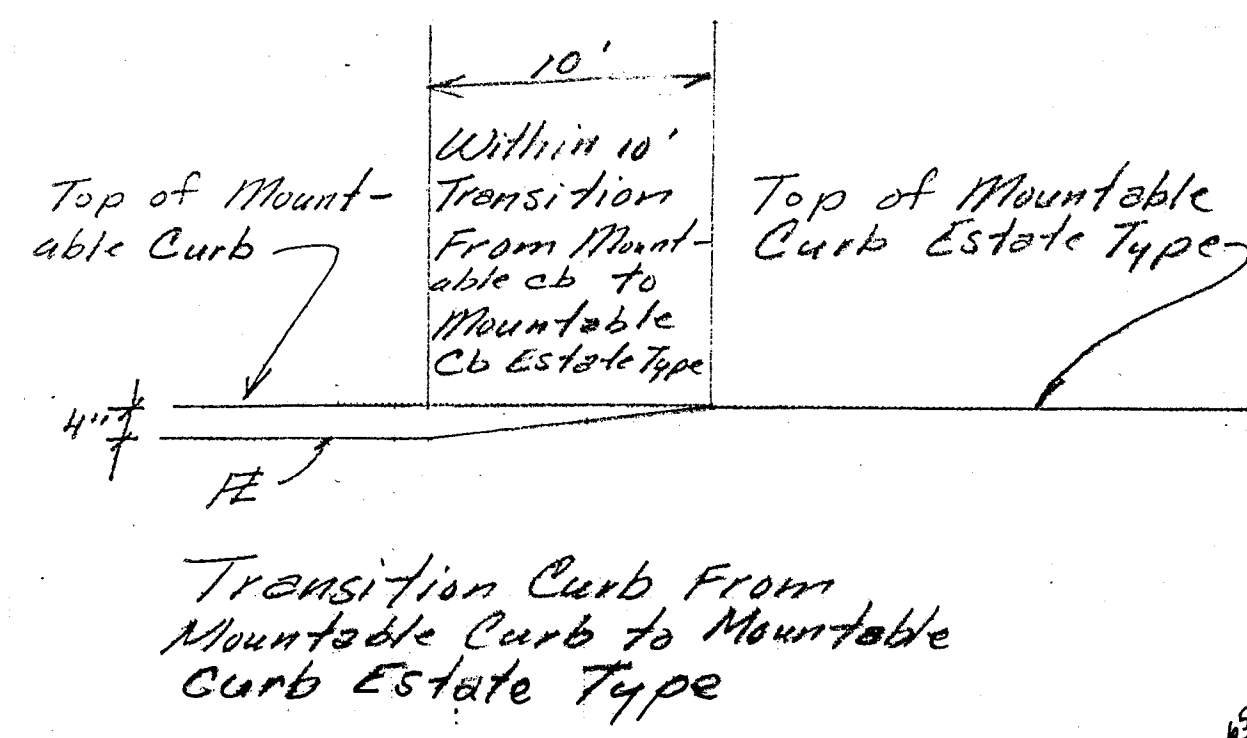



The improvements shown on this drawing have been as-built in accordance with field surveys performed by Espey, Huston and Associates, Inc. and information provided by Construction Associates and Management Inc. (contractors) to reflect construction actually accomplished, as of this date, to the best of my knowledge and belief.

William J. Adams
4/7/07

RECORD DRAWING

William F. Coleman P.E. 5945
4/7/07



AS BUILT INFORMATION		BENCH MARKS		SURVEY INFORMATION		ENGINEER'S SEAL		REVISIONS		CITY OF ALBUQUERQUE MUNICIPAL DEVELOPMENT DEPARTMENT ENGINEERING DIVISION		TITLE PRAIRIE RIDGE UNIT II PAVING RABBIT BRUSH AVENUE & PURPLE SAGE AVENUE	
NO.	DATE	NO.	DATE	NO.	DATE	NO.	DATE	NO.	DATE	NO.	DATE	NO.	DATE
1	5/1/06	1	5/1/06	1	5/1/06	1	5/1/06	1	5/1/06	1	5/1/06	1	5/1/06
2	5/1/06	2	5/1/06	2	5/1/06	2	5/1/06	2	5/1/06	2	5/1/06	2	5/1/06
3	5/1/06	3	5/1/06	3	5/1/06	3	5/1/06	3	5/1/06	3	5/1/06	3	5/1/06
APPROVALS													
City Engineer				Engineer				DATE				APPROVALS	
ACE Design				ACE Design				10/21/06				Liquid Waste	
ACE-Hydrology				ACE-Hydrology				10/21/06				Traffic	
												Water	
DRAWING NO. 3042													
MAP NO.													
SHEET 13 OF 23													

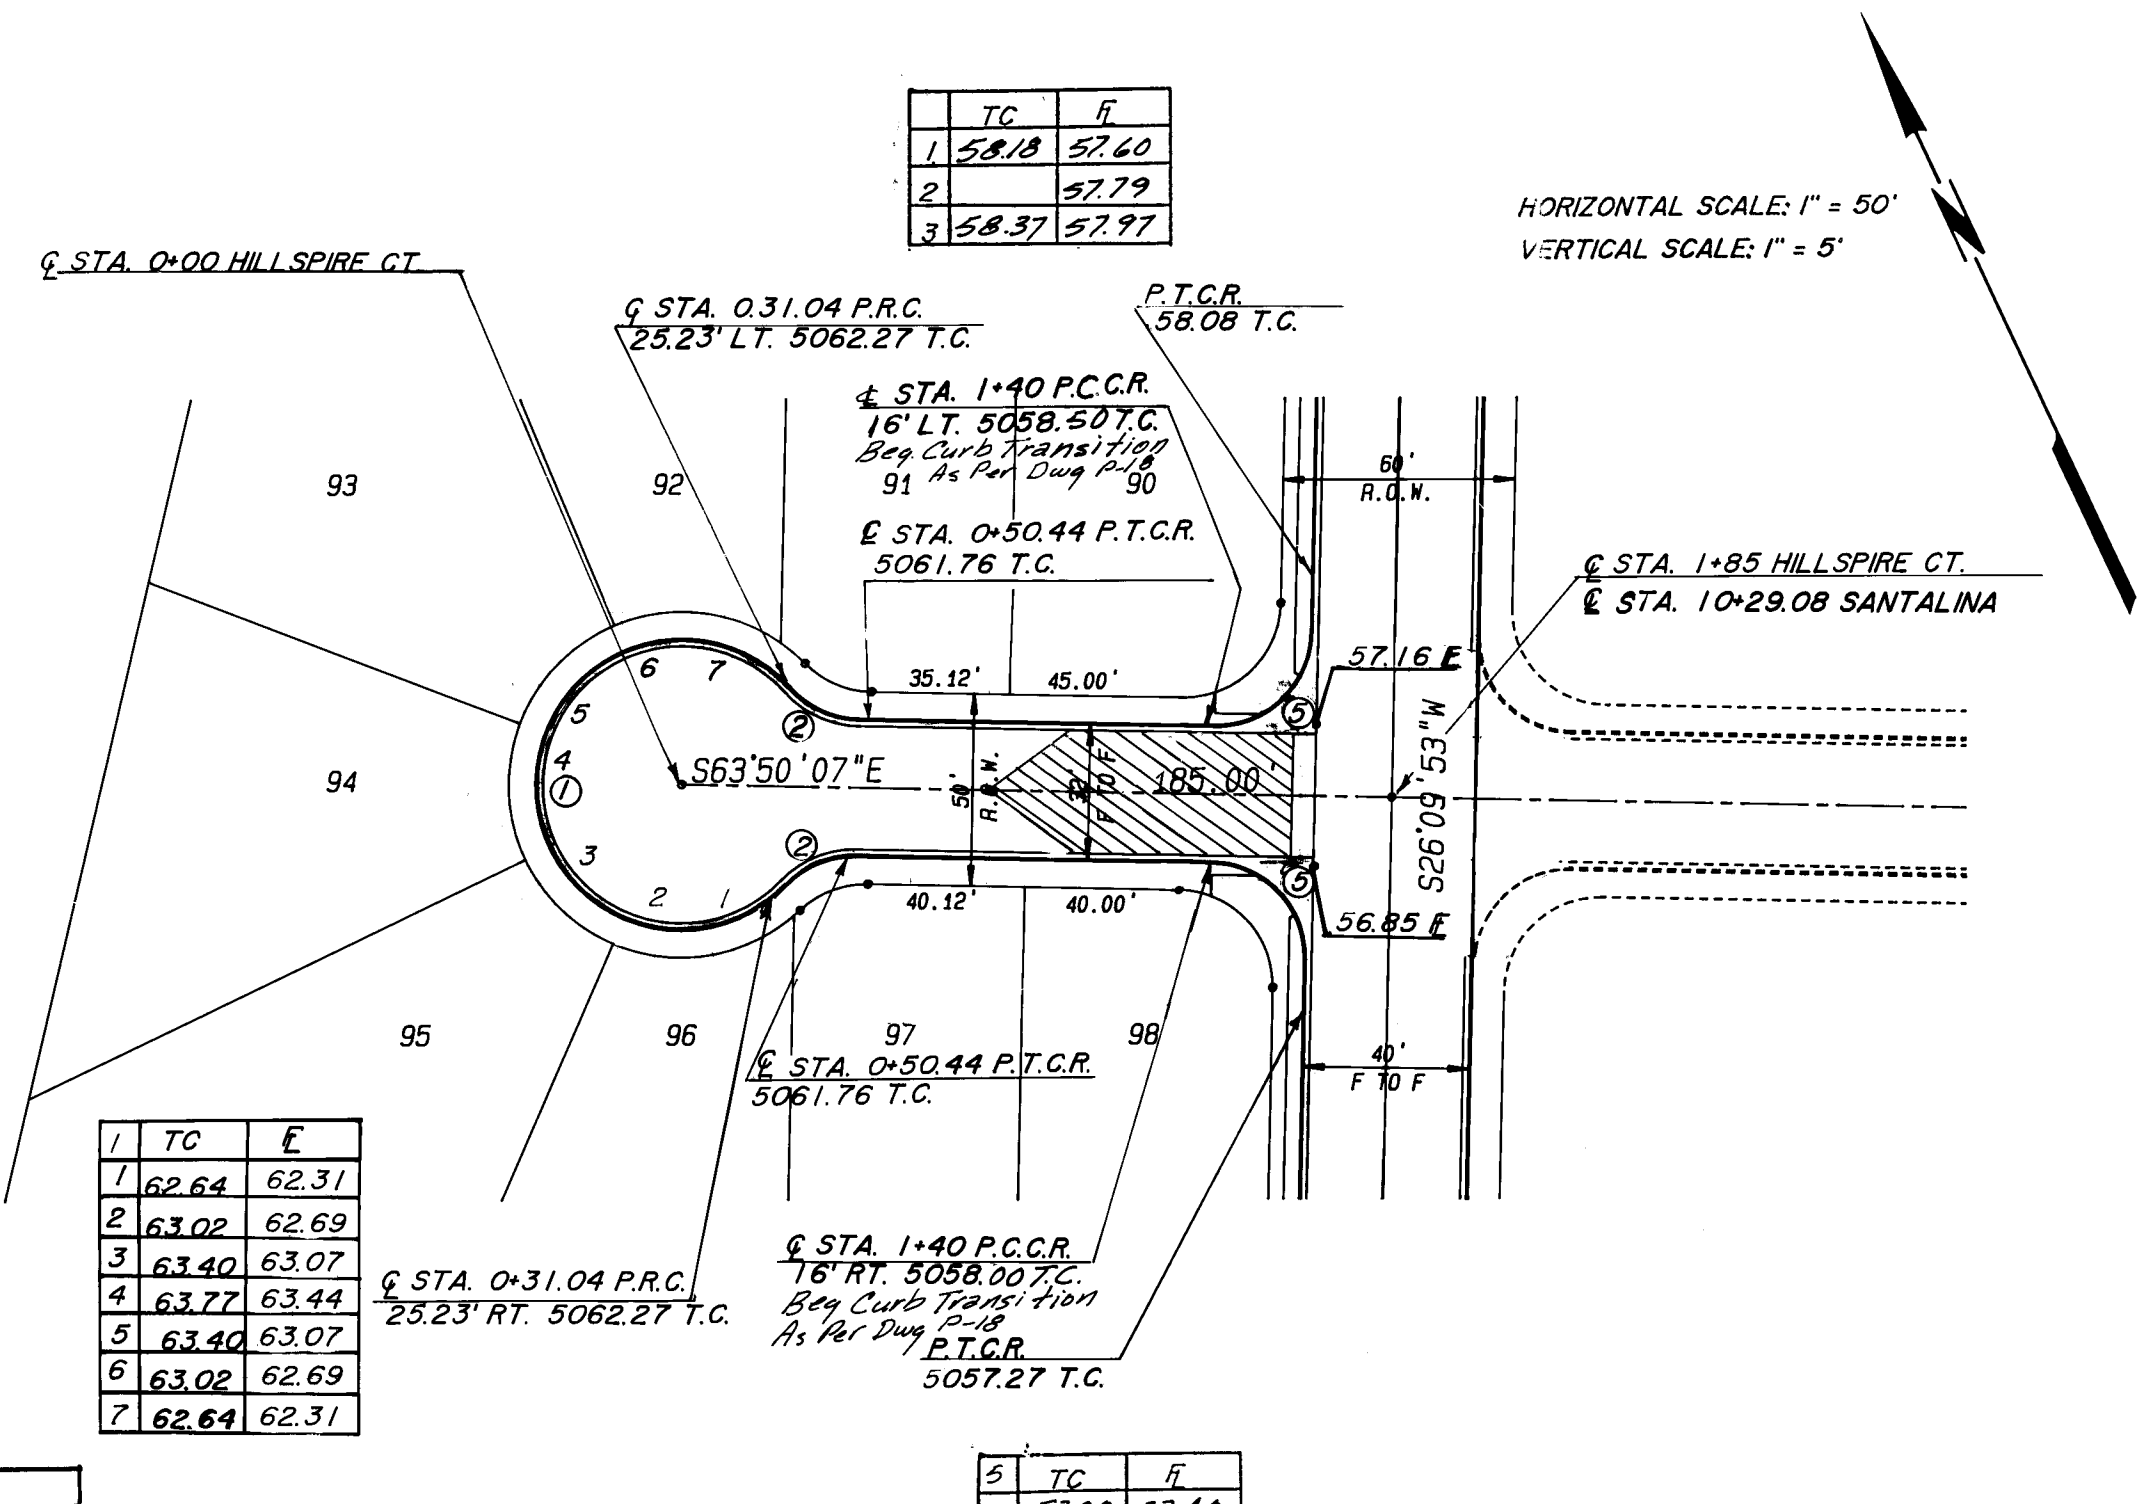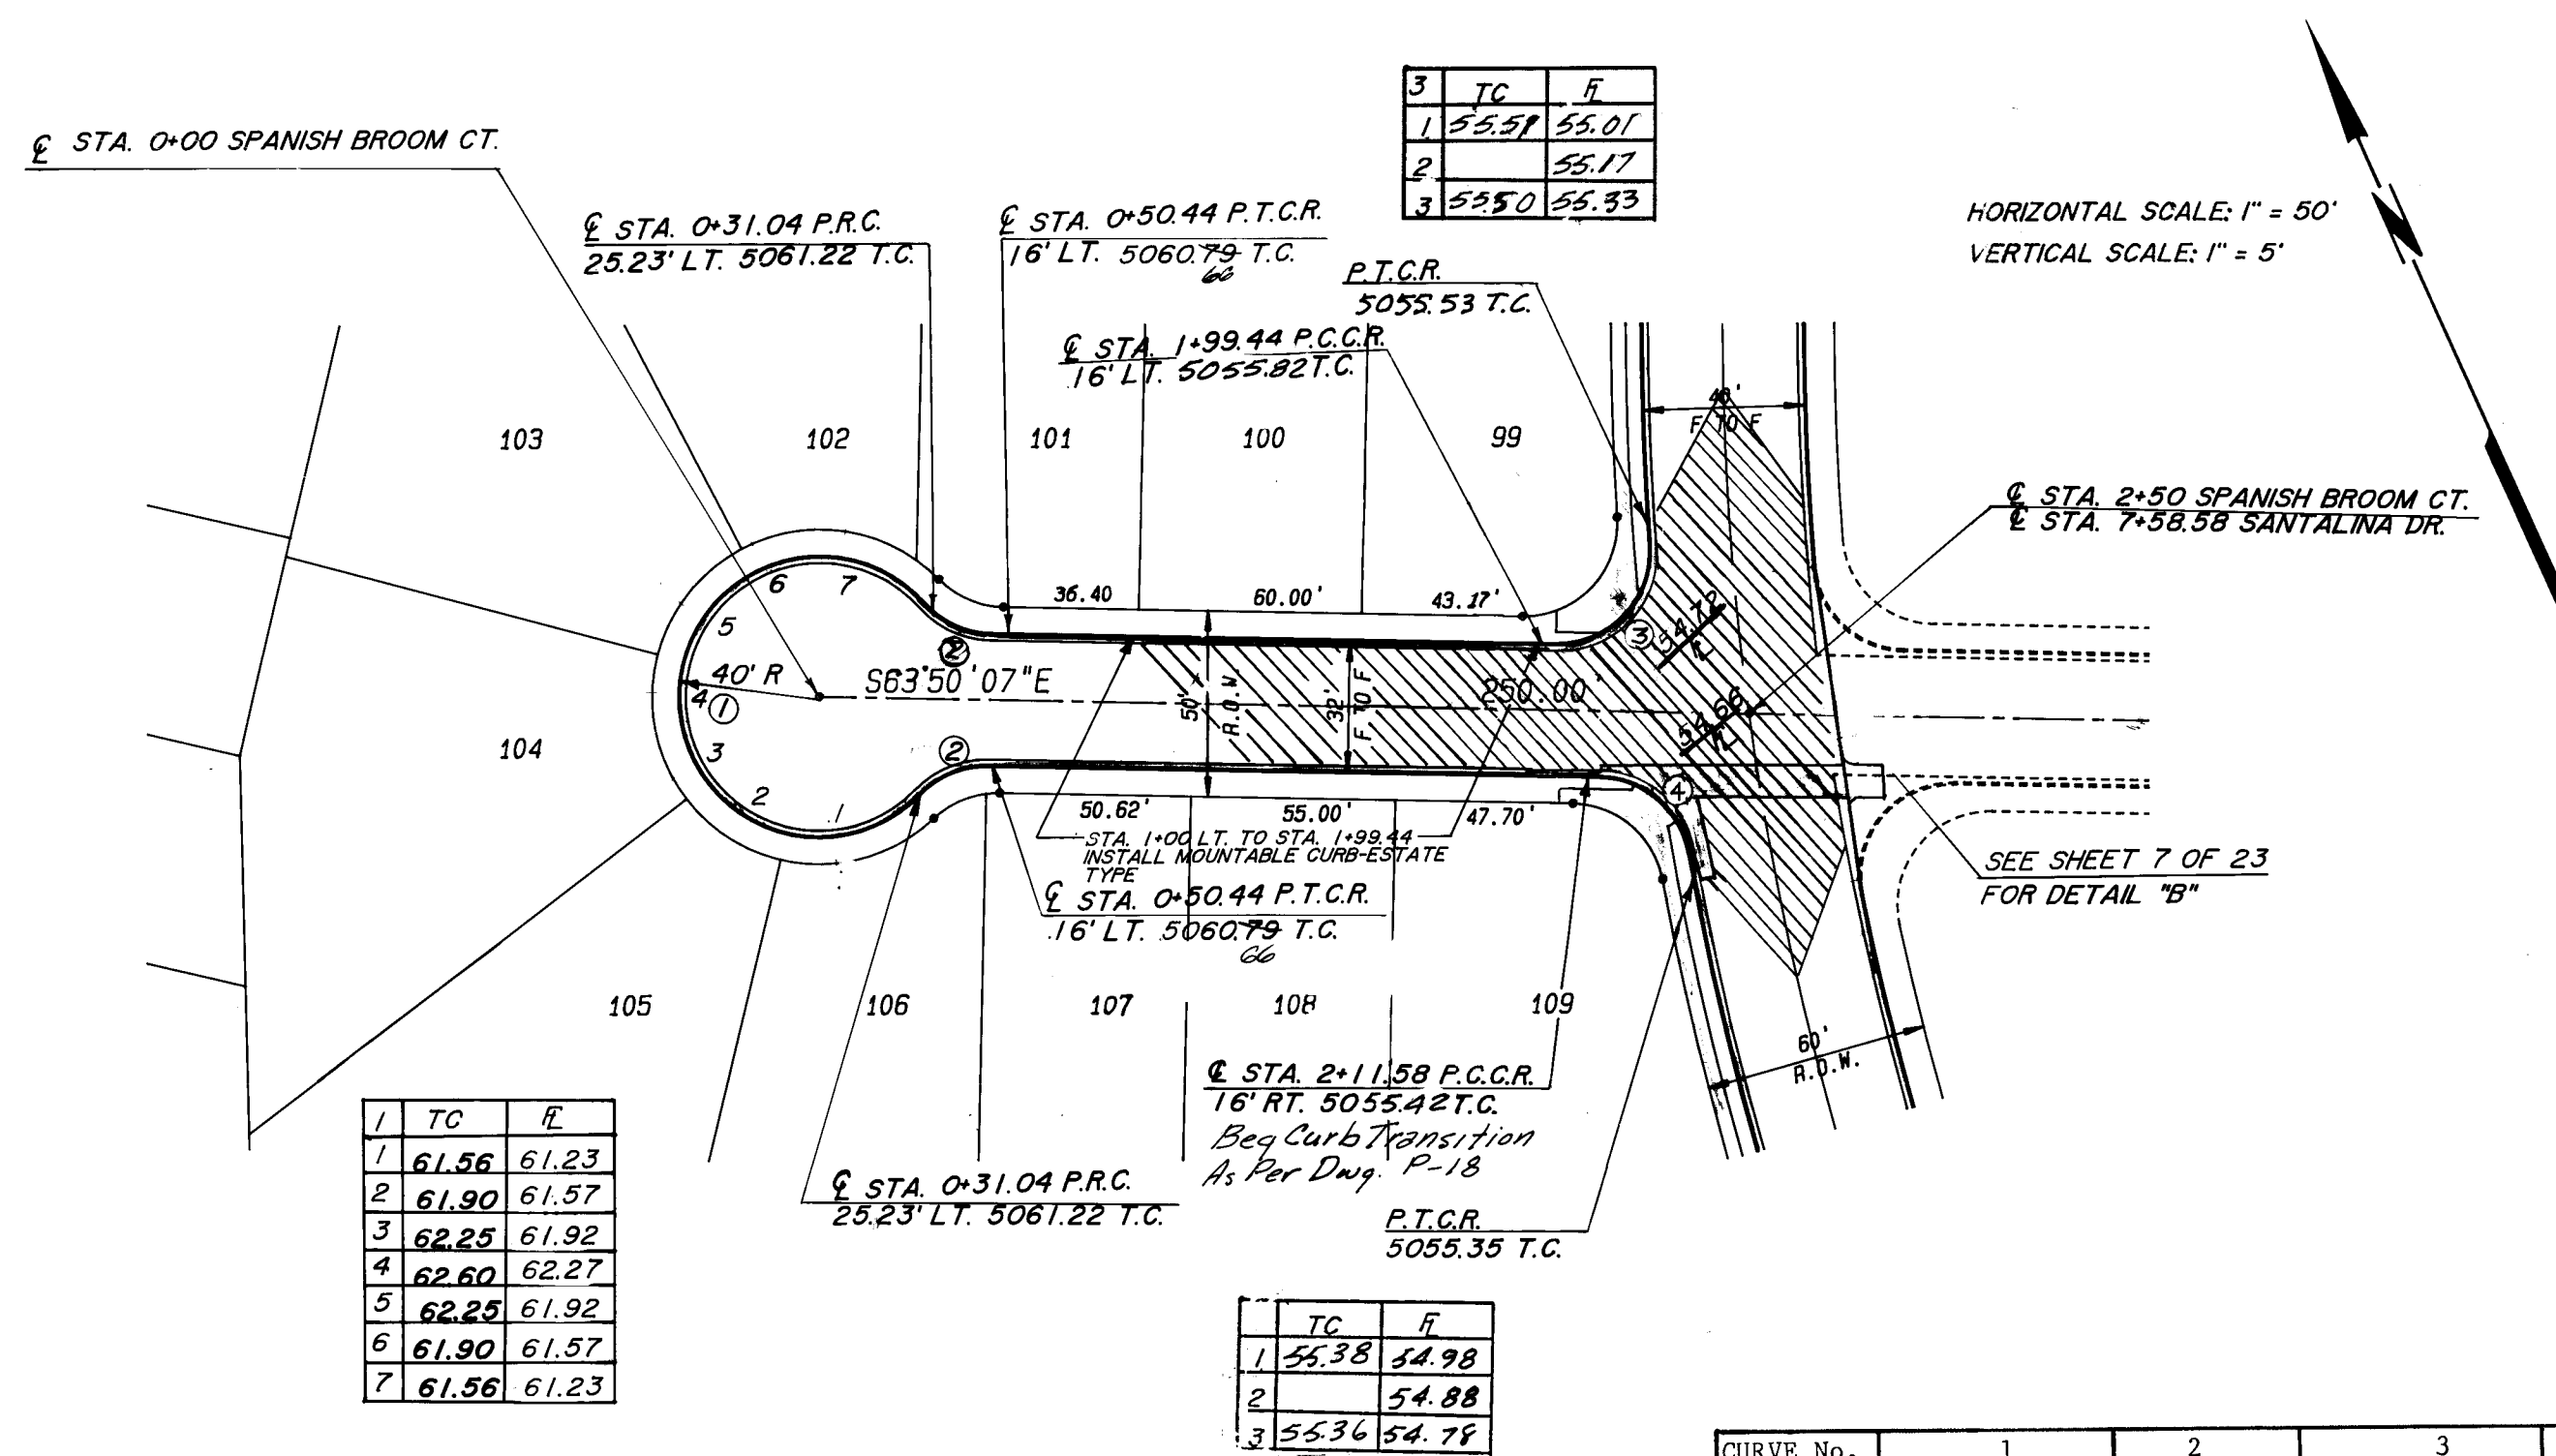

CURVE No.	1	2	3	4	5
DELTA	258°12'50"	39°06'25"	95°36'34.9"	78°46'03"	90°00'00"
RADIUS	40.00'	25.00'	25.00'	25.00'	25.00'
LENGTH	180.27'	17.06'	41.72'	34.37'	39.27'
TANGENT	-0-	8.87'	27.58'	20.52'	25.00'

SPANISH BROOM COURT

HILLSPIRE COURT

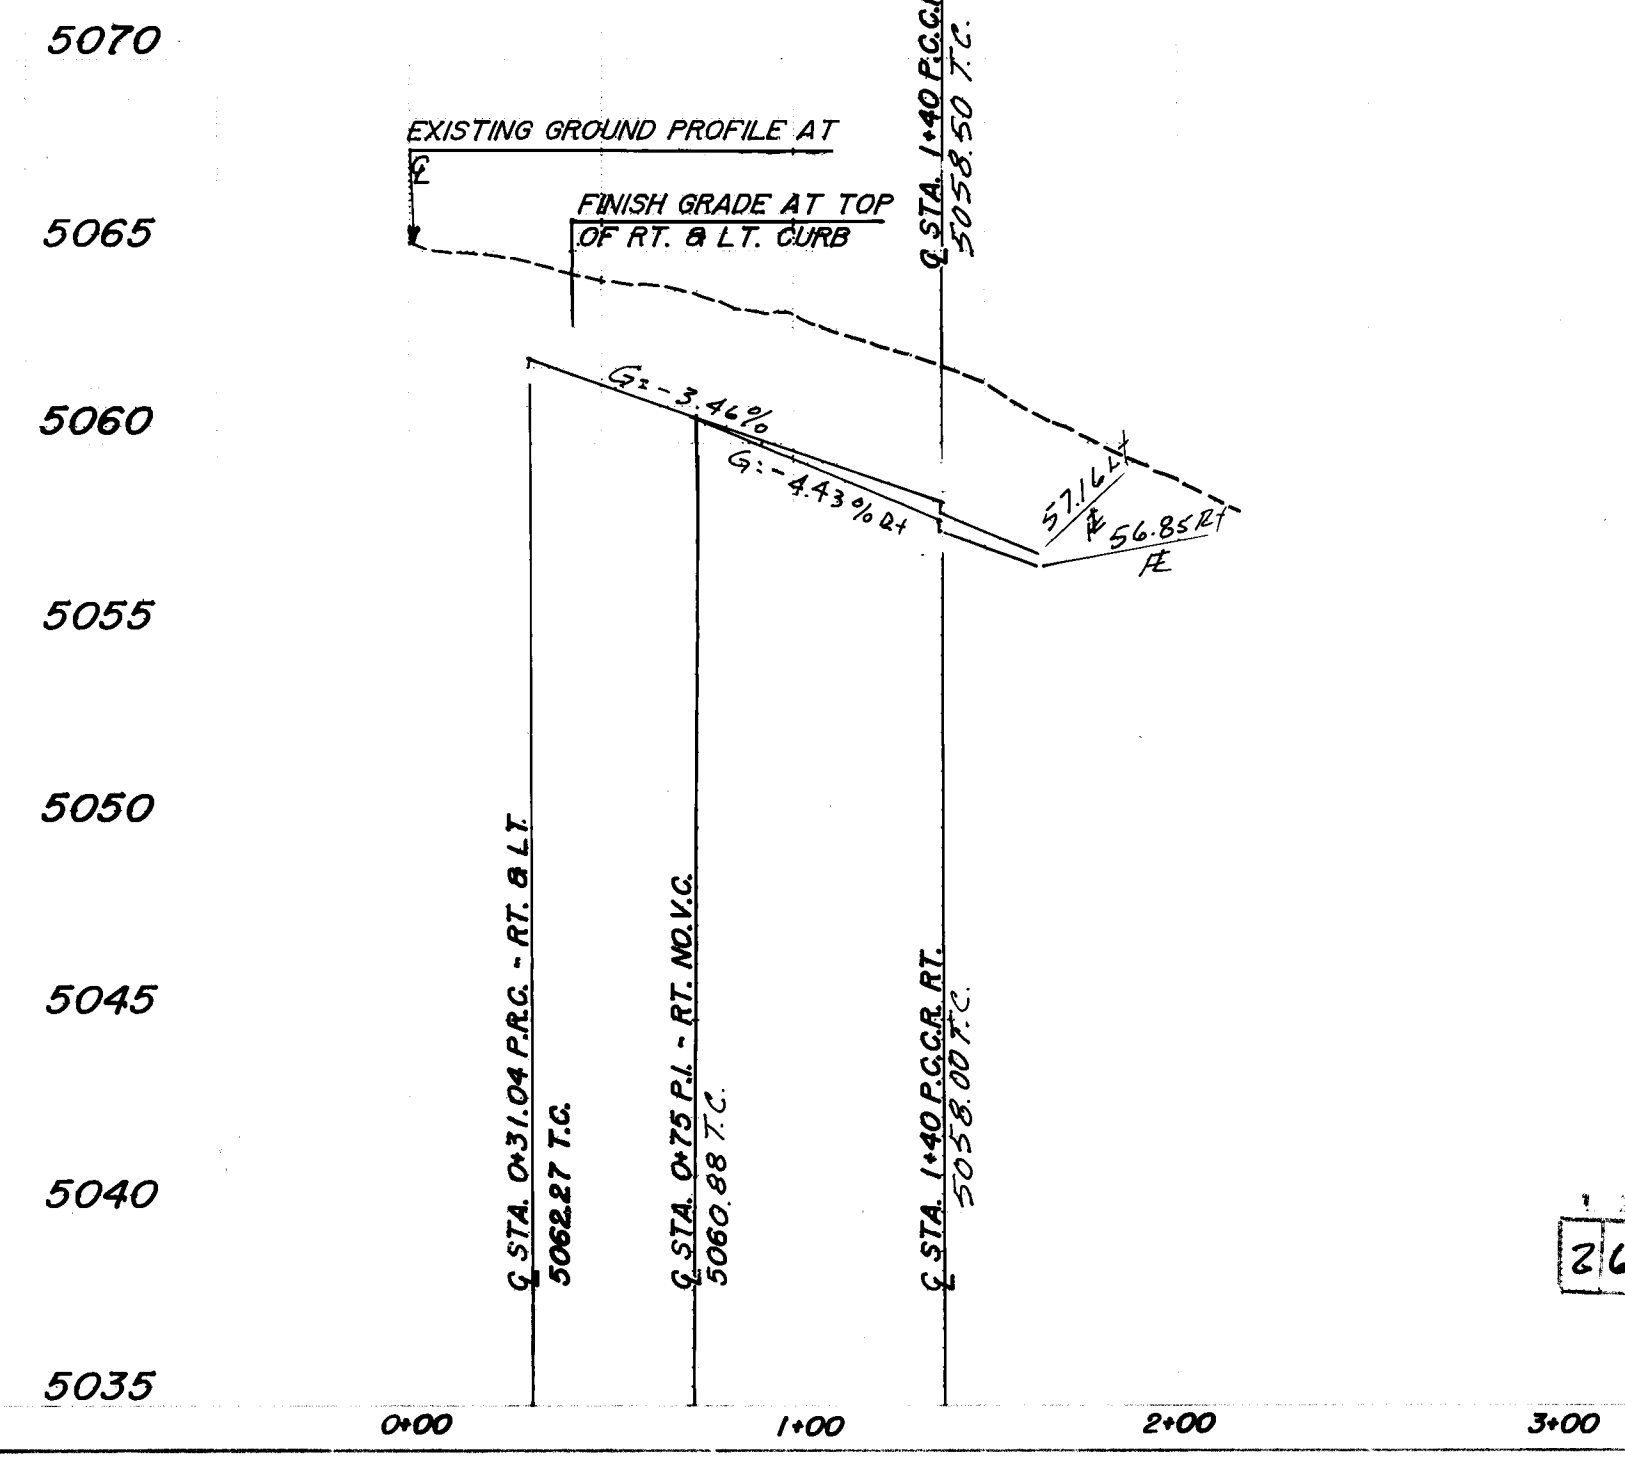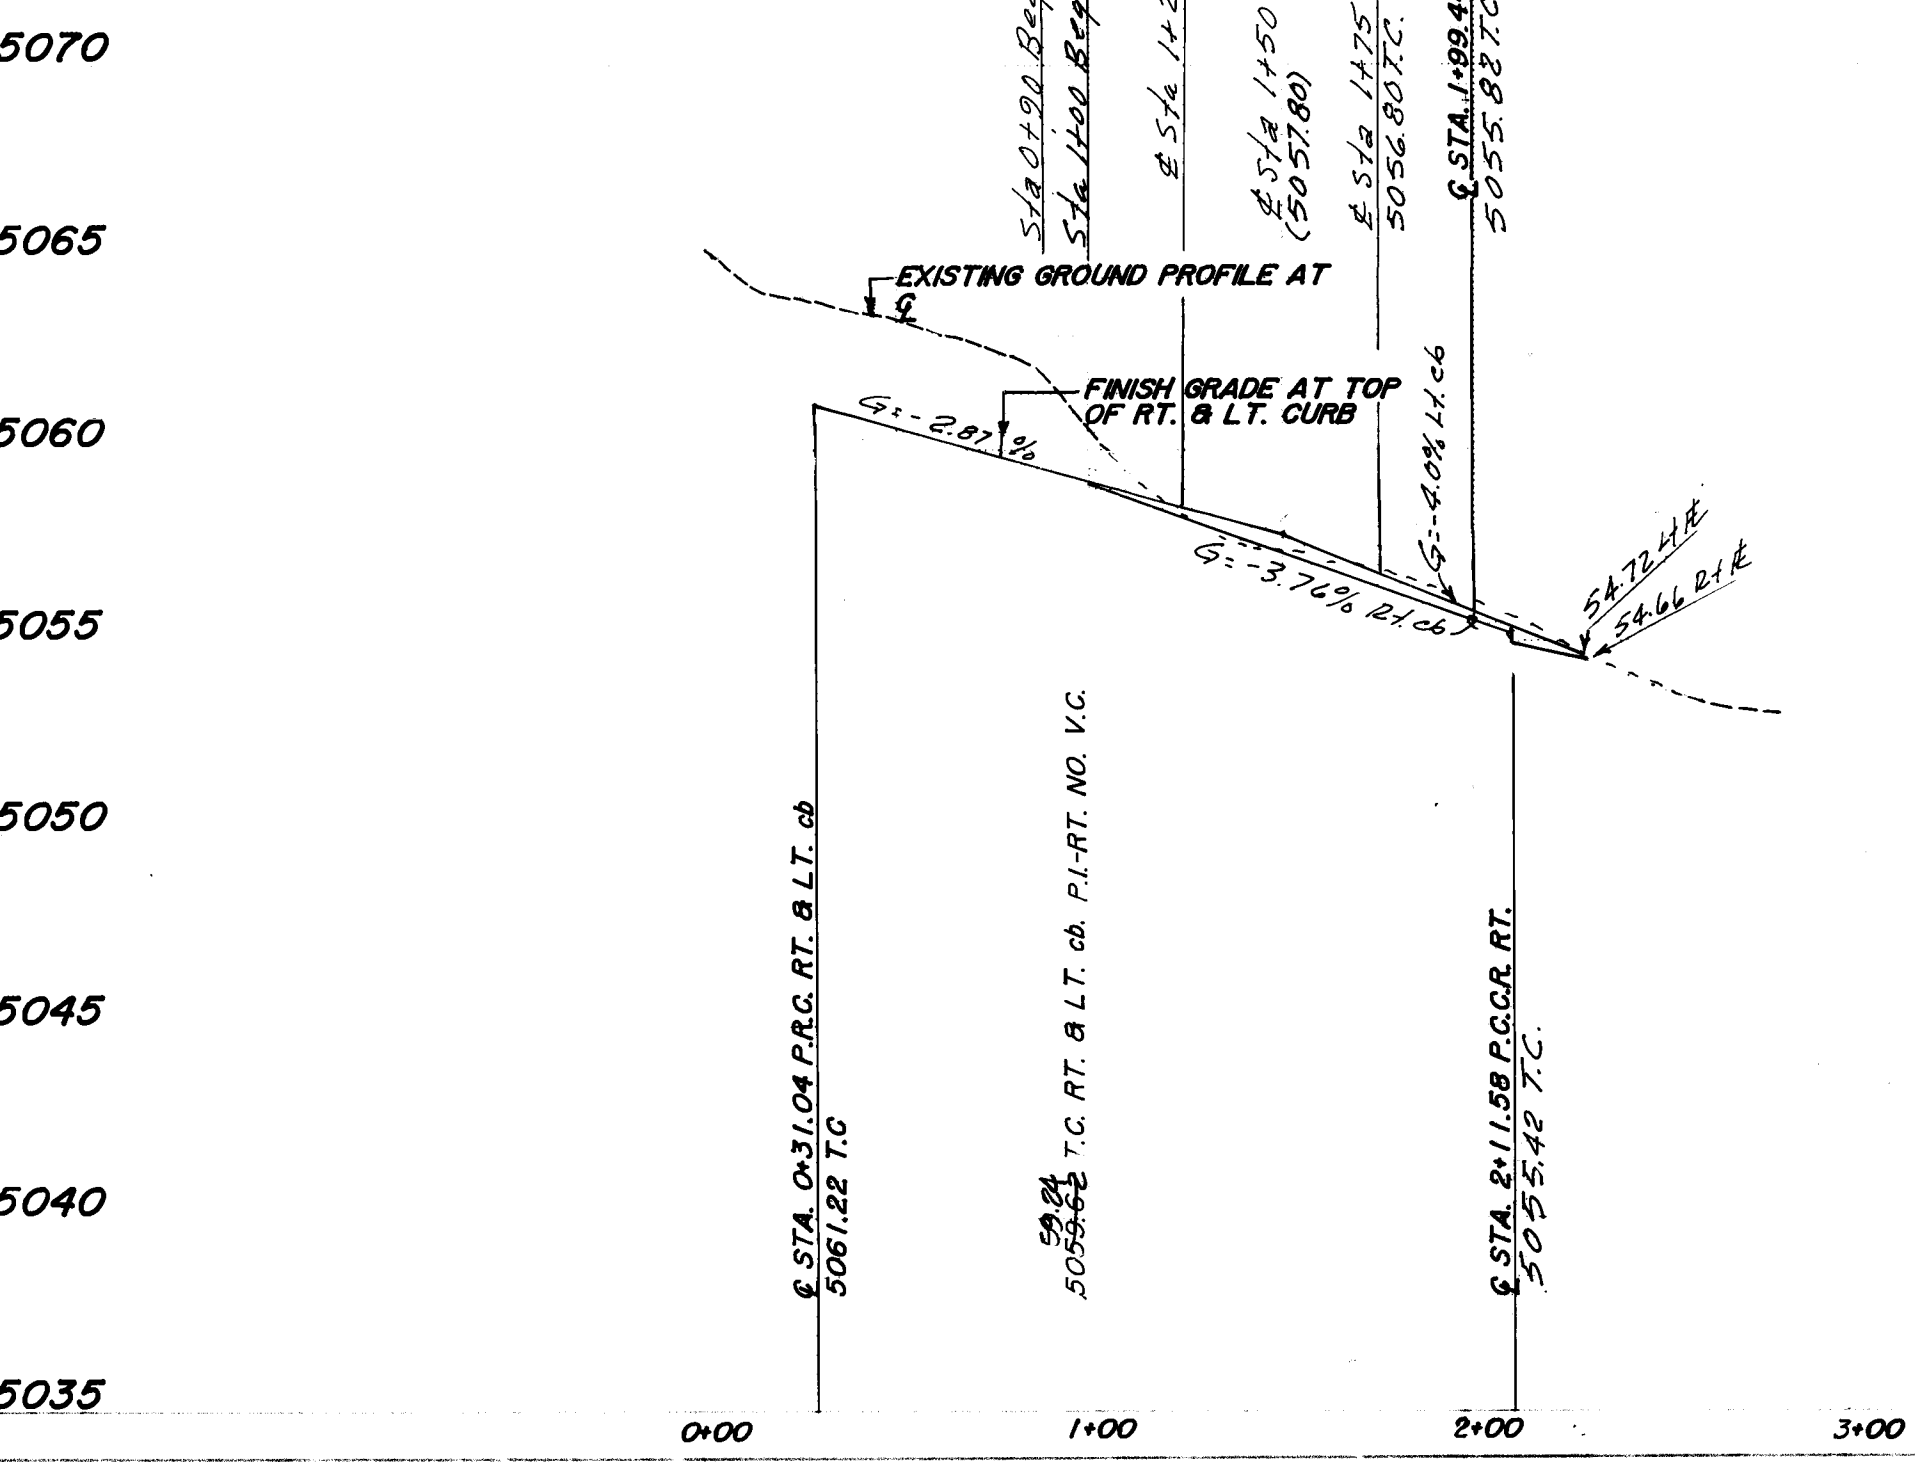


NOTE:
Santalina Dr. will have standard
cbs & r, Spanish Broom, Hillspire
Mountable Cb.

RECORD DRAWING


The improvements shown on this drawing have been as-built in accordance with field surveys performed by Espey, Houston and Construction and Manually accomplished as of this date, to the best of my knowledge and belief.

William F. Coleman
P.E. 5945

Date

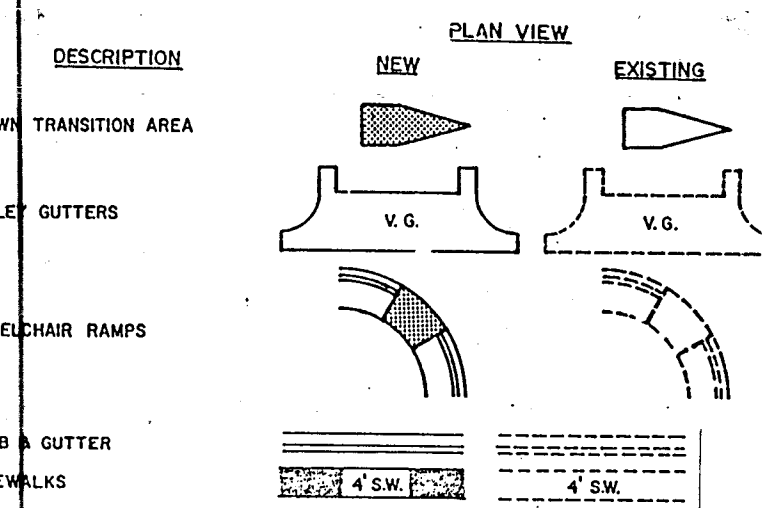

CITY OF ALBUQUERQUE MUNICIPAL DEVELOPMENT DEPARTMENT ENGINEERING DIVISION					
TITLE PRAIRIE RIDGE UNIT II PAVING SPANISH BROOM COURT & HILLSPIRE COURT					
APPROVALS	ENGINEER	DATE	APPROVALS	ENGINEER	DATE
City Engineer	10/21/86	10/21/86	10/21/86	10/21/86	10/21/86
ACE Design	10/21/86	10/21/86	10/21/86	10/21/86	10/21/86
ACE Hydrology	10/21/86	10/21/86	10/21/86	10/21/86	10/21/86
DRAWING NO 3042		MAP NO E-12-Z		SHEET 14 OF 23	

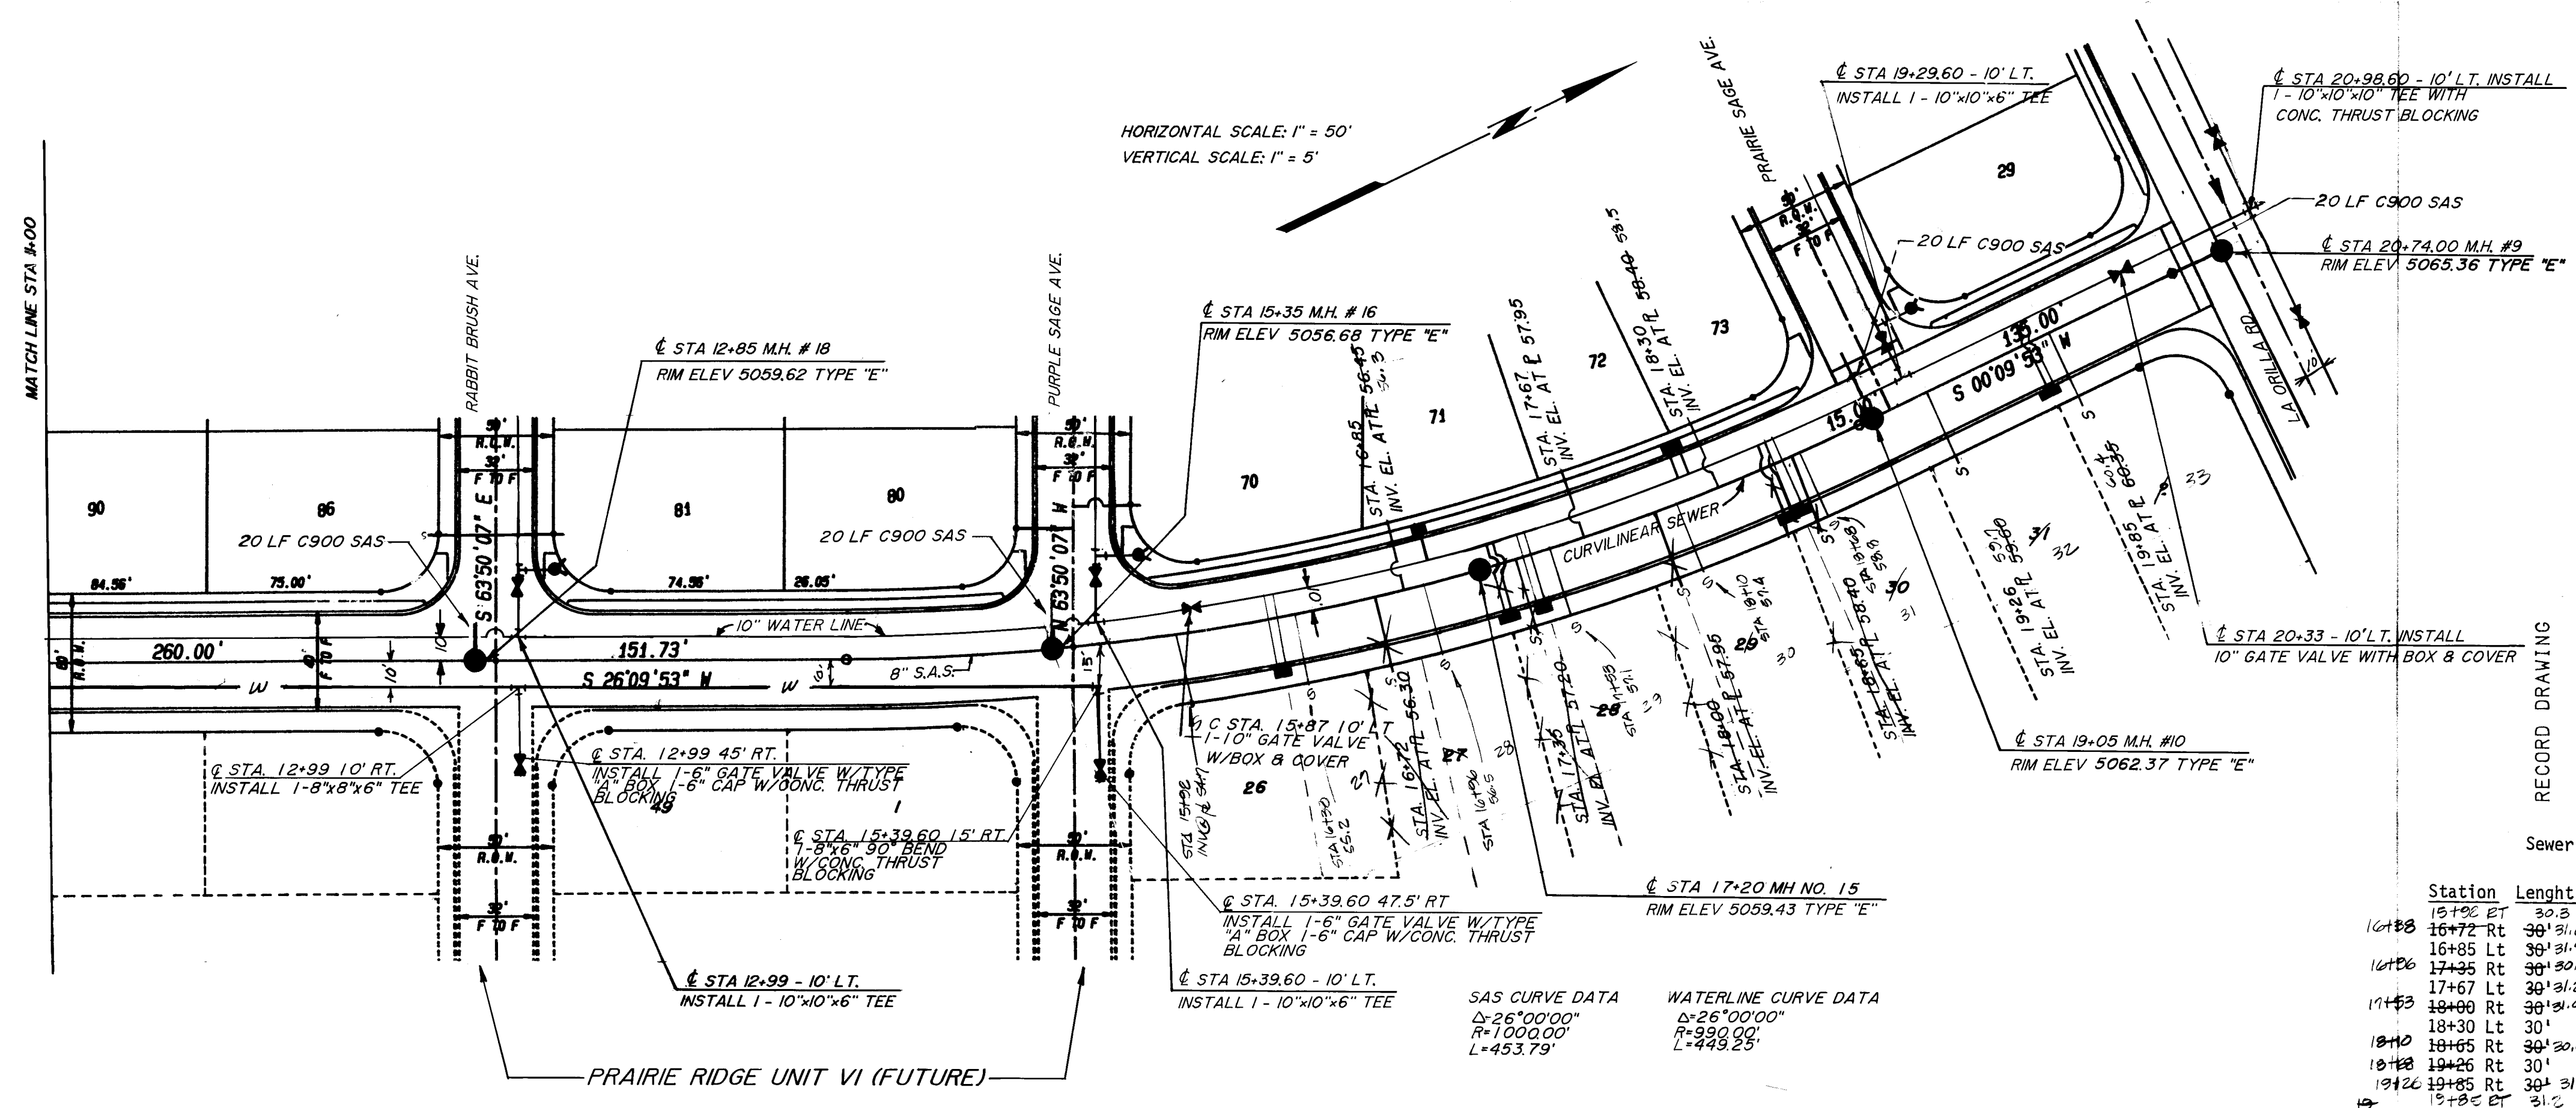

HORIZONTAL SCALE: 1" = 50'
VERTICAL SCALE: 1" = 5'

The improvements shown on this drawing have been as-built in accordance with field surveys performed by Espey, Huston and Associates, Inc. and information provided by Construction Associates, Inc. (contractors) to reflect construction actually accomplished as of this date, to the best of my knowledge and belief.

William F. Coleman P.E. 5645
11/1/87
Date


Sewer Service Connection

Station	Length	Mainline Invert	Sewer Ser. Invert @ P.I.	Lot
16+85	16+85	30' 31.0	56-30 50.2	26
16+85	16+85	30' 31.0	56-45 50.3	27
16+85	16+85	30' 31.0	56-45 50.3	28
16+85	16+85	30' 31.0	56-45 50.3	29
16+85	16+85	30' 31.0	56-45 50.3	30
16+85	16+85	30' 31.0	56-45 50.3	31
16+85	16+85	30' 31.0	56-45 50.3	32
16+85	16+85	30' 31.0	56-45 50.3	33
16+85	16+85	30' 31.0	56-45 50.3	34
16+85	16+85	30' 31.0	56-45 50.3	35

SAS CURVE DATA
Δ=26°00'00"
R=1000.00'
L=453.79'

WATERLINE CURVE DATA
Δ=26°00'00"
R=330.00'
L=449.25'

SANTALINA DRIVE

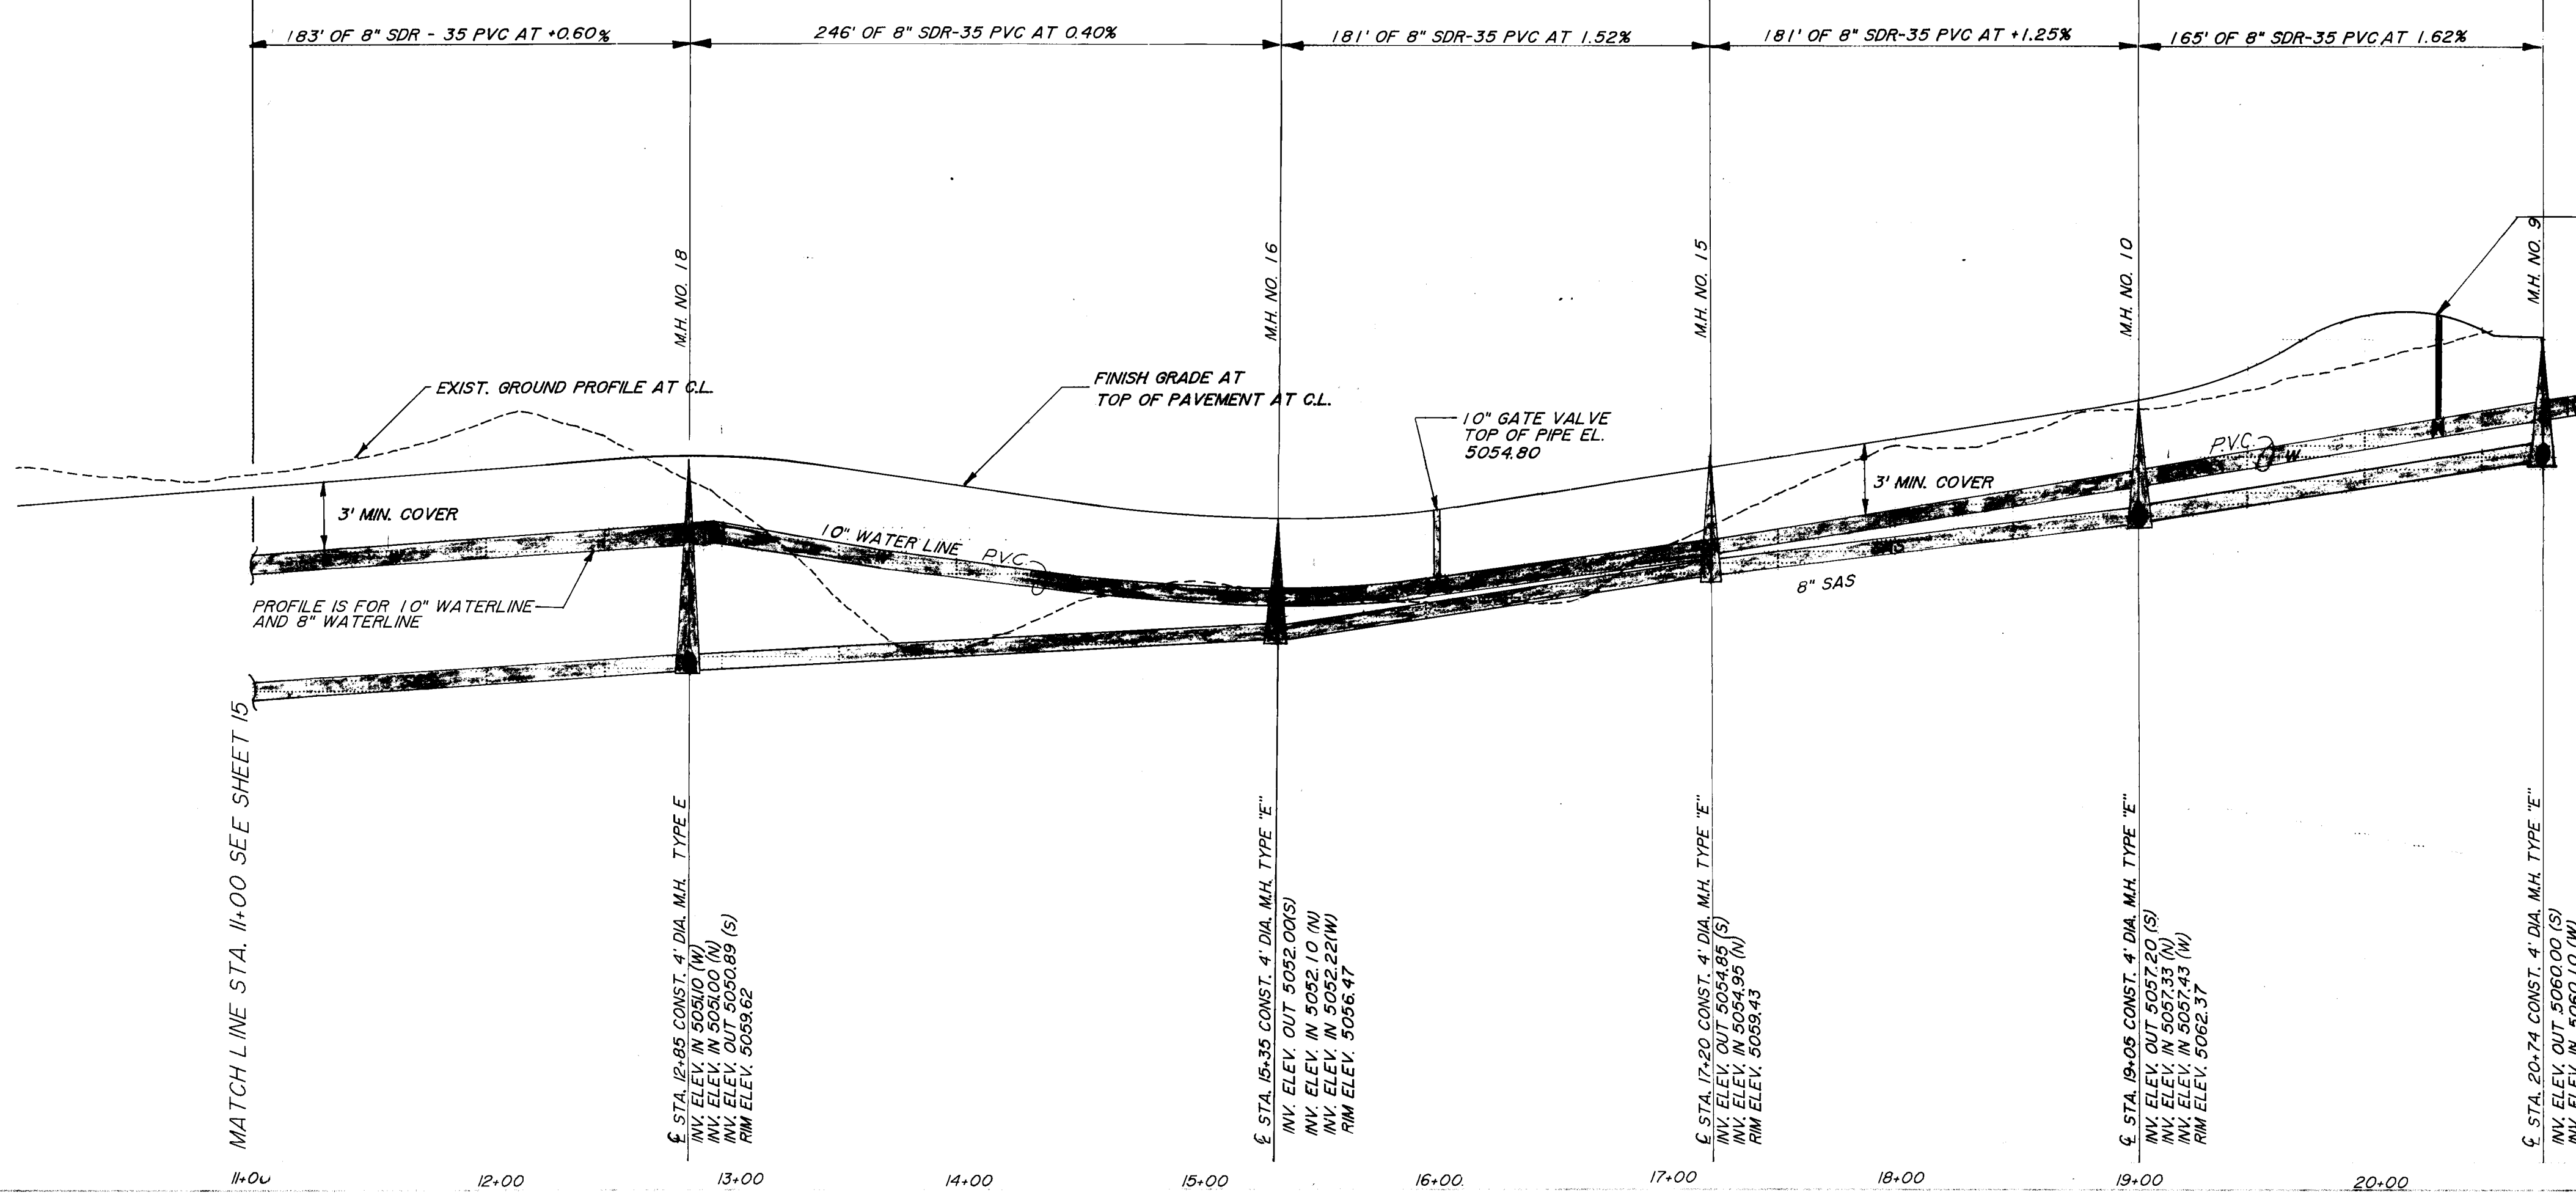

DESCRIPTION	NEW	EXISTING
SANITARY SEWER LINE	SAS	SAS
ENCASEMENT		
SANITARY SEWER MANHOLE		
SAS SERVICE CONNECTION		
STORM DRAIN LINE	SD	SD
STORM DRAIN MANHOLE		
STORM DRAIN INLETS		
WATER LINE	W	W
GATE VALVE		
BUTTERFLY VALVE		
FIRE HYDRANTS		
REDUCERS		
WATER SERVICE CONNECTION		
TEES		
CROSSES		
BENDS		
CAPS & PLUGS		
EXISTING GROUND		
TOP OF CURB		
SANITARY SEWER LINE	SAS	SAS
MANHOLES (ALL)		
STORM DRAIN LINES	SD	SD
WATER LINES	W	W
VERTICAL BENDS		


26 3042 1687

CITY OF ALBUQUERQUE
MUNICIPAL DEVELOPMENT DEPARTMENT
ENGINEERING DIVISION


TITLE: PRAIRIE RIDGE UNIT II UTILITIES
SANTALINA DRIVE 11+00 TO 20+98.60

APPROVAL	DESIGNER	DATE	APPROVAL	ENGINEER	DATE
City Engineer	10/1/87	10/1/87	10/1/87	10/1/87	10/1/87
A.E. Design	10/1/87	10/1/87	10/1/87	10/1/87	10/1/87
A.E. Hydrology	10/1/87	10/1/87	10/1/87	10/1/87	10/1/87

DRAWING NO. 3042 MAP NO. E-12-Z SHEET 16 OF 23

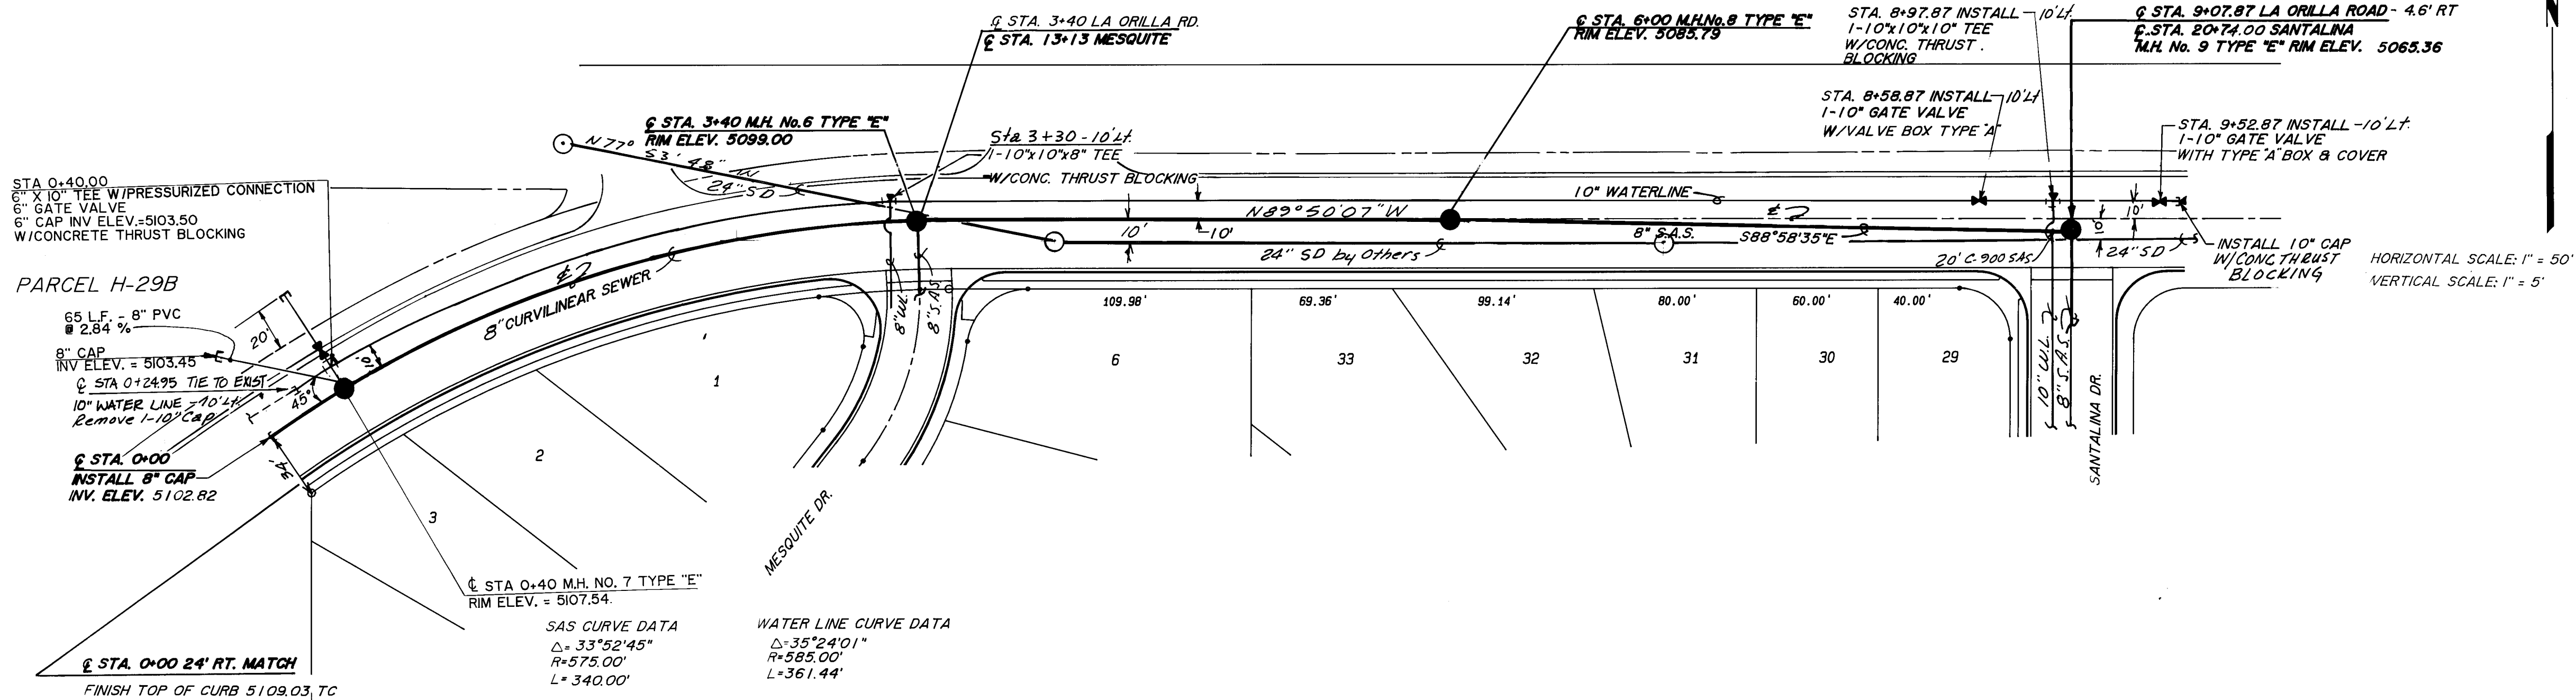

LA ORILLA ROAD

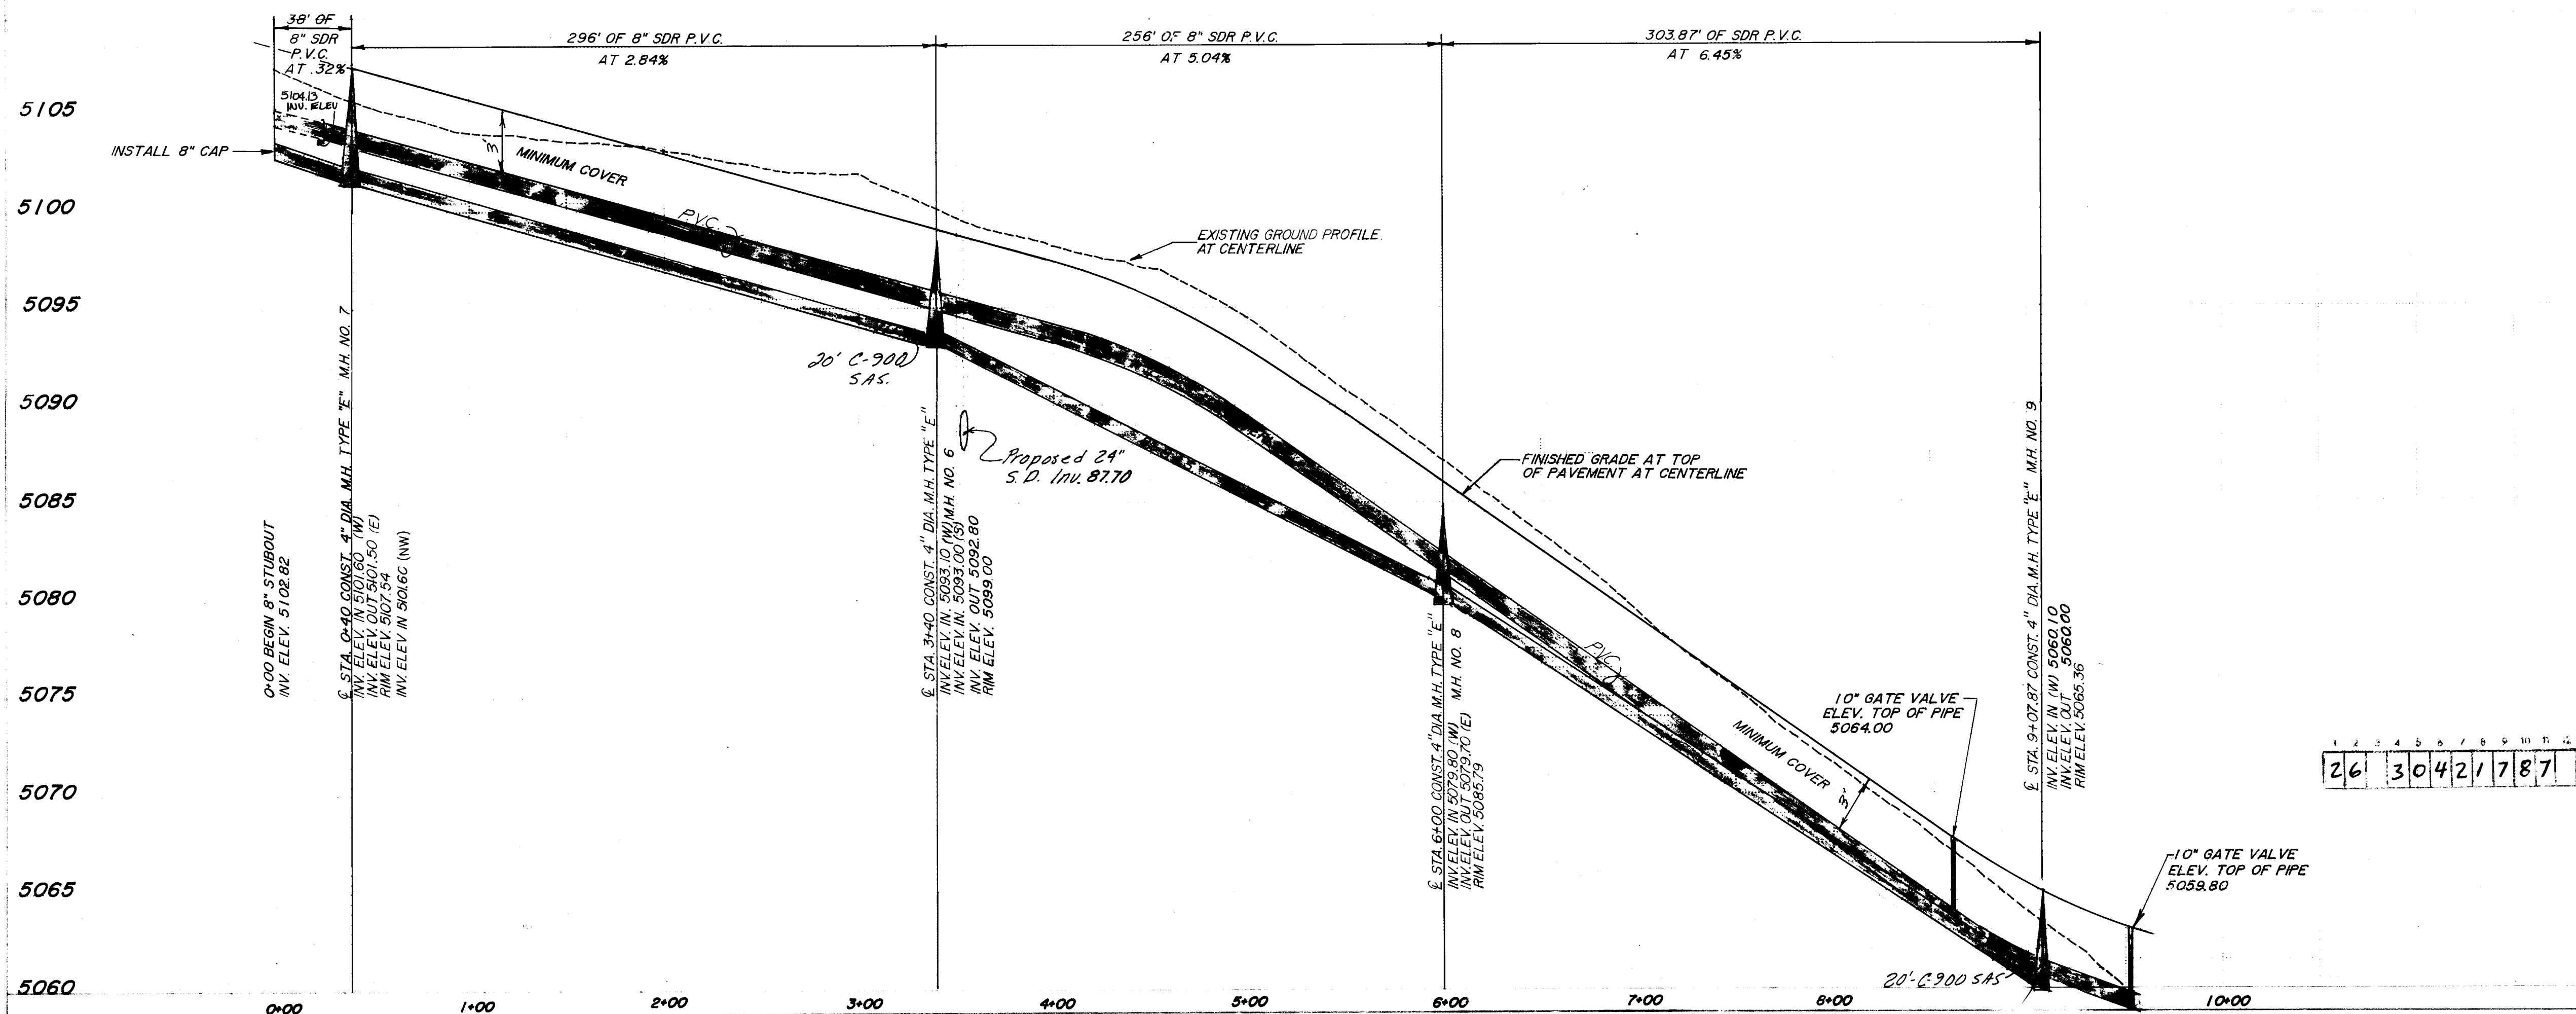

DESCRIPTION	NEW	EXISTING
SANITARY SEWER LINE	SAS	SAS
ENCASEMENT	ENC	ENC
SANITARY SEWER MANHOLE	SMH	SMH
SAS SERVICE CONNECTION	SSC	SSC
STORM DRAIN LINE	SD	SD
STORM DRAIN MANHOLE	SDMH	SDMH
STORM DRAIN INLETS	SDI	SDI
WATER LINE	W	W
GATE VALVE	GV	GV
BUTTERFLY VALVE	BV	BV
FIRE HYDRANTS	FH	FH
REDUCERS	R	R
WATER SERVICE CONNECTION	WSC	WSC
TEES	T	T
CROSSES	C	C
BENDS	B	B
CAPS & PLUGS	CP	CP
EXISTING GROUND	EG	EG
TOP OF CURB	TOC	TOC
SANITARY SEWER LINE	SAS	SAS
MANHOLES (ALL)	MH	MH
STORM DRAIN LINES	SD	SD
WATER LINES	W	W
VERTICAL BENDS	VB	VB

CITY OF ALBUQUERQUE
MUNICIPAL DEVELOPMENT DEPARTMENT
ENGINEERING DIVISION

TITLE **PRAIRIE RIDGE UNIT II UTILITIES
LA ORILLA ROAD**

APPROVALS	ENGINEER	DATE	APPROVALS	ENGINEER	DATE
City Engineer	Amador	10/21/06	Liquid Waste	W. H. H.	10/21/06
A.C.E. - Design	R. H. H.	10/21/06	Traffic	W. H. H.	10/21/06
A.C.E. - Hydrology	R. H. H.	10/21/06	Water	W. H. H.	10/21/06

DRAWING NO. **3042** MAP NO. **E-12-Z** SHEET **17** OF **23**

RECORD DRAWING

The improvements shown on this drawing have been as-built in accordance with field surveys performed by Espey, Huston and Associates, Inc. and information provided by Construction Management, Inc. (Contractors) to reflect construction actually accomplished as of this date, to the best of my knowledge and belief.

William F. Coleman
4/17/07
P.E. 5945

AS BUILT INFORMATION

DATE: 4/17/07

BY: William F. Coleman

DATE: 4/17/07

BY: William F. Coleman

DATE: 4/17/07

BY: William F. Coleman

DATE: 4/17/07

BY: William F. Coleman

DATE: 4/17/07


BY: William F. Coleman

DATE: 4/17/07

BY: William F. Coleman

DATE: 4/17/07

BY: William F. Coleman

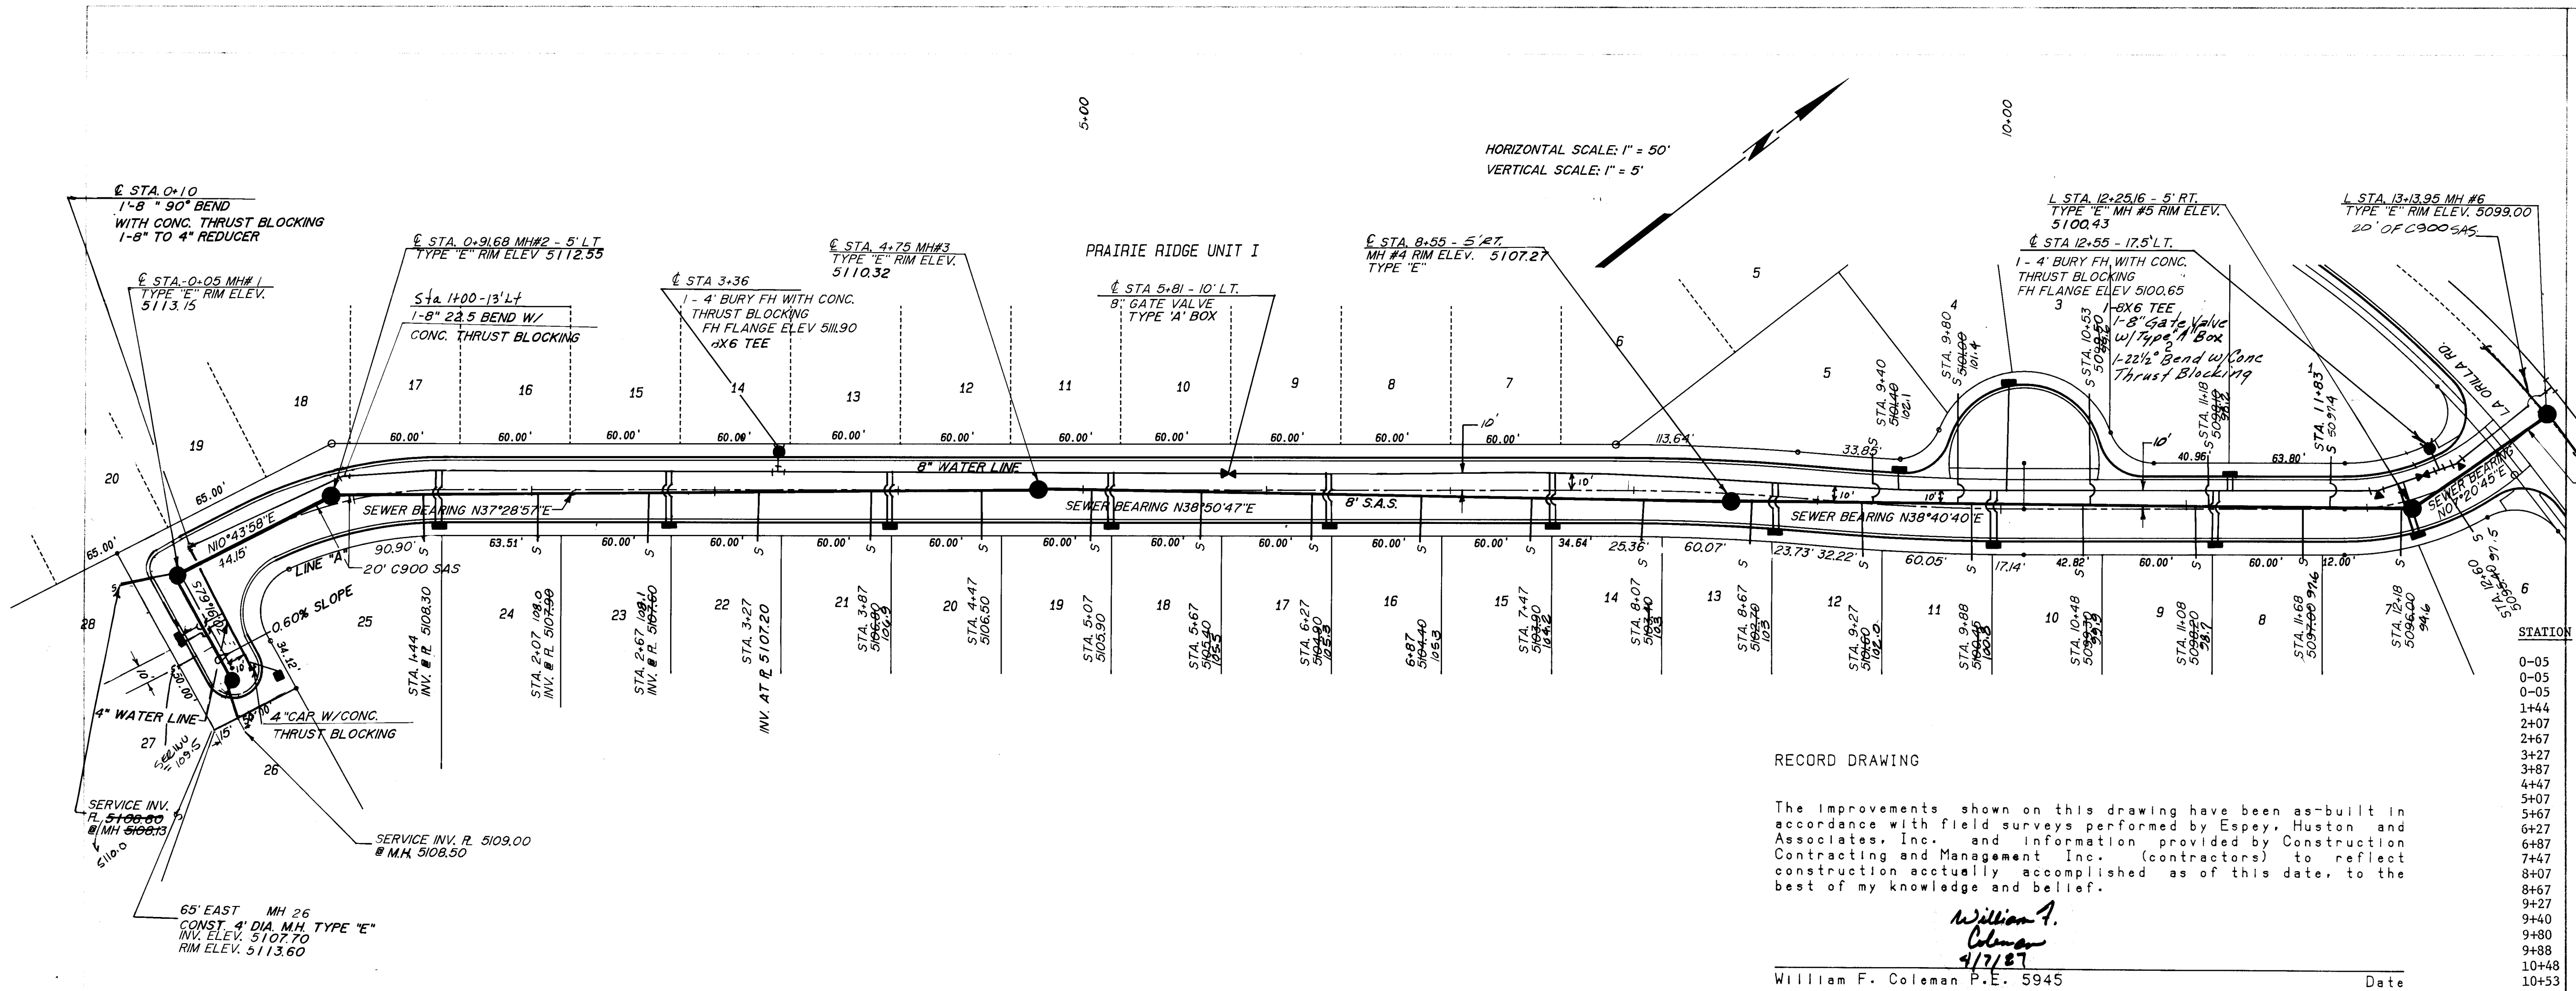


RECORD DRAWING

The improvements shown on this drawing have been as-built in accordance with field surveys performed by Espey, Huston and Associates, Inc. and information provided by Construction Contracting and Management Inc. (contractors) to reflect construction actually accomplished as of this date, to the best of my knowledge and belief.

William F. Coleman
4/1/87

William F. Coleman P.E. 5945 Date

MESQUITE DRIVE

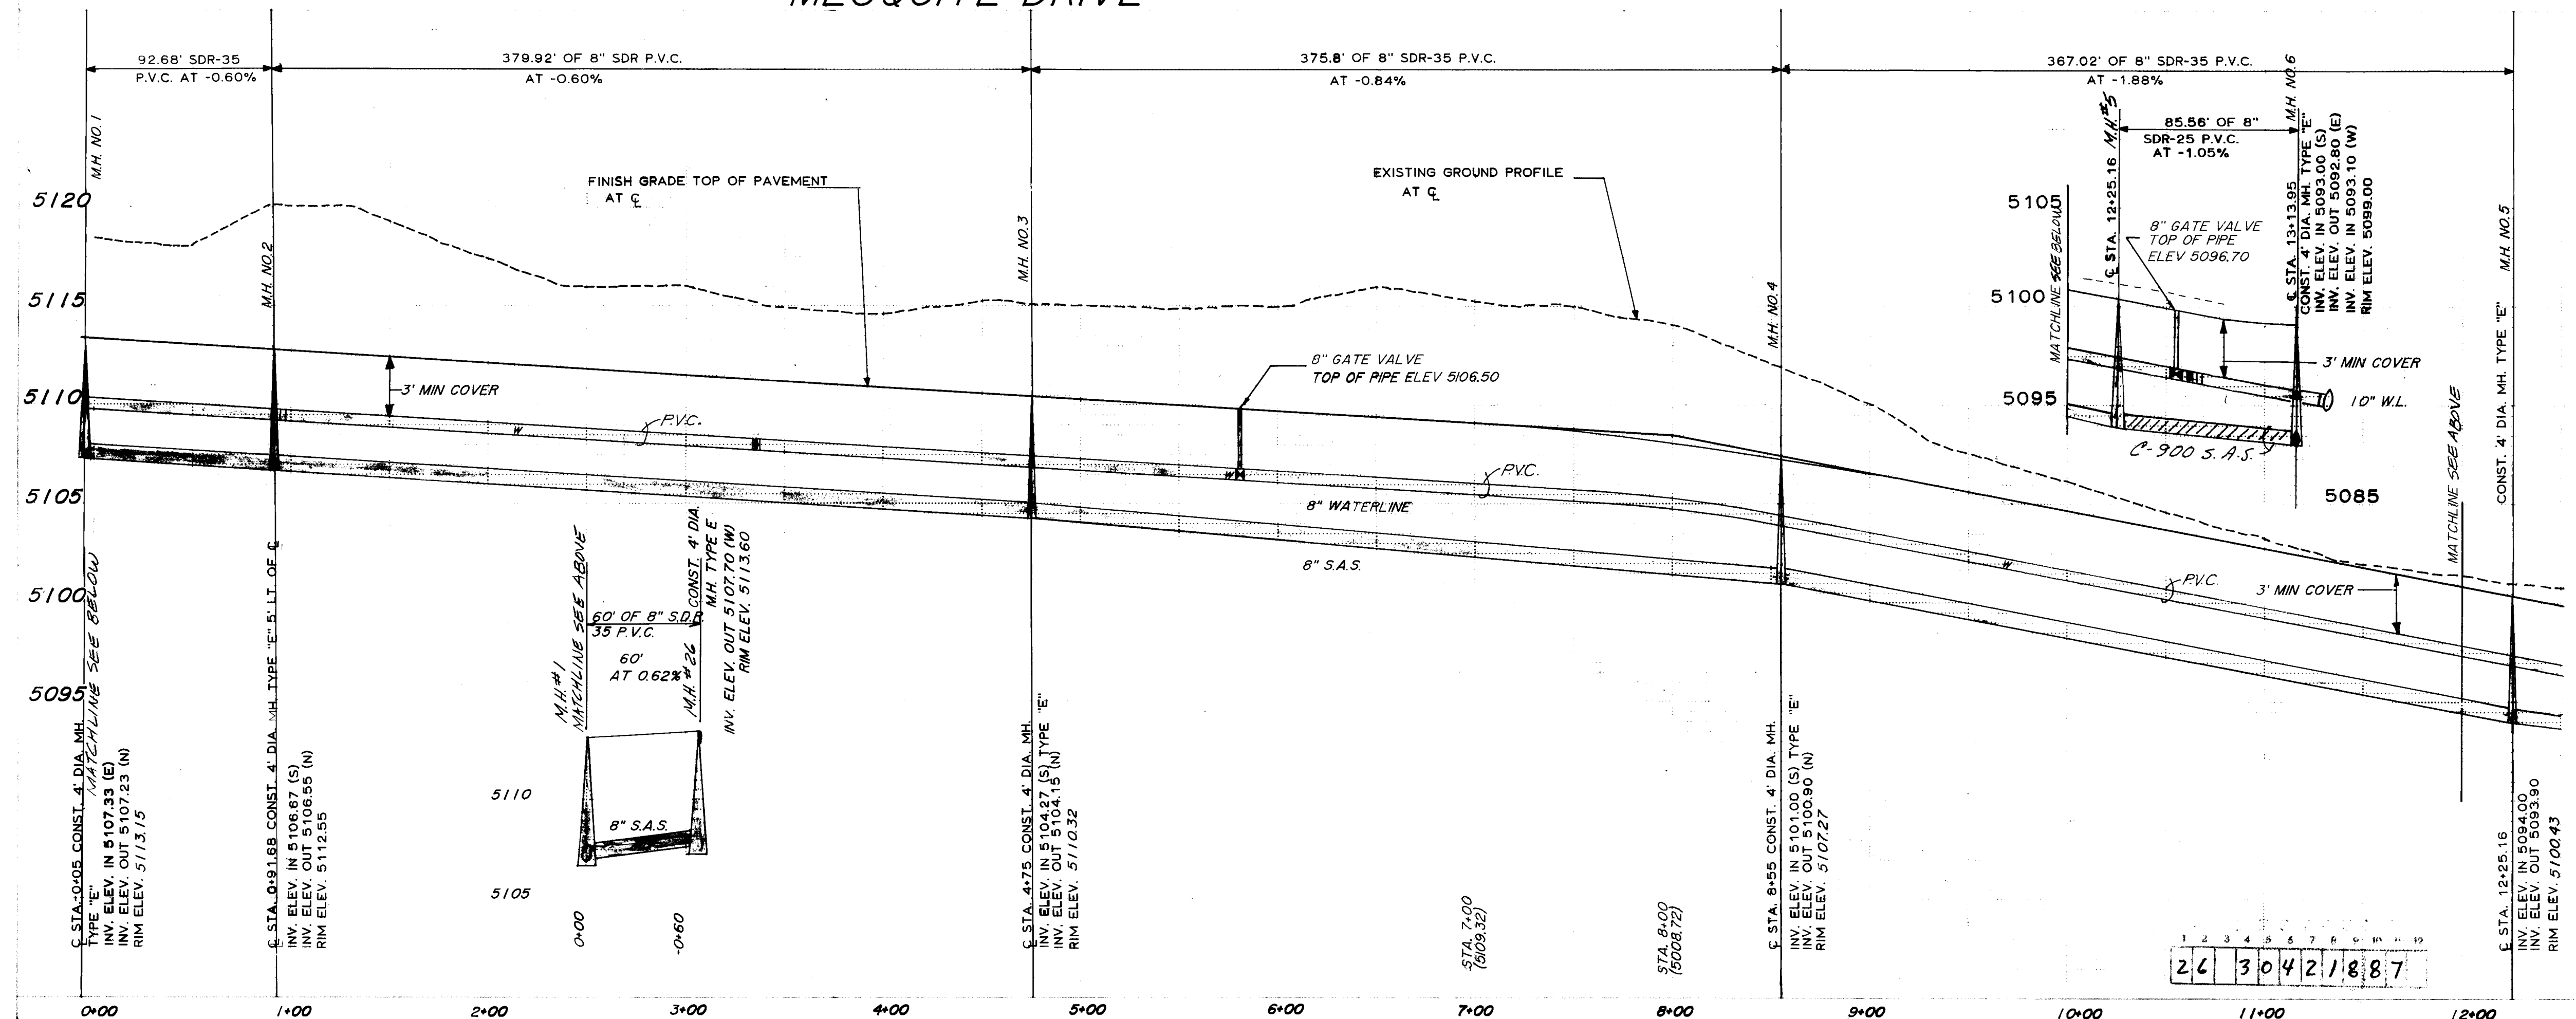

DESCRIPTION	NEW	EXISTING
SEWER LINE		
SEWER MANHOLE		
SEWER SERVICE CONNECTION		
STORM DRAIN LINE		
STORM DRAIN MANHOLE		
STORM DRAIN INLETS		
WATER LINE		
GATE VALVE		
BUTTERFLY VALVE		
FIRE HYDRANTS		
REDUCERS		
WATER SERVICE CONNECTION		
TIES		
CROSSES		
BENDS		
CAPS & PLUGS		
EXISTING GROUND		
TOP OF CURB		
SEWER MANHOLE		
MANHOLES (ALL)		
STORM DRAIN LINES		
WATER LINES		
VERTICAL BENDS		



CITY OF ALBUQUERQUE
MUNICIPAL DEVELOPMENT DEPARTMENT
ENGINEERING DIVISION

TITLE **PRAIRIE RIDGE UNIT II UTILITIES
MESQUITE DRIVE**

APPROVALS	ENGINEER	DATE	APPROVALS	ENGINEER	DATE
City Engineer	<i>William F. Coleman</i>	10/2/86	liquid Waste	<i>William F. Coleman</i>	10/2/86
A.C.E. Design	<i>William F. Coleman</i>	10/2/86	Traffic	<i>William F. Coleman</i>	10/2/86
A.C.E. Hydrology	<i>William F. Coleman</i>	10/2/86	Water	<i>William F. Coleman</i>	10/2/86

DESIGNED BY *William F. Coleman*
DRAWN BY *William F. Coleman*
CHECKED BY *William F. Coleman*

DATE 9-9-86
DATE 10-2-86
DATE 10-13-86

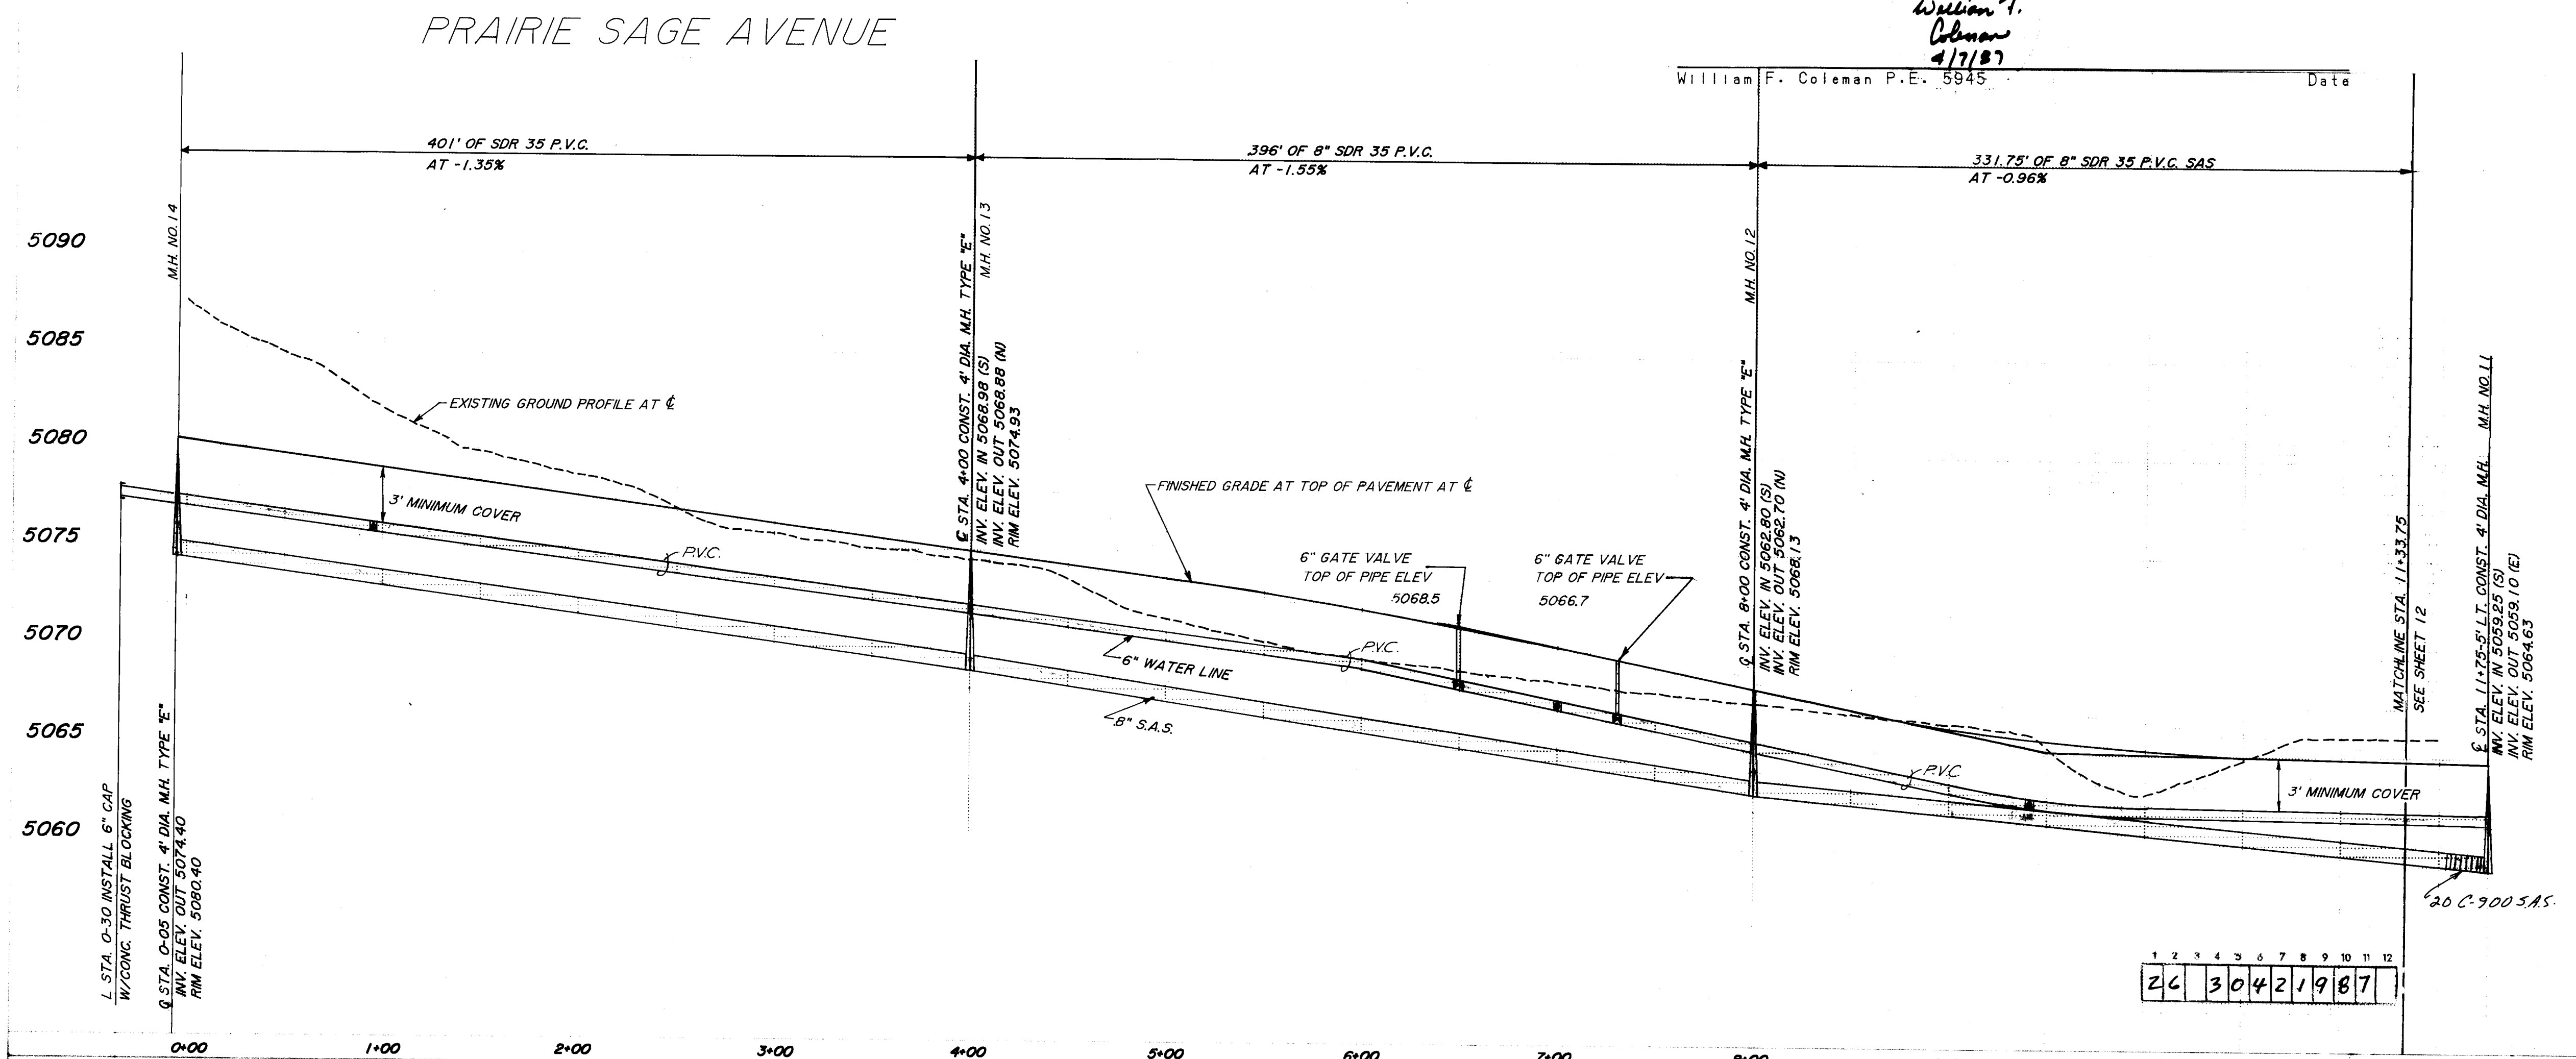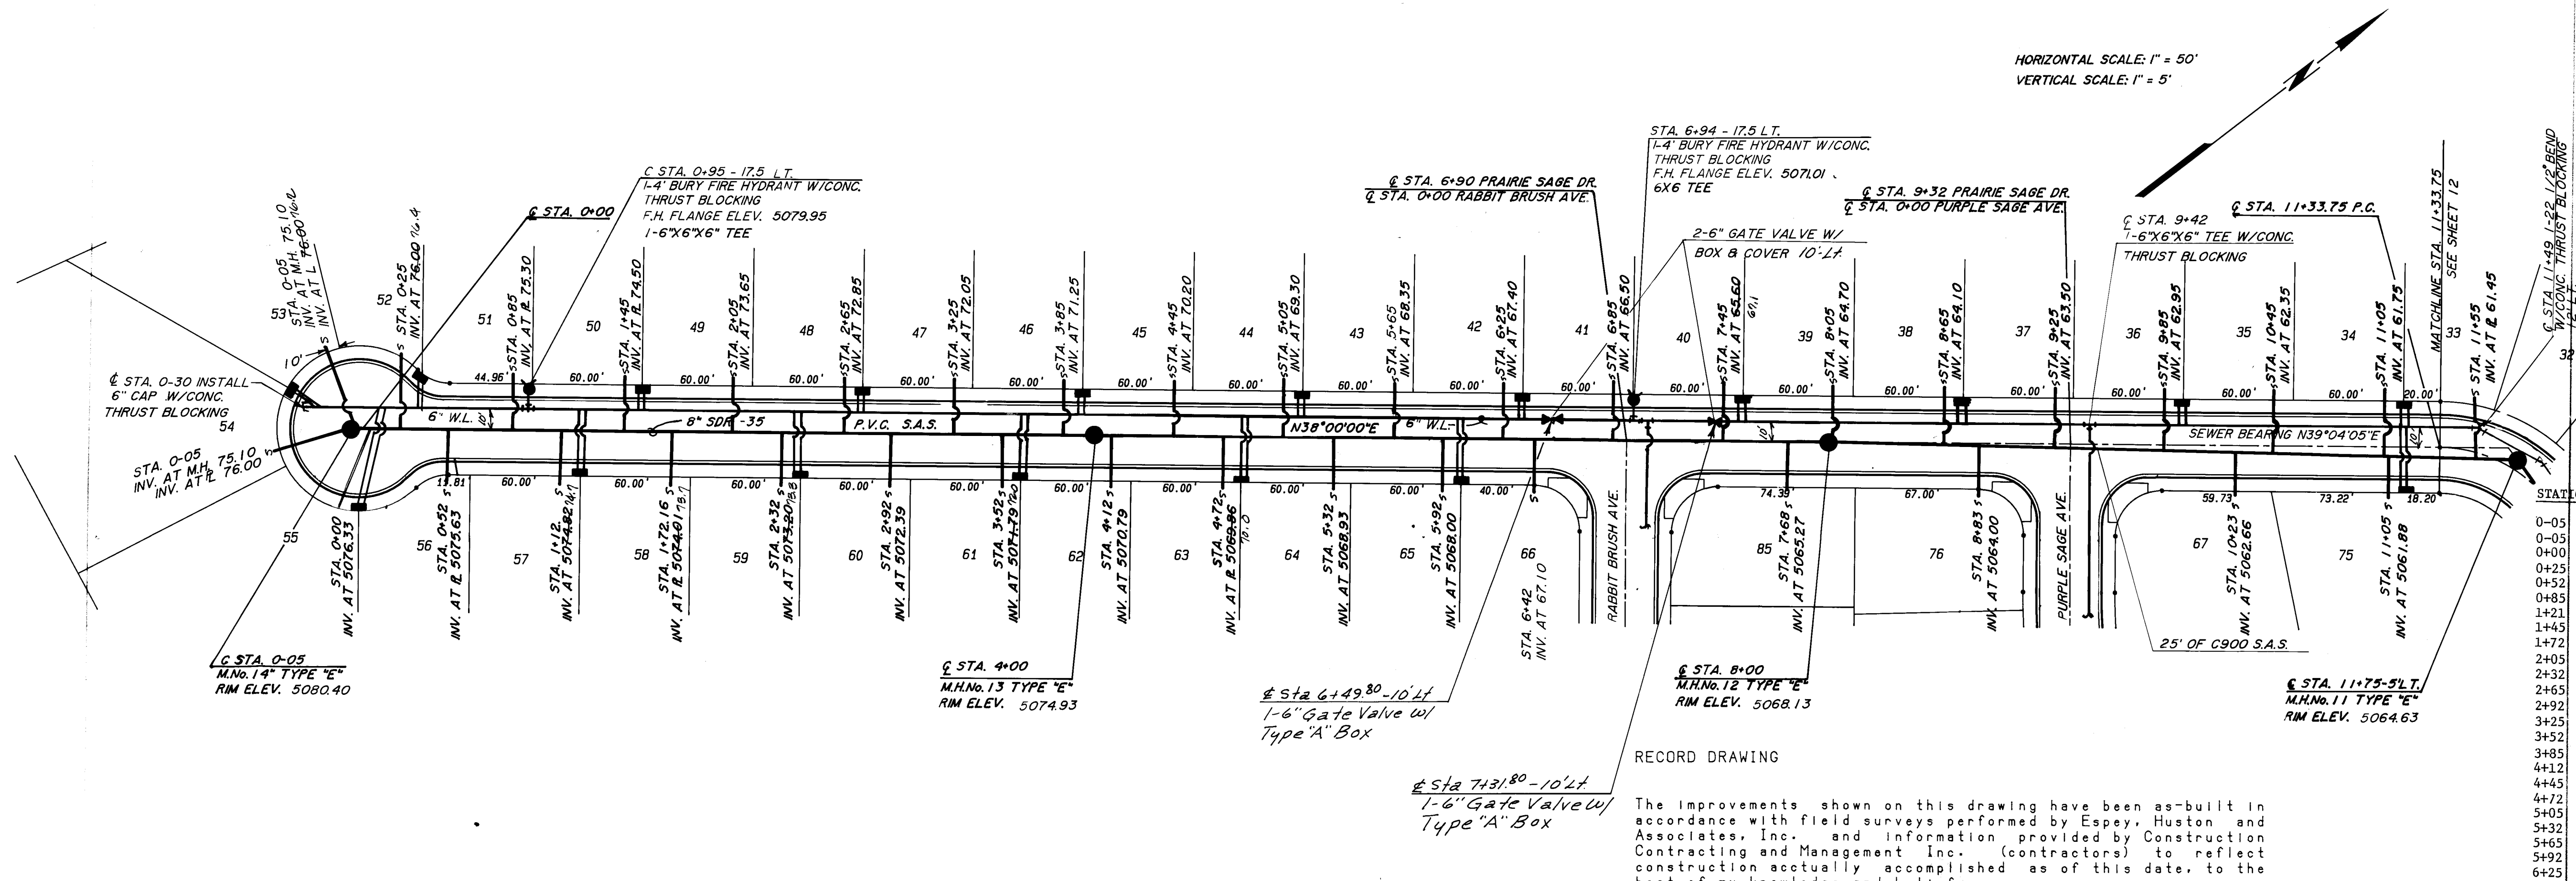


SEWER SERVICE CONNECTION				
STATION	LOCATION	LENGTH	MAINLINE INVERT	SEWER SER. INVERT @ P.I.
0-05	M.H.	40'	5075.10	5076.00
0-05	M.H.	40'	5075.10	5076.00
0+00	RT	40'	5074.35	5076.33
0+25	LT	40'	5074.02	5076.00
0+52	RT	25'	5073.65	5075.63
0+85	LT	25'	5073.21	5075.30
1+21	RT	25'	5072.72	5074.82
1+45	LT	25'	5072.40	5074.50
1+72	RT	25'	5072.04	5074.01
2+05	LT	25'	5071.59	5073.65
2+32	RT	25'	5071.22	5073.28
2+65	LT	25'	5070.78	5072.85
2+92	RT	25'	5070.41	5072.39
3+25	LT	25'	5069.97	5072.05
3+52	RT	25'	5069.60	5071.70
3+85	LT	25'	5069.16	5071.25
4+12	RT	25'	5068.69	5070.79
4+45	LT	25'	5068.18	5070.20
4+72	RT	25'	5067.76	5069.86
5+05	LT	25'	5067.25	5069.30
5+32	RT	25'	5066.83	5068.93
5+65	LT	25'	5066.32	5068.35
5+92	RT	25'	5065.90	5068.00
6+25	LT	25'	5065.39	5067.40
6+42	RT	25'	5064.96	5066.97
6+85	LT	25'	5064.46	5066.30
7+45	LT	25'	5063.53	5065.60
7+68	RT	25'	5063.18	5065.27
8+05	LT	25'	5062.67	5064.70
8+65	LT	25'	5062.09	5064.10
8+83	RT	25'	5061.92	5064.00
9+25	LT	25'	5061.52	5063.50
9+85	LT	25'	5060.94	5062.95
10+23	RT	25'	5060.38	5062.66
10+44	LT	25'	5060.37	5062.35
11+01	RT/WT	25'	5059.79	5061.88
11+53	LT	25'	5059.31	5061.45

DESCRIPTION		NEW	EXISTING
SANITARY SEWER LINE		---	---
ENCASMENT		---	---
SANITARY SEWER MANHOLE		---	---
SAS SERVICE CONNECTION		---	---
STORM DRAIN LINE		---	---
STORM DRAIN MANHOLE		---	---
STORM DRAIN INLETS		---	---
WATER LINE		---	---
GATE VALVE		---	---
BUTTERFLY VALVE		---	---
FIRE HYDRANTS		---	---
REDUCERS		---	---
WATER SERVICE CONNECTION		---	---
TEES		---	---
CROSSES		---	---
CAPS & PLUGS		---	---
EXISTING GROUND		---	---
TOP OF CURB		---	---
SANITARY SEWER LINE		---	---
MANHOLES (ALL)		---	---
STORM DRAIN LINES		---	---
WATER LINES		---	---
VERTICAL BENDS		---	---


REVISIONS		NO.	DATE	REMARKS
1	DESIGN	10/2/86	10/2/86	10/2/86
2	DESIGN	10/2/86	10/2/86	10/2/86
3	DESIGN	10/2/86	10/2/86	10/2/86

CITY OF ALBUQUERQUE MUNICIPAL DEVELOPMENT DEPARTMENT ENGINEERING DIVISION	
TITLE PRAIRIE RIDGE UNIT II UTILITIES PRAIRIE SAGE AVENUE	
APPROVALS City Engineer A.C.E. Design A.C.E. Hydrology	ENGINEER [Signature] [Signature] [Signature]
DATE 10/2/86 10/2/86 10/2/86	DATE 10/2/86 10/2/86 10/2/86
APPROVALS Liquid Waste Traffic Water	ENGINEER [Signature] [Signature] [Signature]
DATE 10/2/86 10/2/86 10/2/86	DATE 10/2/86 10/2/86 10/2/86
DRAWING NO. 3042	MAP NO. E-12-Z SHEET 19 OF 23

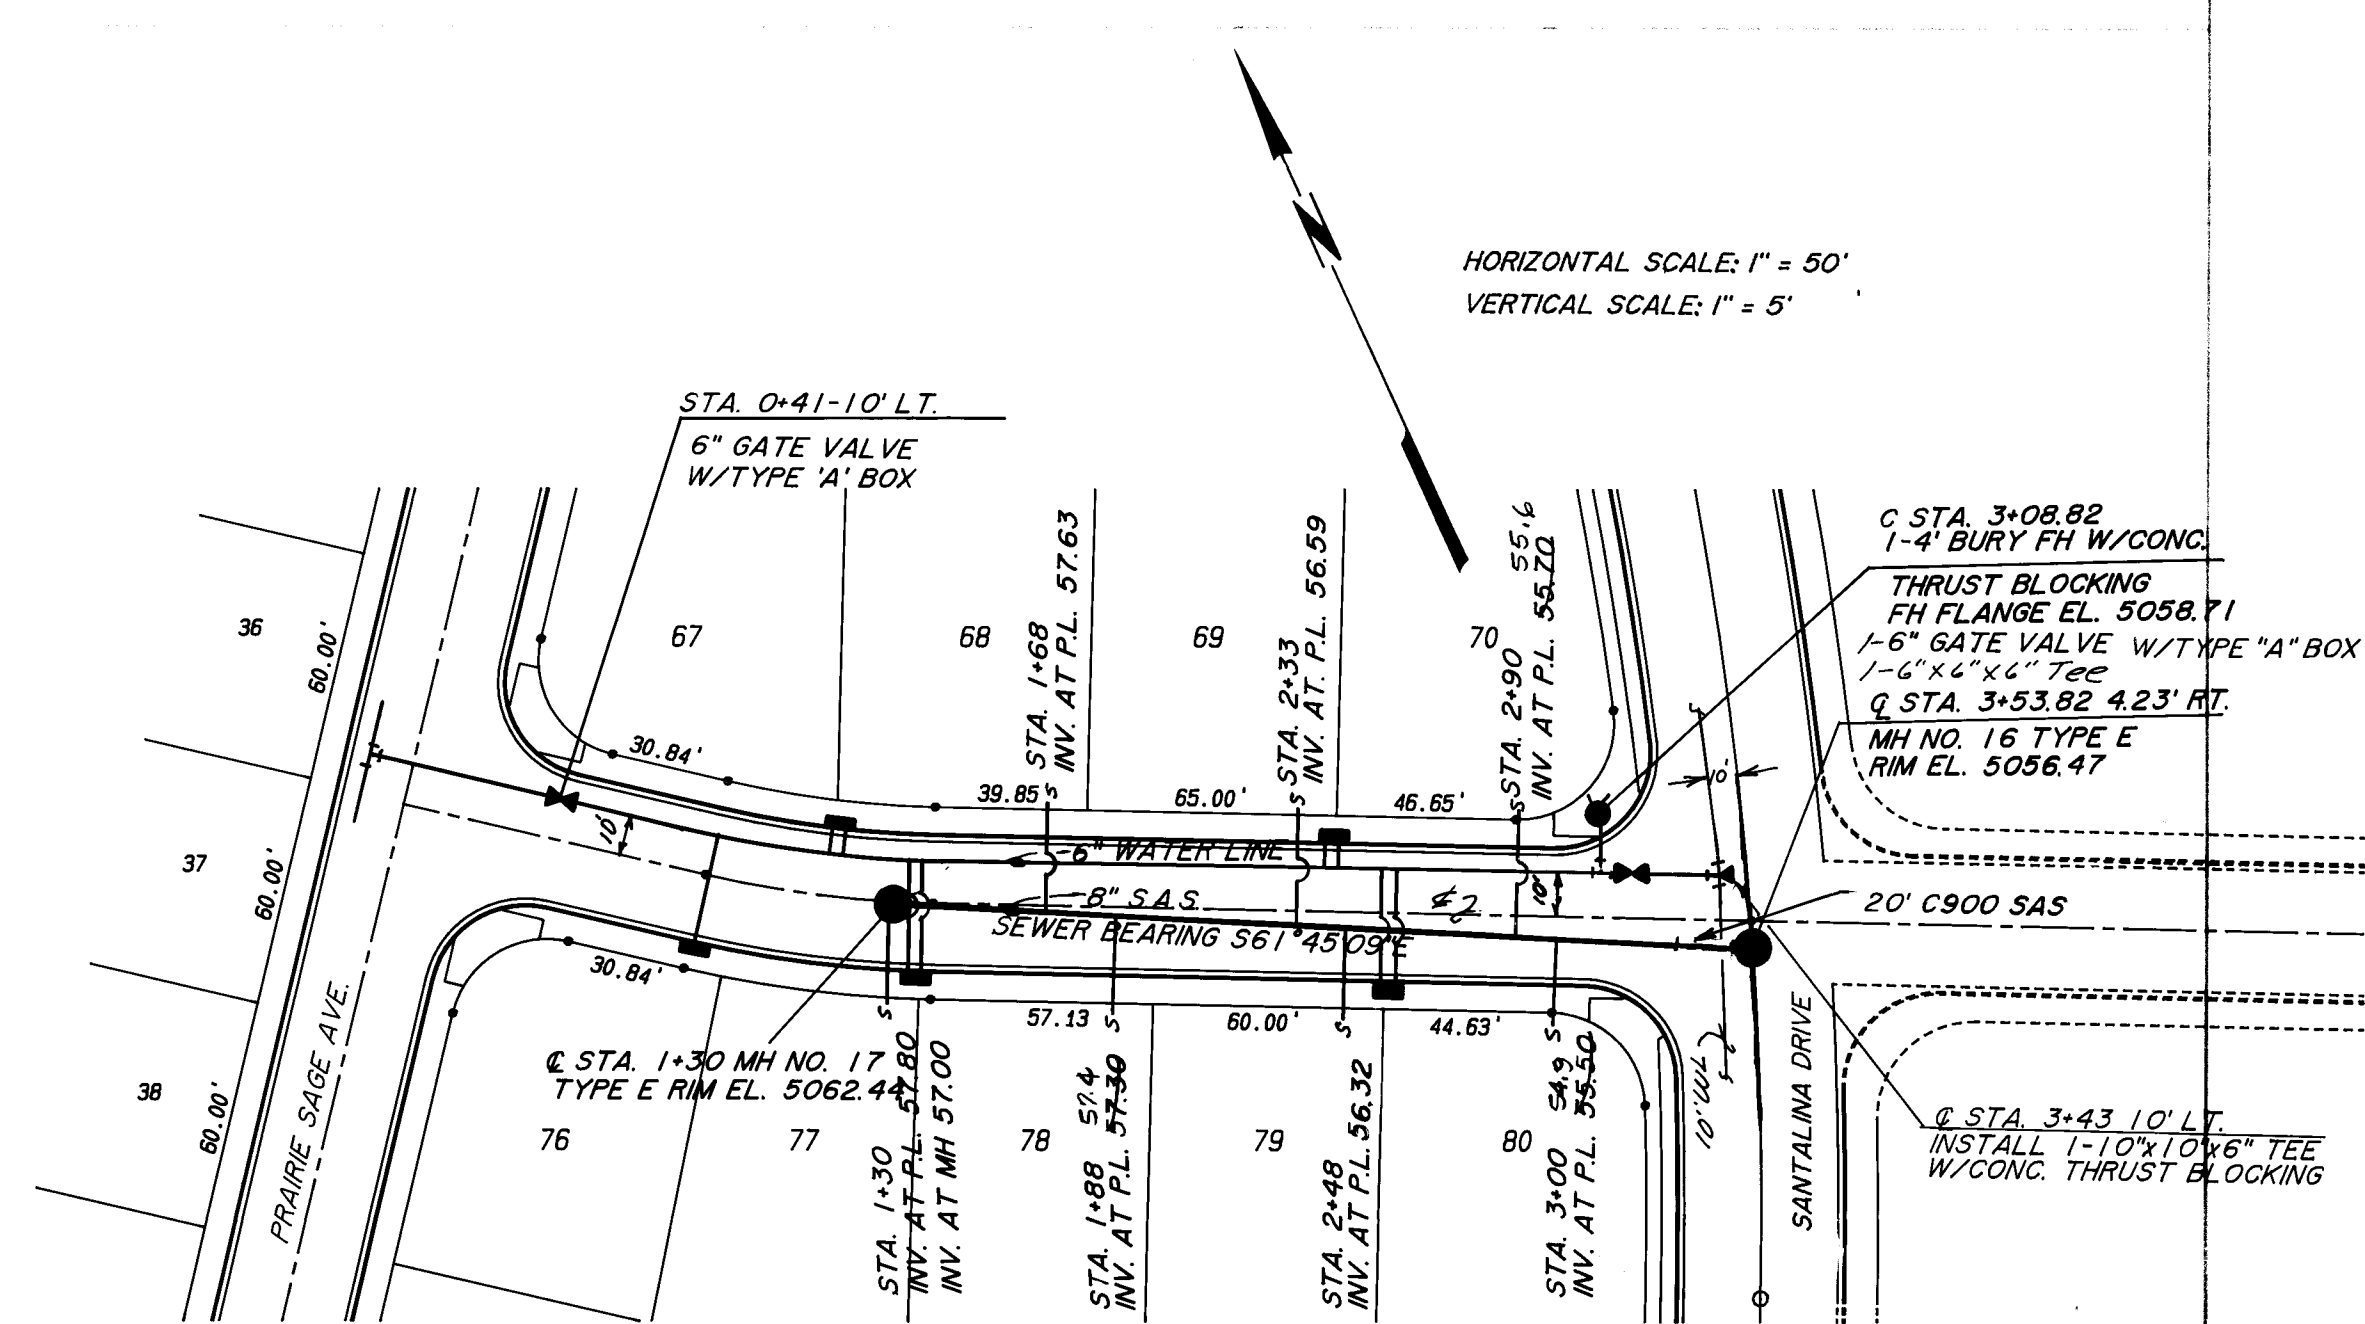


STATION	LOCATION	LENGTH	MAINLINE	SEWER SER.	LOT
			INVERT	INVERT @ P1	
1+30	M.H.	25'	5057.00	5057.80	77
1+68	RT	25' 27	5055.60	5057.40 5048	68
1+88	RT	25'	5055.28	5057.30 5048	78
2+33	LT	25' 30.3	5054.56	5056.59	69
2+48	RT	25' 21.7	5054.32	5056.32	79
2+90	LT	30' 21.3	5053.66	5055.70 5056.6	70
3+00	RT	31' 20.8	5051.50	5055.50 5054.0	80

	BENCH MARKS	AS BUILT INFORMATION	Date
P.L. LOT	G.L.O. BRASS CAP FOR SECTIONS 23, 24, 25 AND 26, T1N, R2E, N.M.P.M. LOCATED WITHIN RIVERVIEW PARCEL H-28 APPROX- IMATELY 250 FEET NORTH OF THE CENTER- LINE OF GOLF COURSE ROAD AND LA ORILLA ROAD, N.W. ELEVATION = 512.83.	N.T.A. "OCM" A. 84/87 B. 84/87 C. 84/87 D. 84/87 E. 84/87 F. 84/87 G. 84/87 H. 84/87 I. 84/87 J. 84/87 K. 84/87 L. 84/87 M. 84/87 N. 84/87 O. 84/87 P. 84/87 Q. 84/87 R. 84/87 S. 84/87 T. 84/87 U. 84/87 V. 84/87 W. 84/87 X. 84/87 Y. 84/87 Z. 84/87 AA. 84/87 AB. 84/87 AC. 84/87 AD. 84/87 AE. 84/87 AF. 84/87 AG. 84/87 AH. 84/87 AI. 84/87 AJ. 84/87 AK. 84/87 AL. 84/87 AM. 84/87 AN. 84/87 AO. 84/87 AP. 84/87 AQ. 84/87 AR. 84/87 AS. 84/87 AT. 84/87 AU. 84/87 AV. 84/87 AW. 84/87 AX. 84/87 AY. 84/87 AZ. 84/87 BA. 84/87 BB. 84/87 BC. 84/87 BD. 84/87 BE. 84/87 BF. 84/87 BG. 84/87 BH. 84/87 BI. 84/87 BJ. 84/87 BK. 84/87 BL. 84/87 BM. 84/87 BN. 84/87 BO. 84/87 BP. 84/87 BQ. 84/87 BR. 84/87 BS. 84/87 BT. 84/87 BU. 84/87 BV. 84/87 BW. 84/87 BX. 84/87 BY. 84/87 BZ. 84/87 CA. 84/87 CB. 84/87 CC. 84/87 CD. 84/87 CE. 84/87 CF. 84/87 CG. 84/87 CH. 84/87 CI. 84/87 CJ. 84/87 CK. 84/87 CL. 84/87 CM. 84/87 CN. 84/87 CO. 84/87 CP. 84/87 CQ. 84/87 CR. 84/87 CS. 84/87 CT. 84/87 CU. 84/87 CV. 84/87 CW. 84/87 84/87 MF. 84/87 MG. 84/87 MH. 84/87 MI. 84/87 MJ. 84/87 MK. 84/87 ML. 84/87 MN. 84/87 MO. 84/87 MP. 84/87 MQ. 84/87 MR. 84/87 MS. 84/87 MT. 84/87 MU. 84/87 MV. 84/87 MW. 84/87 MX. 84/87 MY. 84/87 MZ. 84/87 NA. 84/87 NB. 84/87 NC. 84/87 ND. 84/87 NE. 84/87 NF. 84/87 NG. 84/87 NH. 84/87 NI. 84/87 NJ. 84/87 NK. 84/87 NL. 84/87 NM. 84/87 NN. 84/87 NO. 84/87 NP. 84/87 NQ. 84/87 NR. 84/87 NS. 84/87 NT. 84/87 NU. 84/87 NV. 84/87 NW. 84/87 NX. 84/87 NY. 84/8	

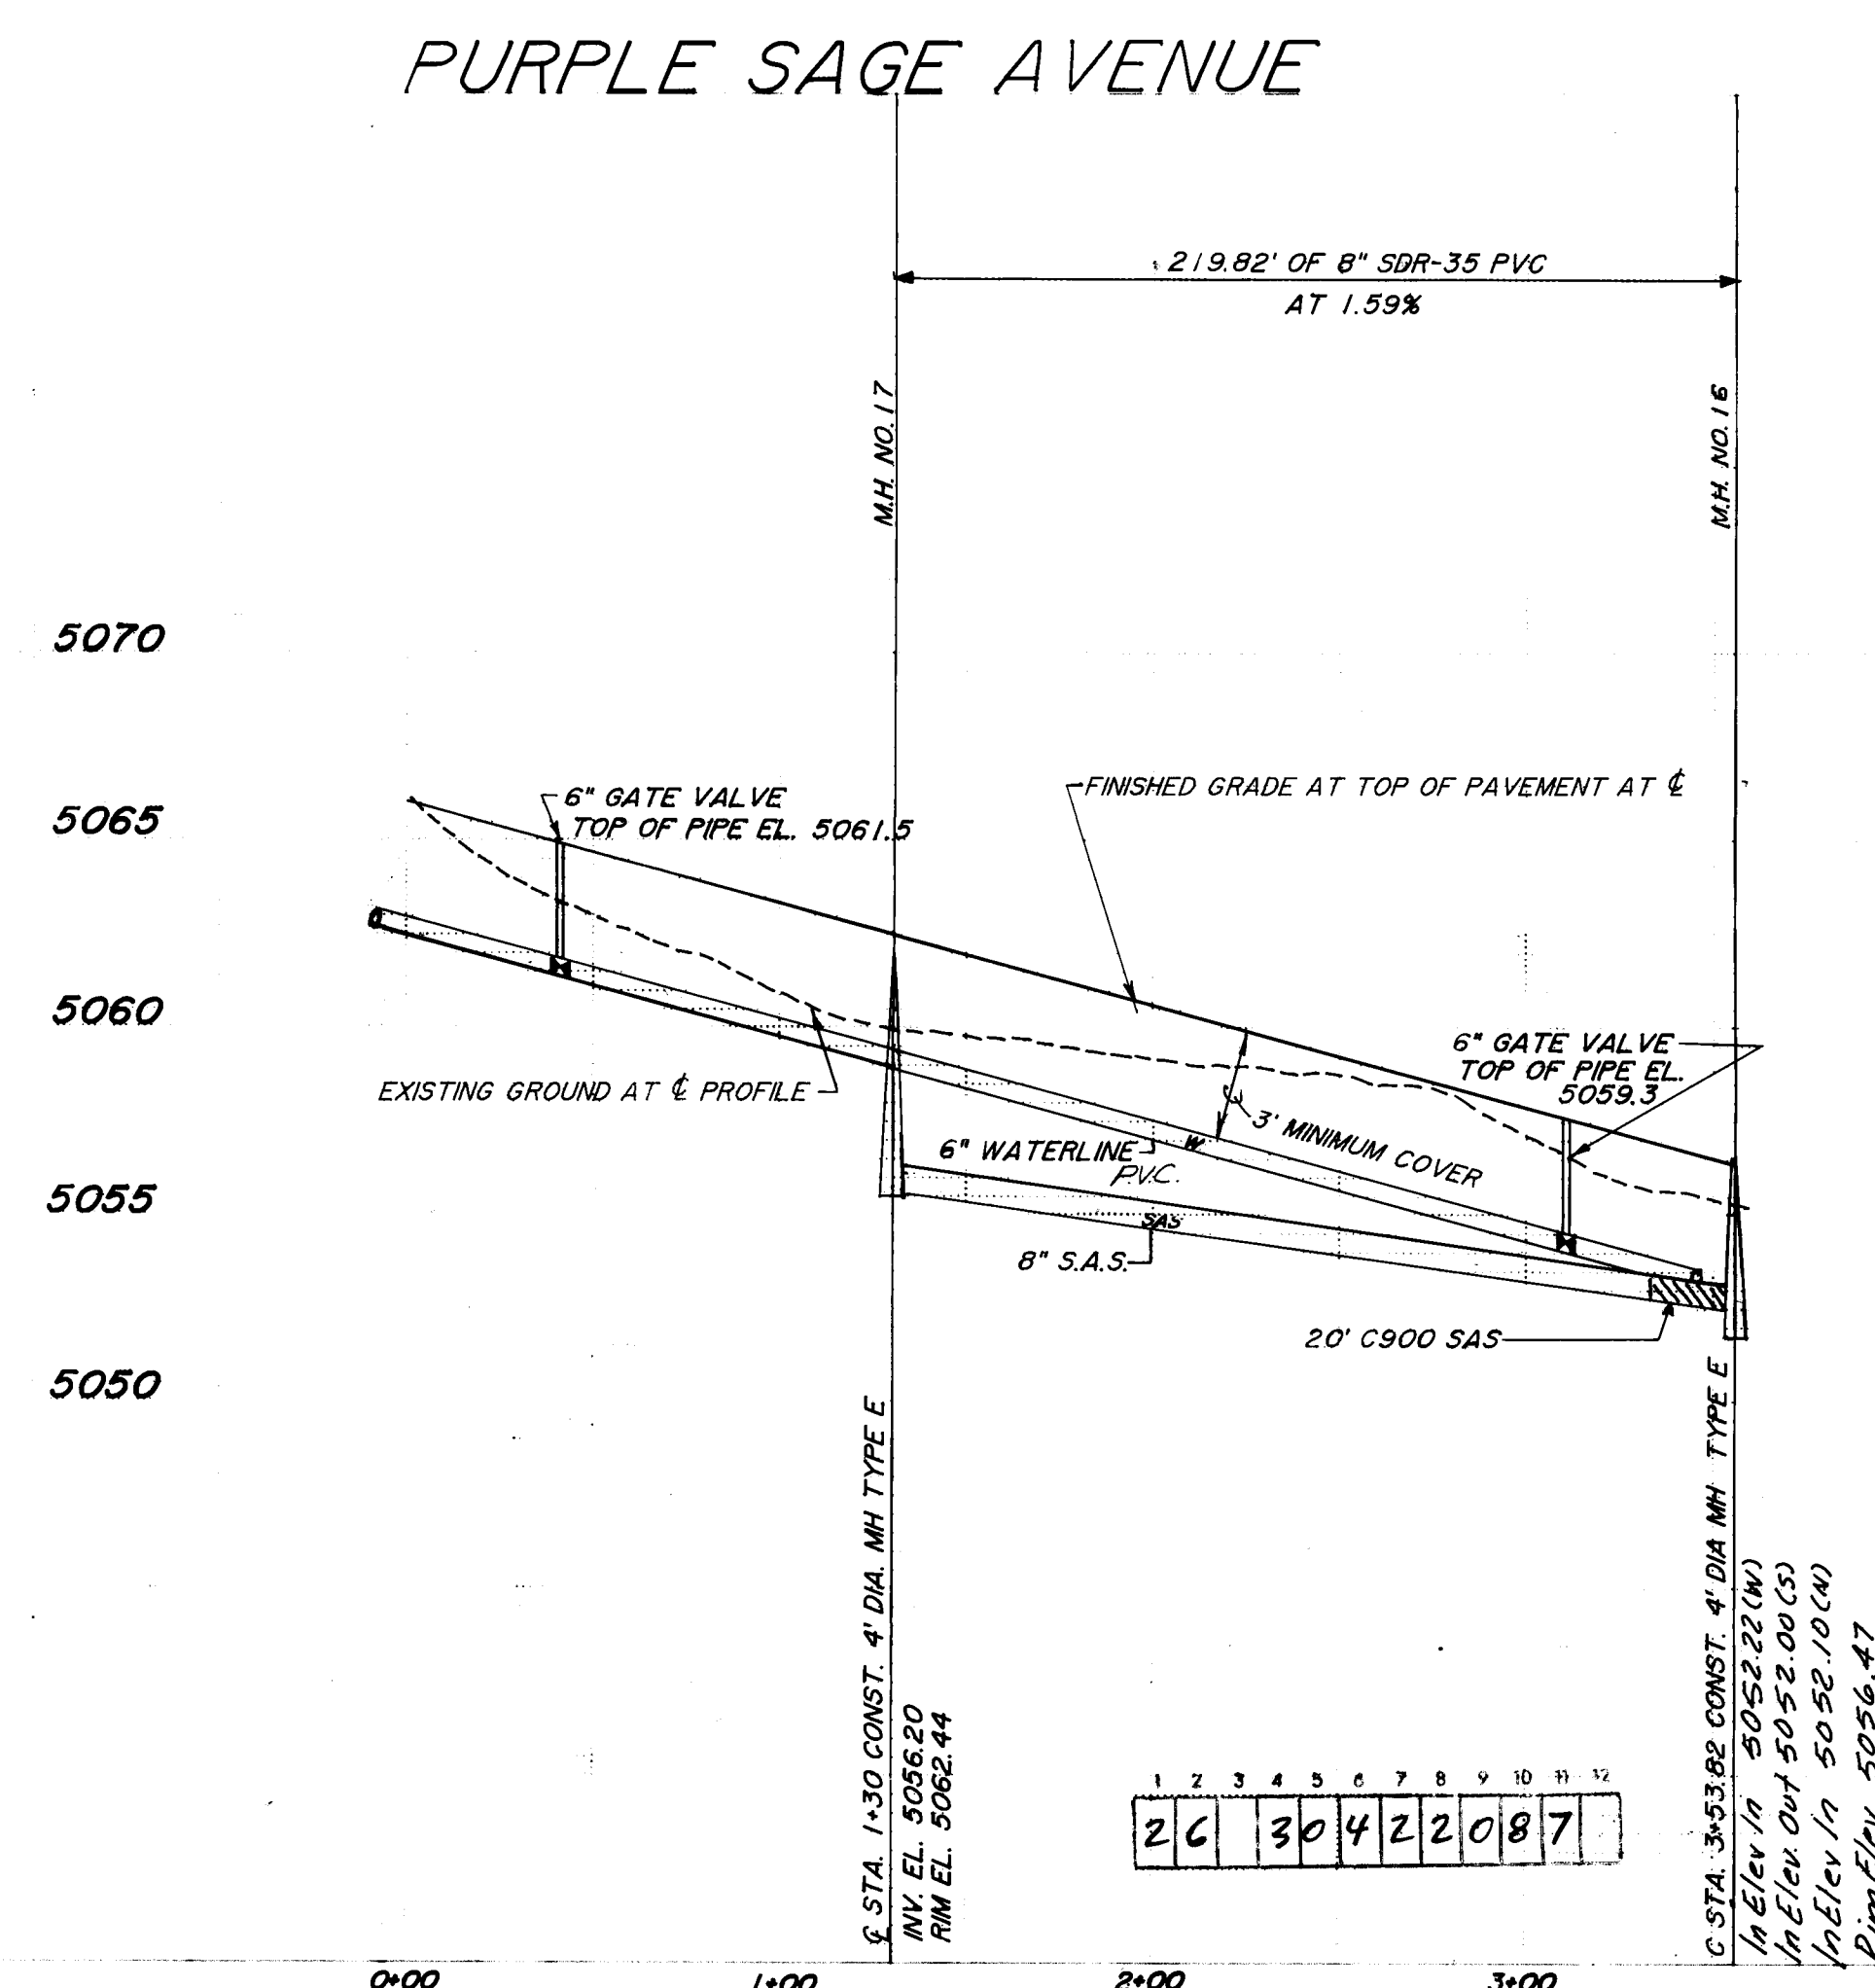

CITY OF ALBUQUERQUE					
MUNICIPAL DEVELOPMENT DEPARTMENT					
ENGINEERING DIVISION					
TITLE: PRAIRIE RIDGE UNIT II UTILITIES RABBIT BRUSH AVENUE & PURPLE SAGE AVENUE					
APPROVALS	ENGINEER	DATE	APPROVALS	ENGINEER	DATE
City Engineer:	<i>[Signature]</i>	12/2/86	Land Waste	<i>[Signature]</i>	10/2/86
A C E Design	<i>[Signature]</i>	12/2/86	Traffic	<i>[Signature]</i>	10/2/86
A C E Hydrology	<i>[Signature]</i>		Water	<i>[Signature]</i>	10/2/86
DRAWING NO. 3042		MAP NO. E-12-Z		SHEET 20 OF 23	

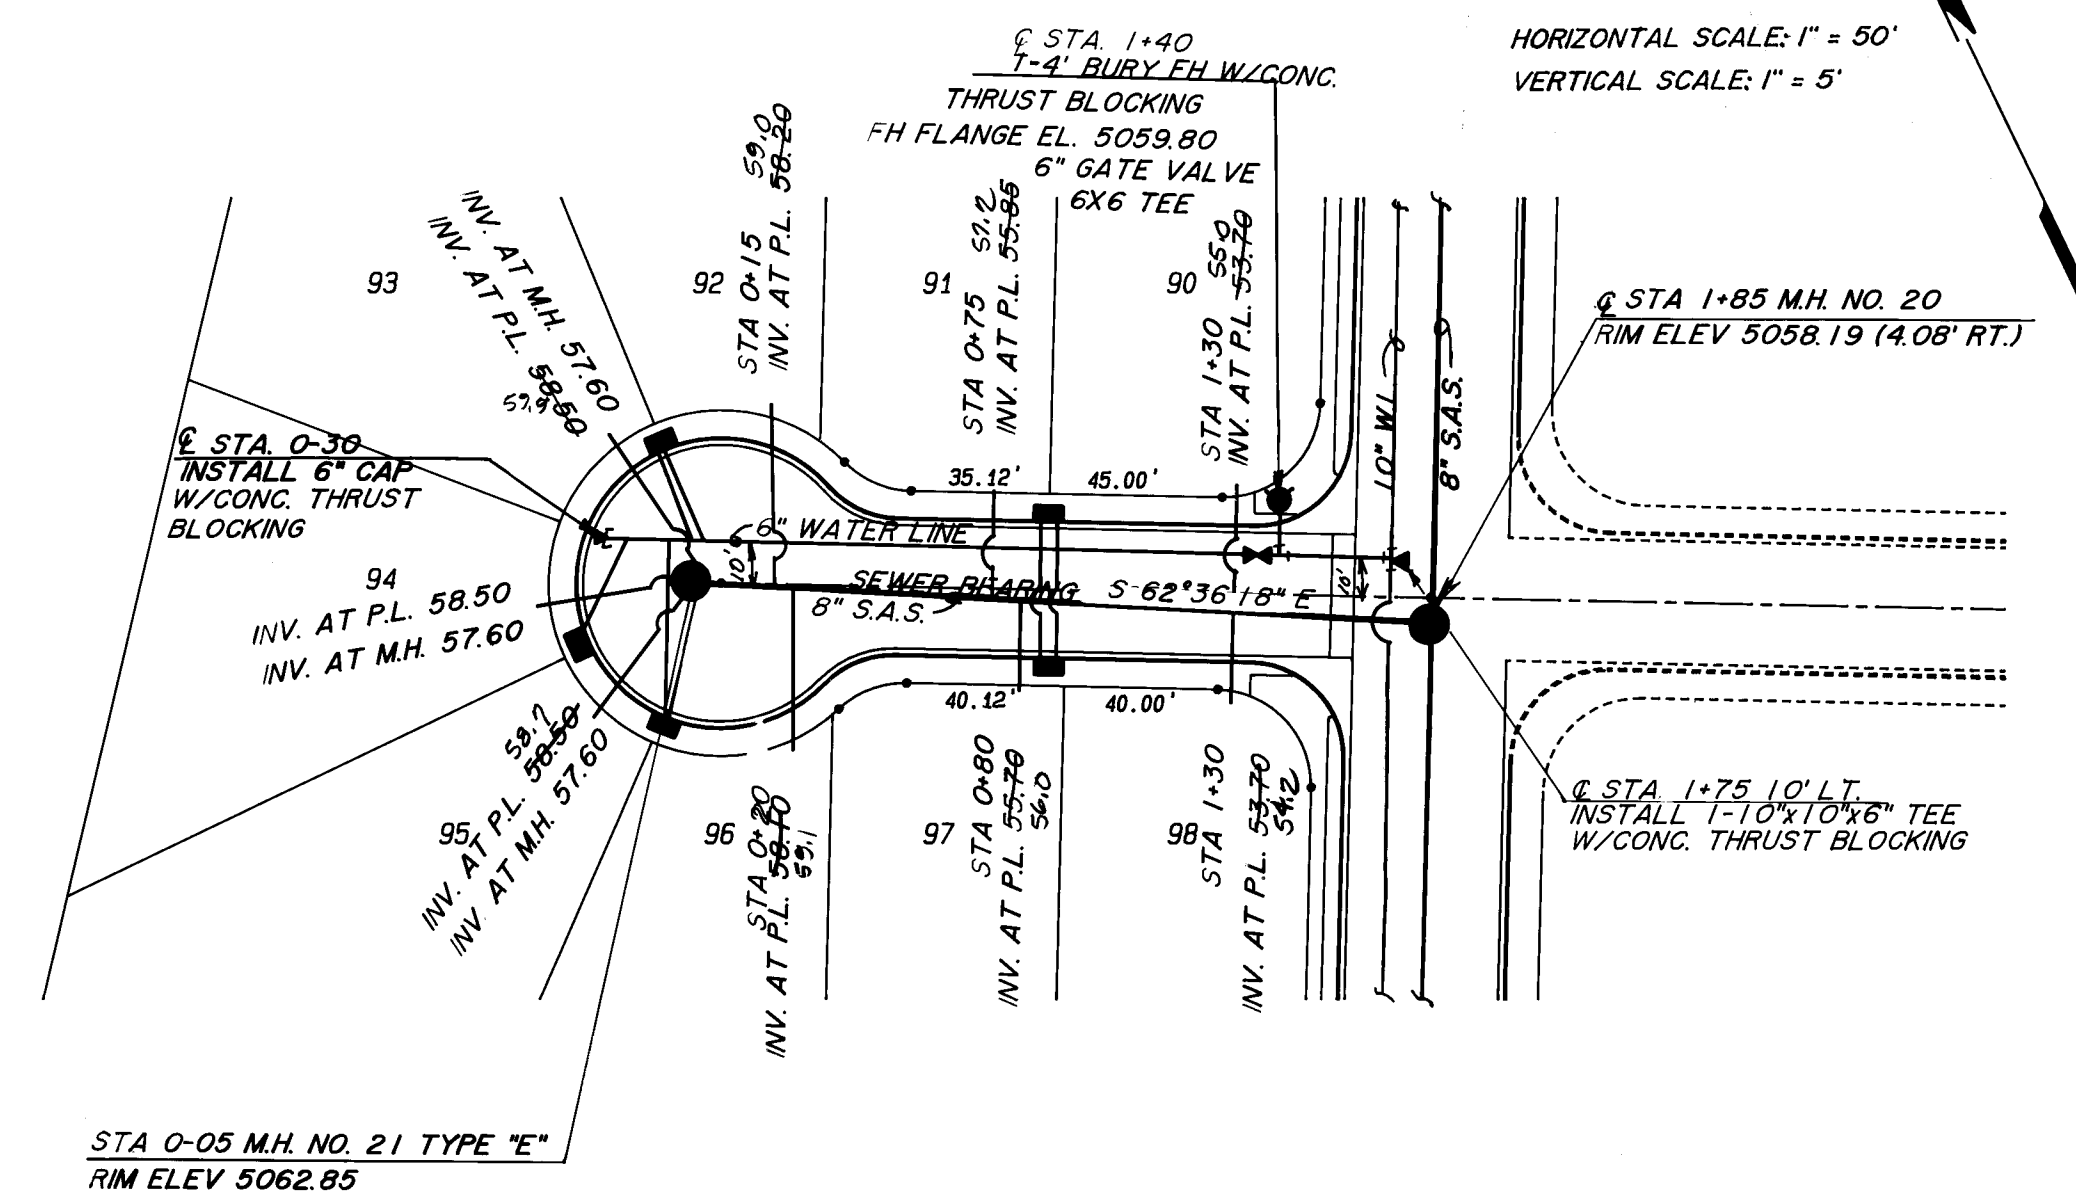


STATION	LOCATION	LENGTH	MAINLINE		SEWER SER.	
			INVERT	INVERT @ PI	INVERT @ PI	INVERT @ PI
0+05	M.H.	40' 40"	5057.60	5058.50	5059.50	93
0+05	M.H.	40'	5057.60	5058.50	5059.50	94
0+05	M.H.	40'	5057.60	5058.50	5059.50	95
1+10	RT	40' 44.8"	5056.02	5058.10	5059.10	96
1+25	LT	40' 46.5"	5056.21	5058.20	5059.00	97
0+75	LT	25' 26.8"	5053.86	5055.85	5057.91	98
0+80	LT	25' 24.5"	5053.67	5055.70	5057.91	99
1+30	RT	25' 23"	5051.72	5053.70	5054.70	100
1+30	LT	25' 20.2"	5051.72	5053.70	5054.70	101

William F. Coleman P.E. 5945
4/7/87
Date

BENCH MARKS	AS BUILT INFORMATION
G.L.O. BRASS CAP FOR SECTIONS. 23, 24, 25 AND 26, T1N, R2E, N1/4M-1. LOCATED WITHIN RIVERVIEW PARCEL H-28 APPROX- IMATELY 250 FEET NORTH OF THE CENTER- LINE OF GOLF COURSE ROAD AND LA ORILLA ROAD, N.W. ELEVATION = 5112.83.	DATE: 8/18/81 BY: JAL CHECKED BY: JAL NO
TMB - 10" DIA. CONC. MON. ALUMINUM CAP "LS 7270" CSC. TBM. ELEV. 5065.61 VICINITY OF NE CORNER TRACT 33 A-2	DATE: 8/18/81 BY: JAL CHECKED BY: JAL NO

HILL SPIRE

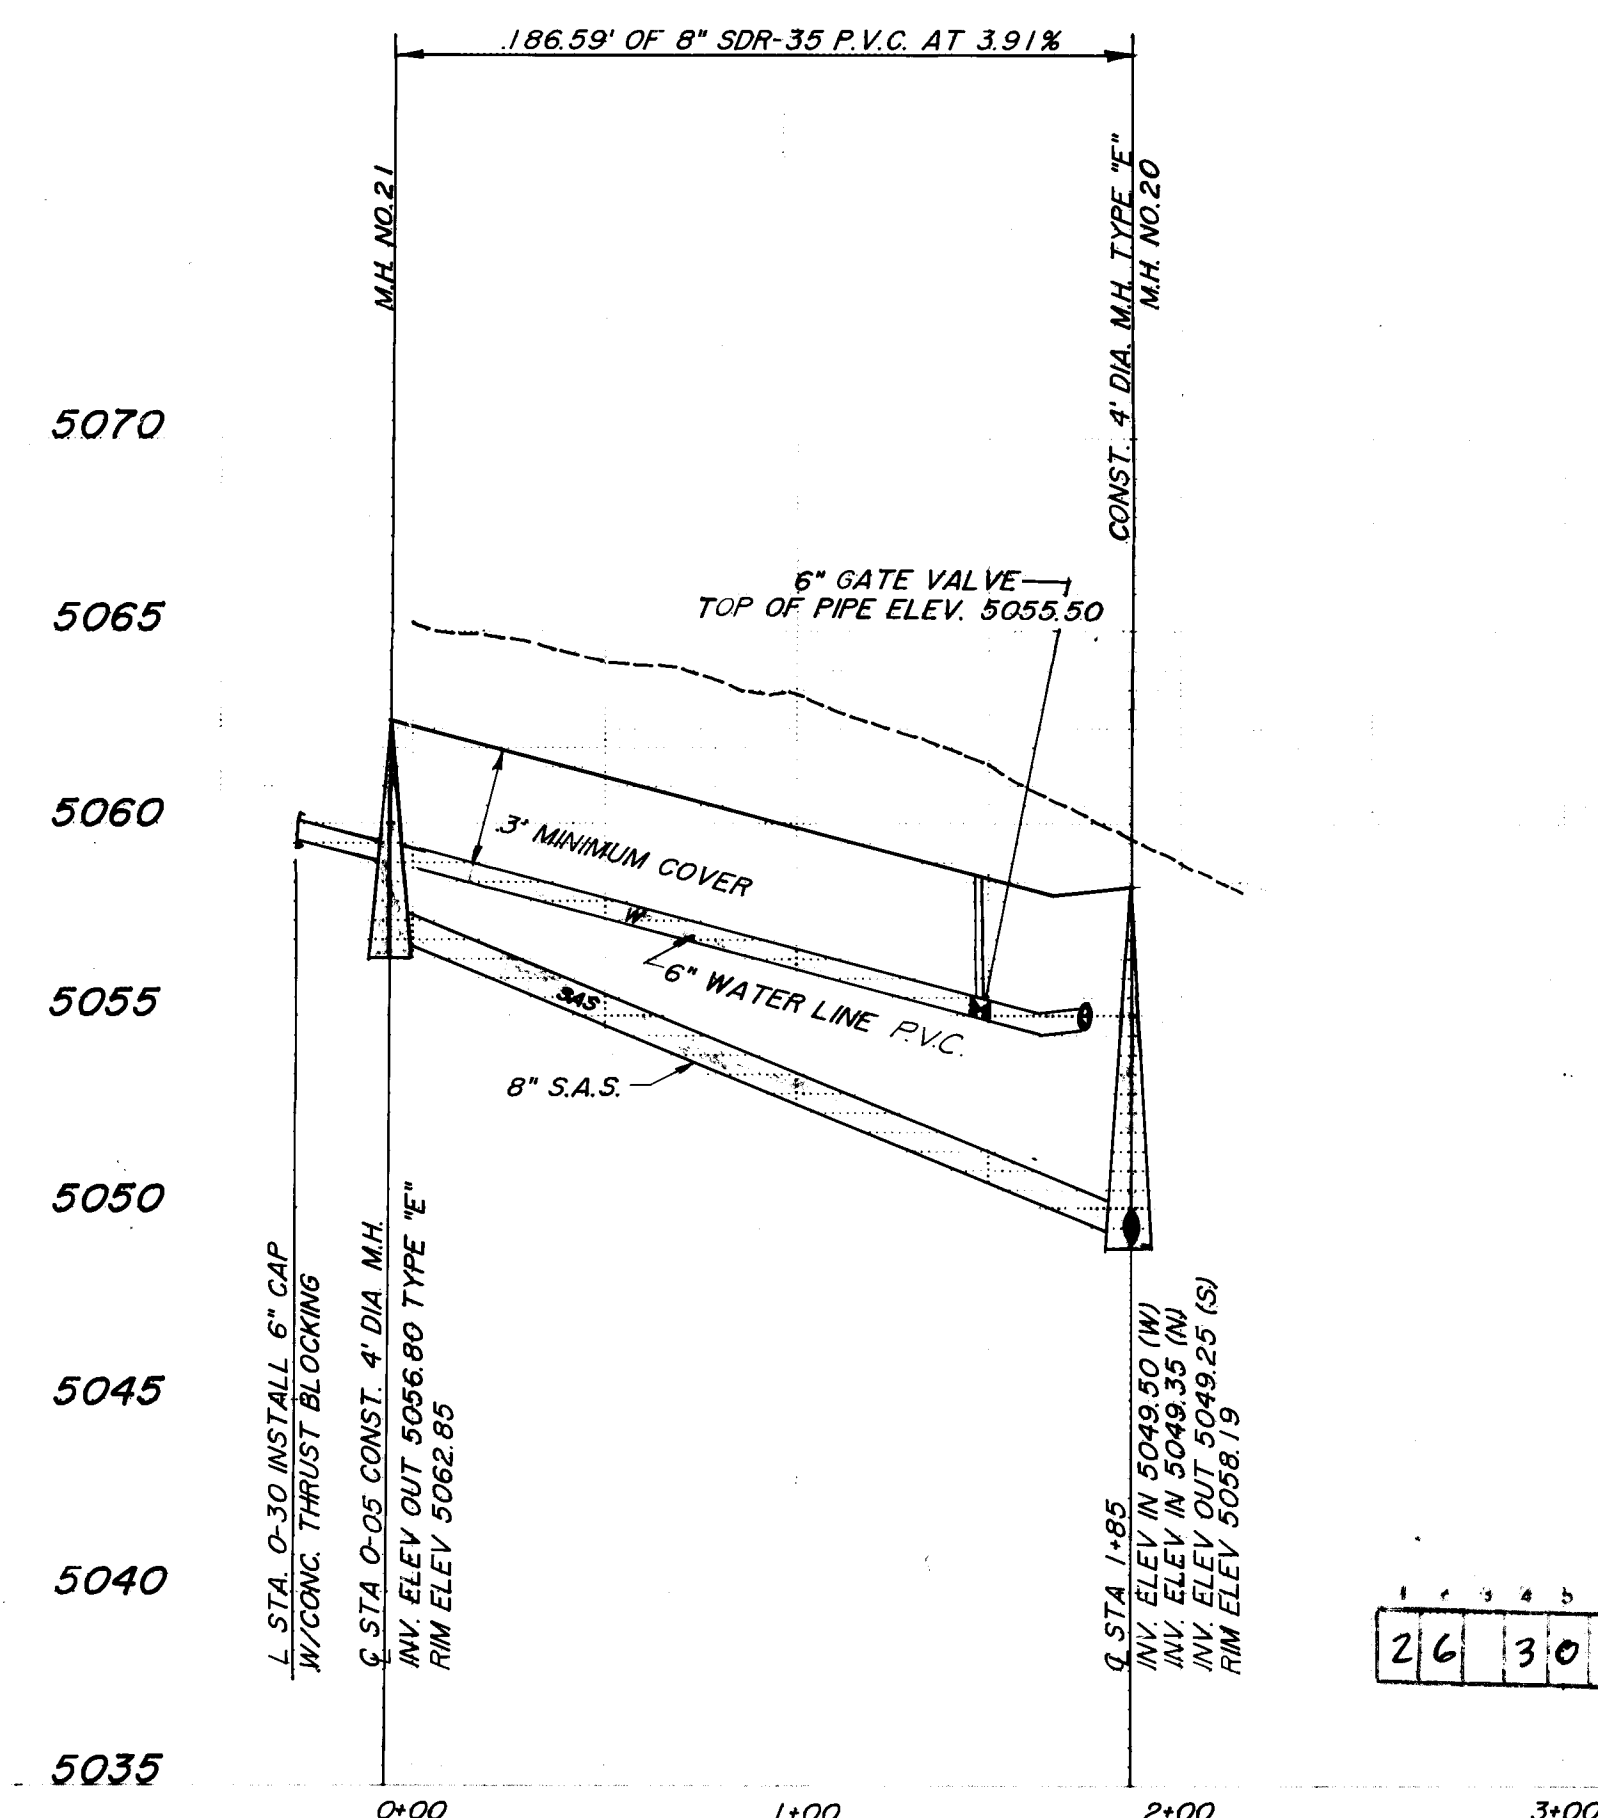

CITY OF ALBUQUERQUE
MUNICIPAL DEVELOPMENT DEPARTMENT
ENGINEERING DIVISION

TITLE **PRARIE RIDGE UNIT II UTILITIES
SPANISH BROOM COURT &
HILLSPICE COURT**

APPROVAL'S	ENGINEER	DATE	APPROVAL'S	ENGINEER	DATE
City Engineer	<i>[Signature]</i>	10/21/86	Liquid Waste	<i>[Signature]</i>	6/21/86
ACE Design	<i>[Signature]</i>	10/21/86	Traffic	<i>[Signature]</i>	2/1/88
ACE - Hydrology	<i>[Signature]</i>	"	Water	<i>[Signature]</i>	6/21/86

DRAWING NO.	3042	MAP NO.	E-12Z	SHEET	21	OF	23
-------------	-------------	---------	-------	-------	-----------	----	-----------



NOT TO SCALE



NOT TO SCALE



NOT TO SCALE

PONDED LOT



NOT TO SCALE



NOT TO SCALE




NOT TO SCALE

f


TYPICAL RESIDENTIAL STREET

CONSTRUCTION NOTES:

- A. SIDEWALK WITH SETBACK.
- B. 6" COMPACTED SUBGRADE.
- C. STANDARD CURB AND GUTTER.
- D. ASPHALT CONCRETE.
- E. COMPACTED SUBBASE.
- F. CROWN (4" TYPICAL).
- G. SIDEWALK ADJACENT TO CURB.
- H. NORMAL CROWN.
- J. TRANSITION SECTION, SEE NOTES 1, 2 & 3.
- K. NO CROWN SECTION.
- L. FLOWLINE.
- M. HALF CROWN, SEE NOTE 2.
- N. CURB RETURN.

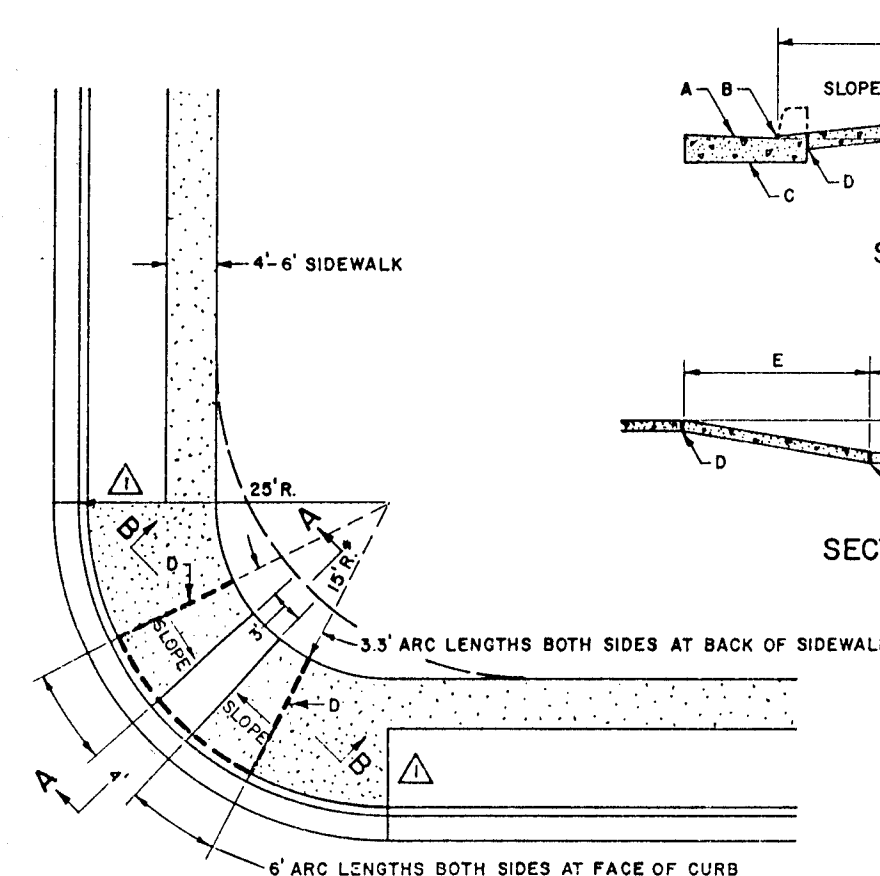

PLAN

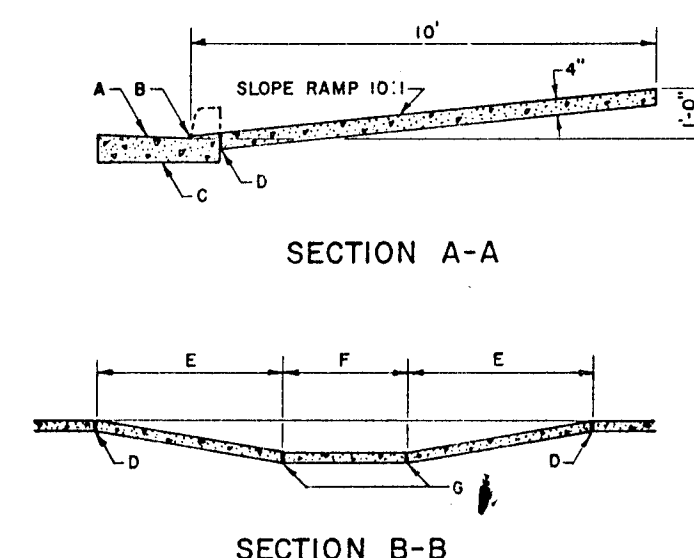


SECTION A-A




SECTION B-B

CONSTRUCTION NOTES:


- A. SLOPE OF GUTTER DEPENDENT ON REQUIREMENTS FOR VALLEY GUTTER.
- B. $\frac{1}{2}$ " LIP AT GUTTER LINE.
- C. CURB AND GUTTER.
- D. $\frac{1}{2}$ " EXPANSION JOINT.
- E. 6 FT. AT FACE OF CURB.
- F. 4 FT. AT FACE OF CURB, 3 FT. MIN. AT BACK OF SIDEWALK.
- G. CONTRACTION (DUMMY) JOINTS.

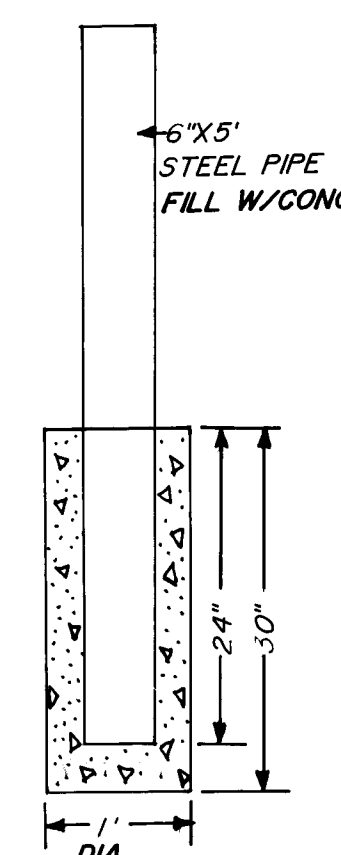


RAILROAD (NOT TO SCALE)

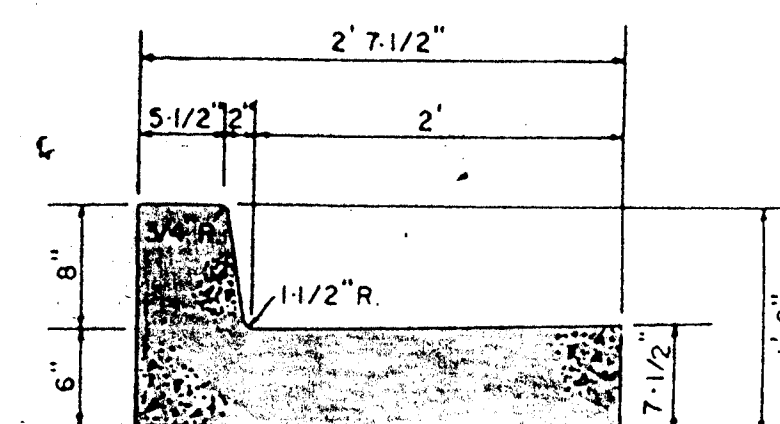


TYPE I
STANDARD CURB & GUTTER
SCALE: 1"=1' STD. DETAIL P-8-2

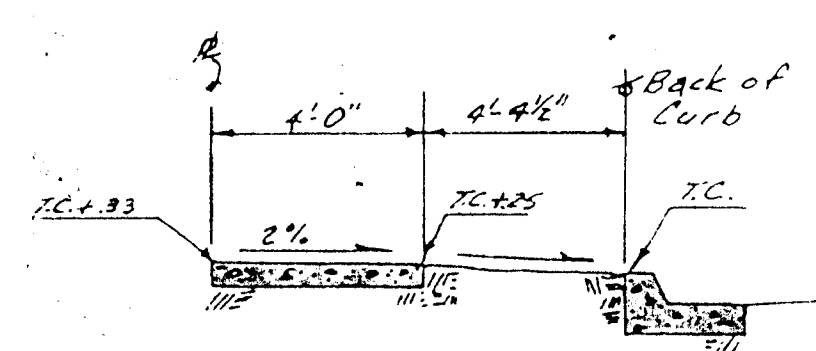

SIDEWALK ELEVATION

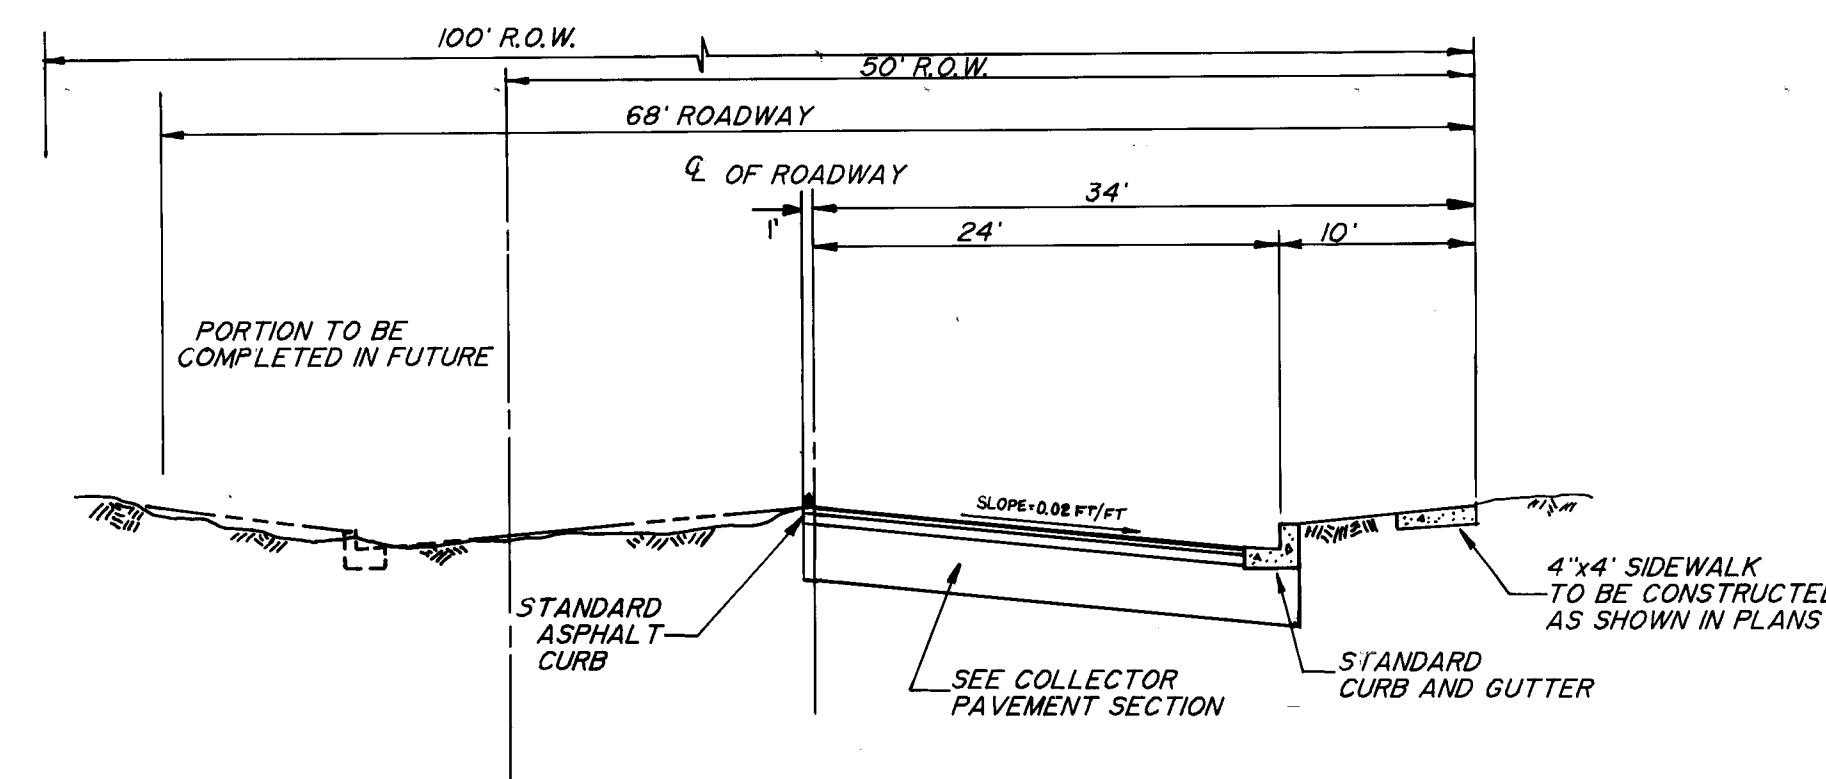


LA ORILLA ROAD N.W.
COLLECTOR STREET
SECTION

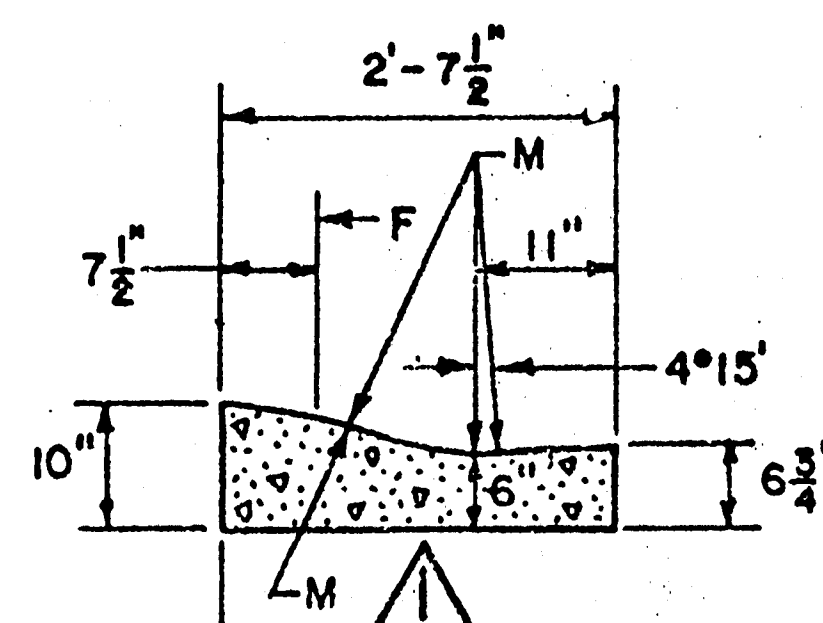


MOUNTABLE CURB
ROLL TYPE


MOUNTABLE CURB TO BE USED ON ALL STREETS
EXCEPT LA ORILLA RD. AND SANTALINA DR.

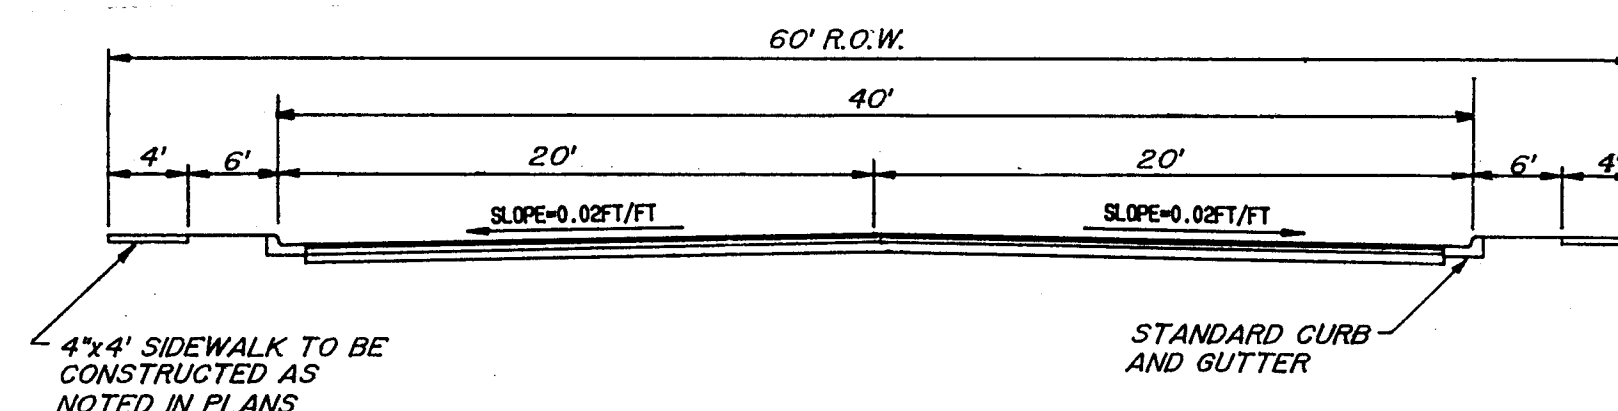


60' RIGHT OF WAY
RESIDENTIAL STREET
SECTION

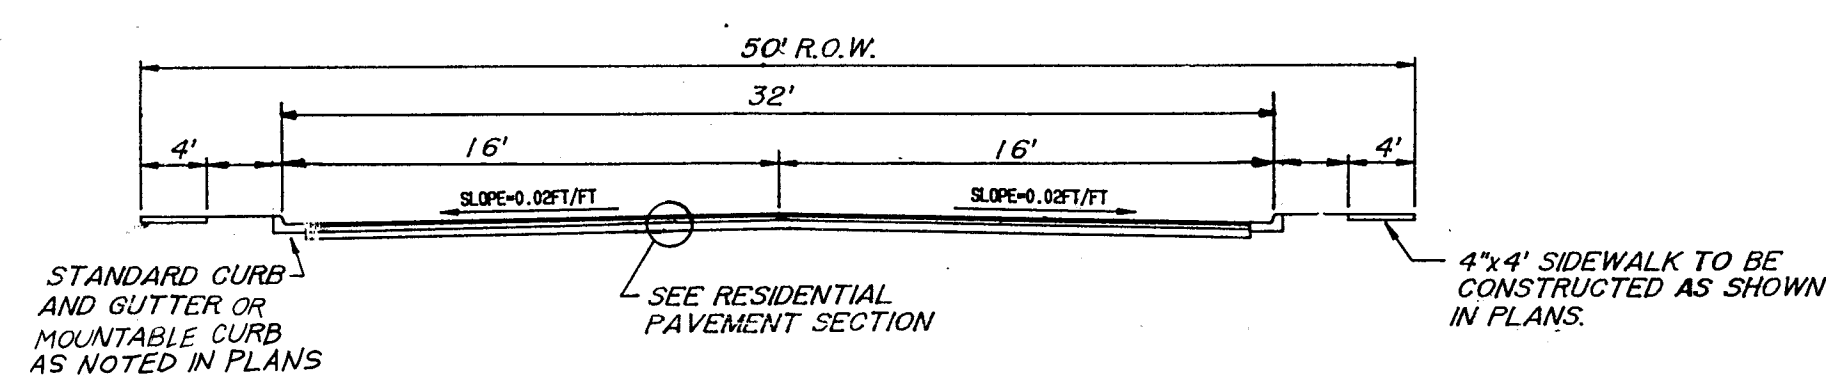


50' RIGHT OF WAY
RESIDENTIAL STREET
SECTION

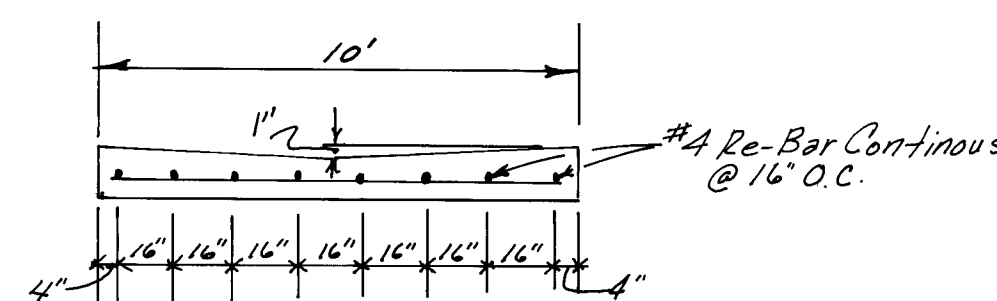


VALLEY GUTTER DETAIL
NOT TO SCALE

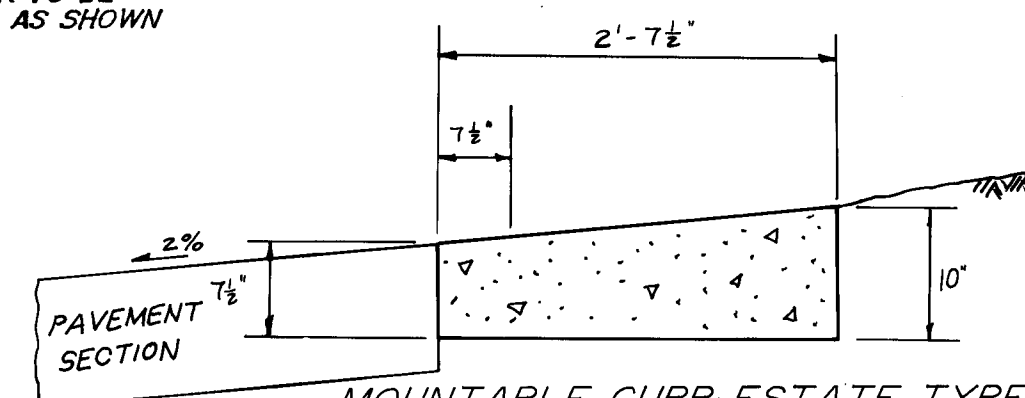


MOUNTABLE CURB-ESTATE TYPE
MOUNTABLE CURB ROLL TYPE TO BE
USED IN INTERIOR STREETS UNLESS
SPECIFIED AS ESTATE TYPE

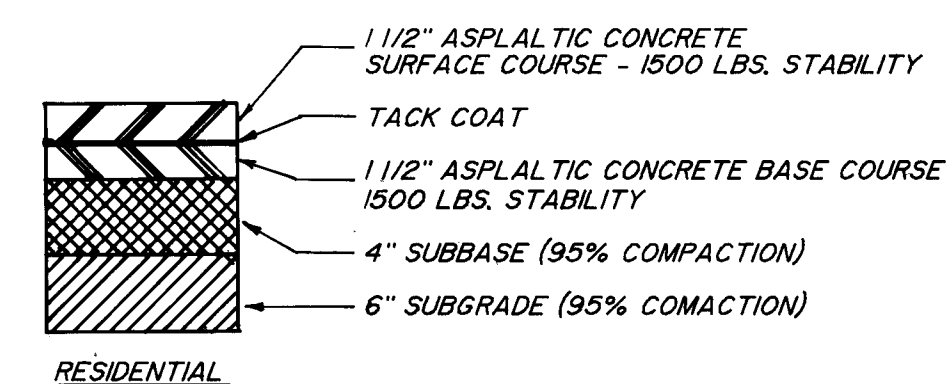

RESIDENTIAL

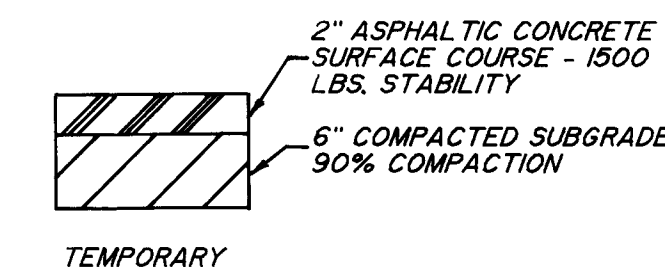

TEMPORARY

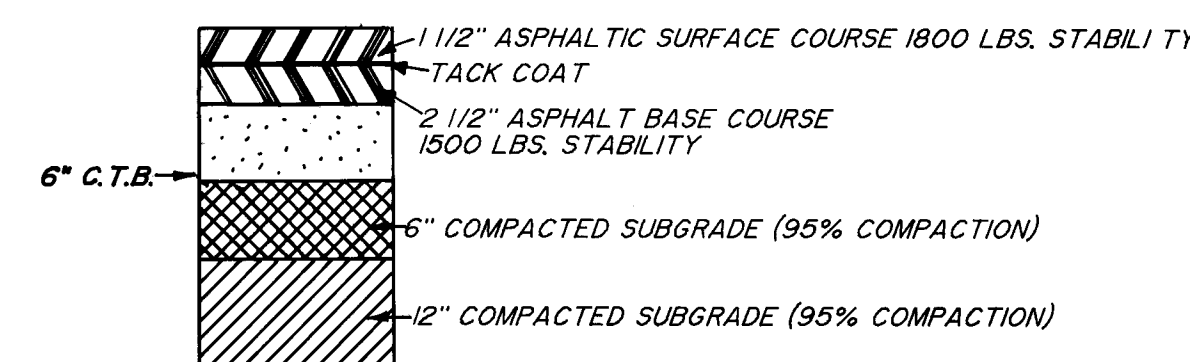

COLLECTOR

PAVEMENT SECTIONS




[illegible]

CITY OF ALBUQUERQUE
MUNICIPAL DEVELOPMENT DEPARTMENT
ENGINEERING DIVISION

TITLE: PRAIRIE RIDGE UNIT II
PAVING DETAILS

APPROVALS	ENGINEER	DATE	APPROVALS	ENGINEER	DATE
City Engineer	<i>[Signature]</i>	10/21/90	Liquid Waste	<i>[Signature]</i>	10/21/90
A.C.E. Design	<i>[Signature]</i>	10/21/90	Traffic	<i>[Signature]</i>	10/21/90
A.C.E. Hydrology	<i>[Signature]</i>	"	Water	<i>[Signature]</i>	10/21/90

DRAWING NO.	3042	MAP NO.	E-12Z	SHEET	23	OF	23
-------------	------	---------	-------	-------	----	----	----

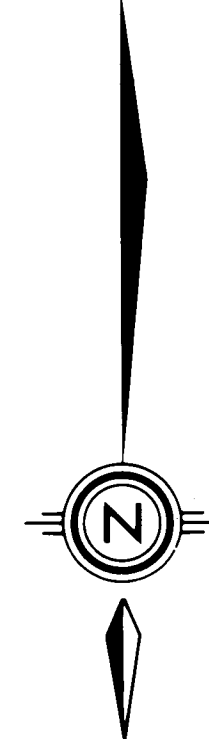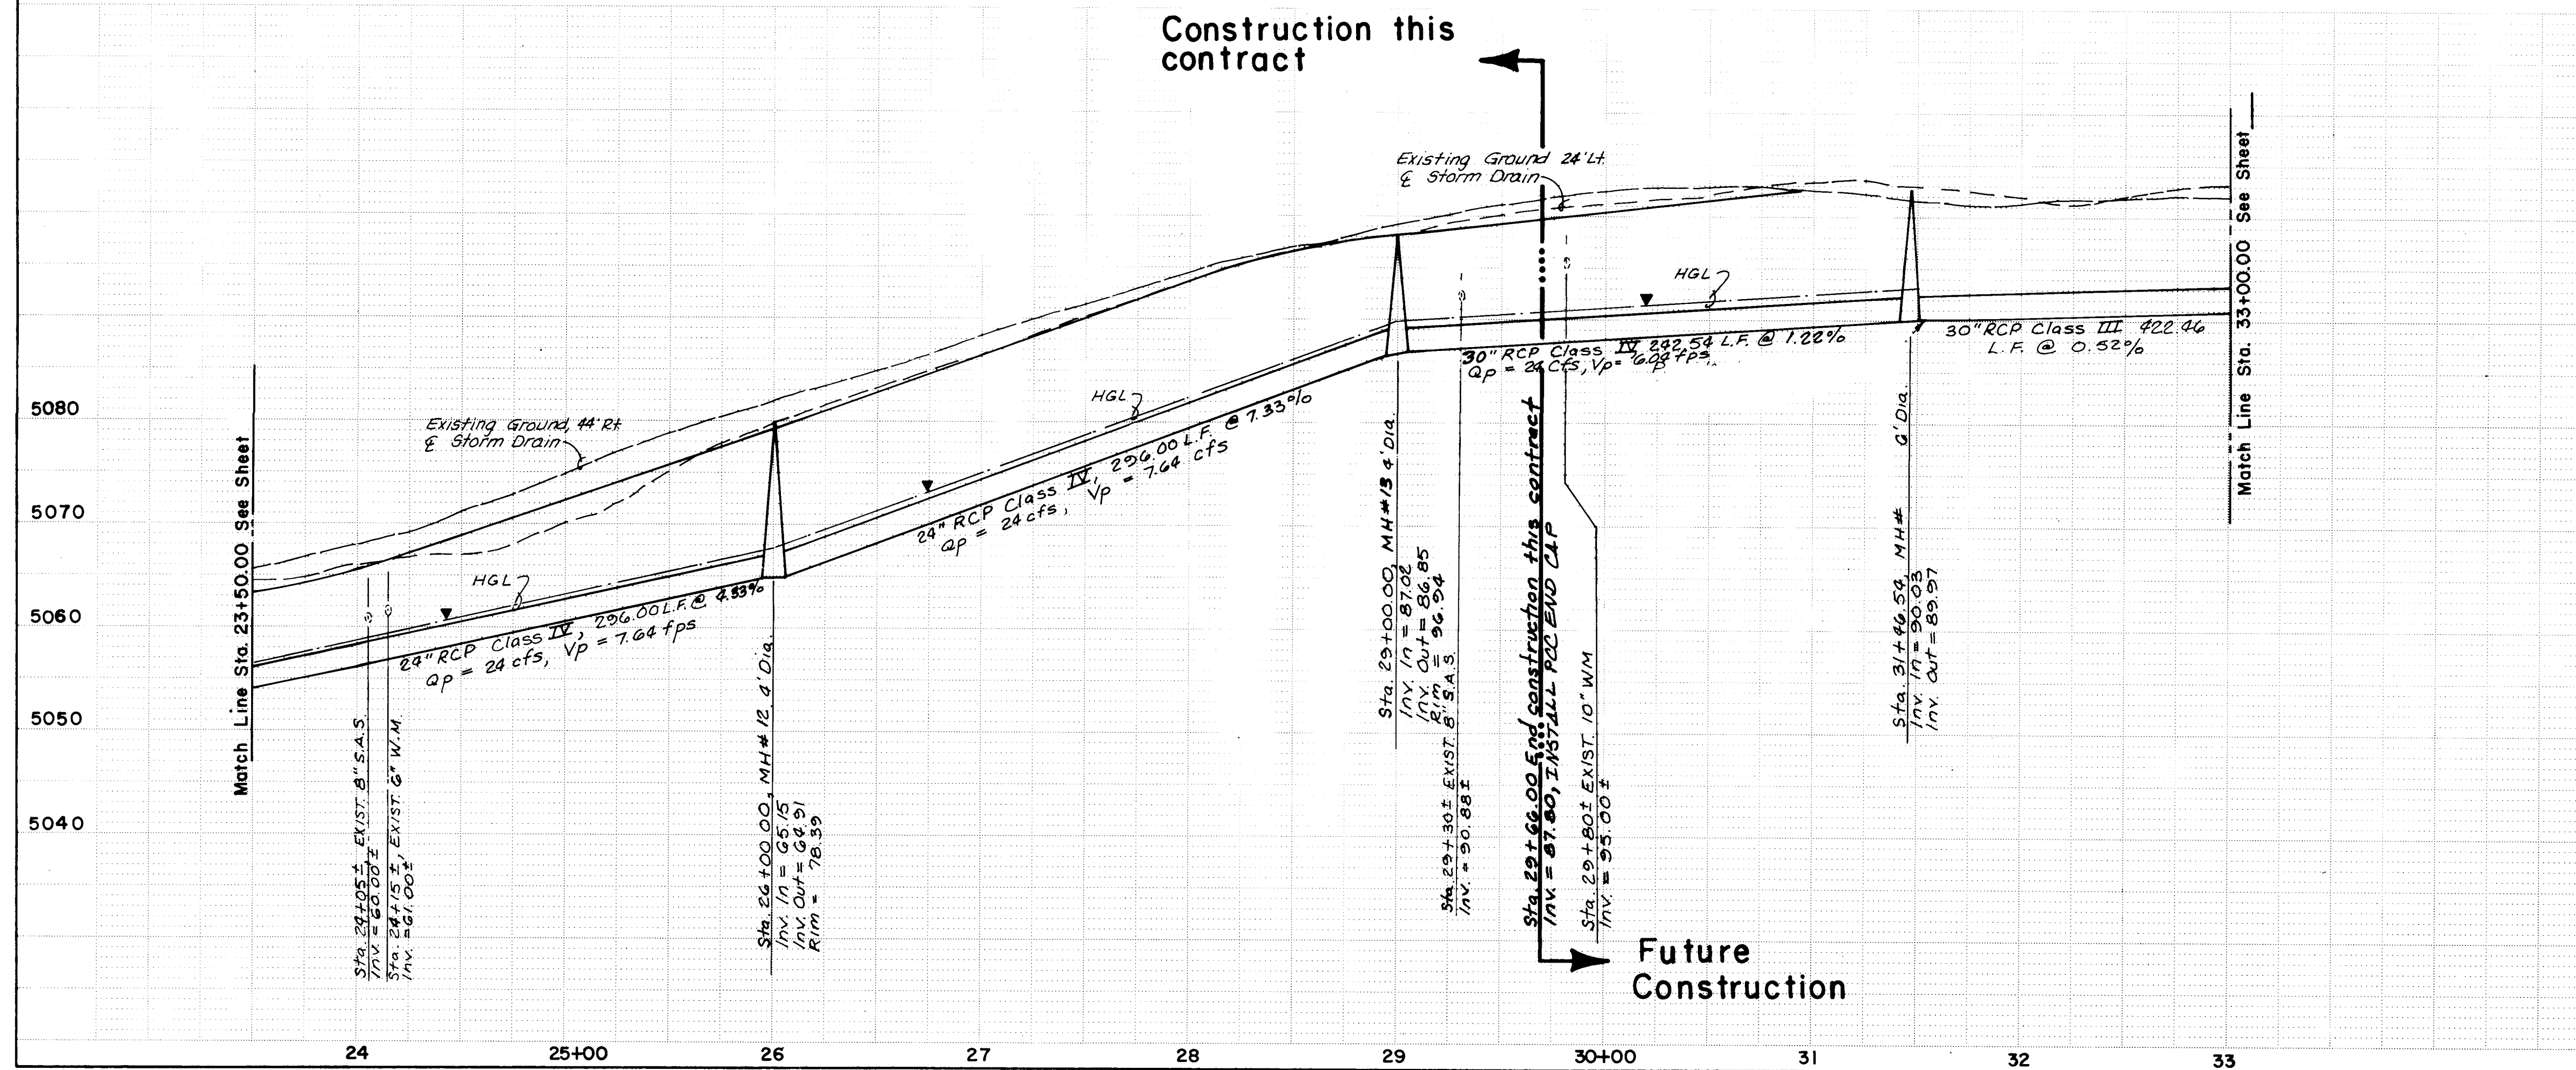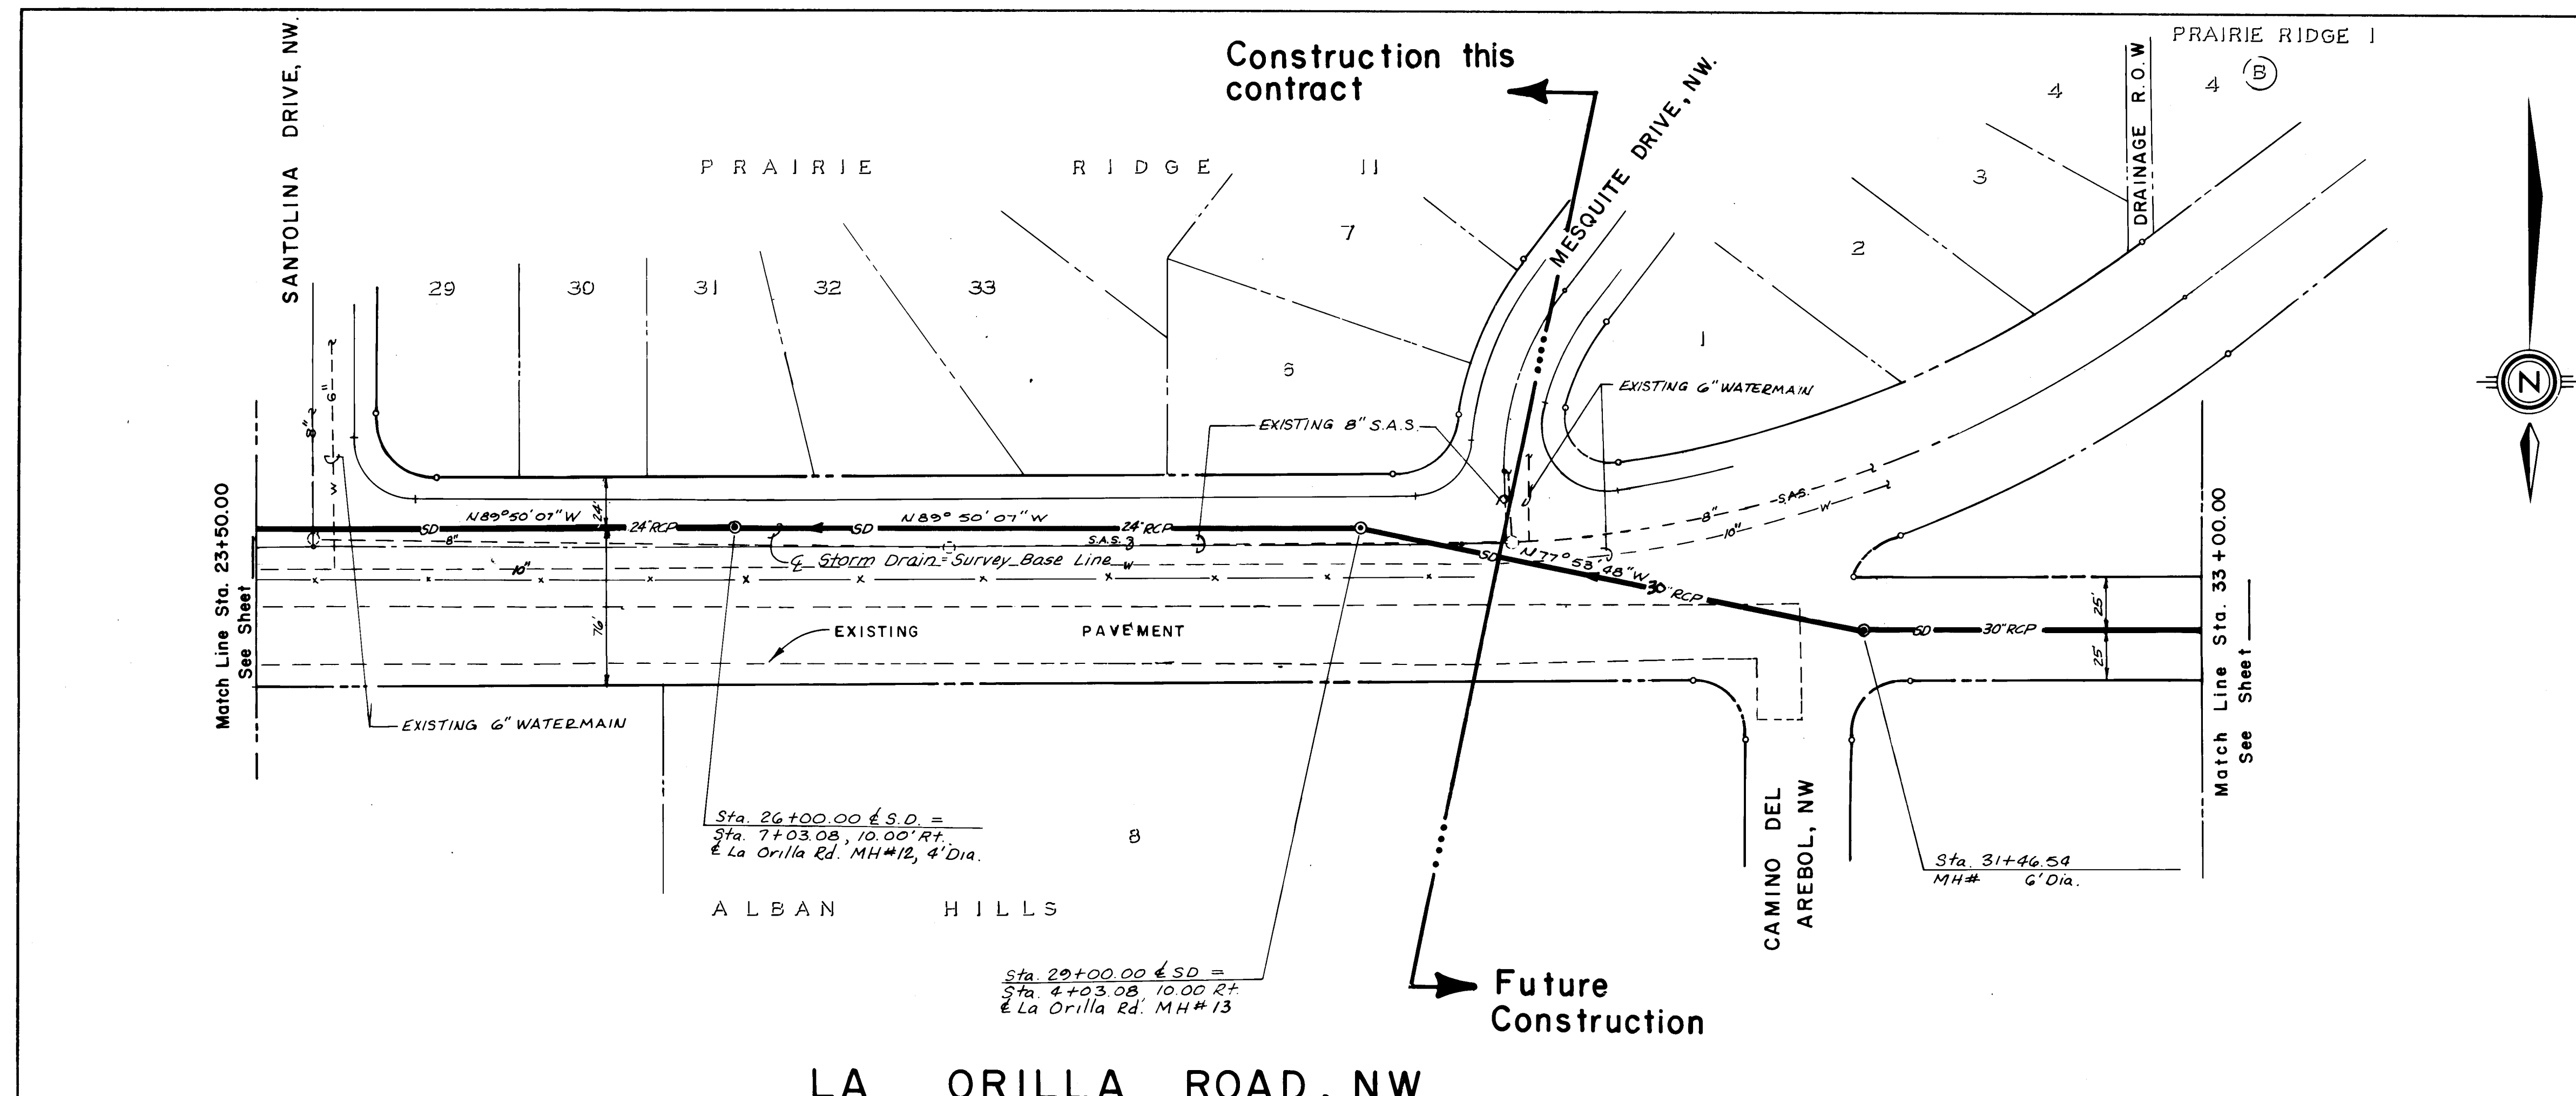

RECORD DRAWING

The improvements shown on this drawing have been as-built in accordance with field surveys performed by Espey, Huston and Associates, Inc. and information provided by Construction Management, Inc. Management (contractors) to reflect construction actually completed as of this date, to the best of my knowledge and belief.

William F. Coleman
 William F. Coleman P.E. 5945
 4/7/07
 Date


ENGINEER'S SEAL			SURVEY INFORMATION			BENCH MARKS			AS BUILT INFORMATION		
			FIELD NOTES			A. STANDARD USLO SECTION CORNER MONUMENT (2 1/2 INCH BRASS TABLET) FOR SECTIONS 23, 24, 25 AND 26, T11N, R2E, N.M.P.M. AND LOCATED APPROXIMATELY 310' DUE NORTH OF INTERSECTION OF GOLF COURSE ROAD N.W. AND TAYLOR RANCH DRIVE, N.W. WITHIN RIVERVIEW PARCEL H-28 ELEV. 5,112.53			CONTRACTOR C21M		
NO.	DATE	BY	NO.	DATE	BY	NO.	DATE	BY	NO.	DATE	BY
REVISIONS			REVISIONS			REVISIONS			REVISIONS		
DESIGN			DESIGN			DESIGN			DESIGN		
DESIGNED BY G.A.			DESIGNED BY G.A.			DESIGNED BY G.A.			DESIGNED BY G.A.		
DRAWN BY M.W.M.			DRAWN BY M.W.M.			DRAWN BY M.W.M.			DRAWN BY M.W.M.		
CHECKED BY M.Y.Y.			CHECKED BY M.Y.Y.			CHECKED BY M.Y.Y.			CHECKED BY M.Y.Y.		
DATE October, 1986			DATE October, 1986			DATE October, 1986			DATE October, 1986		
DATE November, 1986			DATE November, 1986			DATE November, 1986			DATE November, 1986		



CITY OF ALBUQUERQUE
 MUNICIPAL DEVELOPMENT DEPARTMENT
 ENGINEERING DIVISION

TITLE: STORM SEWER IMPROVEMENTS-GOLF COURSE/LA ORILLA
 FROM STA. 23+50.00 TO STA. 33+00.00

APPROVALS	ENGINEER	DATE	APPROVALS	ENGINEER	DATE
City Engineer	<i>[Signature]</i>	11/10/86	Traffic	<i>[Signature]</i>	11/14/86
A.C.E.-Design	<i>[Signature]</i>	11/14/86	Water Utilities	<i>[Signature]</i>	11/14/86
A.C.E.-Hydrology	<i>[Signature]</i>	11/14/86			

DRAWING NO. 3042 MAP NO. DII-E12 SHEET 23B OF 23

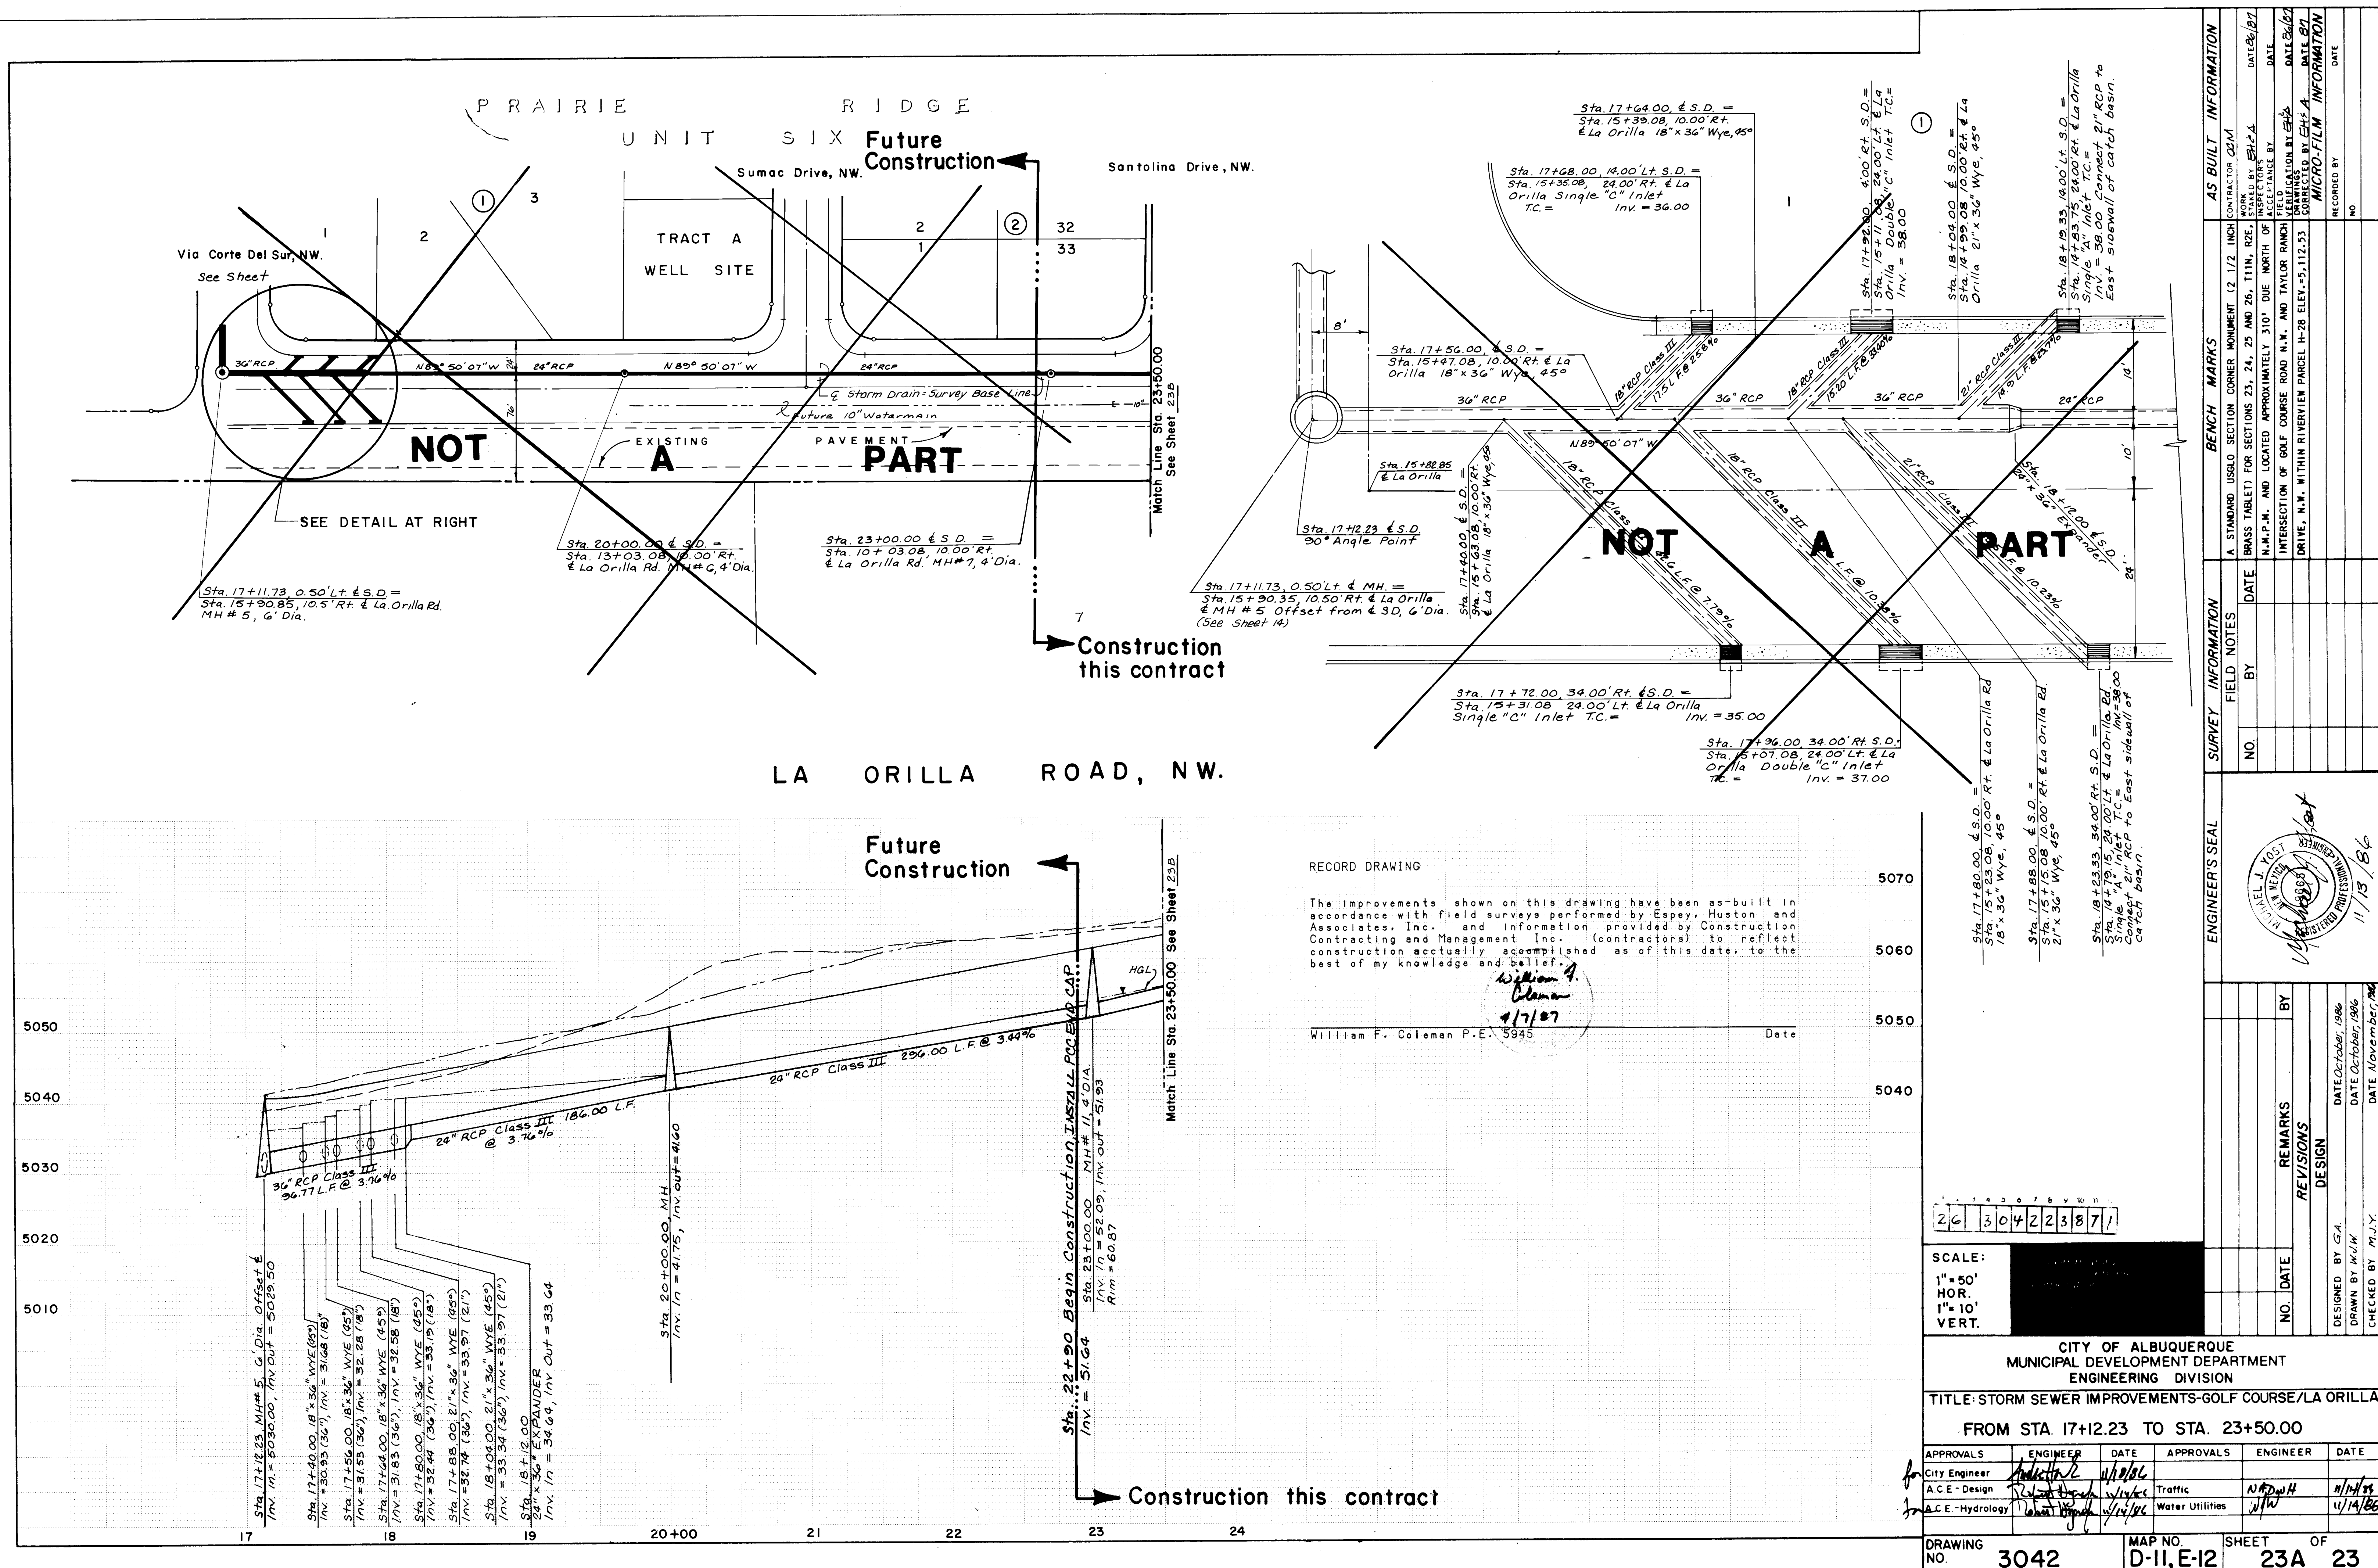

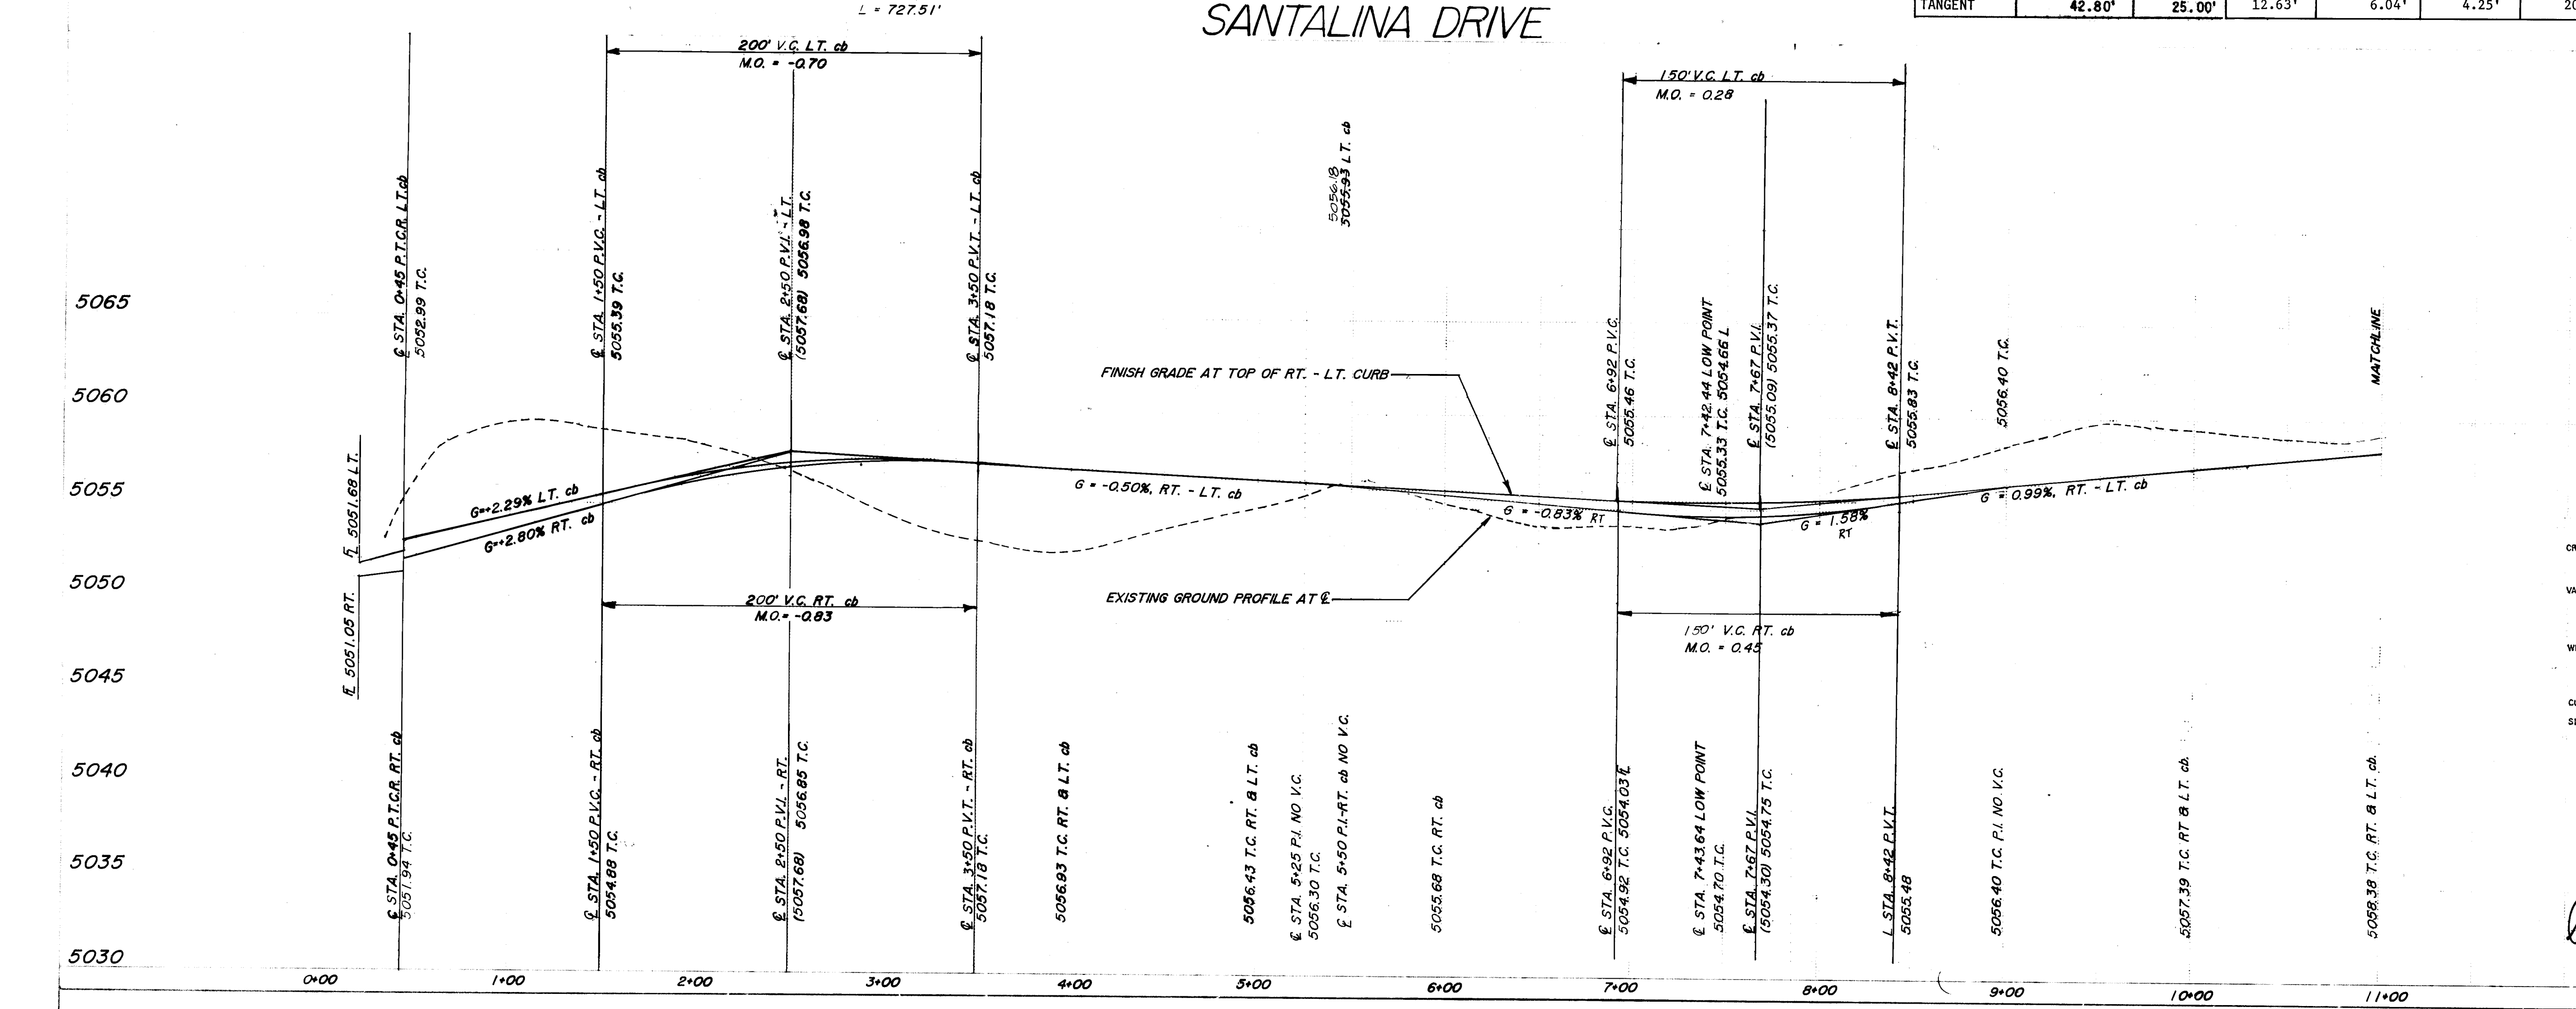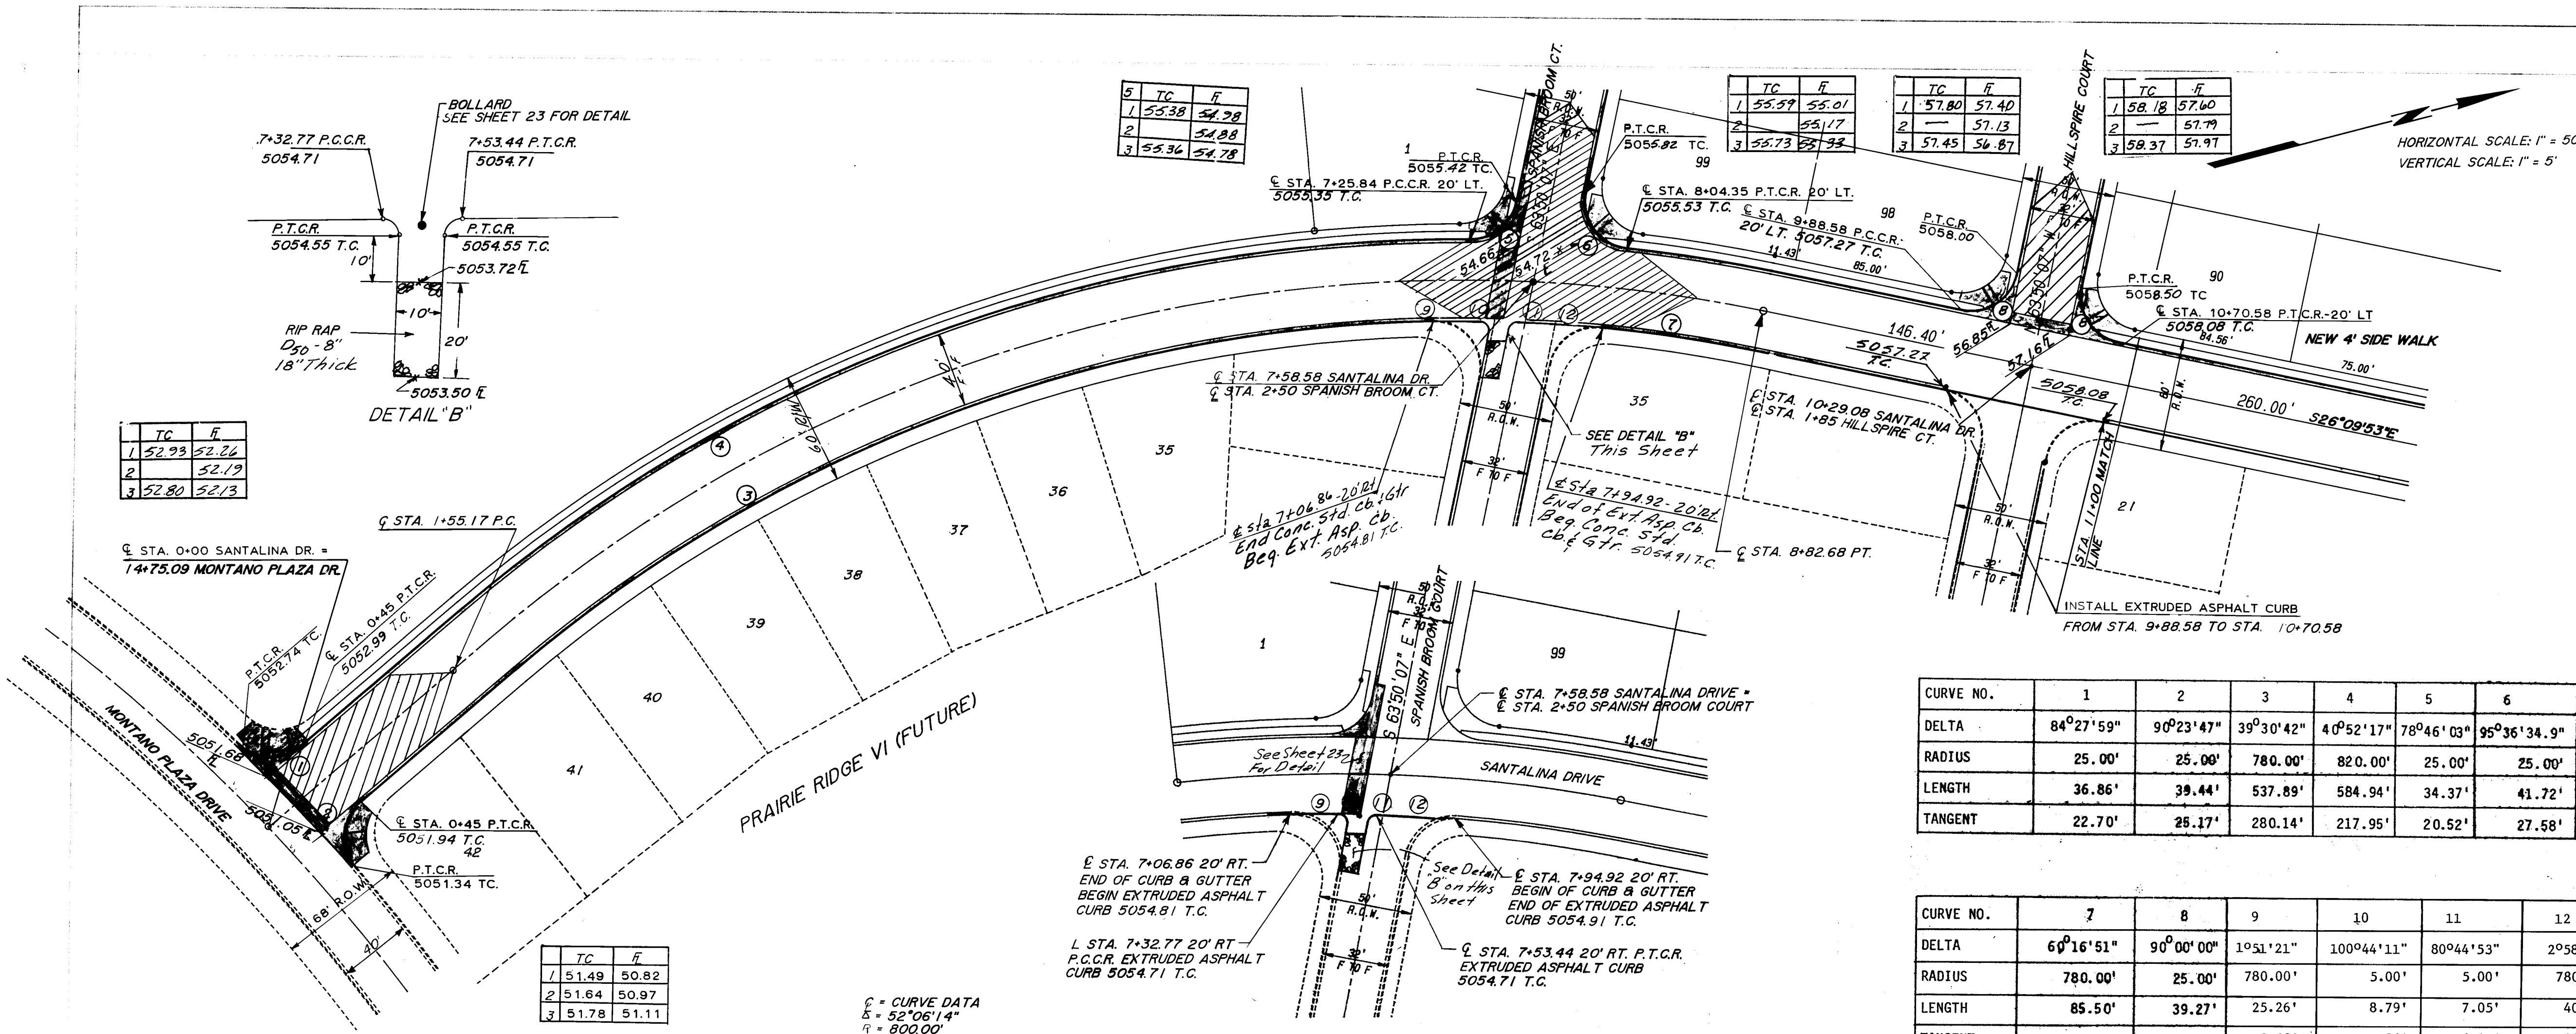

AS BUILT INFORMATION

CM

DATE: 10/21/86

CHECKED BY: C.C.

RECORD DRAWING

DATE: 10/21/86

BY: [Signature]

ENGINEER'S SEAL

REVISIONS

DATE: 10/21/86

DESCRIPTION

NEW

EXISTING

VALLEY

WHEELCHAIR RAMPS

CURB & GUTTER

SIDEWALKS

NOTE: STD. CONC. CURB AND GUTTER TO BE CONSTRUCTED ON SANTALINA DRIVE AND LA ORILLA ROAD

CITY OF ALBUQUERQUE

MUNICIPAL DEVELOPMENT DEPARTMENT

ENGINEERING DIVISION

TITLE: PRAIRIE RIDGE UNIT II PAVING SANTALINA DRIVE

APPROVALS

ENGINEER

DATE

APPROVALS

ENGINEER

DATE

DRAWING NO. 3042

MAP NO. E-12-Z

SHEET 7 OF 23

RECORD DRAWING


The improvements shown on this drawing have been as-built in accordance with field surveys performed by Espey, Huston and Associates, Inc. and information provided by Construction Contracting and Management Inc. (contractors) to reflect construction actually accomplished as of this date, to the best of my knowledge and belief.

William F. Coleman
4/17/87

William F. Coleman P.E. 5945 Date

HORIZONTAL SCALE: 1" = 50'
VERTICAL SCALE: 1" = 5'

NOTE: IF 1200 PIPE IS USED FOR S.A.S., THE 10' HORIZONTAL SEPARATION OR 18" VERTICAL REQUIREMENT MAY BE RELAXED IF CIRCUMSTANCES WARRANT.

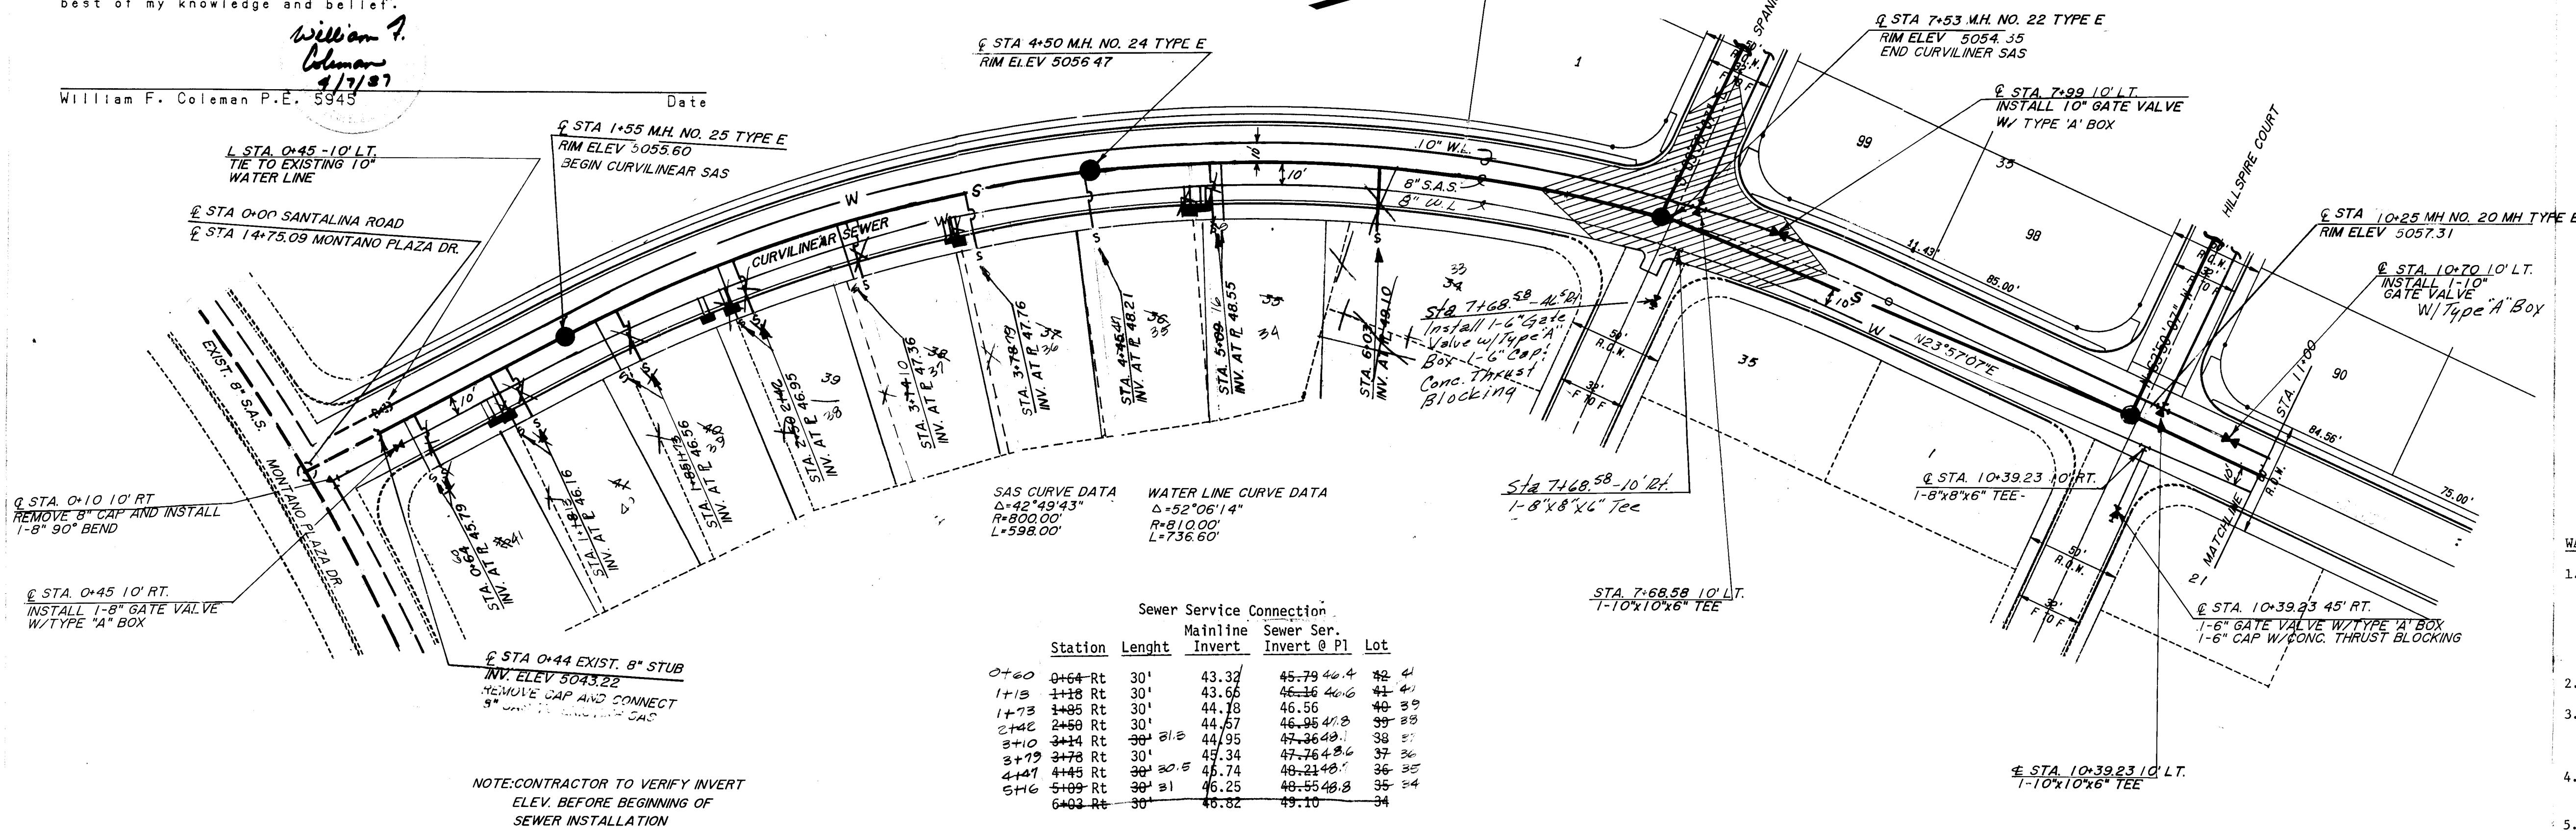

SAS CURVE DATA

Δ=42°49'43"	R=800.00'	L=598.00'
-------------	-----------	-----------


WATER LINE CURVE DATA

Δ=52°06'14"	R=810.00'	L=736.60'
-------------	-----------	-----------

Sewer Service Connection

Station	Length	Mainline Invert	Sewer Ser. Invert @ P.I.	Lot
0+60	0+64 Rt	30'	43.32	45-79 46.4
1+13	1+18 Rt	30'	43.66	46-36 46.6
1+73	1+85 Rt	30'	44.18	46-56 46.8
2+46	2+50 Rt	30'	44.57	46-98 46.9
3+10	3+14 Rt	30'	44.95	47-36 47.1
3+79	3+83 Rt	30'	45.34	47-76 47.4
4+41	4+45 Rt	30'	45.74	48-21 48.1
5+16	5+19 Rt	30'	46.25	48-55 48.3
6+03	6+07 Rt	30'	46.82	49-10 49.1

SANTALINA DRIVE

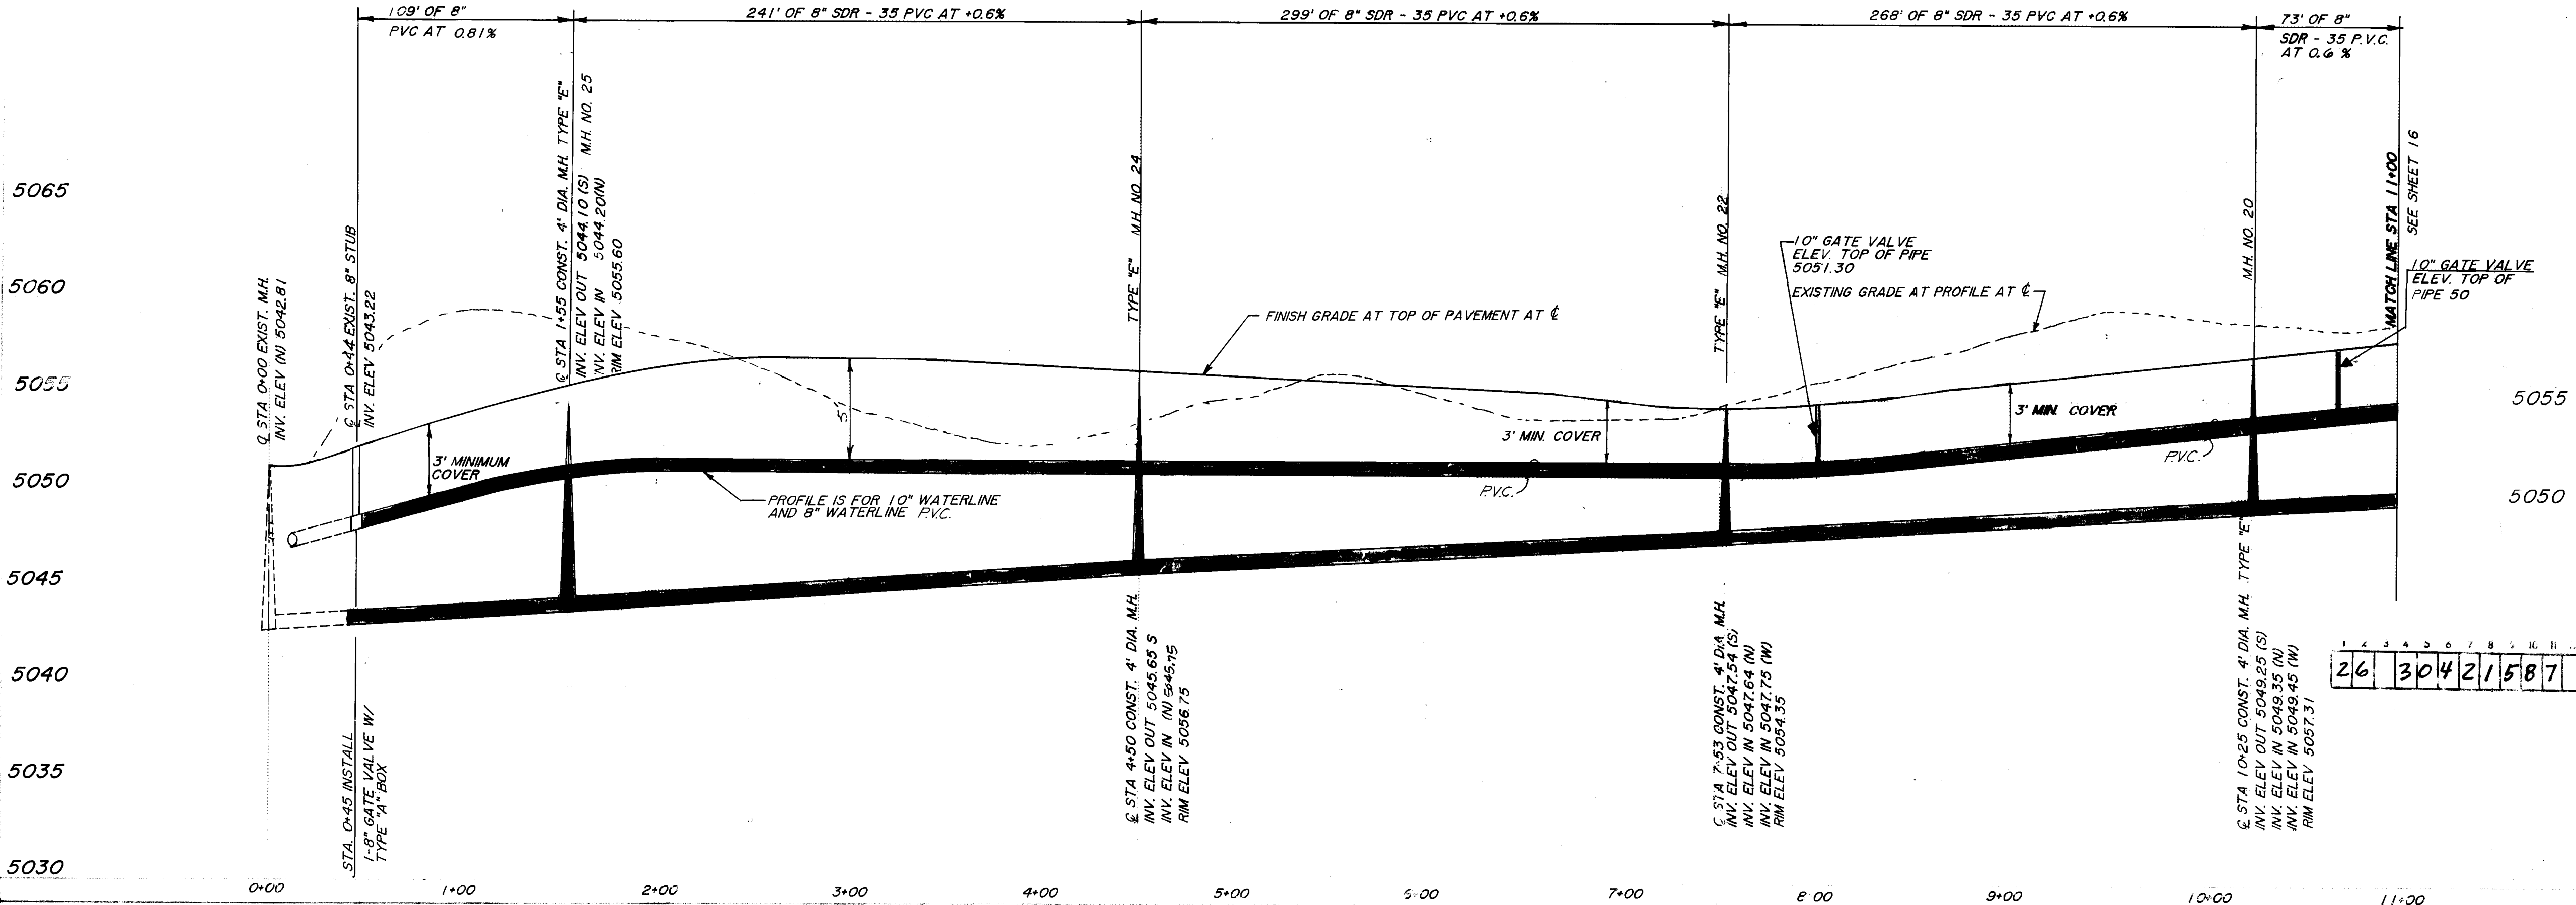

GENERAL NOTES

SEWER & WATER

1. ALL STATIONING REFERS TO Q STATIONING.
2. WHERE A WATER LINE PASSES BENEATH OR LESS THAN 3' ABOVE AN EXISTING SEWER LINE, THE SEWER LINE SHALL BE ENCASED IN CONCRETE AS PER STANDARD DRAWING S-10 FOR AT LEAST 10' ON EACH SIDE OF THE WATER LINE, OR THE SEWER LINE SHALL BE DUCTILE IRON PIPE WITH PRESSURE-TYPE JOINTS FOR 10' ON EACH SIDE OF THE WATER LINE. THIS SHALL ALSO APPLY WHERE A PARALLEL WATER LINE IS LESS THAN 10' HORIZONTAL AND LESS THAN 2' ABOVE THE SEWER LINE.

SANITARY SEWER LINES

1. ALL SANITARY SEWER MAINS SHALL BE 8" P.V.C. SDR-35.
2. MANHOLES SHALL BE TYPE "C" OR "E" AS SHOWN ON P & P SHEETS. THEY SHALL BE 4' IN DIAMETER UNLESS OTHERWISE SHOWN ON PLANS. AS PER CITY STD DWG S-1, S-2.
3. ALL SANITARY SEWER SERVICE LINES ARE TO BE LOCATED 10' FROM THE LOW SIDE PROPERTY CORNER AS PER CITY STD DWG S-9 (TYPICAL).

WATER LINES

1. WATER LINES SHALL BE LOCATED 10' NORTH OR WEST OF THE STREET EXCEPT AS OTHERWISE SHOWN ON PLANS.
2. MINIMUM COVER FOR WATER LINES SHALL BE 3'.
3. ALL FIRE HYDRANTS, VALVES AND FITTINGS SHALL BE PROVIDED WITH CONCRETE BLOCKING AS PER CITY STANDARDS.
4. ALL FIRE HYDRANTS SHALL HAVE A MINIMUM BURY OF 4'.
5. GATE VALVES SHALL BE RESILIENT SEAT GATE VALVES.
6. WATER SERVICES SHALL BE LOCATED 10' FROM HIGH SIDE OF PROPERTY CORNER OR AS OTHERWISE INDICATED.
7. DEFLECTION OFFSETS PER 20' LENGTH SHALL NOT EXCEED THE FOLLOWING CRITERIA:

PIPE SIZE

PIPE SIZE	NEW	EXISTING
6" Ø	10	10 1/2"
8" Ø	8	8"
10" Ø	6	6"

DESCRIPTION

DESCRIPTION	NEW	EXISTING
SANITARY SEWER LINE	---	---
ENCASEMENT	---	---
SANITARY SEWER MANHOLE	---	---
SAS SERVICE CONNECTION	---	---
STORM DRAIN LINE	---	---
STORM DRAIN MANHOLE	---	---
STORM DRAIN INLETS	---	---
WATER LINE	---	---
GATE VALVE	---	---
BUTTERFLY VALVE	---	---
FIRE HYDRANTS	---	---
REDUCERS	---	---
WATER SERVICE CONNECTION	---	---
TEES	---	---
CROSSES	---	---
BENDS	---	---
CAPS & PLUGS	---	---
EXISTING GROUND	---	---
TOP OF CURB	---	---
SANITARY SEWER LINE	---	---
MANHOLES (ALL)	---	---
STORM DRAIN LINES	---	---
WATER LINES	---	---
VERTICAL BENDS	---	---

CITY OF ALBUQUERQUE
MUNICIPAL DEVELOPMENT DEPARTMENT
ENGINEERING DIVISION

TITLE
**PRAIRIE RIDGE UNIT II UTILITIES
SANTALINA DRIVE 0+00 TO 11+00**

DESIGN	ENGINEER	DATE	APPROVALS	ENGINEER	DATE
City Engineer	John H. [Signature]	10/21/86	City Engineer	John H. [Signature]	10/21/86
A.C.E. Design	NA DWH	10/21/86	City Engineer	John H. [Signature]	10/21/86
A.C.E. Hydrology	NA DWH	10/21/86	City Engineer	John H. [Signature]	10/21/86

DRAWING NO. **3042** MAP NO. E-12-Z SHEET 15 OF 23