


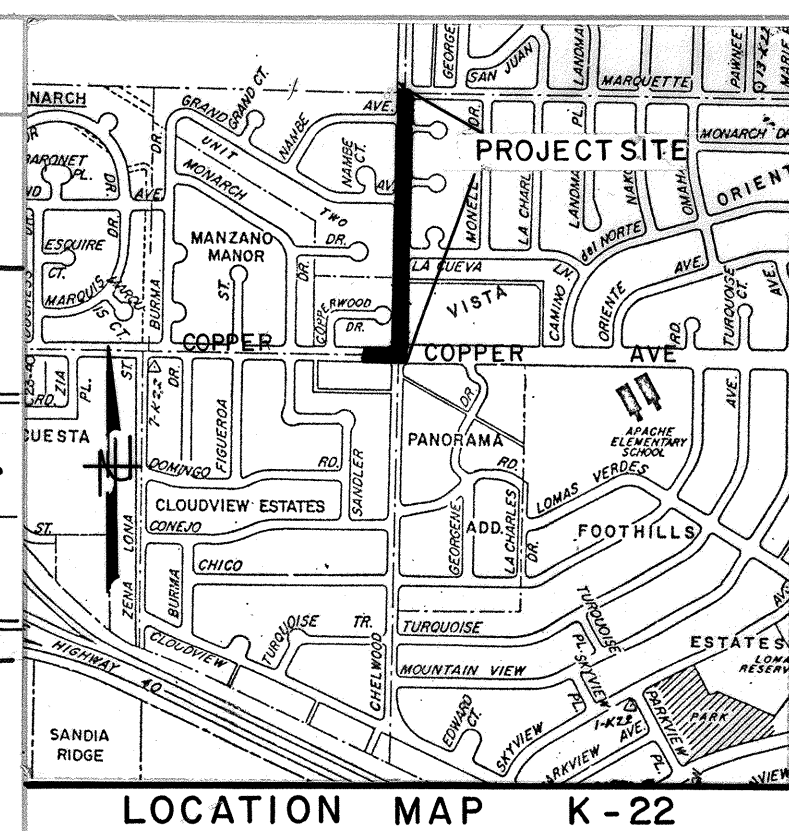

2. Two (2) working days prior to any excavation, the contractor must contact Line Locating Service, 765-1234, for location of existing utilities.
3. Prior to construction, the contractor shall excavate and verify the horizontal and vertical locations of all obstructions. Should a conflict exist, the contractor shall notify the engineer or surveyor so that the conflict can be resolved with minimum amount of delay.



- ☒ All utilities and utility service lines shall be installed prior to paving.
- ☒ Backfill compaction shall be according to specified street use.
- ☐ Tack coat requirements shall be determined by the City Engineer.
- ☐ Sidewalks and wheelchair ramps within the curb return shall be constructed wherever a new curb return is constructed.
- ☐ If curb is depressed for a driveway or a handicap ramp, the driveway or ramp shall be constructed prior to acceptance of the curb and gutter.
- ☒ All storm drainage facilities shall be completed prior to final acceptance.

- ① MANHOLE PER STD. DWG. S-2
CITY OF ALBUQUERQUE INTERM. STD.
- ② ARTERIAL PAVEMENT REMOVAL AND
REPLACEMENT INCLUDING COMPACTION.
- ③ EXISTING UTILITIES ARE SHOWN IN THEIR
APPROXIMATE LOCATION ONLY. CONTRAC-
TOR SHALL BE RESPONSIBLE FOR FIELD
VERIFICATION OF THEIR ACTUAL LOCATION.
ALL WORK RELATED TO THE PROTECTION
AND OR RELOCATION OF EXISTING UTILI-
TIES, SHALL BE CONSIDERED INCIDENTAL
TO CONSTRUCTION OF THIS PROJECT.
- ④ SURVEY BASELINE (SEE PLAN VIEW)

APPROVED FOR
CONSTRUCTION
Chris E. [Signature]
CIVIL ENGINEER 12/31/88

TITLE: INSTALLATION OF NEW INLETS ON
CHELWOOD PARK AVE & COPPER AVE
(BETWEEN MARQUETTE AVE & COPPER AVE)

DRAWING NO.	30 48	MAP NO. K-22	SHEET 1	OF 1
----------------	-------	-----------------	------------	---------

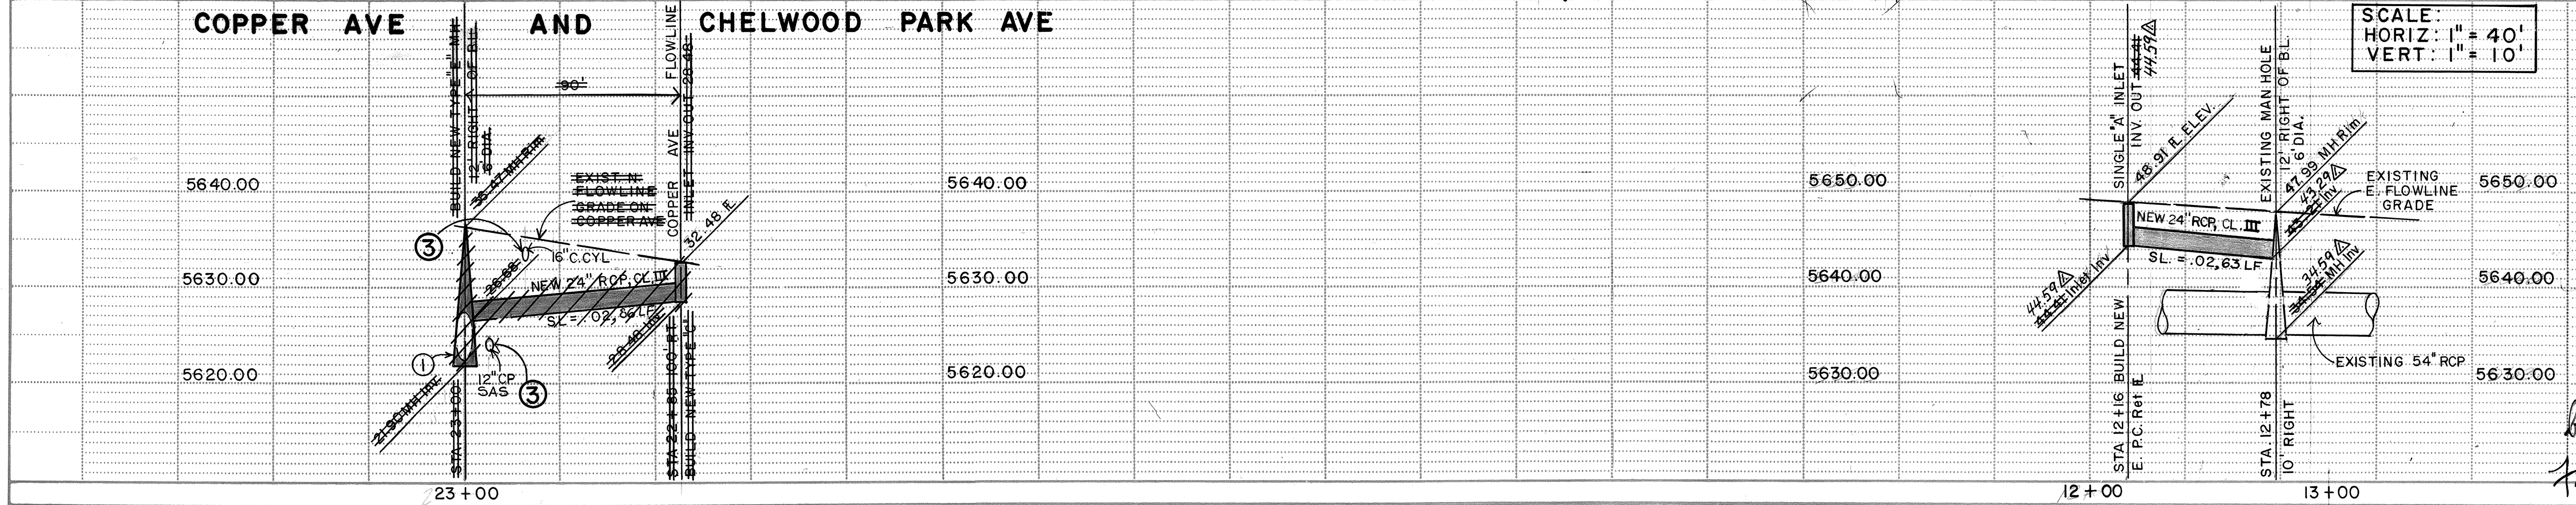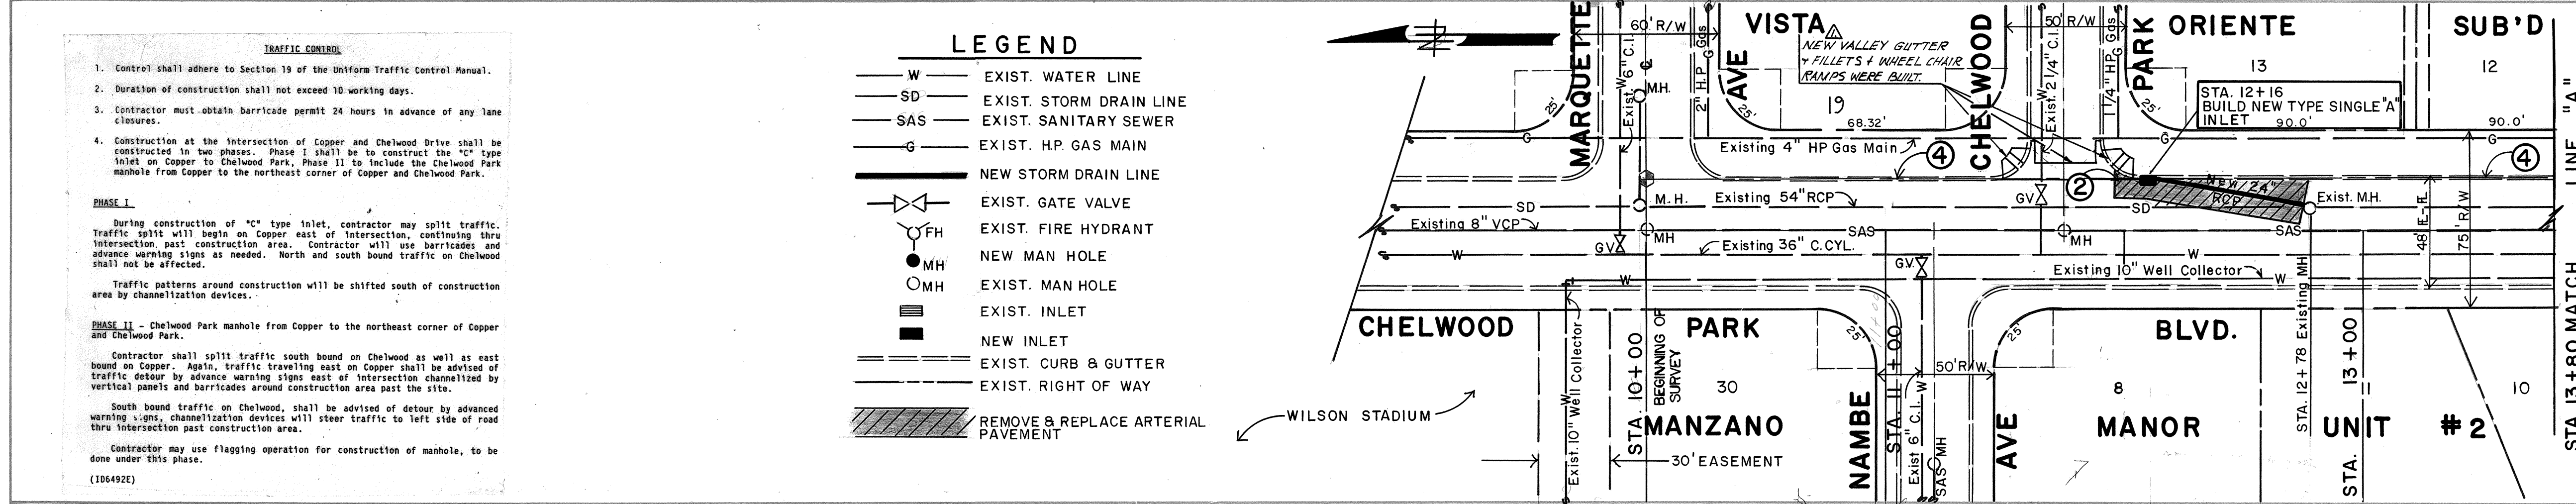

DRAWING NO.	30 48	MAP NO. K-22	SHEET 1	OF 1
----------------	-------	-----------------	------------	---------