
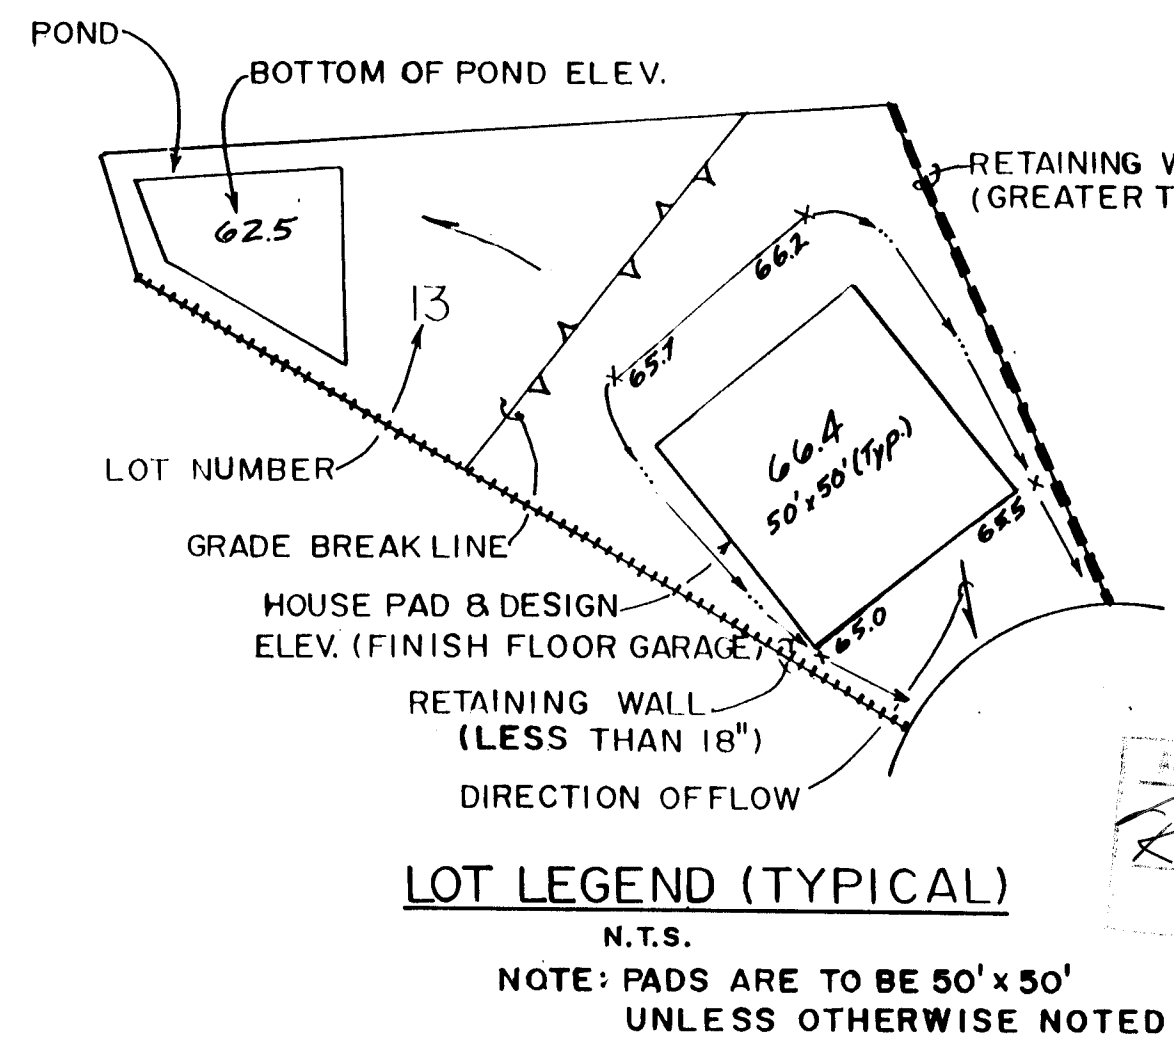
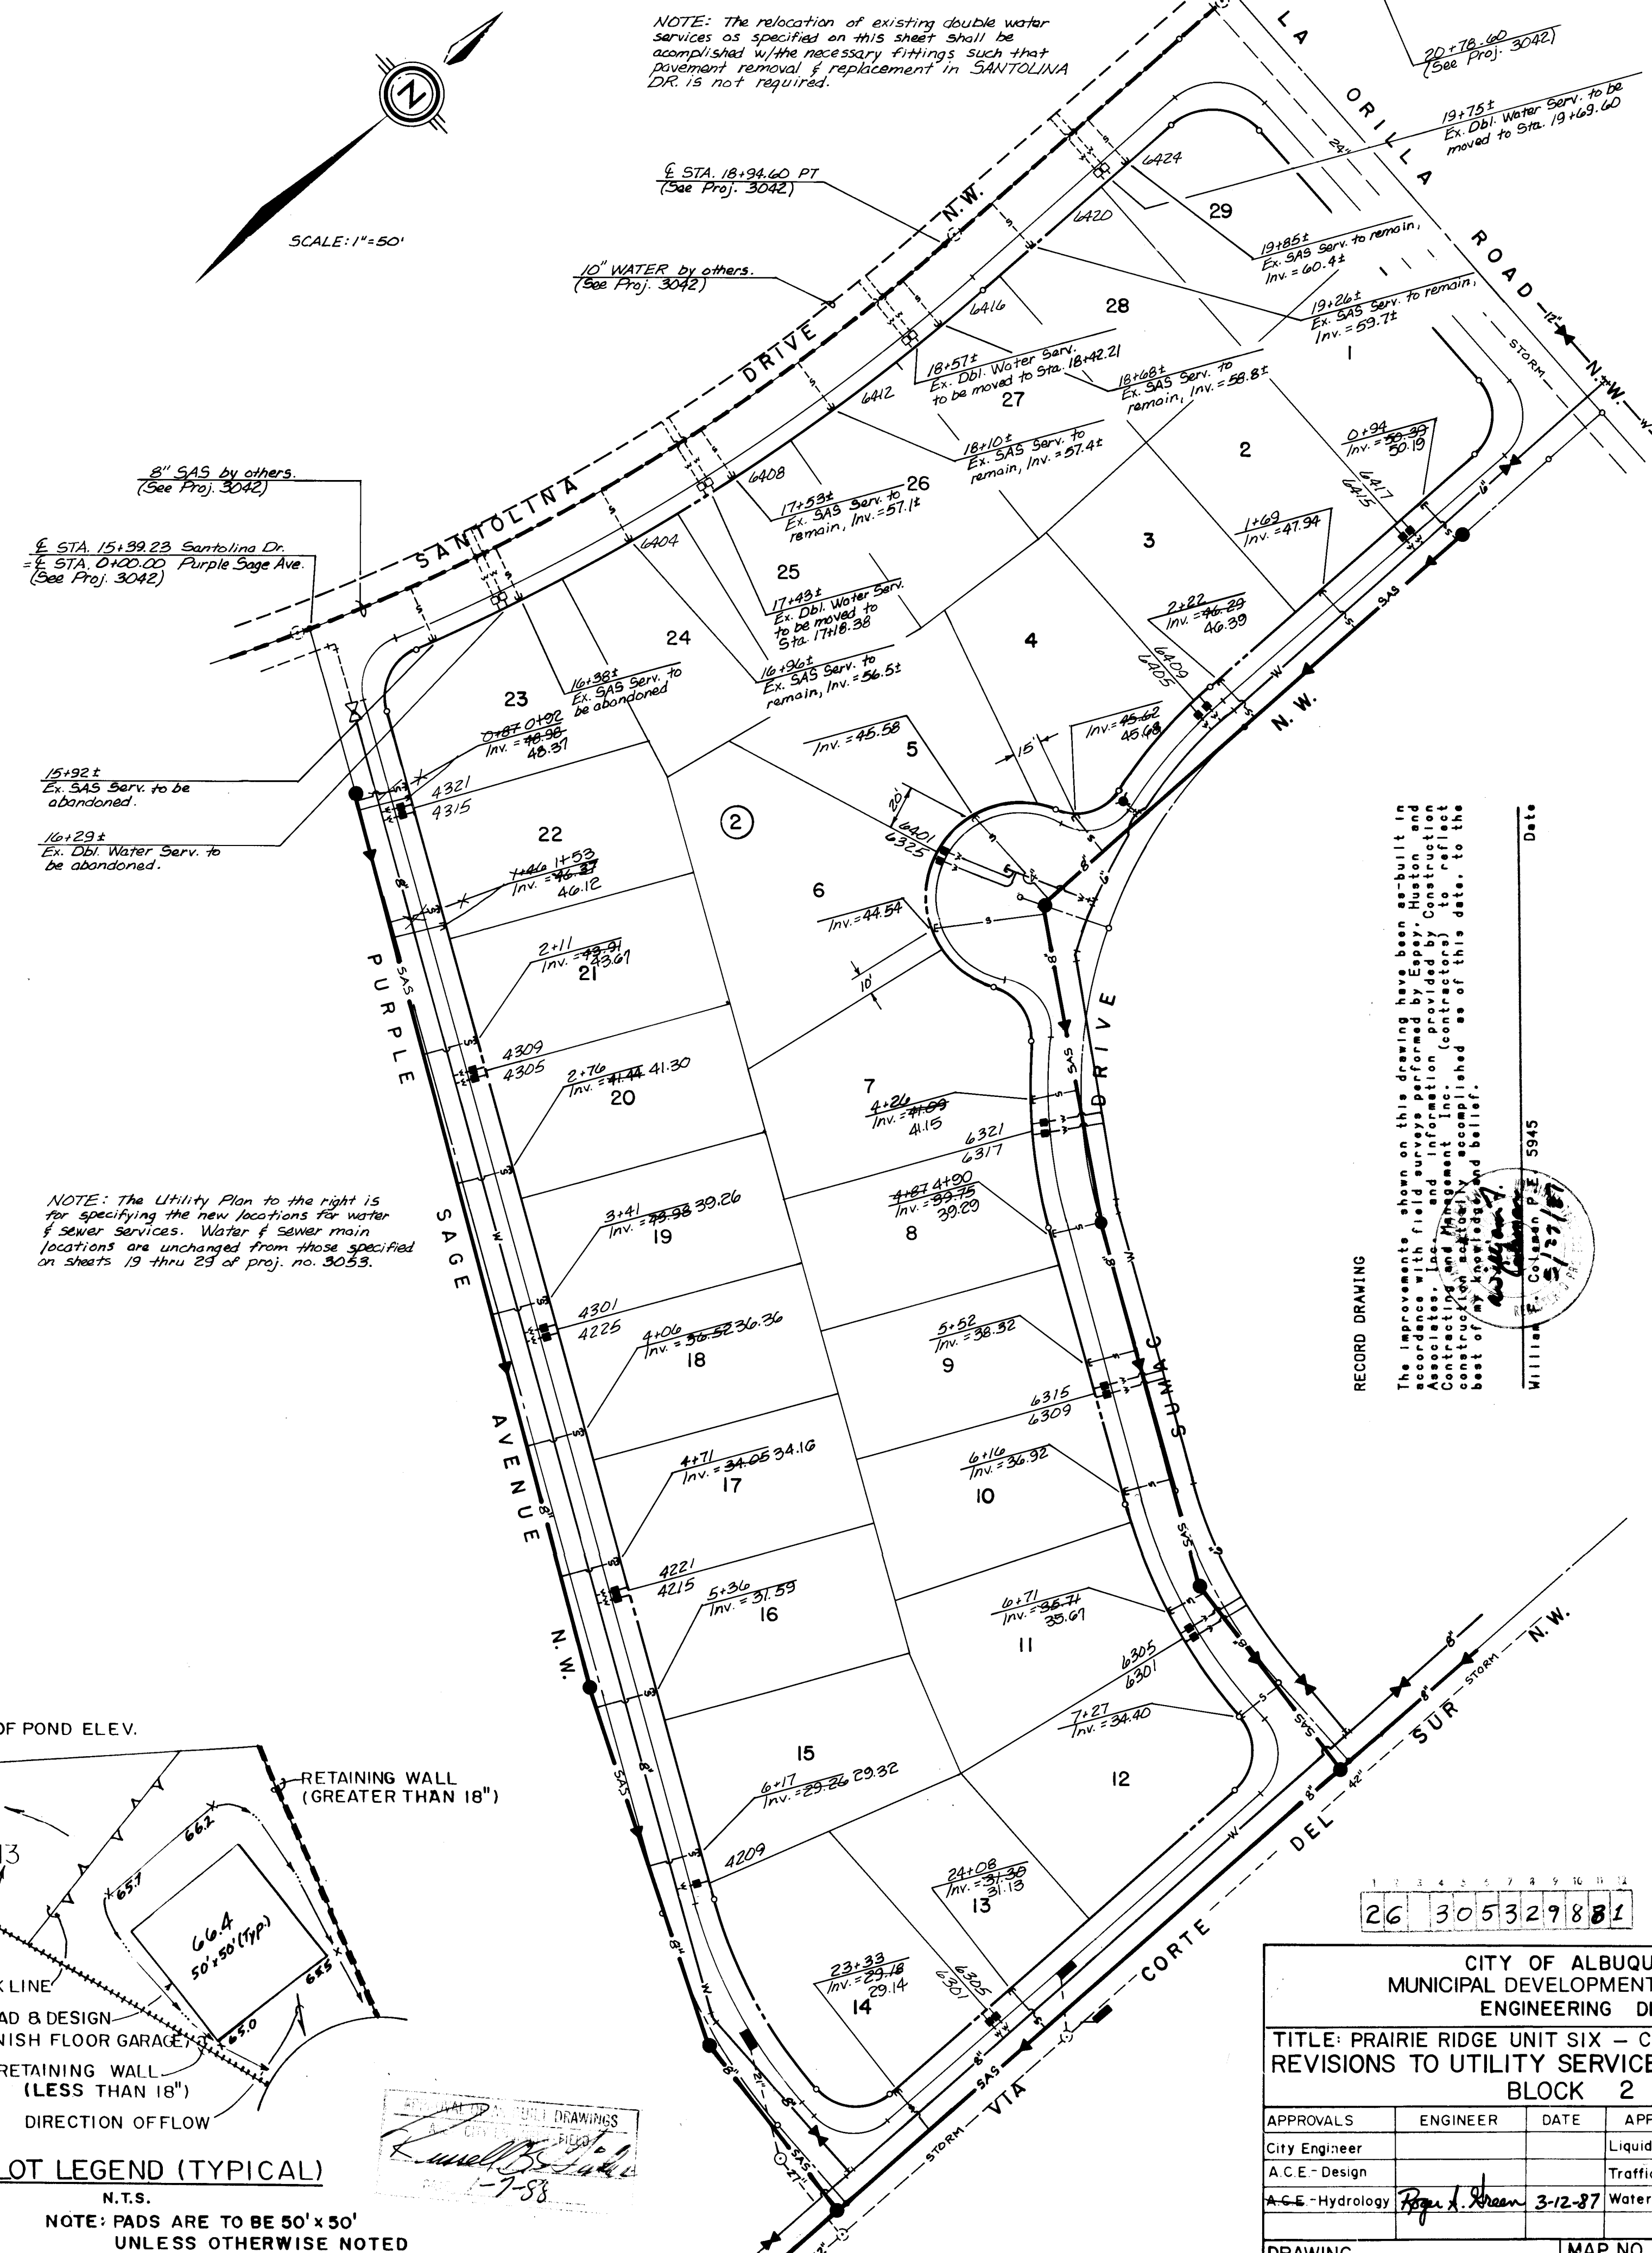


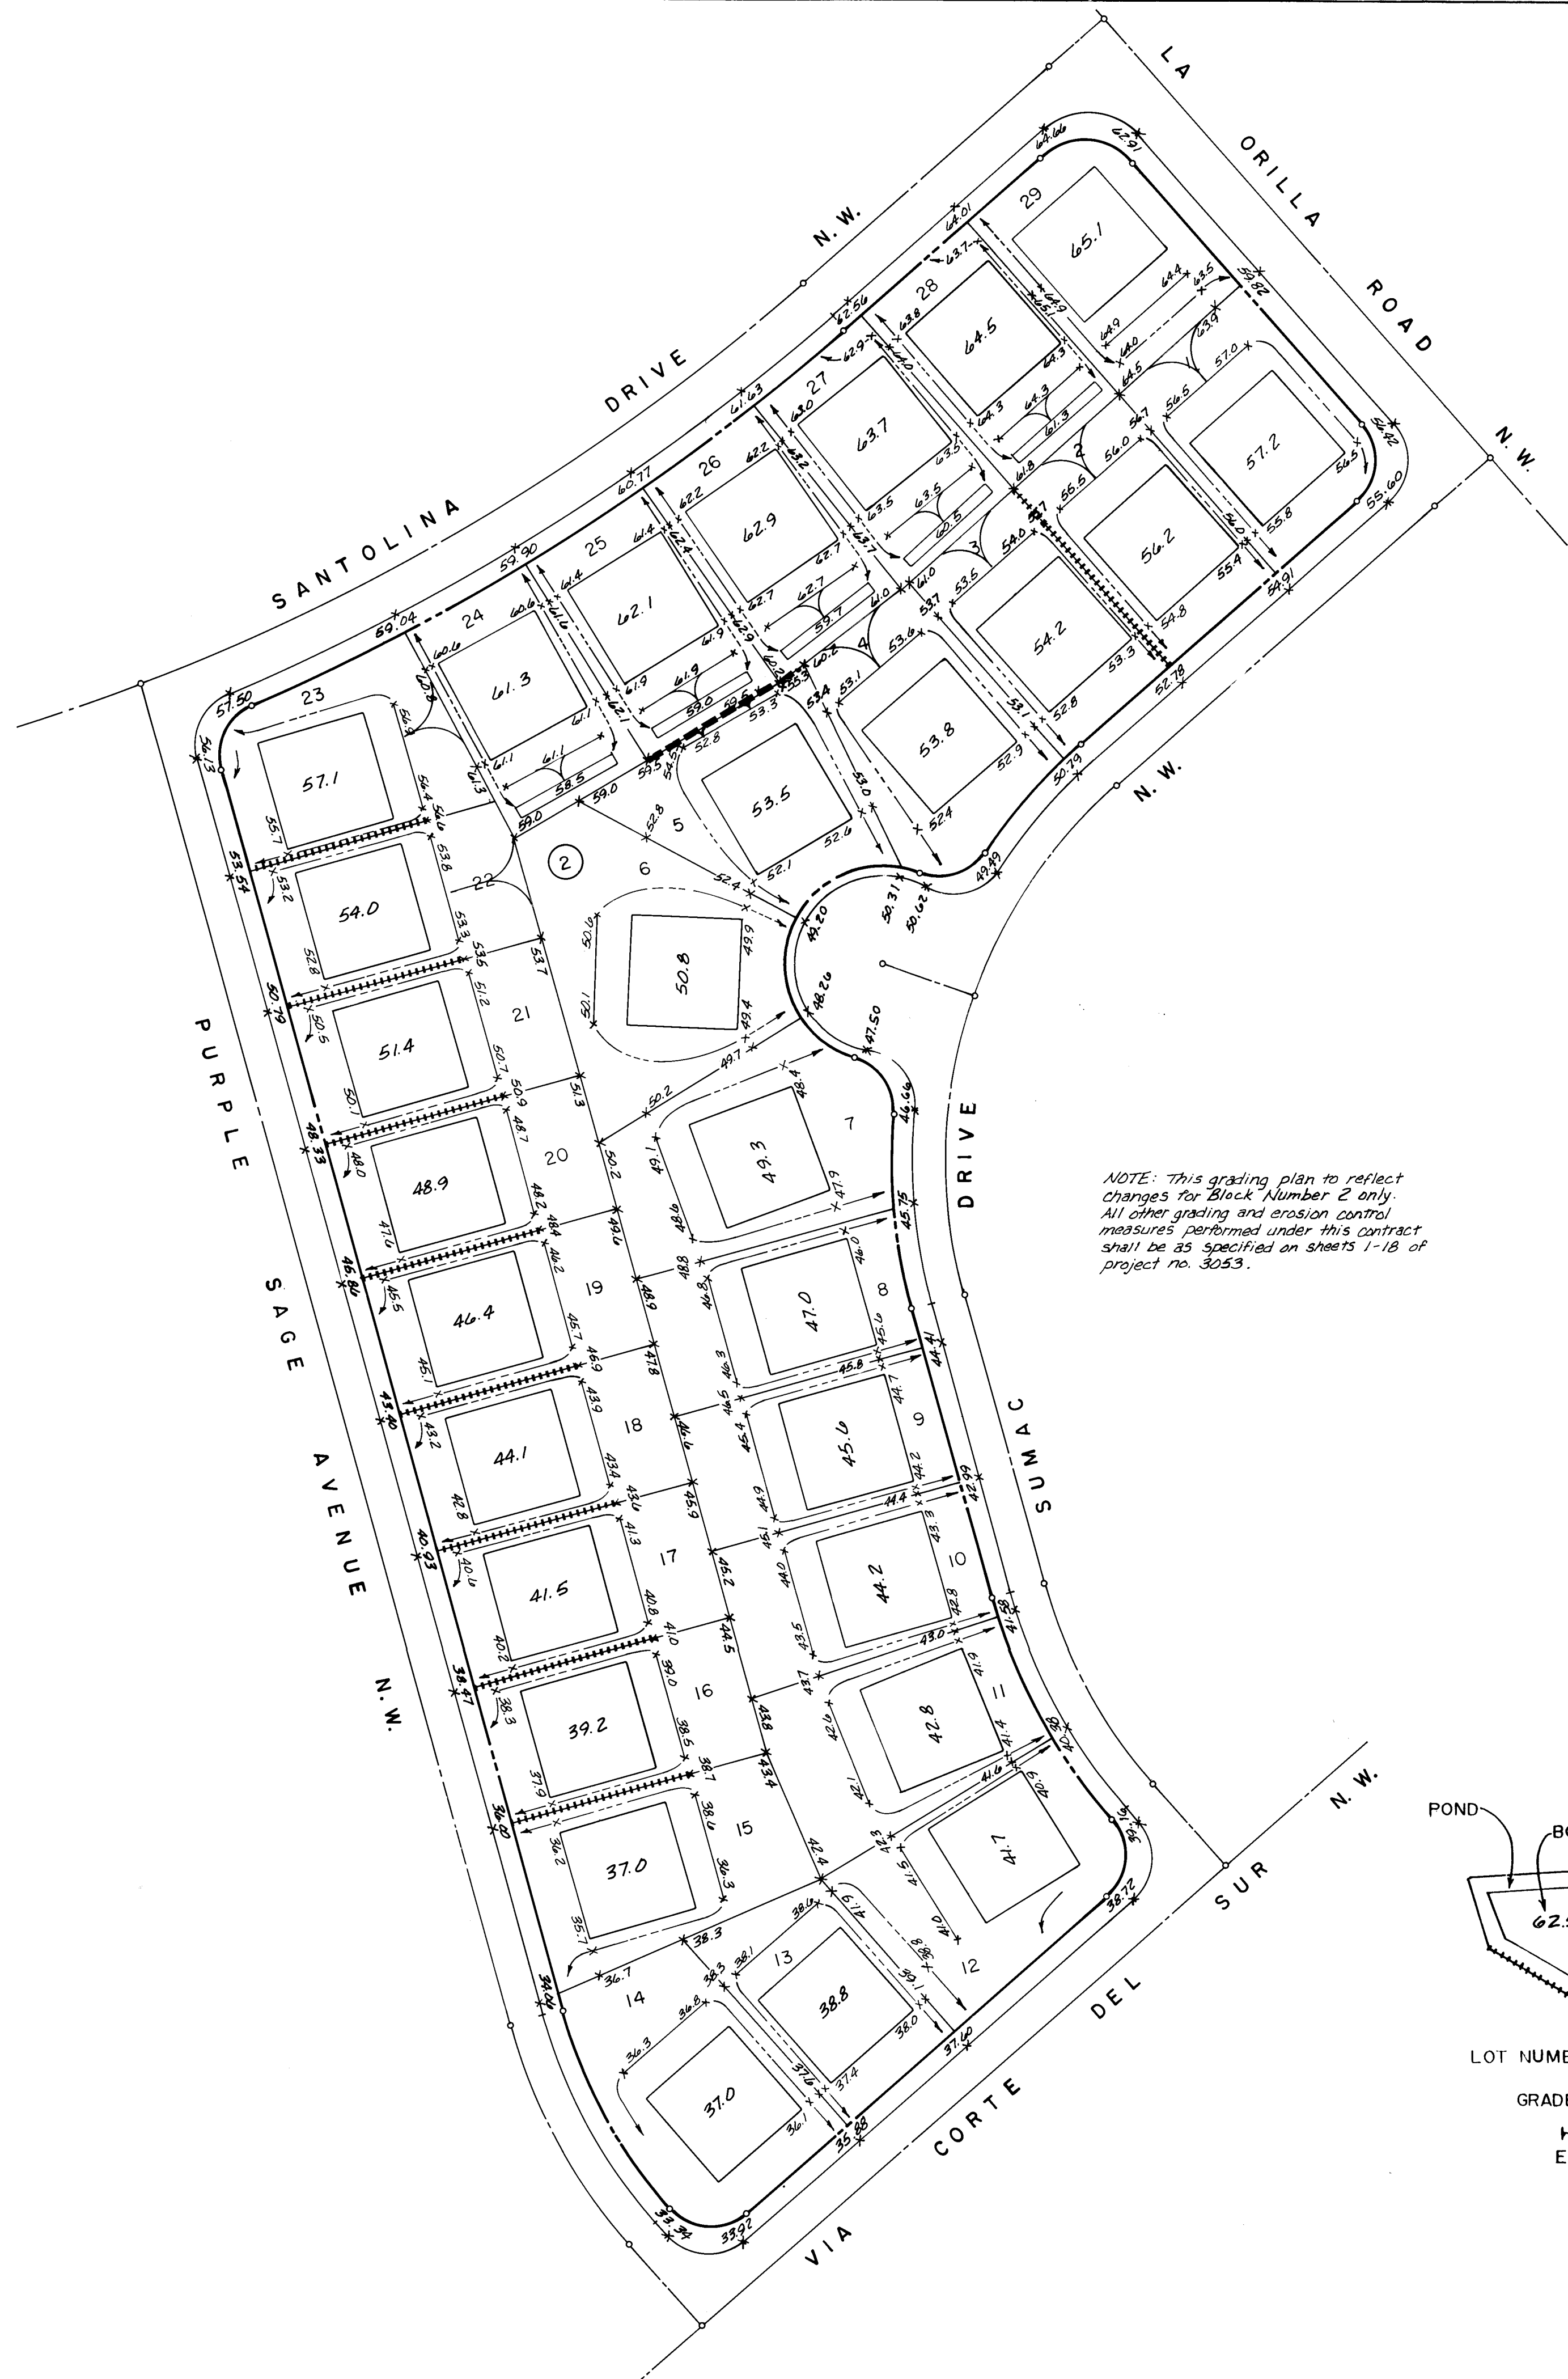

CITY OF ALBUQUERQUE MUNICIPAL DEVELOPMENT DEPARTMENT ENGINEERING DIVISION					
TITLE: PRAIRIE RIDGE UNIT SIX - CHANGE ORDER NO. 1 - REVISIONS TO UTILITY SERVICES AND GRADING FOR BLOCK 2					
APPROVALS	ENGINEER	DATE	APPROVALS	ENGINEER	DATE
City Engineer			Liquid Waste		
A.C.E. - Design			Traffic		
A.C.E. - Hydrology			Water		
DRAWING NO. 3053		MAP NO. D-12		SHEET OF 1	

AS BUILT INFORMATION		BENCH MARKS		SURVEY INFORMATION		ENGINEER'S SEAL	
CONTRACTOR	CCM	DATE	2/87	FIELD NOTES	BY	DATE	2/87
WORK	CCM	DATE	2/87	NO.			
STAKED BY	EH&A	DATE	2/87				
FIELD	EH&A	DATE	2/87				
ACCEPTANCE BY	EH&A	DATE	2/87				
REVISIONS	EH&A	DATE	2/87				
CORRECTED BY	EH&A	DATE	2/87				
RECORDED BY	NO	DATE					