
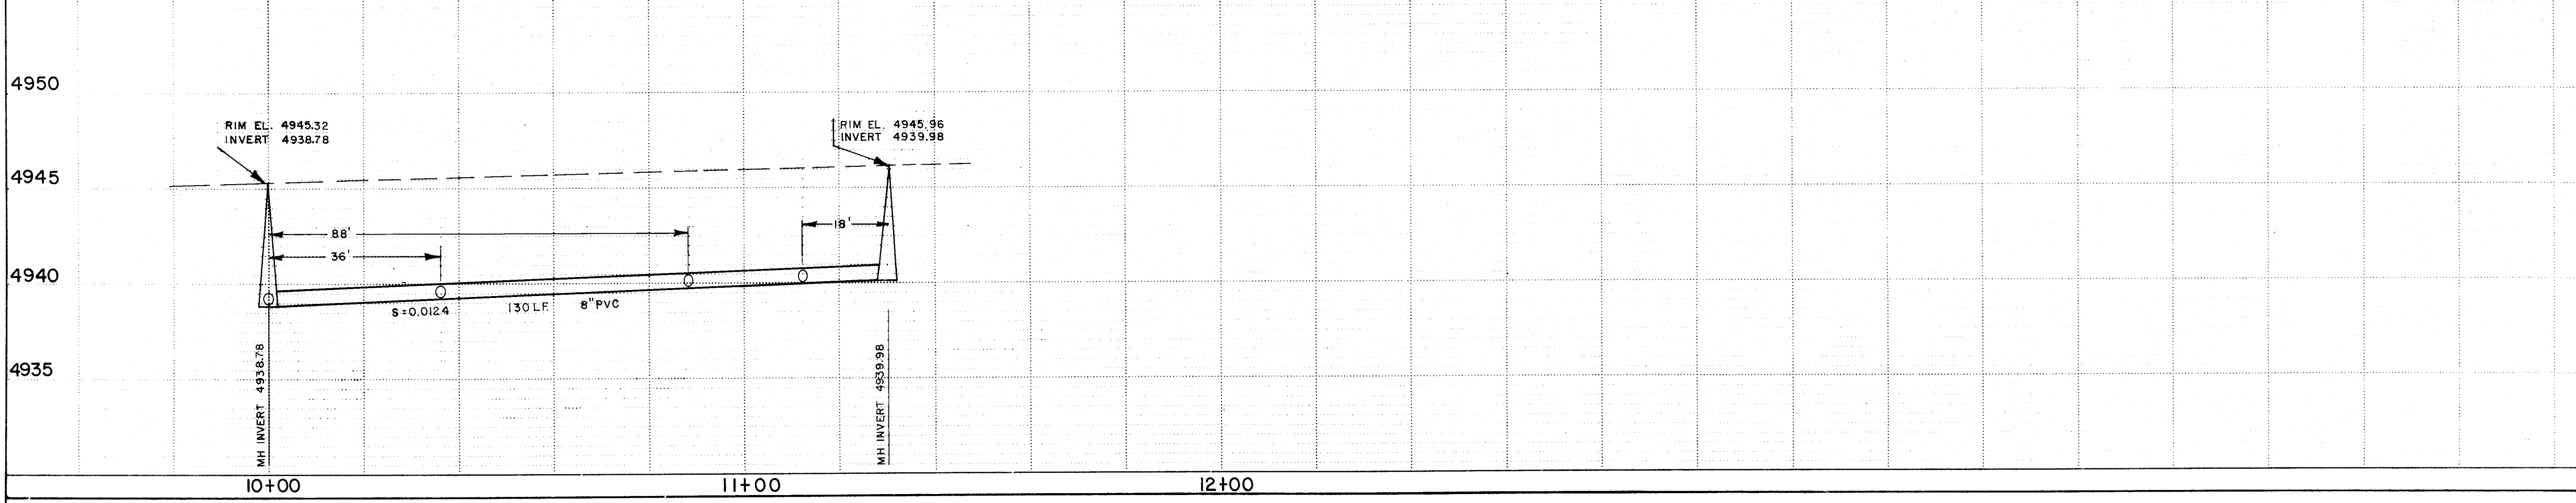
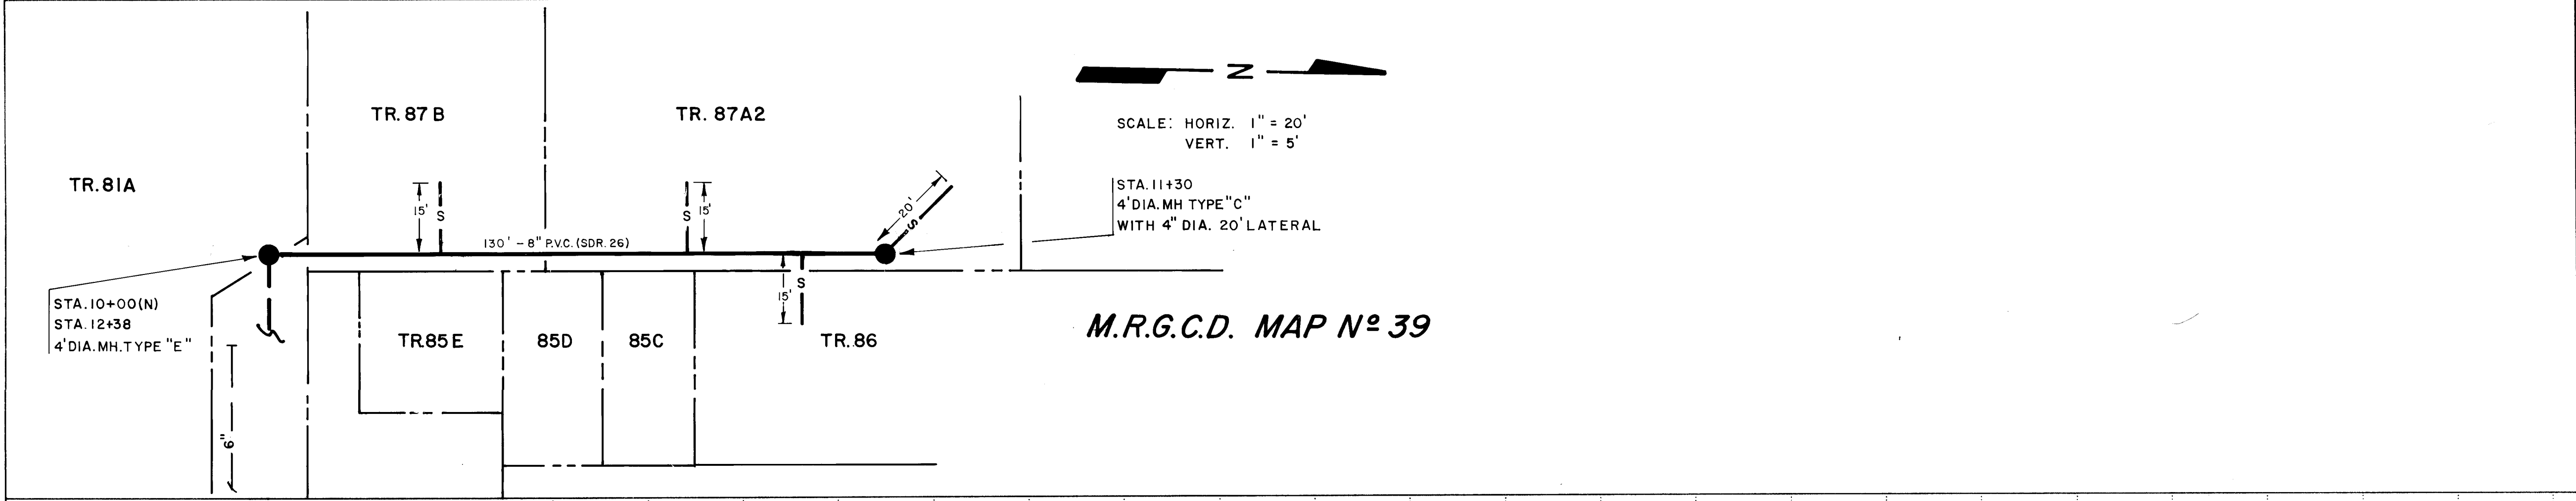
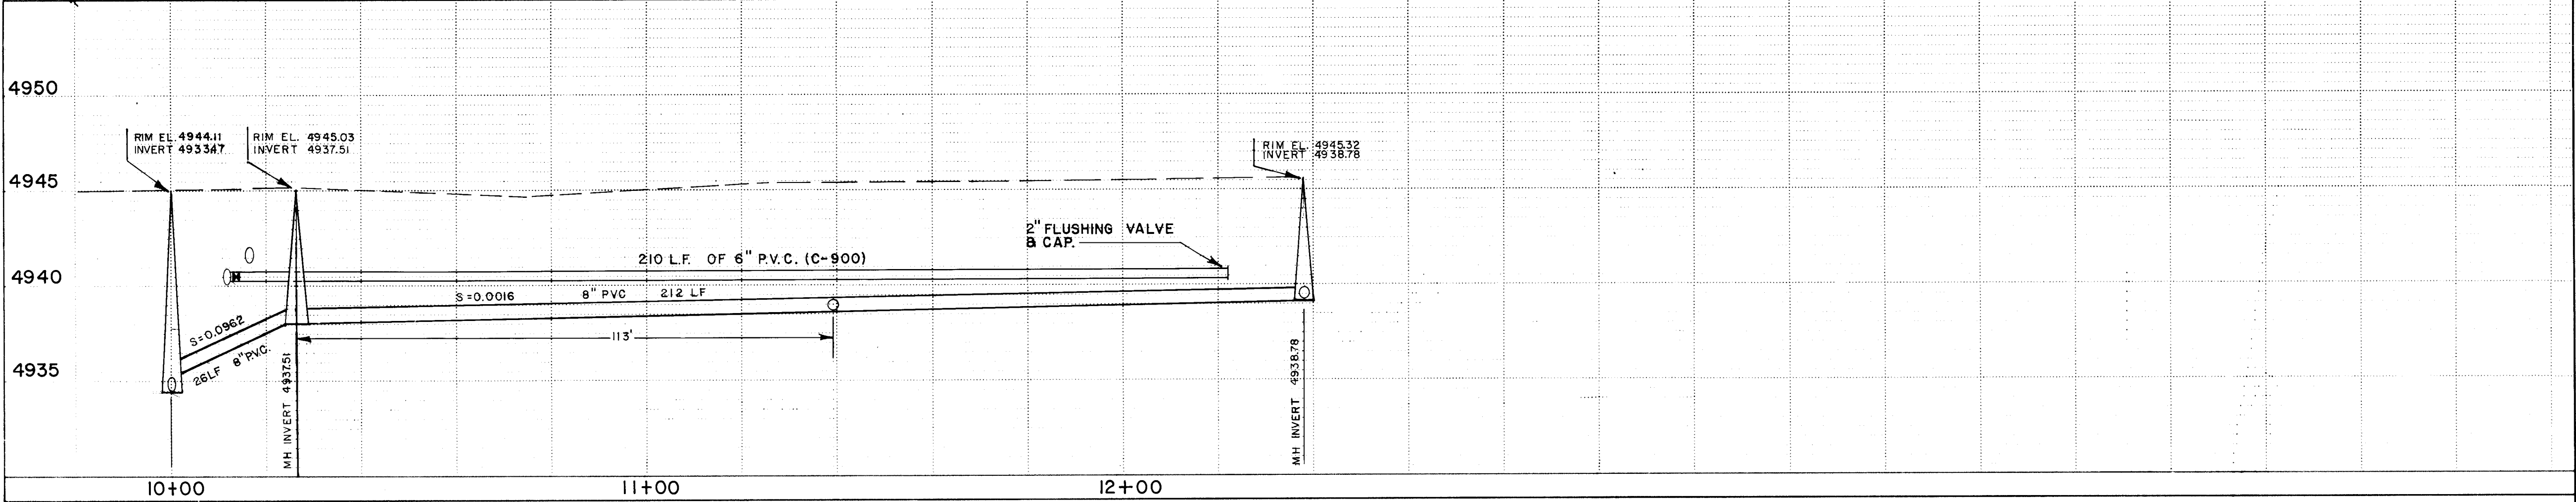


E N H 100

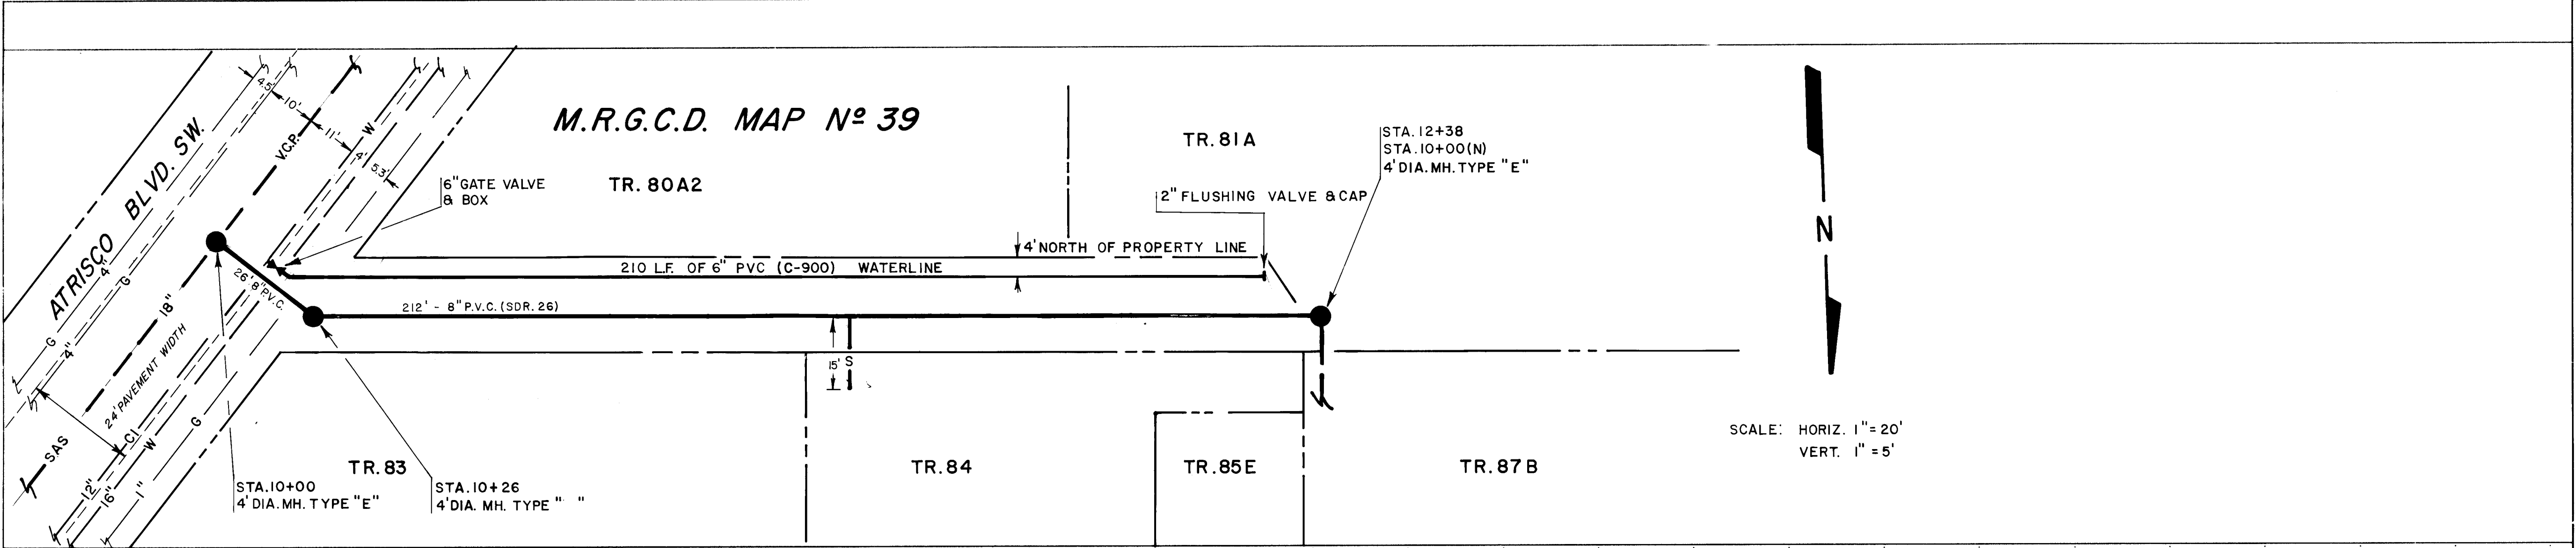

AS BUILT INFORMATION		BENCH MARKS		SURVEY INFORMATION		ENGINEER'S SEAL	
CONTRACTOR SUPER EXCAVATORS OF N.M.	NO. 11-K12	60-PENNY NAIL IN EAST SIDE OF POWER	NO. 11-K12	DATE	BY	DATE	BY
WORK BY SAME	DATE 3/06	POLE NO. 887 LOCATED NW CORNER OF INTERSECTION	DATE 3/06	DATE	BY	DATE	BY
INSPECTED BY	DATE 3/06	OF GONZALES RD. AND ATRISCO RD., SW.	DATE 3/06	DATE	BY	DATE	BY
ACCEPTANCE BY W.U.D.	DATE 3/06		DATE 3/06	DATE	BY	DATE	BY
FIELD DRAWINGS	DATE 3/06		DATE 3/06	DATE	BY	DATE	BY
CORRECTED BY A.R.P.	DATE 7/06		DATE 7/06	DATE	BY	DATE	BY
RECORDED BY	DATE		DATE	DATE	BY	DATE	BY
NO			NO				

2630600186

APPROVED BY
Brian Dolan
10/10/06

CITY OF ALBUQUERQUE WATER UTILITIES DEPARTMENT ENGINEERING DIVISION					
TITLE: 8" SANITARY SEWER & 6" WATERLINE EXTENSION WEST OF ATRISCO RD. SW. BTW. MAE AVE. SW. & GONZALES RD. SW.					
APPROVALS	ENGINEER	DATE	APPROVALS	ENGINEER	DATE
City Engineer			Liquid Waste		
A C E - Design			Traffic		
A C E - Hydrology			Water		

DRAWING NO.	MAP NO.	SHEET	OF
3060	K-12	1	1