


RIO GRANDE SWIM & TENNIS CLUB

TRACT A

FERNANDO ADDITION

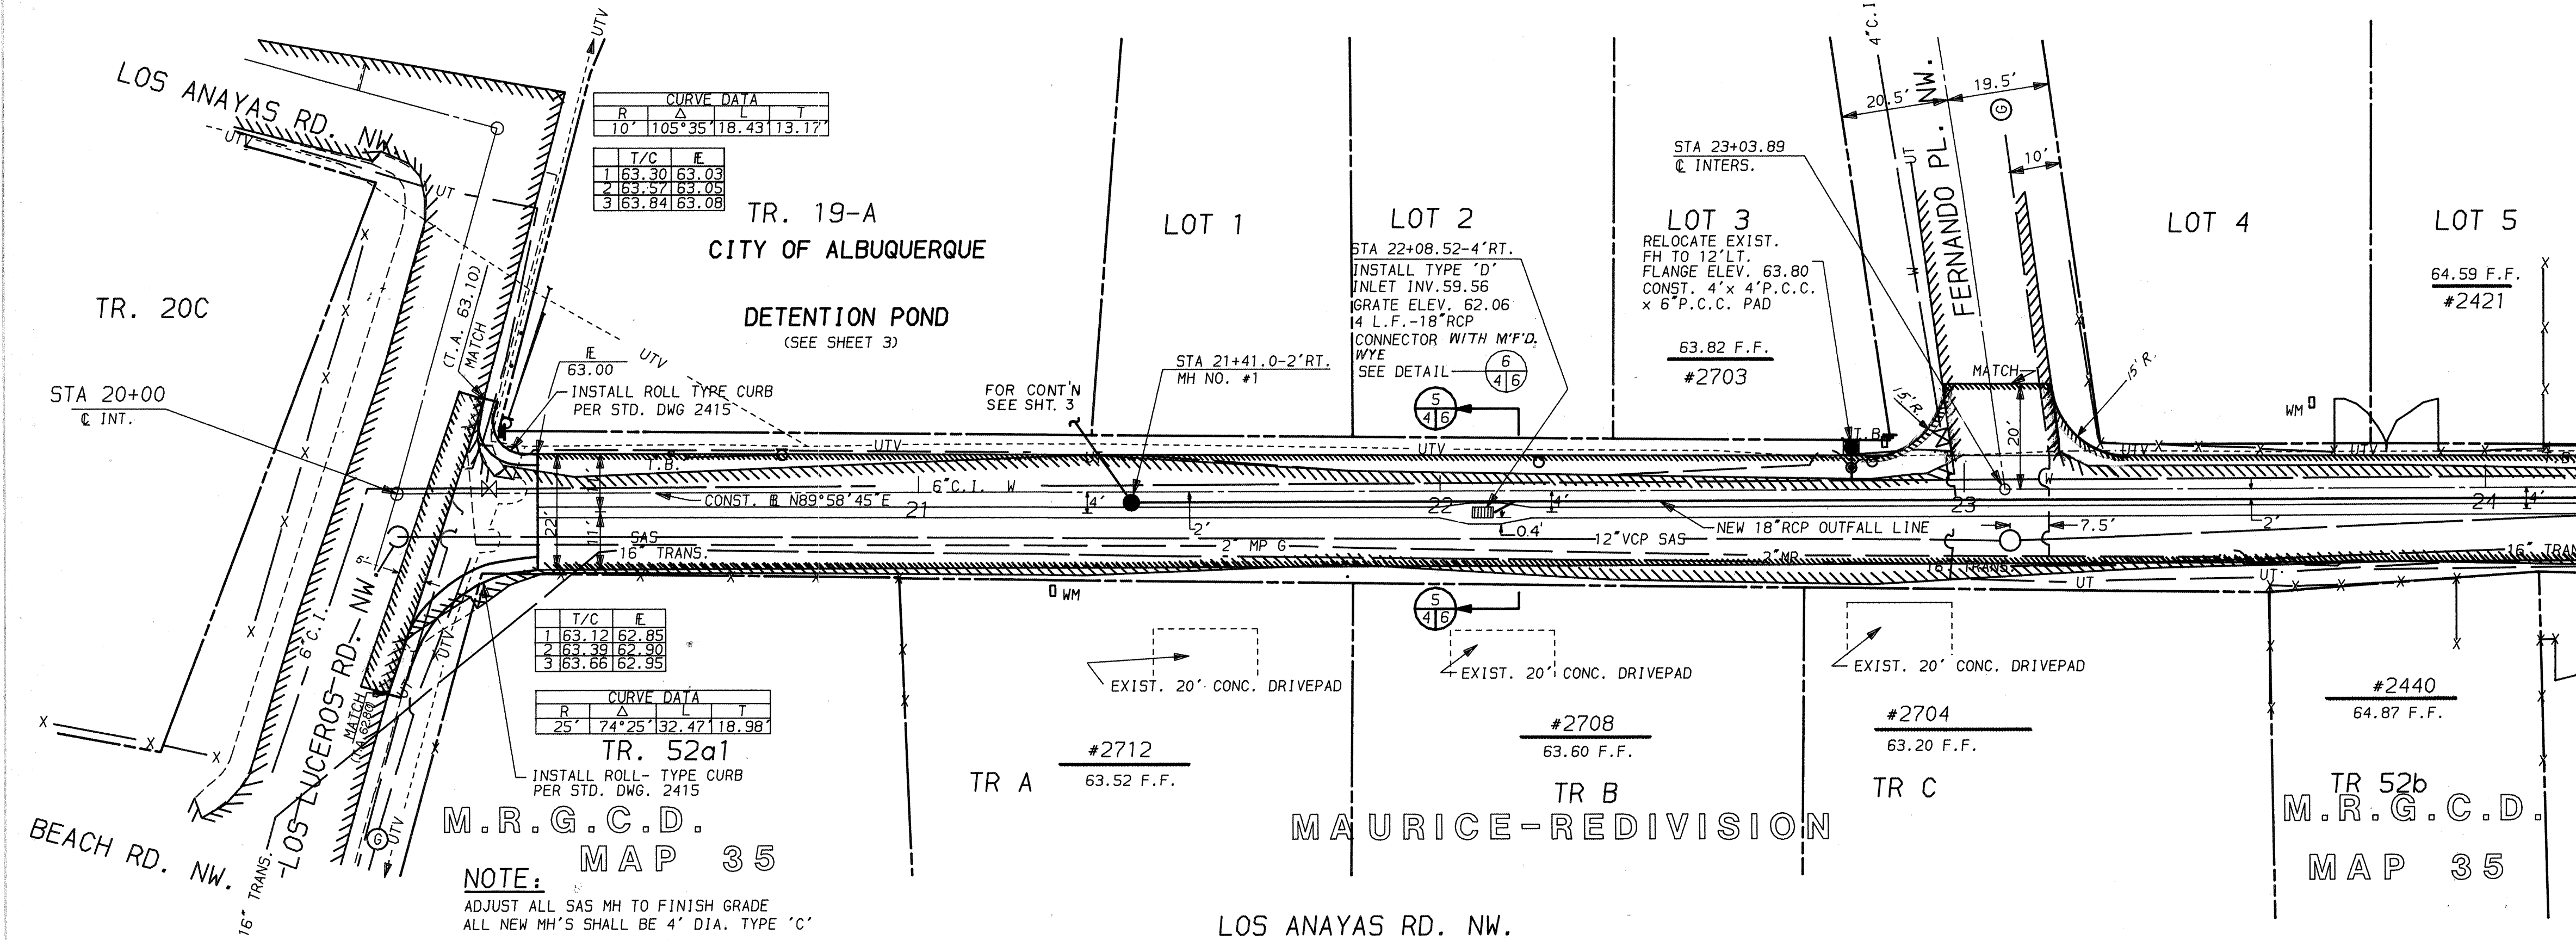


NOTE:
ADJUST ALL SAS MH TO FINISH GRADE
ALL NEW MH'S SHALL BE 4' DIA. TYPE 'C'

SCALE: 1"=20'

- LEGEND**
- TRAFFIC SIGN
 - P.P.
 - TELEPHONE BOX
 - WATER METER
 - CHAINLINK FENCE
 - WOOD FENCE
 - P.P./GUYWIRE
 - FIRE HYDRANT
 - EDGE OF PAVEMENT
 - EXIST. 2"MP GAS LINE
 - EXIST. WATER VALVE
 - EXIST. MANHOLE



PROFILE
HORIZONTAL SCALE: 1"=20'
VERTICAL SCALE: 1"=2.5'

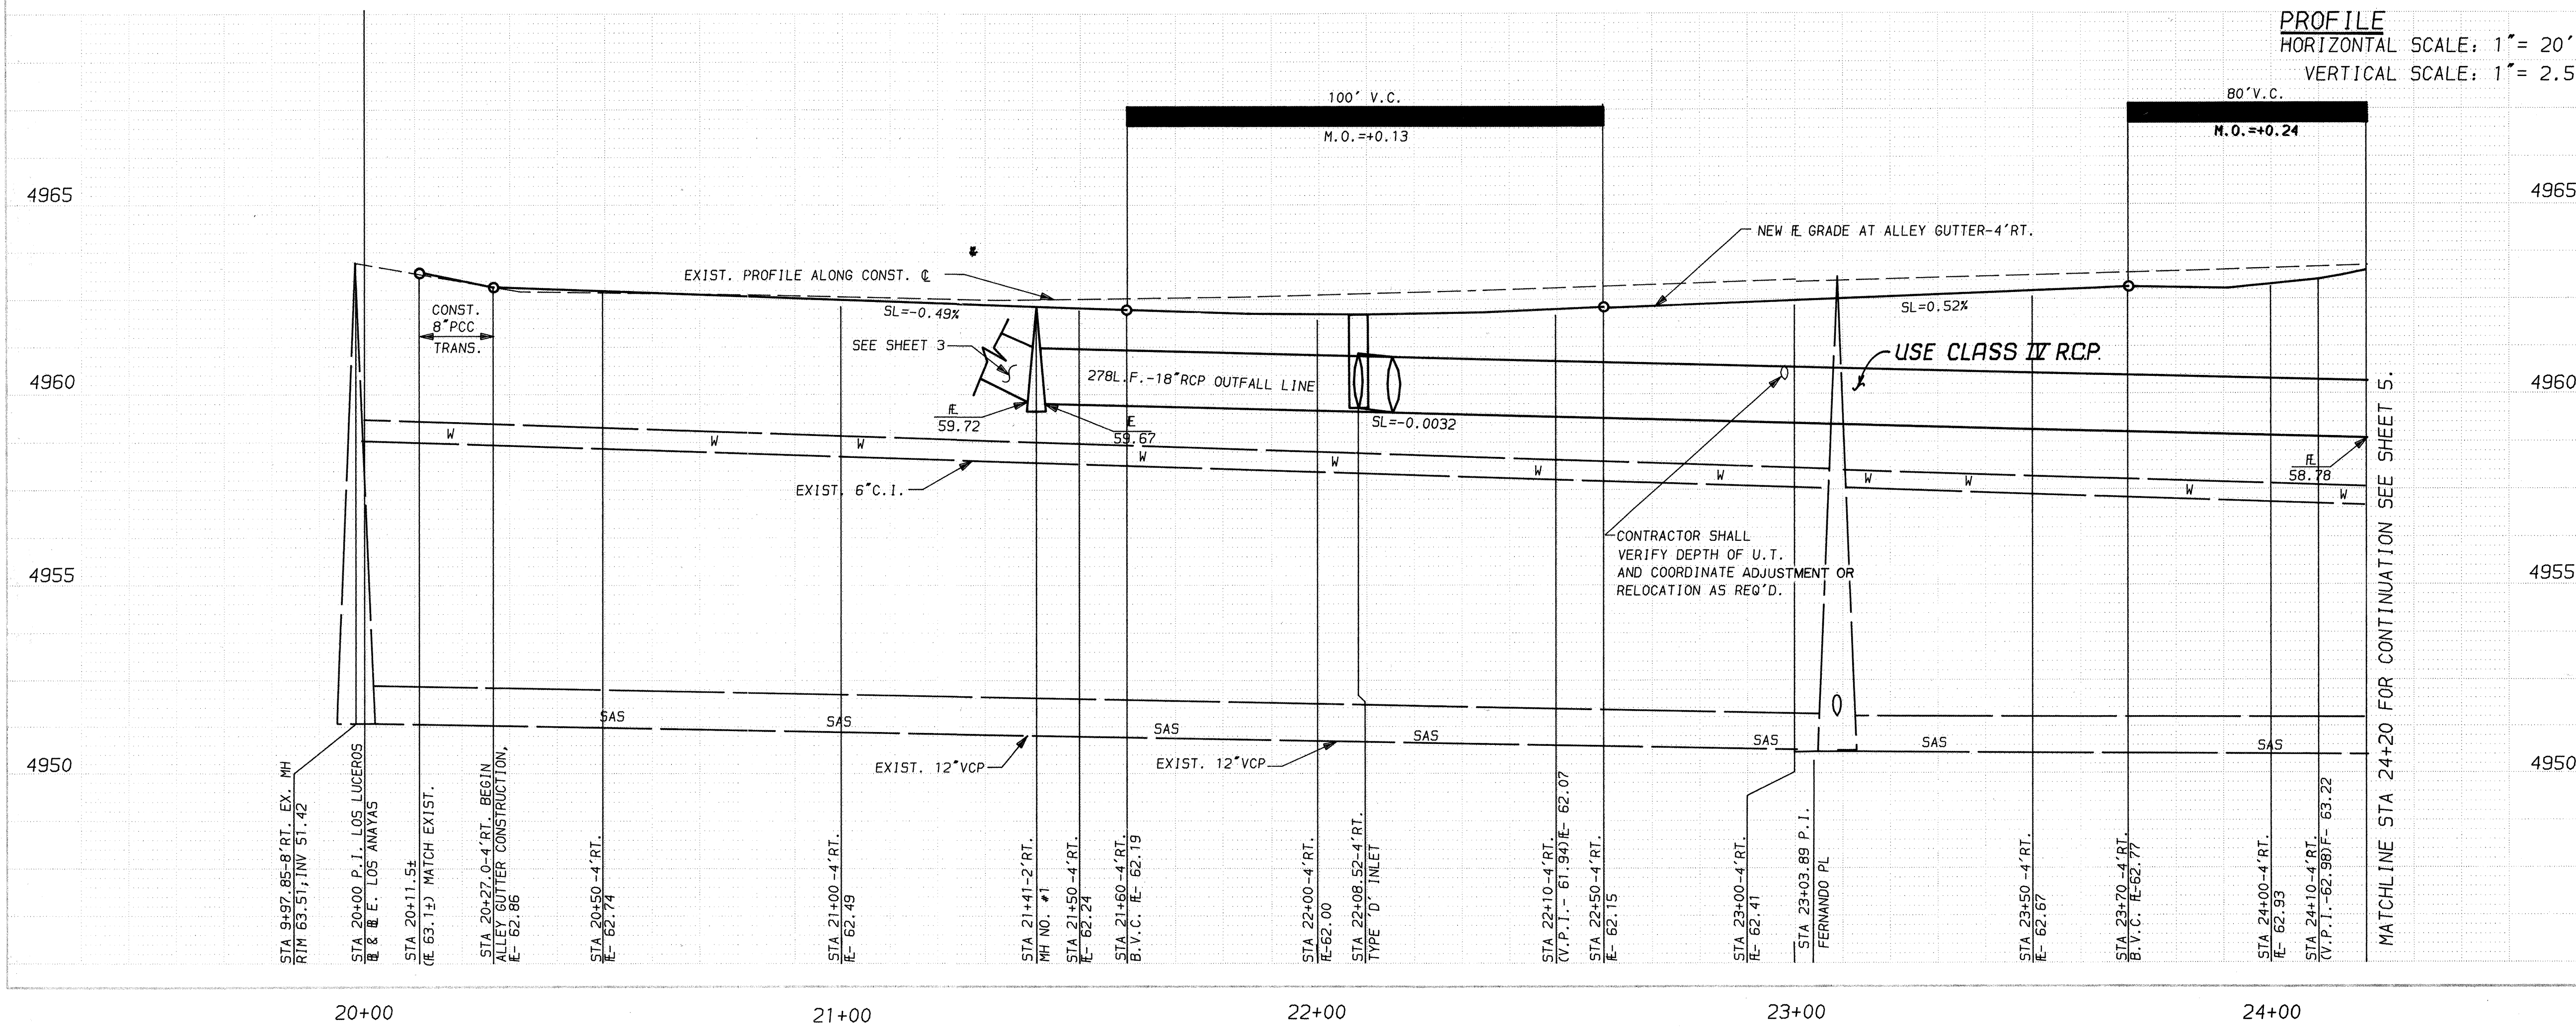

FOR INFORMATION ONLY
REVISED/AS-BUILT

CITY OF ALBUQUERQUE PUBLIC WORKS DEPARTMENT ENGINEERING GROUP			
TITLE: LOS ANAYAS RD. NW. DETENTION POND PLAN & PROFILE LOS ANAYAS RD. & OUTFALL LINE STA 20+00 TO STA 24+20			
APPROVALS	ENGINEER	APPROVALS	ENGINEER
D.R.C. Chair	Raymond Olivas	D.R.C. Chair	Raymond Olivas
Trans. Dev	Raymond Olivas	Trans. Dev	Raymond Olivas
Utility Dev	Raymond Olivas	Utility Dev	Raymond Olivas
H.Y.D.	C.A.M.	H.Y.D.	C.A.M.
DRAWING NO.	3069	MAP NO.	H12
SHEET 4		OF 6	

AS BUILT INFORMATION		BENCH MARKS		SURVEY INFORMATION		ENGINEER'S SEAL	
CONTRACTOR	DATE	BR 7-H13B	THE STATION MARK IS A STANDARD ACS 3-1/4" ALUMINUM CAP STAMPED 7-H13B, 1984 SET FLUGH WITH CURB.	NO.	BY	NO.	BY
WORKED BY	DATE	INSPECTORS	DATE	NO.	BY	NO.	BY
ACCEPTANCE BY	DATE	VERIFICATION BY	DATE	NO.	BY	NO.	BY
DRAWING NO.	DATE	DRAWING NO.	DATE	NO.	BY	NO.	BY
RECORDED BY	DATE	RECORDED BY	DATE	NO.	BY	NO.	BY

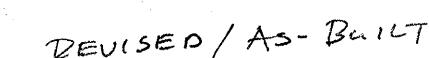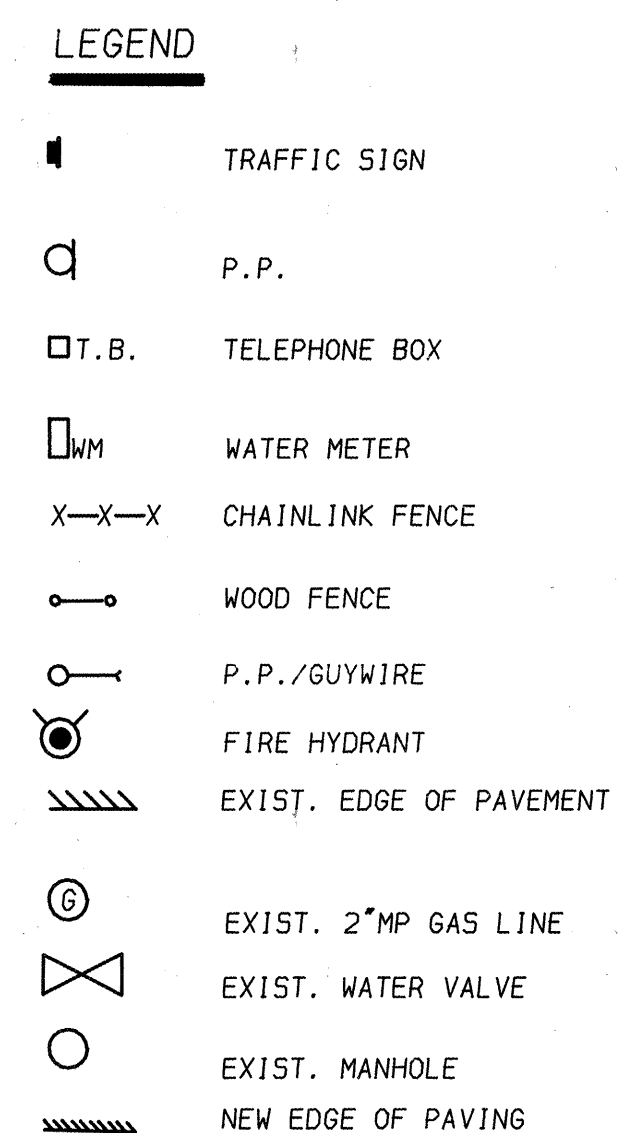[illegible]