



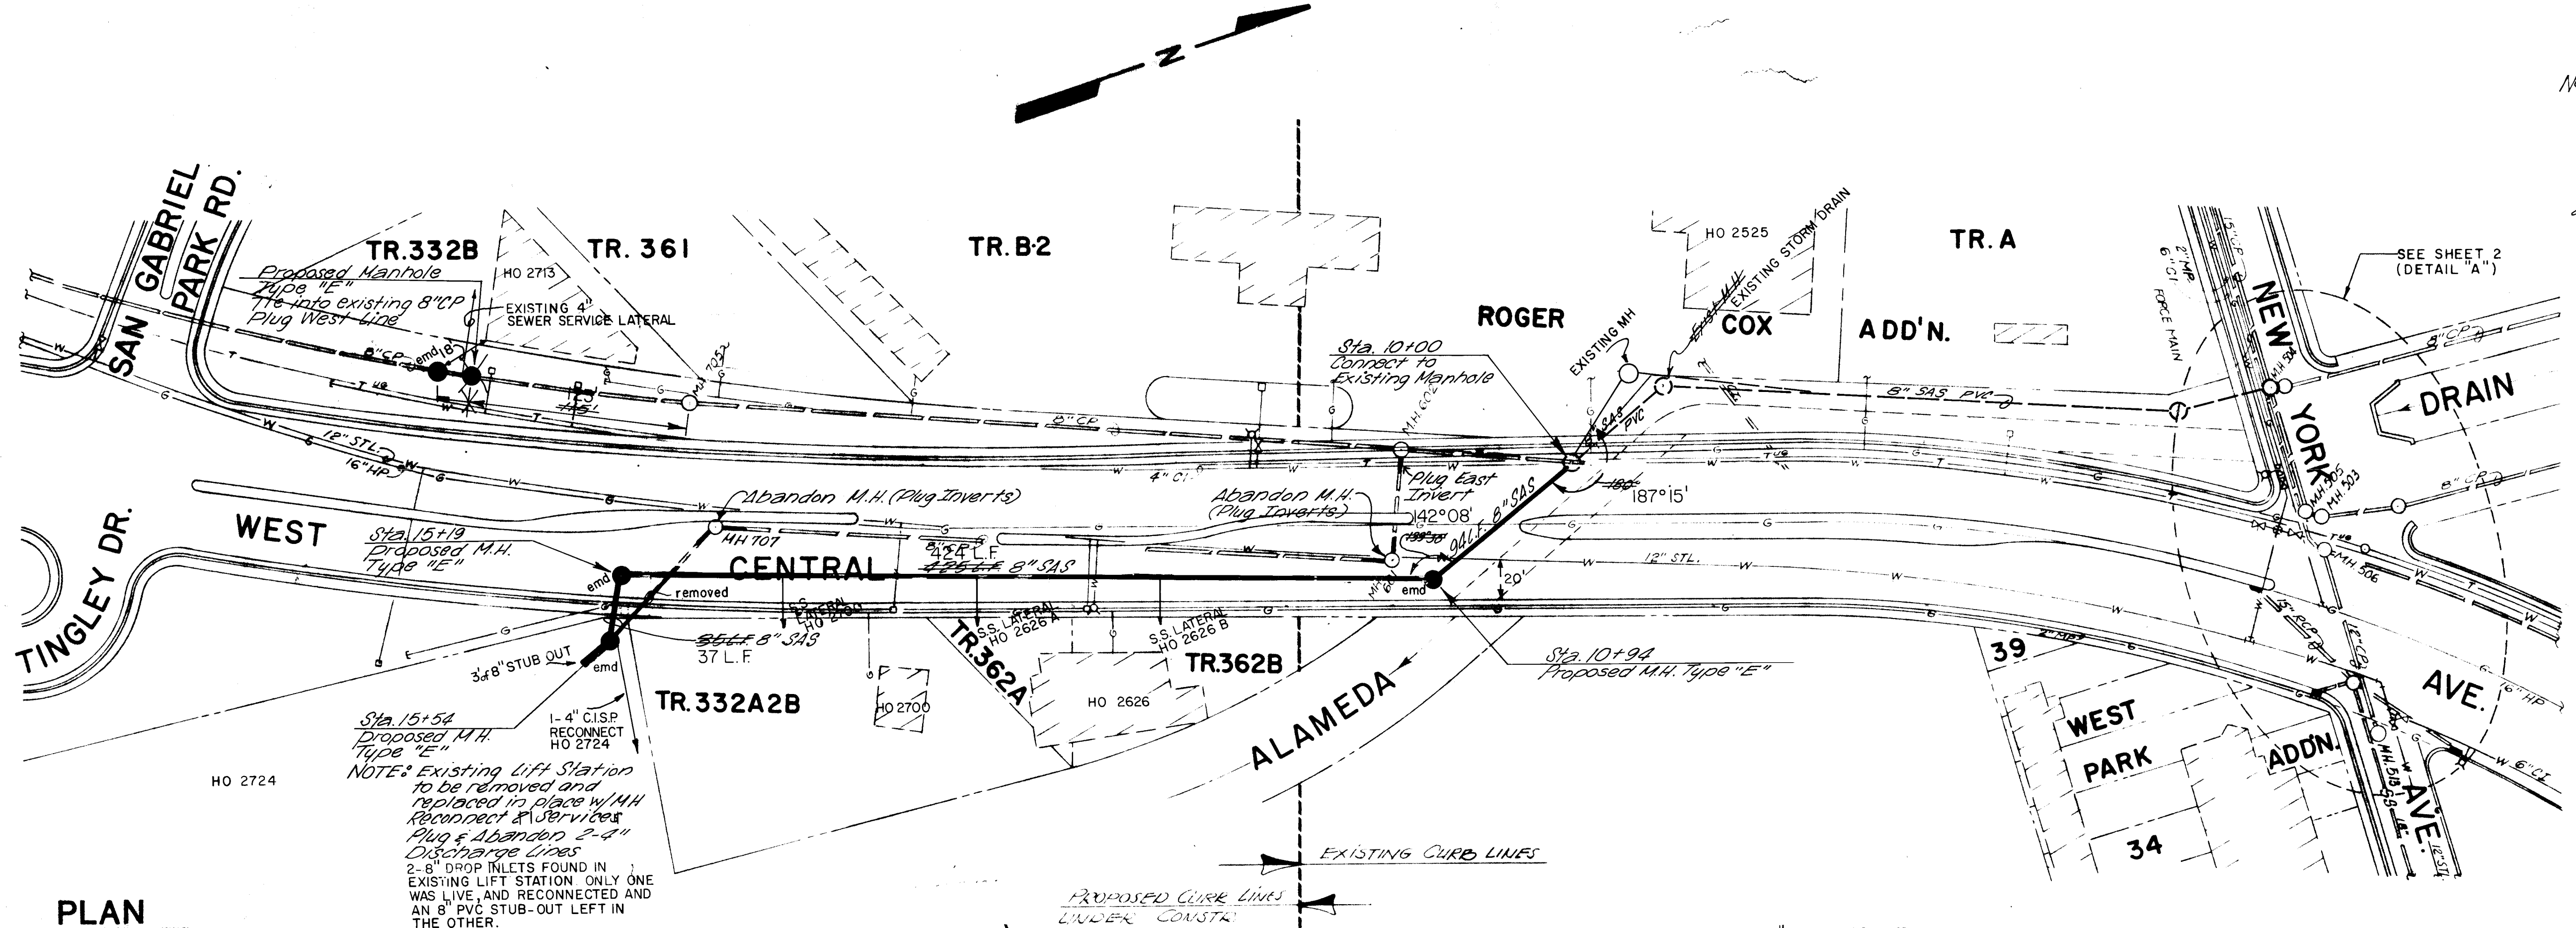

PLAN
SCALE: 1"=50'
PROFILE
SCALE: 1"=50' HORIZ.
1"=5' VERT.

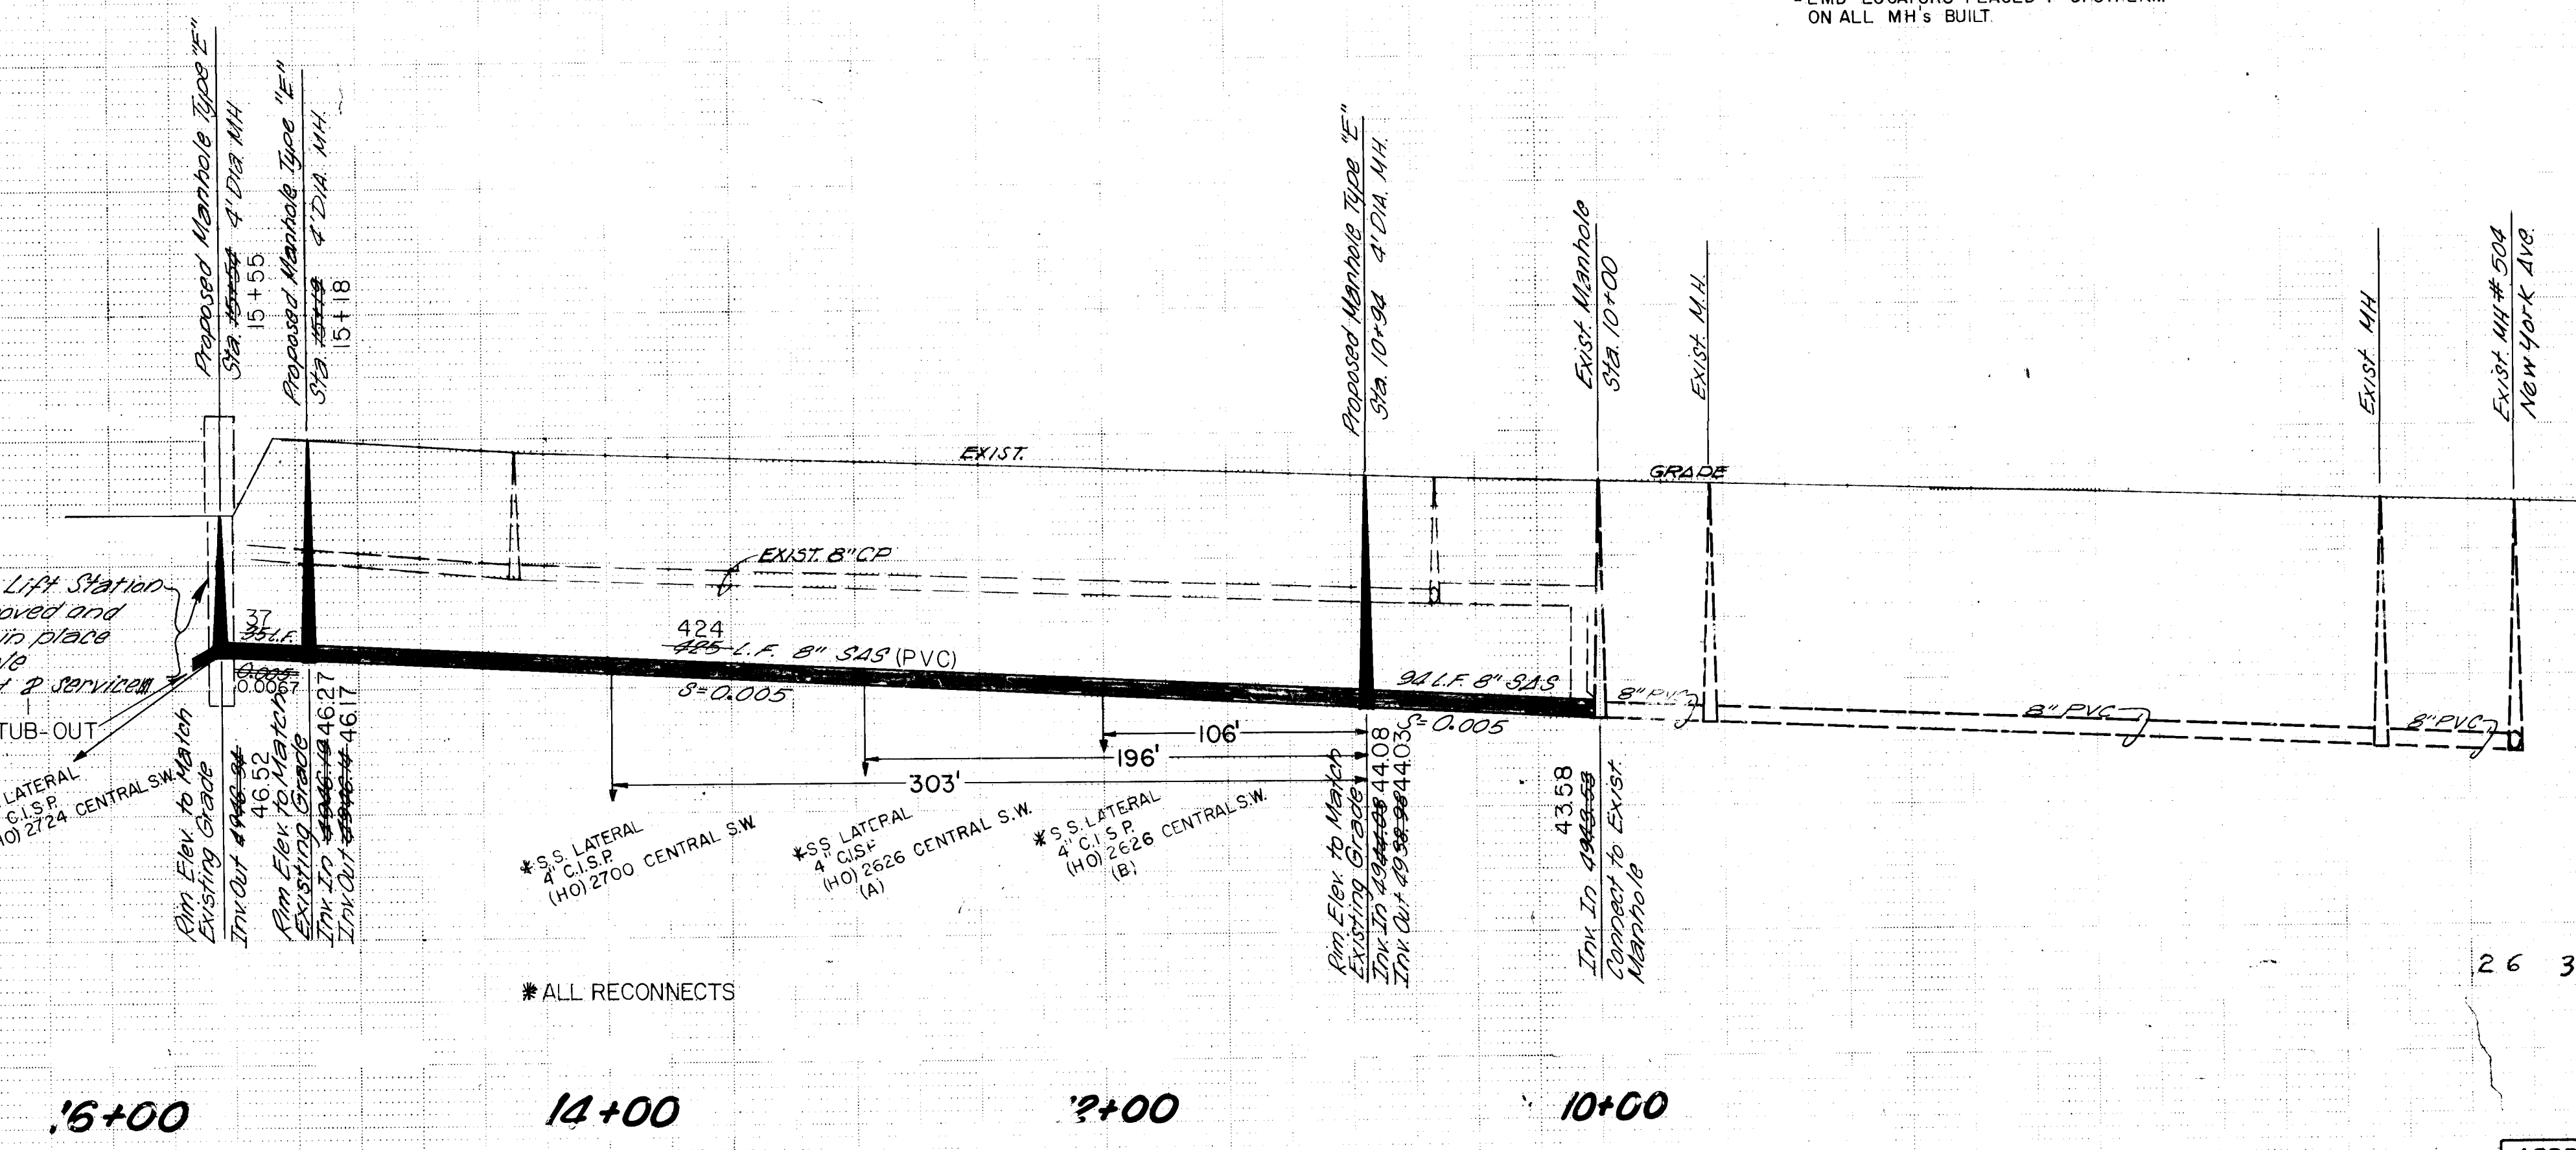

Note:
1. Abandonment of Manhole will be done by plugging lines with 1 foot long mortar plug. Break up bottom of M.H. Fill M.H. w/sand, remove/return castings.
2. Reconnect all sewer services.

NOTES: - ALL OF 8" SAS INSTALLED WAS PVC.
- AN "S" IS INSCRIBED ON CURB WHERE S.S. LATERALS RUN.
- EMD LOCATORS PLACED 1' UPSTREAM ON ALL M.H.'S BUILT

WATER RESOURCES DEPARTMENT
APPROVAL OF
[Signature]
DATE 7/9/87

PROJECT UNDER THE GUIDANCE OF

[Signature] DATE 7-83
DESIGN ENGINEER

CITY OF ALBUQUERQUE
WATER RESOURCES DEPARTMENT


TITLE: CENTRAL AVE. SAS REPLACEMENT
BETWEEN NEW YORK AVE. & TINGLEY DR.

APPROVALS	ENGINEER	DATE	APPROVALS	ENGINEER	DATE
City Engineer			Liquid Waste		
ACE - Design			Traffic		
ACE - Hydrology			Water		

APPROVED FOR
CONSTRUCTION
CHIEF ENGINEER, WRD DATE

DRAWING NO. 3072 J-12 SHEET 1

AS BUILT INFORMATION		BENCH MARKS		SURVEY INFORMATION		REFERENCES		REVISIONS	
CONTRACTOR	New Concepts	DATE	11	FIELD NOTES	DATE	MAP NO.	EST. NO.	NO.	DATE
STATED BY		DATE	11	BY		W.O. NO.		REMARKS	BY
ACCEPTANCE BY		DATE	11					DESIGN	
RECORDED BY		DATE	11					REVISIONS	
NO.		DATE	11					DESIGNED BY	HT
		DATE	11					DRAWN BY	HT
		DATE	11					CHECKED BY	HT
		DATE	11						

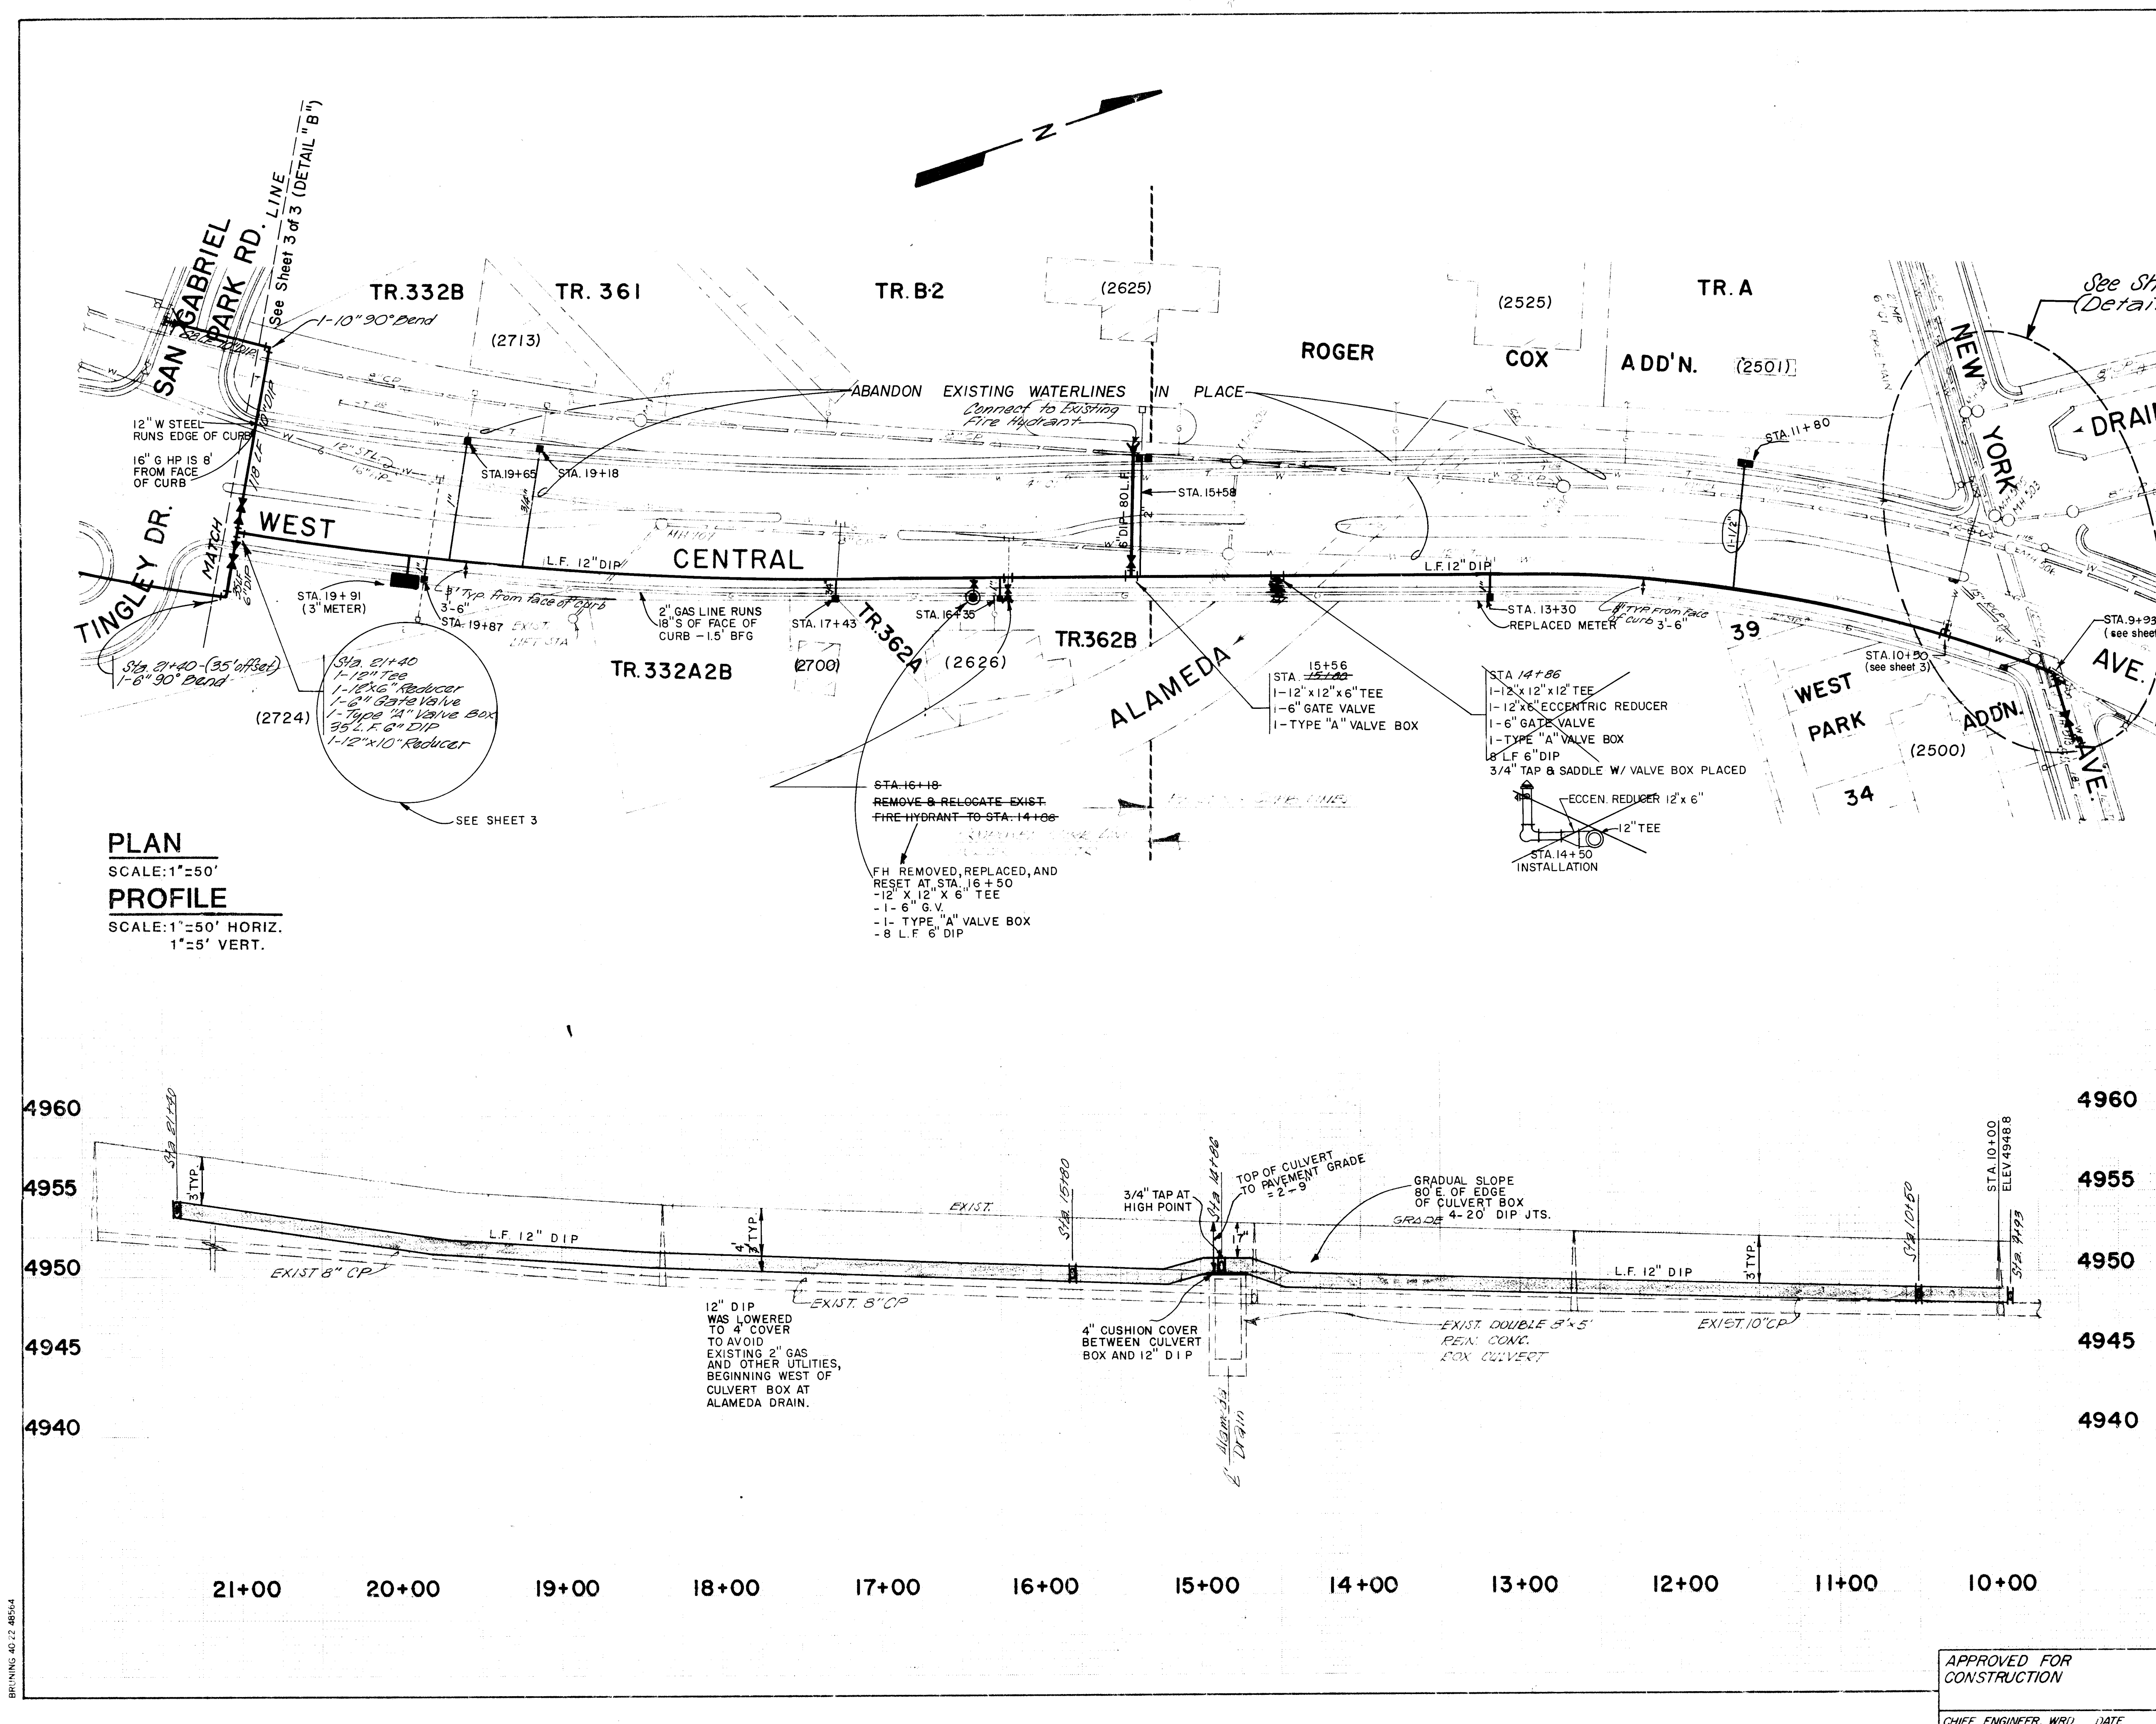

AS BUILT INFORMATION			BENCH MARKS			SURVEY INFORMATION			REFERENCES			
CONTRACT NO.	DATE	BY	LOCATION	DATE	BY	MAP NO.	EST. NO.	WO. NO.	NO.	FIELD NOTES	DATE	BY
1100	11/82	WJZ	1100	11/82	WJZ	1100	1100	1100	1100	1100	1100	1100
PROJECT UNDER THE GUIDANCE OF												
CITY OF ALBUQUERQUE WATER RESOURCES DEPARTMENT												
TITLE: CENTRAL AVE. WATERLINE REPLACEMENT BTW. NEW YORK AVE. & THE R J GRANDE												
APPROVALS												
City Engineer	ENGINEER	DATE	APPROVALS	ENGINEER	DATE							
A.C.E. - Design			liquid Waste									
A.C.E. - Hydrology			Traffic									
			Water									
DRAWING NO. 3072 J-12 SHEET 2 OF 3												

26 30720284

WATER RESOURCES DEPARTMENT
APPROVAL OF AS BUILT DRAWINGS
Ben L. Spauld
Date 7/1/84

PROJECT UNDER THE GUIDANCE OF

WJZ
DESIGN ENGINEER

6-2-83
DATE

CITY OF ALBUQUERQUE
WATER RESOURCES DEPARTMENT

TITLE:
CENTRAL AVE. WATERLINE REPLACEMENT BTW.
NEW YORK AVE. & THE R J GRANDE

APPROVALS



ENGINEER	DATE	APPROVALS	ENGINEER	DATE
		liquid Waste		
		Traffic		
		Water		

DRAWING NO. 3072 J-12 SHEET 2 OF 3

APPROVED FOR CONSTRUCTION

CHIEF ENGINEER, WRD DATE

BRUNING 40-12 4854

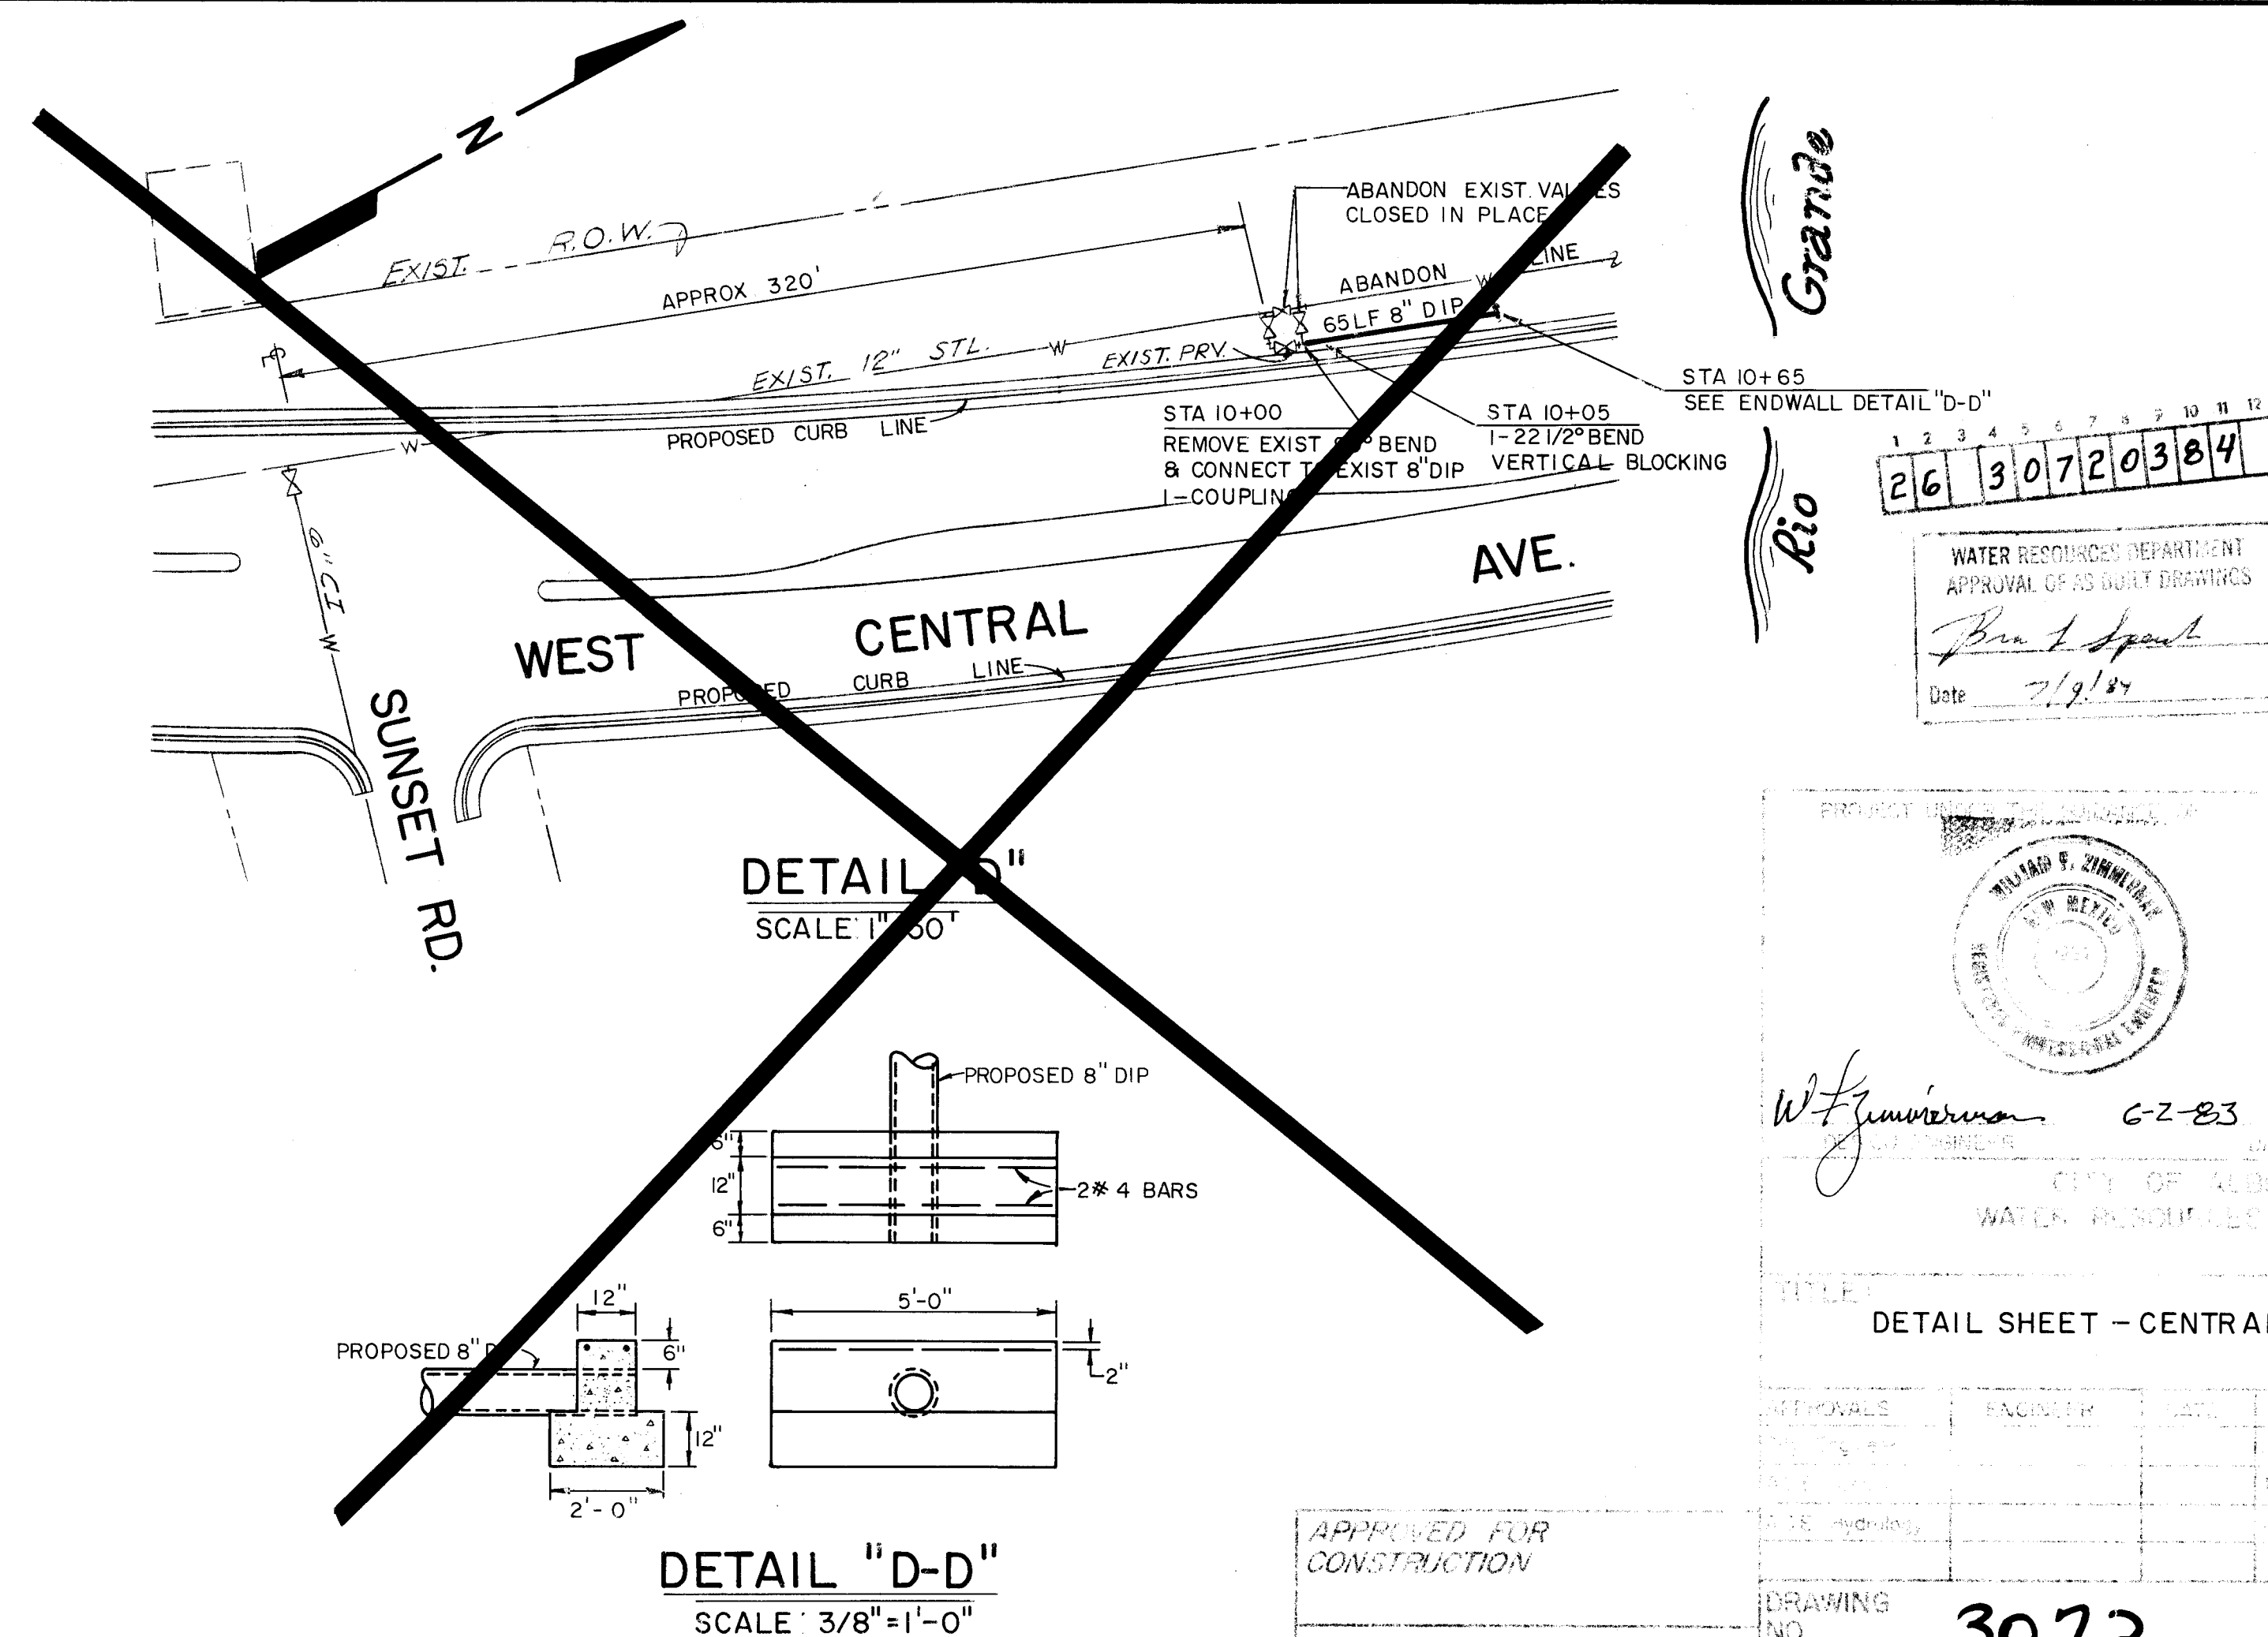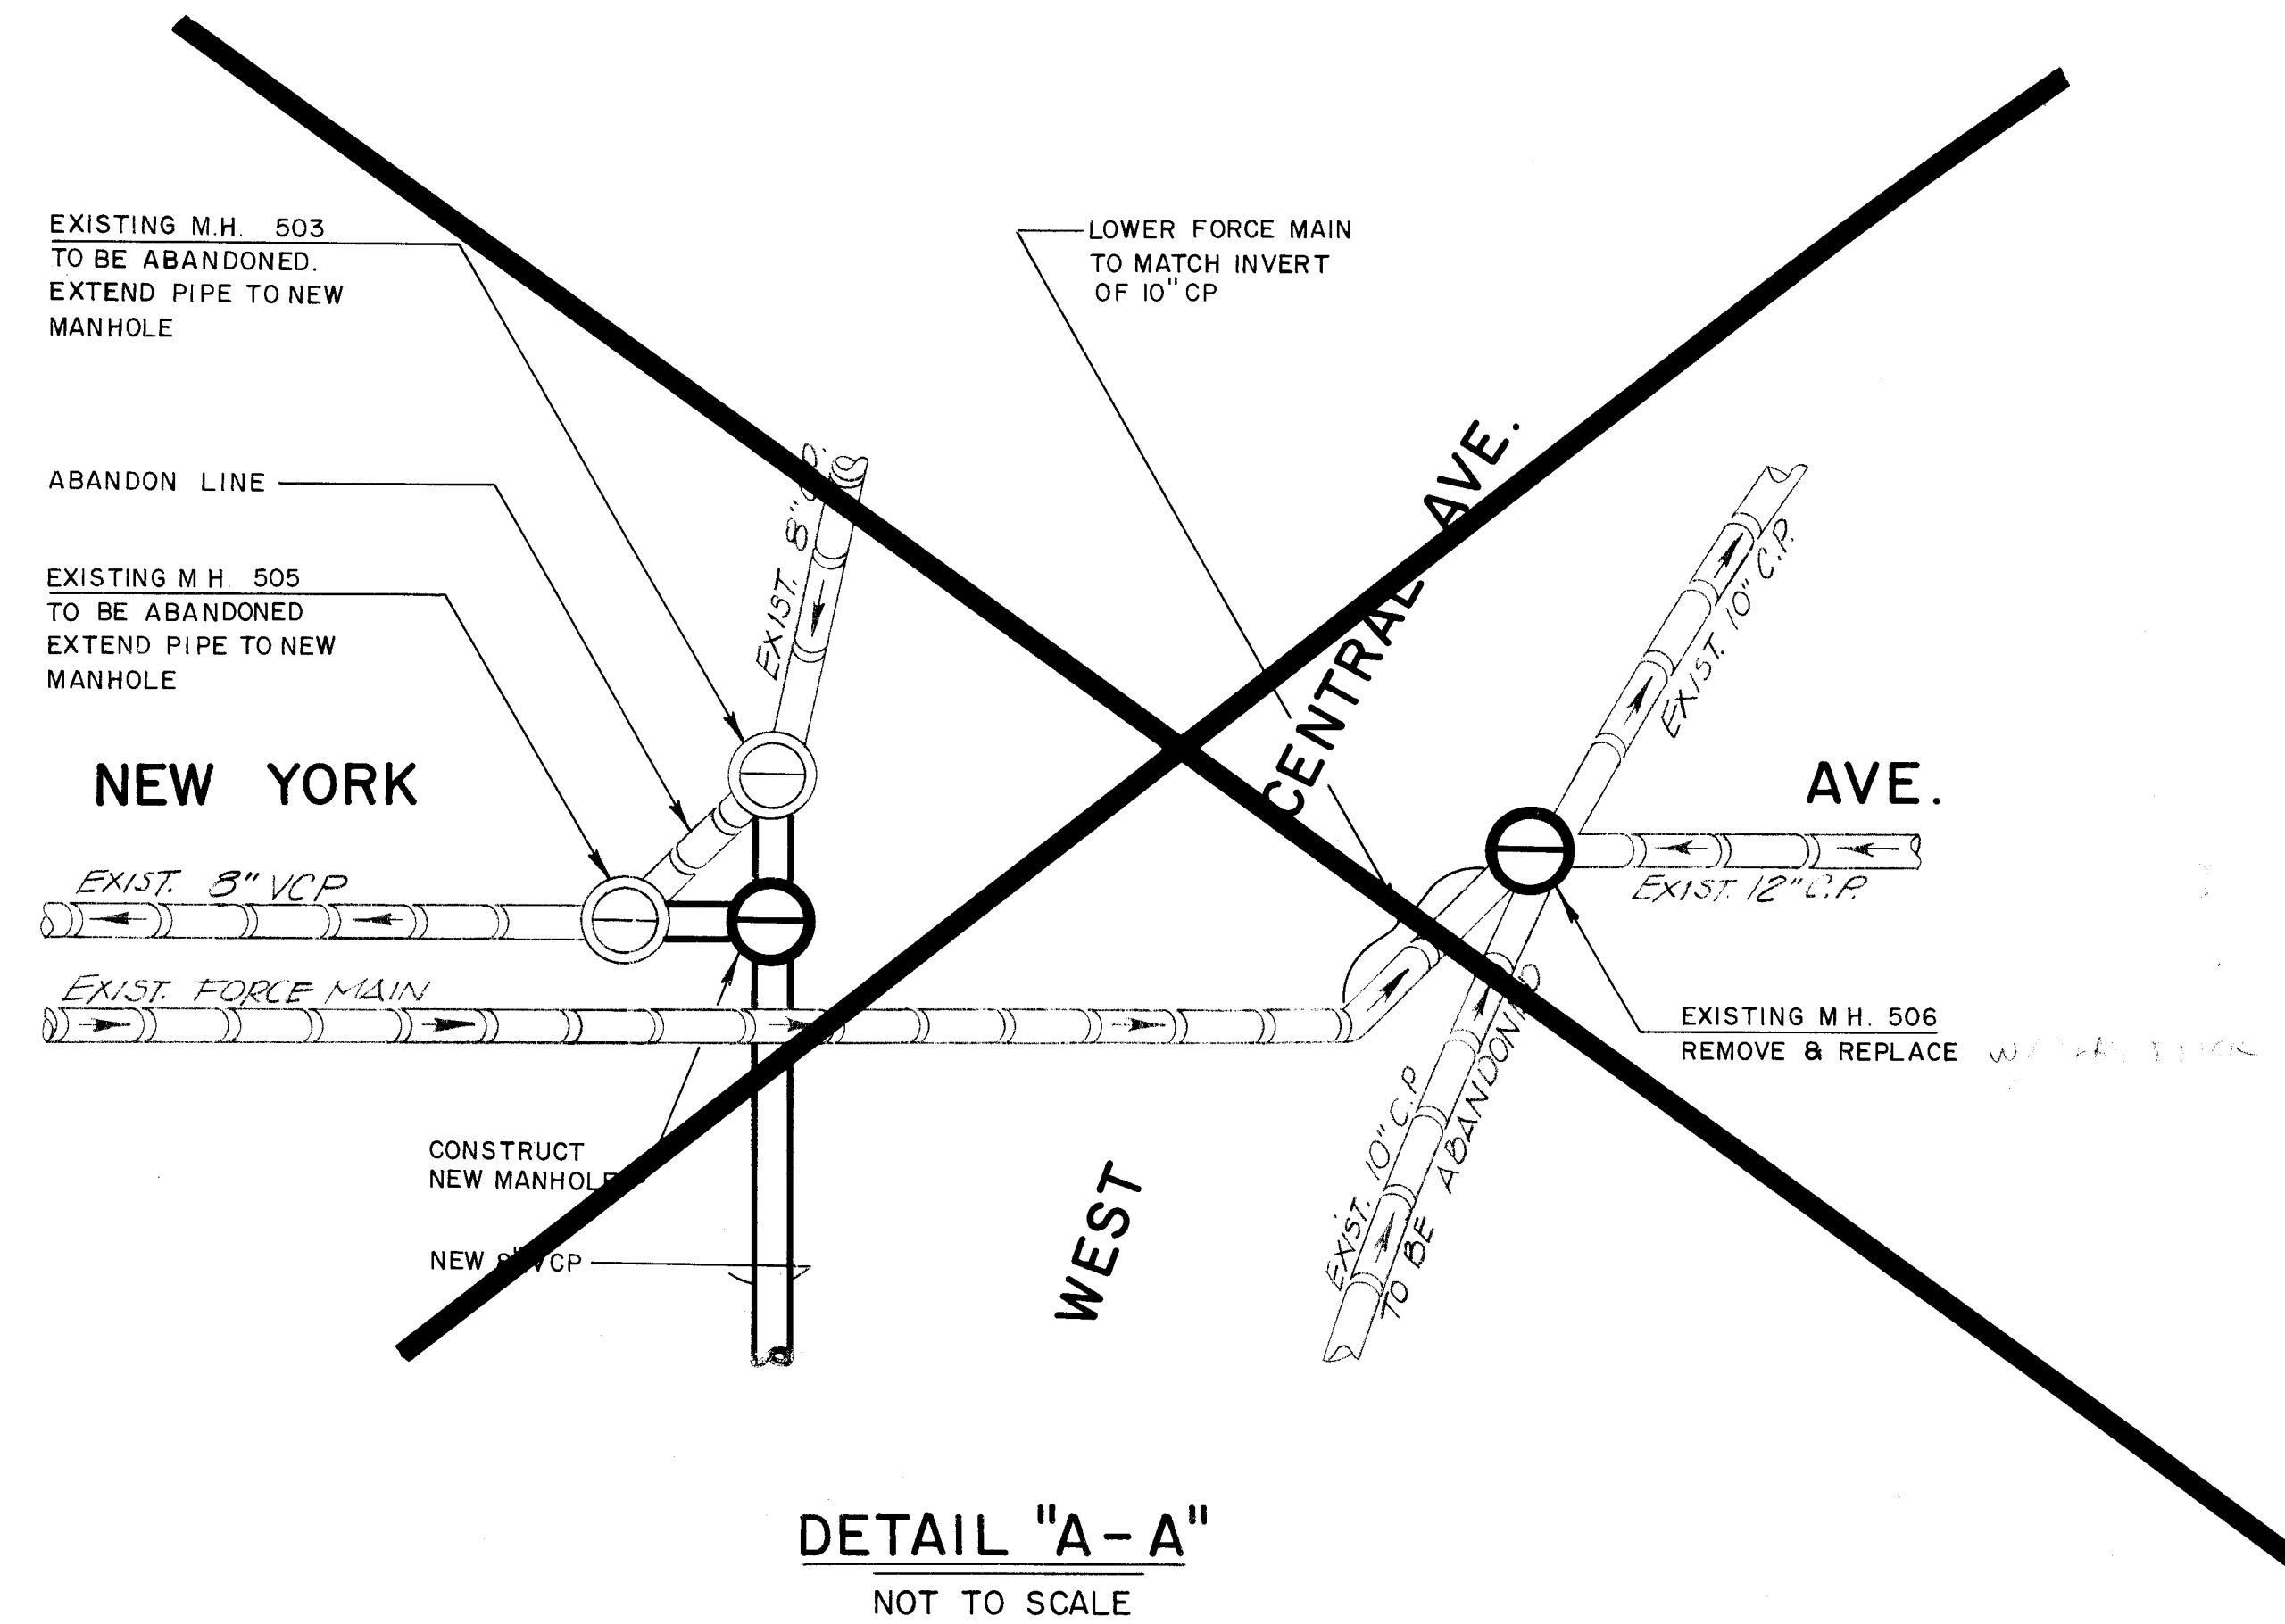

BM - "OTB-1" USE/INGS
LOCATION - N E CORNER OF THE OLD TOWN BRIDGE
OVER THE RIO GRANDE RIVER
ELEV - 4962.149

NOTE: FILE HERE DONT HAS BEEN RESET
THEREFORE BM IS OFF