



PLAN	DATE	BY	REVISIONS
NO.			
NO.			
NO.			
NO.			

PROFILE	DATE	BY	REVISIONS
NO.			
NO.			
NO.			
NO.			

MONTGOMERY BLVD.

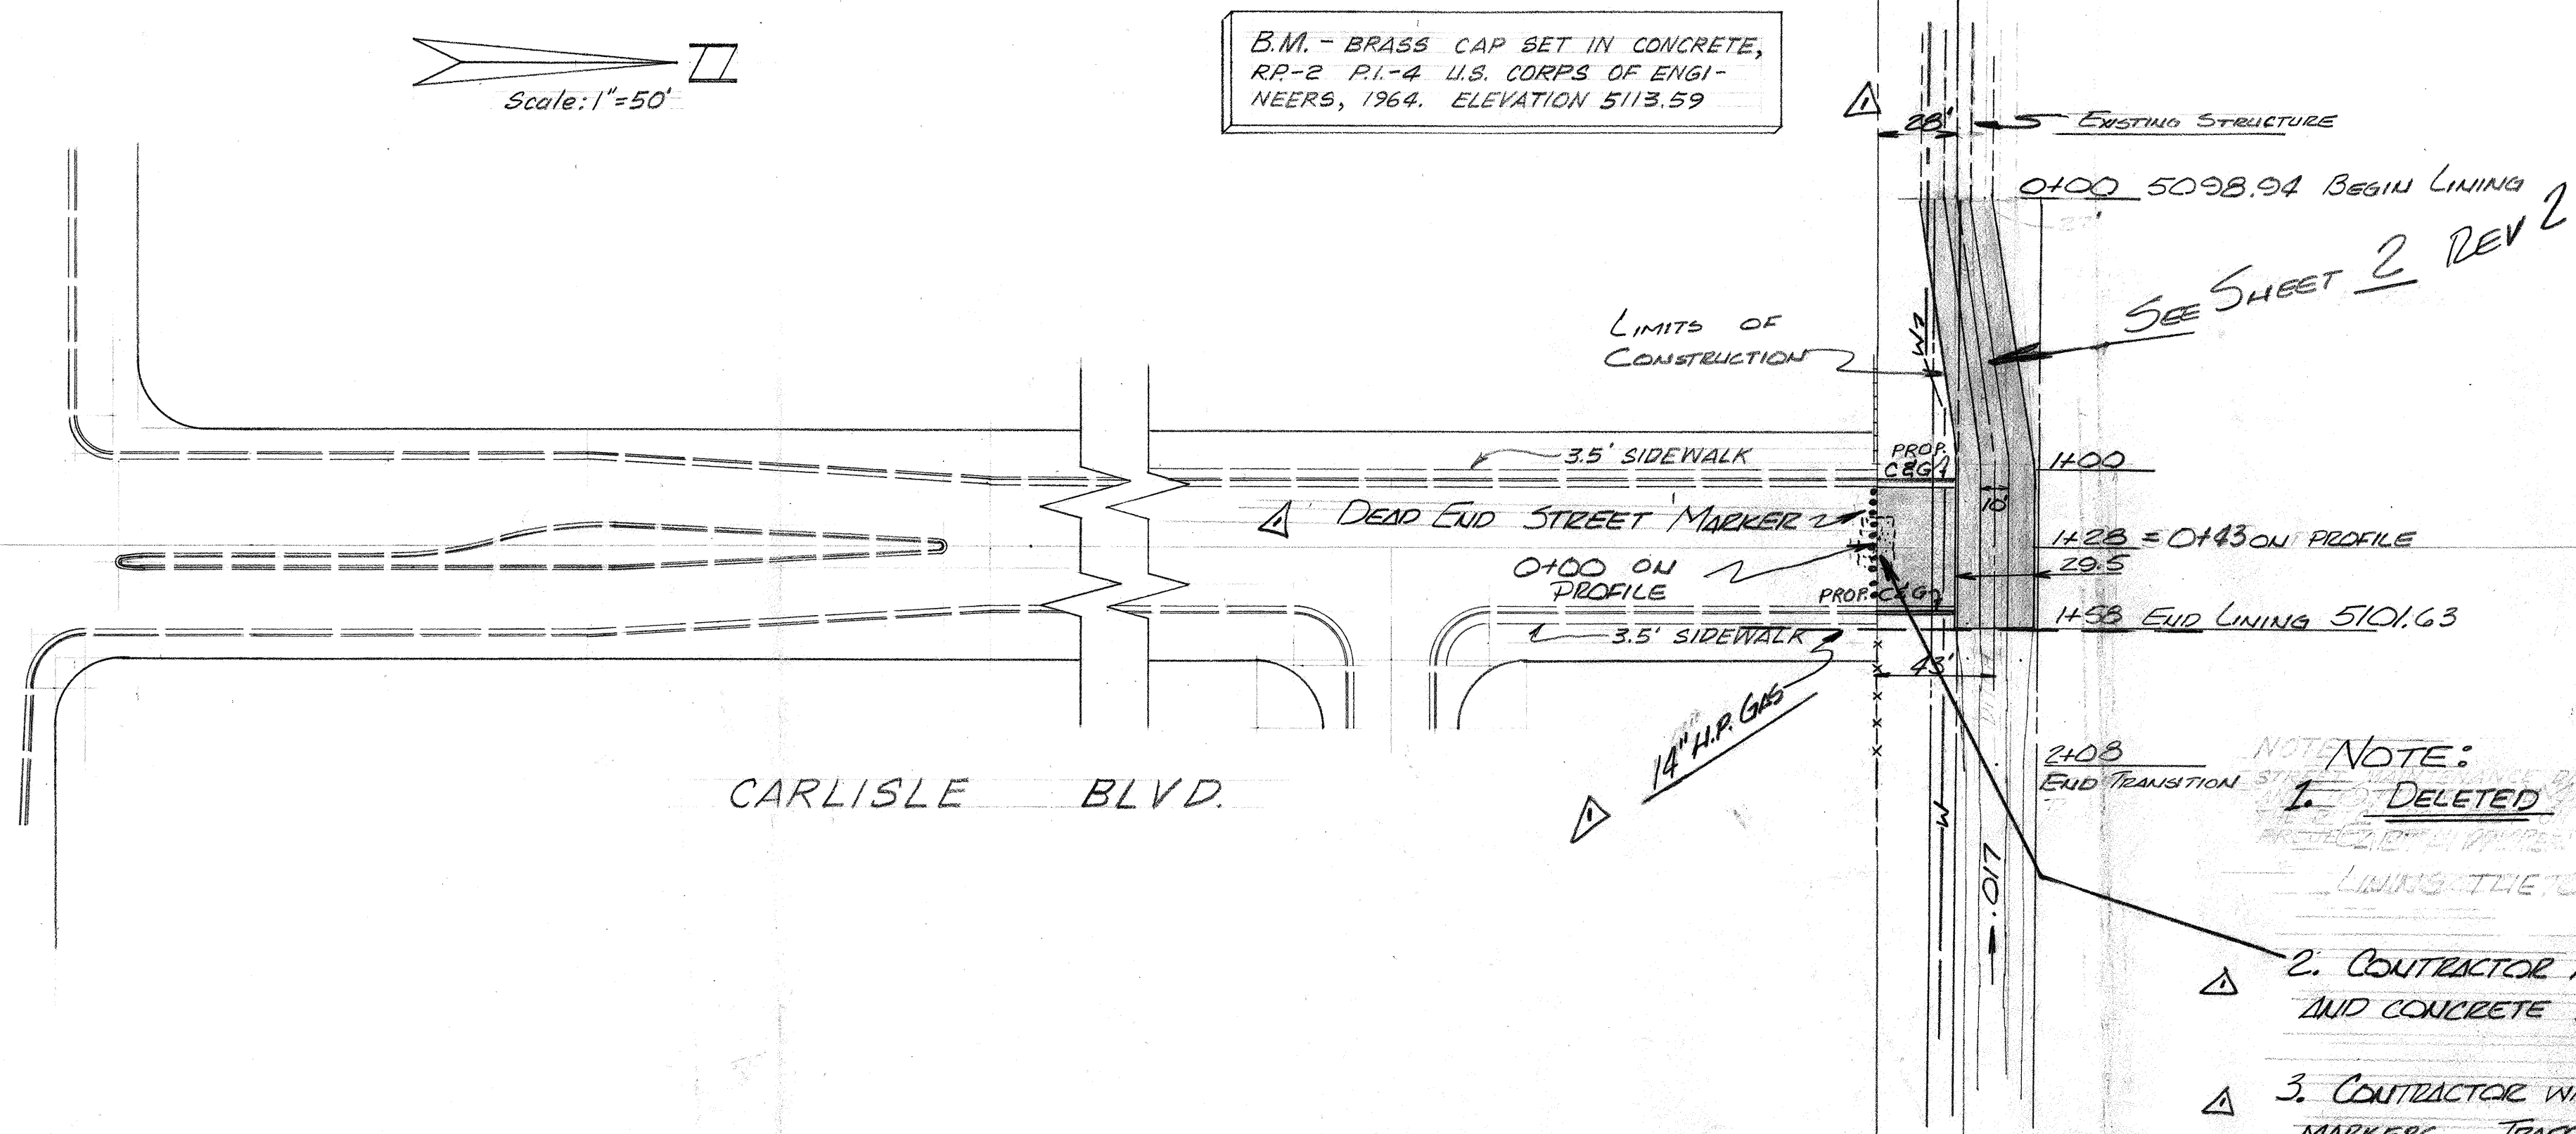

Scale: 1"=5' Natural

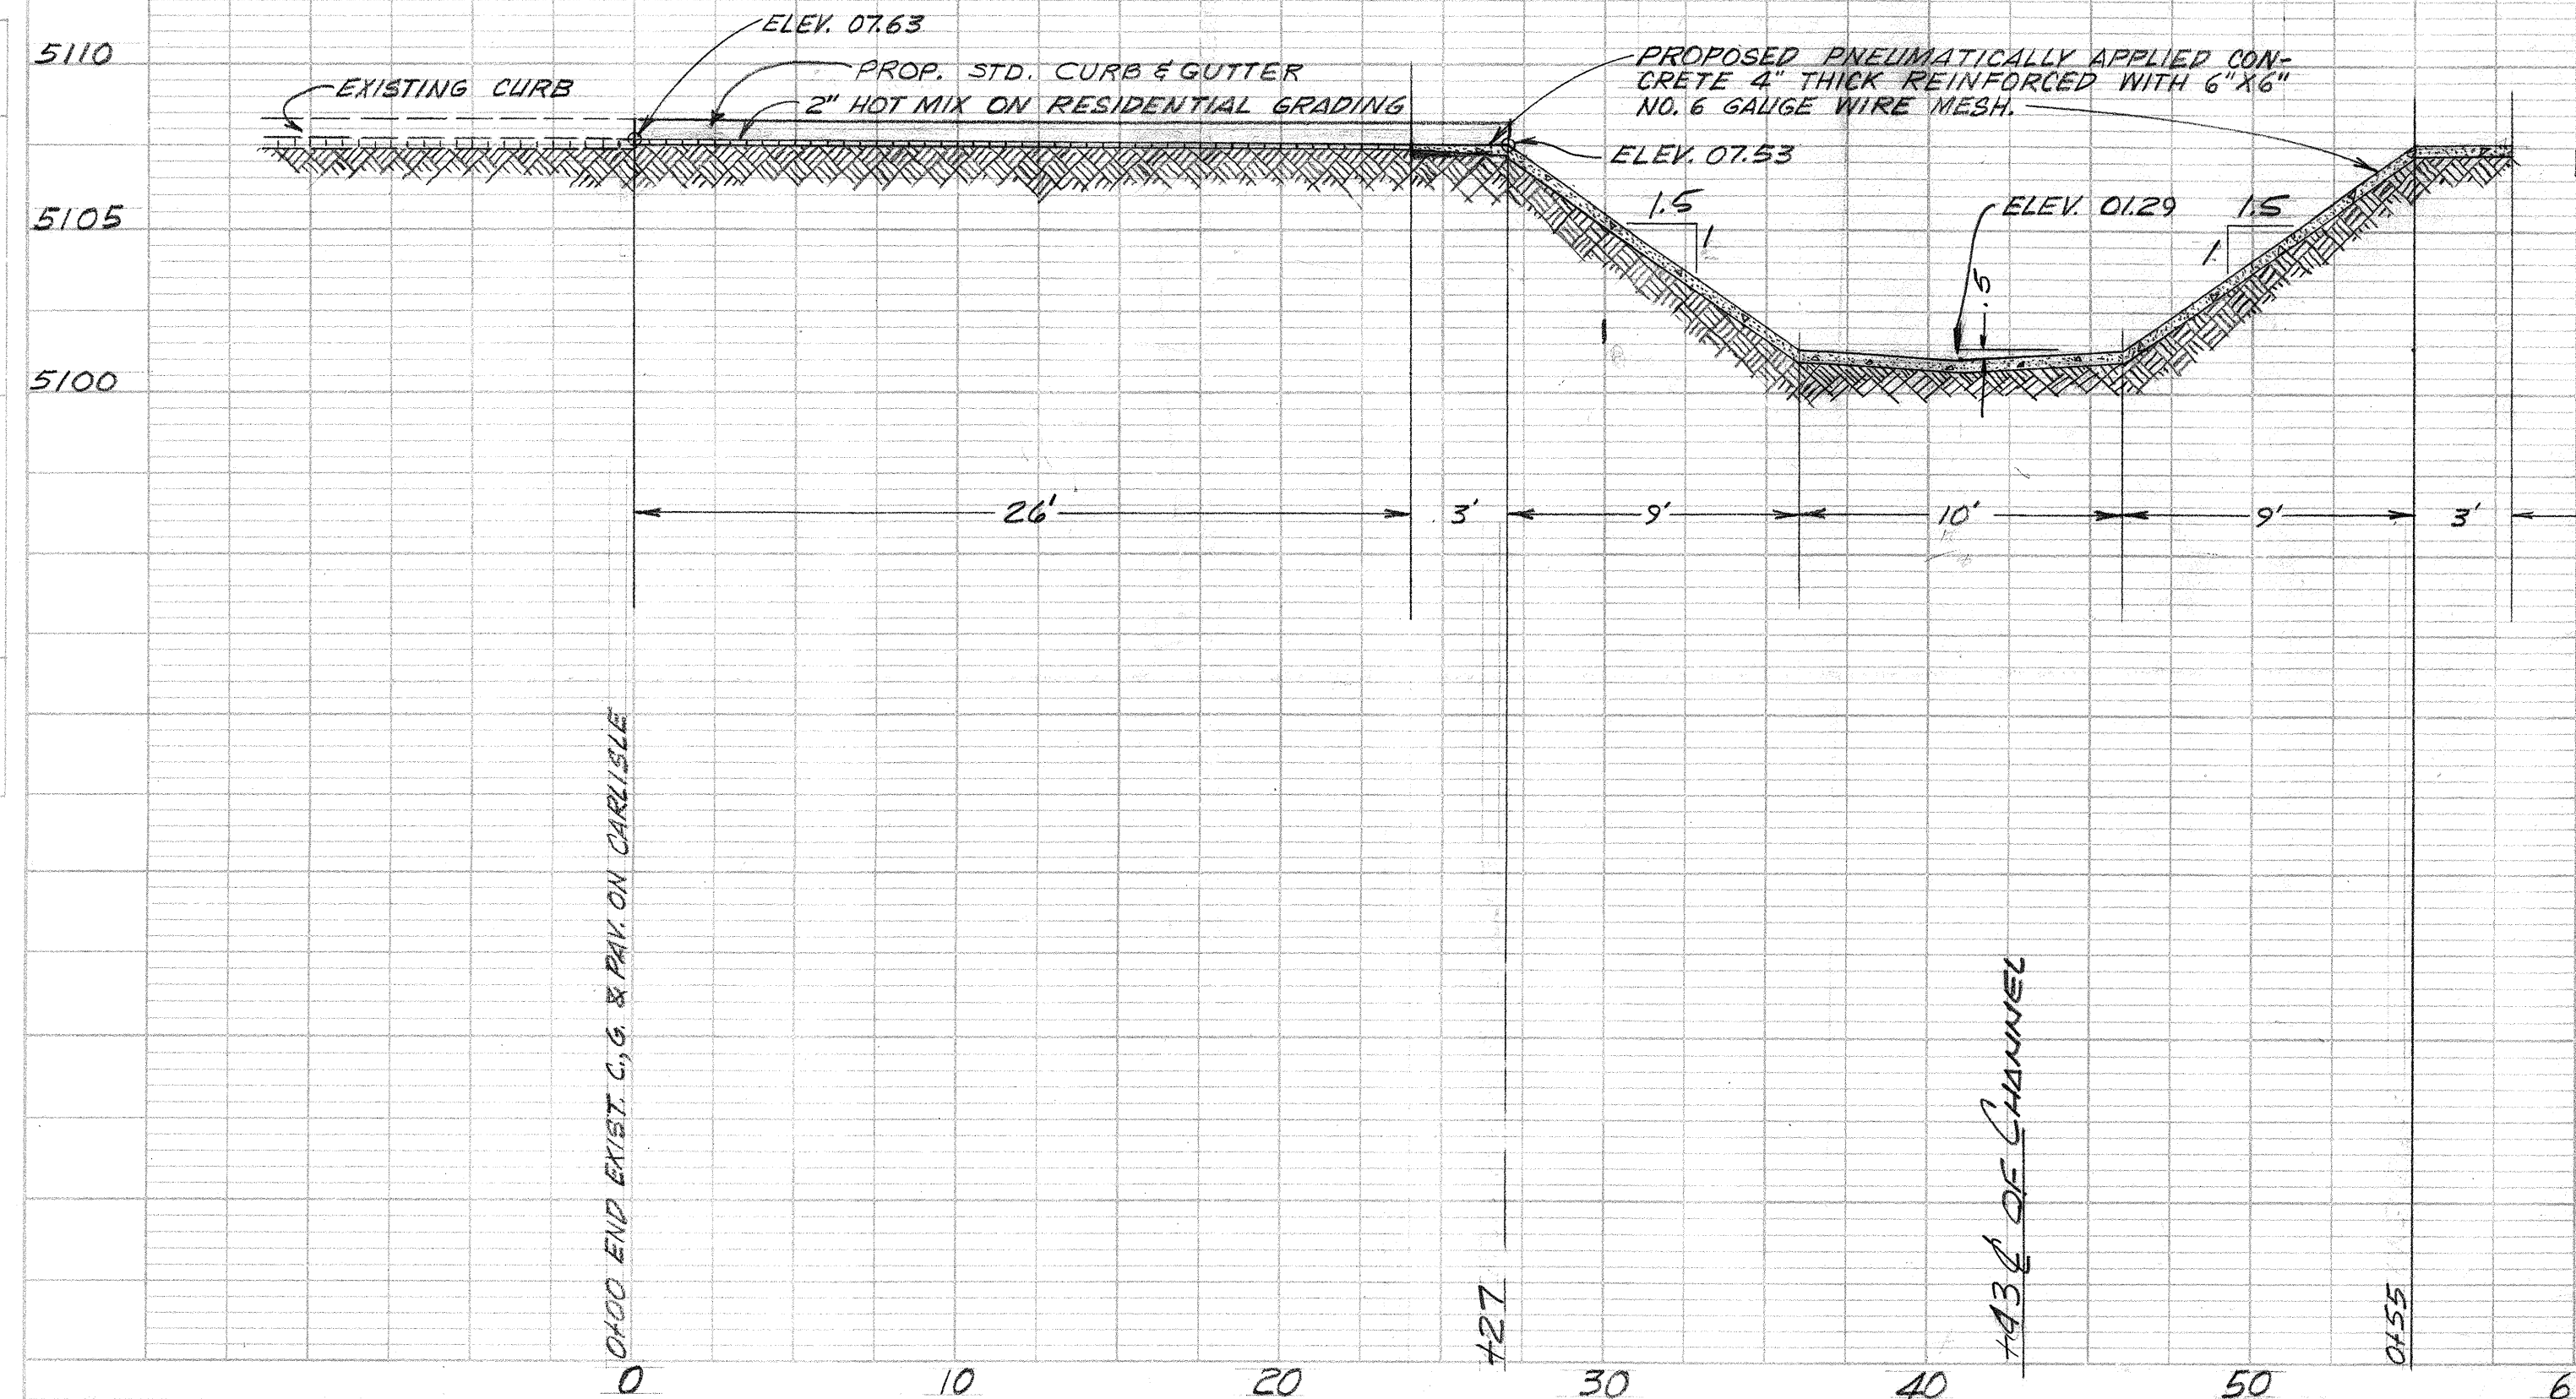

1	2	3	4	5	6	7	8	9	10	11	12	13	14	15	16	17	18	19	20	21	22	23	24	25	26	27	28	29	30
22			030				0174							02															3

Maps No. F-16 & F-17

2 1175 STRUCTURE REDESIGN		110
1 1875 STRUCTURE, GAS & MONUMENT LOCATION		110
NO.	DATE	REVISIONS
CITY OF ALBUQUERQUE PUBLIC WORKS DEPARTMENT ENGINEERING DIVISION		
TITLE Proposed Channel Improvements on Carlisle North of Montgomery		
DESIGNED BY	DRAWN BY	AS BUILT
TITLE	DATE	SUBMITTED BY
DATE	DATE	TITLE
APPROVAL	REVISIONS	DATE
ASSY. CITY ENGINEER	CITY ENGINEER	RECORDED BY
DATE	DATE	TITLE
DATE	DATE	DATE
DRAWING NUMBER	55-30-74	