


CONSTRUCTION PLANS FOR

RICHFIELD PARK
PHASE I

GRADING, PAVING, WATER
SANITARY SEWER, AND DRAINAGE IMPROVEMENTS

INDEX TO SHEETS

SHEET NUMBER	DESCRIPTION
1	COVER SHEET
2	PLAT SHEET
3	PLAT SHEET
4	PLAT SHEET
5	GRADING PLAN
6	OVERALL PAVING PLAN
7	OVERALL UTILITY PLAN
8	WASHINGTON ST. N.E. PAVING PLAN & PROFILE STATION 0+00.00 TO 12+00.00
9	WASHINGTON ST. N.E. PAVING PLAN & PROFILE STATION 12+00.00 TO 18+42.70
10	ADAMS ST. N.E. PAVING PLAN & PROFILE STATION 18+42.70 TO 26+89.24
11	COLUMBINE AVE. N.E. PAVING PLAN & PROFILE STATION 16+48.05 TO 26+72.48
12	COLUMBINE AVE. N.E. PAVING PLAN & PROFILE STATION 26+72.48 TO 32+35.84
13	ALAMEDA BLVD. N.E. MEDIAN RECONSTRUCTION
14	JEFFERSON ST. N.E. MEDIAN RECONSTRUCTION
15	WASHINGTON ST. N.E. SANITARY SEWER & WATER PLAN & PROFILE STATION 0+46.00 TO 12+00.62
16	WASHINGTON ST. N.E. SANITARY SEWER & WATER PLAN & PROFILE STATION 12+00.62 TO 18+42.70
17	ADAMS ST. N.E. SANITARY SEWER & WATER PLAN & PROFILE STATION 18+42.70 TO 26+89.24
18	COLUMBINE AVE. N.E. SANITARY SEWER & WATER PLAN & PROFILE STATION 16+48.04 TO 26+72.48
19	COLUMBINE AVE. N.E. WATER PLAN & PROFILE STATION 26+72.48 TO 32+25.84
20	OFFSITE WATER PLAN & PROFILE STATION 0+00.00 TO 8+38.38
21	DETAIL SHEET
22	DETAIL SHEET
23	A.M.A.F.C.A. CHANNEL - PLAN & PROFILE

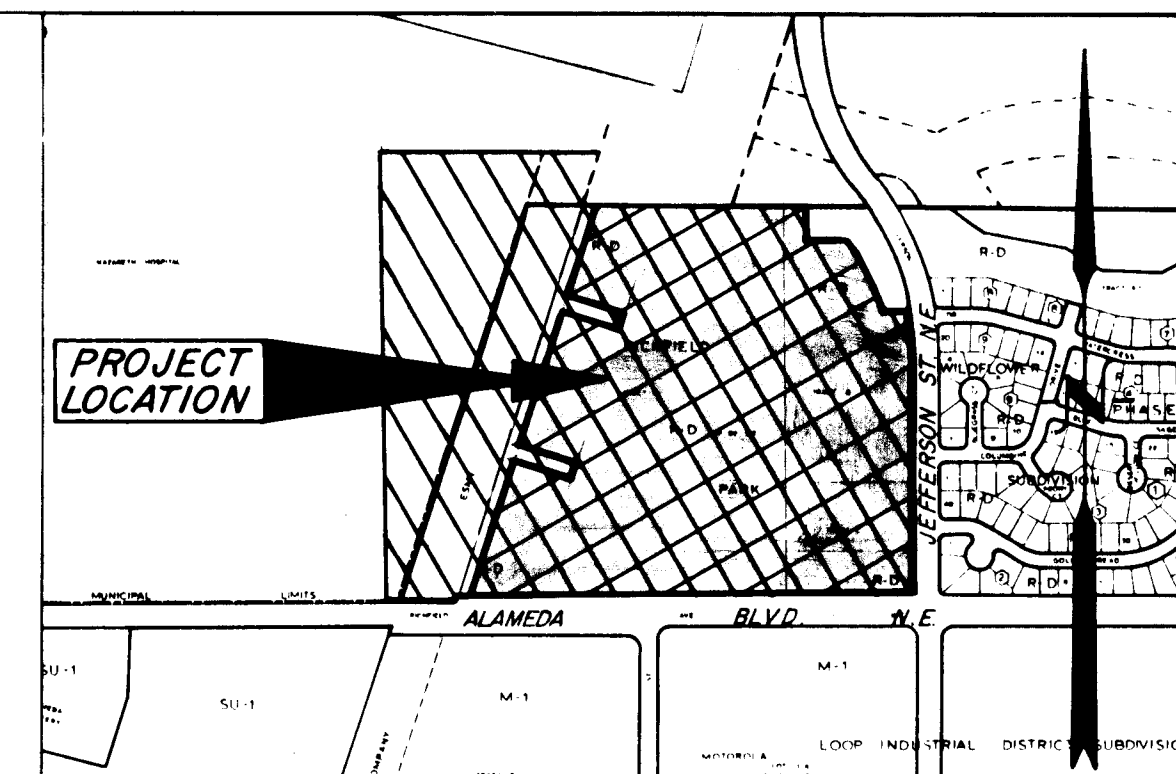


VICINITY MAP: C-17

SCALE: 1" = 800'

GENERAL NOTES


- All work detailed on these plans to be performed under contract, unless stated otherwise or provided for hereon, shall be constructed in accordance with the City of Albuquerque Standard Specifications, Public Works Construction, 1986 (referred herein as "Standard Specification").
- Two (2) working days prior to any excavation, Contractor must contact line locating service, 765-1234, for location of existing utilities.
- Prior to construction, the contractor shall excavate and verify the horizontal and vertical locations of all potential obstructions. Should a conflict exist, the Contractor shall notify the Engineer so that the conflict can be resolved with a minimum amount of delay.
- All work on this project shall be performed in accordance with applicable Federal, State and Local laws, rules, and regulations concerning construction safety and health.
- Contractor shall maintain access to adjacent properties during construction.
- All gas, electric, telephone lines, cables, and appurtenances encountered during construction that require relocation, shall be done by the responsible utility. Contractor shall be responsible for coordination of all necessary utility adjustments.
- It will be the Contractor's responsibility to protect and maintain in service all existing utilities.
- The Contractor will be required to confine his work within the construction limits and/or public right-of-way to preserve existing vegetation and private property. Overnight parking of construction equipment shall not obstruct driveways or designated traffic lanes.
- A disposal site for all excess excavation material, asphaltic paving, concrete curbs and sidewalks, etc., shall be obtained by the Contractor in compliance with applicable environmental regulations and approved by the Field Engineer. All costs incurred in obtaining a disposal site and haul thereto shall be considered incidental to the project and no separate measurement or payment shall be made.
- When abutting new pavement to existing, sawcut existing pavement to a straight edge and at a right angle, or as approved by the Project Engineer, to remove any broken or cracked pavement.
- The Contractor must submit a construction signing and barricading plan to Traffic Engineering a minimum of three (3) working days prior to construction to receive a barricading permit.
- All trench backfill shall be compacted to a minimum 90% maximum density as per ASTM D-1557.
- Contractor shall coordinate with the Water Systems Division 3 working days prior to initiating any work affecting existing public water utilities.

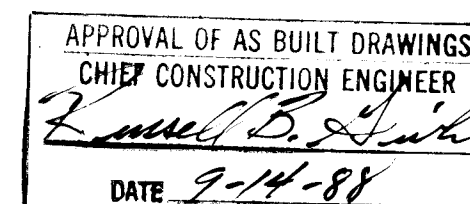

1 2 3 4 5 6 7 8 9 10 11 12
26 30760188

22	5/24/80				
REV. SHEETS	ENGR	DATE	USER	DEPT	DATE
APPROVAL OF REVISIONS					

ENGINEERS' SEAL 	ESPEY, HUSTON & ASSOC., INC. Engineering & Environmental Consultants 317 COMMERCIAL ST. N.E. ALBUQUERQUE, NEW MEXICO 87102 PHONE (505) 242-1909	APPROVED FOR CONSTRUCTION
PROJECT NUMBER 3076		SHEET 1 OF 23

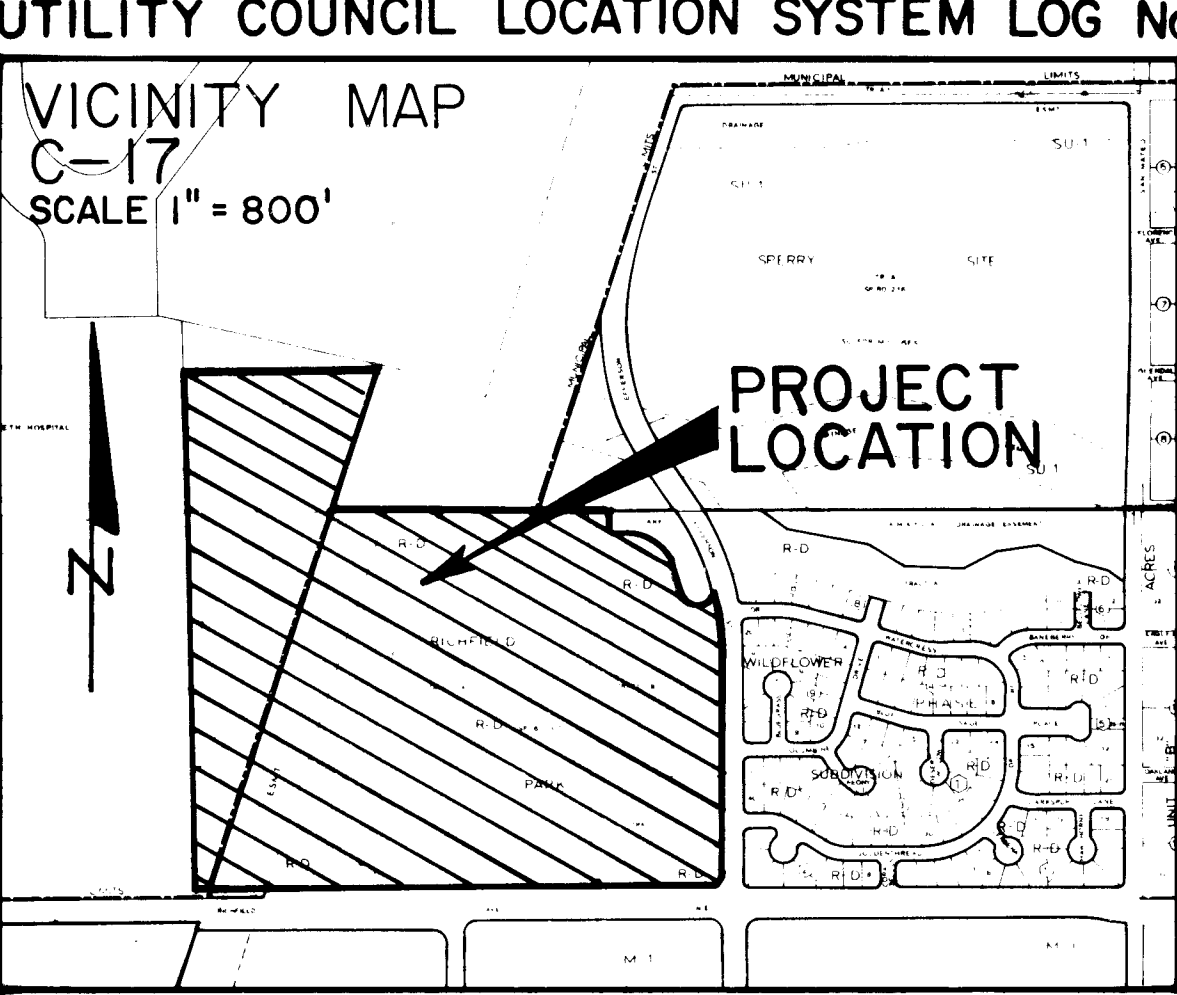

FREE CONSENT AND DEDICATION

The subdivision hereon described is with the free consent and in accordance with the desires of the undersigned owner and/or proprietor thereof and said owner and/or proprietors do hereby dedicate all public streets shown hereon to the City of Albuquerque in fee simple and do hereby grant Electrical Power and Communication easements reserved for overhead distribution lines for pole type utilities and buried distribution lines, conduits, pipes and other necessary equipment for underground utilities where shown or indicated, and including the right of ingress of egress for construction and maintenance, and the right to trim interfering trees and shrubs. The undersigned owners and/or proprietors do hereby grant public waterline easements for installation, service and maintenance of waterlines, valves, pumps, hydrants and/or other related equipment and facilities reasonably necessary to provide fire protection and potable water to the residents of the subdivision shown hereon in accordance with the plans and procedures of the City of Albuquerque, and said owners and/or proprietors do hereby grant public drainage, public sanitary sewer, sidewalk, pedestrian easements and private drainage easements as shown hereon. The undersigned owners and/or proprietors do hereby consent to the vacation of interior lot lines of TRACTS B and C, TRACT A-1 RICHFIELD PARK, and easements as shown hereon.

CLIFFORD PARTNERSHIP

Jack J. Clifford
Jack J. Clifford, general partner
7-15-86
Date

STATE OF NEW MEXICO)
COUNTY OF BERNALILLO) SS

On this 15th day of July, 1986, the foregoing instrument was acknowledged before me.
My commission expires 3-14-90.

Marjorie Townsend
Notary Public

SOUTHWEST NATIONAL BANK

Jack J. Clifford
Jack J. Clifford, Chairman of the Board
7-15-86
Date

STATE OF NEW MEXICO)
COUNTY OF BERNALILLO) SS

On this 15th day of July, 1986, the foregoing instrument was acknowledged before me.
My commission expires 3-14-90.

Marjorie Townsend
Notary Public

Frank L. Hines, Co-Owner TRACT B-1

Dolores H. Hines
Dolores H. Hines, Co-Owner, TRACT B-1
7-16-86
Date

STATE OF NEW MEXICO)
COUNTY OF BERNALILLO) SS

On this 16th day of July, 1986, the foregoing instrument was acknowledged before me.
My commission expires 7-8-89.

Ray A. Hernandez
Notary Public

DESCRIPTION

A tract of land situate within projected Sections 11 and 14, Township 11 North, Range 3 East, New Mexico Principal Meridian within the Elena Gallegos Grant, Bernalillo County, New Mexico being TRACTS B and C, RICHFIELD PARK, as the same are shown and designated on said plat, filed in the office of the County Clerk of Bernalillo County, New Mexico on December 22, 1982 (C20-125(1,2)), together with TRACT A-1, RICHFIELD PARK as the same is shown and designated on said plat filed in the office of the County Clerk of Bernalillo County, New Mexico on August 29, 1985 (C28-40), and being more particularly described as follows:

BEGINNING at the southwest corner, a point on the north right-of-way line of Alameda Boulevard NE and further being on an east boundary line of TRACT A, SISTERS OF THE ORDER OF ST. DOMINIC as the same is shown and designated on said plat filed in the office of the County Clerk of Bernalillo County, New Mexico on June 26, 1985 (C27-141(1-5)) from whence ACS monument "6-C17" bears N 28° 19' 30" W, 2321.44 feet;

THENCE N 00° 15' 04" E, 2065.09 feet to a point;

THENCE S 89° 45' 07" E, 867.28 feet to a point;

THENCE S 18° 16' 52" W, 600.88 feet to a point;

THENCE S 89° 44' 47" E, 1077.23 feet to a point, said point being common with the northwest corner of PARK SITE, WILD FLOWER SUBDIVISION as the same is shown and designated on said plat filed in the office of the County Clerk of Bernalillo County, New Mexico on May 30, 1985 (C 27-71);

THENCE along the boundary line of PARK SITE, WILDFLOWER SUBDIVISION, S 00° 15' 13" W, 115.00 feet to a point;

THENCE continuing S 89° 44' 46" E, 105.33 feet to a point of curvature;

THENCE continuing 124.20 feet along a curve to the right, whose radius is 112.50 feet through a central angle of 63° 15' 12" to a point of compound curvature;

THENCE continuing 206.46 feet along a curve to the right, whose radius is 837.00 feet through a central angle of 14° 07' 58" to a point of reverse curvature;

THENCE continuing 33.71 feet along a curve to the left, whose radius is 25.00 feet through a central angle of 77° 15' 59" to a point of tangency;

THENCE continuing S 89° 37' 35" E, 71.63 feet to a point of curvature;

THENCE continuing 44.40 feet along a curve to the left, whose radius is 25.00 feet and whose long chord bears N 39° 29' 32" E, 38.79 feet through a central angle of 101° 45' 47" to a point, said point being on the west right-of-way line of Jefferson Street NE;

THENCE along said right-of-way line 196.48 feet along a curve to the right, whose radius is 957.00 feet and whose long chord bears S 05° 30' 28" E, 196.13 feet through a central angle of 11° 45' 47" to a point of tangency;

THENCE continuing along said right-of-way line S 00° 22' 25" W, 917.78 feet to a point of curvature;

THENCE leaving said right-of-way line 39.27 feet along a curve to the right, whose radius is 25.00 feet through a central angle of 90° 00' 00" to a point of tangency, said point being on the north right-of-way line of Alameda Boulevard NE;

THENCE along said right-of-way line N 89° 37' 35" W, 2146.83 feet to the point of beginning and containing 82.5254 acres more or less.

SURVEYOR'S CERTIFICATION

"I, Timothy Aldrich, a duly qualified Registered Professional Land Surveyor under the laws of the State of New Mexico, do hereby certify that this plat was prepared by me or under my supervision, shows all easements and restrictions as shown on the plat of record and noted in title reports prepared by Lawyers Title Insurance Corporation on June 19, 1984, Policy No. 85-00-156829 and on September 30, 1981, Policy No. 85-81-62258, or made known to me by the owners and/or proprietors of the subdivision shown hereon, utility companies and other parties expressing an interest. I further certify that this plat meets the minimum requirements for monumentation and surveys of the Albuquerque Subdivision Ordinance, meets the requirements set forth by the State of New Mexico, and is true and correct to the best of my knowledge and belief."

Timothy Aldrich
Timothy Aldrich, N.M.P.L.S. No. 7719
07-14-86
Date

STATE OF NEW MEXICO)
COUNTY OF BERNALILLO) SS

On this 17th day of July, 1986, the SURVEYOR'S CERTIFICATION was acknowledged before me.

Karen R. Hillman
Notary Public

PLAT FOR
RICHFIELD PARK SUBDIVISION
ALBUQUERQUE, NEW MEXICO
JUNE, 1986

APPROVED AND ACCEPTED:

Subdivision Case No. S-86-43

Planning Director, City of Albuquerque, New Mexico
Date

City Engineer, City of Albuquerque, New Mexico
Date

Albuquerque Metropolitan Arroyo Flood Control Authority
Date
Robert A. Farnsworth
Traffic Engineer, City of Albuquerque, New Mexico
8-5-86
Date

Water Utilities Department, City of Albuquerque, New Mexico
Date

Parks & Recreation Department, City of Albuquerque, New Mexico
Date
James H. Stone
Chief City Surveyor, City of Albuquerque, New Mexico
071866
Date

Property Management, City of Albuquerque, New Mexico
Date
O. Valverde
7-21-86
Date

Gas Company of New Mexico
Date
Wayne H. Hernandez
7-16-86
Date

Mountain Bell Telephone
Date
John Myer
7-16-86
Date

Public Service Company of New Mexico
Date

SUBDIVISION DATA

- DRB Case No. 86-154
- Zone Atlas Index No. C-17
- Total Number Lots Created: 42
Total Number Tracts Created: 3
- Gross Subdivision Acreage: 82.5254 acres
- Date of Survey: May 20, 1985
- Total Mileage of Full Width Public Streets Created: 0.7788 miles
- Total Public Street Right-of-Way Dedicated By This Plat: 5.8172 acres

NOTES

- Bearings are New Mexico State Plane Grid Bearings (Central Zone).
- Distances are ground distances.
- Bearings and distances in parenthesis are record.
- Unless otherwise indicated, all points marked with an open circle are set 5/8" rebar with cap "EH&A L.S. 7719".
- Centerline (in lieu of R/W monumentation) to be installed at all centerline PC's, PT's, angle points and street intersections prior to acceptance of subdivision street improvements and will consist of a standard four inch (4") aluminum alloy cap stamped "City of Albuquerque", "Centerline Monumentation", "Survey Marker", "Do Not Disturb", "PLS #7719", indicated thus ▲.
- Right turn ingress and egress to Tract D-1, Lots 1 through 5 and 26 from the westbound lane of Alameda Boulevard will be permitted. Left turn ingress and egress to Tract D-1, Lots 1 through 5 and 26 to Alameda Boulevard will only be permitted within the median openings marked with an asterisk.
- Left turn ingress and egress to Tract C-1 will not be permitted at the first median opening north and the first median opening west of the Alameda Boulevard/Jefferson Street intersection.
- Clifford Partnership, the owner of Tract D-1, and the City of Albuquerque, agree that a well site will be reserved on Tract D-1. The size, location and method of the City's acquisition of the well site is to be determined prior to further subdivision of Tract D-1.

PURPOSE OF PLAT

- Vacate interior lot lines of Richfield Park Tract B and C and subdivide Richfield Park Tract A-1.
- Create Lots 1 through 42 and TRACTS B-1, C-1, and D-1.
- Dedicate public streets as shown hereon.
- Grant public drainage, public sanitary sewer, power and communication easements, as shown hereon.

JOB No. 7795
Office TA, D.J.
Draft VVH, CR
F.B.
Date 7-14-86

eh ESPEY, HUSTON & ASSOC., INC.
Engineering & Environmental Consultants
317 COMMERCIAL ST. NE
ALBUQUERQUE, NEW MEXICO 87102
PHONE (505) 242-1909

SHEET 1 OF 5

UTILITY COUNCIL LOCATION SYSTEM LOG No. SP-07-14-1177

SHEET 3


REF. NO.	BEARING	DISTANCE
1	S18°16'52"W	600.88
2	(115.00) (S00°04'20"W)	
3	S89°44'46"E	(105.33) (S89°55'40"E)
4	S89°37'35"E	(71.63) (S89°48'30"E)
5	N89°37'35"E	15.42
6	S89°37'35"E	15.42
7	N89°37'35"E	30.00
8	N00°22'25"E	30.00
9	S89°44'47"E	176.01
10	S89°44'47"E	30.00
11	S71°43'08"E	55.00
12	S89°37'35"E	33.04
13	N89°37'35"E	23.04
14	S18°16'52"W	58.58
15	N89°44'47"E	35.19

CURVE NO.	DELTA	RADIUS	LENGTH	CHORD	TAN	CH-BEARING
1	63°15'12"	(112.50)	(124.20)	(117.99)	(69.28)	S 58° 7' 10" E
2	14° 7' 58"	(837.00)	(206.46)	(205.93)	(103.76)	S 19° 25' 33" E
3	77° 15' 59"	(25.00)	(33.71)	(31.22)	(19.96)	S 50° 50' 59" E
4	101° 45' 47"	(25.00)	(44.40)	(38.79)	(30.74)	N 39° 29' 32" E
5	11° 45' 47"	(957.00)	(196.48)	(196.13)	(98.58)	S 5° 30' 28" E
6	15° 42' 07"	(25.00)	(39.27)	(35.36)	(25.00)	S 45° 22' 25" W
7	90° 0' 0"	30.00	47.12	42.43	30.00	S 89° 37' 35" E
8	36° 58' 4"	410.00	224.54	259.97	137.06	S 71° 53' 23" W
9	36° 58' 4"	410.00	224.54	259.97	137.06	S 71° 53' 23" E
10	36° 58' 4"	410.00	224.54	259.97	137.06	S 71° 53' 23" E
11	36° 58' 4"	410.00	224.54	259.97	137.06	S 71° 53' 23" E
12	90° 0' 0"	30.00	47.12	42.43	30.00	N 44° 37' 35" E
13	90° 0' 0"	30.00	47.12	42.43	30.00	N 44° 37' 35" E
14	17° 54' 27"	770.00	240.66	239.68	121.32	S 9° 19' 39" E
15	90° 0' 0"	25.00	39.27	35.36	25.00	S 63° 16' 52" E
16	17° 54' 27"	530.00	165.65	164.97	83.50	N 54° 16' 22" E
17	17° 54' 27"	530.00	165.65	164.97	83.50	N 54° 16' 22" E
18	90° 0' 0"	25.00	39.27	35.36	25.00	S 63° 16' 52" W
19	90° 0' 0"	25.00	39.27	35.36	25.00	S 63° 16' 52" W
SHEET 4

REF. NO.	BEARING	DISTANCE
1	S18°16'52"W	600.88
2	S89°37'35"E	483.04
3	N81°28'51"W	148.04
4	N81°28'51"W	68.83
5	S81°28'51"E	68.83
6	N81°28'51"W	203.04
7	N71°43'08"E	55.00
8	N81°28'51"W	89.27
9	N00°22'25"E	30.00
10	S89°44'47"E	176.01
11	S81°28'51"E	123.83
12	N89°37'35"E	125.00
13	N89°37'35"W	150.00
14	S89°37'35"E	241.81
15	S89°37'35"E	150.00
16	S89°37'35"E	150.00
17	N89°37'35"W	150.00
18	N89°37'35"E	150.00
19	S89°37'35"E	150.00
20	N89°37'35"E	23.04
21	S89°44'47"E	90.24
22	N89°37'35"W	140.00
23	S18°16'52"W	58.58

CURVE DATA						
CURVE NO.	DELTA	RADIUS	LENGTH	CHORD	TAN	CH-BEARING
1	90° 0' 0"	30.00	47.12	42.43	30.00	N 44° 37' 35" W
2	17° 54' 27"	770.00	239.66	239.68	121.32	N 9° 19' 39" E
3	90° 0' 0"	25.00	39.27	35.36	25.00	N 63° 16' 52" E
4	17° 54' 27"	530.00	165.65	164.97	83.50	S 80° 40' 21" E
5	17° 54' 27"	470.00	146.90	146.30	74.05	N 80° 40' 21" W
6	90° 0' 0"	25.00	39.27	35.36	25.00	N 26° 43' 8" W
7	71° 58' 21"	170.00	213.55	199.78	123.45	N 54° 16' 22" E
8	71° 58' 21"	270.00	288.92	270.29	167.02	N 54° 16' 22" E
9	90° 0' 0"	25.00	39.27	35.36	25.00	S 63° 16' 52" W
10	5° 27' 18"	2577.15	245.37	245.28	122.78	N 74° 26' 47" W
11	9° 11' 11"	1770.01	245.84	245.64	123.13	S 75° 49' 6" E
12	90° 0' 0"	25.00	39.27	35.36	25.00	S 26° 43' 8" E
13	17° 54' 27"	830.00	259.41	258.36	130.77	S 9° 19' 39" E
14	90° 0' 0"	25.00	39.27	35.36	25.00	S 45° 22' 25" W
15	5° 35' 8"	2517.15	245.39	245.29	122.79	S 74° 30' 42" E
16	90° 0' 0"	25.00	39.27	35.36	25.00	S 63° 16' 52" W
17	90° 0' 0"	25.00	39.27	35.36	25.00	S 63° 16' 52" W
18	7° 55' 13"	1778.01	245.78	245.58	123.09	N 75° 44' 44" W
19	1° 56' 16"	2677.15	130.72	130.67	30.66	N 56° 28' 00" E
20	90° 0' 0"	25.00	39.27	35.36	25.00	N 56° 28' 00" E
21	42° 50' 0"	25.00	18.69	18.36	9.81	N 29° 56' 10" E
22	265° 40' 0"	25.00	231.84	73.23	9.81	N 81° 28' 51" W
23	42° 50' 0"	25.00	18.69	18.36	9.81	N 29° 56' 10" E
24	42° 50' 0"	25.00	18.69	18.36	9.81	N 29° 56' 10" E
25	175° 40' 0"	25.00	153.30	99.93	1321.64	S 35° 28' 51" W
26	1° 50' 0"	25.00	18.69	18.26	9.81	N 29° 56' 10" E
27	1° 50' 0"	25.00	18.69	18.26	9.81	N 29° 56' 10" E
28	1° 50' 0"	25.00	18.69	18.26	9.81	N 29° 56' 10" E
29	90° 0' 0"	25.00	39.27	35.36	25.00	S 63° 16' 52" W
30	90° 0' 0"	25.00	39.27	35.36	25.00	S 63° 16' 52" W
31	17° 54' 27"	500.00	156.27	155.64	78.78	N 80° 40' 21" W
32	90° 0' 0"	25.00	39.27	35.36	25.00	S 63° 16' 52" W
33	3° 49' 16"	470.00	237.08	237.16	123.45	N 36° 28' 59" E
34	90° 0' 0"	80.00	125.66	125.66	63.50	N 36° 28' 59" E
35	17° 54' 27"	530.00	165.65	164.97	83.50	N 80° 40' 21" E
36	71° 58' 21"	200.00	251.23	235.04	145.24	N 54° 16' 22" E
37	71° 58' 21"	200.00	251.23	235.04	145.24	N 54° 16' 22" E
38	141° 17' 8"	770.00	191.98	191.49	96.49	N 7° 30' 59" E
39	3° 37' 19"	770.00	48.68	48.67	24.35	N 16° 28' 12" E
40	8° 40' 0"	770.00	74.05	73.94	37.53	N 16° 28' 12" E
41	9° 54' 7"	770.00	91.60	91.48	45.91	S 84° 40' 31" E
42	14° 24' 34"	770.00	118.20	117.89	59.41	N 82° 25' 18" W
43	3° 29' 43"	770.00	28.26	28.25	14.13	N 16° 28' 12" E
44	25° 50' 46"	170.00	76.69	76.04	39.05	N 31° 12' 15" E
45	46° 7' 35"	170.00	136.86	133.19	72.38	N 67° 11' 26" E
46	11° 22' 47"	870.00	165.06	165.06	82.53	N 67° 11' 26" E
47	6° 26' 40"	870.00	93.36	93.31	46.73	S 1° 35' 32" E
48	5° 46' 50"	230.00	120.21	120.20	11.61	S 25° 10' 17" W
49	36° 6' 18"	230.00	144.92	142.78	61.68	N 7° 06' 06" E
50	30° 5' 23"	230.00	23.79	19.40	61.82	S 75° 12' 31" W

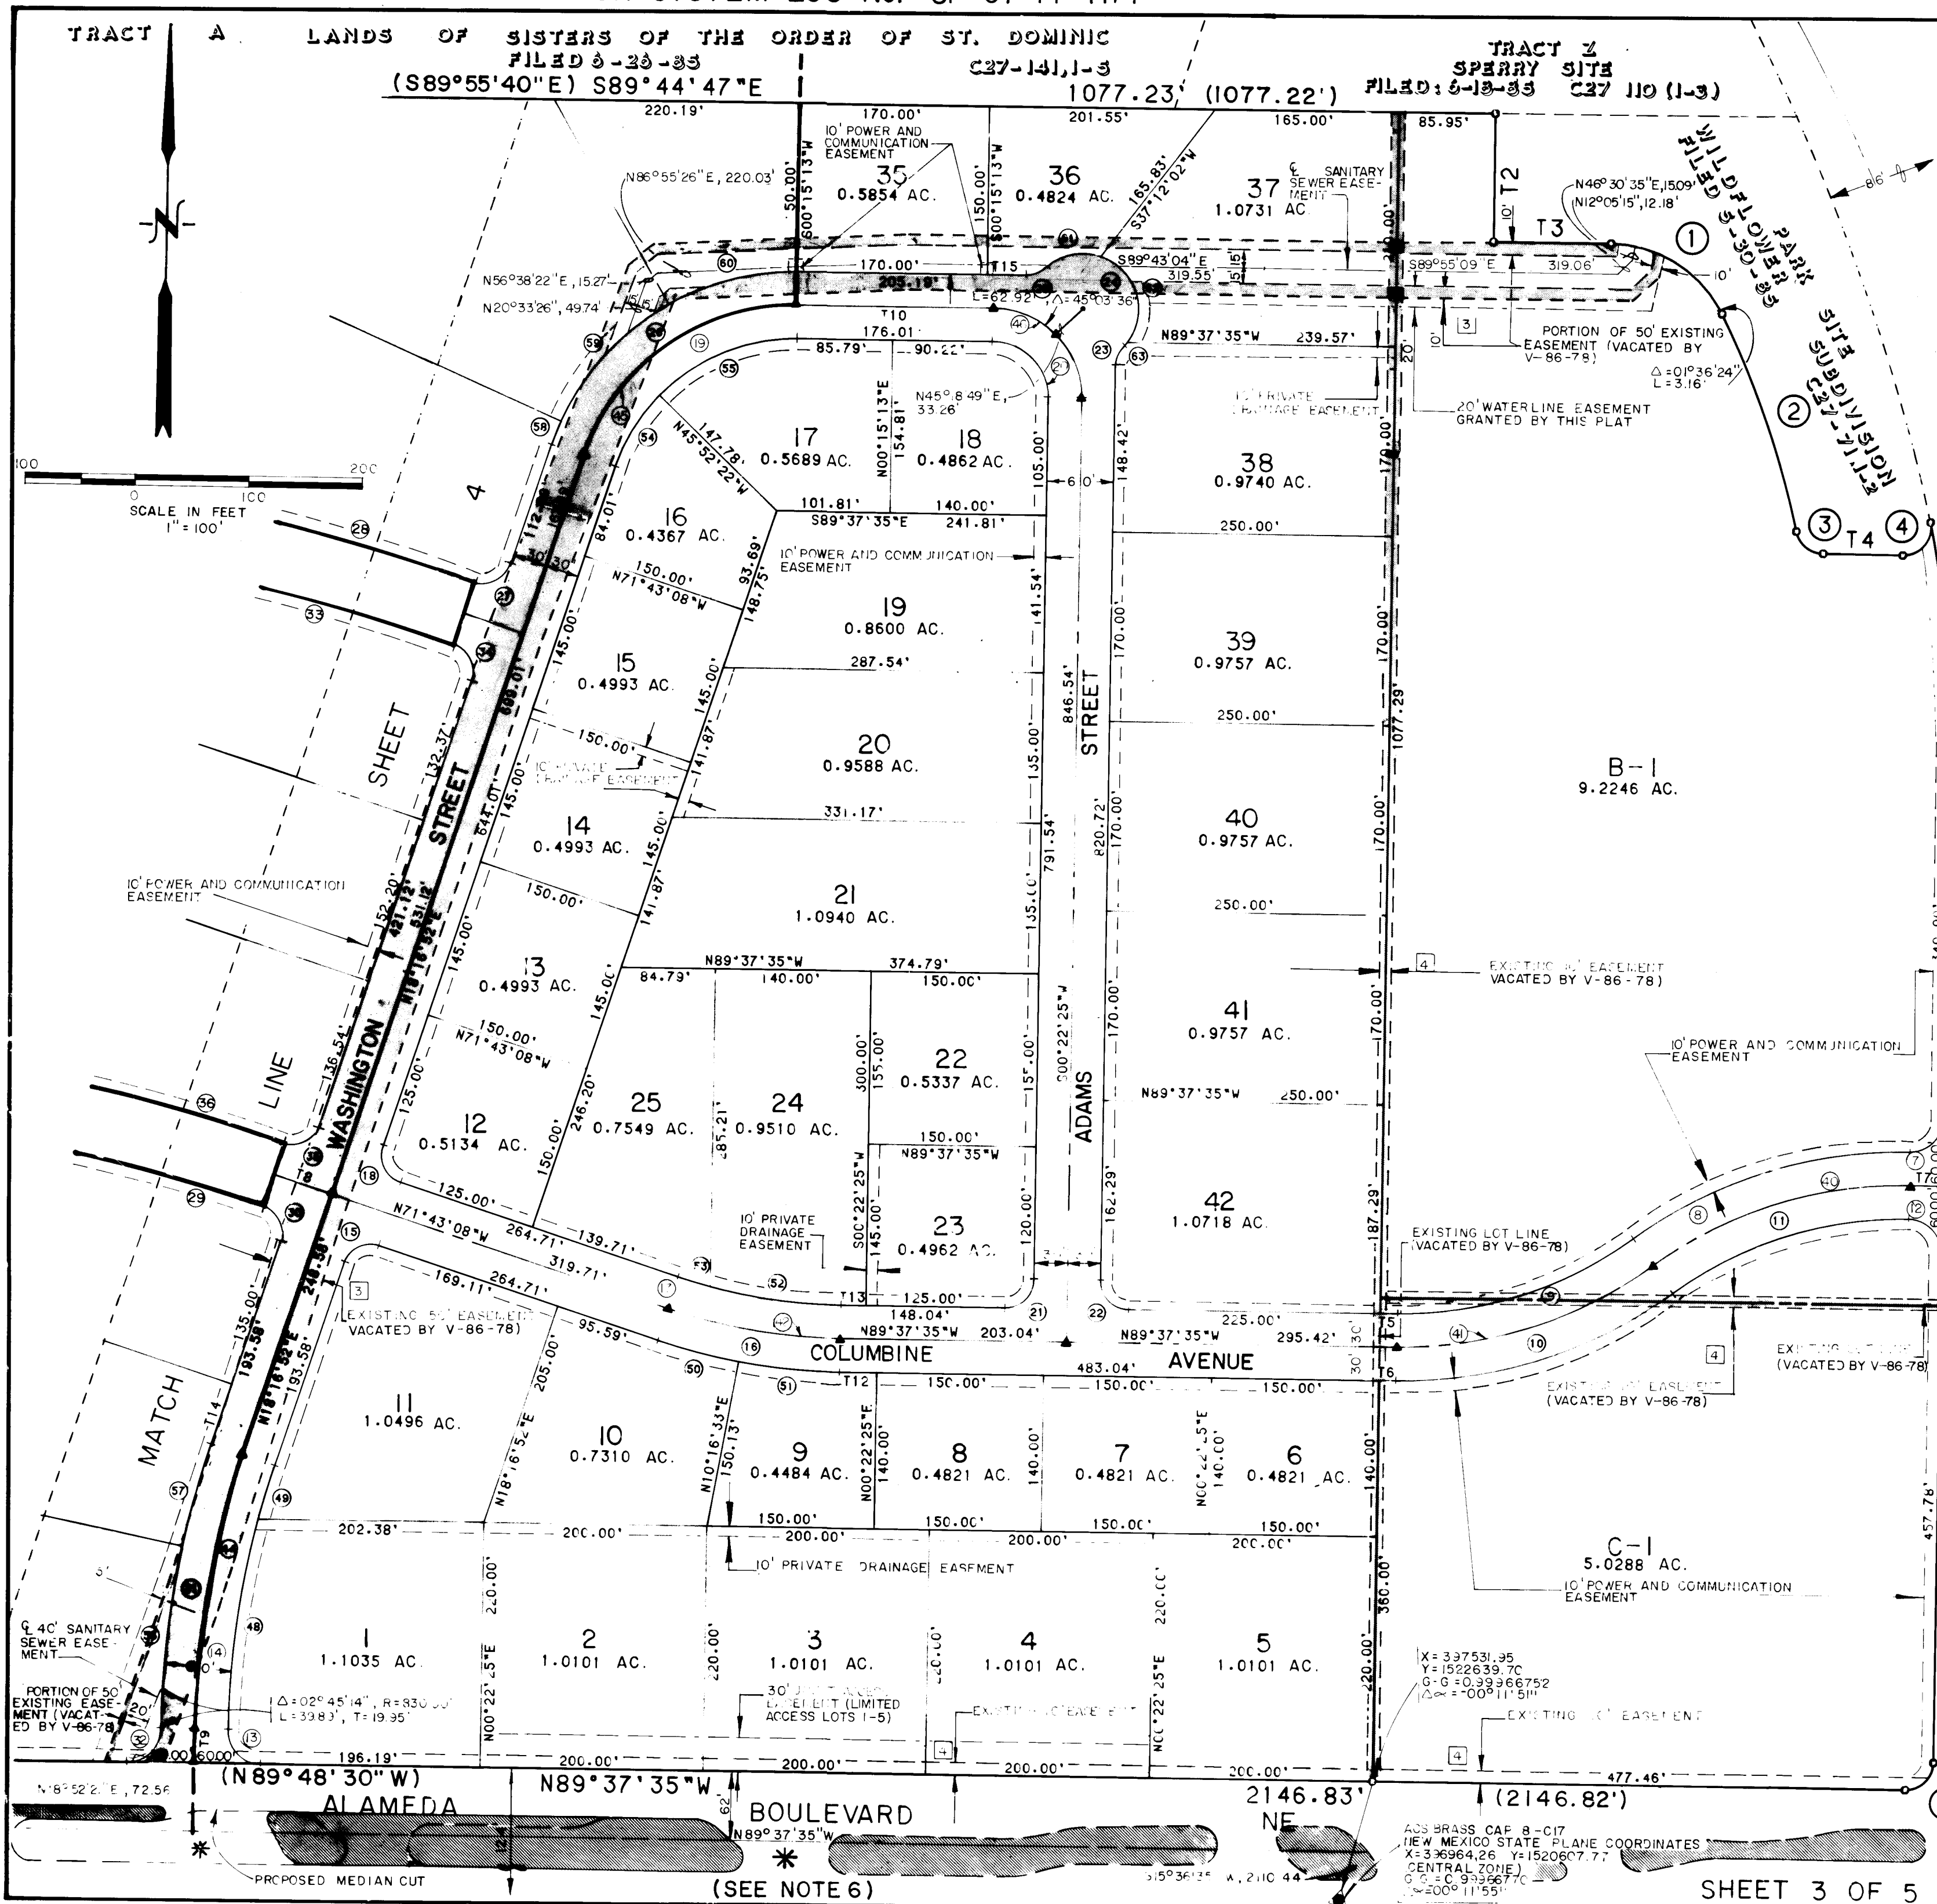

PLAT FOR
RICHFIELD PARK SUBDIVISION
ALBUQUERQUE, NEW MEXICO
JUNE, 1986

SURVEYOR'S CERTIFICATION

"I, Timothy Aldrich, a duly qualified Registered Professional Land Surveyor under the laws of the State of New Mexico, do hereby certify that this plat was prepared by me or under my supervision, shows all easements and restrictions as shown on the plat of record and noted in title reports prepared by Lawyers Title Insurance Corporation on June 19, 1984, Policy No. 85-00-156829 and on September 30, 1981, Policy No. 85-81-62258, or made known to me by the owners and/or proprietors of the subdivision shown hereon, utility companies and other parties expressing an interest. I further certify that this plat meets the minimum requirements for monumentation and surveys of the Albuquerque Subdivision Ordinance, meets the requirements set forth by the State of New Mexico, and is true and correct to the best of my knowledge and belief."

Timothy Aldrich 07-14-86
Timothy Aldrich, N.M.L.S. No. 7719 Date

STATE OF NEW MEXICO) SS
COUNTY OF BERNALILLO)


On this 14th day of July, 1986, the SURVEYOR'S CERTIFICATION was acknowledged before me.

Karen R. Nelson
Notary Public

- EASEMENTS**
- EXISTING 25' PRIVATE ROAD ACCESS EASEMENT (MISC. BOOK 126A, PAGES 423-427)
 - EXISTING 200' PUBLIC SERVICE CO. OF NEW MEXICO EASEMENT (DEED BOOK 390, PAGE 99)
 - EXISTING 50' SANITARY SEWER EASEMENT (RICHFIELD PARK TRACT A-1 - BOOK C28, FOLIO 40)
 - EXISTING 10' PUBLIC UTILITY EASEMENT (RICHFIELD PARK TRACT A-1 - BOOK C28, FOLIO 40)
 - EXISTING 100' AMAFCA EASEMENT (MISC. BOOK 89, PAGES 188-197)

Job No. 7795
Office TA, DJ
Draft VVH, CR
F.B.
Date 7-14-86

ESPEY, HUSTON & ASSOC., INC.
Engineering & Environmental Consultants
317 COMMERCIAL ST. N.E.
ALBUQUERQUE, NEW MEXICO 87102
PHONE (505) 242-1909

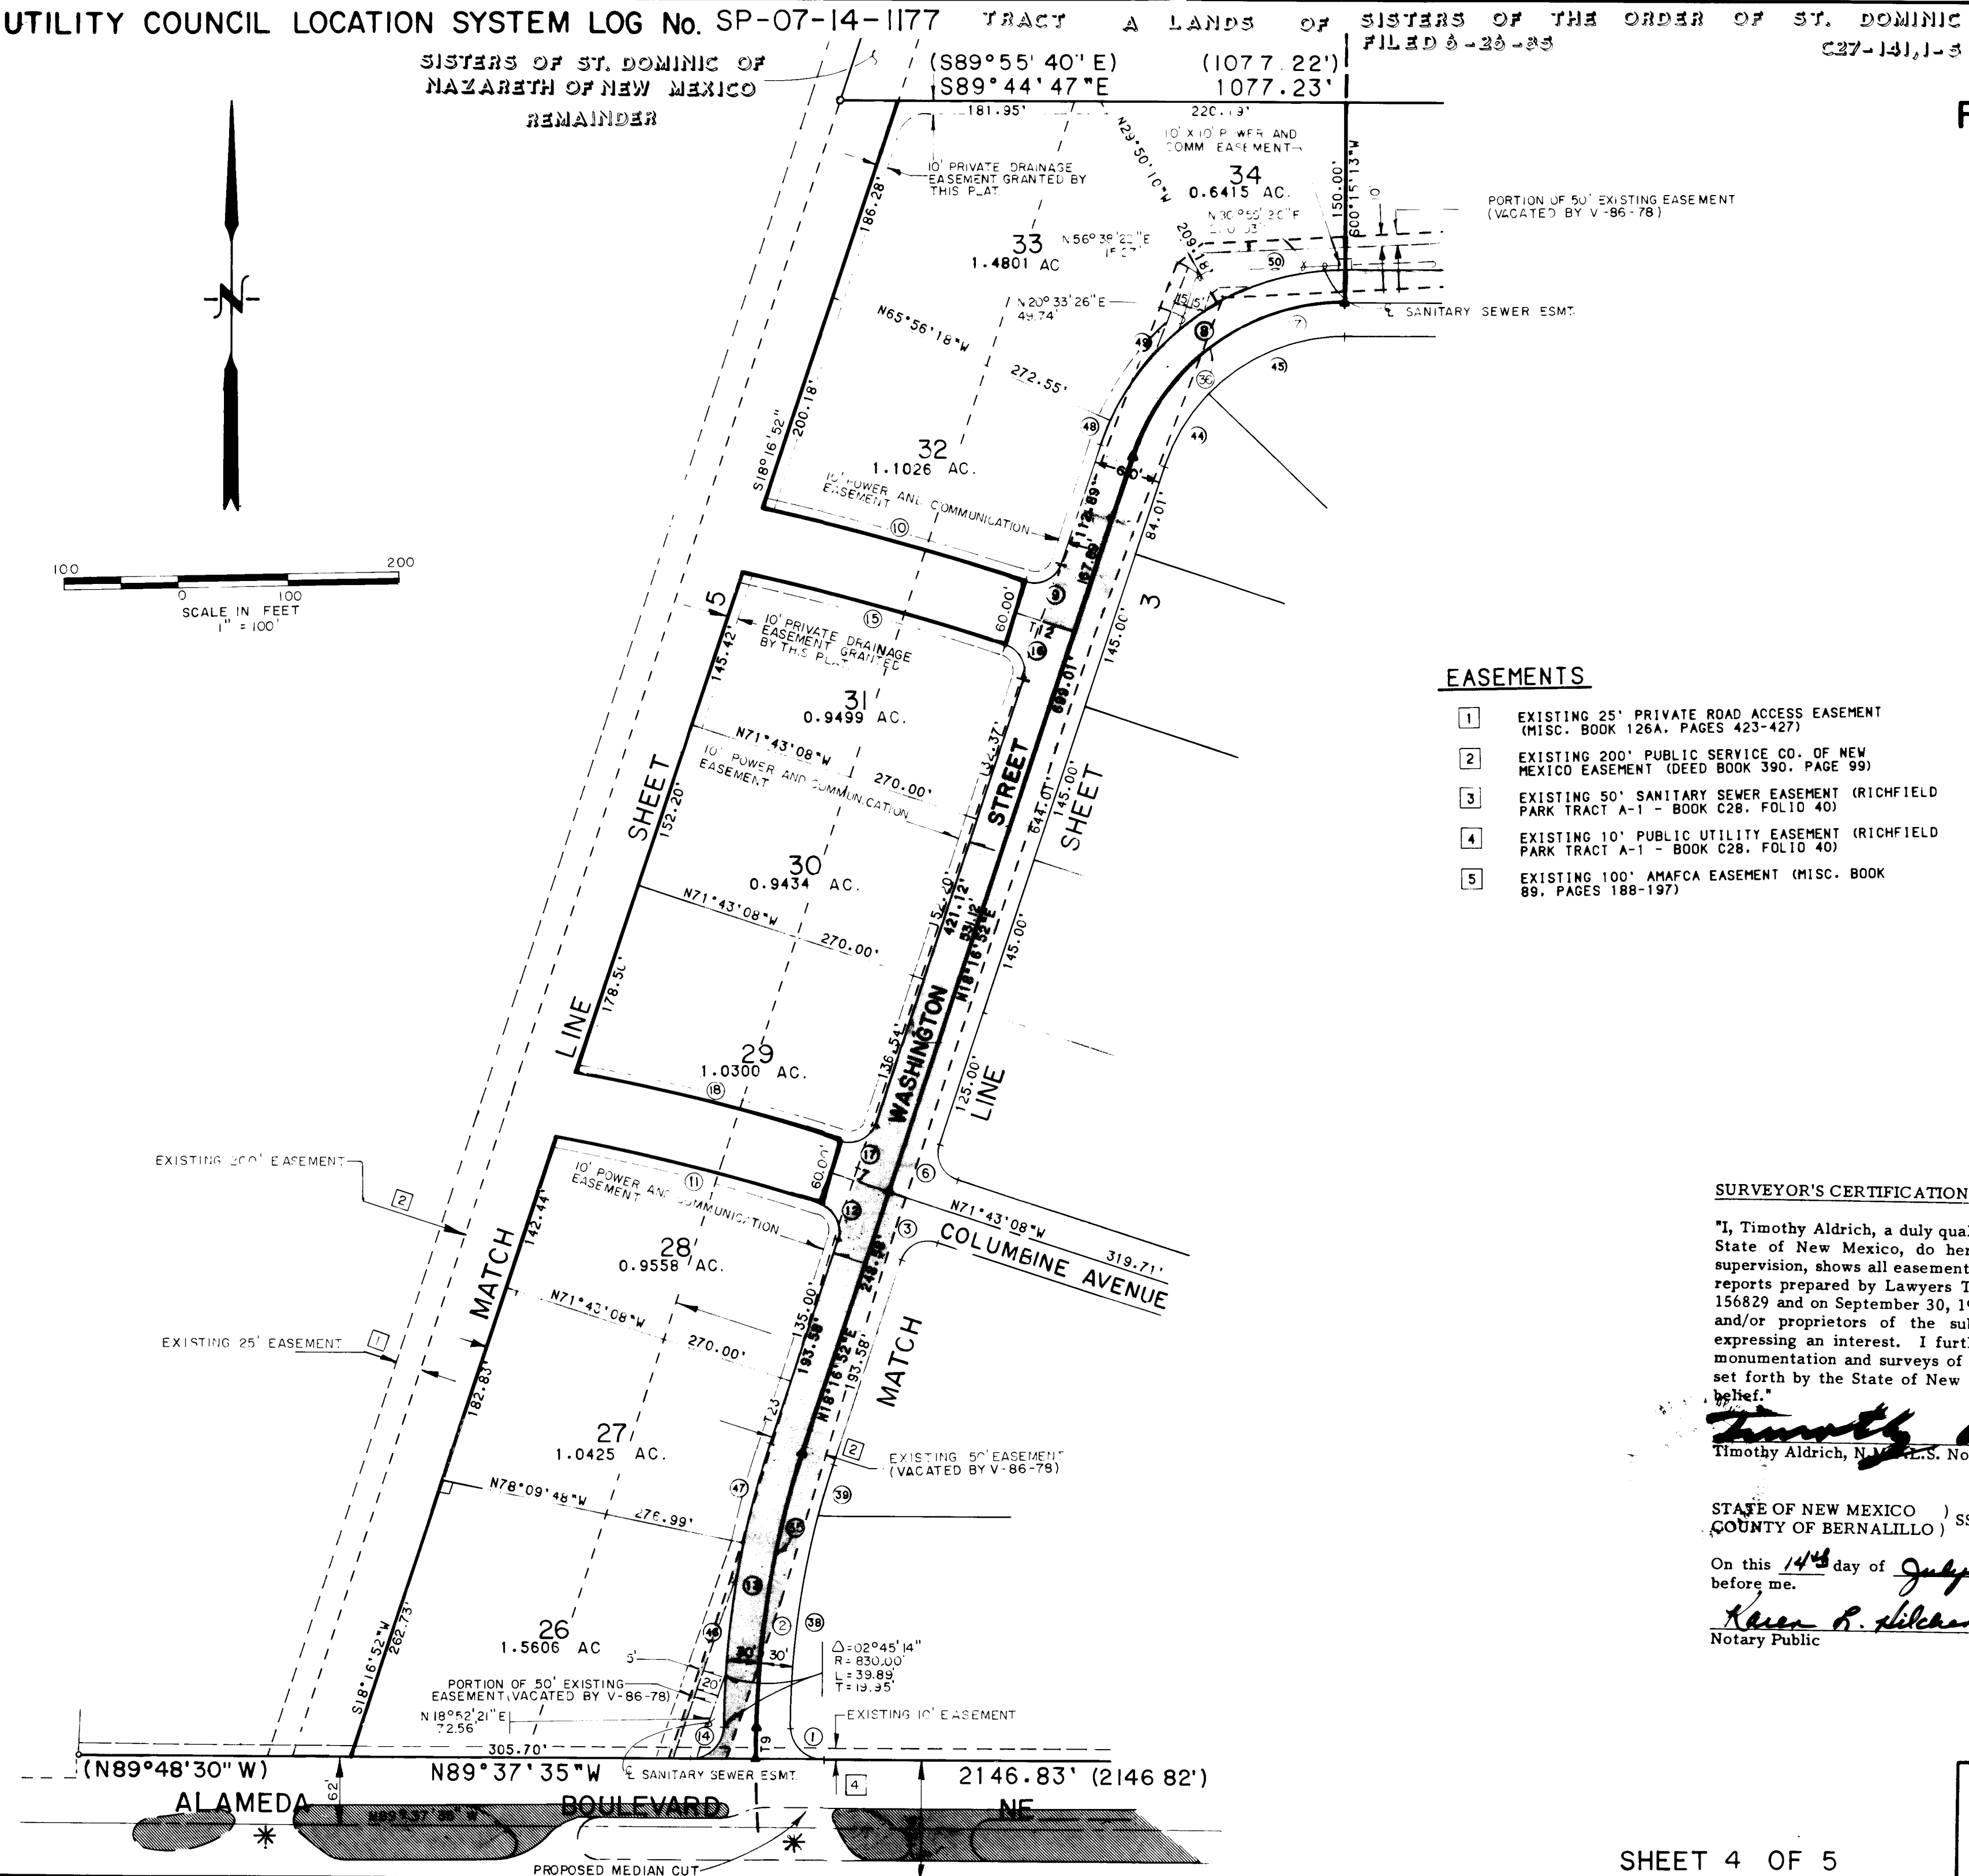

PLAT FOR
RICHFIELD PARK SUBDIVISION
ALBUQUERQUE, NEW MEXICO
JUNE, 1986

- EASEMENTS**
- EXISTING 25' PRIVATE ROAD ACCESS EASEMENT (MISC. BOOK 126A, PAGES 423-427)
 - EXISTING 200' PUBLIC SERVICE CO. OF NEW MEXICO EASEMENT (DEED BOOK 390, PAGE 99)
 - EXISTING 50' SANITARY SEWER EASEMENT (RICHFIELD PARK TRACT A-1 - BOOK C28, FOLIO 40)
 - EXISTING 10' PUBLIC UTILITY EASEMENT (RICHFIELD PARK TRACT A-1 - BOOK C28, FOLIO 40)
 - EXISTING 100' AMAFCA EASEMENT (MISC. BOOK 89, PAGES 188-197)

SURVEYOR'S CERTIFICATION

"I, Timothy Aldrich, a duly qualified Registered Professional Land Surveyor under the laws of the State of New Mexico, do hereby certify that this plat was prepared by me or under my supervision, shows all easements and restrictions as shown on the plat of record and noted in title reports prepared by Lawyers Title Insurance Corporation on June 19, 1984, Policy No. 85-00-156829 and on September 30, 1981, Policy No. 85-81-62258, or made known to me by the owners and/or proprietors of the subdivision shown hereon, utility companies and other parties expressing an interest. I further certify that this plat meets the minimum requirements for monumentation and surveys of the Albuquerque Subdivision Ordinance, meets the requirements set forth by the State of New Mexico, and is true and correct to the best of my knowledge and belief."

Timothy Aldrich 07-14-86
Timothy Aldrich, N.M.L.S. No. 7719 Date

STATE OF NEW MEXICO) SS
COUNTY OF BERNALILLO)

On this 14th day of July, 1986, the SURVEYOR'S CERTIFICATION was acknowledged before me.

Karen R. Nelson
Notary Public

Job No. 7795
Office TA, DJ
Draft VVH, CR
F.B.
Date 7-14-86

ESPEY, HUSTON & ASSOC., INC.
Engineering & Environmental Consultants
317 COMMERCIAL ST. N.E.
ALBUQUERQUE, NEW MEXICO 87102
PHONE (505) 242-1909

PLAT FOR
RICHFIELD PARK SUBDIVISION
ALBUQUERQUE, NEW MEXICO
JUNE, 1986TRACT A
LANDS OF
SISTERS OF THE ORDER OF ST. DOMINIC
FILED 8-28-83 C27-141,1-3

NOTE:
Interim public and private drainage easements are located on Tract D-1 for the purpose of conveying storm runoff from Richfield Park Subdivision, Lots 1-42 and Tracts B-1 and C-1 to the west boundary of Tract D-1. The width, alignment and exact locations of these easements shall be determined at the time Tract D-1 develops.

TRACT A
LANDS OF
SISTERS OF THE ORDER OF ST. DOMINIC
FILED 8-28-83 C27-141,1-3

EASEMENTS

- 1 EXISTING 25' PRIVATE ROAD ACCESS EASEMENT (MISC. BOOK 126A, PAGES 423-427)
- 2 EXISTING 200' PUBLIC SERVICE CO. OF NEW MEXICO EASEMENT (DEED BOOK 390, PAGE 99)
- 3 EXISTING 50' SANITARY SEWER EASEMENT (RICHFIELD PARK TRACT A-1 - BOOK C28, FOLIO 40)
- 4 EXISTING 10' PUBLIC UTILITY EASEMENT (RICHFIELD PARK TRACT A-1 - BOOK C28, FOLIO 40)
- 5 EXISTING 100' AMAFCA EASEMENT (MISC. BOOK 89, PAGES 188-197)

SURVEYOR'S CERTIFICATION

"I, Timothy Aldrich, a duly qualified Registered Professional Land Surveyor under the laws of the State of New Mexico, do hereby certify that this plat was prepared by me or under my supervision, shows all easements and restrictions as shown on the plat of record and noted in title reports prepared by Lawyers Title Insurance Corporation on June 19, 1984, Policy No. 85-00-156829 and on September 30, 1981, Policy No. 85-81-62258, or made known to me by the owners and/or proprietors of the subdivision shown hereon, utility companies and other parties expressing an interest. I further certify that this plat meets the minimum requirements for monumentation and surveys of the Albuquerque Subdivision Ordinance, meets the requirements set forth by the State of New Mexico, and is true and correct to the best of my knowledge and belief."

Timothy Aldrich 07-18-86
Timothy Aldrich, N.M. L.S. No. 7719 Date

STATE OF NEW MEXICO) SS
COUNTY OF BERNALILLO)

On this 18th day of July, 1986, the SURVEYOR'S CERTIFICATION was acknowledged before me.

Raven R. Hagan
Notary Public

SHEET 5 OF 5

Job No. 7795
Office TA, DJ
Draft VVH, CK
F.B.
Date 7-18-86

eh ESPEY, HUSTON & ASSOC., INC.
Engineering & Environmental Consultants
317 COMMERCIAL ST. N.E.
ALBUQUERQUE, NEW MEXICO 87102
PHONE (505) 242-1909

PLAT FOR
RICHFIELD PARK SUBDIVISION
ALBUQUERQUE, NEW MEXICO
JUNE, 1986TRACT A
LANDS OF
SISTERS OF THE ORDER OF ST. DOMINIC
FILED 8-28-83 C27-141,1-3TRACT A
LANDS OF
SISTERS OF THE ORDER OF ST. DOMINIC
FILED 8-28-83 C27-141,1-3

EASEMENTS

- 1 EXISTING 25' PRIVATE ROAD ACCESS EASEMENT (MISC. BOOK 126A, PAGES 423-427)
- 2 EXISTING 200' PUBLIC SERVICE CO. OF NEW MEXICO EASEMENT (DEED BOOK 390, PAGE 99)
- 3 EXISTING 50' SANITARY SEWER EASEMENT (RICHFIELD PARK TRACT A-1 - BOOK C28, FOLIO 40)
- 4 EXISTING 10' PUBLIC UTILITY EASEMENT (RICHFIELD PARK TRACT A-1 - BOOK C28, FOLIO 40)
- 5 EXISTING 100' AMAFCA EASEMENT (MISC. BOOK 89, PAGES 188-197)

SURVEYOR'S CERTIFICATION

"I, Timothy Aldrich, a duly qualified Registered Professional Land Surveyor under the laws of the State of New Mexico, do hereby certify that this plat was prepared by me or under my supervision, shows all easements and restrictions as shown on the plat of record and noted in title reports prepared by Lawyers Title Insurance Corporation on June 19, 1984, Policy No. 85-00-156829 and on September 30, 1981, Policy No. 85-81-62258, or made known to me by the owners and/or proprietors of the subdivision shown hereon, utility companies and other parties expressing an interest. I further certify that this plat meets the minimum requirements for monumentation and surveys of the Albuquerque Subdivision Ordinance, meets the requirements set forth by the State of New Mexico, and is true and correct to the best of my knowledge and belief."

Timothy Aldrich 07-14-86
Timothy Aldrich, N.M. L.S. No. 7719 Date

STATE OF NEW MEXICO) SS
COUNTY OF BERNALILLO)

On this 14th day of July, 1986, the SURVEYOR'S CERTIFICATION was acknowledged before me.

Raven R. Hagan
Notary Public

SHEET 5 OF 5

Job No. 7795
Office DJ, TA
Draft VVH
F.B.
Date 7-14-86

eh ESPEY, HUSTON & ASSOC., INC.
Engineering & Environmental Consultants
317 COMMERCIAL ST. N.E.
ALBUQUERQUE, NEW MEXICO 87102
PHONE (505) 242-1909


MATCHLINE SEE SHT.21 FOR CONTINUATION

100' AMAFCA DRNG. ESMT.

TRACT D-1


TRACT A LANDS OF SISTERS OF THE ORDER OF ST. DOMINIC FILED 8-28-83 C27-141,1-3

TRACT Z SPERRY SITE FILED 8-19-83 C27-110

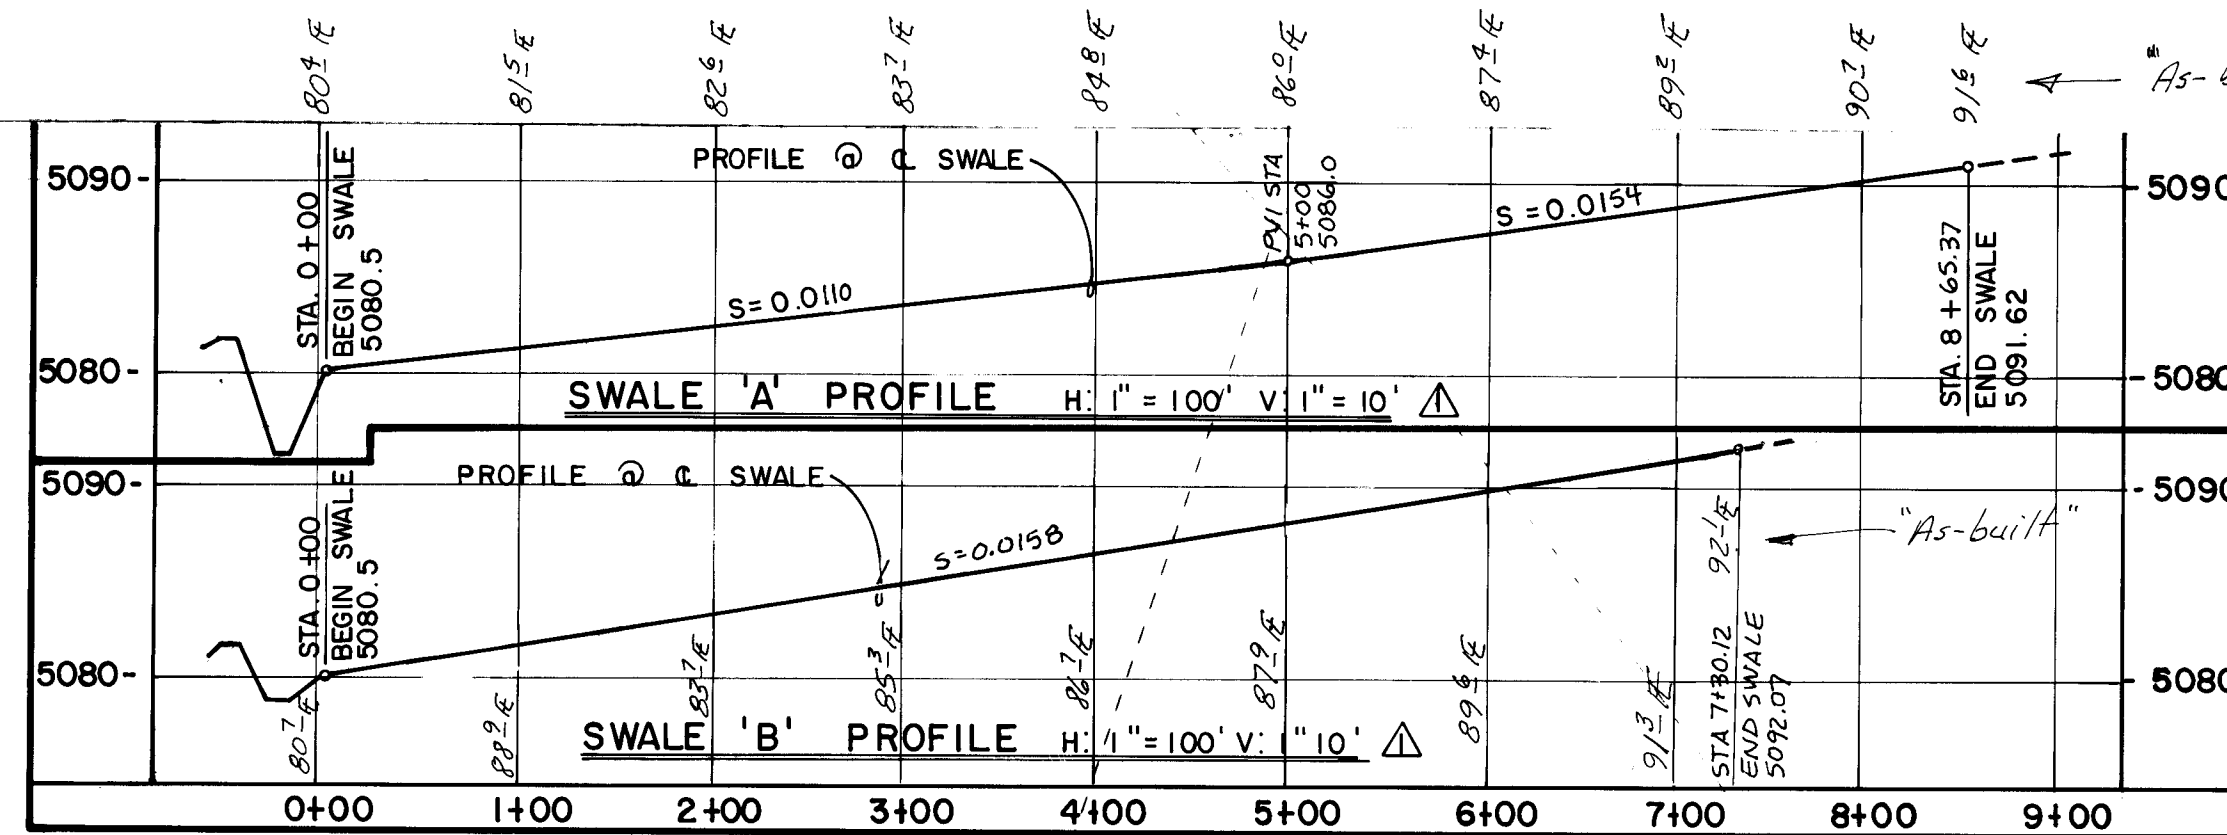

TRACT J-2A
SPERRY SITE
FILED 8-18-83
C27-110,1-3

SCALE = 1"=40'

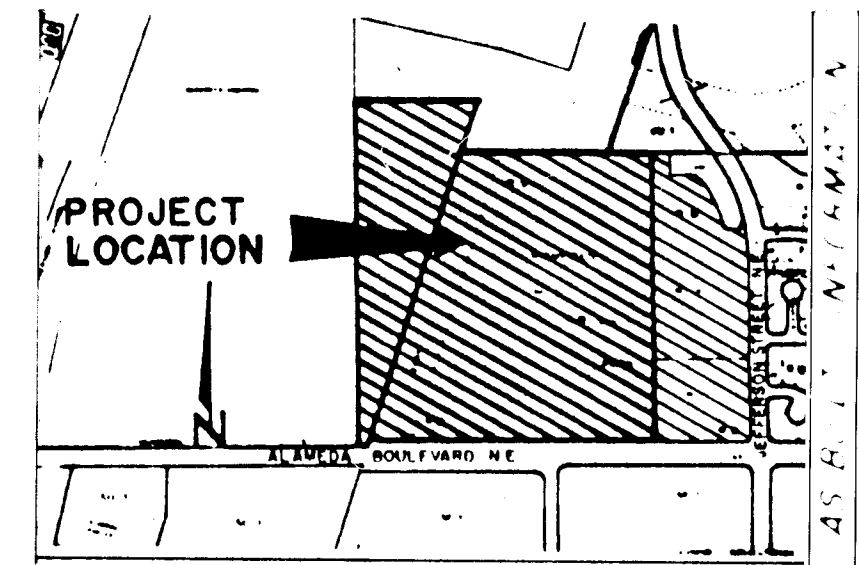

LOCATION MAP: C-17
SCALE: 1"=1000'

NOTES:

- 1) CONTRACTOR SHALL OBTAIN TOPSOIL DISTURBANCE PERMIT PRIOR TO BEGINNING EARTHWORK OPERATIONS.
- 2) CONTRACTOR SHALL NOTIFY AMAFCA FIELD ENGINEER 48 HOURS PRIOR TO ANY WORK WITHIN AMAFCA R.O.W.

APPROVED FOR ROUGH GRADING:

C.O.A. HYDROLOGY DATE

LEGEND

- EXISTING CONTOUR LINE
- PROPOSED CONTOUR
- EXISTING SPOT ELEVATION
- PROPOSED SPOT ELEVATION
- PROPOSED TOP OF CURB ELEV.
- WATER BLOCK
- EROSION CONTROL BERM
- EXISTING STORM DRAIN
- PROPOSED CONCRETE VALLEY GUTTER
- TRANSITION FROM CROWN TO NO CROWN
- PROPOSED STORM DRAIN
- PROPOSED WHEEL CHAIR RAMP
- PROJECT PHASE BOUNDARY
- TEMPORARY EROSION CONTROL BERM

ESPEY,
HUSTON &
ASSOCIATES, INC.
Engineering & Environmental Consultants
317 COMMERCIAL ST. NE
ALBUQUERQUE, NEW MEXICO 87102
PHONE: (505) 242-1909

CITY OF ALBUQUERQUE
PUBLIC WORKS DEPARTMENT
ENGINEERING DIVISION

TITLE RICHFIELD PARK - PHASE I
GRADING PLAN

APPROVALS	ENGINEER	DATE	APPROVALS	IN CHARGE
City Engineer	1/2/88	1/2/88	1/2/88	1/2/88
ACE Design	1/2/88	1/2/88	1/2/88	1/2/88
ACE Hydrology	1-20-88	1-20-88	1-20-88	1-20-88

DRAWING NO. 3076 MAP NO. C-17 SHEET 5 OF 23



TRACT A LANDS OF SISTERS OF THE ORDER OF ST. DOMINIC FILED 8-28-83 C27-141,1-3

TRACT A-1
WILDFLOWER
SUBDIVISION
FILED 8-30-83
C27-71,1-2

WILDFLOWER
PHASE 2
FILED 10-17-80
C17-107,1-2

REVISIONS	DATE	BY	REMARKS
3-9-88	11/20/88	REMARKS	ADDED SWALE & DATA PROFILES
11/20/88	11/20/88	REMARKS	ADDED SWALE & DATA PROFILES
11/20/88	11/20/88	REMARKS	ADDED SWALE & DATA PROFILES

D.L.	9/86
M.E.C.	9/86
D.L.	11/86

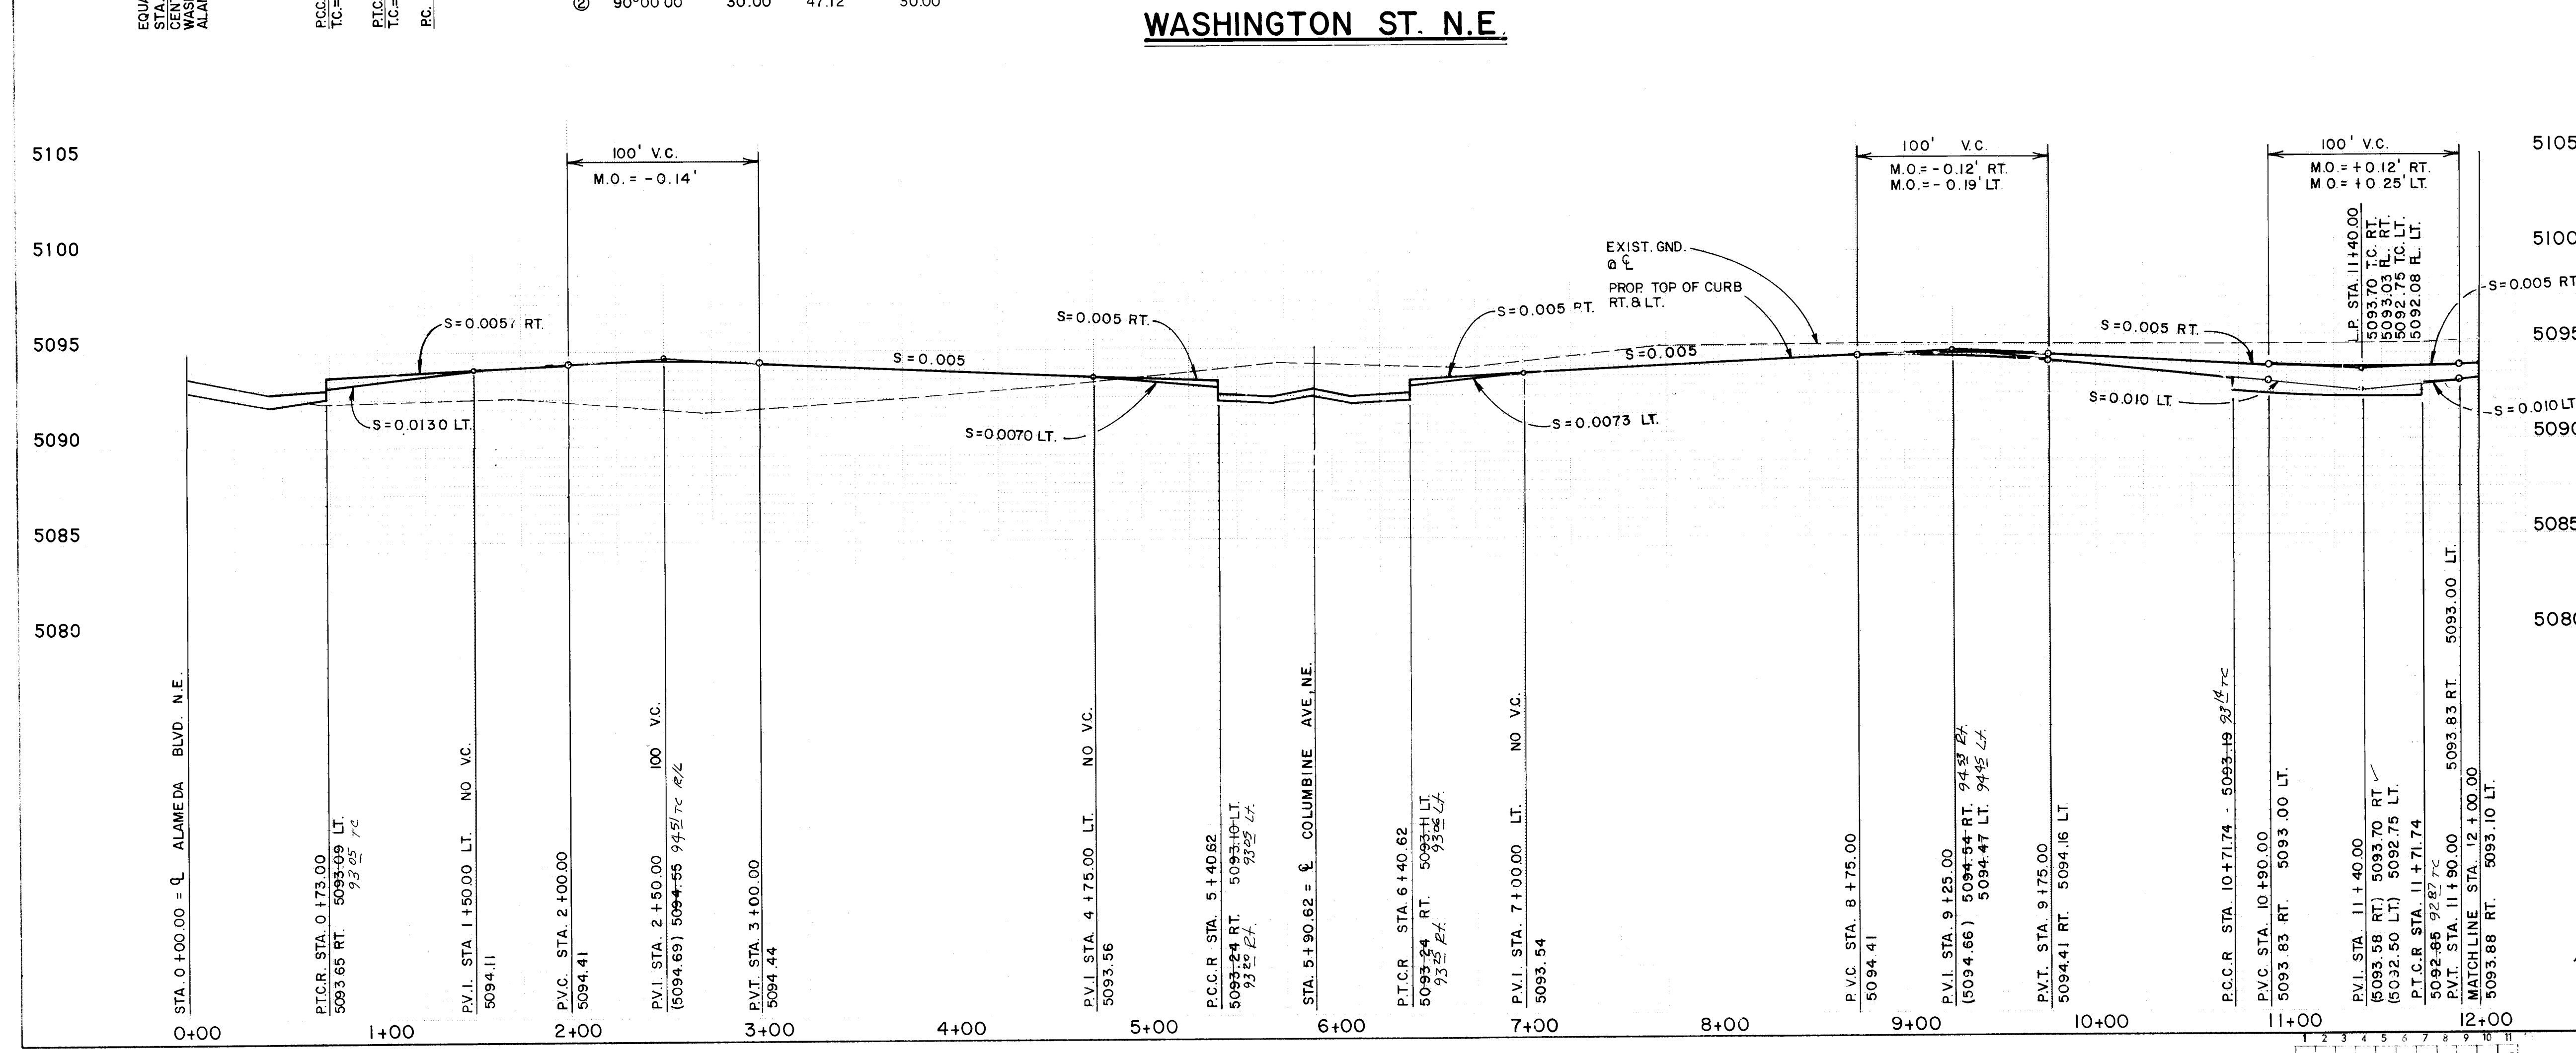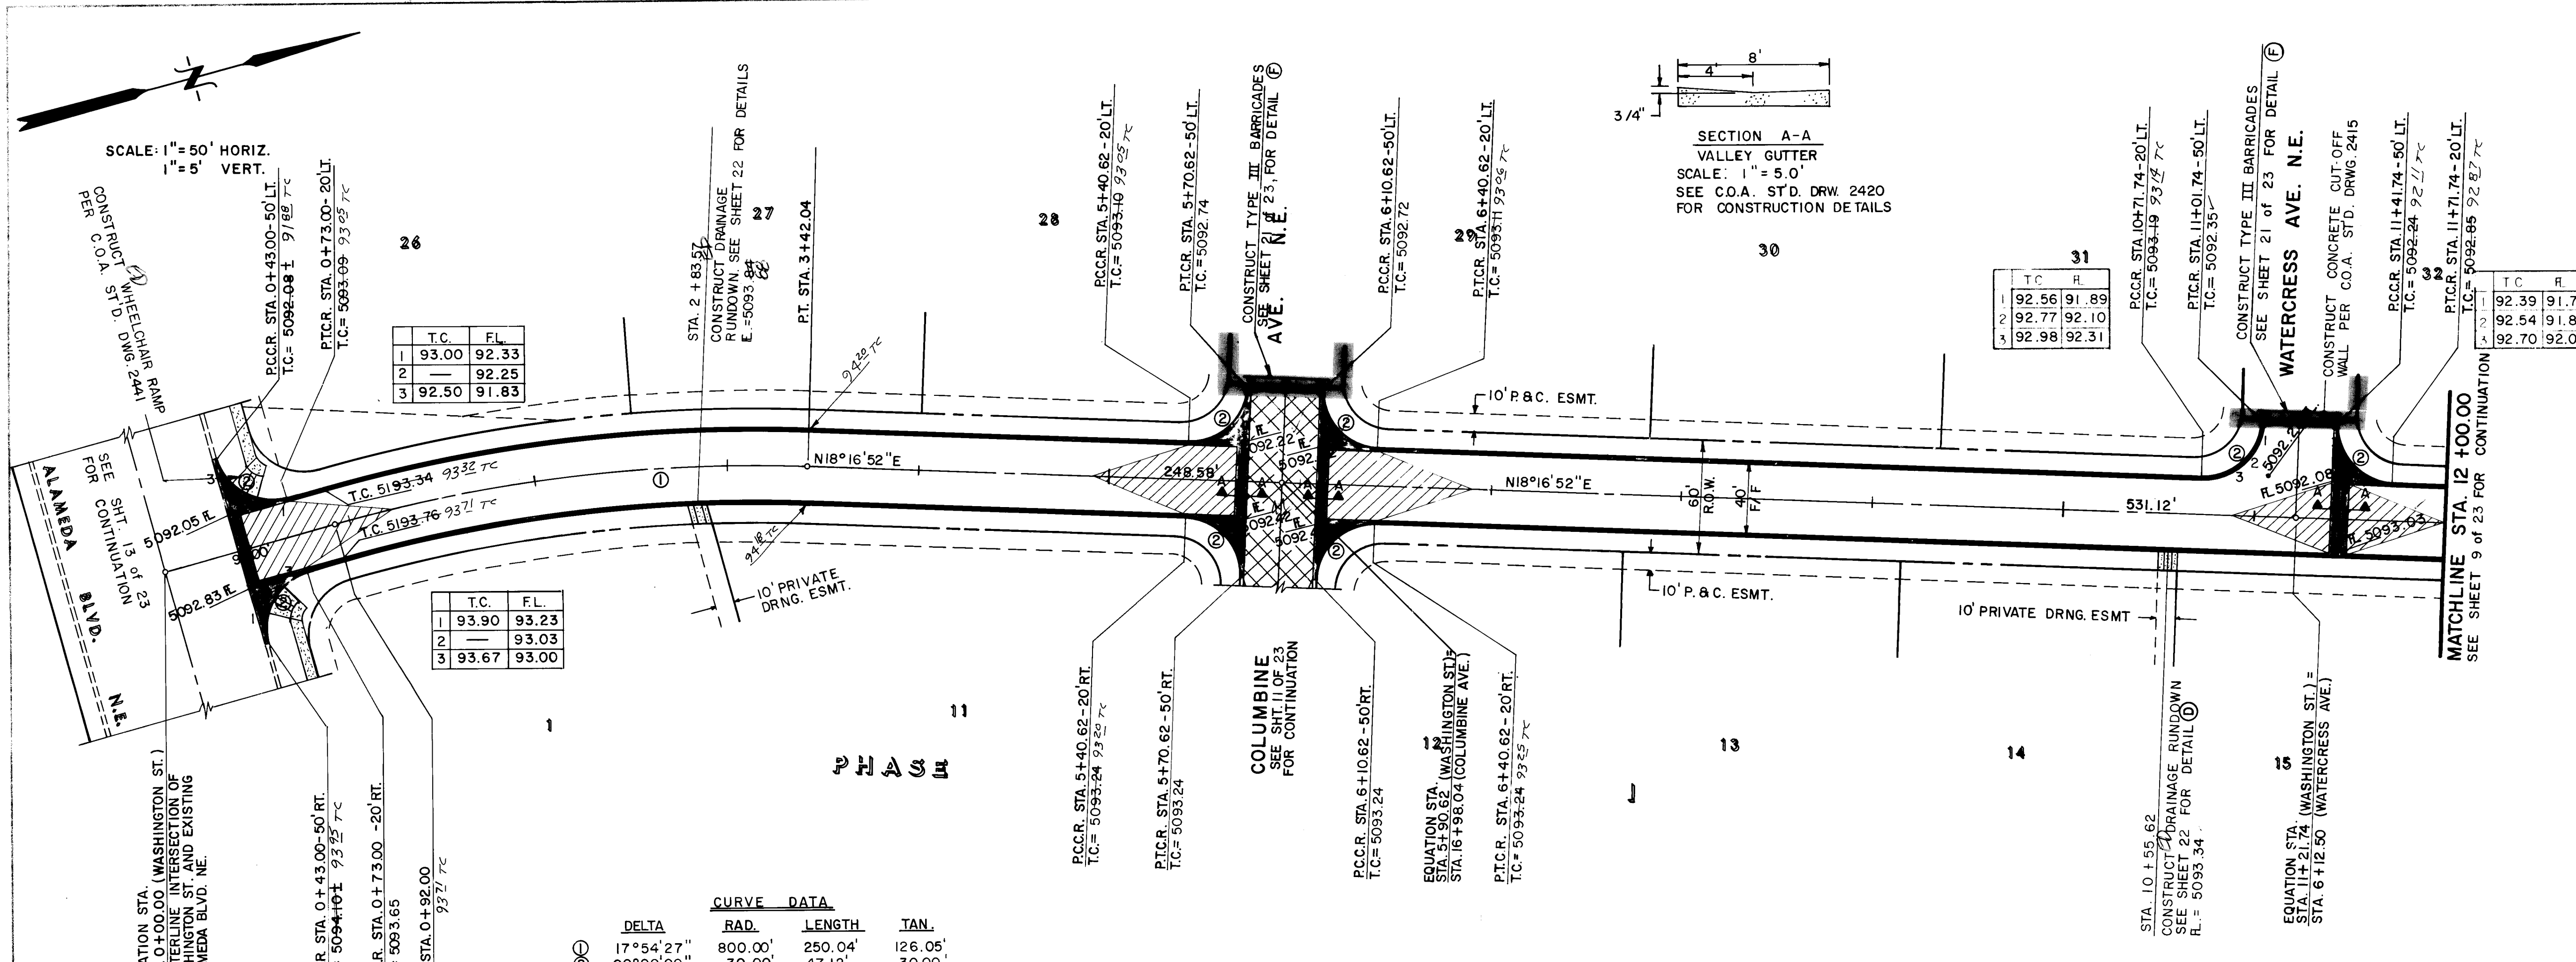

26	30	31	32	100
----	----	-----

NOTES:

- ALL STATIONING BASED ON THE CENTERLINE OF THE RIGHT-OF-WAY.
- THE FOLLOWING CITY OF ALBUQUERQUE STANDARD DRAWINGS ARE TO BE USED:
PAVING ART. / COLL. ST. SECTIONS WITH-OUT MEDIAN (2407)
PAVING CURB AND GUTTER & TEMPORARY PAVING SECTION (2415)
PAVING CONCRETE VALLEY GUTTER (2420 and 2421)
PAVING SIDEWALK DETAILS (2430)
AND PAVING WHEEL CHAIR RAMP (2440 and 2441)

LEGEND

- CURB AND GUTTER
- RIGHT-OF-WAY
- LOT BOUNDARY
- TRANSITION TO OR NOT TO CROWN
- VALLEY GUTTER
- TOP OF CURB
- CENTERLINE OF STREET
- PROPOSED WHEELCHAIR RAMP
- PROJECT PHASE BOUNDARY
- TRANSITION TO 1/2 CROWN (1%)


ESPEY, HUSTON & ASSOCIATES, INC.
Engineering & Environmental Consultants
317 COMMERCIAL ST. N.E.
ALBUQUERQUE, NEW MEXICO 87102
PHONE: (505) 242-1909

CITY OF ALBUQUERQUE
PUBLIC WORKS DEPARTMENT
ENGINEERING DIVISION

TITLE: RICHFIELD PARK - PHASE I
WASHINGTON ST., N.E.
PAVING PLAN & PROFILE STA. 0+00.00 TO 12+00.00


APPROVALS	ENGINEER	DATE	APPROVALS	ENGINEER	DATE
City Engineer	<i>[Signature]</i>	2/1/88	Liquid Waste	<i>[Signature]</i>	1/20/88
A.C.E. - Design	<i>[Signature]</i>		Traffic	<i>[Signature]</i>	1/20/88
A.C.E. - Hydrology	<i>[Signature]</i>	1-26-88	Water	<i>[Signature]</i>	1/20/88

DRAWING NO.	3076	MAP NO.	C-17	SHEET	8	OF	23
-------------	------	---------	------	-------	---	----	----

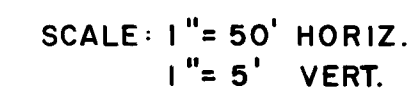


TAN.

①	42° 50' 00"	35.00'	26.17'	13.73'
②	175° 47' 13"	40.00'	122.72'	1087.47'
③	42° 50' 00"	35.00'	26.17'	13.73'
④	90° 07' 12"	60.00'	94.37'	60.13'
⑤	90° 07' 12"	100.00'	157.29'	100.21'
⑥	71° 58' 21"	200.00'	251.23'	145.24'

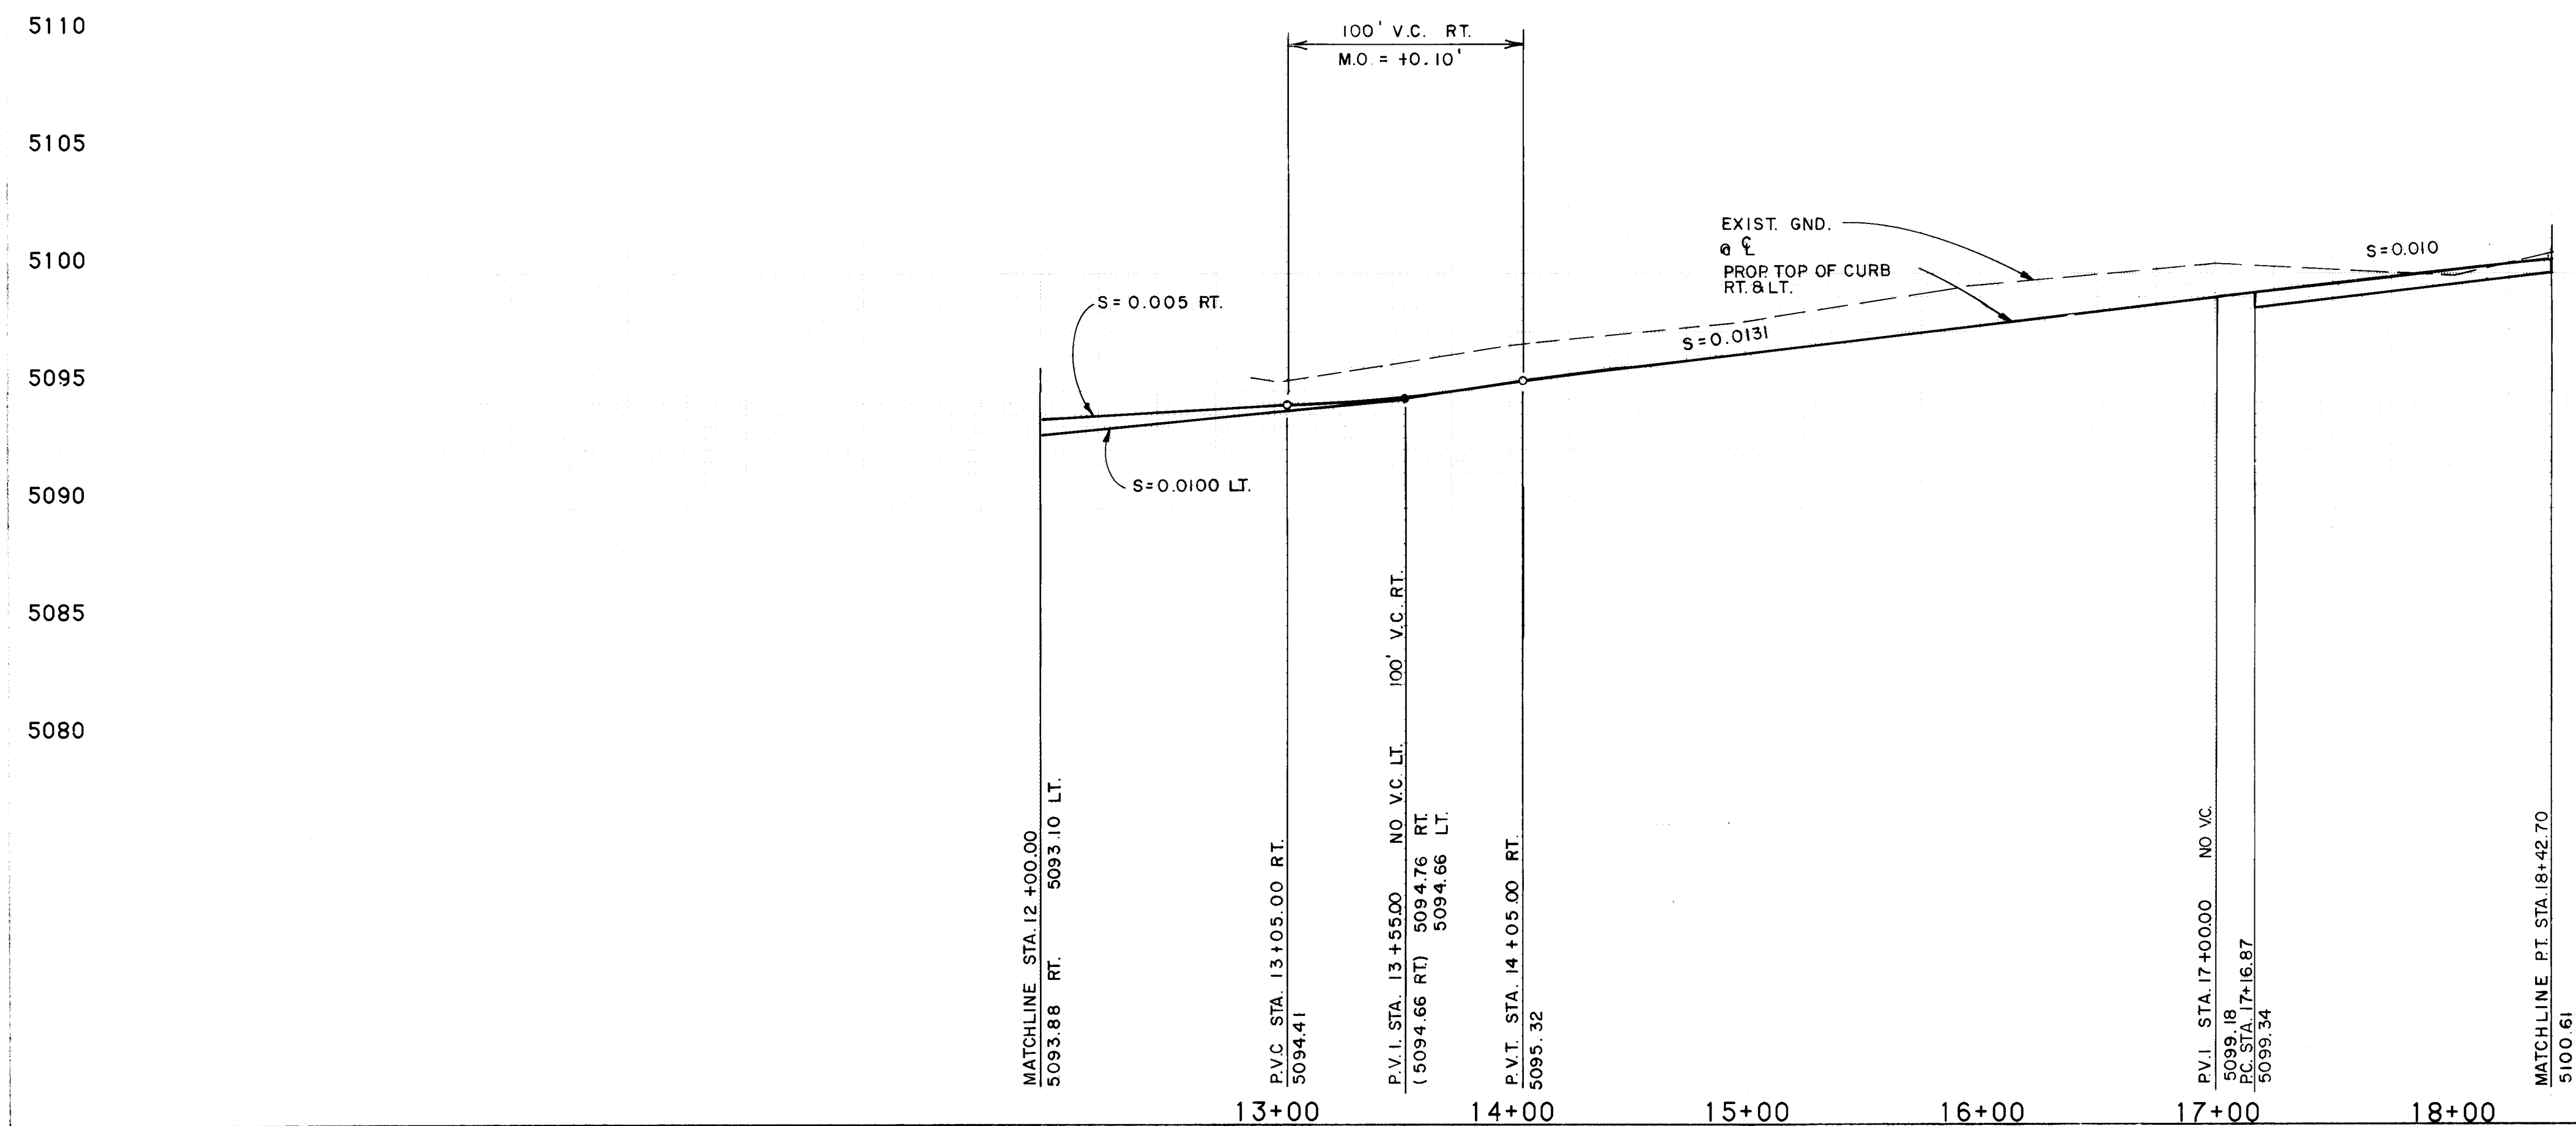

1. ALL STATIONING BASED ON THE CENTER-LINE OF THE RIGHT-OF-WAY.
2. THE FOLLOWING CITY OF ALBUQUERQUE STANDARD DRAWINGS ARE TO BE USED:
PAYING ART., / COLL. ST. SECTIONS WITHOUT MEDIAN(2407)
PAYING CURB AND GUTTER & TEMPORARY PAYING SECTION (2415)
PAYING CONCRETE VALLEY GUTTER (2420 and 2421)
PAYING SIDEWALK DETAILS (2430)
AND PAYING WHEEL CHAIR RAMP (2440 and 2441)

"AS BUILT" HORIZONTAL
AND VERTICAL LOCATION ONLY)

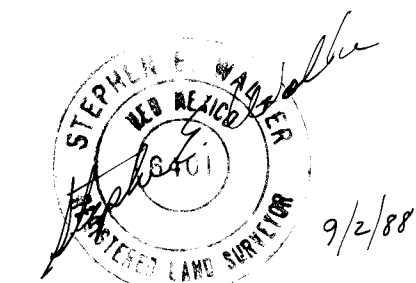

LEGEND

- | | | |
|------|---|-----------------------------------|
| |  | CURB AND GUTTER |
| |  | RIGHT-OF-WAY |
| |  | LOT BOUNDARY |
| 5110 |  | TRANSITION TO OR
NOT TO CROWN. |
| 5105 |  | VALLEY GUTTER |
| |  | TOP OF CURB |
| 5100 |  | CENTERLINE OF STREET |
| |  | PROPOSED WHEELCHAIR
RAMP |

**ESPEY,
HUSTON &
ASSOCIATES, INC.**
Engineering & Environmental Consultants

**317 COMMERCIAL ST. N.E.
ALBUQUERQUE, NEW MEXICO 87101
PHONE: (505) 242-1909**

PHONE (505) 242-1969

CITY OF ALBUQUERQUE
PUBLIC WORKS DEPARTMENT
ENGINEERING DIVISION

TITLE: RICHFIELD PARK - PHASE I
WASHINGTON ST., N.E.
PAVING PLAN & PROFILE STA 12+00.00 TO 18+42.70

APPROVALS	ENGINEER	DATE	APPROVALS	ENGINEER	DATE
City Engineer	<i>[Signature]</i>	2/11/88	Liquid Waste	REGO	1/20/88
A C E - Design	" "	" "	Traffic	<i>[Signature]</i>	2/2/88
A C E - Hydrology	N/A REGO	1-20-88	Water	REGO	1/20/88

DRAWING NO.	3076	MAP NO.	C-17	SHEET	9	OF	23
-------------	------	---------	------	-------	---	----	----



43 BUILT INFORMATION

BENCH MARKS


The Station is Located 7.5 Miles N.E. of Downtown, And 0.3 Miles

N. of The Intersection of Los Angeles Boulevard and Washington Street N.E. To Reach The Station From The Intersection of Los Angeles Blvd. And 2nd St. Go East On Los Angeles Blvd. 165 Miles To Intersection With Washington ST., N.E., Then N. On Washington ST., N.E. 0.3 Miles To The Station On Left (West Side of the Street). The Station Mark Is A Standard ACS Brass Tablet, Stamped "8-C17, 1975," Cemented in A Drill Hole In Top of Concrete Curb. Elev. 5,111.029

REVISIONS		DESIGN
D.A.L	DATE	9/86
R.D.	DATE	9/86

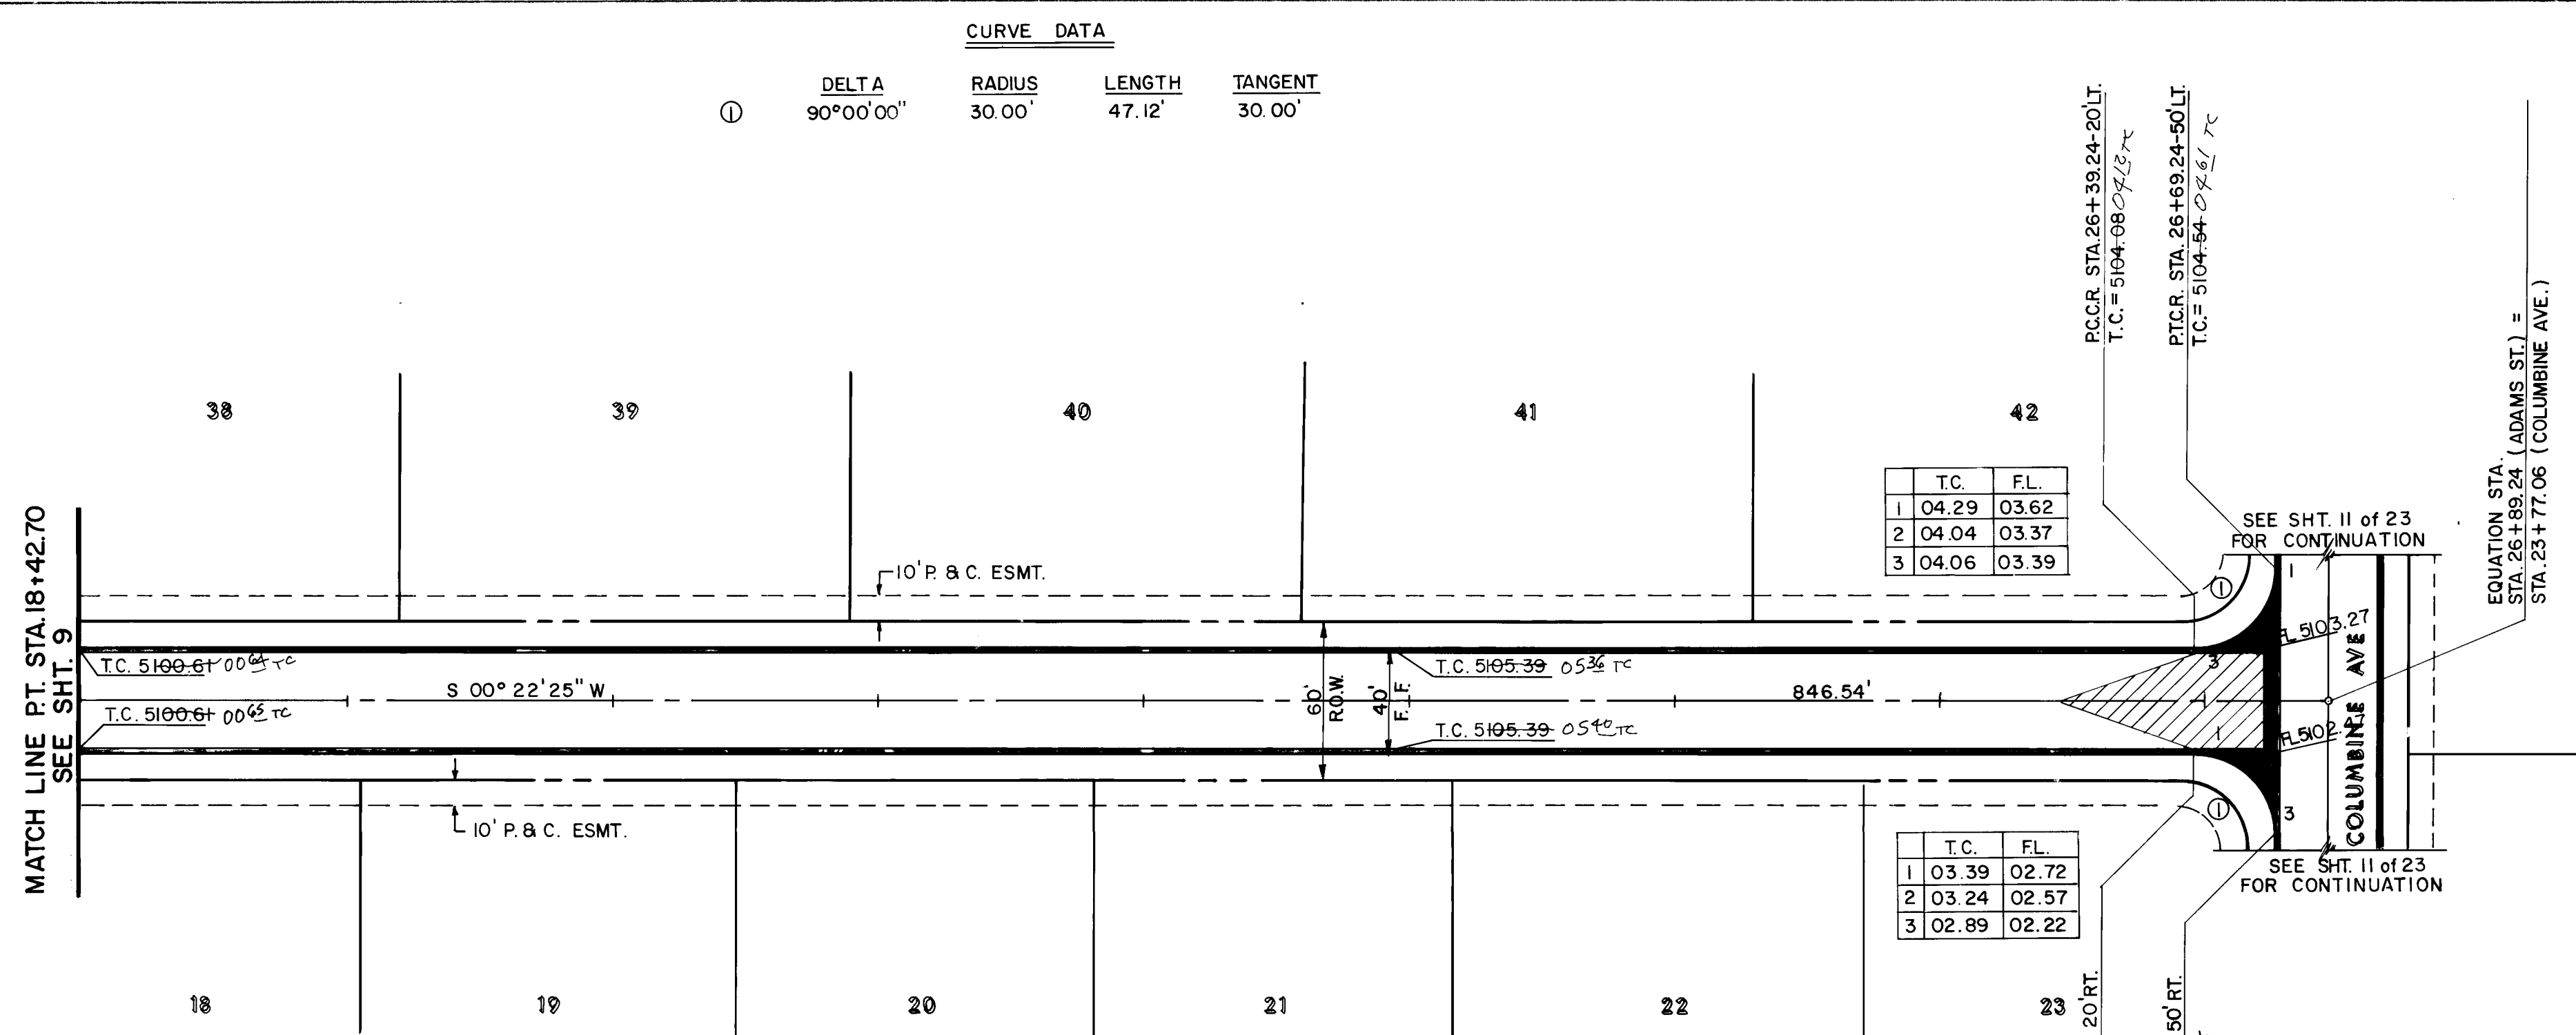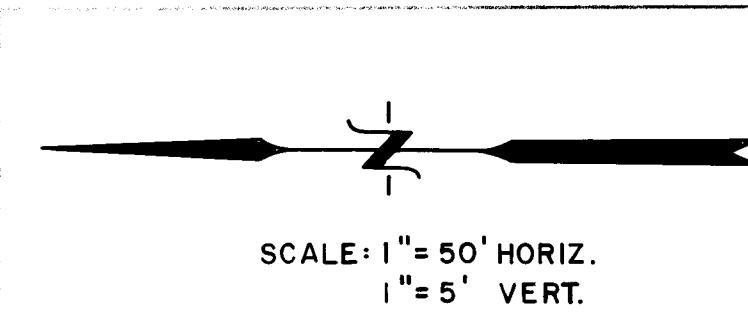

ADAMS ST. N.E.

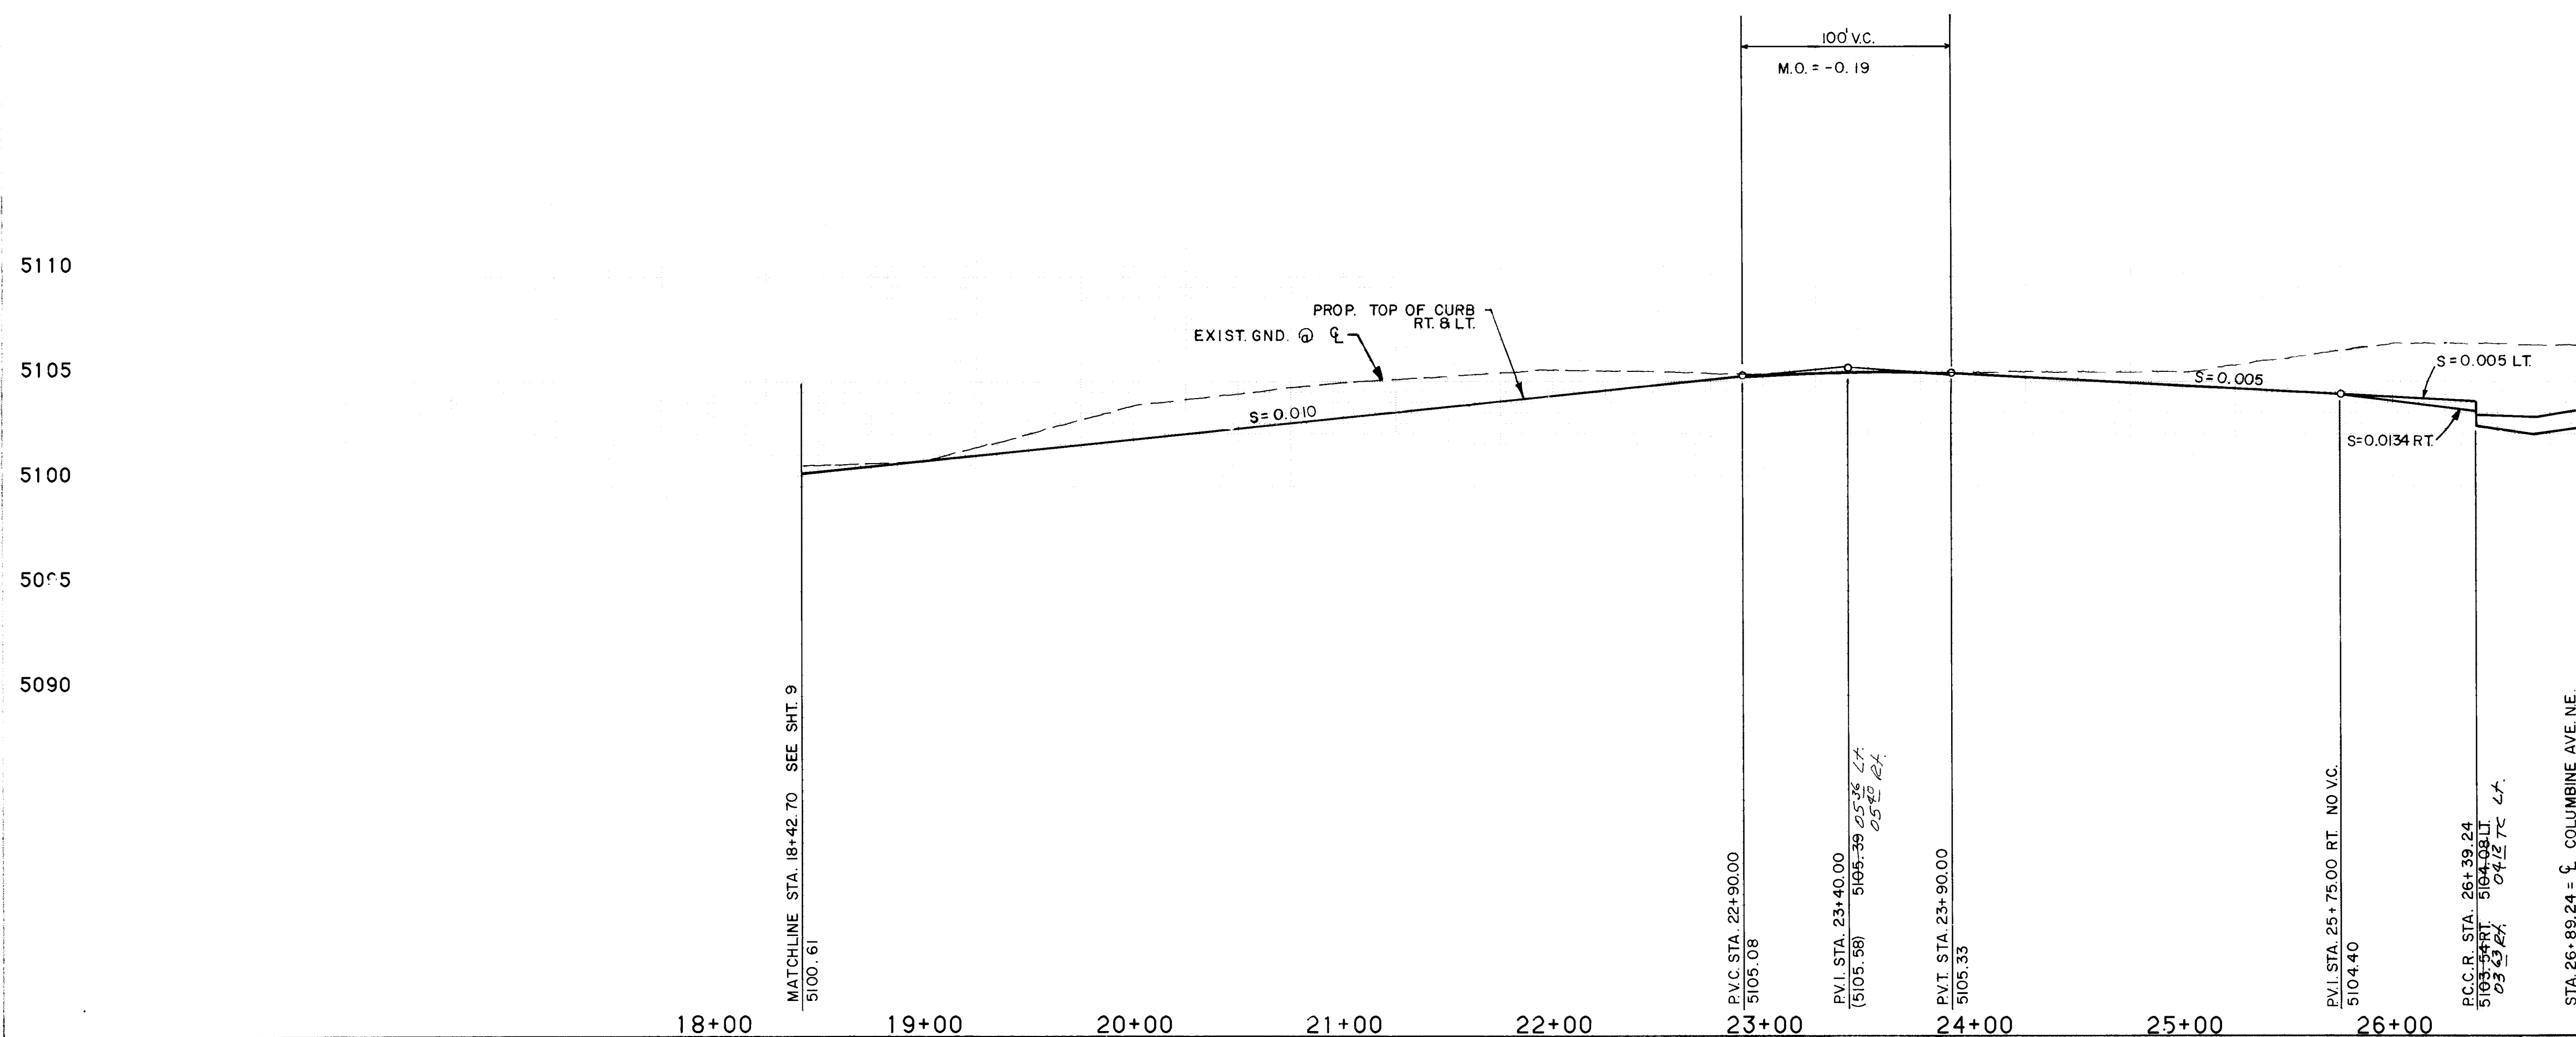

NOTES:

- ALL STATIONING BASED ON THE CENTER-LINE OF THE RIGHT-OF-WAY.
- THE FOLLOWING CITY OF ALBUQUERQUE STANDARD DRAWINGS ARE TO BE USED: PAVING ART. / COLL. ST. SECTIONS WITH-OUT MEDIAN (2407); PAVING CURB AND GUTTER & TEMPORARY PAVING SECTION (2415); PAVING CONCRETE VALLEY GUTTER (2420 and 2421); PAVING SIDEWALK DETAILS (2430); AND PAVING WHEEL CHAIR RAMP (2440 and 2441).

"AS BUILT" (HORIZONTAL AND VERTICAL LOCATION ONLY)



LEGEND

- CURB AND GUTTER
- RIGHT-OF-WAY
- LOT BOUNDARY
- TRANSITION TO OR NOT TO CROWN.
- VALLEY GUTTER
- TOP OF CURB
- CENTERLINE OF STREET
- PROPOSED WHEELCHAIR RAMP

26 307610818

ESPEY,
HUSTON &
ASSOCIATES, INC.
Engineering & Environmental Consultants
317 COMMERCIAL ST. N.E.
ALBUQUERQUE, NEW MEXICO 87102
PHONE: (505) 242-1909


CITY OF ALBUQUERQUE
PUBLIC WORKS DEPARTMENT
ENGINEERING DIVISION

TITLE RICHFIELD PARK - PHASE I
ADAMS ST. N.E.
PAVING PLAN & PROFILE STA. 18+42.70 TO 26+89.24

APPROVALS	ENGINEER	DATE	APPROVALS	ENGINEER	DATE
City Engineer	<i>[Signature]</i>	2/11/88	Liquid Waste	PECO	1/20/88
A.C.E. - Design			Traffic	<i>[Signature]</i>	1/20/88
A.C.E. - Hydrology	N/A RAS	1-20-88	Water	PECO	1/20/88

DRAWING NO. 3076 MAP NO. C-17 SHEET 10 OF 23

SURVEY INFORMATION		BENCH MARKS		AS BUILT INFORMATION	
NO.	DATE	The Station is Located 7.5 Miles NE of Downtown, And 0.3 Miles N. of The Intersection of Los Angeles Boulevard And Washington Street NE. To Reach The Station From The Intersection of Los Angeles Blvd And 2nd St. Go East On Los Angeles Blvd 1.65 Miles To Intersection With Washington ST, N.E., Then N. On Wash- ington ST, N.E. 0.3 Miles To The Station On Left (West Side of The Street). The Station Mark is A Standard ACS Brass Tablet, Stamped "B-C17, 1975", Cemented in A Drill Hole in Top of Concrete Curb. Elev. 5111.029			
BY	DATE	FBE 9/88			
REVISIONS	DATE	MICRO FILM INFORMATION			
DESIGN	DATE	DATE			
NO.	DATE	DATE			
BY	DATE	DATE			
REVISIONS	DATE	DATE			
DESIGN	DATE	DATE			
NO.	DATE	DATE			
BY	DATE	DATE			
REVISIONS	DATE	DATE			
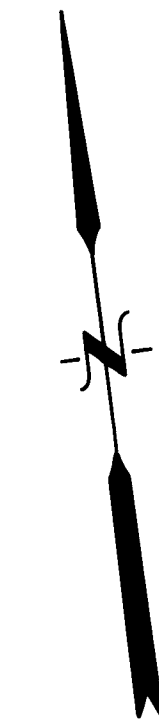

SCALE: 1"=50' HORIZ.
1"=5' VERT.

CONSTRUCT TYPE III BARRICADES
SEE SHEET 21 OF 23 FOR DETAIL.

T.C.	F.L.
1 92.84	92.17
2 92.94	92.27
3 93.02	92.35

T.C.	F.L.
1 92.84	92.17
2 92.94	92.27
3 93.02	92.35

CURVE DATA

	DELTA	RAD.	LENGTH	TAN.
①	17° 54' 27"	500.00	156.27	78.78
②	90° 00' 00"	30.00	47.12	30.00

5120

5115

5110

5105


5100

5095

5090

5085

COLUMBINE AVE. N.E.

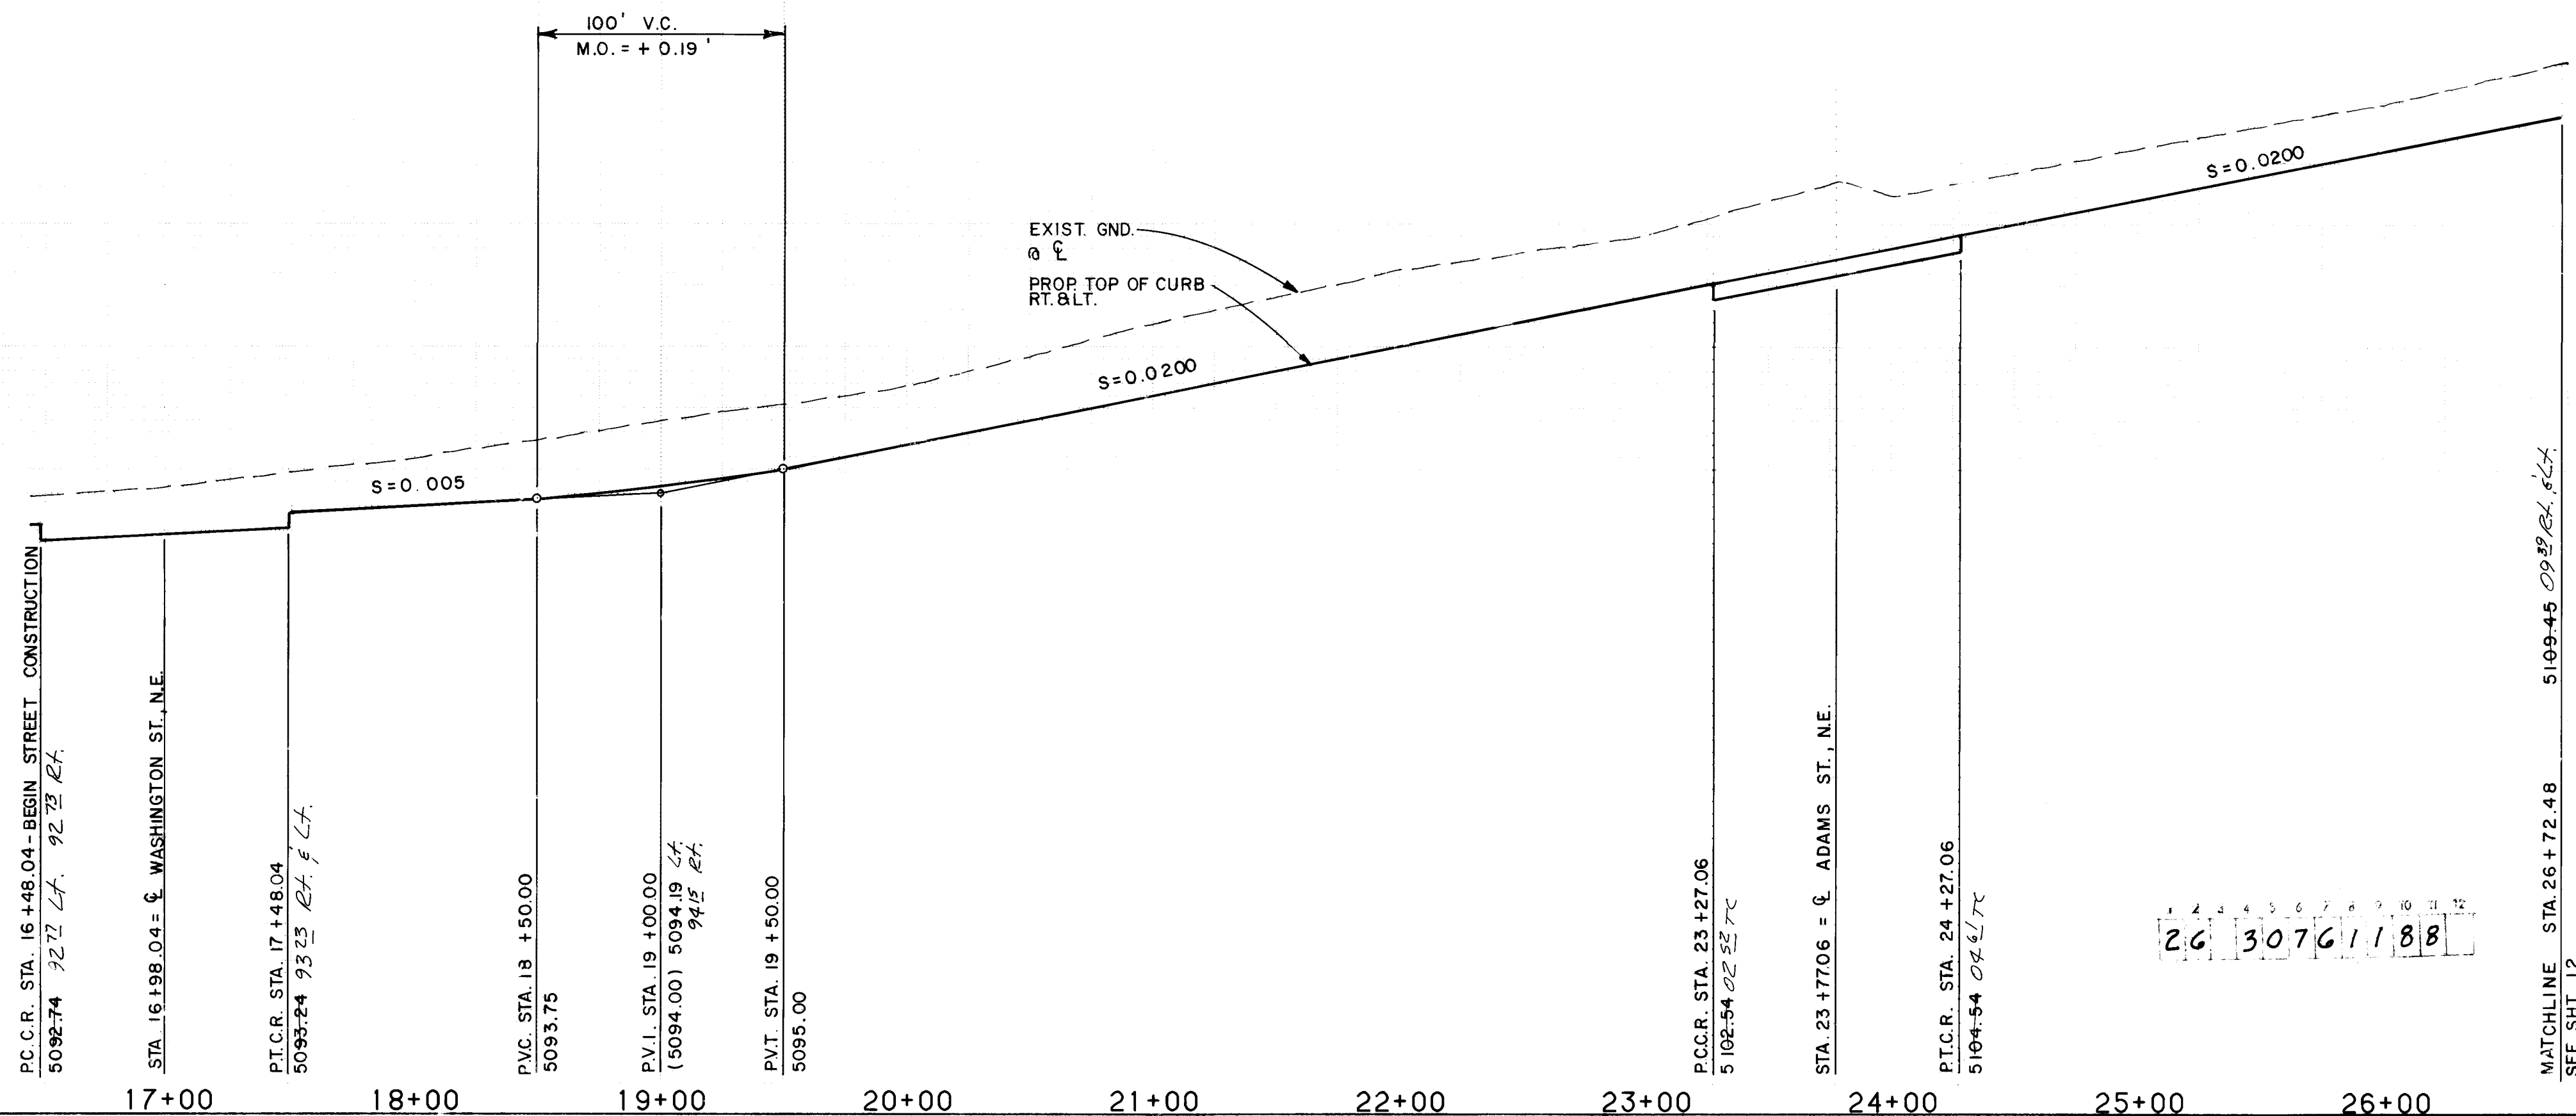

NOTES:

1. ALL STATIONING BASED ON THE CENTERLINE OF THE RIGHT-OF-WAY.
2. THE FOLLOWING CITY OF ALBUQUERQUE STANDARD DRAWINGS ARE TO BE USED: PAVING ART. / COLL. ST. SECTIONS WITHOUT MEDIAN (2407); PAVING CURB AND GUTTER & TEMPORARY PAVING SECTION (2415); PAVING CONCRETE VALLEY GUTTER (2420 and 2421); PAVING SIDEWALK DETAILS (2430) AND PAVING WHEEL CHAIR RAMP (2440 and 2441).

"AS BUILT" (HORIZONTAL
AND VERTICAL LOCATION ONLY)


LEGEND

- CURB AND GUTTER
- RIGHT-OF-WAY
- LOT BOUNDARY
- TRANSITION TO 1/2 CROWN
- VALLEY GUTTER
- TOP OF CURB
- CENTERLINE OF STREET
- PROPOSED WHEELCHAIR RAMP
- PROJECT PHASE BOUNDARY

ESPEY,
HUSTON &
ASSOCIATES, INC.
Engineering & Environmental Consultants
317 COMMERCIAL ST. N.E.
ALBUQUERQUE, NEW MEXICO 87102
PHONE: (505) 242-1909

CITY OF ALBUQUERQUE PUBLIC WORKS DEPARTMENT ENGINEERING DIVISION			
TITLE RICHFIELD PARK - PHASE I COLUMBINE AVE., N.E. PAVING PLAN & PROFILE STA. 16+48.05 TO 26+72.48			
APPROVALS	ENGINEER	DATE	APPROVALS
City Engineer	<i>[Signature]</i>	2/11/88	Liquid Waste
A.C.E. - Design	" "	" "	Traffic
A.C.E. - Hydrology	W/A RAL	1-20-88	Water
DRAWING NO. 3076		MAP NO. C-17	SHEET 11 OF 23


BENCH MARKS		AS BUILT INFORMATION	
The Station is Located 7.5 Miles NE of Downtown, And 0.3 Miles N. of The Intersection of Los Angeles Boulevard and Washington Street N.E. To Reach The Station From The Intersection of Los Angeles Blvd And 2nd St, Go East On Los Angeles Blvd 165 Miles To Intersection With Washington St. N.E., Then N. On Washington St. N.E. 0.3 Miles To The Station On Left (West Side of The Street). The Station Mark is A Standard ACS Brass Tablet, Stamped "B-C17, 1975" Cemented in A Drill Hole in Top of Concrete Curb. Elev. 511.029		DATE 9/2/88	
REVISIONS		NO. DATE	
DESIGN		1-12-88	
D.L.		D.L.	
M.E.C.		M.E.C.	
D.L.		D.L.	

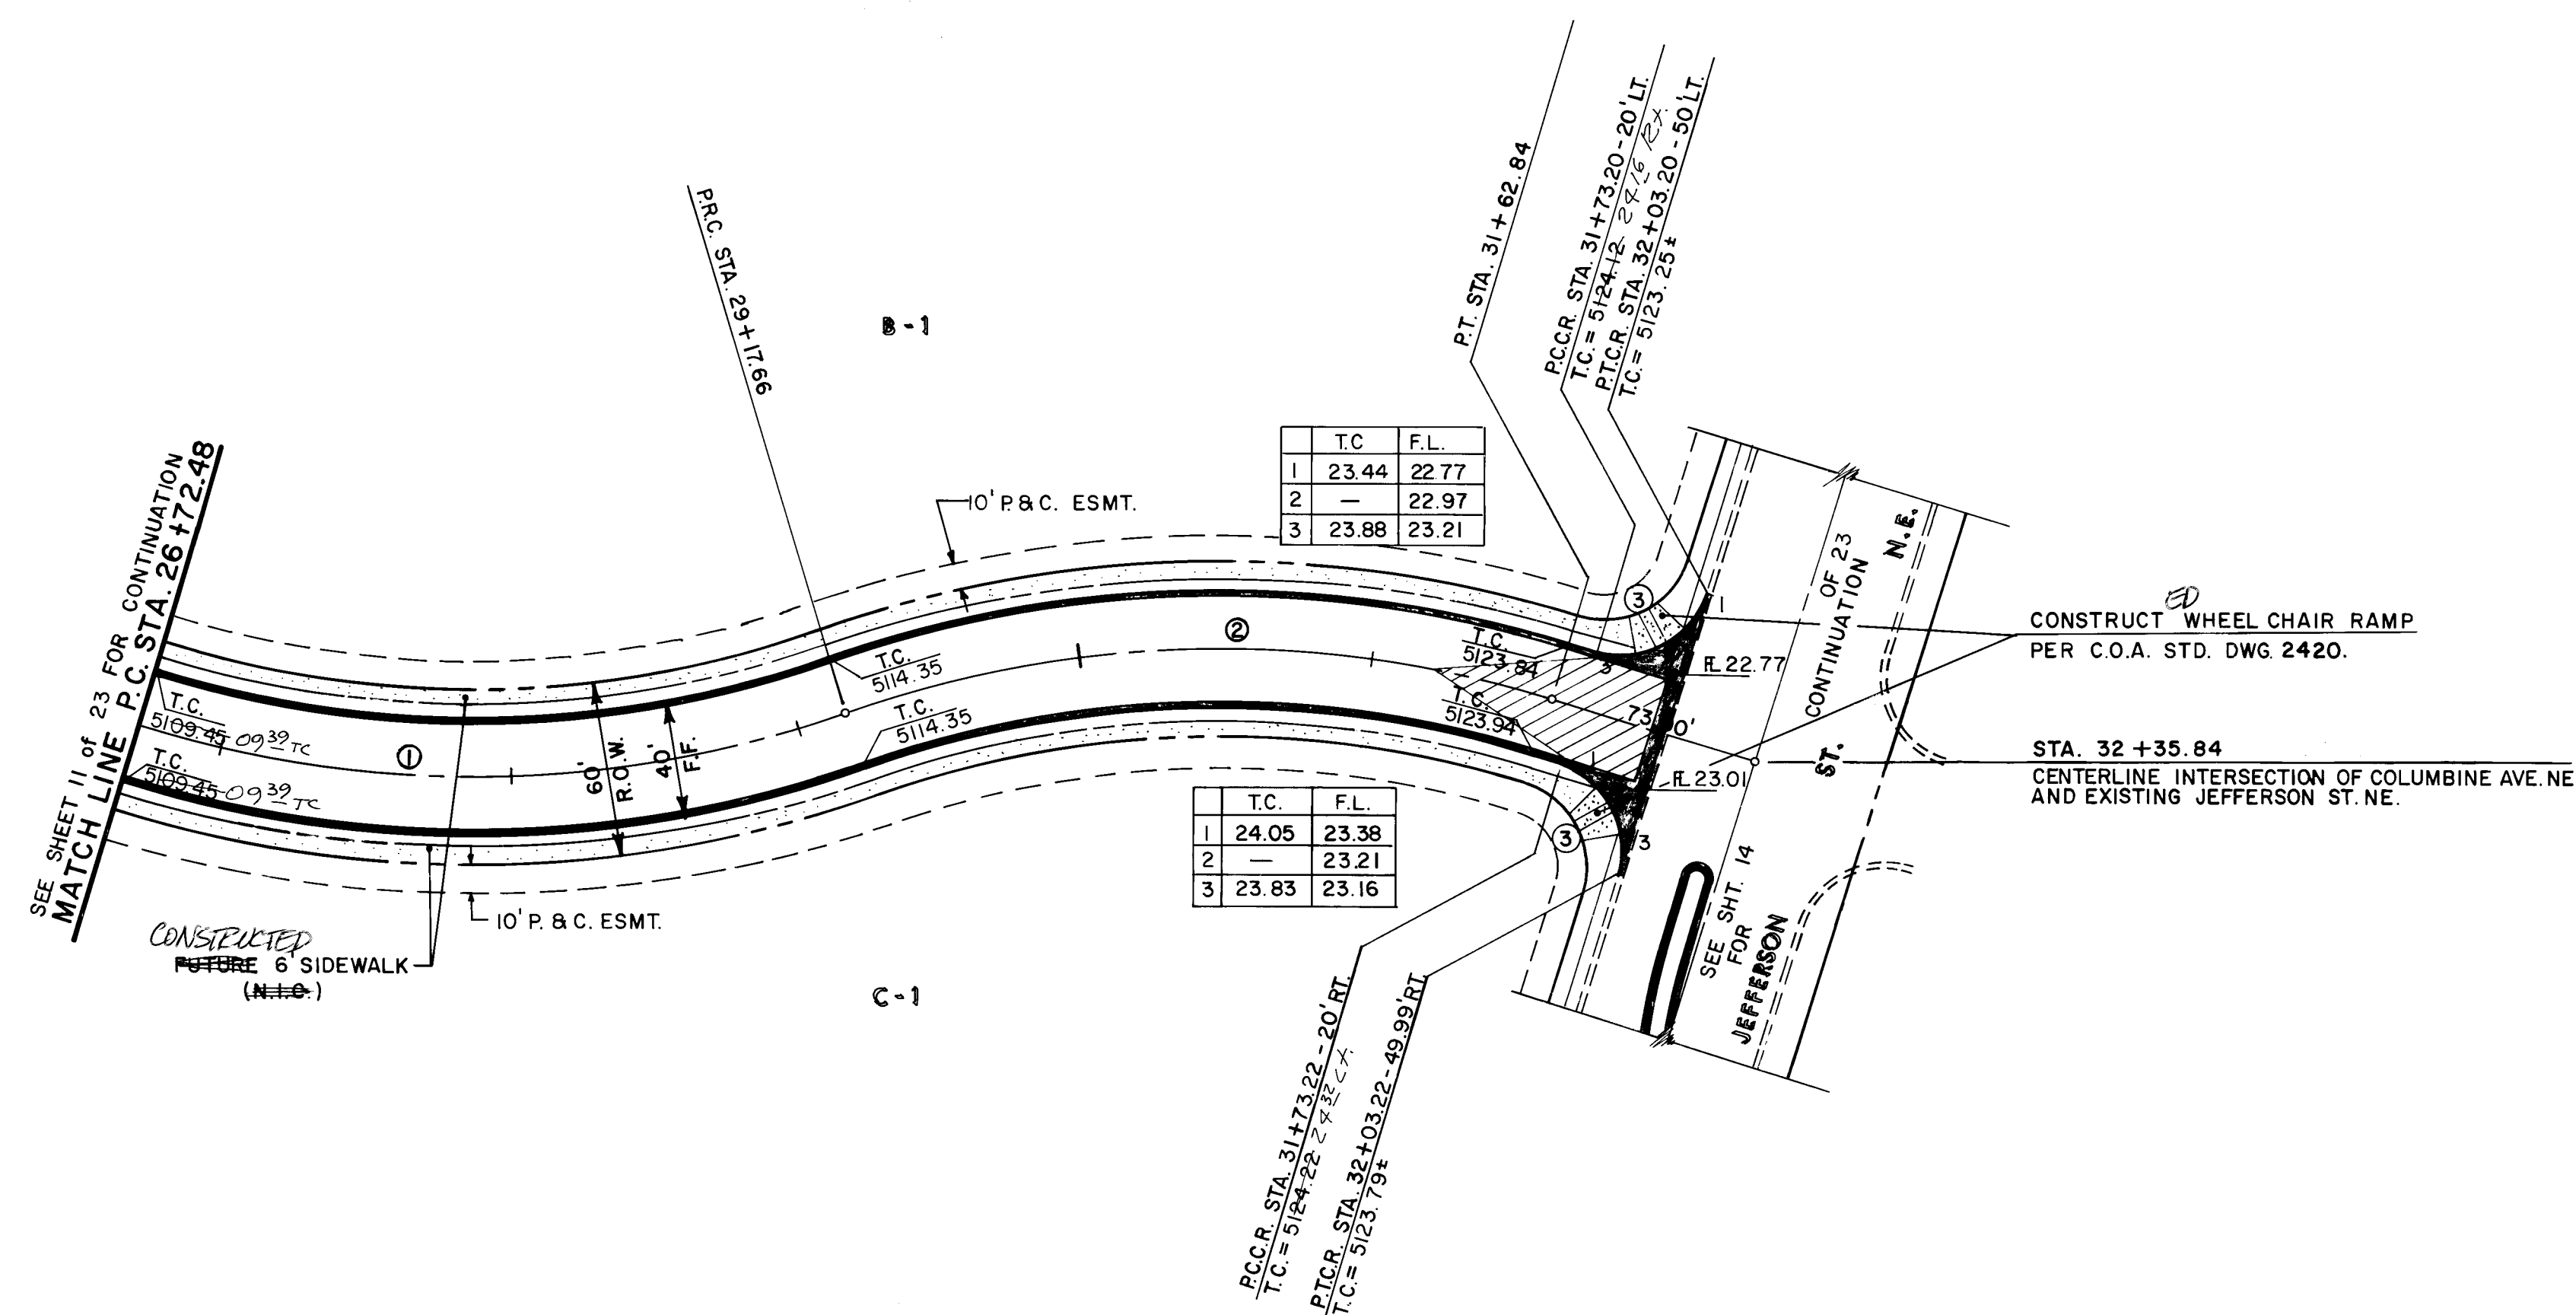


"AS-BUILT" (HORIZONTAL
AND VERTICAL LOCATION ONLY)

		<u>CURVE DATA</u>		
	<u>DELTA</u>	<u>RAD.</u>	<u>LENGTH</u>	<u>TAN.</u>
①	36°58'04"	380.00'	245.10'	127.03
②	36°58'04"	380.00'	245.10'	127.03
③	90°00'00"	30.00'	47.12'	30.00

COLUMBINE AVE. N.E.

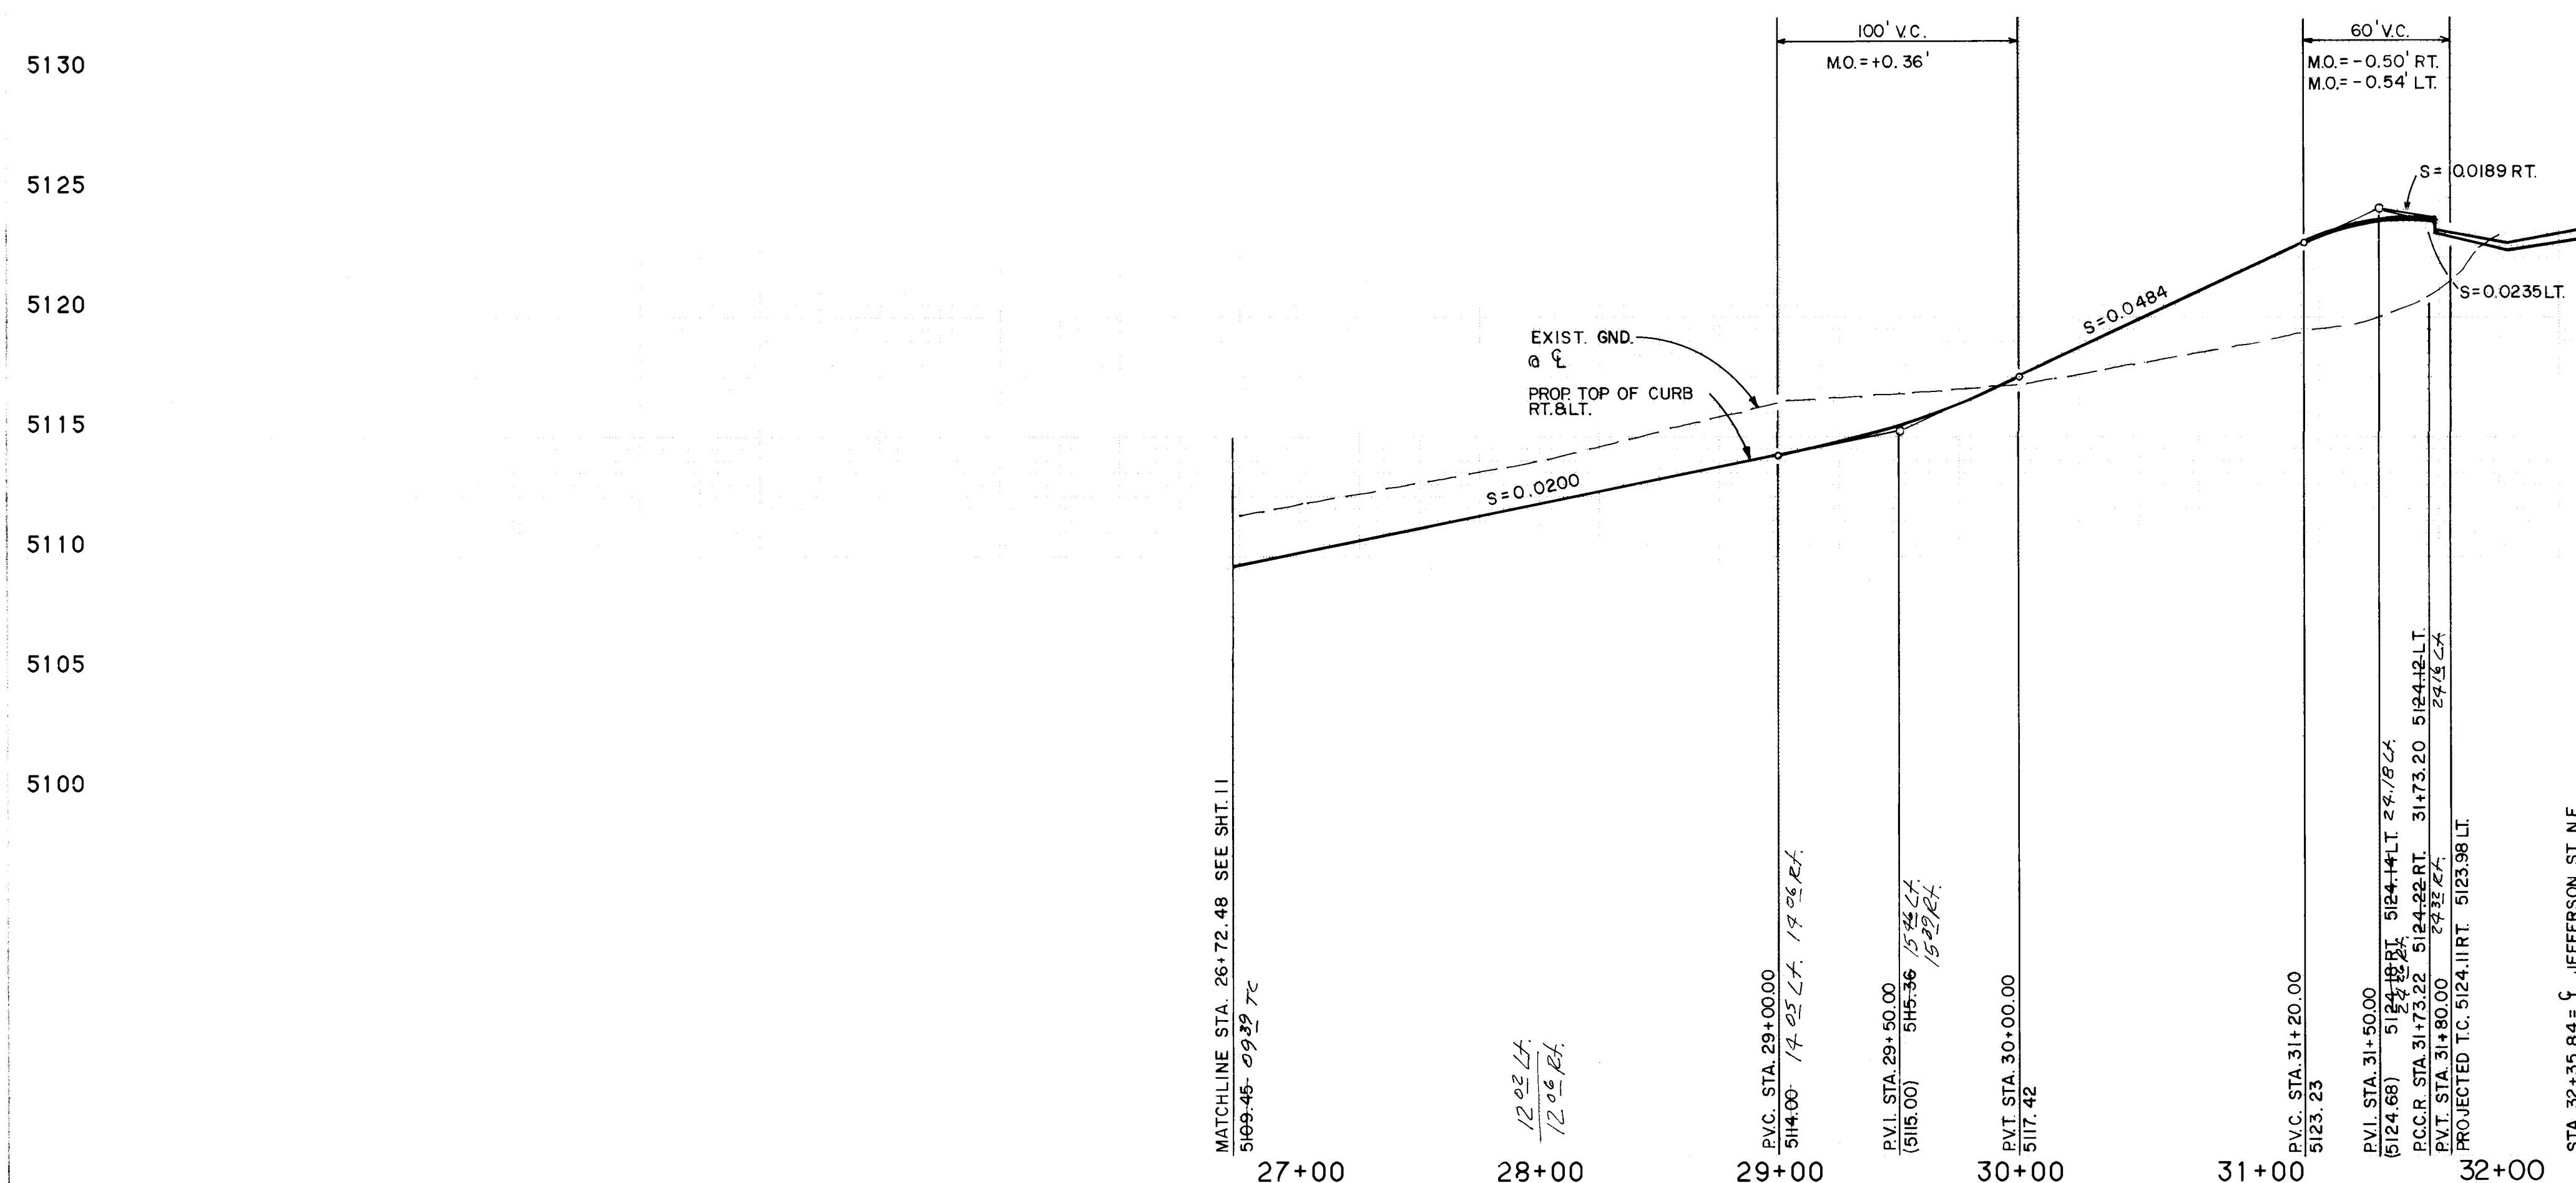

LEGEND

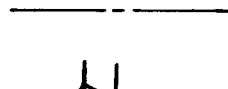- | | | |
|------|---|-----------------------------------|
| 5130 |  | CURB AND GUTTER |
| |  | RIGHT-OF-WAY |
| |  | LOT BOUNDARY |
| 5125 |  | TRANSITION TO OR
NOT TO CROWN. |
| 5120 |  | VALLEY GUTTER |
| |  | TOP OF CURB |
| |  | CENTERLINE OF STREET |
| 5115 |  | PROPOSED WHEELCHAIR
RAMP |
| 5110 |  | FUTURE SIDEWALK |

**ESPEY,
HUSTON &
ASSOCIATES, INC.**
Engineering & Environmental Consultants

**317 COMMERCIAL ST. N.E.
ALBUQUERQUE, NEW MEXICO 87102
PHONE: (505) 242-1909**


CITY OF ALBUQUERQUE
PUBLIC WORKS DEPARTMENT
ENGINEERING DIVISION

TITLE: RICHFIELD PARK - PHASE I
COLUMBINE AVE., N.E.

APPROVALS	ENGINEER	DATE	APPROVALS	ENGINEER	DATE
City Engineer	<i>[Signature]</i>	2/11/88	Liquid Waste	<i>[Signature]</i>	1/20/88
A C E - Design	" "	" "	Traffic	<i>[Signature]</i>	1/20/88
A C E - Hydrology	<i>[Signature]</i>	1-20-88	Water	<i>[Signature]</i>	1/20/88

DRAWING NO	3076	MAP NO.	C-17	SHEET	12	OF	23
------------	------	---------	------	-------	----	----	----


PHASE II

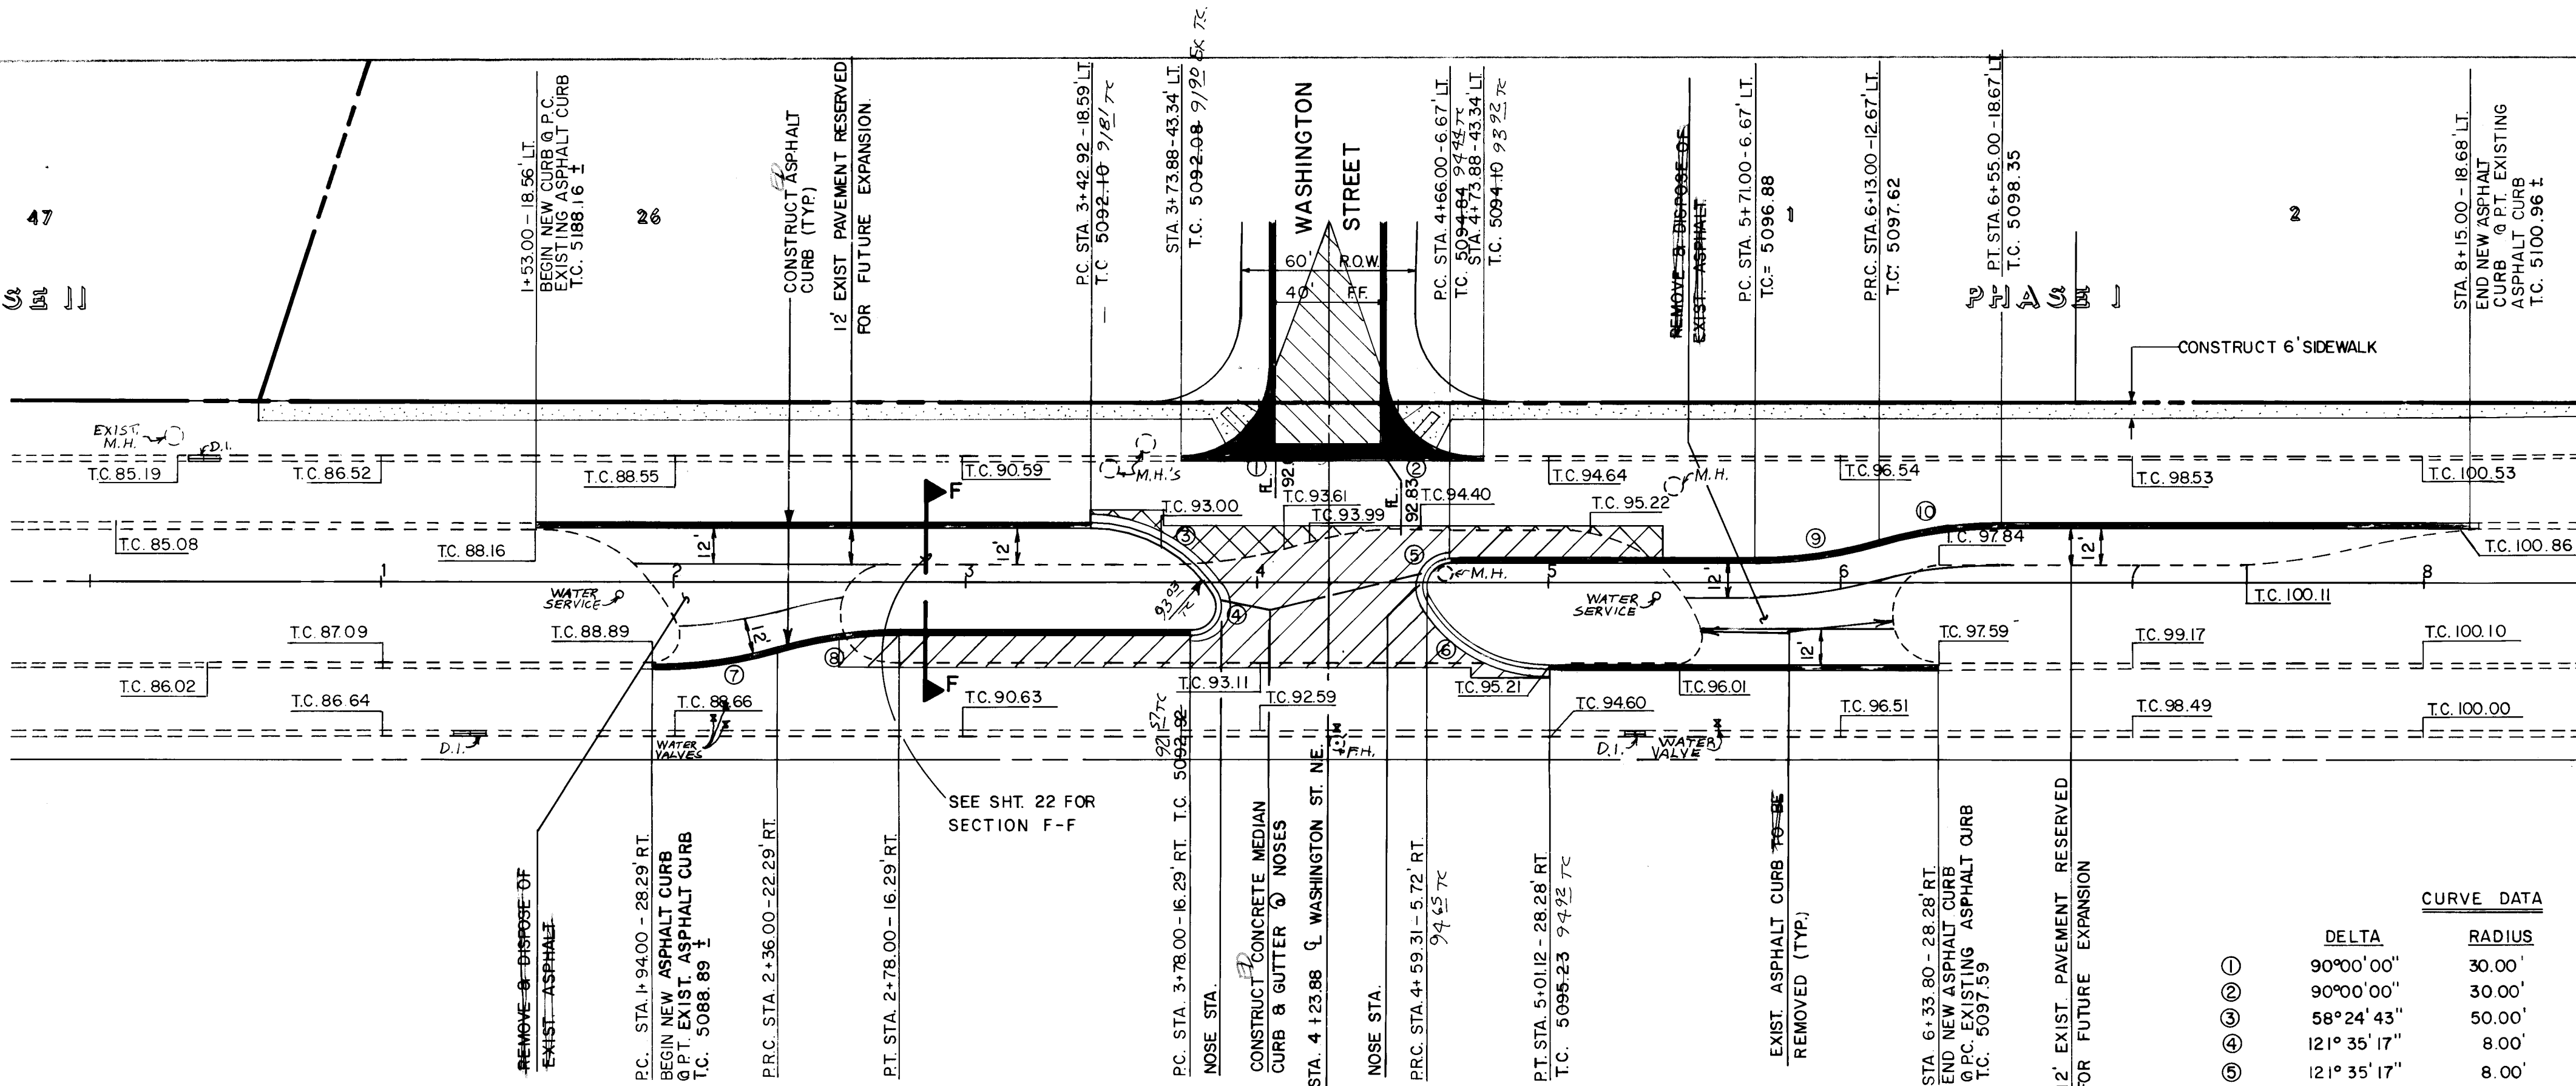

ALAMEDA BOULEVARD N.E.

CURVE DATA			
DELTA	RADIUS	LENGTH	TANGENT
90°00'00"	30.00'	47.12'	30.00'
90°00'00"	30.00'	47.12'	30.00'
58°24'43"	50.00'	50.97'	27.95'
121°35'17"	8.00'	16.98'	14.31'
121°35'17"	8.00'	16.98'	14.31'
58°24'43"	50.00'	50.97'	27.95'
16°15'37"	150.00'	42.57'	21.43'
16°15'37"	150.00'	42.57'	21.43'
16°15'37"	150.00'	42.57'	21.43'
16°15'37"	150.00'	42.57'	21.43'

5105
5100
5095
5090
5085

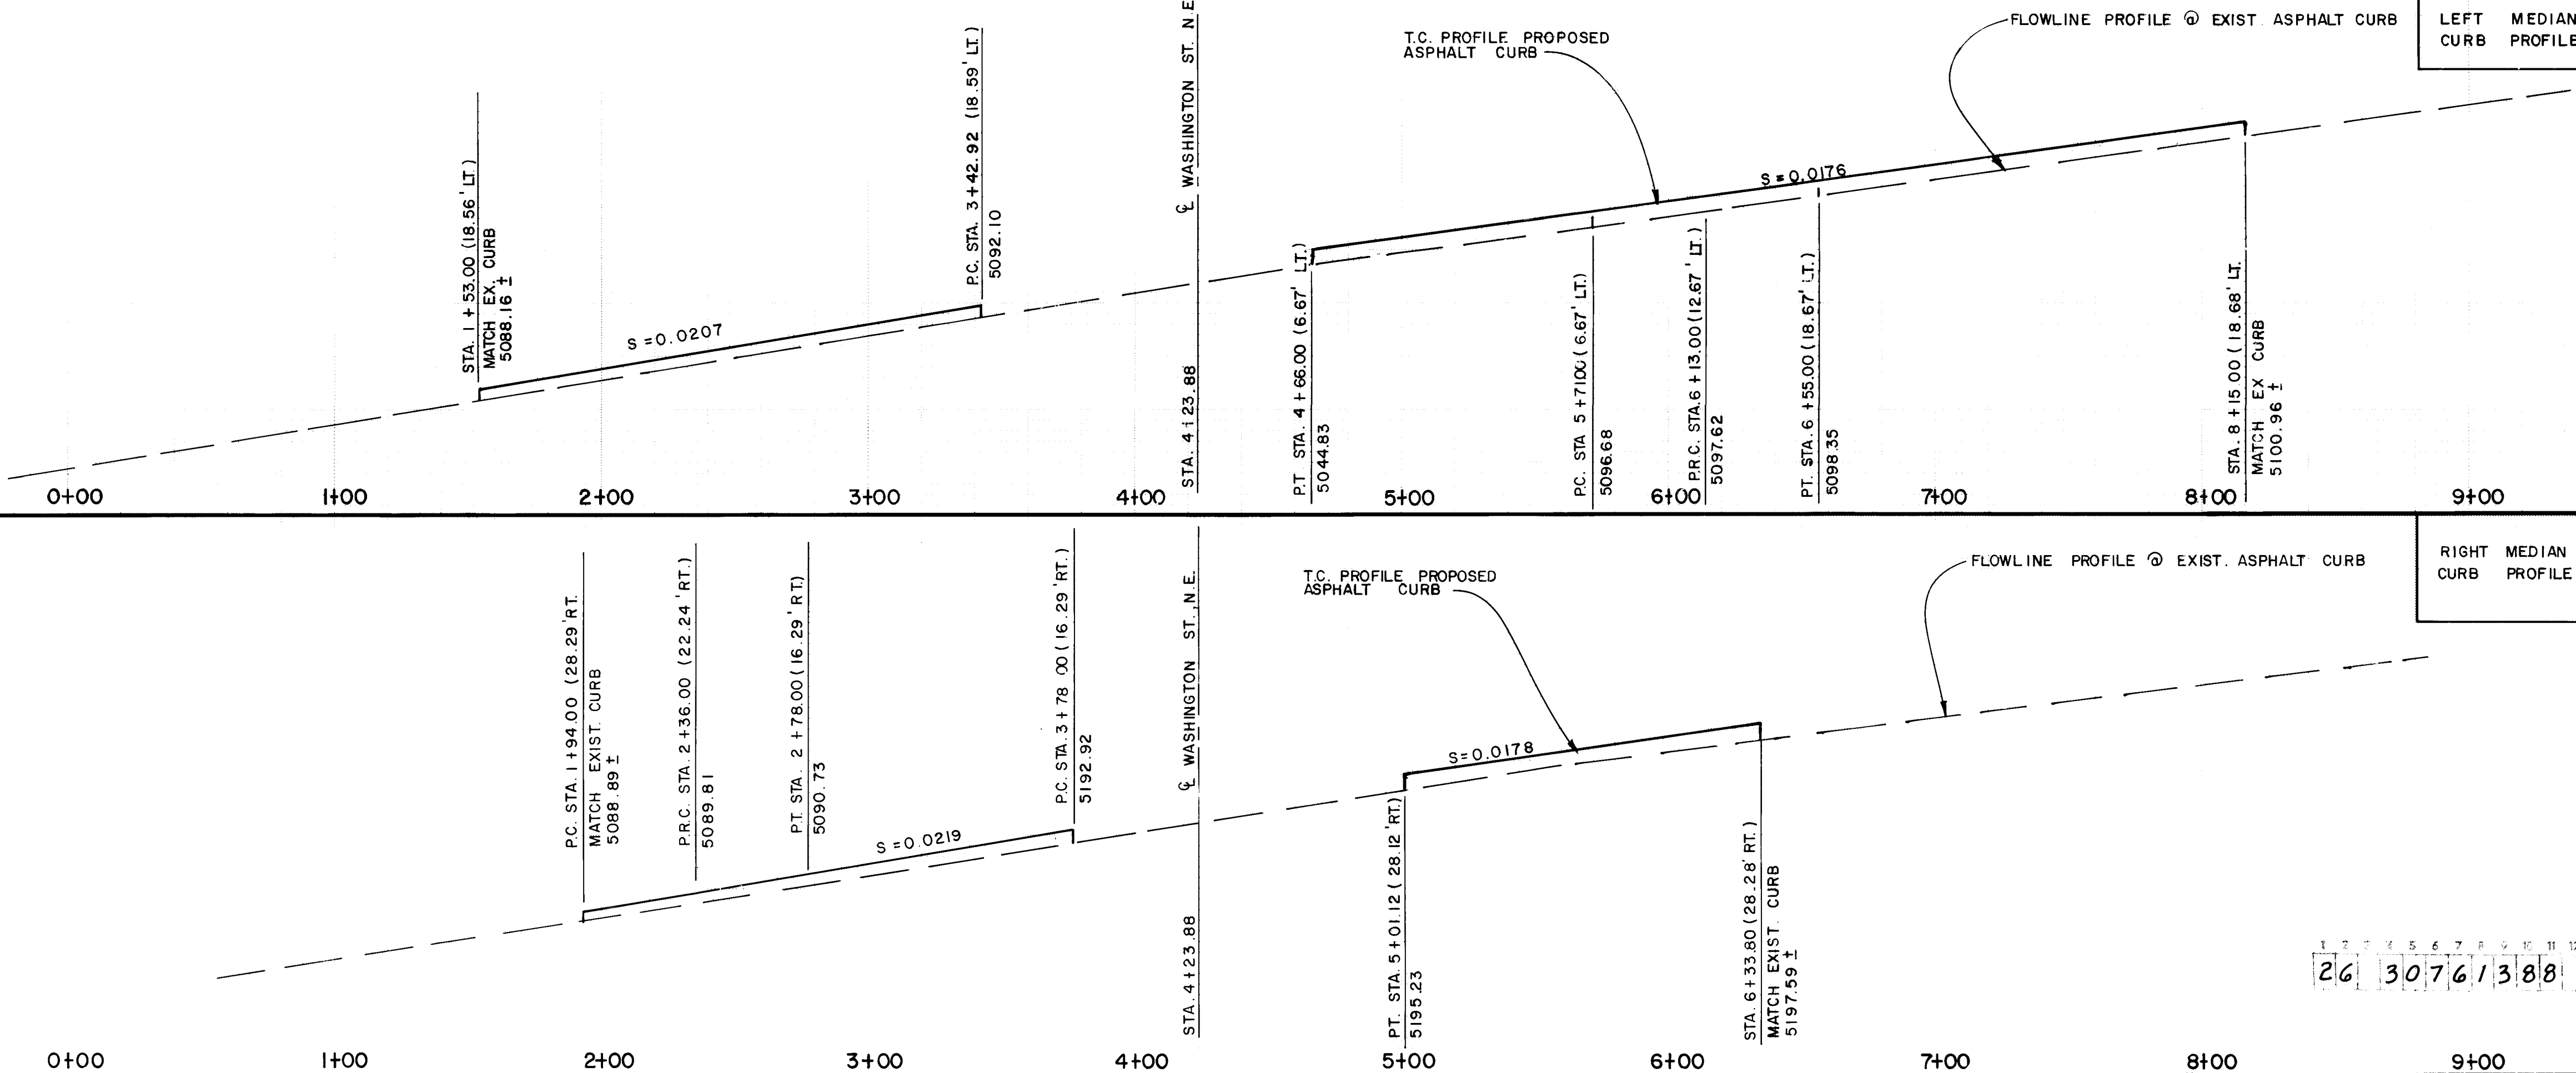

LEFT MEDIAN CURB PROFILE
RIGHT MEDIAN CURB PROFILE

- NOTES:
- ALL STATIONING BASED ON THE CENTERLINE OF THE RIGHT-OF-WAY.
 - THE FOLLOWING CITY OF ALBUQUERQUE STANDARD DRAWINGS ARE TO BE USED: PAVING ART. / COLL. ST. SECTIONS WITH-OUT MEDIAN (2407) PAVING CURB AND GUTTER & TEMPORARY PAVING SECTION (2415) PAVING CONCRETE VALLEY GUTTER (2420 and 2421) PAVING SIDEWALK DETAILS (2430) AND PAVING WHEEL CHAIR RAMP (2440 and 2441)

"AS BUILT" (HORIZONTAL AND VERTICAL LOCATION ONLY)

- LEGEND
- CONC. MEDIAN CURB & GUTTER
 - REMOVE & REPLACE PAVEMENT
 - PROP. ASPHALT CURB
 - EXIST. TOP CURB ELEV.
 - EXIST. ASPHALT CURB
 - RIGHT-OF-WAY
 - LOT BOUNDARY
 - TRANSITION TO OR NOT TO CROWN
 - VALLEY GUTTER
 - TOP OF CURB
 - CENTERLINE OF STREET
 - PROPOSED WHEELCHAIR RAMP
 - PROPOSED SIDEWALK
 - EXISTING CURB & GUTTER
 - ASPHALT REMOVE & DISPOSE
 - ASPHALT REPLACEMENT

ESPEY, HUSTON & ASSOCIATES, INC.
Engineering & Environmental Consultants
317 COMMERCIAL ST. N.E.
ALBUQUERQUE, NEW MEXICO 87102
PHONE: (505) 242-1909

CITY OF ALBUQUERQUE
PUBLIC WORKS DEPARTMENT
ENGINEERING DIVISION

TITLE: RICHFIELD PARK - PHASE I
ALAMEDA BOULEVARD N.E.
MEDIAN RECONSTRUCTION STA. 1+53.00 TO 8+15.00

APPROVALS	ENGINEER	DATE	APPROVALS	ENGINEER	DATE
City Engineer	[Signature]	2/1/88	Liquid Waste	[Signature]	1/20/88
A.C.E. - Design			Traffic	[Signature]	1/20/88
A.C.E. - Hydrology	N/A RAS	1-20-88	Water	[Signature]	1/20/88


DRAWING NO. 3076 MAP NO. C-17 SHEET 13 OF 23

REVISIONS

NO.	DATE	REMARKS
1	10/86	D.A.L.
2	10/86	E.L.S.
3	11/86	D.L.


DATE 1-12-88

THE STATION IS LOCATED 7.5 MILES N.E. OF DOWNTOWN, AND 0.3 MILES N. OF THE INTERSECTION OF LOS ANGELES BOULEVARD AND WASHINGTON STREET N.E.. TO REACH THE STATION FROM THE INTERSECTION OF LOS ANGELES BLVD. AND 2ND ST., GO EAST ON LOS ANGELES BLVD. 1.65 MILES TO INTERSECTION WITH WASHINGTON ST. N.E., THEN N. ON WASHINGTON ST. N.E. 0.3 MILES TO THE STATION ON LEFT (WEST SIDE OF THE STREET). THE STATION MARK IS A STANDARD ACS BRASS TABLET, STAMPED "8-C17, 1975," CEMENTED IN A DRILL HOLE IN TOP OF CONCRETE CURB. ELEV. 5111.028

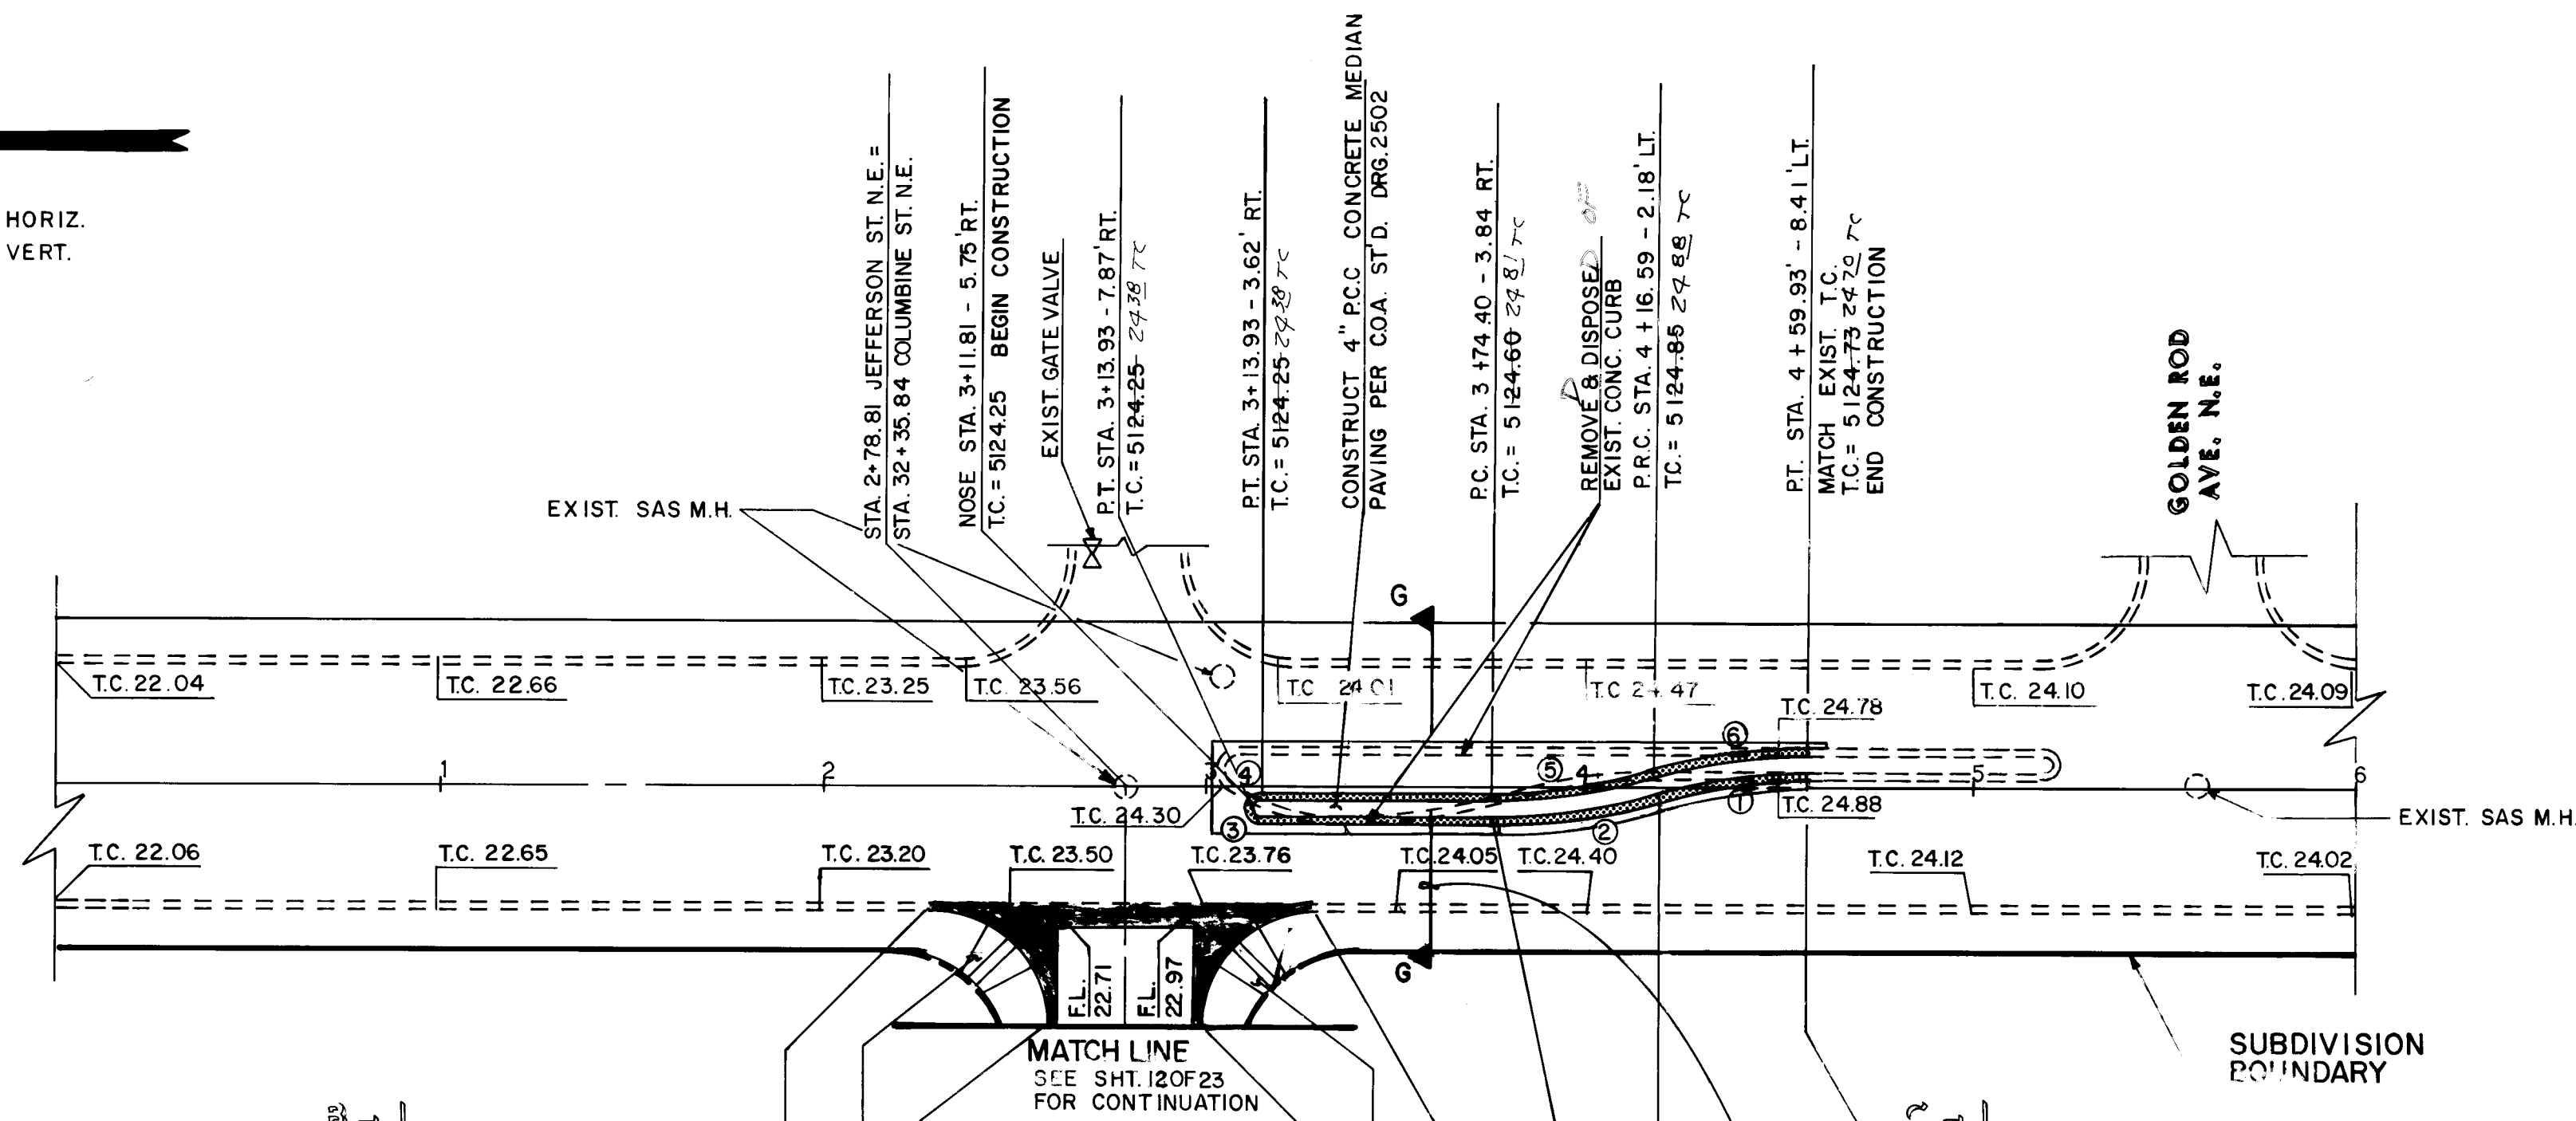

	<u>CURVE</u>	<u>DATA</u>	
	<u>DELTA</u>	<u>RADIUS</u>	<u>LENGTH</u>
①	16° 29' 59"	150.00'	43.20
②	16° 19' 18"	154.00'	43.47'
③	90° 00' 00"	2.00'	3.14'
④	90° 00' 00"	2.00'	3.14'
⑤	16° 20' 00"	150.00'	42.76'
⑥	16° 19' 12"	154.25'	43.79'

JEFFERSON STREET N.E.

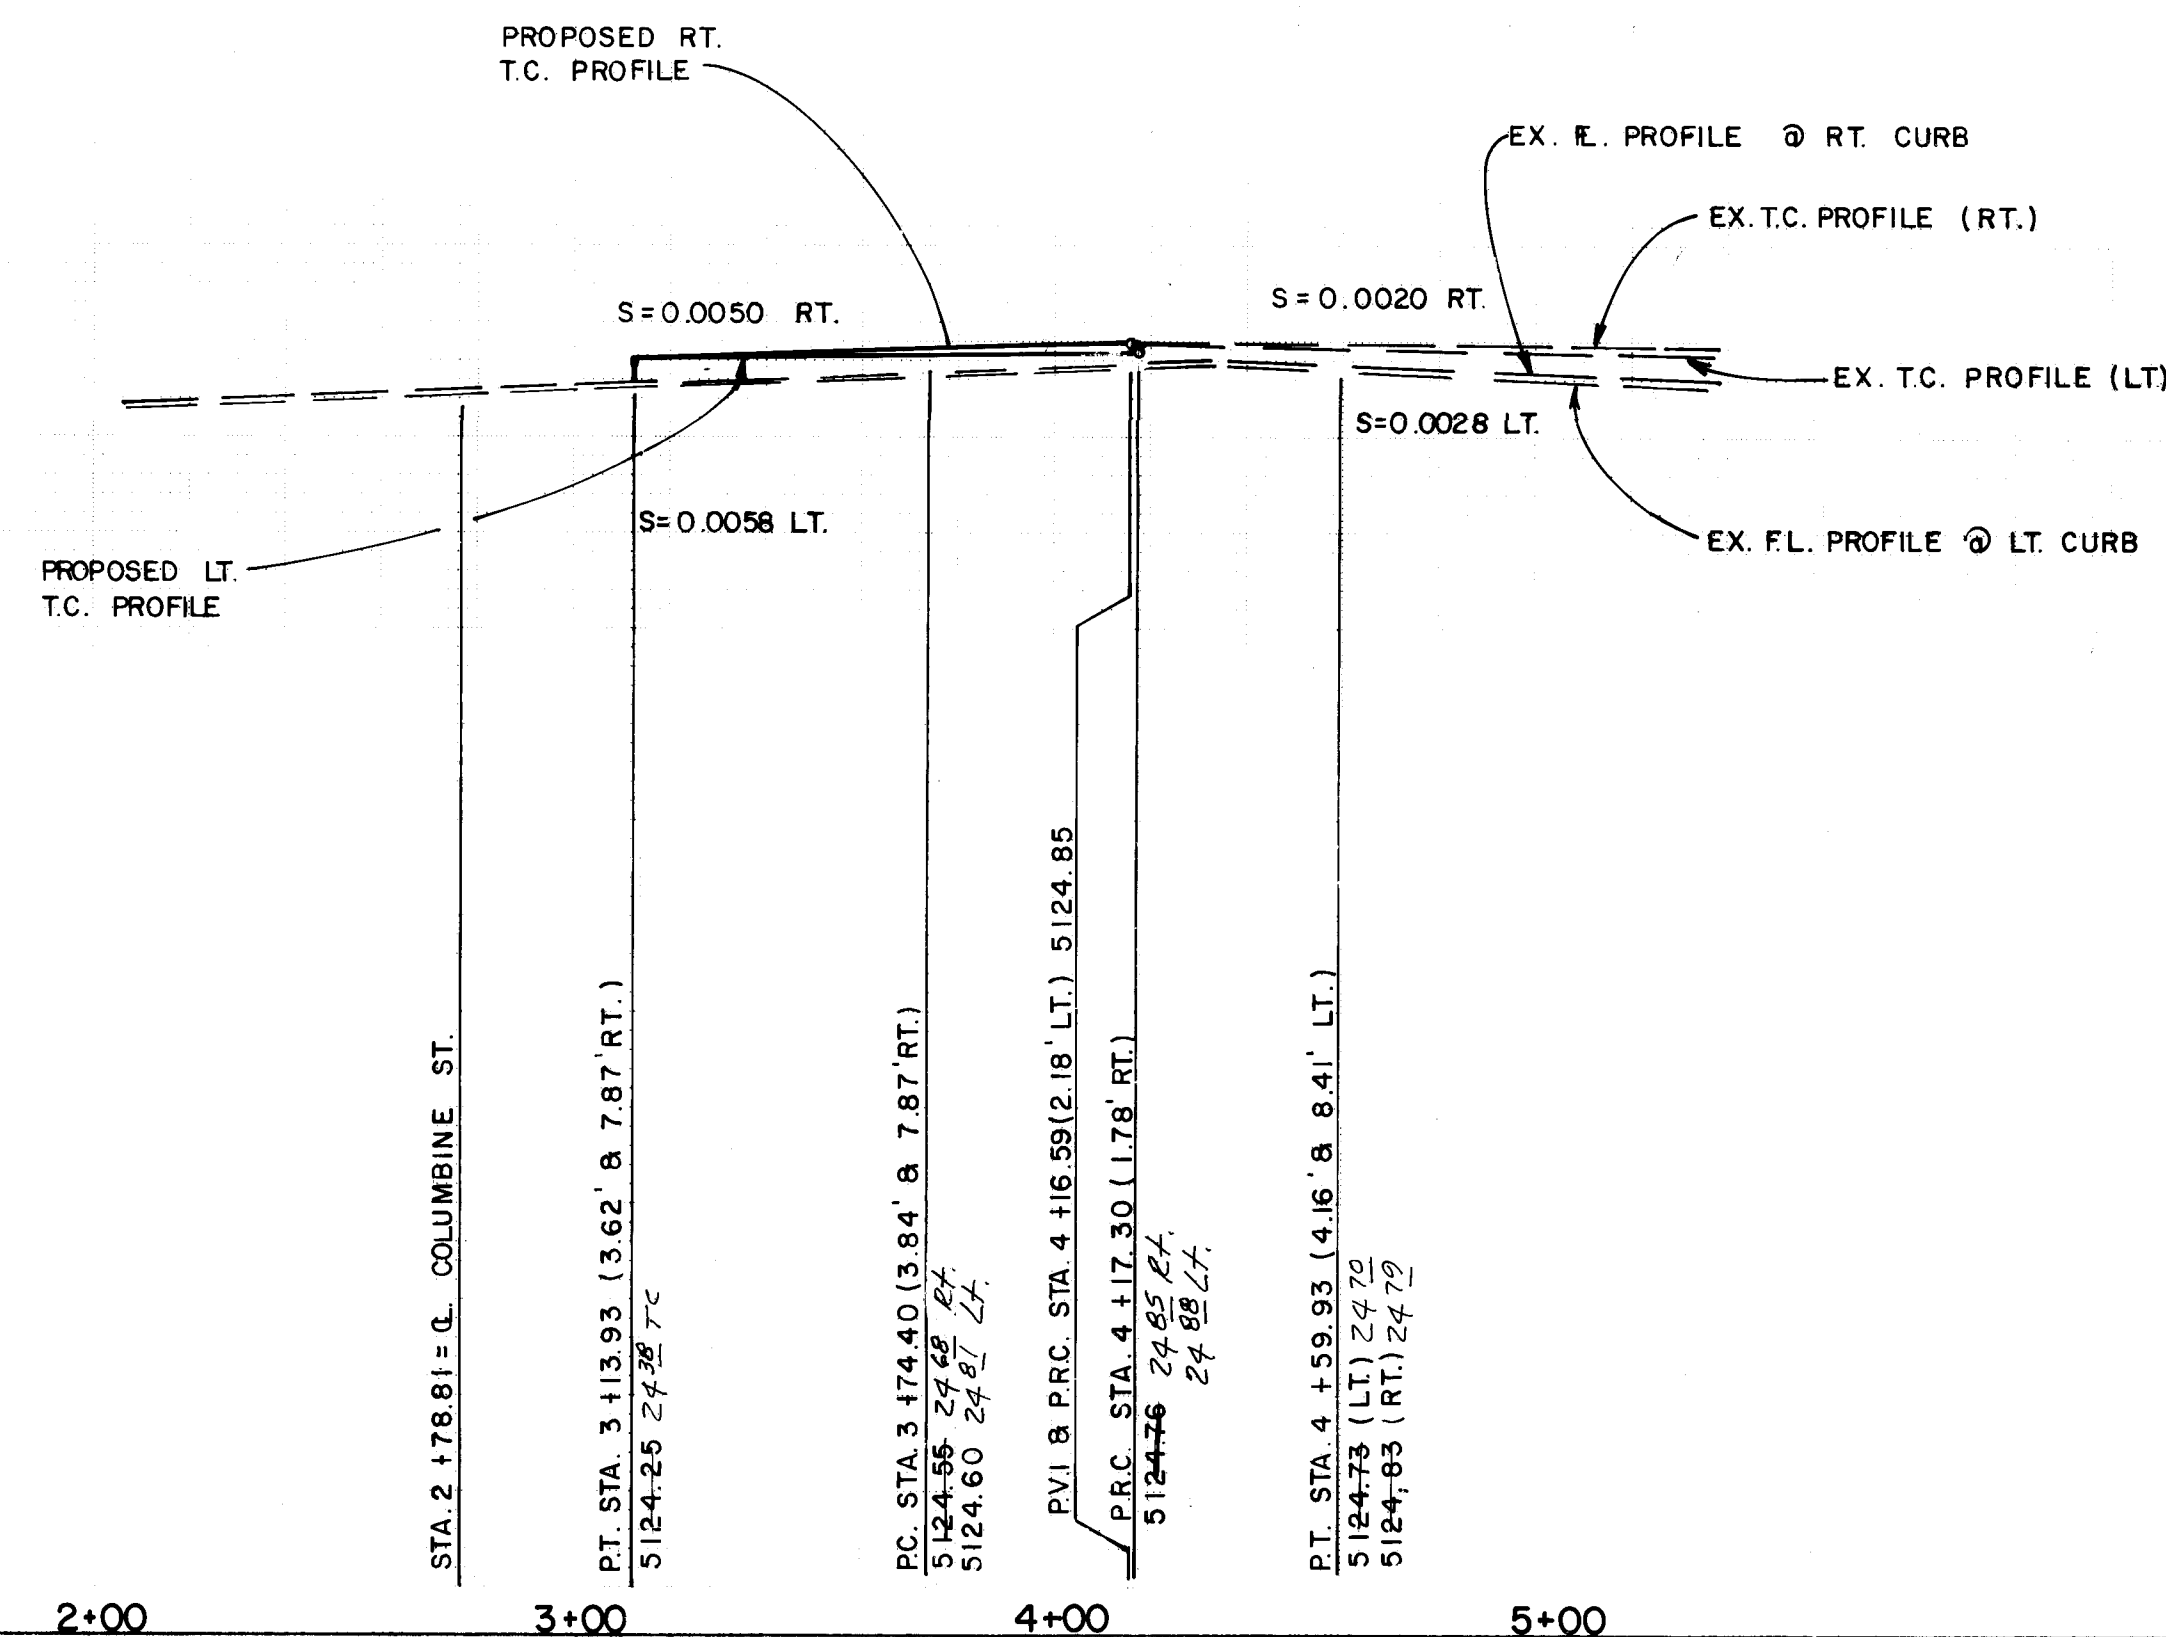


1. ALL STATIONING BASED ON THE CENTER-LINE OF THE RIGHT-OF-WAY.
2. THE FOLLOWING CITY OF ALBUQUERQUE STANDARD DRAWINGS ARE TO BE USED:
PAVING ART. / COLL. ST. SECTIONS WITHOUT MEDIAN (2407)
PAVING CURB AND GUTTER & TEMPORARY PAVING SECTION (2415)
PAVING CONCRETE VALLEY GUTTER (2420 and 2421)
PAVING SIDEWALK DETAILS (2430)
AND PAVING WHEEL CHAIR RAMP (2440 and 2441)

"AS-BUILT" (HORIZONTAL
AND VERTICAL LOCATION ONLY)



LEGEND

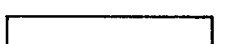- | | |
|---|--------------------------------|
|  | CURB AND GUTTER |
|  | RIGHT-OF-WAY |
|  | LOT BOUNDARY |
|  | TRANSITION TO OR NOT TO CROWN. |
|  | VALLEY GUTTER |
|  | TOP OF CURB |
|  | CENTERLINE OF STREET |
|  | PROPOSED WHEELCHAIR RAMP |
|  | ASPHALT REMOVE & REPLACE |
|  | NEW ASPHALT PAVEMENT |
|  | PROPOSED ASPH. CURB |



**ESPEY,
HUSTON &
ASSOCIATES, INC.**
Engineering & Environmental Consultants

**317 COMMERCIAL ST. N.E.
ALBUQUERQUE, NEW MEXICO 87
PHONE: (505) 242-1909**


CITY OF ALBUQUERQUE
PUBLIC WORKS DEPARTMENT
ENGINEERING DIVISION

TITLE: RICHFIELD PARK - PHASE I
JEFFERSON STREET N.E.
MEDIAN RECONSTRUCTION

APPROVALS	ENGINEER	DATE	APPROVALS	ENGINEER	DATE
City Engineer	<i>[Signature]</i>	2/11/88	Liquid Waste	<i>[Signature]</i>	1/20/88
A C E - Design	"	"	Traffic	<i>[Signature]</i>	1/20/88
A C E - Hydrology	N/A RAB	1-20-88	Water	<i>[Signature]</i>	1/20/88

DRAWING NO.	3076	MAP NO. C-17	SHEET 14	OF 23
----------------	------	-----------------	-------------	----------

1	2	3	4	5	6	7	8	9	10	11	12
2	6		3	0	7	6	1	4	8	8	

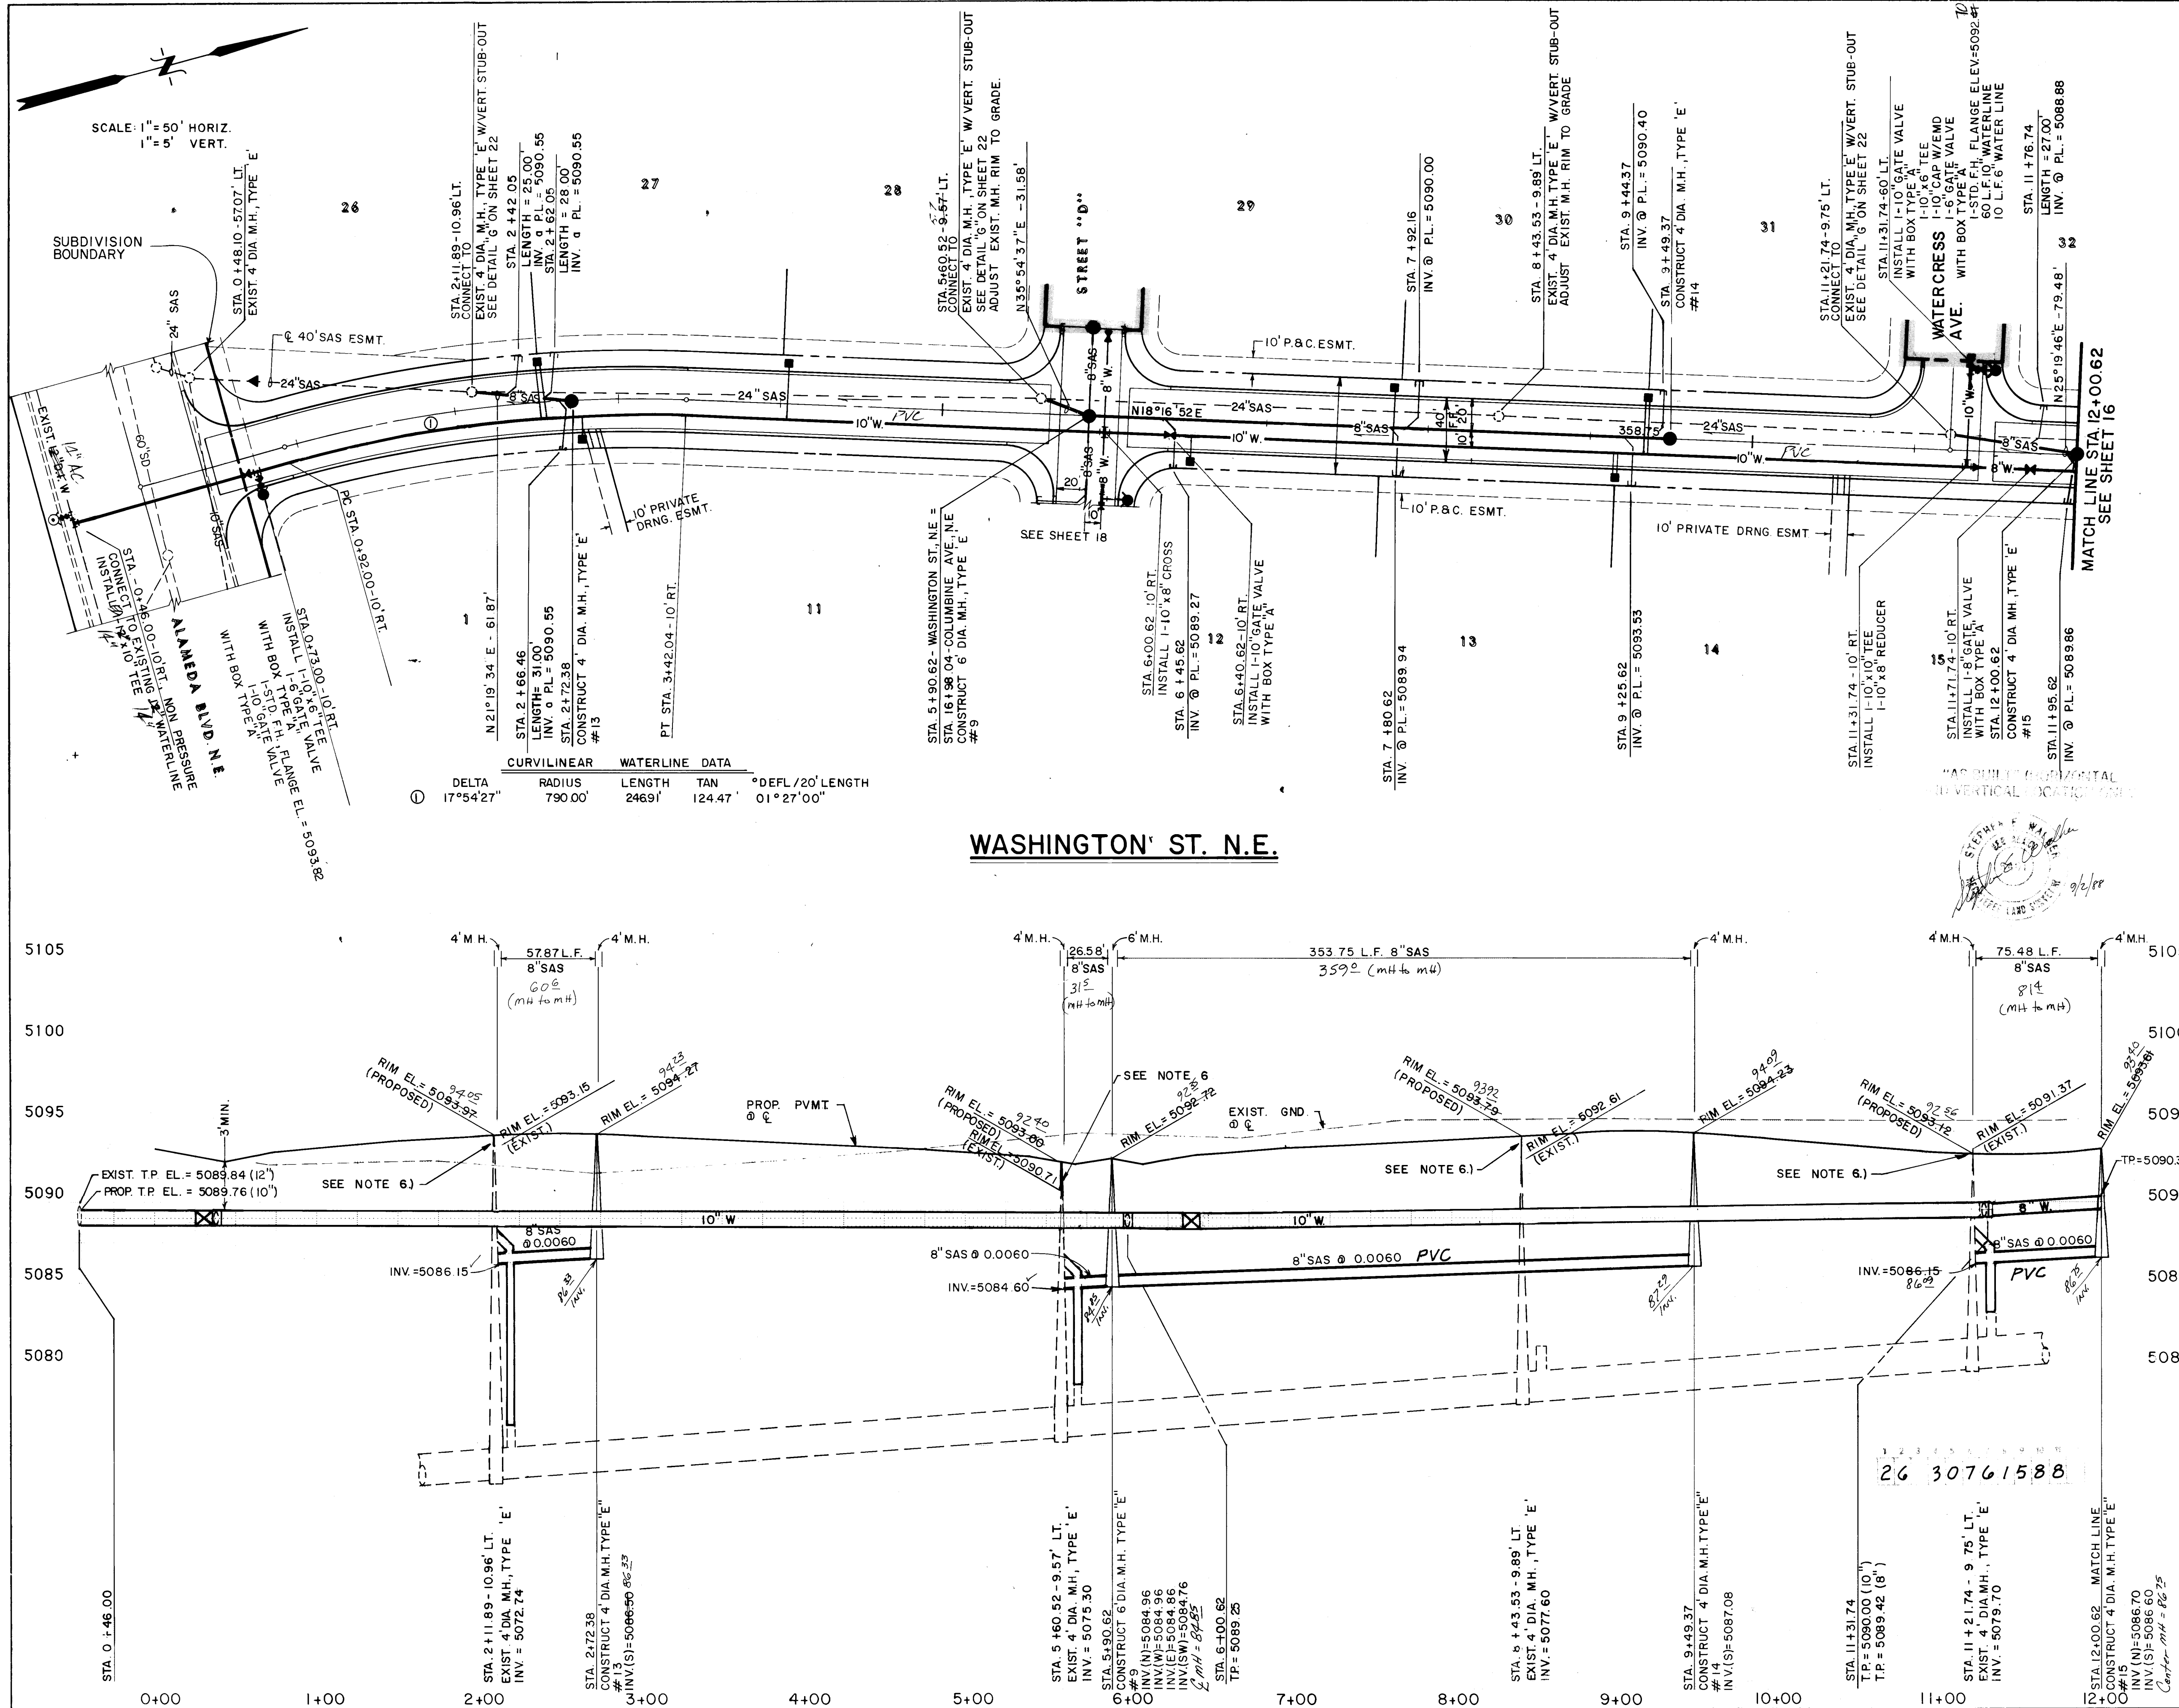

NOTES:

- UTILITY STATIONING IS BASED ON STREET CENTERLINE STATIONING EXCEPT WHERE NOTED OTHERWISE.
- THE FOLLOWING CITY OF ALBUQUERQUE STANDARD DRAWINGS ARE APPLICABLE TO THE WATER AND SANITARY SEWER CONSTRUCTION:
- SEWER SERVICE LENGTHS ARE 30' EXCEPT WHERE NOTED OTHERWISE.
- CONCRETE THRUST BLOCKING TO BE USED IN ALL CASES WHERE REQUIRED PER C.O.A. STD DWG 2320.
- CONTRACTOR TO FIELD VERIFY LOCATION OF ALL EXISTING UTILITIES.
- ADJUST RIMS TO PROPOSED ELEVATION.
- ALL FIRE HYDRANTS SHALL BE 4' BURY. PER C.O.A. STD DWG 2340.

AS BUILT INFORMATION

CONTRACT NO.	DATE	BY	DATE
102	2136	2325	2333
2110	2145	2326	2340
2118	2301	2328	2344
2125	2315	2332	2347

BENCH MARKS

The Station is Located 7.5 Miles N.E. of Downtown, And 0.3 Miles N. of The Intersection of Los Angeles Boulevard And Washington Street N.E. To Reach The Station From The Intersection of Los Angeles Blvd. And 2nd St., Go East On Los Angeles Blvd. 1.65 Miles To Intersection With Washington St. N.E., Then N. On Washington St. N.E. 0.3 Miles To The Station On Left (West Side of The Street). The Station Mark is A Standard ACS Brass Table, Stamped "B-C17 1975", Cemented in A Drill Hole in Top of Concrete Curb. Elev. 5111.029

SURVEY INFORMATION

NO.	DATE	BY	DATE
1	2102	2136	2325
2	2110	2145	2326
3	2118	2301	2328
4	2125	2315	2332

LEGEND

PROPOSED WATER SERVICE 1"

EXISTING WATER SERVICE

PROPOSED WATERLINE

EXISTING WATERLINE

EXISTING STORM DRAIN

PROPOSED FIRE HYDRANT

EXISTING FIRE HYDRANT

PROPOSED GATE VALVE

EXISTING GATE VALVE

PROPOSED REDUCER

PROPOSED BUTTERFLY VALVE

PROPOSED CAP

EXISTING CAP

PROPOSED CROSS

PROPOSED TEE

PROPOSED 90° BEND

PROPOSED 45° BEND

EXISTING CROSS

PROPOSED SIDEWALK

PROPOSED CURB & GUTTER

EXISTING SANITARY SEWER MANHOLE

8"SAS - EXISTING SANITARY SEWER LINE

8"SAS - PROPOSED SANITARY SEWER LINE

PROJECT PHASE BOUNDARY

PROPOSED SAS SERVICE 4"

REVISIONS


NO.	DATE	BY	DATE
1	2102	2136	2325
2	2110	2145	2326
3	2118	2301	2328
4	2125	2315	2332

DESIGNED BY: D.A.L. DATE: 9/86


DRAWN BY: S.F.B. DATE: 9/86

CHECKED BY: DL DATE: 11/86

SCALE: 1" = 50' HORIZ.
1" = 5' VERT.

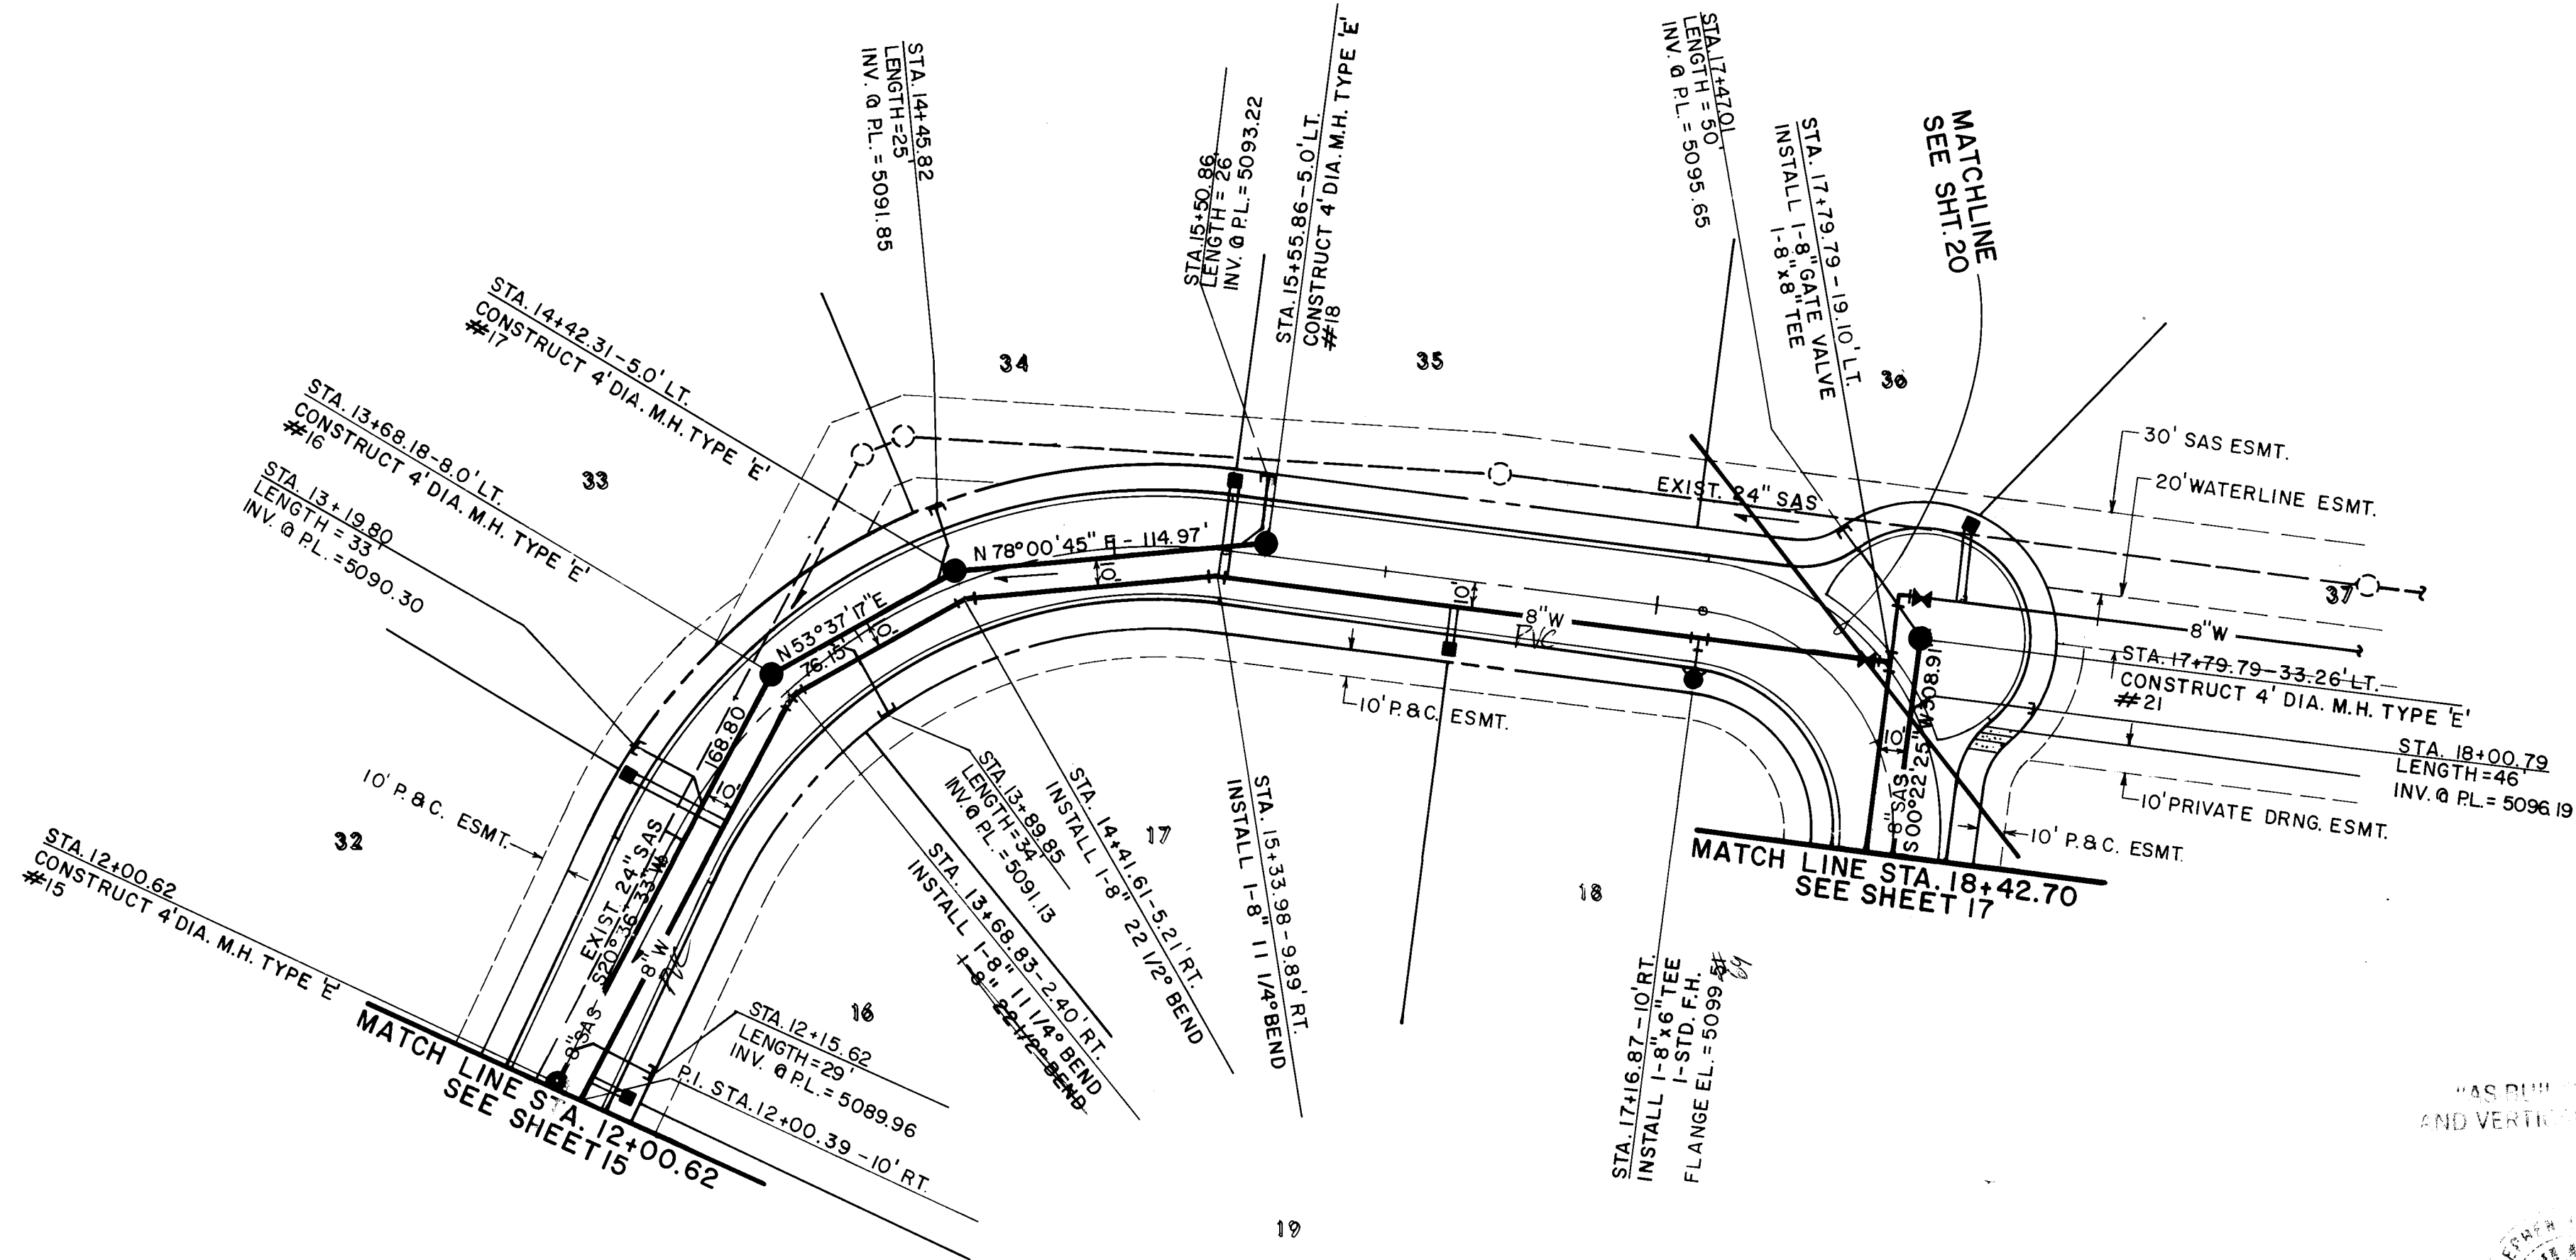

WASHINGTON ST. N.E.

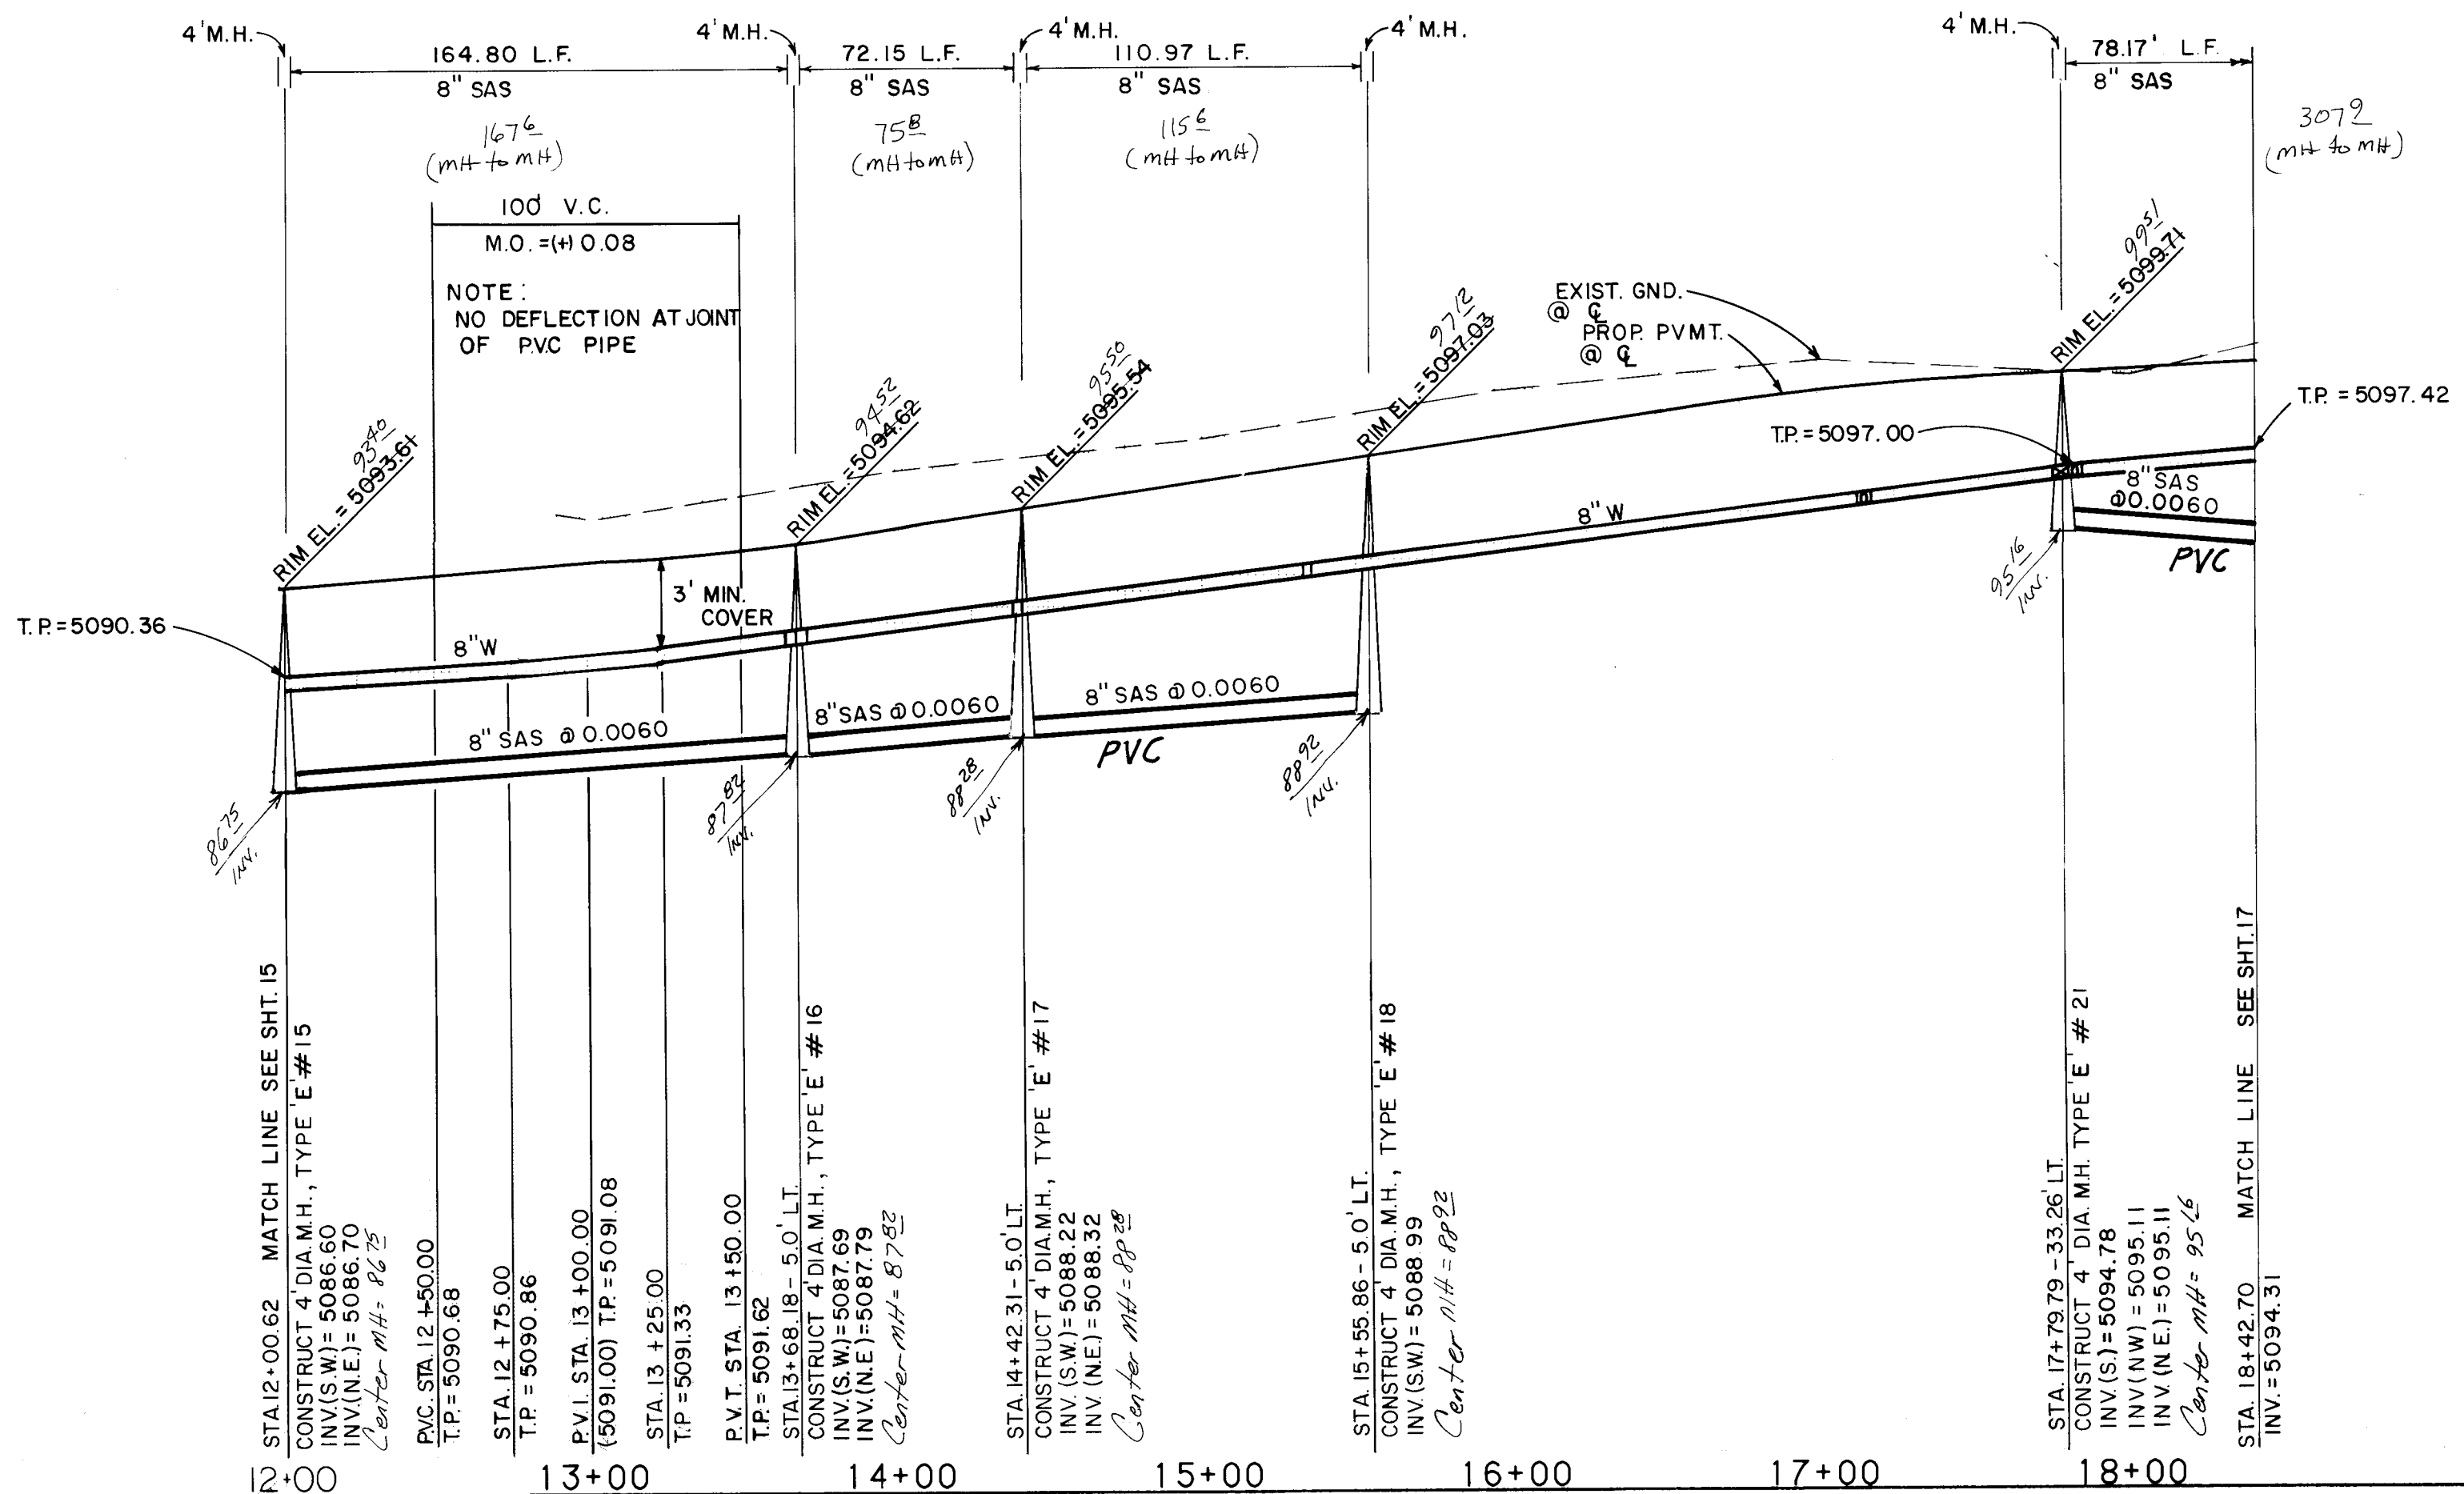

NOTES:

- UTILITY STATIONING IS BASED ON STREET CENTERLINE STATIONING EXCEPT WHERE NOTED OTHERWISE.
- THE FOLLOWING CITY OF ALBUQUERQUE STANDARD DRAWINGS ARE APPLICABLE TO THE WATER AND SANITARY SEWER CONSTRUCTION:
- SEWER SERVICE LENGTHS ARE 30' EXCEPT WHERE NOTED OTHERWISE.
- CONCRETE THRUST BLOCKING TO BE USED IN ALL CASES WHERE REQUIRED PER C.O.A. STD DWG 2320.
- CONTRACTOR TO FIELD VERIFY LOCATION OF ALL EXISTING UTILITIES.
- ADJUST RIMS TO PROPOSED ELEVATION.
- ALL FIRE HYDRANTS SHALL BE 4' BURY PER C.O.A. STD. DWG. 2340.

AS BUILT INFORMATION

DATE	BY	NO.
9/88	EEB	

BENCH MARKS

The Station is Located 7.5 Miles NE of Downtown, And 0.3 Miles N of the Intersection of Los Angeles Boulevard And Washington Street NE. To Reach The Station From The Intersection of Los Angeles Blvd. And 2nd St. Go East On Los Angeles Blvd. 1.65 Miles To Intersection With Washington St. NE, Then N On Washington St. NE. 0.3 Miles To The Station On Left (West Side of The Street). The Station Mark is A Standard ACS Brass Tablet, Stamped "8-C17, 1975", Cemented in A Drill Hole in Top of Concrete Curb. Elev. 5111.029

SANITARY SEWER SERVICES

LOT	STATION	LENGTH	INV.	PL
16	12+15.62 RT.	29'	5089.96	892
33	13+19.80 LT.	33'	5090.30	892
17	13+89.85 RT.	34'	5091.13	904
34	14+45.82 LT.	25'	5091.65	904
35	15+50.80 LT.	25'	5093.28	921
36	17+47.01 LT.	50'	5095.65	951
37	18+00.79 LT.	46'	5096.19	961

LEGEND

- PROPOSED SINGLE WATER SERVICE - 1"
- PROPOSED DOUBLE WATER SERVICE - 1"
- PROPOSED WATERLINE
- EXISTING WATERLINE
- EXISTING STORM DRAIN
- PROPOSED FIRE HYDRANT
- EXISTING FIRE HYDRANT
- PROPOSED GATE VALVE
- EXISTING GATE VALVE
- PROPOSED REDUCER
- PROPOSED BUTTERFLY VALVE
- PROPOSED CAP
- EXISTING CAP
- PROPOSED CROSS
- PROPOSED TEE
- PROPOSED 90° BEND
- PROPOSED 45° BEND
- EXISTING CROSS
- PROPOSED SIDEWALK
- PROPOSED CURB & GUTTER
- PROPOSED SANITARY SEWER MANHOLE
- SAS - PROPOSED SANITARY SEWER LINE
- EXISTING SAS MANHOLE
- EXISTING SAS LINE
- PROPOSED 4" SAS SERVICE

ENGINEER'S SEAL

ESPEY, HUSTON & ASSOCIATES, INC.
Engineering & Environmental Consultants
317 COMMERCIAL ST. N.E.
ALBUQUERQUE, NEW MEXICO 87102
PHONE: (505) 242-1909

CITY OF ALBUQUERQUE
PUBLIC WORKS DEPARTMENT
ENGINEERING DIVISION


TITLE: RICHFIELD PARK - PHASE I
WASHINGTON ST. N.E.
SANITARY SEWER & WATER PLAN & PROFILE
STA. 12+00.62 TO 18+42.70

APPROVALS	ENGINEER	DATE	APPROVALS	ENGINEER	DATE
City Engineer		2/11/88	Liquid Waste		1/20/88
A.C.E. - Design			Traffic		1/20/88
A.C.E. - Hydrology		1/20/88	Water		1/20/88

DRAWING NO. 3076

MAP NO. C-17

SHEET 16 OF 23

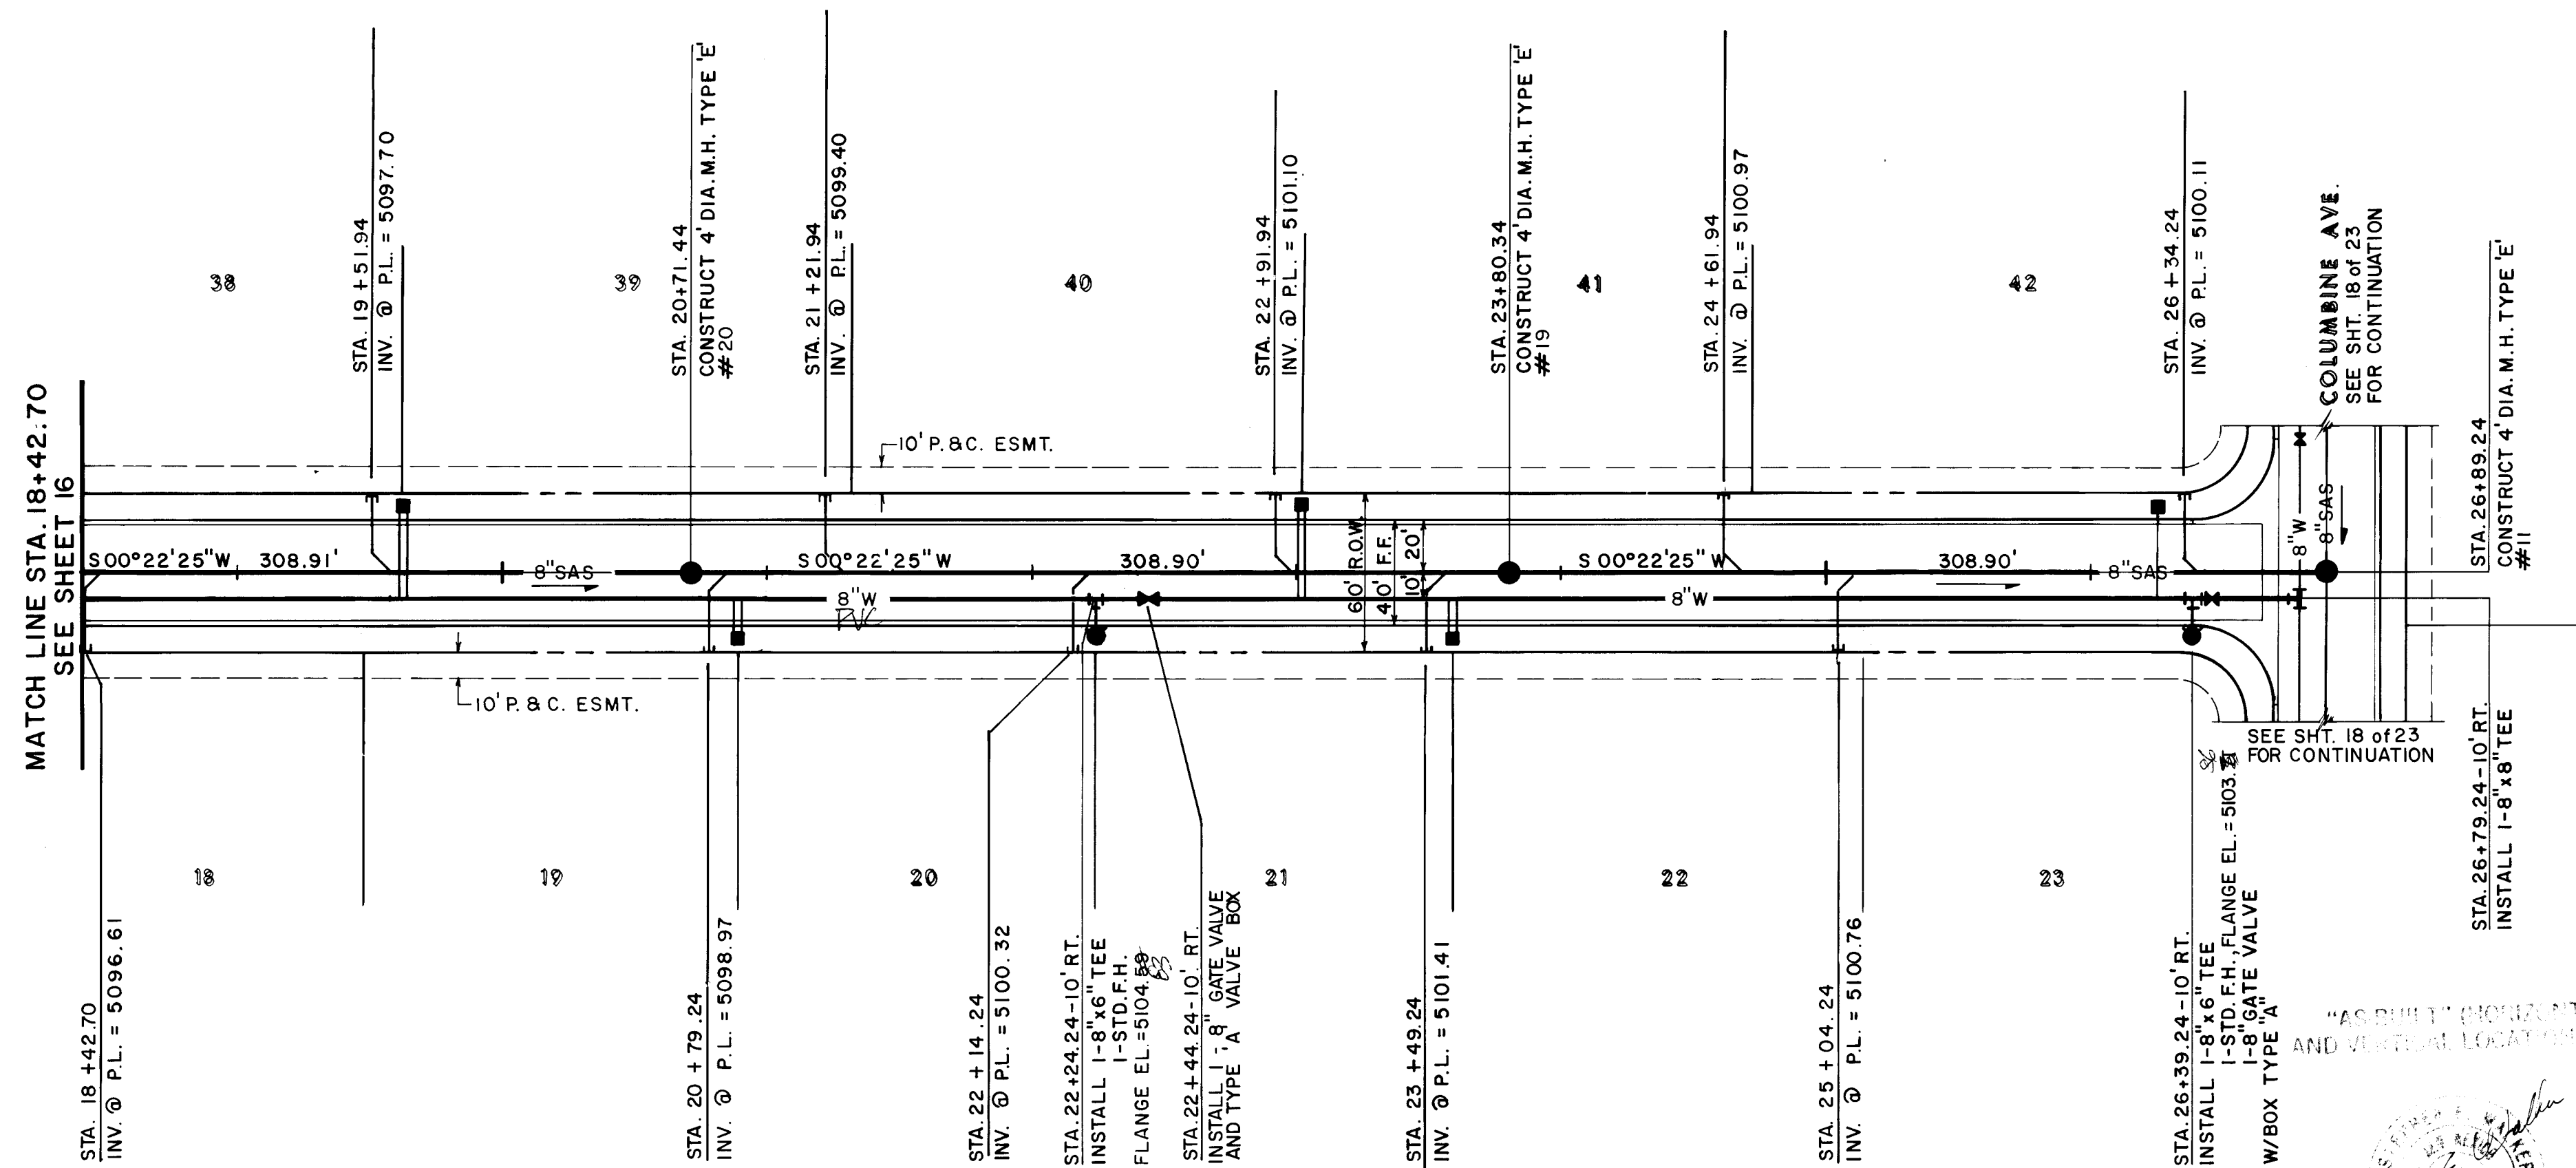

- | SANITARY SEWER SERVICES | | | | |
|-------------------------|--------------|--------|---------|------|
| LOT | STATION | LENGTH | INV. | • PL |
| 18 | 18+42.70 RT. | 30' | 5096.61 | 97.4 |
| 18 | 19+51.94 LT. | 30' | 5097.70 | 98.0 |
| 38 | 20+79.94 LT. | 30' | 5098.80 | 98.6 |
| 39 | 21+21.94 LT. | 30' | 5099.40 | 99.2 |
| 20 | 22+14.24 RT. | 30' | 5100.32 | 98.9 |
| 20 | 22+91.94 LT. | 30' | 5101.10 | 98.7 |
| 21 | 23+49.24 RT. | 30' | 5101.41 | 99.3 |
| 41 | 24+61.94 LT. | 30' | 5100.97 | 99.8 |
| 22 | 25+04.24 RT. | 30' | 5100.76 | 98.6 |
| 42 | 26+34.24 LT. | 30' | 5100.11 | 98.6 |

- ESPEY,
HUSTON &
ASSOCIATES, INC.
Engineering & Environmental Consultants
-
- 317 COMMERCIAL ST. N.E.
ALBUQUERQUE, NEW MEXICO 87102
PHONE: (505) 242-1909

TITLE: RICHFIELD PARK -
ADAMS ST., N
SANITARY SEWER & WATER PI
STA. 18+42.70 TO 26+

APPROVALS	ENGINEER	DATE	APPROV
City Engineer	<i>[Signature]</i>	2/11/88	Liquid Wa
ACE - Design	" "	"	Traffic
ACE - Hydrology	N/A RAS	1-20-88	Water

DRAWING NO.	3076	MAP NO.	C-17
-------------	------	---------	------


[illegible][illegible]

QUE
RTMENT
SION

PHASE I
E.
PLAN & PROFILE
8924

WALS	ENGINEER	DATE
ste	M. Muenner	1/20/88
	LRC	1/20/88
	M. Muenner	1/20/88

SHEET	17	OF	23
-------	----	----	----

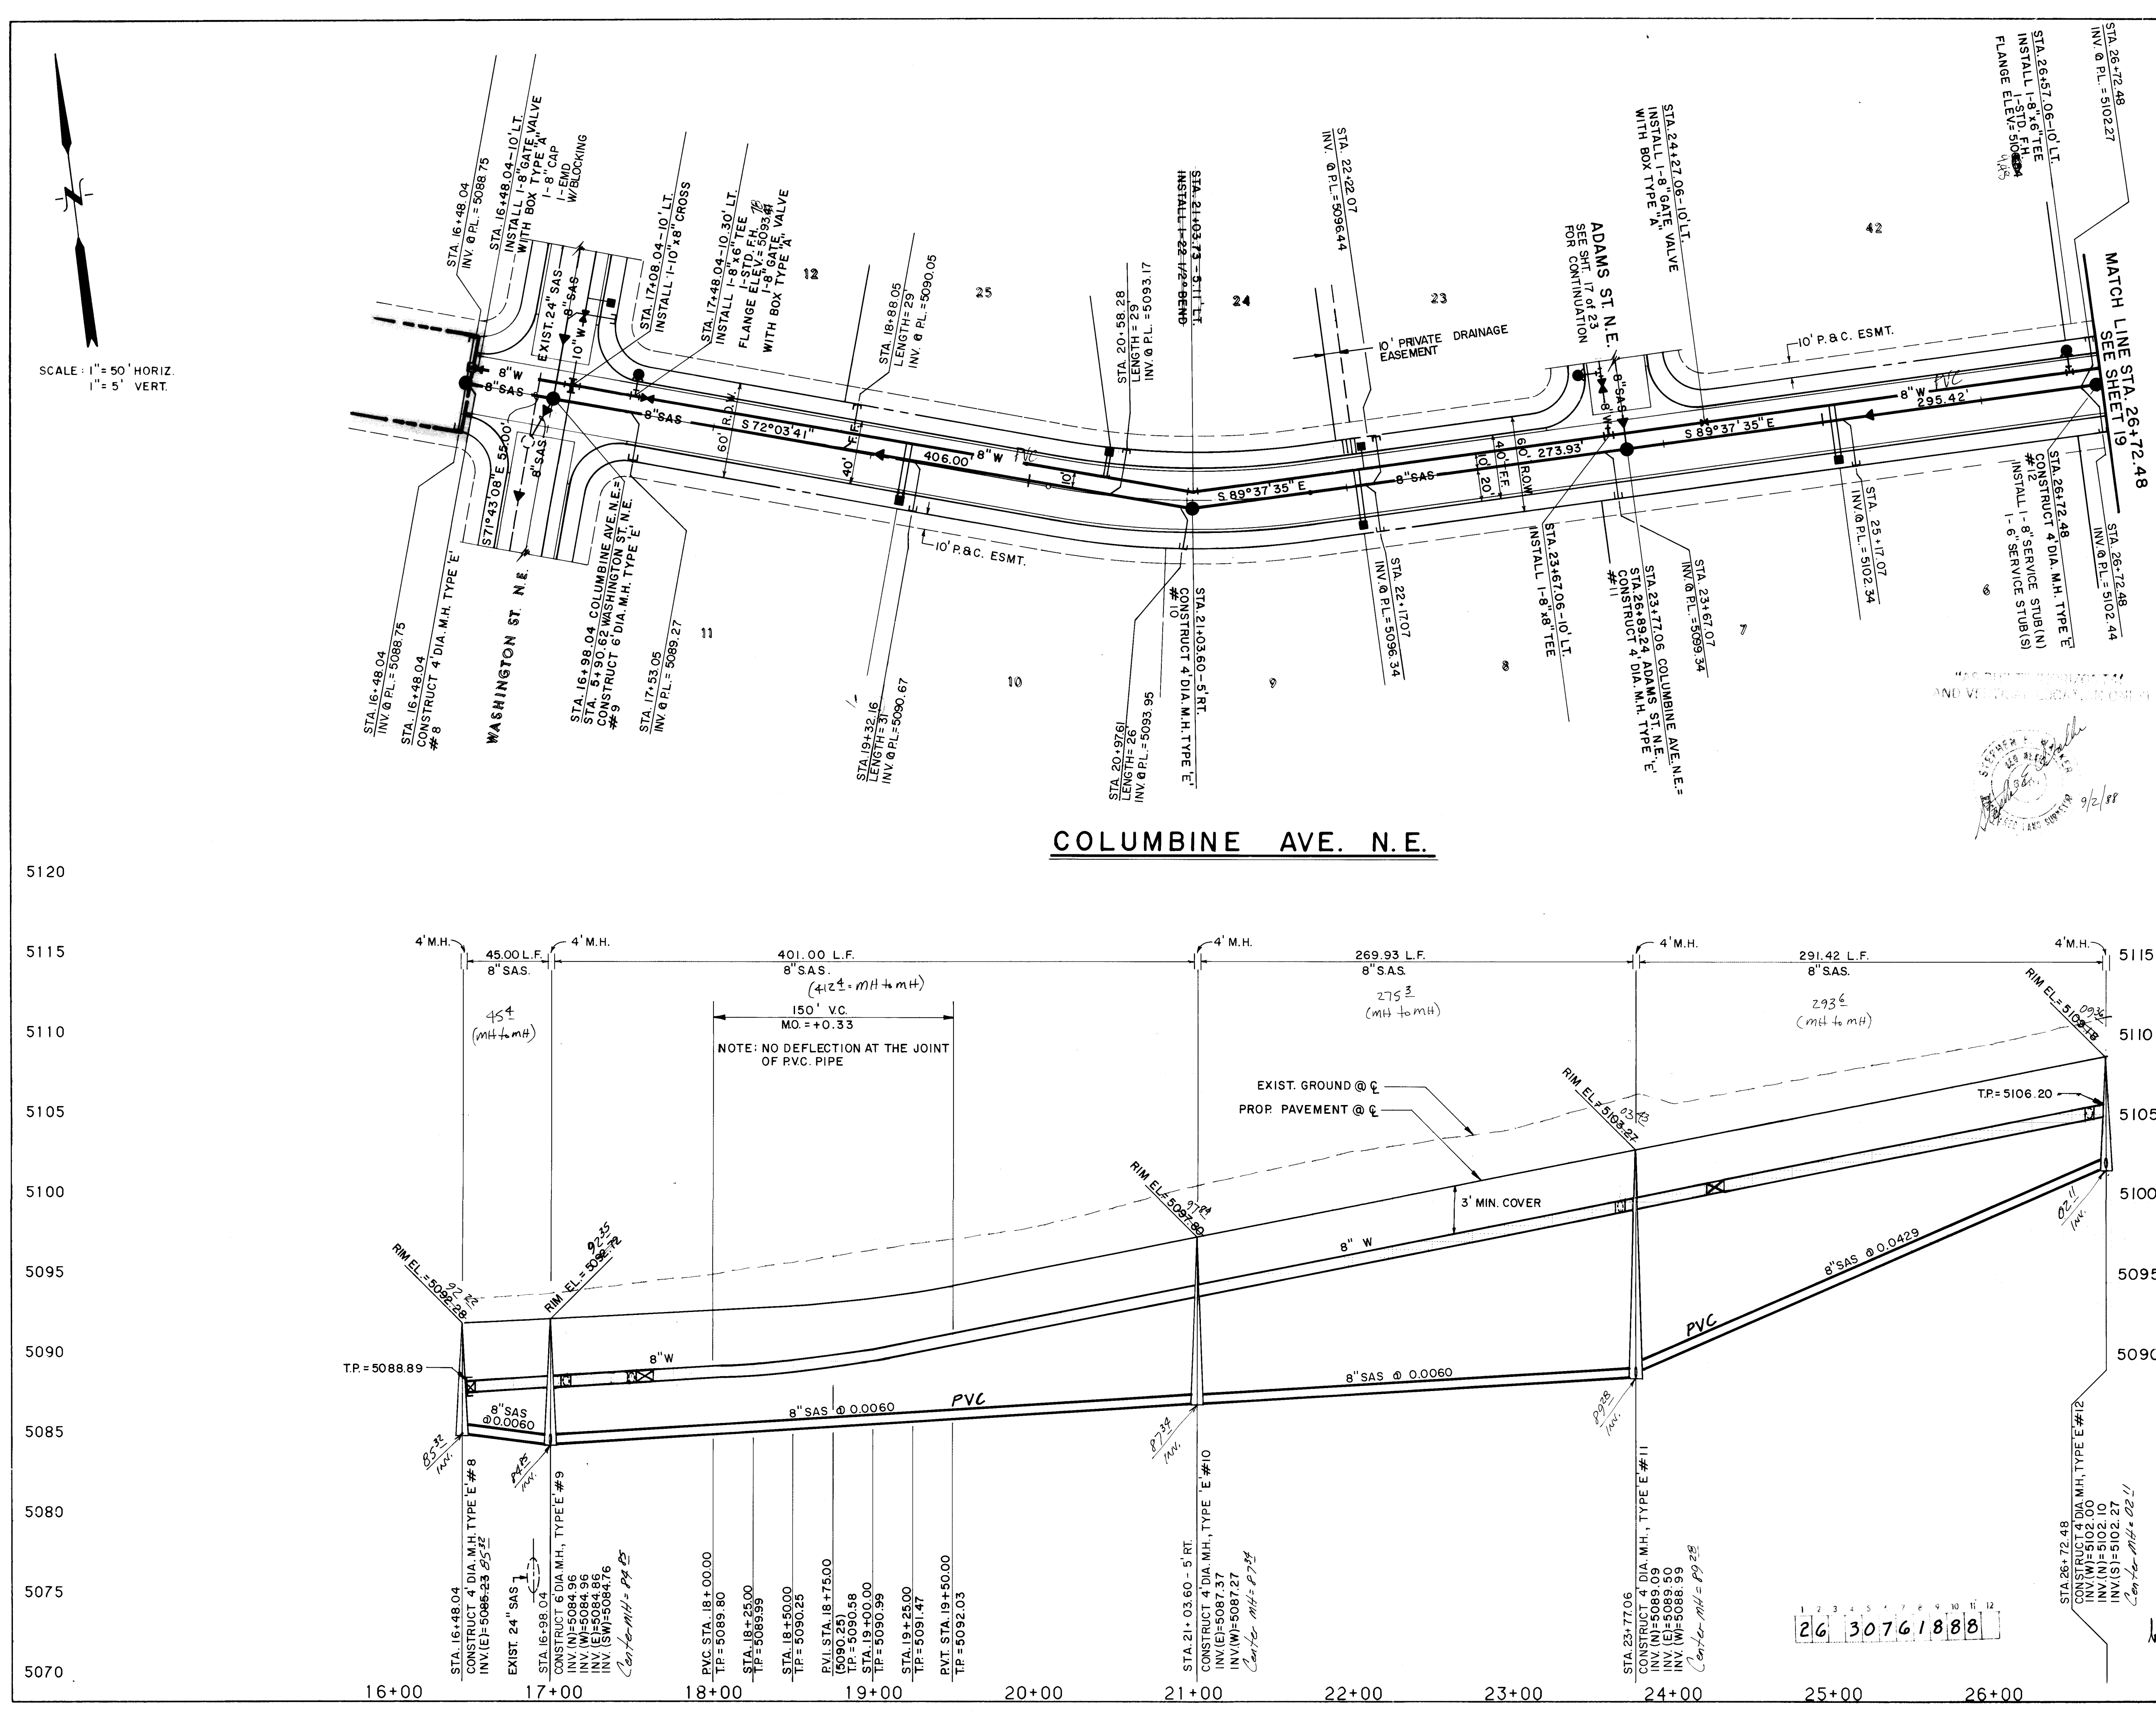

NOTES:

- UTILITY STATIONING IS BASED ON STREET CENTERLINE STATIONING EXCEPT WHERE NOTED OTHERWISE.
- THE FOLLOWING CITY OF ALBUQUERQUE STANDARD DRAWINGS ARE APPLICABLE TO THE WATER AND SANITARY SEWER CONSTRUCTION:
- SEWER SERVICE LENGTHS ARE 30' EXCEPT WHERE NOTED OTHERWISE.
- CONCRETE THRUST BLOCKING TO BE USED IN ALL CASES WHERE REQUIRED PER C.O.A. STD DWG 2320.
- CONTRACTOR TO FIELD VERIFY LOCATION OF ALL EXISTING UTILITIES.
- ADJUST RIMS TO PROPOSED ELEVATION.
- ALL FIRE HYDRANTS SHALL BE 4' BURY AS PER C.O.A. STD DWG 2340.

SANITARY SEWER SERVICES

LOT	STATION	LENGTH	INVERT	PIPE
28	16+48.04 RT.	30'	5088.75	PL
29	16+48.04 LT.	30'	5088.75	PL
11	17+53.05 RT.	30'	5089.27	8"
25	18+88.05 LT.	29'	5090.65	8"
11	19+32.16 RT.	30'	5090.67	8"
24	20+58.28 LT.	29'	5093.17	8"
24	20+97.61 RT.	26'	5093.95	8"
28	22+17.07 RT.	30'	5096.34	8"
28	22+22.07 LT.	30'	5096.44	8"
6	23+67.07 RT.	30'	5099.34	8"
6	25+17.07 RT.	30'	5102.34	8"
B-1	26+72.48 LT.	30'	5102.27	8"
C-1	26+72.48 RT.	30'	5102.44	8"

AS-BUILT INVERT

LEGEND

- PROPOSED PHASE BOUNDARY
- PROPOSED SINGLE WATER SERVICE - 1"
- PROPOSED DOUBLE WATER SERVICE - 1"
- PROPOSED WATERLINE
- EXISTING WATERLINE
- EXISTING STORM DRAIN
- PROPOSED FIRE HYDRANT
- EXISTING FIRE HYDRANT
- PROPOSED GATE VALVE
- EXISTING GATE VALVE
- PROPOSED REDUCER
- PROPOSED BUTTERFLY VALVE
- PROPOSED CAP
- EXISTING CAP
- PROPOSED CROSS
- PROPOSED TEE
- PROPOSED 90° BEND
- PROPOSED 45° BEND
- EXISTING CROSS
- PROPOSED SIDEWALK
- PROPOSED CURB & GUTTER
- PROPOSED SANITARY SEWER MANHOLE
- 8" SAS - PROPOSED SANITARY SEWER LINE
- PROPOSED SAS SERVICE - 4"
- EXISTING SAS MANHOLE
- SAS - EXISTING SAS LINE

ESPEY, HUSTON & ASSOCIATES, INC.
Engineering & Environmental Consultants
317 COMMERCIAL ST. N.E.
ALBUQUERQUE, NEW MEXICO 87102
PHONE: (505) 242-1909

CITY OF ALBUQUERQUE
PUBLIC WORKS DEPARTMENT
ENGINEERING DIVISION

TITLE: RICHFIELD PARK - PHASE I
COLUMBINE AVE. N.E.
SANITARY SEWER & WATER PLAN & PROFILE
STA 16+48.04 TO 26+72.48

APPROVALS	ENGINEER	DATE	APPROVALS	ENGINEER	DATE
City Engineer	LLH	2/11/89	Liquid Waste	W. H. H.	1/2/88
A.C.E. - Design	"	"	Traffic	PER	1/2/88
A.C.E. - Hydrology	N/A RAB	1-20-89	Water	W. H. H.	1/2/88


DESIGNED BY	D.A.L.	DATE	9/86
DRAWN BY	S.F.B.	DATE	9/86
CHECKED BY	D.L.	DATE	11/86

DRAWING NO. 3076 MAP NO. C-17 SHEET 18 OF 23

SCALE: 1"=50' HORIZ.
1"=5' VERT.

	DELTA	RADIUS	LENGTH	TAN	°DEFL./20' LENGTH
1.	36°58'04"	370.00'	238.73'	123.69'	03°05'40"
2.	36°58'04"	390.00'	251.63'	130.37'	02°56'20"

COLUMBINE AVE. N.E.

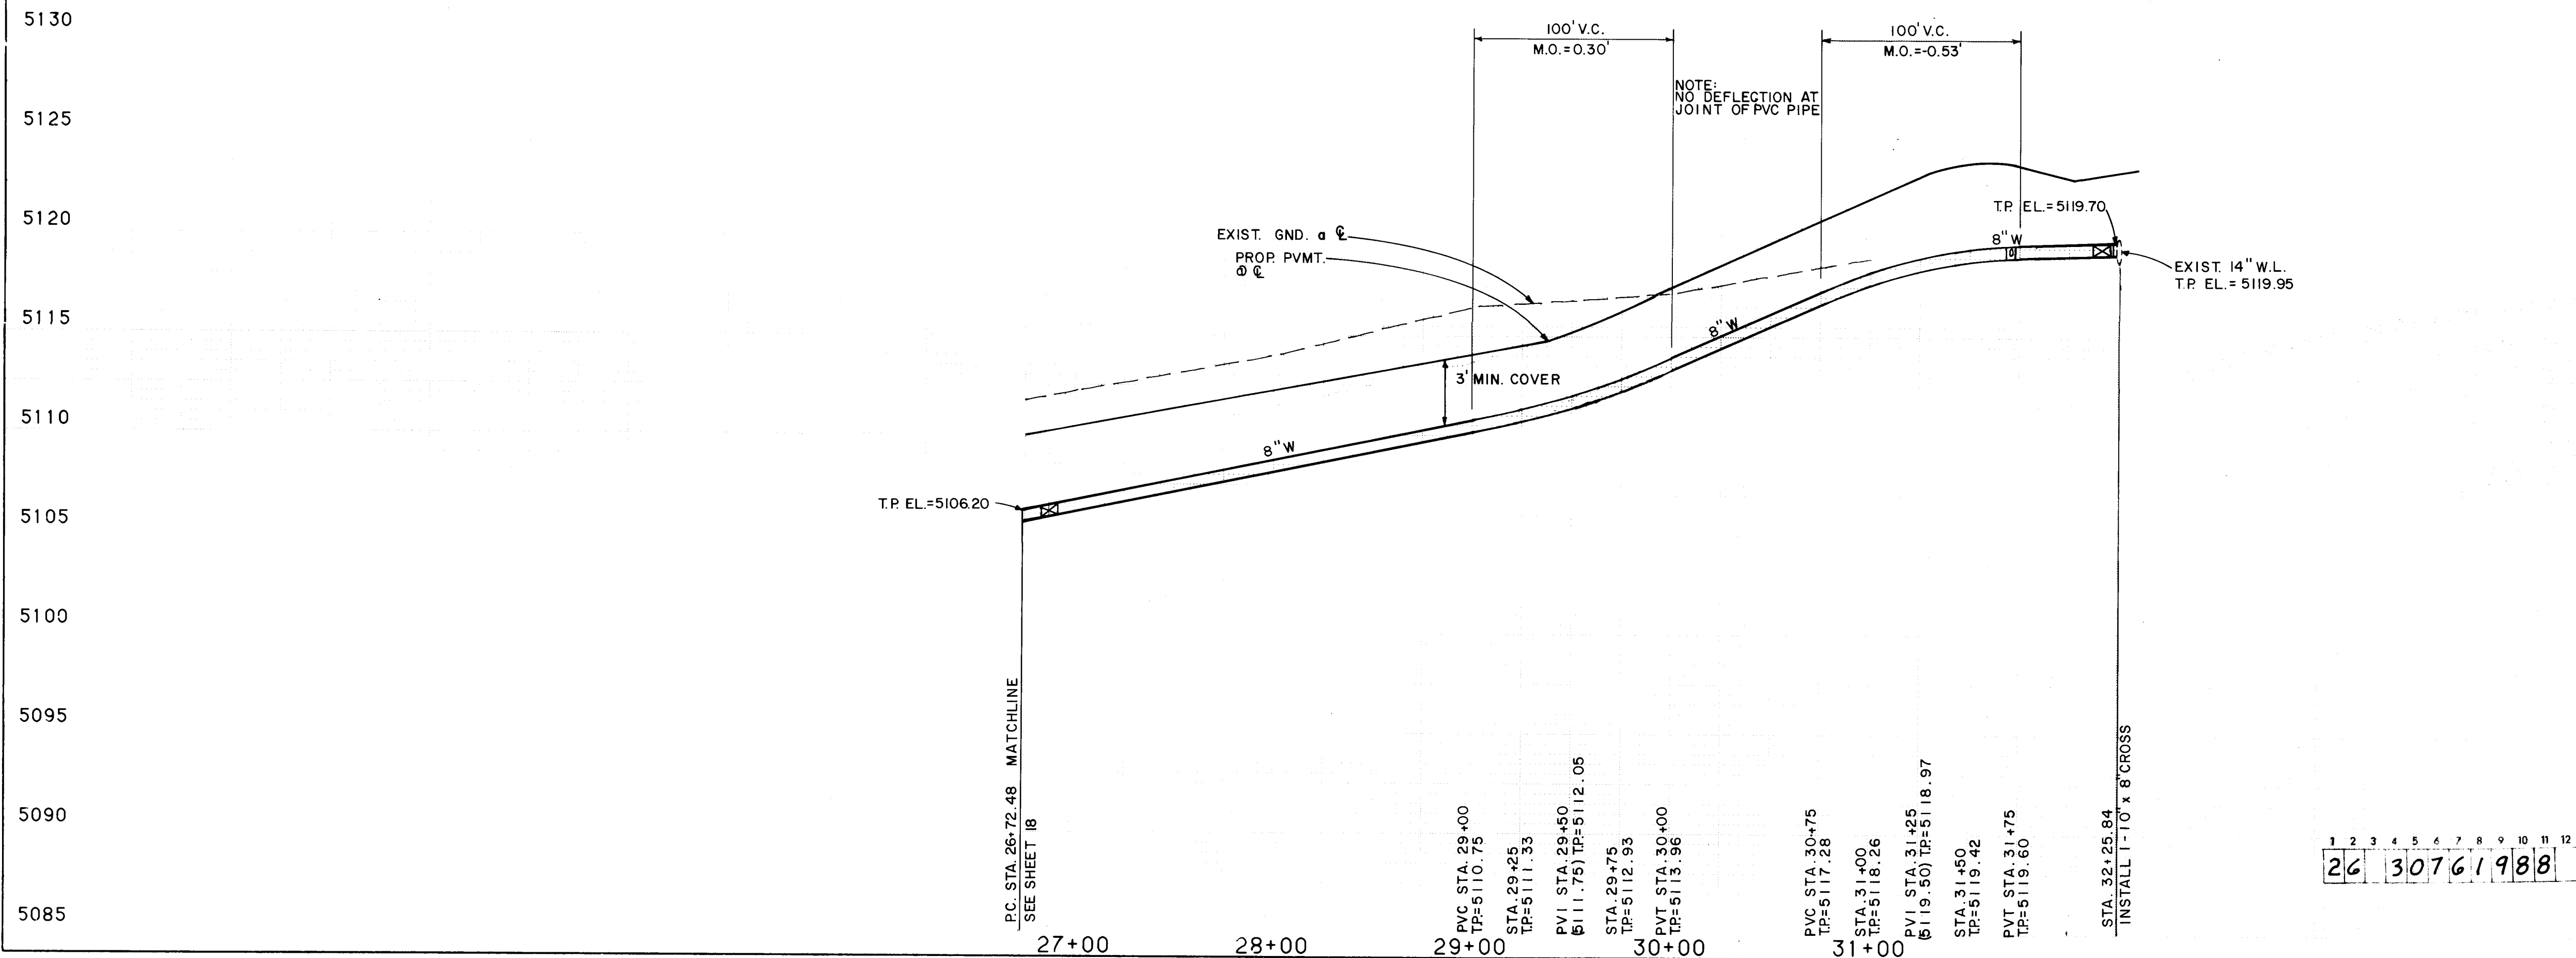

NOTES:

- UTILITY STATIONING IS BASED ON STREET CENTERLINE STATIONING EXCEPT WHERE NOTED OTHERWISE.
- THE FOLLOWING CITY OF ALBUQUERQUE STANDARD DRAWINGS ARE APPLICABLE TO THE WATER AND SANITARY SEWER CONSTRUCTION:

2102	2136	2325	2333	2360	2368
2110	2145	2326	2340	2361	2369
2118	2301	2328	2344	2363	
2125	2315	2332	2347	2367	
- SEWER SERVICE LENGTHS ARE 30' EXCEPT WHERE NOTED OTHERWISE.
- CONCRETE THRUST BLOCKING TO BE USED IN ALL CASES WHERE REQUIRED PER C.O.A. STD DWG 2320.
- CONTRACTOR TO FIELD VERIFY LOCATION OF ALL EXISTING UTILITIES.
- ADJUST RIMS TO PROPOSED ELEVATION.
- ALL FIRE HYDRANTS SHALL BE 4' BURY. AS PER C.O.A. STD. DWG 2340

"AS BUILT" (HORIZONTAL AND VERTICAL LOCATION ONLY)

LEGEND

- PROPOSED WATER SERVICE
- EXISTING WATER SERVICE
- PROPOSED WATERLINE
- EXISTING WATERLINE
- EXISTING STORM DRAIN
- PROPOSED FIRE HYDRANT
- EXISTING FIRE HYDRANT
- PROPOSED GATE VALVE
- EXISTING GATE VALVE
- PROPOSED REDUCER
- PROPOSED BUTTERFLY VALVE
- PROPOSED CAP
- EXISTING CAP
- PROPOSED CROSS
- PROPOSED TEE
- PROPOSED 90° BEND
- PROPOSED 45° BEND
- EXISTING CROSS
- PROPOSED SIDEWALK
- PROPOSED CURB & GUTTER
- EXISTING MANHOLE
- 8" SAS - EXISTING SANITARY SEWER LINE


ESPEY,
HUSTON &
ASSOCIATES, INC.
Engineering & Environmental Consultants
317 COMMERCIAL ST. N.E.
ALBUQUERQUE, NEW MEXICO 87102
PHONE: (505) 242-1909

CITY OF ALBUQUERQUE
PUBLIC WORKS DEPARTMENT
ENGINEERING DIVISION

TITLE: RICHFIELD PARK - PHASE I
COLUMBINE AVE. N.E.
WATER PLAN & PROFILE
STA 26+72.48 TO 32+25.84


APPROVALS	ENGINEER	DATE	APPROVALS	ENGINEER	DATE
City Engineer	ALH	6/11/88	Liquid Waste	ALH	6/20/88
A.C.E. - Design	"	"	Traffic	REL	6/20/88
A.C.E. - Hydrology	W.A. RAY	6-20-88	Water	ALH	6-20-88

DRAWING NO. 3076 MAP NO. C-17 SHEET 19 OF 23

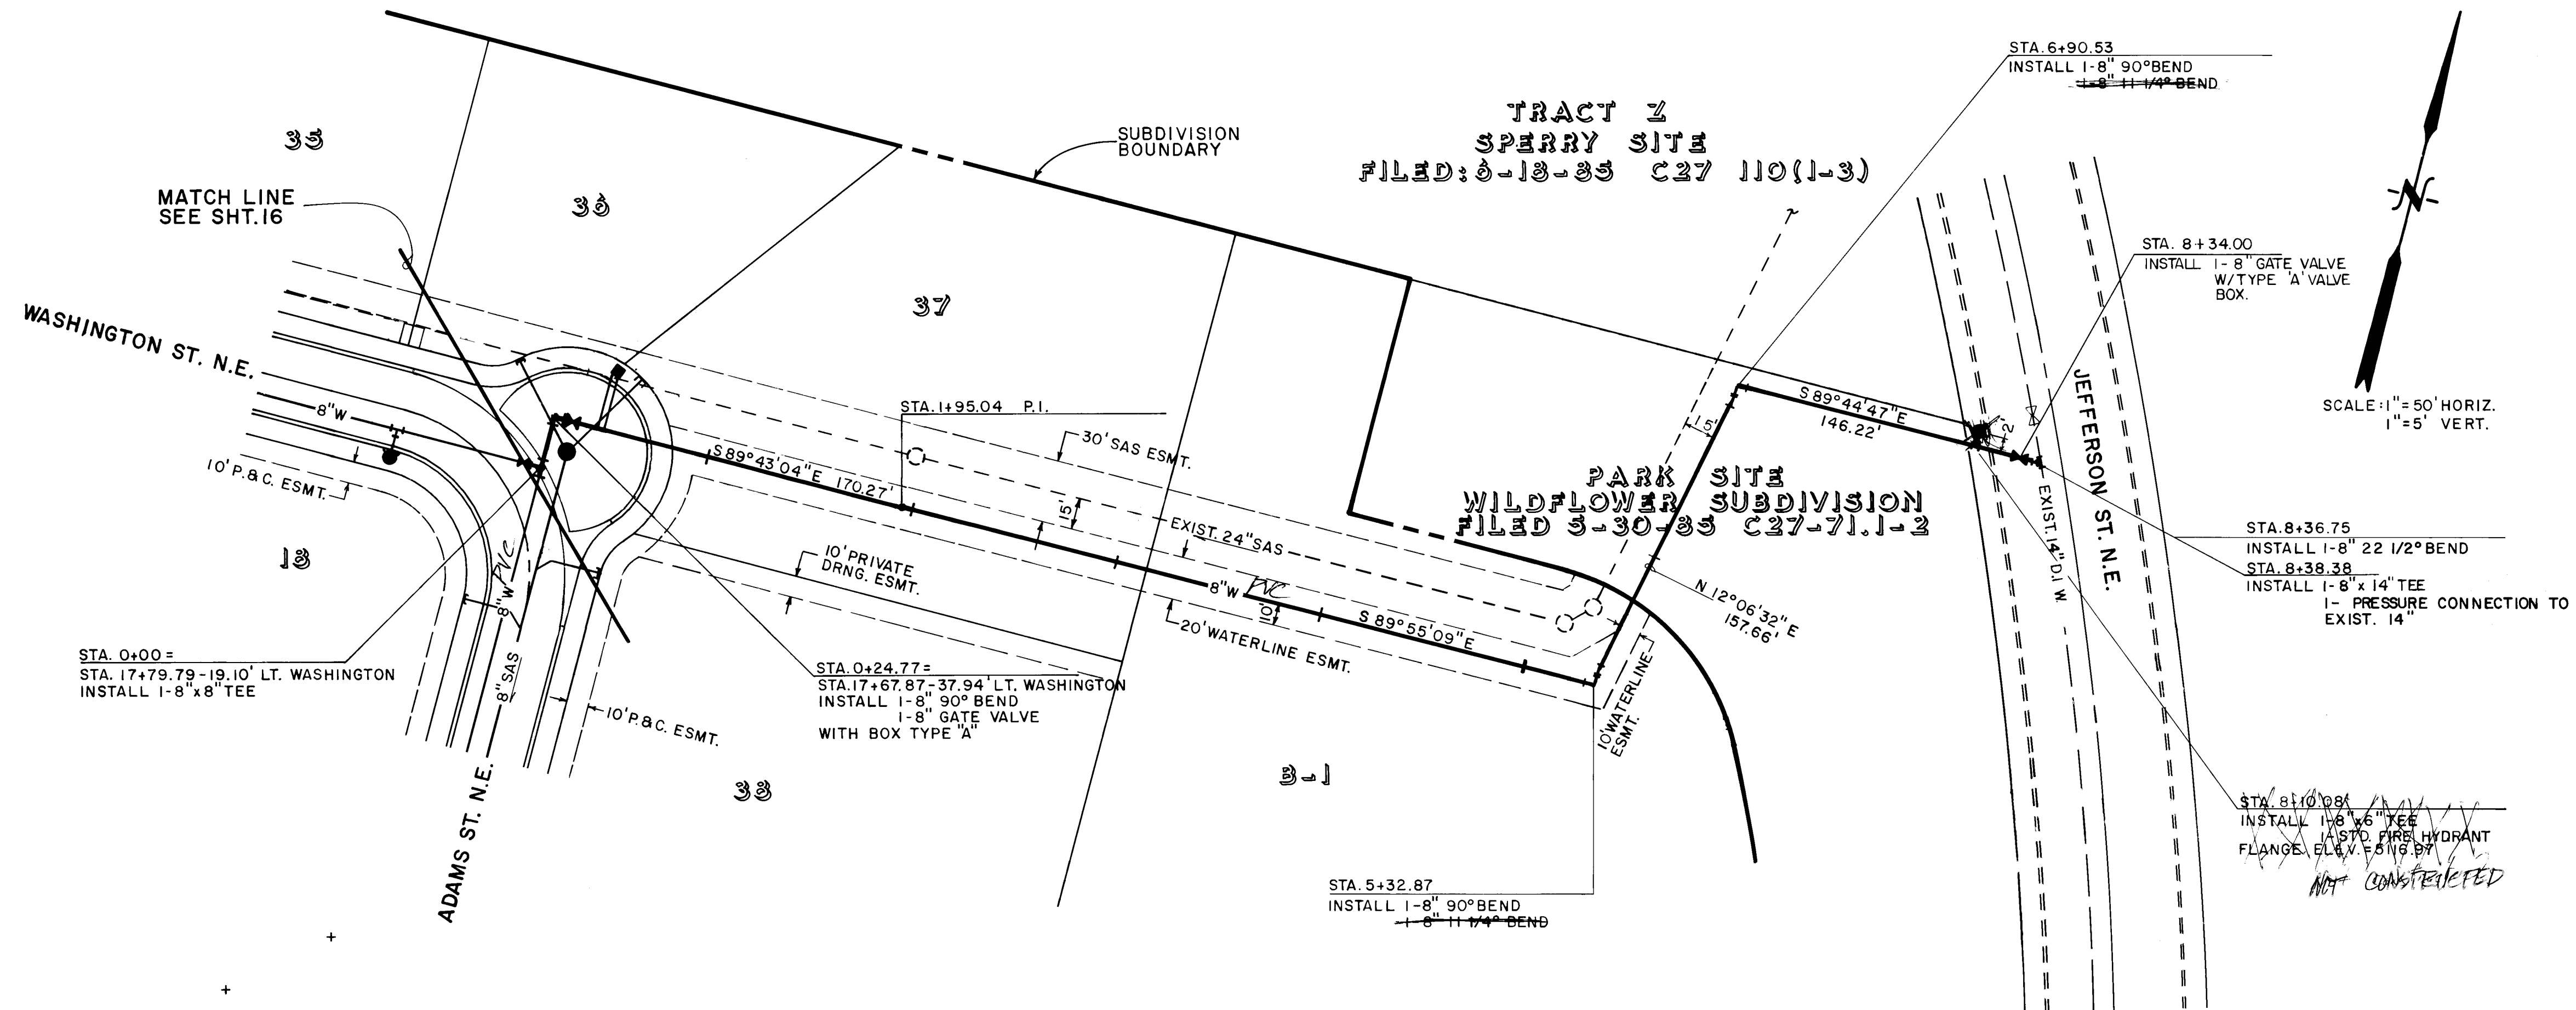

OFFSITE WATERLINE

5120
5115
5110
5105
5100
5095

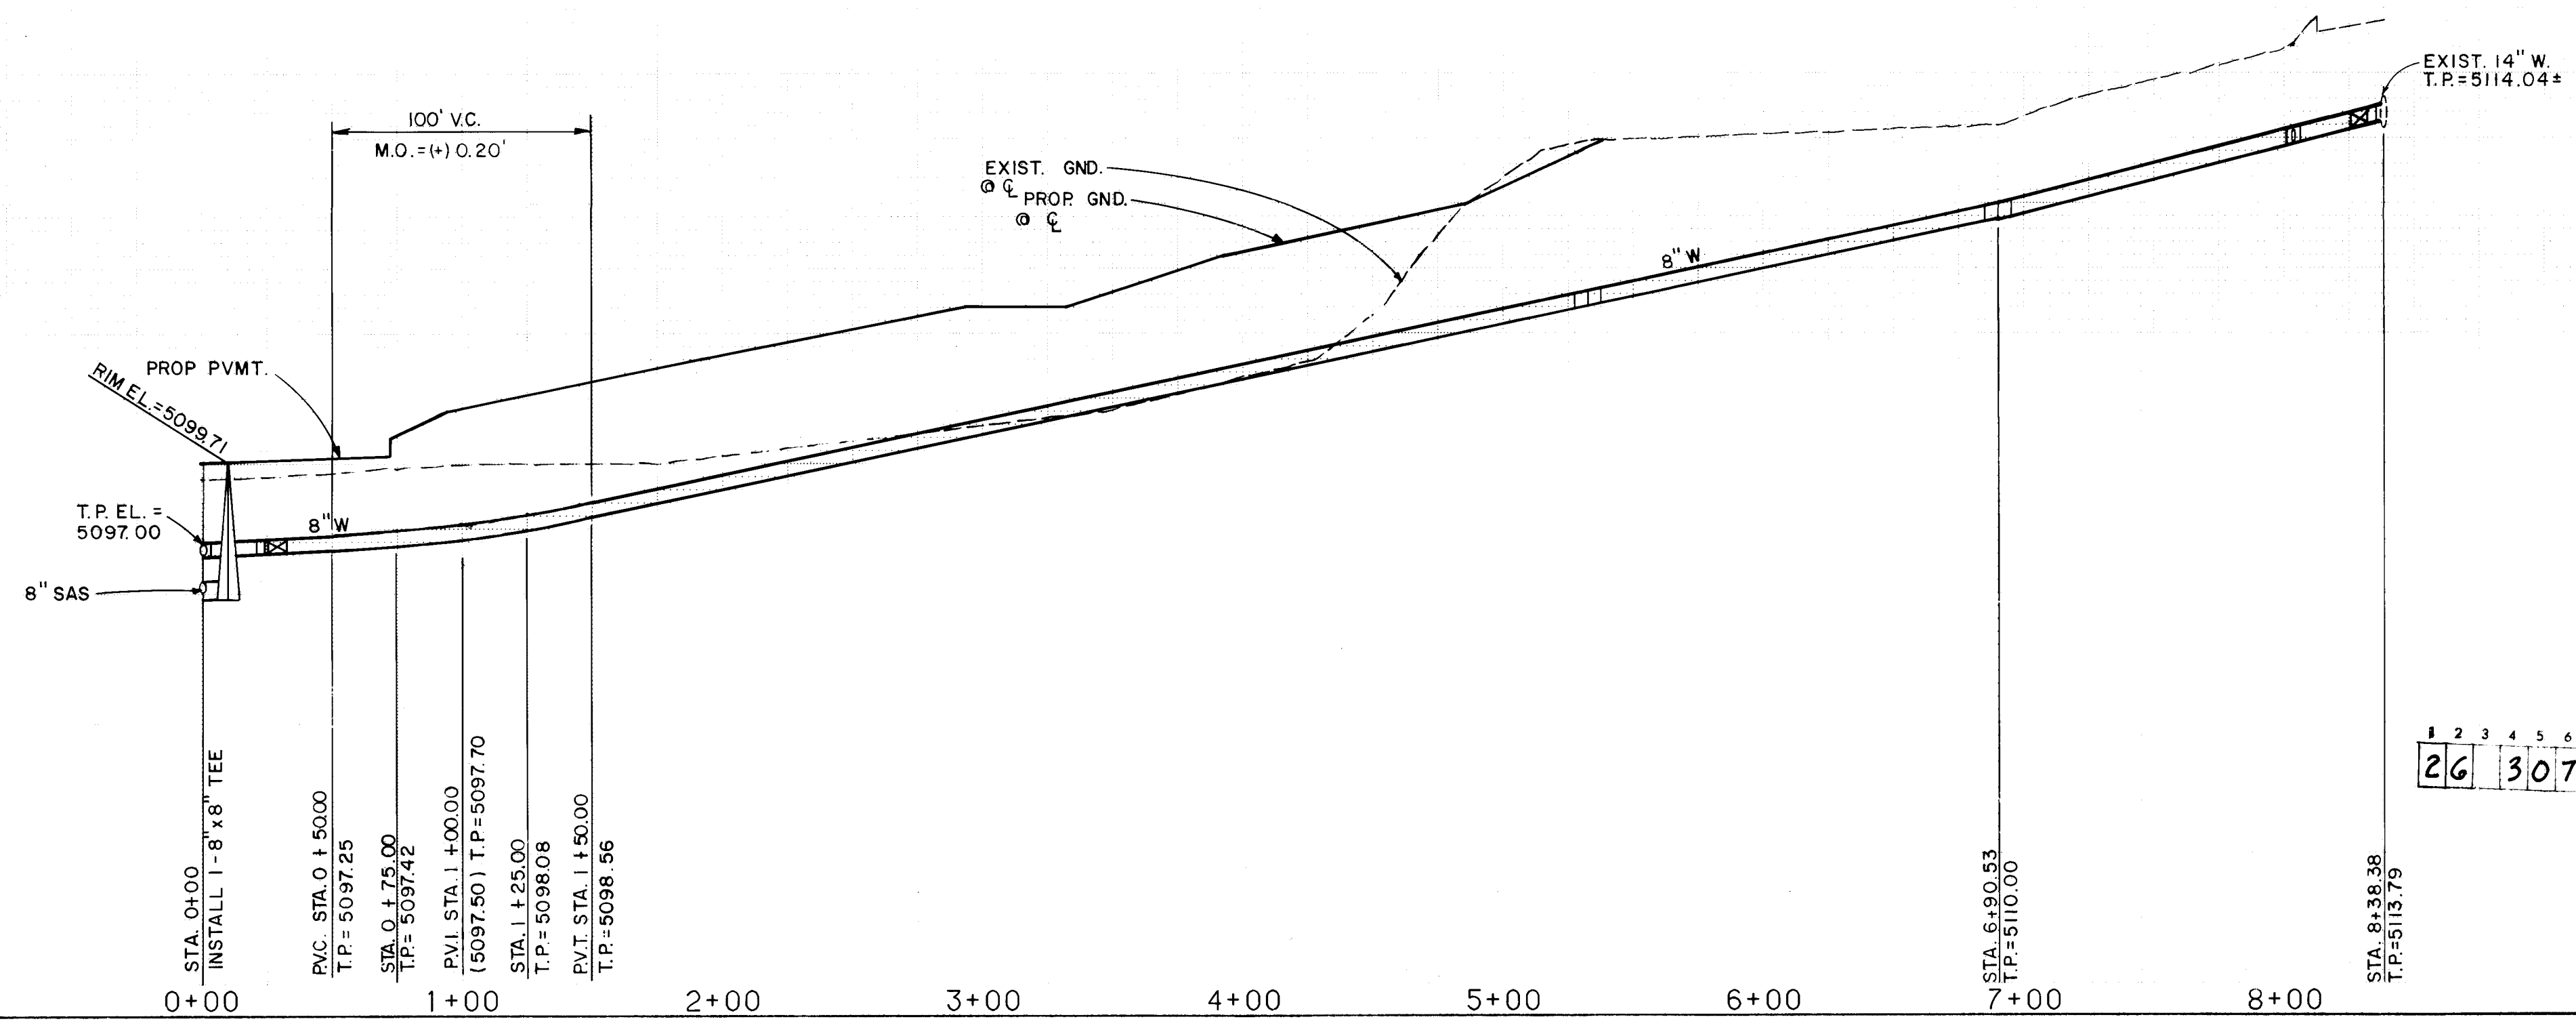

NOTES:

- UTILITY STATIONING IS BASED ON STREET CENTERLINE STATIONING EXCEPT WHERE NOTED OTHERWISE.
- THE FOLLOWING CITY OF ALBUQUERQUE STANDARD DRAWINGS ARE APPLICABLE TO THE WATER AND SANITARY SEWER CONSTRUCTION:

2102	2136	2325	2333	2360	2368
2110	2145	2326	2340	2361	2369
2118	2301	2328	2344	2363	
2125	2315	2332	2347	2367	
- SEWER SERVICE LENGTHS ARE 30' EXCEPT WHERE NOTED OTHERWISE.
- CONCRETE THRUST BLOCKING TO BE USED IN ALL CASES WHERE REQUIRED PER C.O.A. STD DWG 2320.
- CONTRACTOR TO FIELD VERIFY LOCATION OF ALL EXISTING UTILITIES.
- ADJUST RIMS TO PROPOSED ELEVATION.
- ALL FIRE HYDRANTS SHALL BE 4' BURY. PER C.O.A. STD. DWG. 2340

"AS BUILT" (HORIZONTAL AND VERTICAL LOCATION ONLY)

LEGEND

8" SAS	PROPOSED 4" SAS LINE
1" PROPOSED SGL. WATER SERVICE	
1" PROPOSED DBL. WATER SERVICE	
PROPOSED WATERLINE	
EXISTING WATERLINE	
EXISTING STORM DRAIN	
PROPOSED FIRE HYDRANT	
EXISTING FIRE HYDRANT	
PROPOSED GATE VALVE	
EXISTING GATE VALVE	
PROPOSED REDUCER	
PROPOSED BUTTERFLY VALVE	
PROPOSED CAP	
EXISTING CAP	
PROPOSED CROSS	
PROPOSED TEE	
PROPOSED 90° BEND	
PROPOSED 11 1/4° BEND	
PROPOSED 22 1/2° BEND	
PROPOSED SAS SERVICE 4"	
PROPOSED CURB & GUTTER	
EXISTING SANITARY SEWER MANHOLE	
8" SAS	EXISTING SANITARY SEWER LINE
PROPOSED SANITARY SEWER MANHOLE	

ESPEY, HUSTON & ASSOCIATES, INC.
Engineering & Environmental Consultants
317 COMMERCIAL ST. N.E.
ALBUQUERQUE, NEW MEXICO 87102
PHONE: (505) 242-1909

CITY OF ALBUQUERQUE
PUBLIC WORKS DEPARTMENT
ENGINEERING DIVISION

TITLE: RICHFIELD PARK - PHASE I
OFFSITE WATER PLAN & PROFILE
STA. 0+00 TO 8+38.38

APPROVALS	ENGINEER	DATE	APPROVALS	ENGINEER	DATE
City Engineer	[Signature]	2/11/88	Liquid Waste	[Signature]	2/24/88
A.C.E. - Design			Traffic	[Signature]	1/24/88
A.C.E. - Hydrology		1-20-88	Water	[Signature]	1/24/88

DRAWING NO. 3076 MAP NO. C-17 SHEET 20 OF 23

AS BUILT INFORMATION

BEACH MARKS

The Station is Located 7.5 Miles NE of Downtown, And 0.3 Miles N. of The Intersection of Los Angeles Boulevard And Washington Street NE. To Reach The Station From The Intersection of Los Angeles Blvd. And 2nd St., Go East On Los Angeles Blvd. 1.63 Miles To Intersection With Washington St. NE, Then N. On Washington St. NE. 0.3 Miles To The Station On Left West Side of The Street. The Station Mark is A Standard ACS Brass Tablet, Stamped "3-C17, 1975, Cemented in A Drill Hole in Top of Concrete Curb. Elev. 5110.29

DATE 9/2/88





1-12-88



* AT LEAST 30% OF ALL STONES BY WEIGHT MUST BE THIS SIZE.



2. CONTRACTOR SHALL NOTIFY AMAFCA FIELD ENGINEER 48 HOURS PRIOR TO ANY WORK WITHIN AMAFCA R.O.W.

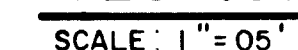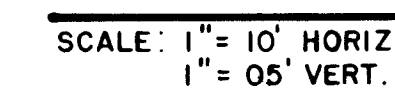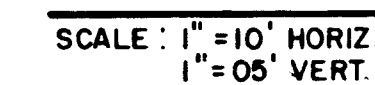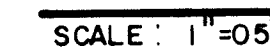

Sieve Size	% by Weight
2"	90 - 100
1-1/2"	-
3/4"	20 - 90
3/8"	-
#4	0 - 20
#16	-
#50	-
#100	-
#200	0-3


CITY OF ALBUQUERQUE

APPROVALS	ENGINEER	DATE	APPROVALS	ENGINEER	DATE
City Engineer	<i>[Signature]</i>	2/11/88	Liquid Waste	<i>[Signature]</i>	1/20/88
A.C.E. - Design	<i>[Signature]</i>	1/20/88	Traffic	<i>[Signature]</i>	1/20/88
A.C.E. - Hydrology	<i>[Signature]</i>	1-20-88	Water	<i>[Signature]</i>	1/20/88


DRAWING NO.	3076	MAP NO.	C-17	SHEET	21	OF	23
-------------	------	---------	------	-------	----	----	----




REVISIONS			
DESIGN			
DESIGNED BY	D.A.L.	DATE	10/86
DRAWN BY	E.L.S., M.E.C.	DATE	10/86
CHECKED BY	D.L.	DATE	11/86

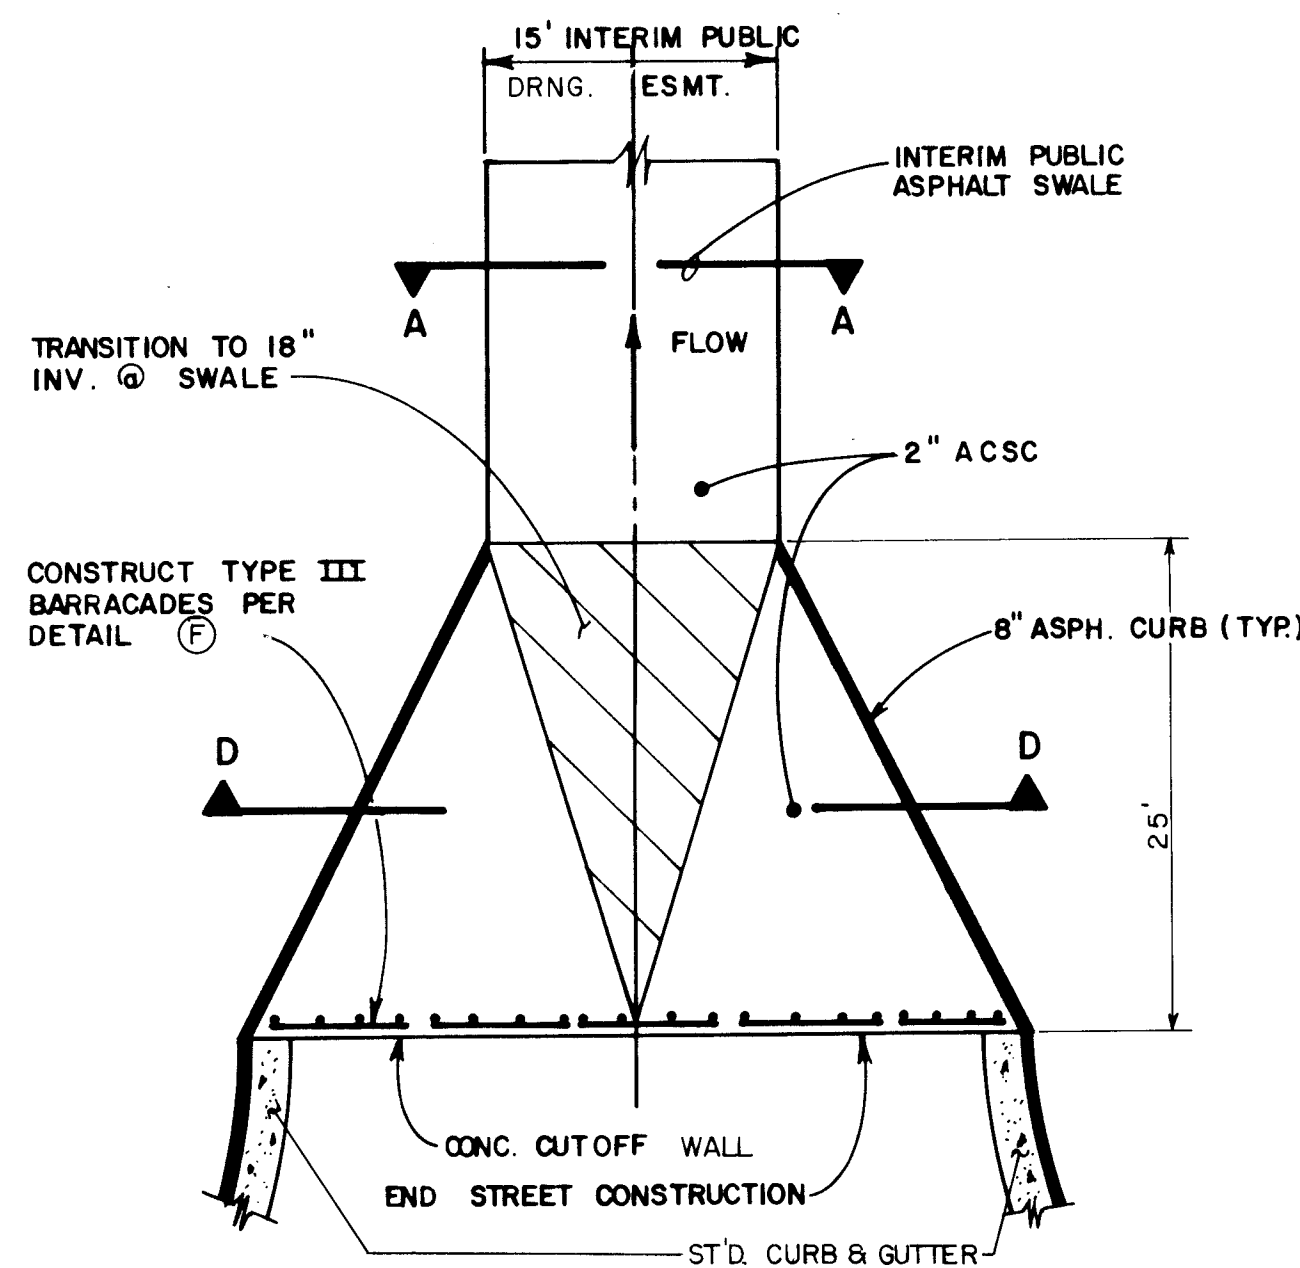


DRAINAGE SWALE TRANSITION
SCALE: 1" = 10'

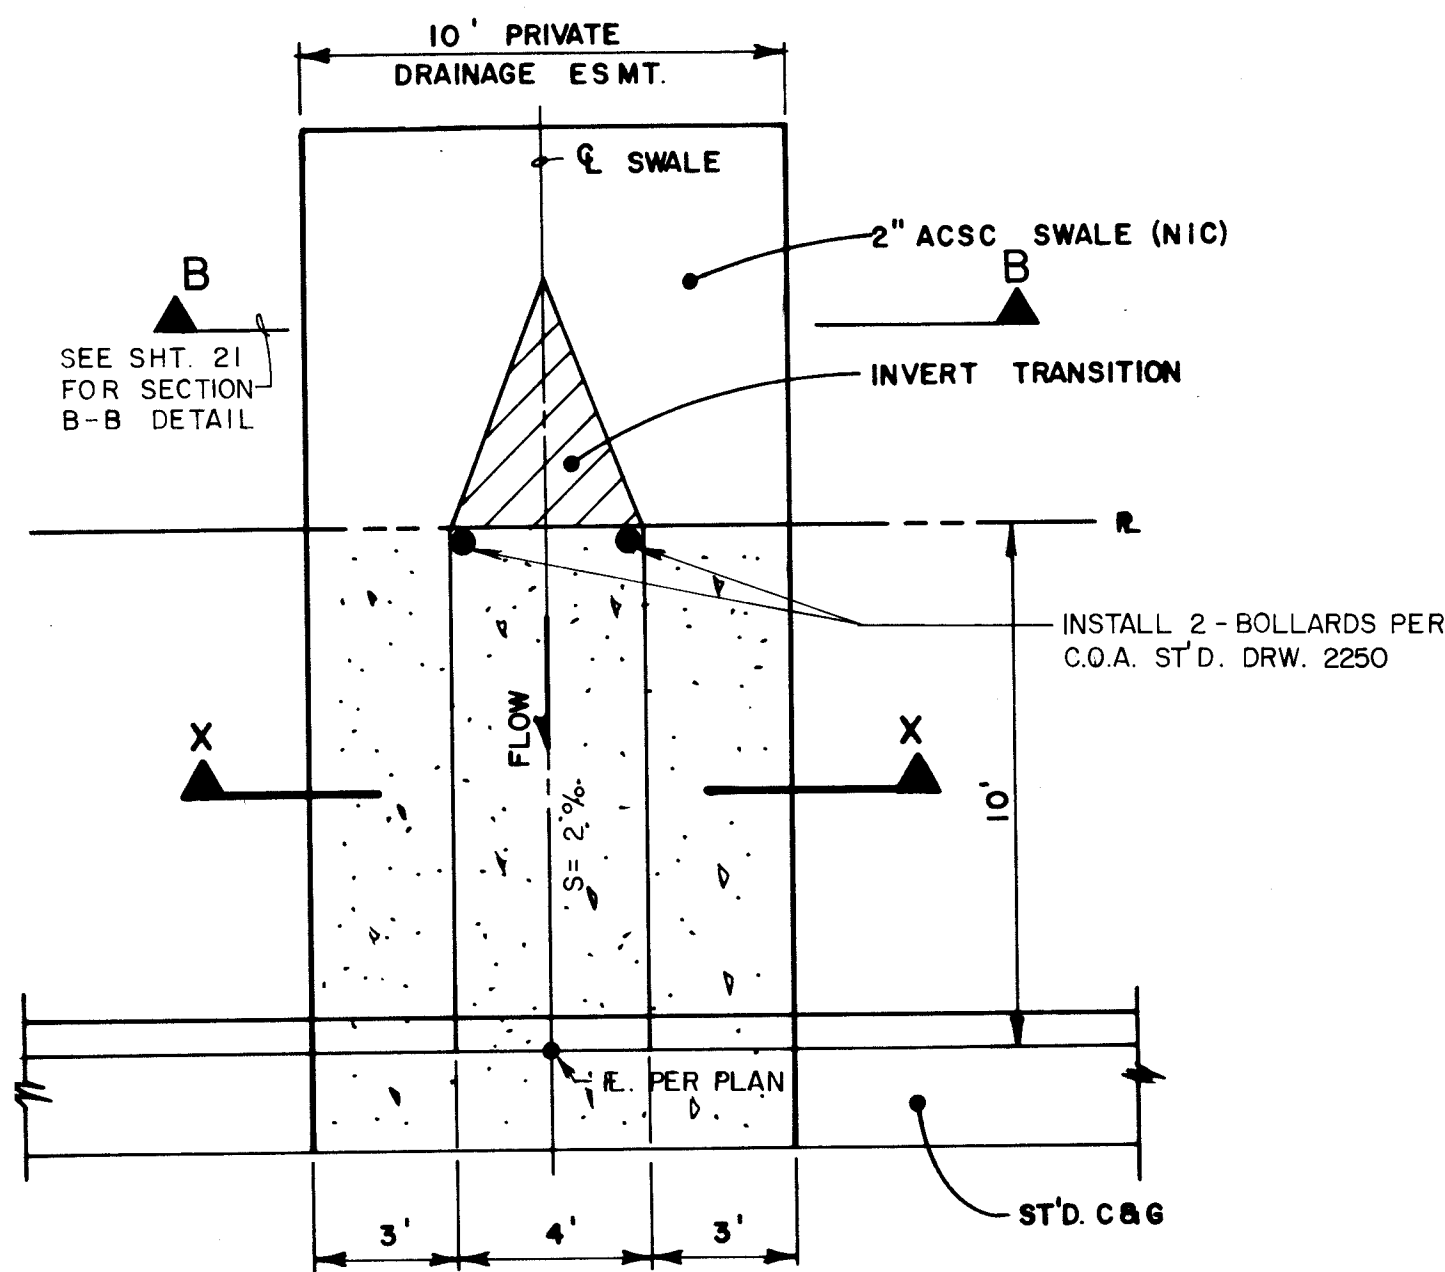


PRIVATE SWALE RUN DOWN
SCALE: 1" = 04'

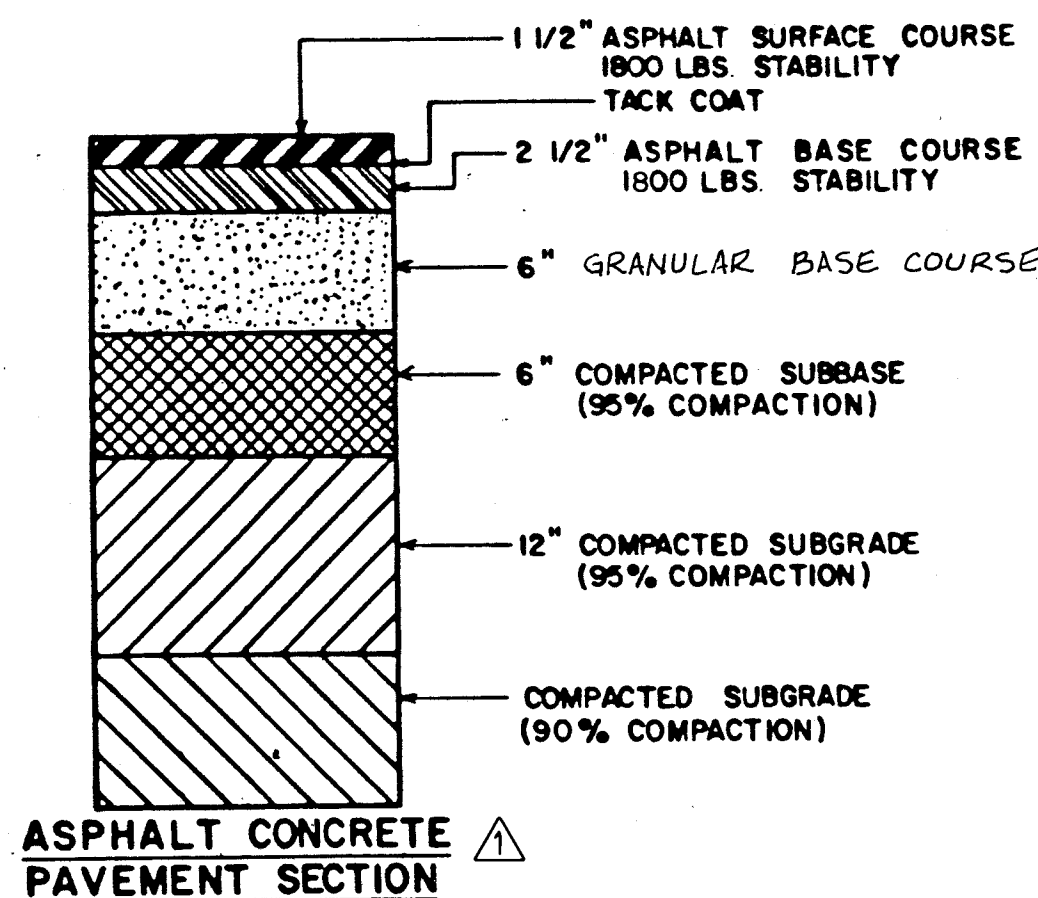


SCALE: 1" = 1' VERT.

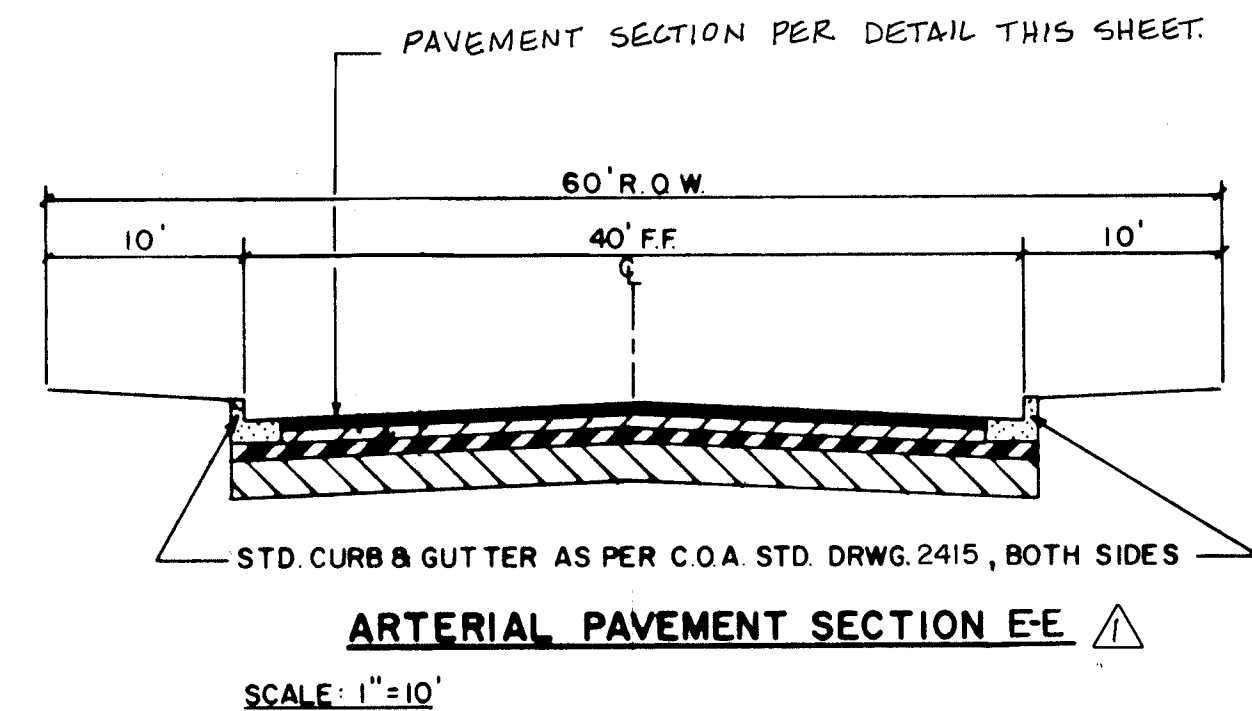


ARTERIAL PAVEMENT SECTION E-E

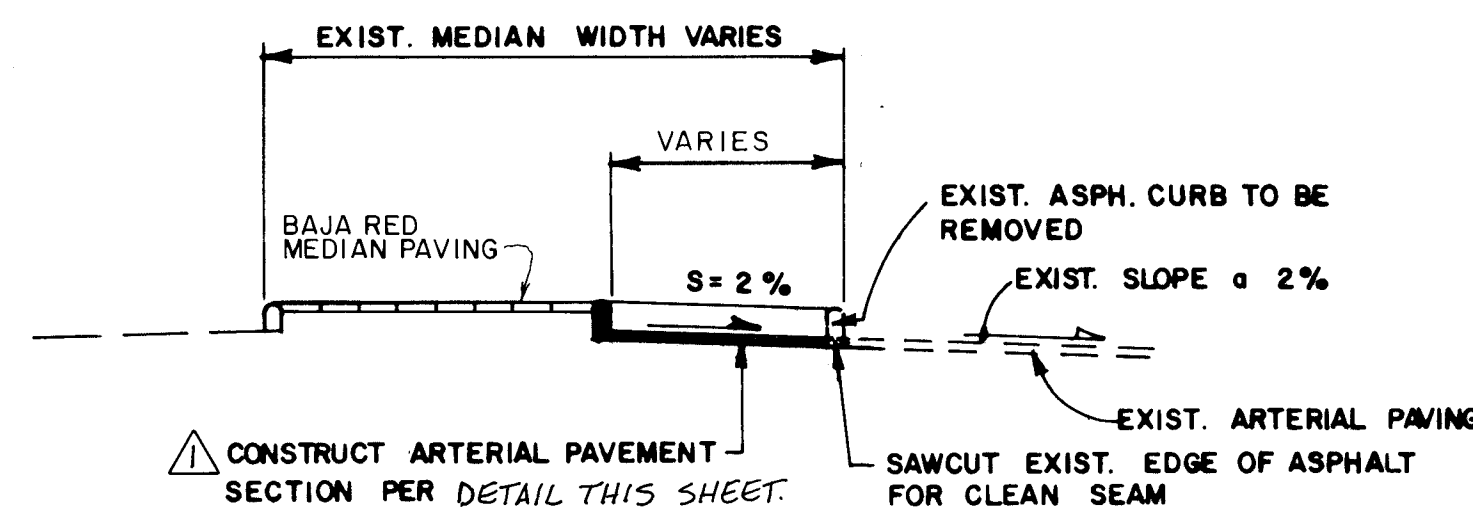


MEDIAN SECTION G-G
SCALE: 1" = 10' HORIZ. 1" = 05' VERT.

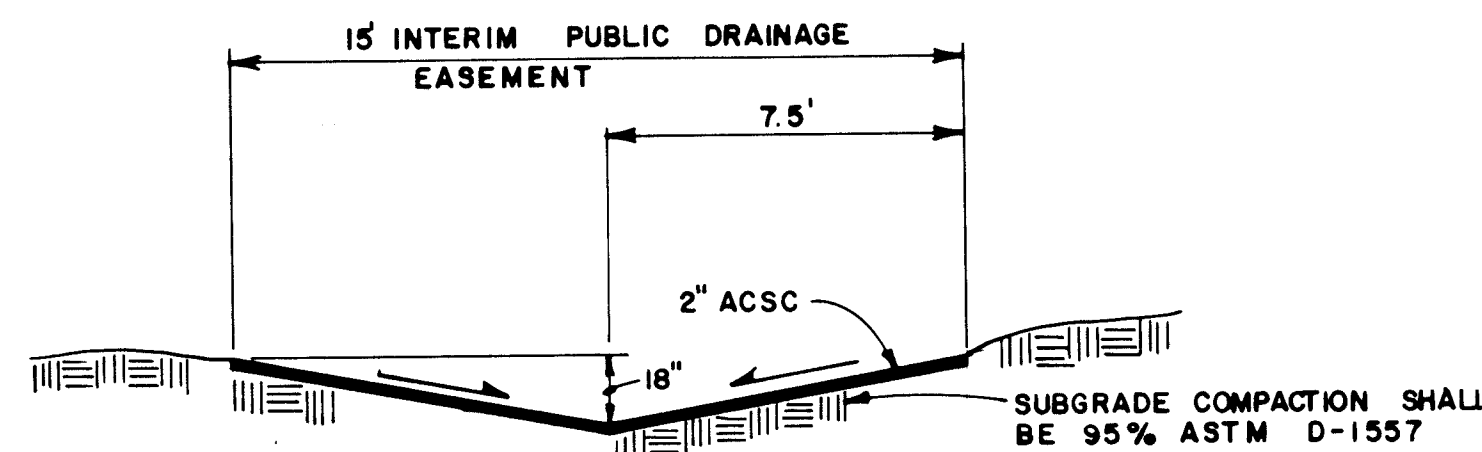


PUBLIC SWALE SECTION A-A
SCALE: 1" = 04' HORIZ. 1" = 05' VERT.

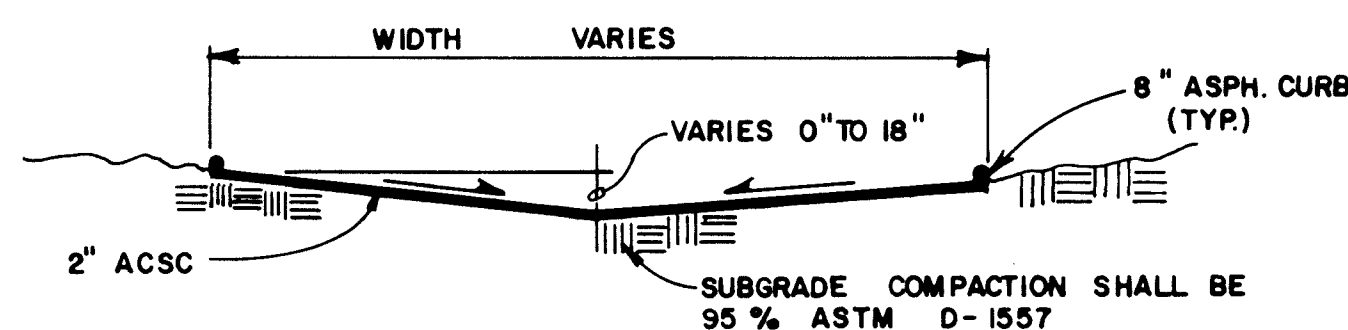


TRANSITION SECTION D-D
SCALE: 1" = 10' HORIZ. 1" = 05' VERT.

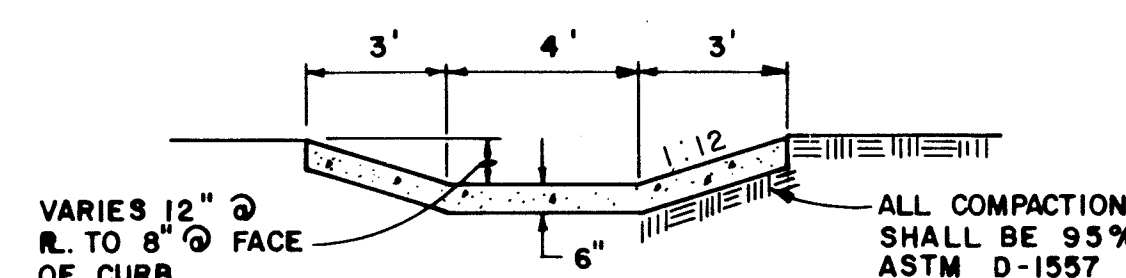


RUN DOWN SECTION X-X
SCALE: 1" = 04'

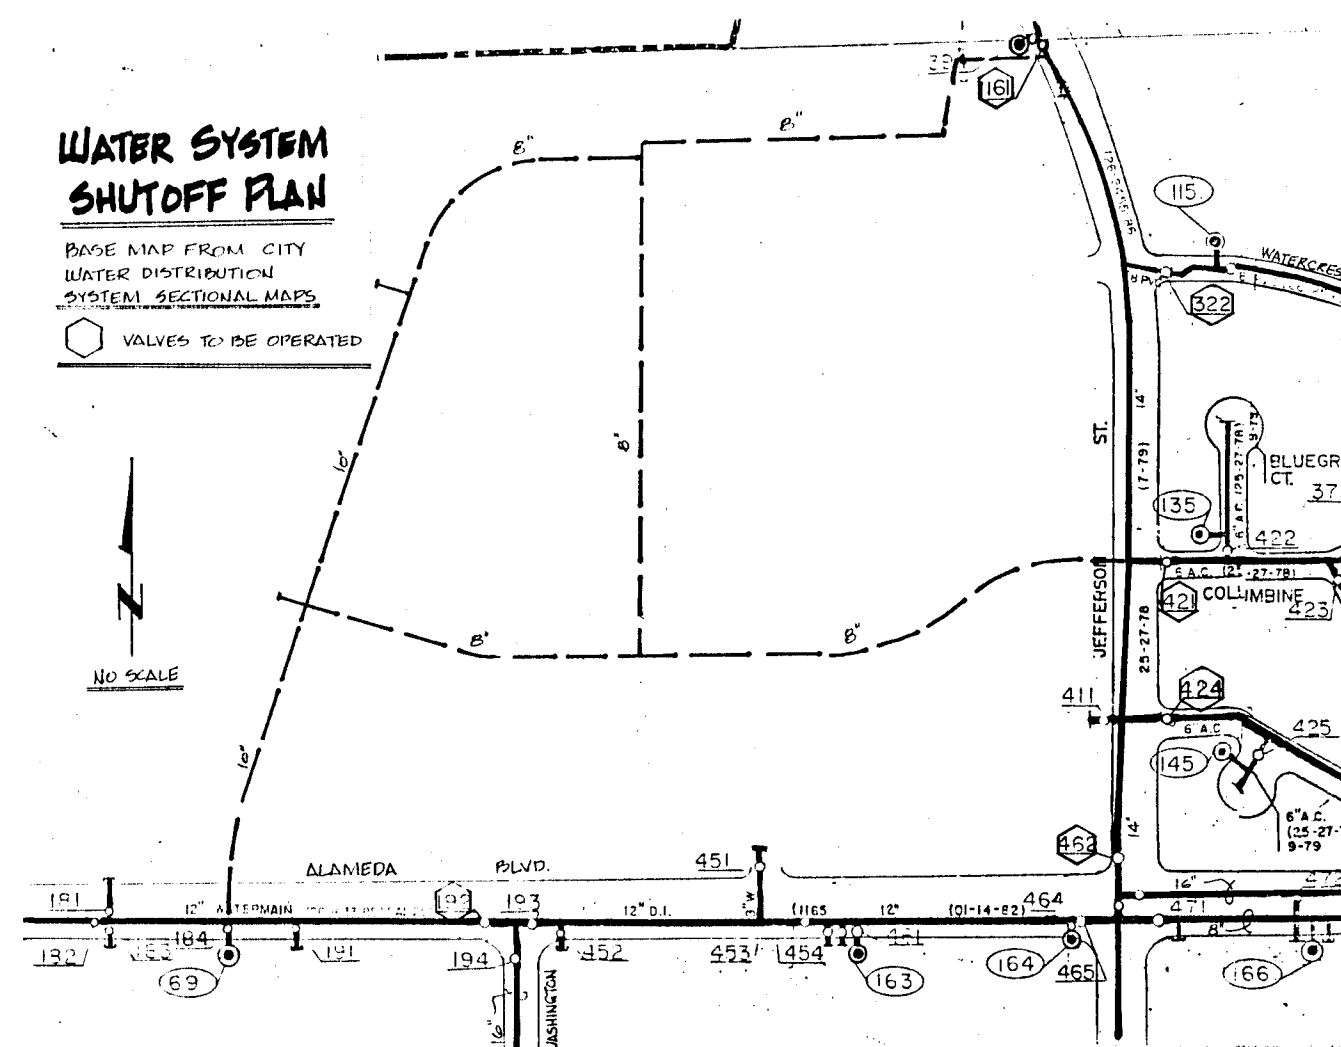

CONTRACTOR SHALL CONTACT WATER SYSTEMS DIVISION FOR EXECUTION OF APPROVED WATER VALVE SHUT-OFF PLAN AT LEAST 48 HOURS PRIOR TO CONSTRUCTION. EXISTING WATER SYSTEM VALVES AND APPURTENANCES SHALL BE OPERATED BY WATER SYSTEMS DIVISION ONLY.

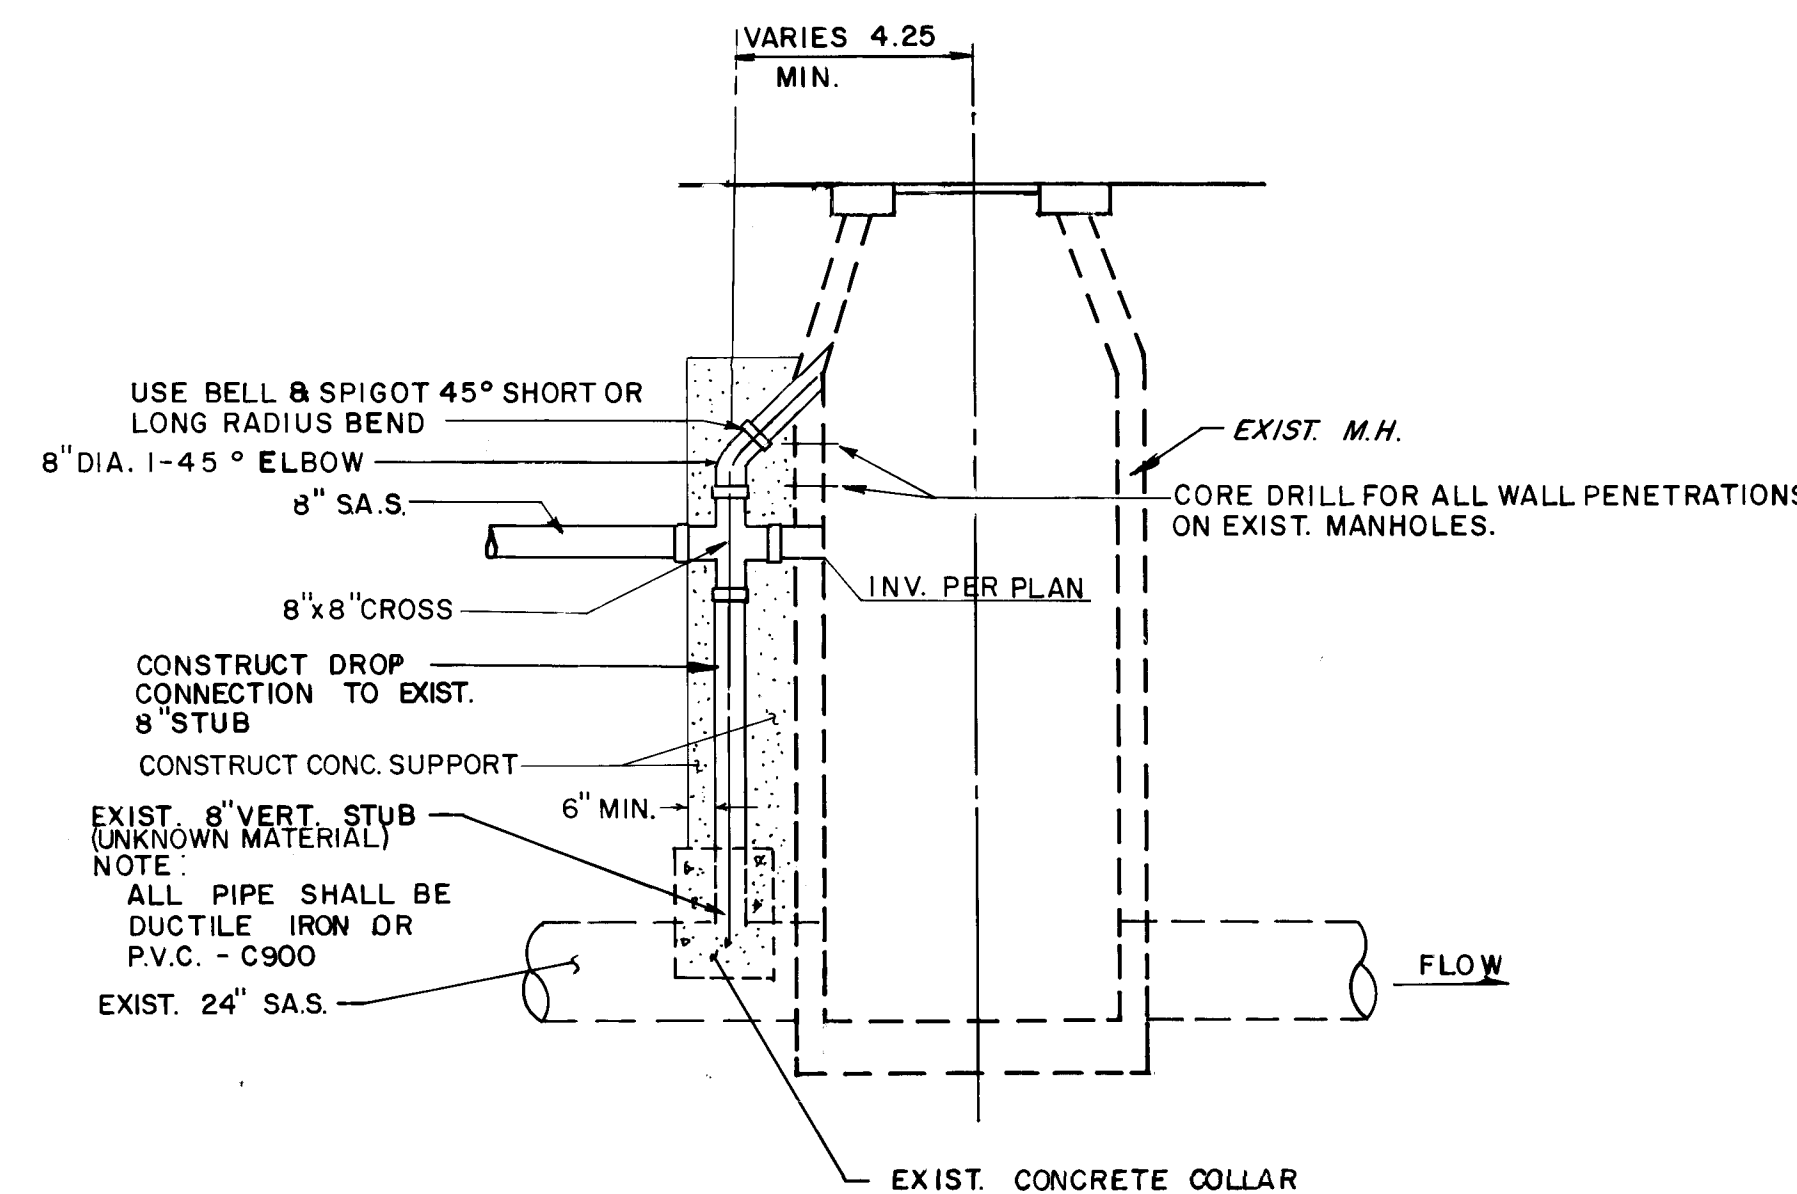

SEWER CONNECTION DETAIL C
SCALE: 1" = 04'

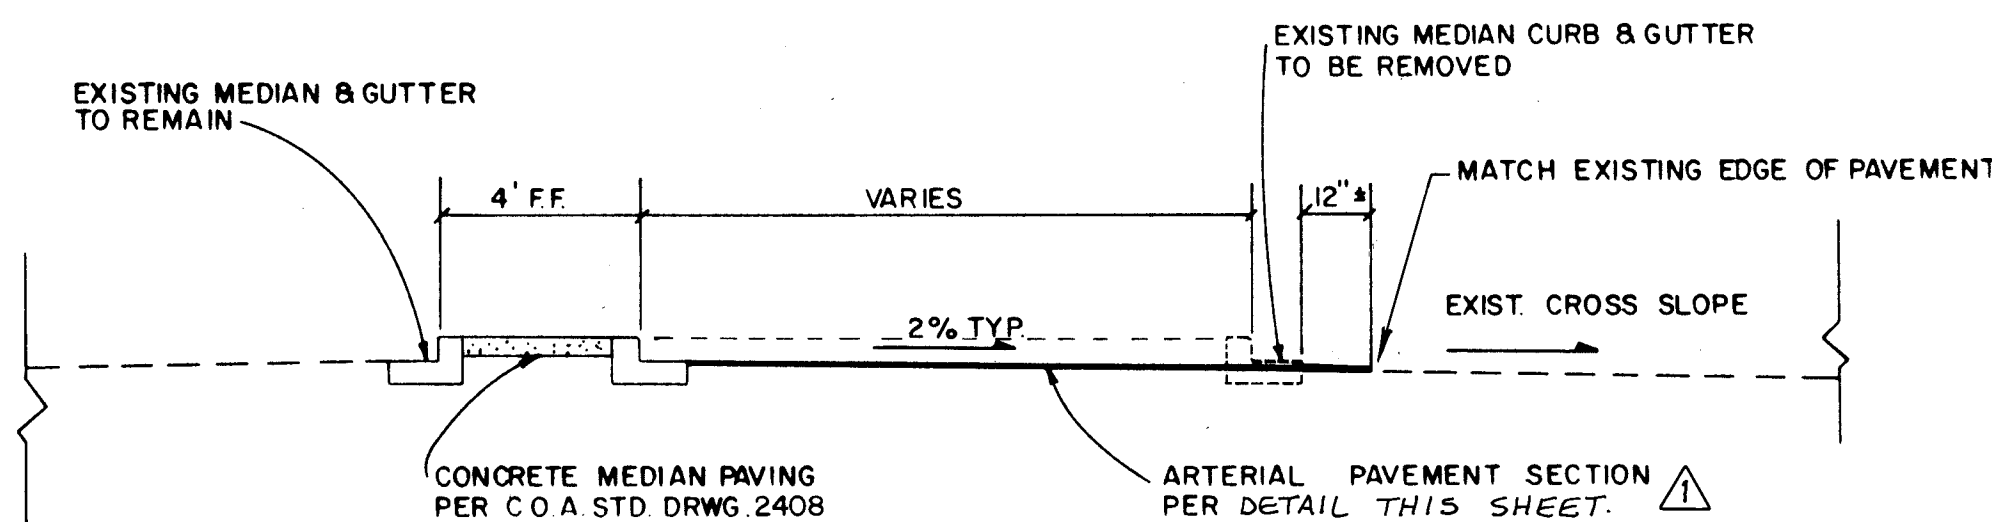


MEDIAN SECTION F-F
SCALE: 1" = 4'

26 30762288


ESPEY,
HUSTON &
ASSOCIATES, INC.
Engineering & Environmental Consultants
317 COMMERCIAL ST. N.E.
ALBUQUERQUE, NEW MEXICO 87102
PHONE: (505) 242-1909

CITY OF ALBUQUERQUE PUBLIC WORKS DEPARTMENT ENGINEERING DIVISION					
TITLE: RICHFIELD PARK - PHASE I DETAIL SHEET					
APPROVALS	ENGINEER	DATE	APPROVALS	ENGINEER	DATE
City Engineer	<i>[Signature]</i>	11/1/86	Liquid Waste	<i>[Signature]</i>	1/20/88
A.C.E. - Design	<i>[Signature]</i>	1/20/88	Traffic	<i>[Signature]</i>	1/20/88
A.C.E. - Hydrology	<i>[Signature]</i>	1-20-88	Water	<i>[Signature]</i>	1/20/88
DRAWING NO.	3076	MAP NO.	C-17	SHEET	22 OF 23

AS BUILT INFORMATION		BENCH MARKS		SURVEY INFORMATION		ENGINEER'S SEAL		REVISIONS		DESIGN	
CONTRACTOR	DATE	NO.	BY	NO.	BY	NO.	BY	NO.	DATE	NO.	DATE
WORK	DATE	NO.	BY	NO.	BY	NO.	BY	NO.	DATE	NO.	DATE
STAKED BY	DATE	NO.	BY	NO.	BY	NO.	BY	NO.	DATE	NO.	DATE
ACCEPTED BY	DATE	NO.	BY	NO.	BY	NO.	BY	NO.	DATE	NO.	DATE
FIELD	DATE	NO.	BY	NO.	BY	NO.	BY	NO.	DATE	NO.	DATE
ADJUSTED BY	DATE	NO.	BY	NO.	BY	NO.	BY	NO.	DATE	NO.	DATE
RECORDED BY	DATE	NO.	BY	NO.	BY	NO.	BY	NO.	DATE	NO.	DATE

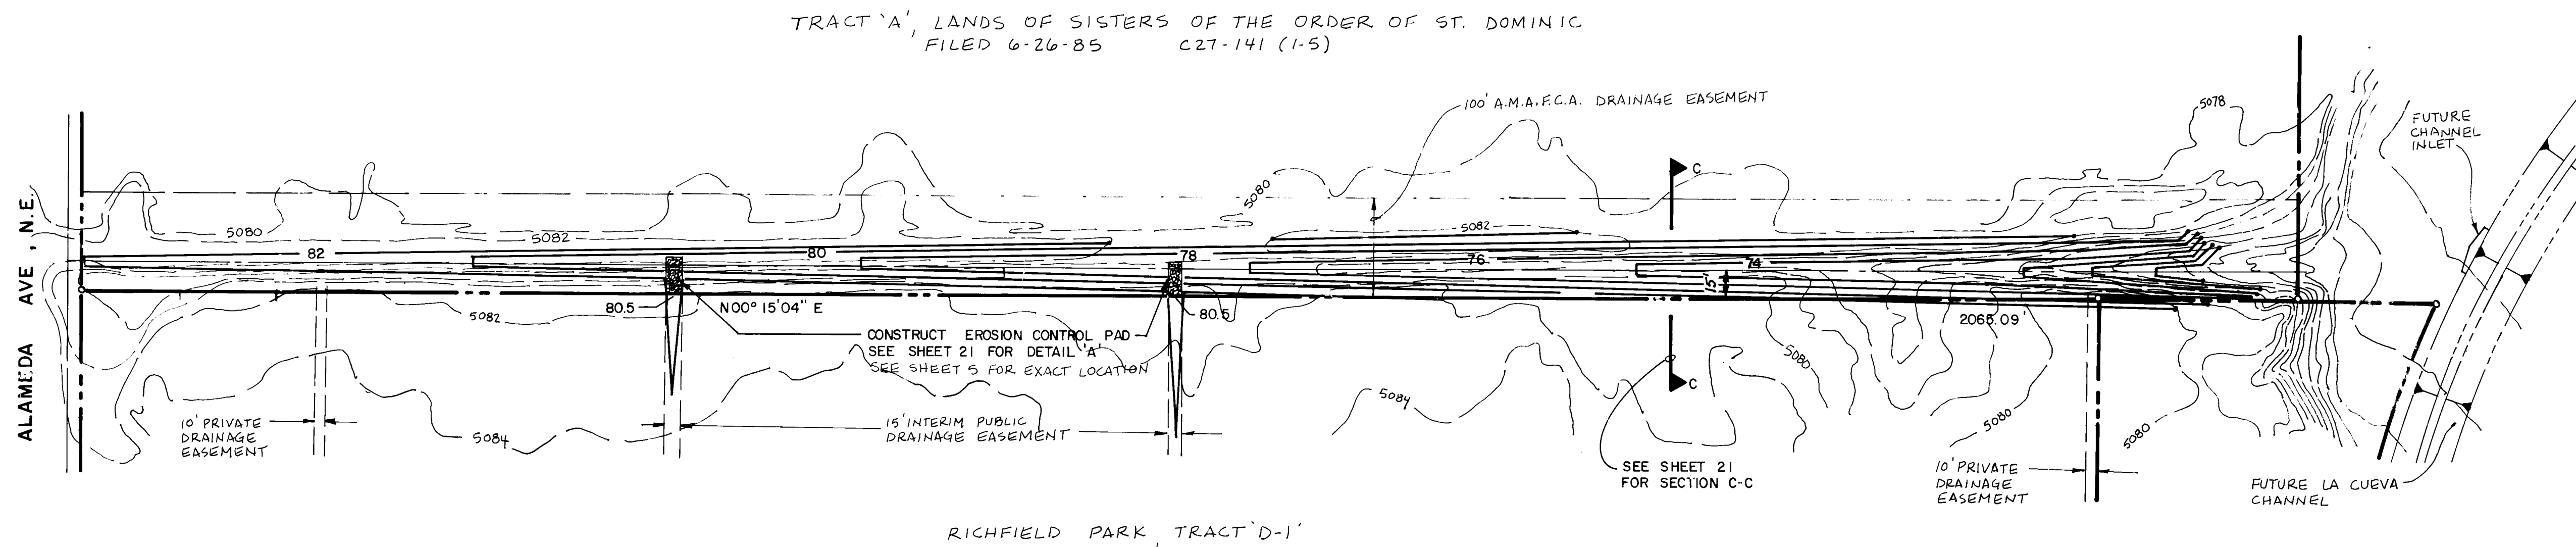

SCALES:
H: 1"=100'
V: 1"=10'

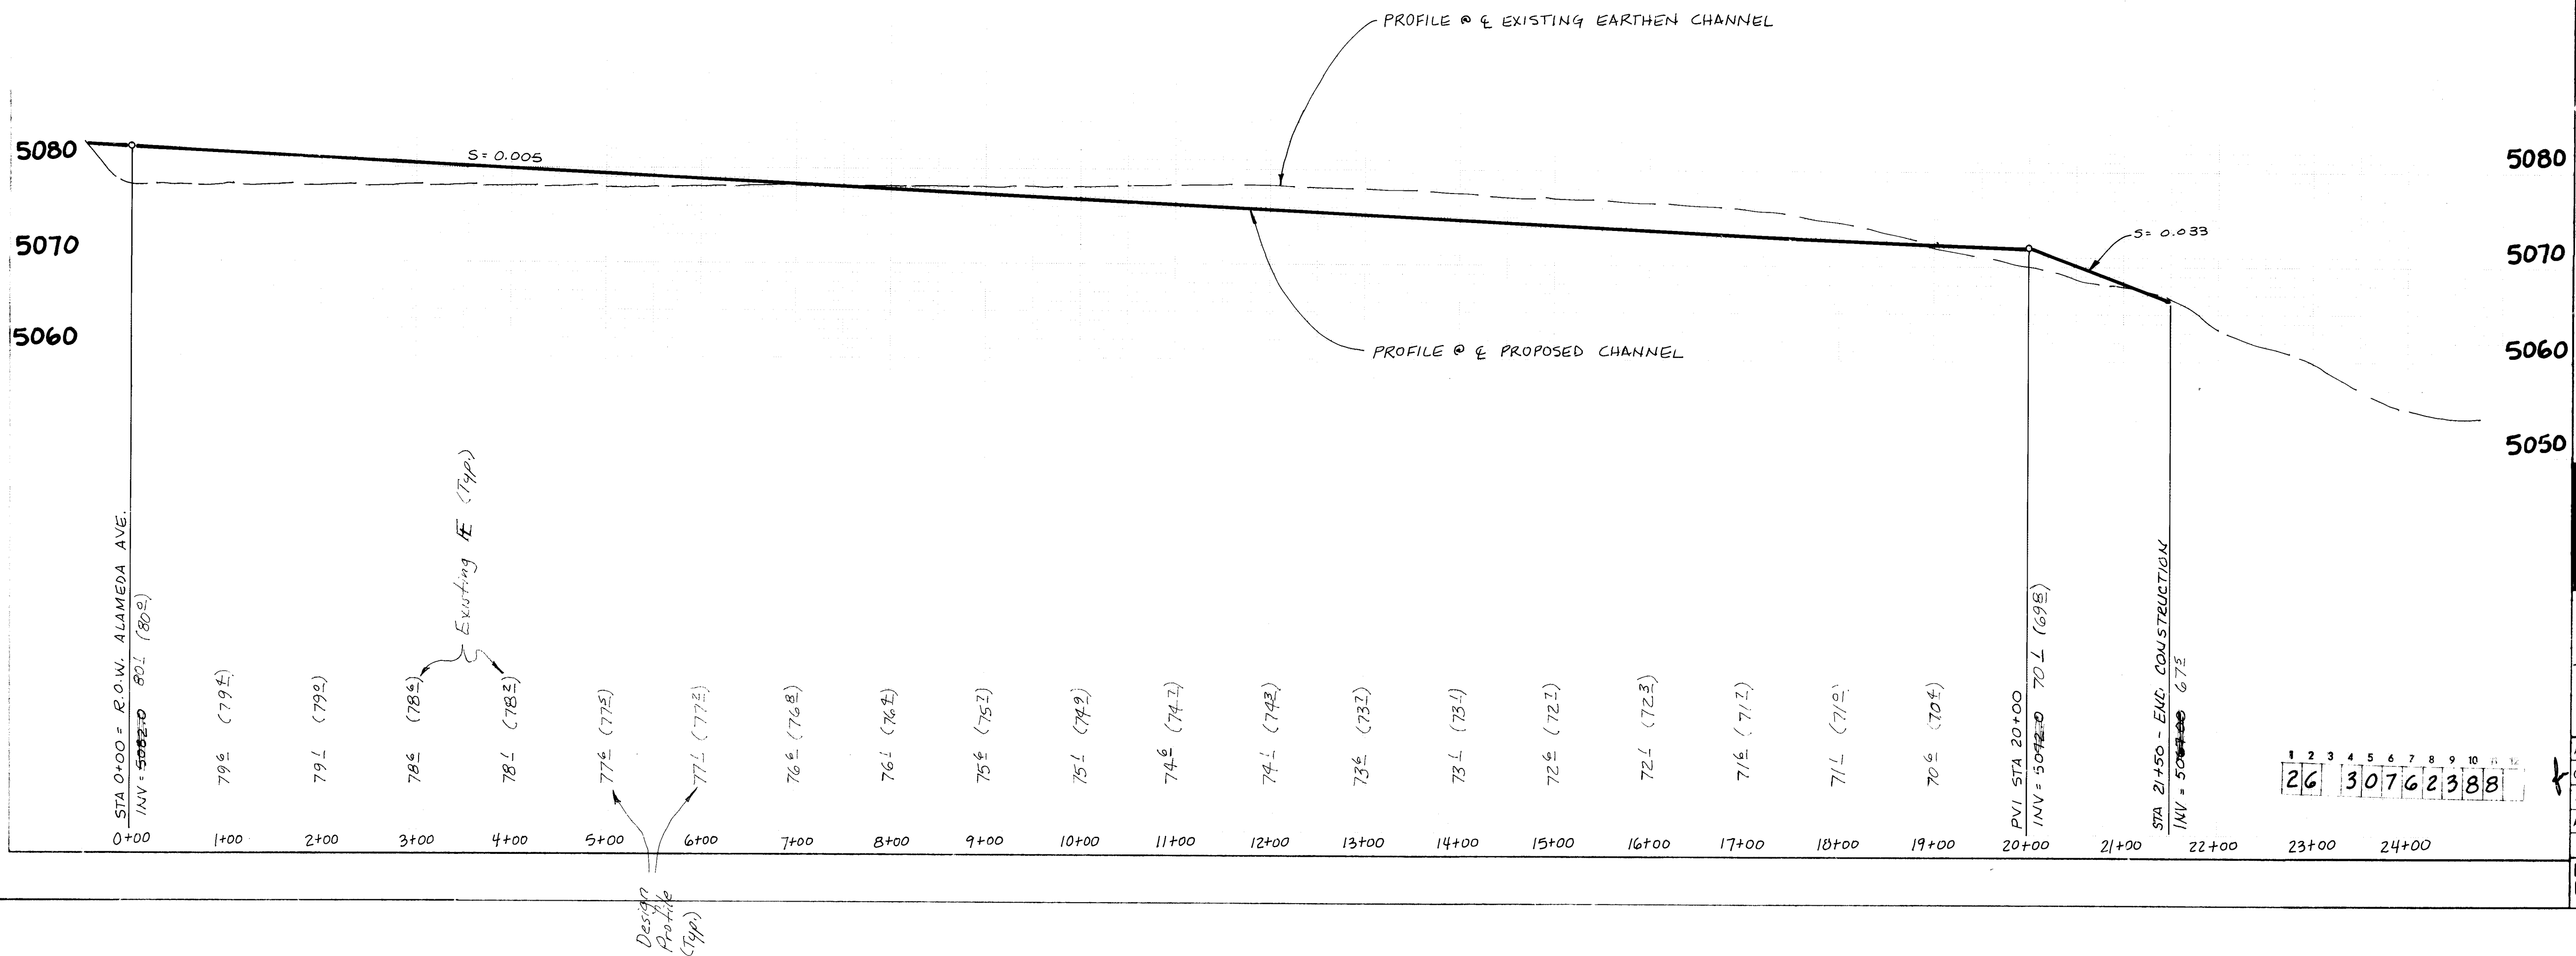

NOTES:
1. NOTIFY AMAFCA FIELD ENGINEER
48 HOURS PRIOR TO ANY WORK
IN AMAFCA R.O.W.

SURVEY INFORMATION		BENCH MARKS		AS BUILT INFORMATION	
NO.	DATE	BY	FIELD NOTES	NO.	DATE
			The Station is Located 7.5 Miles N.E. of Downtown, And 0.3 Miles N. of The Intersection of Los Angeles Boulevard And Washington Street N.E. To Reach The Station From The Intersection of Los Angeles Blvd. And 2nd St., Go East On Los Angeles Blvd. 1.65 Miles To Intersection With Washington ST, N.E., Then N. On Washington ST, N.E. 0.3 Miles To The Station On Left (West Side of The Street). The Station Mark is A Standard ACS Brass Tablet, Stamped "S-CIT, 1975", Cemented in A Drill Hole in Top of Concrete Curb. Elev. 5110.29		

ENGINEER'S SEAL

NEW MEXICO
REGISTERED PROFESSIONAL ENGINEER
1-12-88

ESPEY,
HUSTON &
ASSOCIATES, INC.
Engineering & Environmental Consultants
317 COMMERCIAL ST. N.E.
ALBUQUERQUE, NEW MEXICO 87102
PHONE: (505) 242-1909

NO.	DATE	REMARKS	BY
REVISIONS			
DESIGN			
DESIGNED BY D.L.	DATE 12/86		
DRAWN BY D.L.	DATE 12/86		
CHECKED BY D.L.	DATE 12/86		

CITY OF ALBUQUERQUE
PUBLIC WORKS DEPARTMENT
ENGINEERING DIVISION

TITLE: RICHFIELD PARK
AMAFCA. CHANNEL-PLAN AND PROFILE

APPROVALS	ENGINEER	DATE	APPROVALS	ENGINEER	DATE
City Engineer	<i>[Signature]</i>	2/1/88	Liquid Waste	<i>[Signature]</i>	1/20/88
A.C.E. - Design	" "	" "	Traffic	<i>[Signature]</i>	1/20/88
A.C.E. - Hydrology	<i>[Signature]</i>	1-20-88	Water	<i>[Signature]</i>	1/20/88

AMAFCA

DRAWING NO. 3076 MAP NO. C-17 SHEET 23 OF 23