


CORONADO AVE.
8" WATERLINE EXTENSION B/W SAN PEDRO BLVD.
AND FRONTAGE ROAD NE.

INDEX

SHEET	TITLE
1	
2	PLAN & PROFILE
3	PLAN & PROFILE

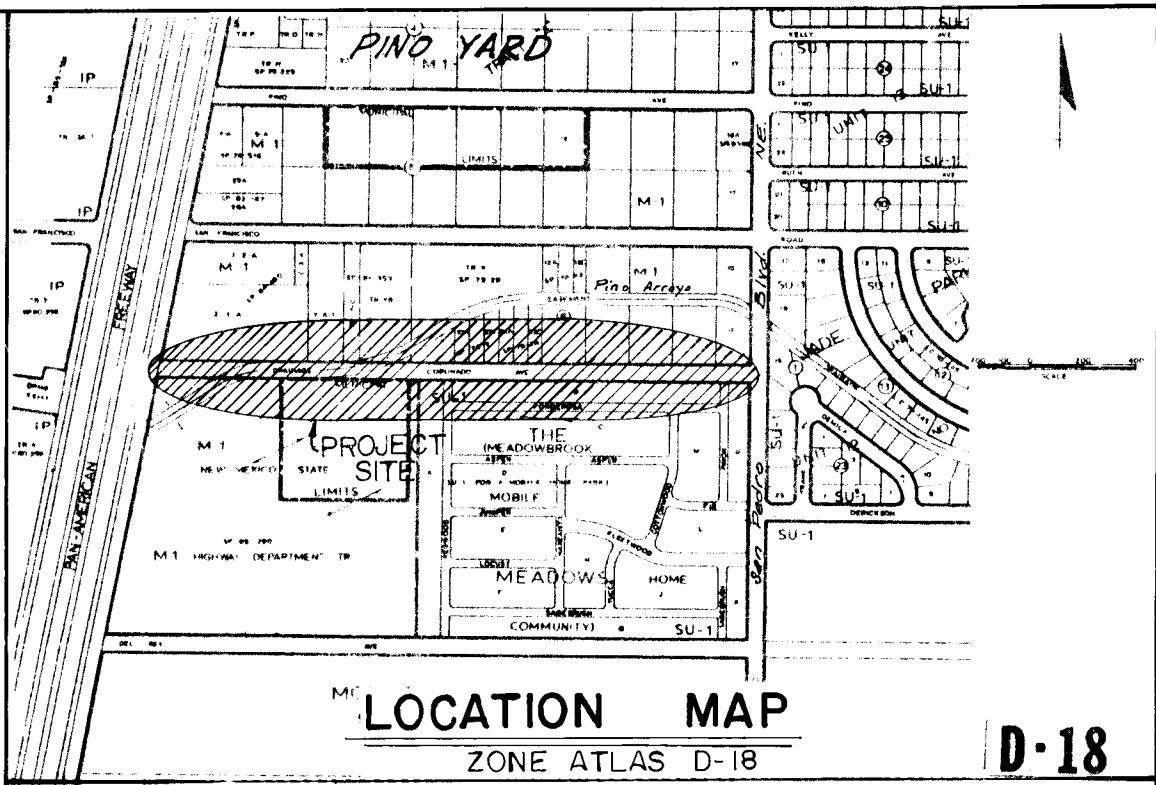


NOTICE TO CONTRACTORS

- ALL WORK DETAILED ON THESE PLANS TO BE PERFORMED UNDER CONTRACT SHALL BE PERFORMED AS OTHER WORK PROVIDED FOR HEREON, BE SUBJECT TO THE CITY OF ALBUQUERQUE STANDARD SPECIFICATIONS FOR PUBLIC WORKS CONSTRUCTION 1986.
- TWO (2) WORKING DAYS PRIOR TO ANY EXCAVATION THE CONTRACTOR MUST CONTACT LINE LOCATING SERVICE 765-1234, FOR LOCATION OF EXISTING UTILITIES.
- PRIOR TO CONSTRUCTION, THE CONTRACTOR SHALL EXCAVATE AND VERIFY THE HORIZONTAL AND VERTICAL LOCATIONS OF ALL EXISTING UTILITIES. SHOULD ANY EXISTING UTILITIES BE LOCATED, THE CONTRACTOR SHALL NOTIFY THE ENGINEER OR SURVEYOR SO THAT THE CONFLICT CAN BE RESOLVED WITH MINIMUM AMOUNT OF DELAY.


THE FOLLOWING NOTES ALSO APPLY WHEN


CHECKED

- ☐ ALL UTILITIES AND UTILITY SERVICE LINES SHALL BE INSTALLED PRIOR TO PAVING.
- ☐ BACKFILL COMPACTION SHALL BE ACCORDING TO SPECIFIED STREET USE.
- ☐ TACK COAT REQUIREMENTS SHALL BE DETERMINED BY THE CITY ENGINEER.
- ☐ SIDEWALKS AND WHEELCHAIR RAMPS WITHIN THE CURB RETURNS SHALL BE CONSTRUCTED WHENEVER A NEW CURB RETURN IS CONSTRUCTED.
- ☐ IF CURB IS DEPRESSED FOR A DRIVEPAD OR A HANDICAP RAMP, THE DRIVEPAD OR RAMP SHALL BE CONSTRUCTED PRIOR TO ACCEPTANCE OF THE CURB AND CURBING.
- ☐ ALL STORM DRAINAGE FACILITIES SHALL BE CONSTRUCTED PRIOR TO FINAL ACCEPTANCE.

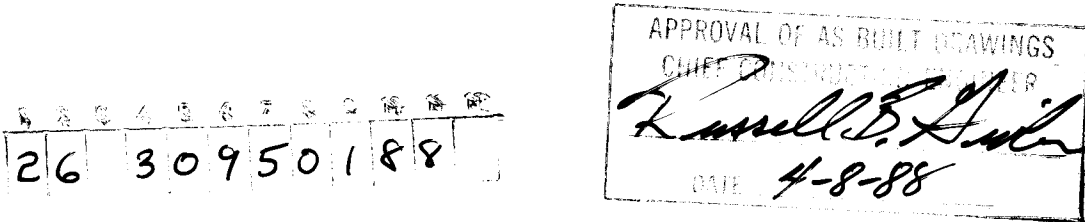

DRAWING NO.	CITY OF ALBUQUERQUE	APPROVED FOR CONSTRUCTION
3095		
SHEET OF		1 3

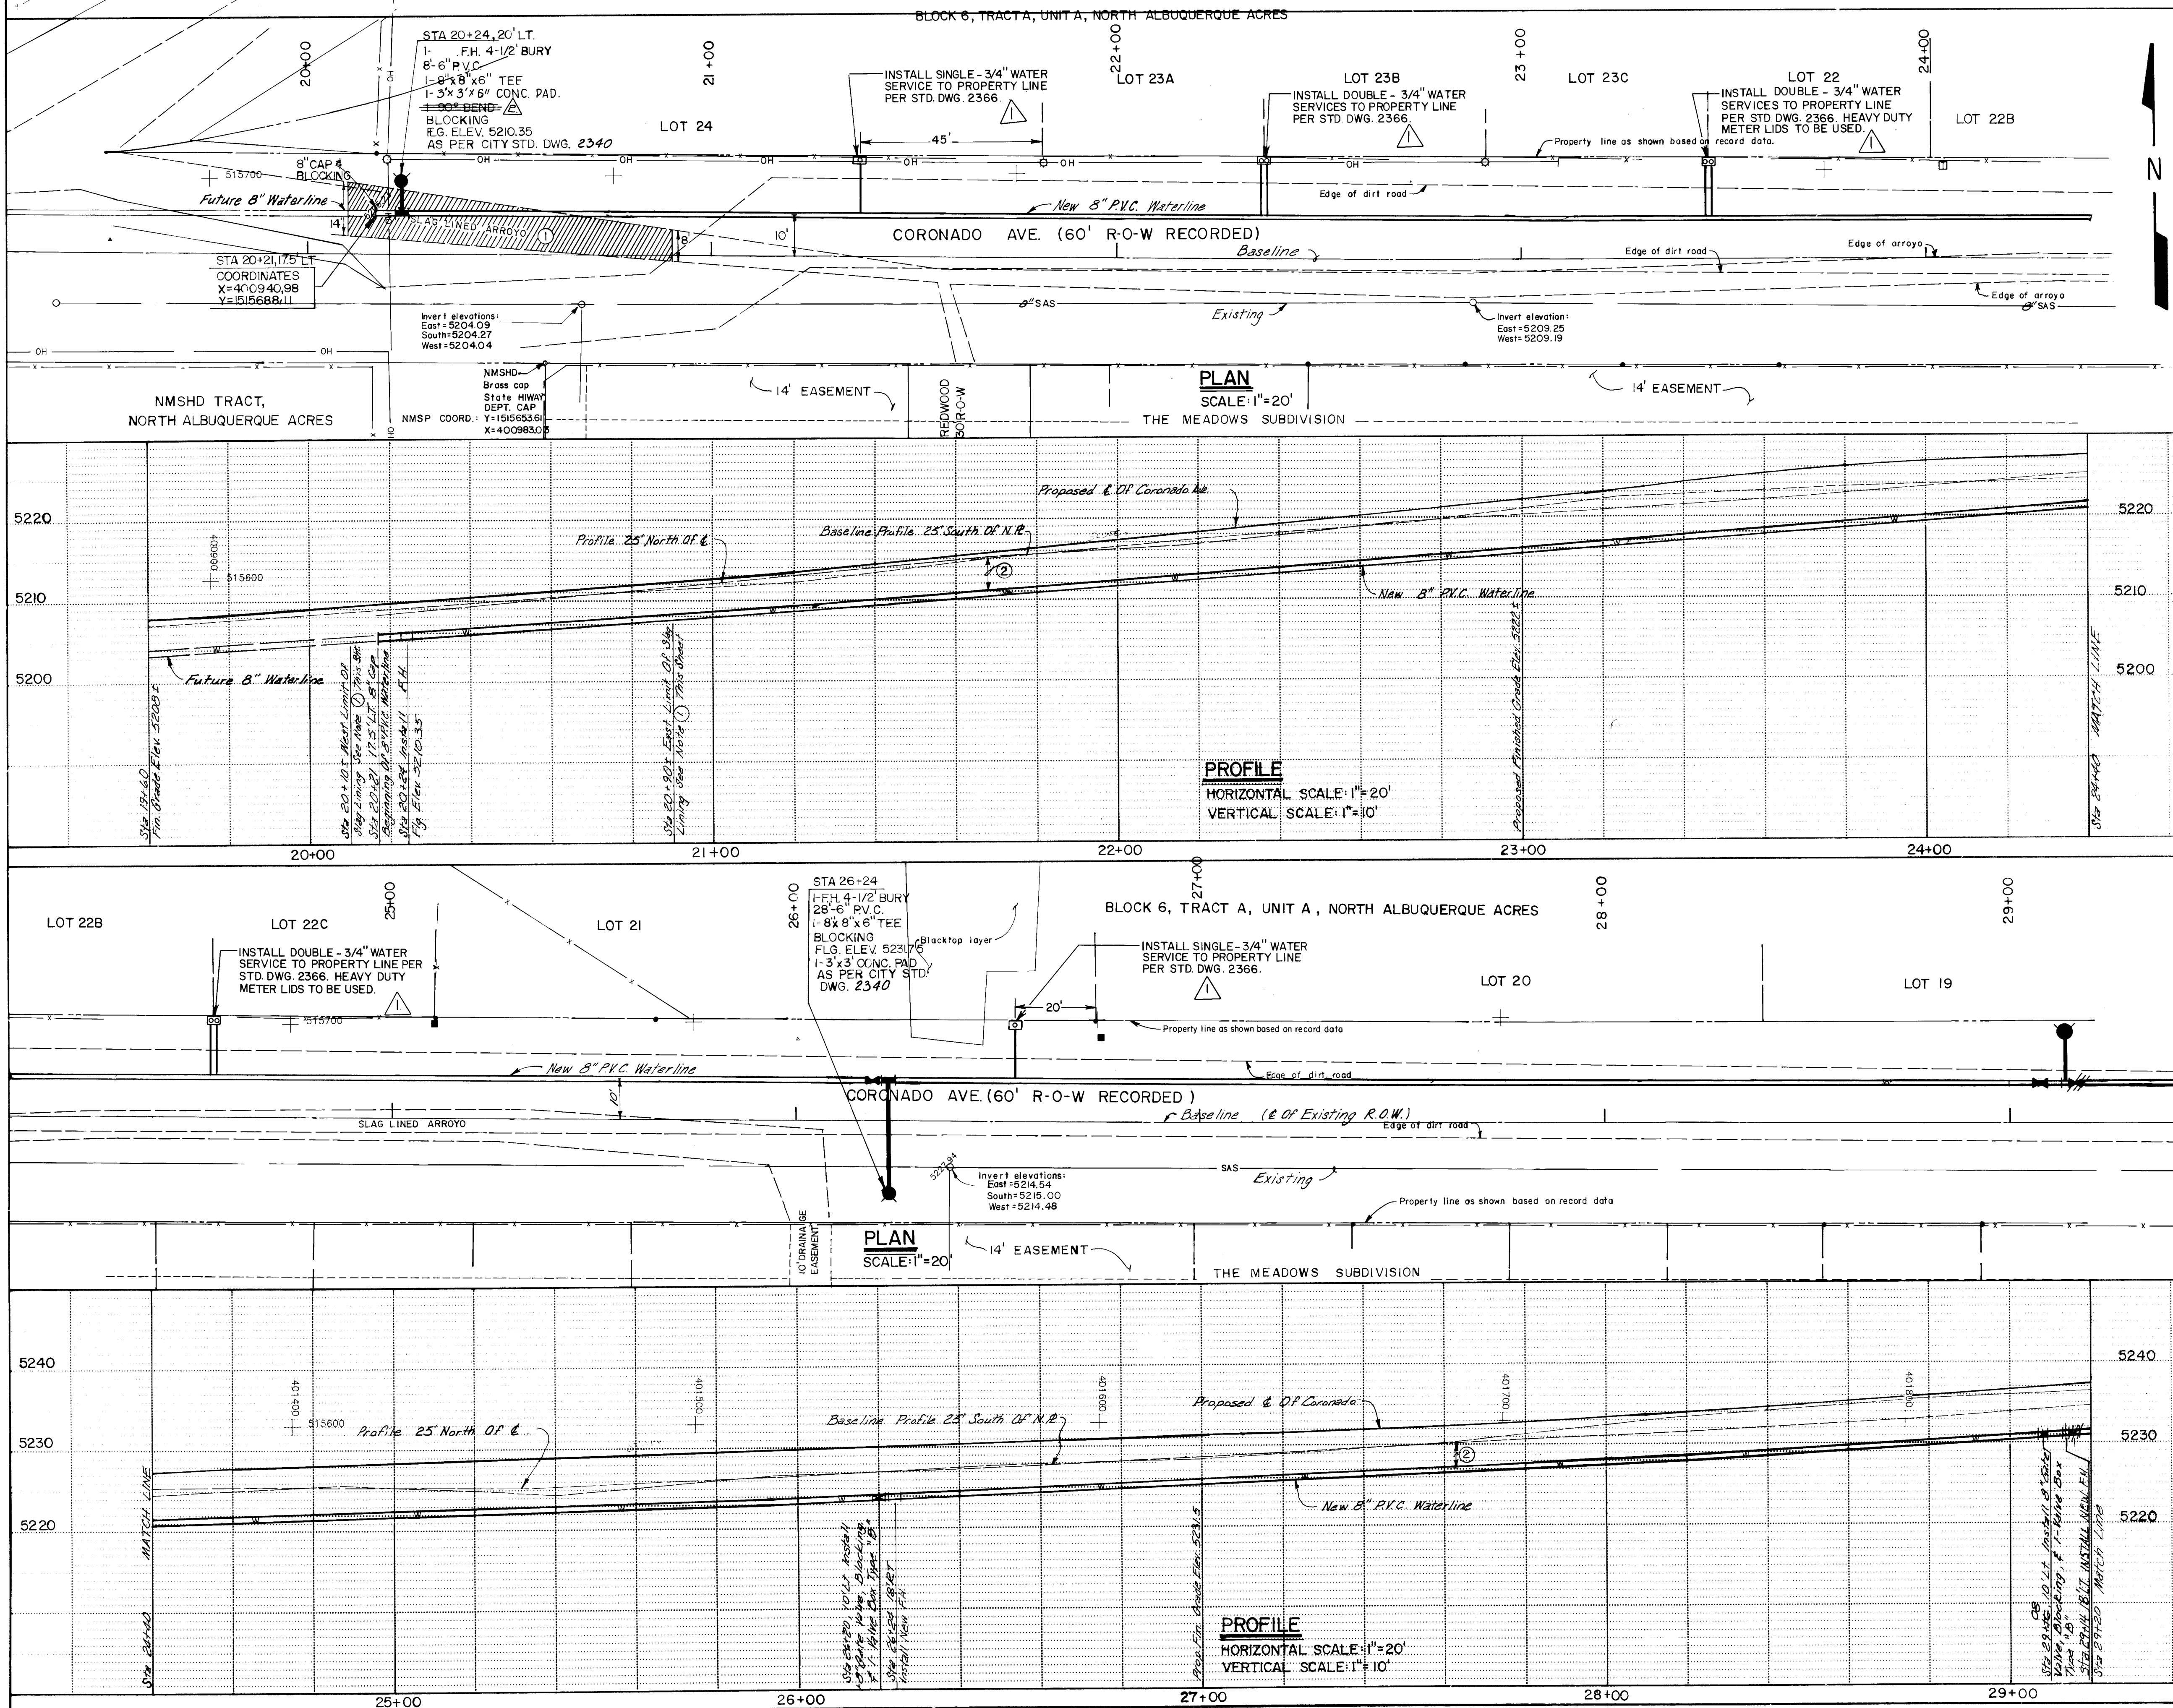

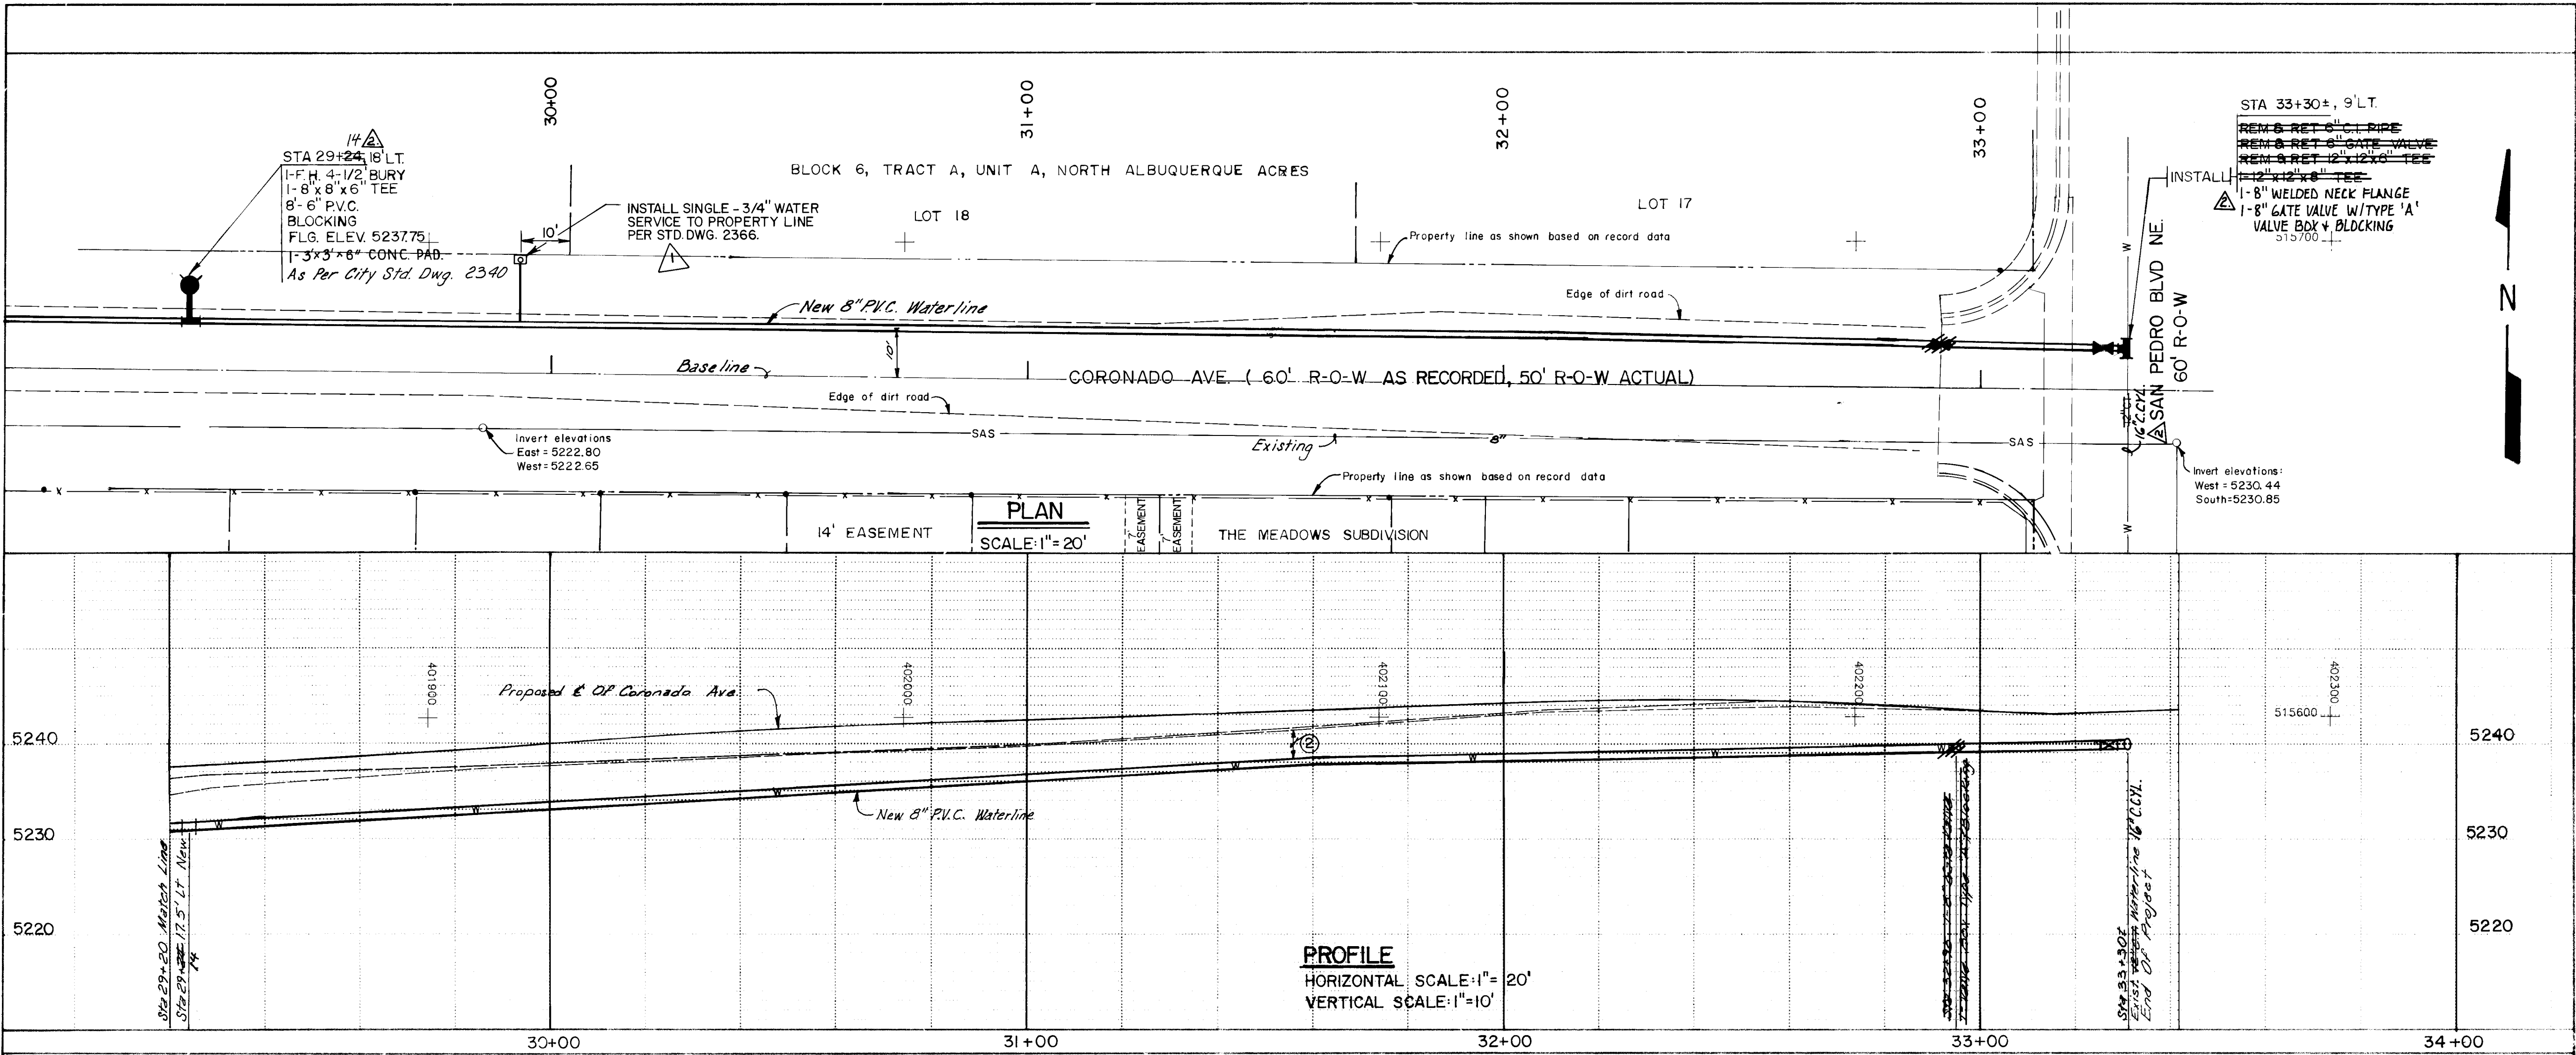

AS BUILT INFORMATION				BENCH MARKS				SURVEY INFORMATION				ENGINEER'S SEAL			
MCC INC.				B.M. 7.018 An "x" Chisled On The West Corner Built Of A. F.H. Located On The Eastside Of U.S. HWY 1-25 East Frontage Rd. Elevation 5190.862				FIELD NOTES				ENGINEER'S SEAL			
DATE 2/88				DATE 2/88				DATE				DATE			
BY RBR				BY RBR				BY				BY			
DATE 4/88				DATE 4/88				DATE				DATE			
BY EN				BY EN				DATE				DATE			
DATE 1/88				DATE 1/88				DATE				DATE			
MICRO-FILM INFORMATION				MICRO-FILM INFORMATION				MICRO-FILM INFORMATION				MICRO-FILM INFORMATION			
DATE				DATE				DATE				DATE			
NO				NO				NO				NO			
26 30950388				CITY OF ALBUQUERQUE MUNICIPAL DEVELOPMENT DEPARTMENT ENGINEERING DIVISION				TITLE: WATERLINE EXTENSION ON CORONADO AVE. NE. FROM STA 29+20 TO EXISTING WATERLINE AT STA 33+31.5 (SAN PEDRO BLVD. NE.)				APPROVALS			
APPROVALS				ENGINEER				DATE				APPROVALS			
City Engineer				3/20/87				Liquid Waste				3-18-87			
A.C.E. - Design				3/20/87				Traffic				3/17/87			
A.C.E. - Hydrology				3/20/87				Water				3-18-87			
DESIGNED BY P.G.				DATE 3-87				DESIGNED BY P.G.				DATE 3-87			
DRAWN BY A.C.B.				DATE 3-87				DRAWN BY A.C.B.				DATE 3-87			
CHECKED BY P.G.				DATE 3-87				CHECKED BY P.G.				DATE 3-87			
DRAWING NO 3095				MAP NO D-18				SHEET 3 OF 3				SHEET 3 OF 3			