

CONSTRUCTION PLANS FOR
THE CHAMPIONS AT TANOAN

PHASE I


BEING A PORTION OF TRACT E OF THE AMENDED
SUMMARY PLAT OF TANOAN PROPERTIES

ALBUQUERQUE, NEW MEXICO

FEBRUARY, 1987

INDEX TO DRAWINGS

SHEET NO.	DESCRIPTION
1	COVER SHEET
2-3	SUBDIVISION PLAT
4	GRADING PLAN - WEST
5	GRADING PLAN - EAST
6	TEMPORARY ASPHALT TURNAROUND & EROSION CONTROL PLAN
7	OVERALL PRIVATE STREET PAVING PLAN
8	OVERALL PUBLIC WATER
PRIVATE PAVING PLAN & PROFILE	
9	BRIDGEPOINTE - STA. 4+53.31 TO STA. 13+50
10	BRIDGEPOINTE - STA. 13+50 TO STA. 18+18.63
11	WELLINGTON - STA. 5+00 TO STA. 16+50
12	WELLINGTON - STA. 16+50 TO STA. 25+05.84
13	WESTMINSTER & WENTWORTH
14	BARRINSON
15	GARDENWALK
PUBLIC UTILITY PLAN & PROFILE	
16	BRIDGEPOINTE - STA. 4+88.48 TO STA. 13+50
17	BRIDGEPOINTE - STA. 13+50 TO STA. 18+55
18	WELLINGTON - STA. 4+90 TO STA. 16+50
19	WELLINGTON - STA. 16+50 TO STA. 25+05.84
20	WESTMINSTER & WENTWORTH
21	BARRINSON
22	GARDENWALK
23	GRADING PLAN DETAILS
24	PAVING DETAILS
25	DRAINAGE CHANNEL DETAILS
26	DRAINAGE CHANNEL PLAN & PROFILE
27	RETAINING WALL DETAILS
28	TYPE I & TYPE II RETAINING WALL PLAN & PROFILE

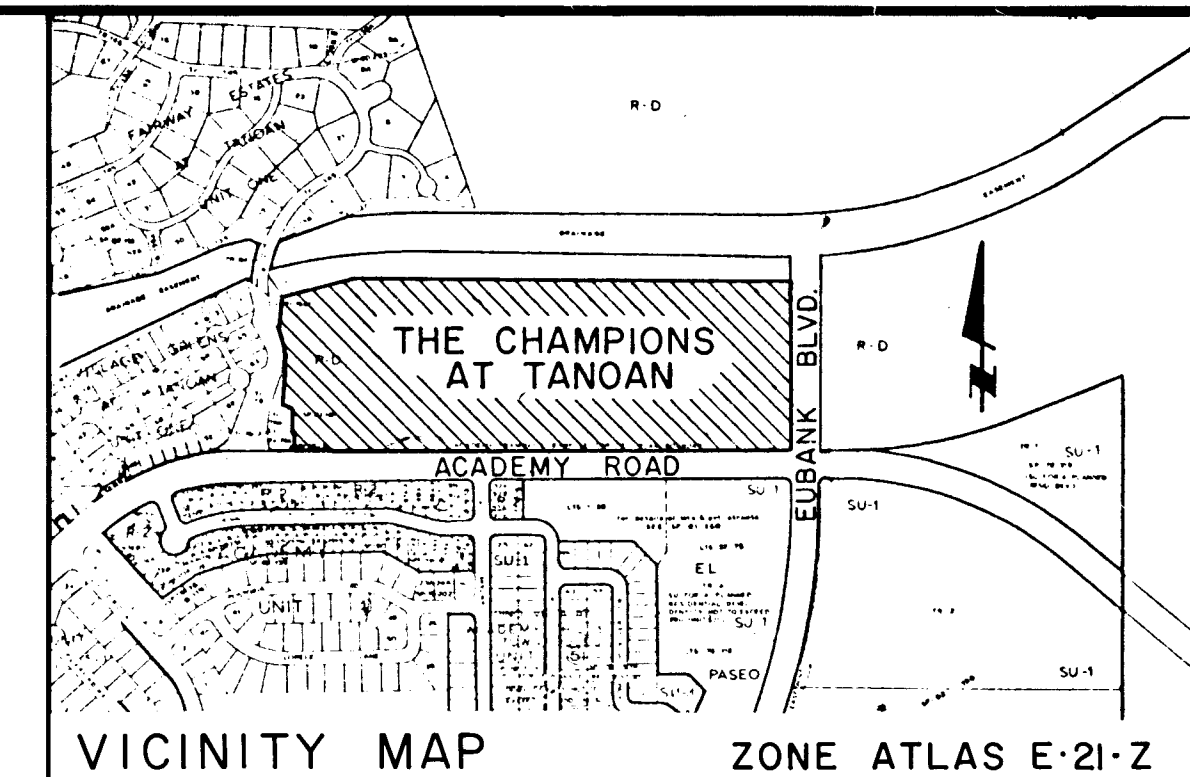

GENERAL NOTES

- All work detailed on these plans to be performed under contract shall, except as otherwise stated or provided for hereon, be constructed in accordance with the City of Albuquerque Interim Standard Specifications Public Works Construction, 1985.
- Two (2) working days prior to any excavation, Contractor must contact line locating service (765-1234), Tanoan Homeowner's Assoc. and Tanoan Country Club for location of existing utilities.
- Prior to construction, the Contractor shall excavate and verify the horizontal and vertical locations of all obstructions. Should a conflict exist, the Contractor shall notify the Engineer or Surveyor so that the conflict can be resolved with minimum amount of delay.
- All utilities and utility service lines shall be installed and tested prior to paving.
- Backfill compaction shall be according to specified street use.
- Tack coat requirements shall be determined by the City Engineer.
- Sidewalks and wheelchair ramps within the curb returns shall be constructed wherever a new curb return is constructed.
- If curb is depressed for a driveway or a handicap ramp, the driveway or ramp shall be constructed prior to acceptance of the curb and gutter.
- All storm drainage facilities shall be completed prior to final acceptance.
- Manholes shall be 4' inside diameter Type "C" or "E" except as noted.
- Electronic marker disks (EMD's) are to be installed per Section 170. In addition to those shown on the plans, the following EMD's are required:
 - Sewer - At the property line for all service lines.
 - Water - Single service. Over the main line at the service tap.
 - Water - Double service. Over the main line halfway between the service taps.
- Contractor should be aware of the soil reports available from F.M. Fox. The Contractor should be thoroughly aware of the findings and recommendations.

Prepared by: Daniel L. Morehead 1-29-87
Daniel L. Morehead, Project Manager Date
Robert Molina 1-29-87
Robert Molina, Project Engineer Date
Prepared Under the Supervision of:
Carl A. Tebbens 1/29/87
Carl A. Tebbens, Vice-President Date

Prepared For: INMAN ENTERPRISES, INC.
7801 Academy Blvd., N.E.
Albuquerque, New Mexico 87112

Contact: J. L. Brown (505) 821-5600


1 2 3 4 5 6 7 8 9 10 11 12
26 30960187

APPROVAL OF AS BUILT DRAWINGS
ASST. CITY ENGINEER EMD
Kenneth B. Fisher
Date 7-30-87

REV	SHEETS	CITY ENGR	DATE	USER	DEPT.	DATE	USER	DEPT.	DATE
APPROVAL OF REVISIONS									

<u>Daniel L. Morehead</u> 1-29-86	GREINER ENGINEERING 2601 WYOMING BLVD., NE ALBUQUERQUE, NM 87112 (505) 292-1936	APPROVED FOR CONSTRUCTION <u>Mark A. Smith</u> 3/18/87
	DRAWING NO. 3096	SHEET I OF 28

GREINER Job No. 0690600

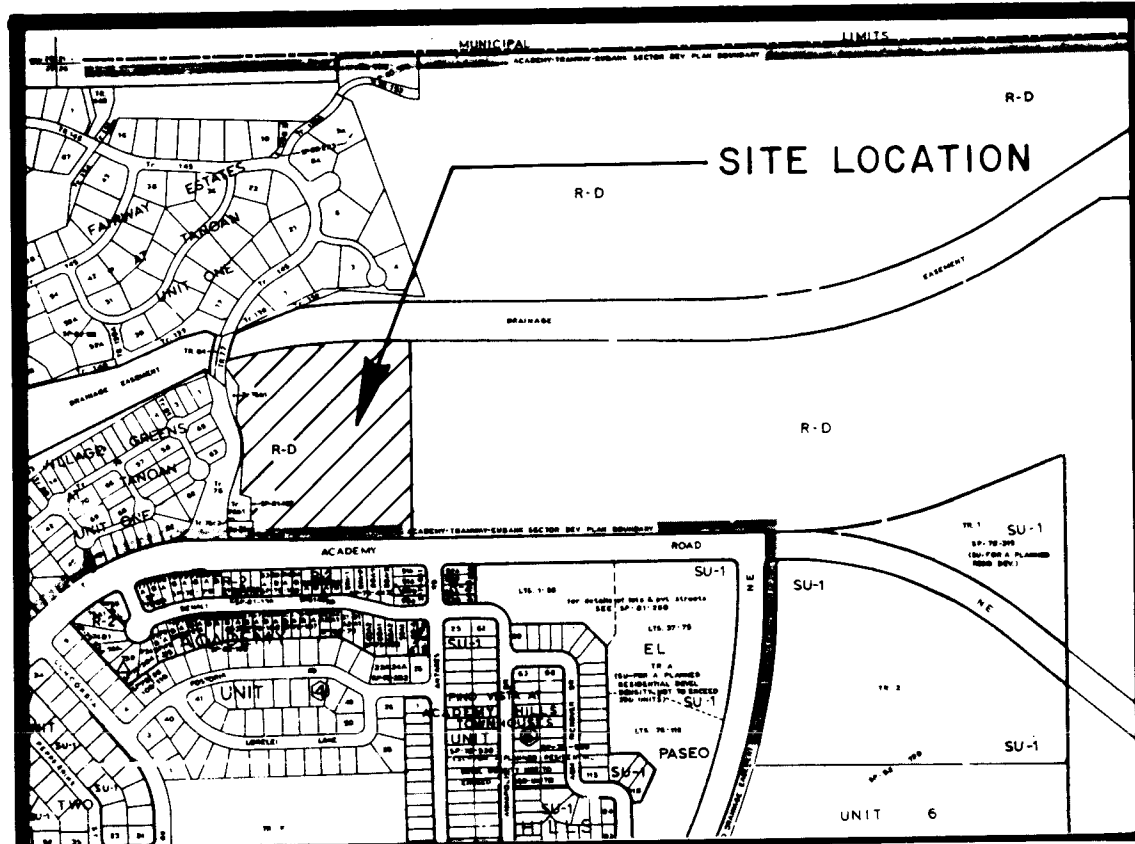

VICINITY MAP
N.T.S.

GENERAL NOTES:

- Bearing basis is N.M. State plane Coordinate System (Central Zone).
- (N/R) indicates non-radial.
- All lots and parcels within this subdivision are subject to declaration of restrictive covenants filed separately from this plat.
- Monumentation - After subdivision improvements are completed it is the developer's responsibility to monument centerline P.C.s, P.T.s and intersection points in lieu of block control per City of Albuquerque subdivision requirement.
- The purpose of this replat is to create a 53 Lot Subdivision.
- Any relocation of the Public Waterline and Public Water Easement shall be at the owners expense and with City of Albuquerque Water Resources Department approval.

APPROVED BY:

Traffic Engineer, Transportation Department Date

Parks and Recreation Department Date

Chief City Surveyor, Engineering Division Date

Water Resources Department Date

Property Management Date

Albuquerque Metropolitan Arroyo Flood Control Authority Date

City Engineer, Engineering Division Date

City Planner, Albuquerque/Bernalillo County Planning Division Date

Public Service Company of New Mexico Date

Mountain Bell Date

Mal Cordova 1-29-87
Gas Company of New Mexico Date

Replat Data

D.R.B. Case Number _____
Zone Atlas Number E-21
Gross Acreage 10.853
Total Number Tracts Created 59
Total Mileage of Streets Created 0.426 mi.
(Private)
Date of Survey 8-86
Talos Log Number 01-20-1394

DESCRIPTIONS OF EASEMENTS

- UTILITY EASEMENTS: Utility easements on the plat are granted for the common and joint use and benefit of:
 - The City of Albuquerque for installation, service and maintenance of water and sewer lines, valves, pumps and/or other related equipment and facilities reasonably necessary to deliver potable water to the residents of the subdivision and provide a liquid waste disposal system in accordance with the plans and procedures of the City of Albuquerque;
 - the Public Service Company of New Mexico for installation, maintenance and service of electrical lines, transformers and other equipment and related facilities reasonably necessary to provide electric service to the residents of the subdivision, including the rights of ingress and egress and the right to trim interfering trees;
 - The Gas Company of New Mexico for installation of natural gas lines, valves and other equipment and facilities reasonably necessary to provide natural gas to the residents of the subdivisions;
 - Mountain Bell for the installation, service and maintenance of all telephone lines, switching equipment and other related equipment and facilities reasonably necessary to provide telephone service to the residents of the subdivision;
 - Albuquerque Cable Television, Inc., for the purpose of installation, service and maintenance of such line or cable as is reasonably required to provide cable TV service to the residents of the subdivision;
 - Tanoan Community Associations, for the purpose of installing, maintenance and service to the residents of the subdivision;
- DRAINAGE AND IRRIGATING EASEMENTS: Drainage and irrigating easements are private, for the benefit of all owners of the subdivision or indicated on the plat for the passage, containment or diversion of surface and irrigation waters, and between individual property owners as indicated on the plat by reference or notation.
- ACCESS EASEMENTS: The City of Albuquerque is hereby granted an access easement over and across Tract "F" for the purpose of allowing its various operating departments to provide service to the residents of the subdivision in the same manner and to the same extent as though Tract "F" was a dedicated public street. "Operating Departments" as referred to above shall include but shall not be limited to the department of the city providing the following services: (1) Police protection; (2) Fire protection; (3) Water Resources; (4) Solid refuse and liquid disposal; (5) Animal control; and (6) City planning functions. All owners of the subdivision are hereby granted the right to access their property over and across Tract "F".
- In Tract "F" the City of Albuquerque shall have the exclusive right to place underground utility lines within six (6) feet of the centerline of a water or sewer line except for perpendicular crossings or where written approval has been obtained from the City of Albuquerque. Gas Company of New Mexico, Public Service Company of New Mexico and Mountain States Telephone and Telegraph are excepted from compliance with the requirements of the first sentence in this paragraph.
- PEDESTRIAN EASEMENT: Pedestrian easements are exclusive ingress egress easements for the benefit of all owners of the subdivision.
- Tracts "A, B, C & D" are for private Landscaping purposes.
- Tract "E" is for landscaping purposes; for the use and enjoyment by all Homeowners. Tract "E" Maintenance will be done by the Homeowners Association.
- Tract "F" as shown hereon is a Private Way hereby granted as a permanent access easement to be indivisible and collectively owned by the owners of the individual properties which the easements serve and said private ways are also private water and sewer easements.
- PARKING: Parking area will be included in Tract "F" only, and not in Tracts "A thru E"
- BACKYARD ACCESS: Lots 95 through 100 inclusive will have access from Bridgepointe only. Lots 101 through 106 will have access from Barrinson only.

CERTIFICATION

I, Daniel L. Morehead, New Mexico Registered Land Surveyor Number 8324 certify that this Plat was prepared by me or under my supervision and that an actual field survey was performed on the ground shown hereon, and that this Plat shows all easements of record and that this Plat meets the minimum requirements of the Albuquerque Subdivision Ordinance and is true and correct to the best of my knowledge and belief.

D. L. Morehead, NMLS No. 8324
Greiner Engineering Sciences, Inc.

Date

THE CHAMPIONS AT TANOAN

PHASE I

CITY OF ALBUQUERQUE
BERNALILLO COUNTY, NEW MEXICO

BEING A REPLAT OF
A PORTION OF

THE CHAMPIONS AT TANOAN
REVISION PLAT OF TANOAN PROPERTIES.

JANUARY, 1987

DEDICATION & FREE CONSENT

The undersigned owners of the land hereon shown do hereby consent to the subdivision of the land shown hereon. THE CHAMPIONS AT TANOAN, PHASE I, being a tract of land situate within projected Section 28, T11N, R1E, N.M.P.M., within the Elena Gallegos Grant, City of Albuquerque, Bernalillo County, New Mexico being a replat of a portion of THE CHAMPIONS AT TANOAN, REVISION PLAT OF TANOAN PROPERTIES as the same is shown and designated on the plat filed in the office of the County Clerk of Bernalillo County, New Mexico on May 7, 1985 in Volume C27, Folio 37 and being more particularly described by New Mexico State Plane Grid Bearings (Central Zone) and ground distances as follows:

Beginning at the southwest corner of the tract herein described, said point of beginning being at the intersection of the northerly right-of-way line of Academy Blvd., N.E. and the extension of the easterly line of Tract 76 C-1 as shown on the REPLAT OF TRACT 76-B & 76-C OF VILLAGE GREENS AT TANOAN, UNIT ONE, recorded in Vol. C18, Folio 114, records Bernalillo County. From which the ACS aluminum cap 8-E21 bears S 89°30'30" E, a distance of 1519.59 feet:

Thence along the easterly line of Tracts 76 B-1, 76 C-1 and 76 C-3, as shown on said replat, the following eight (8) courses:

- thence N 00°10'12" E a distance of 86.41 feet;
- thence N 89°49'48" W a distance of 10.00 feet;
- thence N 00°10'12" E a distance of 91.85 feet;
- thence N 74°30'00" W a distance of 44.14 feet;
- thence N 05°23'37" E a distance of 163.08 feet to a point of curvature; thence S 27°15'41" W, a radius of 229.00 feet, a chord bearing of N 07°20'12" W, and an arc distance of 101.78 feet;
- thence N 20°04'17" W a distance of 38.97 feet;
- thence N 05°23'37" E a distance of 123.16 feet;
- thence N 81°25'53" E a distance of 613.06 feet;
- thence S 81°53'24" E a distance of 126.76 feet;
- thence S 00°32'15" E a distance of 125.95 feet;
- thence S 00°40'35" W a distance of 28.12 feet;
- thence S 03°02'20" W a distance of 127.04 feet;
- thence S 11°53'20" E a distance of 33.12 feet;
- thence S 01°17'36" W a distance of 113.31 feet;
- thence N 88°42'24" W a distance of 20.04 feet;
- thence S 00°10'12" W a distance of 116.94 feet;
- thence S 30°56'32" E a distance of 37.38 feet;
- thence S 00°10'12" W a distance of 112.00 feet to a point on the northerly right-of-way line of Academy Blvd., N.E.;
- thence N 89°49'48" W along said right-of-way line a distance of 677.20 feet more or less to the Point of Beginning. The above described parcel contains 472755.81 sq. ft. or 10.853 Acres more or less.

The subdivision of the land hereon described is with the free consent and in accordance with the desires of the undersigned owners and proprietors thereof, and said owners and proprietors do hereby dedicate all easements shown on this plat, the use of which easements shall be limited to those uses specified in the Description of Easements on this cover sheet.

HIGHLANDS/CHAMPIONS, JOINT VENTURE BY
INMAN ENTERPRISES, INC.

Christopher C. Inman, President

State of New Mexico)

County of Bernalillo) ss.

The foregoing instrument was acknowledged before me this _____ day of _____, 19____, by Christopher C. Inman, President of Highlands/Champions, Joint Venture by Inman Enterprises, Inc., a New Mexico Corporation, on behalf of said corporation.

Notary Public

My Commission expires _____.

Revisions

Greiner
Engineering
Sciences, Inc.

Greiner Engineering Sciences, Inc.
Denver, Colorado
Albuquerque, N.M.
Kennebec, Wyoming


Design
Drawn
Check

Scale 1" = 50'

Date 1-14-87
Job No. 0690601

Sheet 1 of 3

1 2 3 4 5 6 7 8 9 10 11 12
26 30 9 60 28 7

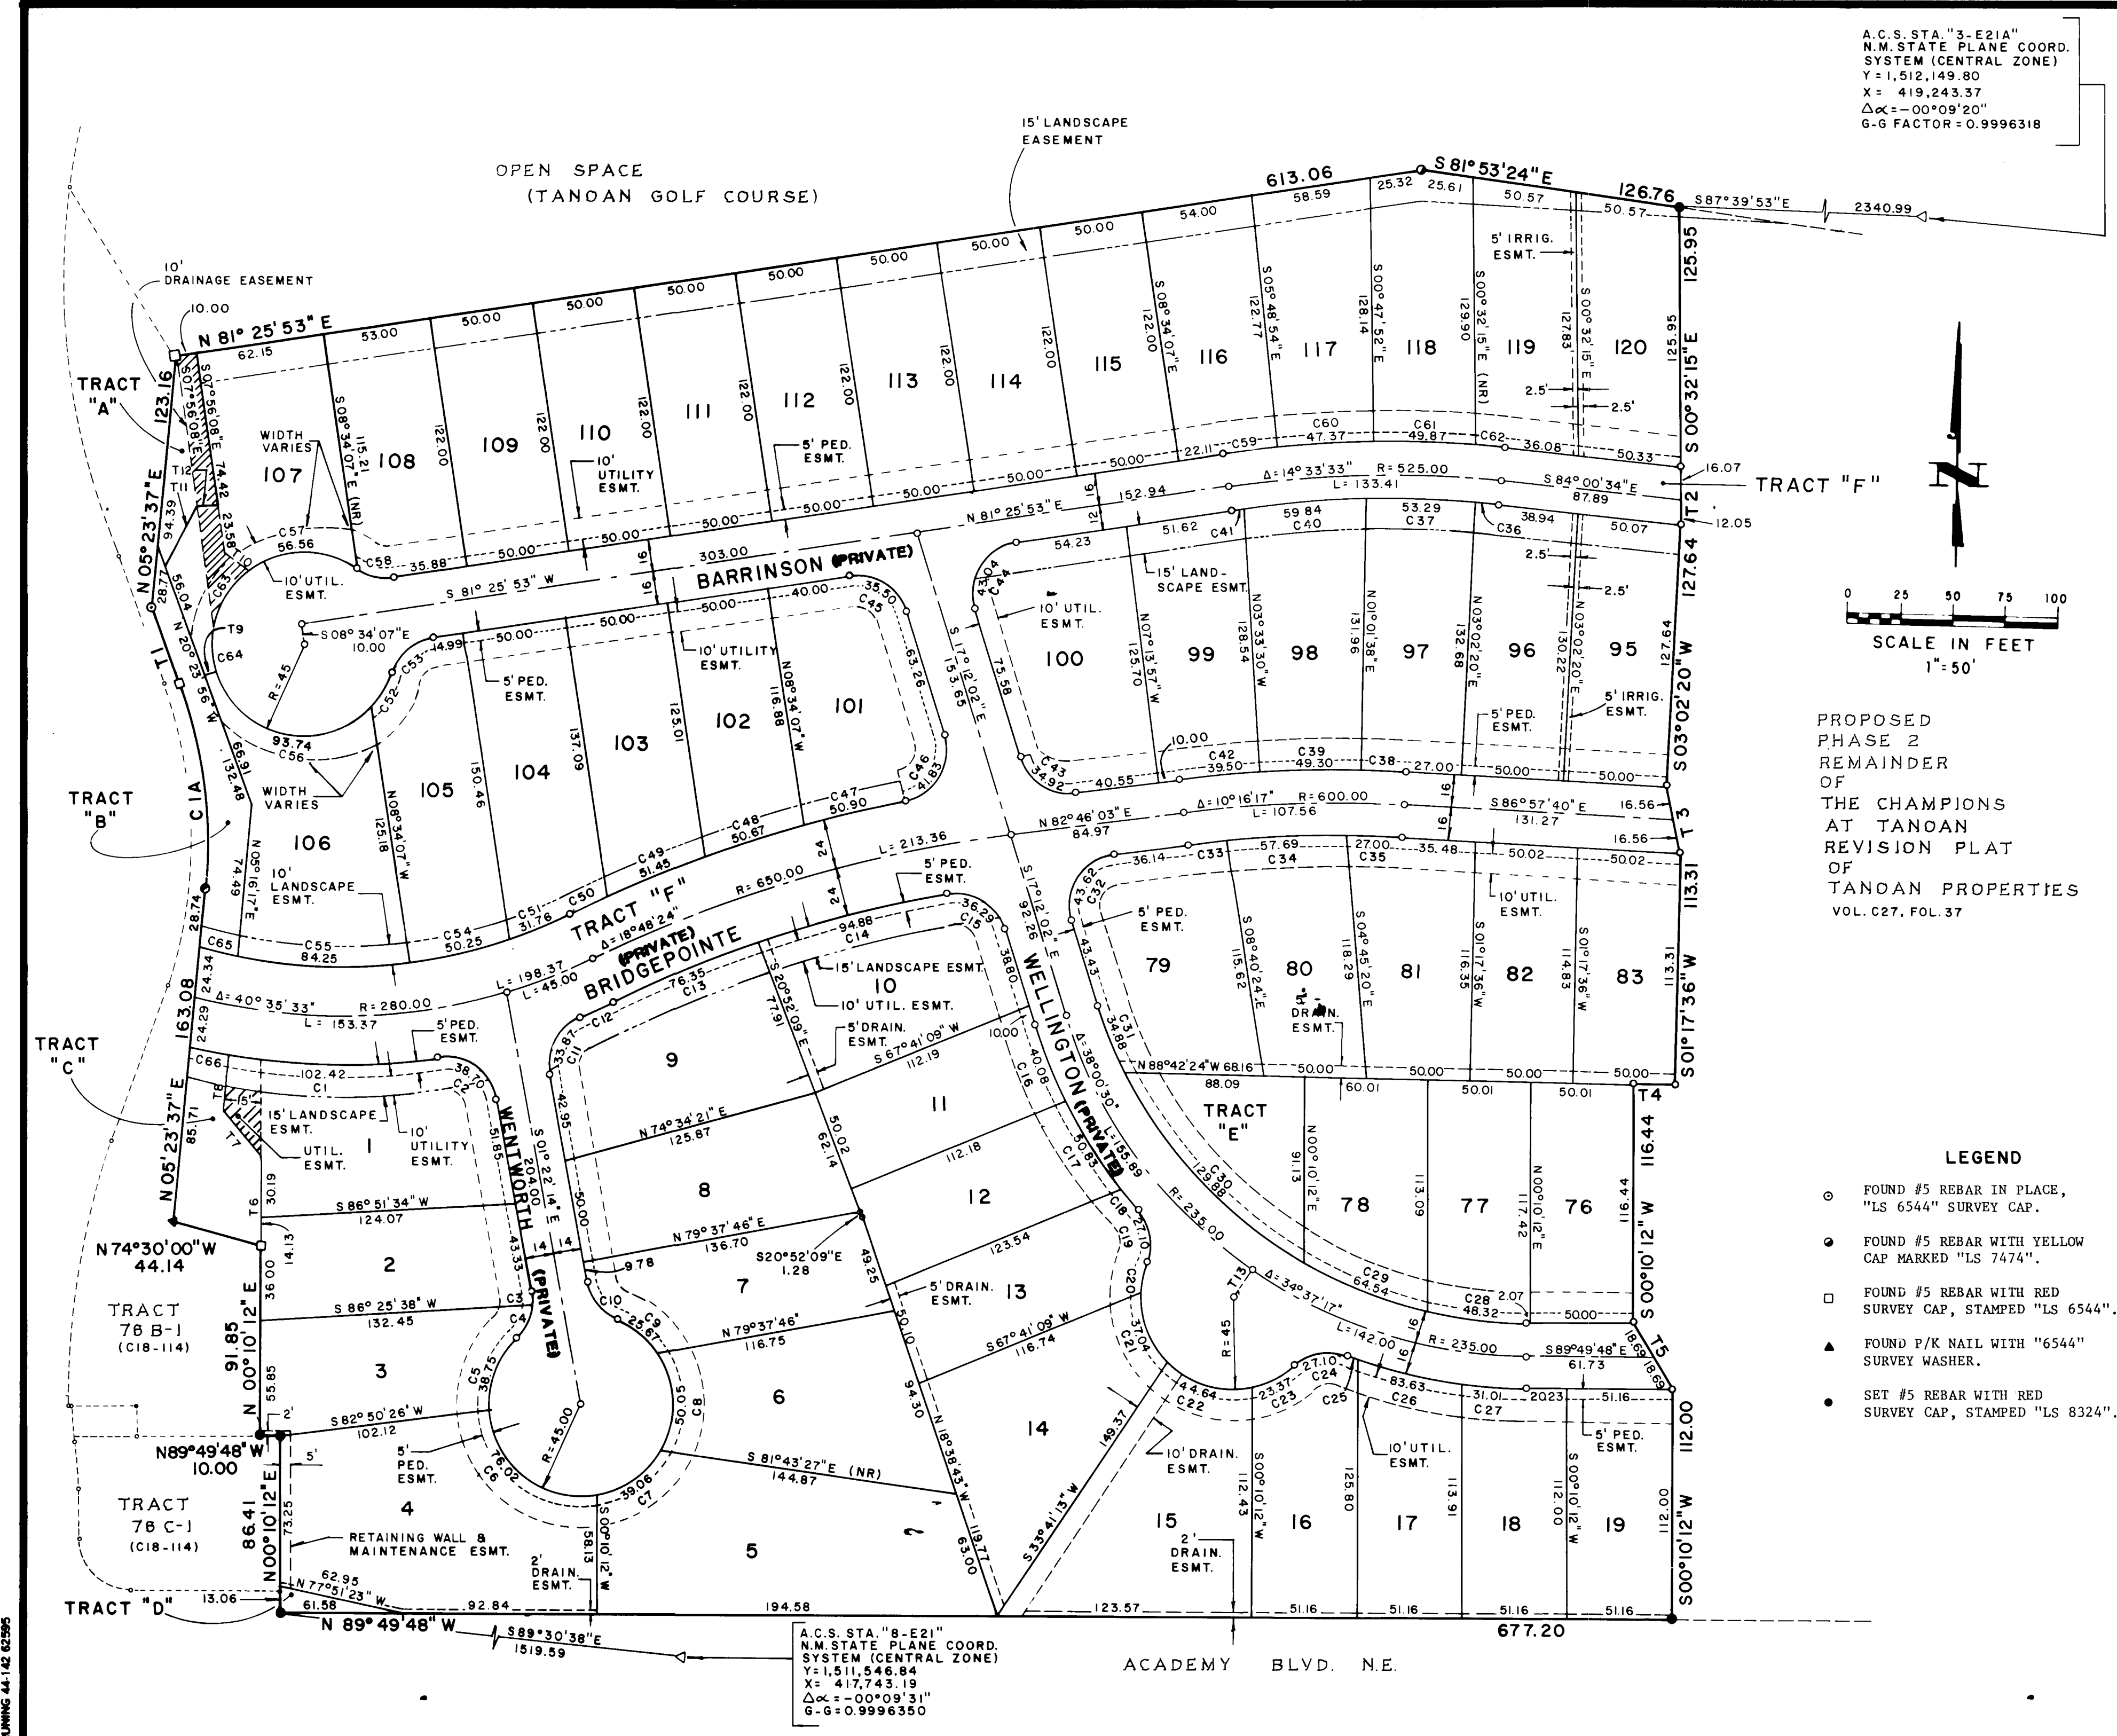

PROPOSED
PHASE 2
REMAINDER
OF
THE CHAMPIONS
AT TANOAN
REVISION PLAT
OF
TANOAN PROPERTIES
VOL. C27, FOL. 37

LEGEND

- FOUND #5 REBAR IN PLACE, "LS 6544" SURVEY CAP.
- FOUND #5 REBAR WITH YELLOW CAP MARKED "LS 7474".
- FOUND #5 REBAR WITH RED SURVEY CAP, STAMPED "LS 6544".
- FOUND P/K NAIL WITH "6544" SURVEY WASHER.
- SET #5 REBAR WITH RED SURVEY CAP, STAMPED "LS 8324".

Revisions

Design

Drawn J.P.W.

Check J.P.W.

Scale 1" = 50'

Date 1-14-87

Job No. 0690601

Sheet 2 of 3

Revisions

Design

Drawn

Check

Scale

Date 1-14-87

Job No. 0690601

Sheet 3 of 3

CURVE TABLE

NO.	DELTA	RADIUS	LENGTH	CHORD BEARING
C1A	25 27' 54"	229.00	101.78	N 07 20' 20" W
C1	19 18' 09"	304.00	102.42	S 89 24' 50" E
C2	88 41' 41"	25.00	38.70	S 54 43' 04" E
C3	13 55' 51"	25.00	6.08	S 03 24' 18" E
C4	42 12' 39"	25.00	18.42	S 24 30' 57" W
C5	49 20' 38"	45.00	38.75	S 21 05' 57" W
C6	96 47' 52"	45.00	76.02	S 51 58' 18" E
C7	49 43' 53"	45.00	39.06	N 54 45' 50" E
C8	63 43' 35"	45.00	50.05	N 01 57' 54" W
C9	32 41' 02"	45.00	25.87	N 50 10' 12" W
C10	56 08' 30"	25.00	24.50	N 38 26' 29" W
C11	77 37' 32"	25.00	33.87	N 28 26' 32" E
C12	03 17' 39"	304.00	17.48	N 65 36' 29" E
C13	06 59' 18"	626.00	76.35	N 67 27' 18" E
C14	08 41' 04"	626.00	94.88	N 75 17' 29" E
C15	83 09' 58"	25.00	36.29	S 58 47' 01" E
C16	09 09' 00"	251.00	40.08	S 21 46' 32" E
C17	11 36' 13"	251.00	50.83	S 32 09' 08" E
C18	02 59' 05"	251.00	13.08	S 39 26' 47" E
C19	62 06' 35"	25.00	27.10	S 09 53' 02" E
C20	19 00' 06"	45.00	14.92	S 11 40' 13" W
C21	47 09' 45"	45.00	37.04	S 21 24' 43" E
C22	56 50' 29"	45.00	44.64	S 73 24' 50" E
C23	29 45' 14"	45.00	23.37	N 63 17' 19" E
C24	62 06' 35"	25.00	27.10	N 79 27' 59" E
C25	01 15' 43"	251.00	5.53	S 70 08' 35" E
C26	19 05' 22"	251.00	83.63	S 80 17' 07" E
C27	07 04' 42"	251.00	31.01	S 86 17' 27" E
C28	12 38' 28"	219.00	48.32	N 83 30' 34" W
C29	16 53' 05"	219.00	64.54	N 68 44' 47" W
C30	33 58' 45"	219.00	129.88	N 43 18' 52" W
C31	09 07' 28"	219.00	34.88	N 21 45' 45" W
C32	99 58' 05"	25.00	43.62	N 32 47' 01" E
C33	01 57' 44"	584.00	20.00	N 83 44' 55" E
C34	05 39' 37"	584.00	57.69	N 87 33' 36" E
C35	02 38' 56"	584.00	27.00	S 88 17' 08" E
C36	01 14' 31"	513.00	11.12	S 84 37' 49" E
C37	05 57' 08"	513.00	63.29	S 88 13' 39" E
C38	02 00' 42"	616.00	21.63	N 87 58' 01" W
C39	04 35' 08"	616.00	49.30	S 88 44' 04" W
C40	06 41' 00"	513.00	59.84	N 85 27' 17" E
C41	00 40' 54"	513.00	6.10	N 81 46' 20" E
C42	03 40' 26"	616.00	39.50	S 84 36' 17" W
C43	80 01' 55"	25.00	34.92	N 57 12' 59" W
C44	98 37' 55"	25.00	43.04	N 32 06' 56" E
C45	81 22' 06"	25.00	35.50	S 57 53' 04" E
C46	95 52' 20"	25.00	41.83	S 30 44' 08" W
C47	04 19' 36"	674.00	50.90	S 76 30' 30" W
C48	04 18' 26"	674.00	50.67	S 72 11' 29" W
C49	04 22' 26"	674.00	51.45	S 67 51' 03" W
C50	01 42' 11"	674.00	20.03	S 64 48' 45" W
C51	07 06' 26"	256.00	31.76	S 67 30' 52" W
C52	25 38' 01"	45.00	20.13	N 30 32' 04" E
C53	63 42' 49"	25.00	27.80	N 49 34' 28" E
C54	11 14' 49"	256.00	50.25	S 76 41' 29" W
C55	18 51' 24"	256.00	84.25	N 88 15' 24" W
C56	102 43' 21"	45.00	80.68	S 85 17' 15" E
C57	72 00' 38"	45.00	56.56	S 88 39' 34" W
C58	43 14' 00"	25.00	18.86	N 76 57' 07" W
C59	02 45' 13"	541.00	26.00	S 82 48' 30" W
C60	05 01' 02"	541.00	47.37	S 86 41' 37" W
C61	05 16' 54"	541.00	49.87	N 88 09' 26" W
C62	01 30' 25"	541.00	14.23	N 84 45' 48" W
C63	43 17' 25"	45.00	34.00	S 31 00' 32" W
C64	26 39' 20"	45.00	20.94	S 03 57' 50" E
C65	04 14' 55"	256.00	18.98	N 76 42' 14" W
C66	03 35' 13"	304.00	19.03	S 77 58' 08" E

LOT AND TRACT AREA TABLE

LOT	SQ. FT.	ACRES	LOT	SQ. FT.	ACRES
1	9105.397	0.2090	109	6100.000	0.1400
2	6371.695	0.1463	110	6100.000	0.1400
3	6379.480	0.1465	111	6100.000	0.1400
4	12490.458	0.2867	112	6100.000	0.1400
5	12648.236	0.2904	113	6100.000	0.1400
6	8615.448	0.1978	114	6100.000	0.1400
7	6547.375	0.1503	115	6100.000	0.1400
8	7310.589	0.1678	116	6235.500	0.1431
9	8384.376	0.1925	117	6607.154	0.1517
10	8020.328	0.1841	118	6537.653	0.1501
11	5571.983	0.1279	119	6439.412	0.1478
12	5839.983	0.1341	120	6344.393	0.1456
13	6291.827	0.1444	A	1671.389	0.0384
14	9091.138	0.2087	B	3072.632	0.0705
15	9847.363	0.2261	C	2774.535	0.0637
16	6298.467	0.1446	D	402.109	0.0092
17	6083.428	0.1397	E	4832.238	0.1109
18	5749.389	0.1320	F	87702.346	2.0134
19	5729.696	0.1315			
76	5846.301	0.1342			
77	5810.931	0.1334			
78	6228.460	0.1430			
79	8353.656	0.1918			
80	6282.409	0.1442			
81	6588.712	0.1513			
82	5779.579	0.1327			
83	5703.393	0.1309			
95	6446.471	0.1480			
96	6574.930	0.1509			
97	6758.181	0.1551			
98	7110.953	0.1632			
99	6791.421	0.1559			
100	8764.915	0.2012			
101	7692.138	0.1766			
102	6031.308	0.1385			
103	6535.864	0.1500			
104	7213.126	0.1656			
105	7290.967	0.1674			
106	8635.106	0.1982			
107	8191.327	0.1880			
108	6429.648	0.1476			

TANGENT TABLE

NO.	BEARING	DIST.
T1	N 20 04' 17" W	38.97
T2	S 00 40' 35" W	28.12
T3	S 11 53' 20" E	33.12
T4	N 88 42' 24" W	20.04
T5	S 30 56' 32" E	37.38
T6	N 00 10' 12" E	44.32
T7	N 40 33' 59" W	28.46
T8	N 05 16' 17" E	27.34
T9	N 72 42' 31" E	6.26
T10	N 54 04' 16" W	15.07
T11	S 28 20' 55" W	33.30
T12	S 82 03' 52" W	10.00
T13	S 34 47' 29" W	16.00

25 30 9 6 0 3 8 7


PRELIMINARY ONLY

DRAWING NO. 3096

SHEET 3 OF 28

BRUNING 44-142 62395

BRUNING 44-142 62395

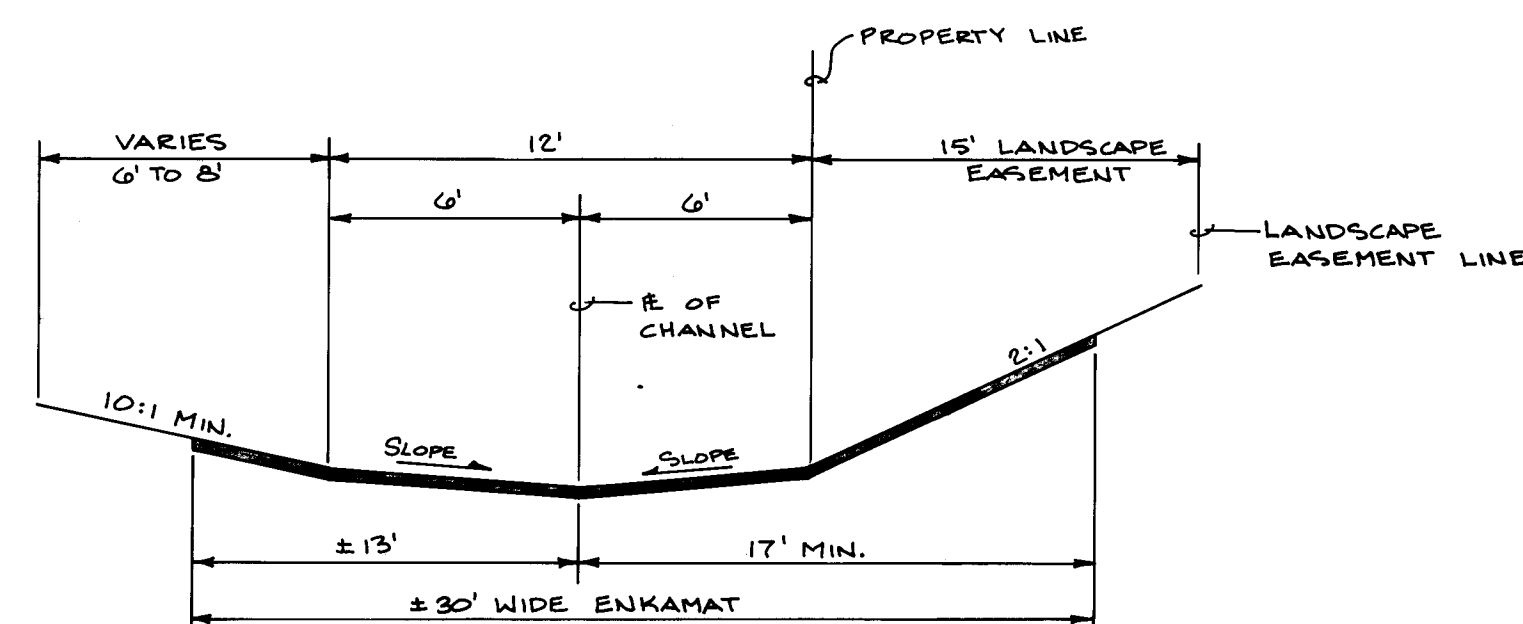

NOTE: INSTALL 30' x 0.25' ENKAMMAT. SEE GRADING PLAN FOR LIMITS OF ENKAMMAT INSTALLATION. ANTICIPATED 0.100 DRAINAGE RUN-OFF IN THIS AREA OF CHANNEL; 2.5' DEEP FLOWS, 10 F.P.S. @ 12" FREE BOARD REQUIRED.


PINO ARROYO CHANNEL DETAIL
N.T.S.

NOTE TO CONTRACTOR:
OVER LOT GRADE SHOULD BE STAKED AT 0.3' BELOW SHOWN FINISH PAD ELEVATIONS. EXCESS MATERIAL FROM PLUMBING AND HVAC ROUGH-IN TRENCHING WILL BE USED TO GRADE PAD TO ELEVATION SHOWN.

NOTE TO CONTRACTOR:
ALL GRADING TO BE COMPLETED UNDER PHASE I

ENKAMMAT INSTALLATION LIMITS. SEE PINO ARROYO CHANNEL DETAIL


LANDSCAPE EASEMENT

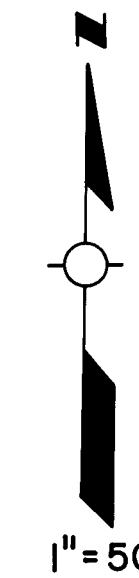

LEGEND

FUTURE	PROPOSED	EXISTING	DESCRIPTION
---	---	---	CURB & GUTTER
		⊗	SPRINKLER (GOLF COURSE)
		○	SPRINKLER (TANOAN)
		□	SPRINKLER CONTROL BOX
		---	DROP INLET
		---	WATER BLOCK
		---	CONTOUR
		---	SIDEWALK
		---	SIDEWALK CULVERT
		---	SUBDIVISION BOUNDARY
		---	MATCHLINE AND/OR PHASE LIMIT
		---	RETAINING WALL
		---	PROPERTY LINE
		---	CONCRETE RUNDOWN
		---	FINISHED GROUND ELEVATION
		---	TOP OF RETAINING WALL
		---	BOTTOM OF RETAINING WALL
		---	TOP OF CURB
		---	FLOWLINE
		---	LOT NUMBER
		---	PROPOSED PAD WITH PAD ELEVATION
		---	EMERGENCY ACCESS ENTRANCE
		---	TOP OF RETEMENT WALL ELEVATION
		---	BLOCK WALL
		---	EXISTING BLOCK WALL TO REMAIN
		---	EXISTING BLOCK WALL TO BE REMOVED

EXISTING BLOCK WALL IS TO REMAIN. 72' OF EXISTING BLOCK WALL IS TO BE REMOVED AT BRIDGEPOINTE.

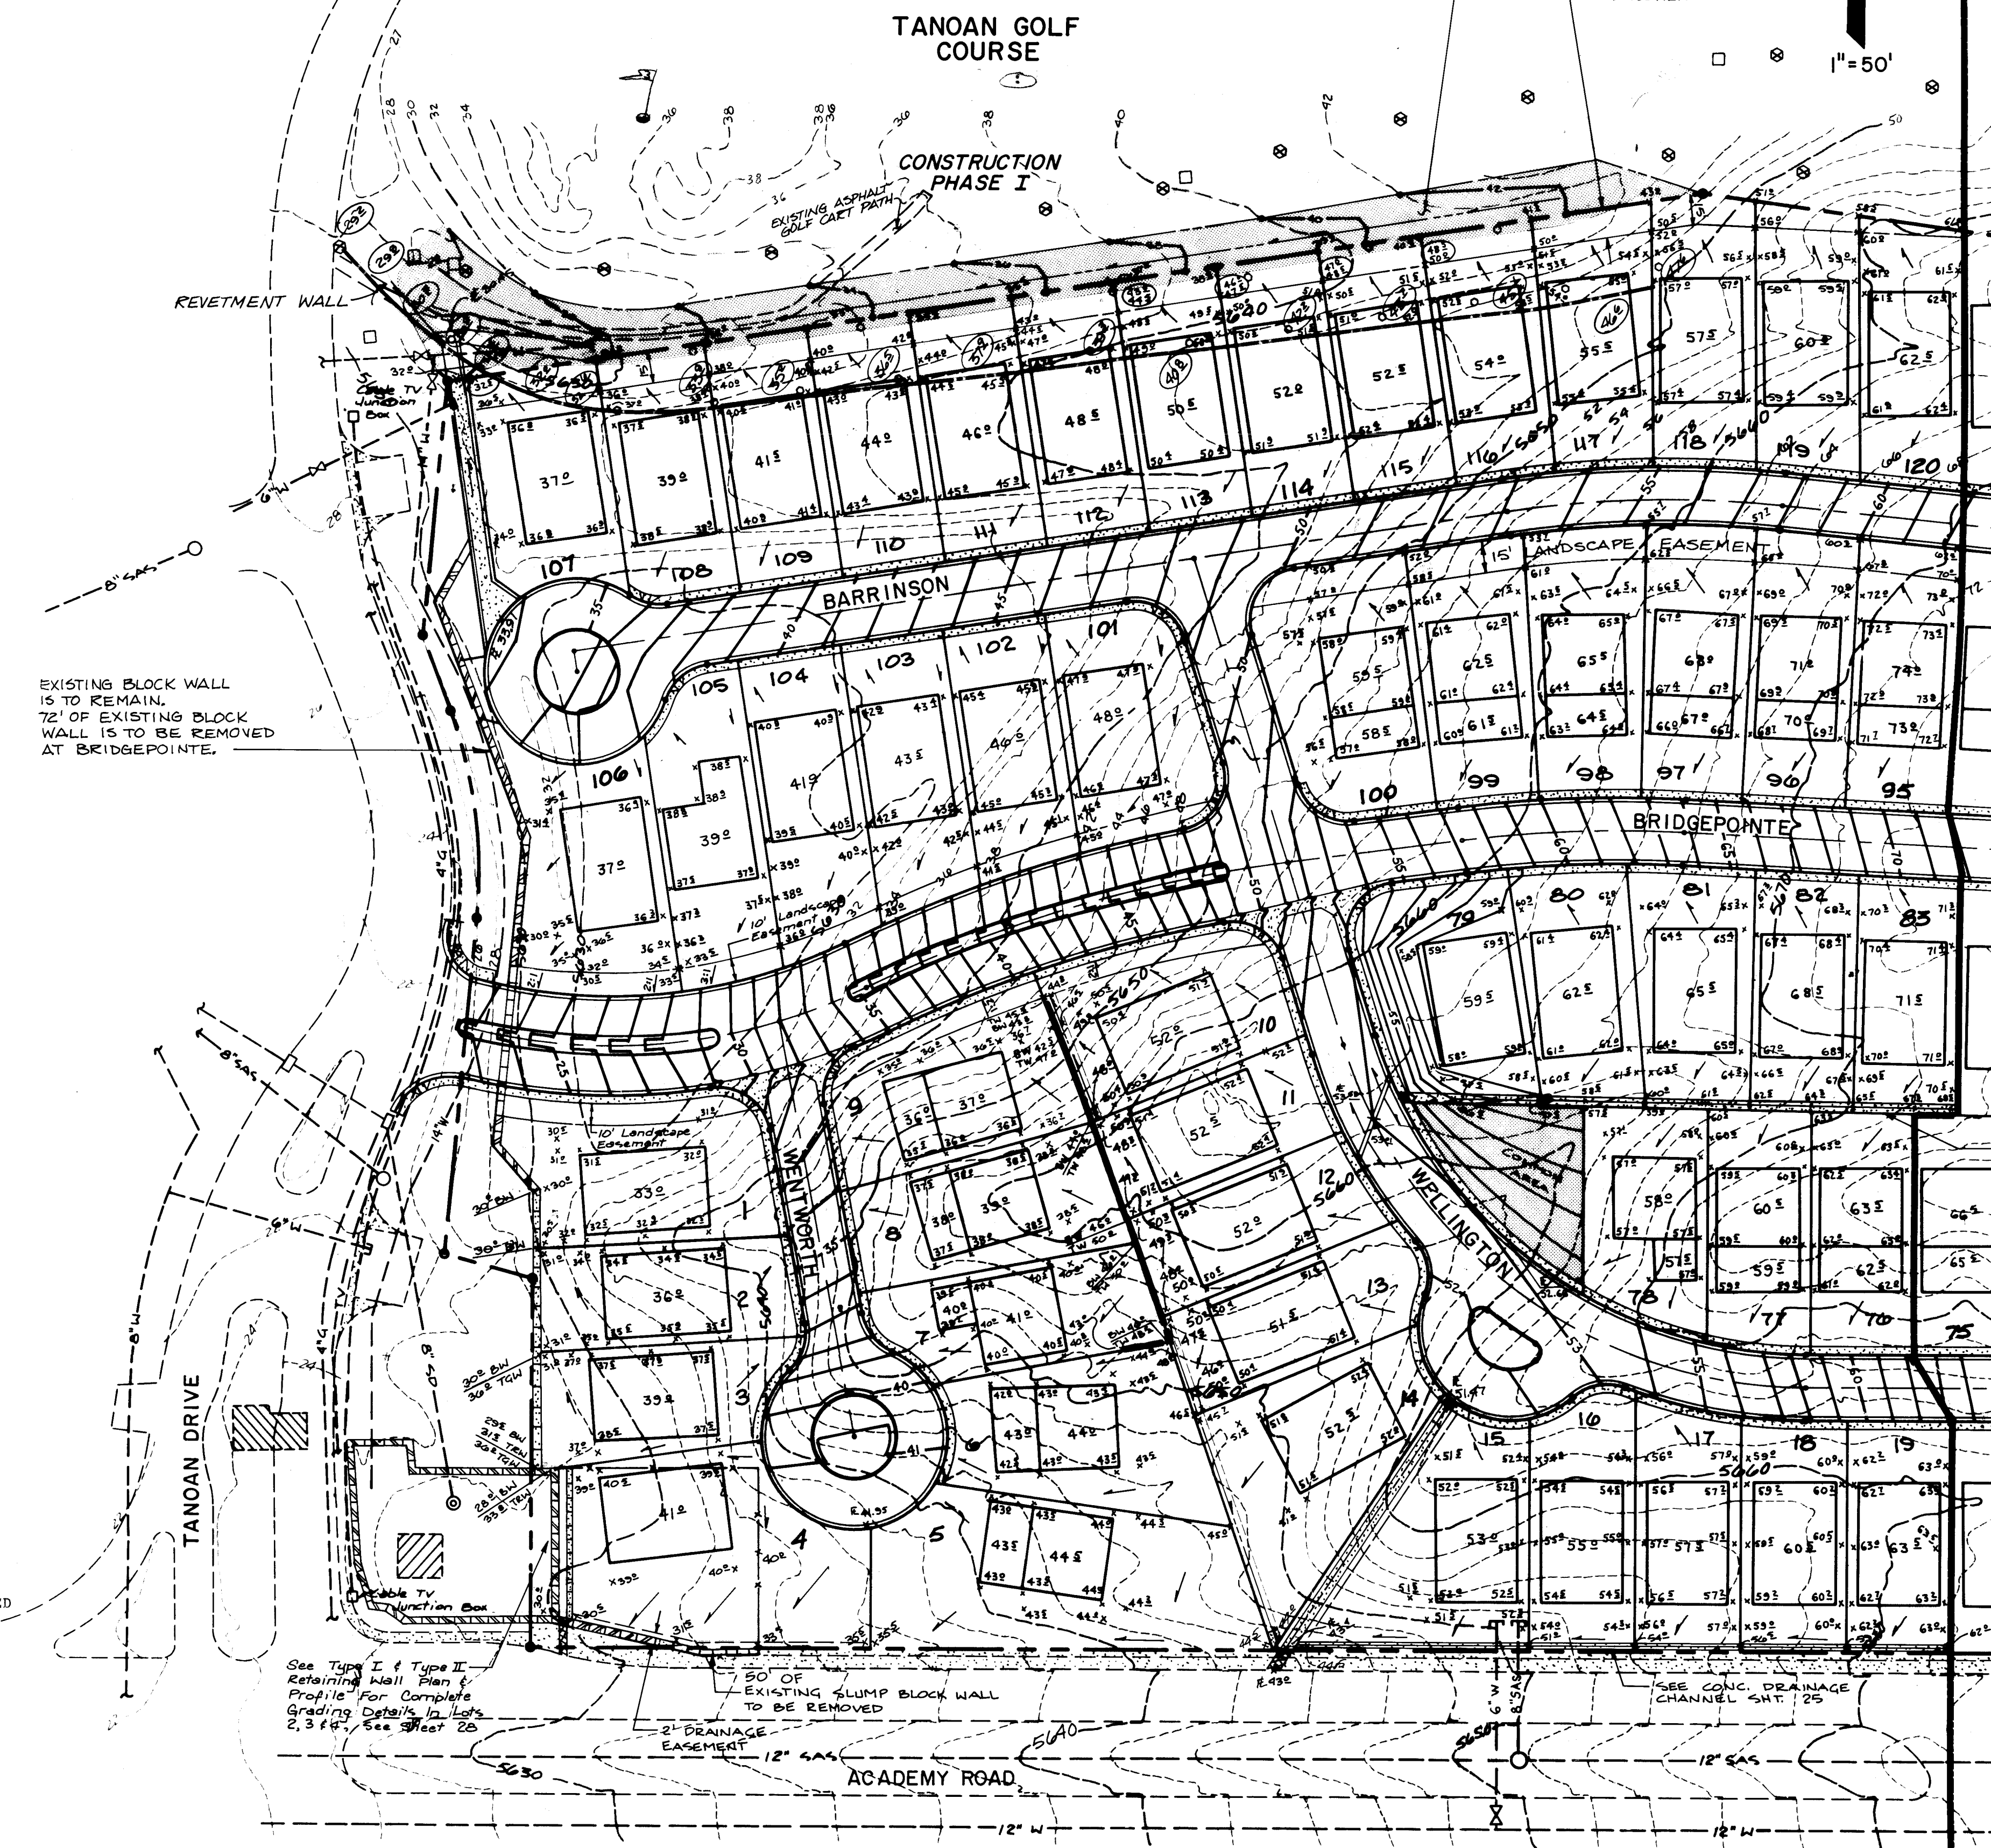

See Type I & Type II Retaining Wall Plan & Profile for Complete Grading Details. See 2.3.1.1. See 2.3.1.2. See 2.3.1.3.

30' OF EXISTING SLUMP BLOCK WALL TO BE REMOVED

SEE CONC. DRAINAGE CHANNEL SHT. 25

GENERAL NOTES

- The Contractor and Mr. John Brown (Inman Homes) shall coordinate with the Tanoan Community Golf Course staff and Tanoan Home Owners Association on the removal and replacement of sod and asphalt golf cart path. The Contractor shall be responsible for any breakage of existing irrigation system, water meters and valves. The Contractor shall also be responsible for any other damages such as trees and any other utility breakage on site.
- Enkammat installation shall be per Sec. 604, City of Albuquerque Interim Specification, manufactures recommendations. Call American Excelsior Co. for details, (505) 345-7806.
- Where backyard swales (easements) cross property lines, garden wall blocks should be turned to allow for drainage.
- See sheet 23 for additional notes.

AS BUILT INFORMATION			BENCH MARKS		
CONTRACTOR	DATE	BY	CONTRACTOR	DATE	BY
WORK	DATE	BY	CONTRACTOR	DATE	BY
STAKE	DATE	BY	CONTRACTOR	DATE	BY
FIELD	DATE	BY	CONTRACTOR	DATE	BY
REVISIONS	DATE	BY	CONTRACTOR	DATE	BY
DESIGN	DATE	BY	CONTRACTOR	DATE	BY
CHECKED	DATE	BY	CONTRACTOR	DATE	BY
DRAWN	DATE	BY	CONTRACTOR	DATE	BY
CHECKED	DATE	BY	CONTRACTOR	DATE	BY

26 30 9 6 0 4 8 7

Approved Rough Grading
Caleb A. Maty.

SCALE: 1" = 50'
EXISTING CONTOUR INTERVAL: 2'
DATE OF PHOTOGRAPHY: 8/7/86 BY T.R. MANN


Greiner Engineering
2601 Wyoming NE
Albuquerque, New Mexico 87112
(505) 292-1936

CITY OF ALBUQUERQUE PUBLIC WORKS DEPARTMENT ENGINEERING DIVISION					
TITLE: THE CHAMPIONS AT TANOAN					
GRADING PLAN WEST					
APPROVALS	ENGINEER	DATE	APPROVALS	ENGINEER	DATE
City Engineer	ALM	2/10/87	Liquid Waste	WU	2/13/87
A.C.E. Design			Traffic	NA-DMH	2/13/87
A.C.E. Hydrology	CAM	2-20-87	Water	WU	2-13-87
DRAWING NO.	3096	MAP NO.	E-21	SHEET	4 OF 28


TANOAN GOLF COURSE

1" = 100'

VILLAGE
GREENS AT
TANOAN

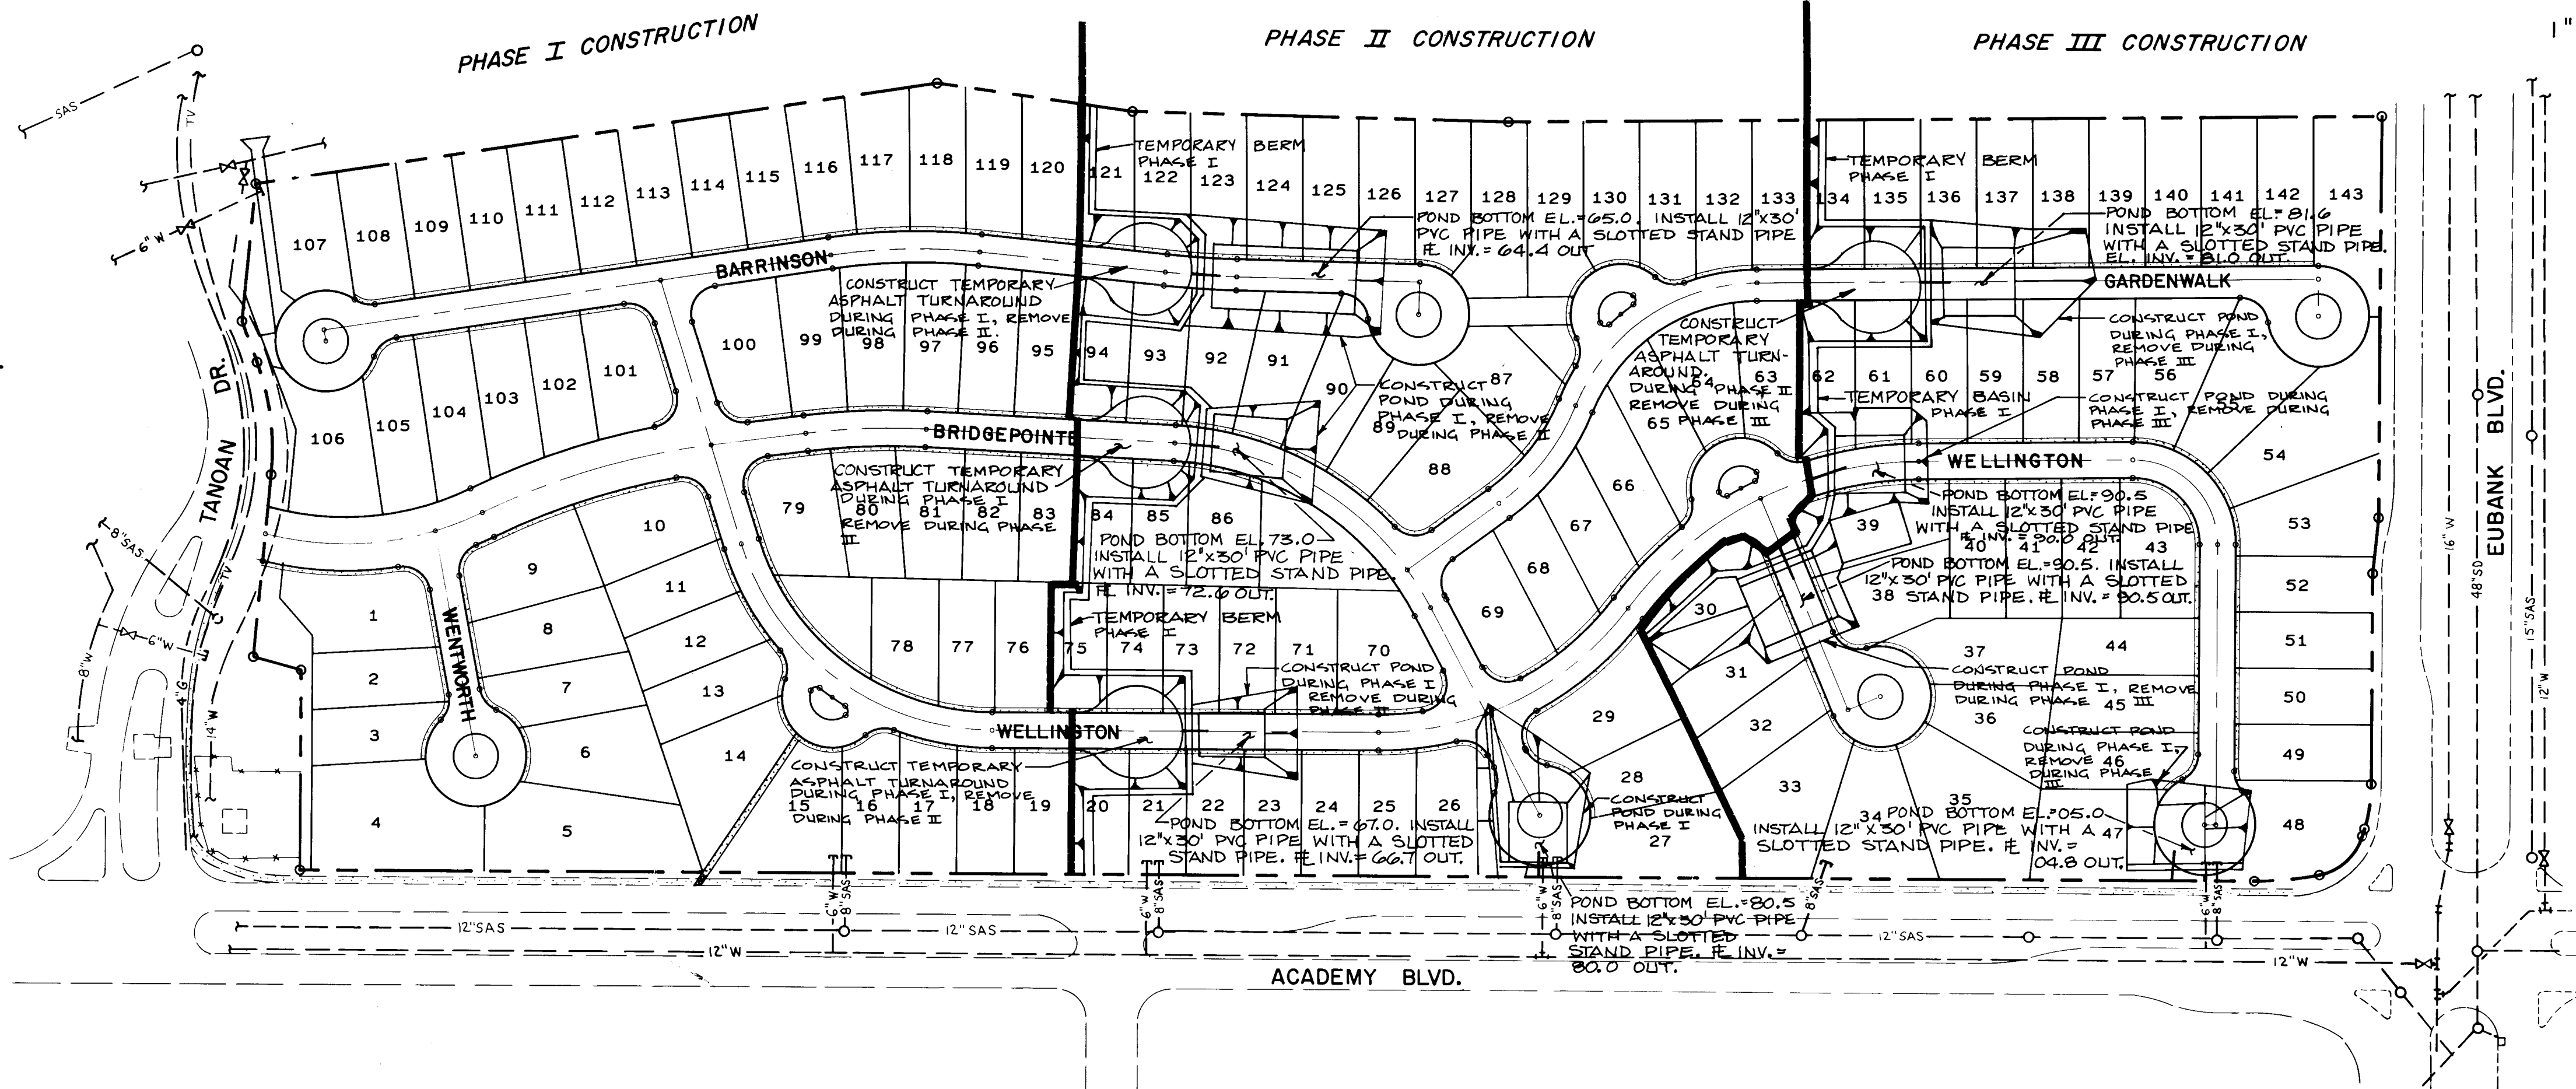


END PROPOSED CURB AND GUTTER & RESIDENTIAL PAVEMENT SECTION AT THE PHASE CONSTRUCTION LINE. WHEN PHASE II & III ARE UNDER CONSTRUCTION THE CONTRACTOR SHALL SAWCUT 12" BACK INTO THE EXISTING PAVEMENT LEAVING A SMOOTH, STRAIGHT LINE BEFORE LAYING ANY NEW ASPHALT PAVEMENT. NO SEPARATE PAYMENT SHALL BE MADE AND SHALL BE CONSIDERED INCIDENTAL TO THE PROJECT.

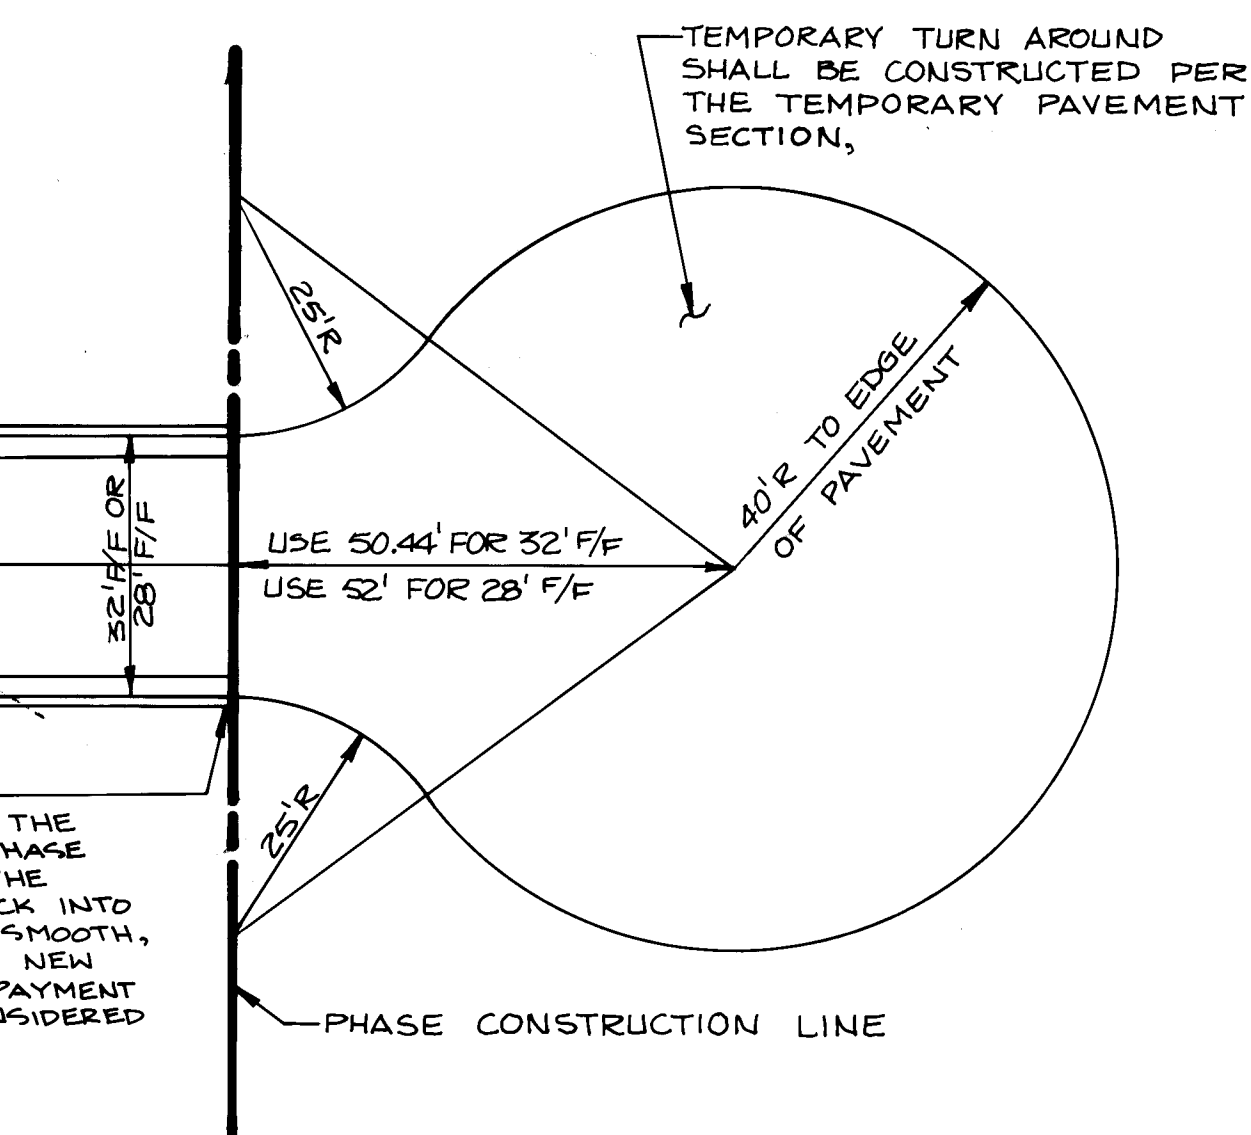


TEMPORARY ASPHALT TURN AROUND

SCALE: 1" = 20'

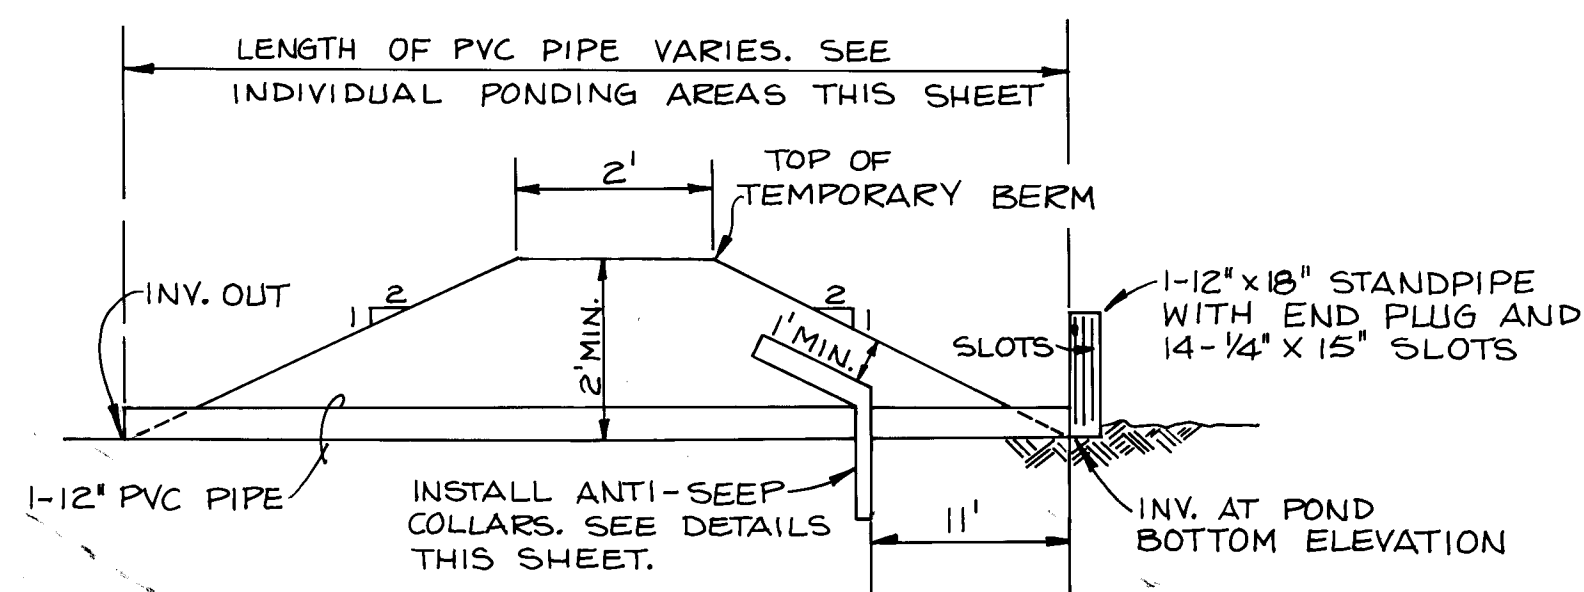


NOTE: CONSTRUCT TEMPORARY BERM OF CLEAN EARTHEN MATERIAL. FILL TO BE COMPACTED TO 90% MINIMUM MODIFIED PROCTOR.

BERM & OUTFLOW PIPE DETAIL

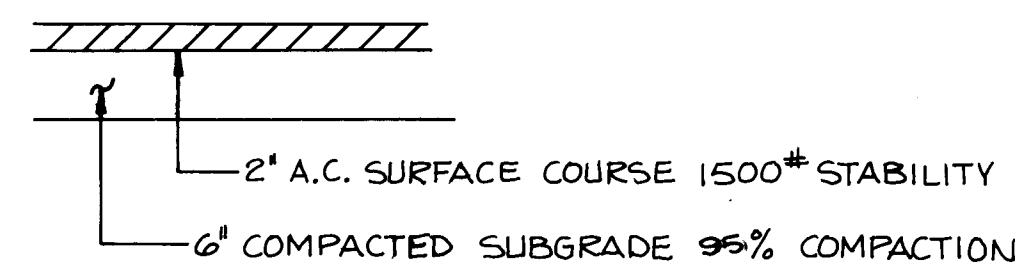

TEMPORARY PAVEMENT SECTION

N.T.S.

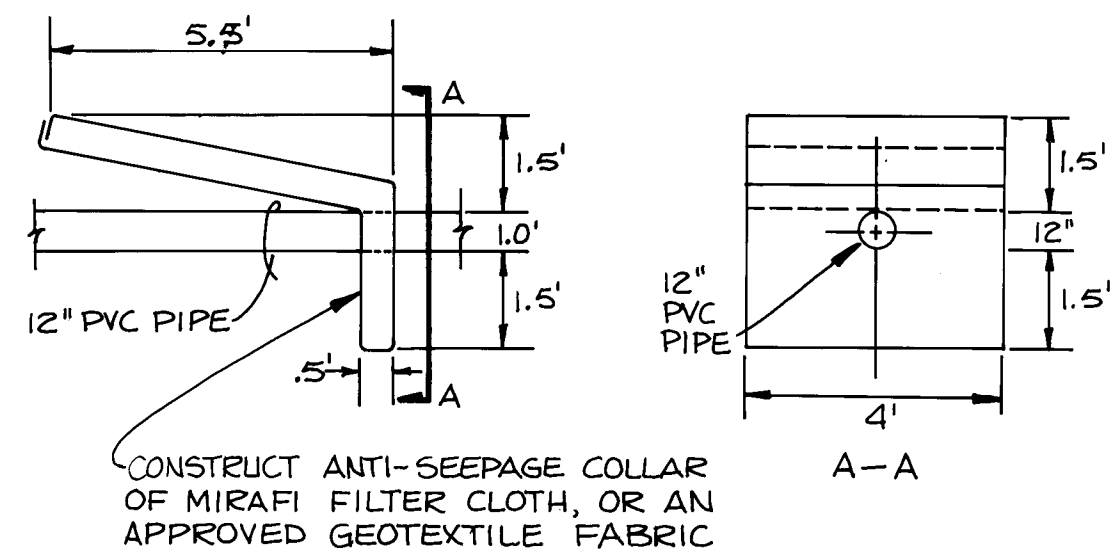

ANTI-SEEPAGE COLLAR DETAIL

SCALE: 1" = 3'

GENERAL NOTES

- During the construction of the proposed perimeter wall, the wall contractor shall place one (1) block over on its side every 10' for uniform backyard drainage, except along south R/W on Academy Road.
- The following lots 48 thru 54 will drain onto the Eubank Blvd. R/W via turned over blocks within the perimeter wall. The turned over blocks will be every + 10'.
- During the Phase I construction, should any silt or trash be washed onto Academy Road, Tanoan Drive, or the golf course as a result of a rain storm, the Contractor/developer shall be responsible for the maintenance and clean-up of deposits. Clean-up shall be done as quickly as possible after a storm.
- Sidewalk culverts will be required during construction of the Champions. See Overall Private Street Paving Plan for sidewalk culvert locations.
- Temporary detention pond shall be lined with impervious linings. Use 10 mil. polyethylene sheeting lapped + 1 foot at the joint, for the full width of the detention pond. The lining should be covered with + 6" foot of top soil.

AS BUILT INFORMATION			BENCH MARKS			SURVEY INFORMATION			ENGINEER'S SEAL		
CONTRACTOR	WORK	DATE	CONTRACTOR	WORK	DATE	NO.	BY	DATE	ENGINEER'S SEAL	PROJECT NO.	0690600
CONTRACTOR	WORK	DATE	CONTRACTOR	WORK	DATE	1748	GREINER	1986		DESIGNED BY	DATE 1-87
CONTRACTOR	WORK	DATE	CONTRACTOR	WORK	DATE	1653	GREINER	6-84			
CONTRACTOR	WORK	DATE	CONTRACTOR	WORK	DATE	1653	GREINER	6-84			
CONTRACTOR	WORK	DATE	CONTRACTOR	WORK	DATE	1653	GREINER	6-84	DESIGNED BY	DATE 1-87	DATE 1-87
CONTRACTOR	WORK	DATE	CONTRACTOR	WORK	DATE	1653	GREINER	6-84	DRAWN BY	DATE 1-87	DATE 1-87
CONTRACTOR	WORK	DATE	CONTRACTOR	WORK	DATE	1653	GREINER	6-84	CHECKED BY	DATE 1-87	DATE 1-87

Greiner Engineering

2601 Wyoming NE
Albuquerque, New Mexico 87112
(505) 292-1936


CITY OF ALBUQUERQUE
PUBLIC WORKS DEPARTMENT
ENGINEERING DIVISION

TITLE: THE CHAMPIONS AT TANOAN
TEMPORARY ASPHALT TURNAROUND AND
EROSION CONTROL PLAN

APPROVALS	ENGINEER	DATE	APPROVALS	ENGINEER	DATE
City Engineer	ALH	2/13/87	Liquid Waste	WJW	2-13-87
A.C.E. Design	"	"	Traffic	NAJH	2/13/87
A.C.E. Hydrology	CAM	2-20-87	Water	WJW	2-13-87

DRAWING NO. 3096 MAP NO. E-21 SHEET 6 OF 28

Caution: There are Several Utilities Located Within The Tanoan Drive Right-of-Way. The Contractor Should Have Utilities Verified and Marked Prior To Any Grading or Construction.

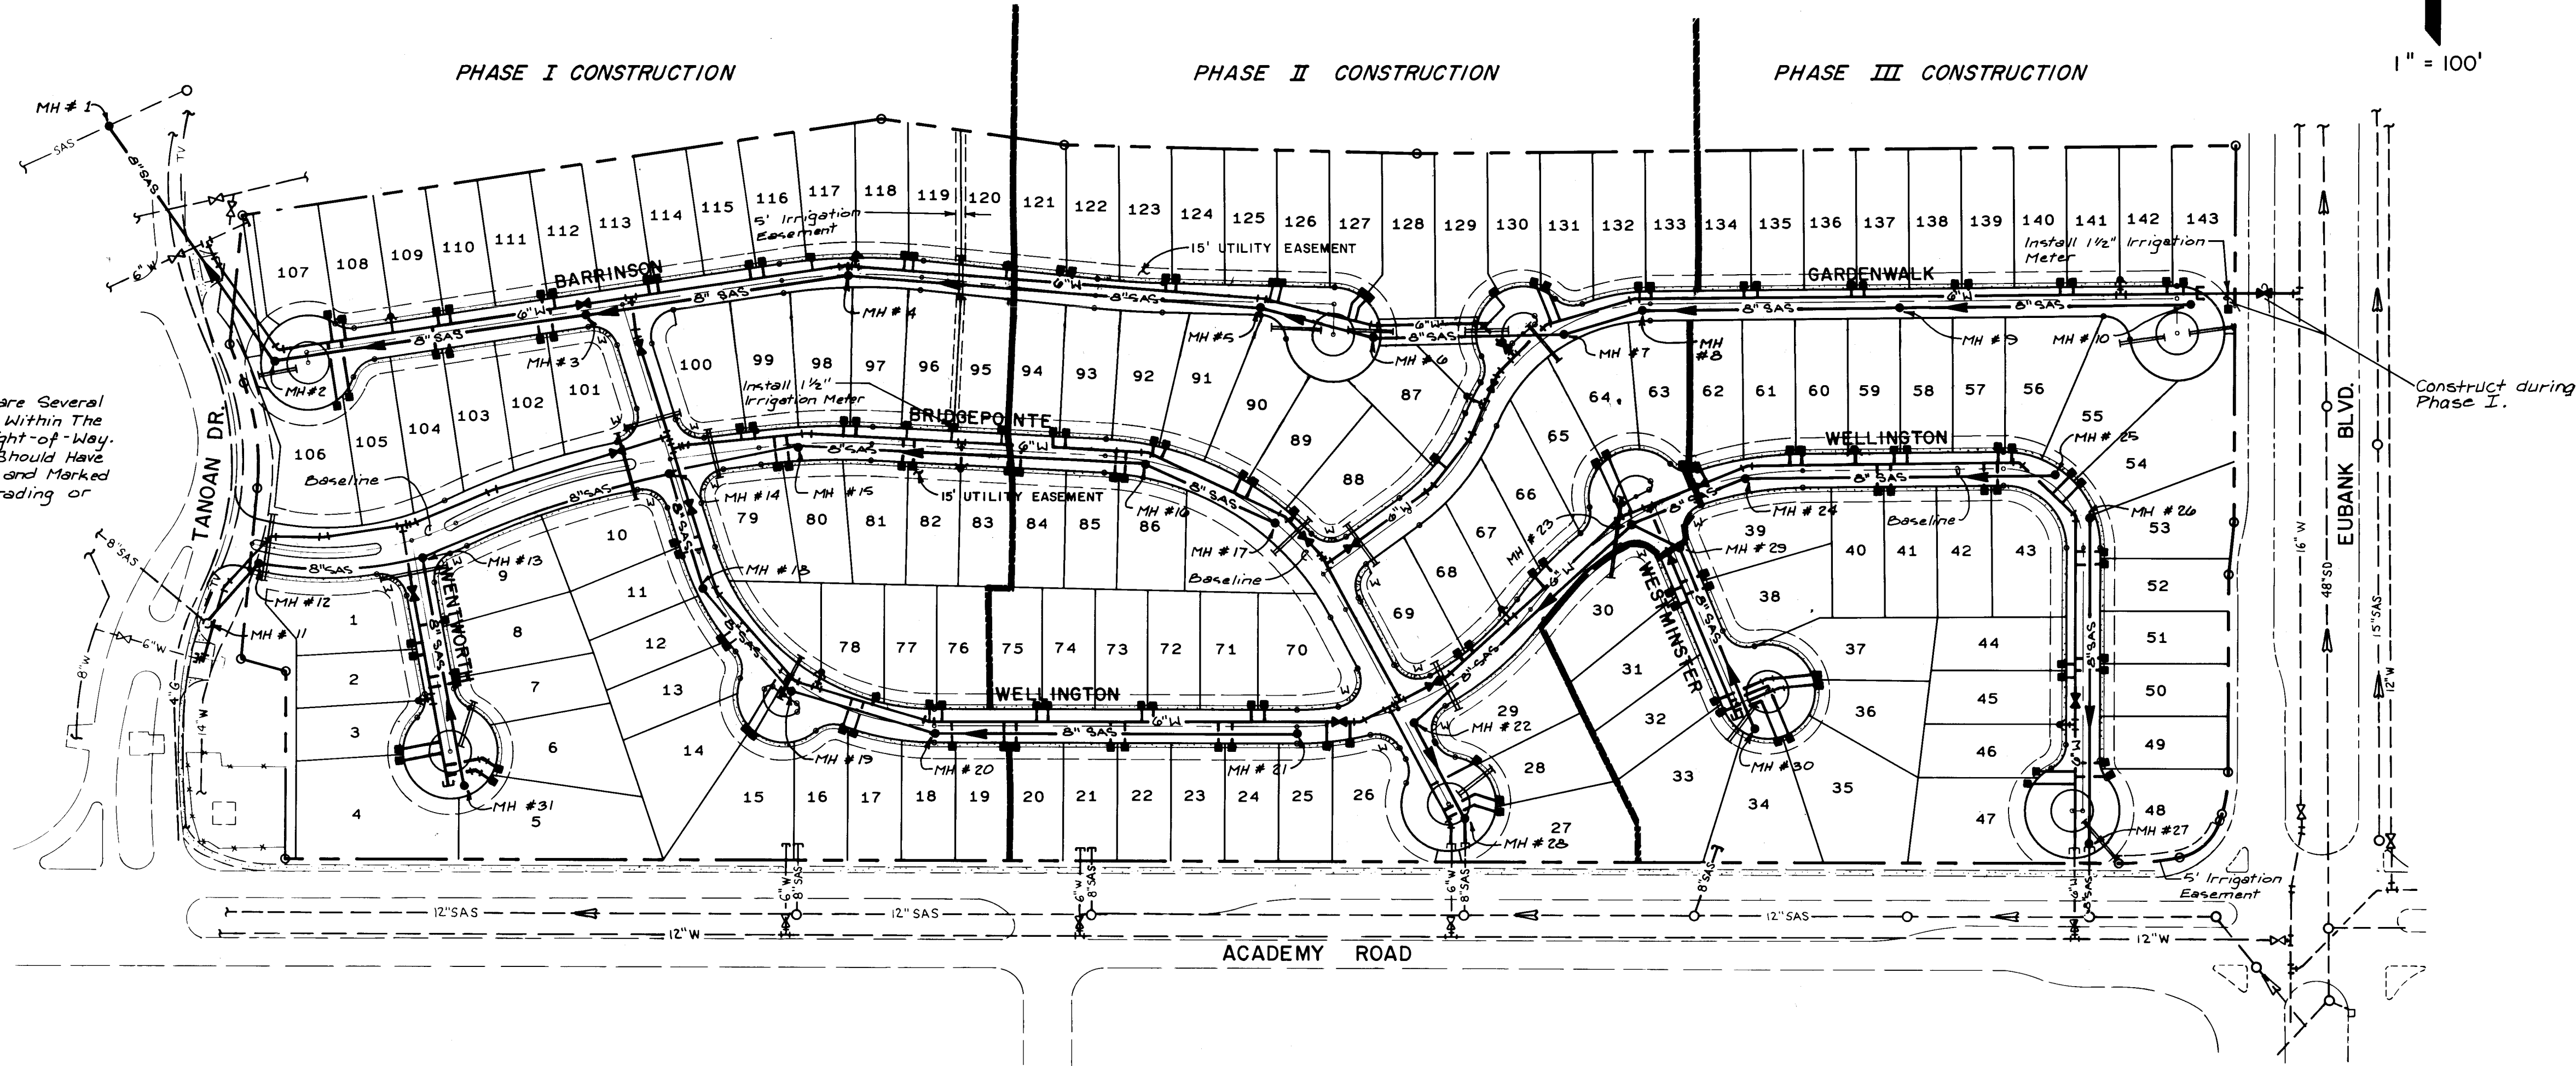

SANITARY SEWER NOTES

- Sanitary sewer and sewer service installation shall comply with all applicable City of Albuquerque standards.
- All stationing is based on street baseline, and in some cases is different than the stationing for the street paving improvements.
- Slopes shown on the profiles are based on true distances, not baseline stationing. Lengths shown on profiles are true distances from center of manhole to center of manhole.
- All manholes shall be 4' diameter, Type "E", as per City of Albuquerque Standard Drawing S-2, unless otherwise noted.
- Sewer service laterals shall be provided with electronic marker disks as per City of Albuquerque Standard Drawing S-12. EMD shall be provided in accordance with Section 170 of the City of Albuquerque Interim Standard Specifications Public Works Construction - 1985.
- Note the proximity of water and sanitary sewer lines, Section 701.8.1 (Interim Standard Specifications Public Works 1985).
- Where the sewer line is to be deflected, maximum allowable deflection shall be two-thirds (2/3) of the manufacturer's recommended allowable deflection.
- All service connections shall be made such that the service is perpendicular or radial to the sewer main. (See Notes 10 & 11).
- All service connections shall have a slope of 1/4" per foot toward the main and shall have a minimum depth of 4' below the top of curb elevation from the finished surface projected to the property line measured to the pipe invert.

- All service connections must be made to the main line except at the end of cul-de-sacs where connection to a manhole is permitted in the manner shown in the City Standard Details.
- Service connections to a manhole are to be made with the invert of the service at the elevation of the top of the main line.
- PVC SAS line shall meet the requirements of ASTM F 679. See Section 121.3.2.2, City of Albuquerque Interim Standard Specifications Public Works Construction.
- See Utility P & P sheets for sewer service locations and inverts.
- Proposed 8" SAS mains shall terminate 10' east of the Construction Phase Line. SAS mains shall be plugged at the terminus of the line in a manner that is approved by the City of Albuquerque WRD. In order that pressure loss testing can be done on the new SAS line installation. An EMD must be placed over the terminus of the SAS main.
- Fire hydrants shall be placed 4' from back of curb, similar to City of Albuquerque Standard Dwg. W-20.

WATERLINE NOTES

- Waterline and water service (3/4") installation shall comply with all applicable City of Albuquerque standards.
- Waterline shall have a minimum cover of 4'-0" for water transmission lines 10" and over, and a minimum cover of 3'-6" for water distribution lines 8" and under, unless otherwise noted.
- All stationing is based on street baseline, and in some cases is different than the stationing for the street paving improvements.
- Where the waterline is to be deflected, maximum allowable deflection shall be two-thirds (2/3) of the manufacturer's recommended allowable deflection.
- Water services shall have a minimum of 1'-0" clearance from plugs at connection to water mains.
- PVC waterline shall meet the requirements of AWWA C 900. See Section 121.3.1, City of Albuquerque Interim Standard Specifications Public Works Construction.
- Electronic Marker Disks (EMD) shall be installed in accordance with Section 170 City of Albuquerque Interim Standard Specifications for Public Works Construction.
- Proposed 6" Watermains shall terminate 10' east of the Construction Phase Line. Watermains shall be capped, concrete blocked and an EMD placed over the terminus of the watermain.
- Install Irrigation Sleeve 18" min. bury from top of finish grade, extend sleeve 1' past the curb or sidewalk, mark both ends of the curb with paint.

LEGEND

PROPOSED	EXISTING	
		Water Line
		Water Service Boxes
		Water Valves
		Fire Hydrant
		Tees
		Crosses
		Bends
		Caps
		Sanitary Sewer
		Manholes
		Sewer Service Connections
		Plugs
		Sidewalk
		Conc. Rundown
		Cable Television
		Gas Line
		Storm Sewer
		Phase Limit
		Wheelchair Ramp
		4" PVC Irrigation Sleeve

GENERAL NOTES

- Contractor should field verify all existing utility locations at point of connection for new construction. If locations are greatly different than those shown, the Engineer must be contacted. Information shown is from the record drawings available from the City of Albuquerque and the Engineer does not certify their correctness.
- The proposed 6" watermain and 8" sanitary sewer lines will be constructed in a 3 phased construction plan. See Watermain Note No. 8 and Sanitary Sewer Main Note No. 14.
- Trenches and Excavation: These notes are credited to Fox and Associates of New Mexico, Geotechnical Investigation for the Champions at Tanoan, Job No. 0119590.
 - All trenches and excavations greater than 5 feet deep must be sloped, shored, sheeted, braced, or otherwise supported according to OSHA construction safety and health standards. Where unstable soil conditions are encountered in trenches shallower than 5 feet these trenches must also be sloped, shored or supported.
 - Trenches for utility lines shall be a minimum of 16 inches wide. Backfill for utility trenches may not be floated or jetted. Backfill shall be placed and compacted as specified for structural backfill. Particular care shall be taken to compact the backfill below the springline of pipes.
- The Contractor shall notify the Tanoan Community ten days in advance of proposed traffic control and barricading on Tanoan Drive prior to any pavement cuts and utility work.
- No separate payment shall be made for final adjustment of manhole rim, valves etc.

AS BUILT INFORMATION

CONTRACTOR
WORK
DATE

DATE
1986
GREINER

DATE
6-84
GREINER

DATE
1653
GREINER

DATE
Aerial Photography
Ton Mann and Assoc.

DATE
8-7-86
Ton Mann and Assoc.

DATE
8-7-86
Ton Mann and Assoc.

ENGINEER'S SEAL

DATE
1986
GREINER

DATE
6-84
GREINER

DATE
1653
GREINER

DATE
Aerial Photography
Ton Mann and Assoc.

DATE
8-7-86
Ton Mann and Assoc.

DATE
8-7-86
Ton Mann and Assoc.

REVISIONS

DATE
1986
GREINER

DATE
6-84
GREINER

DATE
1653
GREINER

DATE
Aerial Photography
Ton Mann and Assoc.

DATE
8-7-86
Ton Mann and Assoc.

DATE
8-7-86
Ton Mann and Assoc.


DATE
8-7-86
Ton Mann and Assoc.

DATE
8-7-86
Ton Mann and Assoc.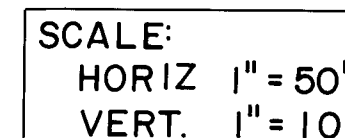

NOTES:

1. Build Type I Wheelchair Ramp Per C.O.A. Std. Dwg. P-17 & Transition From Std. C & G To Mountable C & G Roll Type Per C.O.A. Std. Dwg. P-18.

2. Construct Red Brick Pattern Stamped Concrete Between Median Curb. Stamped Concrete Shall Match Existing Stamped Concrete On Academy.

3. All Curb Returns Have A 25' Radius Measured From Face Unless Otherwise Noted

4. See Paving Detail Sheet For Road Section.

AS BUILT INFORMATION

CONTRACTOR: J. E. HALE
DATE: 8/1/87
INSPECTOR'S ACCEPTANCE BY: EHEA
VERIFICATION BY: EHEA
DRAWINGS TO BE: EHEA
SUBMITTED BY: EHEA
MICRO-FILM INFORMATION
RECORDED BY: NO
DATE: 8/1/87

BENCH MARKS

A standard AGS brass tablet stamped "5-821-A" set in a concrete post 0.3 ft. above the ground. To reach the station from the intersection of I-25 and San Mateo NE, go south on San Mateo 0.2 miles to Academy Rd., turn left, go east and then northeast. Miles to Eubank NE. The station is about 0.4 miles northeast of this point.
Elevation = 5765.23

SURVEY INFORMATION


FIELD NOTES	
NO.	BY
1748	GREINER
1653	GREINER
Aerial Photography	
Tom Mann and Assoc.	
8-7-86	

BRIDGEPOINT 4+85 TO 13+50

STATION	OFFSET	FLOWLINE
A 4+75 ±	44' ± LT.	23.2 ±
B 4+80 ±	47' ± RT.	21.5 ±
C 5+03 ±	24.00' RT.	22.67 22.60
D 5+05	24.00' LT.	23.36 23.46
E 4+96.00	2.00' RT.	22.77 22.84
F 4+96.00	2.00' RT.	22.77 22.88
G 6+15.42	24.00' RT.	28.77 28.74
H 6+21.37	2.00' LT.	29.55 29.74
J 6+21.37	2.00' RT.	29.65
K 6+82.28	24.00' RT.	33.72 33.80
L 6+85.37	2.00' LT.	34.40 34.36
M 6+85.37	2.00' RT.	34.40
N 6+98.37	2.00' LT.	35.39
O 6+98.37	2.00' RT.	35.39
P 8+65.26	24.00' LT.	46.03 46.11
Q 8+76.18	24.00' RT.	48.50 48.63
R 8+77.73	2.00' LT.	49.07 49.10
S 8+77.73	2.00' RT.	49.05 49.10
T 9+46.15	16.00' LT.	54.53
U 9+60.56	16.00' RT.	54.65

ENGINEER'S SEAL

</

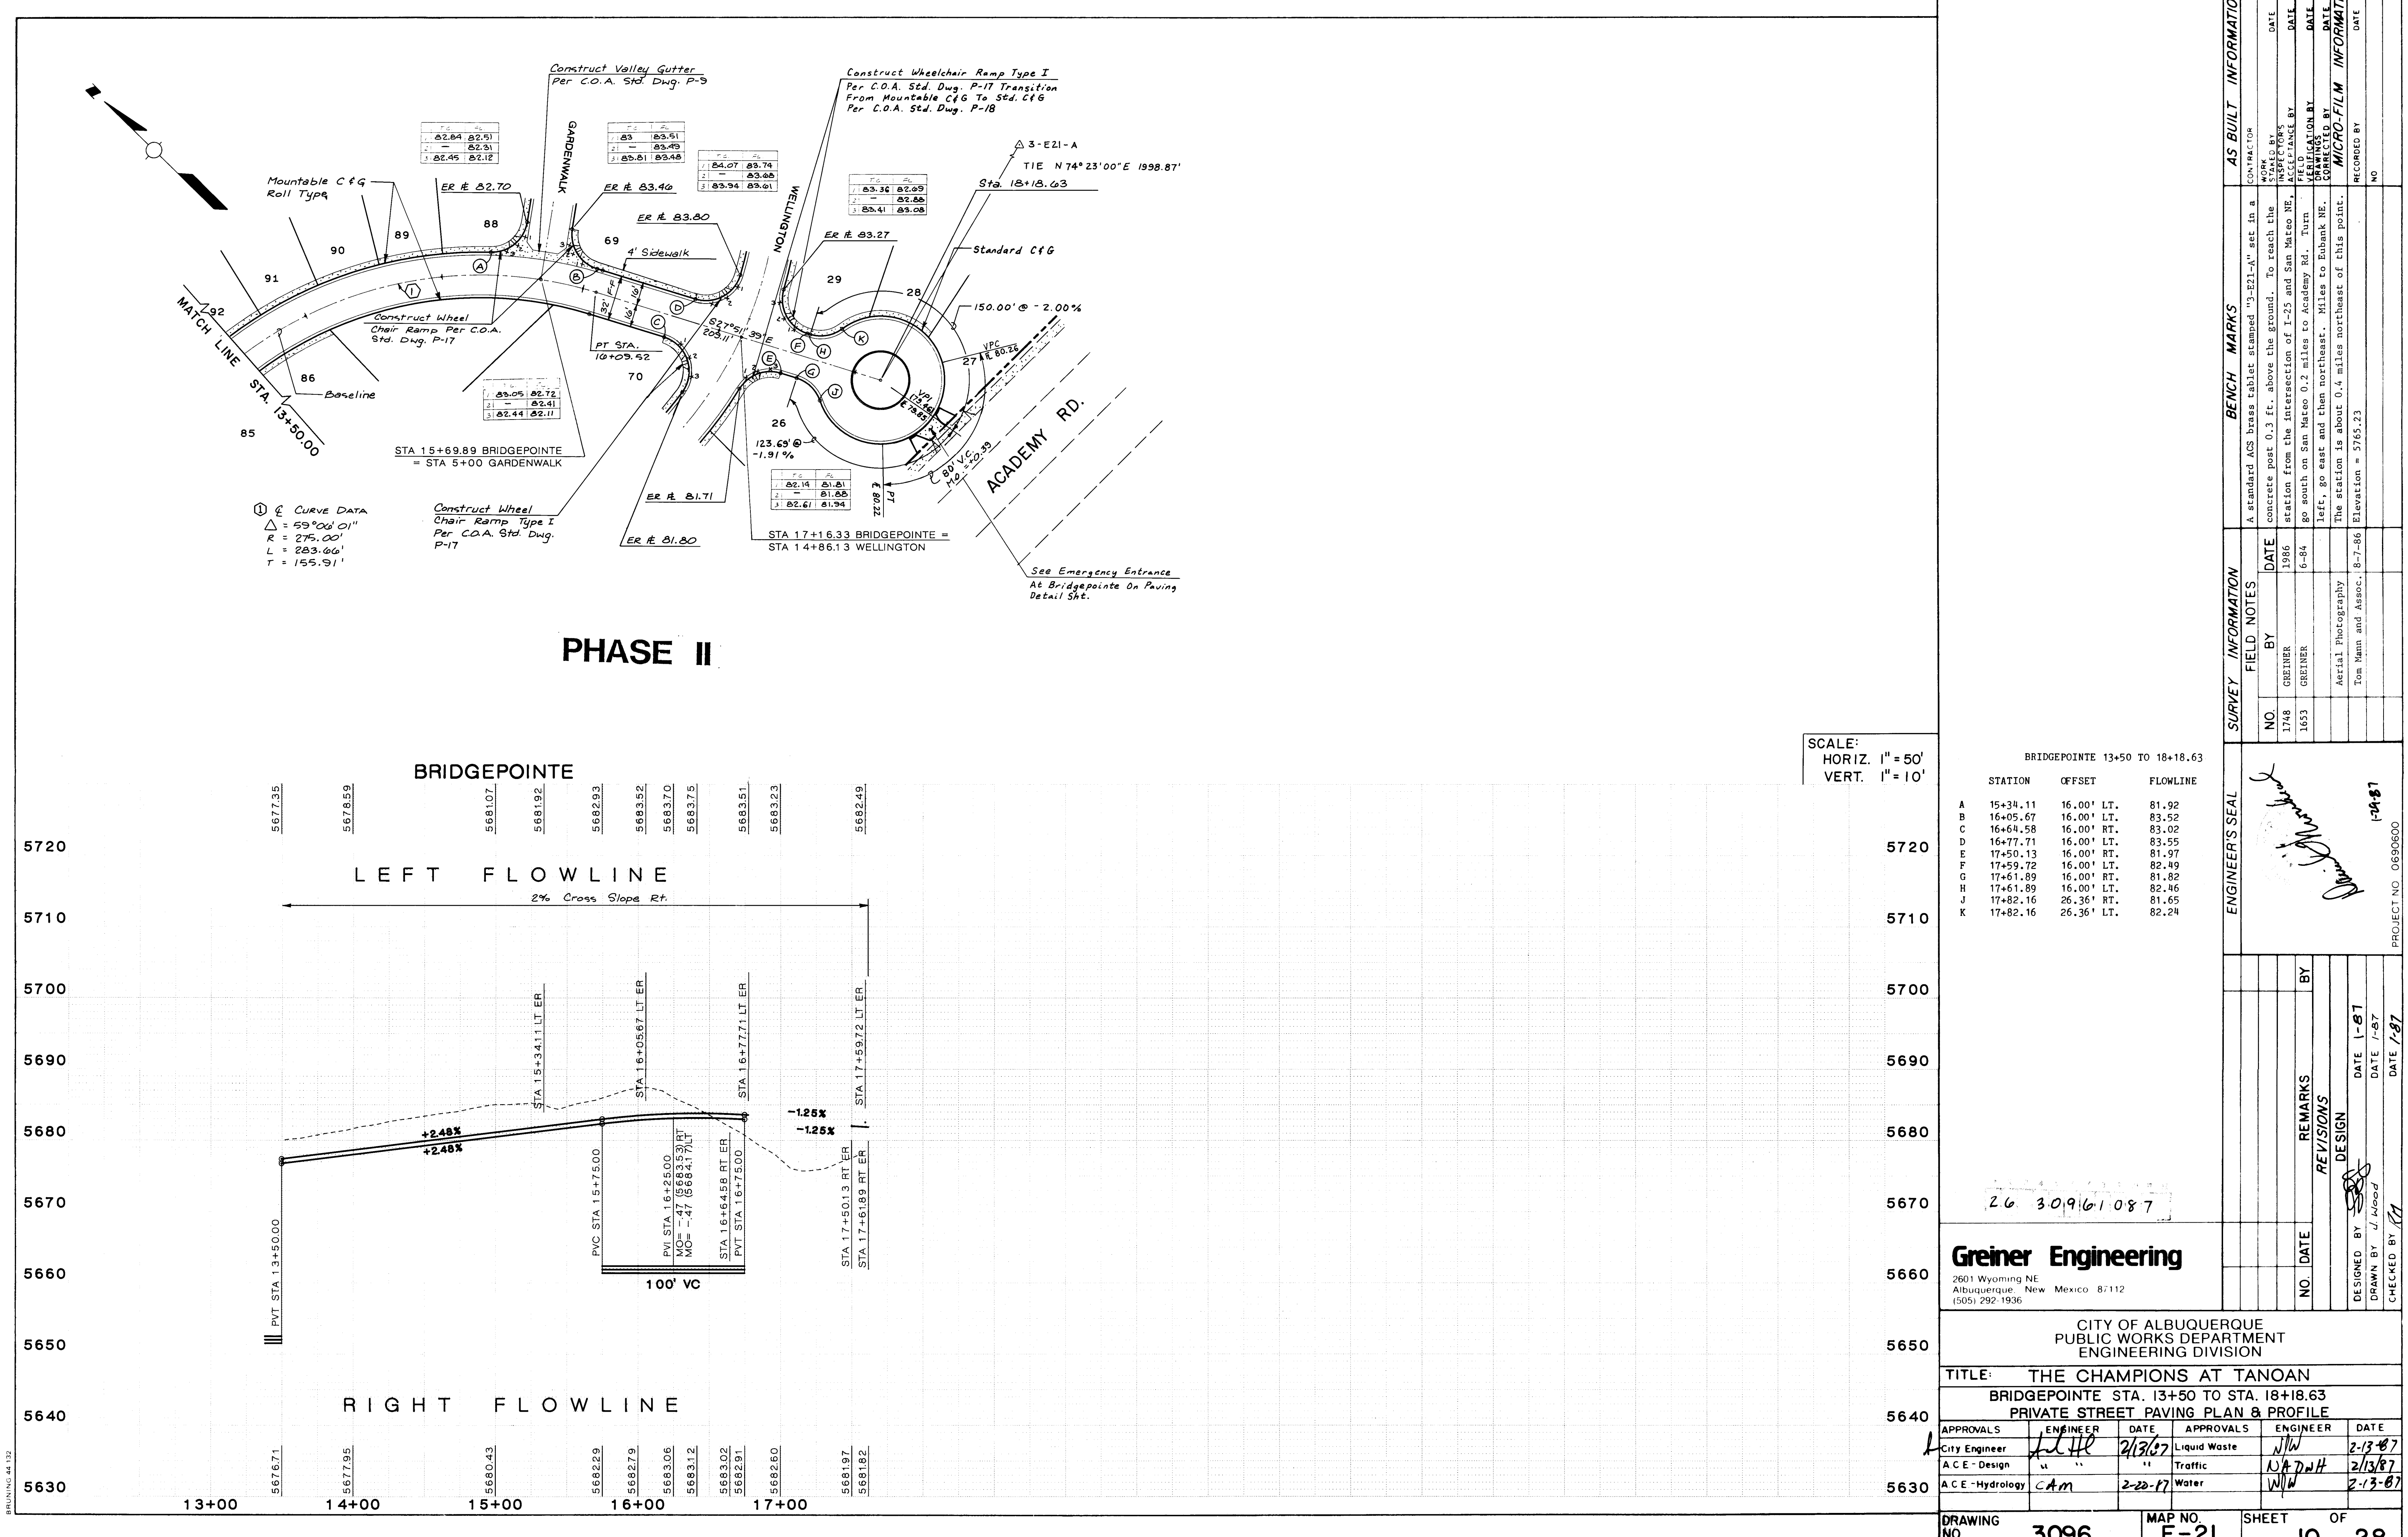

PHASE II

SCALE:
HORIZ. 1" = 50'
VERT. 1" = 10'

BRIDGEPOINTE 13+50 TO 18+18.63		
STATION	OFFSET	FLOWLINE
A 15+34.11	16.00' LT.	81.92
B 16+05.67	16.00' LT.	83.52
C 16+64.58	16.00' RT.	83.02
D 16+77.71	16.00' LT.	83.55
E 17+50.13	16.00' RT.	81.97
F 17+59.72	16.00' LT.	82.49
G 17+61.89	16.00' RT.	81.82
H 17+61.89	16.00' LT.	82.46
J 17+82.16	26.36' RT.	81.65
K 17+82.16	26.36' LT.	82.24

26 30961087

Greiner Engineering

2601 Wyoming NE
Albuquerque, New Mexico 87112
(505) 292-1936

CITY OF ALBUQUERQUE
PUBLIC WORKS DEPARTMENT
ENGINEERING DIVISION

TITLE: THE CHAMPIONS AT TANOAN
BRIDGEPOINTE STA. 13+50 TO STA. 18+18.63
PRIVATE STREET PAVING PLAN & PROFILE


APPROVALS	ENGINEER	DATE	APPROVALS	ENGINEER	DATE
City Engineer	J. H. H.	2/13/07	Liquid Waste	J. H. H.	2-13-07
A.C.E. - Design	"	"	Traffic	N. A. D. H.	2/13/07
A.C.E. - Hydrology	C. A. M.	2-22-07	Water	J. H. H.	2-13-07

DRAWING NO. 3096 MAP NO. E-21 SHEET 10 OF 28

SURVEY INFORMATION		BENCH MARKS		AS BUILT INFORMATION	
NO.	BY	DATE	CONTRACTOR	WORK	DATE
1748	GREINER	1986	A standard ACS brass tablet stampped "9-E21-A" set in a concrete post 0.3 ft. above the ground. To reach the station from the intersection of I-25 and San Mateo NE, go south on San Mateo 0.2 miles to Academy Rd. Turn left, go east and then northeast. Miles to Eubank NE. The station is about 0.4 miles northeast of this point. Elevation = 5765.23	INSPECTION BY	DATE
1653	GREINER	6-84		VERIFICATION BY	DATE
	Aerial Photography			DRAWINGS BY	DATE
	Tom Mann and Assoc.	8-7-86		RECORDED BY	DATE

ENGINEER'S SEAL
1-24-87
PROJECT NO. 0690600



NO.	DATE	REMARKS	BY
		DESIGN	
		REVISIONS	
		DESIGNED BY	
		DRAWN BY	
		CHECKED BY	

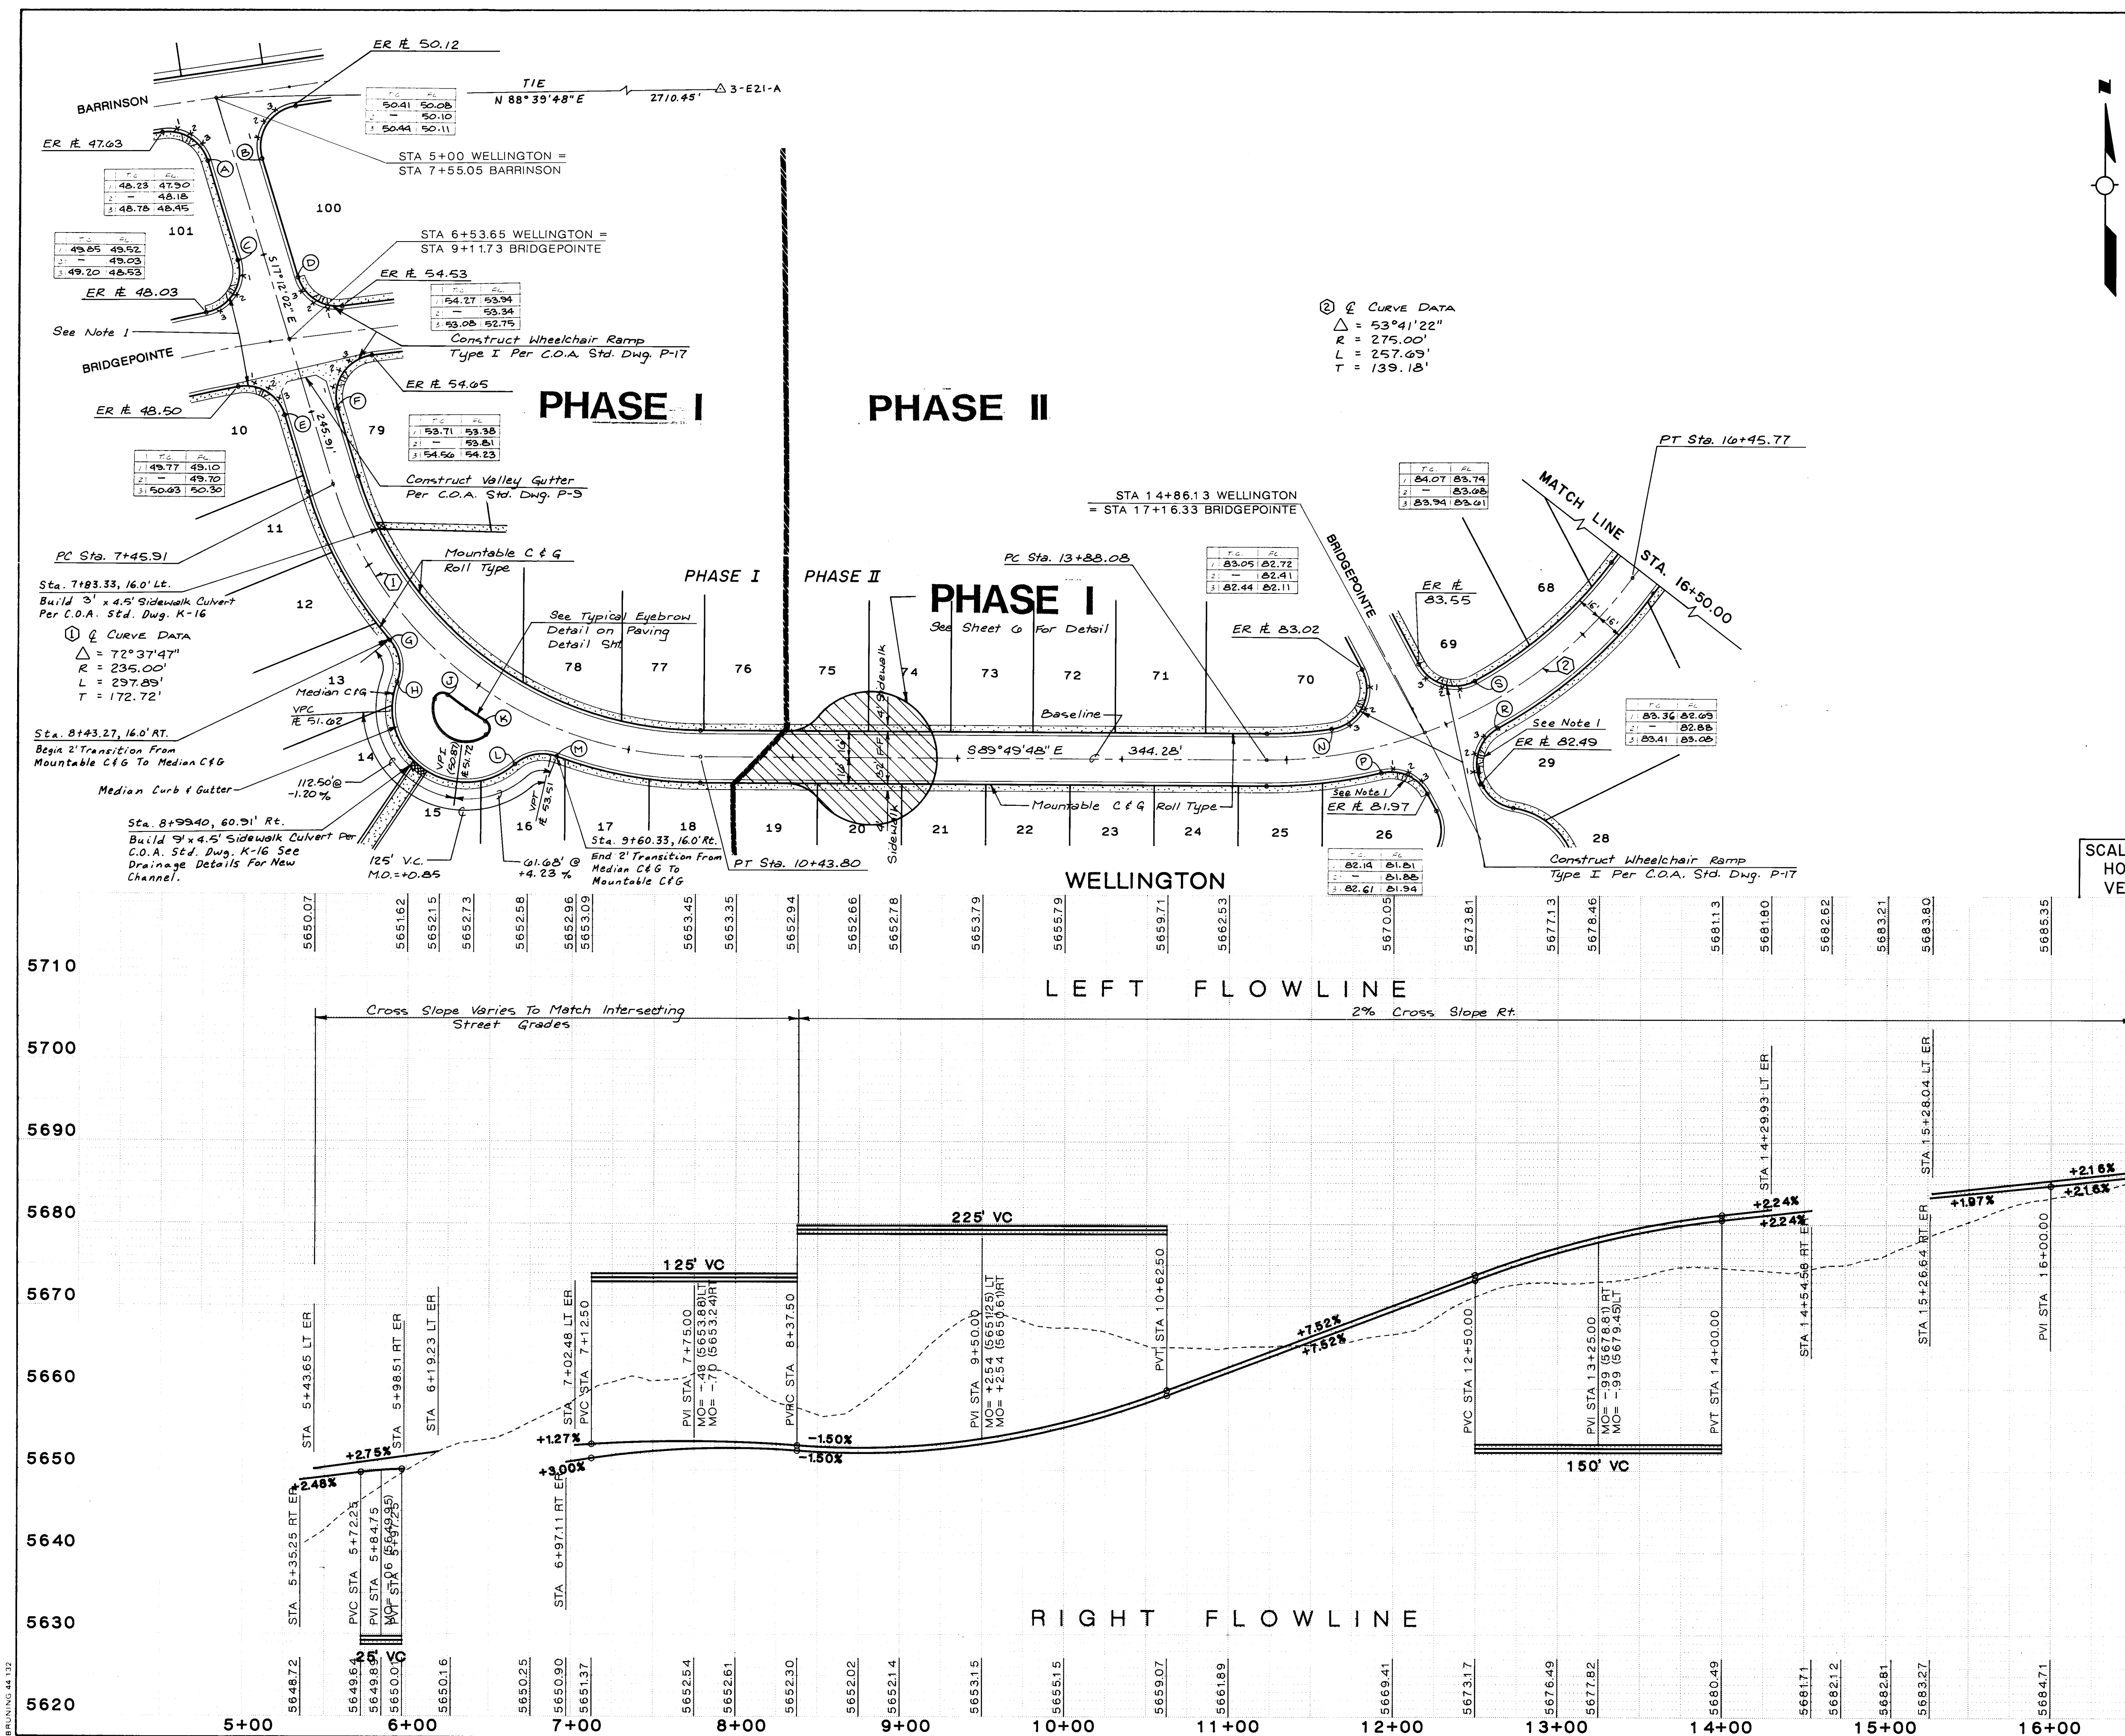

NOTES:

1. Build Type I Wheelchair Ramp Per
C.O.A. Std. Dwg. P-17 & Transition
From Std. C & G To Mountable C & G
Roll Type Per C.O.A. Std. Dwg. P-18.

[illegible]

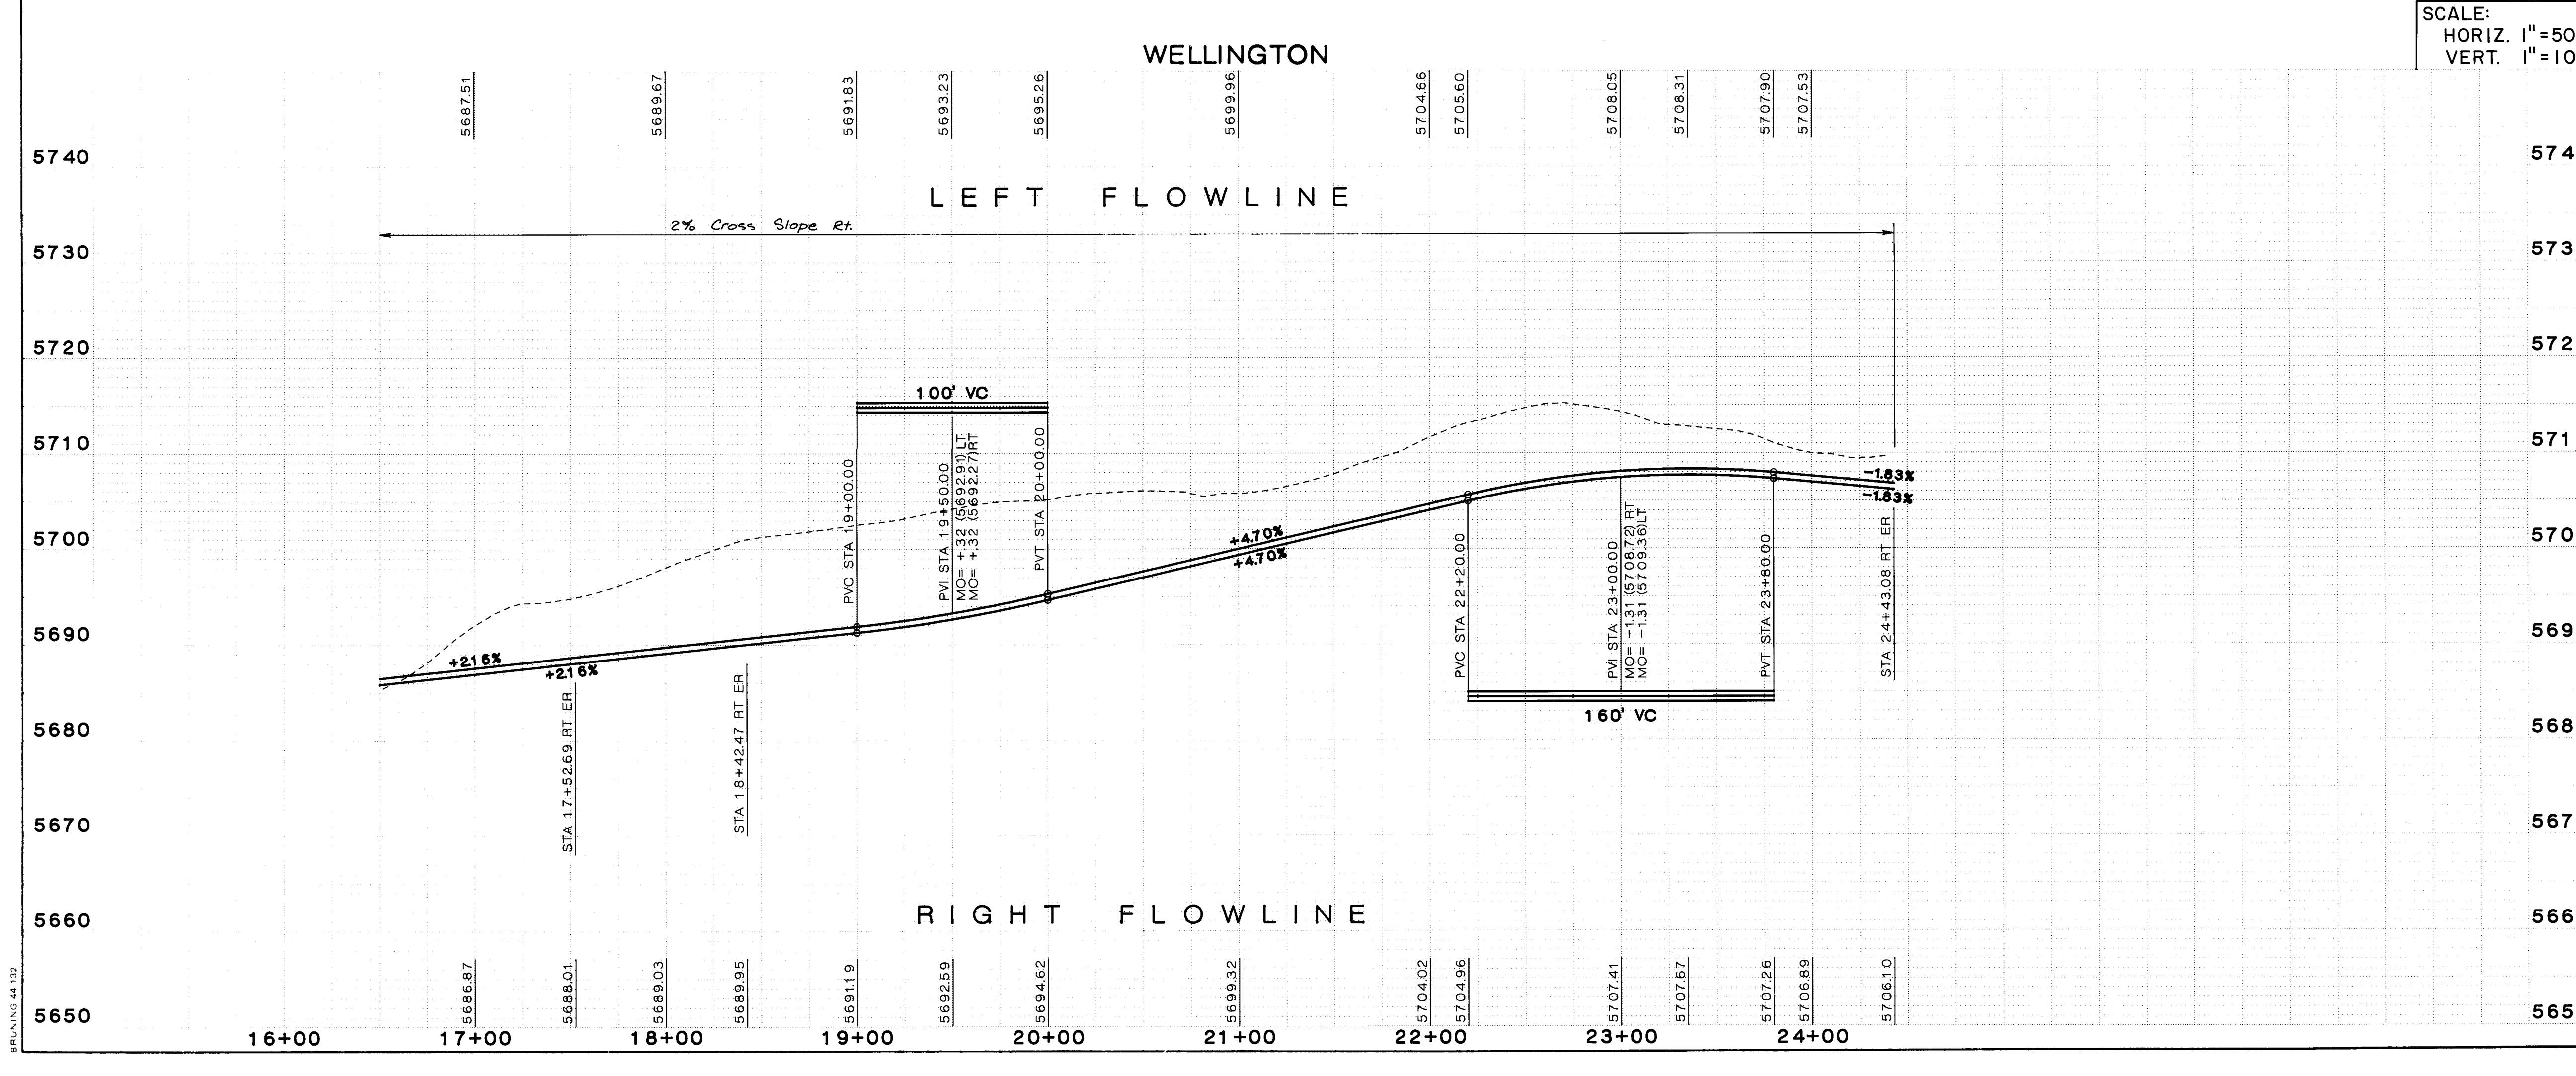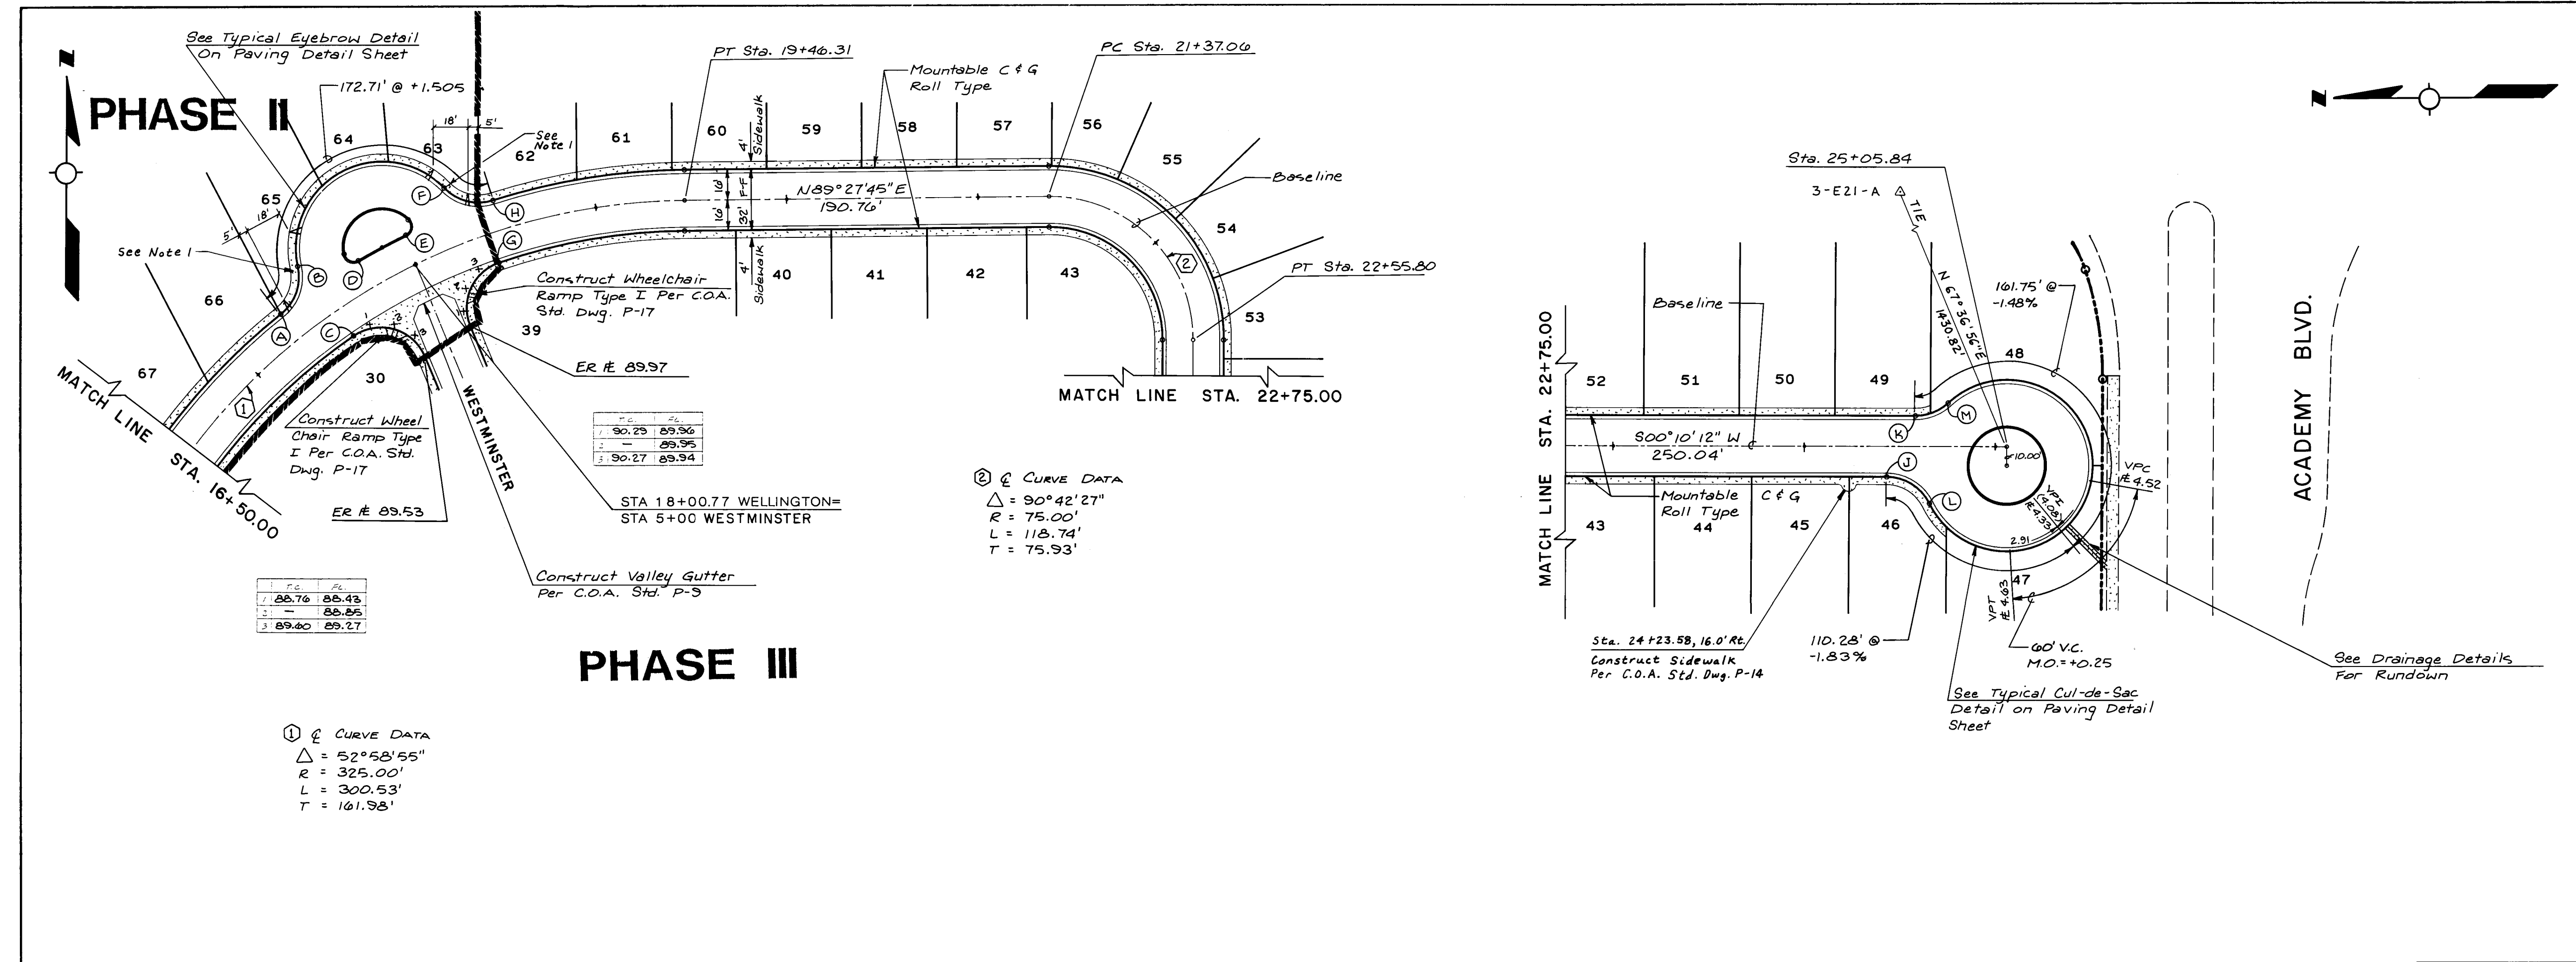

NOTES:
1. Build 18' Wide Driveway Per C.O.A. Std. Dwg. P-11.

AS BUILT INFORMATION		BENCH MARKS		SURVEY INFORMATION		ENGINEER'S SEAL	
CONTRACTOR	DATE	NO.	BY	NO.	BY	NO.	BY
WORK	DATE	1748	GREINER	1748	GREINER		
INSPECTORS	DATE	1653	GREINER	1653	GREINER		
VERIFICATION BY	DATE						
DRAWINGS	DATE						
BY	DATE						
MICRO-FILM INFORMATION							
RECORDED BY	DATE						
NO.							

WELLINGTON 16+50 TO 25+05.84

STATION	OFFSET	FLOWLINE
A	17+29.07	16.00' LT.
B	17+49.58	30.69' LT.
C	17+52.69	16.00' RT.
D	17+75.92	16.00' LT.
E	18+02.69	16.00' LT.
F	18+29.02	30.69' LT.
G	18+42.47	16.00' RT.
H	18+49.54	16.00' LT.
J	24+43.08	16.00' RT.
K	24+57.89	16.00' LT.
L	24+65.49	29.93' RT.
M	24+75.01	22.79' LT.

26 30961287

Greiner Engineering
2601 Wyoming NE
Albuquerque, New Mexico 87112
(505) 292-1936

CITY OF ALBUQUERQUE
PUBLIC WORKS DEPARTMENT
ENGINEERING DIVISION





TITLE: THE CHAMPIONS AT TANOAN
WELLINGTON STA. 16+50 TO STA. 25+05.84
PRIVATE STREET PAVING PLAN & PROFILE

APPROVALS	ENGINEER	DATE	APPROVALS	ENGINEER	DATE
City Engineer	Adelle	2/13/87	Liquid Waste	W/D	2/13/87
ACE - Design	"	"	Traffic	NADPH	2/13/87
ACE - Hydrology	CAM	2-22-87	Water	W/D	2-13-87

DRAWING NO. 3096

MAP NO. E-21

SHEET 12 OF 28

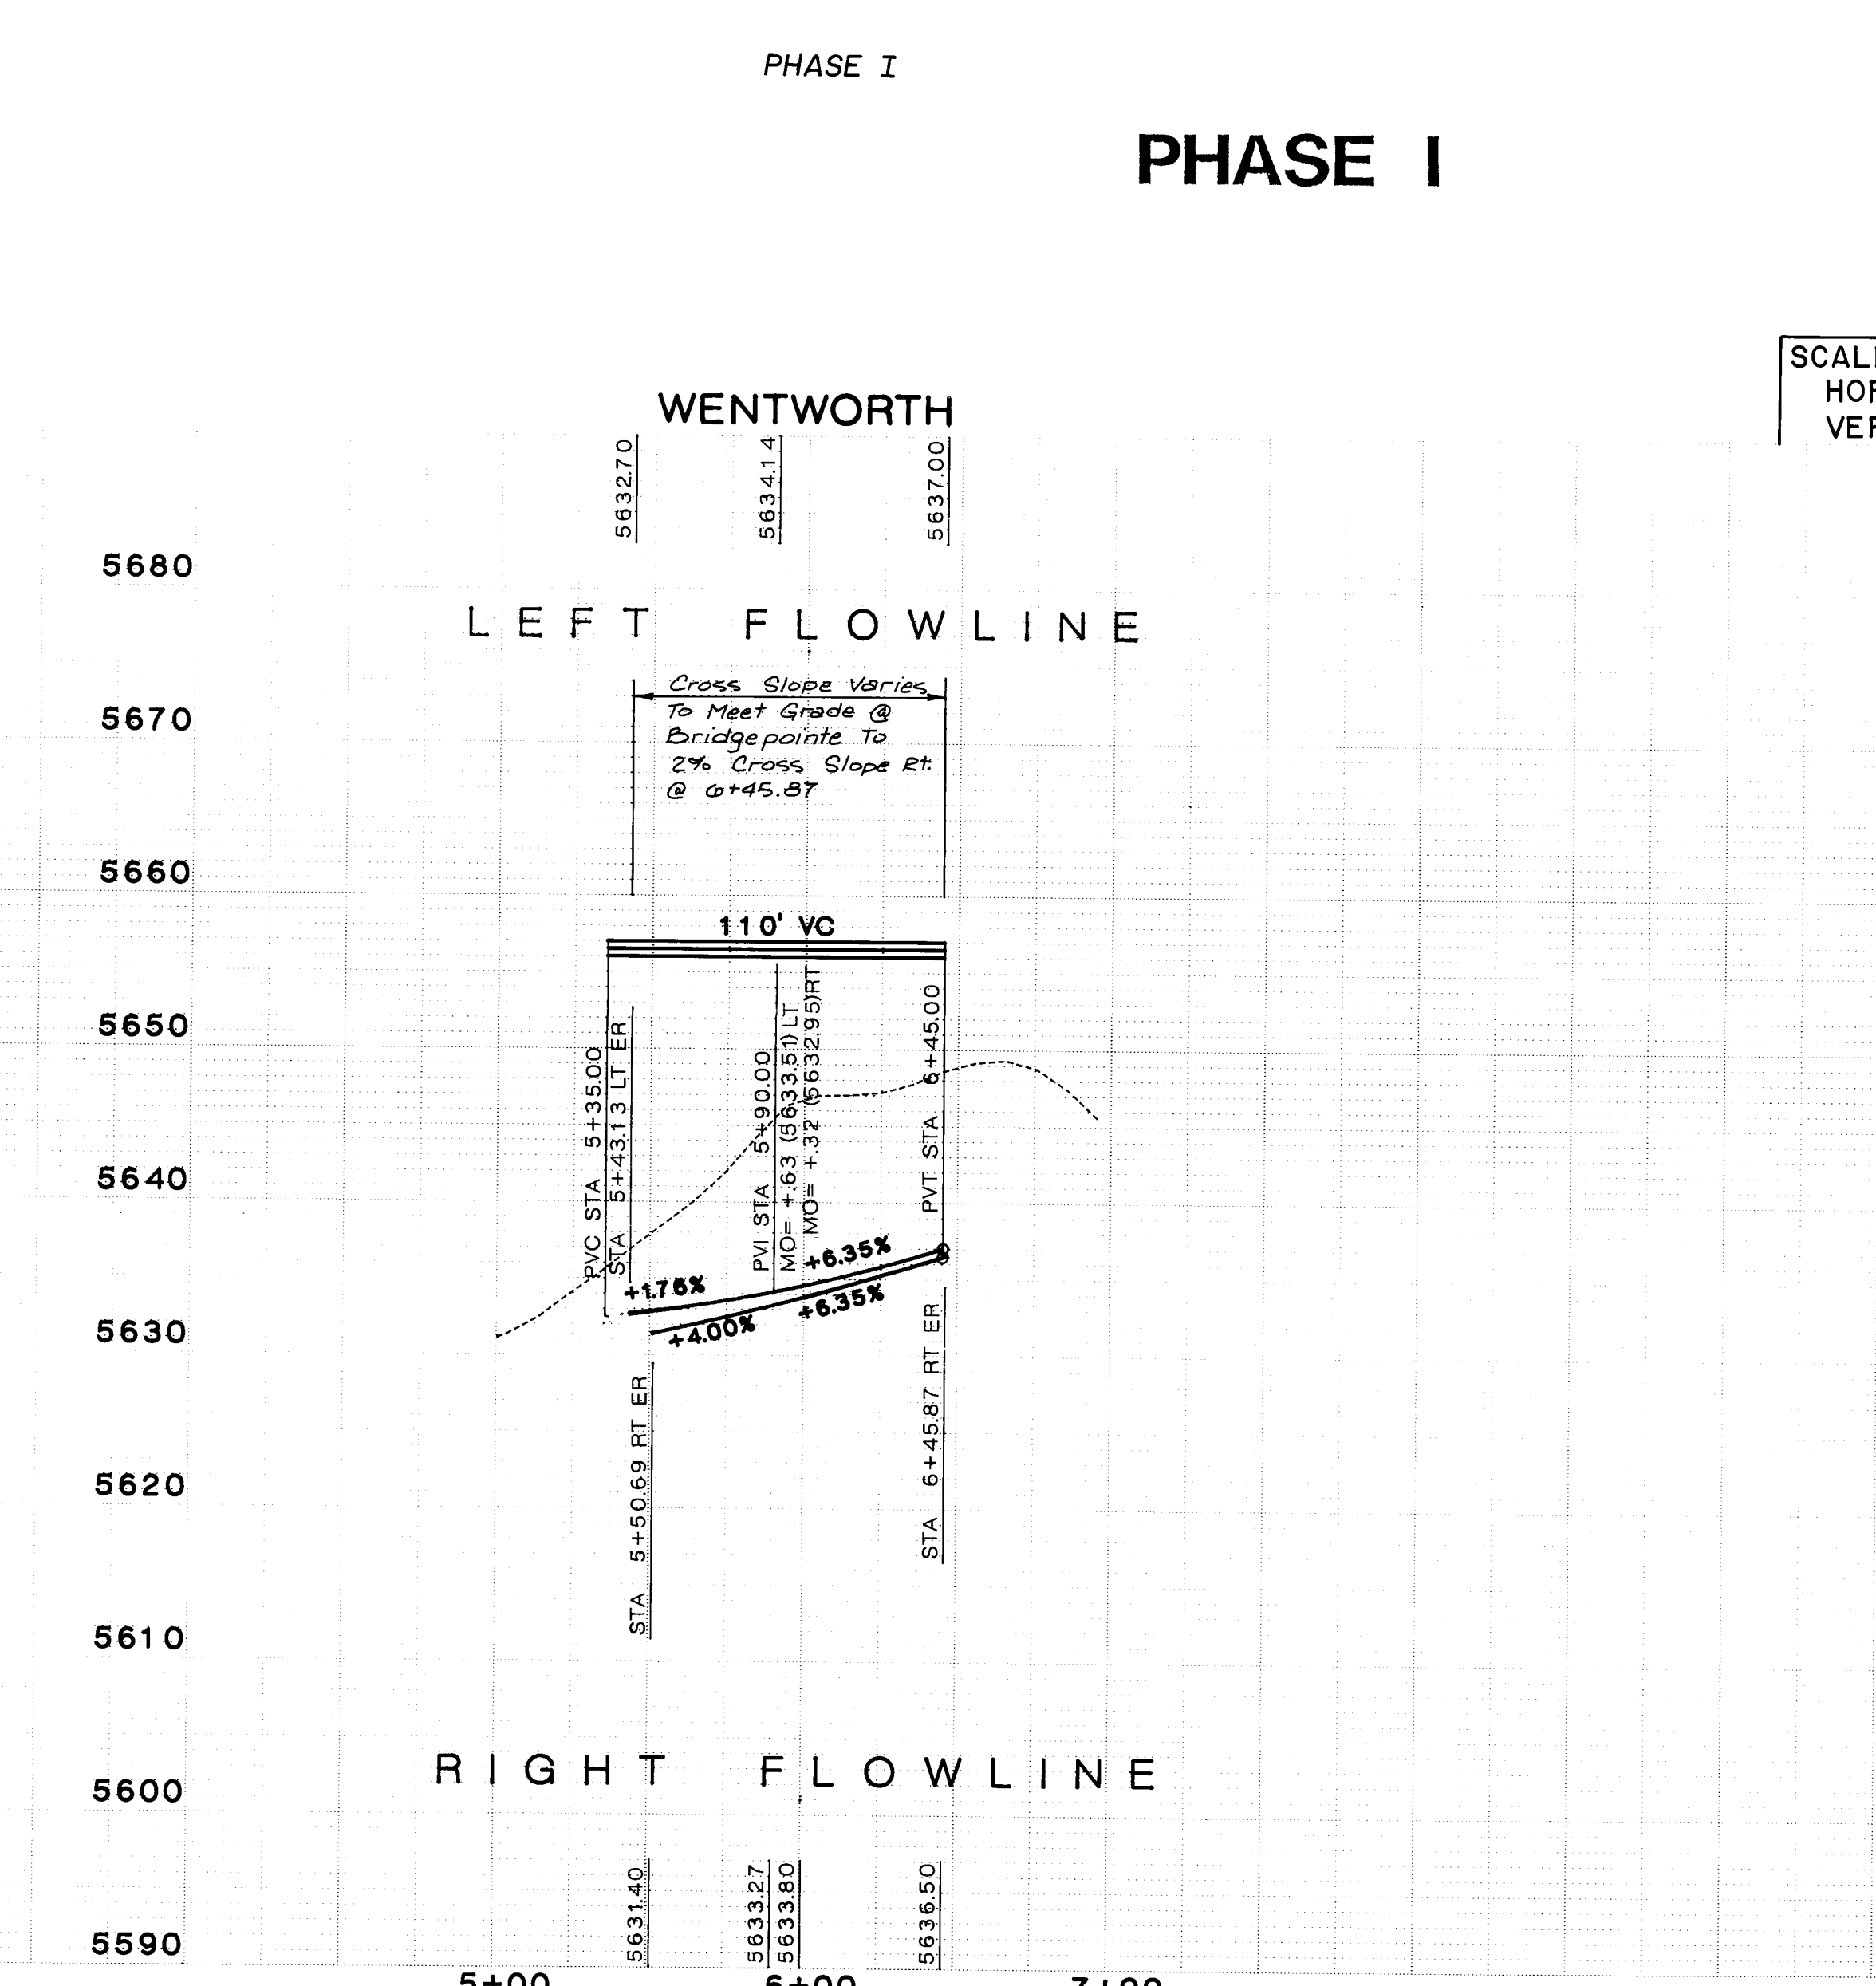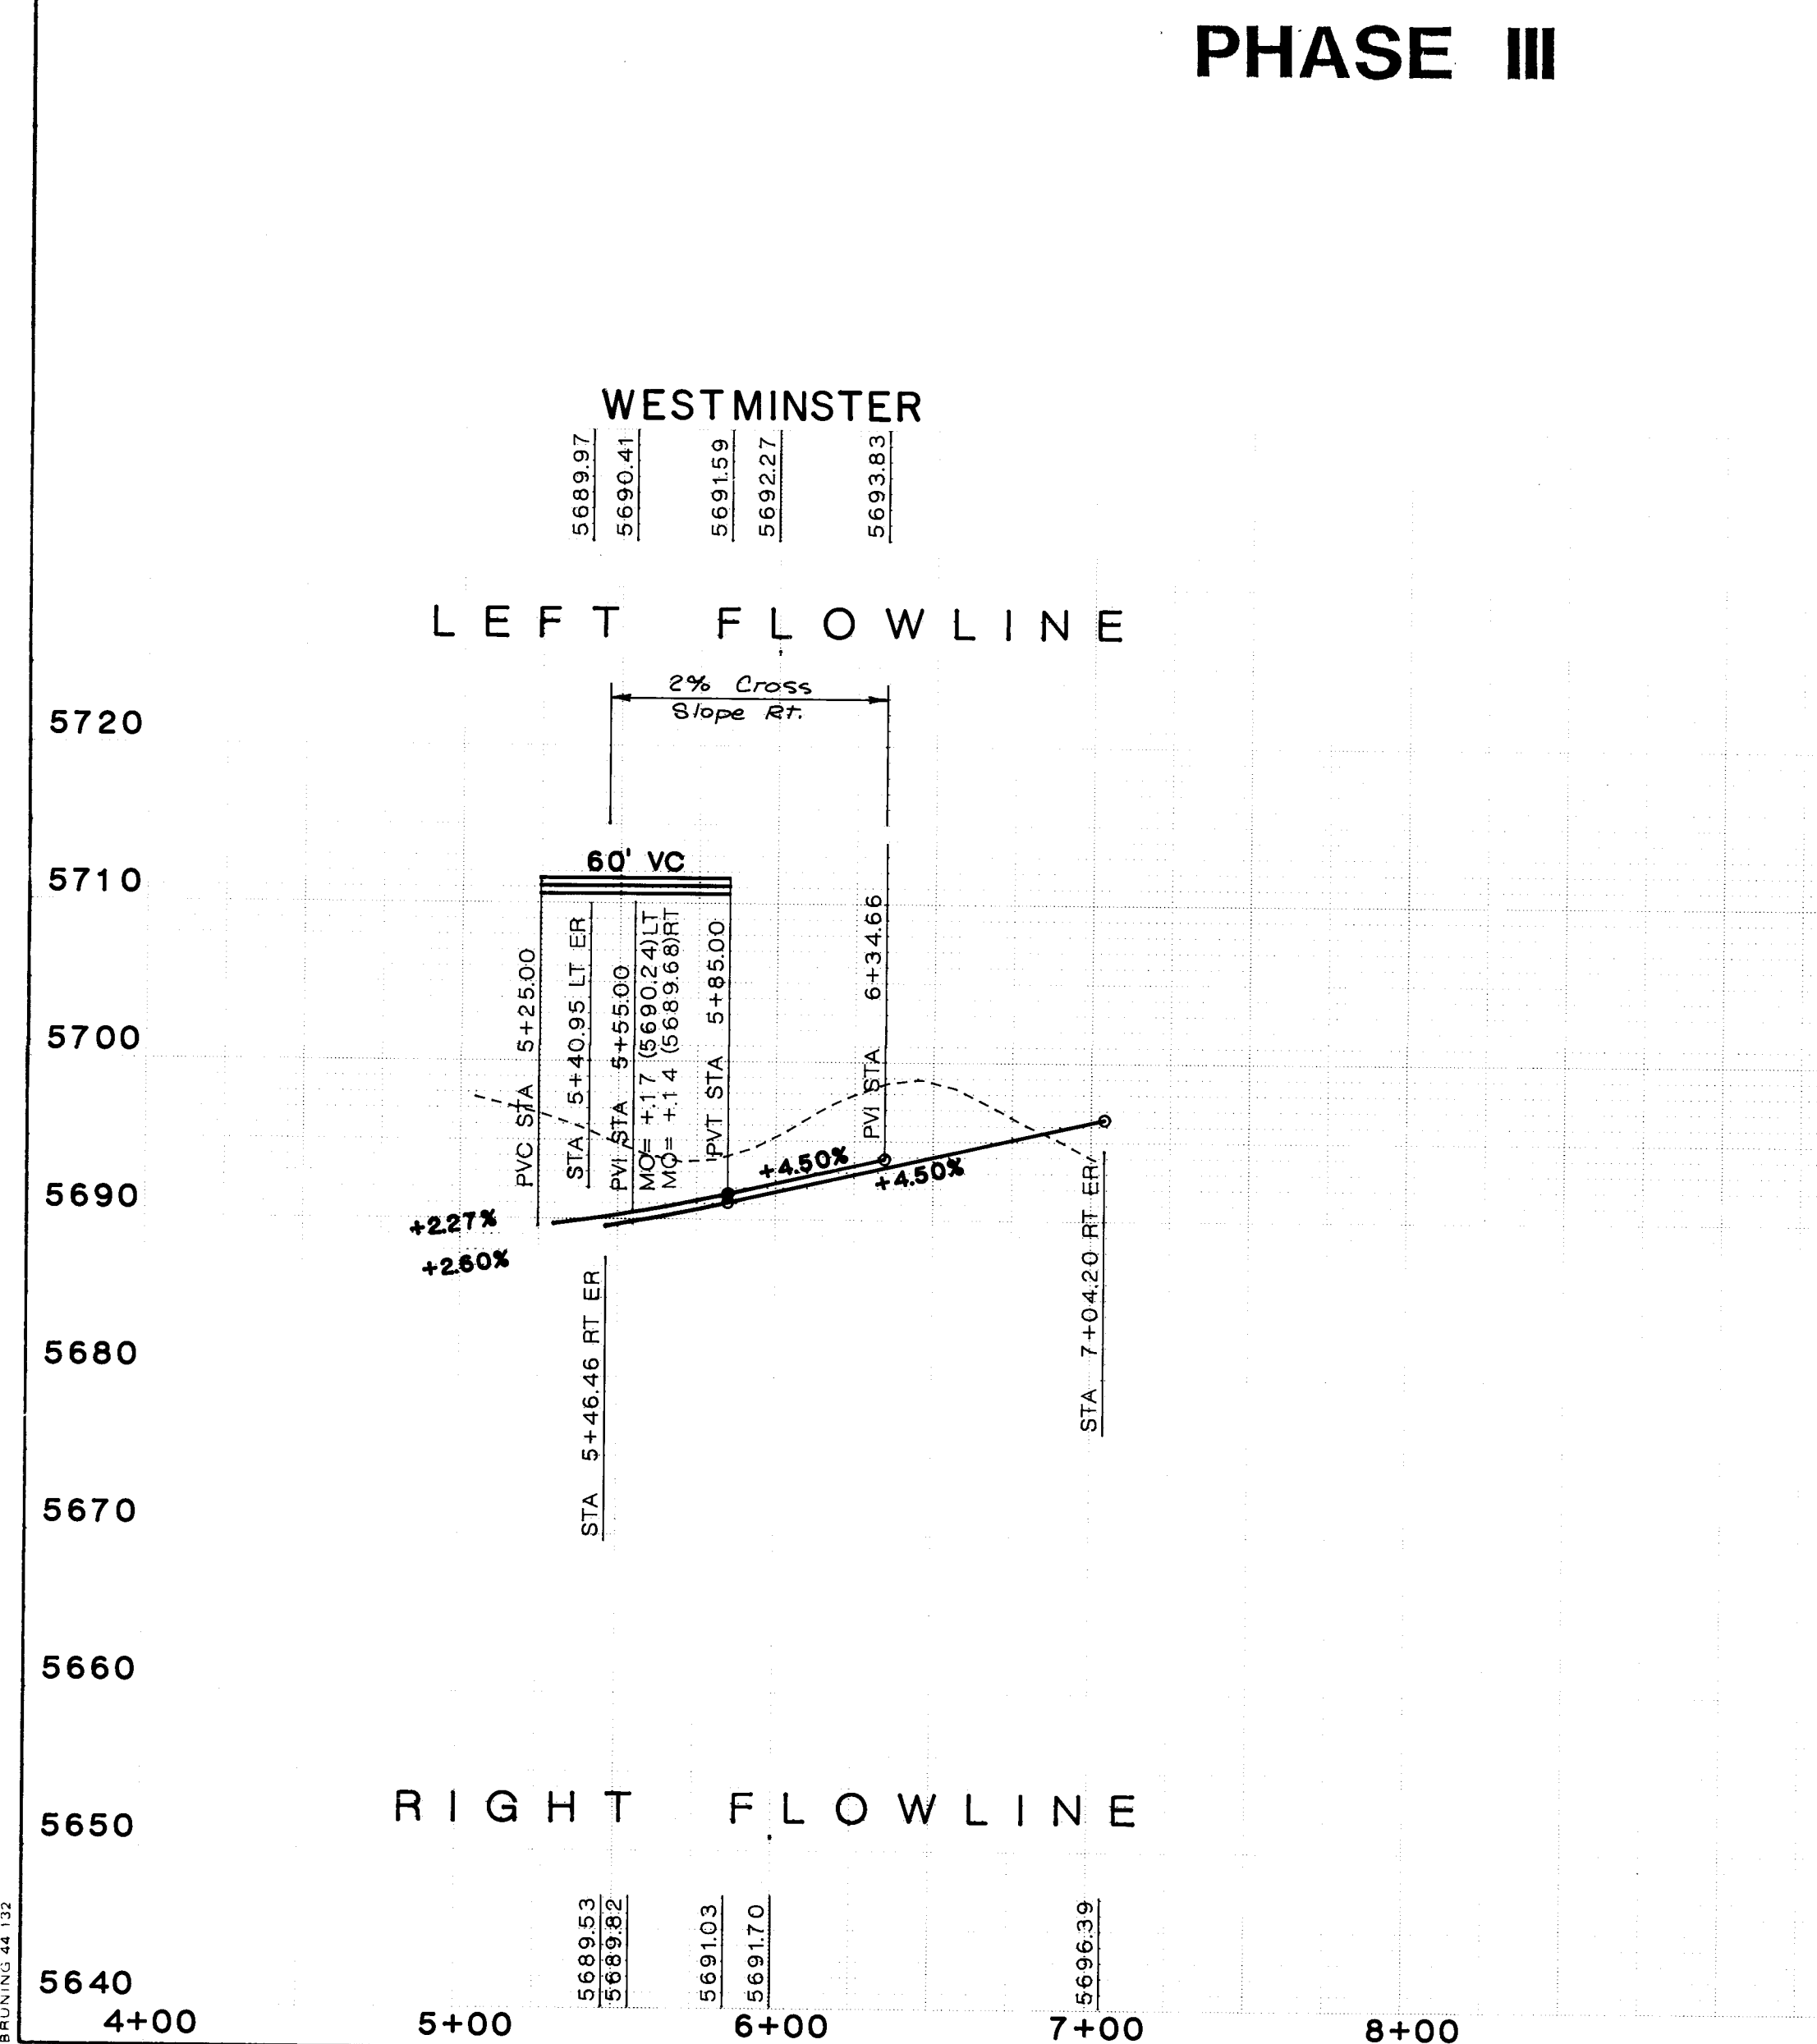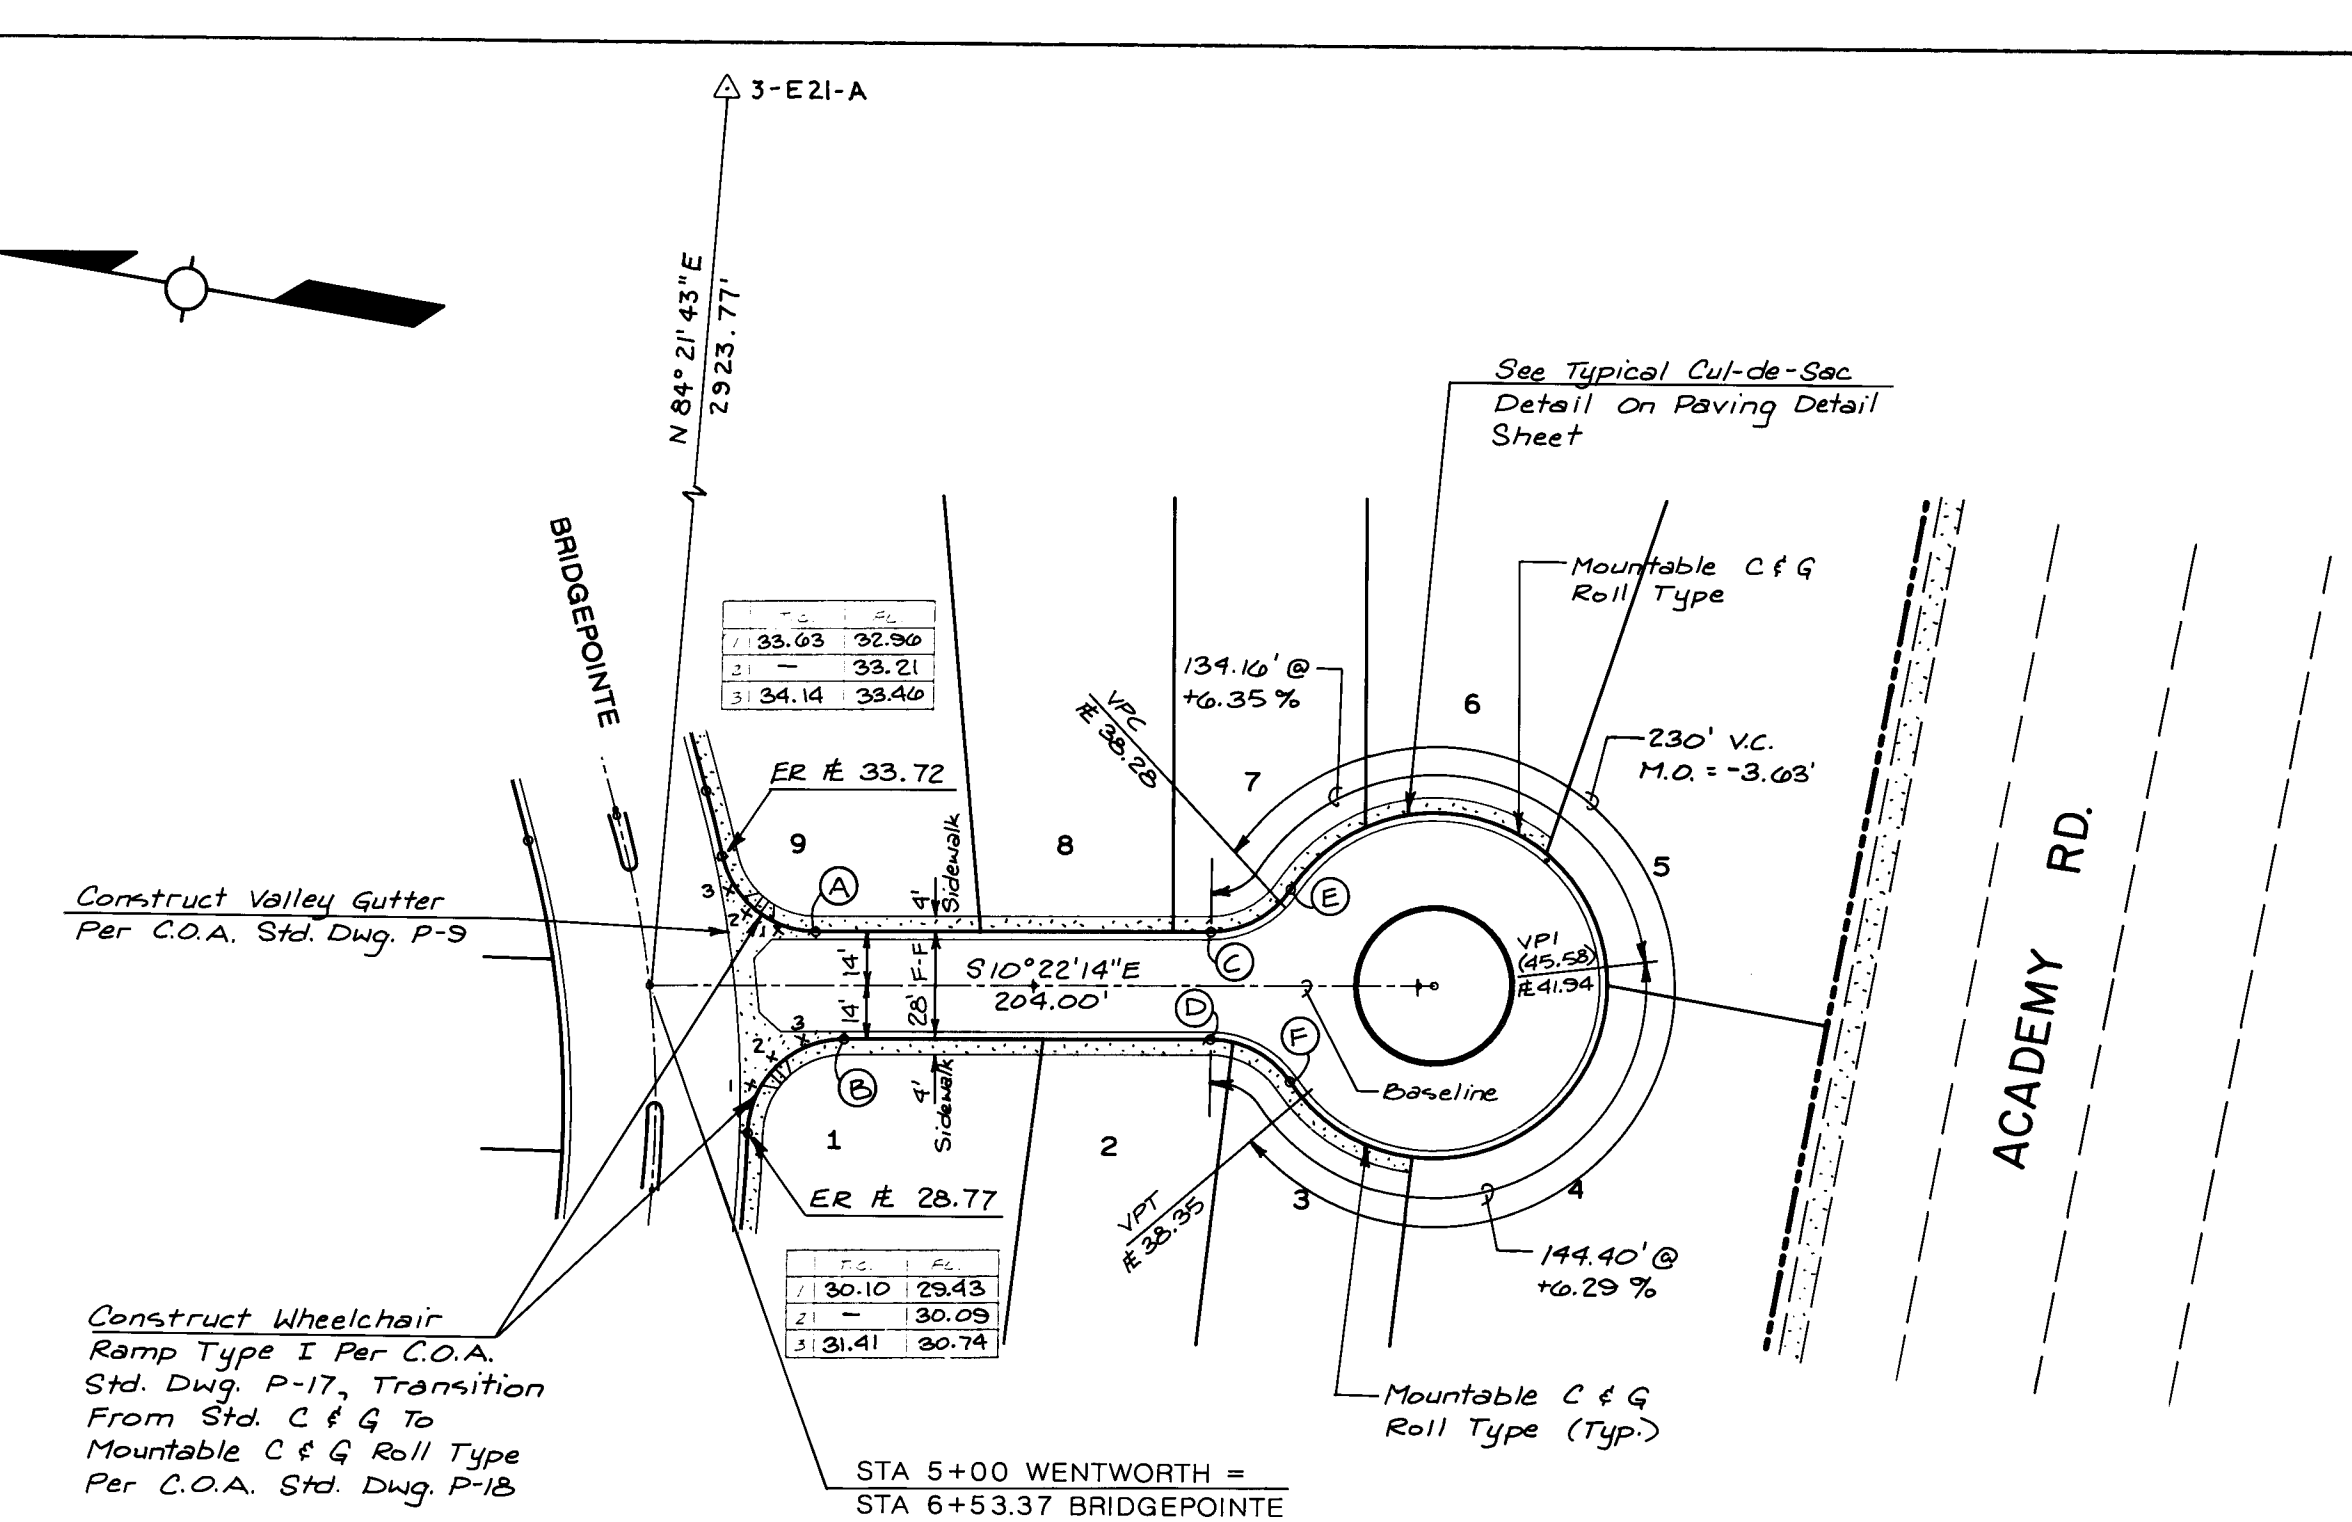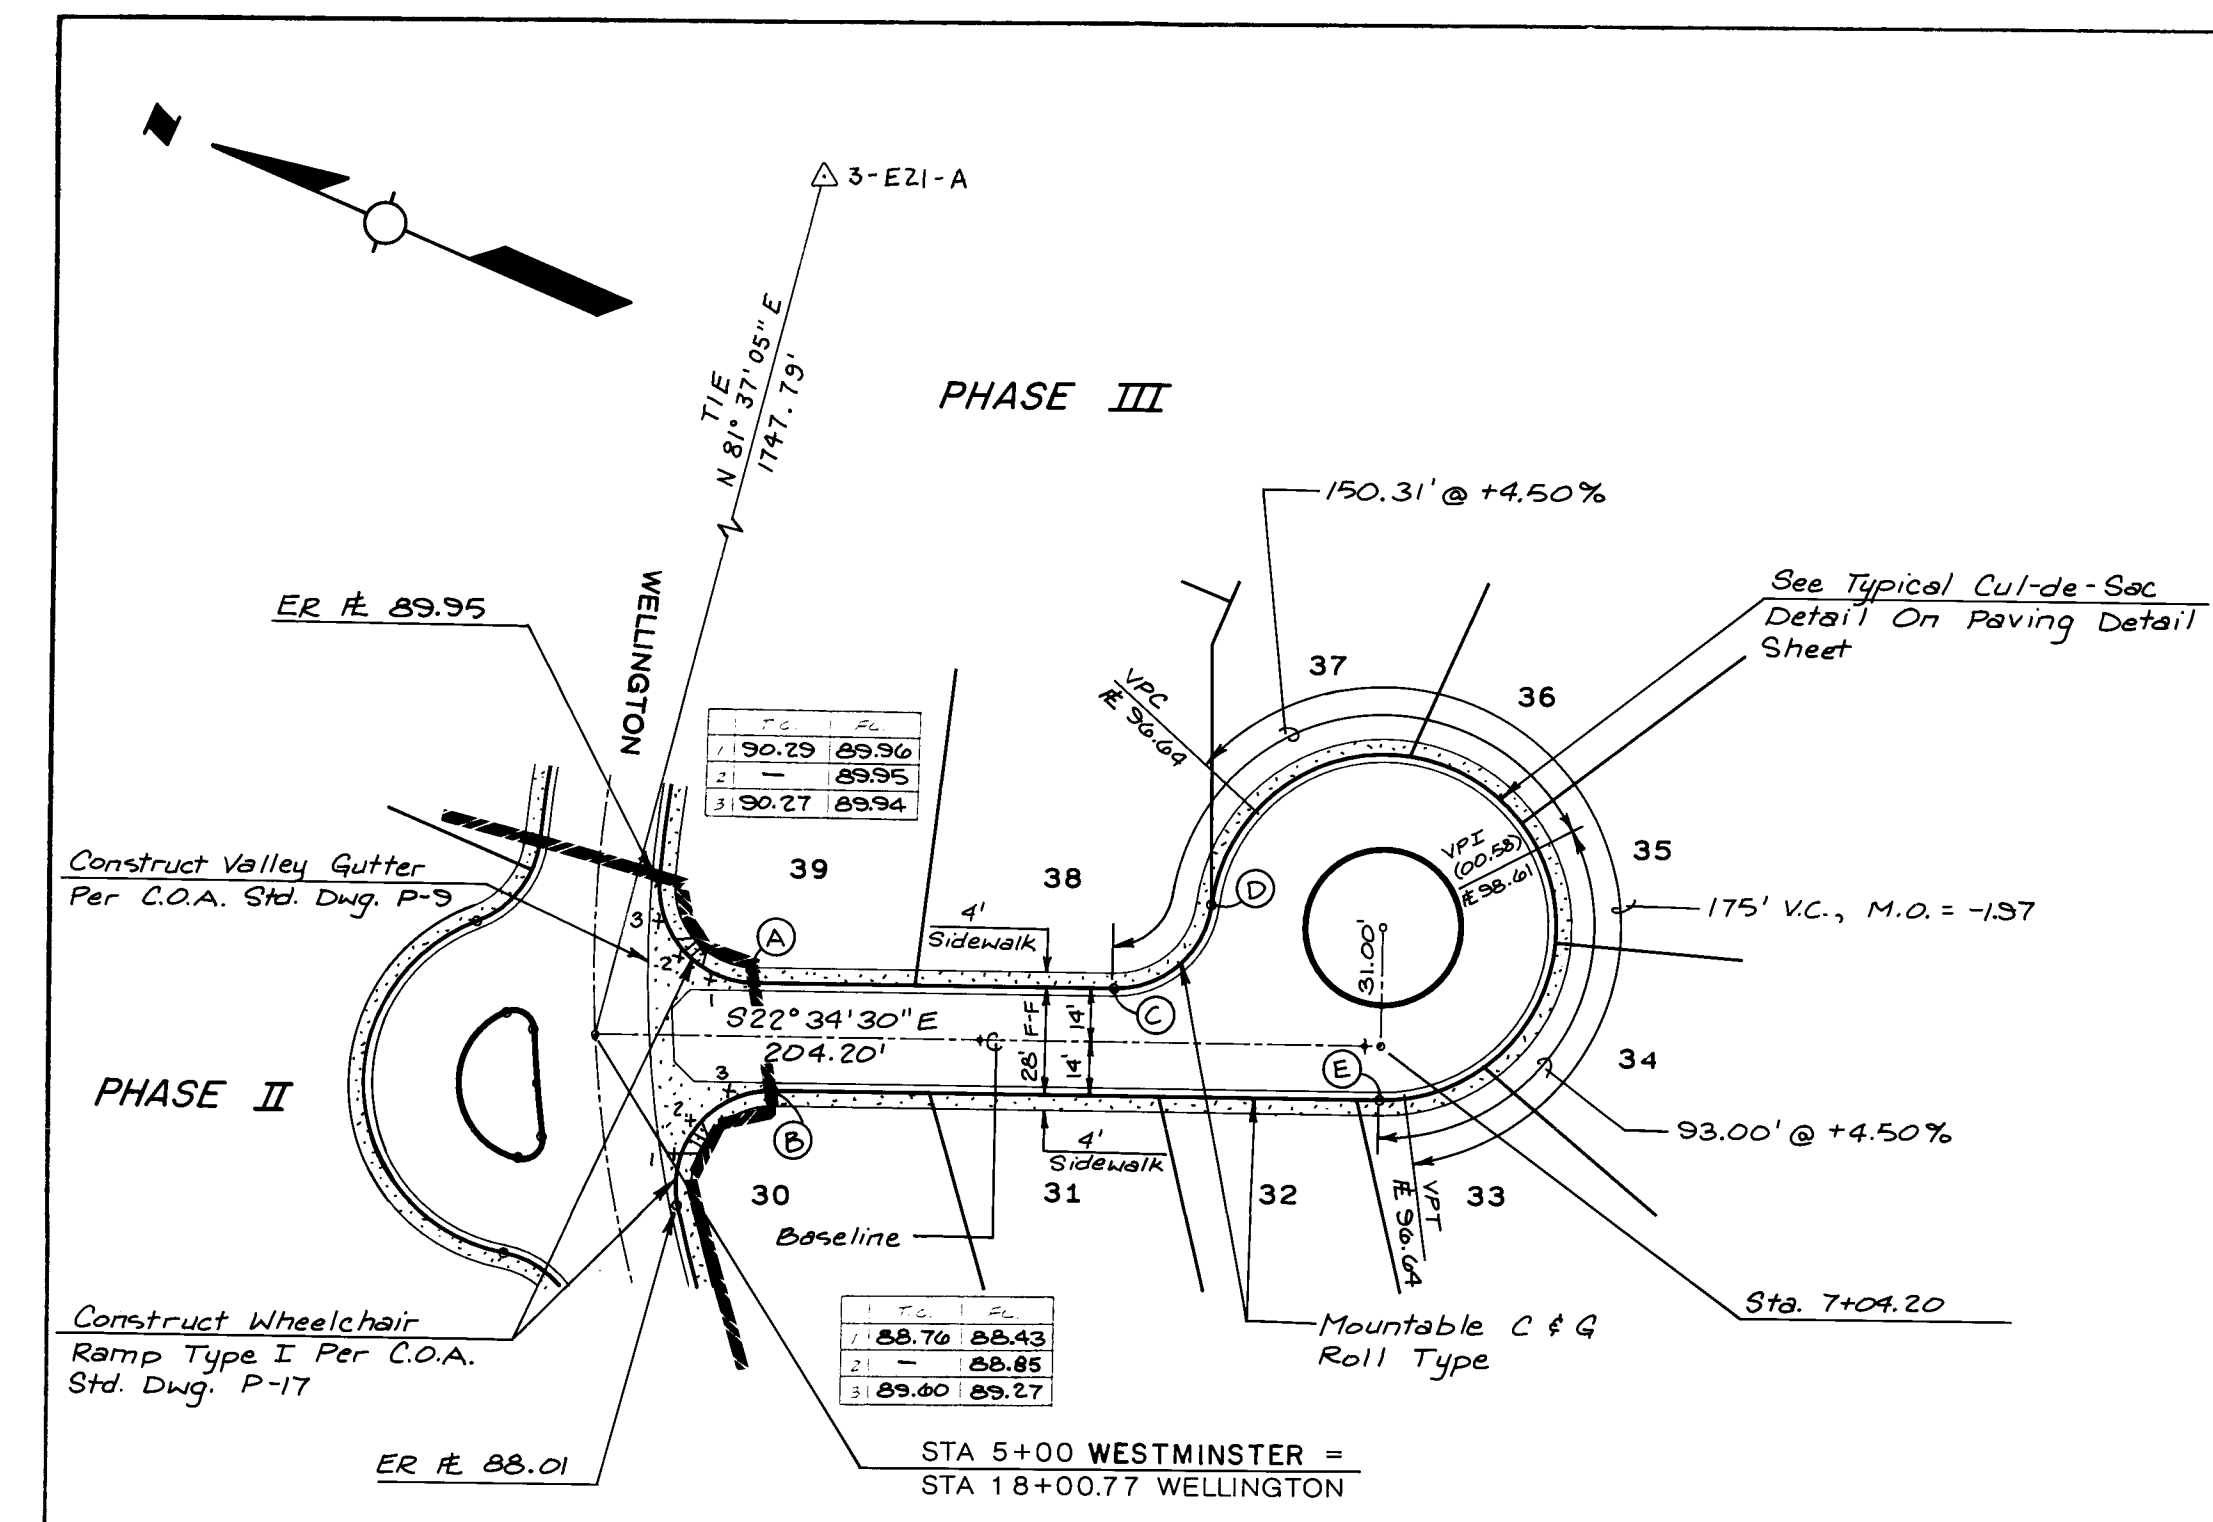

SCALE:
HORIZ. 1"=50'
VERT. 1"=10'


WESTMINSTER		
STATION	OFFSET	FLOWLINE
A 5+40.95	14.00' LT.	89.97
B 5+46.66	14.00' RT.	89.53
C 6+34.66	14.00' LT.	93.82
D 6+59.49	36.14' LT.	95.46
E 7+04.20	14.00' RT.	96.39

WENTWORTH		
STATION	OFFSET	FLOWLINE
A 5+43.13	14.00' LT.	32.70
B 5+50.69	14.00' RT.	31.40
C 6+45.87	14.00' LT.	37.06
D 6+45.87	14.00' RT.	36.50
E 6+66.63	25.07' LT.	38.61
F 6+66.63	25.07' RT.	38.04

Greiner Engineering
2601 Wyoming NE
Albuquerque, New Mexico 87112
(505) 292-1936


CITY OF ALBUQUERQUE PUBLIC WORKS DEPARTMENT ENGINEERING DIVISION			
TITLE: THE CHAMPIONS AT TANOAN WESTMINSTER & WENTWORTH PRIVATE STREET PAVING PLAN & PROFILE			
APPROVALS	ENGINEER	DATE	APPROVALS
City Engineer	ALH	2/13/87	Liquid Waste
A.C.E. Design	"	"	Traffic
A.C.E. Hydrology	Cam	2-20-87	Water

WARNING:
Contractor To Field Verify
Horizontal & Vertical Location
Of Existing Utilities In The
Intersection Of Bridgepointe
& Tanoan Dr.

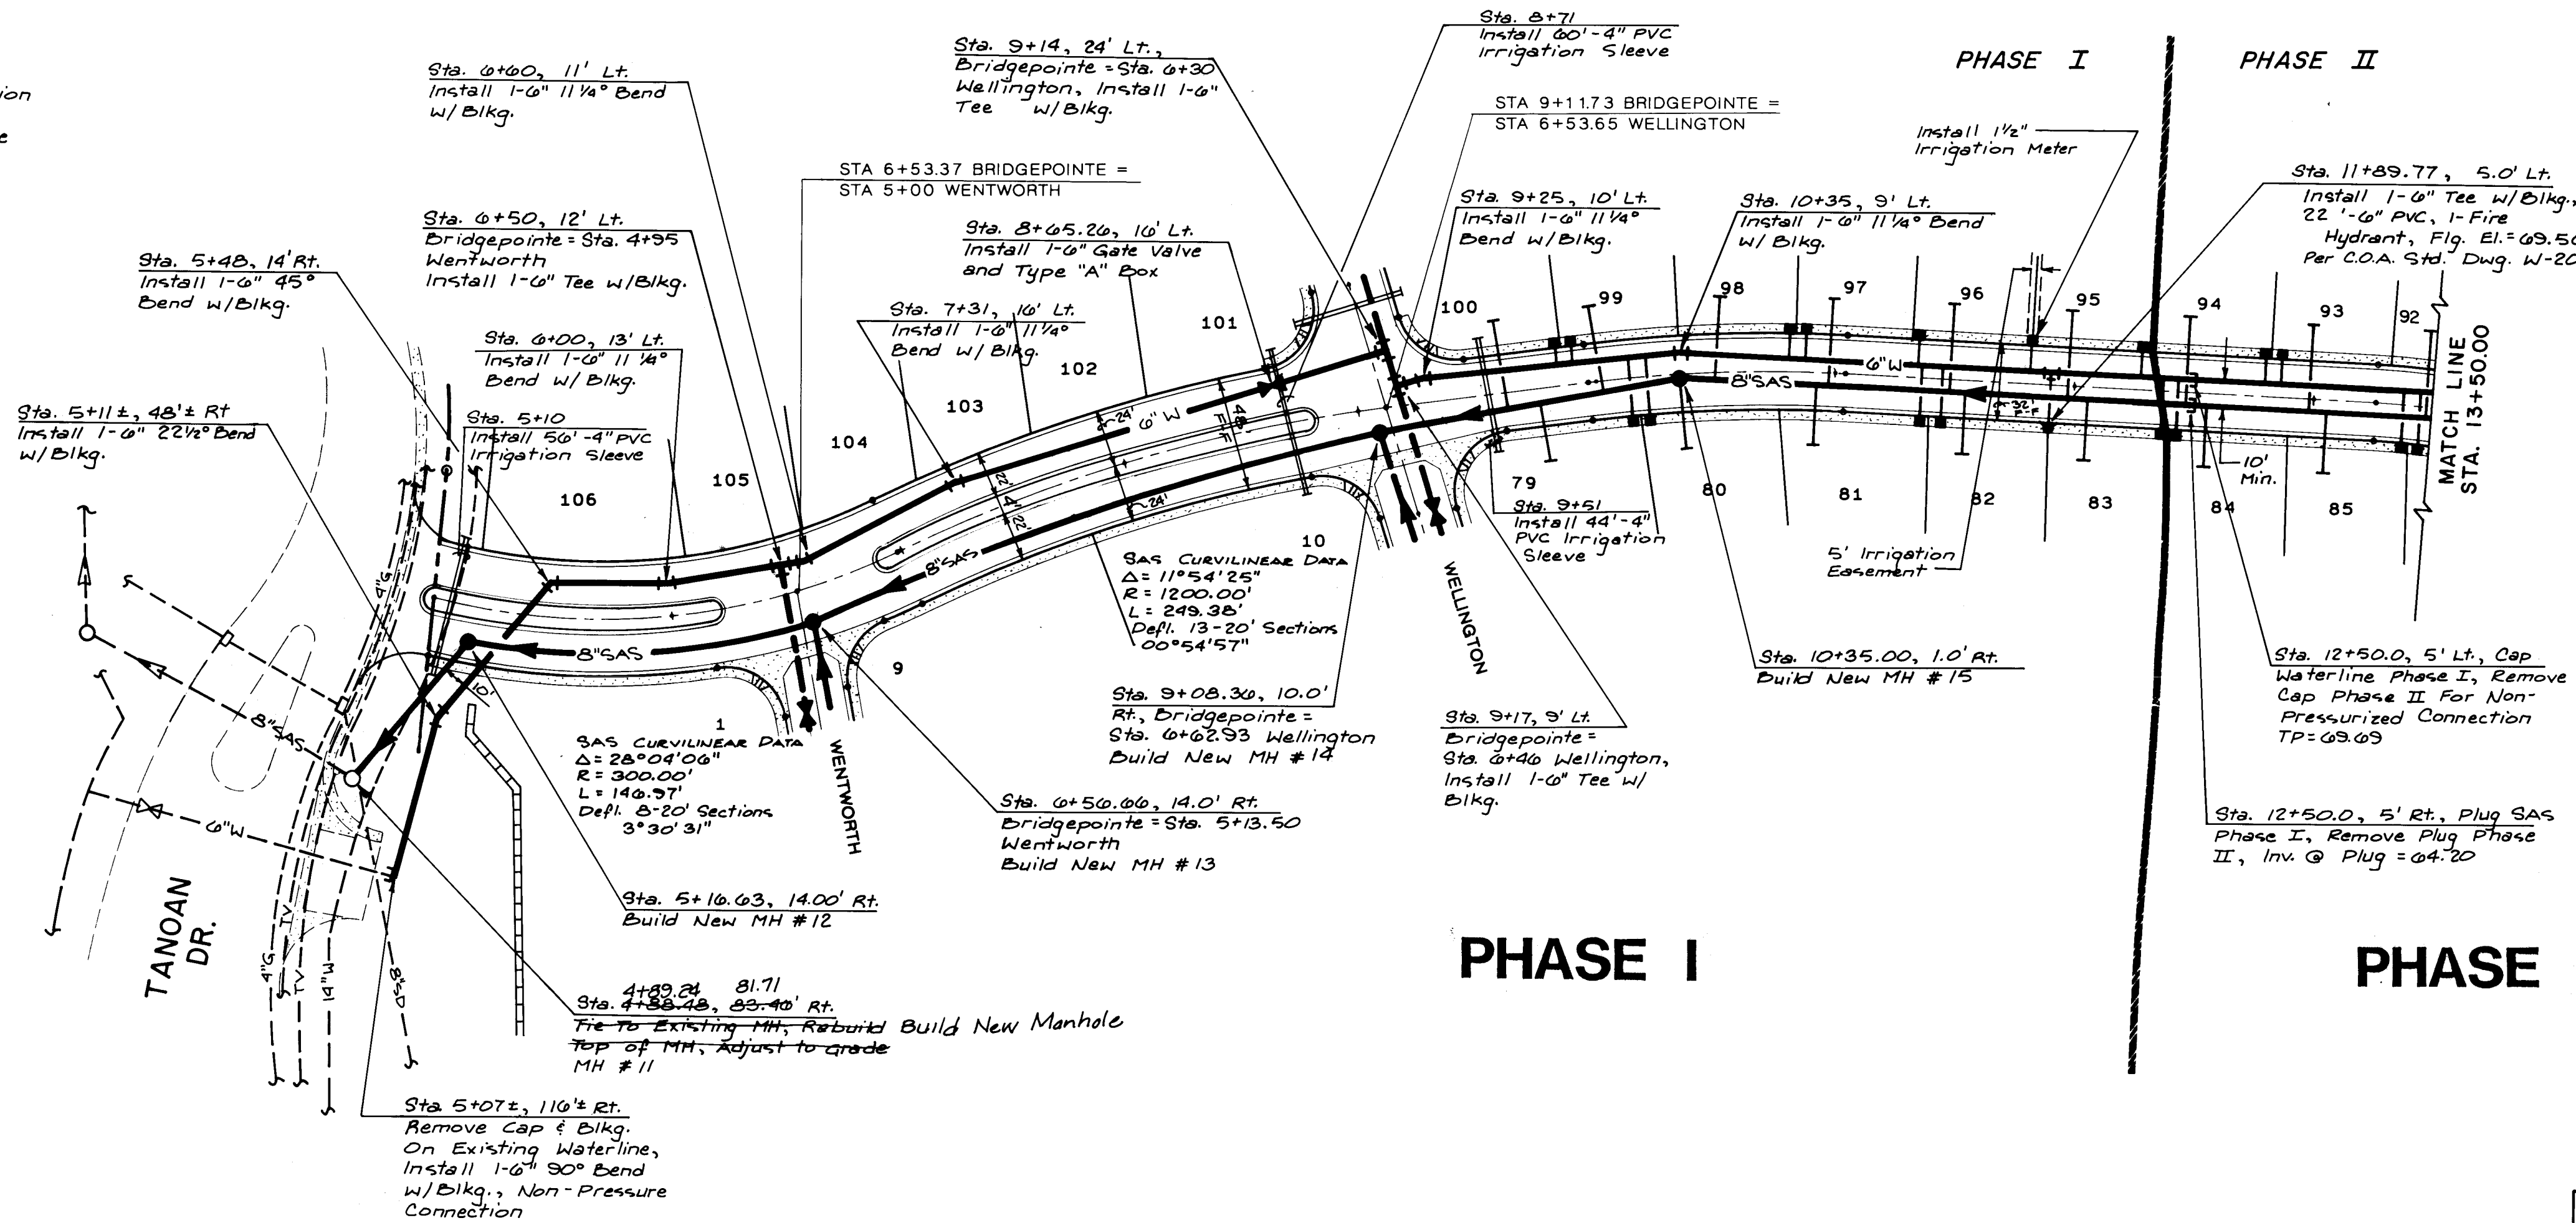

SCALE:
HORIZ. 1" = 50'
VERT. 1" = 10'

BRIDGEPOINTE

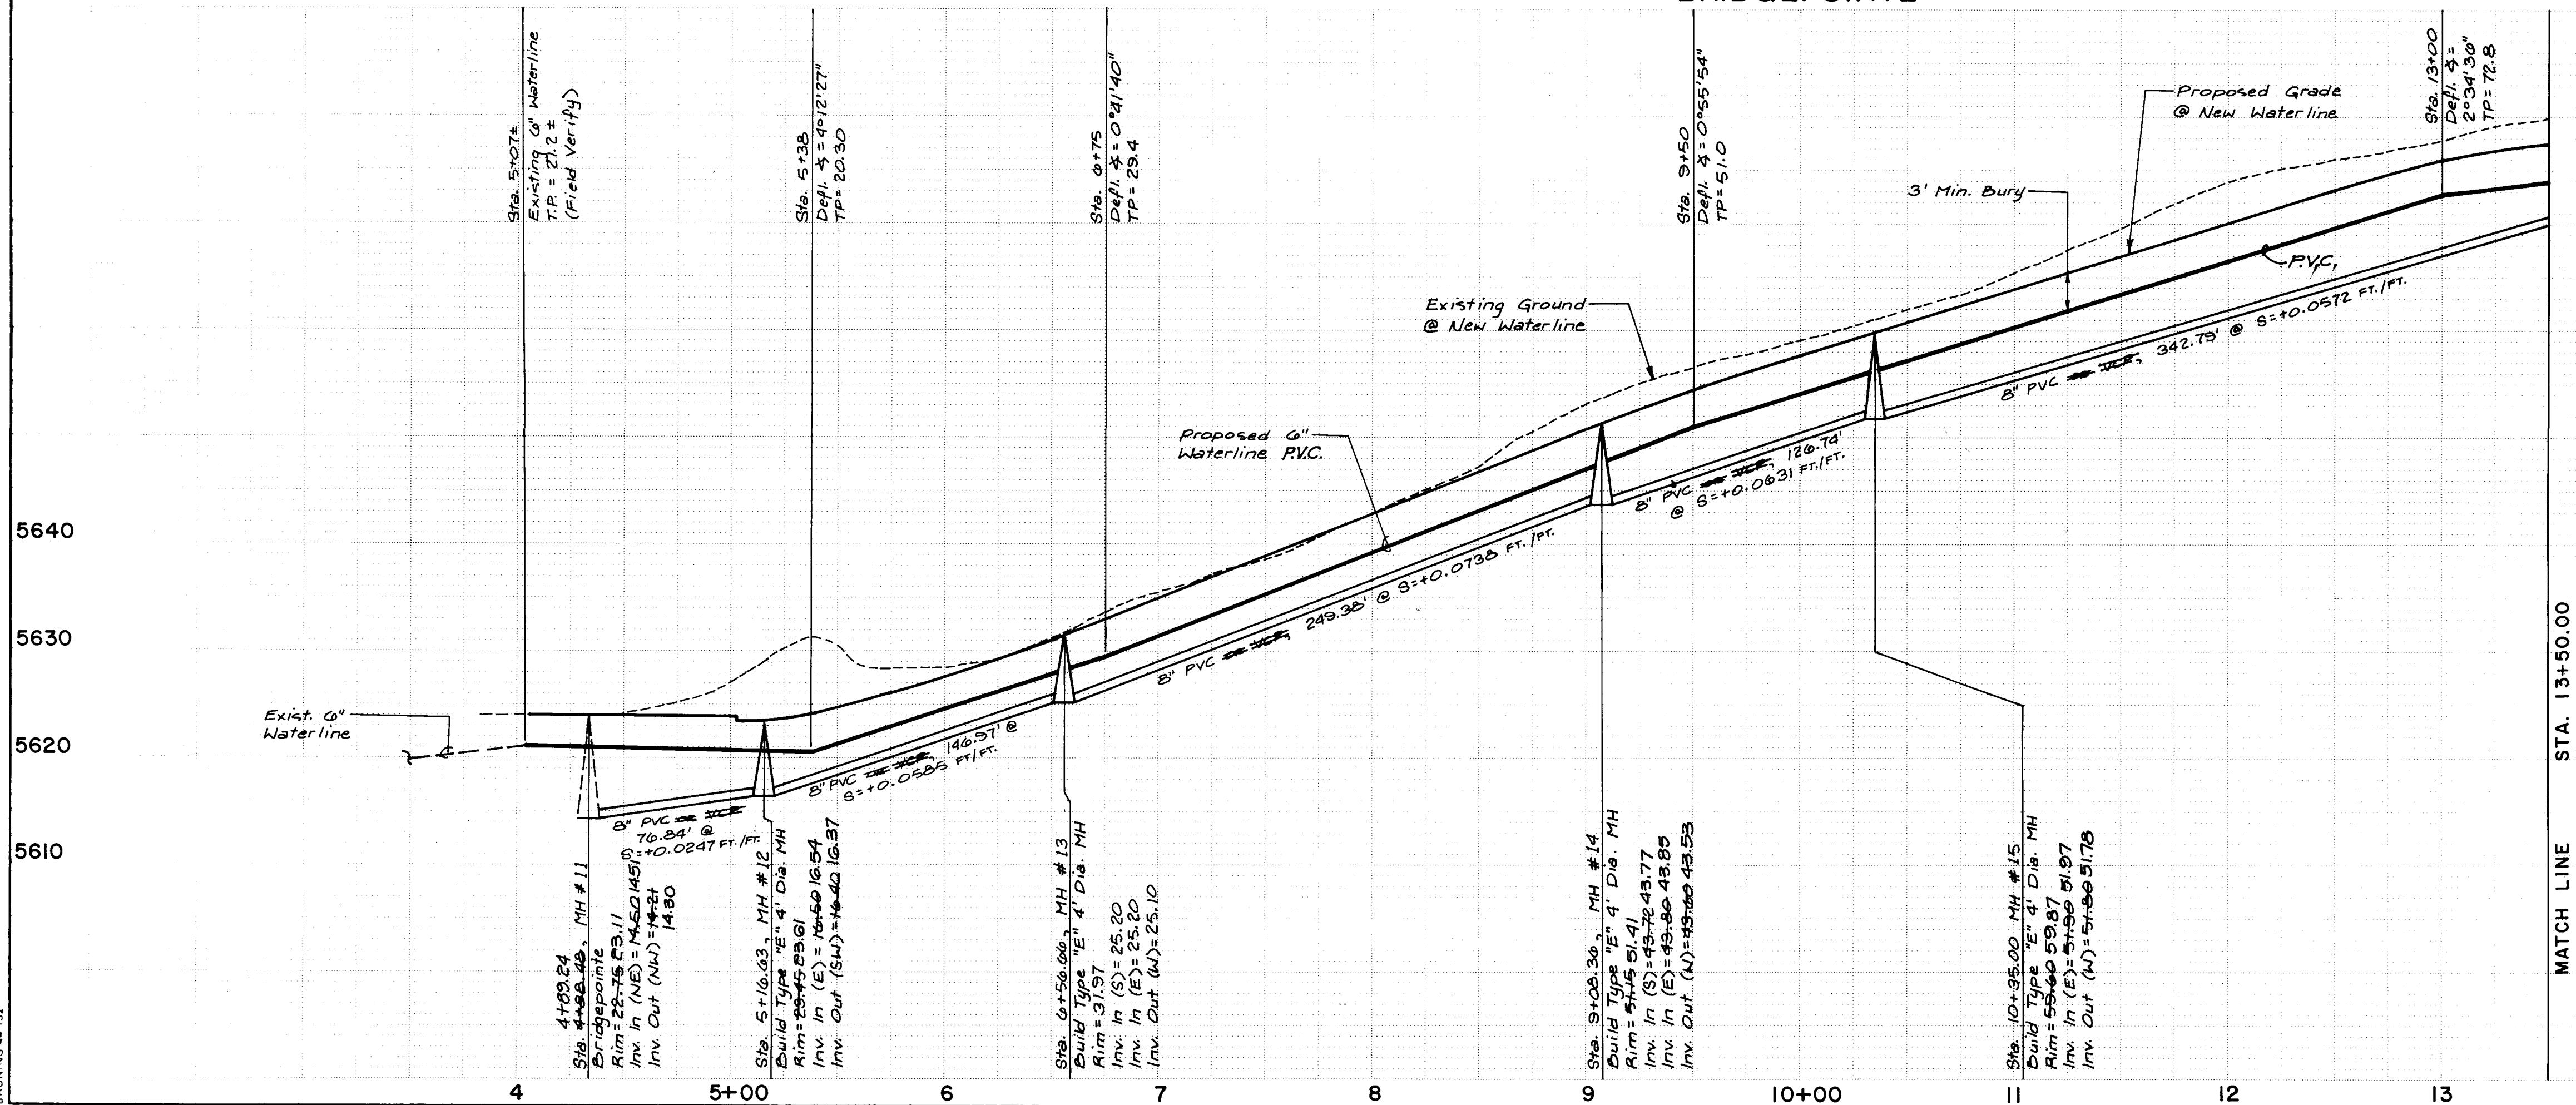

SEWER SERVICES

BRIDGEPOINTE 4+85 TO 13+50

LOT NO.	STATION	INVERT #	PLUG	LENGTH
100	9+60.0	49.3	38'	
79	9+75.5	50.0	25'	
99	10+03.0	52.0	52.1	36'
80	10+32.3	53.6	26'	
98	10+50.2	55.0	55.2	35'
81	10+91.5	57.2	56.6	26'
97	10+98.2	57.7	56.7	36'
96	11+46.3	60.7	60.6	36'
82	11+48.0	60.7	60.3	26'
95	11+96.3	63.3	63.3	36'
83	12+04.8	63.6	63.6	26'
94	12+46.3	66.2	66.3	36'
84	12+54.8	66.5	66.5	26'
93	12+96.3	69.1	69.1	36'
85	13+04.8	69.4	69.4	26'
92	13+46.0	71.9	71.9	36'

Greiner Engineering

2601 Wyoming NE
Albuquerque, New Mexico 87112
(505) 292-1936

CITY OF ALBUQUERQUE
PUBLIC WORKS DEPARTMENT
ENGINEERING DIVISION

TITLE: THE CHAMPIONS AT TANOAN
BRIDGEPOINTE STA. 4+88.48 - 13+50
PUBLIC UTILITY PLAN & PROFILE

APPROVALS	ENGINEER	DATE	APPROVALS	ENGINEER	DATE
City Engineer	ALR	2/13/97	Liquid Waste	W. H. Wood	2/13/97
ACE - Design			Traffic	NADPH	2/13/97
ACE - Hydrology	NR		Water	W. H. Wood	2/13/97

DRAWING NO. 3096 MAP NO. E-21 SHEET 16 OF 28

RECORD DRAWING


This drawing was modified to show public improvements as constructed. These modifications were made using information and measurements obtained by the contractor. The contractor is responsible for the accuracy of the information and measurements obtained by the contractor. The modifications were made to the original drawing by the engineer. The engineer is responsible for the accuracy of the modifications. The modifications were made to the original drawing by the engineer. The engineer is responsible for the accuracy of the modifications.

William F. Coleman P.E. 3345 7/14/97
Professional Engineer

NO.	BY	DATE	FIELD NOTES	AS BUILT INFORMATION
1748	GREINER	1996	station post 0.3 ft. above the ground. To reach the station post from the intersection of I-25 and San Mateo NE, go south on San Mateo 0.2 miles to Academy Rd. Turn left, go east and then northeast. Miles to Eubank NE. The station is about 0.4 miles northeast of this point. Elevation = 5765.23	CONTRACTOR J.E. HALE DATE 8/97 APPROVED BY RBR DATE 7/97 FIELD BY RBR DATE 8/97 CORRECTED BY E.H. DATE 8/97 MICRO-FILM INFORMATION RECORDED BY DATE

ENGINEER'S SEAL
Professional Engineer
William F. Coleman
P.E. 3345
7/14/97

NO.	DATE	REVISIONS	BY
1	1-87	DESIGN	W. H. Wood
2	1-87	DESIGN	W. H. Wood
3	1-87	DESIGN	W. H. Wood
4	1-87	DESIGN	W. H. Wood
5	1-87	DESIGN	W. H. Wood
6	1-87	DESIGN	W. H. Wood
7	1-87	DESIGN	W. H. Wood
8	1-87	DESIGN	W. H. Wood
9	1-87	DESIGN	W. H. Wood
10	1-87	DESIGN	W. H. Wood
11	1-87	DESIGN	W. H. Wood
12	1-87	DESIGN	W. H. Wood

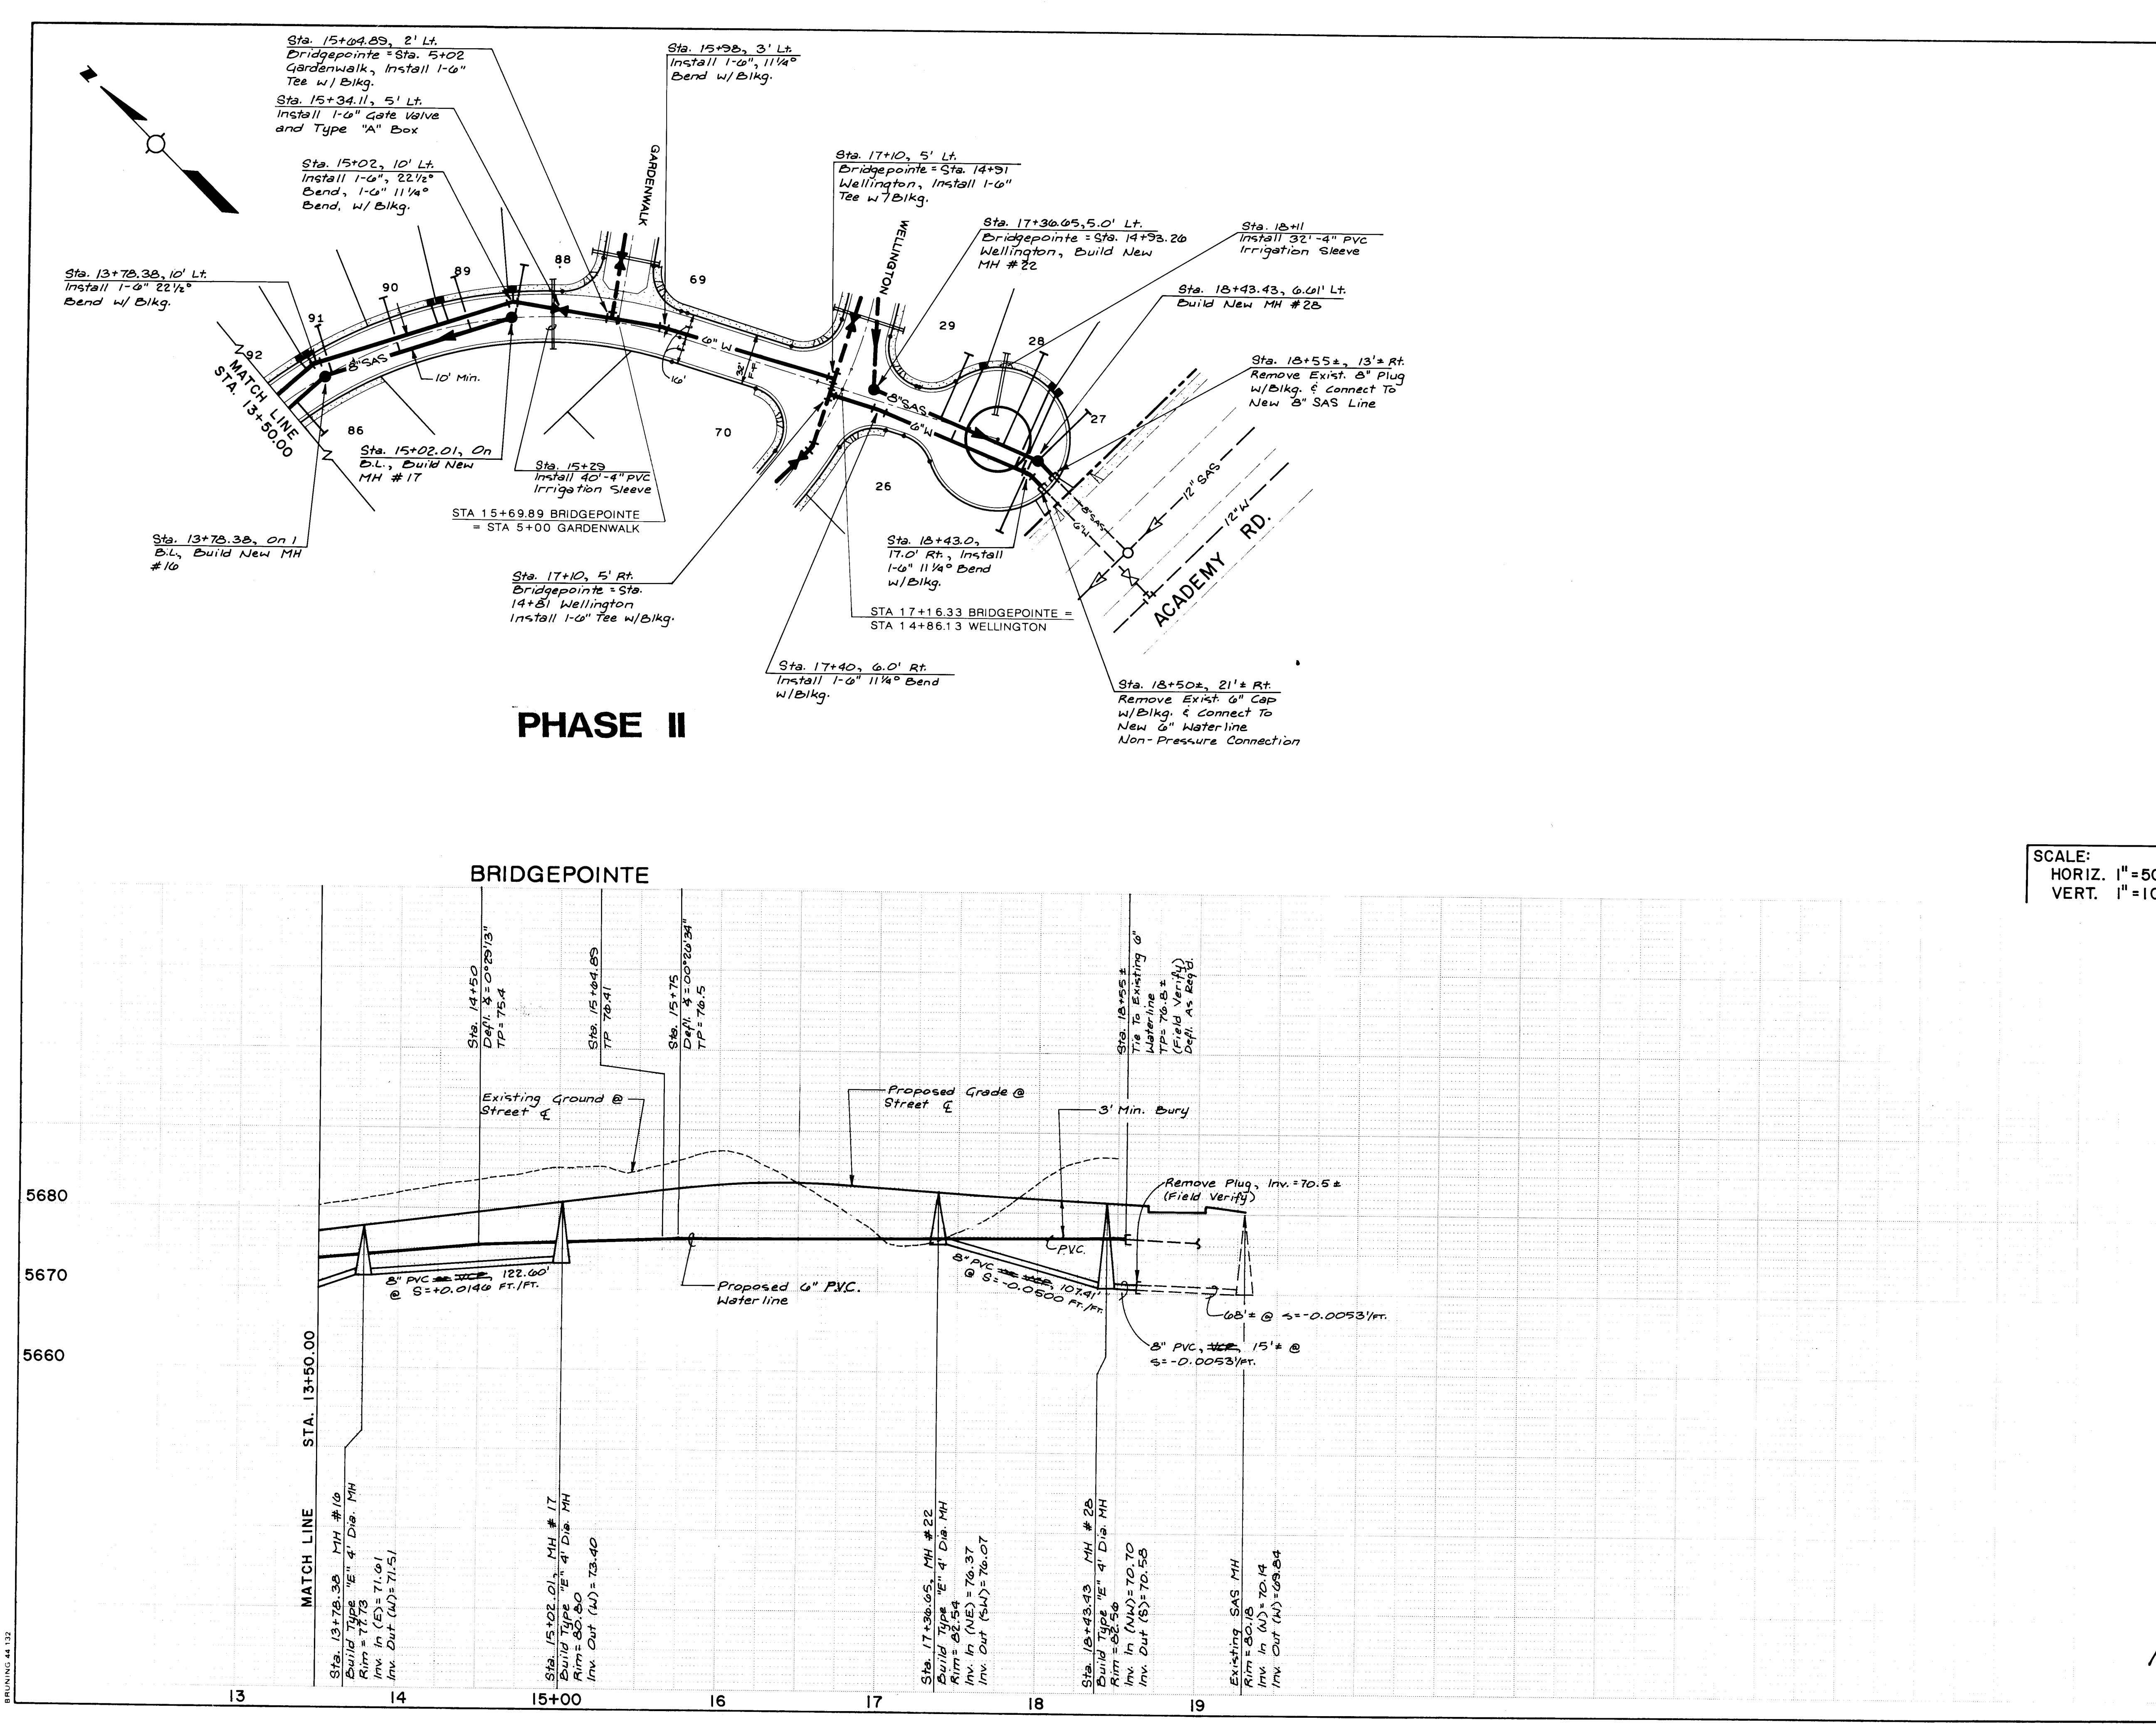

SCALE:
HORIZ. 1"=50'
VERT. 1"=10'

SEWER SERVICES

BRIDGEPOINTE 13+50 TO 18+55


LOT NO.	STATION	INVERT @	LENGTH
86	13+55.7	72.2	25'
91	13+83.7	73.9	35'
90	14+27.0	74.6	39'
89	14+74.3	75.3	38'
88	15+02.0	75.6	32'
29	17+82.0	76.2	44'
28	18+22.0	74.5	63'
27	18+43.4	73.0	42'
26	18+43.4	73.2	48'

1	2	3	4	5	6	7	8	9	10	11	12
26	30	9	6	1	7	8	7				

Greiner Engineering
2601 Wyoming NE
Albuquerque, New Mexico 87112
(505) 292 1936

CITY OF ALBUQUERQUE PUBLIC WORKS DEPARTMENT ENGINEERING DIVISION					
TITLE: THE CHAMPIONS AT TANOAN BRIDGEPOINTE STA. 13+50 - 18+55 PUBLIC UTILITY PLAN & PROFILE					
APPROVALS	ENGINEER	DATE	APPROVALS	ENGINEER	DATE
City Engineer	<i>[Signature]</i>	2/13/87	Liquid Waste	<i>[Signature]</i>	2/13/87
A C E - Design	" "	"	Traffic	<i>[Signature]</i>	2/13/87
A C E - Hydrology	" "	"	Water	<i>[Signature]</i>	2/13/87
DRAWING NO. 3096		MAP NO. E-21		SHEET 17 OF 28	

SURVEY INFORMATION		FIELD NOTES		BENCH MARKS		AS BUILT INFORMATION	
NO.	BY	DATE	CONTRACTOR	CONTRACTOR	CONTRACTOR	CONTRACTOR	CONTRACTOR
1748	GREINER	1986	CONTRACTOR	CONTRACTOR	CONTRACTOR	CONTRACTOR	CONTRACTOR
1653	GREINER	6-84	CONTRACTOR	CONTRACTOR	CONTRACTOR	CONTRACTOR	CONTRACTOR
Aerial Photography		Tom Mann and Assoc. 8-7-86		Elevation = 5765.23		Elevation = 5765.23	
DESIGNED BY		DATE 1-87		DESIGNED BY		DATE 1-87	
DRAWN BY		DATE 1-87		DRAWN BY		DATE 1-87	
CHECKED BY		DATE 1-87		CHECKED BY		DATE 1-87	

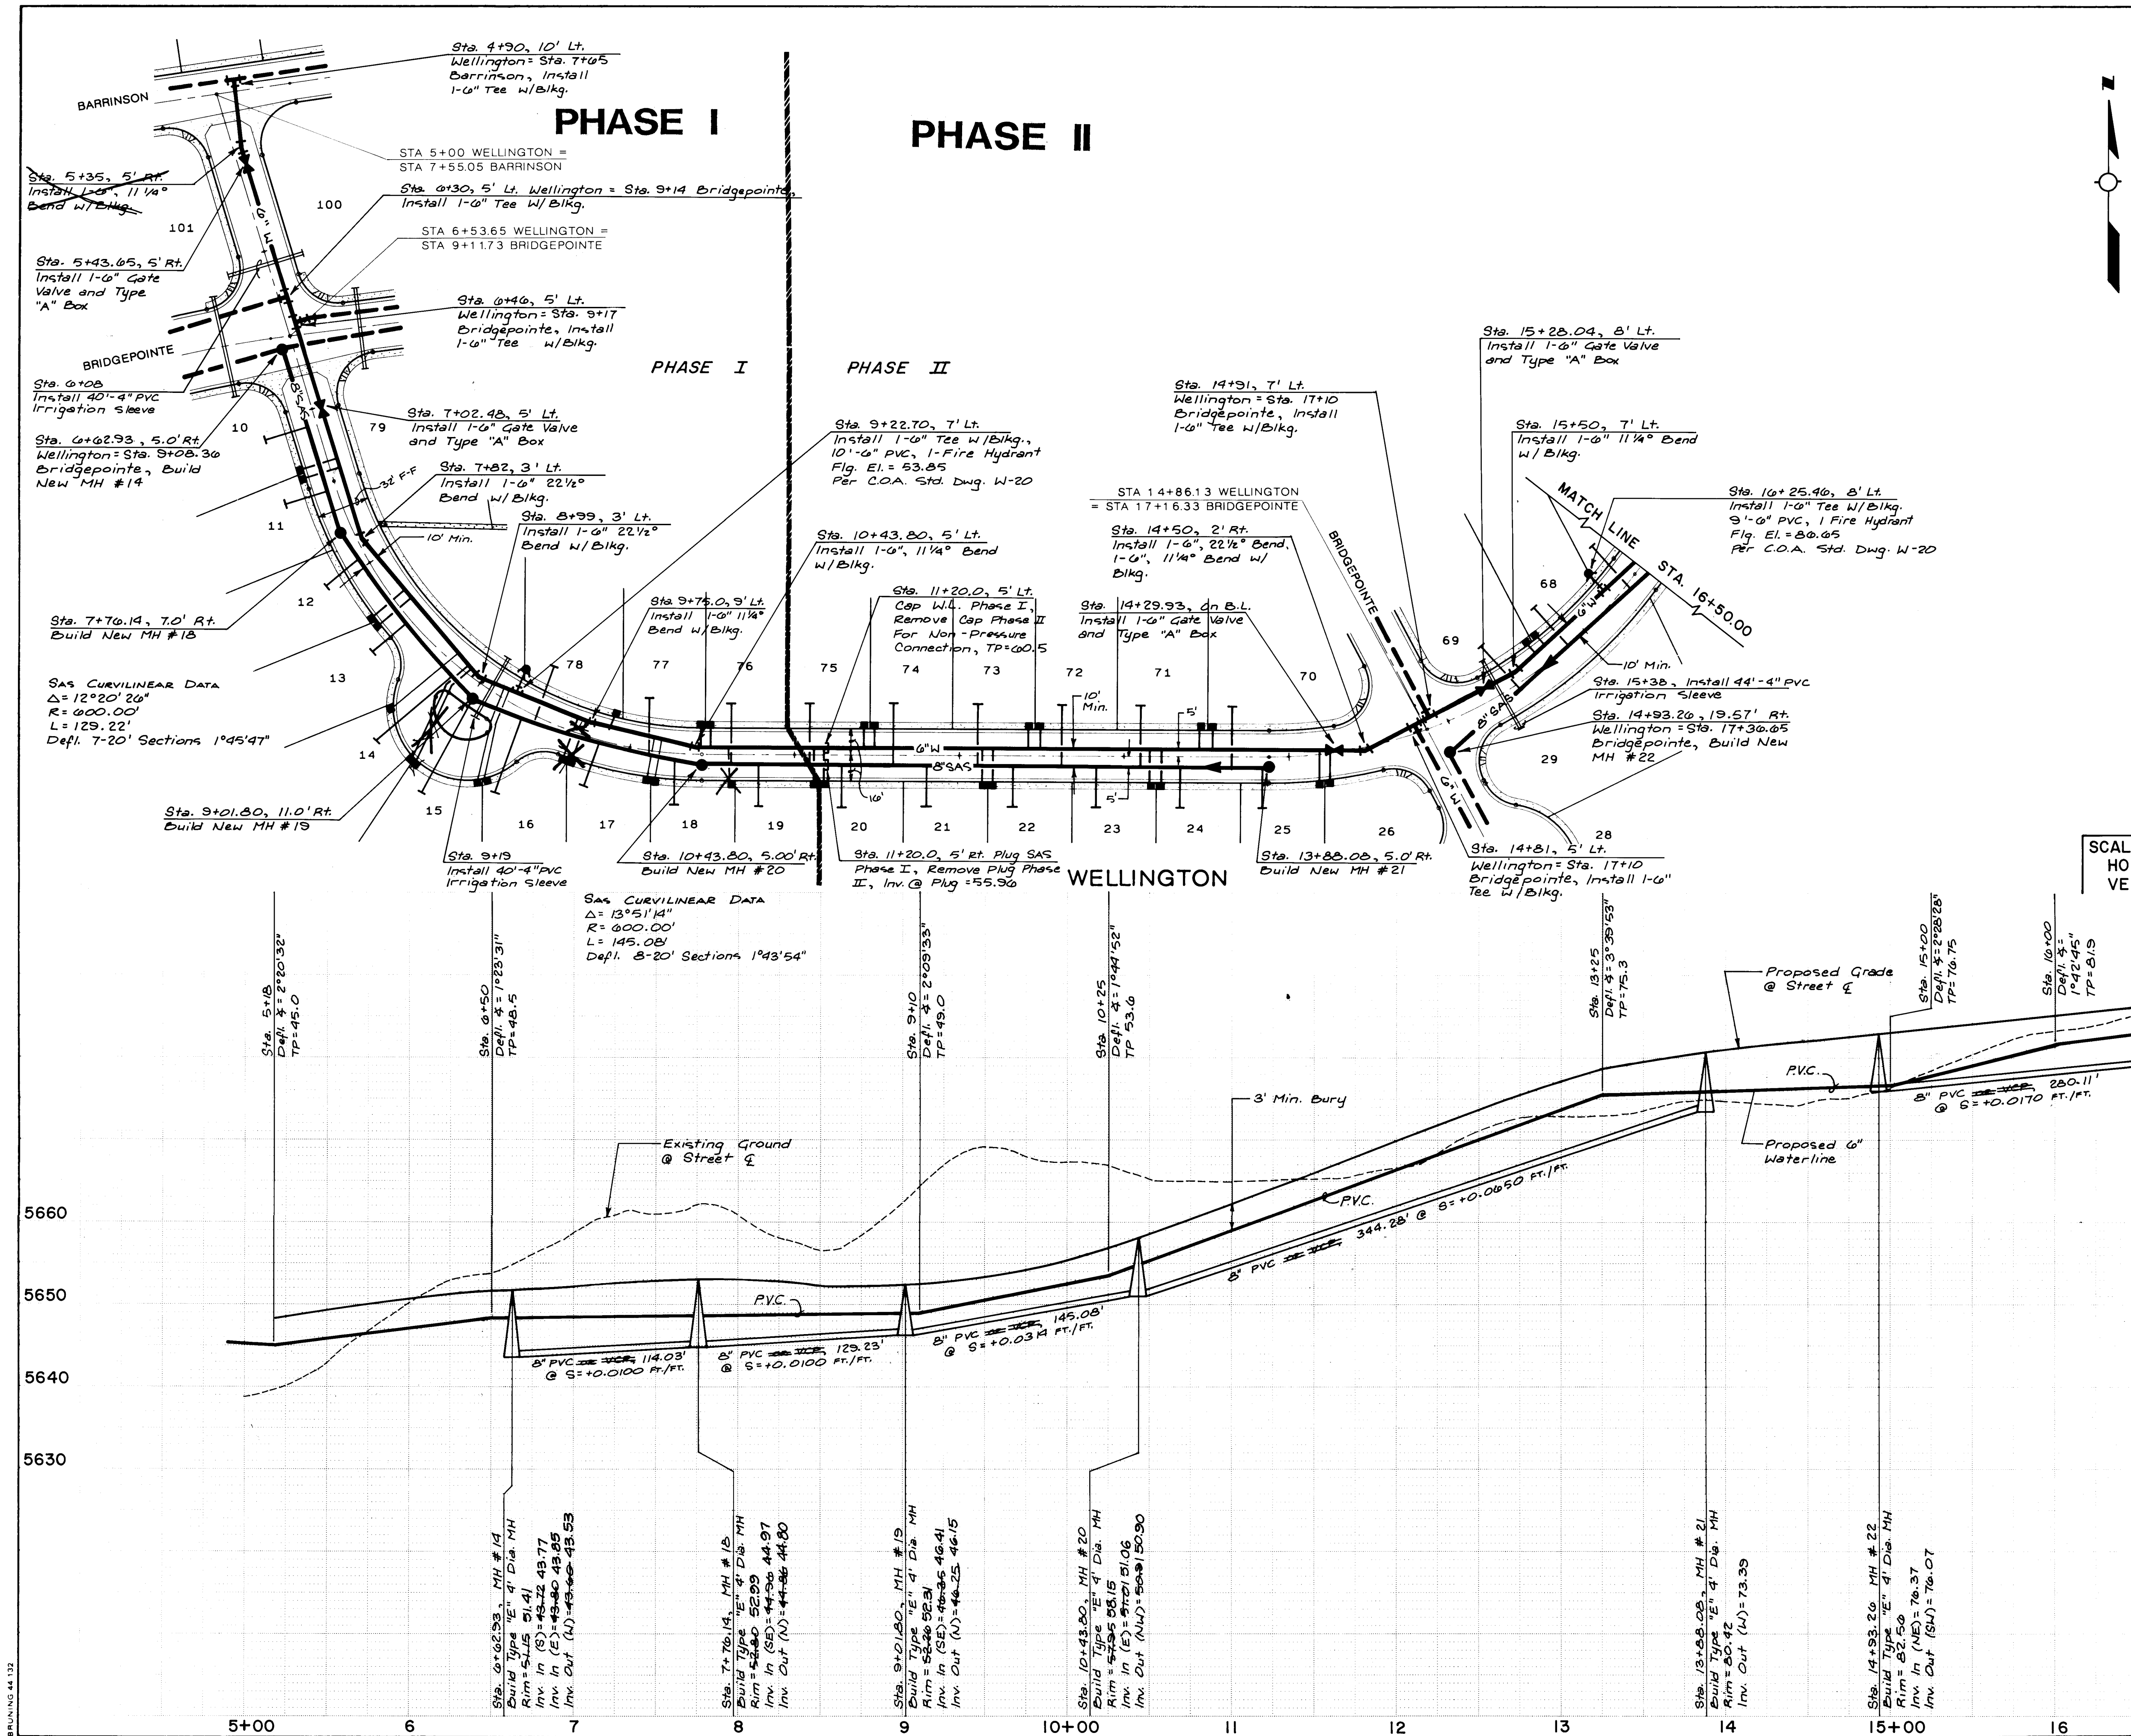

SCALE:
HORIZ. 1"=50'
VERT. 1"=10'

RECORD DRAWING

This drawing is modified from public information and measurements obtained by the contractor and City Inspector. The modifications are as required by the City Engineer and the Development Process Manual, Section 27.4 to the best of my knowledge and belief.

William F. Coleman P.E. 5945-7/10/10

Date _____


SEWER SERVICES

WELLINGTON 4+90 TO 16+50				
LOT NO.	STATION	INVERT #	PLUG	LENGTH
10	7+13.0	46.2	26'	
11	7+54.0	46.7	26'	
12	7+95.0	47.2	26'	
13	8+44.0	47.7	26'	
14	8+81.0	48.7	60'	
15	9+01.8	49.1	65'	
16	9+31.0	49.7	48'	
17	9+40.0	49.8	37'	
18	9+82.0	50.9	27'	
19	10+11.0	52.0	34'	
20	10+27.0	52.3	27'	
21	10+61.0	54.3	36'	
22	10+78.0	55.2	24'	
23	11+09.0	57.5	36'	
24	11+29.0	58.5	24'	
25	11+60.0	60.8	36'	
26	11+80.0	61.8	24'	
27	12+11.0	64.1	36'	
28	12+32.0	65.2	24'	
29	12+62.0	67.4	36'	
30	12+83.0	63.5	24'	
31	13+10.0	70.5	36'	
32	13+34.0	71.9	24'	
33	13+65.0	74.1	36'	
34	13+84.0	75.1	24'	
35	14+51.0	79.6	36'	
36	15+91.0	80.2	31'	
37	16+41.0	81.1	36'	

Greiner Engineering


2601 Wyoming NE
Albuquerque, New Mexico 87112
(505) 292-1936

CITY OF ALBUQUERQUE PUBLIC WORKS DEPARTMENT ENGINEERING DIVISION				
TITLE: THE CHAMPIONS AT TANOAN				
WELLINGTON STA. 4+90 - 16+50 PUBLIC UTILITY PLAN & PROFILE				
APPROVALS	ENGINEER	DATE	APPROVALS	ENGINEER
City Engineer	<i>[Signature]</i>	2/13/07	Liquid Waste	<i>[Signature]</i>
ACE - Design	<i>[Signature]</i>	11	Traffic	<i>[Signature]</i>
ACE - Hydrology	<i>[Signature]</i>	11	Water	<i>[Signature]</i>
DESIGNED BY <i>[Signature]</i> DATE 1-87				
DRAWN BY <i>[Signature]</i> DATE 1-87				
CHECKED BY <i>[Signature]</i> DATE 1-87				

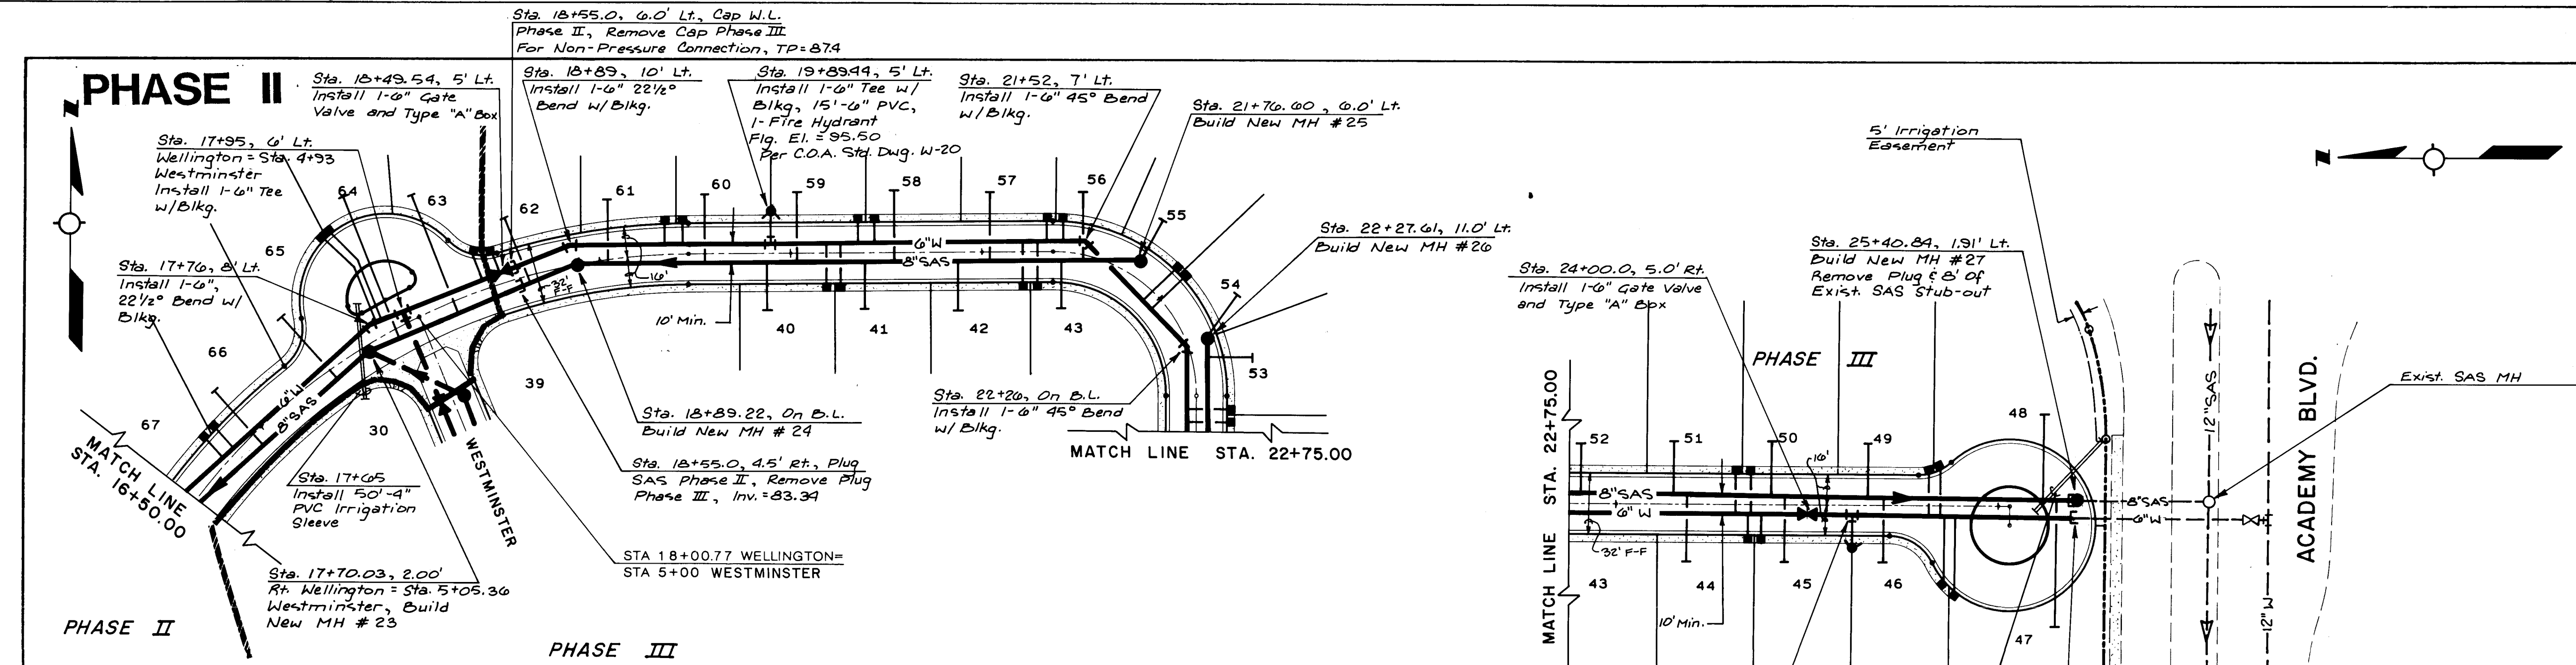

PHASE III

WELLINGTON

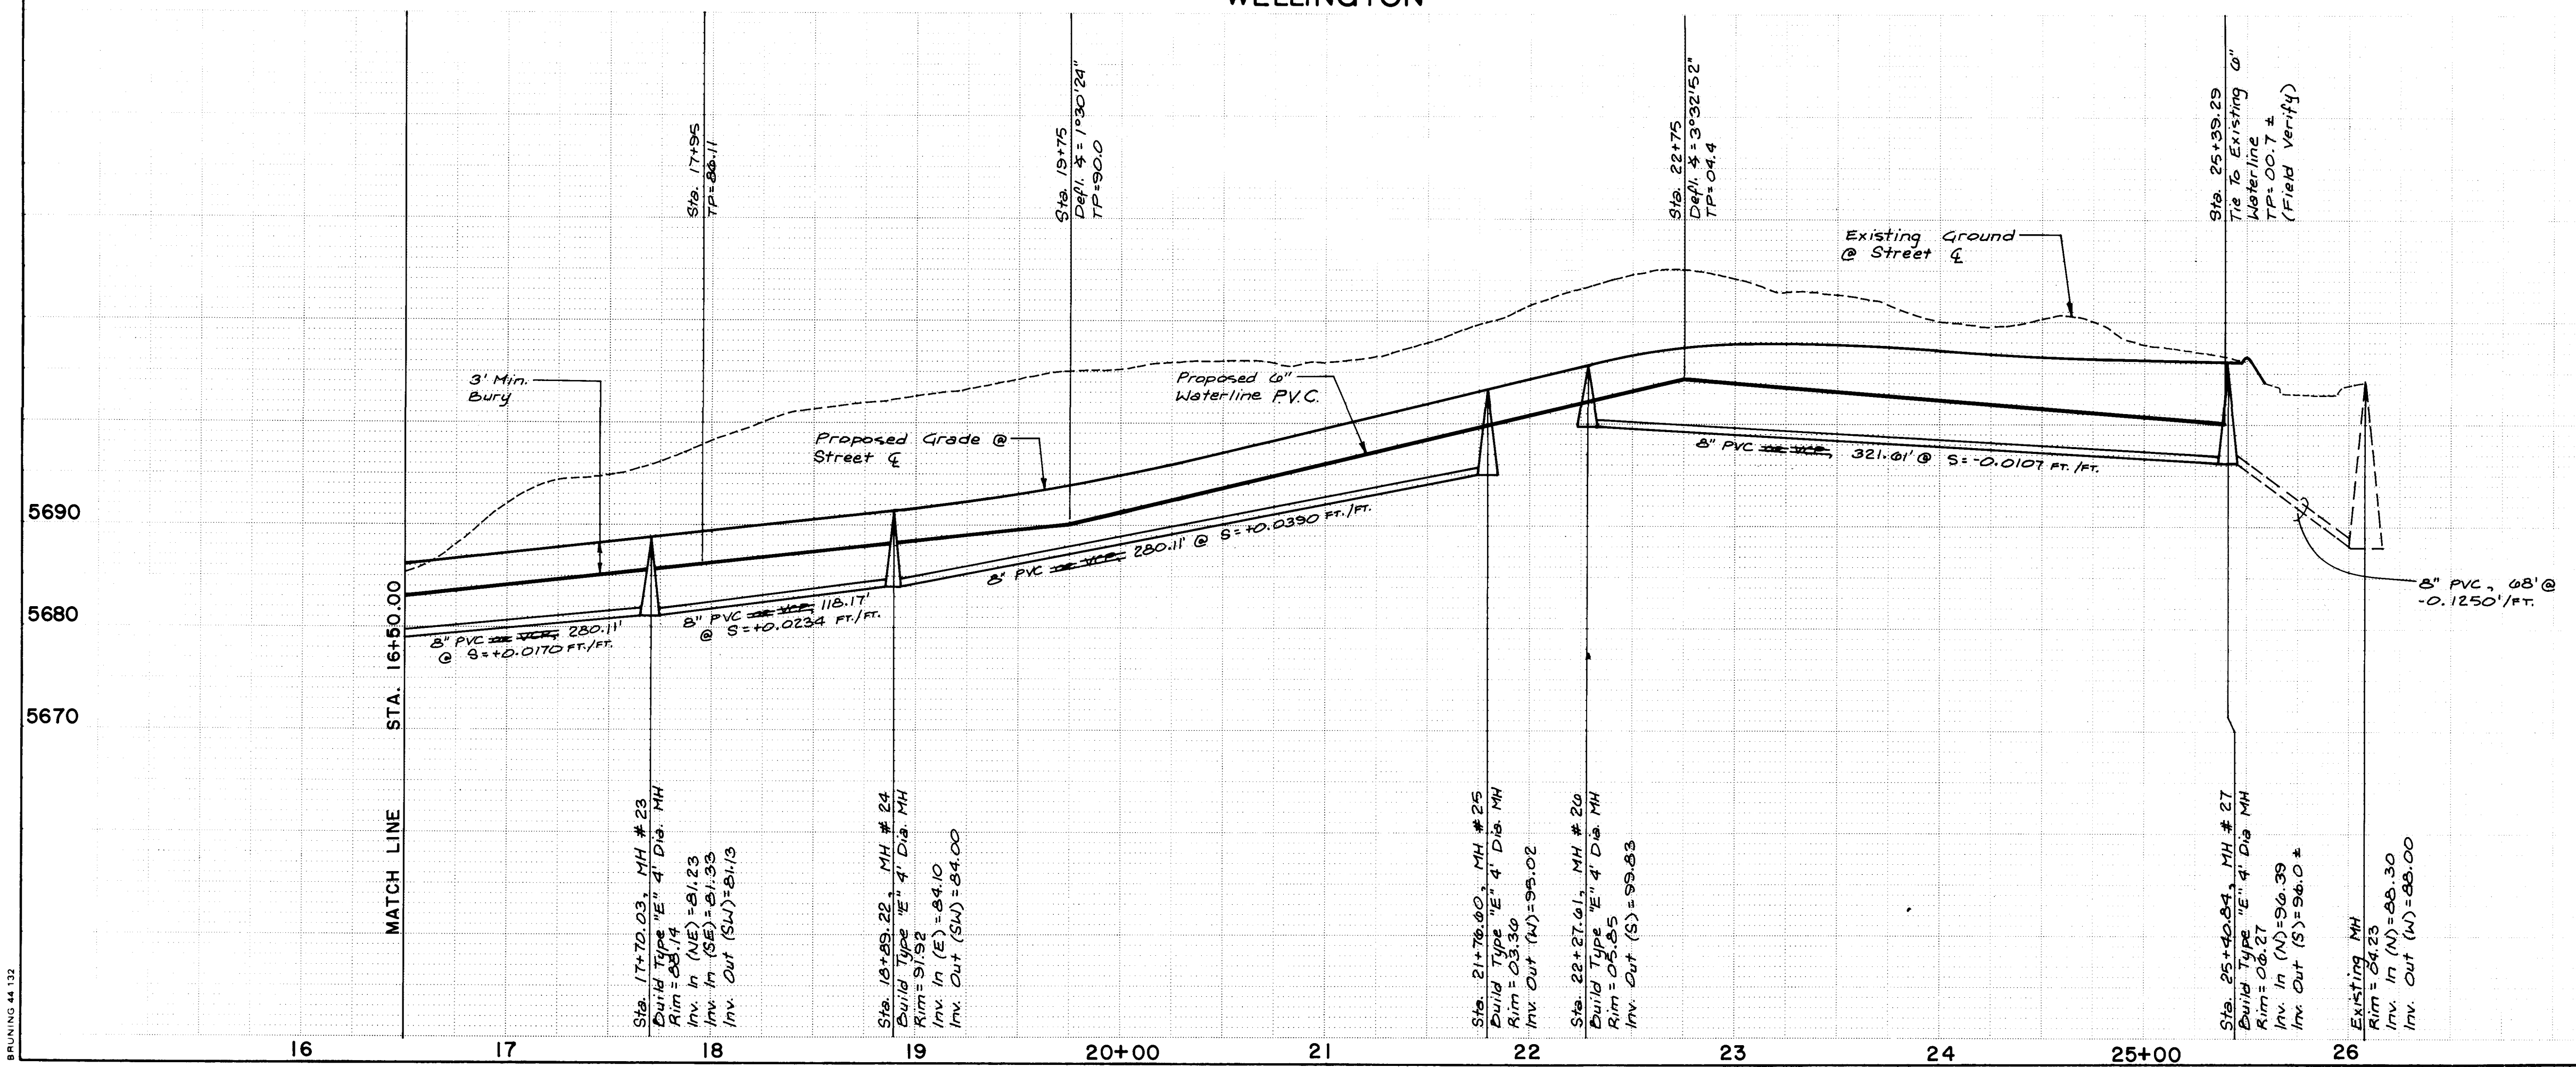

SCALE:
HORIZ. 1"=50'
VERT. 1"=10'

SEWER SERVICES

WELLINGTON 16+50 TO 25+05.84			
LOT NO.	STATION	INVERT #	LENGTH
66	16+95.0	82.1	38'
65	17+48.0	83.1	44'
64	17+87.0	84.7	80'
63	18+21.0	85.3	67'
62	18+62.0	85.6	37'
61	19+05.0	86.9	34'
60	19+56.0	88.9	36'
40	19+88.0	89.9	24'
59	20+04.0	90.8	36'
41	20+40.0	92.0	24'
58	20+55.0	92.8	36'
42	20+88.0	93.8	24'
57	21+05.0	94.7	36'
43	21+42.0	95.9	24'
56	21+54.0	96.6	36'
55	21+76.6	97.0	24'
54	22+27.6	101.9	27'
53	22+37.0	101.6	24'
52	22+81.0	101.2	26'
51	23+30.0	100.7	26'
44	23+37.0	100.8	36'
50	23+81.0	100.1	26'
45	23+88.0	100.2	36'
49	24+31.0	99.6	26'
46	24+40.0	99.6	34'
48	25+23.0	99.0	45'
47	25+30.0	99.3	66'

1	2	3	4	5	6	7	8	9	10	11	12
26	30	96	19	87							

Greiner Engineering

2601 Wyoming NE
Albuquerque, New Mexico 87112
(505) 292-1936



CITY OF ALBUQUERQUE
PUBLIC WORKS DEPARTMENT
ENGINEERING DIVISION

TITLE: THE CHAMPIONS AT TANOAN
WELLINGTON STA. 16+50 - 25+05.84
PUBLIC UTILITY PLAN & PROFILE

APPROVALS	ENGINEER	DATE	APPROVALS	ENGINEER	DATE
City Engineer	J. Wood	2/13/97	Liquid Waste	J. Wood	2/13/97
ACE - Design			Traffic	NADWA	2/13/97
ACE - Hydrology	NA		Water	J. Wood	2/13/97

DRAWING NO.	MAP NO.	SHEET	OF
3096	E-21	19	28

AS BUILT INFORMATION		BENCH MARKS		SURVEY INFORMATION		ENGINEER'S SEAL	
CONTRACTOR	DATE	A standard ACS brass tablet stamped "3-221-A" set in a concrete post 0.3 ft. above the ground. To reach the station from the intersection of I-25 and San Mateo NE, go south on San Mateo 0.2 miles to Academy Rd. Turn left, go east and then northeast. Miles to Eubank NE. The station is about 0.4 miles northeast of this point. Elevation = 5765.23	NO.	BY	DATE	NO.	BY
WORK BY	DATE		1746	GREINER	1986		
CHECKED BY	DATE		1653	GREINER	6-84		
FIELD	DATE						
DRAWING	DATE						
CONNECTED BY	DATE						
MICRO-FILM INFORMATION	DATE						
RECORDED BY	DATE						
NO.	DATE						

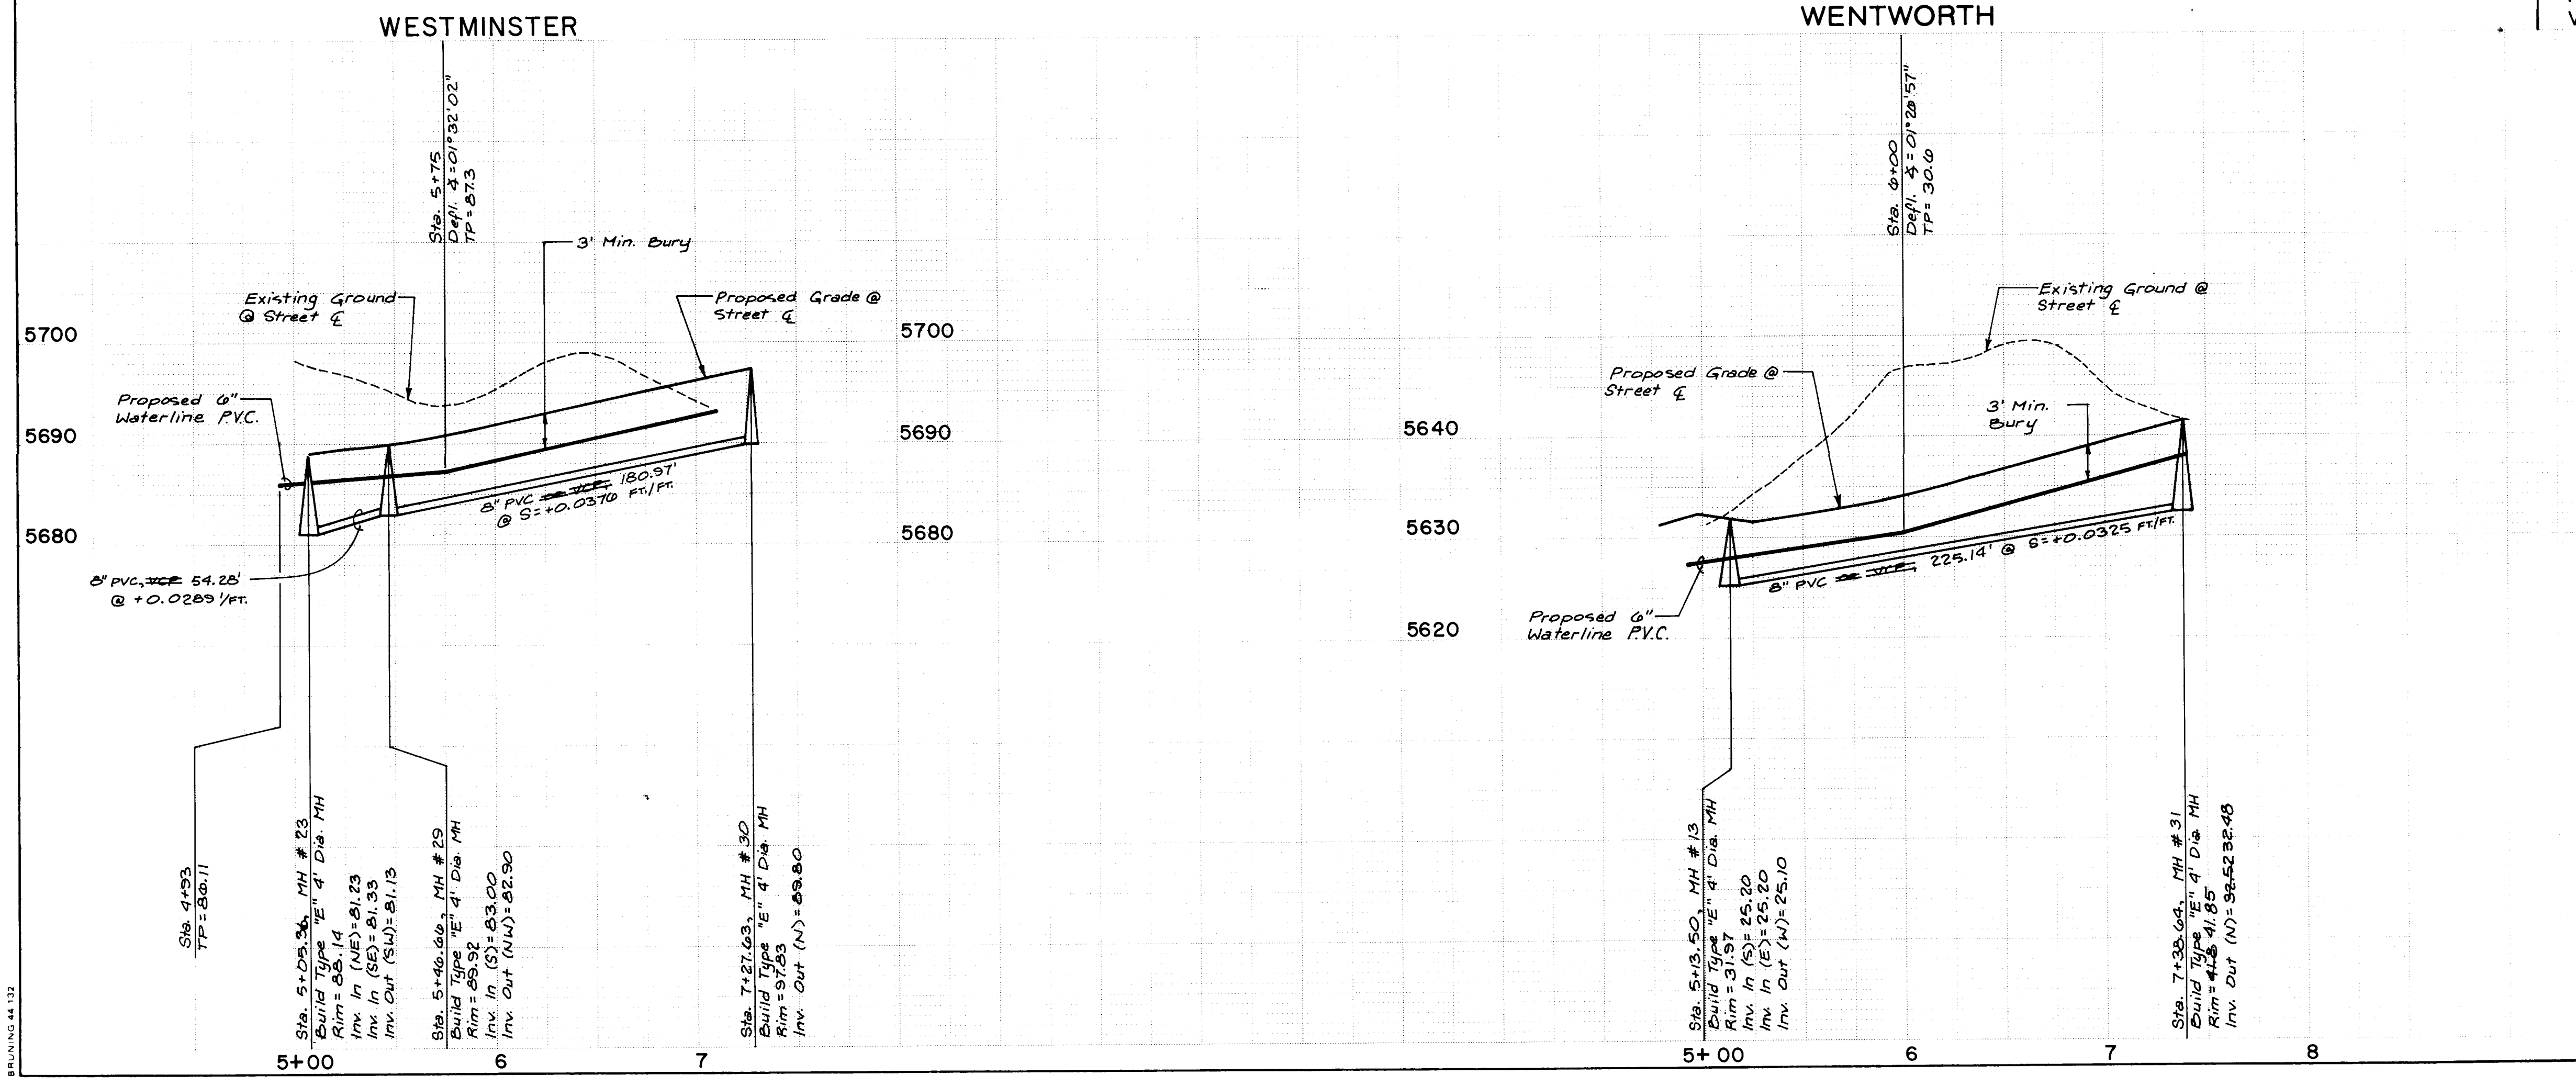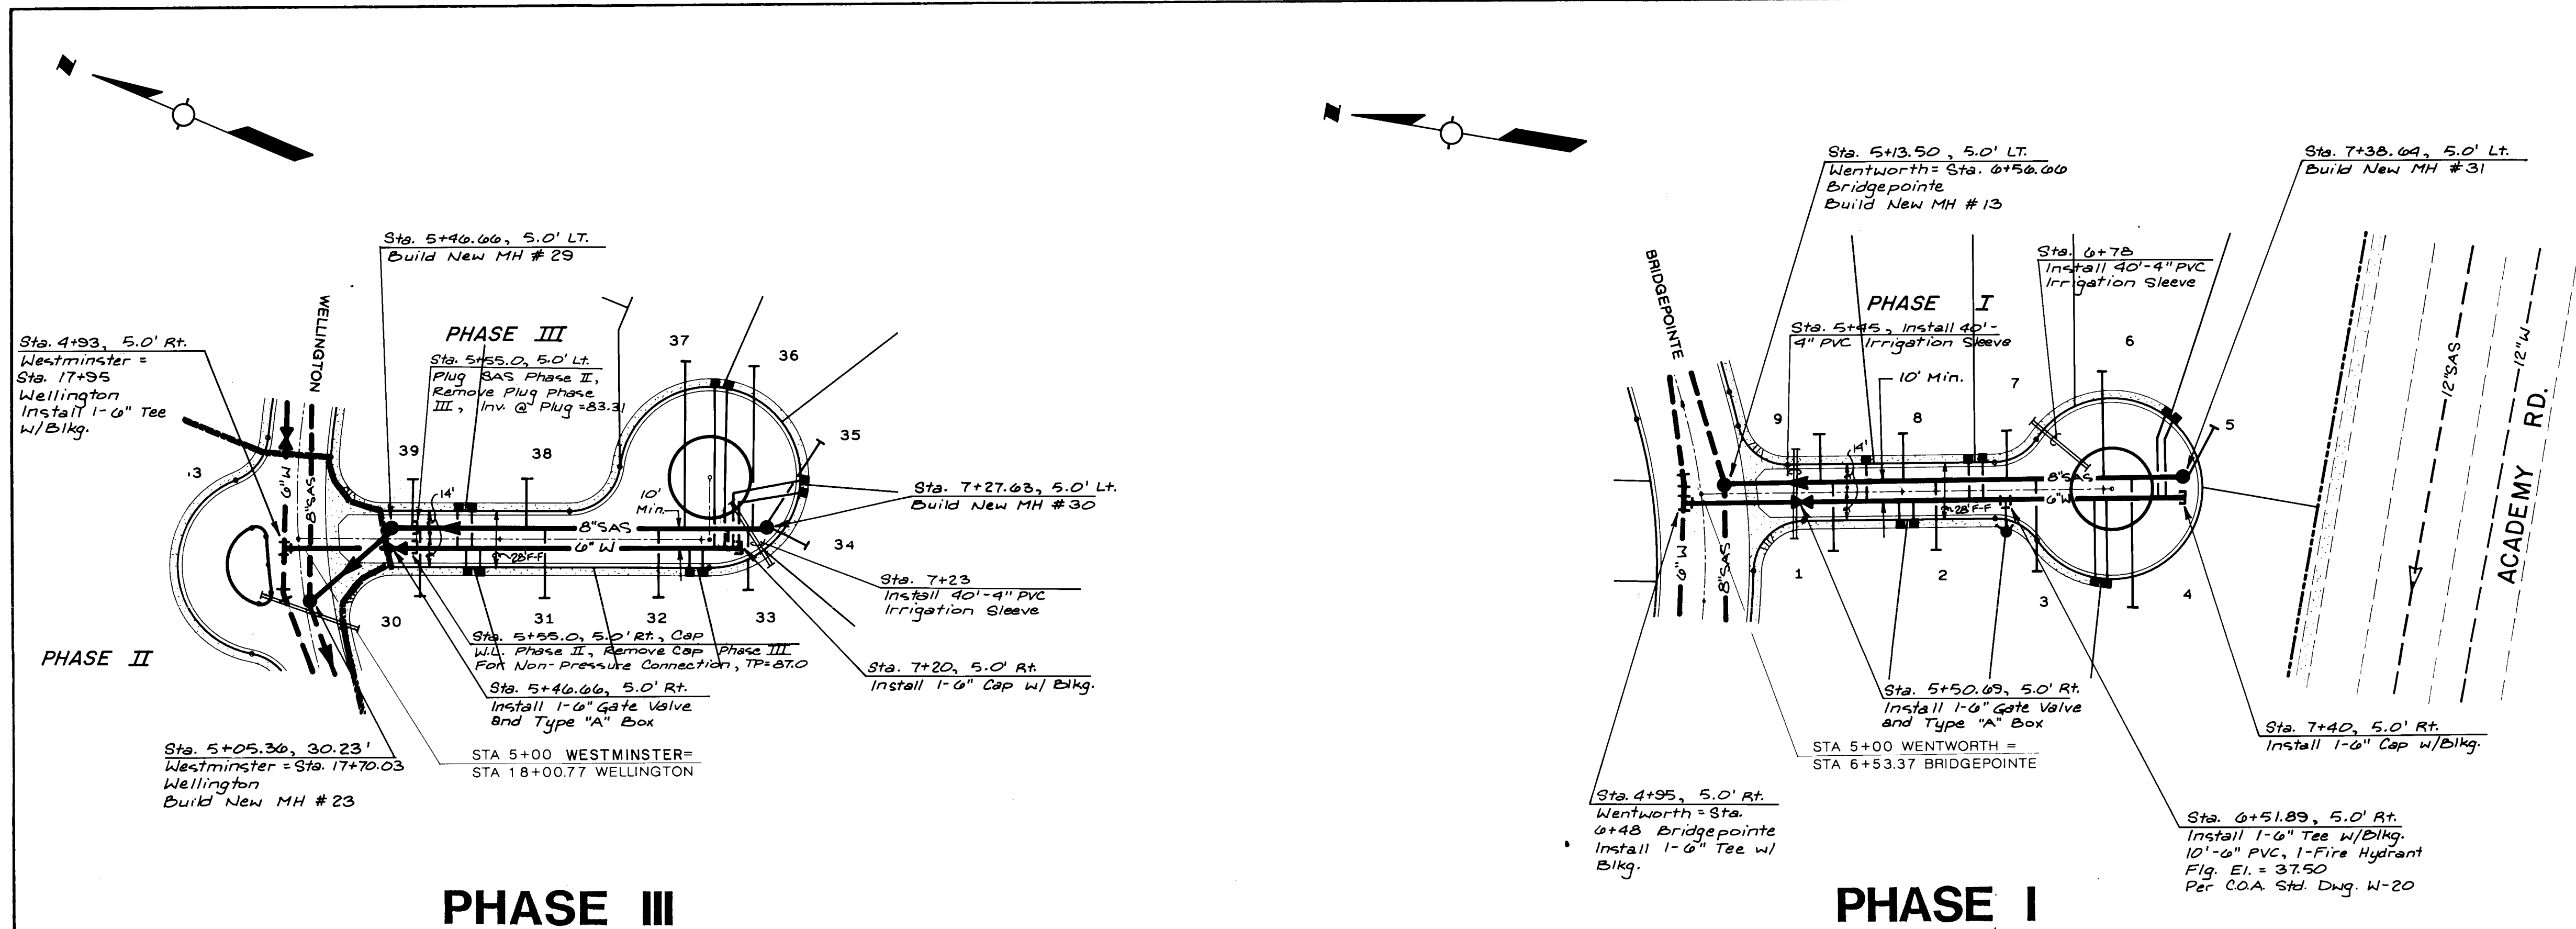

SCALE:
HORIZ. 1" = 50'
VERT. 1" = 10'

RECORD DRAWING
This drawing as modified shows public improvements as indicated. The contractor shall be responsible for obtaining all necessary permits and approvals. The contractor shall be responsible for obtaining all necessary permits and approvals. The contractor shall be responsible for obtaining all necessary permits and approvals.

SEWER SERVICES

WESTMINSTER			
LOT NO.	STATION	INVERT #	LENGTH
39	5+56.0	85.3	24'
30	5+60.0	85.7	24'
38	6+12.0	87.4	24'
31	6+23.0	88.1	34'
32	6+78.0	90.1	34'
37	6+92.0	91.6	84'
33	7+20.0	91.7	34'
36	7+22.0	92.7	80'
35	7+27.6	92.3	50'
34	7+27.6	91.7	20'

WENTWORTH			
LOT NO.	STATION	INVERT #	LENGTH
9	5+58.0	28.5 28.7	24'
1	5+65.0	29.1 29.0	34' 34.3'
8	6+01.0	30.0	24'
2	6+17.5	30.8	34' 34.2'
7	6+51.1	31.7	24'
3	6+67.0	32.5 32.7	34' 34.6'
6	7+00.0	33.8	52'
4	7+15.0	34.5 34.6	54' 64.5'
5	7+38.6	34.6	28'

Greiner Engineering

2601 Wyoming NE
Albuquerque, New Mexico 87112
(505) 292-1936


CITY OF ALBUQUERQUE
PUBLIC WORKS DEPARTMENT
ENGINEERING DIVISION

TITLE: THE CHAMPIONS AT TANOAN
WESTMINSTER AND WENTWORTH
PUBLIC UTILITY PLAN & PROFILE

APPROVALS	ENGINEER	DATE	APPROVALS	ENGINEER	DATE
City Engineer	W. J. Greiner	2/13/87	Liquid Waste	W. J. Greiner	2/13/87
A C E - Design	W. J. Greiner	2/13/87	Traffic	W. J. Greiner	2/13/87
A C E - Hydrology	W. J. Greiner	2/13/87	Water	W. J. Greiner	2/13/87



DRAWING NO.	3096	MAP NO.	E-21	SHEET	20	OF	28
-------------	------	---------	------	-------	----	----	----

SURVEY INFORMATION		BENCH MARKS		AS BUILT INFORMATION	
NO.	BY	DATE	DESCRIPTION	CONTRACTOR	DATE
1748	GREINER	1986	Station from the intersection of I-25 and San Mateo NE, go south on San Mateo 0.2 miles to Academy Rd. Turn left, go east and then northeast. Miles to Eubank NE. The station is about 0.4 miles northeast of this point. Elevation = 5765.23	CONTRACTOR J. E. HALE	DATE 2/13/87
1653	GREINER	6-84	Station from the intersection of I-25 and San Mateo NE, go south on San Mateo 0.2 miles to Academy Rd. Turn left, go east and then northeast. Miles to Eubank NE. The station is about 0.4 miles northeast of this point. Elevation = 5765.23	CONTRACTOR J. E. HALE	DATE 2/13/87
	Aerial Photography			CONTRACTOR J. E. HALE	DATE 2/13/87
	Tom Mann and Assoc.	8-7-86		CONTRACTOR J. E. HALE	DATE 2/13/87

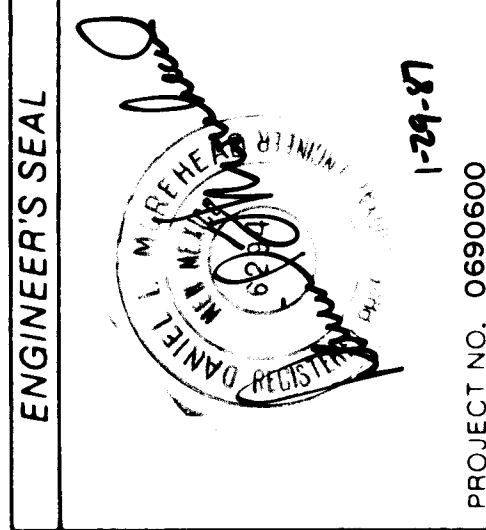

REVISIONS	DATE	BY
1	1-87	W. J. Greiner
2	1-87	W. J. Greiner
3	1-87	W. J. Greiner
4	1-87	W. J. Greiner
5	1-87	W. J. Greiner
6	1-87	W. J. Greiner
7	1-87	W. J. Greiner
8	1-87	W. J. Greiner
9	1-87	W. J. Greiner
10	1-87	W. J. Greiner
11	1-87	W. J. Greiner
12	1-87	W. J. Greiner

DESIGNED BY	W. J. Greiner	CHECKED BY	W. J. Greiner
DRAWN BY	W. J. Greiner	CHECKED BY	W. J. Greiner
DATE	2/13/87	DATE	2/13/87

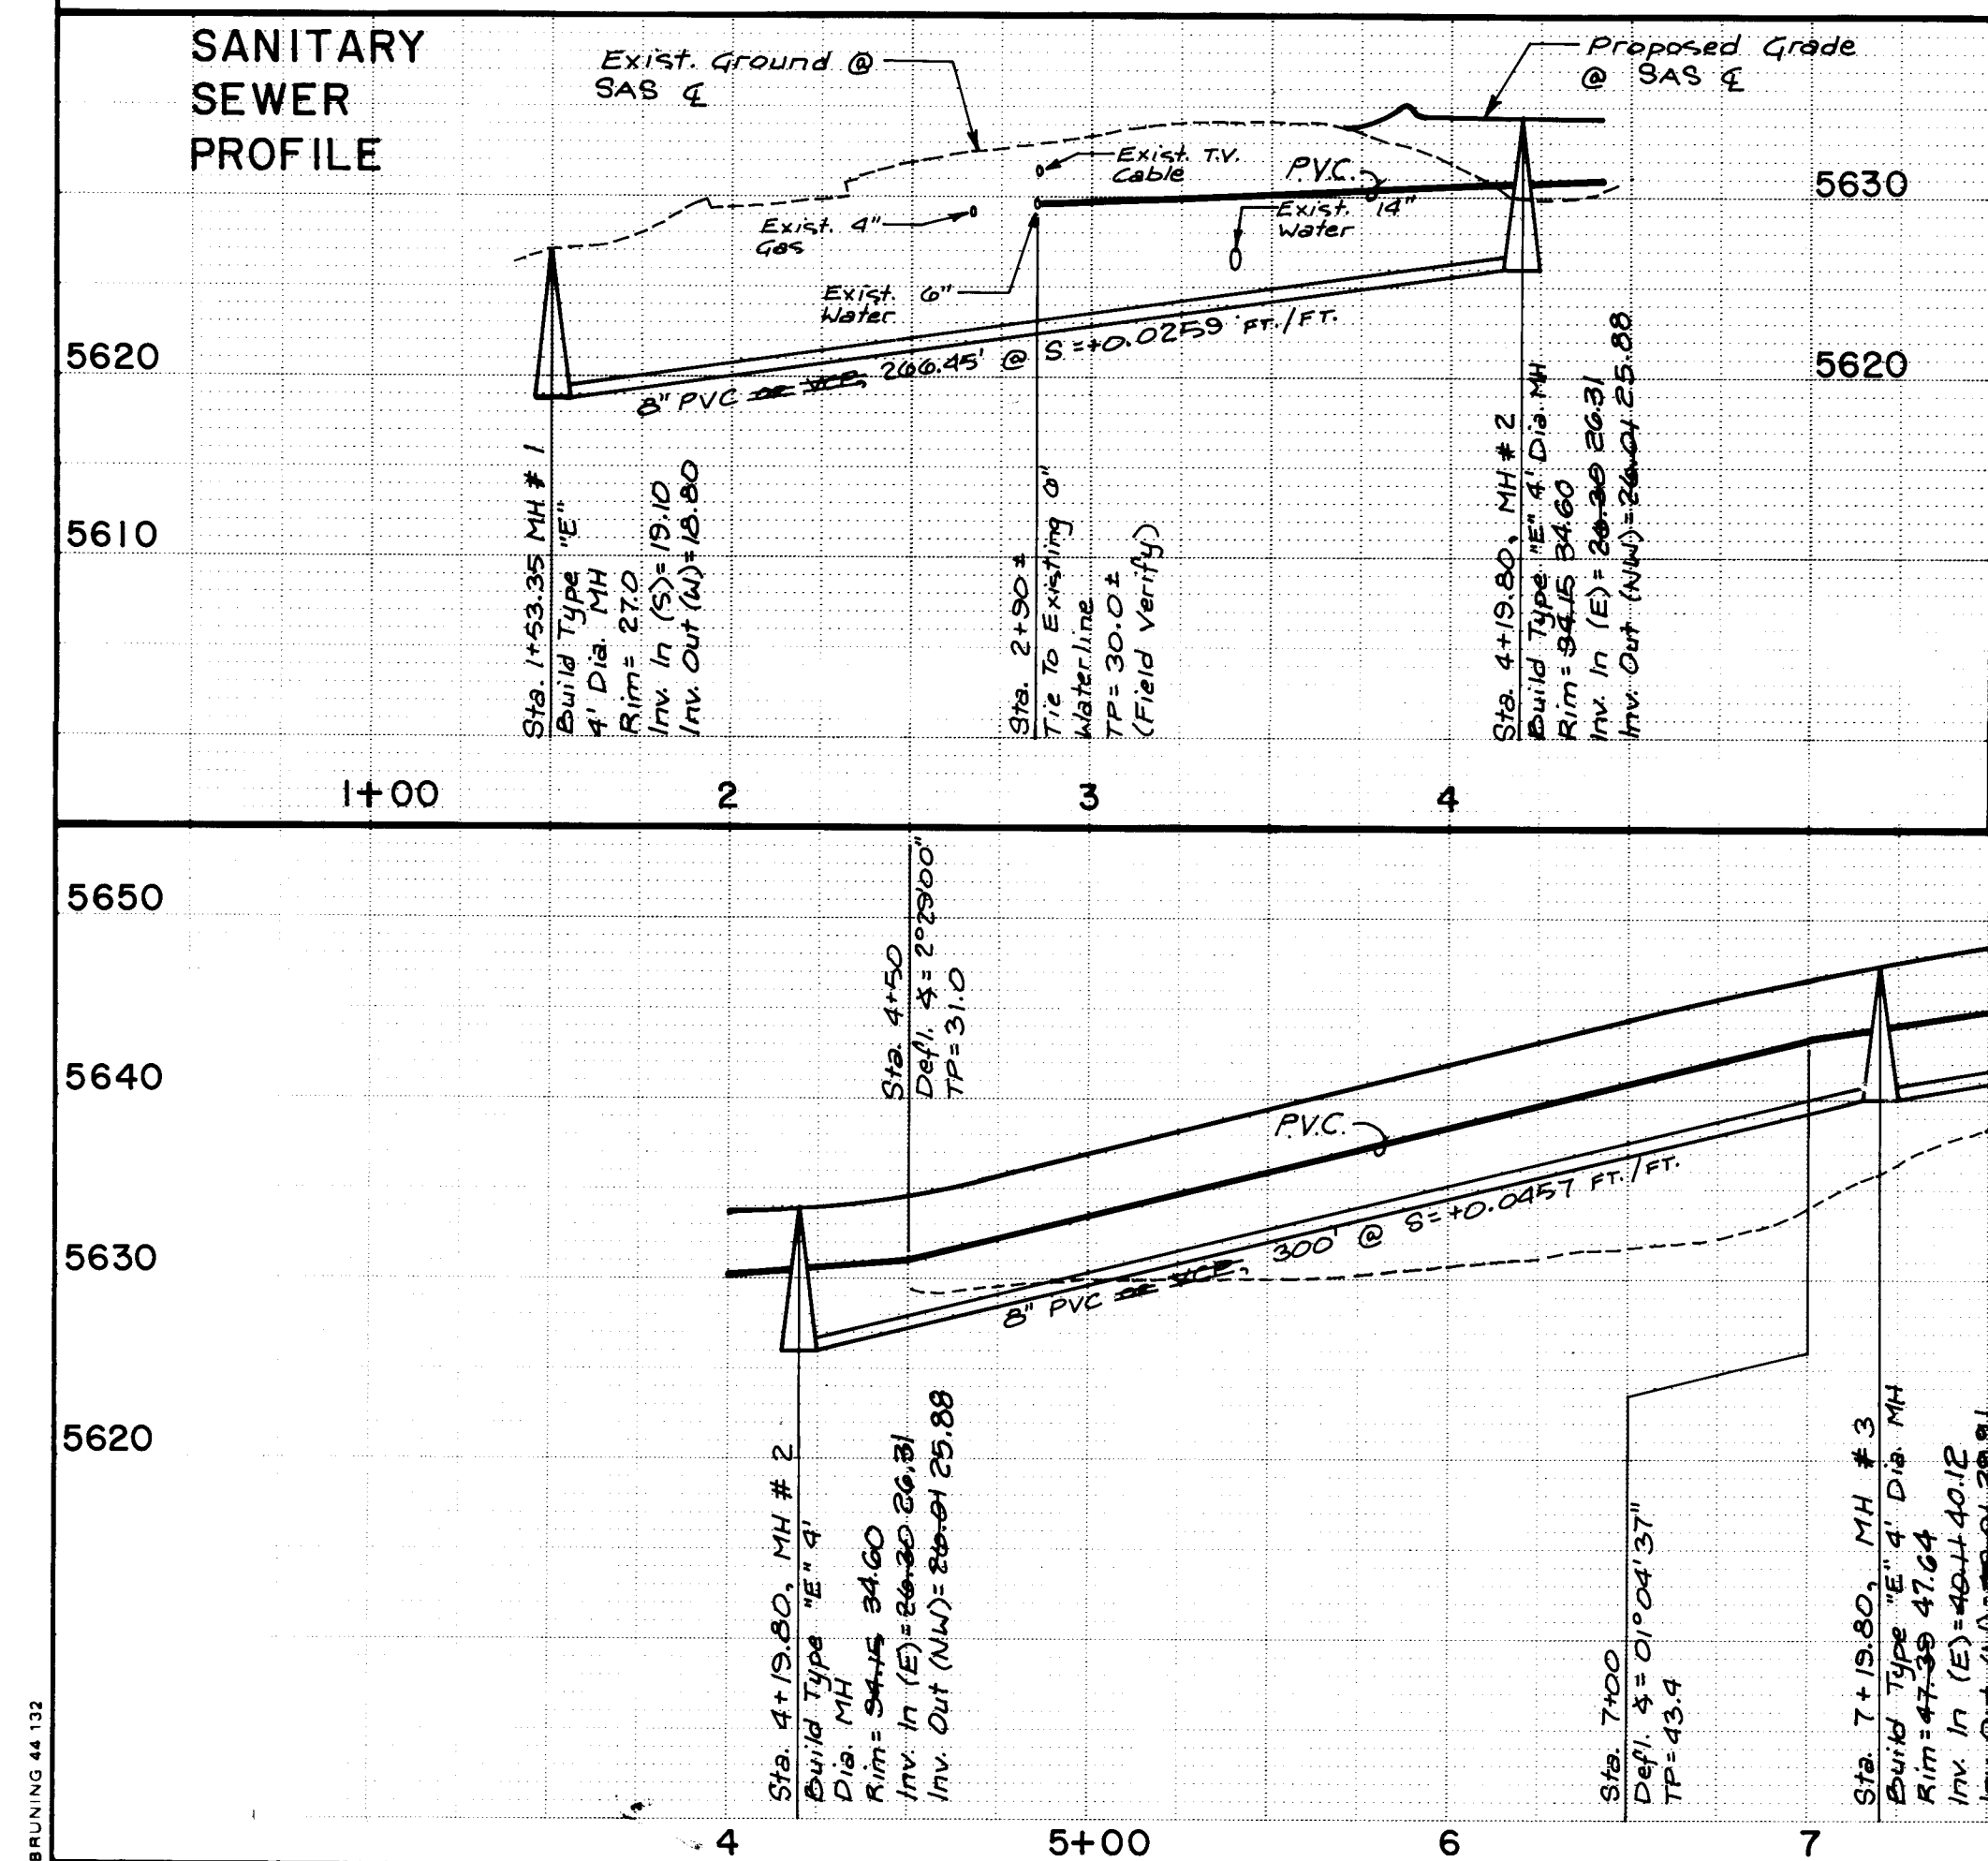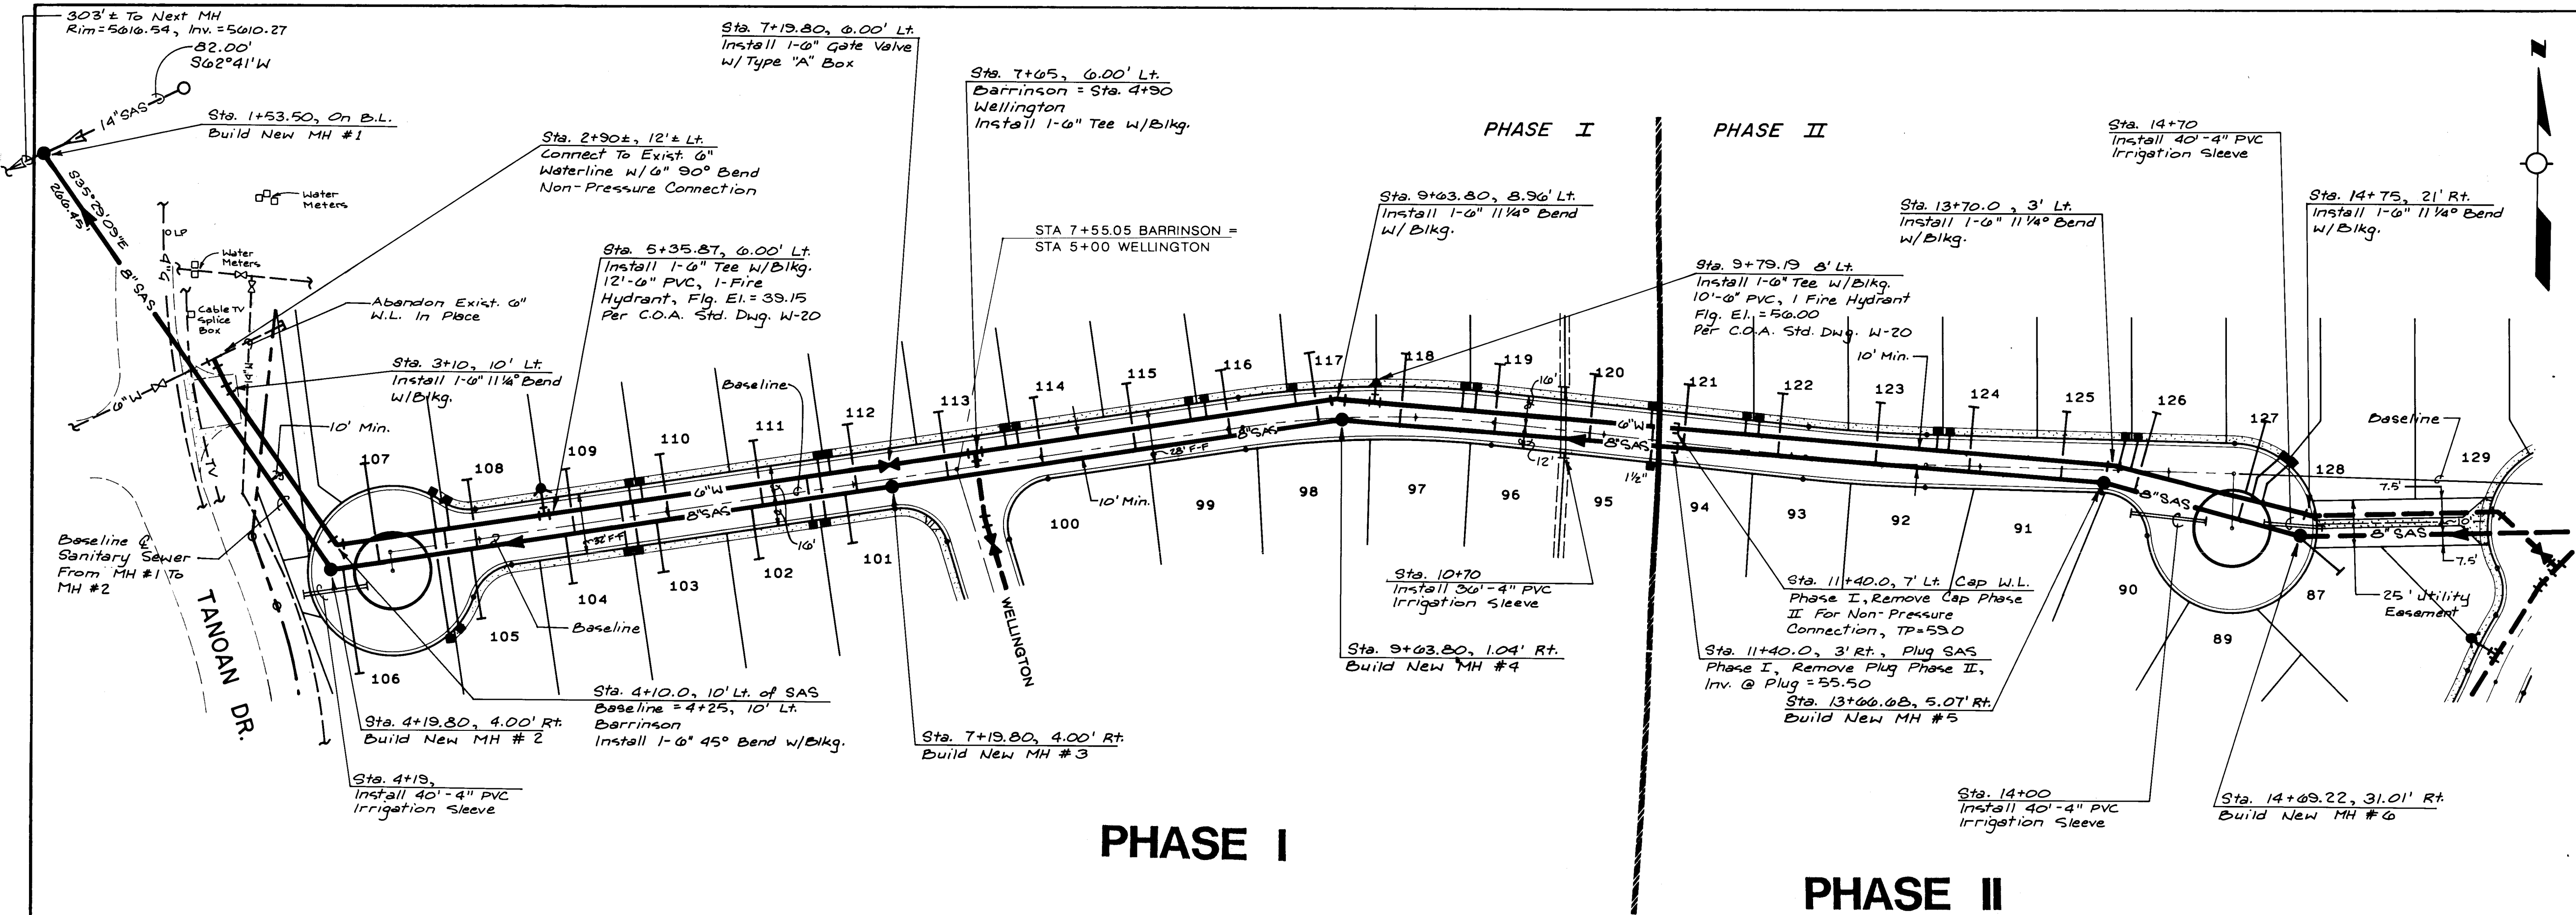

PHASE I

PHASE II

BARRINSON

SCALE:
HORIZ. 1" = 50'
VERT. 1" = 10'

SEWER SERVICES

BARRINSON 1+50 TO 14+74				
LOT NO.	STATION	INVERT #	PLUG	LENGTH
106	4+27.0	29.2		55'
107	4+45.0	30.1		55'
108	4+95.0	31.9		35'
109	5+50.9	34.5		35'
110	6+00.9	36.8		35'
111	6+50.9	38.6		35'
112	7+00.9	40.9		35'
113	7+50.9	43.4		35'
114	8+00.9	44.9		35'
115	8+50.9	46.4		35'
116	9+00.9	48.0		35'
117	9+48.2	49.5		36'
118	9+94.2	51.4		38'
119	10+42.6	53.5		38'
120	10+92.5	55.5		38'
121	11+42.8	57.7		33'
122	11+95.0	60.0		32'
123	12+47.0	62.2		32'
124	12+97.0	64.4		34'
125	13+44.8	66.5		35'
126	13+82.0	68.0		43'
127	14+40.0	69.3		54'
87	14+74.2	69.5		25'

Greiner Engineering

2601 Wyoming NE
Albuquerque, New Mexico 87112
(505) 292-1936


CITY OF ALBUQUERQUE
PUBLIC WORKS DEPARTMENT
ENGINEERING DIVISION

TITLE: THE CHAMPIONS AT TANOAN

BARRINSON
PUBLIC UTILITY PLAN & PROFILE

APPROVALS	ENGINEER	DATE	APPROVALS	ENGINEER	DATE
CITY Engineer	John	2/13/87	Liquid Waste	John	2-13-87
A.C.E. - Design			Traffic	John	2-13-87
A.C.E. - Hydrology	NA	2-20-87	Water	John	2-13-87

DRAWING NO.	MAP NO.	SHEET	OF
3096	E-21	21	28

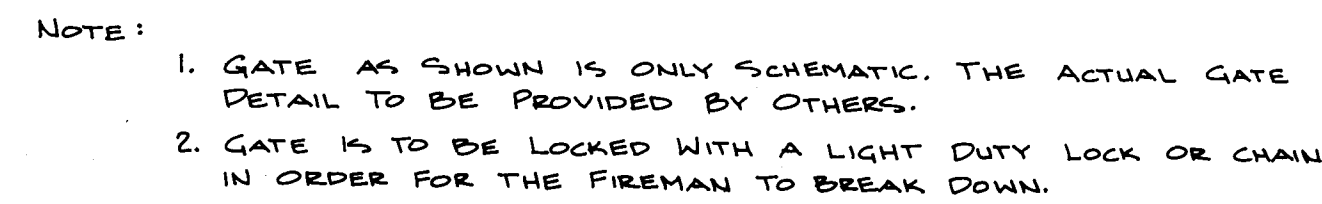

LOT 26

LOT 27

BRIDGEPOINT

STA. 18+15.63

STD. C & G

1/2" EXPANSION JOINT

LOW PT. E 79.85

E 79.93

16'

E 79.86

2'-8" SWINGING WROUGHT IRON GATES (SEE DETAIL)

PROVIDE 2'-0" CURB-CUT FOR DRAINAGE FROM LOT 27

6' SLUMP PERIMETER WALL

INSTALL HEADER CURB PER C.O.A. STD. P-8

BOUNDARY LINE

E 79.59

E 79.99

E 79.75

E 79.11

E 79.10

E 79.00




E 80.00

TIC 81.35

EXIST. 6' SIDEWALK WITH 1" BRICK PATTERN BOMANITE

EXIST. 30' DRIVEWAY






TIC 79.20

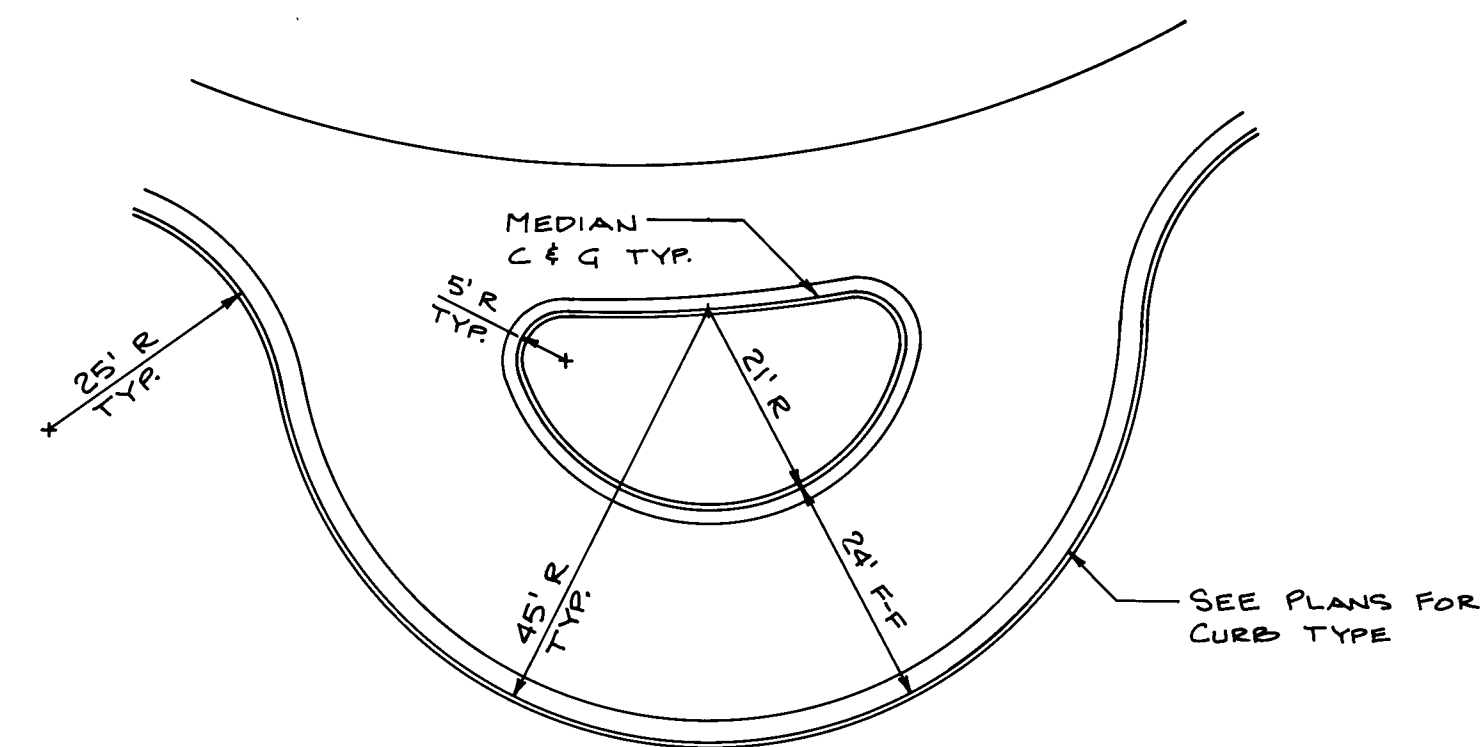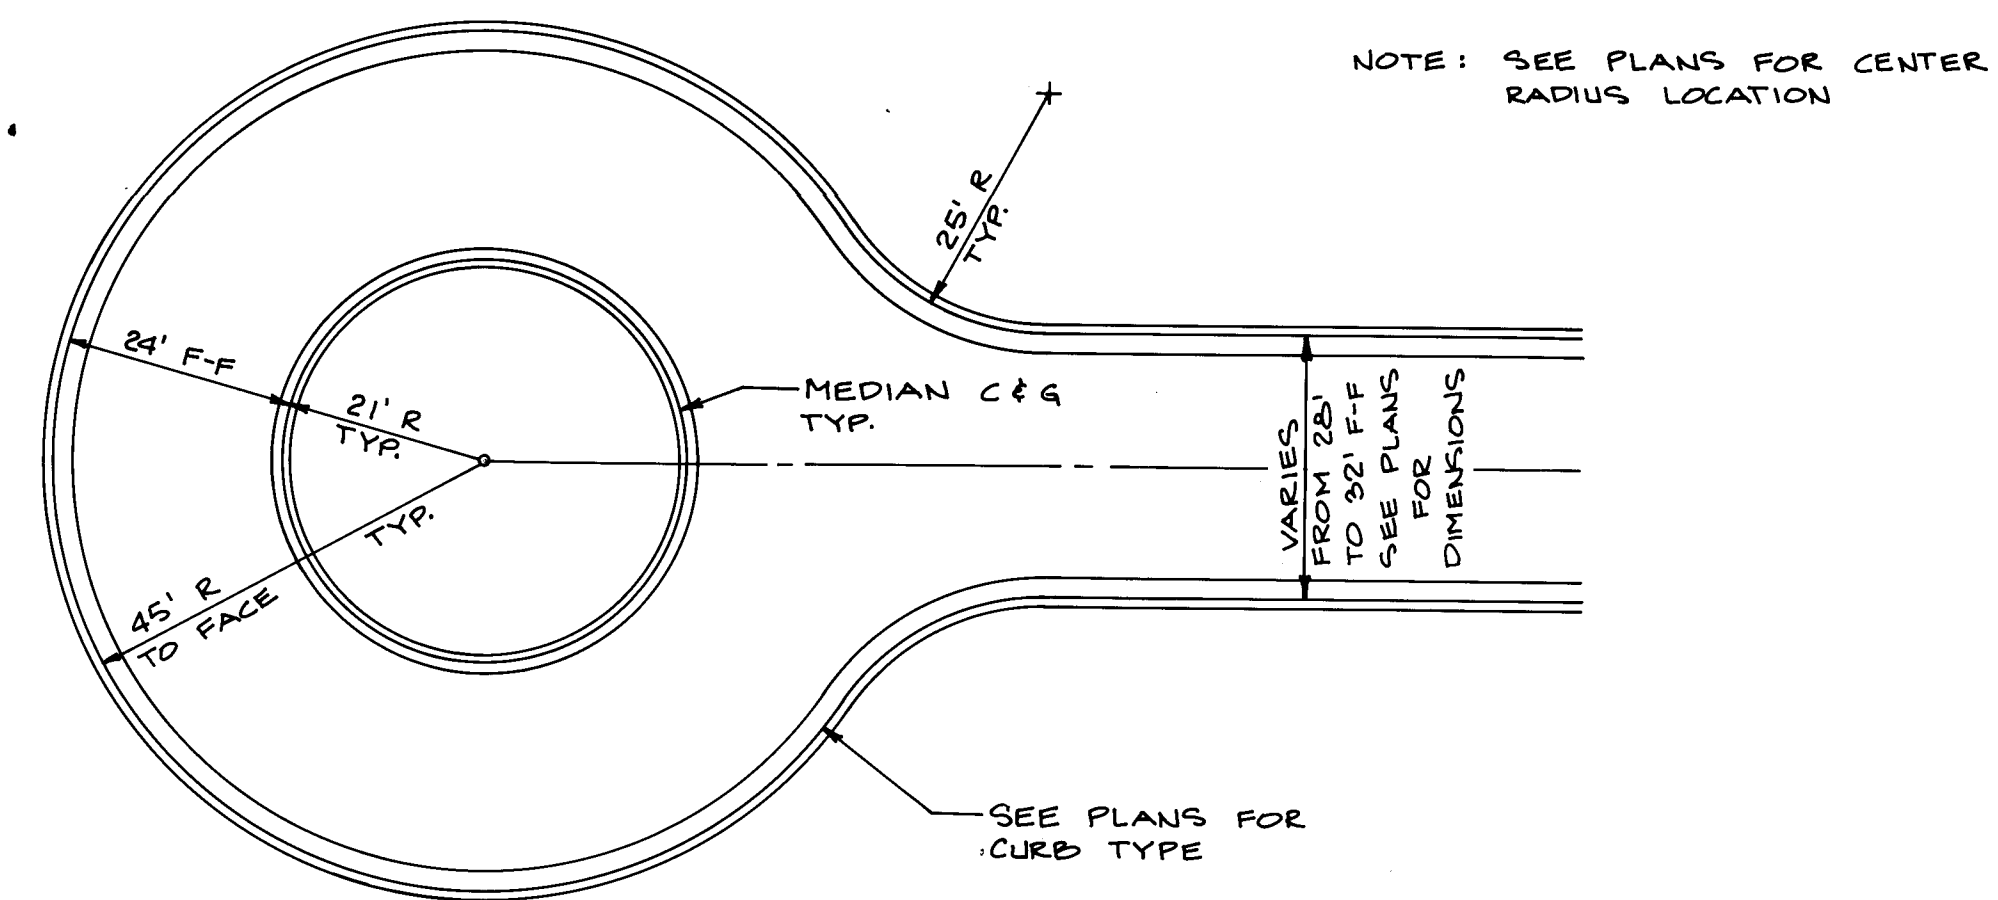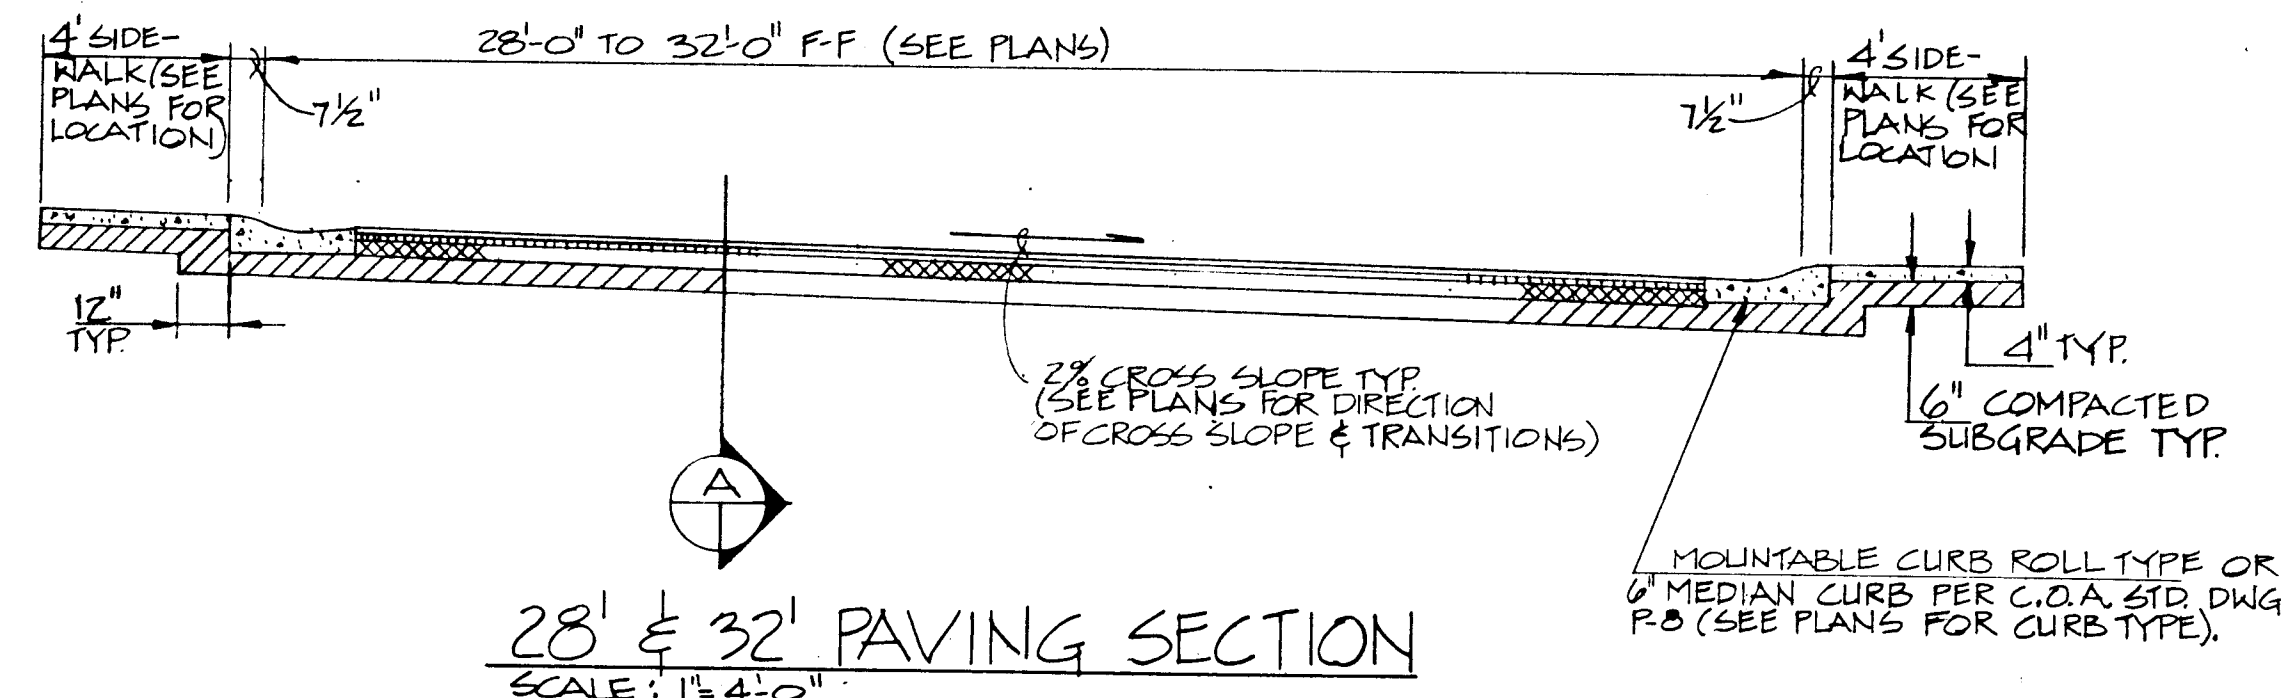


DRAWING NO.	3096	MAP NO.	E-21	SHEET	24	OF	28
-------------	------	---------	------	-------	----	----	----

[illegible]

BRUNING 44-132

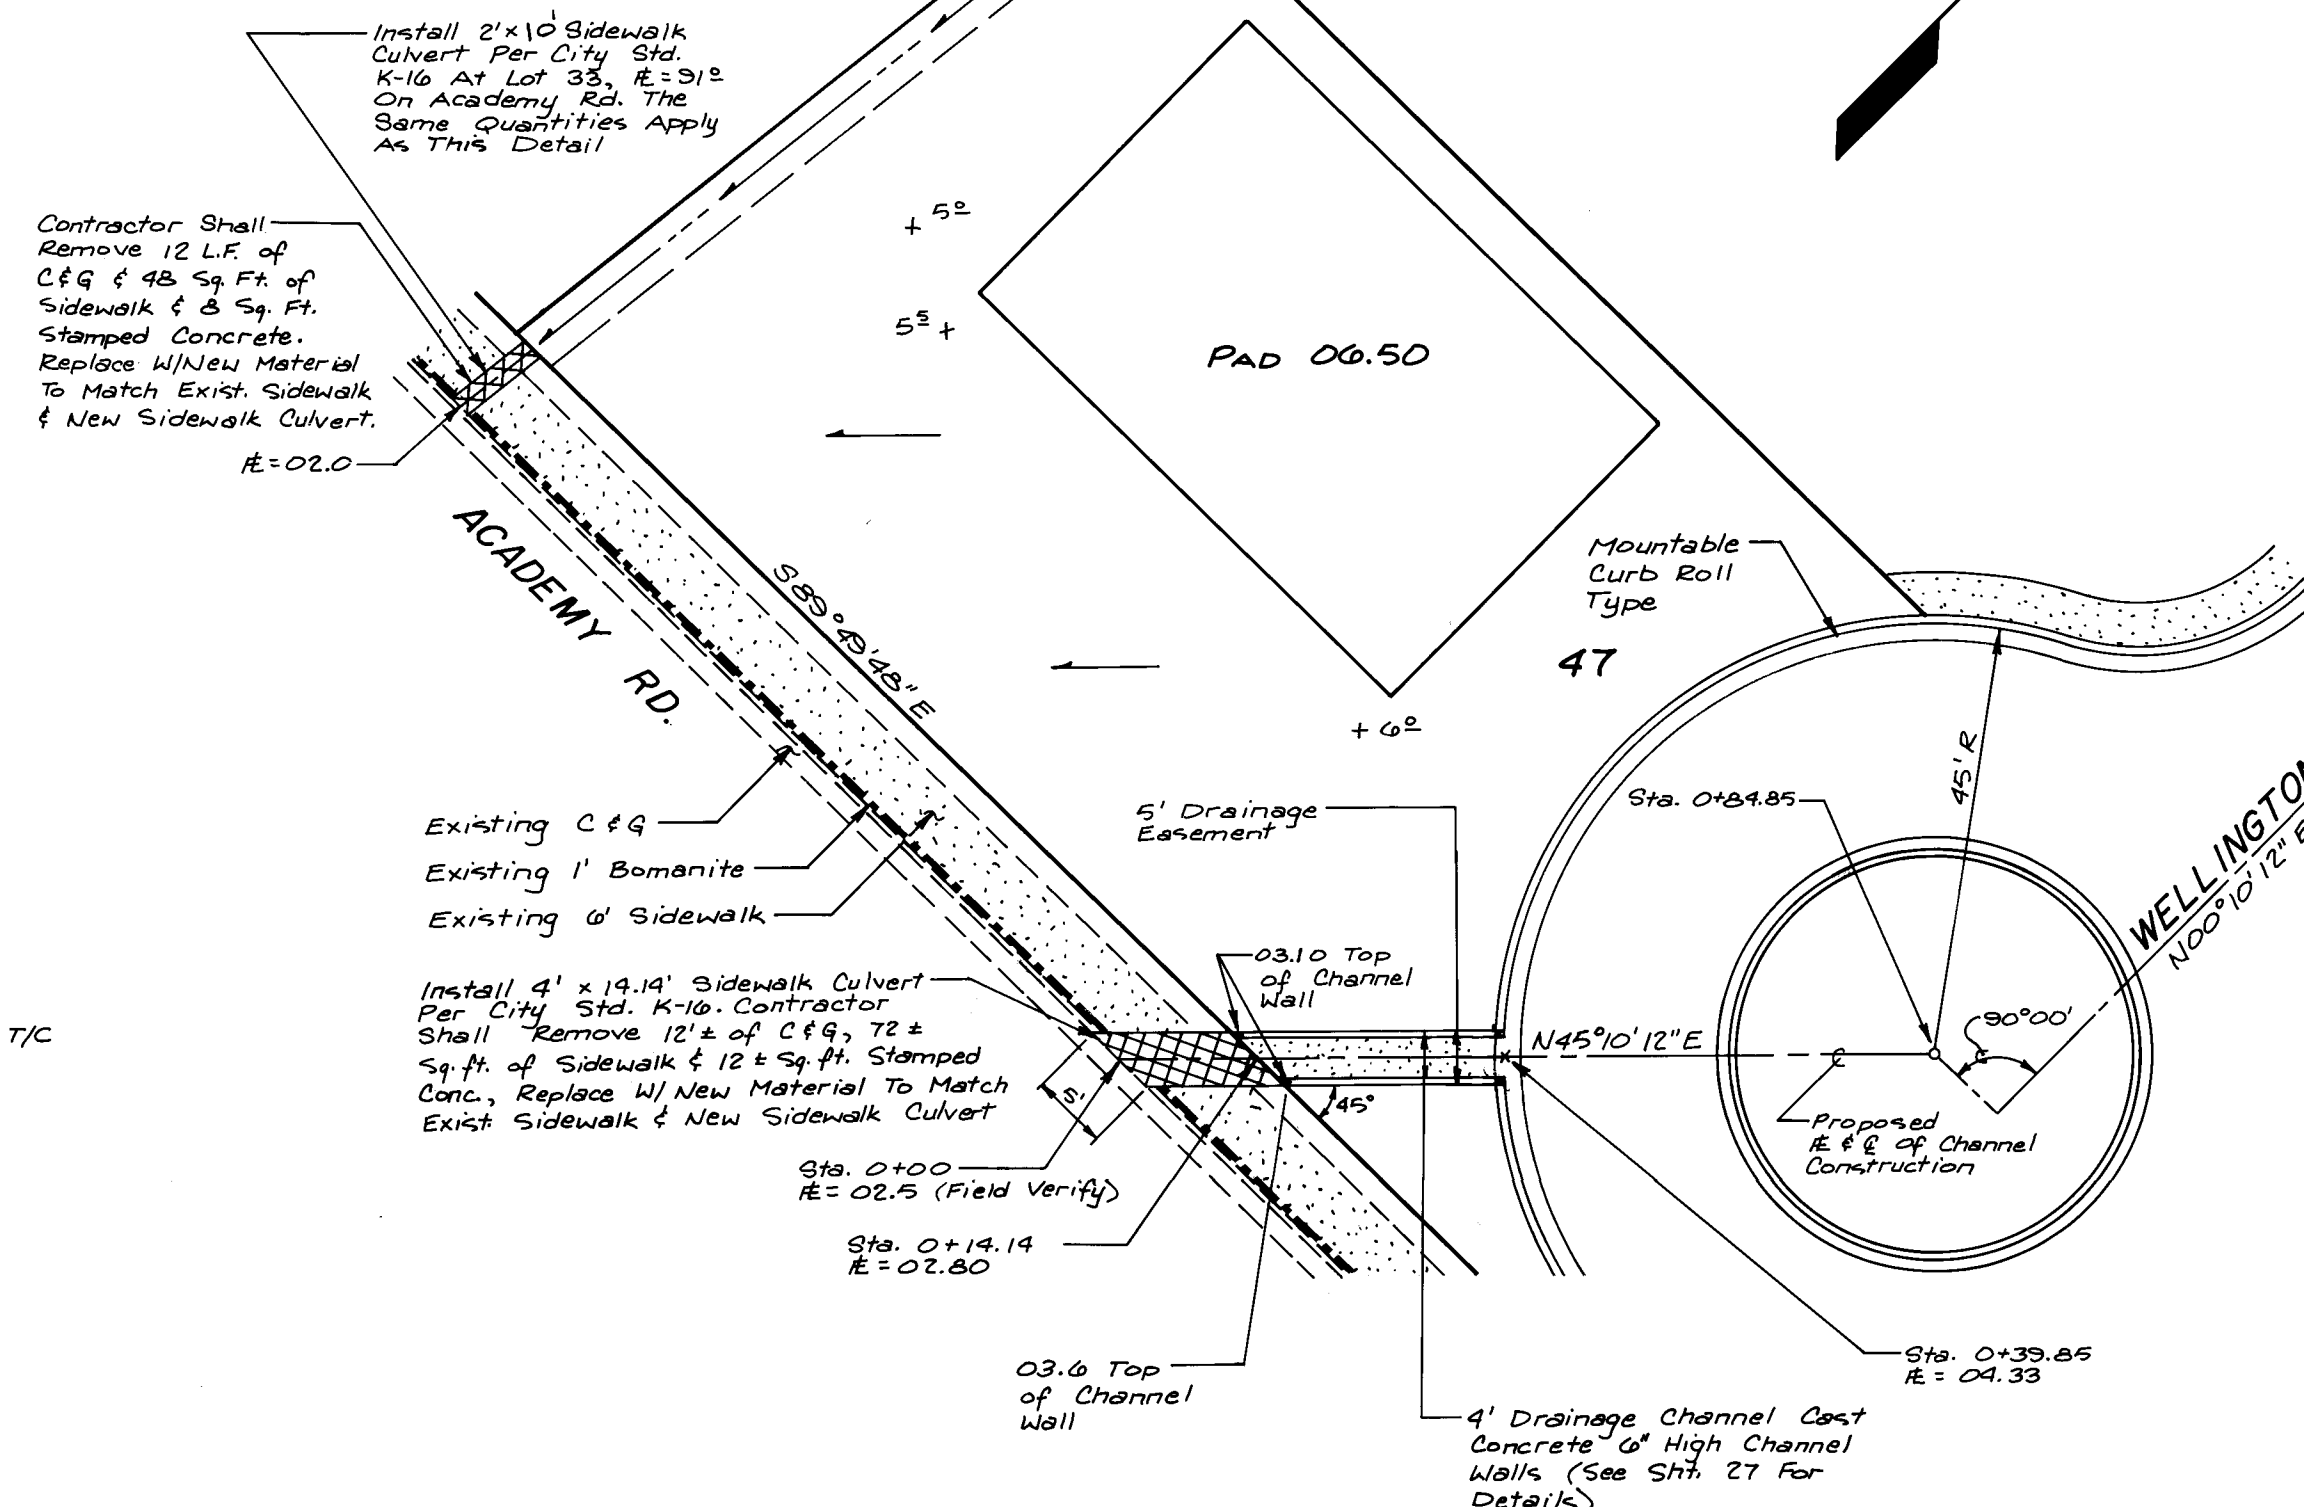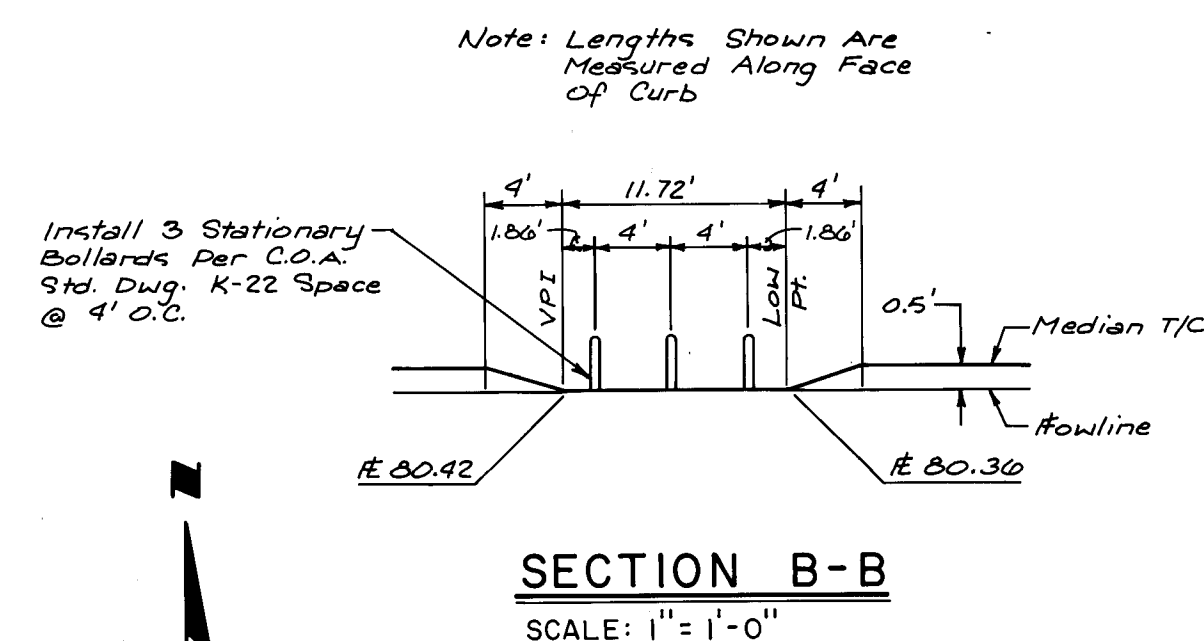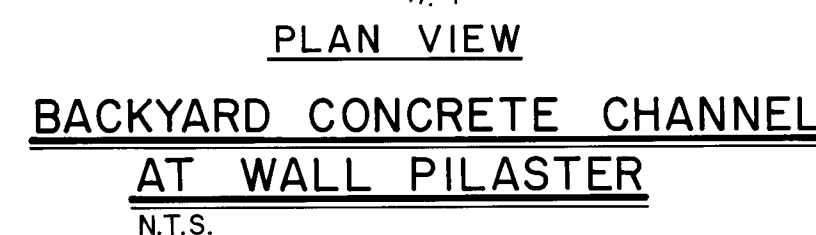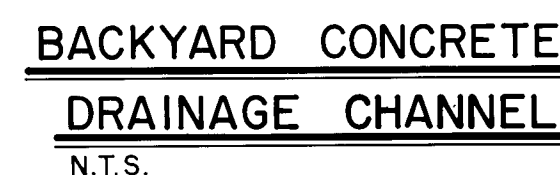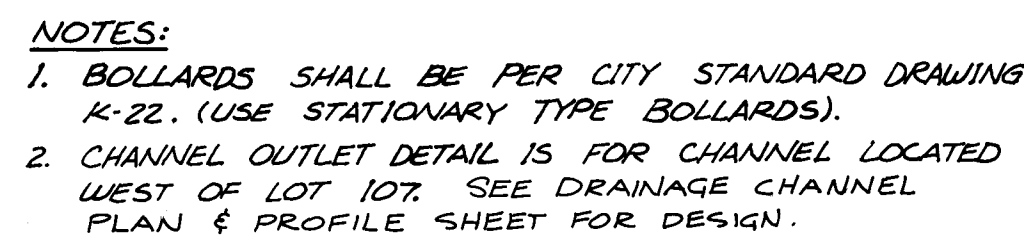


DRAWING NO.	3096	MAP NO.	E-21	SHEET	25	OF	28
-------------	------	---------	------	-------	----	----	----

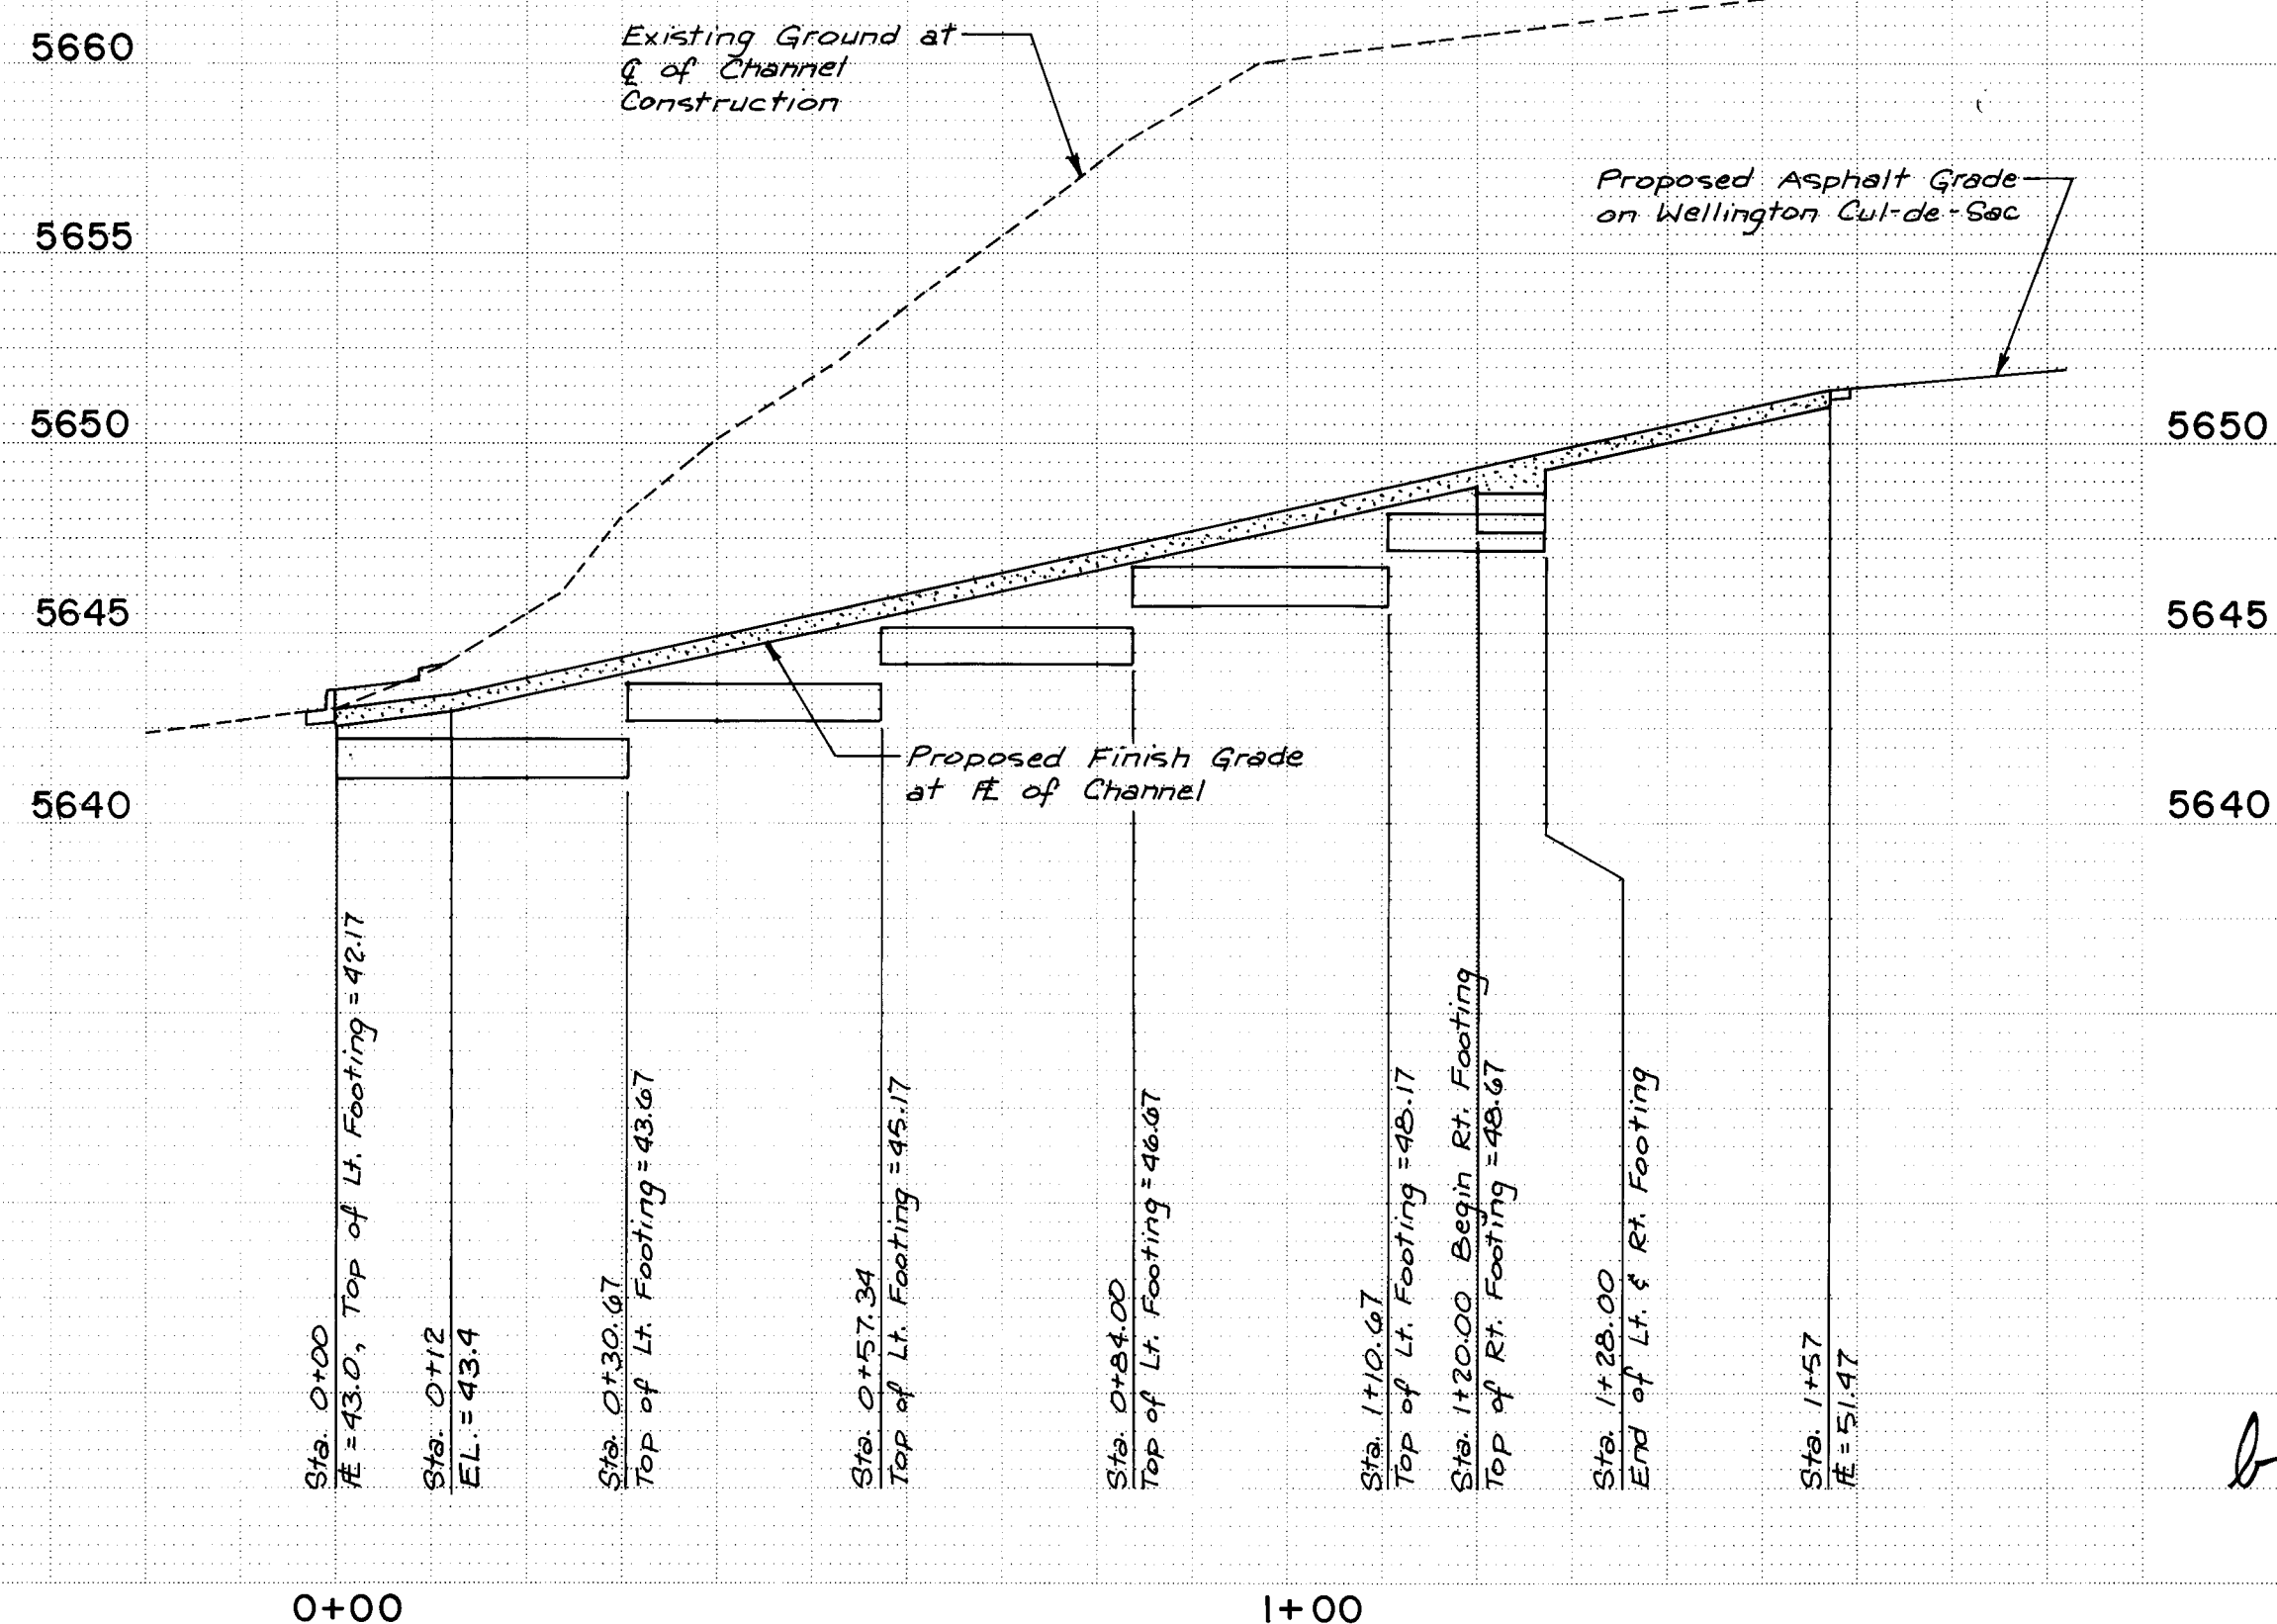


DRAWING NO.	3096	MAP NO.	E-2
-------------	------	---------	-----

ENGINEER'S SEAL					
		SURVEY INFORMATION		BENCH MARKS	
		FIELD NOTES		A standard ACS brass tablet stamped "J-821-A" set in a concrete post 0.3 ft. above the ground. To reach the station from the intersection of I-25 and San Mateo NE, go south on San Mateo 0.2 miles to Academy Rd., turn left, go east and then northeast. Miles to Eubank NE.	
				The station is about 0.4 miles northeast of this point. Elevation = 5765.23	
				RECORDED BY NO	
				DATE	
DESIGNED BY	RN	DATE	1-29-87		
DRAWN BY	J. Used	DATE	1-87		
CHECKED BY	RA	DATE	1-87		
PROJECT NO. 0690600					
TANOAN					
MAN & PROFILE					
OVERALLS		ENGINEER		DATE	
Waste		M/W		2-13-87	
		M/W		2-13-87	
SHEET OF					
26 28					


BRUNING 44-132

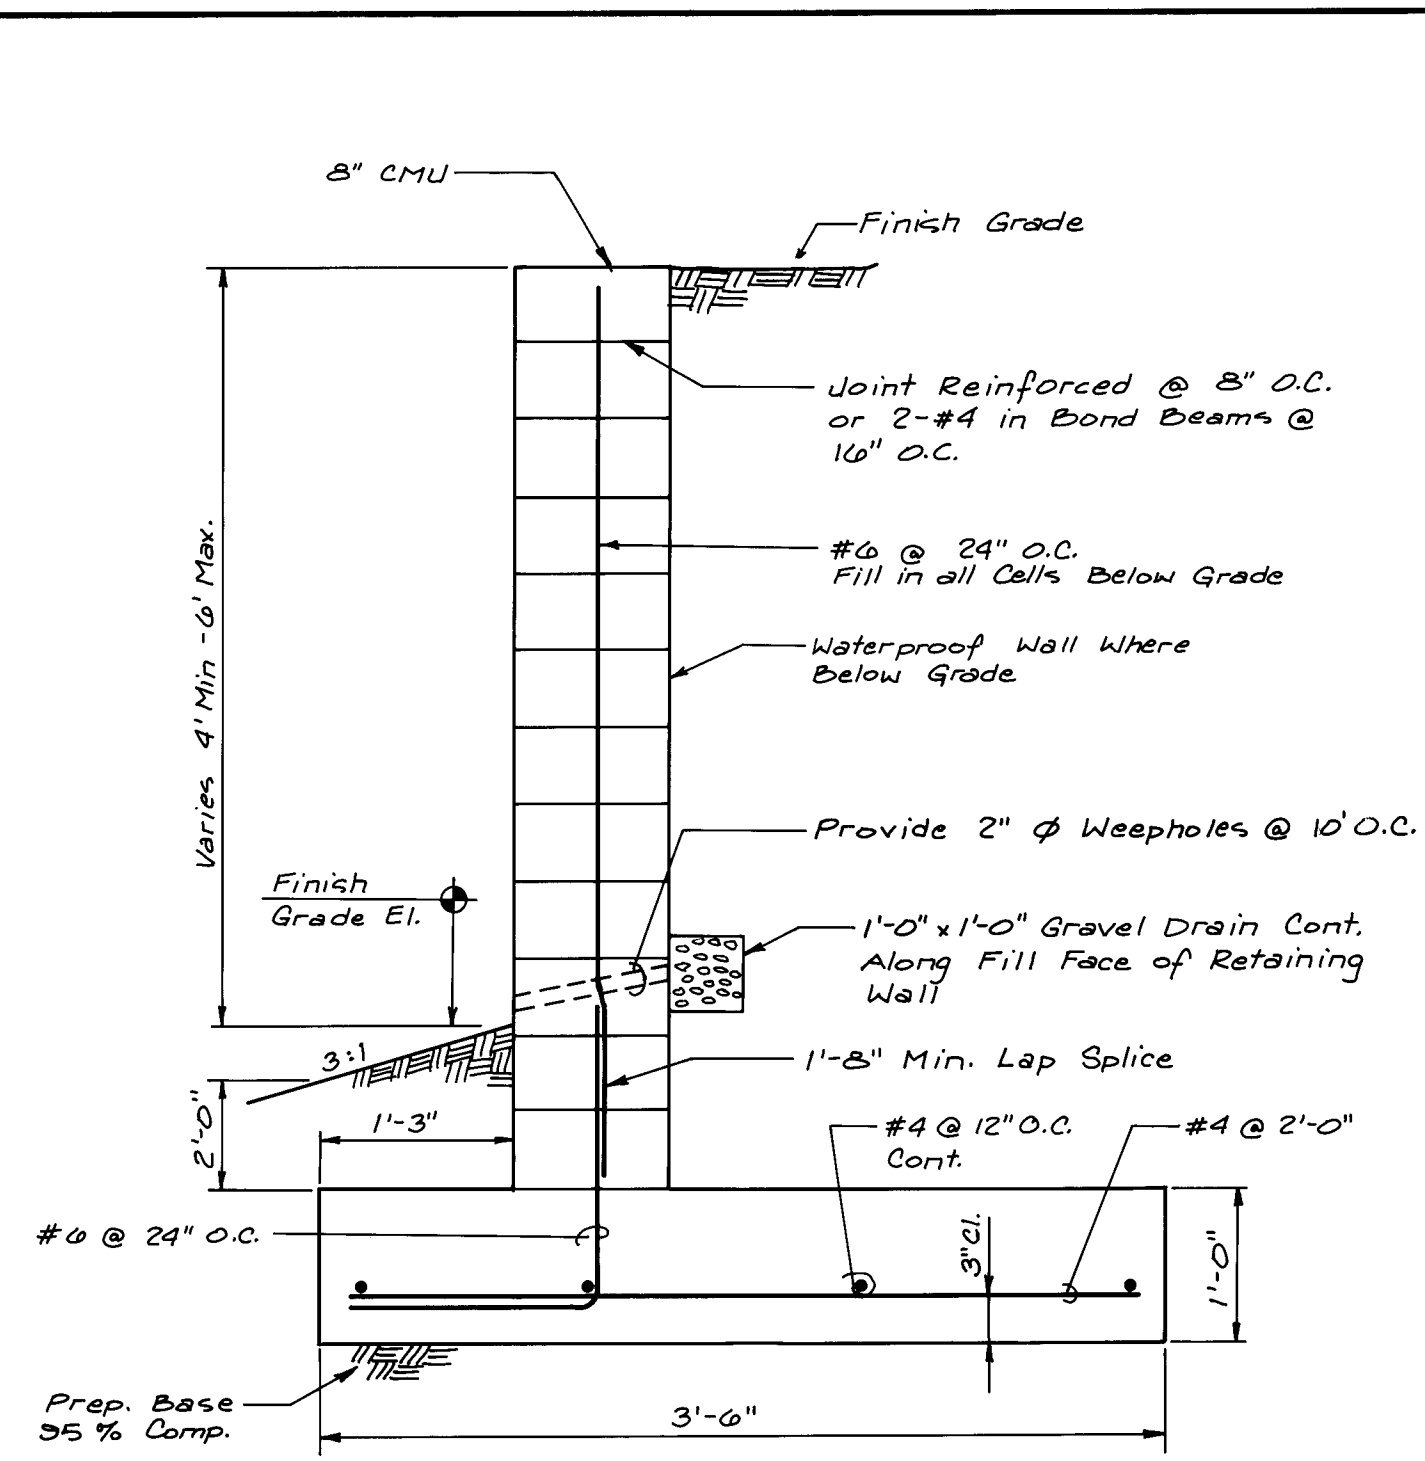

CMU RETAINING WALL (4'-6' MAX. HT.)
N.T.S.

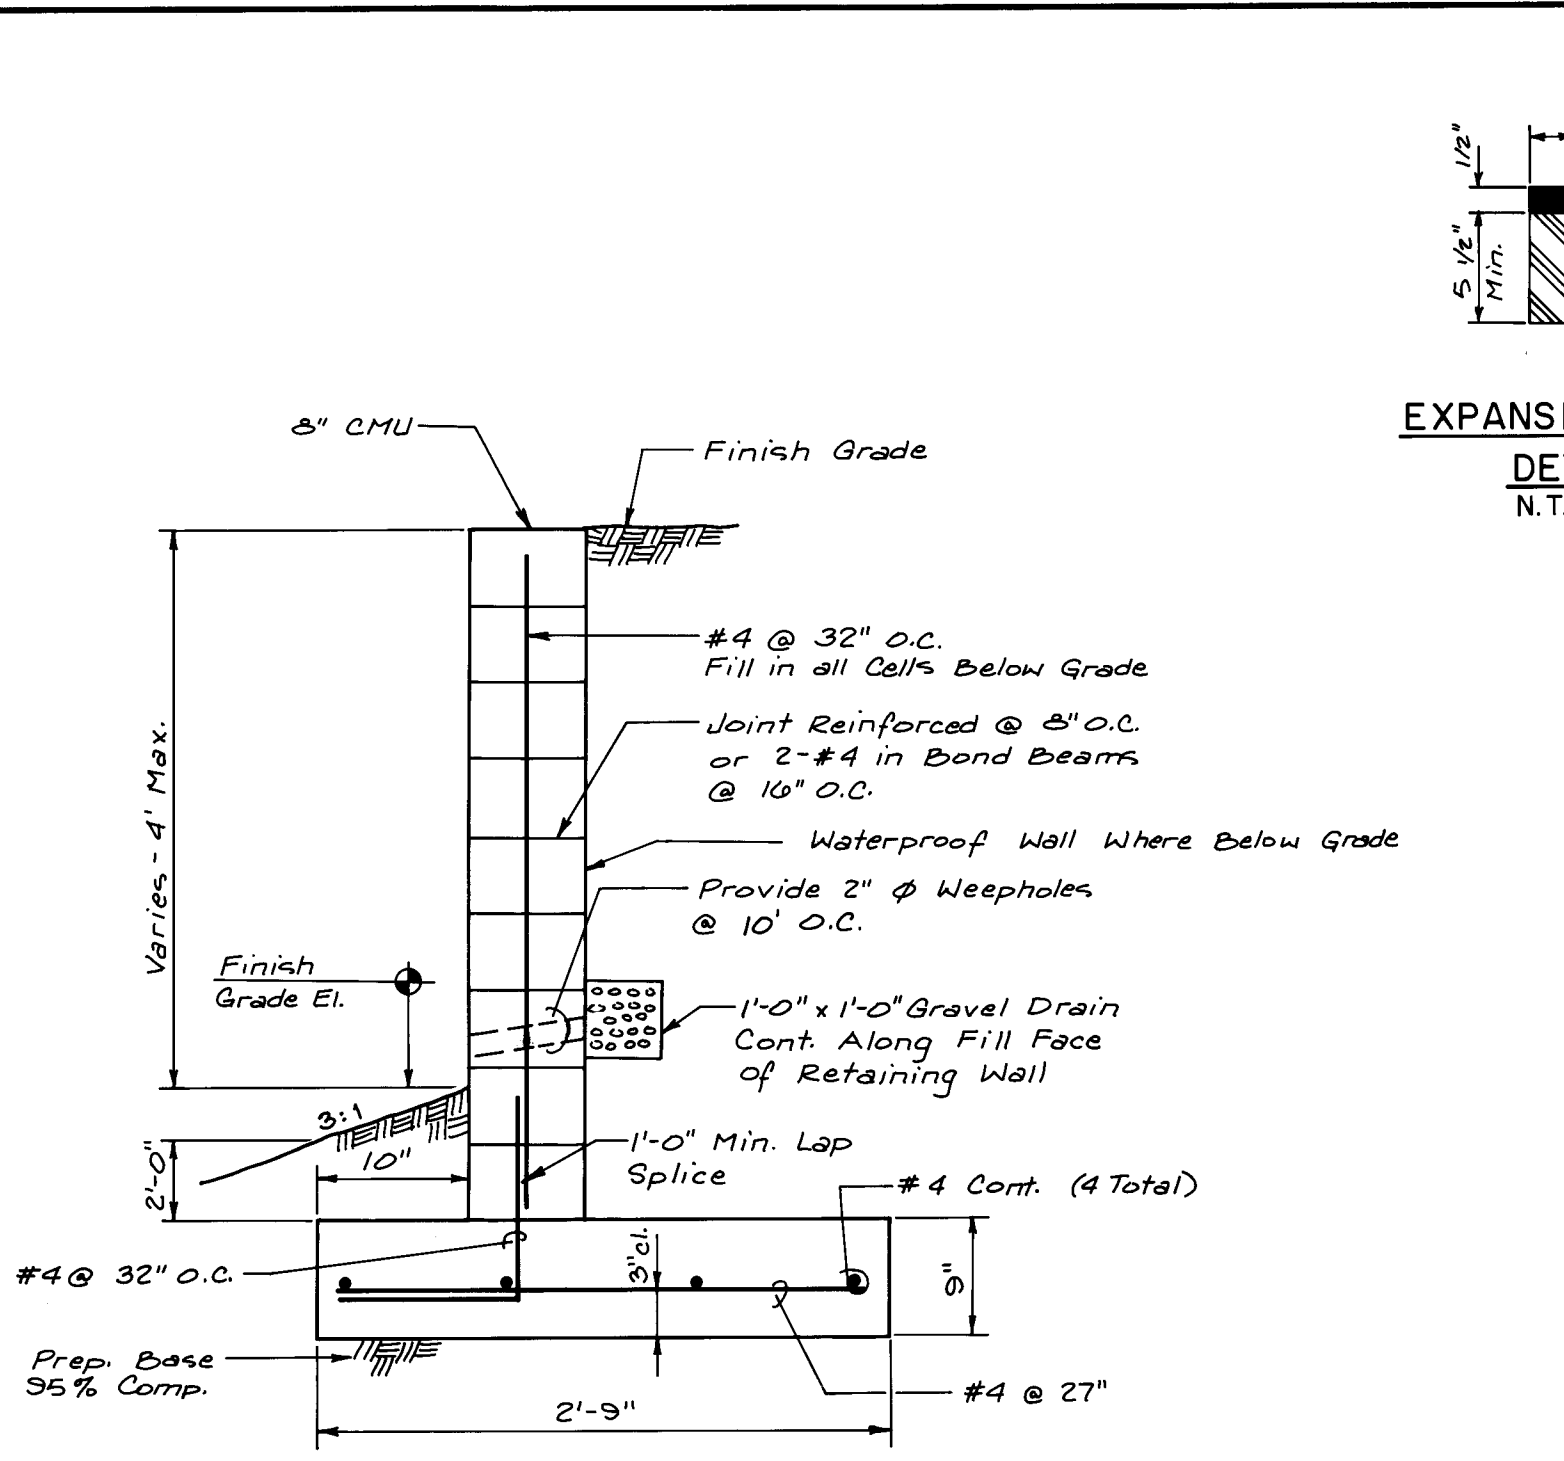


CMU RETAINING WALL (4' MAX. HT.)
N.T.S.

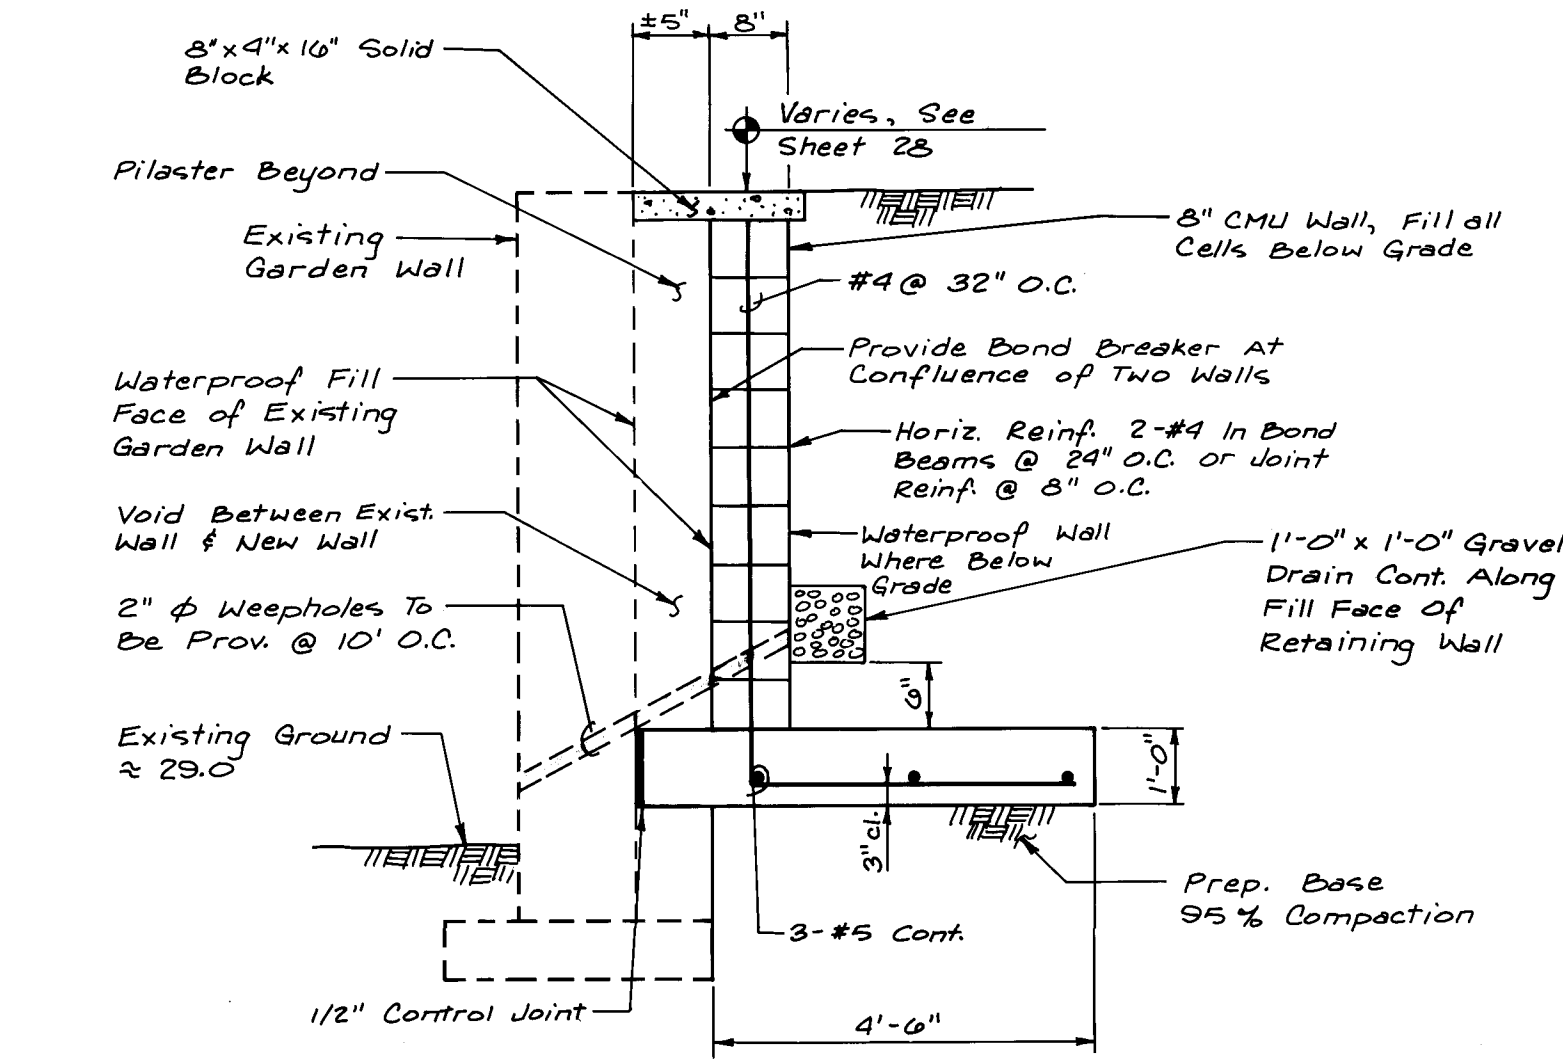


NOTE: Retaining Wall is Intended to Operate Independently of the Existing Garden Wall After Backfill is Completed. Contractor is Responsible For Any Bracing of Garden Wall Required During Construction. Backfill At Wall To Be Compacted Using Hand Operated Mechanical Tampers With Max. 12" Lifts.

TYPE I RETAINING WALL
AT EXISTING GARDEN WALL
N.T.S.


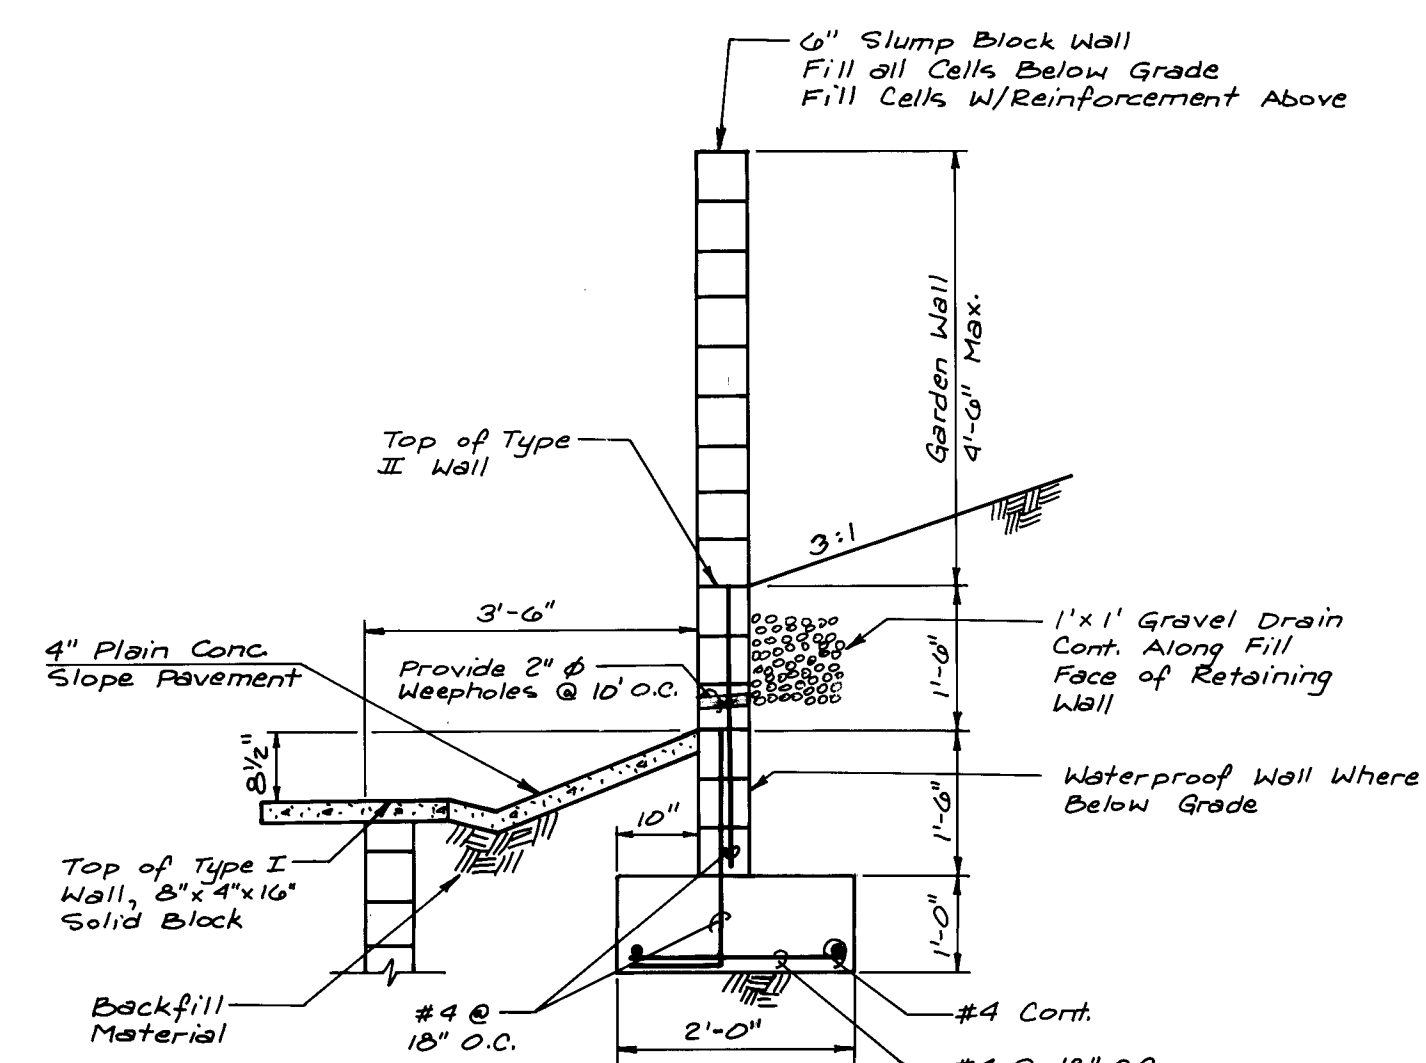


TYPE II RETAINING WALL
SCALE: 1/2" = 1'-0"

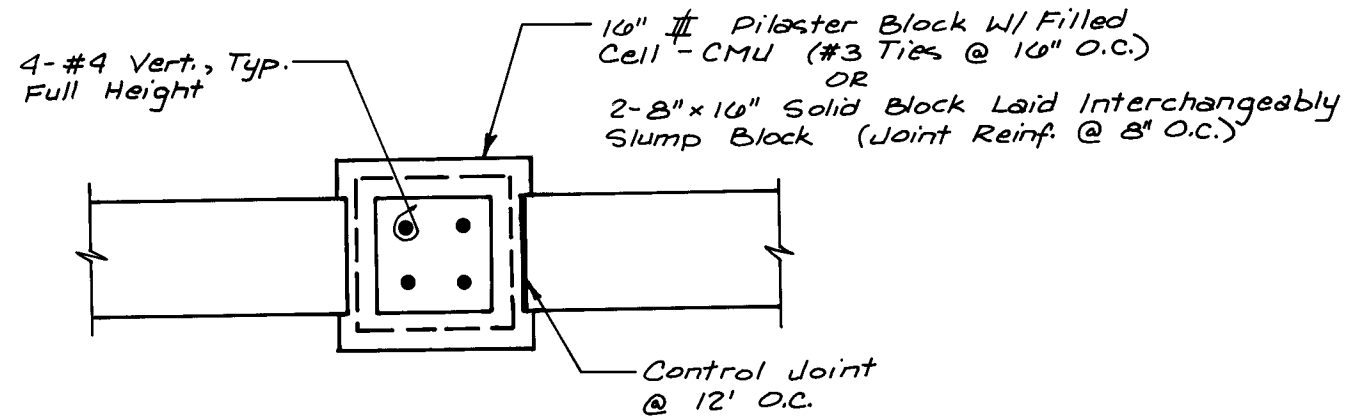


All Walls Are To Have Pilasters Placed @ 12' O.C. Max. These Are Intended To Match Appearance of Other Walls Within Tanoan Communities And To Provide Control Joints.


PILASTER DETAIL
N.T.S.

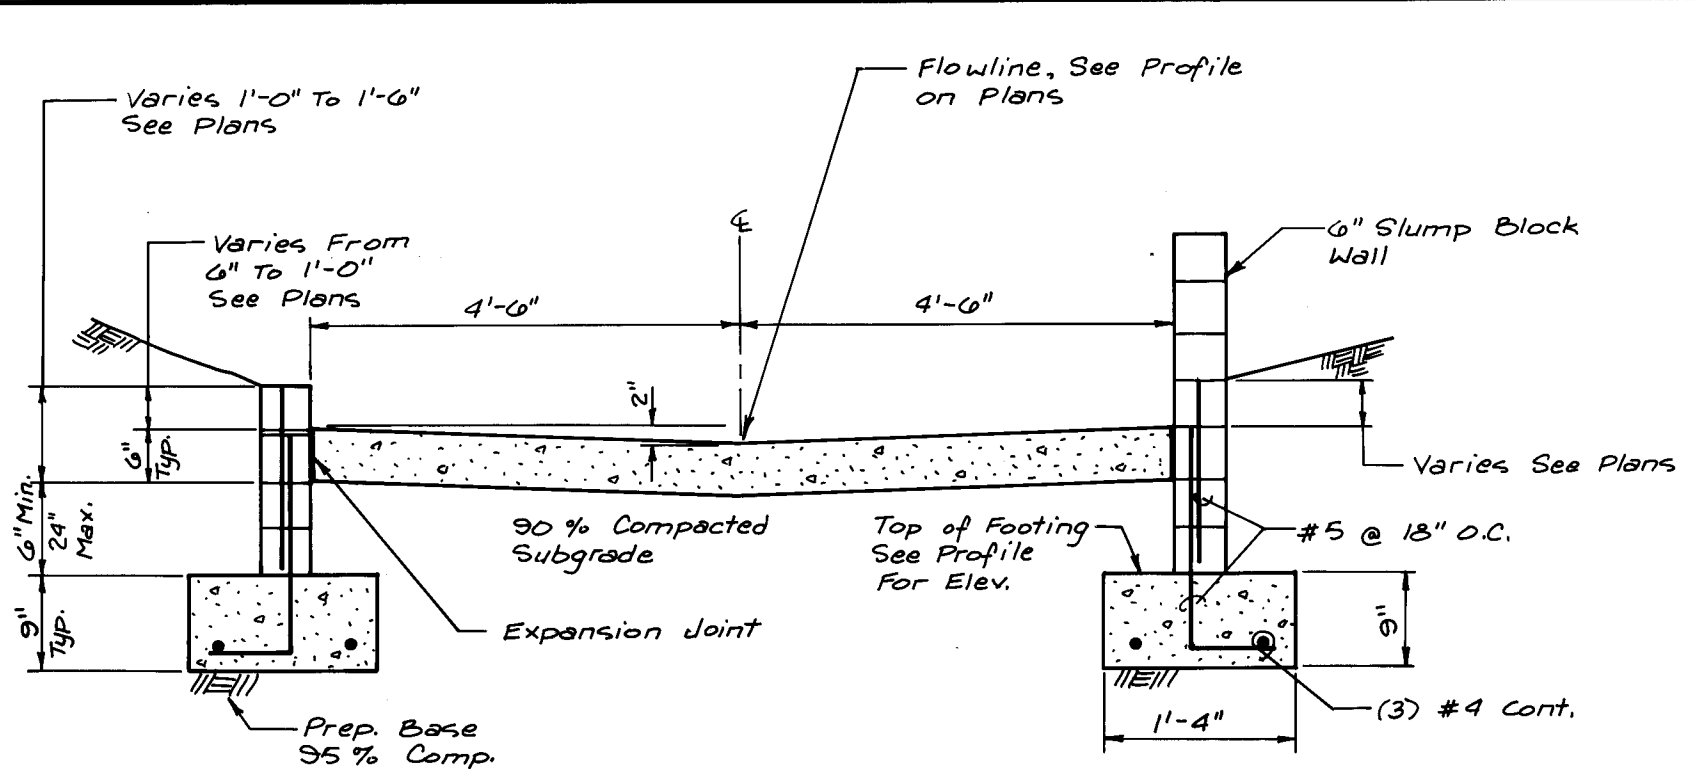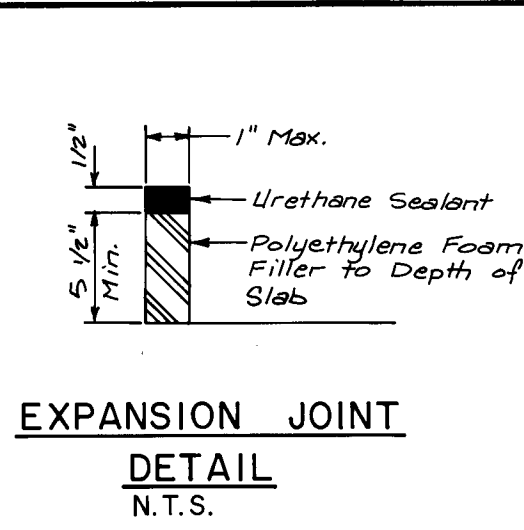


9' DRAINAGE CHANNEL WITH WALL
SCALE: 1/2" = 1'-0"

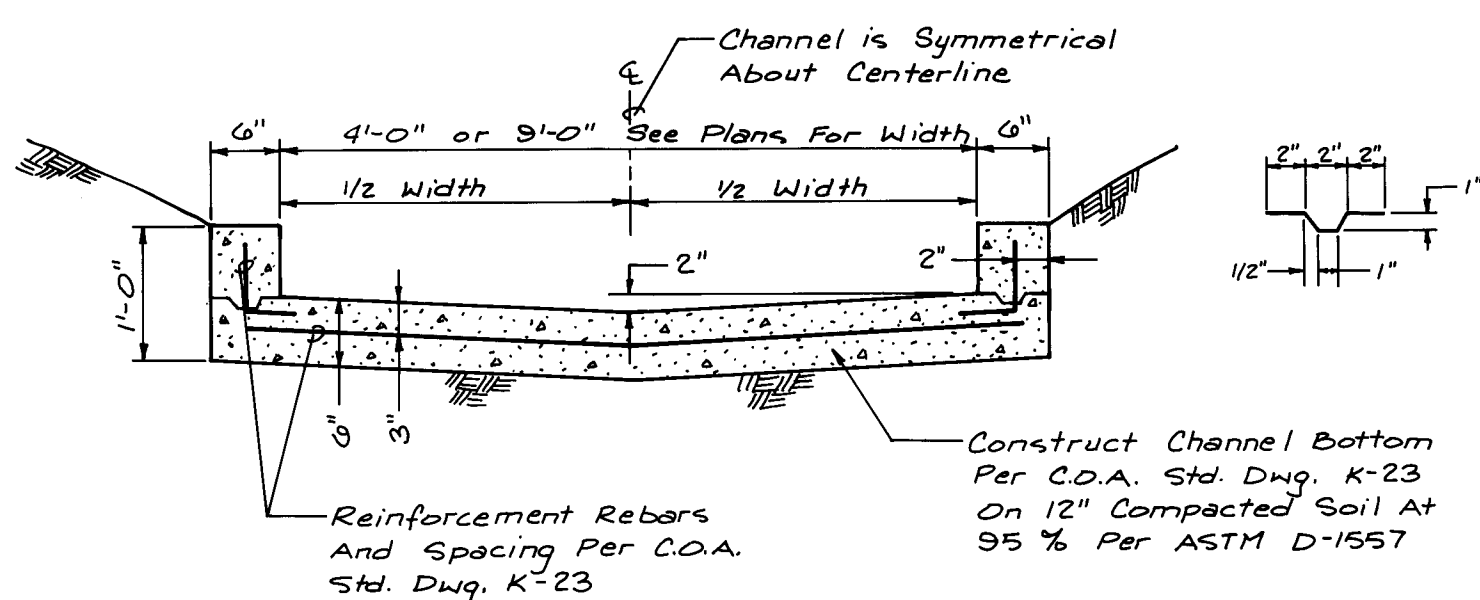

DRAINAGE CHANNEL CAST CONCRETE
N.T.S.

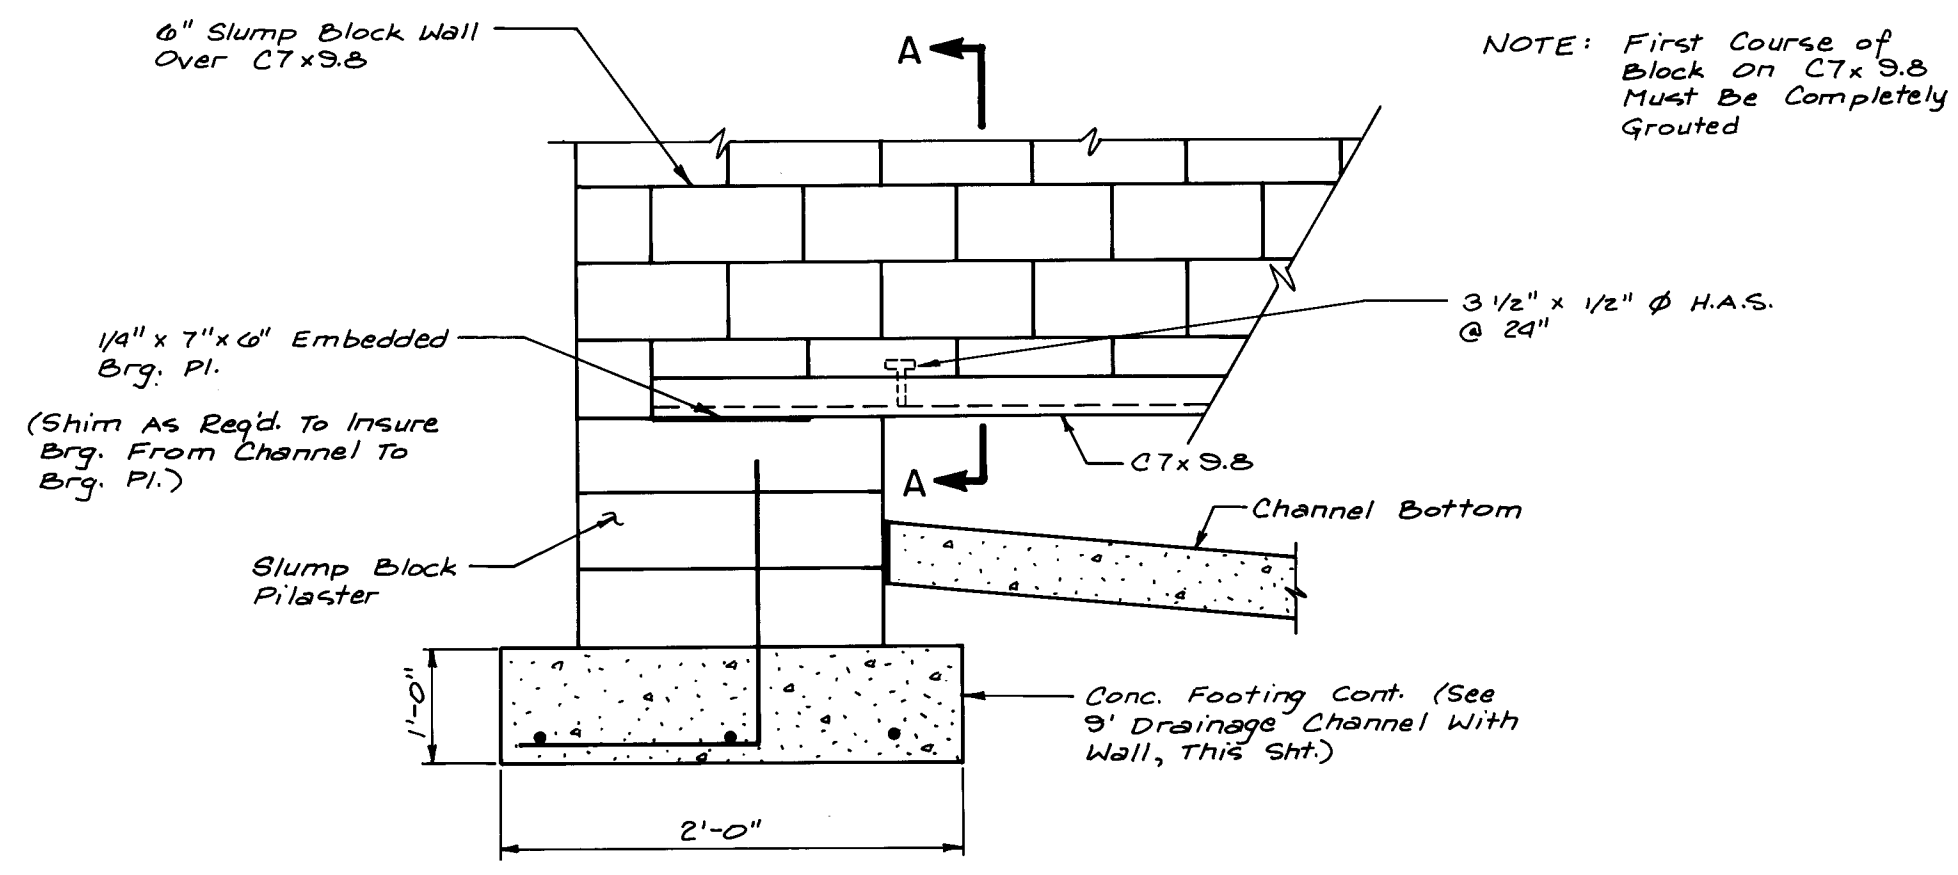

PILASTER & GARDEN WALL OVER CHANNEL
N.T.S.

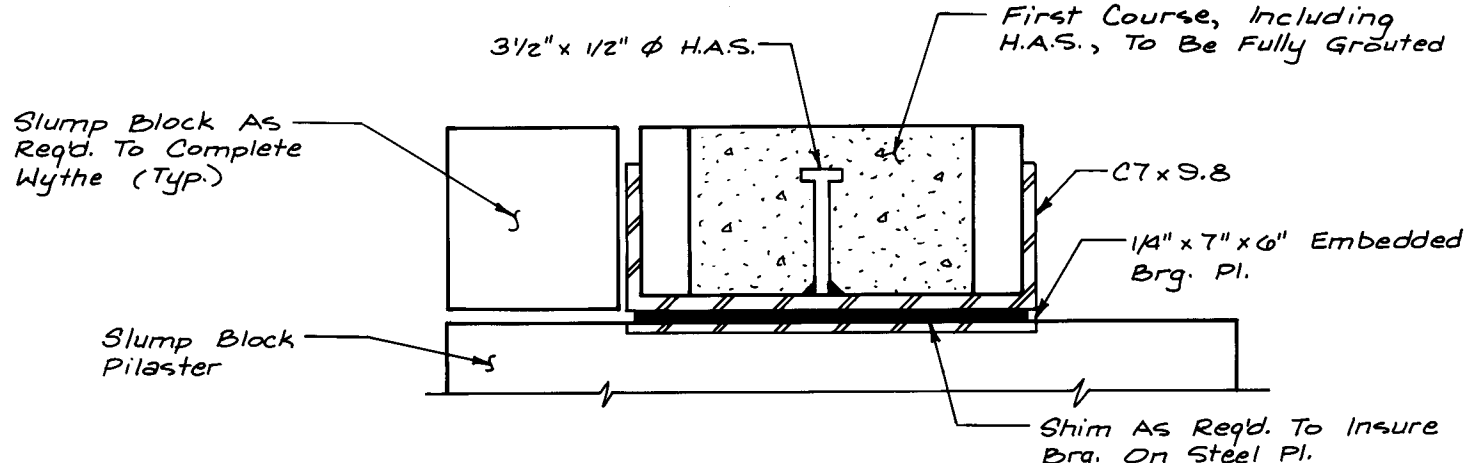

SECTION A-A
N.T.S.

GENERAL NOTES

1. MATERIAL SPECIFICATIONS
Masonry Units: ASTM C-90
Mortar: Type S, ASTM C-270
Grout: f'g = 2000 psi @ 28 days
Slump = 9" $\pm$
ASTM C-476
Concrete: f'c = 3000 psi @ 28 days
Minimum 5-1/2 sacks of cement per cubic yard
Bar Reinforcing: ASTM A-615, Grade 60
Joint Reinforcing: ASTM A-82

2. DESIGN CRITERIA
Horizontal Earth Pressure: 30 pcF
Soil Bearing Pressure: 1000 psf
Wind Load: 15 psf

3. All concrete and grout shall be vibrated

4. Lap bar reinforcing minimum 1'-4" for #5 bar, 1'-8" for #6 bar

5. Lap joint reinforcing minimum 9"

6. All footers shall be placed on 6" min. 95% compacted base per specifications on sheet 23 of 28.

7. Requirements for construction masonry and placing concrete during cold weather shall be enforced

8. All reinforcing shall have the following concrete cover:
Bottom and sides - 3"
Top - 2"

RETAINING WALLS ARE NOT DESIGNED FOR SATURATED EARTH CONDITIONS - GRADE FOR POSITIVE DRAINAGE

NOTE TO CONTRACTOR: All exposed white slump block wall are intended to have the same appearance as all other exposed white slump block wall in Tanoan Communities.

AS BUILT INFORMATION

CONTRACTOR
WORK
DATE
INSPECTOR
DATE
ACCEPTANCE BY
DATE
DRAWINGS
DATE
MICRO-FILM INFORMATION
RECORDED BY
DATE
NO

BENCH MARKS
A standard ACS brass tablet stamped "3-E21-A" set in a concrete post 0.3 ft. above the ground. To reach the station from the intersection of I-25 and San Mateo NE, go south on San Mateo 0.2 miles to Academy Rd. Turn left, go east and then northeast. Miles to Eubank NE. The station is about 0.4 miles northeast of this point. Elevation = 5765.23

SURVEY INFORMATION
FIELD NOTES
DATE
BY
NO
GREINER
1986
GREINER
1653
Aerial Photography
Tom Mann and Assoc.
6-1-86
Elevation = 5765.23


ENGINEER'S SEAL
1-25-87
PROJECT NO. 0690600

REVISIONS
NO
DATE
BY
DESIGN
DATE 1-87
DATE 1-87
DATE 1-87

26 3096 27 87


Greiner Engineering
2601 Wyoming NE
Albuquerque, New Mexico 87112
(505) 292-1936

CITY OF ALBUQUERQUE
PUBLIC WORKS DEPARTMENT
ENGINEERING DIVISION
TITLE: THE CHAMPIONS AT TANOAN
RETAINING WALL DETAILS
APPROVALS
ENGINEER
DATE 2/13/87
City Engineer
A.C.E. Design
A.C.E. Hydrology
CAM
2-20-87
APPROVALS
ENGINEER
DATE 2/13/87
Liquid Waste
Traffic
Water
NA DWH
2/13/87
DRAWING NO. 3096
MAP NO. E-21
SHEET 27 OF 28

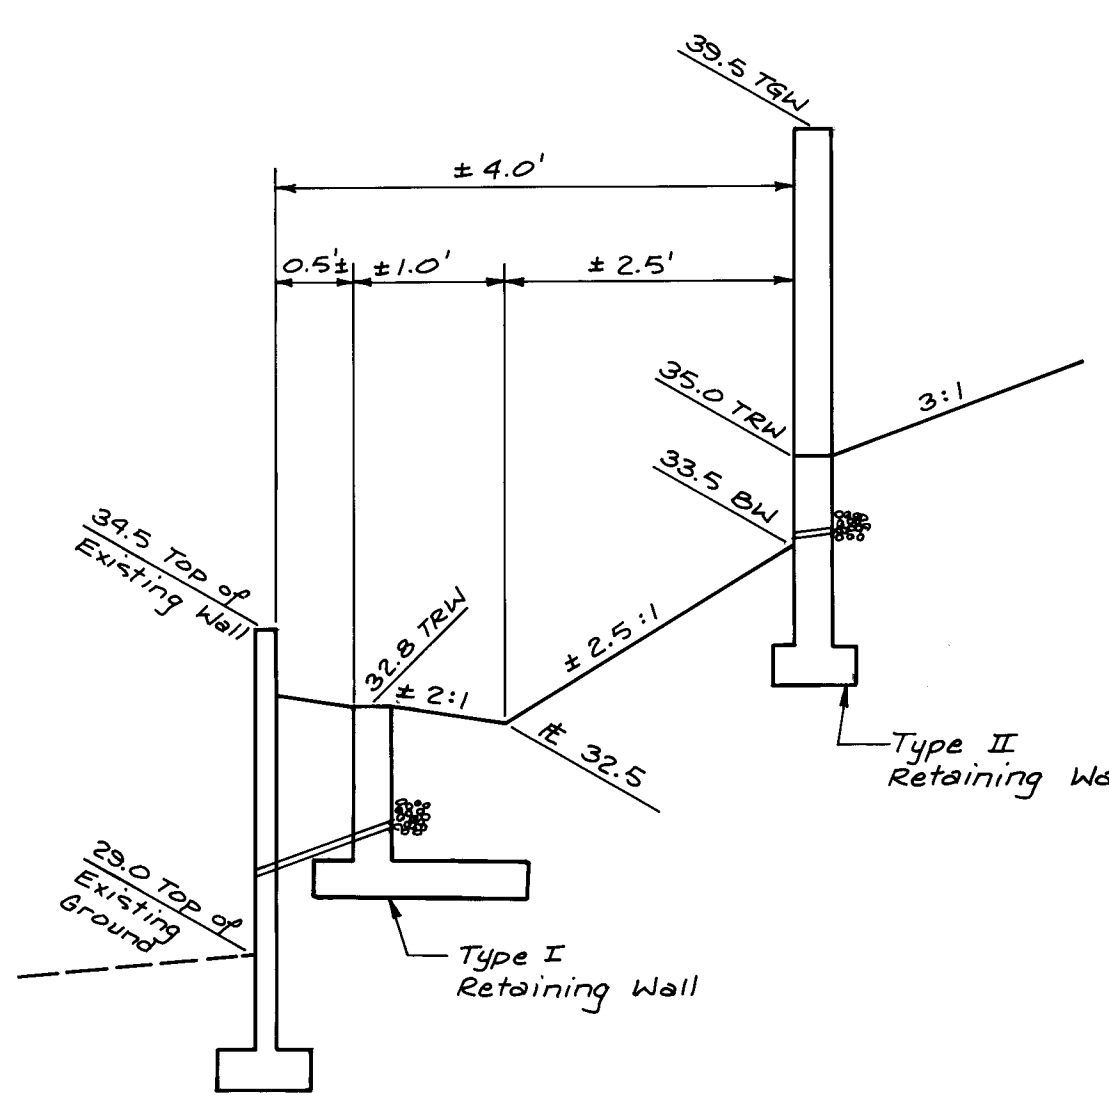

SCALE:
HORIZ. 1" = 20'
VERT. 1" = 5'

Site 1 + 44.7	Site 1 + 93.70
35.0 BW	33.0 BW
30.0 TRN	34.5 TRN
Site 1 + 55.4	Site 2 + 05.70
34.5 BW	32.0 BW
30.0 TRN	33.5 TRN
Site 1 + 69.03	Site 2 + 10.20
34.0 BW	31.0 BW
35.5 TRN	30.0 TRN
Site 1 + 82.03	Site 2 + 17.80
33.5 BW	Reinforcing Wall
35.0 TRN	33.5 BW
	30.0 TRN

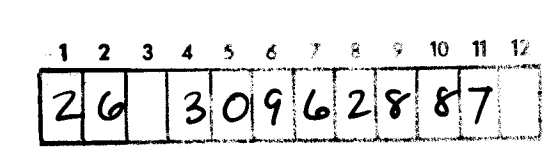

CITY OF ALBUQUERQUE PUBLIC WORKS DEPARTMENT ENGINEERING DIVISION					
TITLE: THE CHAMPIONS AT TANOAN TYPE I & TYPE II RETAINING WALL PLAN & PROFILE					
APPROVALS	ENGINEER	DATE	APPROVALS	ENGINEER	DATE
City Engineer	<i>[Signature]</i>	2/3/8	Liquid Waste	<i>[Signature]</i>	2-23-8
A C E - Design	<i>[Signature]</i>		Traffic	<i>[Signature]</i>	2-13-8
A C E -Hydrology	<i>[Signature]</i>	2-22-8	Water	<i>[Signature]</i>	2-13-8
DRAWING NO.		MAP NO.		SHEET OF	
3096		E-21		28 28	