


Sports Stadium Upper
Parking Improvements
3131

- L E G E N D -


MATERIALS

CONCRETE
RIP-RAP

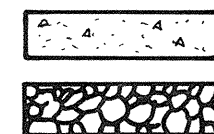


LINES

SUBDIVISION BOUNDARY
PROPERTY LINE (PLAN)
PROPERTY LINE (SECTION)
CENTERLINE
EASEMENT LINE
MATCH LINE
SECTION CUT LINE

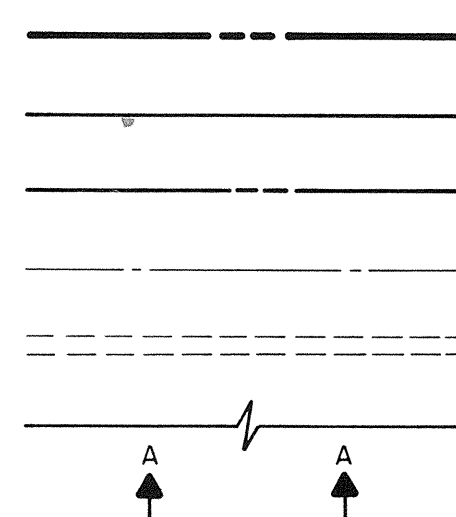


EARTHWORK

CONTOUR LINE
SPOT ELEVATION
PROJECT / PHASE BOUNDARY
SWALE
DIRECTION OF FLOW

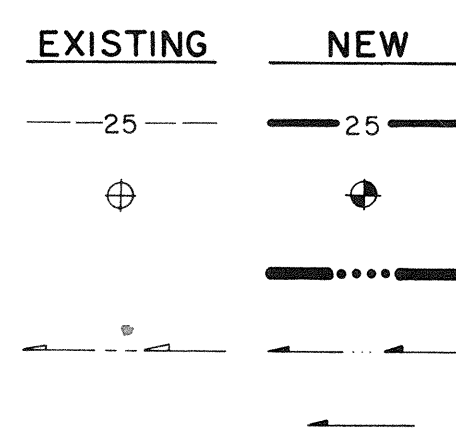


MISCELLANEOUS UTILITIES

GAS LINE
UNDERGROUND TELEPHONE
UNDERGROUND ELECTRICAL
STORM DRAIN
STORM DRAIN MANHOLE
STORM DRAIN INLET

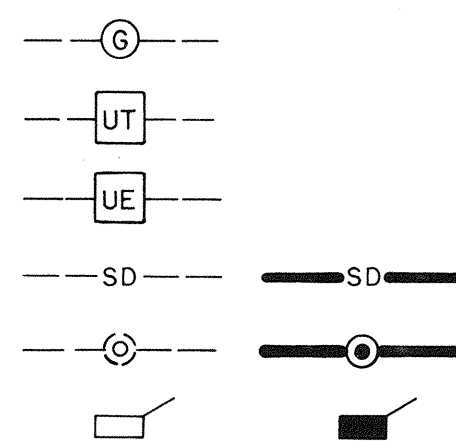


SANITARY SEWER

SANITARY SEWER LINE
SANITARY SEWER MANHOLE
SAS SERVICE CONNECTIONS
SAS CAP OR PLUG
ENCASEMENT

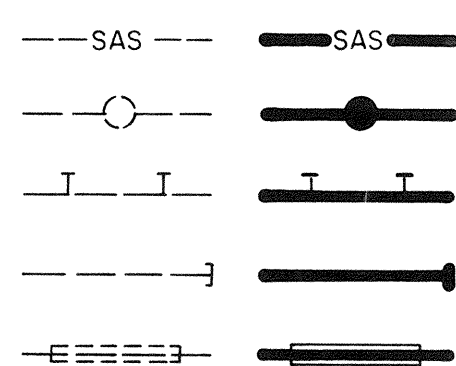


WATER

WATER LINE
WATER SERVICE CONNECTIONS
GATE VALVE
FIRE HYDRANT
BUTTERFLY VALVE
REDUCER
WATER PRESSURE ZONE BOUNDARY

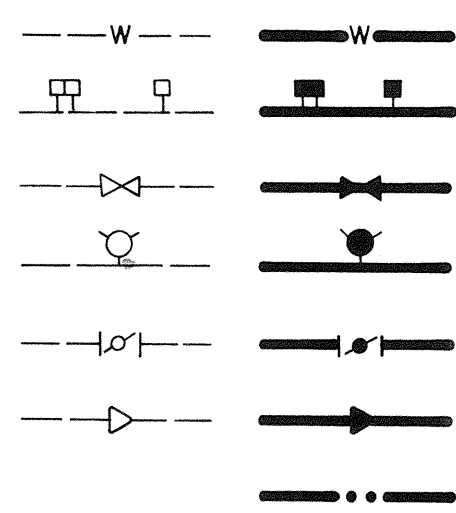


WATER FITTINGS

CAPS AND PLUGS
ELBOW
CROSS
TEE

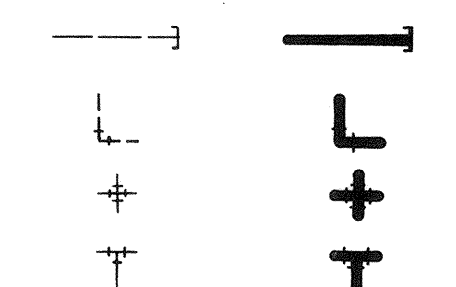

MISCELLANEOUS


CHAINLINK FENCE
FIELD FENCE
COMMON YARD WALL
RETAINING WALL
POWER OR TELEPHONE POLE
TREE

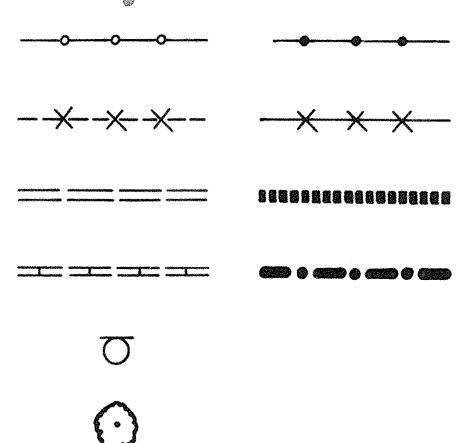

SPORTS STADIUM UPPER PARKING IMPROVEMENTS

INDEX OF DRAWINGS

SHEET NO.	TITLE
1.	TITLE, LEGEND, VICINITY MAP, GENERAL NOTES, INDEX OF DRAWINGS
2.	SITE GRADING PLAN AND COORDINATE DATA
3.	PLAN AND PROFILE
4.	DETAILS AND SECTIONS
5.	THEMUM MODIFICATION ON STADIUM
6.	THEMUM MODIFICATION ON STADIUM

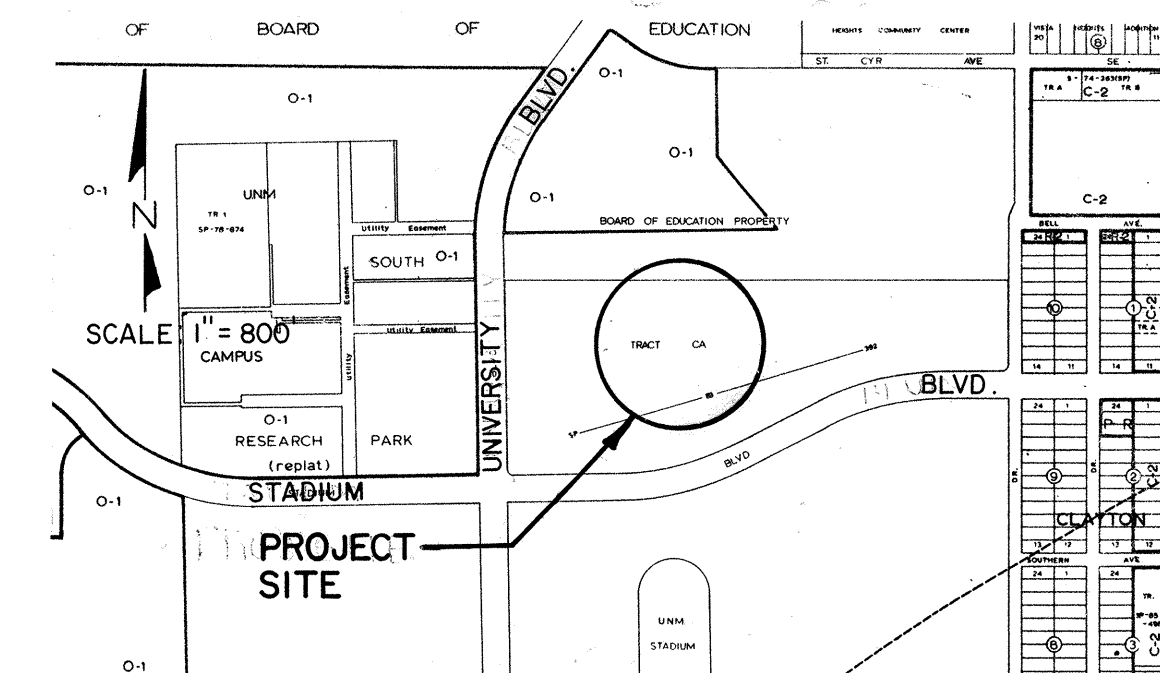

LOCATION MAP

GENERAL NOTES:

- ALL WORK DETAILED ON THESE PLANS TO BE PERFORMED UNDER CONTRACT SHALL, EXCEPT AS OTHERWISE STATED OR PROVIDED FOR HEREON, BE CONSTRUCTED IN ACCORDANCE WITH THE CITY OF ALBUQUERQUE INTERIM STANDARD SPECIFICATIONS - PUBLIC WORKS CONSTRUCTION - 1985.
- TWO (2) WORKING DAYS PRIOR TO ANY EXCAVATION, CONTRACTOR MUST CONTACT LINE LOCATING SERVICE, 765-1234, FOR LOCATION OF EXISTING UTILITIES.
- IF ANY UTILITY LINES, PIPELINES, OR UNDERGROUND UTILITY LINES ARE SHOWN ON THESE DRAWINGS, THEY ARE SHOWN IN AN APPROXIMATE MANNER ONLY, AND SUCH LINES MAY EXIST WHERE NONE ARE SHOWN. IF ANY SUCH EXISTING LINES ARE SHOWN, THE LOCATION IS BASED UPON INFORMATION PROVIDED BY THE OWNER OF SAID UTILITY, AND THE INFORMATION MAY BE INCOMPLETE, OR MAY BE OBSOLETE BY THE TIME CONSTRUCTION COMMENCES. THE ENGINEER HAS UNDERTAKEN NO FIELD VERIFICATION OF THE LOCATION, DEPTH, SIZE, OR TYPE OF EXISTING UTILITY LINES, PIPELINES, OR UNDERGROUND UTILITY LINES, MAKES NO REPRESENTATION PERTAINING THERETO, AND ASSUMES NO RESPONSIBILITY OR LIABILITY THEREFOR. THE CONTRACTOR SHALL INFORM ITSELF OF THE LOCATION OF ANY UTILITY LINE, PIPELINE, OR UNDERGROUND UTILITY LINE IN OR NEAR THE AREA OF THE WORK IN ADVANCE OF AND DURING EXCAVATION WORK. THE CONTRACTOR IS FULLY RESPONSIBLE FOR ANY AND ALL DAMAGE CAUSED BY ITS FAILURE TO LOCATE, IDENTIFY AND PRESERVE ANY AND ALL EXISTING UTILITIES, PIPELINES, AND UNDERGROUND UTILITY LINES IN PLANNING AND CONDUCTING EXCAVATION. THE CONTRACTOR SHALL COMPLY WITH STATE STATUTES, MUNICIPAL AND LOCAL ORDINANCES, RULES AND REGULATIONS, IF ANY, PERTAINING TO THE LOCATION OF THESE LINES AND FACILITIES.
- SHOULD A CONFLICT EXIST BETWEEN THESE PLANS AND ACTUAL FIELD CONDITIONS, THE CONTRACTOR SHALL PROMPTLY NOTIFY THE ENGINEER IN WRITING SO THAT THE CONFLICT CAN BE RESOLVED WITH A MINIMUM AMOUNT OF DELAY FOR ALL PARTIES.
- THE CONTRACTOR SHALL MAINTAIN ACCESS TO ADJACENT PROPERTIES DURING CONSTRUCTION.
- ALL WORK ON THIS PROJECT SHALL BE PERFORMED IN ACCORDANCE WITH APPLICABLE FEDERAL, STATE AND LOCAL LAWS, RULES AND REGULATIONS CONCERNING CONSTRUCTION SAFETY AND HEALTH.
- THE CONTRACTOR MUST SUBMIT A CONSTRUCTION SIGNING AND BARRICADING PLAN TO TRAFFIC ENGINEERING TO RECEIVE A BARRICADING PERMIT 48 HOURS PRIOR TO CONSTRUCTION.
- ALL UTILITIES AND UTILITY SERVICE LINES SHALL BE INSTALLED PRIOR TO PAVING.
- BACKFILL COMPACTION SHALL BE ACCORDING TO SPECIFIED STREET USE.
- TACK COAT REQUIREMENTS SHALL BE DETERMINED BY THE CITY ENGINEER.
- SIDEWALKS AND WHEELCHAIR RAMPS WITHIN THE CURB RETURNS SHALL BE CONSTRUCTED WHEREVER A NEW CURB RETURN IS CONSTRUCTED.
- IF CURB IS DEPRESSED FOR A DRIVEPAD OR A HANDICAP RAMP, THE DRIVEPAD OR RAMP SHALL BE CONSTRUCTED PRIOR TO ACCEPTANCE OF THE CURB AND GUTTER.
- ALL STORM DRAINAGE FACILITIES SHALL BE COMPLETED PRIOR TO FINAL ACCEPTANCE.
- All stationing shall be based on construction centerline.
- Painting for traffic striping shall be conducted by owner.


APPROVAL OF AS BUILT DRAWINGS
CHIEF CONSTRUCTION ENGINEER
[Signature]
DATE 10-12-87

1 2 3 4 5 6 7 8 9 10 11 12
26 31310187

SCANNED BY

REV.	SHEETS	CITY ENGINEER	DATE	USER	DEPT.	DATE	USER	DEPT.	DATE
APPROVAL OF REVISIONS									

CITY OF ALBUQUERQUE	APPROVED FOR CONSTRUCTION <i>[Signature]</i> PRINCIPAL ENGINEER DESIGN
DRAWING NO. 3131	SHEET OF 1 46

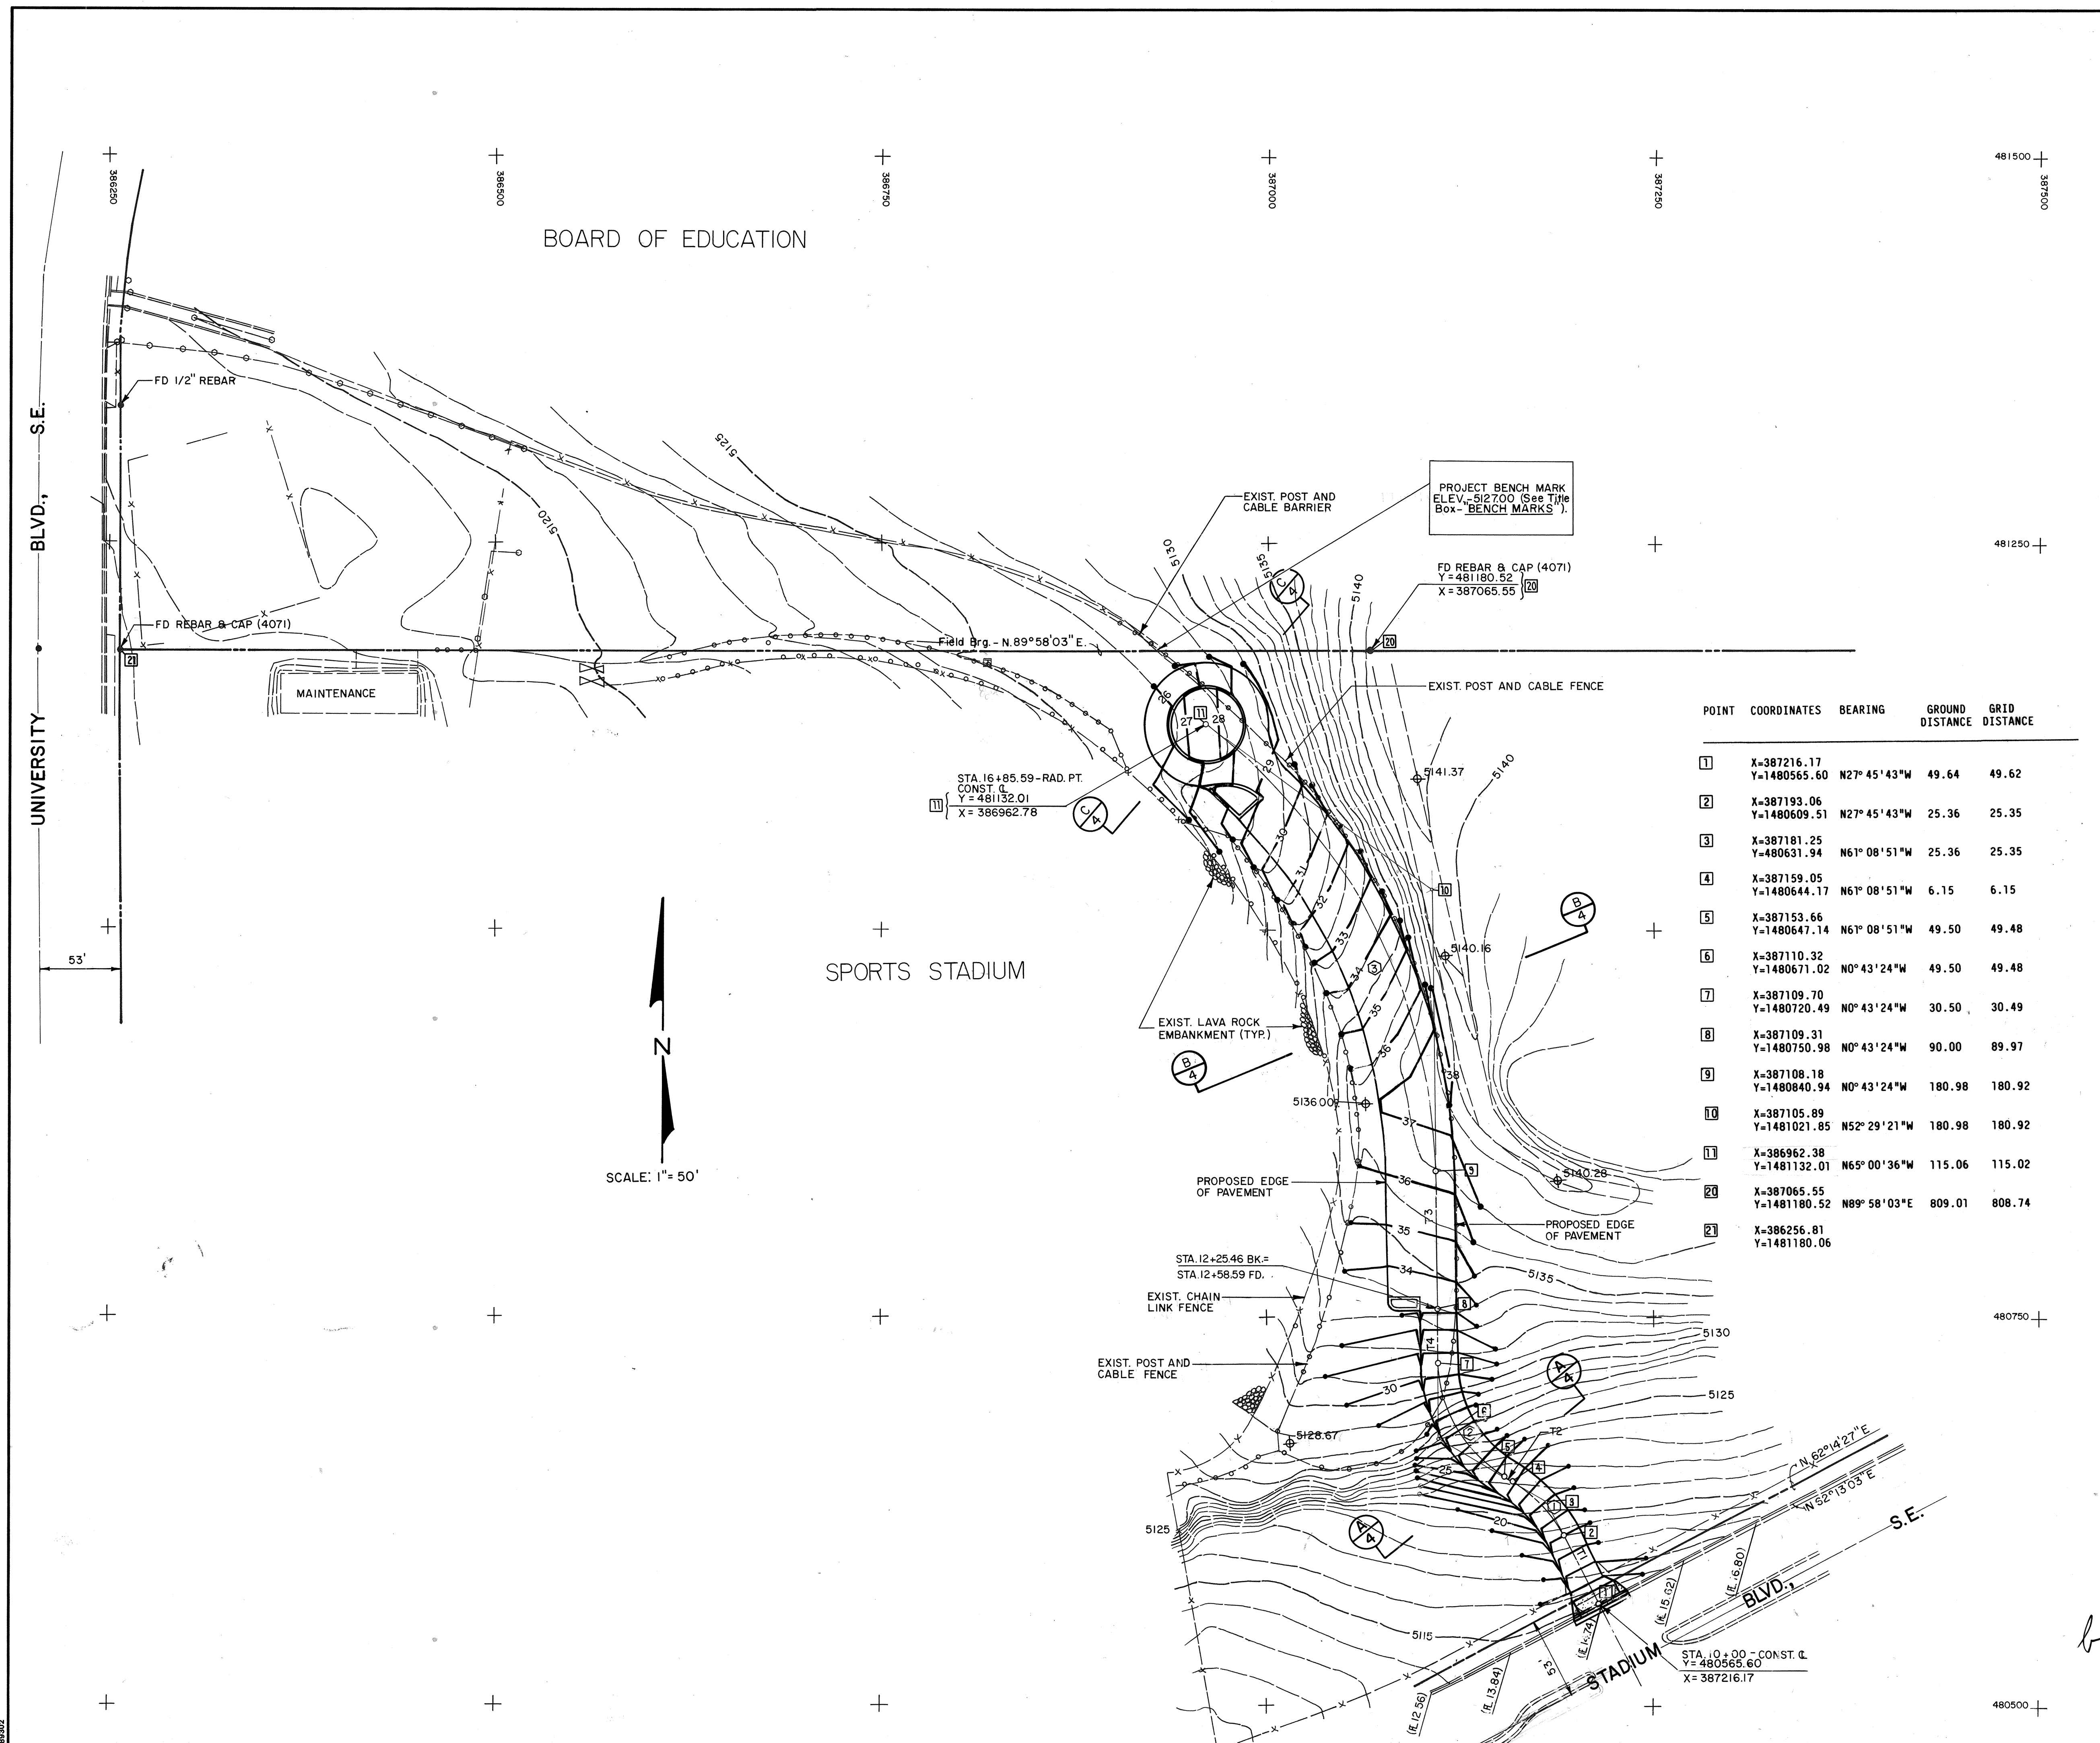

CURVE DATA			
	R	Δ	T
①	85.00'	33° 23' 08"	25.36'
②	85.00'	60° 25' 27"	49.50'
③	373.00'	51° 45' 57"	180.98'
④	40.00'	45° 13' 21"	16.60'
⑤	25.00'	31° 26' 33"	7.04'
⑥	40.00'	256° 39' 54"	179.19'
⑦	30.00'	57° 50' 14"	16.57'
⑧	40.00'	22° 28' 09"	7.95'

	BEARING	DIST.
T1	N. 27° 45' 43" W.	49.64'
T2	N. 61° 08' 51" W.	6.15'
T3	N. 0° 43' 24" W.	90.00'
T4	N. 0° 43' 24" W.	30.50'

CONSTRUCTION NOTES:

- REMOVE AND REPLACE EXISTING ARTERIAL PAVEMENT PER STD. DWG. P-4.
- REMOVE AND REPLACE EXISTING STANDARD CURB AND GUTTER PER STD. DWG. P-8.
- REMOVE EXISTING DRIVEPAD (28'W) AND CONSTRUCT PCC DRIVEPAD TO WIDTH(W) AS SPECIFIED AND PER STD. DWG. P-11.
- REMOVE EXISTING 8' CHAIN LINK FENCE AND CONSTRUCT 25' WIDE CHAINLINK GATE PER STD. DWG. K-21.
- CONSTRUCT A.C. CURB PER STD. DWG. P-11.
- INSTALL TRAFFIC GUARD RAIL PER STD. DWG. P-19.
- CONSTRUCT 2" TYPE I A.C. PAVEMENT PER PLAN AND PROFILE AND DETAIL ON SHEET 4.
- REMOVE EXISTING POST AND RAIL FENCE WITHIN PROPOSED PAVEMENT AREA.
- INSTALL NEW POST AND RAIL FENCE AS SHOWN AND PER DETAIL ON SHEET 4.
- INSTALL 8' PCC BUMPER CURB W/DRAINAGE SLOTS AS SUPPLIED BY MATERIALS INC. OR APPROVED EQUAL.
- CONSTRUCT TYPE I PINNED CURB PER STD. DWG. P-8.
- REMOVE AND REPLACE 25 LINEAL FEET OF EXISTING CHAIN LINK FENCE.

AS BUILT INFORMATION	
CONTRACTOR	J.F. HALE
INSPECTED BY	C.O.A.
DATE	8-87
FIELD DISTANCE BY	FBC
DATE	9-87
VERIFICATION BY	E.N.E.
DATE	10-87
CORRECTED BY	
DATE	
RECORDED BY	
DATE	

BENCH MARKS	
BENCH MARK ON TOP OF CONCRETE BASE OF FENCE POST AT FENCE CORNER	
MARKED BY ORANGE PAINT	
ELEV. = 5127.00	

SURVEY INFORMATION	
FIELD NOTES	
BY	MORRIS G.
DATE	
NO.	

ENGINEER'S SEAL	
REMARKS	BY
DESIGN	
REVISIONS	
DESIGNED BY	R. PANG, B. BENNETT
DATE	2-11-87
DRAWN BY	P. HERNANDEZ
DATE	2-17-87
CHECKED BY	R. PANG
DATE	3/87

1 2 3 4 5 6 7 8 9 10 11 12





26 31310287

CITY OF ALBUQUERQUE
MUNICIPAL DEVELOPMENT DEPARTMENT
ENGINEERING DIVISION

TITLE:
SPORTS STADIUM UPPER PARKING IMPROVEMENTS
SITE GRADING PLAN

APPROVALS	ENGINEER	DATE	APPROVALS	ENGINEER	DATE
City Engineer	<i>[Signature]</i>	4/18/87	Liquid Waste	W/W	3-27-87
A.C.E. Design	<i>[Signature]</i>	4-13-87	Traffic	W/W	
A.C. E-Hydrology	<i>[Signature]</i>	4-13-87	Water	W/W	3-27-87

DRAWING NO.	MAP NO.	SHEET	OF
3131	L-15	2	46

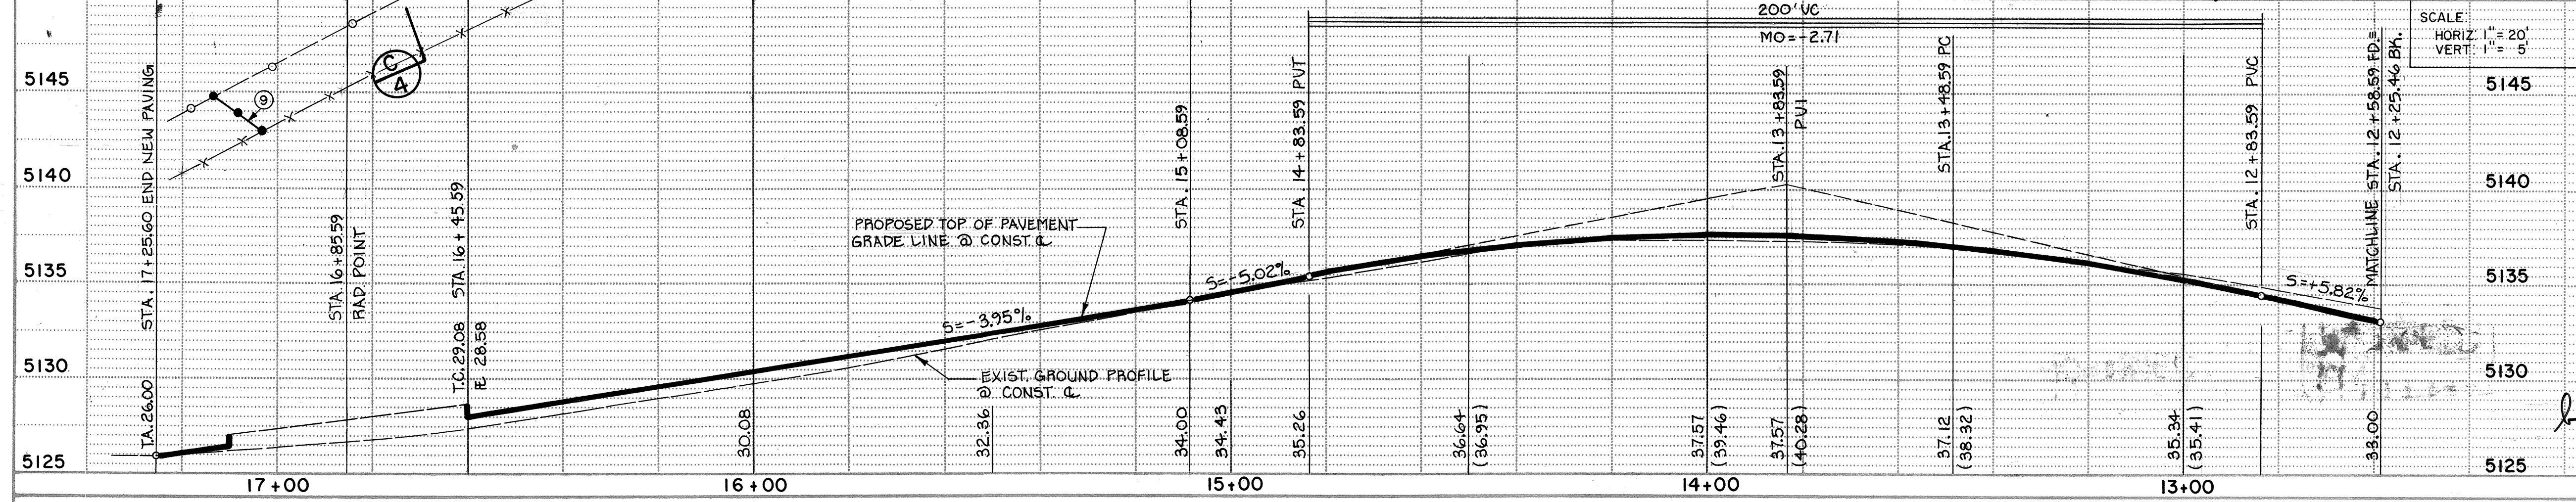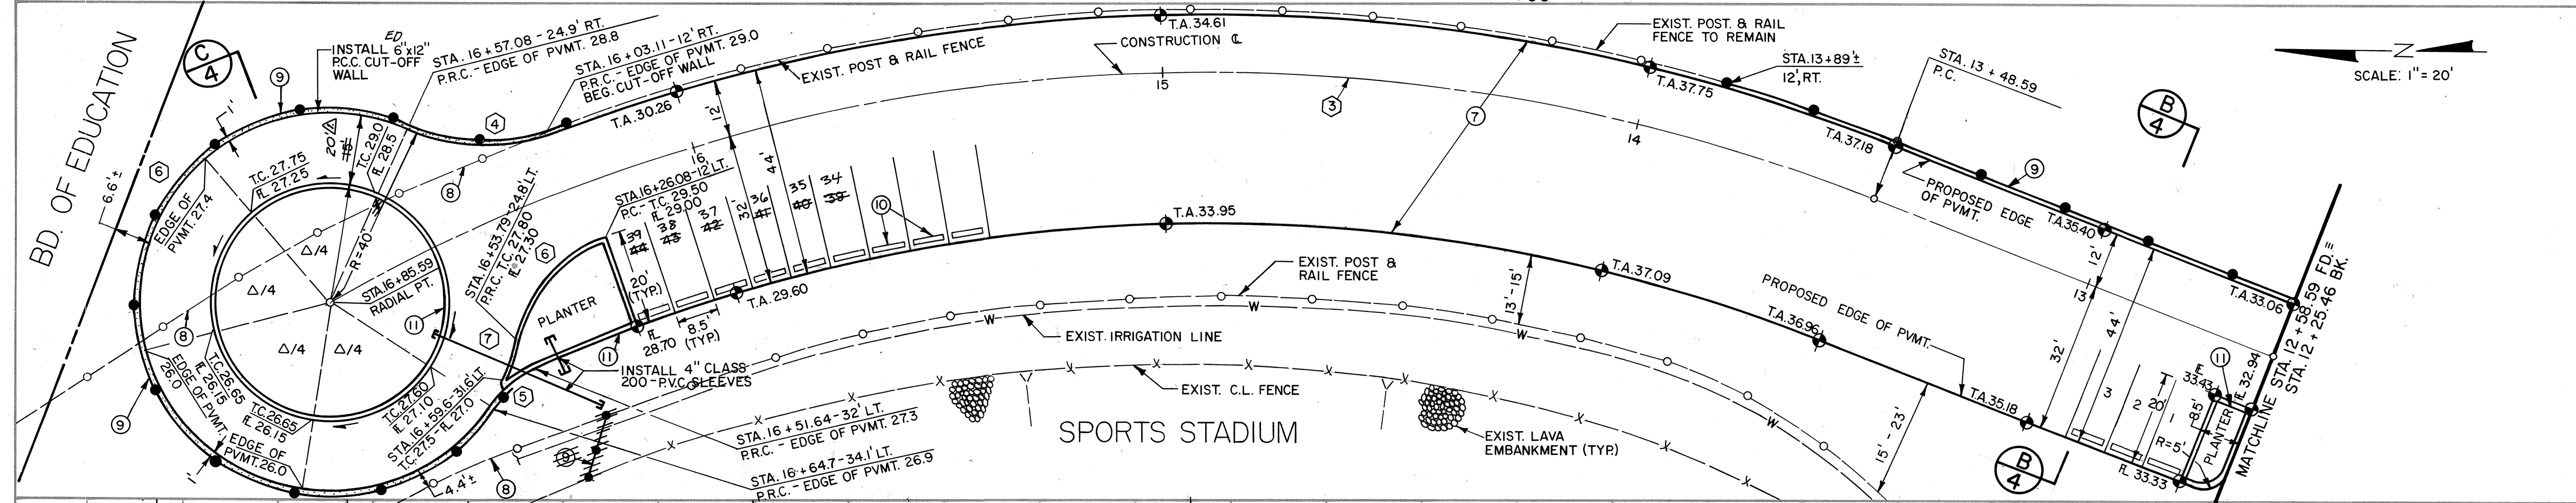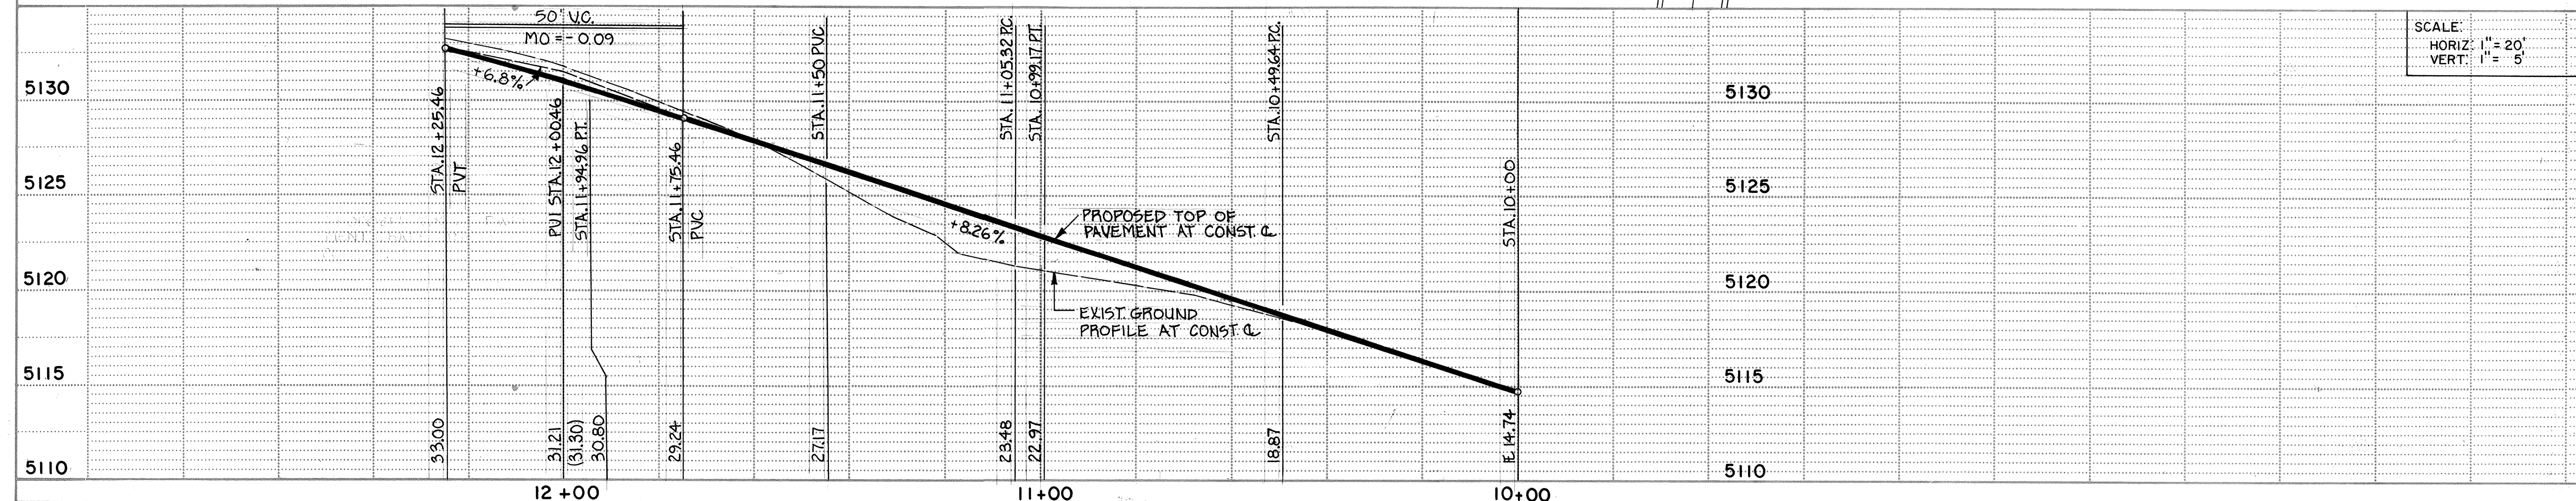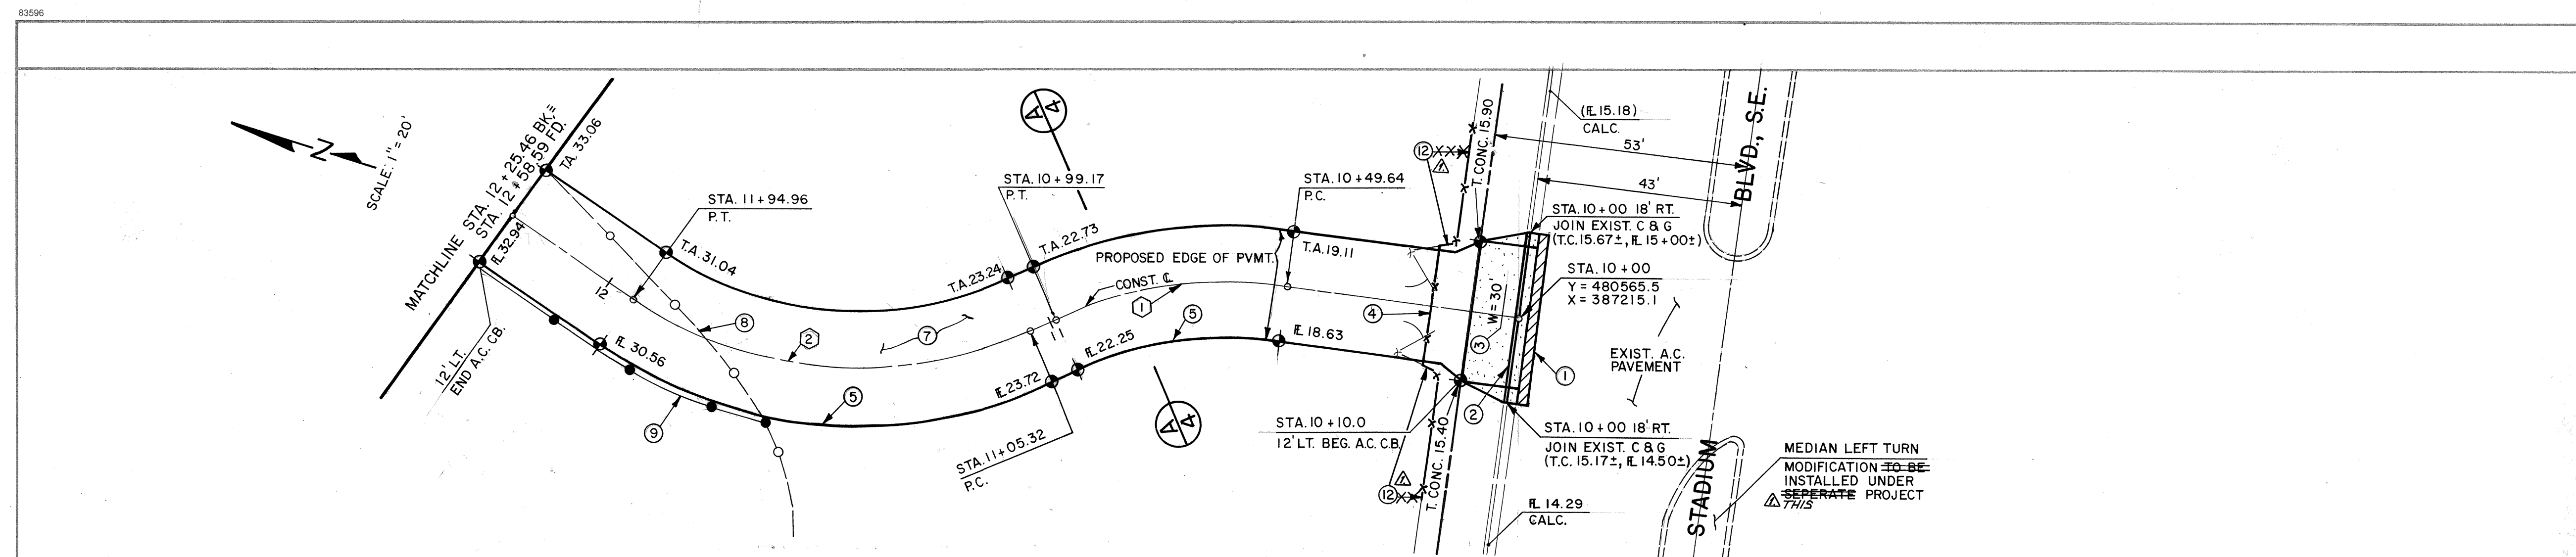[illegible]

- CONSTRUCTION NOTES:
- (1) REMOVE AND REPLACE EXISTING ARTERIAL PAVEMENT PER STD. DWG. P-4.
 - (2) REMOVE AND REPLACE EXISTING STANDARD CURB AND GUTTER PER STD. DWG. P-8.
 - (3) REMOVE EXISTING DRIVEPAD (28'W) AND CONSTRUCT PCC DRIVEPAD TO WIDTH(W) AS SPECIFIED AND PER STD. DWG. P-11.
 - (4) ~~REMOVE EXISTING 8" CHAIN LINK FENCE~~ AND CONSTRUCT 25' WIDE CHAINLINK GATE PER STD. DWG. K-21.
 - (5) CONSTRUCT A.C. CURB PER STD. DWG. P-11.
 - (6) INSTALL TRAFFIC GUARD RAIL PER STD. DWG. P-19.
 - (7) CONSTRUCT 2" TYPE I A.C. PAVEMENT PER PLAN AND PROFILE AND DETAIL ON SHEET 4.
 - (8) REMOVE EXISTING POST AND RAIL FENCE WITHIN PROPOSED PAVEMENT AREA.
 - (9) INSTALL NEW POST AND RAIL FENCE AS SHOWN AND PER DETAIL ON SHEET 4.
 - (10) INSTALL 8' PCC BUMPER CURB W/DRAINAGE SLOTT AS SUPPLIED BY MATERIALS INC. OR APPROVED EQUAL.
 - (11) CONSTRUCT TYPE I PINNED CURB PER STD. DWG. P-8.
 - (12) REMOVE AND REPLACE 25 LINEAL FEET OF EXISTING CHAIN LINK FENCE.

1	2	3	4	5	6	7	8	9	10	11	12
2	6	3	1	3	1	0	3	8	7		

ENGINEER'S SEAL

Δ	100687	Revised from as-built information	EN
NO.	DATE	REMARKS	BY

REVISIONS

DESIGN


DESIGNED BY	P. PANG, B. EMMETT	DATE	2-11-87
DRAWN BY	P. HERNANDEZ	DATE	2-23-87
CHECKED BY	P. PANG	DATE	3/87

CITY OF ALBUQUERQUE
MUNICIPAL DEVELOPMENT DEPARTMENT
ENGINEERING DIVISION


TITLE: **SPORTS STADIUM UPPER PARKING IMPROVEMENTS
PLAN AND PROFILE**

APPROVALS	ENGINEER	DATE	APPROVALS	ENGINEER	DATE
City Engineer	<i>[Signature]</i>	4/19/87	Liquid Waste	W/W	3-27-87
A.C.E.-Design	<i>[Signature]</i>	4-13-87	Traffic	David W. Hanna	4/7/87
A.C.E.-Hydrology	<i>[Signature]</i>	4-13-87	Water	W/W	3-27-87

DRAWING NO.	3131	MAP NO.	L-15	SHEET	3	OF	46
-------------	------	---------	------	-------	---	----	----

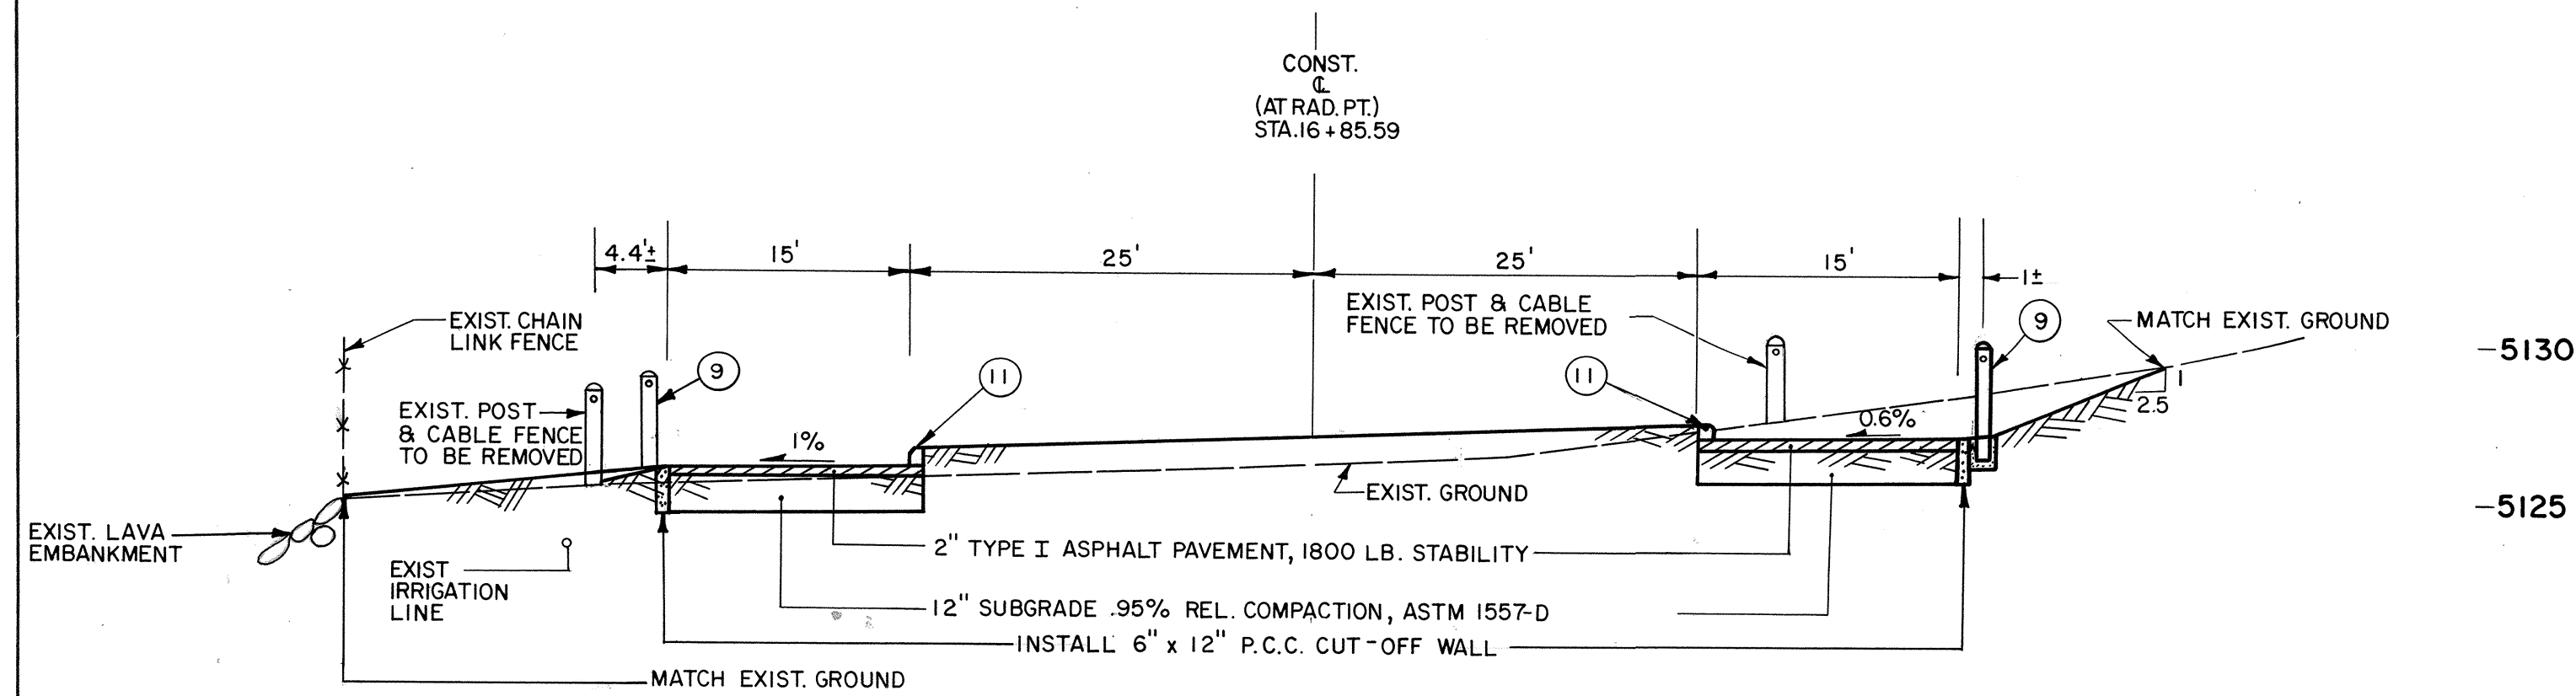

SECTION C
SCALE: 1" = 5'
STA. 16+85.59

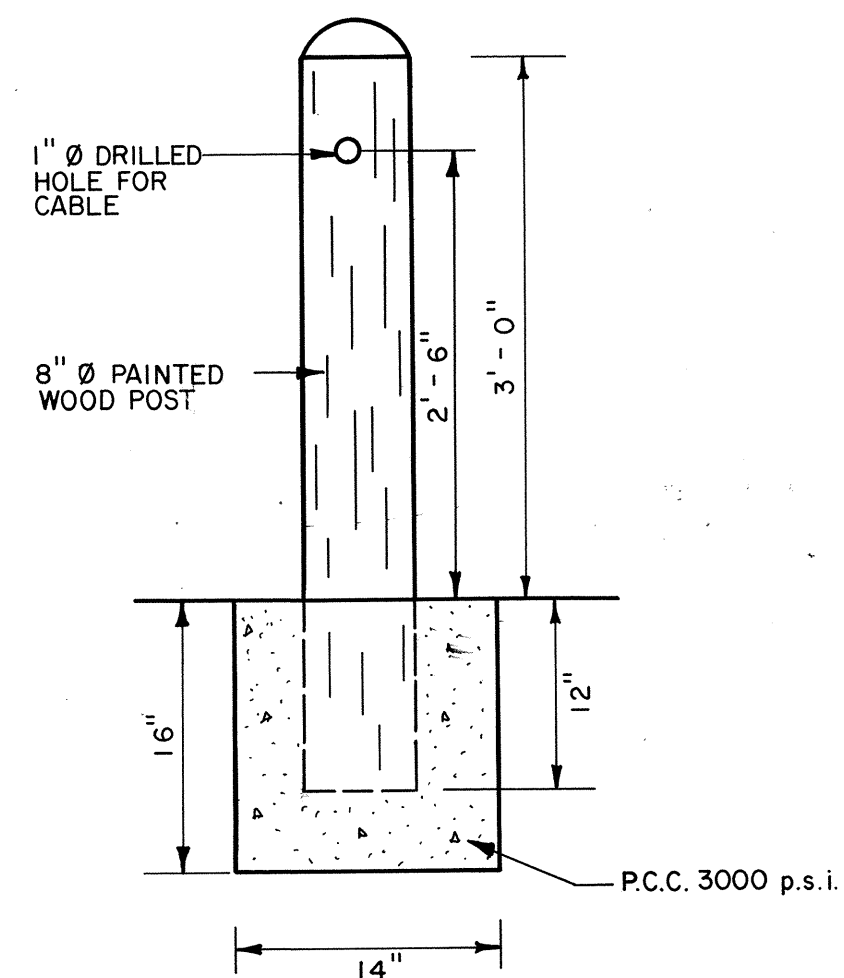


POST ANCHOR DETAIL
POST AND CABLE FENCE
NO SCALE


- CONSTRUCTION NOTES:
1. REMOVE AND REPLACE EXISTING ARTERIAL PAVEMENT PER STD. DWG. P-4.
 2. REMOVE AND REPLACE EXISTING STANDARD CURB AND GUTTER PER STD. DWG. P-8.
 3. REMOVE EXISTING DRIVEPAD (28'W) AND CONSTRUCT PCC DRIVEPAD TO WIDTH(W) AS SPECIFIED AND PER STD. DWG. P-11.
 4. REMOVE EXISTING 8' CHAIN LINK FENCE AND CONSTRUCT 25' WIDE CHAINLINK GATE PER STD. DWG. K-21.
 5. CONSTRUCT A.C. CURB PER STD. DWG. P-11.
 6. INSTALL TRAFFIC GUARD RAIL PER STD. DWG. P-19.
 7. CONSTRUCT 2" TYPE I A.C. PAVEMENT PER PLAN AND PROFILE AND DETAIL ON SHEET 4.
 8. REMOVE EXISTING POST AND RAIL FENCE WITHIN PROPOSED PAVEMENT AREA.
 9. INSTALL NEW POST AND RAIL FENCE AS SHOWN AND PER DETAIL ON SHEET 4.
 10. INSTALL 8' PCC BUMPER CURB W/DRAINAGE SLOTS AS SUPPLIED BY MATERIALS INC. OR APPROVED EQUAL.
 11. CONSTRUCT TYPE I PINNED CURB PER STD. DWG. P-8.
 12. REMOVE AND REPLACE 25 LINEAL FEET OF EXISTING CHAIN LINK FENCE.

SUBGRADE SOIL STERILIZATION NOTE:

ALL SUBGRADE SHALL BE TREATED WITH A SOIL STERILIZATION AGENT (PRIMATOL OR APPROVED EQUAL) TO A LIMIT OF 5 FEET OVERLAPPING EDGE OF PAVEMENT AND IN ACCORDANCE WITH SECTION 342 OF THE SPECIFICATIONS OR AS DIRECTED BY FIELD ENGINEER.

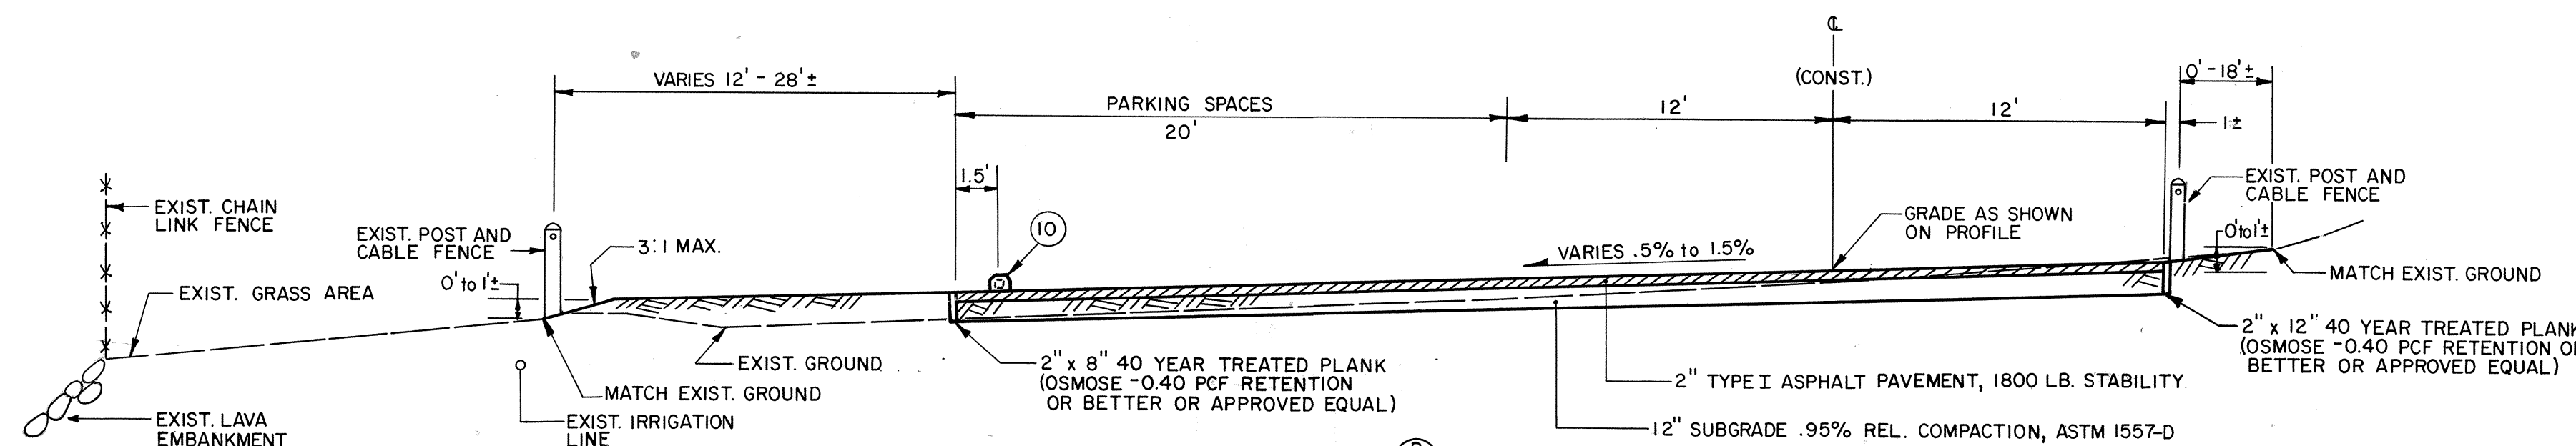

SECTION B
SCALE: 1" = 5'
STA. 12+58.59 TO STA. 16+26.16

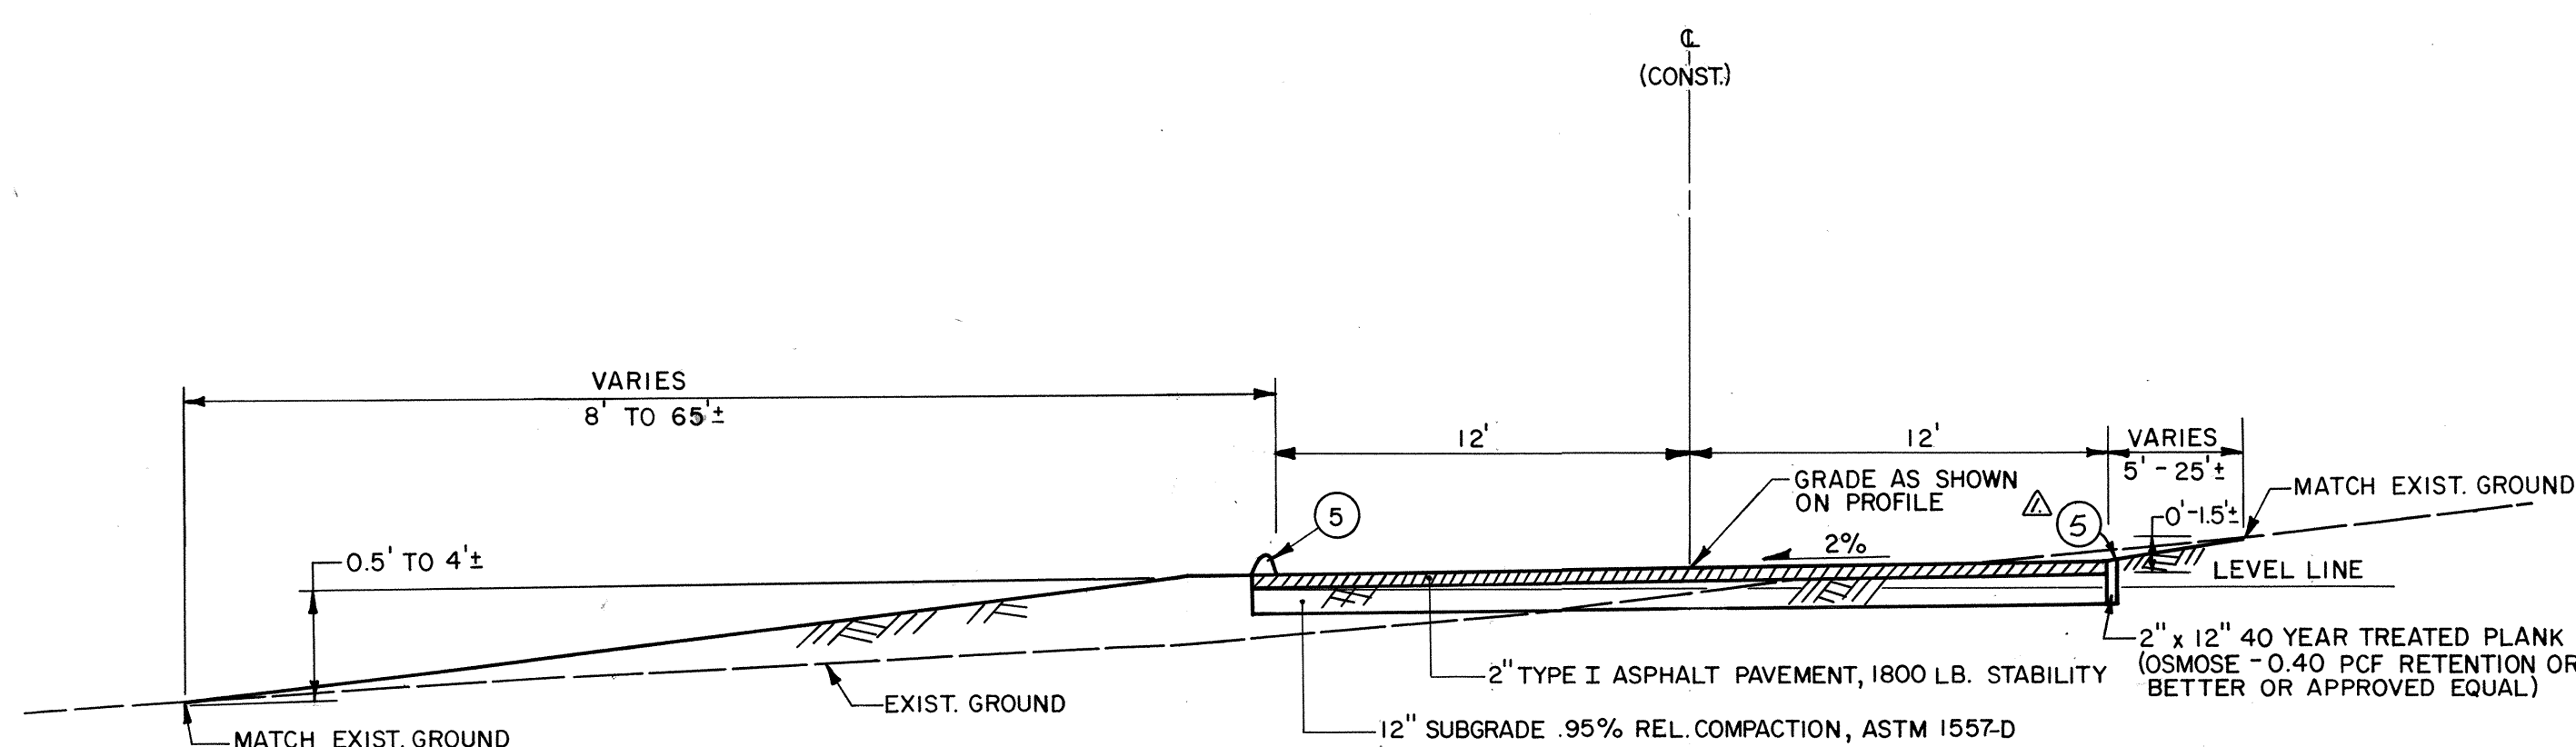

SECTION A
SCALE: 1" = 5'
STA. 10+10.00 TO STA. 12+25.46 BK.

SCANNED BY

SCANNED BY

1 2 3 4 5 6 7 8 9 10 11 12
26 31310487


CITY OF ALBUQUERQUE MUNICIPAL DEVELOPMENT DEPARTMENT ENGINEERING DIVISION					
TITLE: SPORTS STADIUM UPPER PARKING IMPROVEMENTS DETAILS & SECTIONS					
APPROVALS	ENGINEER	DATE	APPROVALS	ENGINEER	DATE
City Engineer	<i>[Signature]</i>	4/14/87	Liquid Waste	<i>[Signature]</i>	3-27-87
A.C.E.-Design	<i>[Signature]</i>	4-12-87	Traffic	<i>[Signature]</i>	4/27/87
A.C.E.-Hydrology	<i>[Signature]</i>	4-13-87	Water	<i>[Signature]</i>	3-27-87
DRAWING NO.	3131	MAP NO.	L-15	SHEET	4 OF 46

- L E G E N D -

MATERIALS

CONCRETE

RIP-RAP

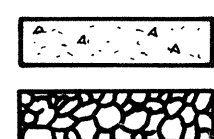

LINES

RIGHT-OF-WAY

PROPERTY LINE (PLAN)


RIGHT-OF-WAY (SECTION)

CENTERLINE

EASEMENT LINE

MATCH LINE

SECTION CUT LINE

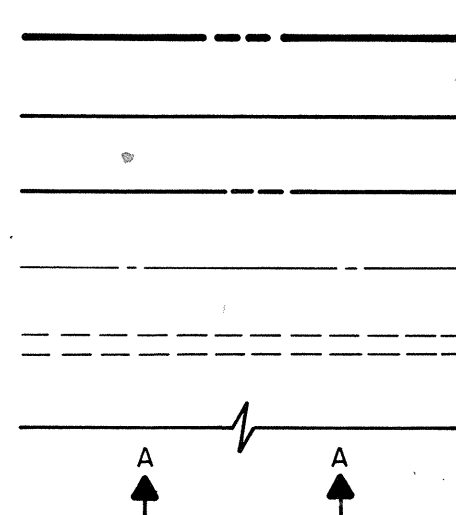

EARTHWORK


CONTOUR LINE

SPOT ELEVATION

PROJECT / PHASE BOUNDARY

SWALE

DIRECTION OF FLOW

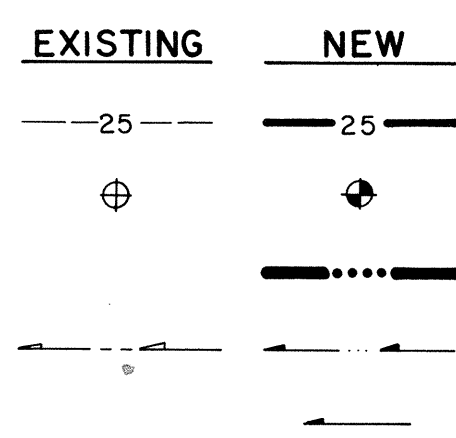

MISCELLANEOUS UTILITIES

GAS LINE


UNDERGROUND TELEPHONE

UNDERGROUND ELECTRICAL

STORM DRAIN

STORM DRAIN MANHOLE

STORM DRAIN INLET

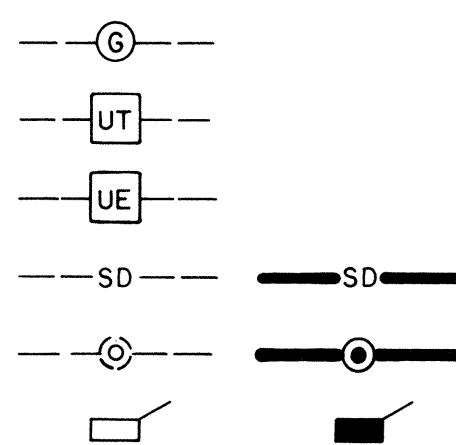

SANITARY SEWER


SANITARY SEWER LINE

SANITARY SEWER MANHOLE

SAS SERVICE CONNECTIONS

SAS CAP OR PLUG

ENCASEMENT

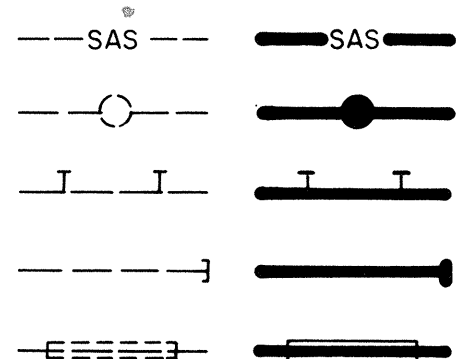

WATER

WATER LINE WITH CAP

WATER SERVICE CONNECTIONS


GATE VALVE

FIRE HYDRANT

BUTTERFLY VALVE

REDUCER

WATER PRESSURE ZONE BOUNDARY

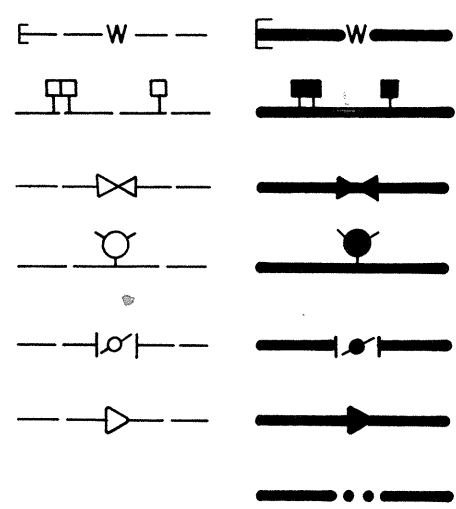


WATER FITTINGS

CAPS AND PLUGS

ELBOW

CROSS

TEE

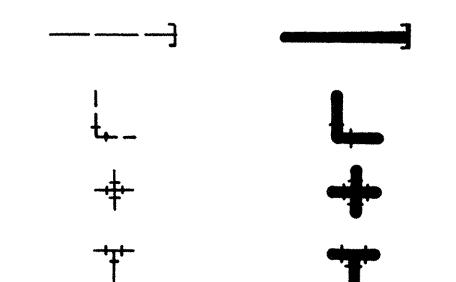

MISCELLANEOUS

EDGE OF ASPHALT


FIELD FENCE/CHAINLINK FENCE

COMMON YARD WALL/BLOCK WALL


RETAINING WALL

POWER OR TELEPHONE POLE

TREE

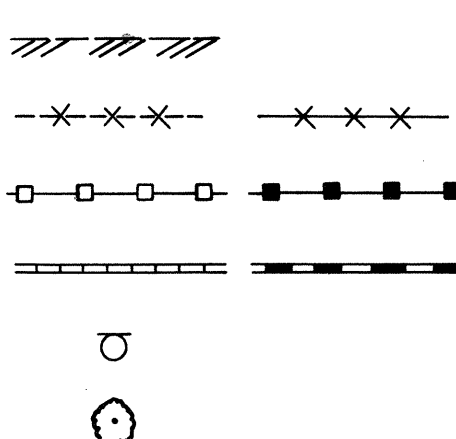

MEDIAN MODIFICATION ON STADIUM BOULEVARD EAST OF UNIVERSITY BOULEVARD

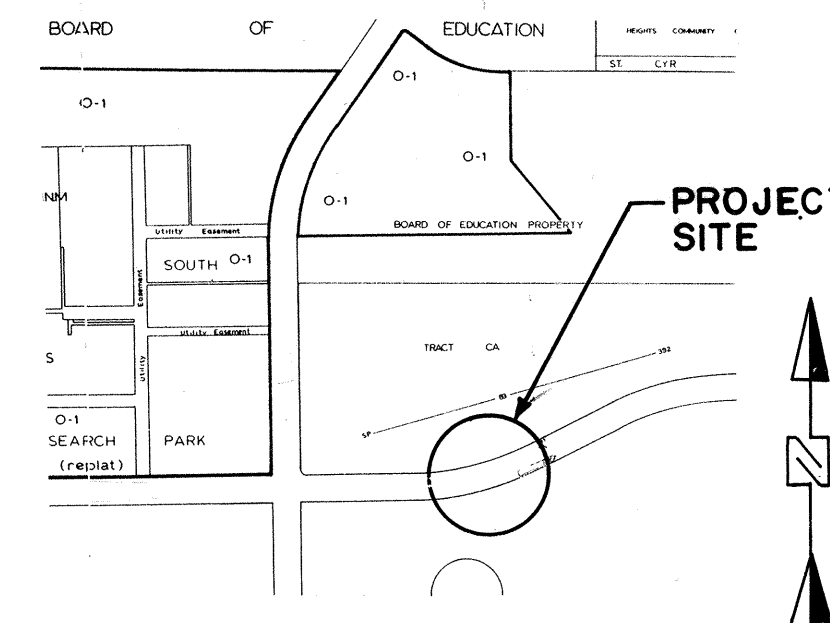

LOCATION MAP NO. - L-15

GENERAL NOTES:

1. ALL WORK DETAILED ON THESE PLANS TO BE PERFORMED UNDER CONTRACT SHALL, EXCEPT AS OTHERWISE STATED OR PROVIDED FOR HEREON, BE CONSTRUCTED IN ACCORDANCE WITH THE CITY OF ALBUQUERQUE INTERIM STANDARD SPECIFICATIONS - PUBLIC WORKS CONSTRUCTION - 1985.
2. TWO (2) WORKING DAYS PRIOR TO ANY EXCAVATION, CONTRACTOR MUST CONTACT LINE LOCATING SERVICE, 765-1234, FOR LOCATION OF EXISTING UTILITIES.
3. IF ANY UTILITY LINES, PIPELINES, OR UNDERGROUND UTILITY LINES ARE SHOWN ON THESE DRAWINGS, THEY ARE SHOWN IN AN APPROXIMATE MANNER ONLY, AND SUCH LINES MAY EXIST WHERE NONE ARE SHOWN. IF ANY SUCH EXISTING LINES ARE SHOWN, THE LOCATION IS BASED UPON INFORMATION PROVIDED BY THE OWNER OF SAID UTILITY, AND THE INFORMATION MAY BE INCOMPLETE, OR MAY BE OBSOLETE BY THE TIME CONSTRUCTION COMMENCES. THE ENGINEER HAS UNDERTAKEN NO FIELD VERIFICATION OF THE LOCATION, DEPTH, SIZE, OR TYPE OF EXISTING UTILITY LINES, PIPELINES, OR UNDERGROUND UTILITY LINES, AND ASSUMES NO RESPONSIBILITY OR LIABILITY THEREFOR. THE CONTRACTOR SHALL INFORM ITSELF OF THE LOCATION OF ANY UTILITY LINE, PIPELINE, OR UNDERGROUND UTILITY LINE IN OR NEAR THE AREA OF THE WORK IN ADVANCE OF AND DURING EXCAVATION WORK. THE CONTRACTOR IS FULLY RESPONSIBLE FOR ANY AND ALL DAMAGE CAUSED BY ITS FAILURE TO LOCATE, IDENTIFY AND PRESERVE ANY AND ALL EXISTING UTILITIES, PIPELINES, AND UNDERGROUND UTILITY LINES. IN PLANNING AND CONDUCTING EXCAVATION, THE CONTRACTOR SHALL COMPLY WITH STATE STATUTES, MUNICIPAL AND LOCAL ORDINANCES, RULES AND REGULATIONS, IF ANY, PERTAINING TO THE LOCATION OF THESE LINES AND FACILITIES.
4. SHOULD A CONFLICT EXIST BETWEEN THESE PLANS AND ACTUAL FIELD CONDITIONS, THE CONTRACTOR SHALL PROMPTLY NOTIFY THE ENGINEER IN WRITING SO THAT THE CONFLICT CAN BE RESOLVED WITH A MINIMUM AMOUNT OF DELAY FOR ALL PARTIES.
5. THE CONTRACTOR SHALL MAINTAIN ACCESS TO ADJACENT PROPERTIES DURING CONSTRUCTION.
6. ALL WORK ON THIS PROJECT SHALL BE PERFORMED IN ACCORDANCE WITH APPLICABLE FEDERAL, STATE AND LOCAL LAWS, RULES AND REGULATIONS CONCERNING CONSTRUCTION SAFETY AND HEALTH.
7. THE CONTRACTOR MUST SUBMIT A CONSTRUCTION SIGNING AND BARRICADING PLAN TO TRAFFIC ENGINEERING TO RECEIVE A BARRICADING PERMIT 48 HOURS PRIOR TO CONSTRUCTION.
8. ALL UTILITIES AND UTILITY SERVICE LINES SHALL BE INSTALLED PRIOR TO PAVING.
9. BACKFILL COMPACTION SHALL BE ACCORDING TO SPECIFIED STREET USE.
10. TACK COAT REQUIREMENTS SHALL BE DETERMINED BY THE CITY ENGINEER.
11. SIDEWALKS AND WHEELCHAIR RAMPS WITHIN THE CURB RETURNS SHALL BE CONSTRUCTED WHEREVER A NEW CURB RETURN IS CONSTRUCTED.
12. IF CURB IS DEPRESSED FOR A DRIVEPAD OR A HANDICAP RAMP, THE DRIVEPAD OR RAMP SHALL BE CONSTRUCTED PRIOR TO ACCEPTANCE OF THE CURB AND GUTTER.
13. ALL STORM DRAINAGE FACILITIES SHALL BE COMPLETED PRIOR TO FINAL ACCEPTANCE.
14. All stationing shall be based on construction centerline.
15. Painting for traffic striping shall be conducted by owner.

1 2 3 4 5 6 7 8 9 10 11 12
26 31310587

SCANNED
BY

SCANNED
BY


REV.	SHEETS	CITY ENGINEER	DATE	USER DEPT.	DATE	USER DEPT.	DATE
APPROVAL OF REVISIONS							

	CITY OF ALBUQUERQUE		APPROVED FOR CONSTRUCTION <i>[Signature]</i> CITY ENGINEER 7/6/87
	DRAWING NO. 3131	SHEET OF 58 26	


CURVE DATA				
①	R	Δ	T	L
①	156'	20°13'34"	27.82'	55.07'
②	144'	16°15'37"	20.57'	40.87'
③	30'	180°	9.42'	
④	15'	169°44'32"	8.40'	1.18'
⑤	990'	26°25'30"	232.56'	456.59'

SPORTS STADIUM

NOTE:
STATIONING IS ALONG C. OF STADIUM BLVD.

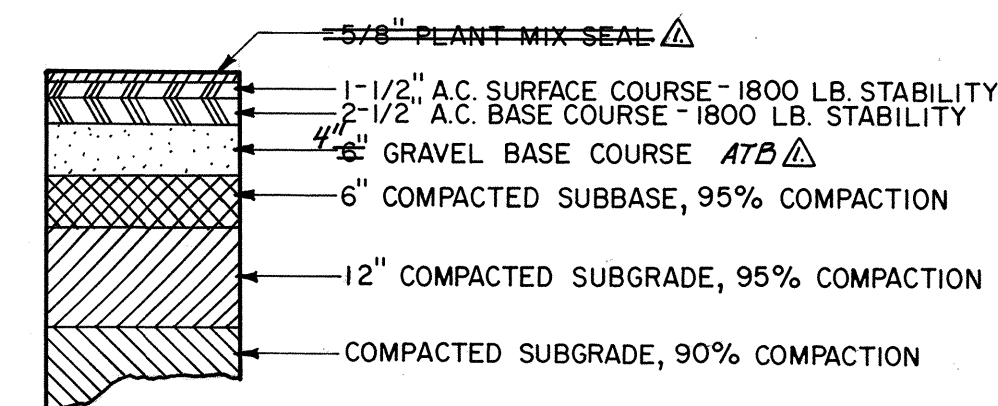

PAVEMENT SECTION

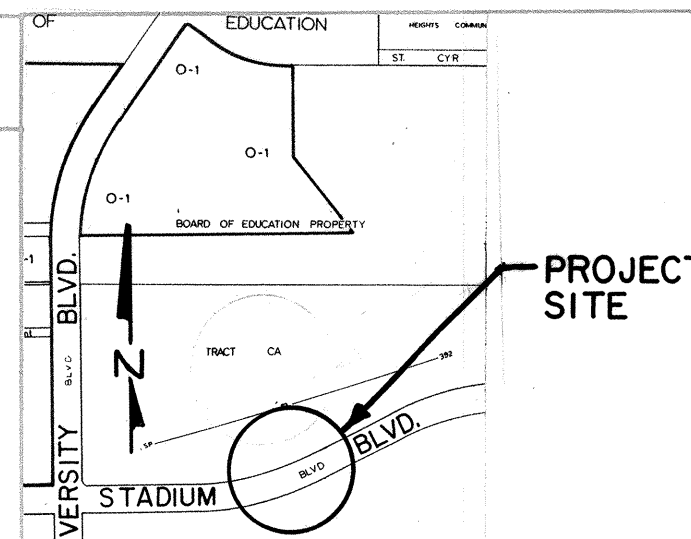

SCALE: 1"=800' LOCATION MAP L-15

CONSTRUCTION NOTES

- REMOVE EXISTING CONCRETE MEDIAN CURB & GUTTER AND EXIST. PAVEMENT AS SHOWN ON PLAN. EXACT LINES OF REMOVAL SHALL BE DETERMINED BY PROJECT ENGINEER.
- CONSTRUCT NEW CONCRETE MEDIAN CURB & GUTTER PER STANDARD DWG. P-8.
- INSTALL 4" CONCRETE MEDIAN NOSE SECTION AS SHOWN.
- INSTALL NEW ARTERIAL TYPE PAVING PER PAVING SECTION SHOWN HEREON.
- REMOVE EXISTING A.C. AND CONCRETE MEDIAN PAVING.
- INSTALL 2" A.C. MEDIAN PAVING.

LEGEND

MATERIALS

CONCRETE

RIP-RAP

UTILITIES

SUBDIVISION BOUNDARY

PROPERTY LINE (PLAN)

PROPERTY LINE (SECTION)

CENTERLINE

EASEMENT LINE

MATCH LINE

SECTION CUT LINE

CONTOUR LINE

SPOT ELEVATION

PROJECT / PHASE BOUNDARY

SWALE

DIRECTION OF FLOW

MISCELLANEOUS UTILITIES

GAS LINE

UNDERGROUND TELEPHONE

UNDERGROUND ELECTRICAL

STORM DRAIN

STORM DRAIN MANHOLE

STORM DRAIN INLET

SANITARY SEWER

SANITARY SEWER LINE

SANITARY SEWER MANHOLE

SAS SERVICE CONNECTIONS

SAS CAP OR PLUG

ENCASEMENT

WATER

WATER LINE

WATER SERVICE CONNECTIONS

GATE VALVE

FIRE HYDRANT

BUTTERFLY VALVE

REDUCER

WATER PRESSURE ZONE BOUNDARY

WATER FITTINGS

CAPS AND PLUGS

ELBOW

CROSS

TEE

MISCELLANEOUS

CHAINLINK FENCE



FIELD FENCE

COMMON YARD WALL

RETAINING WALL


POWER OR TELEPHONE POLE

TREE

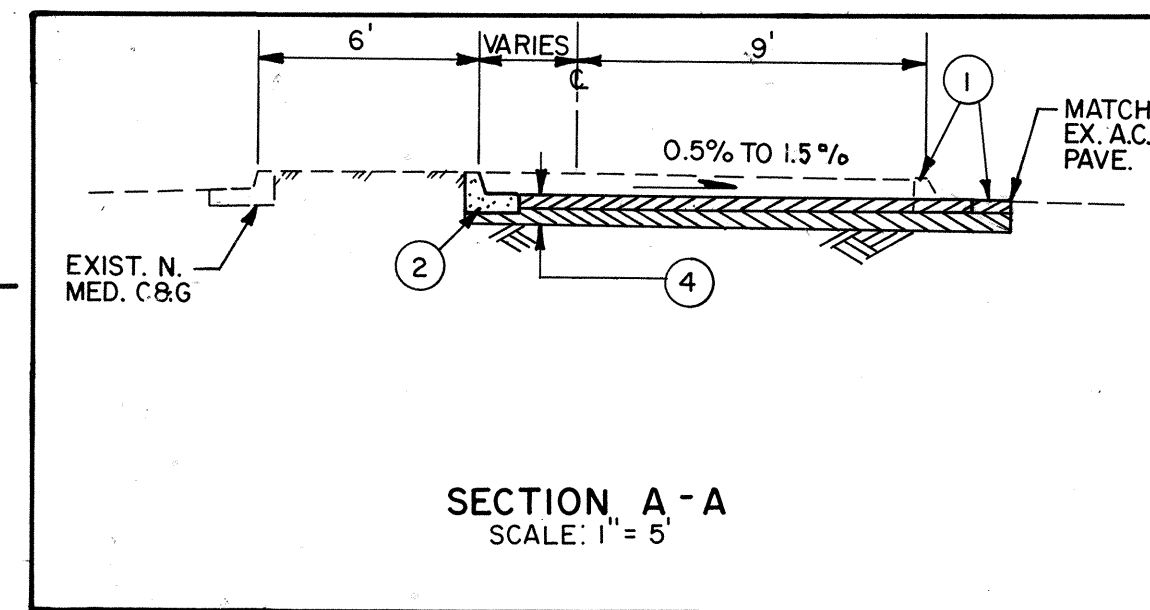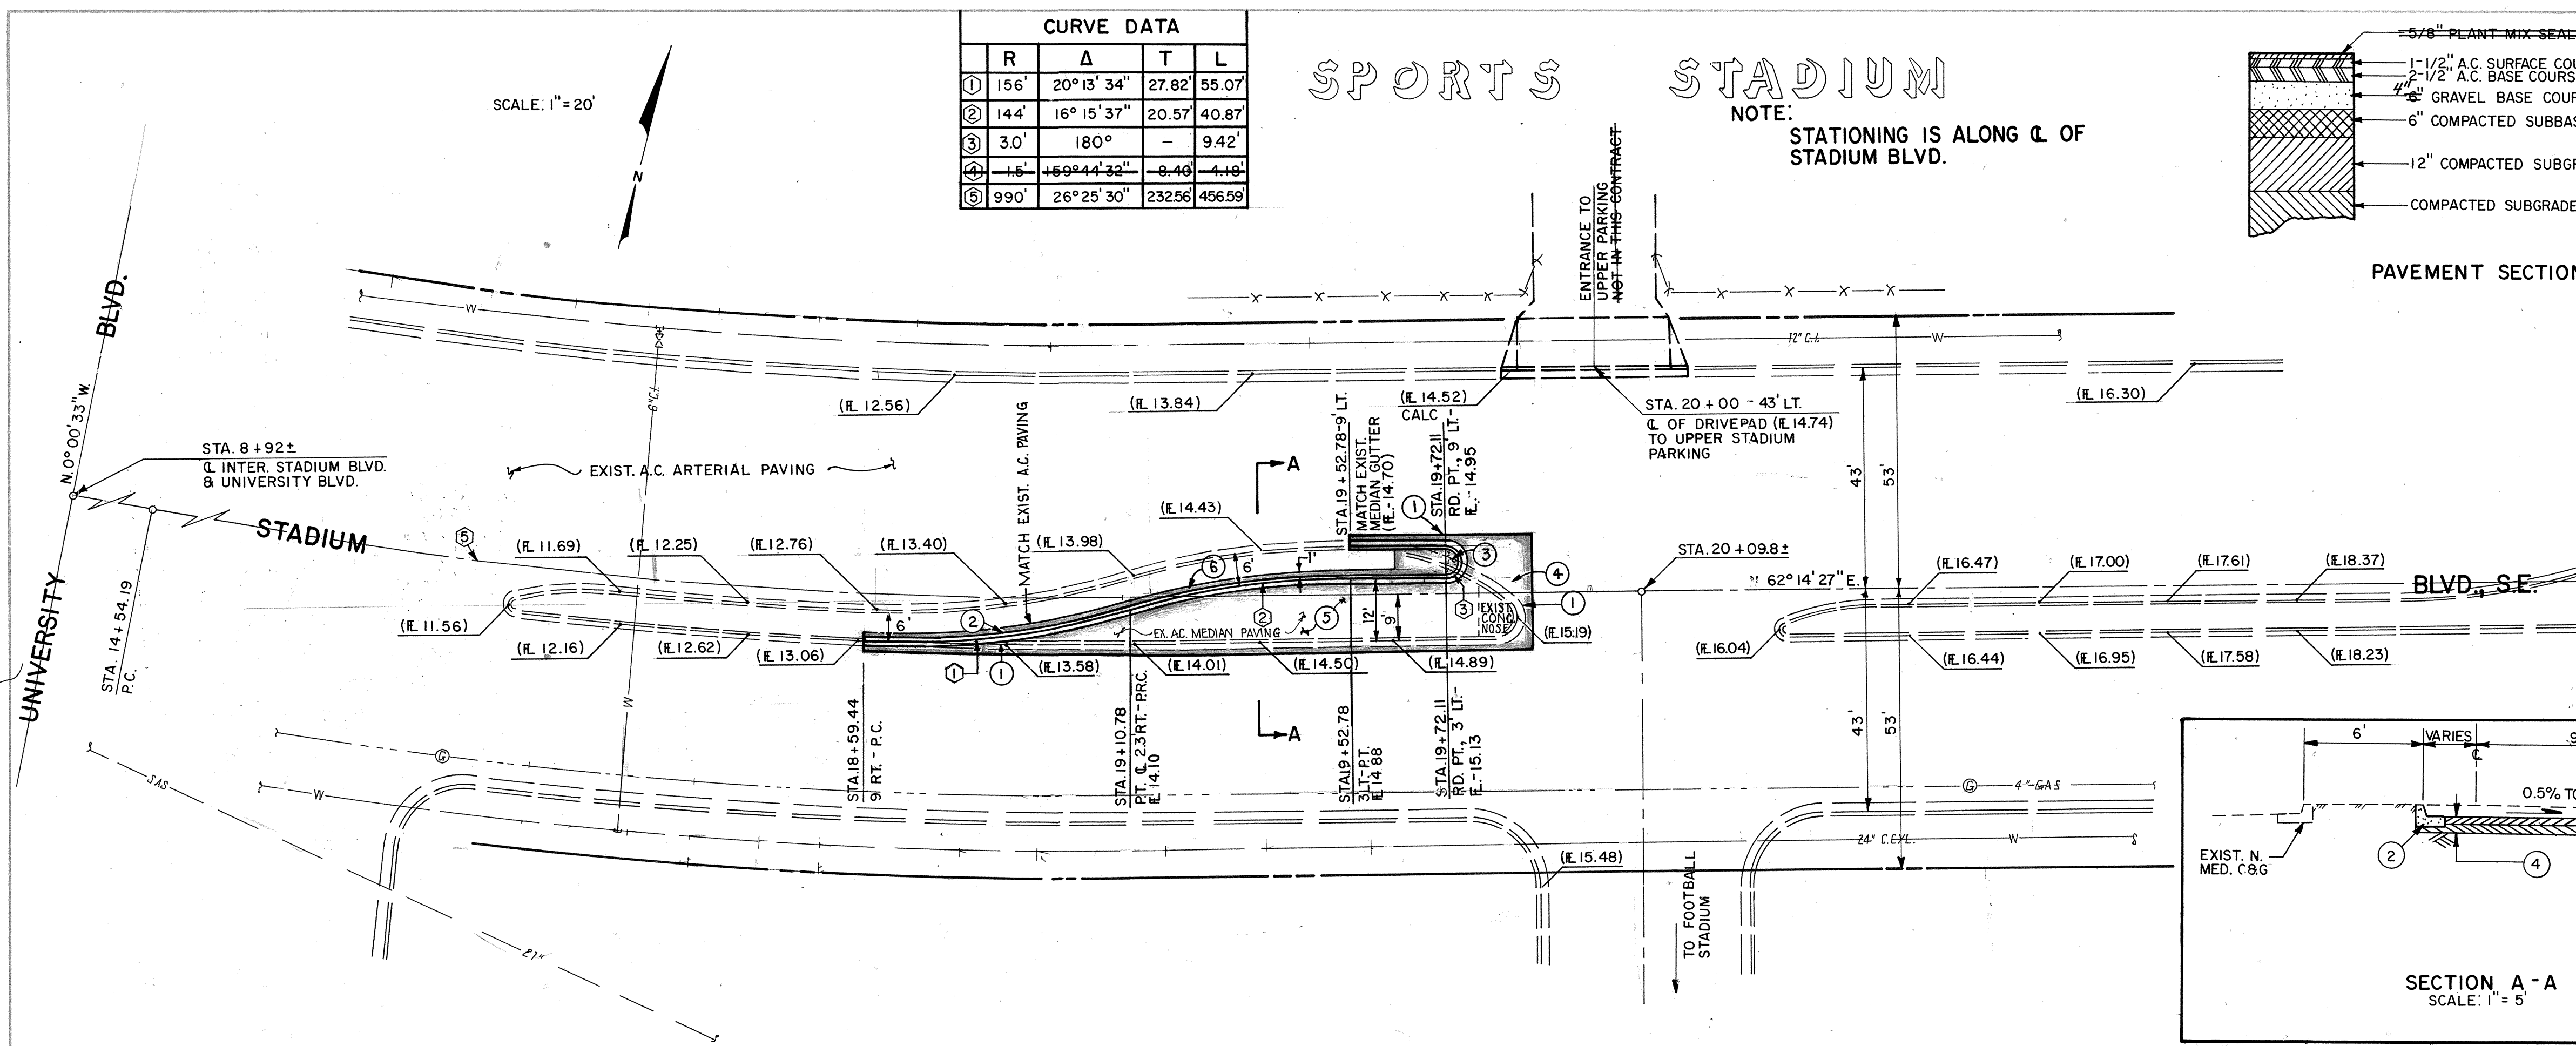

SECTION A-A
SCALE: 1"=5'

SCALE: HORIZ. 1"=20'
VERT. 1"=5'

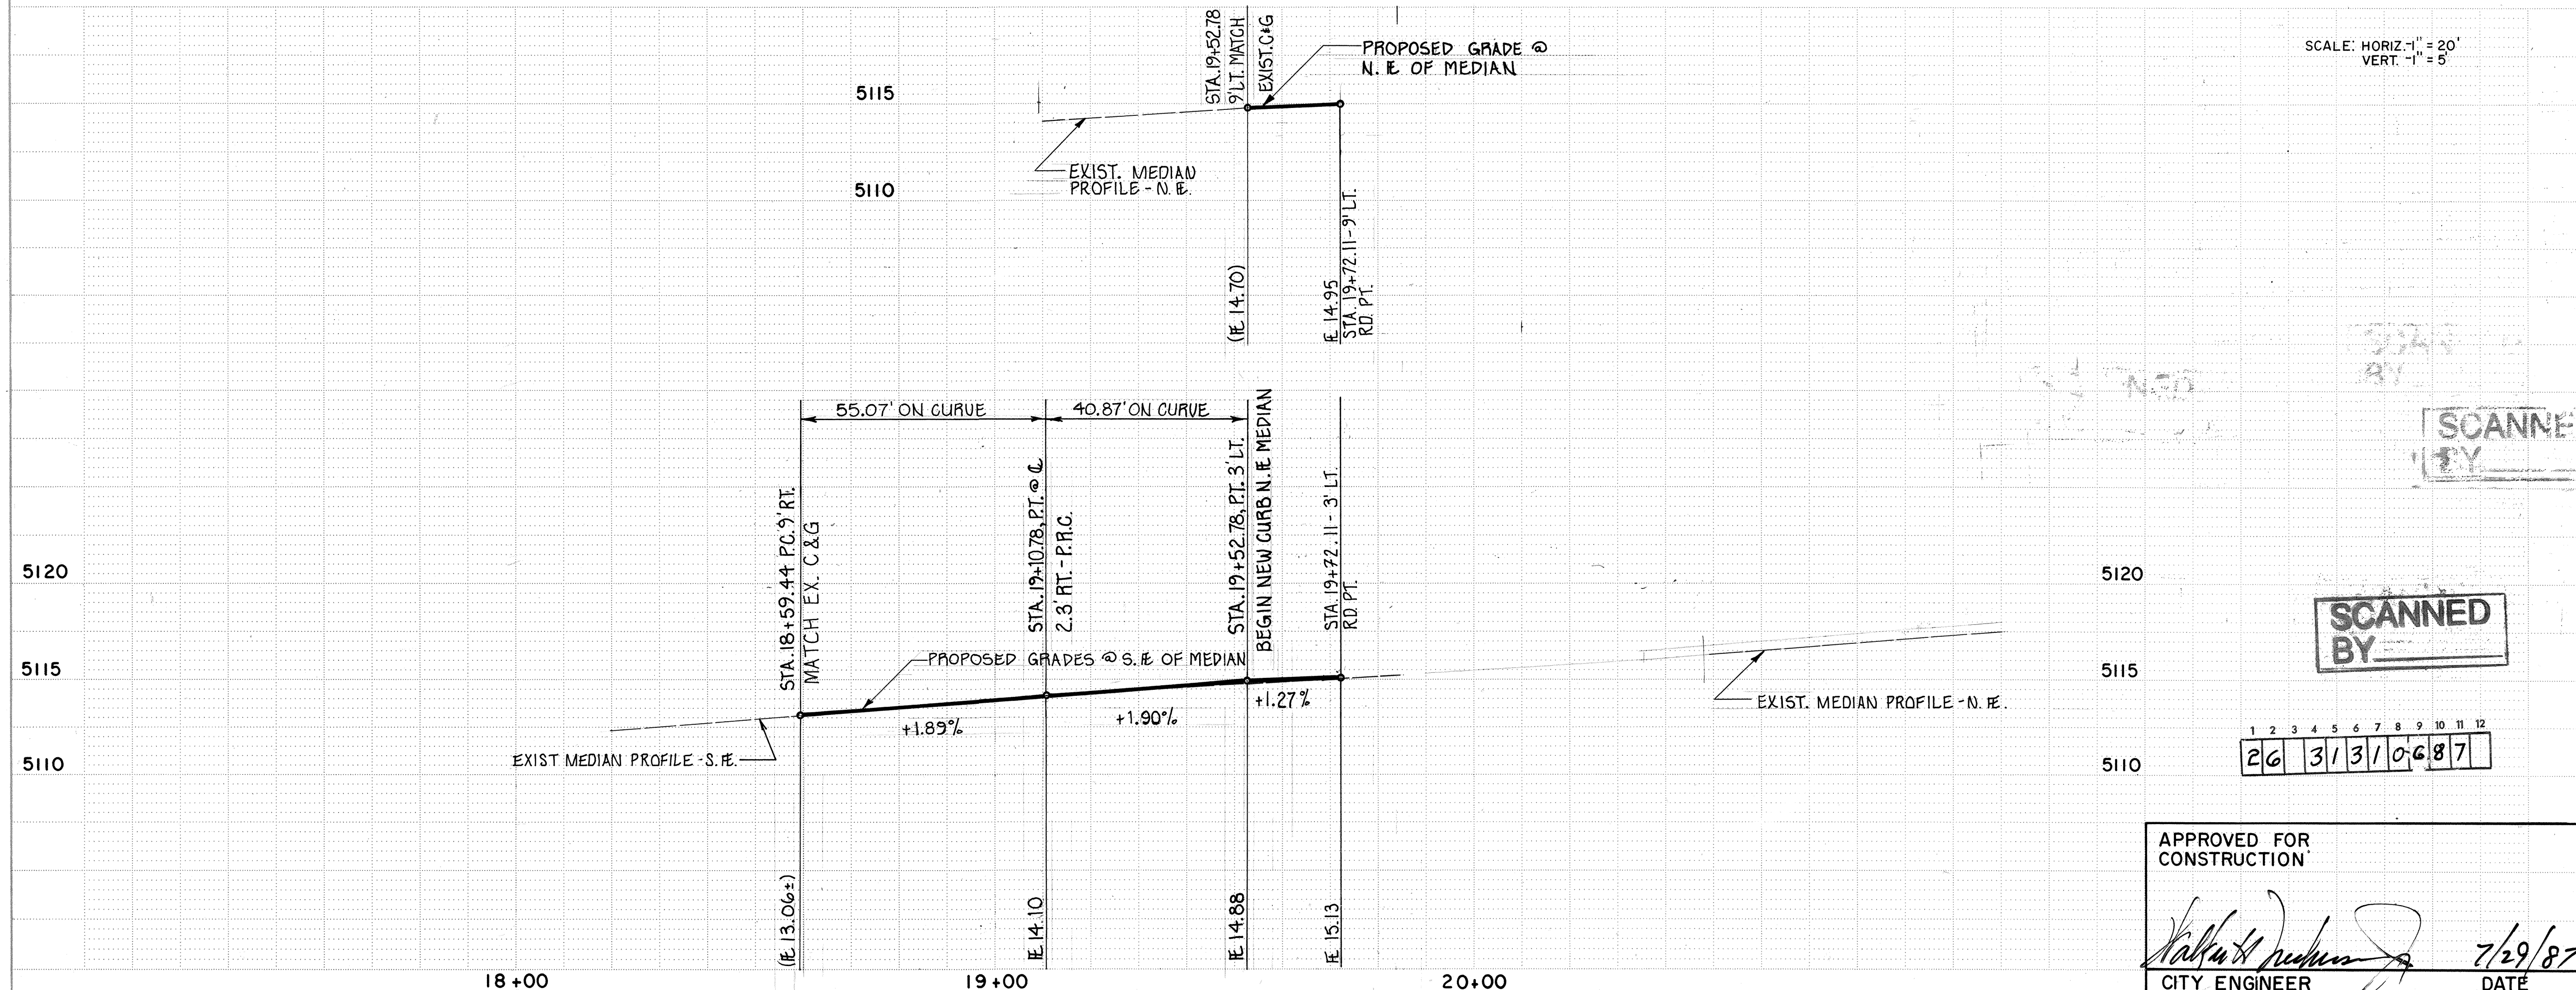

APPROVED FOR
CONSTRUCTION

CITY ENGINEER

7/29/87
DATE

TITLE:
MEDIAN MODIFICATION ON STADIUM
BOULEVARD EAST OF UNIVERSITY BOULEVARD

APPROVALS	ENGINEER	DATE	APPROVALS	ENGINEER	DATE
D.R.C. Chair					
Trans. Dev.					
Utility Dev.					

DRAWING NO.	3131	MAP NO.	L-15	SHEET	2	OF	26
-------------	------	---------	------	-------	---	----	----