

CITY OF ALBUQUERQUE



LEGAL DESCRIPTION OF PROPERTY SERVED PAT HURLEY PARK

BENCH MARK: ACS "111-A" ELEV. 5087.413' SQUARE CHISELED AT THE SOUTHWEST CORNER RETURN AT YUCCA DR & BLUEWATER DR

NOTICE TO CONTRACTOR


- An excavation/construction permit will be required before beginning any work within City right-of-way. An approved copy of these plans must be submitted at the time of application for this permit.
- All work detailed on these plans to be performed, except as otherwise stated or provided hereon, shall be constructed in accordance with City of Albuquerque Interim Standard Specifications for Public Works Construction, 1985.
- Two working days prior to any excavation, contractor must contact Line Locating Service, 765-1234, for location of existing utilities.
- Prior to construction, the contractor shall excavate and verify the horizontal and vertical locations of all structures. Should a conflict exist, the contractor shall notify the engineer so that the conflict can be resolved with a minimum amount of delay.
- Backfill compaction shall be according to residential street use.
- Maintenance of these facilities shall be the responsibility of the Owner of the property served.

RAY GACA 8/18/87 J.R. HALE

APPROVALS	ENGINEER	DATE	TITLE:
D.R.C. CHAIRPERSON	<i>[Signature]</i>	2/18/87	PAT HURLEY PARKING LOT
UTILITY DEV.	<i>[Signature]</i>	2/18/87	PROJECT NO. 3135
TRANS. DEV.	<i>[Signature]</i>	2/18/87	SHEET 1 OF 3

MAP NO. J-11Z

CITY OF ALBUQUERQUE

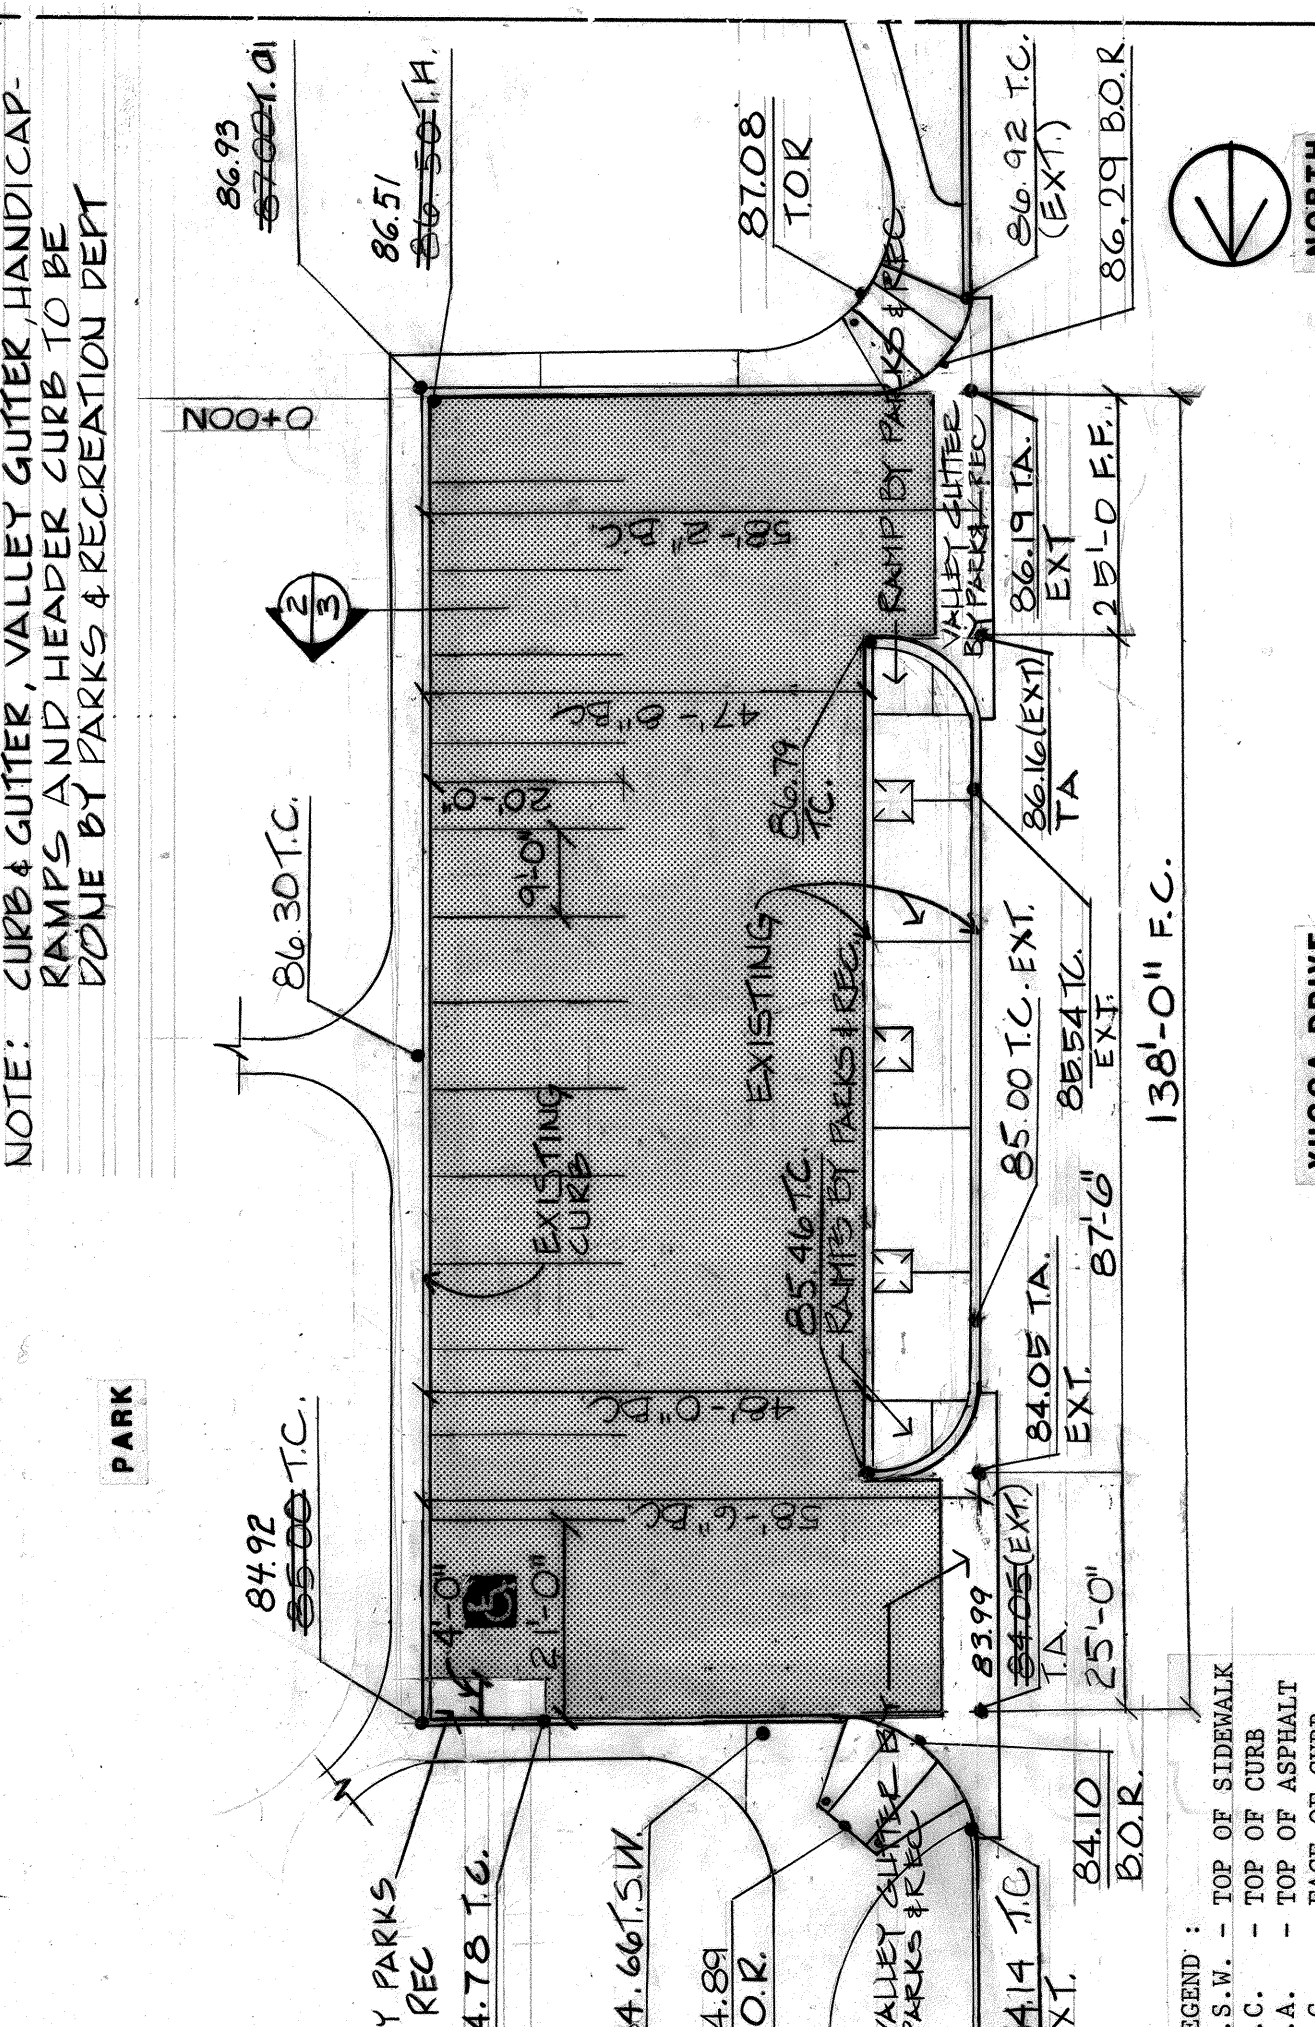


NOTE: CURB, GUTTER, VALLEY GUTTER, HANDICAP RAMP, AND HEADER CURB TO BE DONE BY PARKS & RECREATION DEPT

LEGEND:
 T.S.M. - TOP OF SIDEWALK
 T.C. - TOP OF CURB
 T.A. - TOP OF ASPHALT
 F.C. - FACE OF CURB
 T.O.R. - TOP OF RAMP
 B.O.R. - BOTTOM OF RAMP
 EXT. - EXISTING

APPROVALS	ENGINEER	DATE	TITLE:
D.R.C. CHAIRPERSON	<i>[Signature]</i>	2/18/87	PAT HURLEY PARKING LOT
UTILITY DEV.	<i>[Signature]</i>	2/18/87	PROJECT NO. 3135
TRANS. DEV.	<i>[Signature]</i>	2/18/87	SHEET 2 OF 3

MAP NO. J-11Z

CITY OF ALBUQUERQUE

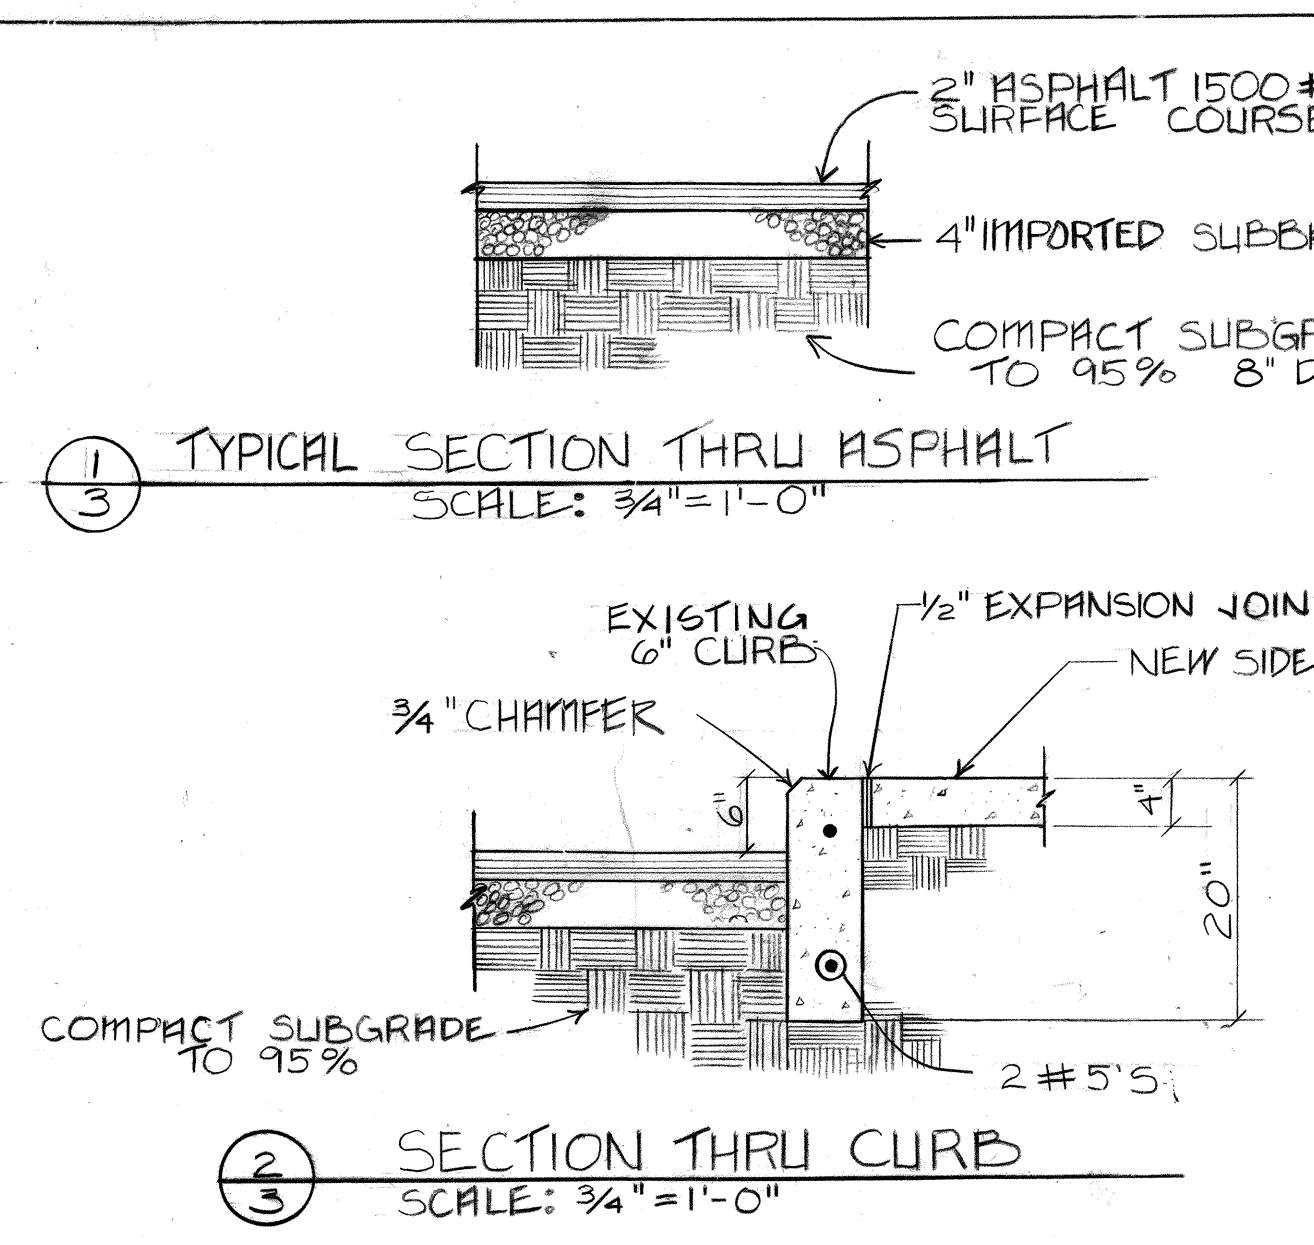

1 TYPICAL SECTION THRU ASPHALT
SCALE: 3/4" = 1'-0"

2 SECTION THRU CURB
SCALE: 3/4" = 1'-0"

APPROVALS	ENGINEER	DATE	TITLE:
D.R.C. CHAIRPERSON	<i>[Signature]</i>	2/18/87	PAT HURLEY PARKING LOT
UTILITY DEV.	<i>[Signature]</i>	2/18/87	PROJECT NO. 3135
TRANS. DEV.	<i>[Signature]</i>	2/18/87	SHEET 3 OF 3

MAP NO. J-11Z

APPROVAL OF AS BUILT DRAWINGS
 ASSY. CITY ENGINEER FIELD
[Signature]
 DATE 9-3-87

1 2 3 4 5 6 7 8 9 10 11 12
 26 31 35 01 87

SCANNED BY