


RECORD
DRAWING AS BUILT
HERITAGE EAST
UNIT SIX
ALBUQUERQUE, NEW MEXICO

INDEX TO SHEETS

SHEET NO.	DESCRIPTION
1	TITLE SHEET & INDEX TO DRAWINGS
2	PLAT OF GEOMETRY
3-5	GRADING PLANS
6-8	EROSION CONTROL PLANS
9	COMPOSITE PAVING PLAN
	<u>PAVING PLAN & PROFILES</u>
10-12	PALOMAS AVENUE, N.E.
13-14	HOLBROOK STREET, N.E.
15	ROSAS AVENUE, N.E.
16	ROSAS AVENUE, N.E. & ALLANDE ROAD, N.E.
17-18	ALLANDE ROAD, N.E.
19	VILLANUEVA DRIVE, N.E.
20	SAN BERNARDINO AVENUE, N.E.
21	MENDOZA AVENUE, N.E.
22	MENDOZA COURT, N.E. & ROSAS COURT, N.E.
23	COMPOSITE UTILITY PLAN
	<u>UTILITY PLAN AND PROFILE</u>
24-26	PALOMAS AVENUE, N.E.
27-28	HOLBROOK STREET, N.E.
29	ROSAS AVENUE, N.E.
30	ROSAS AVENUE, N.E. & ALLANDE ROAD, N.E.
31-32	ALLANDE ROAD, N.E.
33	VILLANUEVA DRIVE, N.E.
34	SAN BERNARDINO AVENUE, N.E.
35	MENDOZA AVENUE, N.E.
36	MENDOZA COURT, N.E. & ROSAS COURT, N.E.
37	STORM SEWER PLAN & PROFILE
38	STORM SEWER DETAILS
39	PEDESTRIAN BRIDGE & DETAILS

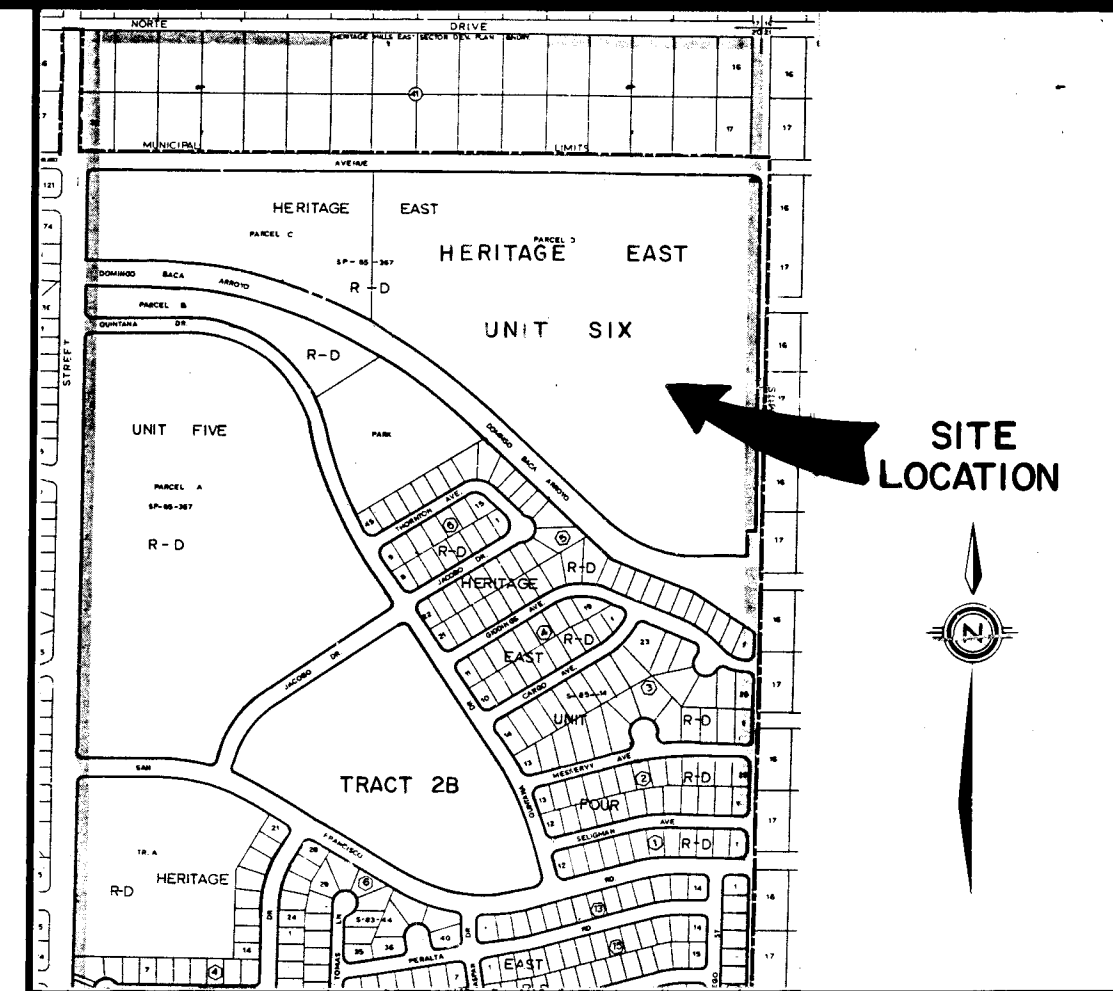

VICINITY MAP

GENERAL NOTES:


- ALL WORK DETAILED ON THESE PLANS TO BE PERFORMED UNDER CONTRACT SHALL, EXCEPT AS OTHERWISE STATED OR PROVIDED FOR HEREON, BE CONSTRUCTED IN ACCORDANCE WITH THE CITY OF ALBUQUERQUE INTERIM STANDARD SPECIFICATIONS PUBLIC WORKS CONSTRUCTION, 1985.
- TWO (2) WORKING DAYS PRIOR TO ANY EXCAVATION, CONTRACTOR MUST CONTACT LINE LOCATING SERVICE, 765-1234, FOR LOCATION OF EXISTING UTILITIES.
- PRIOR TO CONSTRUCTION, THE CONTRACTOR SHALL EXCAVATE AND VERIFY THE HORIZONTAL AND VERTICAL LOCATIONS OF ALL OBSTRUCTIONS AND EXISTING PAVEMENT. SHOULD A CONFLICT EXIST, THE CONTRACTOR SHALL NOTIFY THE ENGINEER OR SURVEYOR SO THAT THE CONFLICT CAN BE RESOLVED WITH MINIMUM AMOUNT OF DELAY.
- ALL UTILITIES AND UTILITY SERVICE LINES SHALL BE INSTALLED PRIOR TO PAVING.
- BACKFILL COMPACTION SHALL BE ACCORDING TO SPECIFIED STREET USE.
- SIDEWALKS AND WHEELCHAIR RAMPS WITHIN THE CURB RETURNS SHALL BE CONSTRUCTED WHEREVER A NEW CURB RETURN IS CONSTRUCTED.
- IF CURB IS DERESSED FOR A DRIVEPAD OR A HANDICAP RAMP, THE DRIVEPAD OR RAMP SHALL BE CONSTRUCTED PRIOR TO ACCEPTANCE OF THE CURB AND GUTTER.
- ALL STORM DRAINAGE FACILITIES SHALL BE COMPLETED PRIOR TO FINAL ACCEPTANCE.

Russell B. Smith
10-15-87

26 31400187

REV.	SHEETS	CITY ENGINEER	DATE	USER DEPARTMENT	DATE	USER DEPARTMENT	DATE
APPROVAL OF REVISIONS							

ENGINEER'S SEAL 	DATE: MAR., 1987	community services corporation	APPROVED FOR CONSTRUCTION <i>[Signature]</i> CITY ENGINEER 5/18/87 DATE
	SCALE: N.A. DESIGNED: C.S.C. DRAWN: W.J.W. JOB NO: 73-37-040		
PROJECT NO. 3140		SHEET 1 OF 39	

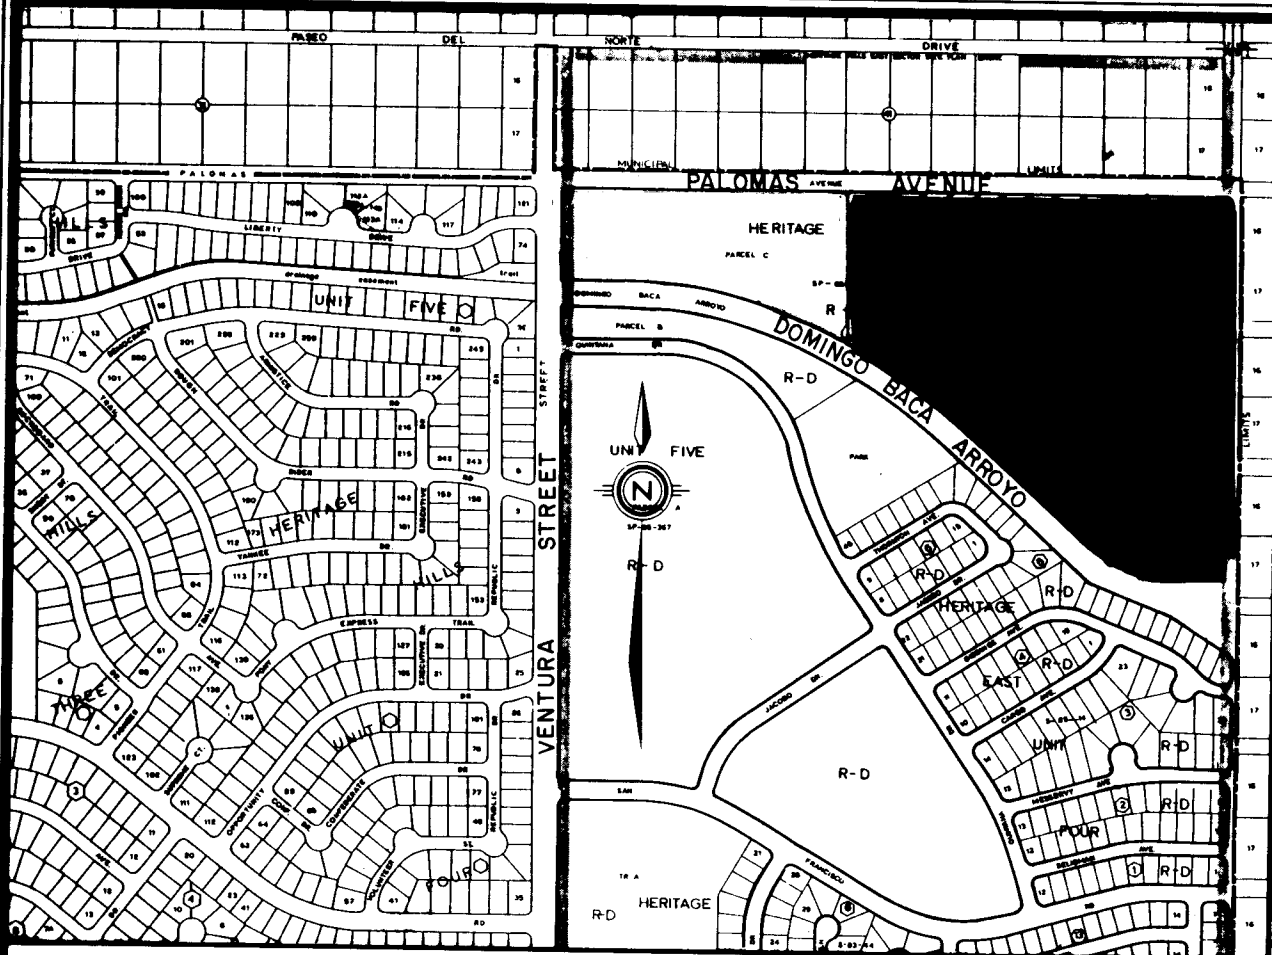

VICINITY MAP
SCALE 1"=800'

NOTES

- BEARING BASE FOR THIS PLAT IS THE RESULT OF SURVEY FOR HERITAGE HILLS EAST FILED FOR RECORD ON FEBRUARY 4, 1981 IN VOLUME C17, FOLIO 200. BEARINGS ARE REFERENCED TO GRID NORTH NEW MEXICO STATE PLANE COORDINATE SYSTEM, CENTRAL ZONE. ALL DISTANCES ARE GROUND.
- ALL DIMENSIONS PUBLISHED ALONG CURVED LINES ARE ARC DISTANCES. LOT LINES MARKED N/R ARE NON-RADIAL.
- BENCHMARK FOR THIS PLAT IS THE A.C.S. BRASS TABLET "1-C21A" SET IN TOP OF CONCRETE POST FLUSH WITH GROUND AND LOCATED AT THE NORTHEAST CORNER OF THE INTERSECTION OF LOS ANGELES DRIVE, N.E. AND HOLBROOK STREET, N.E. ELEV. = 5634.65'
- CENTERLINE (IN LIEU OF R/W) MONUMENTATION TO BE INSTALLED AT ALL CENTERLINE POINTS, PT'S, ANGLE POINTS AND STREET INTERSECTIONS PRIOR TO ACCEPTANCE OF SUBDIVISION STREET IMPROVEMENTS AND WILL CONSIST OF A FOUR (4") ALUMINUM ALLOY CAP STAMPED "CITY OF ALBUQUERQUE CENTERLINE MONUMENTATION SURVEY MARKER DO NOT DISTURB L.S. 7270"
- PUBLIC UTILITY EASEMENTS SHOWN ON THIS PLAT ARE TEN (10) FEET WIDE AND ARE GRANTED FOR THE COMMON AND JOINT USE OF:
 - THE PUBLIC SERVICE COMPANY OF NEW MEXICO FOR THE INSTALLATION, MAINTENANCE, AND SERVICE OF OVERHEAD AND UNDERGROUND ELECTRICAL LINES, TRANSFORMERS, AND OTHER EQUIPMENT AND RELATED FACILITIES REASONABLY NECESSARY TO PROVIDE ELECTRICAL SERVICE.
 - THE GAS COMPANY OF NEW MEXICO FOR INSTALLATION, MAINTENANCE, AND SERVICE OF NATURAL GAS LINES, VALVES AND OTHER EQUIPMENT AND FACILITIES REASONABLY NECESSARY TO PROVIDE NATURAL GAS.
 - MOUNTAIN BELL FOR THE INSTALLATION, MAINTENANCE AND SERVICE OF ALL BURIED AND AERIAL COMMUNICATION LINES AND OTHER RELATED EQUIPMENT AND FACILITIES REASONABLY NECESSARY TO PROVIDE COMMUNICATION SERVICES, INCLUDING BUT NOT LIMITED TO ABOVE GROUND PEDESTALS AND CLOSURES.
 - JONES INTERCABLE FOR THE INSTALLATION, MAINTENANCE, AND SERVICE OF SUCH LINES, CABLE, AND OTHER RELATED EQUIPMENT AND FACILITIES REASONABLY NECESSARY TO PROVIDE CABLE TV SERVICE.INCLUDED IS THE RIGHT OF INGRESS AND EGRESS FOR THE CONSTRUCTION AND MAINTENANCE AND THE RIGHT TO TRIM INTERFERING TREES AND SHRUBS. ALSO INCLUDED IS THE RIGHT TO INSTALL AND MAINTAIN SERVICE LINES.
- MINIMUM TEN FEET (10') SOUTH SIDEYARD SETBACKS AND MINIMUM FIVE FEET (5') NORTH SIDEYARD SETBACKS SHALL APPLY TO THE DEVELOPMENT OF THE FOLLOWING LOTS: 24, 25, 26 AND 27, BLOCK 1; 6, 10, 13, 14 AND 25, BLOCK 3; 7 AND 8, BLOCK 4; AND 9, BLOCK 6. ALL OTHER LOTS SHALL HAVE MINIMUM SIDEYARD SETBACKS AS REQUIRED BY SECTION 10-E.3 OF THE CITY ZONING CODE. ALL STRUCTURES SHALL BE SUBJECT TO THE BUILDING HEIGHT LIMITATIONS OF SECTION 40-C.1-g OF THE CITY ZONING CODE UNLESS ENERGY EFFICIENT CONSTRUCTION STANDARDS SPECIFIED IN SECTION 40-C.1.(g)(4) ARE USED AND A HEIGHT LIMIT WAIVER IS OBTAINED FROM THE ZONING ENFORCEMENT OFFICER.

SUBDIVISION DATA

SUBDIVISION CASE NO. DRB-86-200, S-86-46, V-86-90
GROSS SUBDIVISION ACRES 37.3757 AC
ZONE ATLAS INDEX NO. D-20
NO. OF EXISTING TRACTS/LOTS 1
NO. OF TRACTS/LOTS CREATED 173
MILES OF FULL-WIDTH STREETS CREATED 1.1
DATE OF SURVEY AUGUST, 1986

LEGAL DESCRIPTION

THAT CERTAIN PARCEL OF LAND SITUATE WITHIN THE ELENA GALLEGOS GRANT ("PROJECTED" SECTION 20, TOWNSHIP 11 NORTH, RANGE 4 EAST, NEW MEXICO PRINCIPAL MERIDIAN), CITY OF ALBUQUERQUE, BERNALILLO COUNTY, NEW MEXICO AND BEING COMPRISED OF ALL OF PARCEL "D", HERITAGE EAST UNIT 5 AS THE SAME IS SHOWN AND DESIGNATED ON THE PLAT ENTITLED "HERITAGE EAST UNIT 5" FILED FOR RECORD IN THE OFFICE OF THE COUNTY CLERK OF BERNALILLO COUNTY, NEW MEXICO ON AUGUST 30, 1985 IN VOLUME C28, FOLIO 43 AS DOCUMENT NO. 85 72737, TOGETHER WITH A PORTION OF THE DOMINGO BACA ARROYO RIGHT-OF-WAY, HERITAGE EAST UNIT FOUR AS THE SAME IS SHOWN AND DESIGNATED ON THE PLAT ENTITLED "HERITAGE EAST UNIT 4" FILED FOR RECORD IN THE OFFICE OF THE COUNTY CLERK OF BERNALILLO COUNTY, NEW MEXICO ON SEPTEMBER 12, 1985 IN VOLUME C28, FOLIO 56 AS DOCUMENT NO. 85 75917, AND BEING MORE PARTICULARLY DESCRIBED AS FOLLOWS:

BEGINNING AT A.C.S. "1-C21A" (BRASS CAP IN PLACE AND HAVING N.M. STATE PLANE COORDINATES, CENTRAL ZONE OF X=415,503.35 AND Y=1,518,787.29 FEET); THENCE, S89°09'41"W, 1638.67 FEET TO A POINT ON THE SOUTHERLY RIGHT-OF-WAY LINE OF PALOMAS AVENUE, N.E. (60' R.O.W.), SAID POINT BEING THE NORTHEAST CORNER OF PARCEL "C" OF THE AFOREMENTIONED HERITAGE EAST UNIT 5 AND THE NORTHWEST CORNER AND TRUE PLACE OF BEGINNING OF THE PARCEL HEREIN DESCRIBED; THENCE ALONG SAID SOUTHERLY RIGHT-OF-WAY LINE, S89°39'21"E, 1440.95 FEET TO A POINT-OF-CURVATURE (PC); THENCE LEAVING SAID SOUTHERLY RIGHT-OF-WAY LINE, SOUTHEASTERLY 47.01 FEET ALONG THE ARC OF A CURVE BEARING TO THE RIGHT (SAID ARC HAVING A RADIUS OF 30.00 FEET, A CENTRAL ANGLE OF 89°46'55" AND A CHORD THAT BEARS S44°45'53"E, 42.35 FEET) TO A POINT-OF-TANGENCY (PT) ON THE WESTERLY RIGHT-OF-WAY LINE OF HOLBROOK STREET, N.E. (60' R.O.W.); THENCE ALONG SAID WESTERLY RIGHT-OF-WAY LINE, S00°07'34"W, 1413.54 FEET TO THE SOUTHEAST CORNER OF THE PARCEL HEREIN DESCRIBED; THENCE LEAVING SAID WESTERLY RIGHT-OF-WAY LINE, N89°52'26"W, 241.03 FEET TO A POINT-OF-CURVATURE (PC) ON THE NORTHERLY RIGHT-OF-WAY LINE OF THE AFOREMENTIONED DOMINGO BACA ARROYO RIGHT-OF-WAY, HERITAGE EAST UNIT FOUR; THENCE ALONG SAID NORTHERLY RIGHT-OF-WAY LINE, NORTHWESTERLY 333.95 FEET ALONG THE ARC OF A CURVE BEARING TO THE RIGHT (SAID ARC HAVING A RADIUS OF 450.00 FEET, A CENTRAL ANGLE OF 42°31'10" AND A CHORD THAT BEARS N68°36'51"W, 326.34 FEET) TO A POINT-OF-TANGENCY (PT); THENCE N47°21'16"W, 593.84 FEET TO A POINT-OF-CURVATURE (PC); THENCE, NORTHWESTERLY 506.87 FEET ALONG THE ARC OF A CURVE BEARING TO THE LEFT (SAID ARC HAVING A RADIUS OF 3000.00 FEET, A CENTRAL ANGLE OF 09°40'50" AND A CHORD THAT BEARS N52°11'41"W, 506.27 FEET) TO A POINT-OF-COMPOUND-CURVATURE (PCC); THENCE, NORTHWESTERLY 104.53 FEET ALONG THE ARC OF A CURVE BEARING TO THE LEFT (SAID ARC HAVING A RADIUS OF 1778.43 FEET, A CENTRAL ANGLE OF 03°22'04" AND A CHORD THAT BEARS N58°43'08"W, 104.52 FEET) TO A POINT BEING THE SOUTHWEST CORNER OF THE AFOREMENTIONED PARCEL "C", HERITAGE EAST UNIT 5 AND THE SOUTHWEST CORNER OF THE PARCEL HEREIN DESCRIBED; THENCE LEAVING SAID NORTHERLY RIGHT-OF-WAY LINE, N00°20'39"E, 565.83 FEET TO THE NORTHWEST CORNER AND TRUE PLACE OF BEGINNING OF THE PARCEL HEREIN DESCRIBED. THE ABOVE DESCRIBED ENCLOSURE CONTAINS 37.3757 ACRES, MORE OR LESS.

FREE CONSENT AND DEDICATION

THE SUBDIVISION SHOWN HEREON IS WITH THE FREE CONSENT AND IN ACCORDANCE WITH THE DESIRES OF THE UNDERSIGNED OWNER(S) AND/OR PROPRIETOR(S) THEREOF AND SAID OWNERS AND/OR PROPRIETORS DO HEREBY DEDICATE ALL STREETS AND PUBLIC RIGHT-OF-WAYS SHOWN HEREON TO THE CITY OF ALBUQUERQUE IN FEE SIMPLE AND DO HEREBY GRANT: ALL UTILITY AND DRAINAGE EASEMENTS SHOWN HEREON INCLUDING THE RIGHT TO CONSTRUCT, OPERATE, INSPECT, AND MAINTAIN FACILITIES THEREIN; AND ALL PUBLIC UTILITY EASEMENTS SHOWN HEREON FOR THE COMMON AND JOINT USE OF GAS, ELECTRICAL POWER AND UNDERGROUND SERVICES FOR BURIED DISTRIBUTION LINES, CONDUITS, AND PIPES FOR UNDERGROUND UTILITIES WHERE SHOWN OR INDICATED, AND INCLUDING THE RIGHT OF INGRESS AND EGRESS FOR CONSTRUCTION AND MAINTENANCE, AND THE RIGHT TO TRIM INTERFERING TREES AND SHRUBS (SEE NOTE 5). SAID OWNER(S) AND/OR PROPRIETOR(S) DO HEREBY CONSENT TO ALL OF THE FOREGOING AND DO HEREBY CERTIFY THAT THIS SUBDIVISION IS THEIR FREE ACT AND DEED.

BELLAMAH COMMUNITY DEVELOPMENT
A NEW MEXICO GENERAL PARTNERSHIP


D.T. ROBERTSON
SENIOR VICE-PRESIDENT & REGIONAL MANAGER

STATE OF NEW MEXICO) SS
COUNTY OF BERNALILLO)

THE FOREGOING INSTRUMENT WAS ACKNOWLEDGED BEFORE ME THIS DAY OF 1987 BY D.T. ROBERTSON, SENIOR VICE-PRESIDENT & REGIONAL MANAGER OF BELLAMAH COMMUNITY DEVELOPMENT, A NEW MEXICO GENERAL PARTNERSHIP, ON BEHALF OF SAID PARTNERSHIP.

VACATION AND SUBDIVISION PLAT FOR
HERITAGE EAST UNIT SIX

SITUATE WITHIN THE ELENA GALLEGOS GRANT
("PROJECTED" SECTION 20, T11N, R4E, N.M.P.M.)
CITY OF ALBUQUERQUE
BERNALILLO COUNTY, NEW MEXICO
JANUARY, 1987

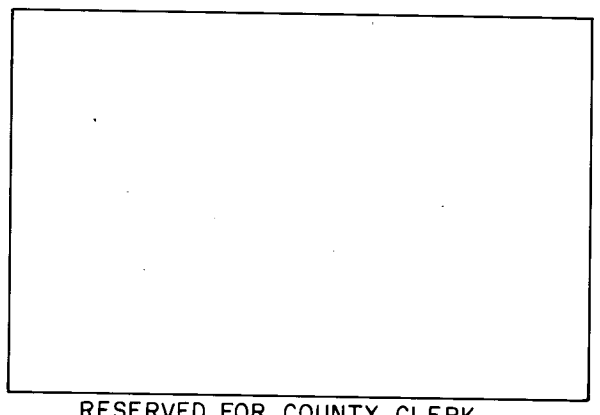

APPROVALS

SUBDIVISION CASE NUMBER _____

CITY PLANNER/ALBUQUERQUE, BERNALILLO CO. PLANNING DIVISION _____ DATE _____

PARKS AND RECREATION DEPARTMENT _____ DATE _____

TRAFFIC ENGINEER, TRANSPORTATION DEPARTMENT _____ DATE _____

CITY ENGINEER, ENGINEERING DIVISION _____ DATE _____

ALBUQUERQUE METROPOLITAN ARROYO FLOOD CONTROL AUTH. _____ DATE _____

UTILITY DEVELOPMENT DEPARTMENT _____ DATE _____

CHIEF CITY SURVEYOR, ENGINEERING DIVISION _____ DATE _____

PROPERTY MANAGEMENT _____ DATE _____

GAS COMPANY OF NEW MEXICO _____ DATE **1-28-87**

MOUNTAIN BELL _____ DATE **1-28-87**

PUBLIC SERVICE COMPANY OF NEW MEXICO _____ DATE **1-28-87**

SURVEYOR'S CERTIFICATION

I, L.A. CARLETON, JR., HEREBY AFFIRM THAT I AM A DULY QUALIFIED LAND SURVEYOR REGISTERED UNDER THE LAWS OF THE STATE OF NEW MEXICO AND DO CERTIFY THAT THIS PLAT WAS PREPARED BY ME OR UNDER MY DIRECT SUPERVISION; SHOWS ACCURATE DIMENSIONS, AND LAND AREAS; SHOWS ALL EASEMENTS OF RECORD READILY AVAILABLE TO A LAND SURVEYOR AND MADE KNOWN TO ME BY THE OWNER, UTILITY COMPANIES OR OTHER PARTIES EXPRESSING AN INTEREST. THE SURVEY MEETS THE MINIMUM REQUIREMENTS FOR MONUMENTATION AND SURVEYS OF THE ALBUQUERQUE SUBDIVISION ORDINANCE AND IS TRUE AND CORRECT TO THE BEST OF MY KNOWLEDGE AND BELIEF.

L.A. CARLETON, JR., N.M.R.L.S. #7270 _____ DATE _____


STATE OF NEW MEXICO) SS
COUNTY OF SANDOVAL)

THE FOREGOING SURVEYOR'S CERTIFICATE WAS ACKNOWLEDGED BEFORE ME THIS DAY OF _____, 1987 BY L.A. CARLETON, JR.

BY: _____ MY COMMISSION EXPIRES: _____

NOTARY PUBLIC

DATE		SHEET 1 OF 2	
JANUARY, 1987		community sciences corporation	
SCALE: N/A		C.S.C.	
DRAWN: C.S.C.		C.S.C.	
JOB NO: 73-37-025		73-37-025	

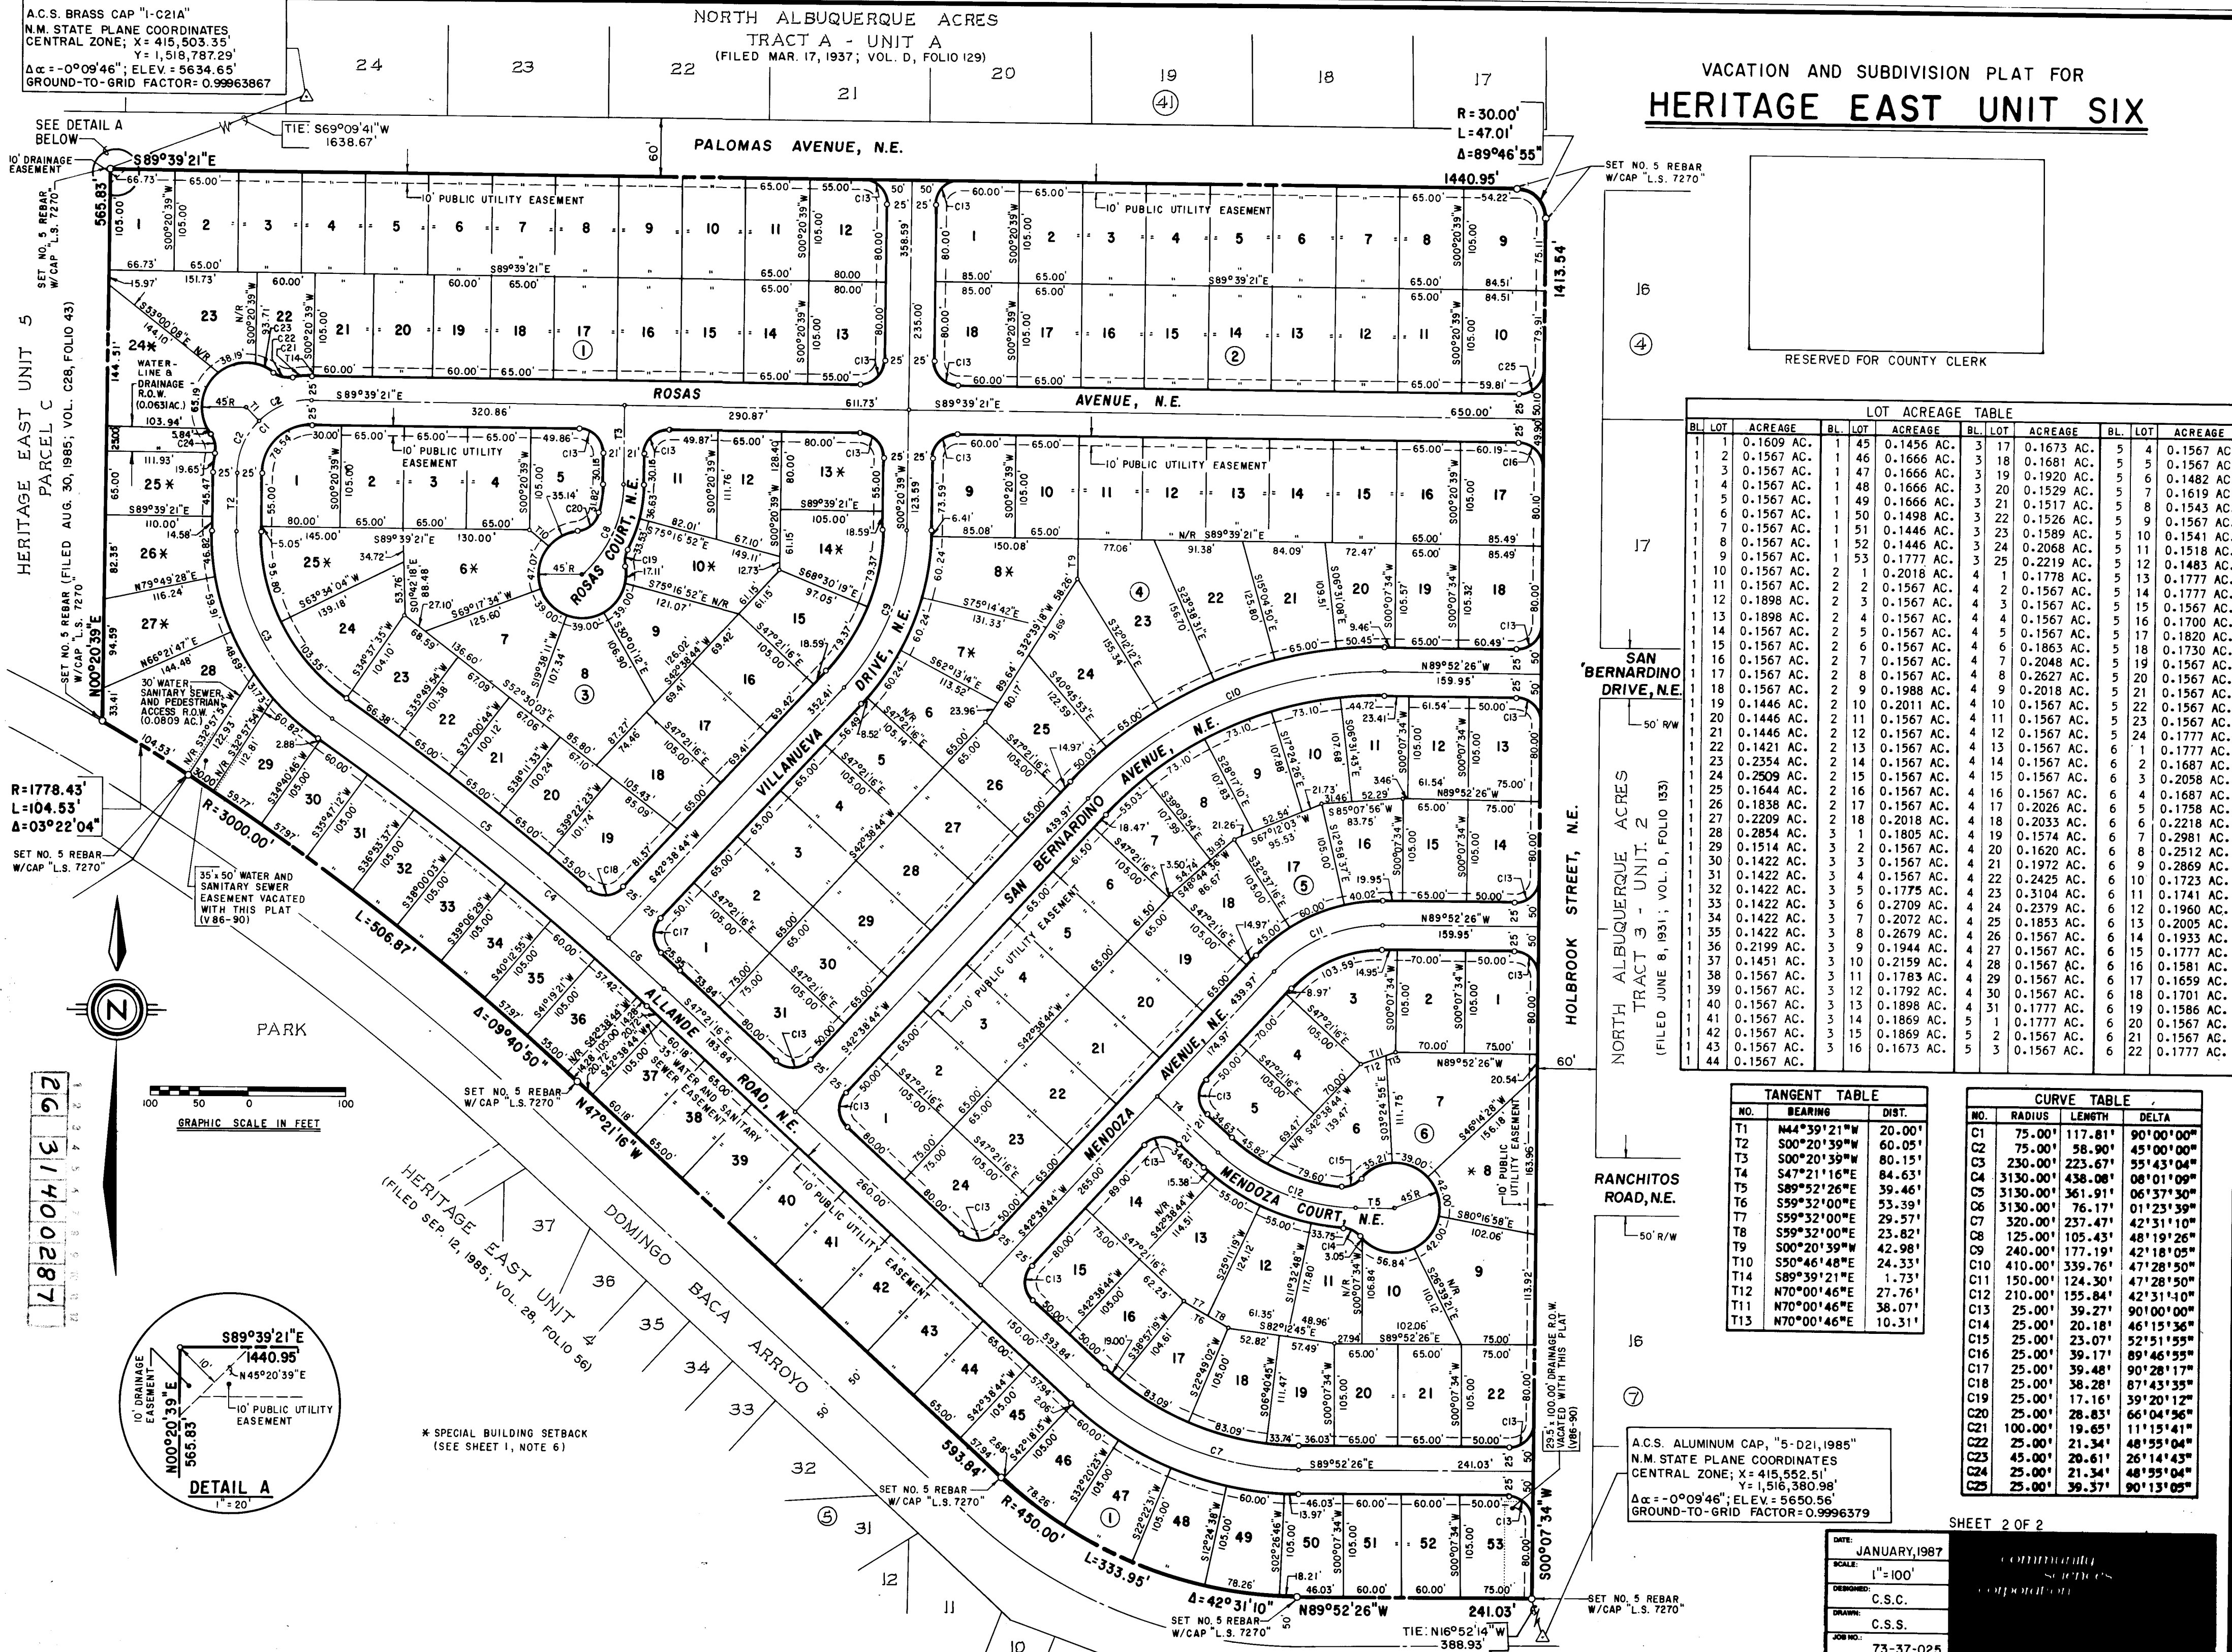

VACATION AND SUBDIVISION PLAT FOR
HERITAGE EAST UNIT SIX

SITUATE WITHIN THE ELENA GALLEGOS GRANT
("PROJECTED" SECTION 20, T11N, R4E, N.M.P.M.)
CITY OF ALBUQUERQUE
BERNALILLO COUNTY, NEW MEXICO
JANUARY, 1987

LOT ACREAGE TABLE																	
BL.	LOT	ACREAGE	BL.	LOT	ACREAGE	BL.	LOT	ACREAGE	BL.	LOT	ACREAGE	BL.	LOT	ACREAGE	BL.	LOT	ACREAGE
1	1	0.1609 AC.	1	45	0.1456 AC.	3	17	0.1673 AC.	5	4	0.1567 AC.	1	1	0.1609 AC.	1	45	0.1456 AC.
1	2	0.1567 AC.	1	46	0.1666 AC.	3	18	0.1681 AC.	5	5	0.1567 AC.	2	2	0.1567 AC.	2	2	0.1567 AC.
1	3	0.1567 AC.	1	47	0.1666 AC.	3	19	0.1681 AC.	5	6	0.1482 AC.	3	3	0.1567 AC.	3	3	0.1567 AC.
4	4	0.1567 AC.	1	48	0.1666 AC.	3	20	0.1529 AC.	5	7	0.1619 AC.	4	4	0.1567 AC.	4	4	0.1567 AC.
5	5	0.1567 AC.	1	49	0.1666 AC.	3	21	0.1517 AC.	5	8	0.1543 AC.	5	5	0.1567 AC.	5	5	0.1567 AC.
6	6	0.1567 AC.	1	50	0.1498 AC.	3	22	0.1526 AC.	5	9	0.1567 AC.	6	6	0.1567 AC.	6	6	0.1567 AC.
7	7	0.1567 AC.	1	51	0.1446 AC.	3	22	0.1526 AC.	5	10	0.1541 AC.	7	7	0.1567 AC.	7	7	0.1567 AC.
8	8	0.1567 AC.	1	52	0.1446 AC.	3	24	0.2068 AC.	5	11	0.1518 AC.	8	8	0.1567 AC.	8	8	0.1567 AC.
9	9	0.1567 AC.	1	53	0.1777 AC.	3	25	0.2219 AC.	5	12	0.1483 AC.	9	9	0.1567 AC.	9	9	0.1567 AC.
10	10	0.1567 AC.	2	1	0.2018 AC.	4	1	0.1778 AC.	5	13	0.1777 AC.	10	10	0.1567 AC.	10	10	0.1567 AC.
11	11	0.1567 AC.	2	2	0.1567 AC.	4	2	0.1567 AC.	5	14	0.1777 AC.	11	11	0.1567 AC.	11	11	0.1567 AC.
12	12	0.1898 AC.	2	3	0.1567 AC.	4	3	0.1567 AC.	5	15	0.1567 AC.	12	12	0.1898 AC.	12	12	0.1898 AC.
13	13	0.1898 AC.	2	4	0.1567 AC.	4	4	0.1567 AC.	5	16	0.1700 AC.	13	13	0.1898 AC.	13	13	0.1898 AC.
14	14	0.1567 AC.	2	5	0.1567 AC.	4	5	0.1567 AC.	5	17	0.1820 AC.	14	14	0.1567 AC.	14	14	0.1567 AC.
15	15	0.1567 AC.	2	6	0.1567 AC.	4	6	0.1863 AC.	5	18	0.1730 AC.	15	15	0.1567 AC.	15	15	0.1567 AC.
16	16	0.1567 AC.	2	7	0.1567 AC.	4	7	0.2048 AC.	5	19	0.1567 AC.	16	16	0.1567 AC.	16	16	0.1567 AC.
17	17	0.1567 AC.	2	8	0.1567 AC.	4	8	0.2627 AC.	5	20	0.1567 AC.	17	17	0.1567 AC.	17	17	0.1567 AC.
18	18	0.1567 AC.	2	9	0.1988 AC.	4	9	0.2018 AC.	5	21	0.1567 AC.	18	18	0.1567 AC.	18	18	0.1567 AC.
19	19	0.1446 AC.	2	10	0.2011 AC.	4	10	0.1567 AC.	5	22	0.1567 AC.	19	19	0.1446 AC.	19	19	0.1446 AC.
20	20	0.1446 AC.	2	11	0.1567 AC.	4	11	0.1567 AC.	5	23	0.1567 AC.	20	20	0.1446 AC.	20	20	0.1446 AC.
21	21	0.1446 AC.	2	12	0.1567 AC.	4	12	0.1567 AC.	5	24	0.1777 AC.	21	21	0.1446 AC.	21	21	0.1446 AC.
22	22	0.1421 AC.	2	13	0.1567 AC.	4	13	0.1567 AC.	5	25	0.1777 AC.	22	22	0.1421 AC.	22	22	0.1421 AC.
23	23	0.2354 AC.	2	14	0.1567 AC.	4	14	0.1567 AC.	5	26	0.1777 AC.	23	23	0.2354 AC.	23	23	0.2354 AC.
24	24	0.2509 AC.	2	15	0.1567 AC.	4	15	0.1567 AC.	5	27	0.2058 AC.	24	24	0.2509 AC.	24	24	0.2509 AC.
25	25	0.1644 AC.	2	16	0.1567 AC.	4	16	0.1567 AC.	5	28	0.1687 AC.	25	25	0.1644 AC.	25	25	0.1644 AC.
26	26	0.1838 AC.	2	17	0.1567 AC.	4	17	0.2026 AC.	5	29	0.1567 AC.	26	26	0.1838 AC.	26	26	0.1838 AC.
27	27	0.2209 AC.	2	18	0.2018 AC.	4	18	0.2033 AC.	5	30	0.1567 AC.	27	27	0.2209 AC.	27	27	0.2209 AC.
28	28	0.2854 AC.	2	19	0.1805 AC.	4	19	0.1574 AC.	5	31	0.1567 AC.	28	28	0.2854 AC.	28	28	0.2854 AC.
29	29	0.1514 AC.	3	2	0.1567 AC.	4	20	0.1620 AC.	5	32	0.2512 AC.	29	29	0.1514 AC.	29	29	0.1514 AC.
30	30	0.1422 AC.	3	3	0.1567 AC.	4	21	0.1972 AC.	5	33	0.2869 AC.	30	30	0.1422 AC.	30	30	0.1422 AC.
31	31	0.1422 AC.	3	4	0.1567 AC.	4	22	0.2425 AC.	5	34	0.1777 AC.	31	31	0.1422 AC.	31	31	0.1422 AC.
32	32	0.1422 AC.	3	5	0.1775 AC.	4	23	0.3104 AC.	5	35	0.1567 AC.	32	32	0.1422 AC.	32	32	0.1422 AC.
33	33	0.1422 AC.	3	6	0.2709 AC.	4	24	0.2379 AC.	5	36	0.1567 AC.	33	33	0.1422 AC.	33	33	0.1422 AC.
34	34	0.1422 AC.	3	7	0.2072 AC.	4	25	0.1567 AC.	5	37	0.1567 AC.	34	34	0.1422 AC.	34	34	0.1422 AC.
35	35	0.1422 AC.	3	8	0.2679 AC.	4	26	0.1567 AC.	5	38	0.1567 AC.	35	35	0.1422 AC.	35	35	0.1422 AC.
36	36	0.2199 AC.	3	9	0.1944 AC.	4	27	0.1567 AC.	5	39	0.1567 AC.	36	36	0.2199 AC.	36	36	0.2199 AC.
37	37	0.1121 AC.	4	10	0.2178 AC.	4	28	0.1567 AC.	5	40	0.1567 AC.	37	37	0.1121 AC.	37	37	0.1121 AC.
38	38	0.1567 AC.	3	11	0.1873 AC.	4	29	0.1567 AC.	5	41	0.1567 AC.	38	38	0.1567 AC.	38	38	0.1567 AC.
39	39	0.1567 AC.	3	12	0.1792 AC.	4	30	0.1567 AC.	5	42	0.1567 AC.	39	39	0.1567 AC.	39	39	0.1567 AC.
40	40	0.1567 AC.	3	13	0.1898 AC.	4	31	0.1777 AC.	5	43	0.1567 AC.	40	40	0.1567 AC.	40	40	0.1567 AC.
41	41	0.1567 AC.	3	14	0.1869 AC.	5	1	0.1777 AC.	6	1	0.1567 AC.	41	41	0.1567 AC.	41	41	0.1567 AC.
42	42	0.1567 AC.	3	15	0.1873 AC.	5	2	0.1567 AC.	6	2	0.1567 AC.	42	42	0.1567 AC.	42	42	0.1567 AC.
43	43	0.1567 AC.	3	16	0.1673 AC.	5	3	0.1567 AC.	6	3	0.1567 AC.	43	43	0.1567 AC.	43	43	0.1567 AC.
44	44	0.1567 AC.	3	17	0.1673 AC.	5	4	0.1567 AC.	6	4	0.1567 AC.	44	44	0.1567 AC.	44	44	0.1567 AC.

EARTH QUANTITIES

CUT = 99,413 CU. YD.
COMPACTED FILL = 80,002 CU. YD.

GENERAL NOTES FOR GRADING


- CONTRACTOR MUST OBTAIN TOP SOIL DISTURBANCE PERMIT PRIOR TO MASS GRADING OPERATION.
- CONTRACTOR MUST OBTAIN RETAINING WALL PERMIT PRIOR TO CONSTRUCTION OF RETAINING WALLS.
- MASS GRADING SHALL BE IN ACCORDANCE WITH EARTH WORK SPECIFICATION AS PREPARED SPECIFICALLY FOR THIS PROJECT BY F. M. FOX AND ASSOCIATES IN A REPORT ENTITLED "SUBSURFACE INVESTIGATION, HERITAGE HILLS, UNIT 6 SUBDIVISION, ALBUQUERQUE, NEW MEXICO, 6/86".

AS BUILT INFORMATION	
CONTRACTOR	WYLLIE CORPORATION
WORK STARTED BY	GUTTERREZ SURV. DATE 6-87
ACCEPTANCE BY	DATE
FIELD	DATE
REVISIONS	DATE
CORRECTED BY	DATE
RECORDED BY	DATE

SURVEY INFORMATION	
FIELD NOTES	DATE
BY	DATE
NO.	DATE

ENGINEER'S SEAL	
BY	DATE
REVISIONS	DATE
DESIGN	DATE
NO.	DATE
DATE	DATE
DATE	DATE

REMARKS	
BY	DATE
REVISIONS	DATE
DESIGN	DATE
NO.	DATE
DATE	DATE
DATE	DATE

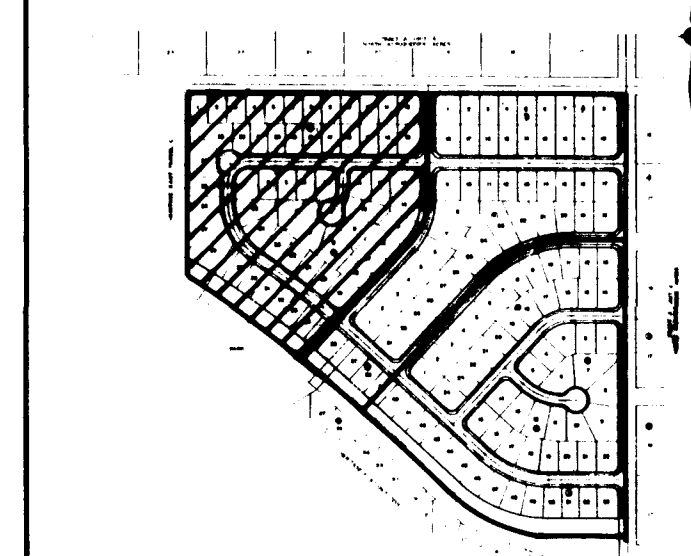

KEY MAP

RECORD DRAWING AS BUILT

SCALE
1"=50'

CITY OF ALBUQUERQUE
MUNICIPAL DEVELOPMENT DEPARTMENT
ENGINEERING DIVISION


TITLE: HERITAGE EAST-UNIT SIX
GRADING PLAN

APPROVALS	ENGINEER	DATE	APPROVALS	ENGINEER	DATE
City Engineer	4/22/87	4/22/87	Traffic	NADW4	4/22/87
A.C.E.-Design	4/22/87	4/22/87	Water Utilities	NADW4	4/22/87
A.C.E.-Hydrology	4/22/87	4/22/87			

DRAWING NO.	3140	MAP NO.	D 20	SHEET	3	OF	39
-------------	------	---------	------	-------	---	----	----



Furnish 6' wide, 4" thick crusher fine pedestrian path. Path surface shall be flush w/adjacent ground and edged w/ smooth plastic landscape edging material.

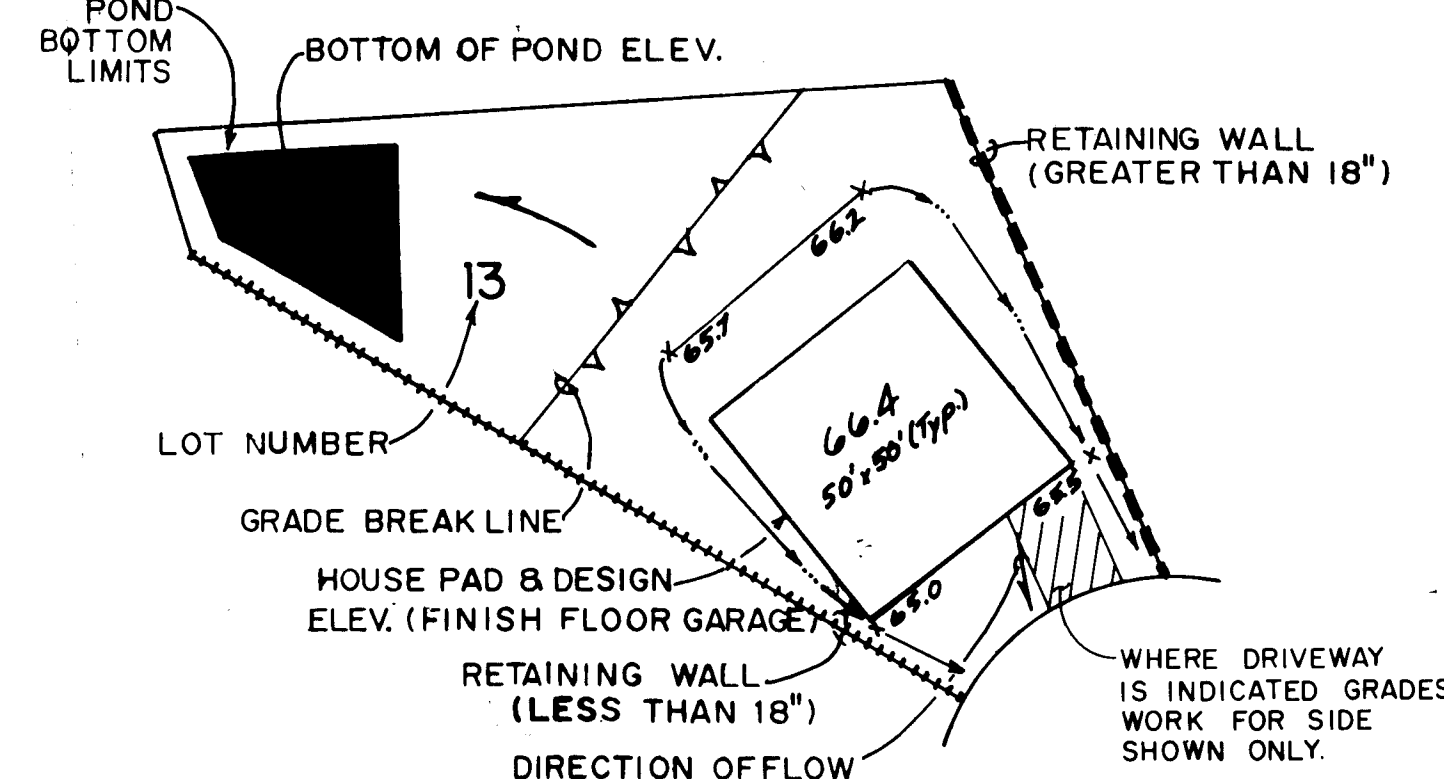

LOT LEGEND TYPICAL

NOTE: PADS ARE TO BE 50' X 50' UNLESS OTHERWISE NOTED.

APPROVED FOR ROUGH GRADING
(2 1/2 FT.)
DATE 4/22/87


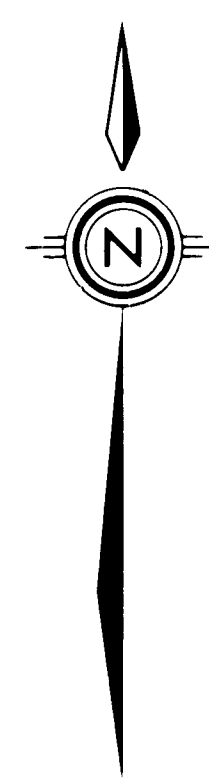


Diagram illustrating a lot layout with various features and elevations:

- LOT NUMBER 13**: Indicated by an arrow pointing to the lot.
- GRADE BREAK LINE**: A dashed line indicating a change in ground level.
- HOUSE PAD & DESIGN ELEV. (FINISH FLOOR GARAGE)**: A rectangular area labeled "60.4 50'x50' (typ)".
- RETAINING WALL (LESS THAN 18")**: A dashed line indicating a retaining wall structure.
- RETAINING WALL (GREATER THAN 18")**: A dashed line indicating a retaining wall structure.
- DIRECTION OF FLOW**: Indicated by an arrow pointing towards the bottom of the pond.
- BOTTOM OF POND ELEV.**: Indicated by an arrow pointing to the bottom of the pond.
- Elevations**: Various elevations are marked along the boundaries and within the lot, including 65.7, 66.2, 65.0, 65.6, and 65.0.
- WHERE DRIVEWAY IS INDICATED GRADES WORK FOR SIDE SHOWN ONLY.**: A note indicating that grades are shown for the side where the driveway is indicated.

EARTH QUANTITIES									
CUT = 99,413 CU. YD. COMPACTED FILL = 80,002 CU. YD.									
GENERAL NOTES FOR GRADING									
1. CONTRACTOR MUST OBTAIN TOP SOIL DISTURBANCE PERMIT PRIOR TO MASS GRADING OPERATION. 2. CONTRACTOR MUST OBTAIN RETAINING WALL PERMIT PRIOR TO CONSTRUCTION OF RETAINING WALLS. 3. MASS GRADING SHALL BE IN ACCORDANCE WITH EARTH WORK SPECIFICATION AS PREPARED SPECIFICALLY FOR THIS PROJECT BY F. M. FOX AND ASSOCIATES IN A REPORT ENTITLED "SUBSURFACE INVESTIGATION, HERITAGE HILLS, UNIT 6 SUBDIVISION, ALBUQUERQUE, NEW MEXICO, 6/86".									
KEY MAP RECORD DRAWING AS BUILT SCALE: 1"=50'									
AS BUILT INFORMATION CONTRACTOR: WYLIE CORP WORK ORDER BY: SUTTERREZ INSPECTORS: DATE 6-87 ACCEPTANCE BY: DATE VERIFICATION BY: DATE SIGNATURE BY: C.S.C. DATE 9-87 MICRO-FILM INFORMATION RECORDED BY: DATE NO. BENCH MARKS A.C.S. BRASS TABLET "11-C21A" SET IN THE TOP OF CONCRETE POST FLUSH WITH GROUND AND LOCATED AT THE NORTHEAST CORNER OF THE INTERSECTION OF PASEO DEL NORTE (LOS ANGELES DRIVE, N.E.) AND HOLBROOK STREET, N.E. ELEVATION = 5634.65'									
SURVEY INFORMATION FIELD NOTES NO. BY DATE ENGINEER'S SEAL									
REVISIONS DESIGN DESIGNED BY: M.K.S. DATE: 1-87 DRAWN BY: W.J.W. DATE: 2-87 CHECKED BY: M.K.S. DATE: 2-87 REMARKS 7-87 GRADING PLAN REVISED FOR 4255 1/2, 43, 56, 59, 60, 61, 653, 654									

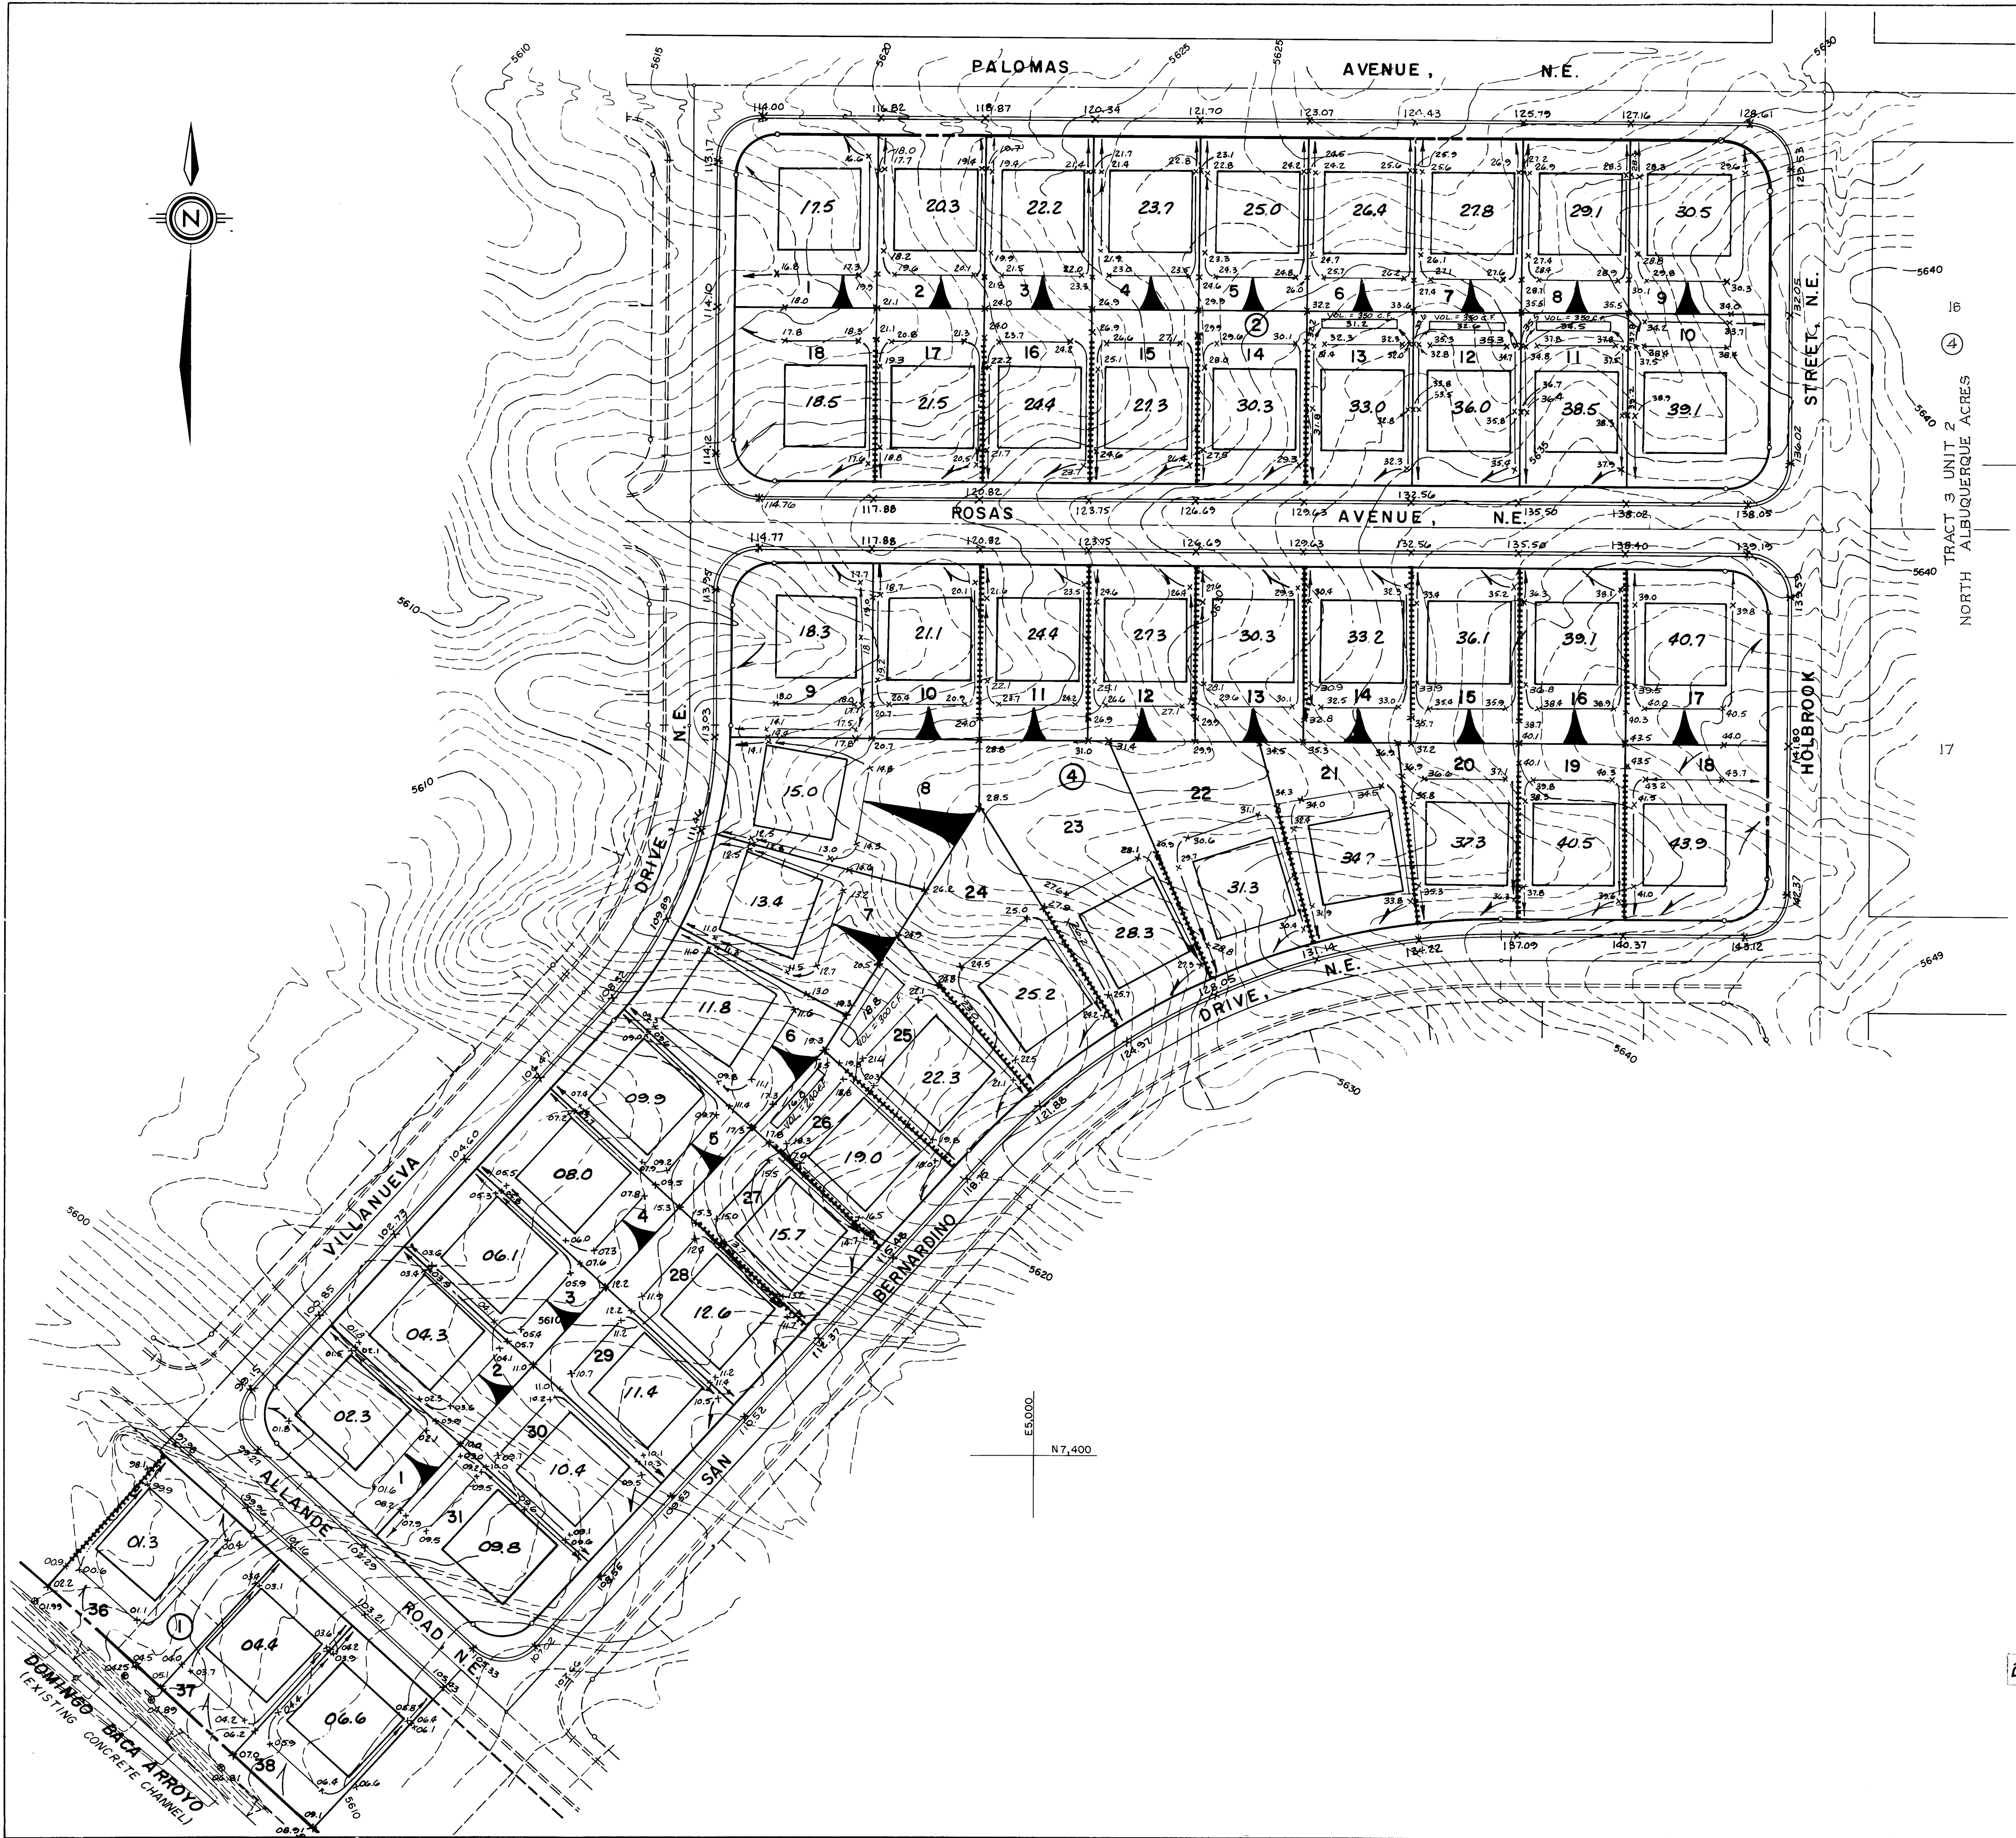


- GENERAL NOTES FOR GRADING**
1. CONTRACTOR MUST OBTAIN TOP SOIL DISTURBANCE PERMIT PRIOR TO MASS GRADING OPERATION.
 2. CONTRACTOR MUST OBTAIN RETAINING WALL PERMIT PRIOR TO CONSTRUCTION OF RETAINING WALLS.
 3. MASS GRADING SHALL BE IN ACCORDANCE WITH EARTH WORK SPECIFICATION AS PREPARED SPECIFICALLY FOR THIS PROJECT BY F. M. FOX AND ASSOCIATES IN A REPORT ENTITLED "SUBSURFACE INVESTIGATION, HERITAGE HILLS, UNIT 6 SUBDIVISION, ALBUQUERQUE, NEW MEXICO, 6/86".

ENGINEER'S SEAL		AS BUILT INFORMATION	
		BENCH MARKS	
		A.C.S. BRASS TABLE "1-221A" SET IN THE TOP OF CONCRETE POST FLUSH WITH GROUND AND LOCATED AT THE NORTHEAST CORNER OF THE INTERSECTION OF PASEO DEL NORTE (LOS ANGELES DRIVE, N.E.) AND HOLBROOK STREET, N.E. ELEVATION = 5634.65'	
REVISIONS		SURVEY INFORMATION	
NO.	DATE	FIELD NOTES	
BY	DATE	NO.	
REMARKS		BY	
DESIGNED BY M. K. S.		DATE 1-87	
DRAWN BY M. J. W.		DATE 2-87	
CHECKED BY M. K. S.		DATE 2-87	
CITY OF ALBUQUERQUE MUNICIPAL DEVELOPMENT DEPARTMENT ENGINEERING DIVISION			
TITLE: HERITAGE EAST-UNIT SIX GRADING PLAN			
APPROVALS		ENGINEER	DATE
City Engineer		<i>[Signature]</i>	4/22/87
A.C.E - Design		TWH	4-22-87
A.C.E - Hydrology		CAM	4-22-87
APPROVED FOR ROUGH GRADING (± 1 FT.)		DATE 3-2-87	
<i>[Signature]</i> CITY HYDROLOGY		DATE 3-2-87	
DRAWING NO. 3140		MAP NO. U 20	SHEET 4 OF 39

26 31400487

APPROVED FOR ROUGH GRADING (± 1 FT.)
[Signature]
CITY HYDROLOGY
DATE 3-2-87

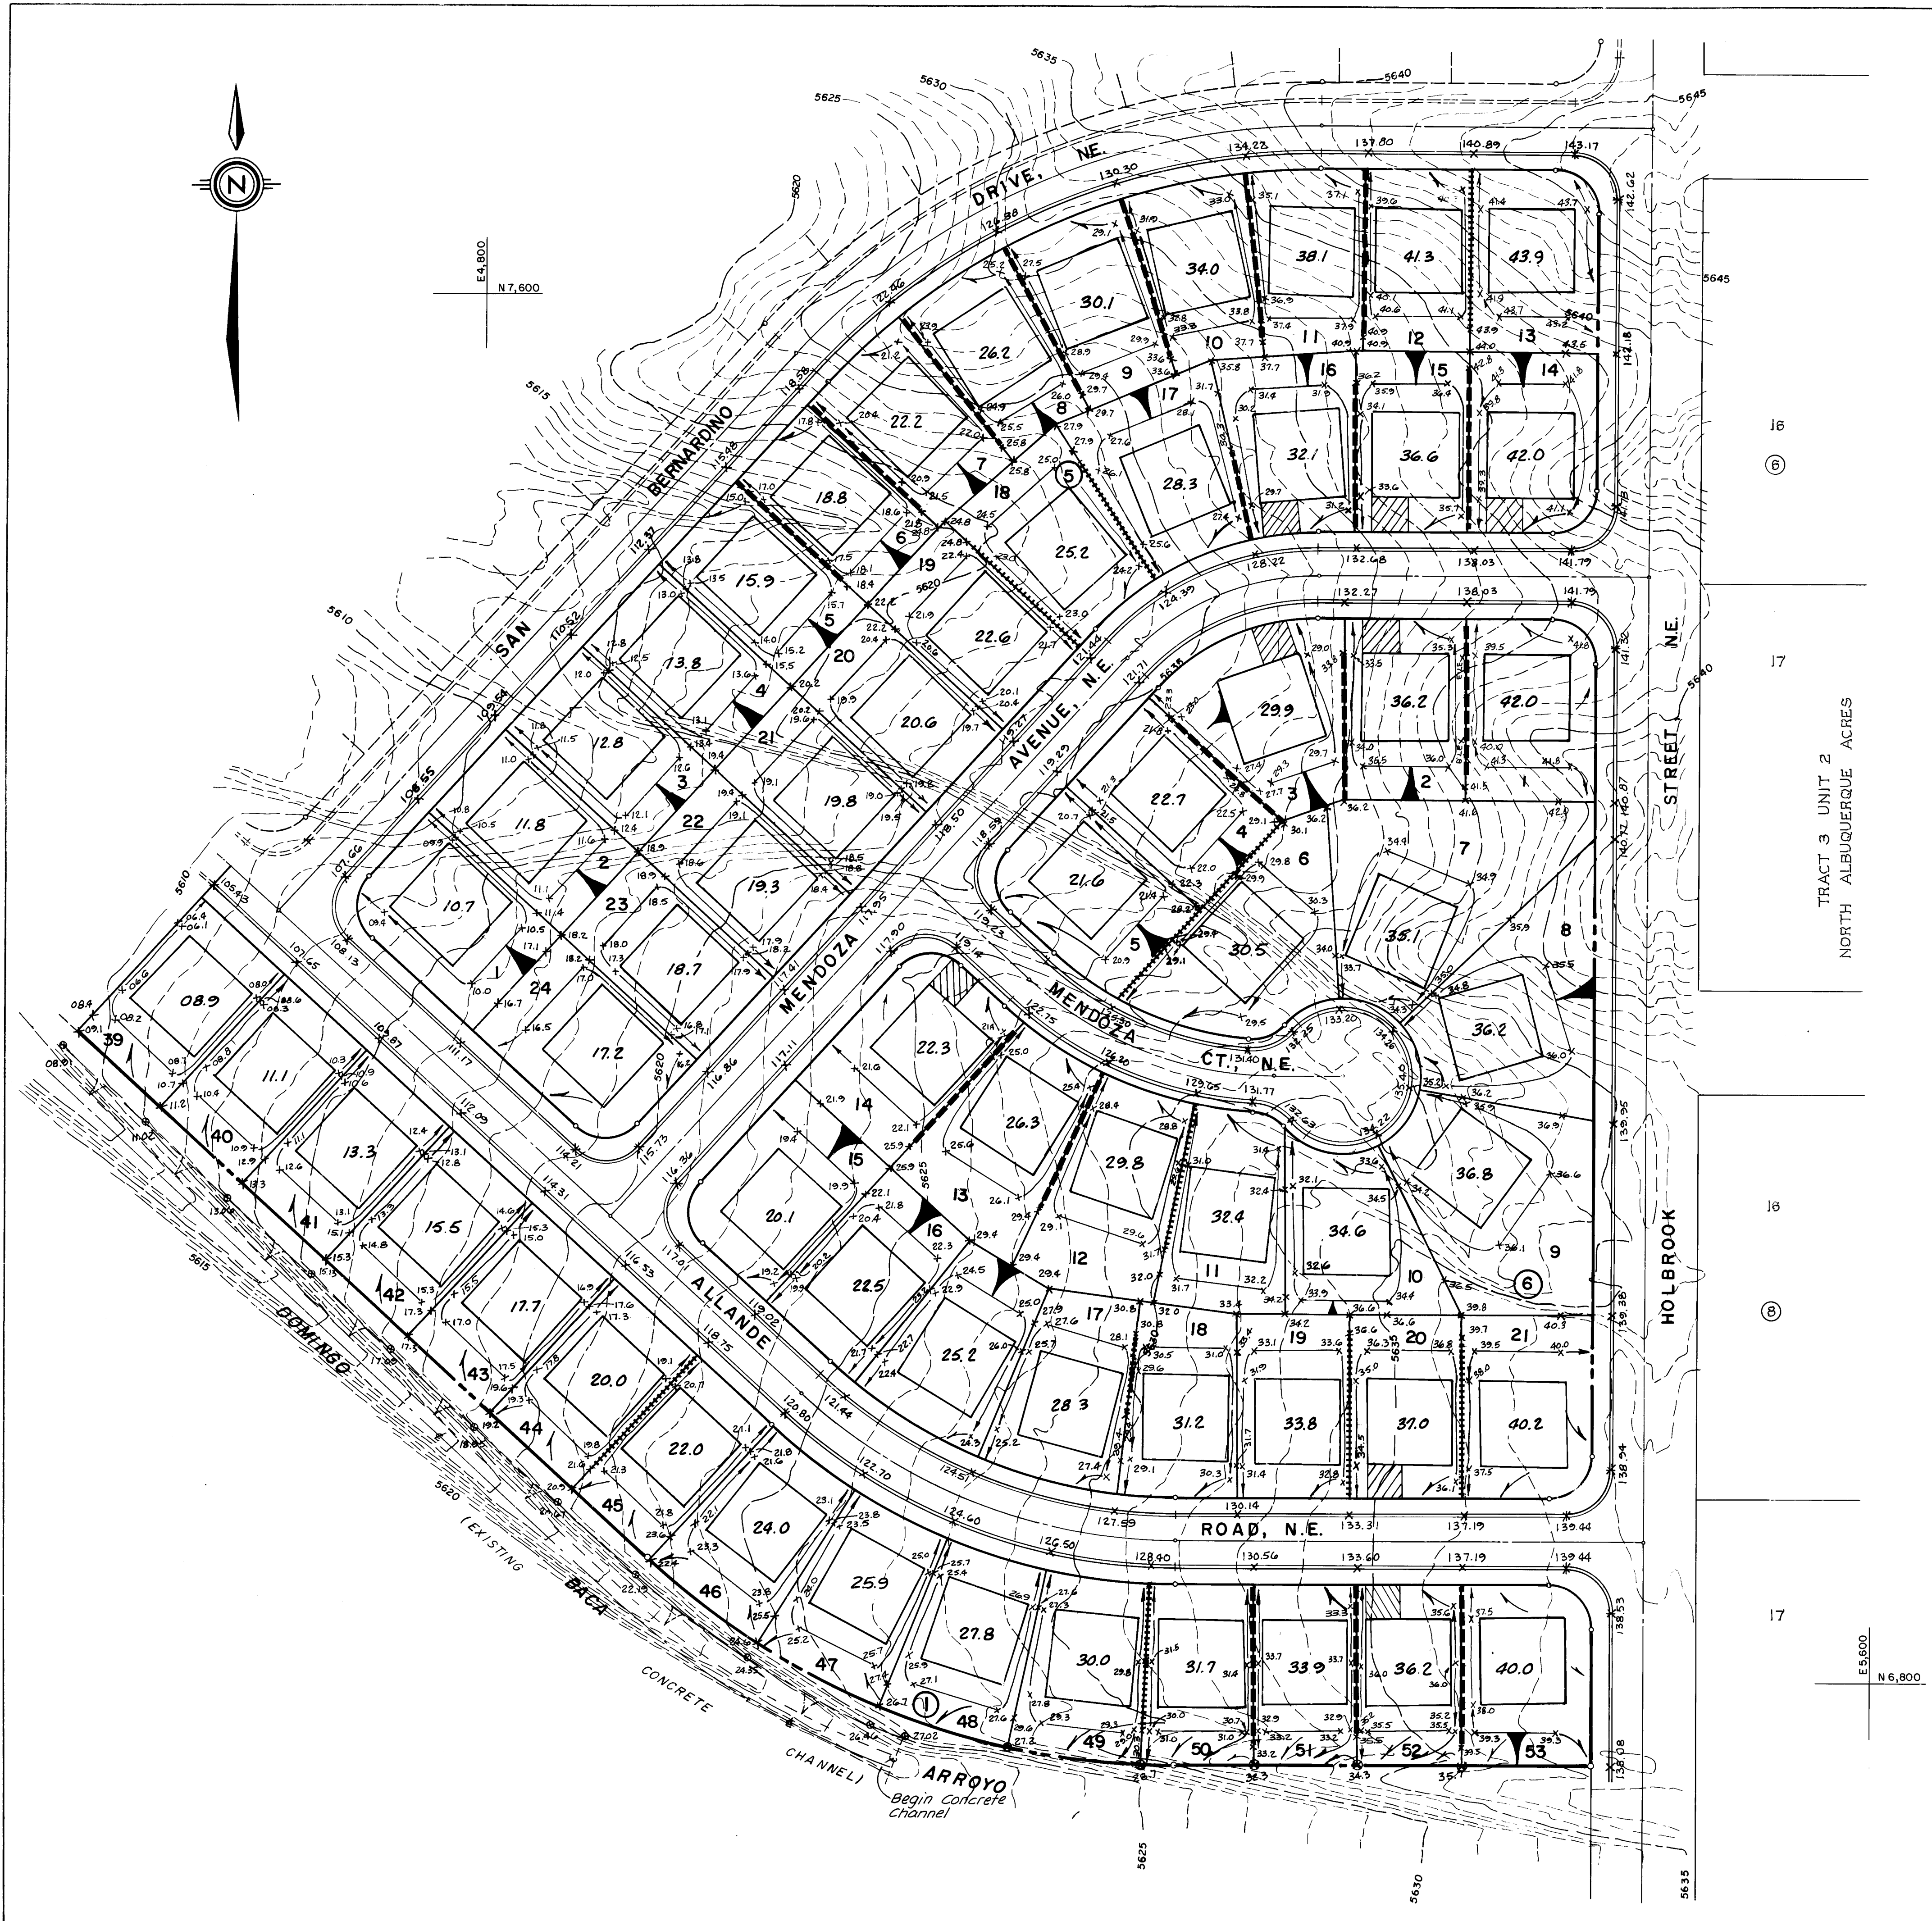

GENERAL NOTES FOR GRADING

- CONTRACTOR MUST OBTAIN TOP SOIL DISTURBANCE PERMIT PRIOR TO MASS GRADING OPERATION.
- CONTRACTOR MUST OBTAIN RETAINING WALL PERMIT PRIOR TO CONSTRUCTION OF RETAINING WALLS.
- MASS GRADING SHALL BE IN ACCORDANCE WITH EARTH WORK SPECIFICATION AS PREPARED SPECIFICALLY FOR THIS PROJECT BY F. M. FOX AND ASSOCIATES IN A REPORT ENTITLED "SUBSURFACE INVESTIGATION, HERITAGE HILLS, UNIT 6 SUBDIVISION, ALBUQUERQUE, NEW MEXICO, 6/86".

AS BUILT INFORMATION	
CONTRACTOR	WYLE CORP.
WORK STAGED BY	GUTIERREZ SURVEYING
DATE	6-87
SURVEY INFORMATION	
NO.	BY
FIELD NOTES	
DATE	
ENGINEER'S SEAL	
[Seal of Kent M. Whitman, Professional Engineer, No. 16168, State of New Mexico]	
2/16/87	
REVISIONS	
NO.	DATE
DESIGN	
DESIGNED BY	M.K.S.
DRAWN BY	W.J.W.
CHECKED BY	M.K.S.
DATE	1-87
DATE	2-87
DATE	2-87

KEY MAP

RECORD DRAWING AS BUILT

SCALE 1"=50'

community services corporation

CITY OF ALBUQUERQUE
MUNICIPAL DEVELOPMENT DEPARTMENT
ENGINEERING DIVISION

TITLE: HERITAGE EAST-UNIT SIX
GRADING PLAN

APPROVALS	ENGINEER	DATE	APPROVALS	ENGINEER	DATE
City Engineer	[Signature]	4/22/87	Traffic	NMDWH	4/22/87
A.C.E. - Design	[Signature]	4-22-87	Water Utilities	W/JW	4-22-87
A.C.E. - Hydrology	[Signature]	4-22-87			

APPROVED FOR ROUGH GRADING (± 1 Ft.)

[Signature] 3-2-87
CITY HYDROLOGY DATE

DRAWING NO. 3140 MAP NO. D 20 SHEET 5 OF 39

EARTH QUANTITIES

CUT = 99,413 CU. YD.
COMPACTED FILL = 80,002 CU. YD.

AS BUILT INFORMATION	
CONTRACTOR: WYLLIE CORP.	DATE: 6-87
WORK: GUTTER/BERM	DATE: 6-87
INSPECTOR: SURVEYING	DATE: 6-87
FIELD: PLANNING BY	DATE: 6-87
VEGETATION: BY	DATE: 6-87
CORRECTION: BY	DATE: 6-87
MICRO-FILM INFORMATION	
RECORDED BY	DATE
NO.	


SURVEY INFORMATION	
FIELD NOTES	DATE
NO.	BY

ENGINEER'S SEAL	
BY	DATE
REMARKS	DATE
REVISIONS	DATE
DESIGN	DATE

NO.	DATE	BY	DATE
1	2/17/87		

NO.	DATE	BY	DATE
1	2/17/87		

APPROVALS	ENGINEER	DATE	APPROVALS	ENGINEER	DATE
City Engineer	4/22/87	4/22/87	Traffic	NADWAH	4/22/87
A.C.E.-Design	4/22/87	4/22/87	Water Utilities	WU	4/22/87
A.C.E.-Hydrology	4/22/87	4/22/87			
DRAWING NO.	3140	MAP NO.	D-20	SHEET	6 OF 39

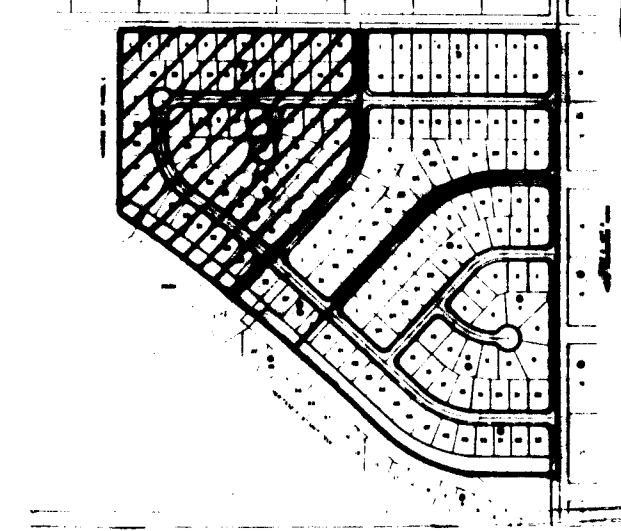

KEY MAP

RECORD DRAWING AS BUILT

SCALE

1"=50'

CITY OF ALBUQUERQUE
MUNICIPAL DEVELOPMENT DEPARTMENT
ENGINEERING DIVISION


TITLE: HERITAGE EAST-UNIT SIX
TEMPORARY EROSION CONTROL PLAN

APPROVALS	ENGINEER	DATE	APPROVALS	ENGINEER	DATE
City Engineer	4/22/87	4/22/87	Traffic	NADWAH	4/22/87
A.C.E.-Design	4/22/87	4/22/87	Water Utilities	WU	4/22/87
A.C.E.-Hydrology	4/22/87	4/22/87			

DRAWING NO.	3140	MAP NO.	D-20	SHEET	6 OF 39
-------------	------	---------	------	-------	---------


LEGEND

- 10' x 10' INSIDE BOTTOM, 2' DEPTH
- EROSION CONTROL BERM, SEE TYPICAL SECTION, THIS SHEET

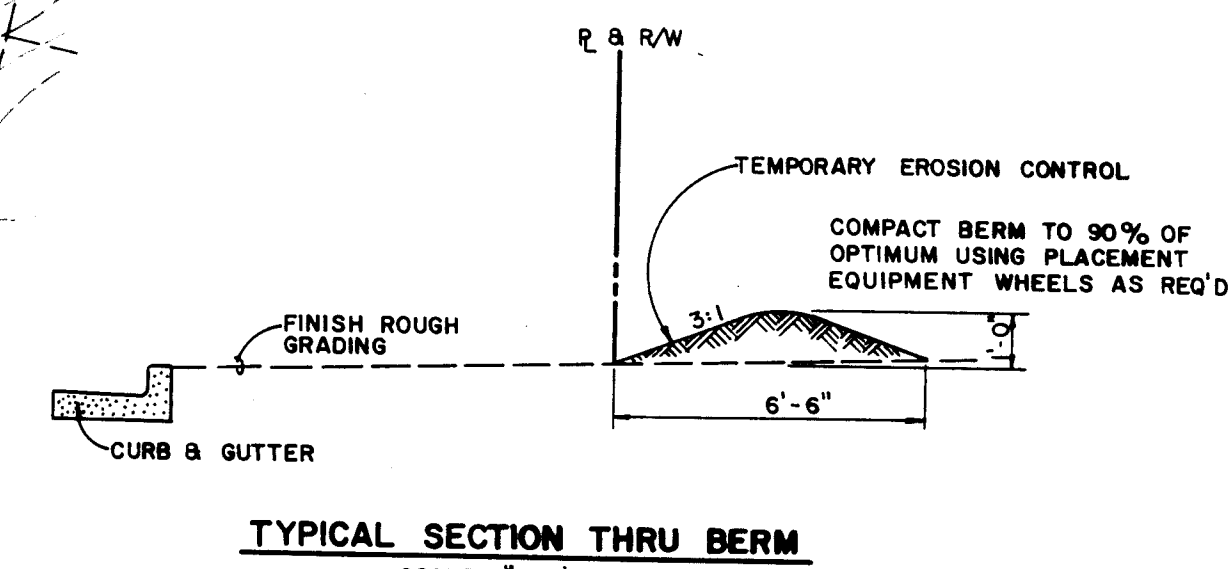

TYPICAL SECTION THRU BERM

SCALE: 1" = 4'

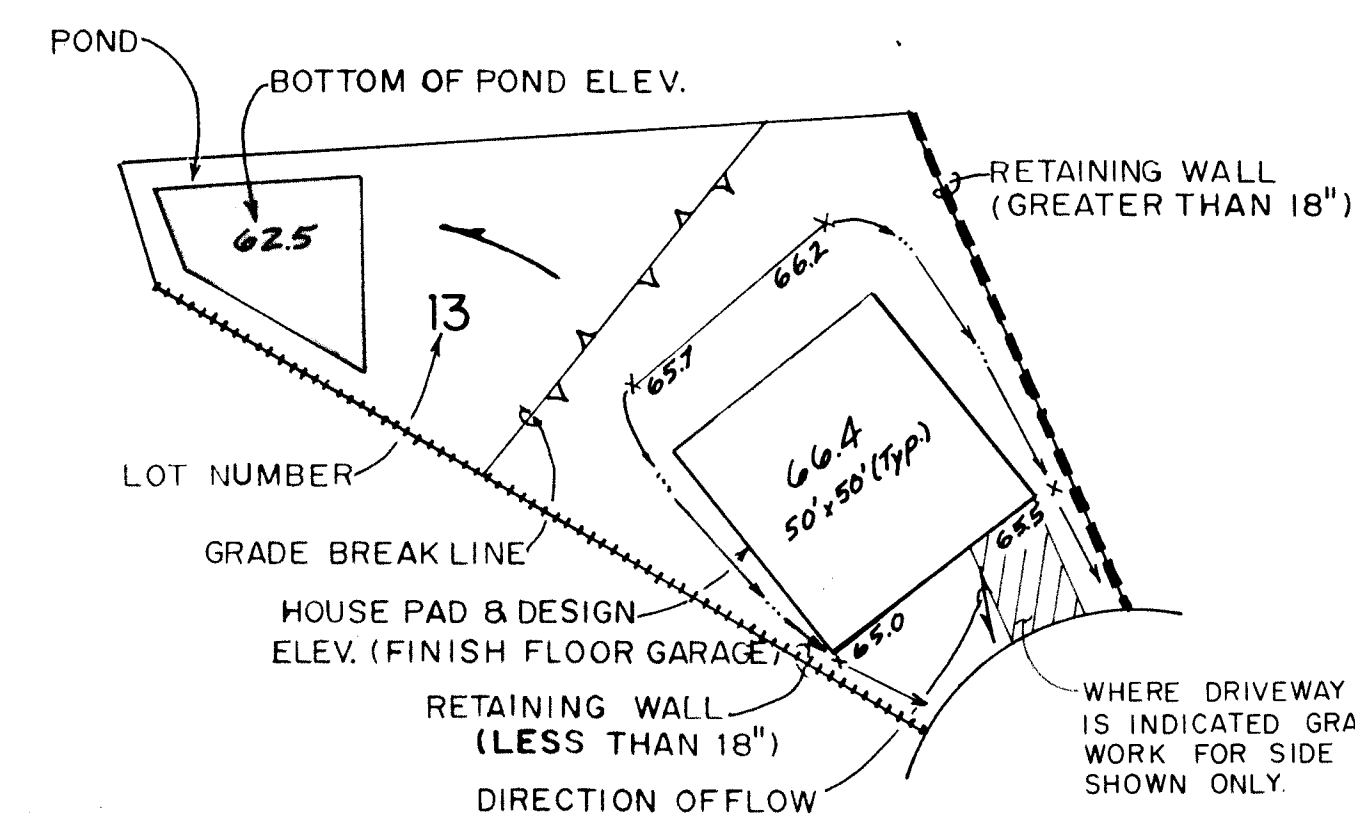



LOT LEGEND TYPICAL

NOTE: PADS ARE TO BE 50' X 50' UNLESS OTHERWISE NOTED.

APPROVED FOR ROUGH GRADING
(± 1 FT.)

SITE HYDROLOGY DATE

NOTE: TO BE USED FOR EROSION CONTROL ONLY. NOT TO BE USED FOR GRADING PURPOSES.

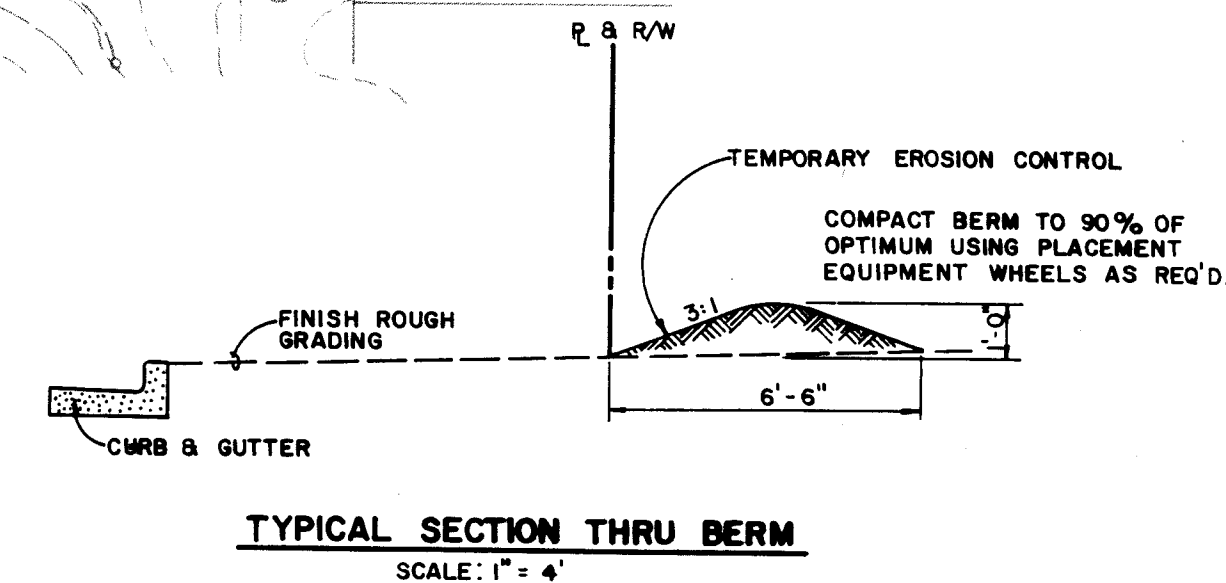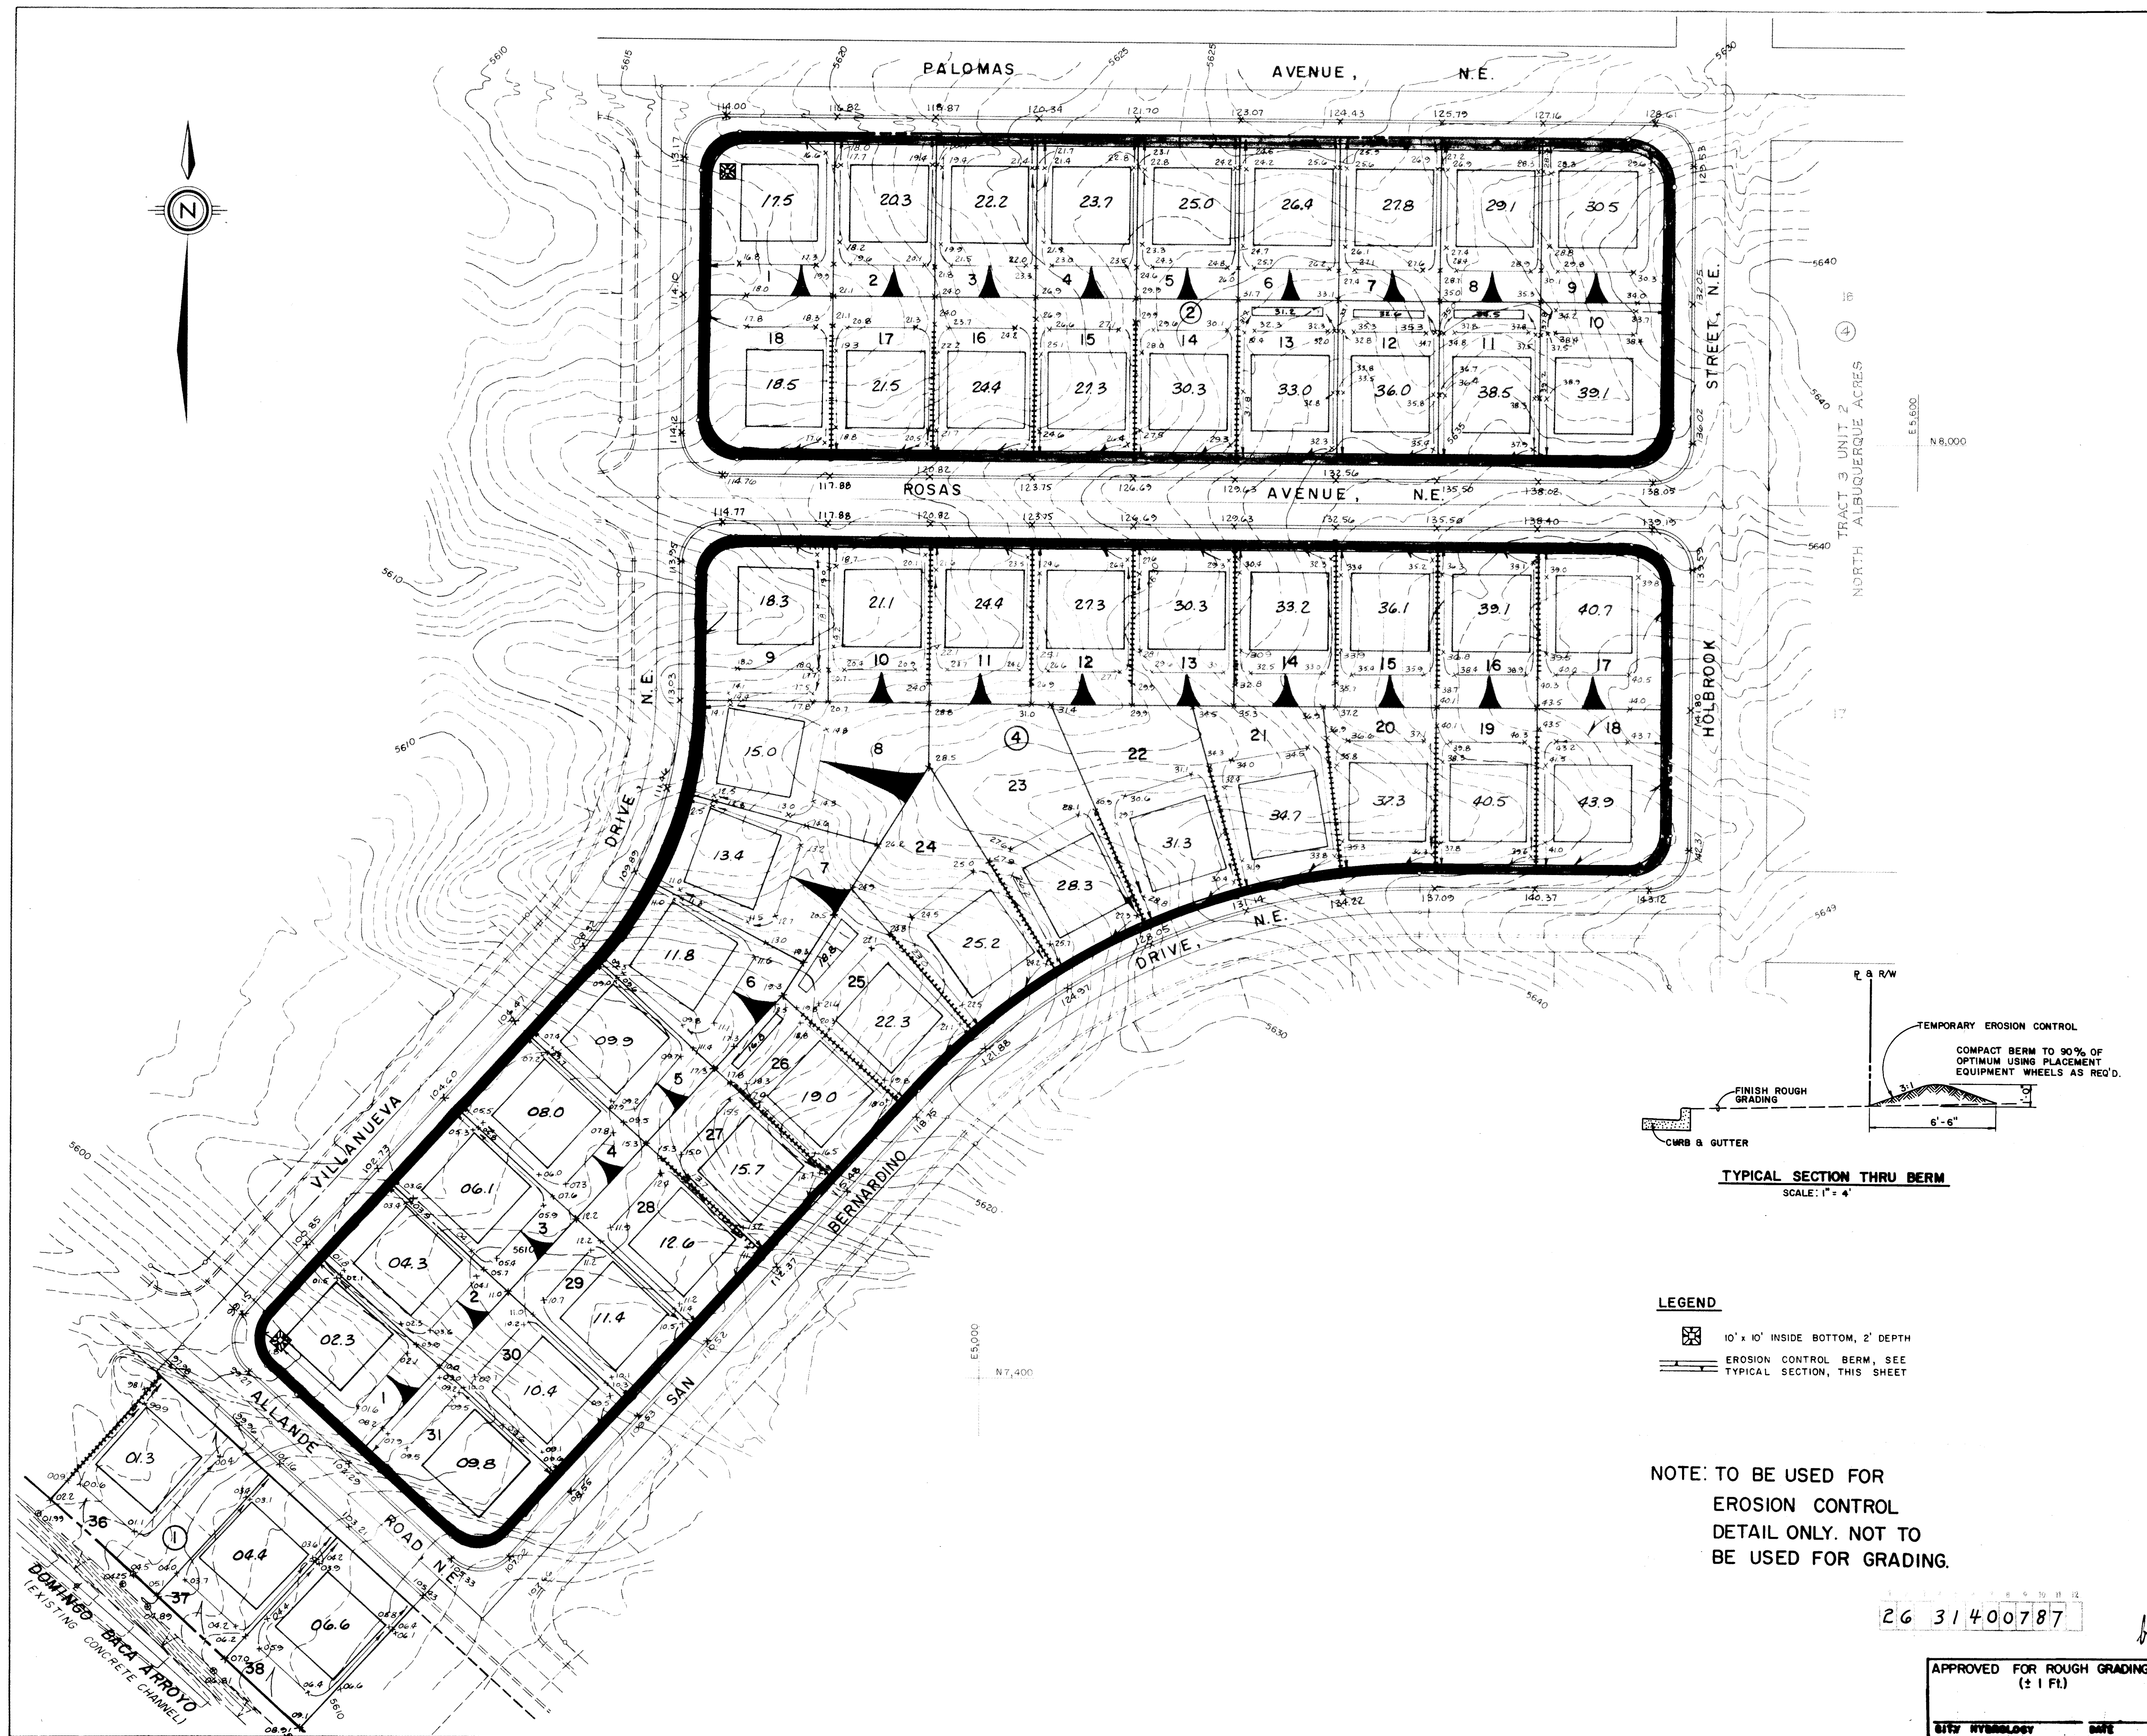


- LEGEND**
- 10' x 10' INSIDE BOTTOM, 2' DEPTH
 - EROSION CONTROL BERM, SEE TYPICAL SECTION, THIS SHEET

NOTE: TO BE USED FOR
EROSION CONTROL
DETAIL ONLY. NOT TO
BE USED FOR GRADING.

26 31400787


APPROVED FOR ROUGH GRADING
(2 I FI)

SITE HYDROLOGY DATE

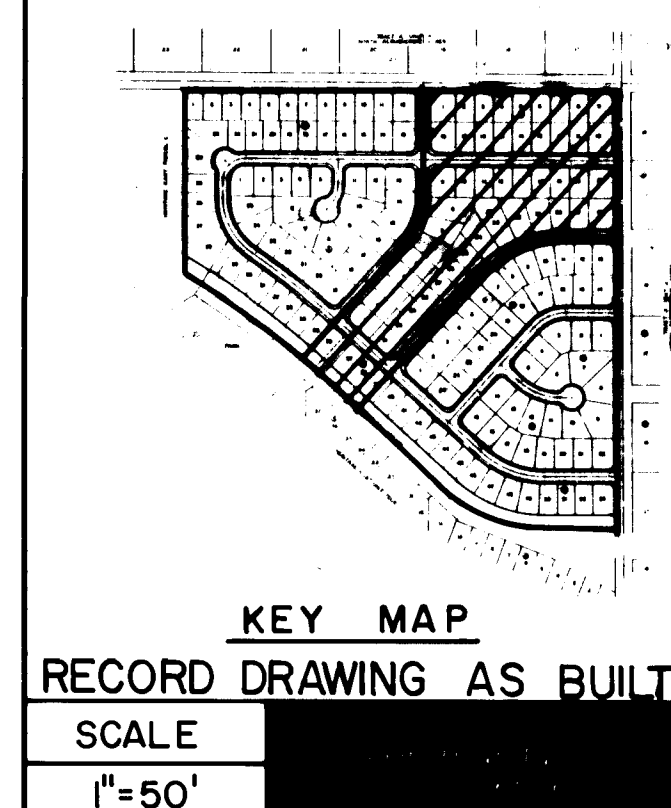

CITY OF ALBUQUERQUE MUNICIPAL DEVELOPMENT DEPARTMENT ENGINEERING DIVISION					
TITLE: HERITAGE EAST-UNIT SIX TEMPORARY EROSION CONTROL PLAN					
APPROVALS	ENGINEER	DATE	APPROVALS	ENGINEER	DATE
City Engineer	<i>[Signature]</i>	4/22/87	Traffic	<i>[Signature]</i>	4/22/87
A.C.E.-Design	<i>[Signature]</i>	4-22-87	Water Utilities	<i>[Signature]</i>	4-22-87
A.C.E.-Hydrology	CAM	4-22-87			
DRAWING NO.	3140	MAP NO.	D-20	SHEET	7 OF 39

ENGINEER'S SEAL		SURVEY INFORMATION		BENCH MARKS		AS BUILT INFORMATION	
		FIELD NOTES		A.C.S. BRASS TABLE "1-C21A" SET IN THE TOP OF CONCRETE POST FLUSH WITH GROUND AND LOCATED AT THE NORTHEAST CORNER OF THE INTERSECTION OF PASEO DEL NORTE (LOS ANGELES DRIVE, N.E.) AND HOLBROOK STREET, N.E. ELEVATION = 5634.05'		CONTRACTOR: WYUVE CORP.	
		NO.		DATE		WORK: GUTTER/REZ.	
		BY		DATE		STAMPED BY: SURVEYING	
		REVISIONS		DATE		ACCEPTANCE BY: FIELD	
DESIGNED BY		DATE		DRAWN BY		DATE	
CHECKED BY		DATE		RECORDED BY		DATE	
						MICRO-FILM INFORMATION	
						NO.	

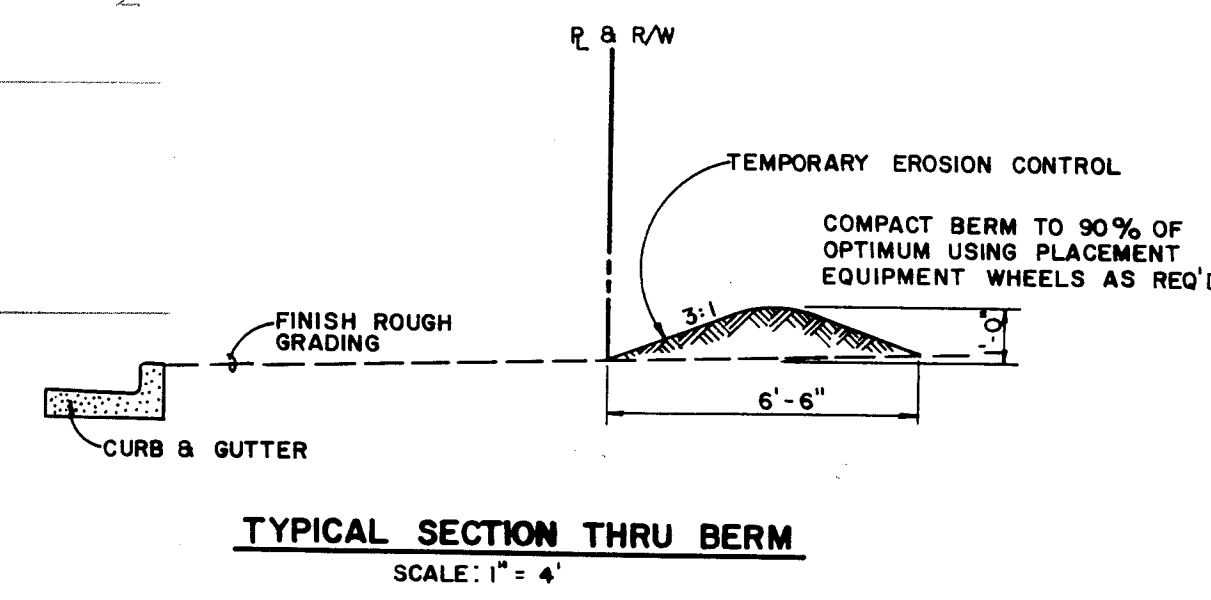


- LEGEND**
- 10' x 10' INSIDE BOTTOM, 2' DEPTH
 - EROSION CONTROL BERM, SEE TYPICAL SECTION, THIS SHEET

NOTE: TO BE USED FOR EROSION CONTROL DETAIL ONLY. NOT TO BE USED FOR GRADING.

26 31400887

APPROVED FOR ROUGH GRADING
(21 FL)

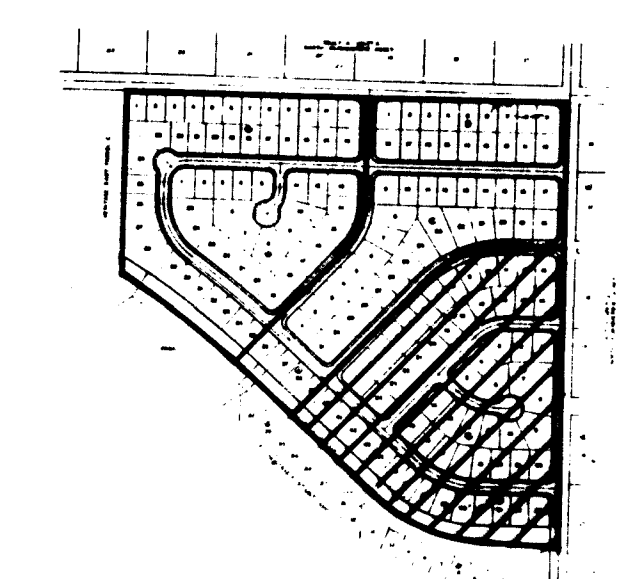



RECORD DRAWING AS BUILT

SCALE
1"=50'

CITY OF ALBUQUERQUE
MUNICIPAL DEVELOPMENT DEPARTMENT
ENGINEERING DIVISION
TITLE: HERITAGE EAST-UNIT SIX
TEMPORARY EROSION CONTROL PLAN

APPROVALS	ENGINEER	DATE	APPROVALS	ENGINEER	DATE
City Engineer	<i>[Signature]</i>	4/22/87	Traffic	<i>[Signature]</i>	4/22/87
A.C.E. - Design	<i>[Signature]</i>	4-22-87	Water Utilities	<i>[Signature]</i>	4-22-87
A.C.E. - Hydrology	<i>[Signature]</i>	4-22-87			
DRAWING NO.	3140	MAP NO.	D-20	SHEET	8 OF 39

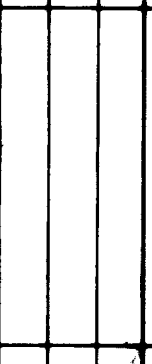		ENGINEER'S SEAL		SURVEY INFORMATION		BENCH MARKS		AS BUILT INFORMATION			
				FIELD NOTES							
				NO.	BY	DATE					
NO.		DATE	REMARKS								
REVIEWS											
DESIGN											
DESIGNED BY		DATE									
DRAWN BY		DATE									
CHECKED BY		DATE									

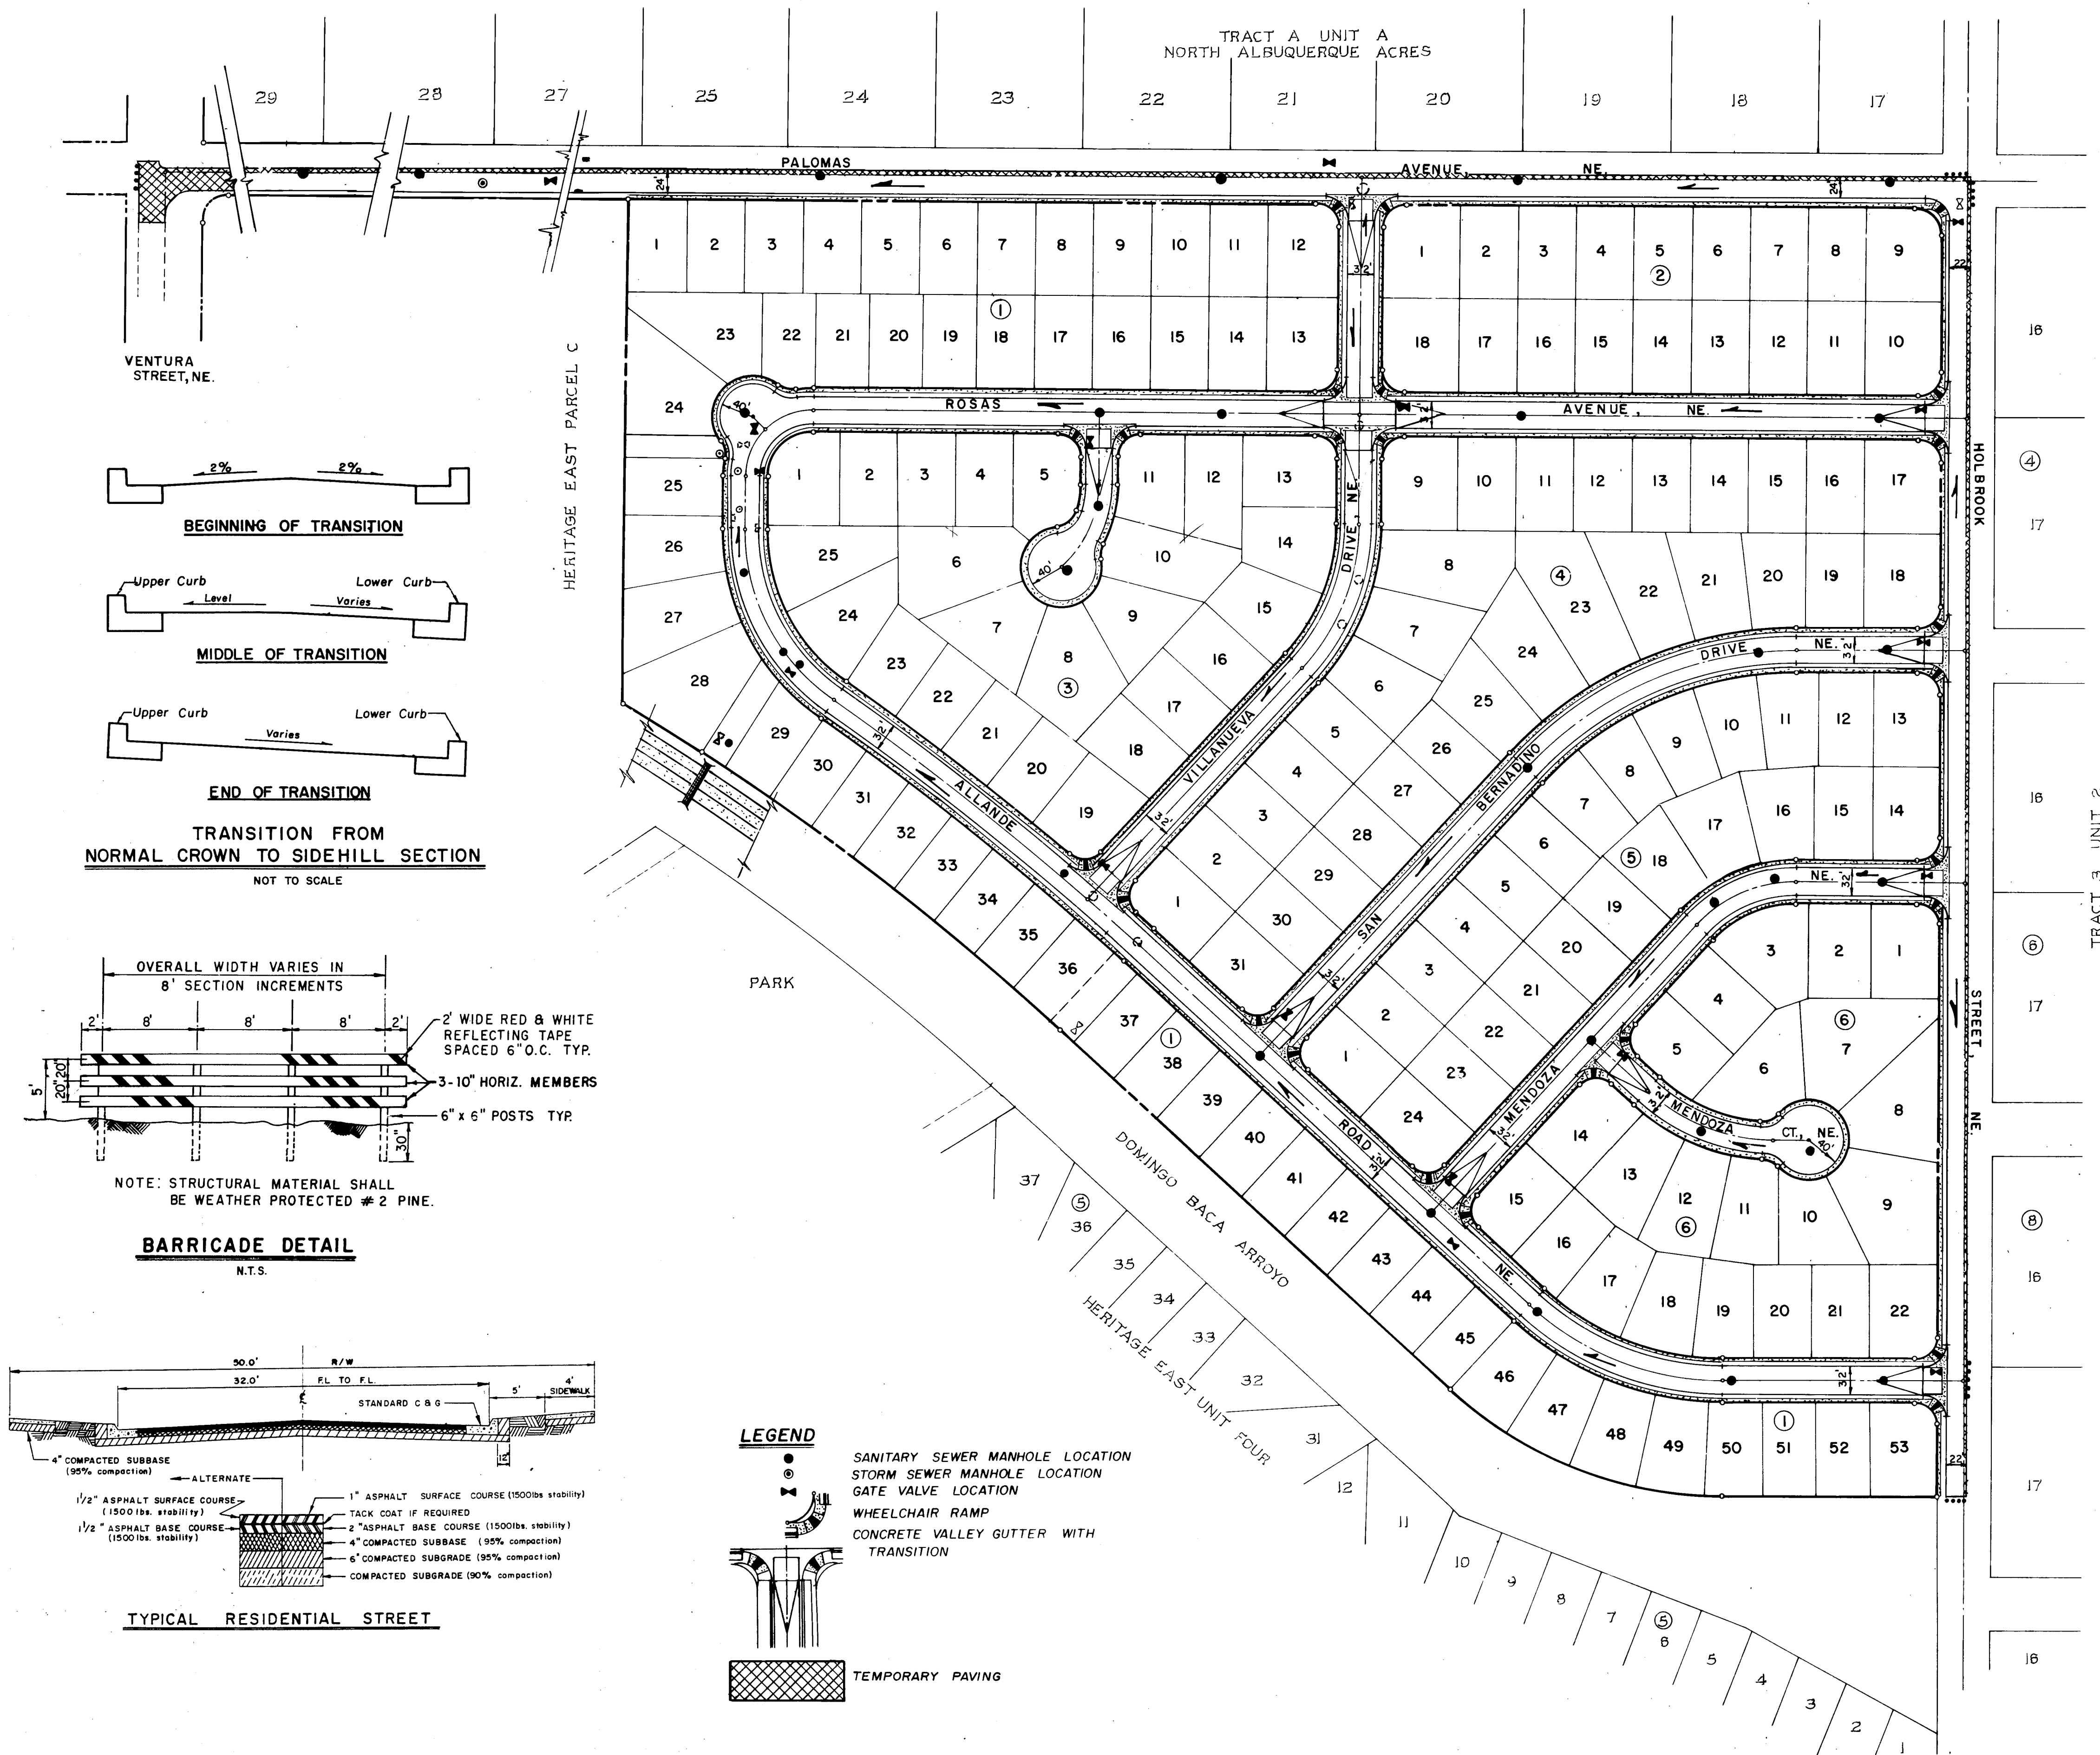

- NOTES:
- 1.) SIDEWALKS TO BE CONSTRUCTED WITH THIS CONTRACT INCLUDE THE WEST SIDE OF HOLBROOK AND ALL WHEEL-CHAIR RAMP. OTHER SIDEWALK CONSTRUCTION IS DEFERRED UNTIL BUILDING CONSTRUCTION TAKES PLACE.
 - 2.) ALL PAVEMENT THIS PROJECT SHALL BE RESIDENTIAL.

AS BUILT INFORMATION		BENCH MARKS		SURVEY INFORMATION		ENGINEER'S SEAL		REVISIONS		REMARKS	
CONTRACTOR	DATE	NO.	DATE	NO.	DATE	NO.	DATE	NO.	DATE	NO.	DATE
WYLLIE CORP.	4-87										
WORK BY	DATE										
INSPECTOR'S	DATE										
ACCEPTANCE BY	DATE										
LOCATED AT THE NORTHEAST CORNER OF THE INTERSECTION OF PASO DEL NORTE (LOS ANGELES DRIVE, N.E.) AND HOLBROOK STREET, N.E. ELEVATION = 5634.65'	DATE										
VERIFICATION BY	DATE										
DRAWINGS	DATE										
RECORDED BY	DATE										
MICRO-FILM INFORMATION	DATE										

RECORD DRAWING AS BUILT

SCALE
1"=100'


community sciences corporation



CITY OF ALBUQUERQUE
MUNICIPAL DEVELOPMENT DEPARTMENT
ENGINEERING DIVISION

TITLE: HERITAGE EAST - UNIT SIX
COMPOSITE PAVING PLAN

APPROVALS	ENGINEER	DATE	APPROVALS	ENGINEER	DATE
CITY ENGINEER		4/22/87	TRAFFIC		4/22/87
ACE-Design		4/22/87	WATER UTILITIES		4/22/87
ACE-Hydrology		4/22/87			

DRAWING NO. 3140 MAP NO. D-20 SHEET 9 OF 39

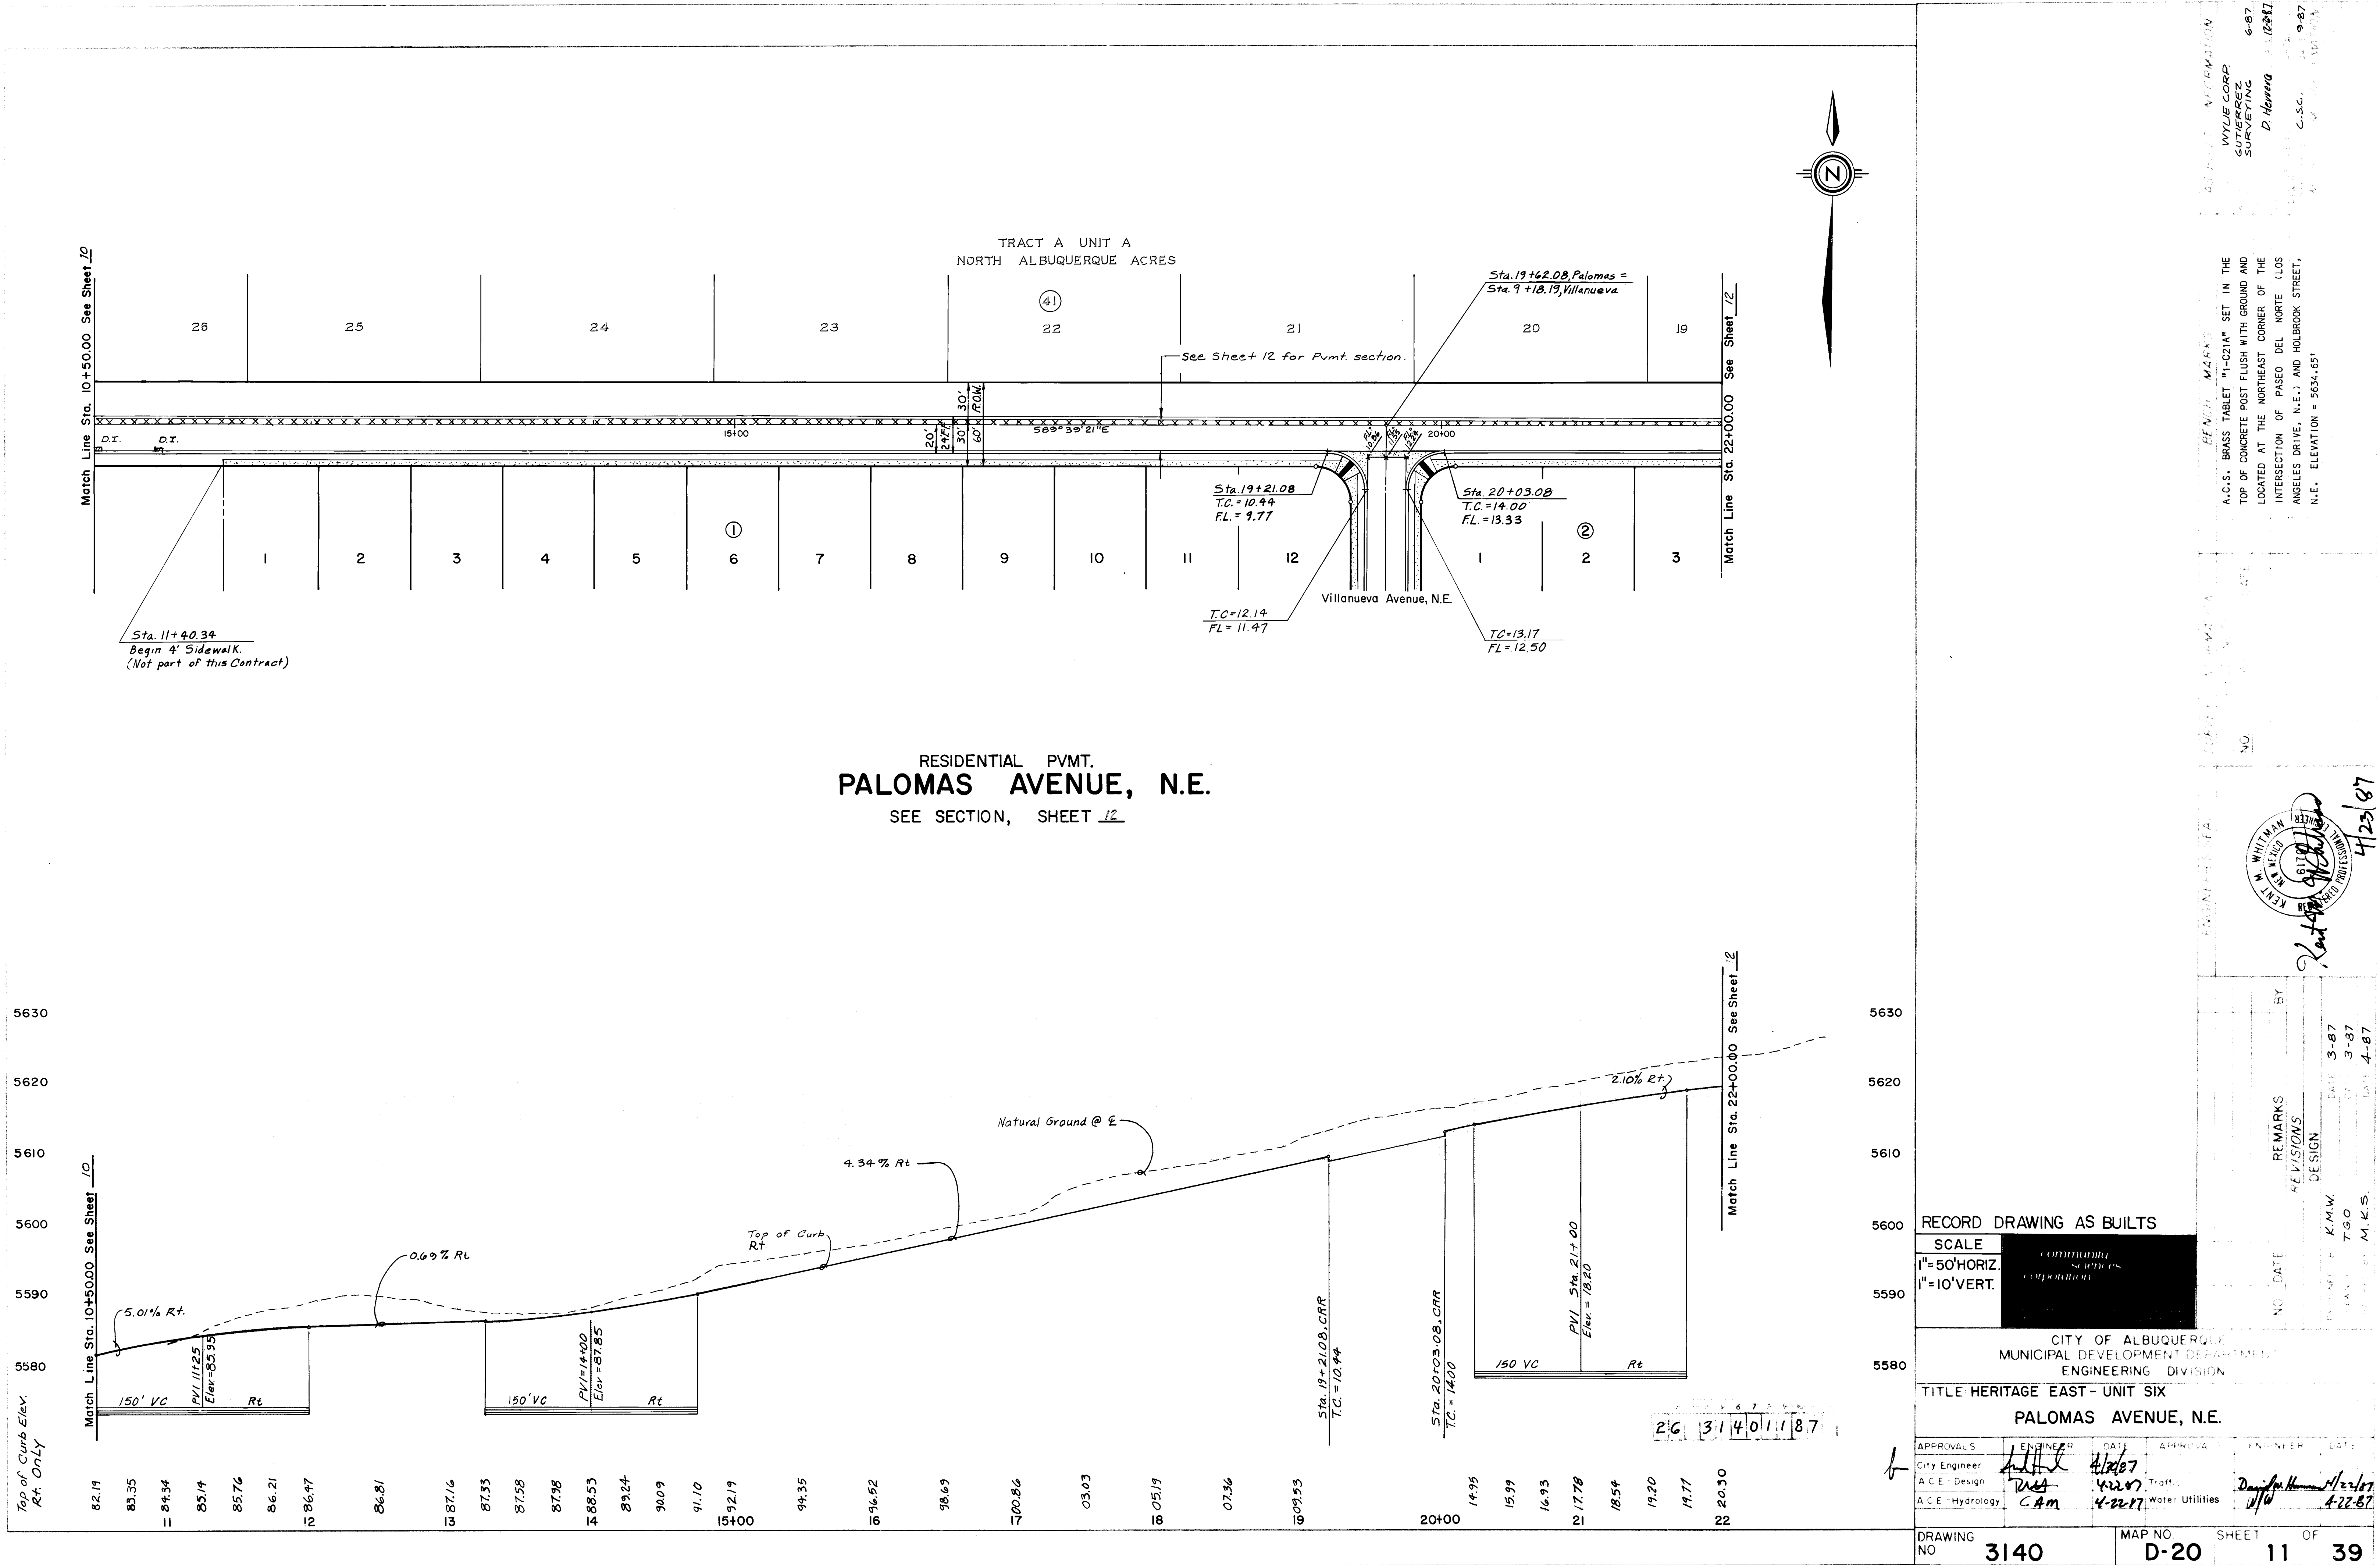

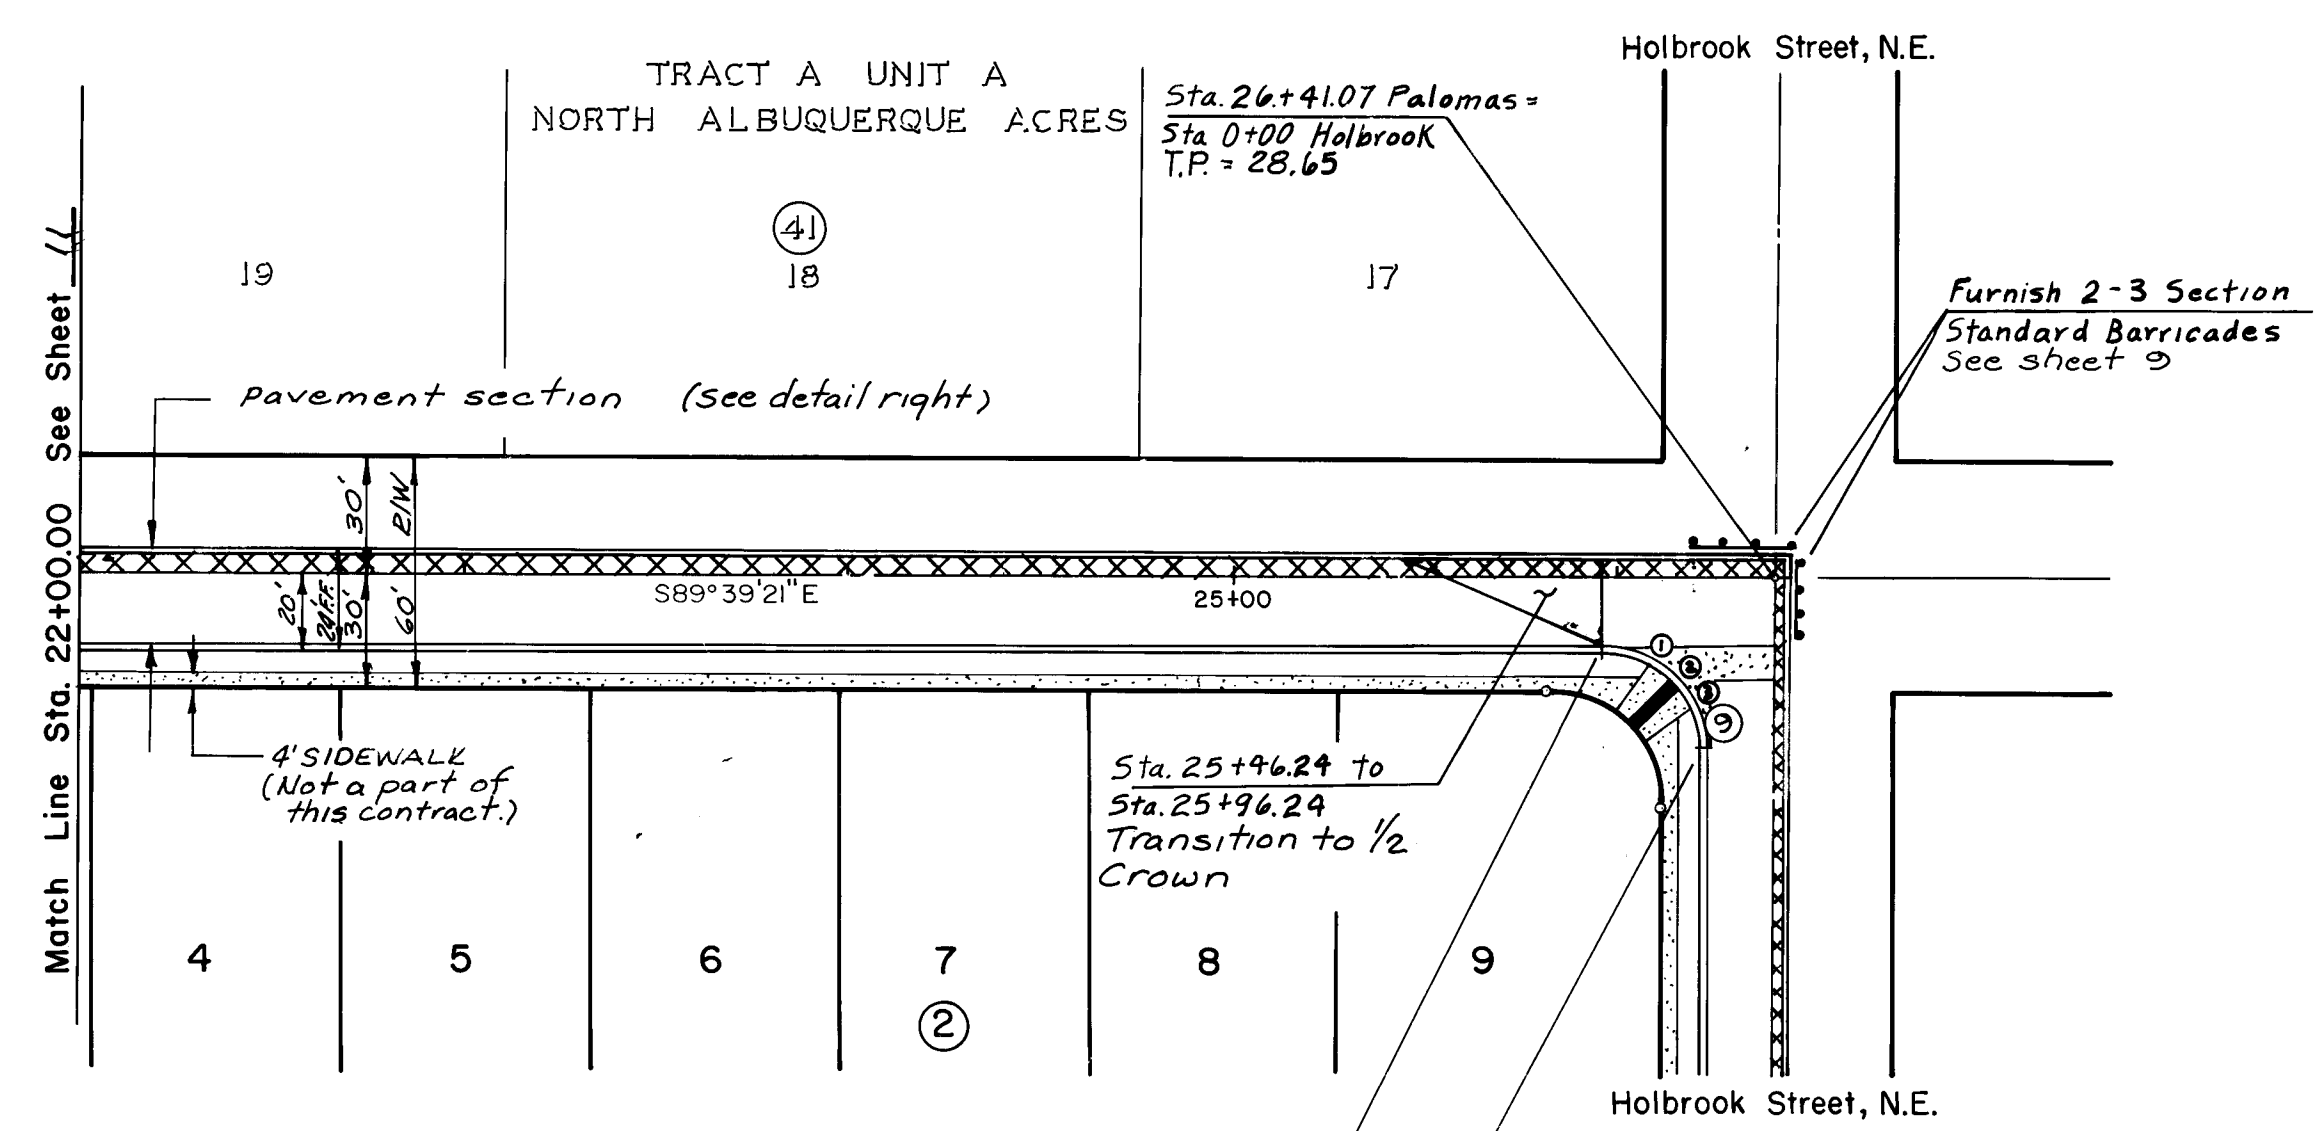
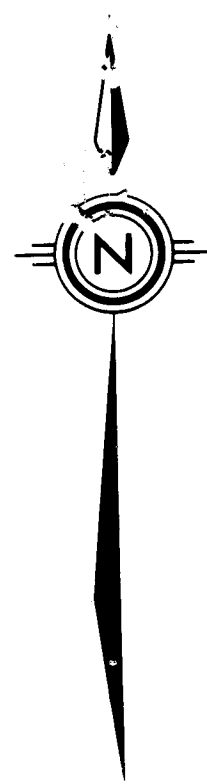


Sta. 25+96.24
T.C. = 28.61
FL. = 27.94


QUARTER POINT ELEVATIONS
1) FL. = 28.17
2) FL. = 28.40
3) FL. = 28.63

T.C. = 29.53
FL. = 28.86

RESIDENTIAL P.V.M.T.
PALOMAS AVENUE, N.E.
SEE SECTION, RIGHT

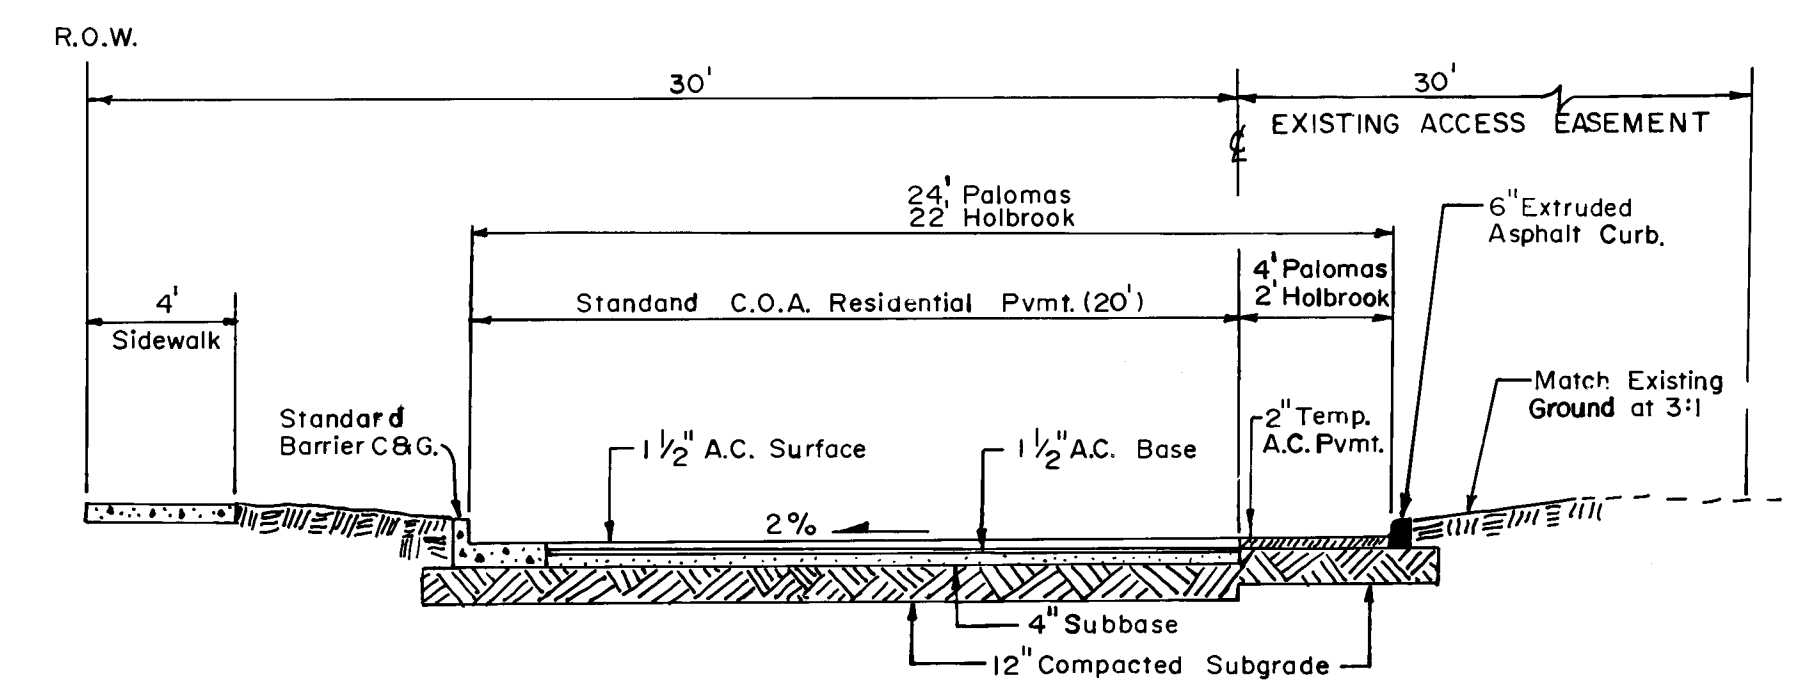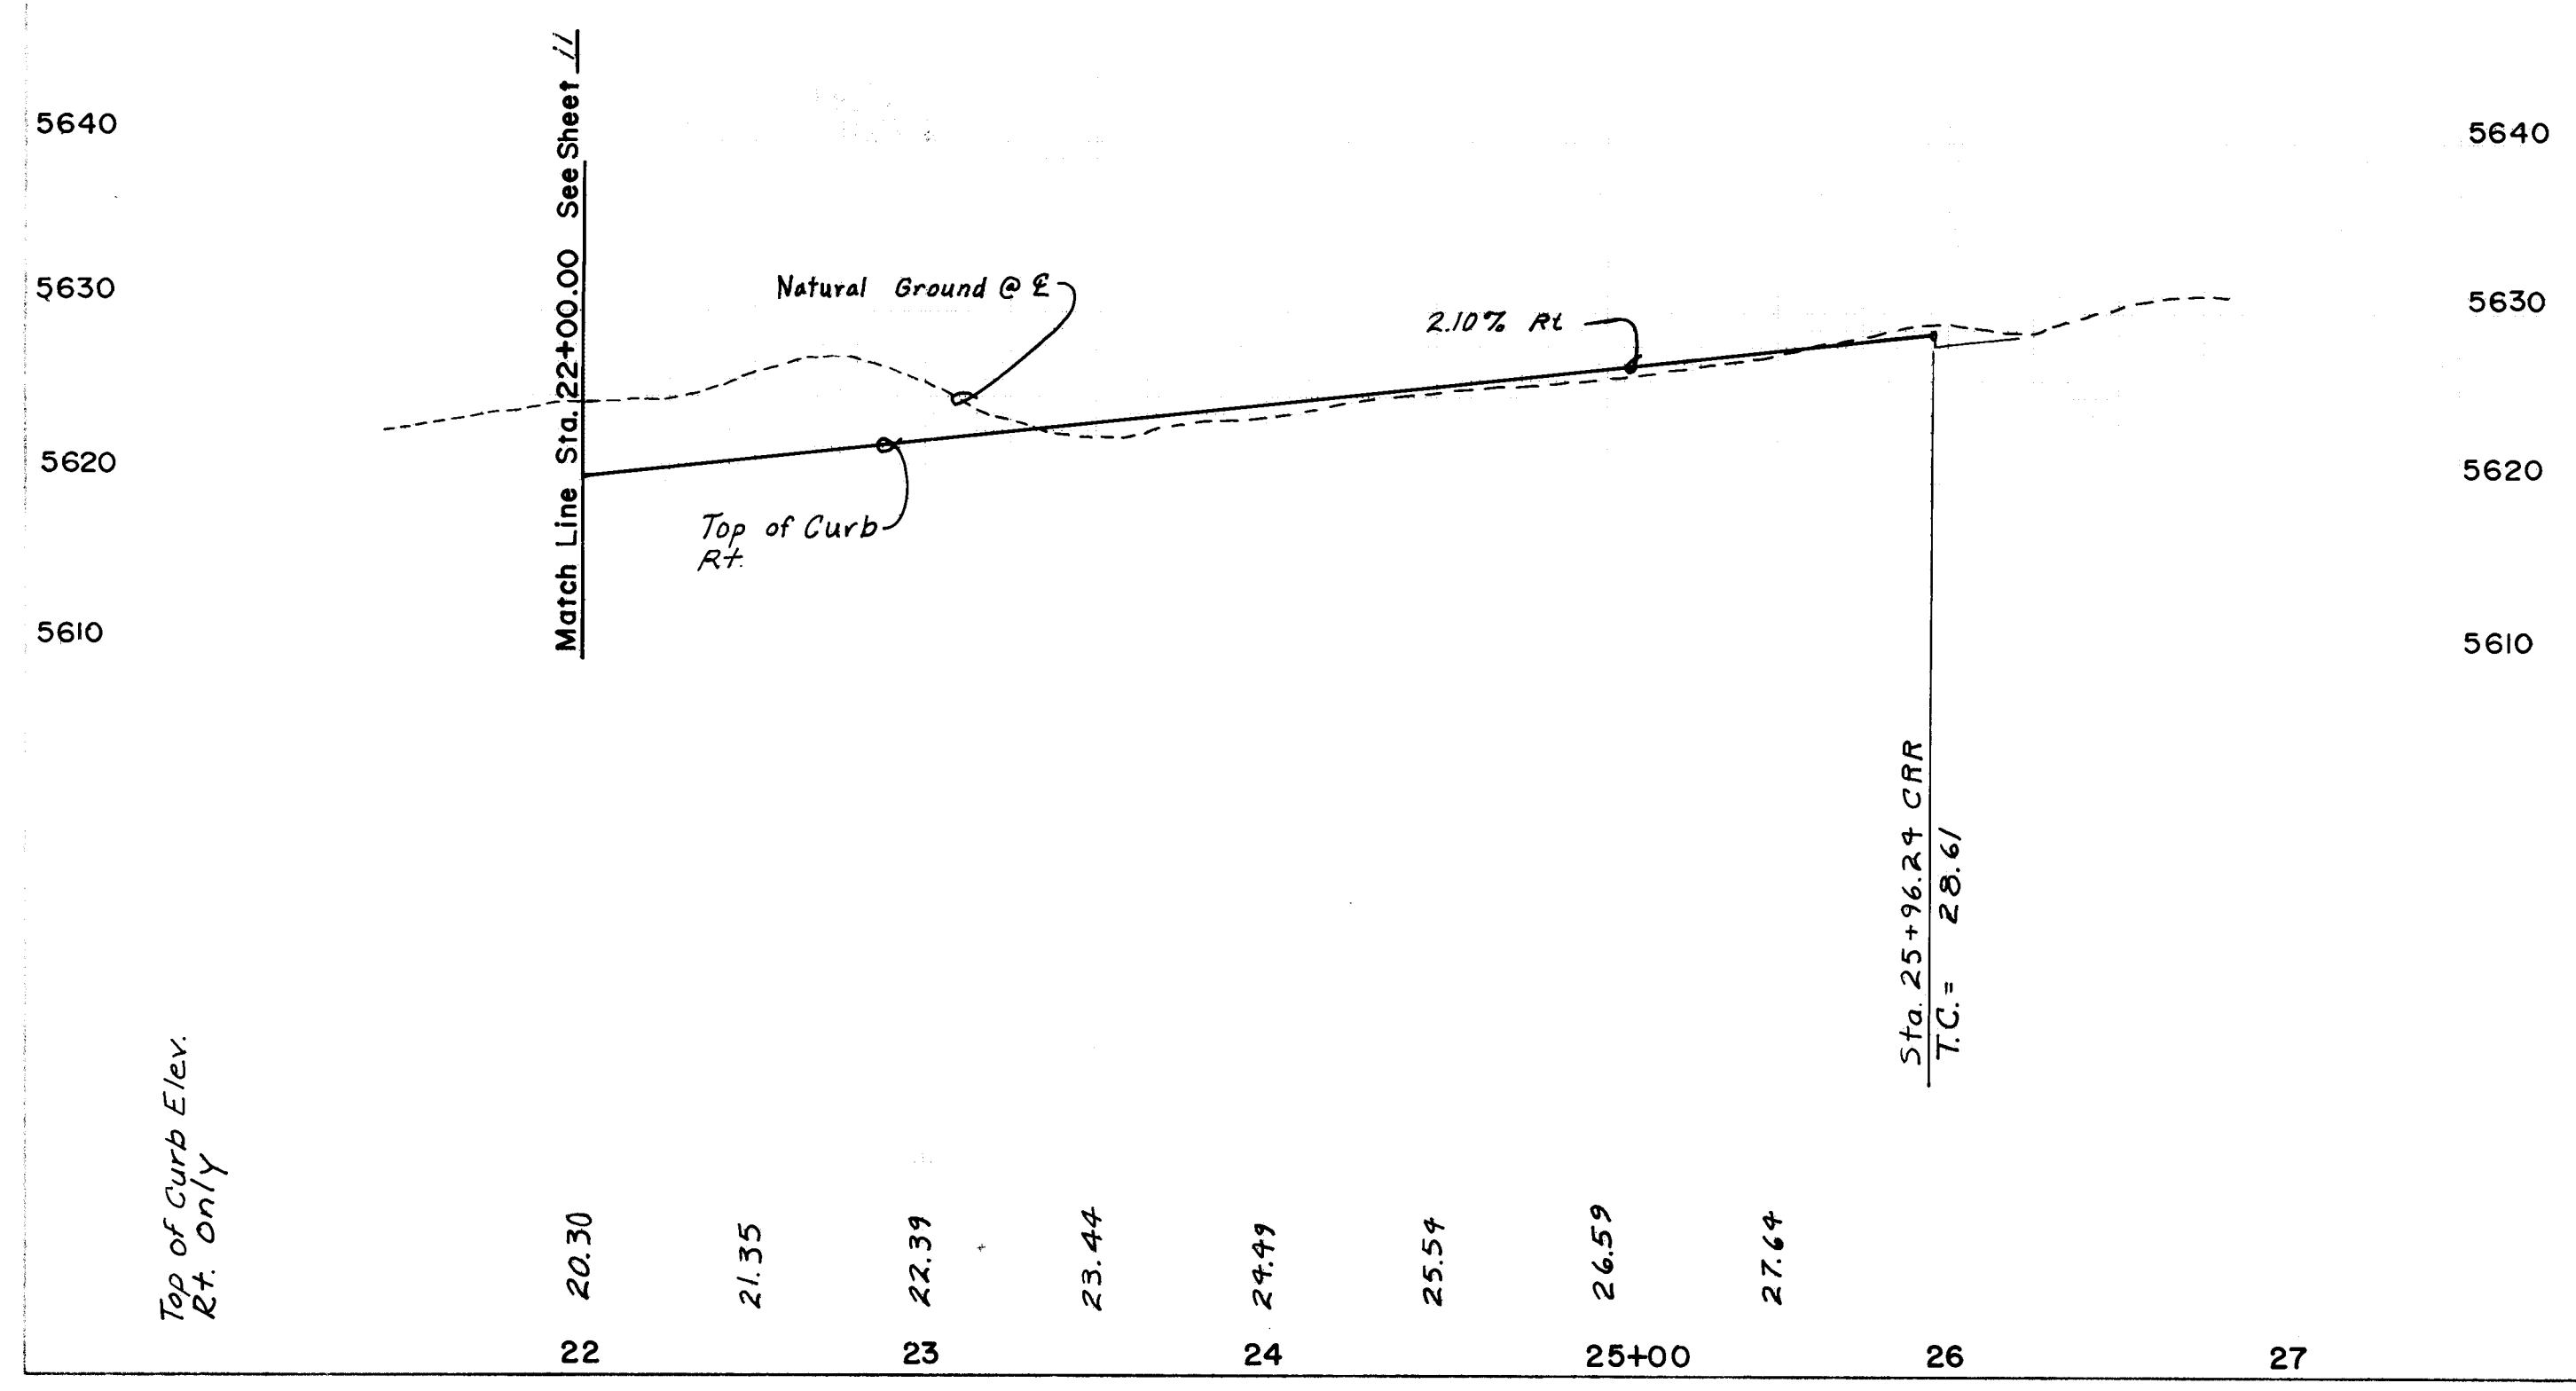

TYPICAL PAVEMENT SECTION
PALOMAS & HOLBROOK
1" = 5'

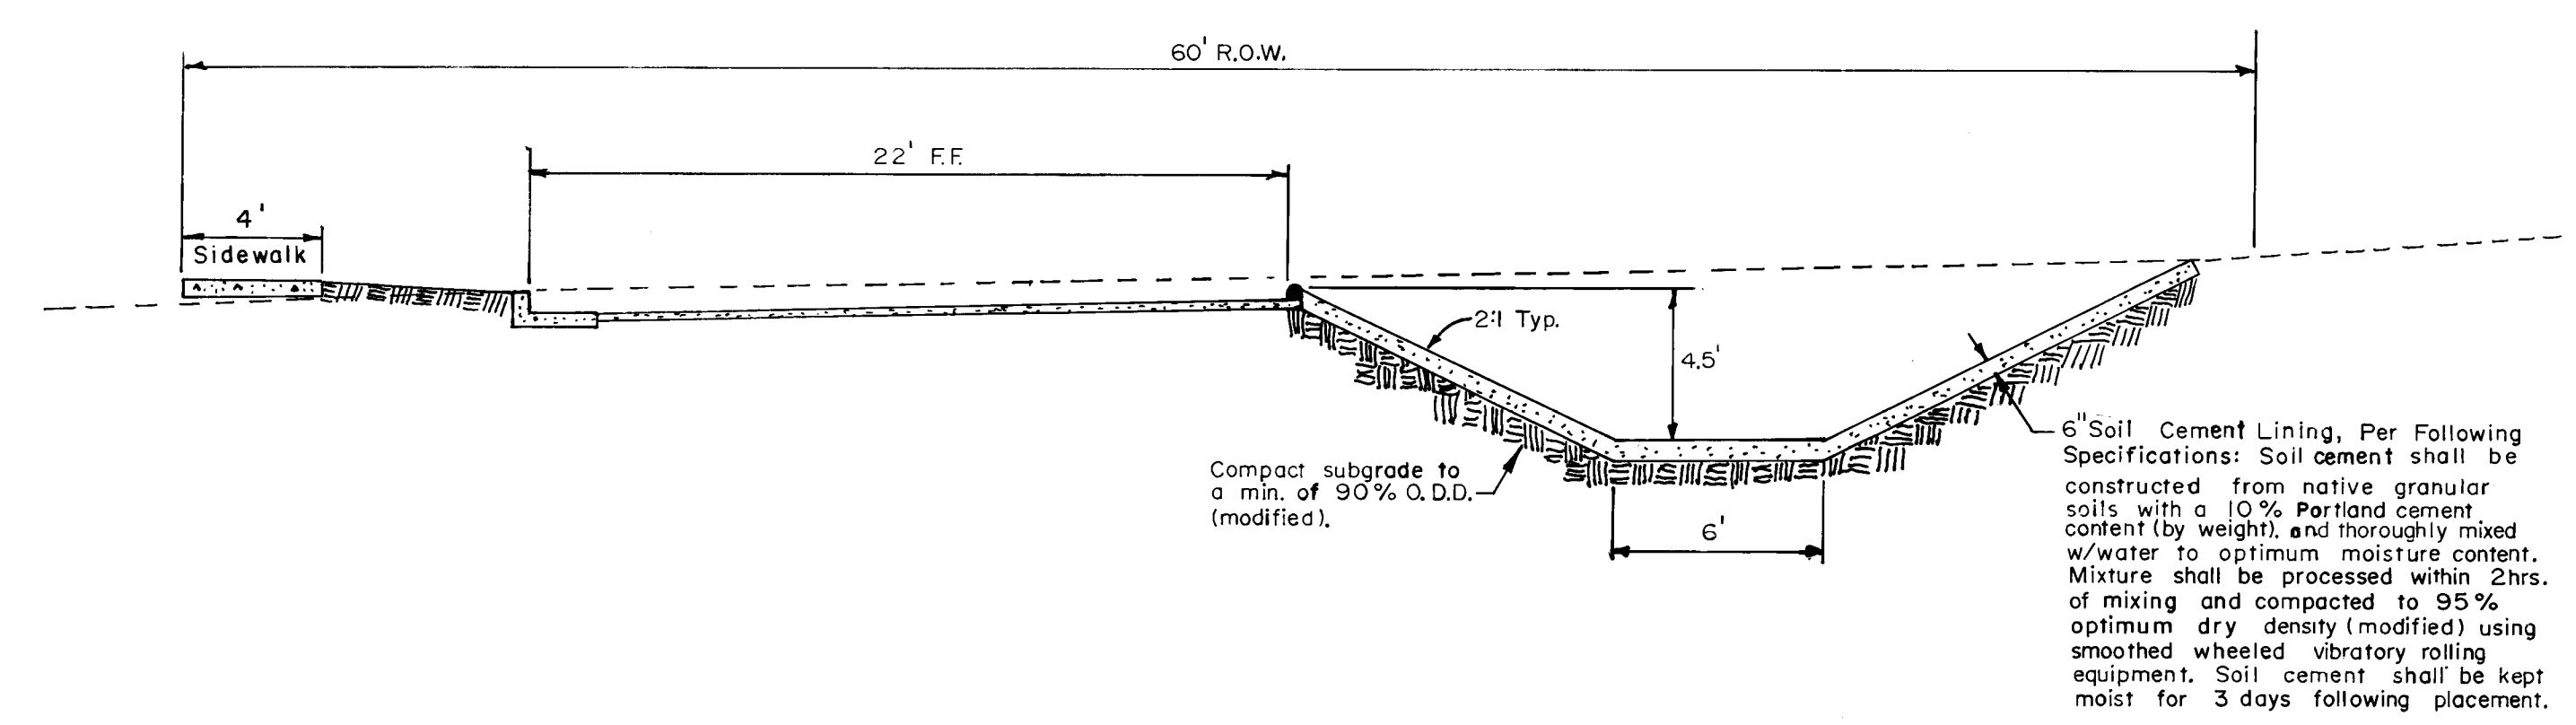

TEMPORARY SOIL CEMENT DIVERSION CHANNEL
1" = 5'

Curb Curve Data			
Curve	Radius	Arc	Delta
②	25.00'	39.17'	89°46'55"

AS BUILT
WYLLIE CORP
GUTIERREZ
SURVEYING
D. Herrera
12-2-87
C.S.C.
9-87

BEACH MARKS
A.C.S. BRASS TABLE "1-C21A" SET IN THE TOP OF CONCRETE POST FLUSH WITH GROUND AND LOCATED AT THE NORTHEAST CORNER OF THE INTERSECTION OF PASO DEL NORTE (LOS ANGELES DRIVE, N.E.) AND HOLBROOK STREET, N.E. ELEVATION = 5634.65'

SURVEY INFORMATION

ENGINEER
KENT WHITMAN
6199
4/23/87

NO.	DATE	REMARKS	BY
1	3-87	DESIGN	K.M.W.
2	3-87	T.G.O.	T.G.O.
3	4-87	M.K.S.	M.K.S.


RECORD DRAWING AS BUILT

SCALE
1" = 50' HORIZ.
1" = 10' VERT.


CITY OF ALBUQUERQUE
MUNICIPAL DEVELOPMENT DEPARTMENT
ENGINEERING DIVISION
TITLE: HERITAGE EAST - UNIT SIX
PALOMAS AVENUE, N.E.

APPROVALS	ENGINEER	DATE	APPROVALS	ENGINEER	DATE
City Engineer	4/23/87				
A.C.E. - Design	4-22-87				
A.C.E. - Hydrology	4-22-87				

DRAWING NO.	MAP NO.	SHEET	OF
3140	D-20	12	39

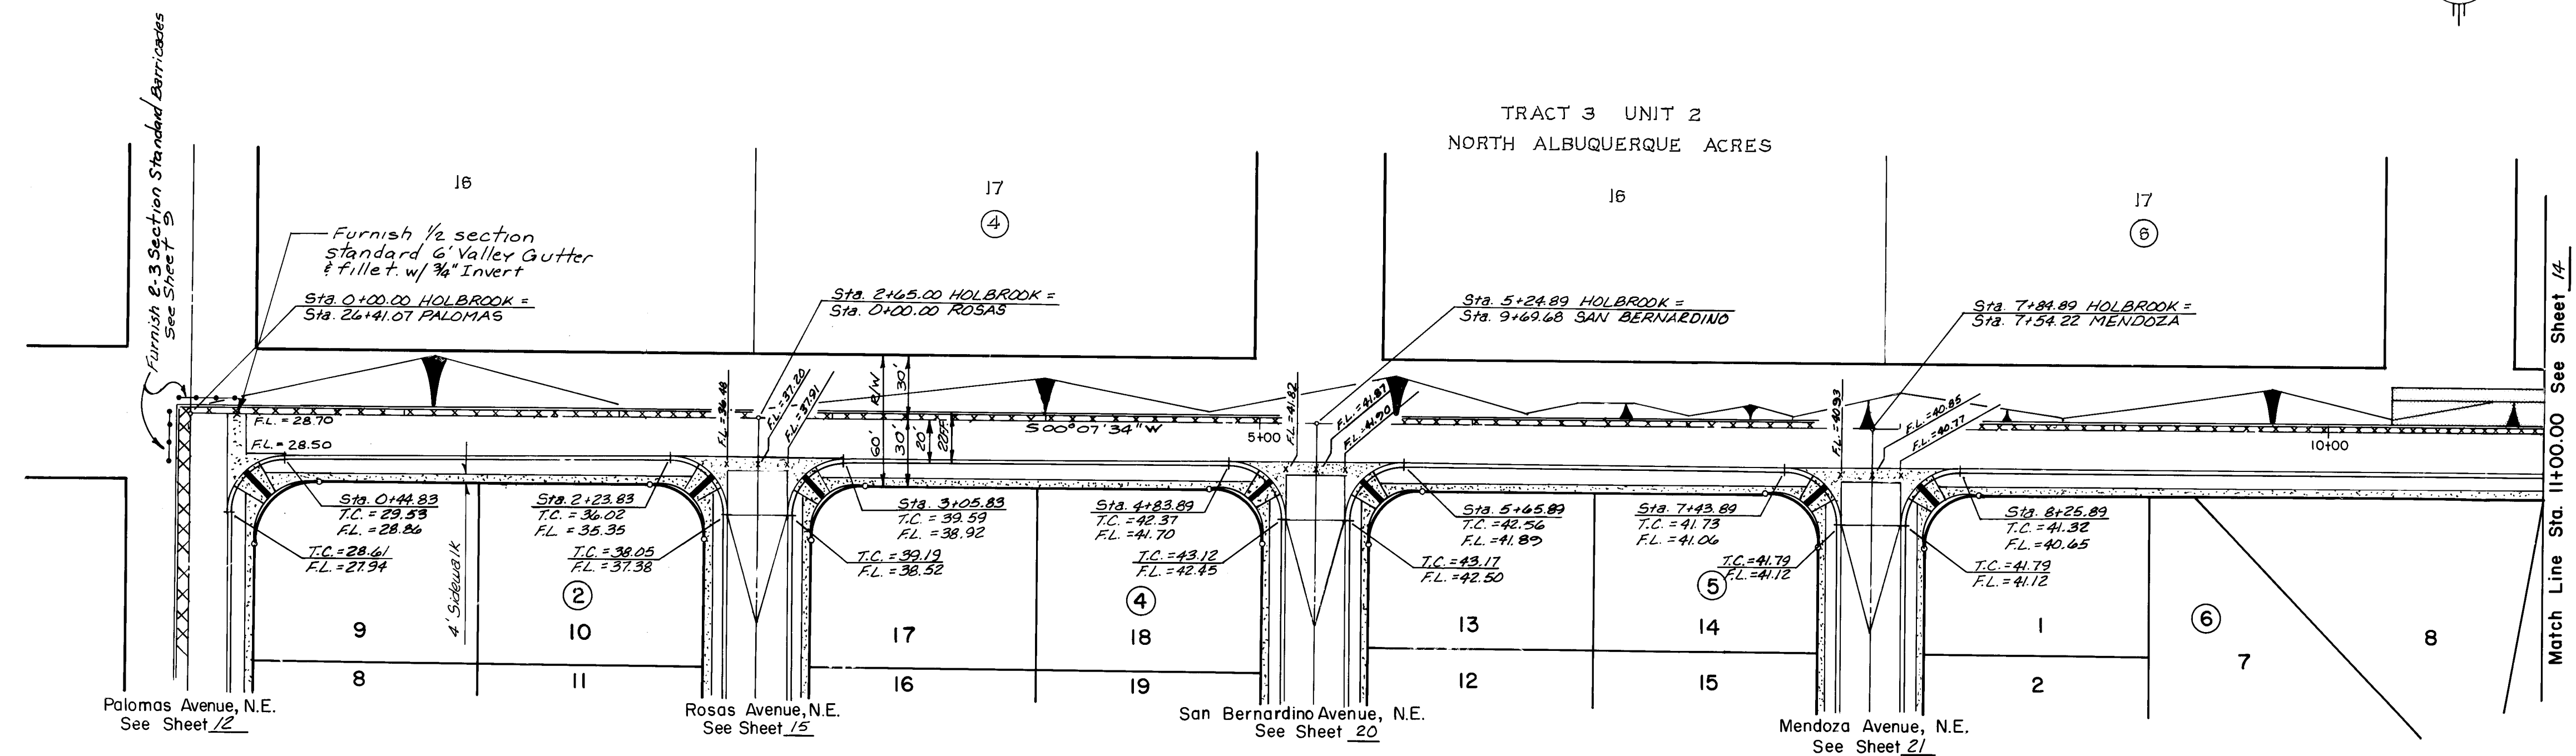

HOLBROOK STREET, N.E.
RESIDENTIAL PAVEMENT

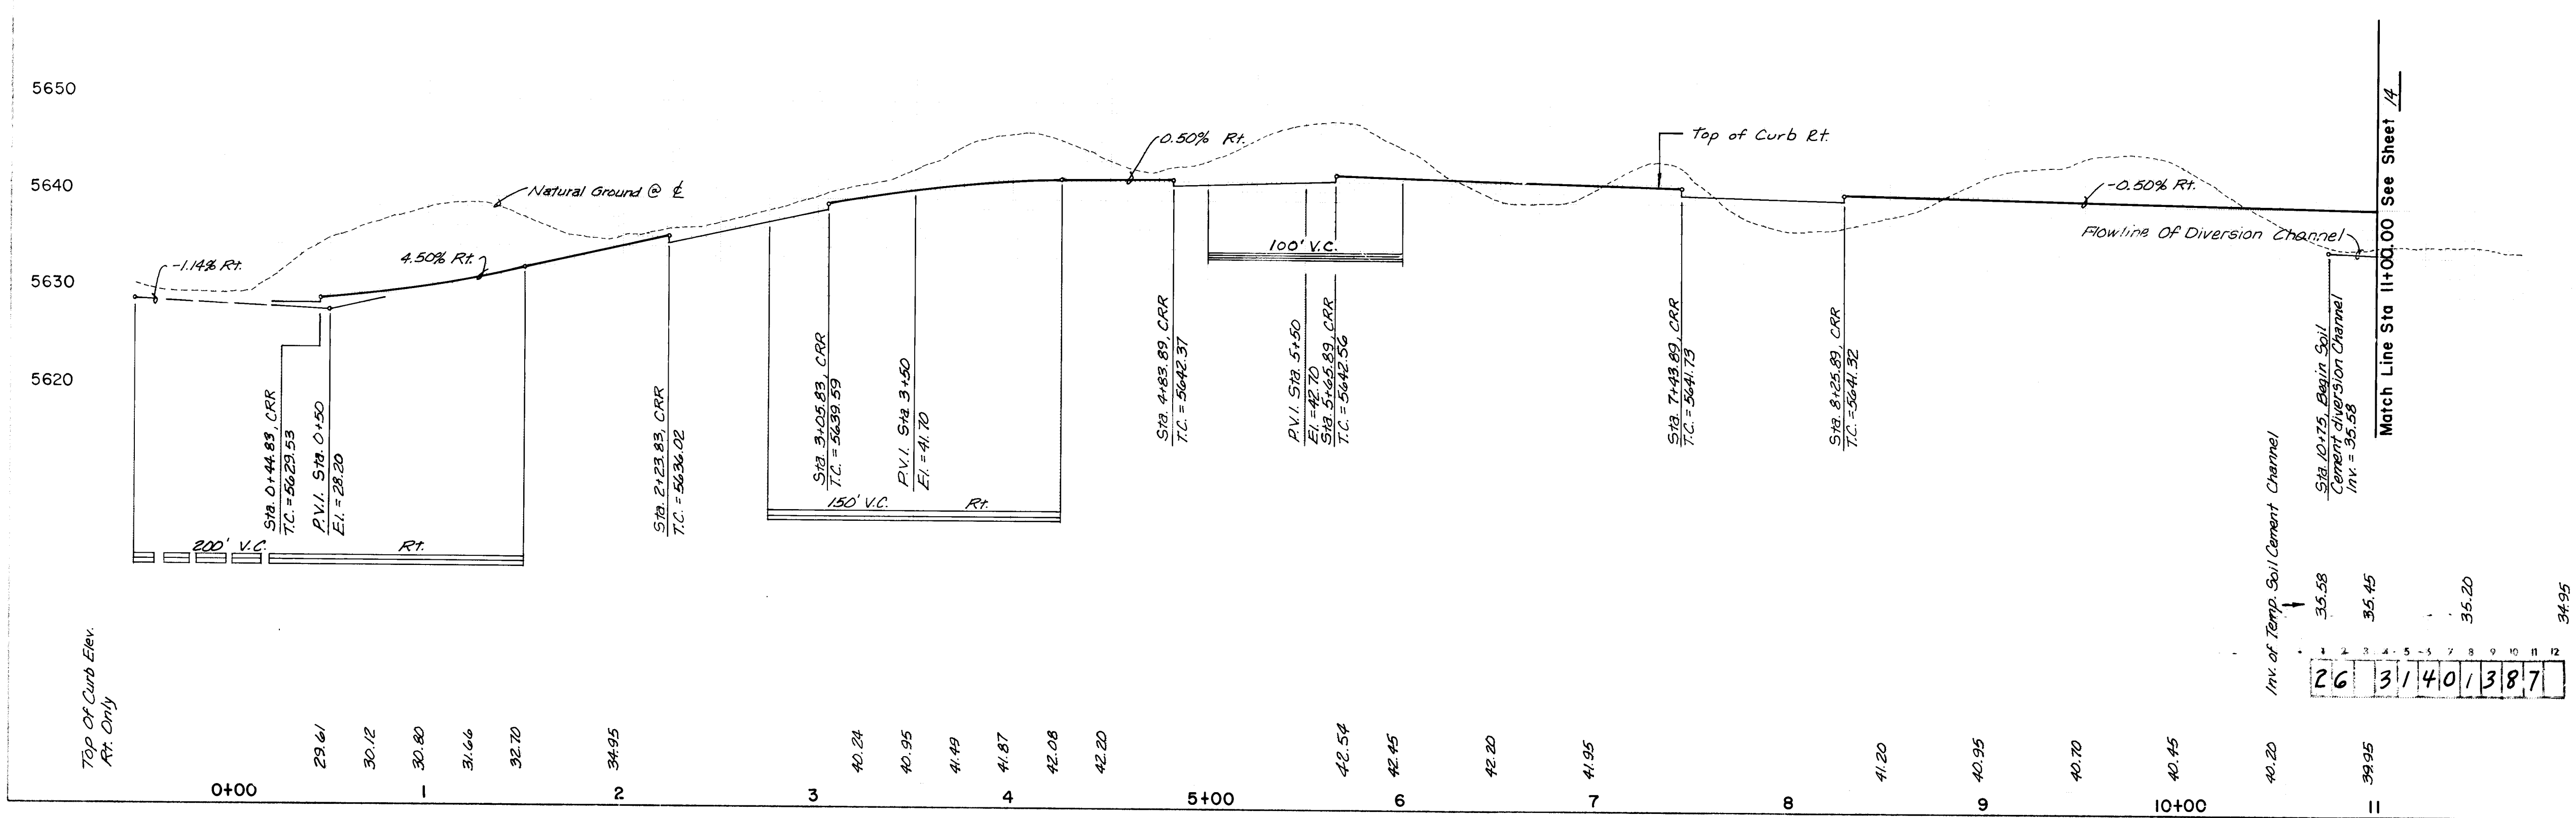

RECORD DRAWING AS BUILT


SCALE
1" = 50' HORIZ.
1" = 10' VERT.

CITY OF ALBUQUERQUE MUNICIPAL DEVELOPMENT DEPARTMENT ENGINEERING DIVISION					
TITLE HERITAGE EAST - UNIT SIX HOLBROOK STREET, N.E.					
APPROVALS	ENGINEER	DATE	APPROVALS	ENGINEER	DATE
City Engineer	<i>[Signature]</i>	4/22/87	Traffic	<i>[Signature]</i>	4-22-87
A.C.E. - Design	<i>[Signature]</i>	4-22-87	Water Utilities	<i>[Signature]</i>	4-22-87
A.C.E. - Hydrology	<i>[Signature]</i>	4-22-87			
DRAWING NO. 3140		MAP NO. D-20		SHEET 13 OF 39	

BRANCH MARKS
A.C.S. BRASS TABLET "1-C21A" SET IN THE
TOP OF CONCRETE POST FLUSH WITH GROUND AND
LOCATED AT THE NORTHEAST CORNER OF THE
INTERSECTION OF PASEO DEL NORTE (LOS
ANGELES DRIVE, N.E.) AND HOLBROOK STREET,
N.E. ELEVATION = 5634.65'


WYU CORP
GUTIERREZ
SURVEYING
D. Hanna
6-87
12-87
9-87

4/22/87
K. M. W. MCG.
M.C.G.
M.C.S.

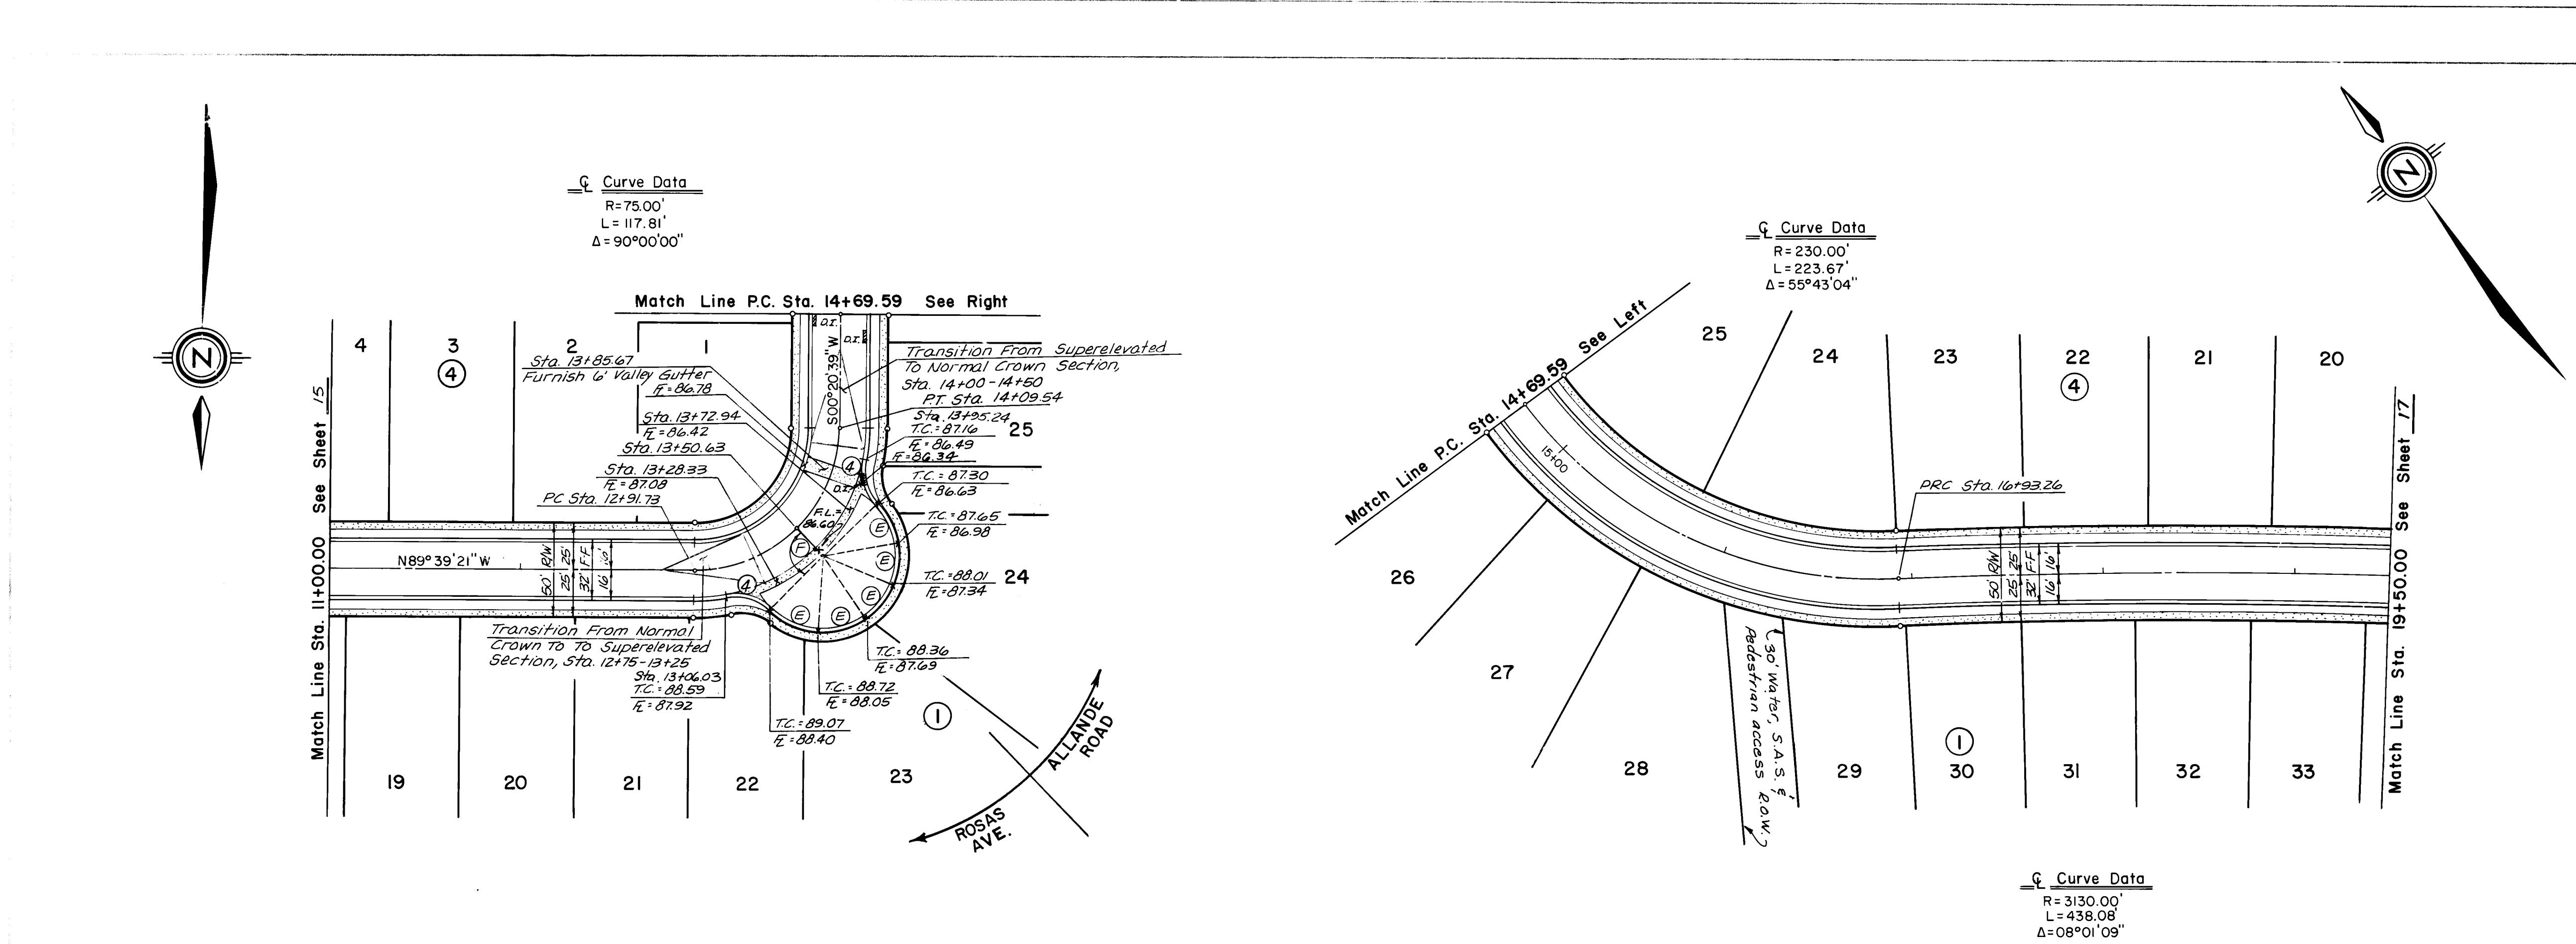

RESIDENTIAL PVMT.
ROSAS AVENUE, N.E.

RESIDENTIAL PVMT.
ALLANDE ROAD, N.E.

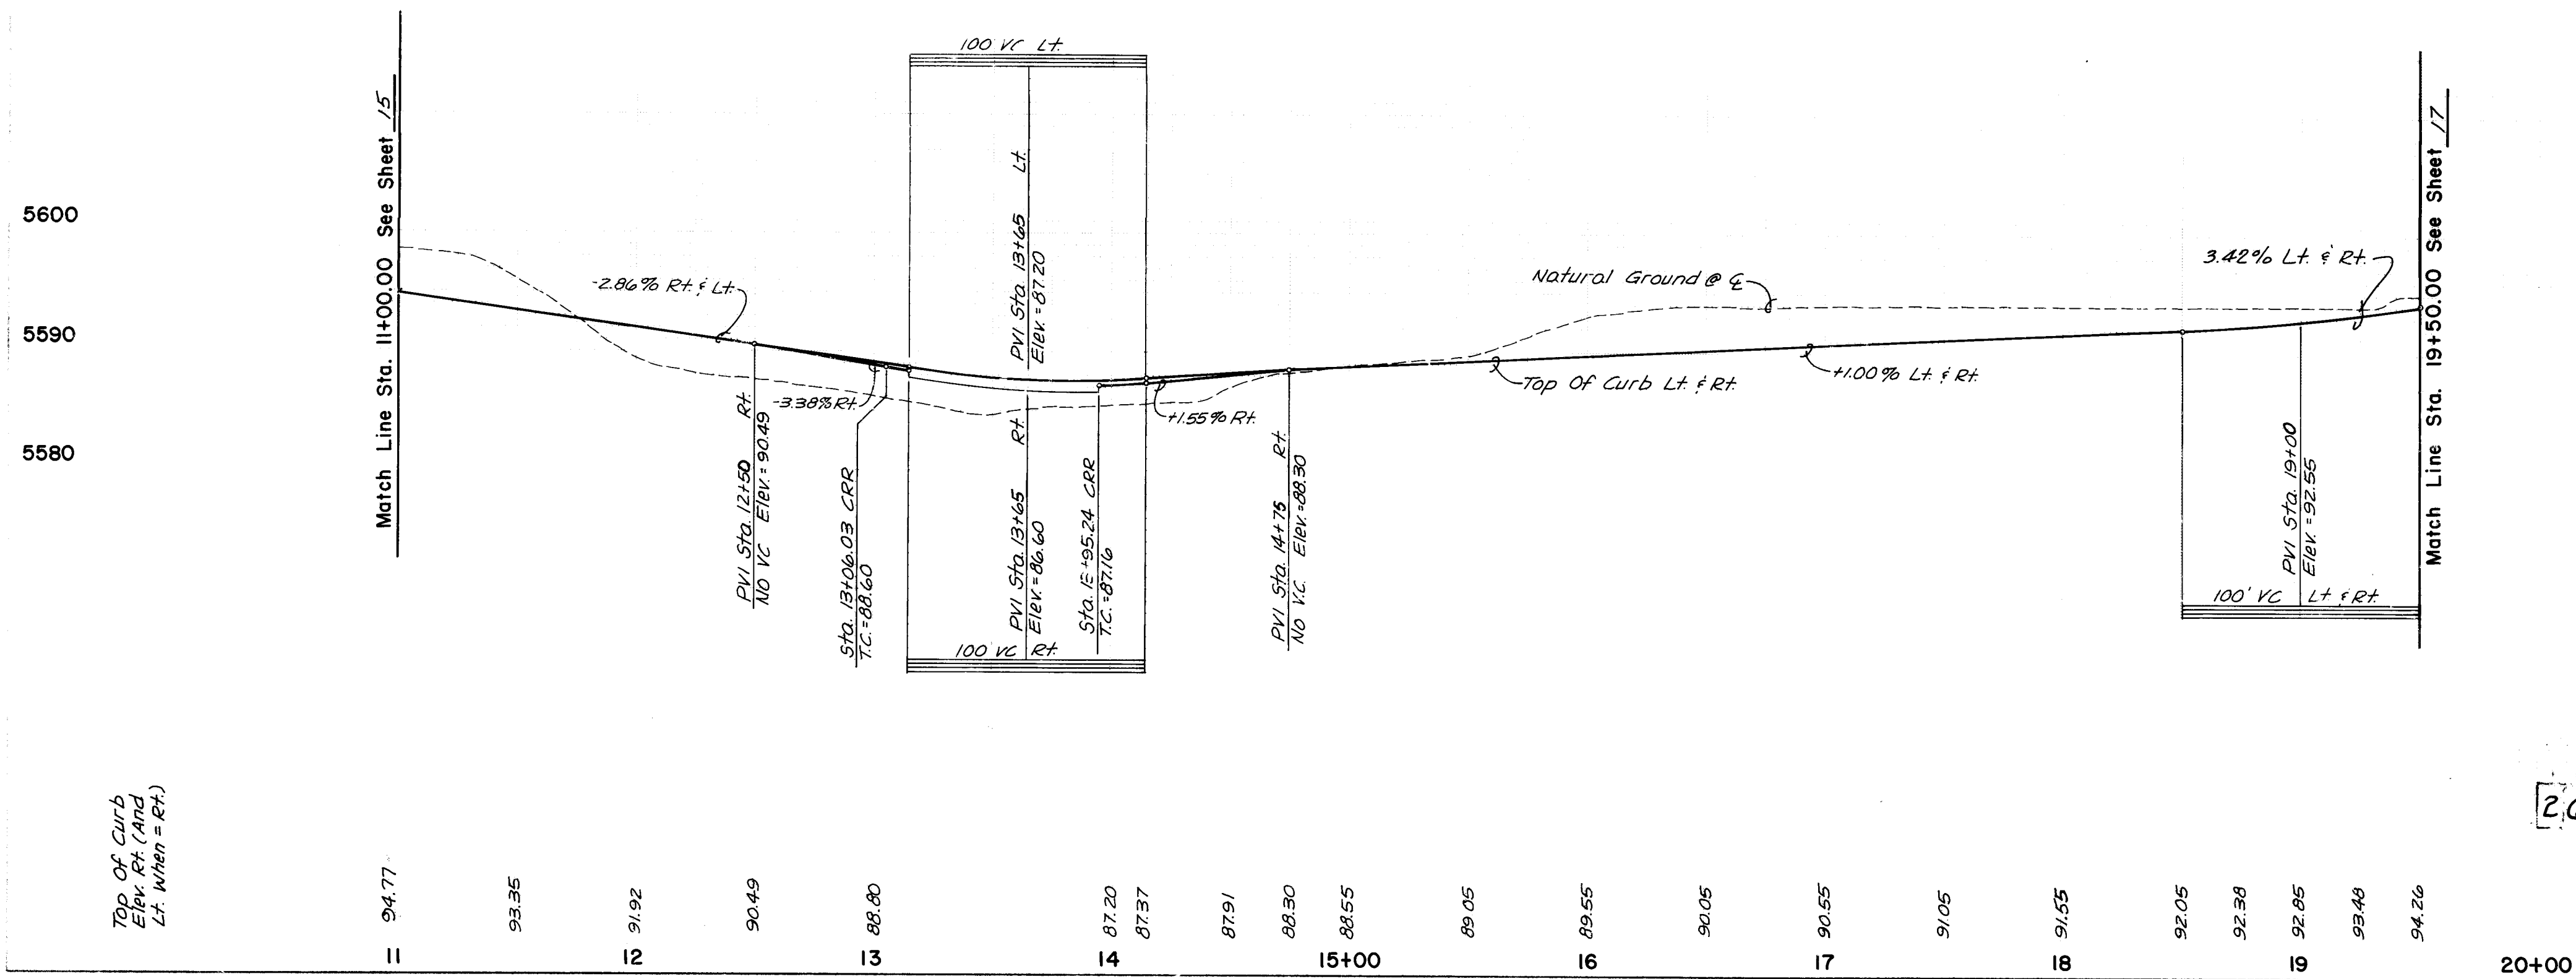

Curb Curve Data		
Curve	Radius	Arc
⑥	40.00'	24.87'
⑦	—	—
⑧	2500'	2399'

AS BUILT INFORMATION
WYLLIE CORP
SURVEYING
D. Herrera
DATE: 12-22-87
C.S.C.
N.E. ELEVATION = 5634.65'

BENCH MARKS
A.C.S. BRASS TABLET "1-C21A" SET IN THE TOP OF CONCRETE POST FLUSH WITH GROUND AND LOCATED AT THE NORTHEAST CORNER OF THE INTERSECTION OF PASO DEL NORTE (LOS ANGELES DRIVE, N.E.) AND HOLBROOK STREET, N.E. ELEVATION = 5634.65'

SURVEY INFORMATION
NO. 1
DATE: 12-22-87
C.S.C.

ENGINEER'S SEAL
KENT W. WHITMAN
REGISTERED PROFESSIONAL ENGINEER
NO. 1
DATE: 12-22-87
C.S.C.

NO.	DATE	REMARKS	BY
REVISIONS			
DESIGN			
1	12-1-87	K.M.W.	3-87
2	12-1-87	C.S.S.	3-87
3	12-1-87	M.K.S.	4-87

RECORD DRAWING AS BUILT

SCALE
1"=50'HORIZ.
1"=10'VERT.

CITY OF ALBUQUERQUE
MUNICIPAL DEVELOPMENT DEPARTMENT
ENGINEERING DIVISION

TITLE: HERITAGE EAST - UNIT SIX
ROSAS AVENUE, N.E. & ALLANDE ROAD, N.E.

APPROVALS	ENGINEER	DATE	APPROVALS	ENGINEER	DATE
City Engineer	Amel	4/22/87	Traffic	Douglas Hernandez	4/22/87
A.C.E. - Design	Amel	4-22-87	Water Utilities	WJW	4-22-87
A.C.E. - Hydrology	CAM	4-22-87			

DRAWING NO. 3140 MAP NO. D-20 SHEET 16 OF 39

Top of curb
Elev. Lt. (When
Rt.)




Top of curb Elev.
Elev. (And Lt. when
= Rt.)

RESIDENTIAL PAVEMENT
ALLANDE ROAD, N.E.

CURVE DATA
R=320'
L=237.47'
Δ=42°31'10"

QUARTER POINT ELEVATIONS
1) FL=38.27
2) FL=38.27
3) FL=38.52

QUARTER POINT ELEVATIONS
1) FL=38.34
2) FL=38.34
3) FL=38.09

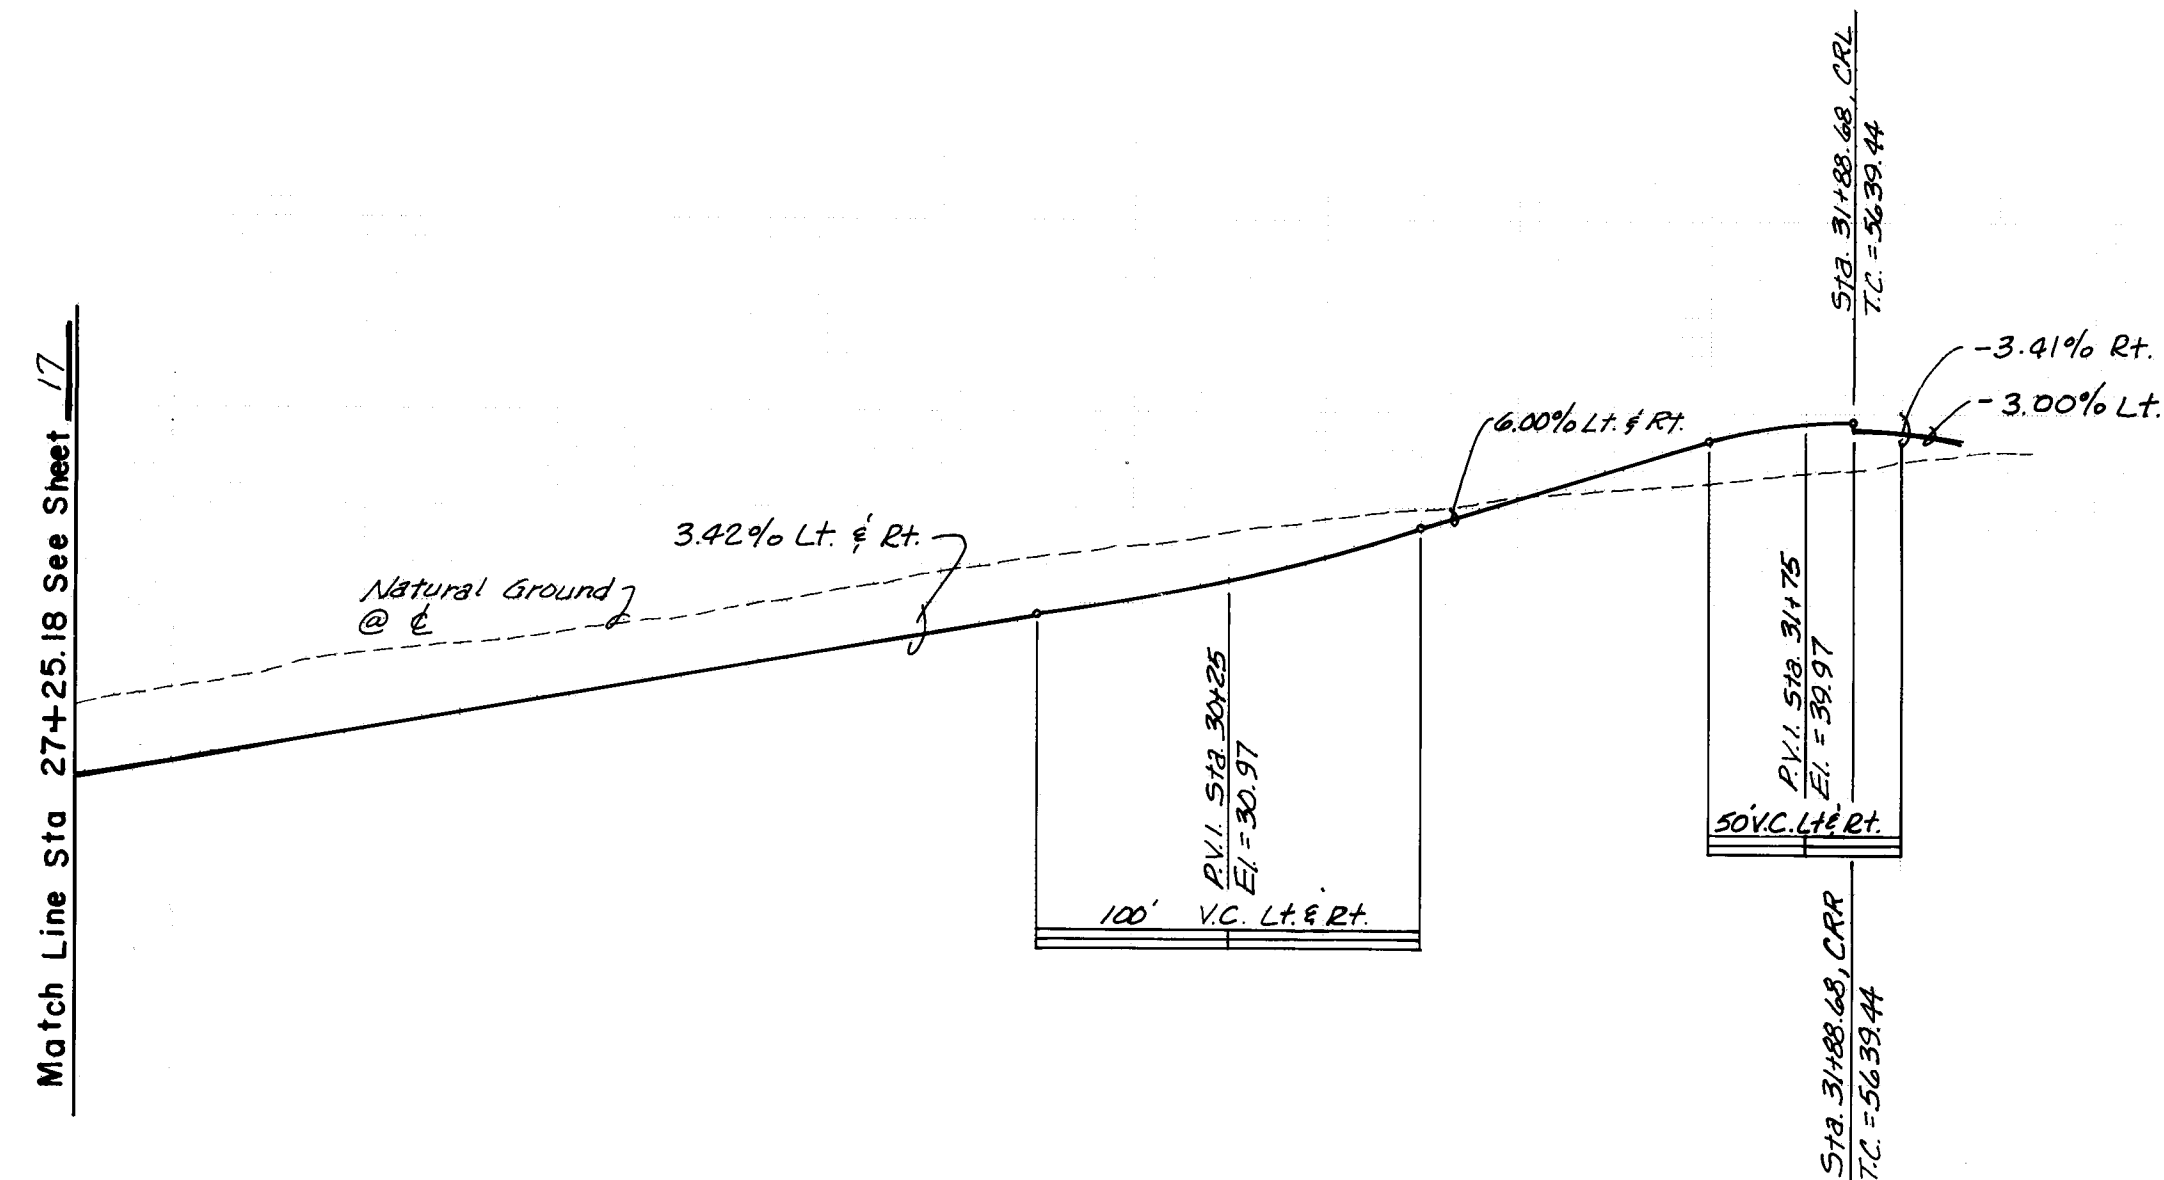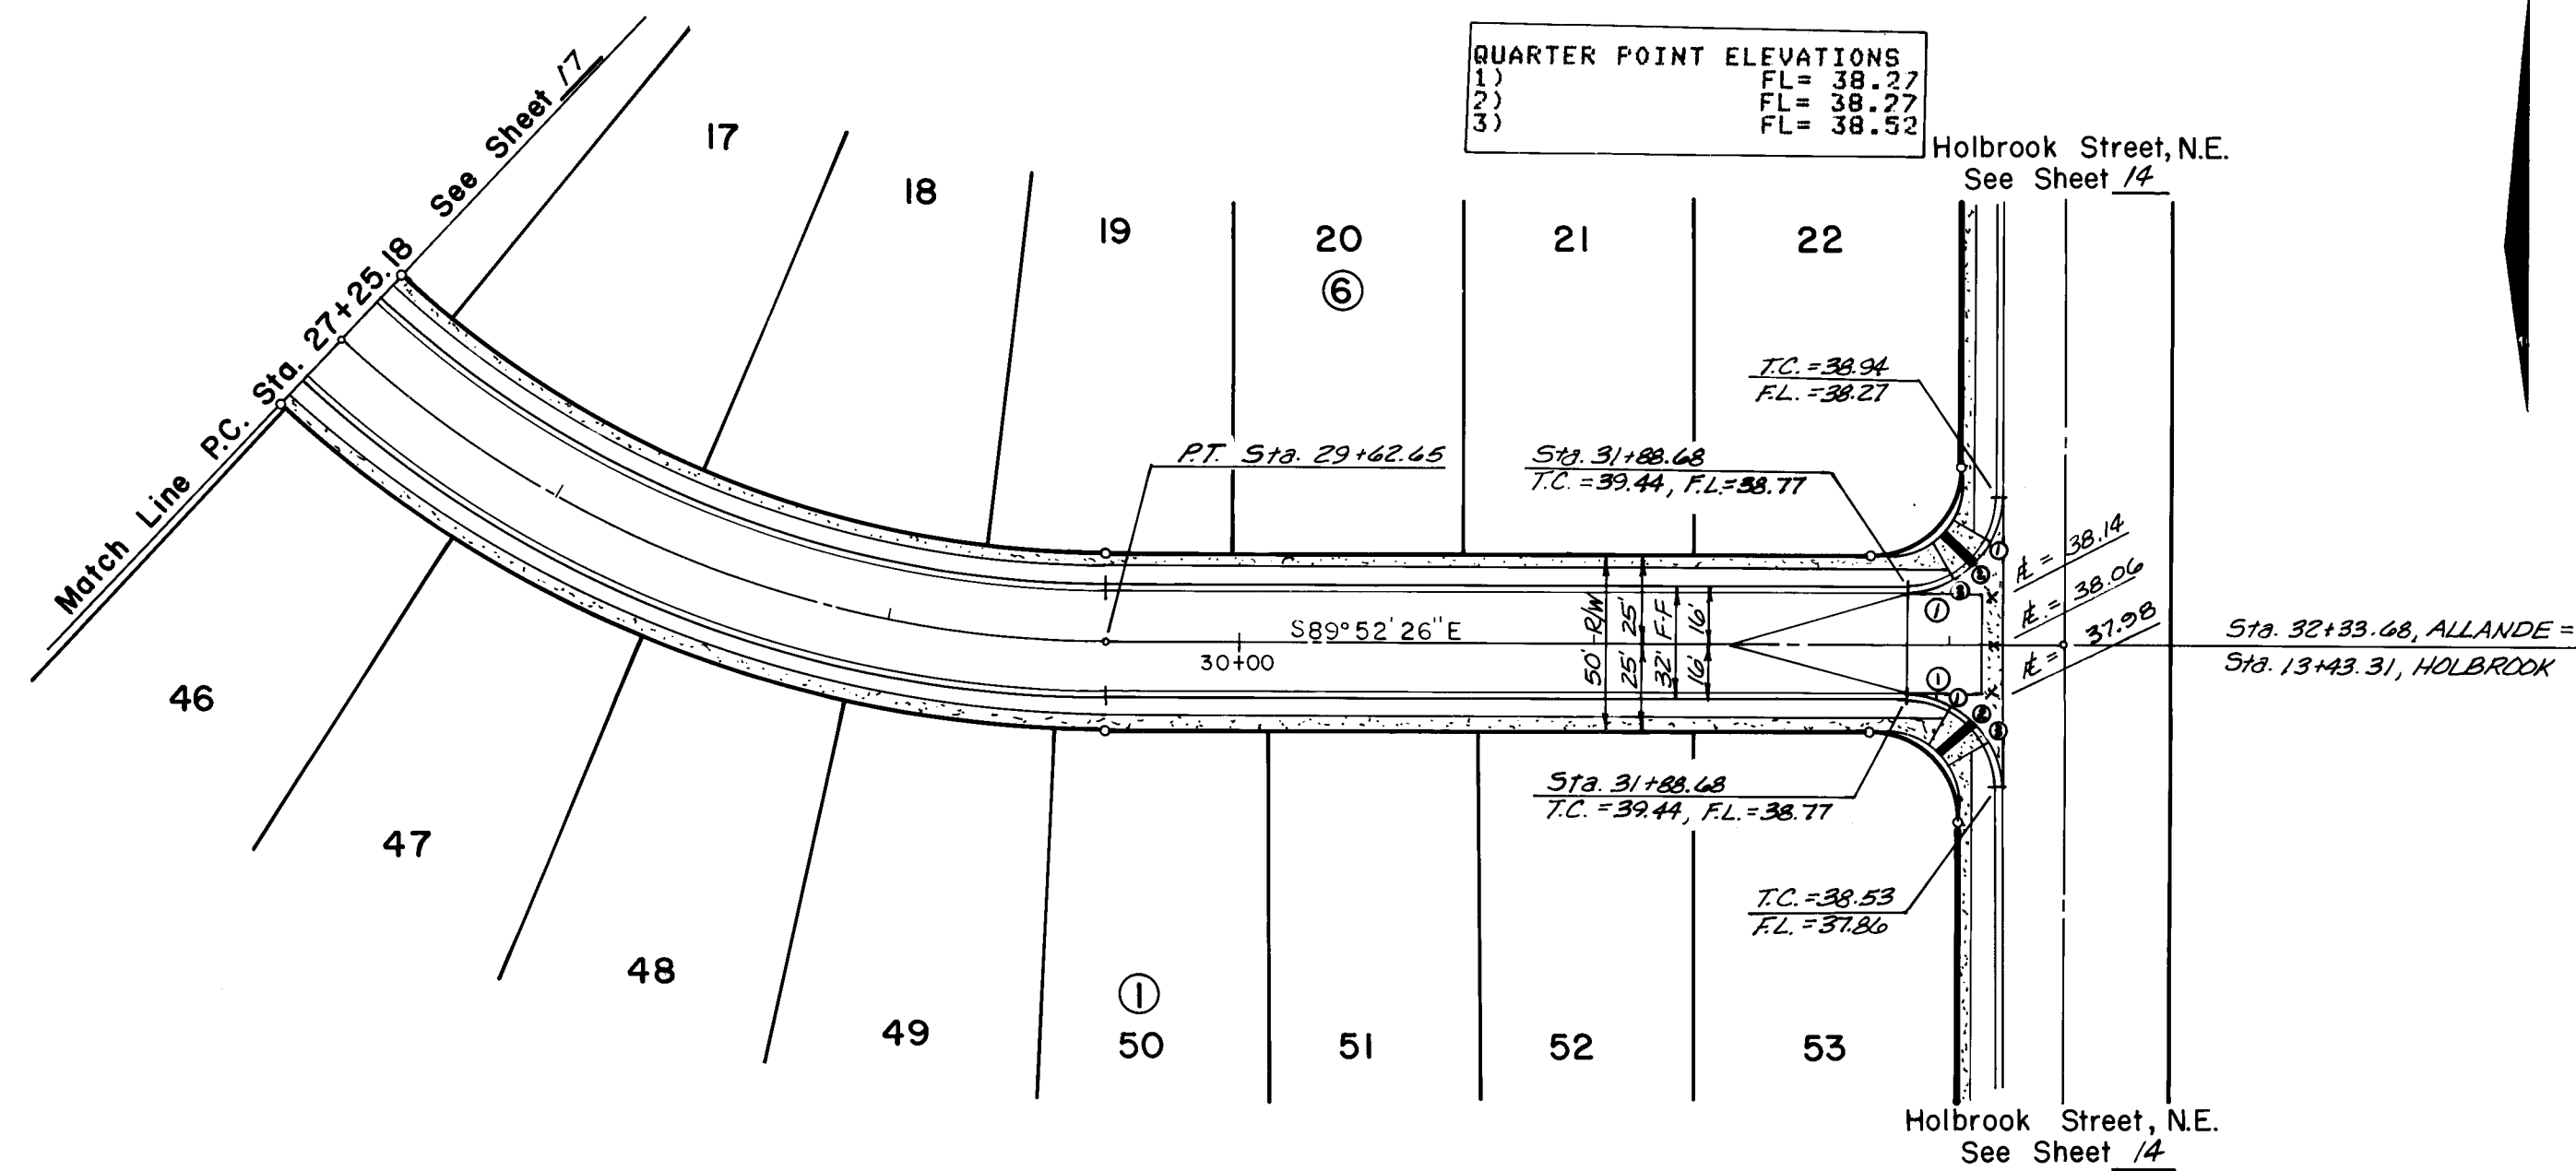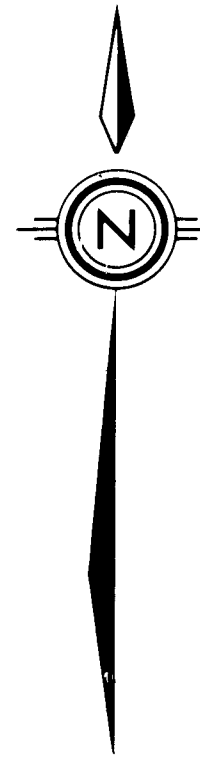

26 31401887

Curve Data			
Curve	Radius	Arc	Delta
①	2500'	39.27'	90°00'00"

AS BUILT INFORMATION
WYLLIE CORP.
GUTIERREZ
SURVEYING
D. Herrera
DATE: 12/28/87
BY: M.C.S.
CHECKED BY: M.C.S.

BENCH MARKS
A.C.S. BRASS TABLE "1-C21A" SET IN THE
TOP OF CONCRETE POST FLUSH WITH GROUND AND
LOCATED AT THE NORTHEAST CORNER OF THE
INTERSECTION OF PASEO DEL NORTE (LOS
ANGELES DRIVE, N.E.) AND HOLBROOK STREET,
N.E. ELEVATION = 5634.65'

SURVEY INFORMATION
FIELD NOTES
NO. 1
DATE 3/87
BY M.C.S.

ENGINEER'S SEAL
KENT N. WHITMAN
REGISTERED PROFESSIONAL ENGINEER
No. 9978
4/23/87

REVISIONS
BY DATE
DESIGN DATE 3/87
DRAWN BY M.C.S. DATE 3/87
CHECKED BY M.C.S. DATE 4/87

RECORD DRAWING AS BUILT


SCALE
1"=50'HORIZ.
1"=10'VERT.

CITY OF ALBUQUERQUE
MUNICIPAL DEVELOPMENT DEPARTMENT
ENGINEERING DIVISION


TITLE: HERITAGE EAST - UNIT SIX
ALLANDE ROAD, N.E.

APPROVALS	ENGINEER	DATE	APPROVALS	ENGINEER	DATE
City Engineer	Arthur	4/20/87	Traffic	David	4/22/87
A.C.E. - Design	Rob	4-22-87	Water Utilities	W/O	4-22-87
A.C.E. - Hydrology	CAM	4-22-87			

DRAWING NO. 3140 MAP NO. D-20 SHEET 18 OF 39

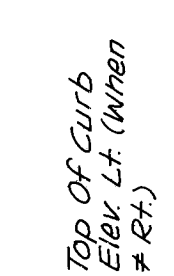

DRAWING NO	3140	MAP NO	D-20	SHEET	OF	19	39
---------------	------	--------	------	-------	----	----	----

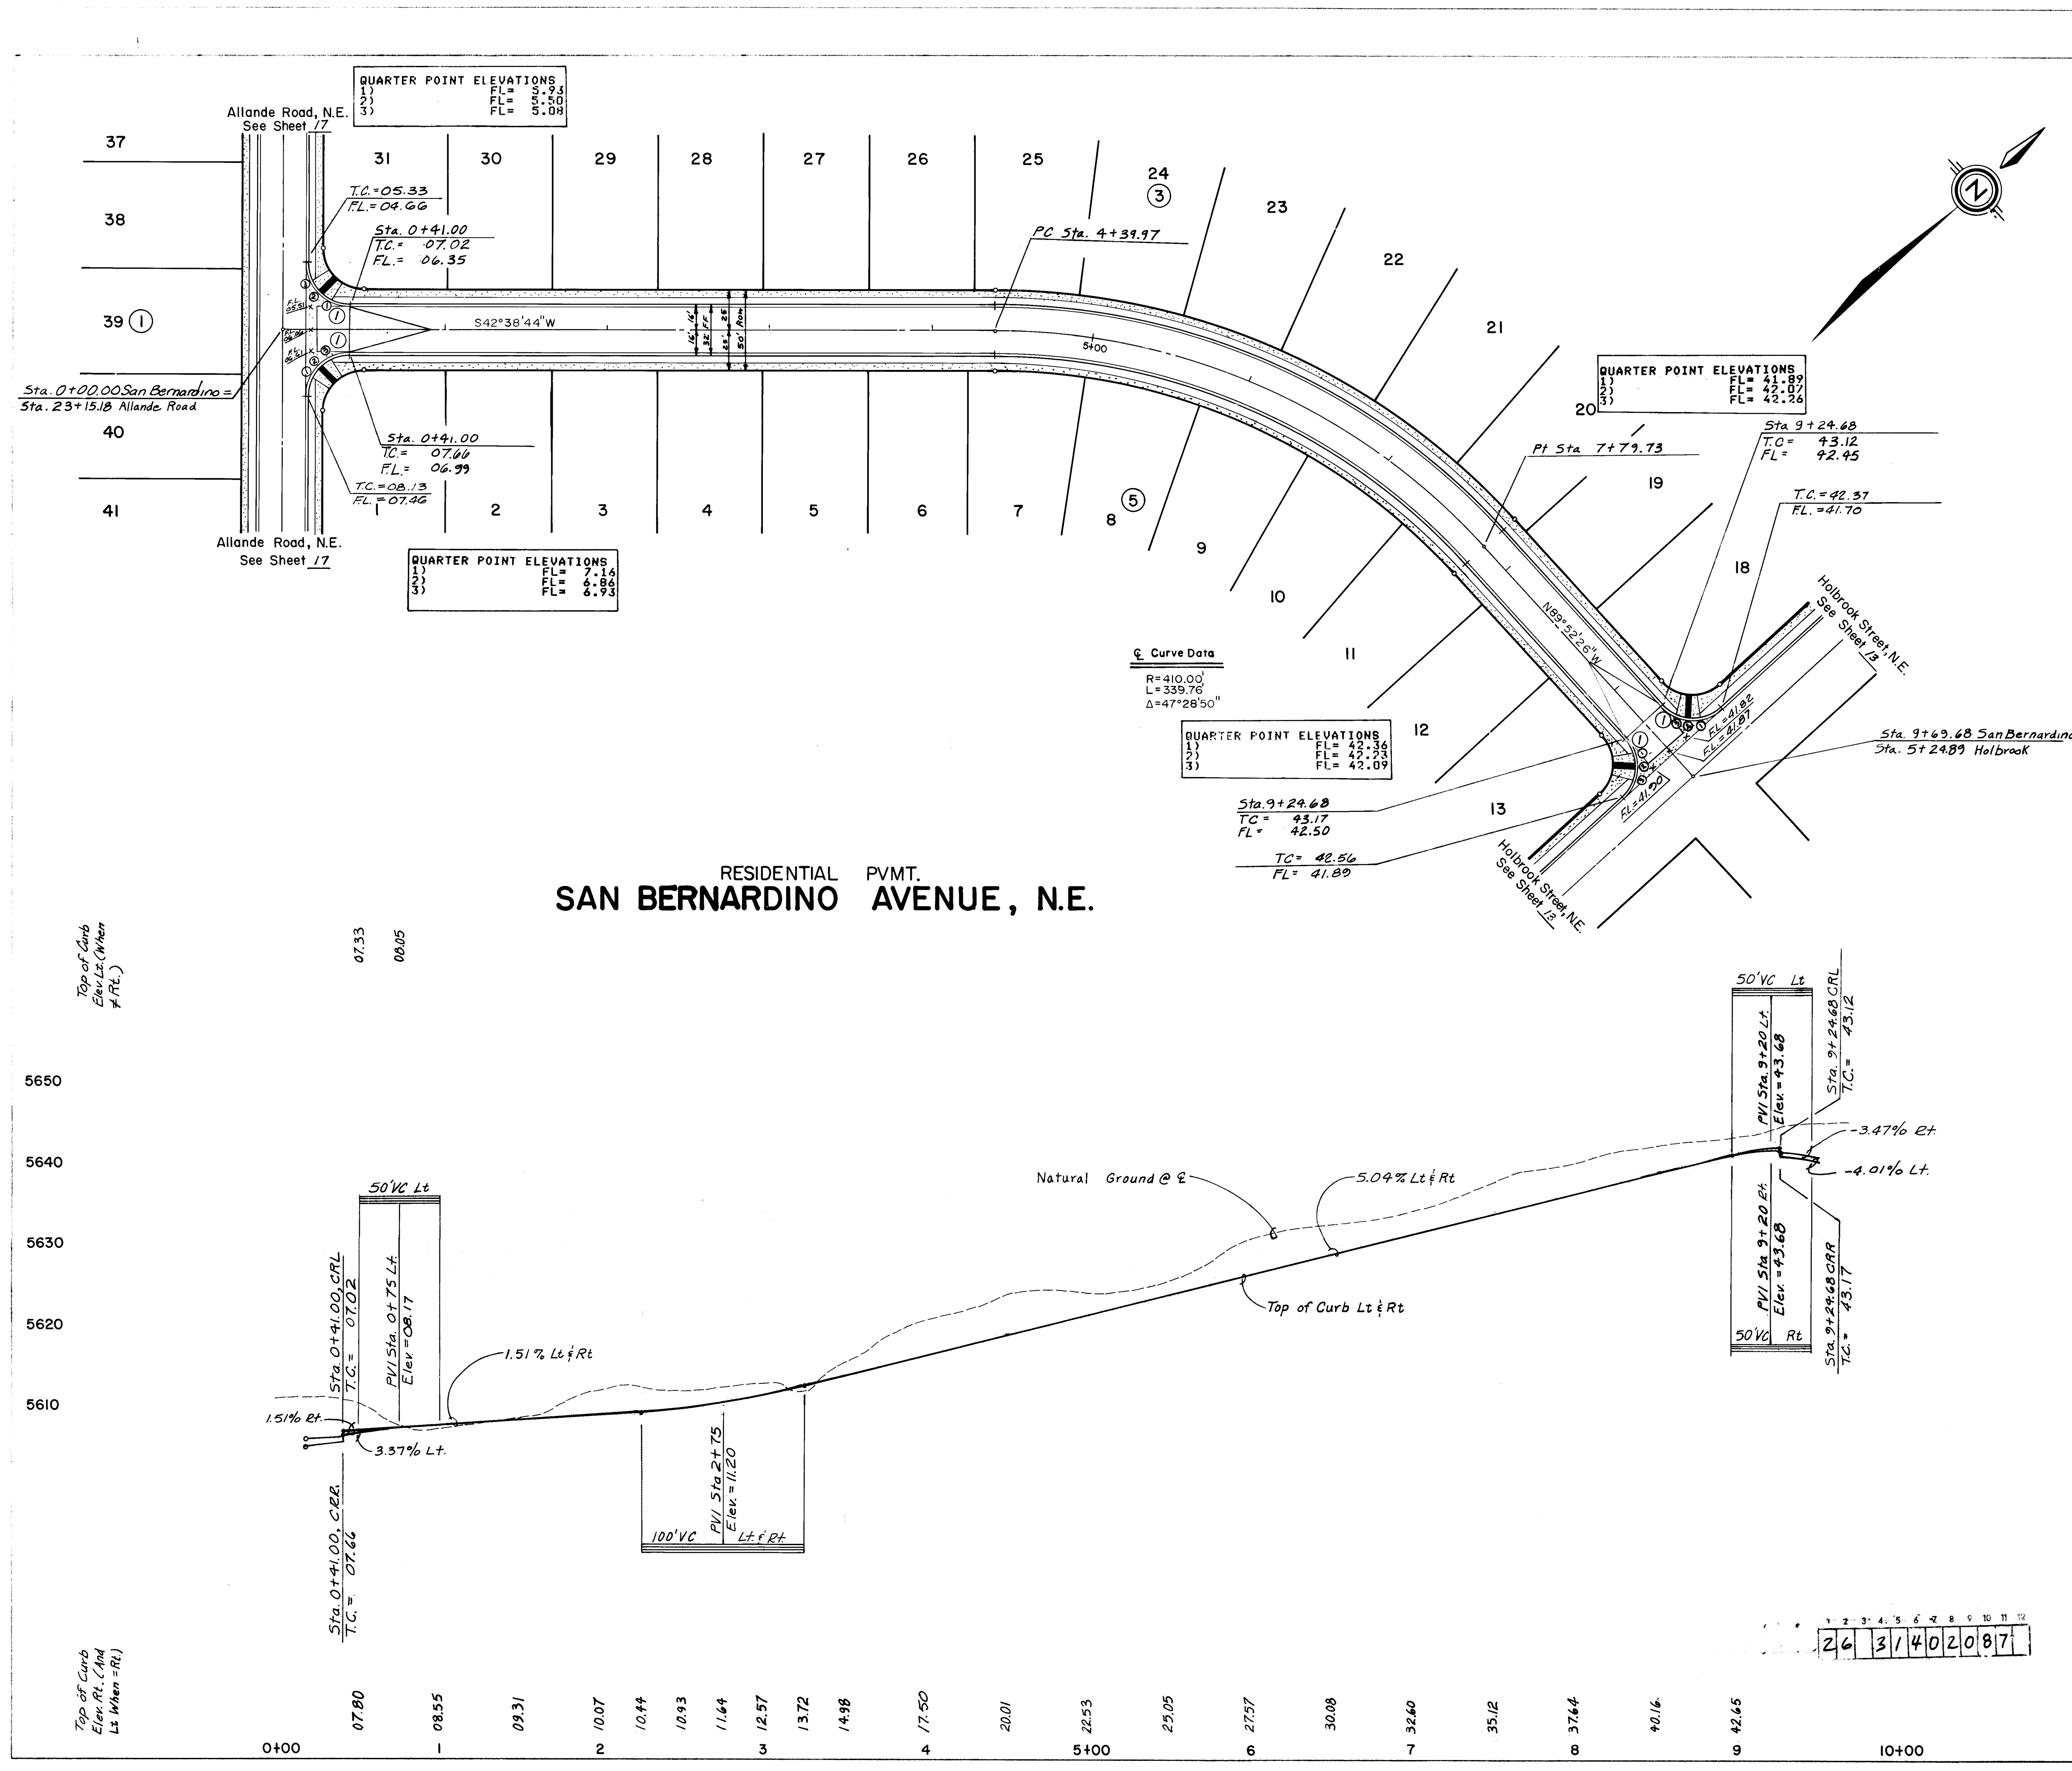

Curb Curve Data			
Curve	Radius	Arc	Delta
①	25.00'	39.27'	90°00'00"

WYLLIE CORP.
CUTTING
SURVISING
D. Herrera
C.S.C.
12-87
9-87

A.C.S. BRASS TABLE "1-C21A" SET IN THE TOP OF CONCRETE POST FLUSH WITH GROUND AND LOCATED AT THE NORTHEAST CORNER OF THE INTERSECTION OF PASO DEL NORTE (LOS ANGELES DRIVE, N.E.) AND HOLBROOK STREET, N.E. ELEVATION = 5634.65'


RECORD DRAWING AS BUILT

SCALE
1"=50'HORIZ.
1"=10' VERT.


CITY OF ALBUQUERQUE
MUNICIPAL DEVELOPMENT DEPARTMENT
ENGINEERING DIVISION

TITLE HERITAGE EAST - UNIT SIX
SAN BERNARDINO AVENUE, N.E.

REVISIONS		DATE	BY
1	DATE	DATE	DATE
2	DATE	DATE	DATE
3	DATE	DATE	DATE
4	DATE	DATE	DATE
5	DATE	DATE	DATE
6	DATE	DATE	DATE
7	DATE	DATE	DATE
8	DATE	DATE	DATE
9	DATE	DATE	DATE
10	DATE	DATE	DATE
11	DATE	DATE	DATE
12	DATE	DATE	DATE

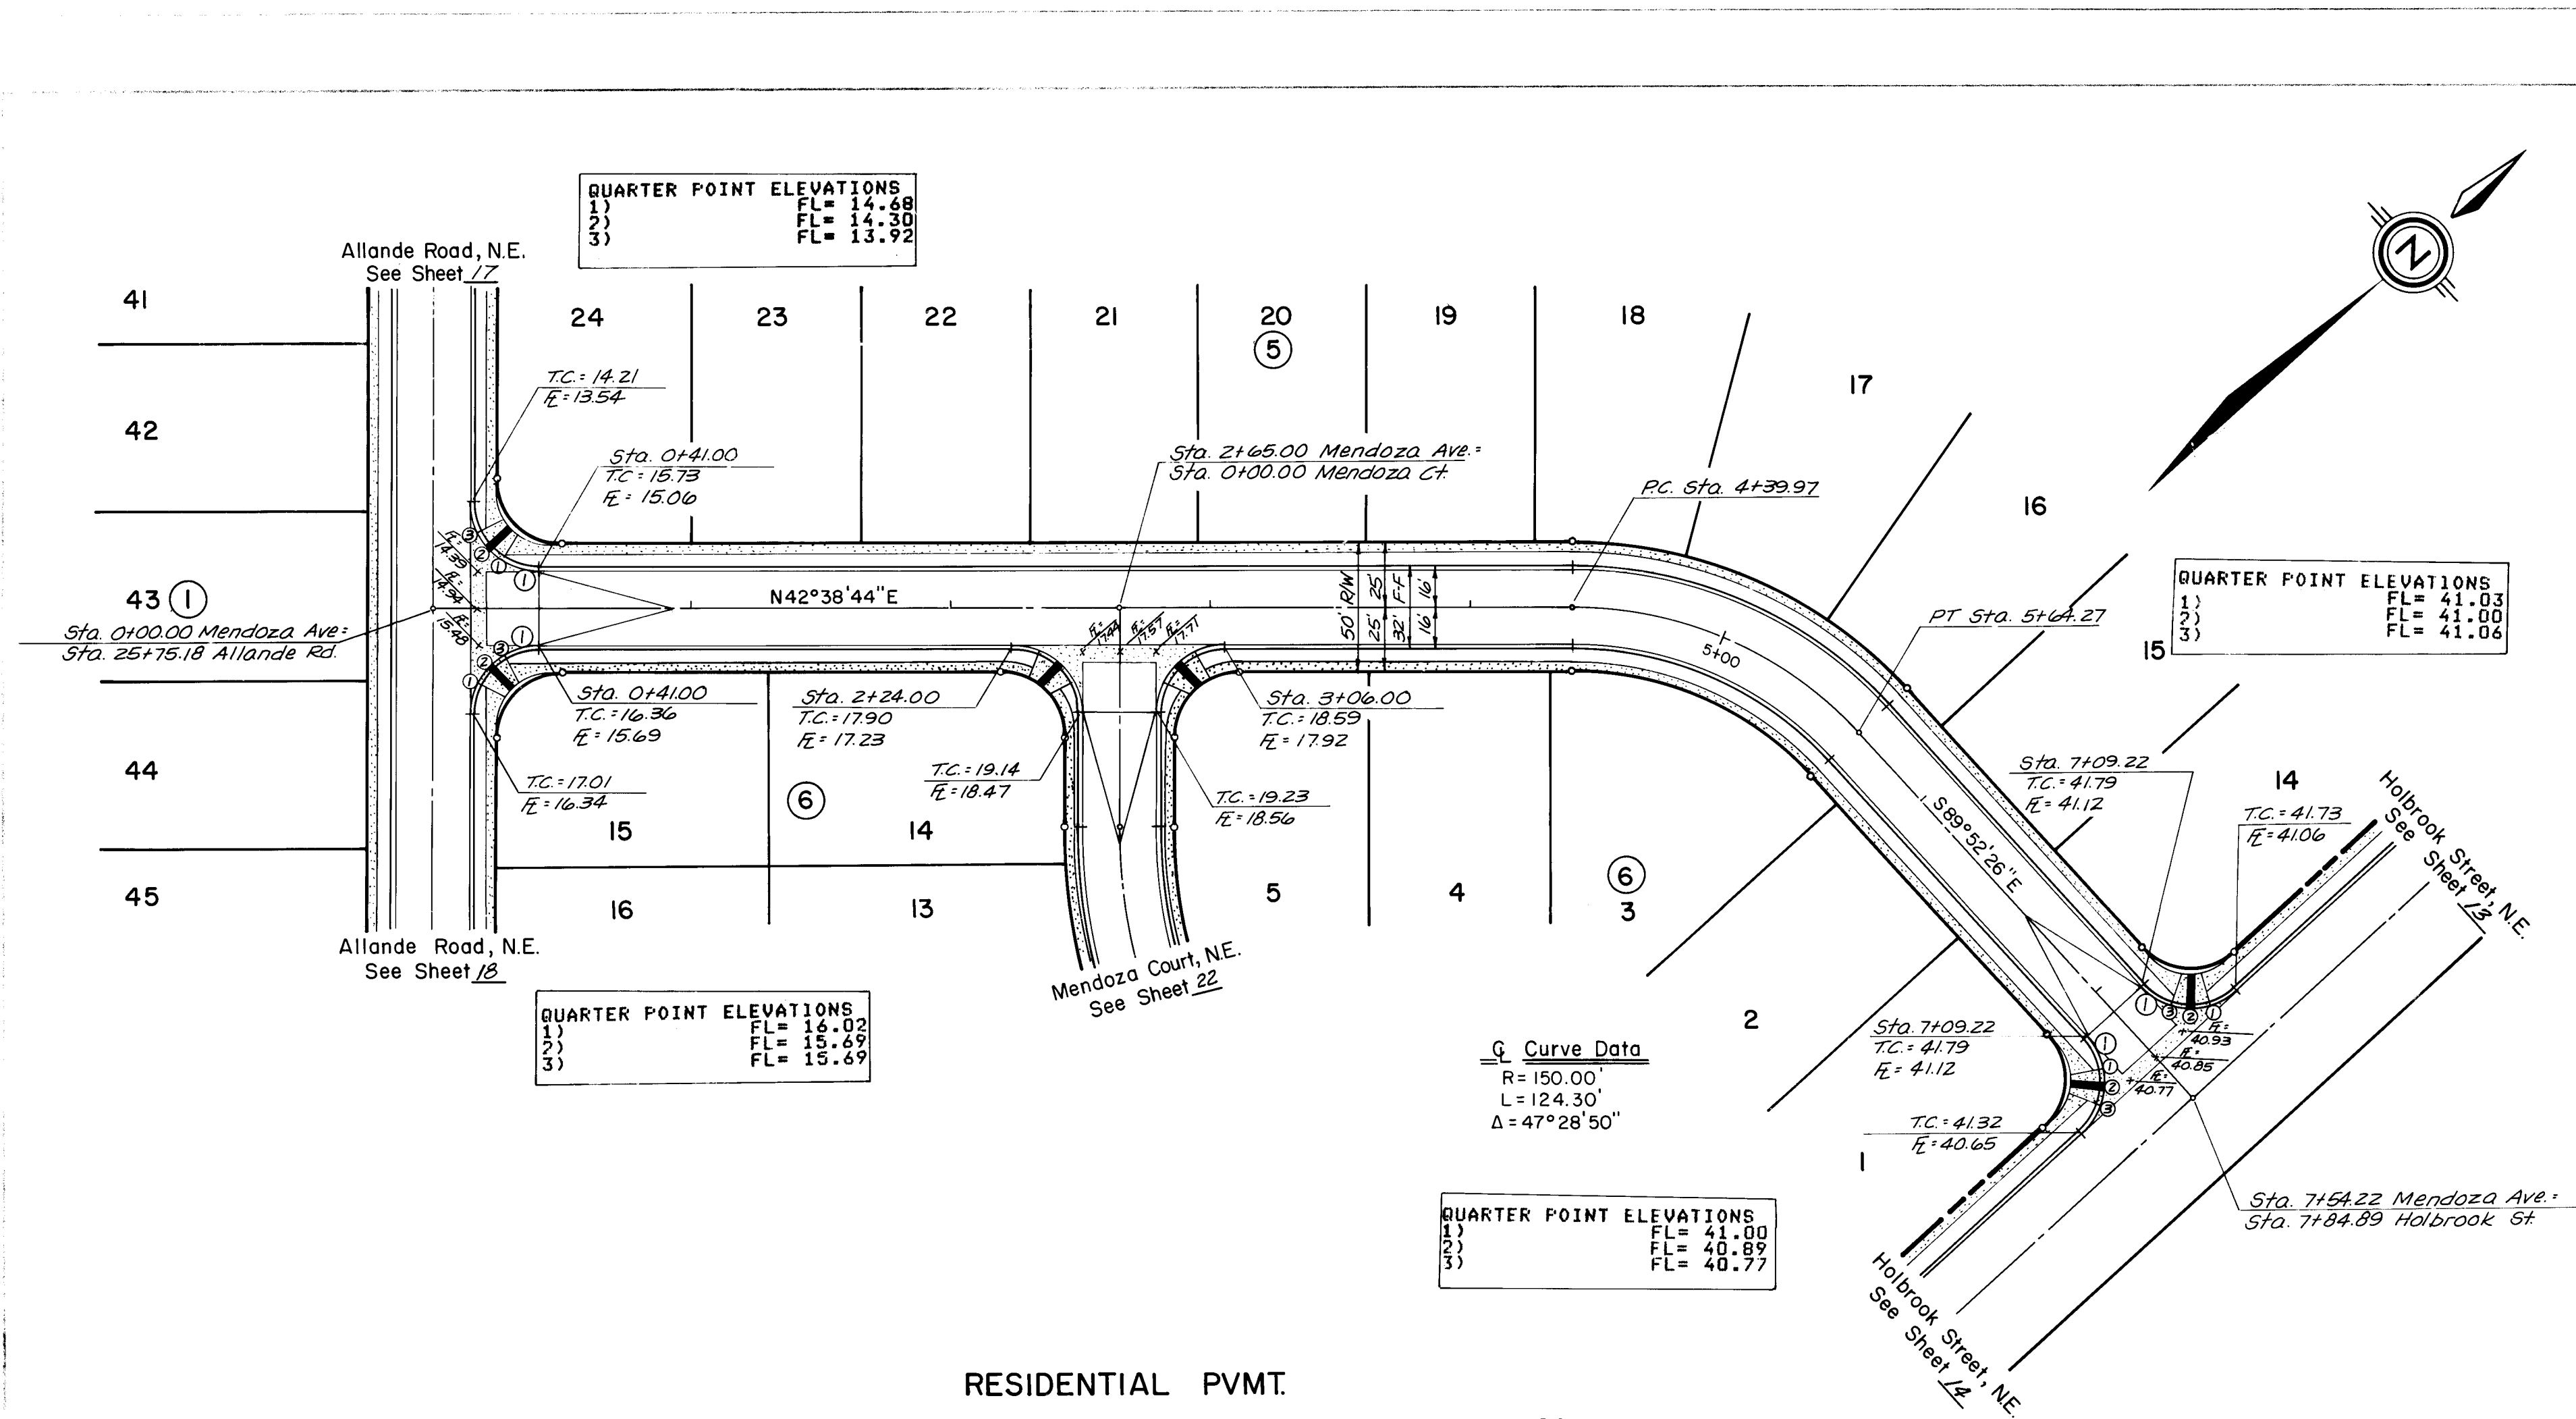

RESIDENTIAL PVMT.
MENDOZA AVENUE, N.E.

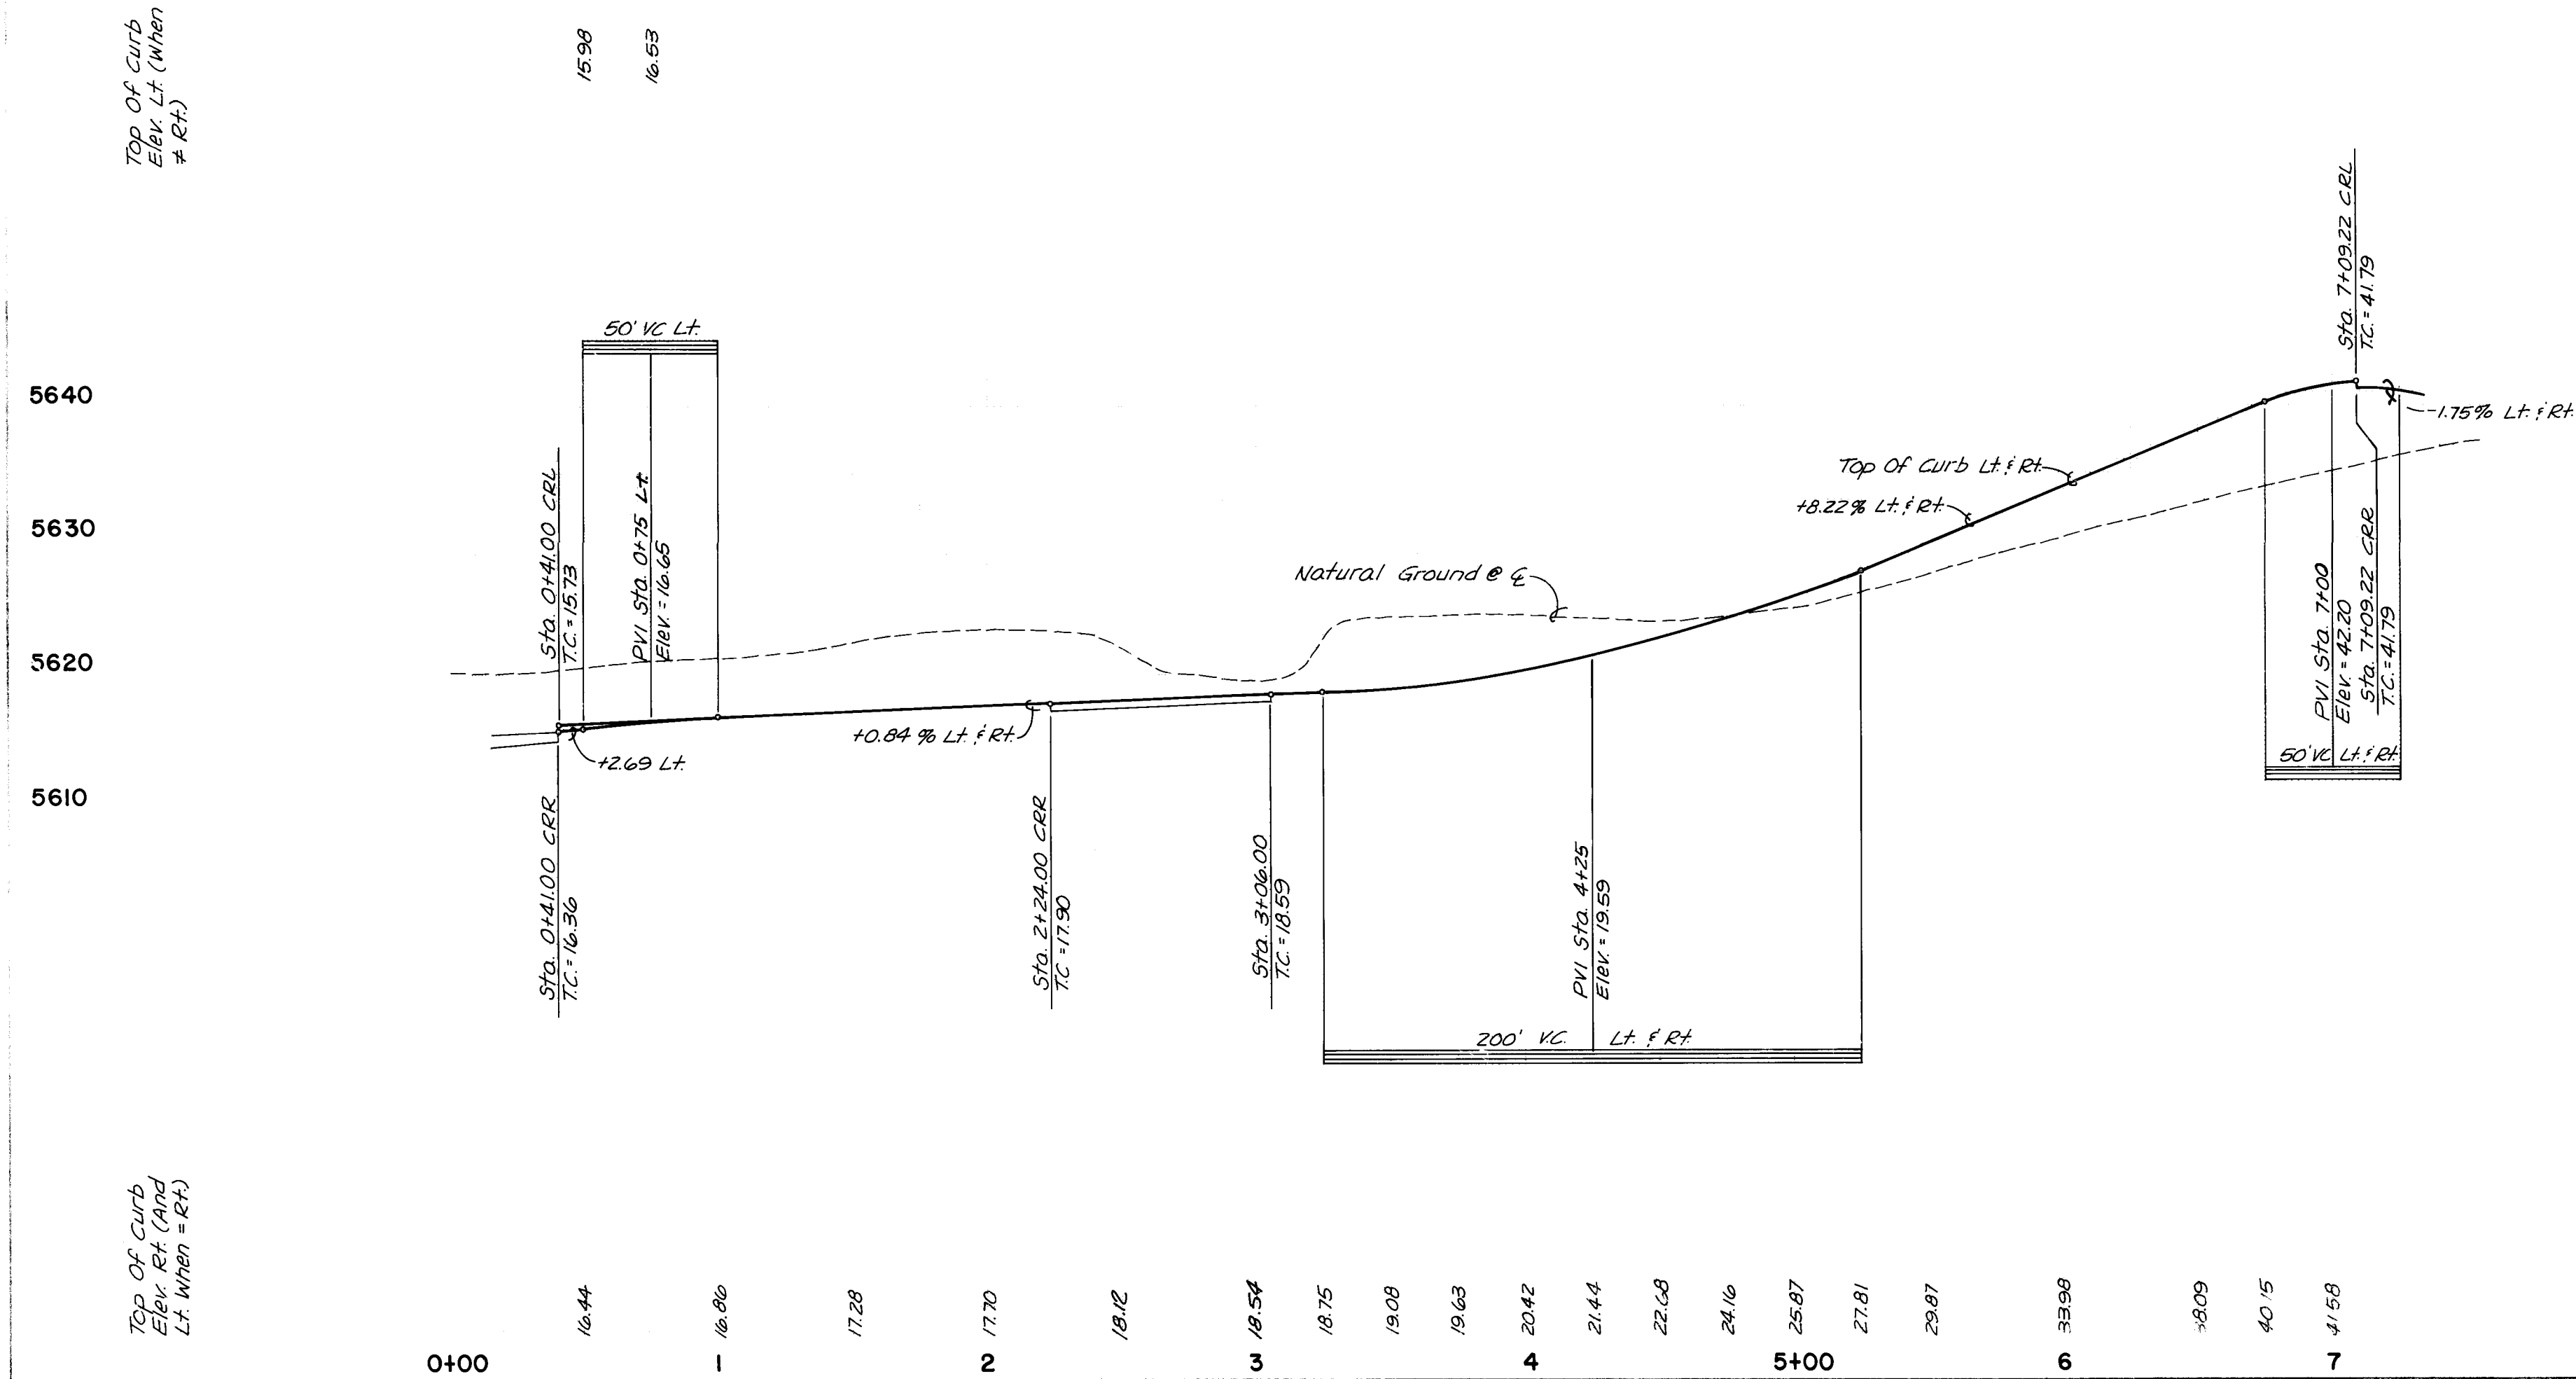


Curb Curve Data			
Curve	Radius	Arc	Delta
①	25.00'	39.27'	90°00'00"

WYKIE CORP.
SURVEYING
D. Herrera
C.S.C.
6-87
12-87
9-87

BRASS TABLE "1-C21A" SET IN THE TOP OF CONCRETE POST FLUSH WITH GROUND AND LOCATED AT THE NORTHEAST CORNER OF THE INTERSECTION OF PASO DEL NORTE (LOS ANGELES DRIVE, N.E.) AND HOLBROOK STREET, N.E. ELEVATION = 5634.65'

RESIDENTIAL PVMT.
MENDOZA AVENUE, N.E.

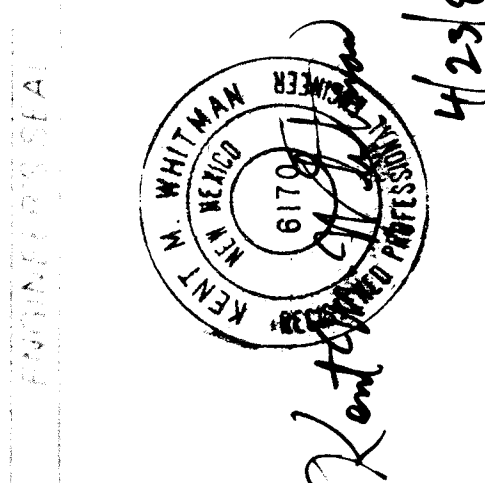


REVISIONS	DATE	BY
DESIGN	3-87	K.M.W.
	3-87	C.S.S.
	4-87	M.K.S.


RECORD DRAWING AS BUILT
SCALE: 1"=50' HORIZ., 1"=10' VERT.

CITY OF ALBUQUERQUE
MUNICIPAL DEVELOPMENT DEPARTMENT
ENGINEERING DIVISION
TITLE HERITAGE EAST - UNIT SIX
MENDOZA AVENUE, N.E.



APPROVALS	ENGINEER	DATE	APPROVALS	IN CHARGE	DATE
City Engineer	<i>[Signature]</i>	4/2/87	Traffic	<i>[Signature]</i>	4/22/87
A.C.E. Design	<i>[Signature]</i>	4-22-87	Water Utilities	<i>[Signature]</i>	4-22-87
A.C.E. Hydrology	CAM	4-22-87			

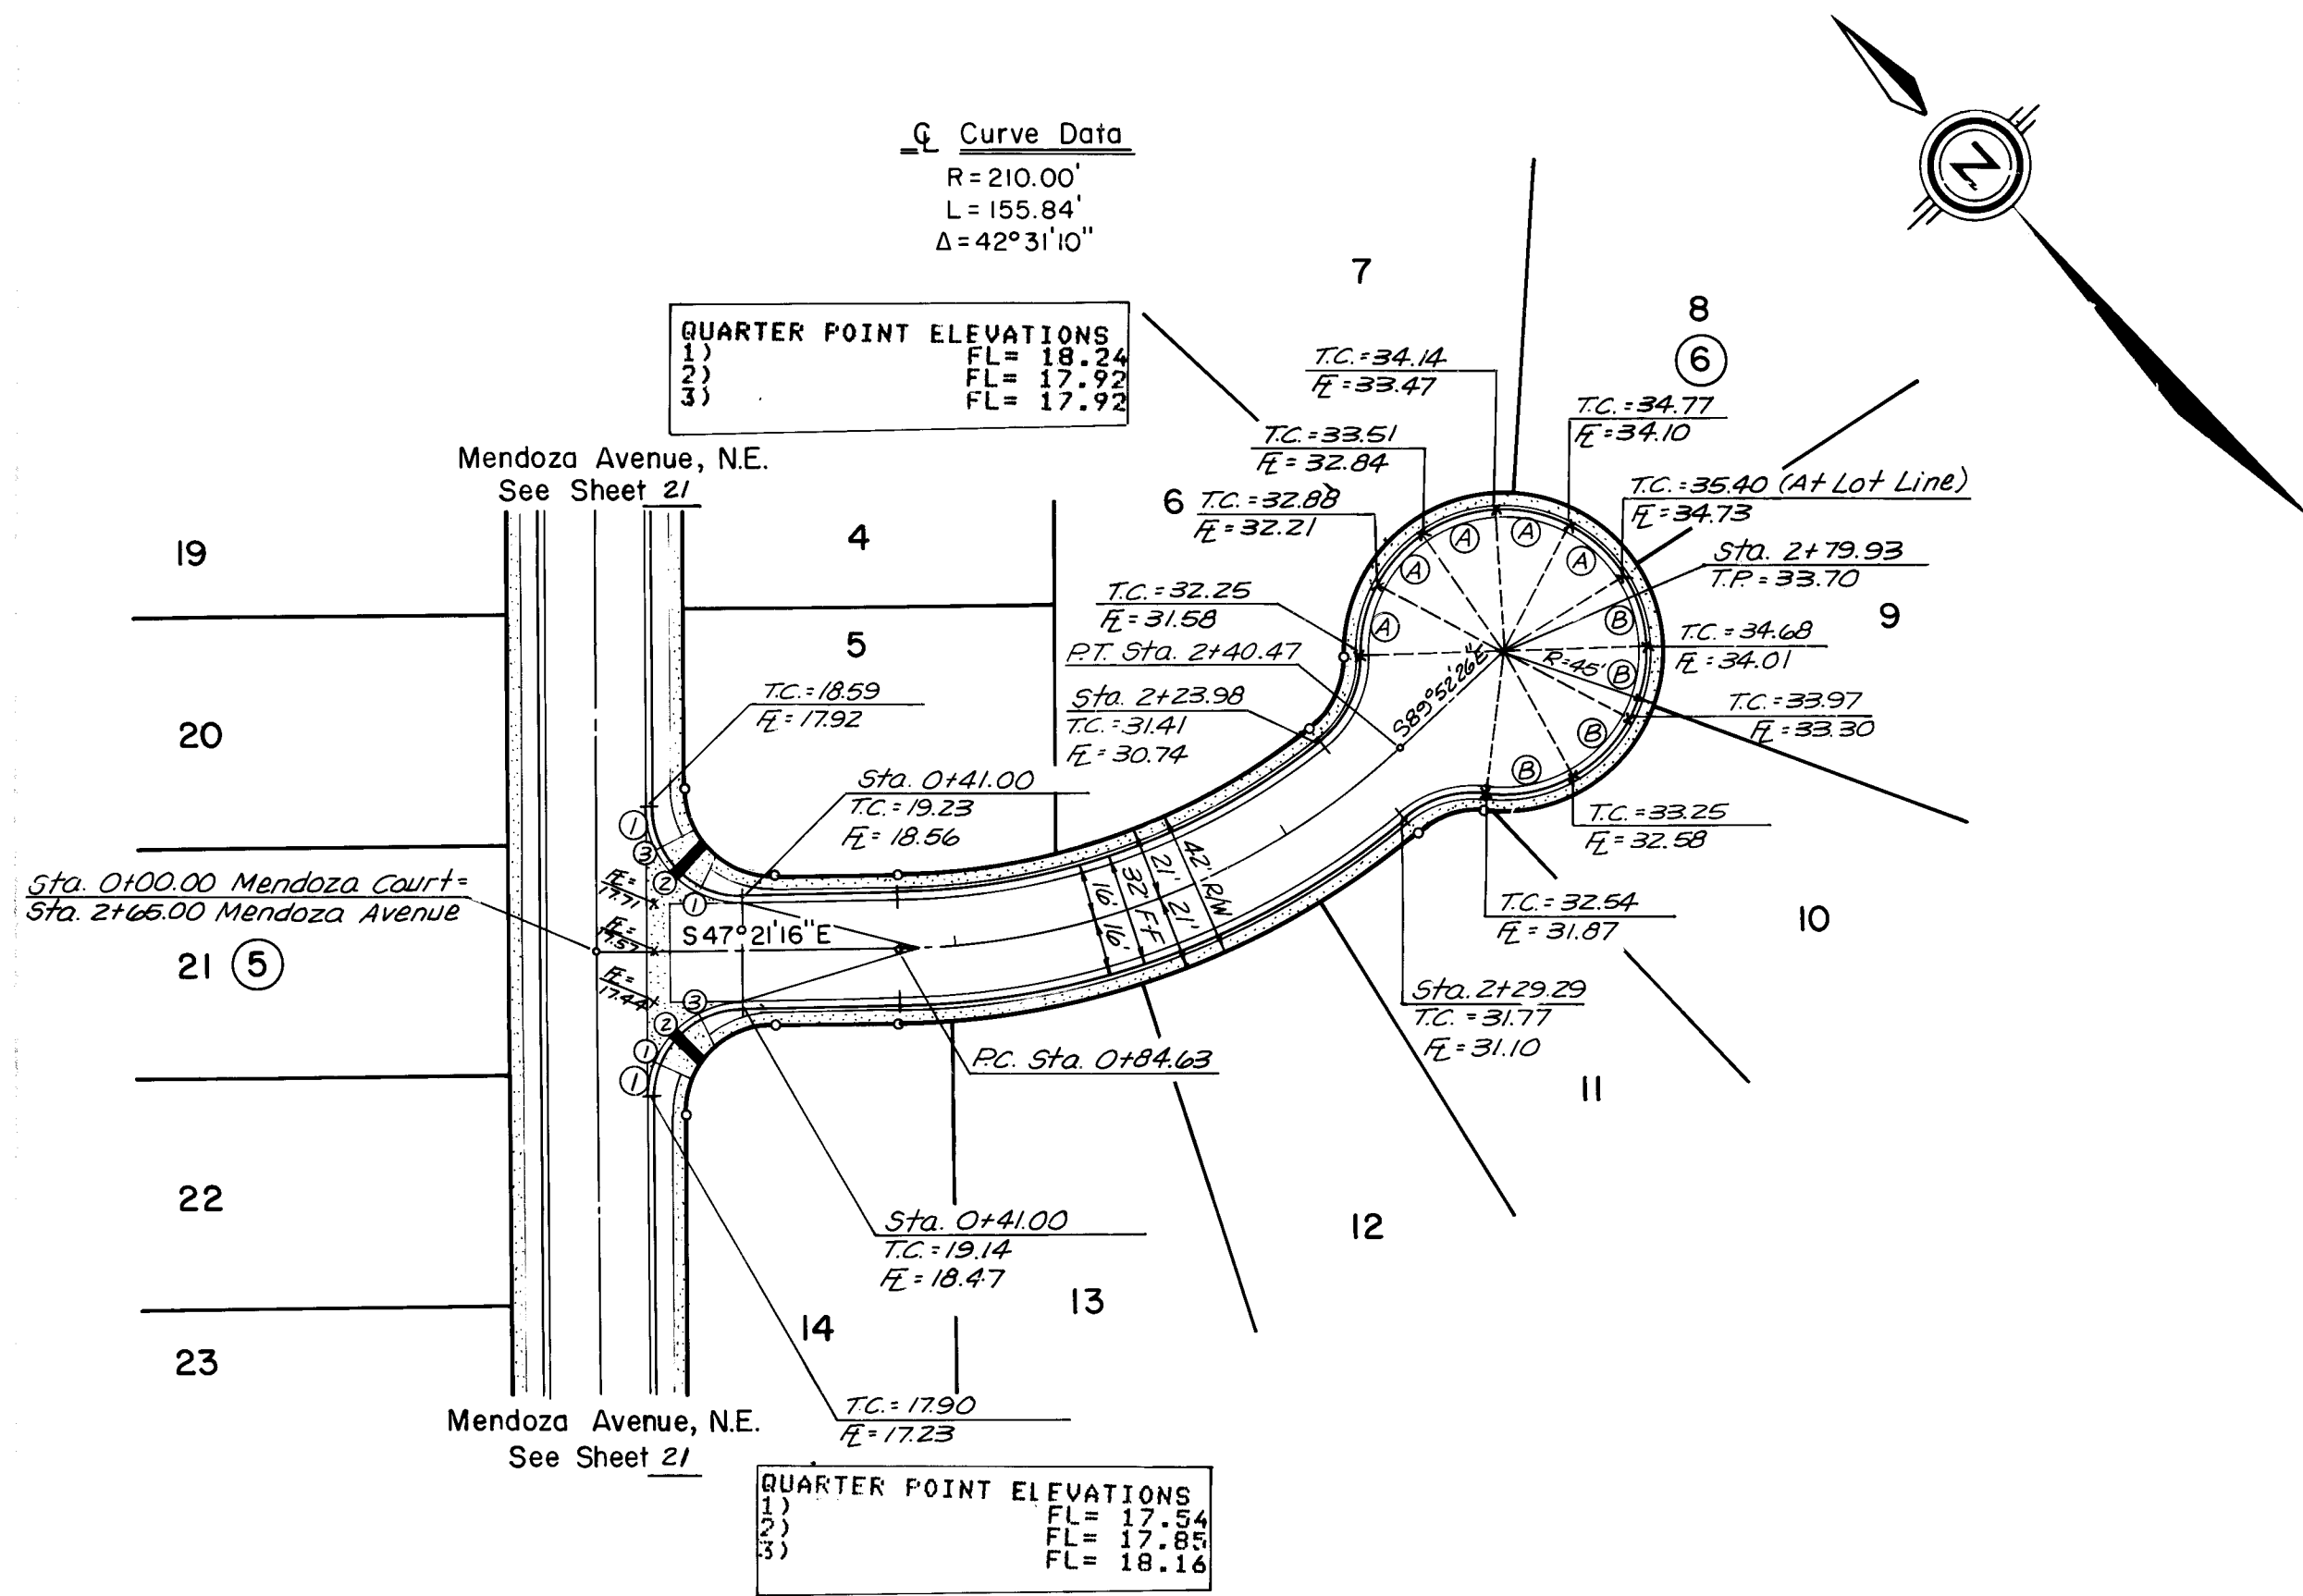

RESIDENTIAL PVMT.
MENDOZA COURT, N.E.

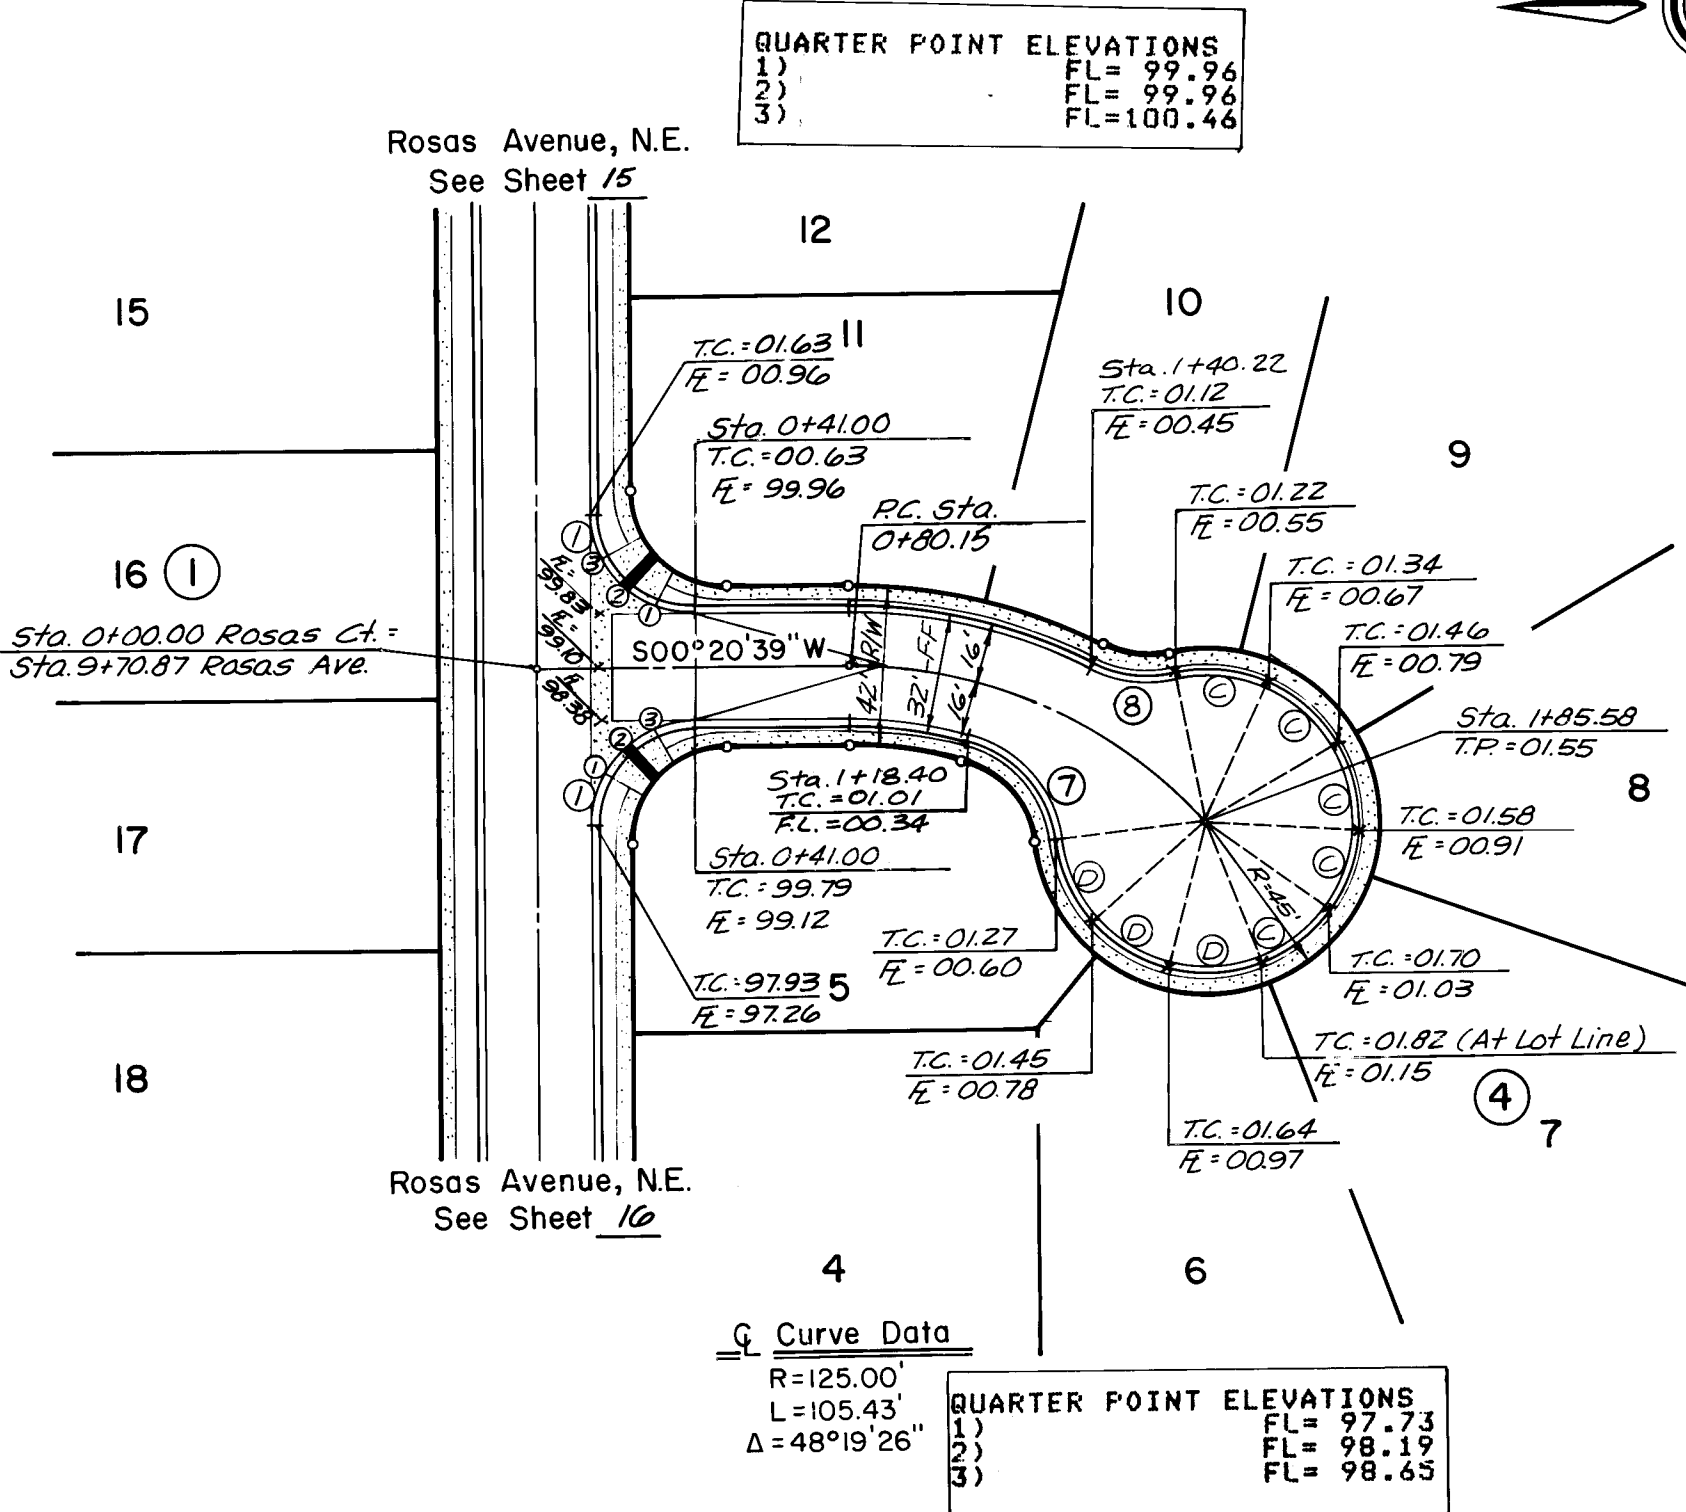

RESIDENTIAL PVMT.
ROSAS COURT, N.E.

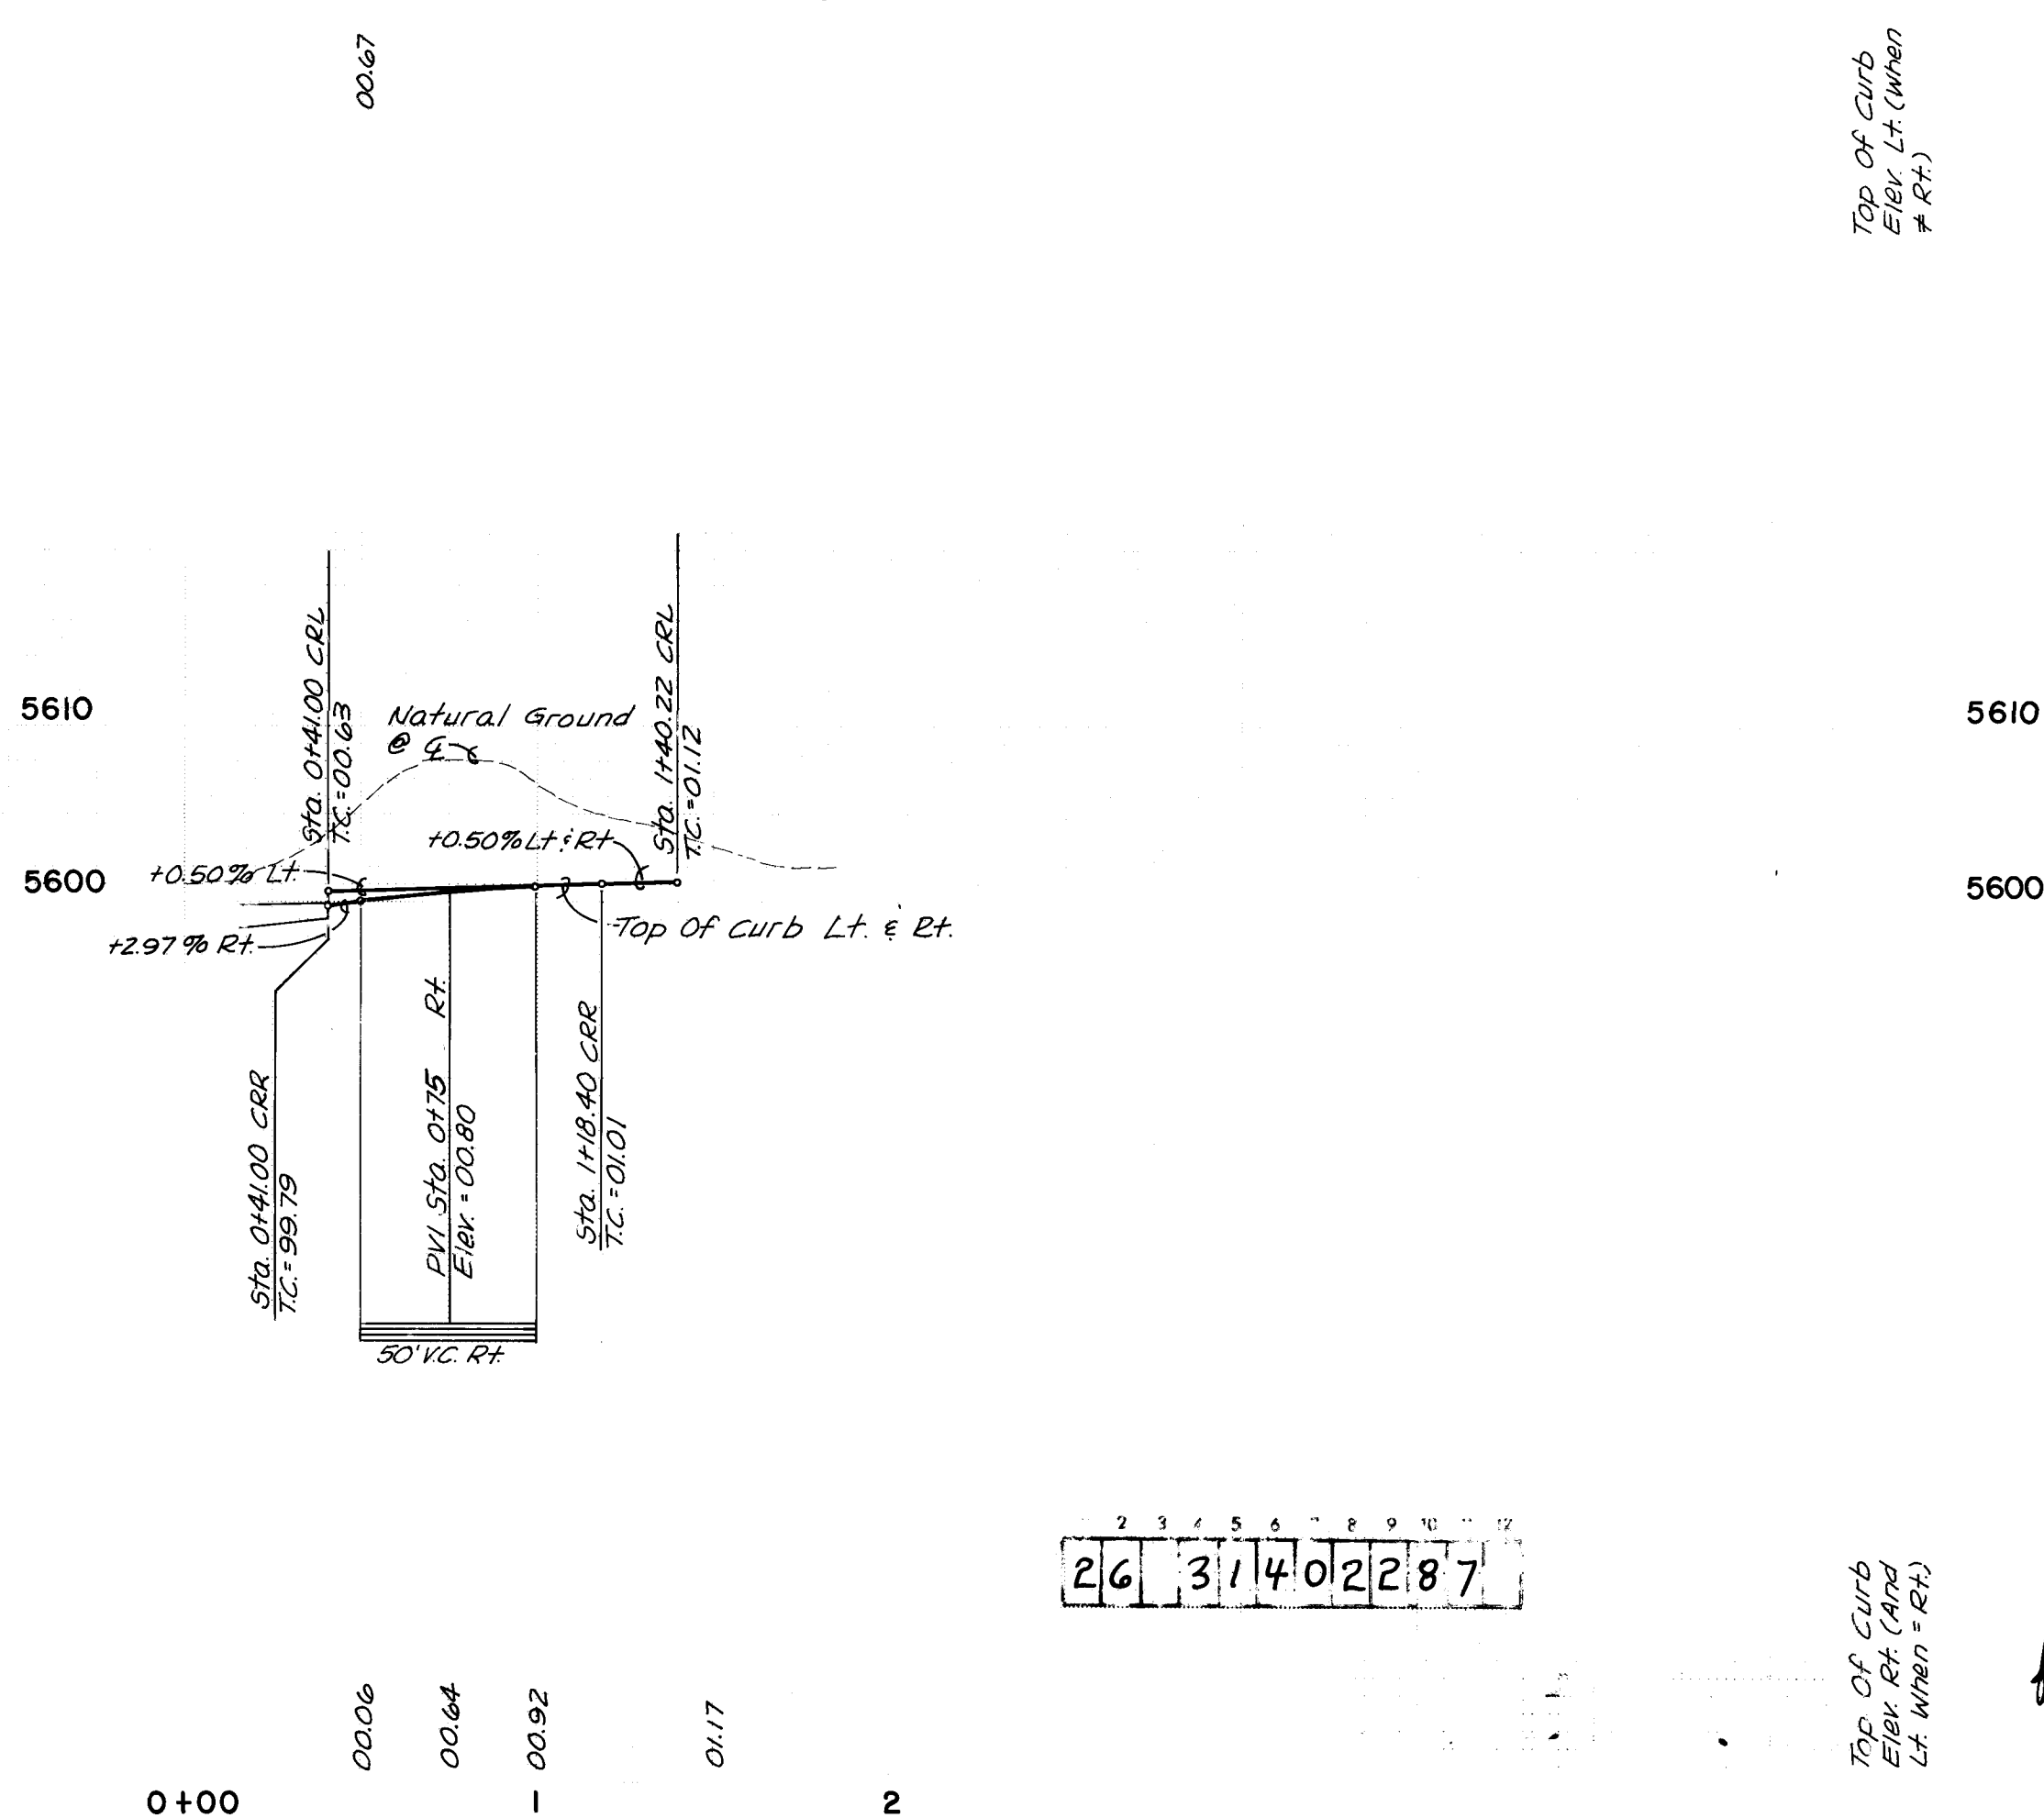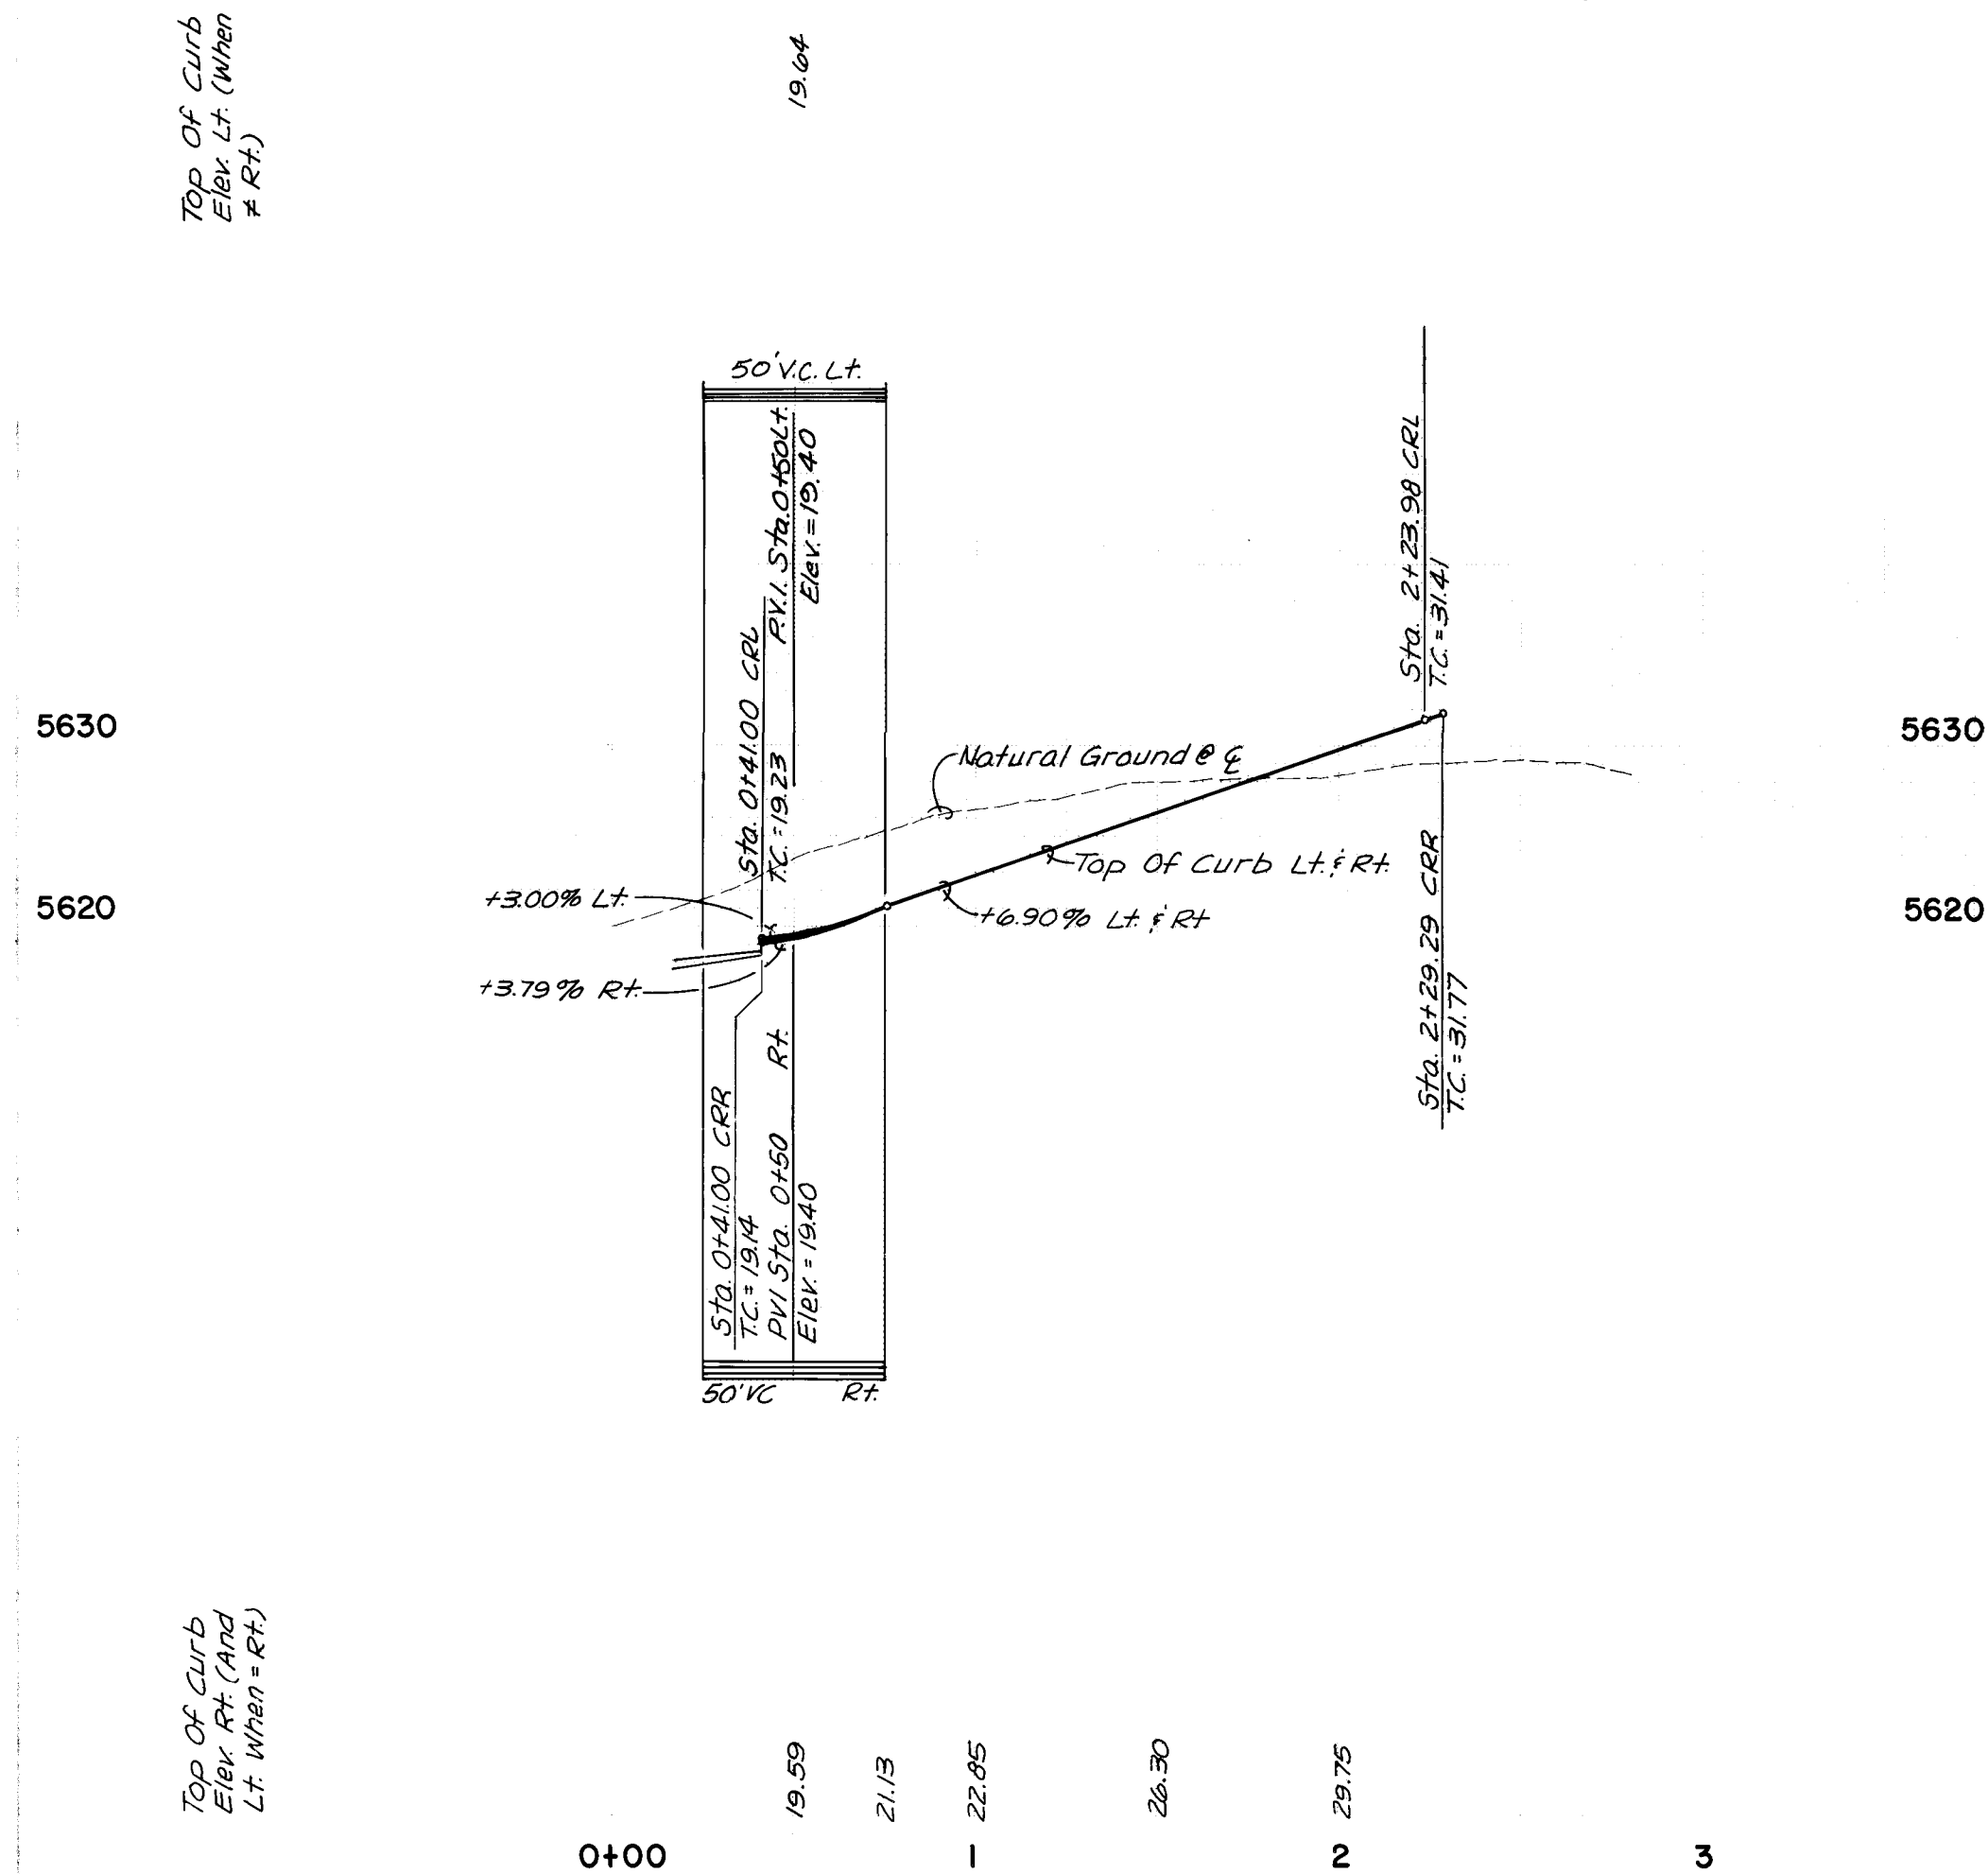

Curb Curve Data			
Curve	Radius	Arc	Delta
①	40.00'	20.66'	29°35'25"
②	40.00'	22.64'	32°25'46"
③	40.00'	23.84'	34°09'14"
④	40.00'	24.36'	34°53'18"
⑤	25.00'	33.27'	90°00'00"
⑥	30.00'	34.60'	66°04'56"
⑦	30.00'	20.60'	39°28'12"

AS BUILT INFORMATION
 WYLE CORP.
 CUTTING
 SURVEYING
 D. Herrera
 6-87
 11-22-87
 9-87
 11-22-87

BENCH MARKS
 A.C.S. BRASS TABLE "1-C21A" SET IN THE TOP OF CONCRETE POST FLUSH WITH GROUND AND LOCATED AT THE NORTHEAST CORNER OF THE INTERSECTION OF PASSED DEL NORTE (LOS ANGELES DRIVE, N.E.) AND HOLBROOK STREET, N.E. ELEVATION = 5634.65'

NO. 1
 DATE 4/23/87

ENGINEER
 KENT W. WHITMAN
 4/23/87


REVISIONS
 NO. DATE BY
 1 3-87
 2 3-87
 3 4-87

RECORD DRAWING AS BUILT
 SCALE
 1"=50'HORIZ.
 1"=10'VERT.

CITY OF ALBUQUERQUE
 MUNICIPAL DEVELOPMENT DEPARTMENT
 ENGINEERING DIVISION
 TITLE: HERITAGE EAST - UNIT SIX
MENDOZA COURT, N.E. & ROSAS COURT, N.E.

APPROVALS	ENGINEER	DATE	APPROVALS	ENGINEER	DATE
City Engineer	<i>[Signature]</i>	4/22/87	Water Utilities	<i>[Signature]</i>	4/22/87
A.C.E. - Design	<i>[Signature]</i>	4-22-87			
A.C.E. - Hydrology	<i>[Signature]</i>	4-22-87			

DRAWING NO. **3140** MAP NO. **D-20** SHEET **22** OF **39**

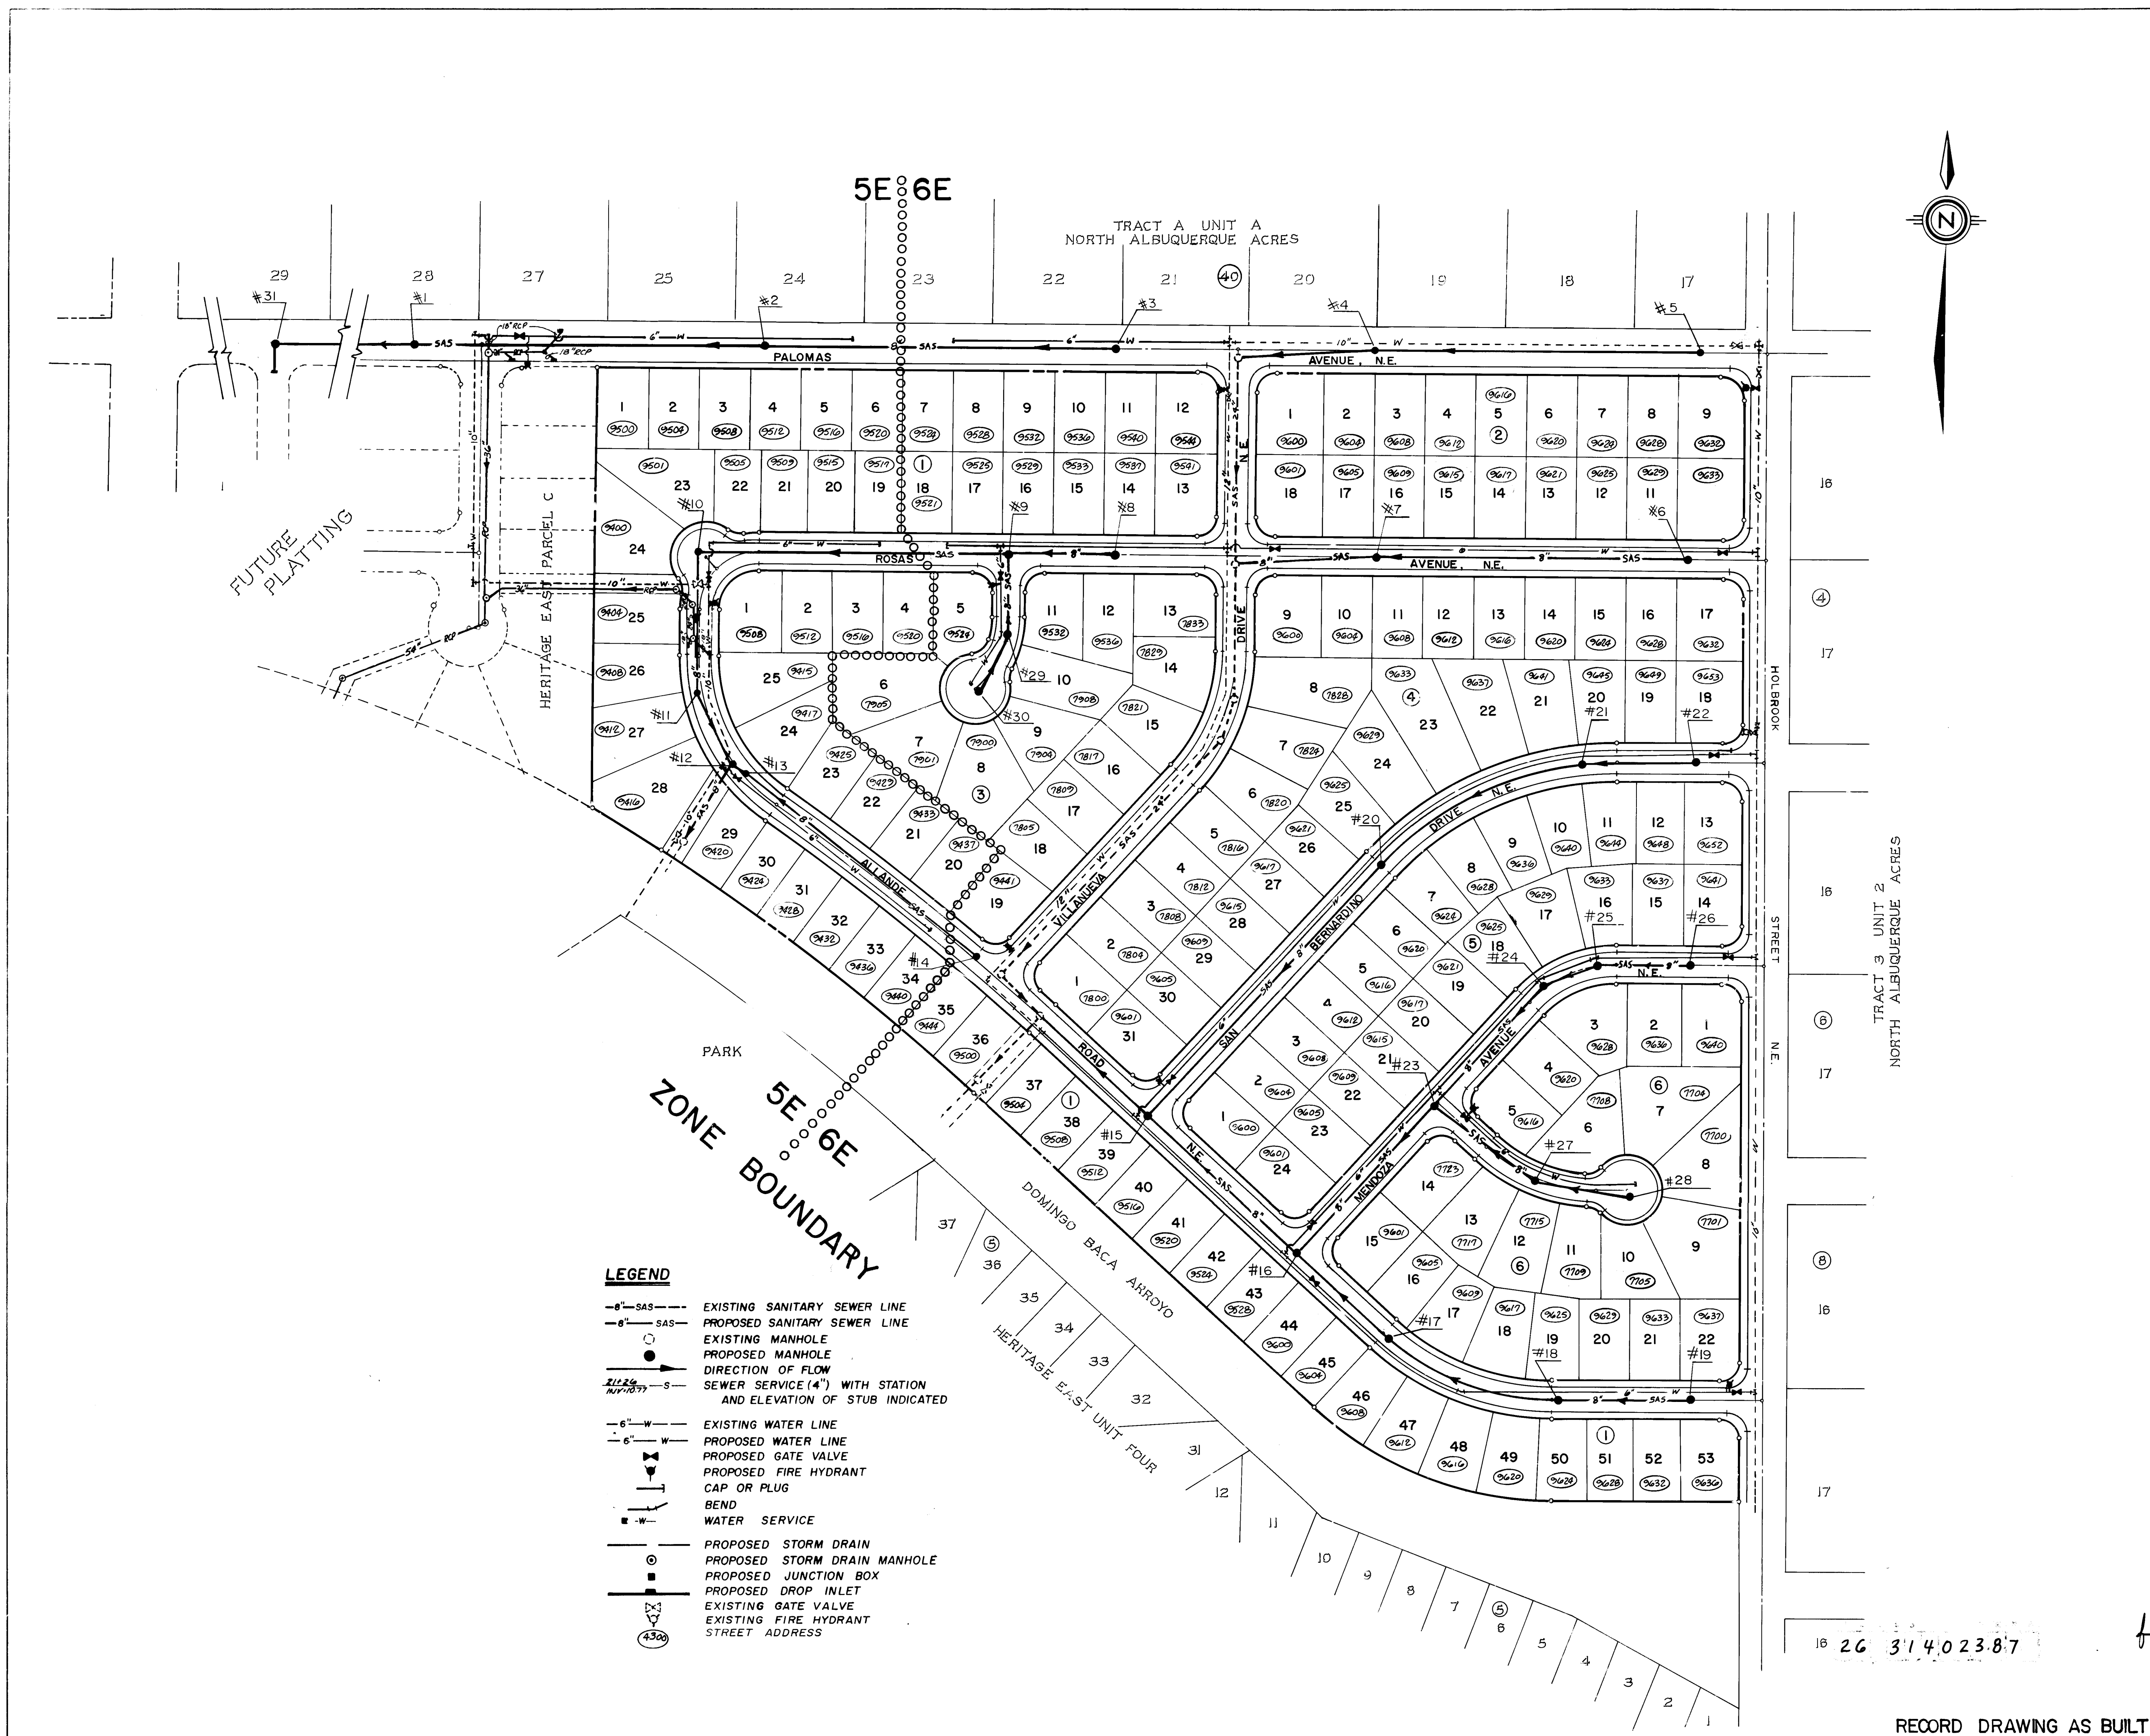

GENERAL NOTES - ALL UTILITY SHEETS

- 1) THE CONTRACTOR SHALL FURNISH ELOS ON ALL WATER AND SEWER SERVICE STUBS, CAPS AND PLUGS.
- 2) ALL STATIONING REFERS TO STREET CENTERLINE, EXCEPT AS OTHERWISE NOTED.
- 3) CONTRACTOR SHALL FIELD VERIFY LOCATIONS AND ELEVATIONS OF ALL EXISTING PIPE AND UTILITIES PRIOR TO CONSTRUCTION.
- 4) WATER SERVICES SHALL BE 3/4" DIAMETER POLYPROPYLENE TUBING (OR OTHER CODE ALLOWED MATERIAL), CLASS 160, WITH 3/4" METERS.
- 5) ALL TEES BENDS AND CAPS SHALL BE BLOCKED ACCORDING TO CITY OF ALBUQUERQUE STANDARDS, DRAWING W-22
- 6) ALL PIPE SHALL BE FURNISHED WITH CLASS "C" BEDDING UNLESS OTHERWISE NOTED.
- 7) WHERE GATE VALVES AND HYDRANTS ARE SHOWN AT INTERSECTIONS, THESE SHALL BE LOCATED OPPOSITE CURB RETURN INDICATED.
- 8) ALL TRENCH BACKFILL SHALL BE COMPACTED TO A MINIMUM OF 90% OF OPTIMUM (MODIFIED).
- 9) WATER PIPE SHALL BE P.V.C. CLASS 150 AWWA C900. SEWER PIPE SHALL BE P.V.C. CLASS SDR35, EXCEPT AS OTHERWISE NOTED.
- 10) ALL PVC WATERMAIN FITTINGS SHALL BE "GRIP-TIGHT" PUSH-ON TYPE FITTINGS - AWWA APPROVED FOR PVC, C900 WATERMAIN, EXCEPT AS OTHERWISE NOTED.
- 11) WATER AND SEWER SERVICES SHALL BE INSTALLED ACCORDING TO THE CITY OF ALBUQUERQUE STANDARDS.
- 12) ALL MANHOLES SHALL BE TYPE "E" PER STD. DWGS. S-2, S-1 AND S-6 W/4" DIAMETER.
- 13) CONNECTIONS OF VERTICAL CURVILINEAR SANITARY SEWER INTO MANHOLES SHALL BE CONSTRUCTED IN ACCORDANCE W/CITY STD. DWG. 2117.

UTILITIES CONSTRUCTION SEQUENCE

1. SEWER SERVICES SHALL BE CONSTRUCTED TO THE R/W LINE. DEPTH AT EASEMENT LINE SHALL BE A MINIMUM OF 5' BELOW TOP OF CURB UNLESS SPECIFIED IN ELS INDICATE OTHERWISE.
2. WATER SERVICES SHALL BE CONSTRUCTED TO CURB STOP WITH VALVE BOXES. DEPTH OF SERVICE AT CURB STOP SHALL BE 2' + 1" BELOW TOP OF CURB.
3. PUBLIC SERVICE COMPANY OF NEW MEXICO SERVICE LINES (ELECTRICAL AND TELEPHONE) SHALL BE CONSTRUCTED COMPLETE. DEPTH OF SERVICE LINES SHALL BE 4' BELOW TOP OF CURB.
4. GAS COMPANY OF NEW MEXICO SHALL CONSTRUCT SERVICE LINES COMPLETE. DEPTH OF SERVICE LINES SHALL BE 18" BELOW TOP OF CURB.
5. WATER SERVICE LINES SHALL BE EXTENDED TO R/W LINE. VALVE BOXES AND METER BOXES SHALL BE SET TO FINAL GRADE AND 5'X5'X4" CONCRETE PAD SHALL BE CONSTRUCTED.
6. UTILITY LOCATIONS SHALL CONFORM WITH THE TYPICAL UTILITY LOCATION DETAIL SHOWN THIS SHEET AND THE DEPTH OF LINES STATED ABOVE SHALL NOT BE VARIED.
7. CURB STOPS WITH VALVE BOXES SHALL BE PROVIDED IMMEDIATELY BEHIND CURBS AT STREET SIDE OF METER BOXES.
8. WHERE METER BOXES ARE ADJACENT TO MOUNTABLE CURB, METER BOX LIDS SHALL BE HEAVY DUTY DRIVEWAY TYPE.
9. METER BOXES SHALL BE LOCATED IN SIDEWALKS WHERE SIDEWALKS ARE ADJACENT TO CURBS; OTHERWISE METER BOXES SHALL BE IMMEDIATELY BEHIND CURB WITH 5'X5'X4" THICKNESS CONCRETE PAD.

SCALE
1"=100'

CITY OF ALBUQUERQUE
MUNICIPAL DEVELOPMENT DEPARTMENT
ENGINEERING DIVISION

TITLE: HERITAGE EAST - UNIT SIX

COMPOSITE UTILITY PLAN

APPROVALS	ENGINEER	DATE	APPROVALS	ENGINEER	DATE
City Engineer	<i>[Signature]</i>	4/22/87	Traffic	<i>[Signature]</i>	4/22/87
A.C.E. - Design	<i>[Signature]</i>	4/22/87	Water Utilities	<i>[Signature]</i>	4-22-87
A.C.E. - Hydrology	<i>[Signature]</i>				

DESIGNED BY	DATE	DRAWN BY	DATE	CHECKED BY	DATE
PL.	3-87	W.J.W.	3-87	M.K.S.	4-87

DRAWING NO. 3140 MAP NO. D-20 SHEET 23 OF 39

AS BUILT INFORMATION

CONTRACTOR: WYLE CORP.

WORK: SURVEYING

DATE: 6-87

INSPECTOR: J. D. HERRERA

DATE: 12-87

FIELD LOCATION BY: J. D. HERRERA

DRAWING BY: J. D. HERRERA

DATE: 12-87

CHECKED BY: J. D. HERRERA

DATE: 12-87

RECORDED BY: J. D. HERRERA

DATE: 12-87

ENGINEER'S SEAL

NO. DATE

REMARKS


REVISIONS

DESIGN


DATE 3-87

DATE 3-87


DATE 4-87

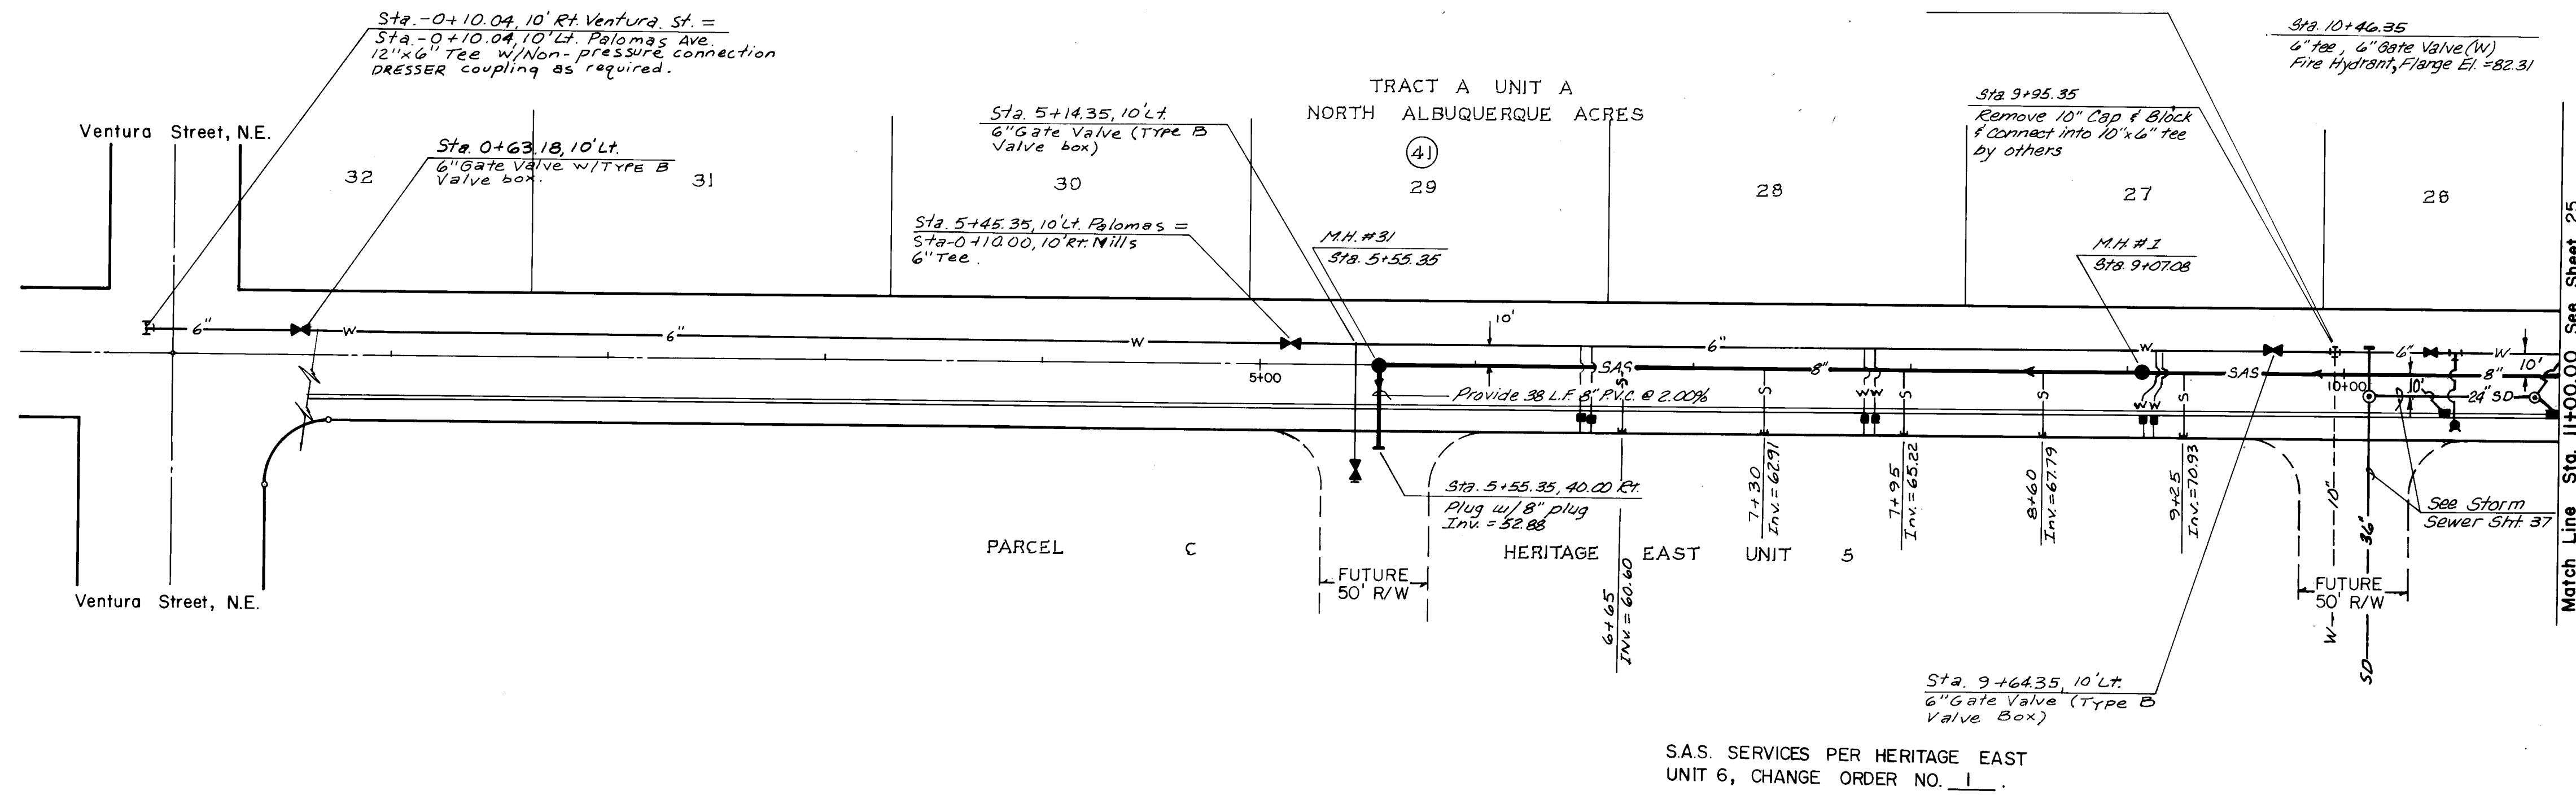


PALOMAS AVENUE, N.E.

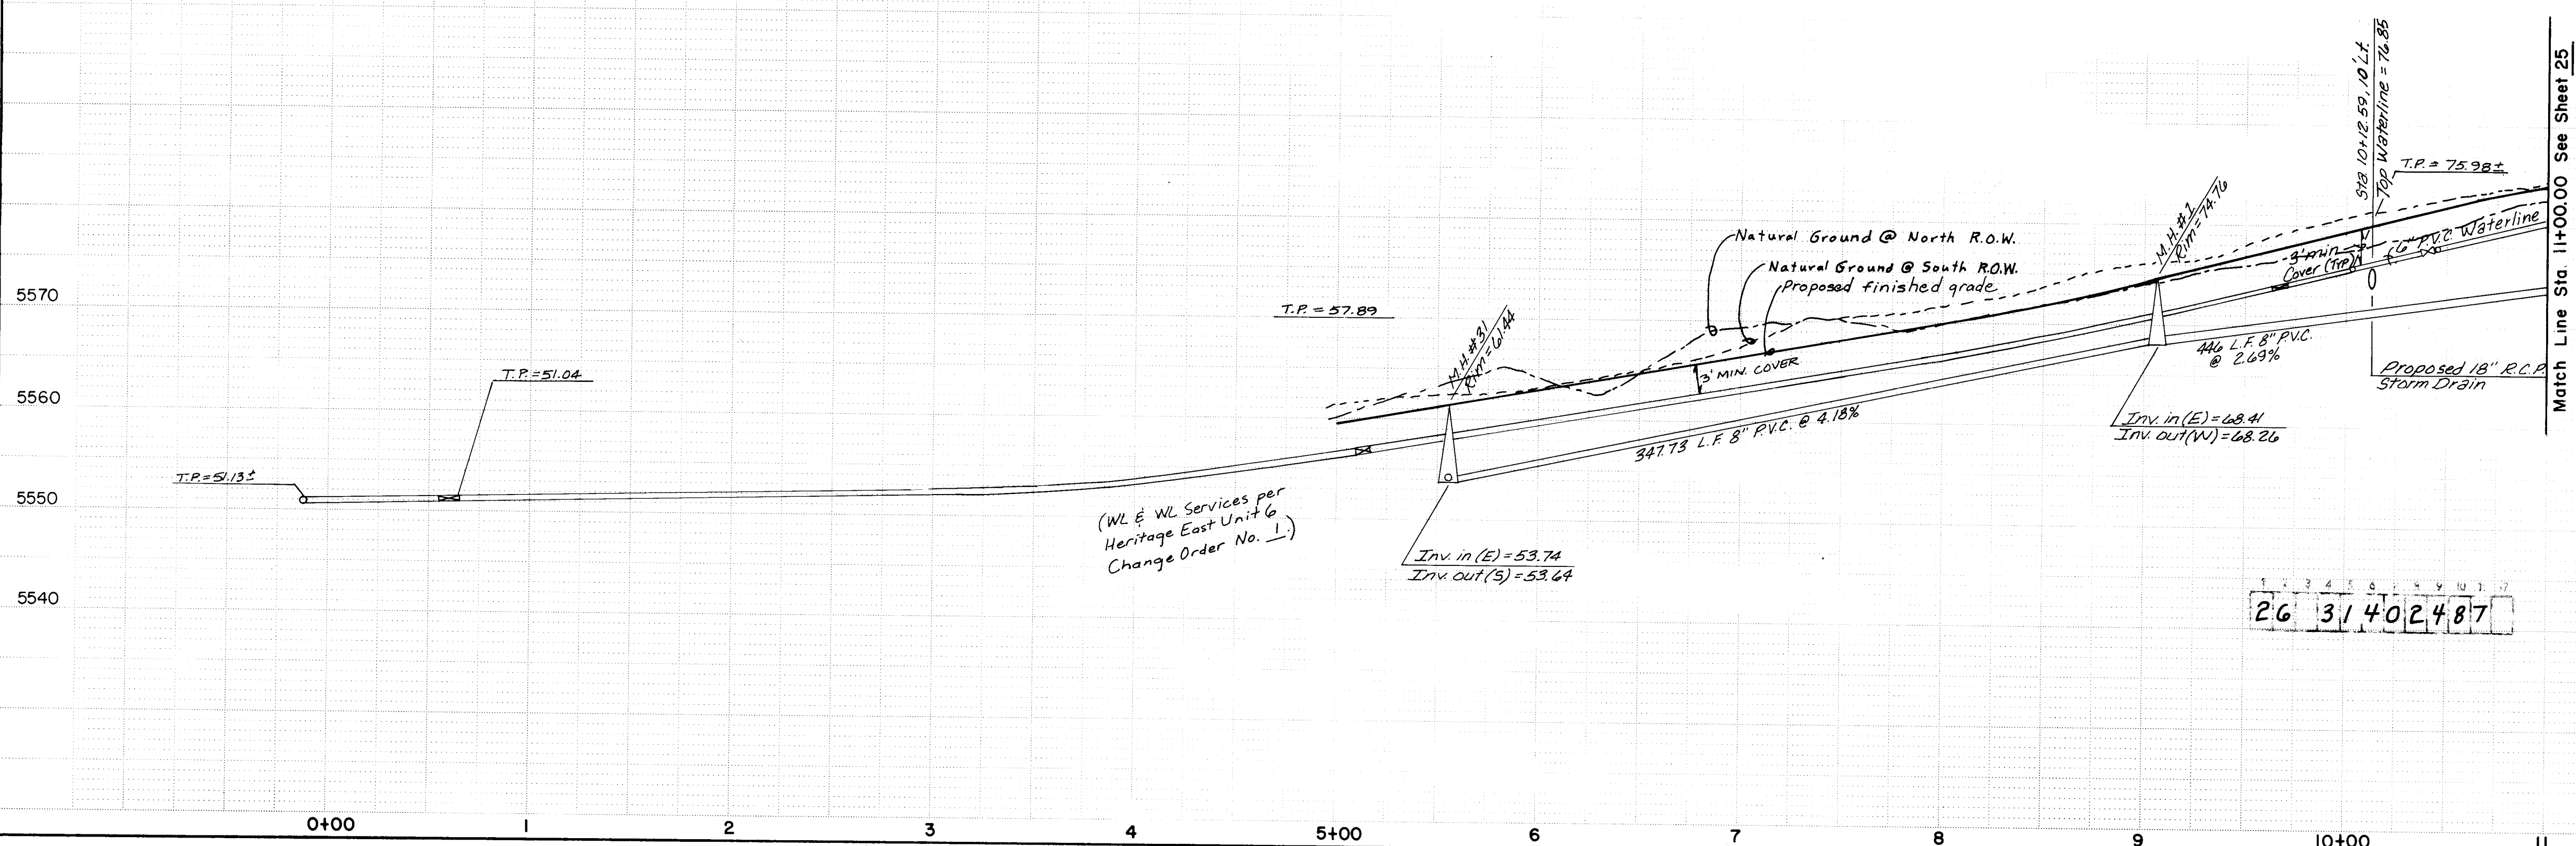

		4/23/87
REVISIONS NO. DATE BY		DESIGNED BY M.K.S. DATE 3-87 DRAWN BY M.C.G. DATE 3-87 CHECKED BY M.K.S. DATE 4-87
RECORD DRAWING AS BUILT SCALE: 1"=50' HORIZ. 1"=10' VERT.		
CITY OF ALBUQUERQUE MUNICIPAL DEVELOPMENT DEPARTMENT ENGINEERING DIVISION TITLE: HERITAGE EAST - UNIT SIX PALOMAS AVENUE, N.E.		
APPROVALS City Engineer: <i>[Signature]</i> DATE 4/24/87 A.C.E. Design: <i>[Signature]</i> DATE 4-22-87 A.C.E. Hydrology: N/A	APPROVALS ENGINEER: <i>[Signature]</i> DATE 4/22/87 Traffic: <i>[Signature]</i> DATE 4-22-87 Water Utilities: <i>[Signature]</i> DATE 4-22-87	DATE
DRAWING NO. 3140		MAP NO. D-20 SHEET 24 OF 39

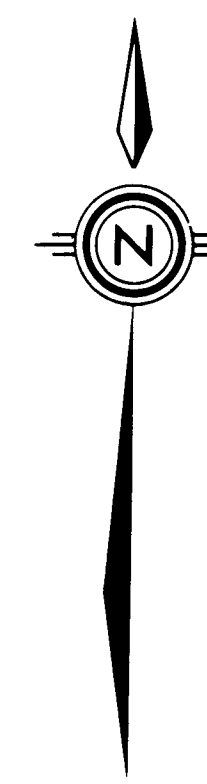

Villanueva Avenue, N.E.
See Sheet 33

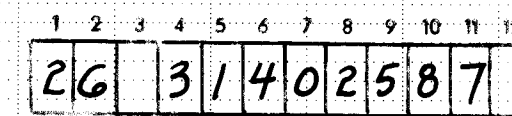

Kent


A circular professional engineer seal for Kent M. Whitman. The outer ring contains the name "KENT M. WHITMAN". The inner circle contains the words "REGISTERED PROFESSIONAL ENGINEER". A signature, which appears to be "Kent M. Whitman", is written across the center of the seal.

4/23/07


SCALE
1" = 50' HORIZ.
1" = 10' VERT.

APPROVALS	ENGINEER	DATE	APPROVALS	ENGINEER	DATE
City Engineer	<i>[Signature]</i>	4/30/07			
A C E - Design	<i>[Signature]</i>	4-22-07	Traffic	NADPH	4/22/07
A C E -Hydrology	NA		Water Utilities	<i>[Signature]</i>	4-22-07

DRAWING NO.	3140	MAP NO.	D-20	SHEET	25	OF	39
----------------	------	---------	------	-------	----	----	----

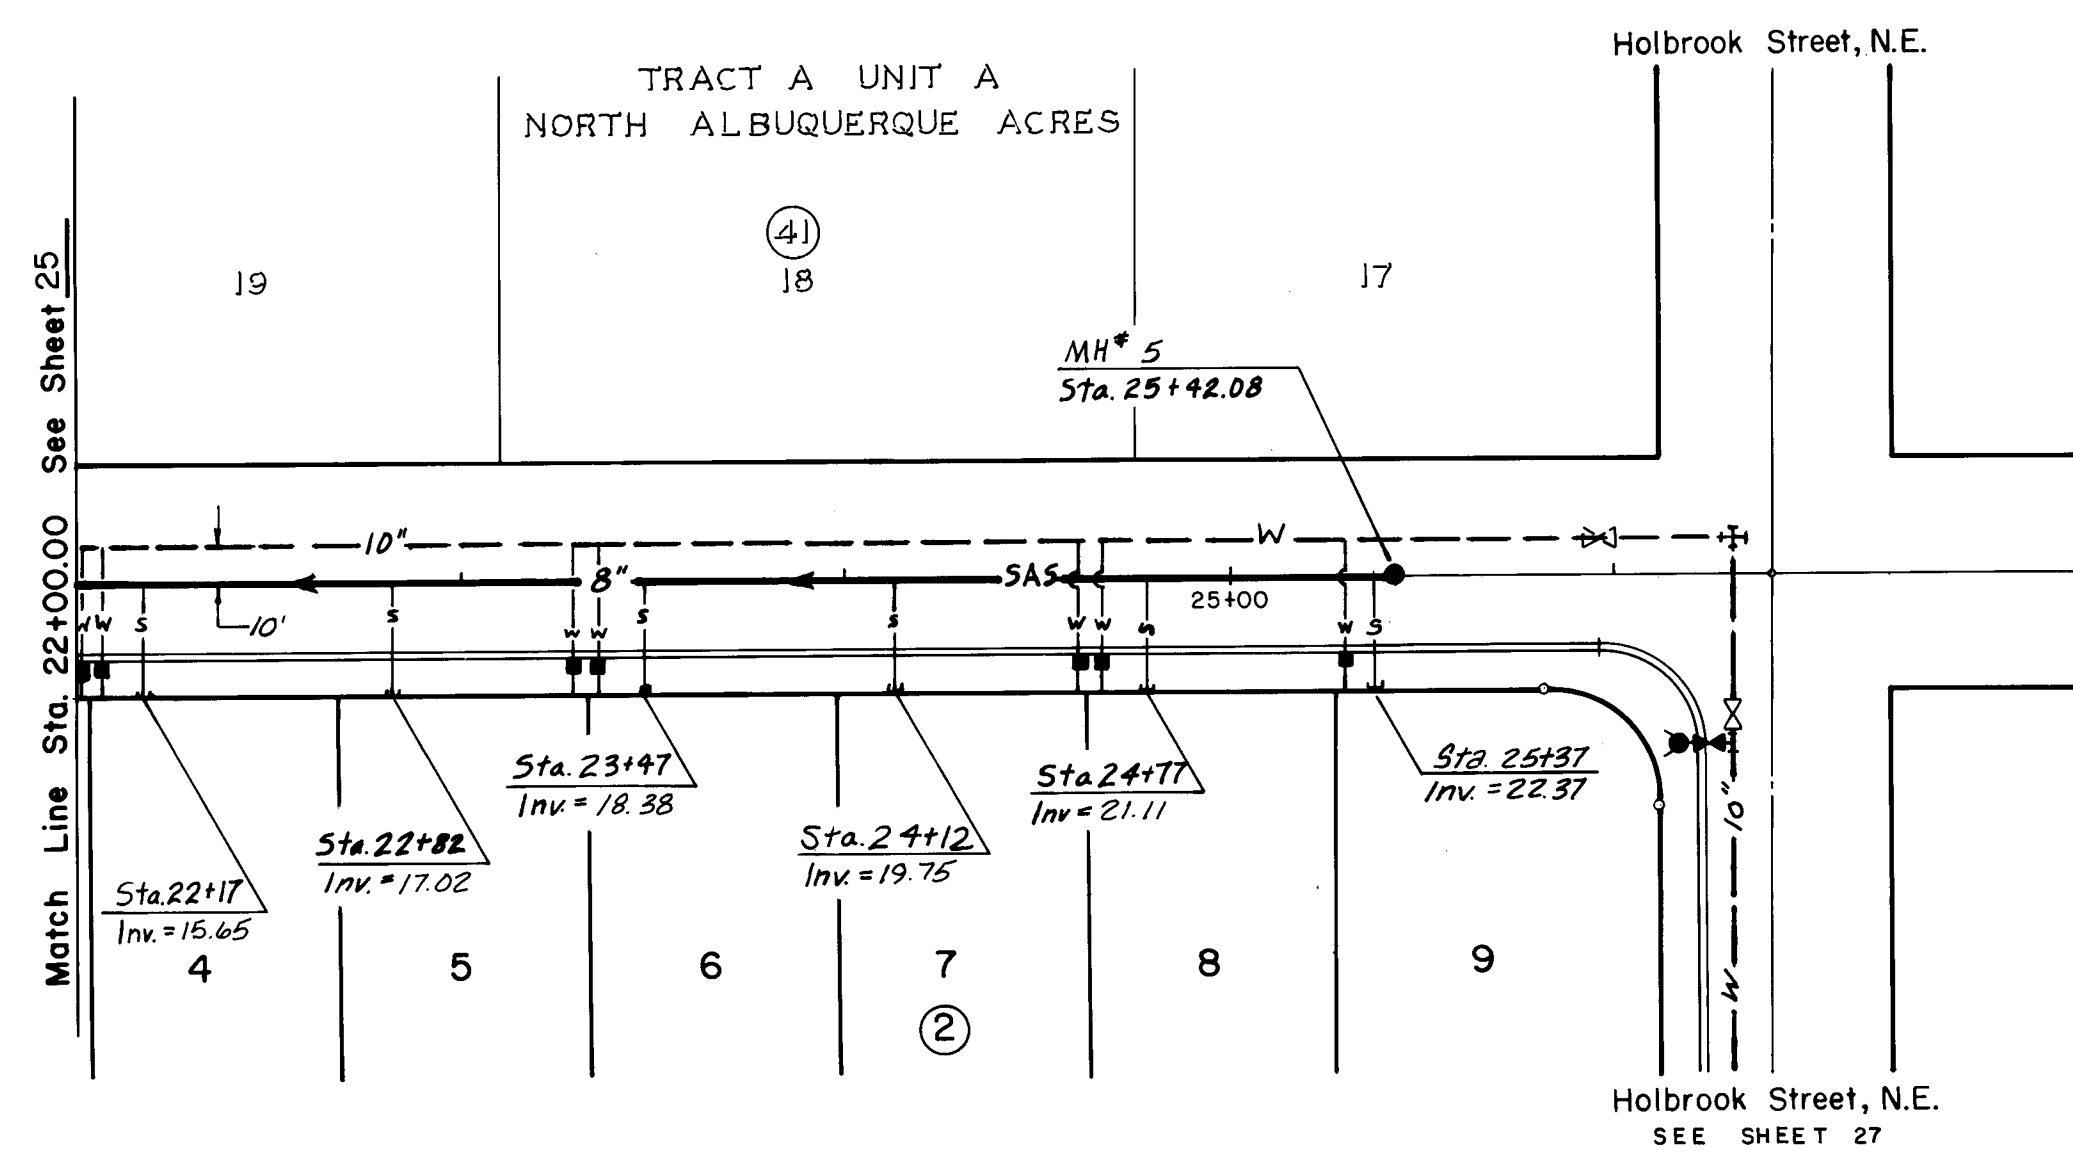

PALOMAS AVENUE, N.E.

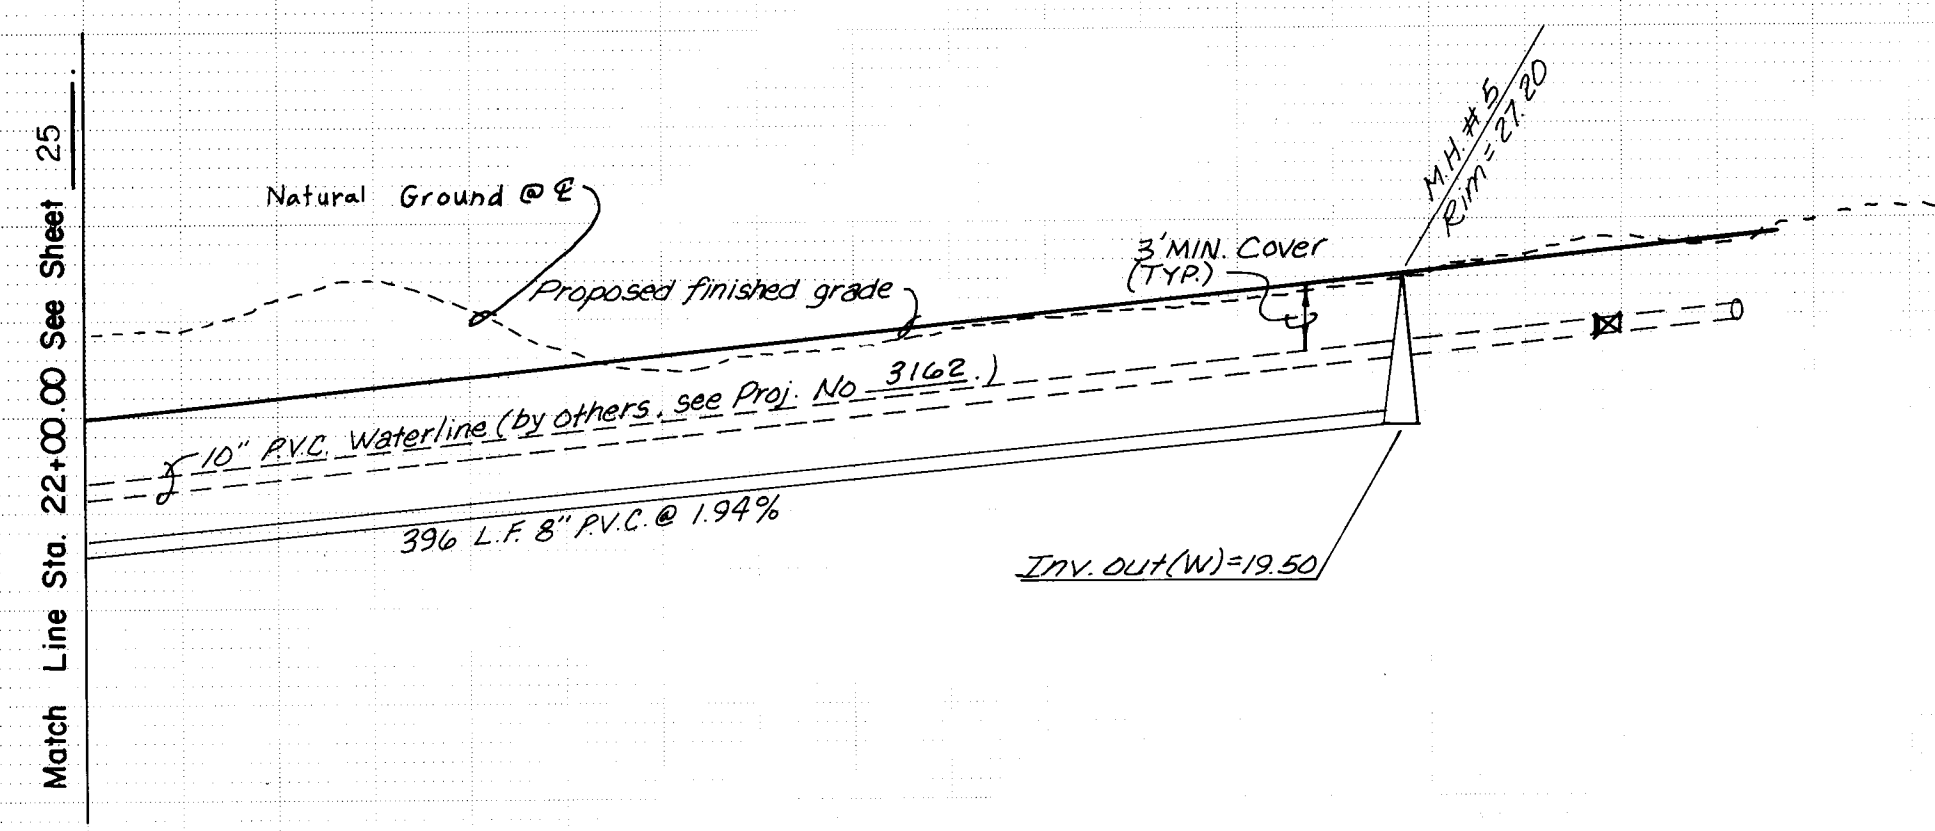


26 3140 2687

RECORD DRAWING AS BUILT
SCALE
1"=50' HORIZ.
1"=10' VERT.

CITY OF ALBUQUERQUE MUNICIPAL DEVELOPMENT DEPARTMENT ENGINEERING DIVISION					
TITLE: HERITAGE EAST - UNIT SIX PALOMAS AVENUE, N.E.					
APPROVALS	ENGINEER	DATE	APPROVALS	ENGINEER	DATE
City Engineer	<i>[Signature]</i>	4/2/87	Traffic	<i>[Signature]</i>	4/2/87
A.C.E. - Design	<i>[Signature]</i>	4/2/87	Water Utilities	<i>[Signature]</i>	4/2/87
A.C.E. - Hydrology	NA				
DRAWING NO. 3140			MAP NO. D-20 SHEET 26 OF 39		

ENGINEER'S SEAL		SURVEY INFORMATION		BENCH MARKS		AS BUILT INFORMATION	
[Seal]		FIELD NOTES		A.C.S. BRASS TABLET '1-C21A' SET IN THE TOP OF CONCRETE POST FLUSH WITH GROUND AND LOCATED AT THE NORTHEAST CORNER OF THE INTERSECTION OF PASO DEL NORTE (LOS ANGELES DRIVE, N.E.) AND HOLBROOK STREET, N.E. ELEVATION = 5634.65'		CONTRACTOR: WYDIE CORP. WORKED BY: SURVEYOR INSPECTOR'S: [Signature] ACCEPTANCE BY: [Signature] DATE: 4-2-87 VERIFICATION BY: [Signature] DATE: 4-2-87 DRAWING NO. 3140 MICRO-FILM INFORMATION RECORDED BY: [Signature] DATE: 4-2-87	
NO.		BY		DATE		DATE	
REVISIONS		BY		DATE		DATE	
DESIGN		BY		DATE		DATE	
CHECKED BY: M.L.S.		BY		DATE		DATE	

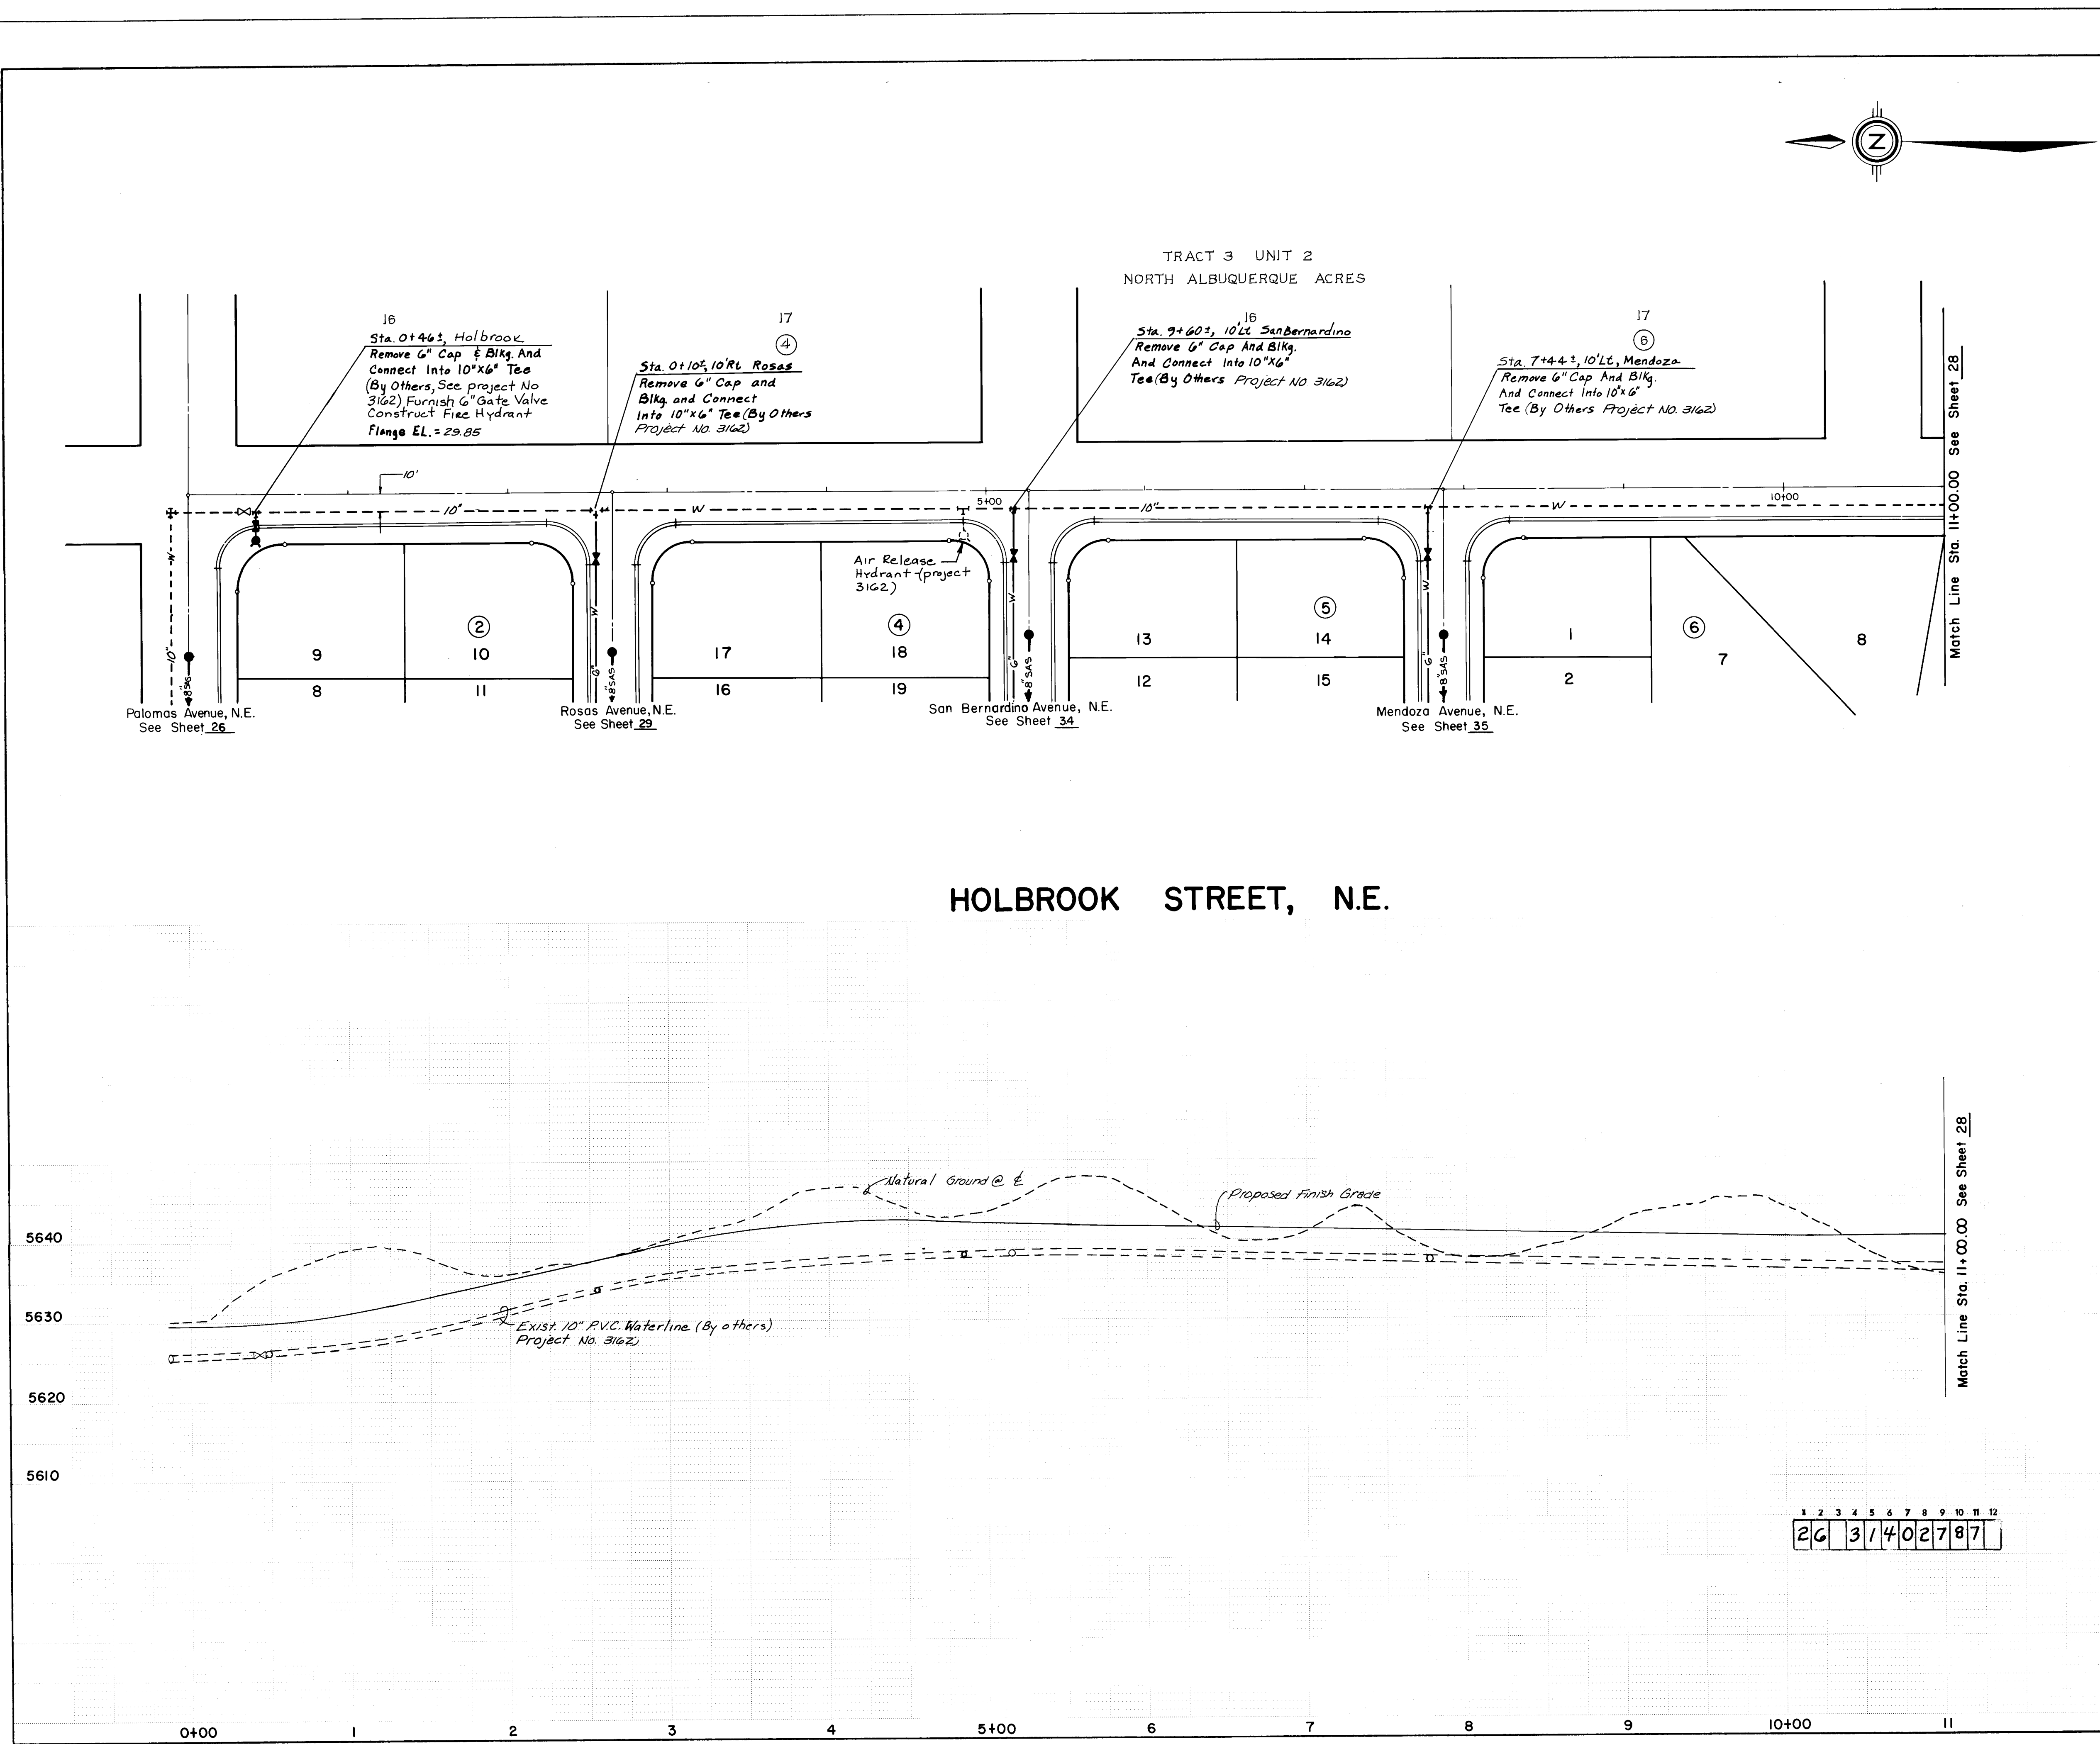

AS BUILT INFORMATION		BENCH MARKS		SURVEY INFORMATION		ENGINEER'S SEAL	
CONTRACTOR	WYCLIFF CORP.	A.C.S. BRASS TABLET "1-C21A" SET IN THE	FIELD NOTES	NO.	BY	DATE	REMARKS
DATE	4/22/87	TOP OF CONCRETE POST FLUSH WITH GROUND AND	DATE				DESIGN
INSPECTOR	JOHN J. SUTHERLAND	LOCATED AT THE NORTHEAST CORNER OF THE					REVISIONS
ACCURACY	DATE 12/22/87	INTERSECTION OF PASO DEL NORTE (LOS					NO.
VERIFICATION	DATE 4/22/87	ANGELES DRIVE, N.E.) AND HOLBROOK STREET,					DATE
COMPLETED BY	DATE 4/22/87	N.E. ELEVATION = 5634.65'					DESIGNED BY K.M.W.
RECORDED BY	DATE						DRAWN BY T.G.O., M.C.G.
NO.							CHECKED BY M.K.S.

RECORD DRAWING AS BUILT


SCALE
1" = 50' HORIZ.
1" = 10' VERT.

CITY OF ALBUQUERQUE
MUNICIPAL DEVELOPMENT DEPARTMENT
ENGINEERING DIVISION


TITLE: HERITAGE EAST - UNIT SIX
HOLBROOK STREET, N.E.

APPROVALS	ENGINEER	DATE	APPROVALS	ENGINEER	DATE
City Engineer	4/22/87	4/22/87	Traffic	N.A. DWH	4/22/87
A.C.E. - Design	4/22/87	4/22/87	Water Utilities	N/A	4/22/87
A.C.E. - Hydrology	N/A				



DRAWING NO. 3140 MAP NO. D-20 SHEET 27 OF 39

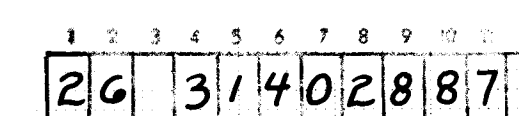

5640	RECORD DRAWING AS BUILT SCALE 1"=50' HORIZ. 1"=10' VERT. community services corporation										
5630											
5620											
5610											
CITY OF ALBUQUERQUE MUNICIPAL DEVELOPMENT DEPARTMENT ENGINEERING DIVISION											
TITLE: HERITAGE EAST - UNIT SIX HOLBROOK AVENUE, N.E.											
APPROVALS		ENGINEER		DATE		APPROVALS		ENGINEER		DATE	
City Engineer		<i>[Signature]</i>		4/22/87							
A.C.E. - Design		<i>[Signature]</i>		4-22-87		Traffic		<i>[Signature]</i>		4/22/87	
A.C.E. - Hydrology		NA				Water Utilities		<i>[Signature]</i>		4-22-87	
DRAWING NO.		3140		MAP NO.		D-20		SHEET		OF	
28		39		28		39		28		39	

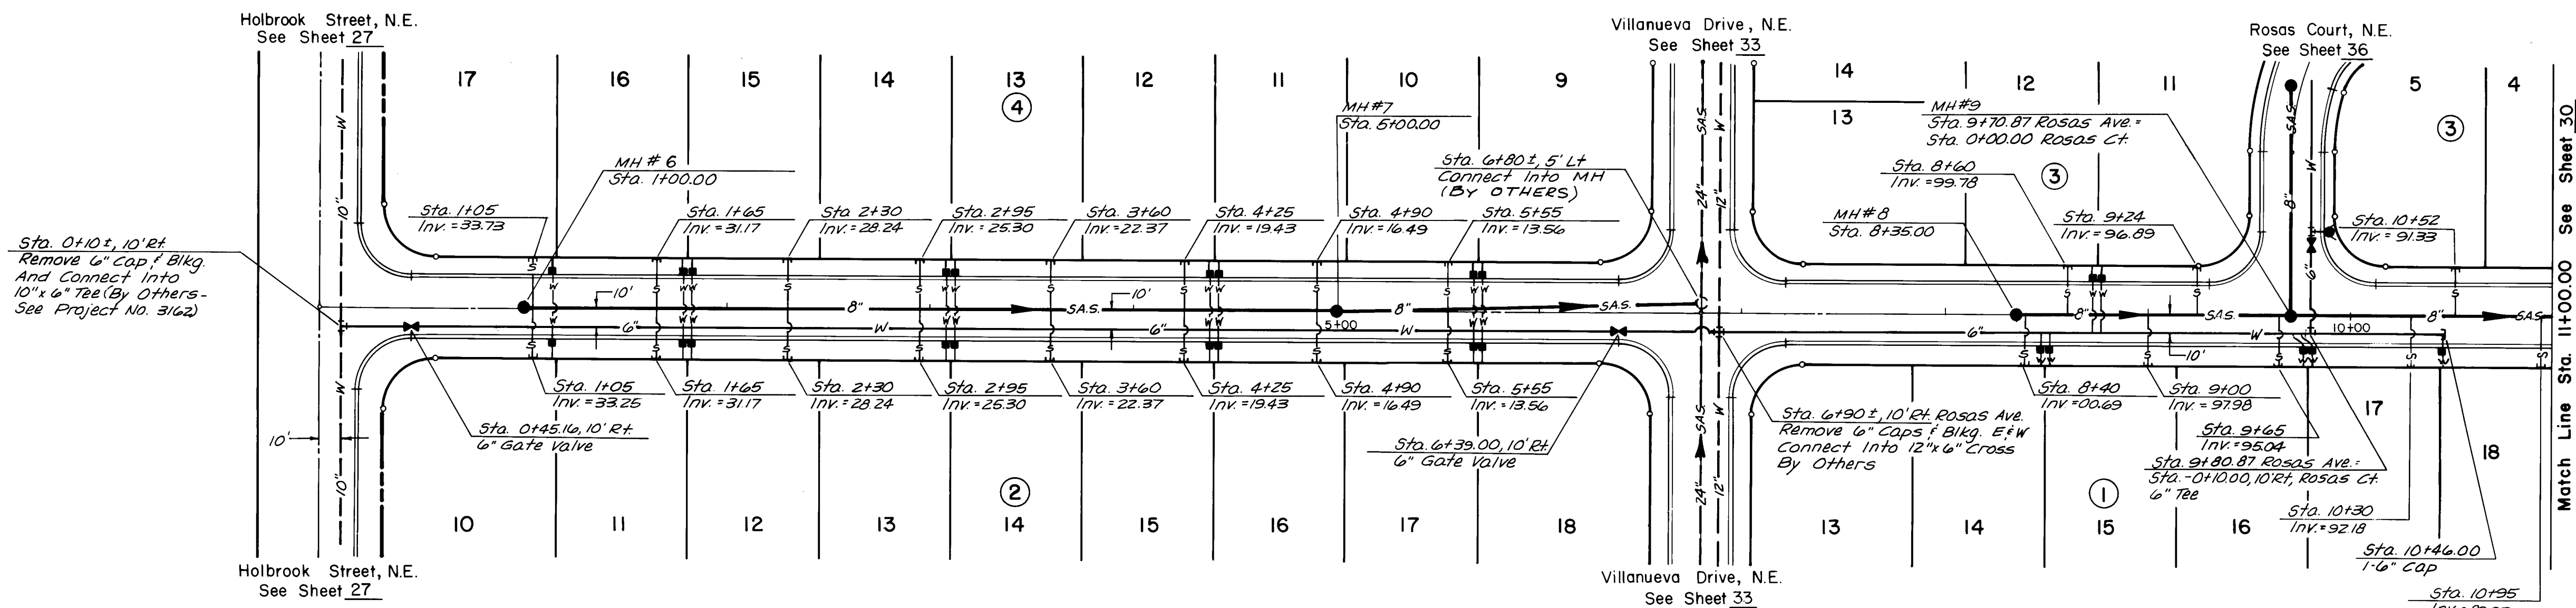

ROSAS AVENUE, N.E.

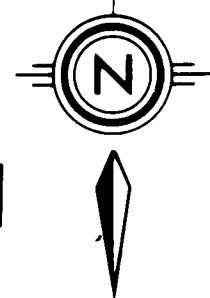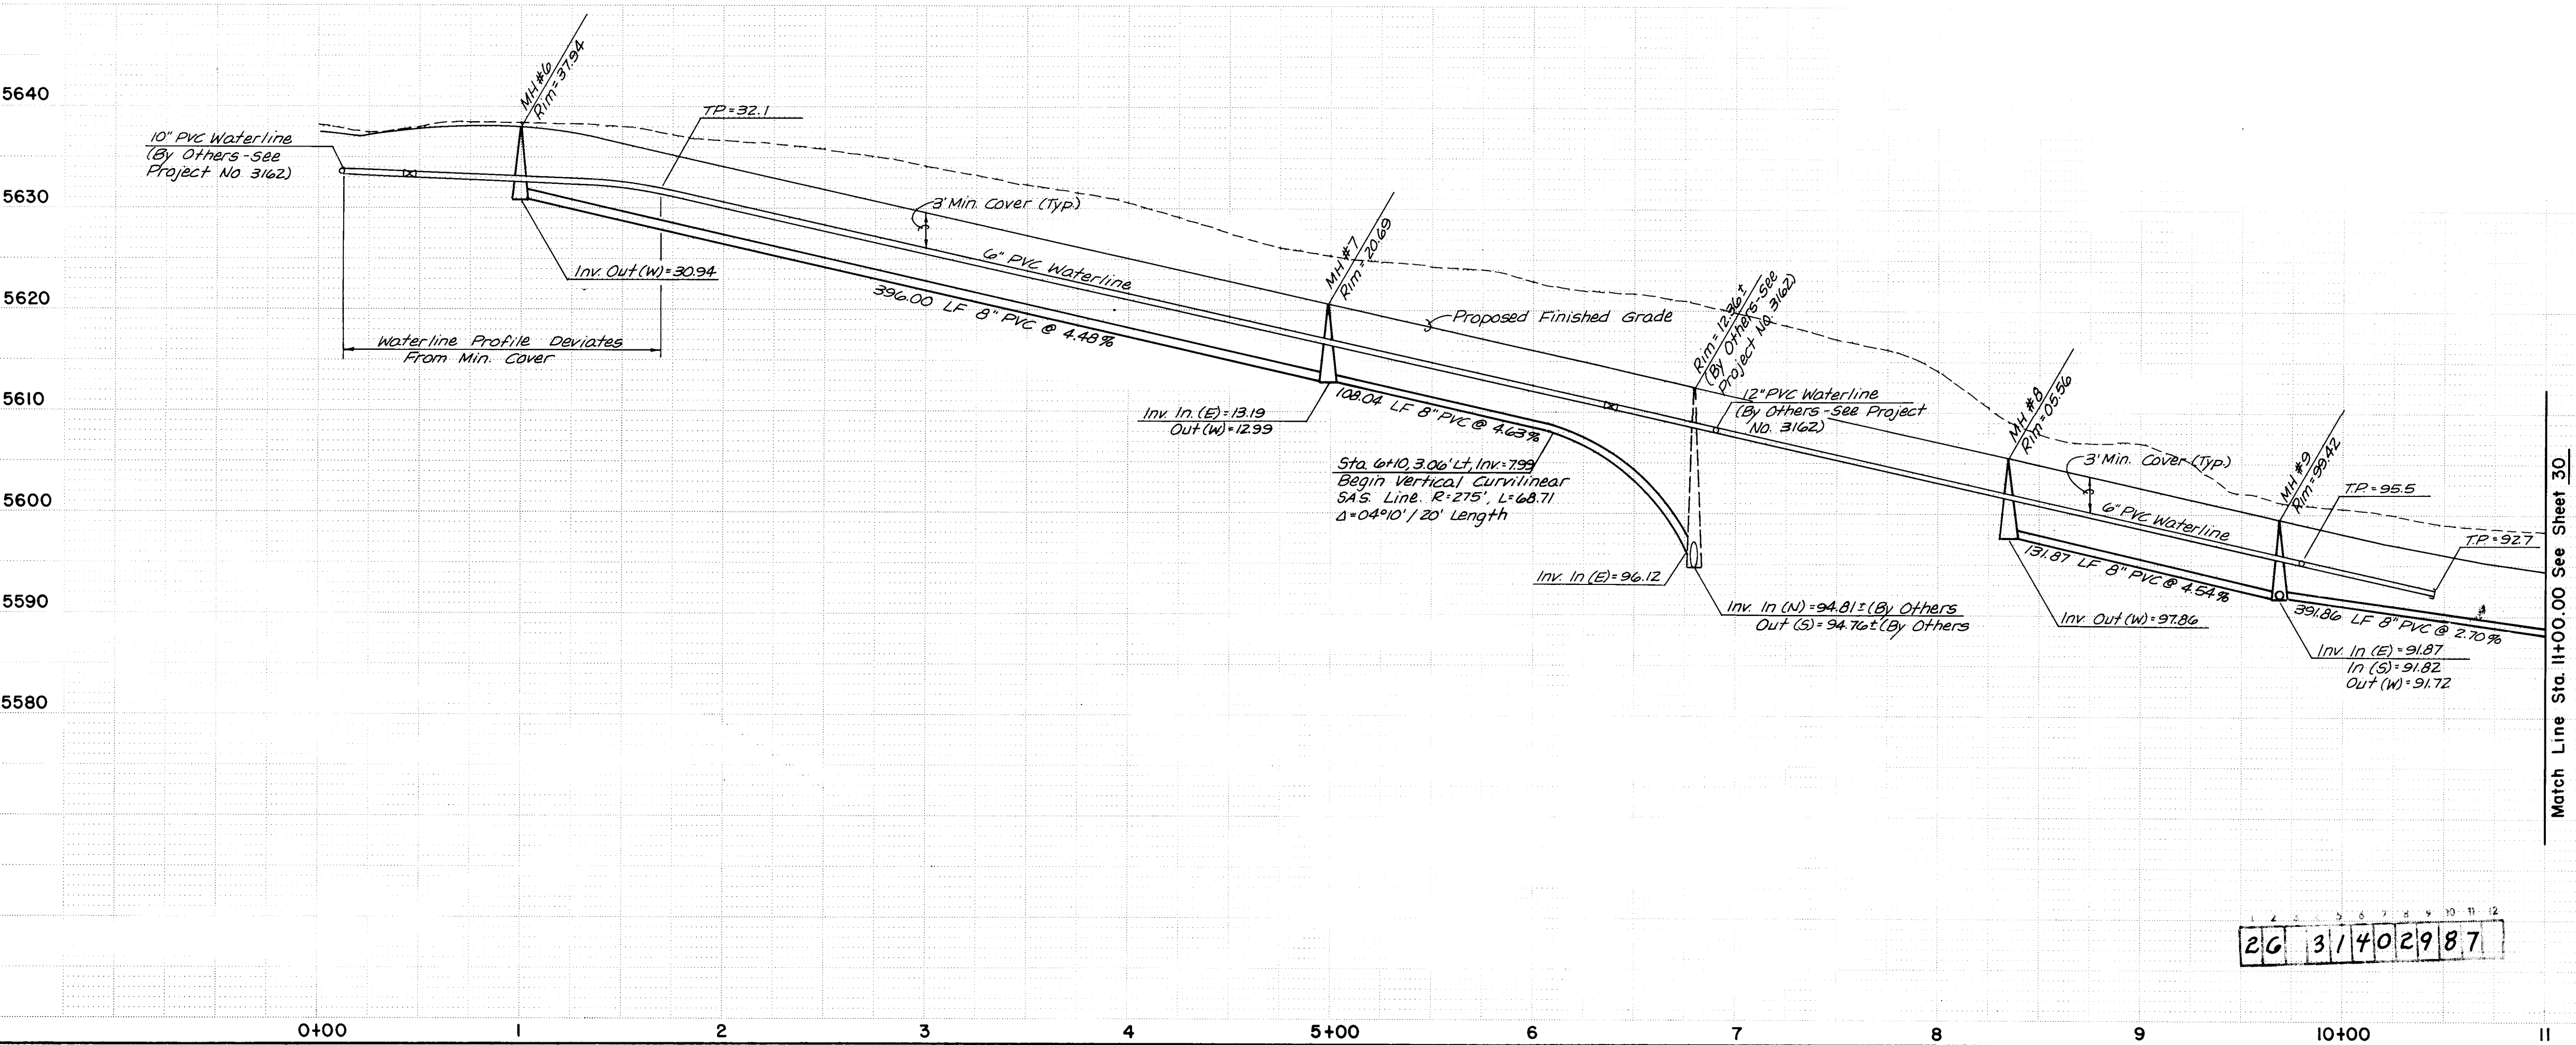

Match Line Sta. 11+00.00 See Sheet 30

26 3/4 02987

AS BUILT INFORMATION			BENCH MARKS			SURVEY INFORMATION			ENGINEER'S SEAL		
CONTRACTOR	WYLE CORP.		A.C.S. BRASS TABLET "11-C21A" SET IN THE			NO.	BY	DATE			
WORK	CUTTING		TOP OF CONCRETE POST FLUSH WITH GROUND AND								
INSPECTOR	DATE 6-87		LOCATED AT THE NORTHEAST CORNER OF THE								
ACCEPTANCE BY	DATE 12-87		INTERSECTION OF PASO DEL NORTE (LOS								
VERIFICATION BY	DATE 12-87		ANGELES DRIVE, N.E., AND HOLBROOK STREET,						4/23/87		
DRAWING NO.	DATE 12-87		N.E. ELEVATION = 5634.65'								
RECORDED BY	DATE										
NO.											



RECORD DRAWING AS BUILT

SCALE
1"=50'HORIZ.
1"=10' VERT.

CITY OF ALBUQUERQUE
MUNICIPAL DEVELOPMENT DEPARTMENT
ENGINEERING DIVISION
TITLE: HERITAGE EAST - UNIT SIX
ROSAS AVENUE, N.E.


APPROVALS	ENGINEER	DATE	APPROVALS	ENGINEER	DATE
City Engineer	4/23/87				
A.C.E. - Design	4/22/87		Traffic	NA	4/22/87
A.C.E. - Hydrology	NA		Water Utilities	W. B. L. L.	4-22-87

DRAWING NO. 3140 MAP NO. D-20 SHEET 29 OF 39

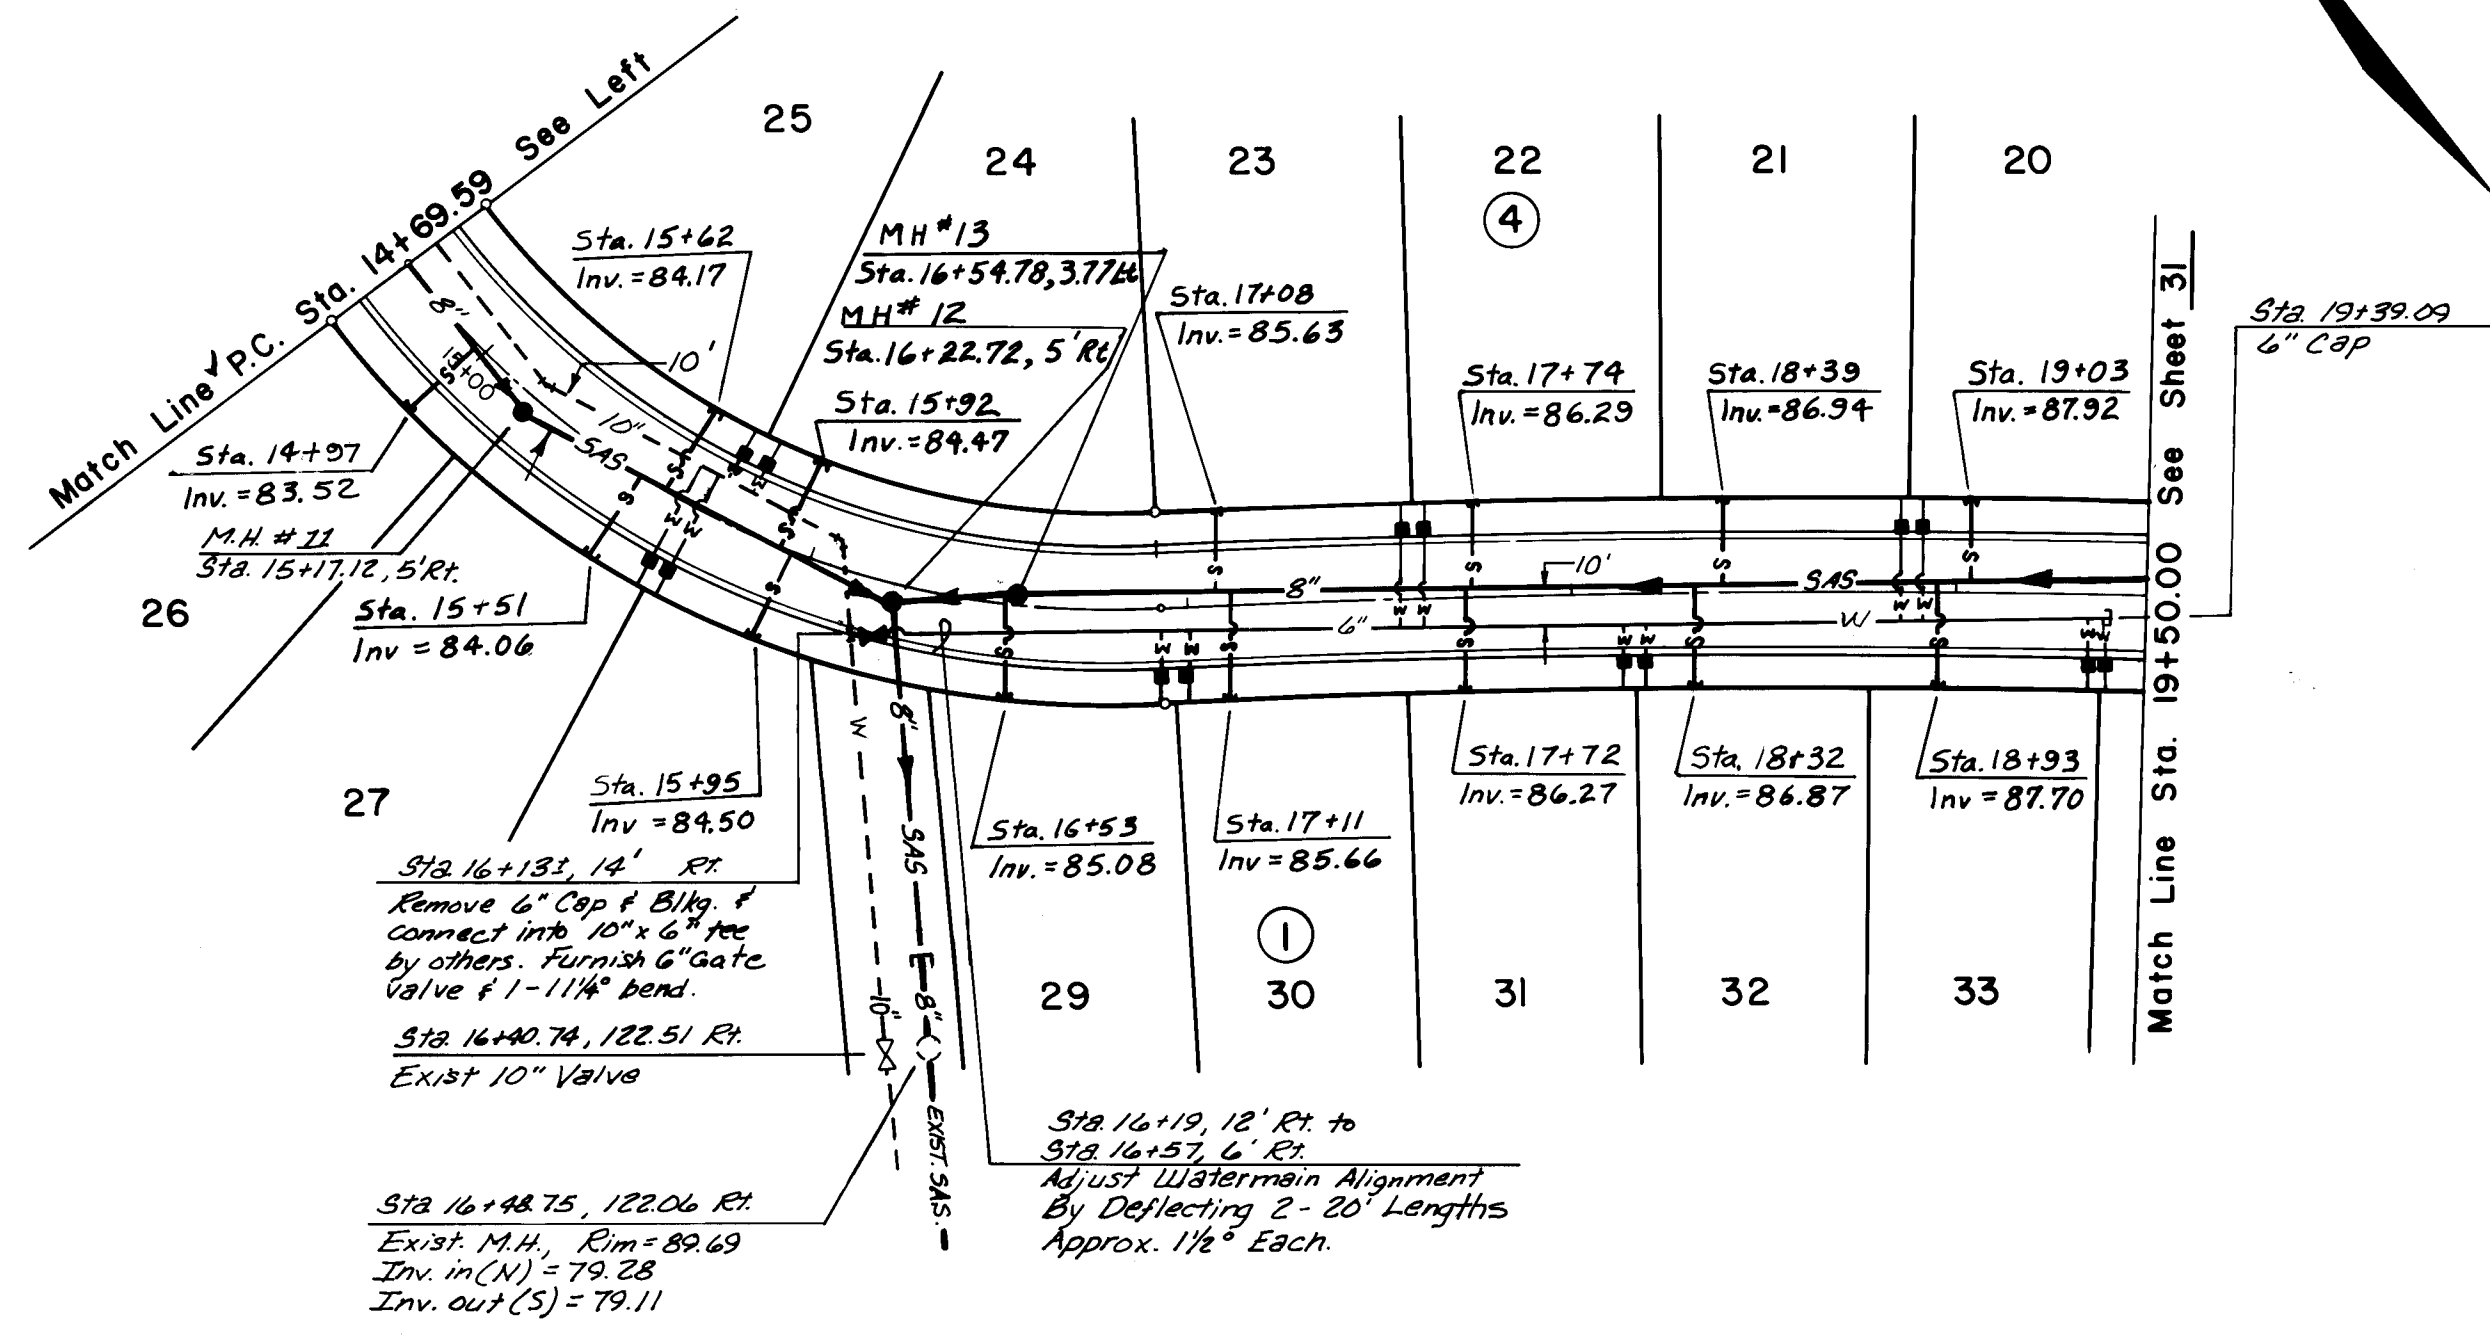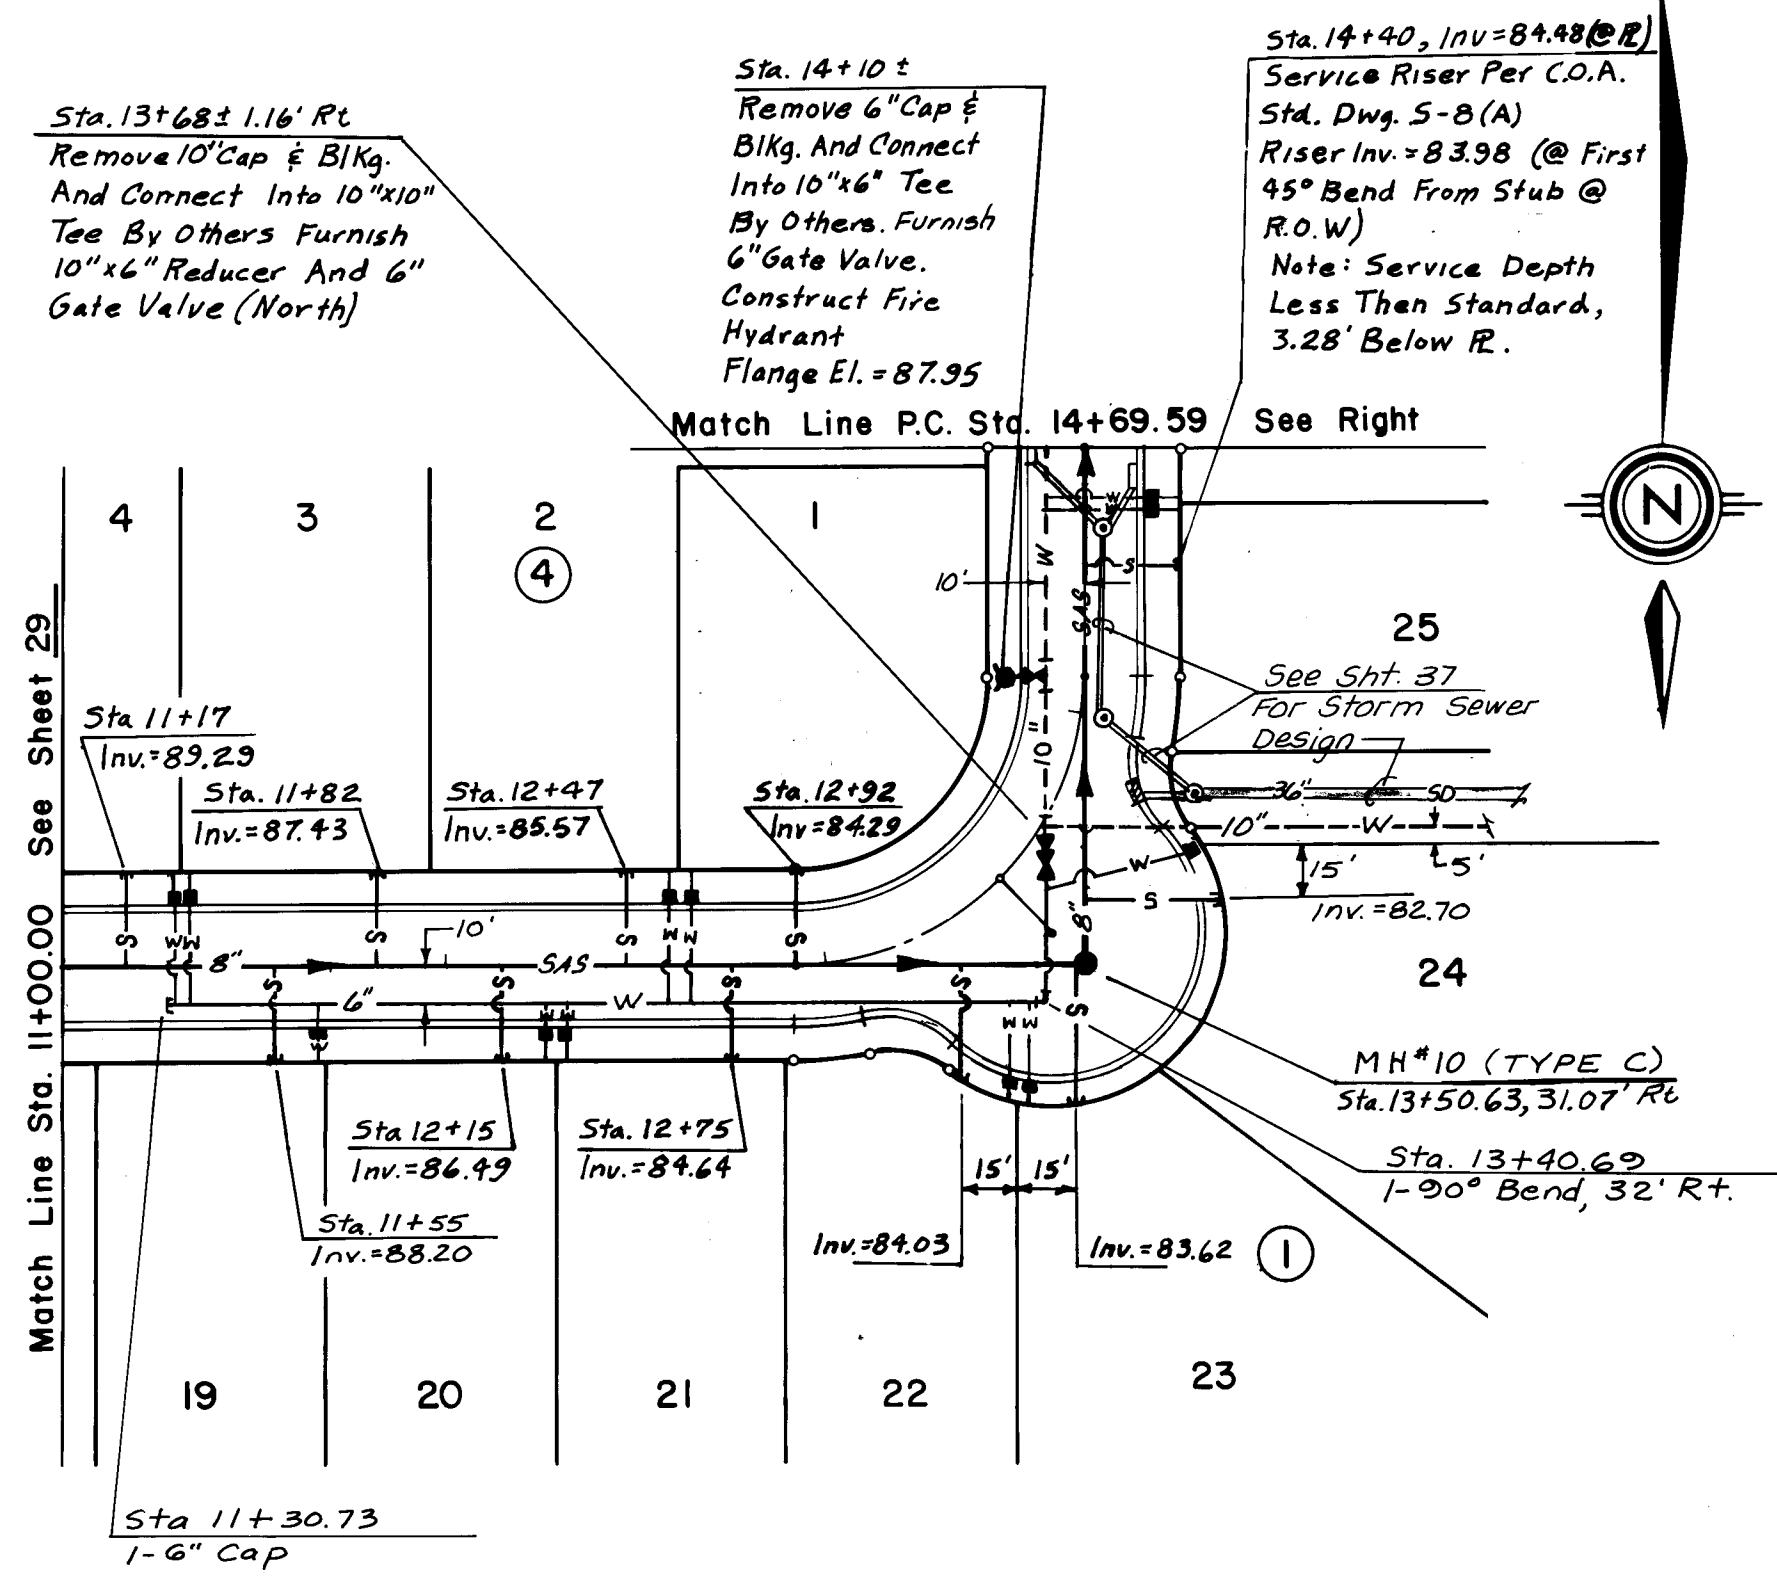

ROSAS AVENUE, N.E.

ALLANDE ROAD, N.E.

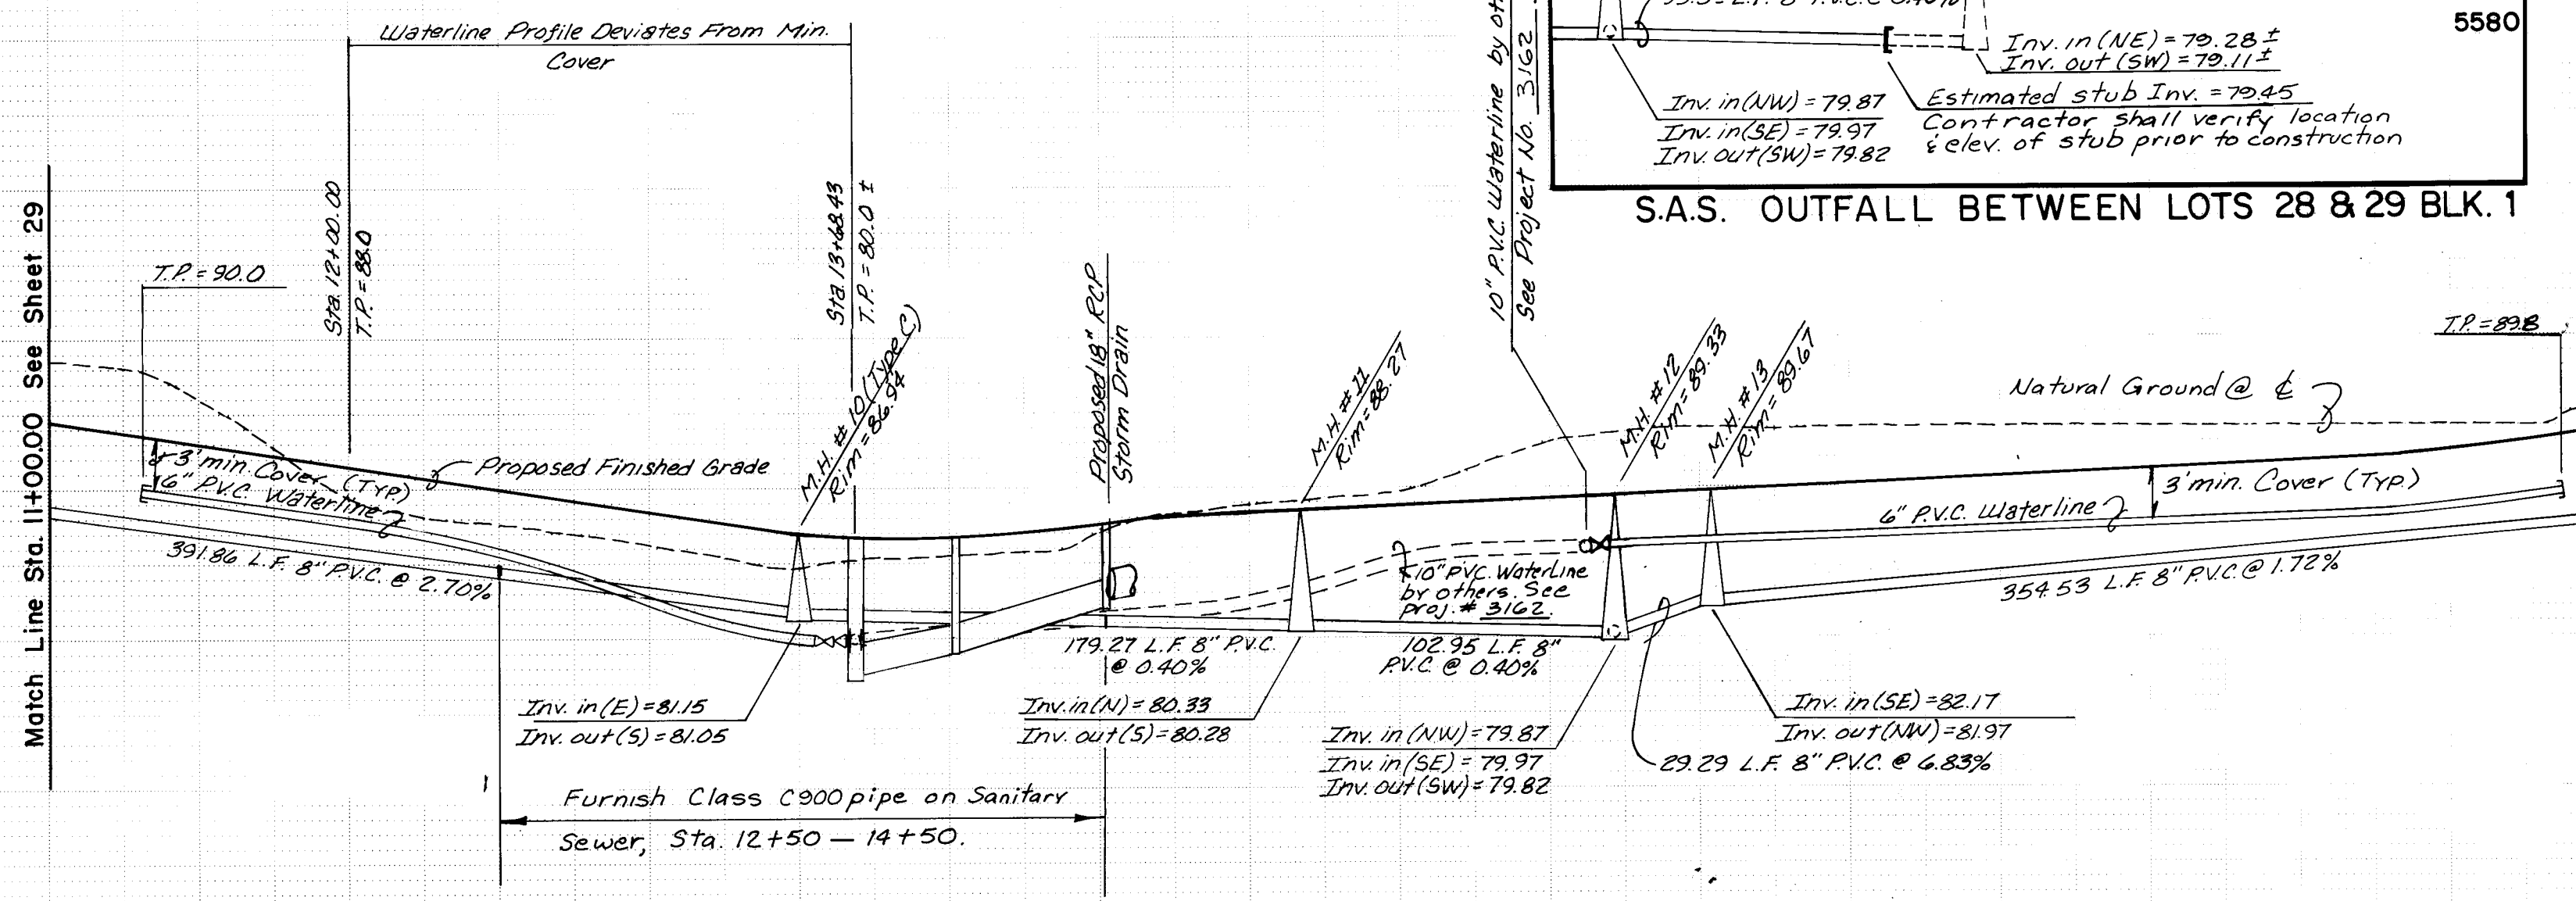

S.A.S. OUTFALL BETWEEN LOTS 28 & 29 BLK. 1

26 31403087


RECORD DRAWING AS BUILT

SCALE
1"=50' HORIZ.
1"=10' VERT.



CITY OF ALBUQUERQUE MUNICIPAL DEVELOPMENT DEPARTMENT ENGINEERING DIVISION					
TITLE: HERITAGE EAST - UNIT SIX ROSAS AVENUE, N.E. & ALLANDE ROAD, N.E.					
APPROVALS	ENGINEER	DATE	APPROVALS	ENGINEER	DATE
City Engineer	<i>[Signature]</i>	4/22/97	Traffic	<i>[Signature]</i>	4/22/97
A.C.E. - Design	<i>[Signature]</i>	4/22/97	Water Utilities	<i>[Signature]</i>	4/22/97
A.C.E. - Hydrology	NA				

DRAWING NO.	3140	MAP NO.	D-20	SHEET NO.	30	OF	39
-------------	------	---------	------	-----------	----	----	----

ENGINEER'S SEAL		SURVEY INFORMATION		BENCH MARKS		AS BUILT INFORMATION	
	BY <i>[Signature]</i>	NO. 	DATE 	A.C.S. BRASS TABLET "1-C21A" SET IN THE TOP OF CONCRETE POST FLUSH WITH GROUND AND LOCATED AT THE NORTHEAST CORNER OF THE INTERSECTION OF PASO DEL NORTE (LOS ANGELES DRIVE, N.E.) AND HOLBROOK STREET, N.E. ELEVATION = 5634.65'	CONTRACTOR WYLLIE CORP.	WORK ORDER NO. 	DATE

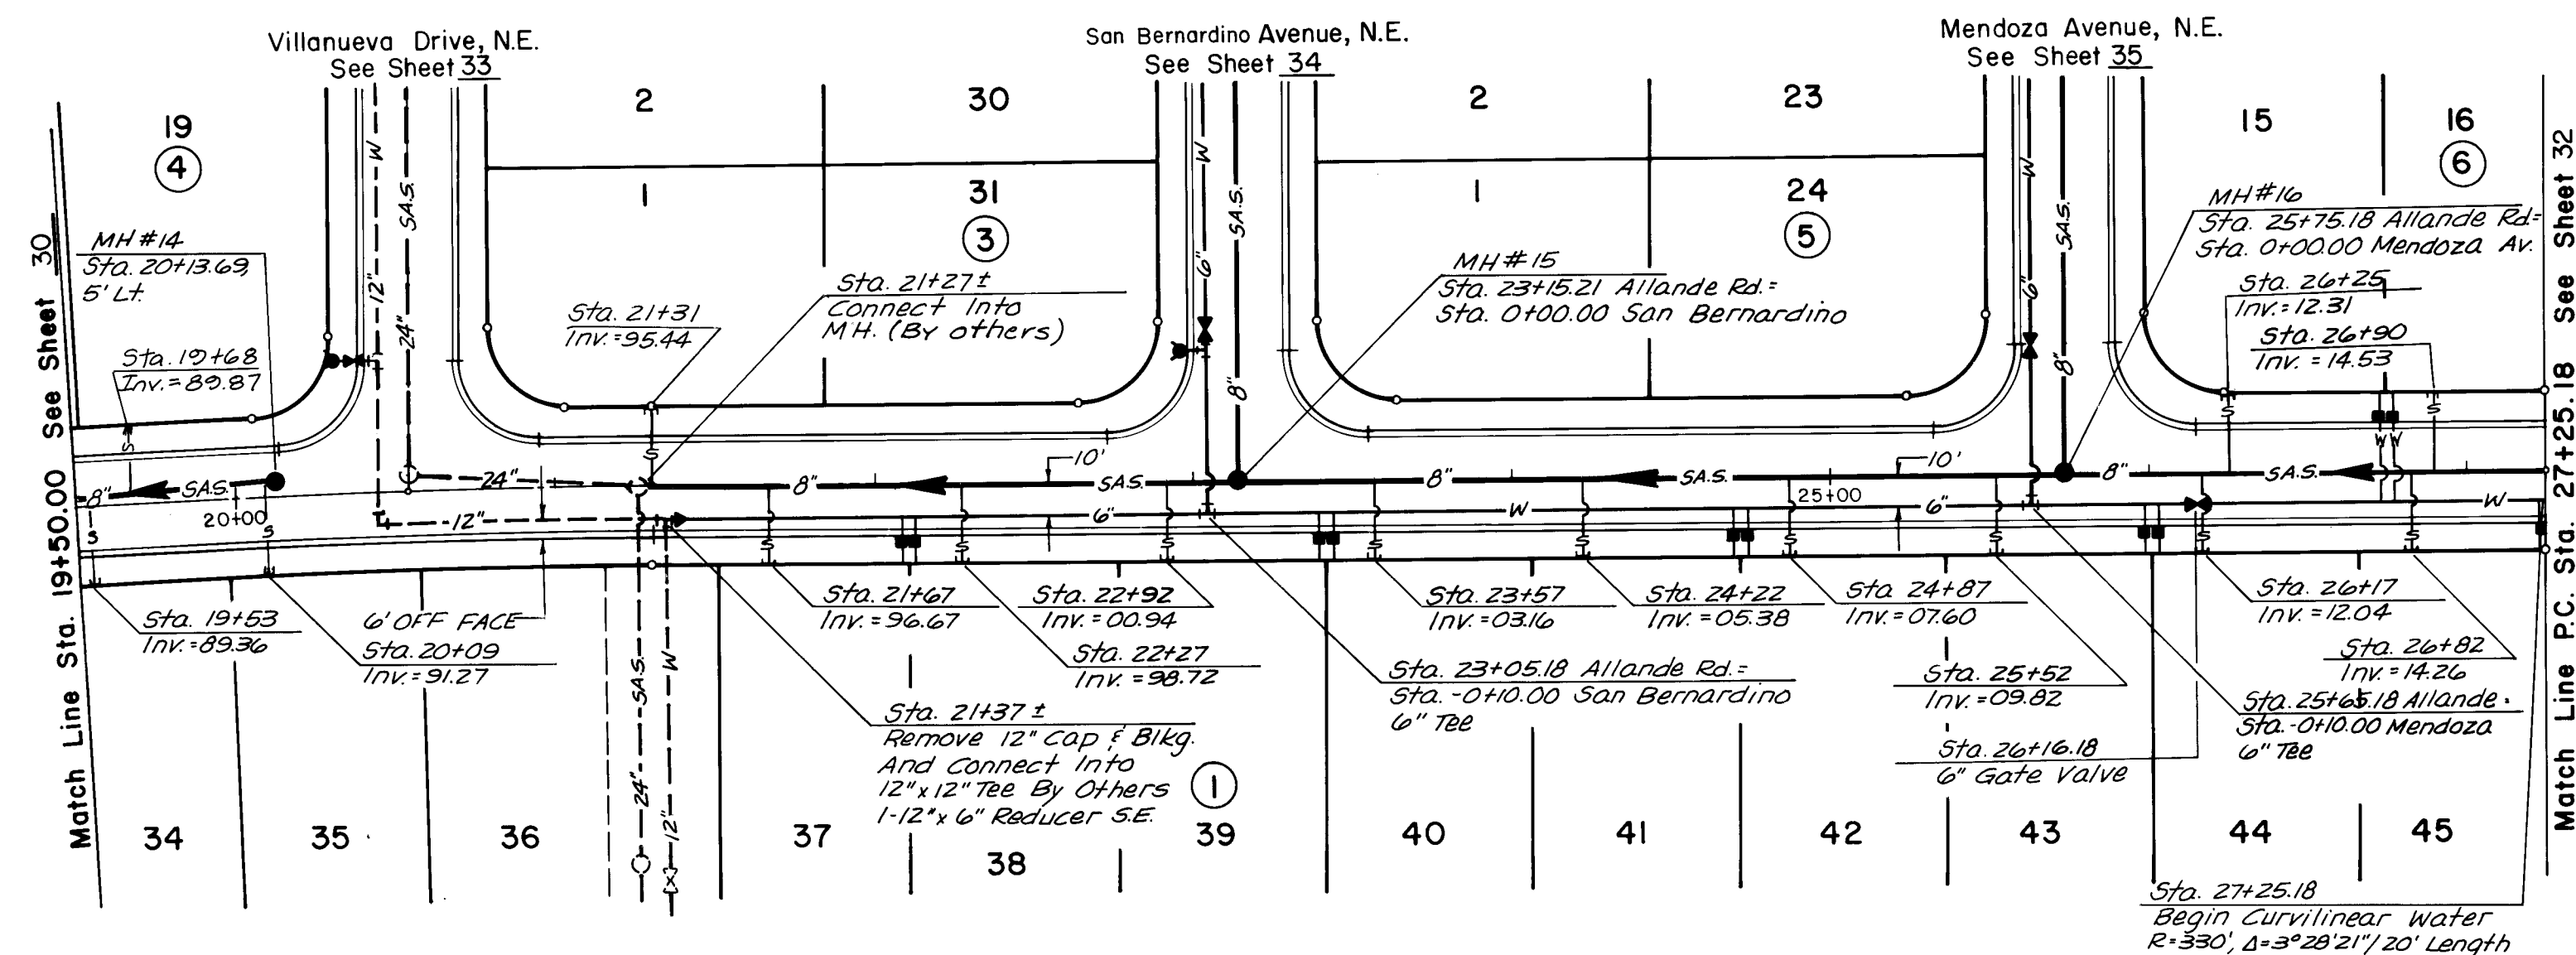

ALLANDE ROAD, N.E.

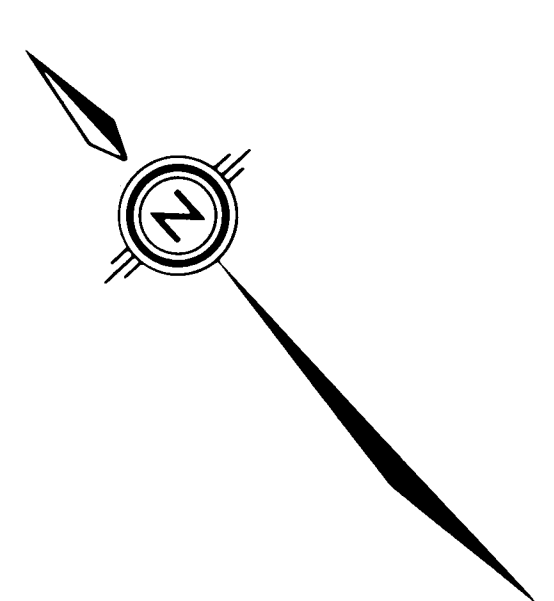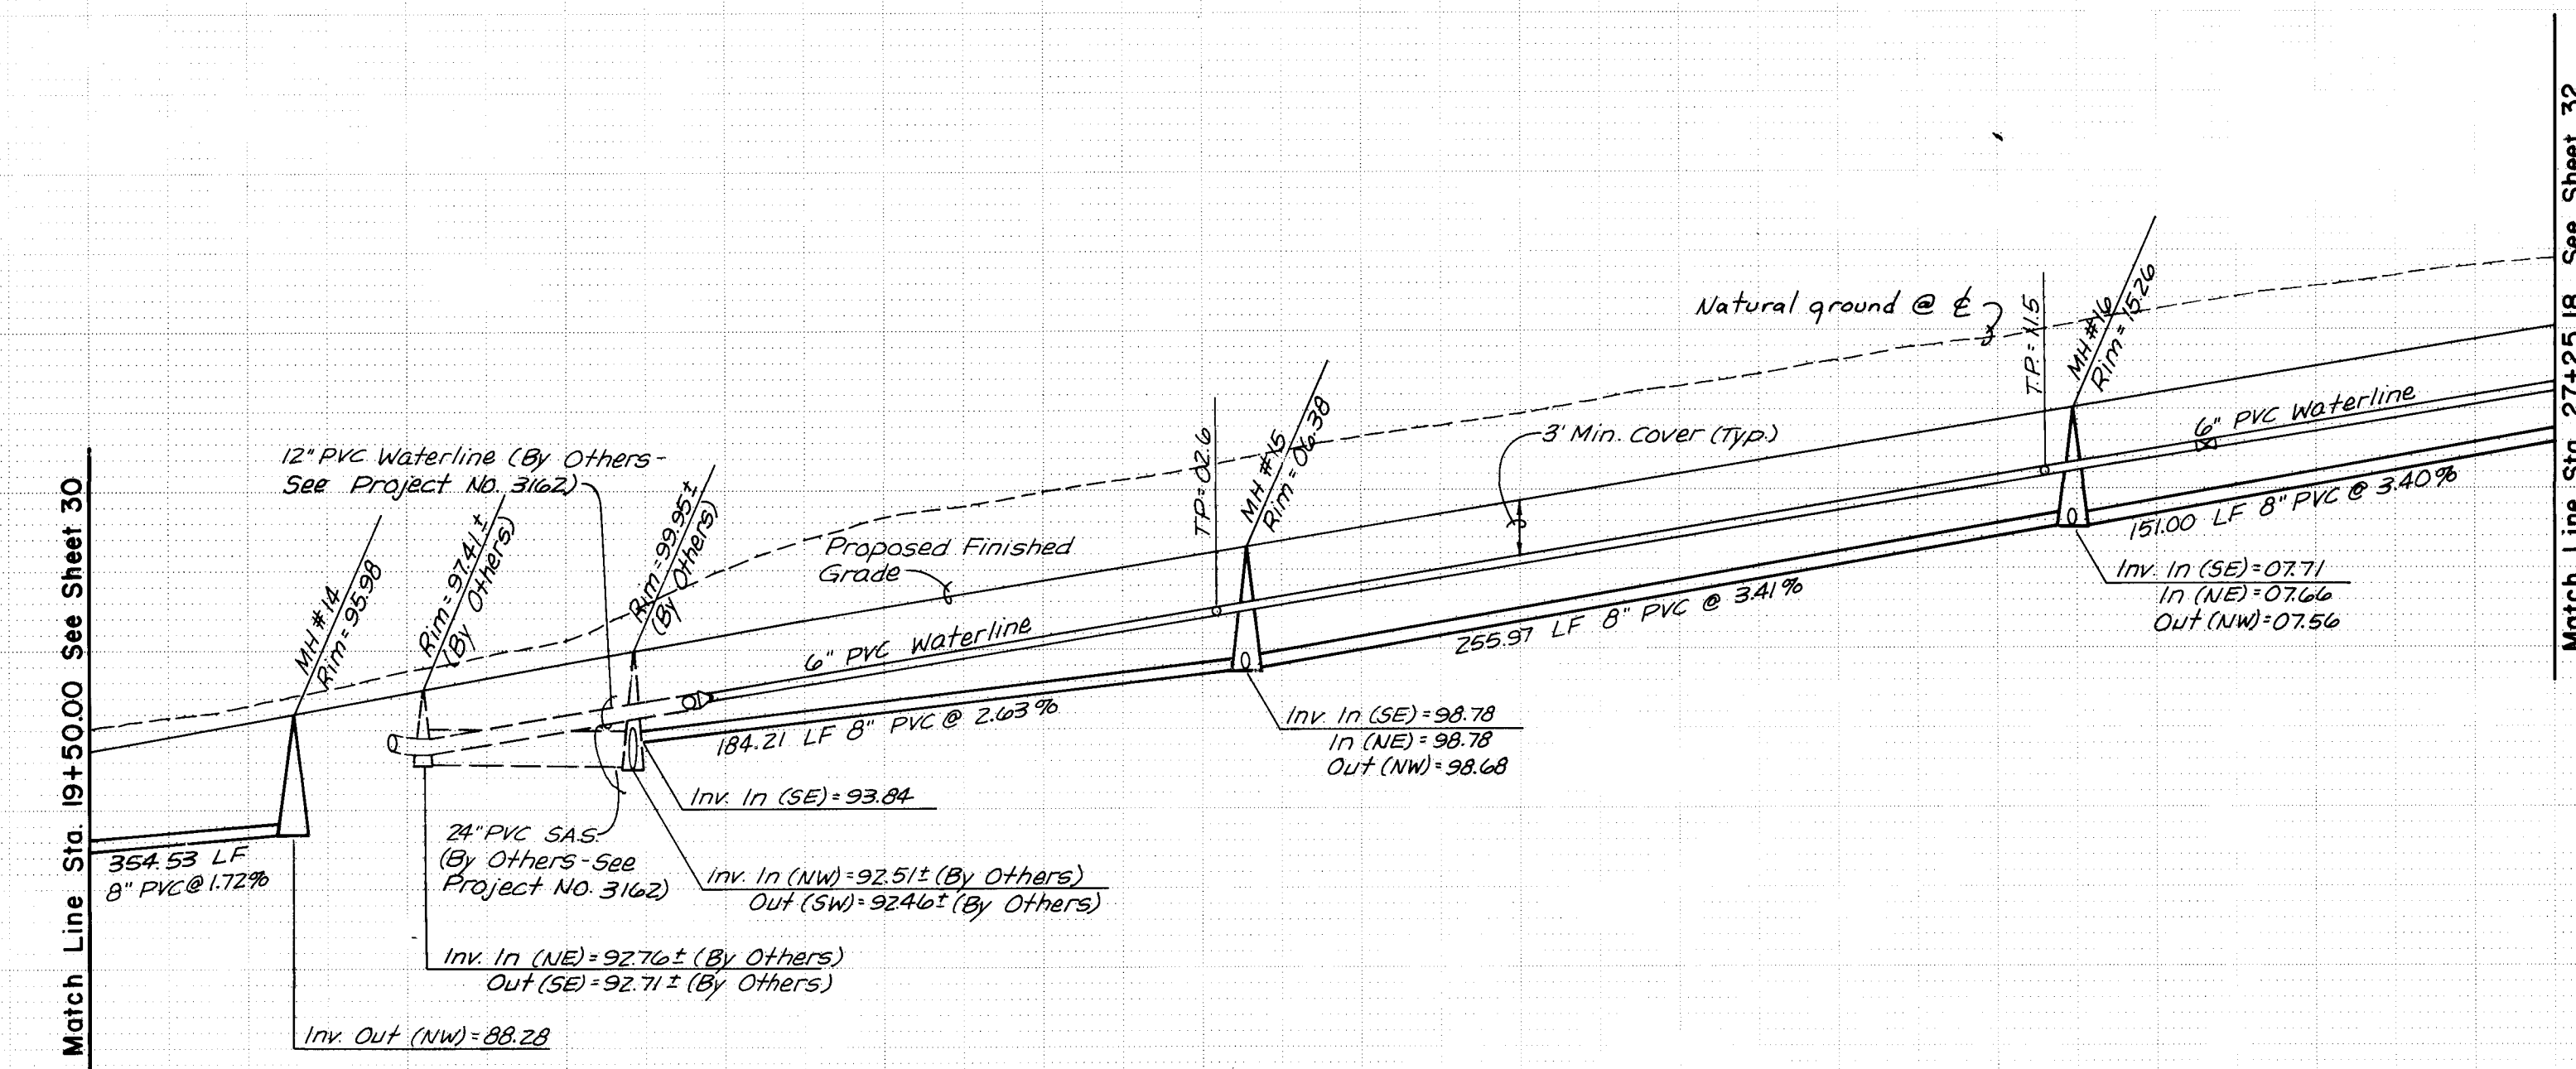

26 314031817

RECORD DRAWING AS BUILT

SCALE
1"=50'HORIZ.
1"=10'VERT.

CITY OF ALBUQUERQUE
MUNICIPAL DEVELOPMENT DEPARTMENT
ENGINEERING DIVISION


TITLE: HERITAGE EAST - UNIT SIX

ALLANDE ROAD, N.E.


APPROVALS	ENGINEER	DATE	APPROVALS	ENGINEER	DATE
City Engineer	<i>[Signature]</i>	4/21/87			
A.C.E. - Design	<i>[Signature]</i>	4/22/87	Traffic	<i>[Signature]</i>	4/22/87
A.C.E. - Hydrology	<i>[Signature]</i>		Water Utilities	<i>[Signature]</i>	4-22-87

DRAWING NO. 3140 MAP NO. D-20 SHEET 31 OF 39

		ENGINEER'S SEAL		SURVEY INFORMATION		BENCH MARKS		AS BUILT INFORMATION	
				FIELD NOTES				CONTRACTOR: WYLLIE CORP.	
				NO.		BY		DATE	
								A.C.S.S. BRASS TABLET "11-C21A" SET IN THE	
								TOP OF CONCRETE POST FLUSH WITH GROUND AND	
								LOCATED AT THE NORTHEAST CORNER OF THE	
								INTERSECTION OF PASO DEL NORTE (LOS	
								ANGELES DRIVE, N.E.) AND HOLBROOK STREET,	
								N.E. ELEVATION = 5634.65'	

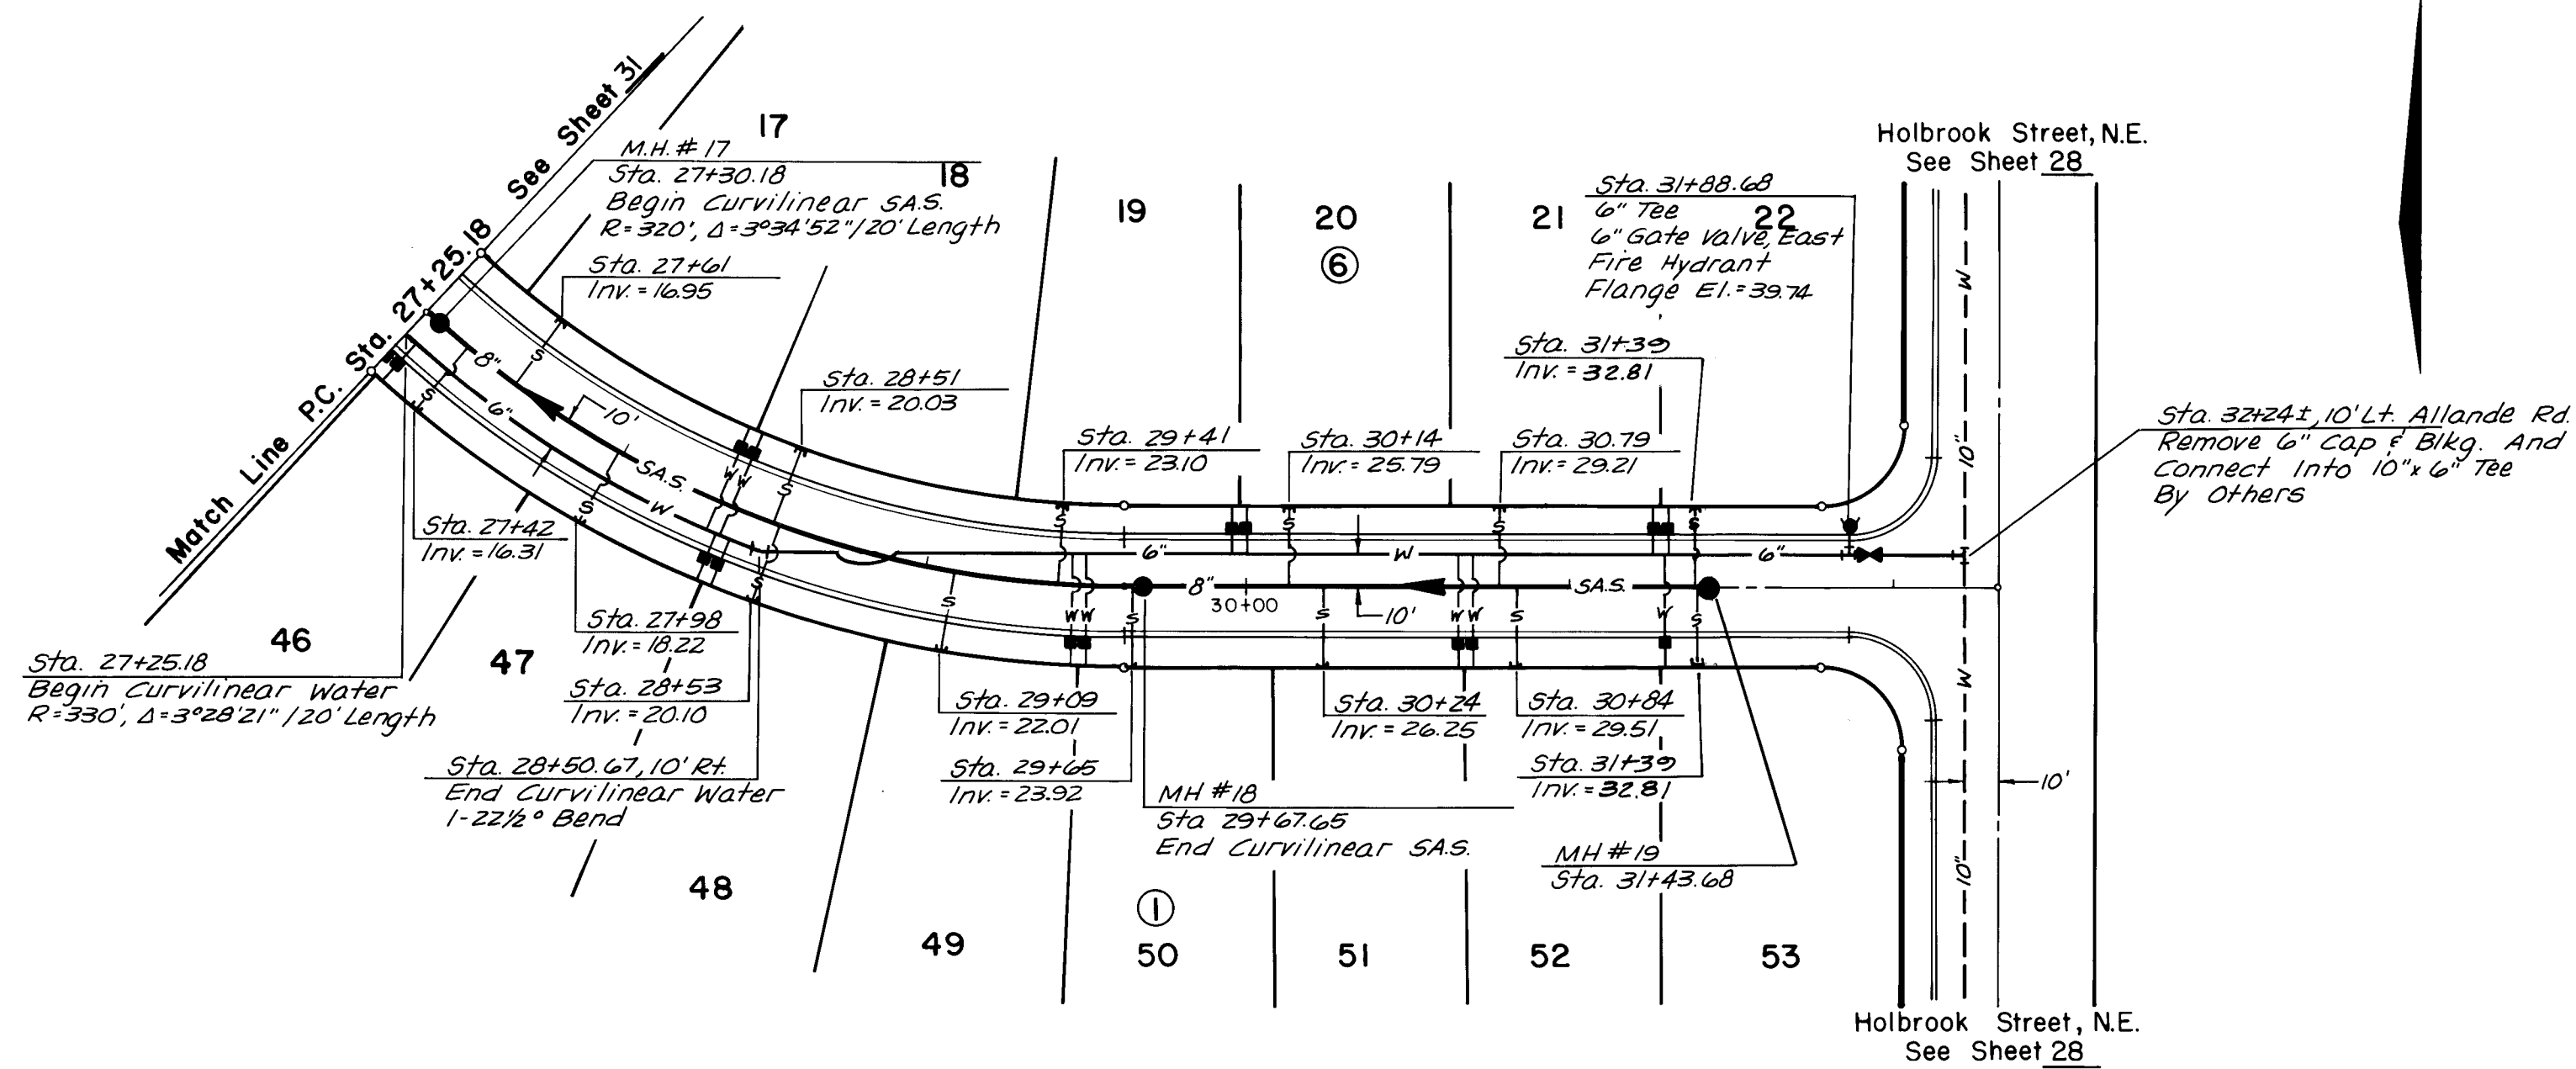

ALLANDE ROAD, N.E.

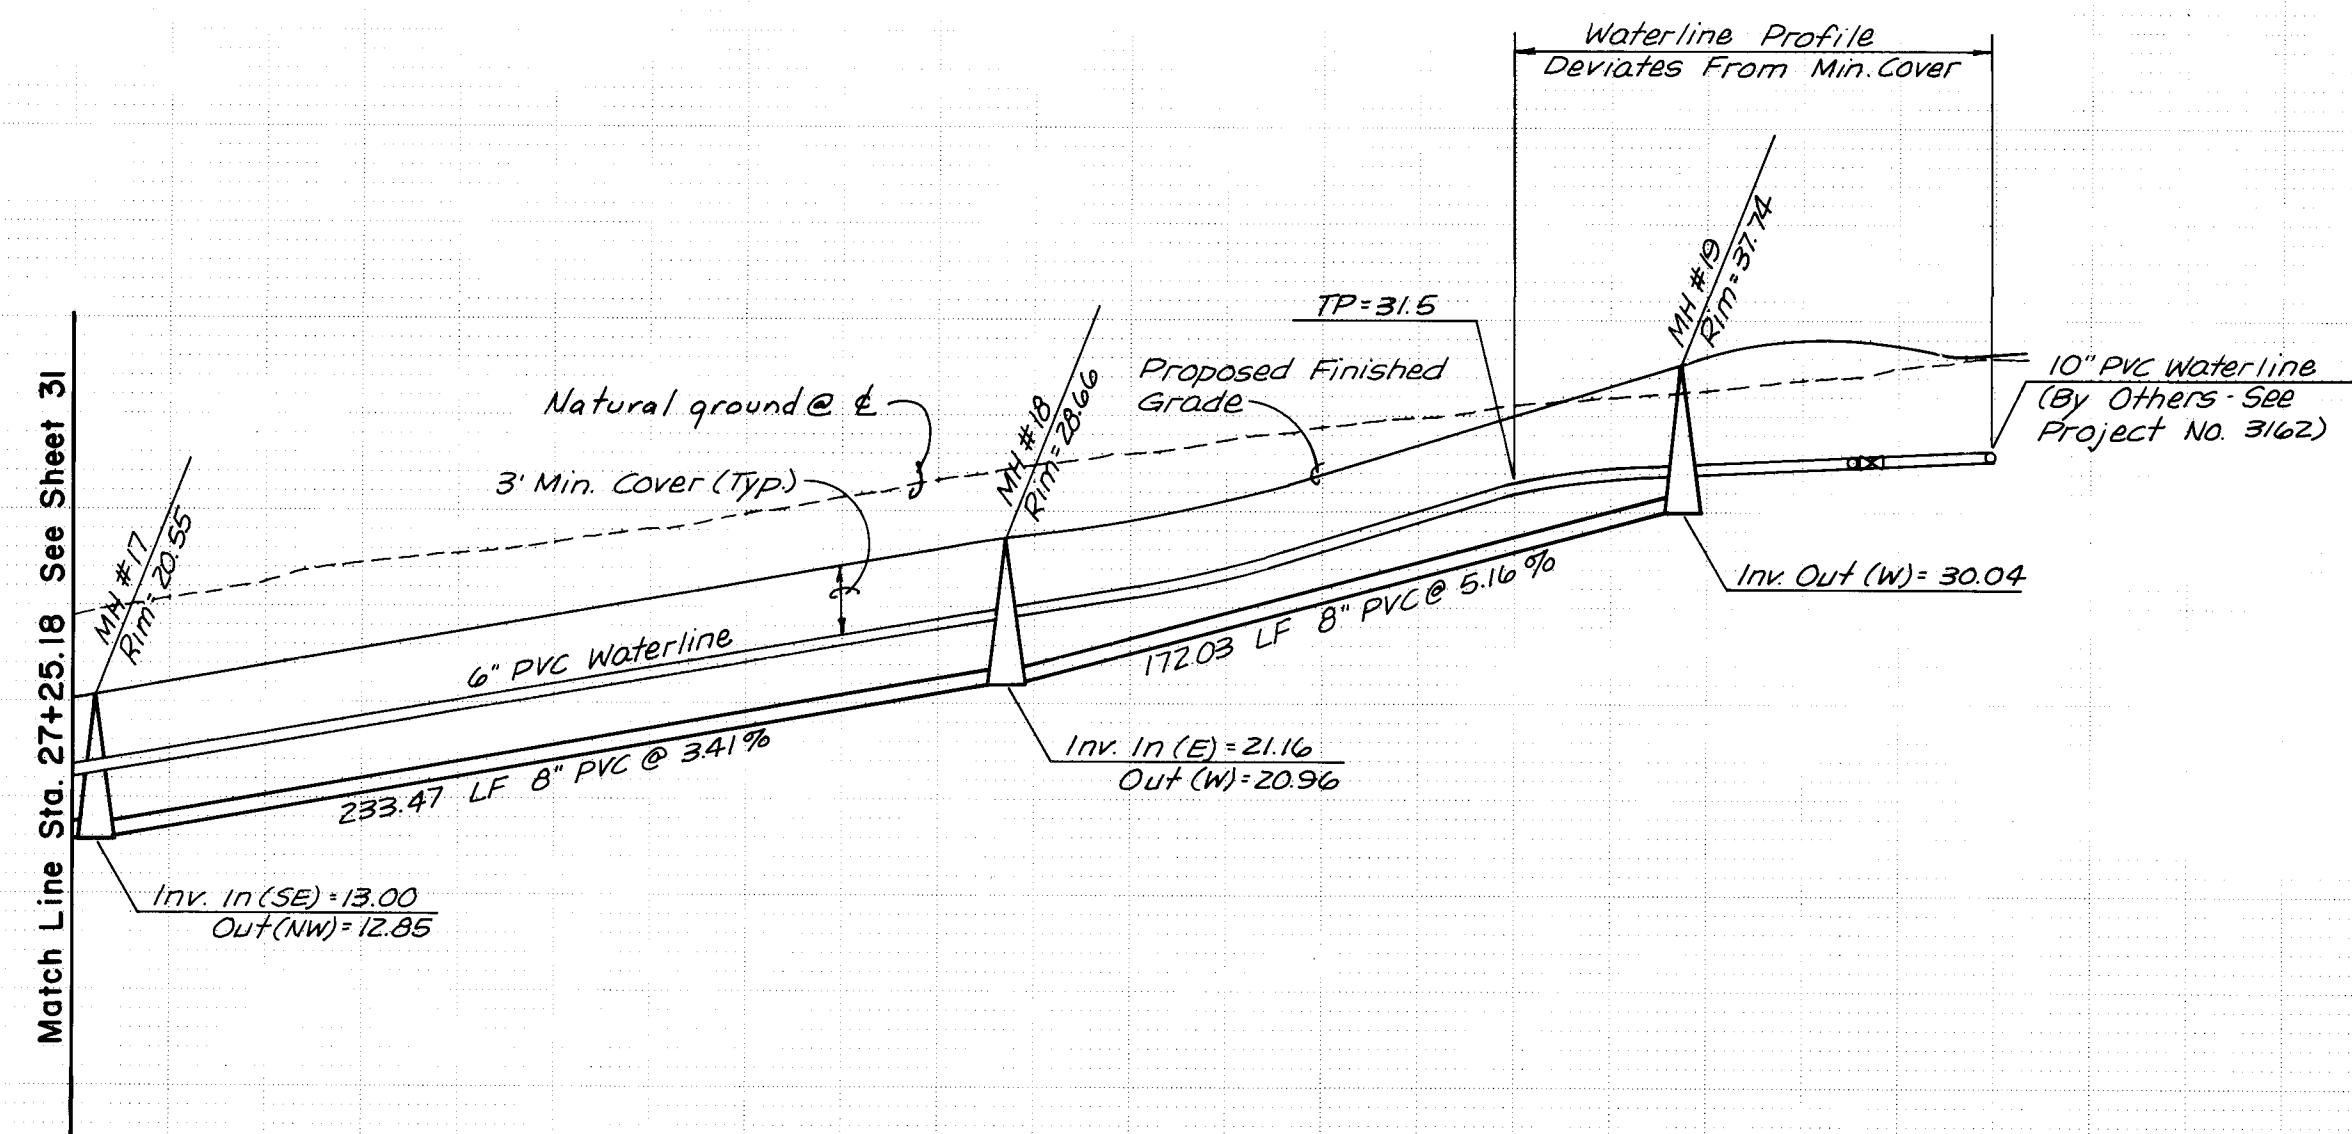

26 31403287

AS BUILT INFORMATION		BENCH MARKS		SURVEY INFORMATION		ENGINEER'S SEAL		REVISIONS		DESIGN		APPROVALS		ENGINEER		DATE	
CONTRACTOR: WYLLIE CORP.		A.C.S. BRASS TABLET "1-C21A" SET IN THE TOP OF CONCRETE POST FLUSH WITH GROUND AND LOCATED AT THE NORTHEAST CORNER OF THE INTERSECTION OF PASO DEL NORTE (LOS ANGELES DRIVE, N.E.) AND HOLBROOK STREET, N.E. ELEVATION = 5634.65'		FIELD NOTES		[Seal of Kent M. Whitman, Registered Professional Engineer, State of New Mexico, No. 4123]		NO.		DATE		APPROVED		ENGINEER		DATE	
WORK BY: CUTLER				BY				REMARKS		DESIGN		CITY ENGINEER		ENGINEER		DATE	
INSPECTOR: [Signature]				NO.				NO.		DATE		A.C.E. - Design		ENGINEER		DATE	
ACCEPTANCE BY: [Signature]				NO.				NO.		DATE		A.C.E. - Hydrology		ENGINEER		DATE	
DRAWING BY: C.S.C.				NO.				NO.		DATE		DESIGNED BY: P.L., M.K.S.		ENGINEER		DATE	
CHECKED BY: C.S.C.				NO.				NO.		DATE		DRAWN BY: C.S.C.		ENGINEER		DATE	
RECORDED BY: [Signature]				NO.				NO.		DATE		CHECKED BY: M.K.S.		ENGINEER		DATE	

RECORD DRAWING AS BUILT

SCALE
1"= 50' HORIZ.
1"= 10' VERT.

CITY OF ALBUQUERQUE
MUNICIPAL DEVELOPMENT DEPARTMENT
ENGINEERING DIVISION


TITLE: HERITAGE EAST - UNIT SIX
ALLANDE ROAD, N.E.

APPROVALS	ENGINEER	DATE	APPROVALS	ENGINEER	DATE
City Engineer	[Signature]	4/12/87	Traffic	N.A.D.W.H.	4/12/87
A.C.E. - Design	[Signature]	4/22/87	Water Utilities	[Signature]	4/22/87
A.C.E. - Hydrology	N.A.				


DRAWING NO. 3140

MAP NO. D-20

SHEET 32 OF 39

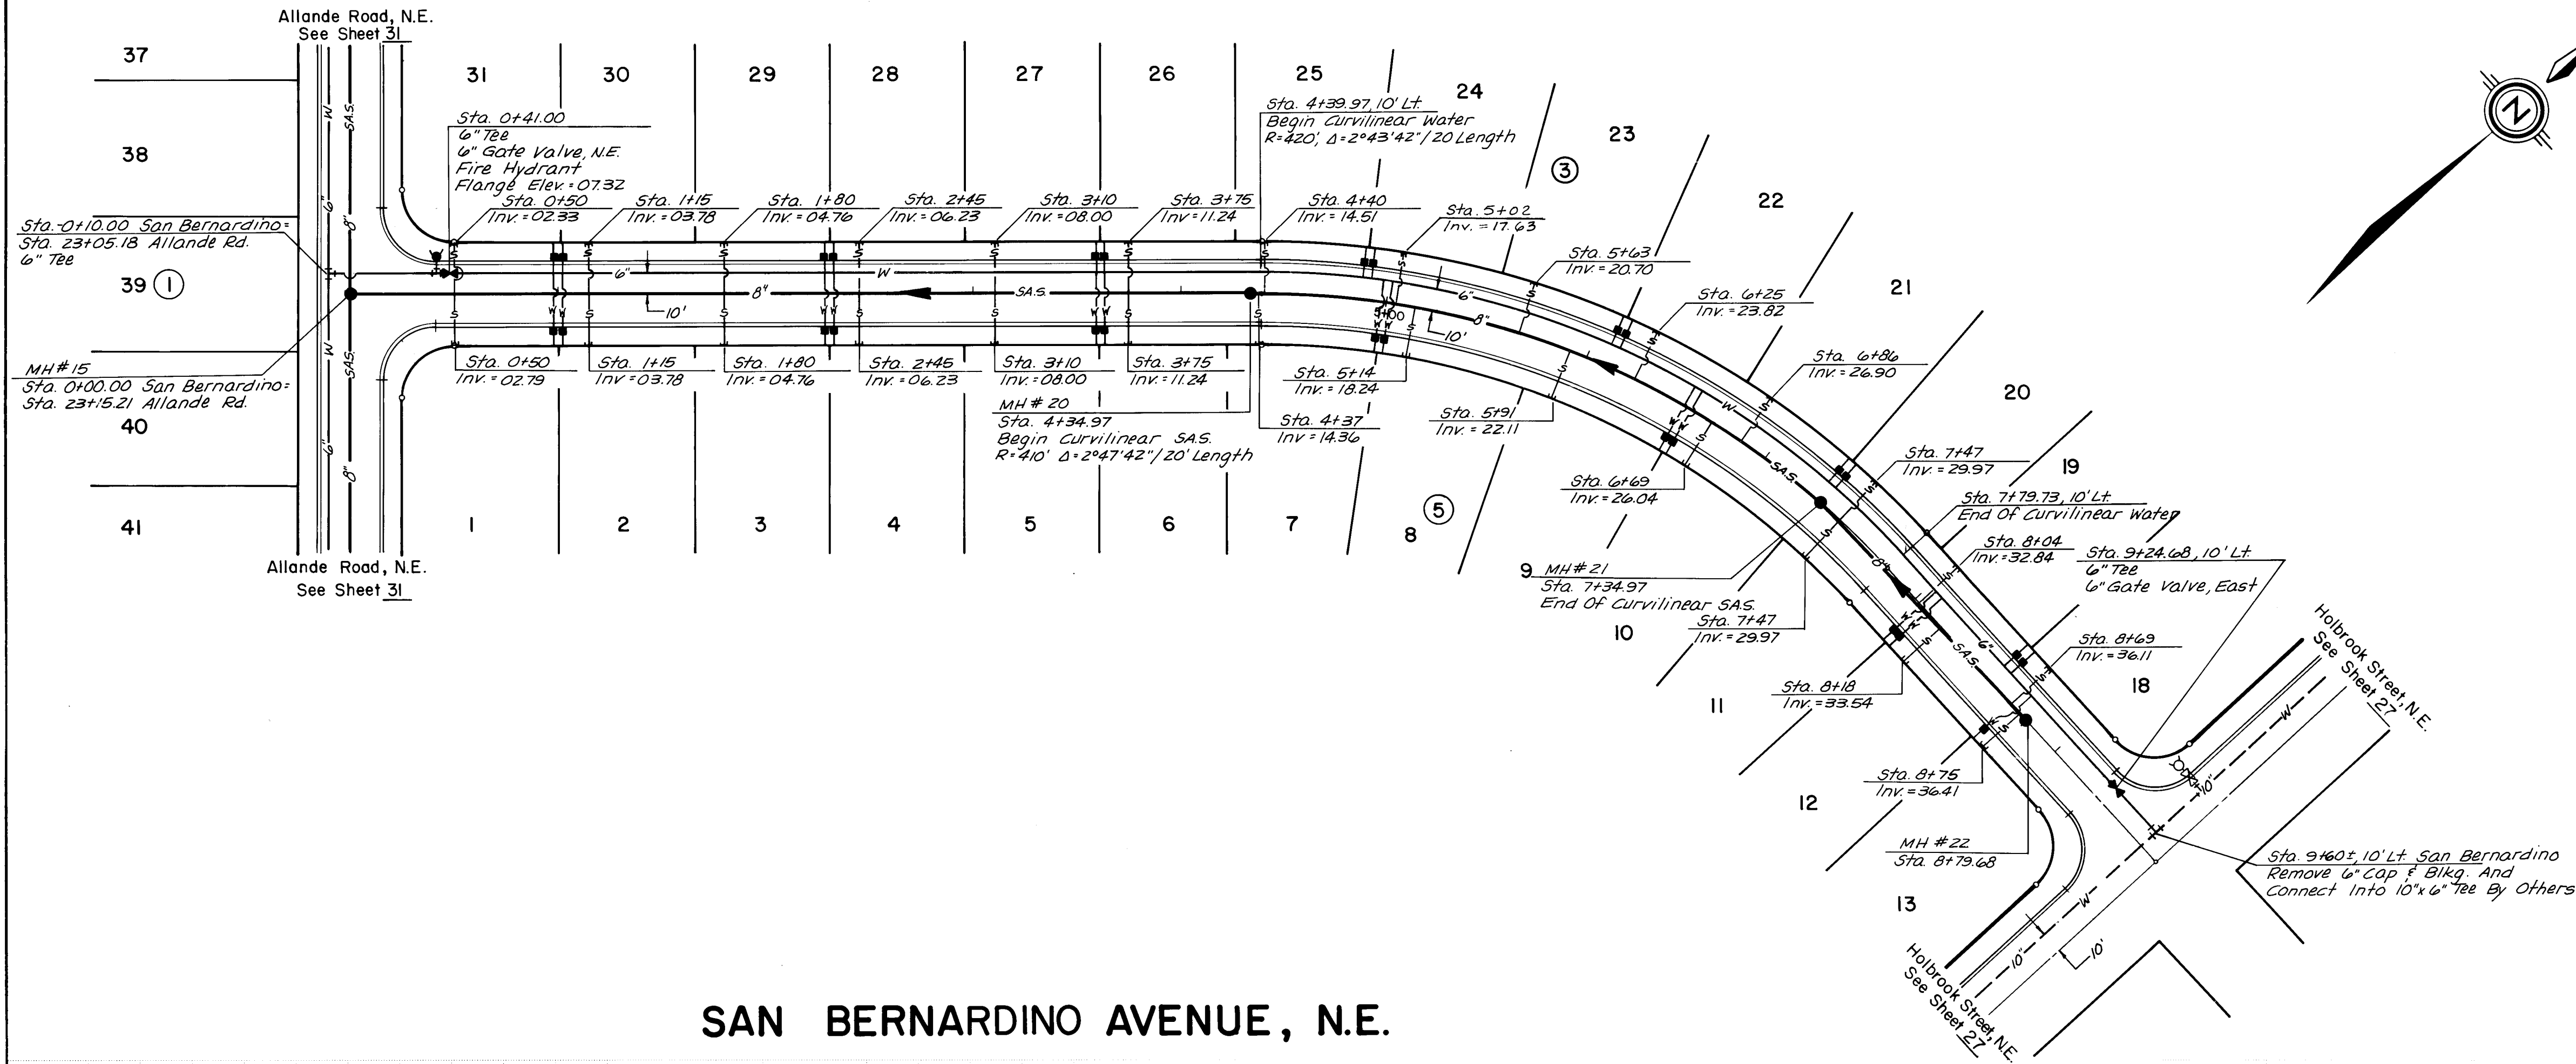


SAN BERNARDINO AVENUE, N.E.

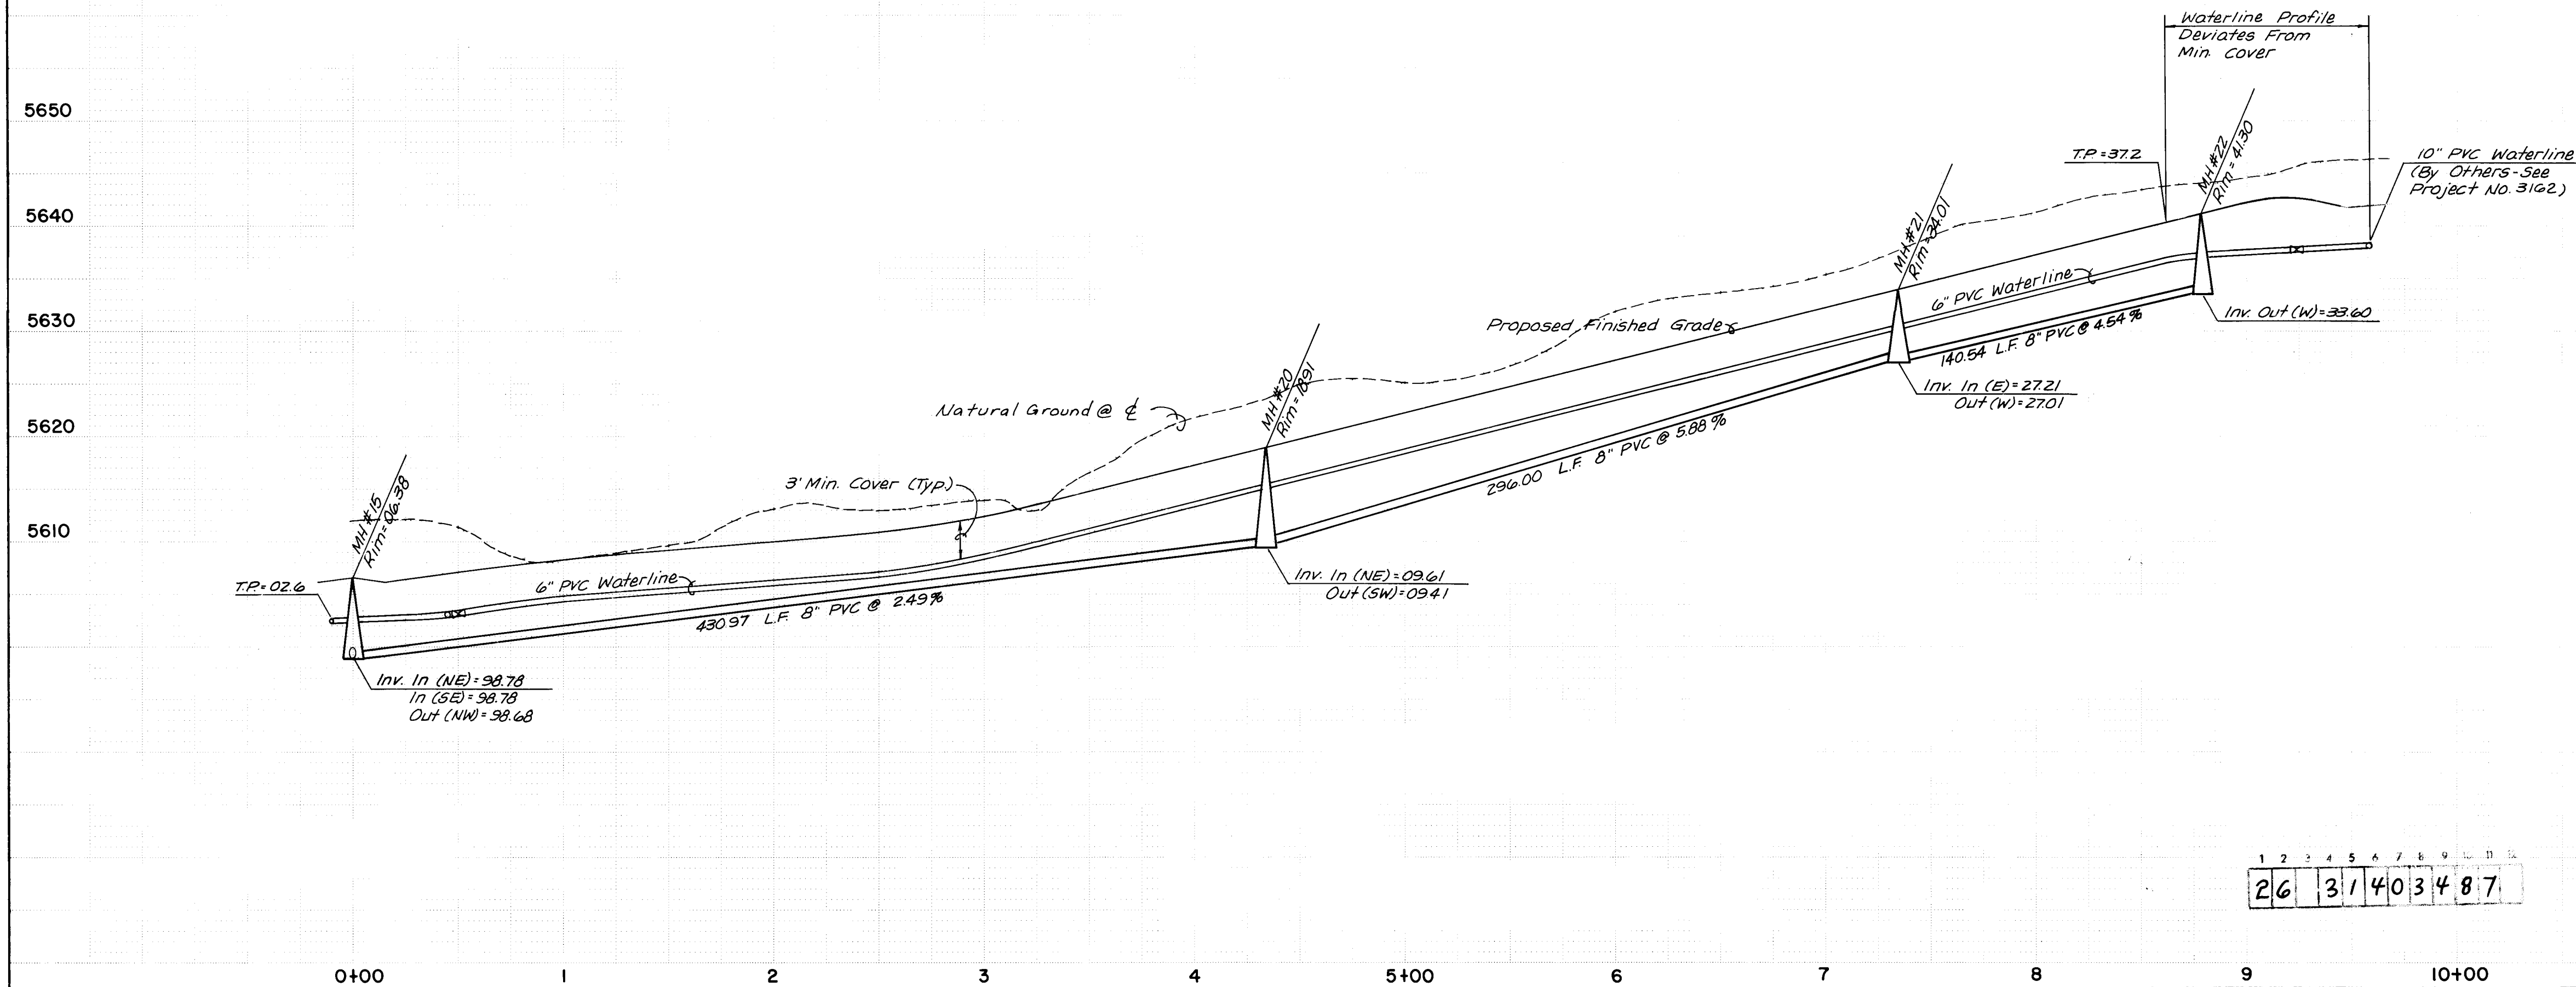


1 2 3 4 5 6 7 8 9 10 11 12
26 31 40 34 8 7

ENGINEER'S SEAL		REVISIONS		DESIGN	
4/23/87		NO.		DATE	
REMARKS		BY		DATE	
DESIGNED BY R.L. M.K.S.		DRAWN BY C.S.S.		CHECKED BY M.K.S.	
DATE 3-87		DATE 3-87		DATE 4-87	
RECORD DRAWING AS BUILT					
SCALE 1"=50'HORIZ. 1"=10' VERT.					
CITY OF ALBUQUERQUE MUNICIPAL DEVELOPMENT DEPARTMENT ENGINEERING DIVISION					
TITLE: HERITAGE EAST - UNIT SIX SAN BERNARDINO AVENUE, N.E.					
APPROVALS		ENGINEER	DATE	APPROVALS	ENGINEER
City Engineer		4/24/87	4/24/87	Traffic	
A.C.E. - Design		NA	4/22/87	Water Utilities	
A.C.E. - Hydrology		NA	4/22/87	4/22/87	
DRAWING NO.		3140	MAP NO.	SHEET	OF
		D-20		34	39

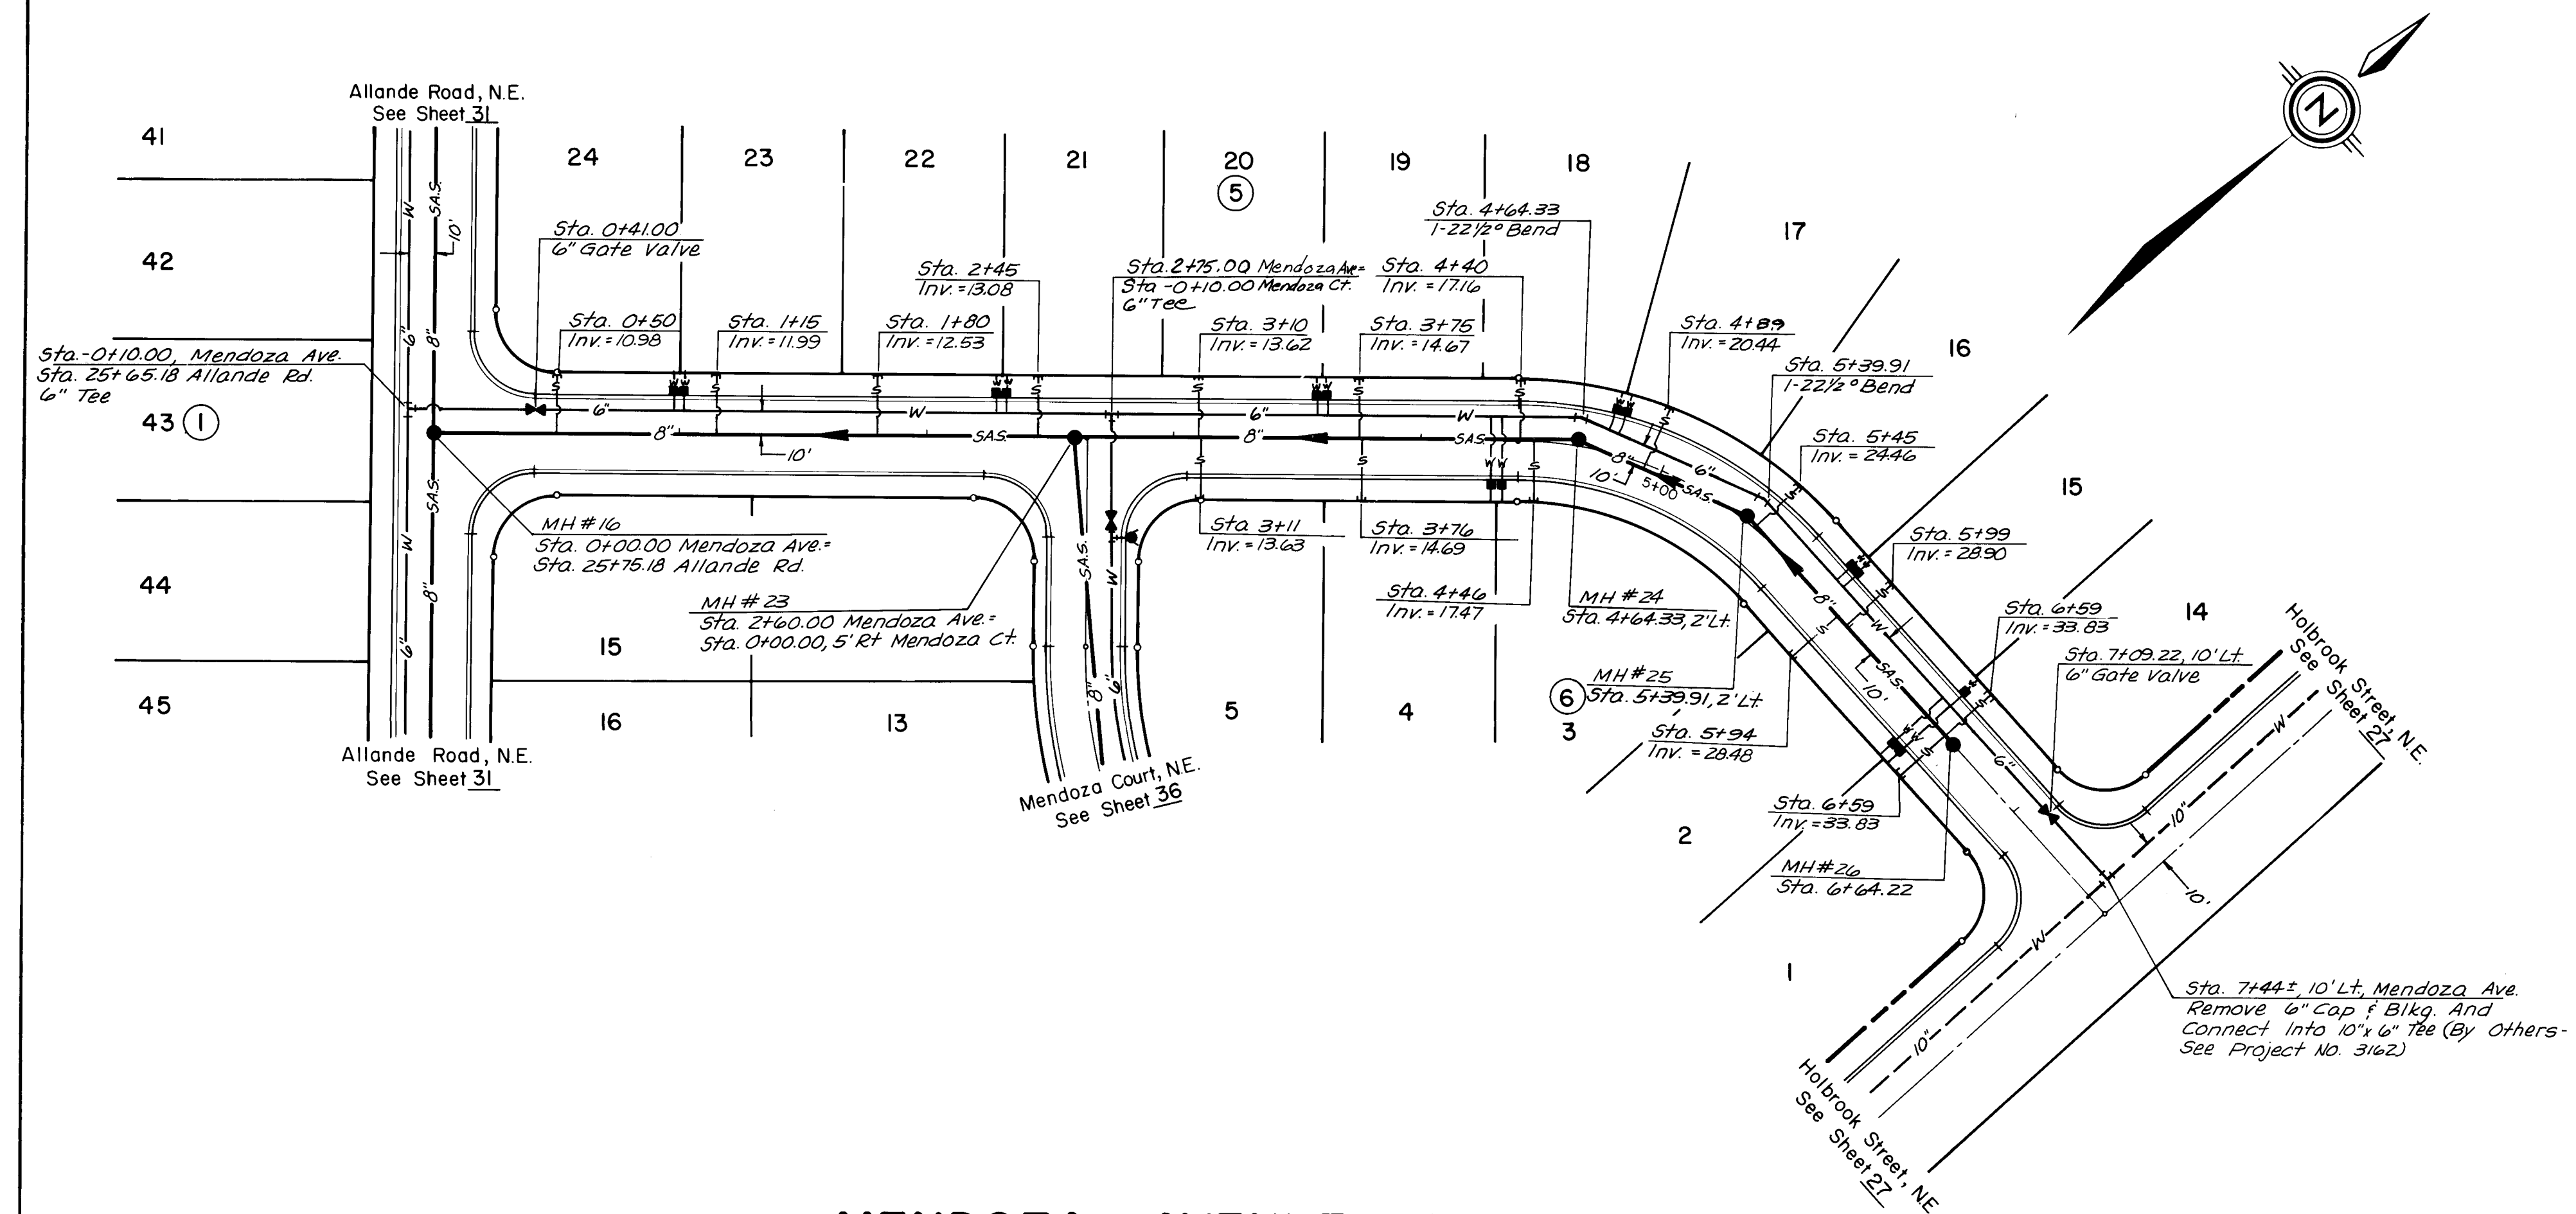

MENDOZA AVENUE, N.E.

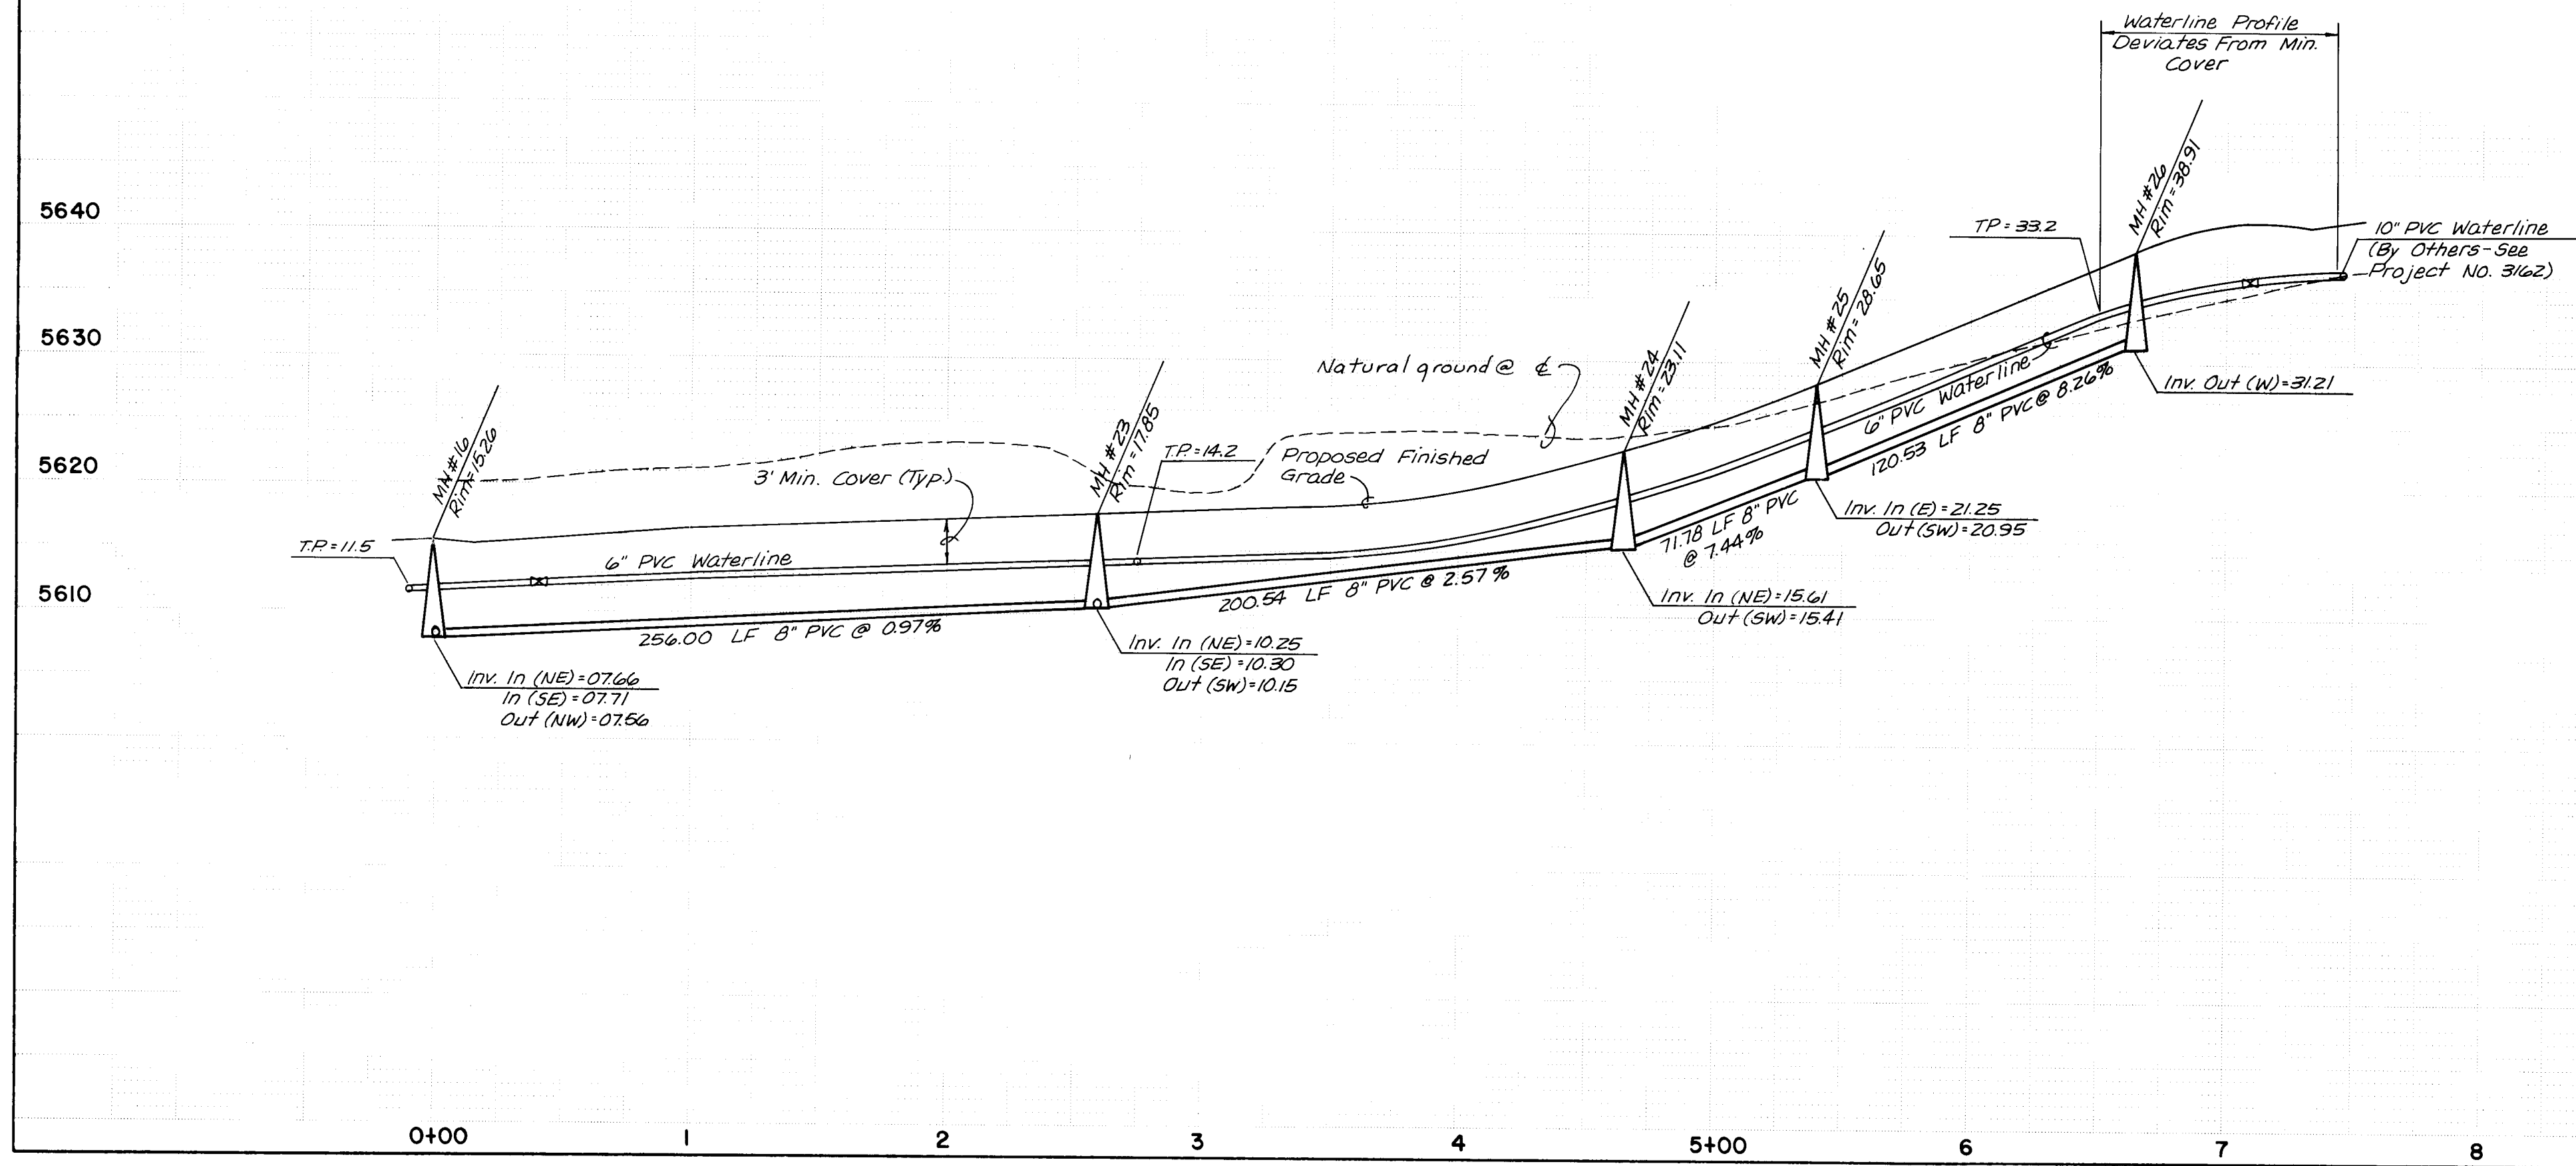

26 31 40 35 87

AS BUILT INFORMATION		BENCH MARKS		SURVEY INFORMATION		ENGINEER'S SEAL		REVISIONS		DESIGN		CITY OF ALBUQUERQUE MUNICIPAL DEVELOPMENT DEPARTMENT ENGINEERING DIVISION		TITLE: HERITAGE EAST - UNIT SIX MENDOZA AVENUE, N.E.		APPROVALS		ENGINEER		DATE	
CONTRACTOR: WYLYE CORP.		A.C.S. BRASS TABLET "1-C21A" SET IN THE TOP OF CONCRETE POST FLUSH WITH GROUND AND LOCATED AT THE NORTHEAST CORNER OF THE INTERSECTION OF PASO DEL NORTE (LOS ANGELES DRIVE, N.E.) AND HOLBROOK STREET, N.E. ELEVATION = 5634.65'		FIELD NOTES		ENGINEER'S SEAL		REVISIONS		DESIGN		CITY OF ALBUQUERQUE MUNICIPAL DEVELOPMENT DEPARTMENT ENGINEERING DIVISION		TITLE: HERITAGE EAST - UNIT SIX MENDOZA AVENUE, N.E.		APPROVALS		ENGINEER		DATE	
WORK: GUTTER REPAIR		DATE: 6-87		DATE: 6-87		DATE: 6-87		DATE: 6-87		DATE: 6-87		DATE: 6-87		DATE: 6-87		DATE: 6-87		DATE: 6-87		DATE: 6-87	
FIELD ACCURACY BY: D. HARRIS		DATE: 6-87		DATE: 6-87		DATE: 6-87		DATE: 6-87		DATE: 6-87		DATE: 6-87		DATE: 6-87		DATE: 6-87		DATE: 6-87		DATE: 6-87	
DRAWING BY: C.S.C.		DATE: 9-87		DATE: 9-87		DATE: 9-87		DATE: 9-87		DATE: 9-87		DATE: 9-87		DATE: 9-87		DATE: 9-87		DATE: 9-87		DATE: 9-87	
RECORDED BY: C.S.C.		DATE: 9-87		DATE: 9-87		DATE: 9-87		DATE: 9-87		DATE: 9-87		DATE: 9-87		DATE: 9-87		DATE: 9-87		DATE: 9-87		DATE: 9-87	
NO.		NO.		NO.		NO.		NO.		NO.		NO.		NO.		NO.		NO.		NO.	

RECORD DRAWING AS BUILT
SCALE
1"=50'HORIZ.
1"=10'VERT.

CITY OF ALBUQUERQUE MUNICIPAL DEVELOPMENT DEPARTMENT ENGINEERING DIVISION		TITLE: HERITAGE EAST - UNIT SIX MENDOZA AVENUE, N.E.		APPROVALS		ENGINEER		DATE	
DESIGNED BY: R.L. M.K.S.		DATE: 3-87		DATE: 3-87		DATE: 3-87		DATE: 3-87	
DRAWN BY: C.S.C.		DATE: 3-87		DATE: 3-87		DATE: 3-87		DATE: 3-87	
CHECKED BY: M.K.S.		DATE: 4-87		DATE: 4-87		DATE: 4-87		DATE: 4-87	
DRAWING NO. 3140		MAP NO. D-20		SHEET 35		OF 39			




BUREAU DEPARTMENT OF AERONAUTICS WASHINGTON, D. C.		
ROSAS COURT, N.E.		
APPROVALS	ENGINEER	DATE
Utilities	<i>NADW</i> <i>[Signature]</i>	<i>1/2 = 1/2</i> <i>4-22-67</i>
30	SHEET 36 OF 39	

SCALE	community surface corporation
1"=50'HORIZ.	
1"=10'VERT.	

CITY OF ALBUQUERQUE MUNICIPAL DEVELOPMENT DEPARTMENT ENGINEERING DIVISION
TITLE: HERITAGE EAST - UNIT SIX MENDOZA COURT, N.E. & ROSAS COURT, N.E.

APPROVALS	ENGINEER	DATE	APPROVALS	ENGINEER	DATE
City Engineer	<i>[Signature]</i>	4-24-07			
A C E - Design	<i>[Signature]</i>	4-22-07	Traffic	NADWH	4-22-07
A C E -Hydrology	NA		Water Utilities	<i>[Signature]</i>	4-22-07

DRAWING NO. 3140		MAP NO. D-20	SHEET 36 OF 39
------------------	--	--------------	----------------

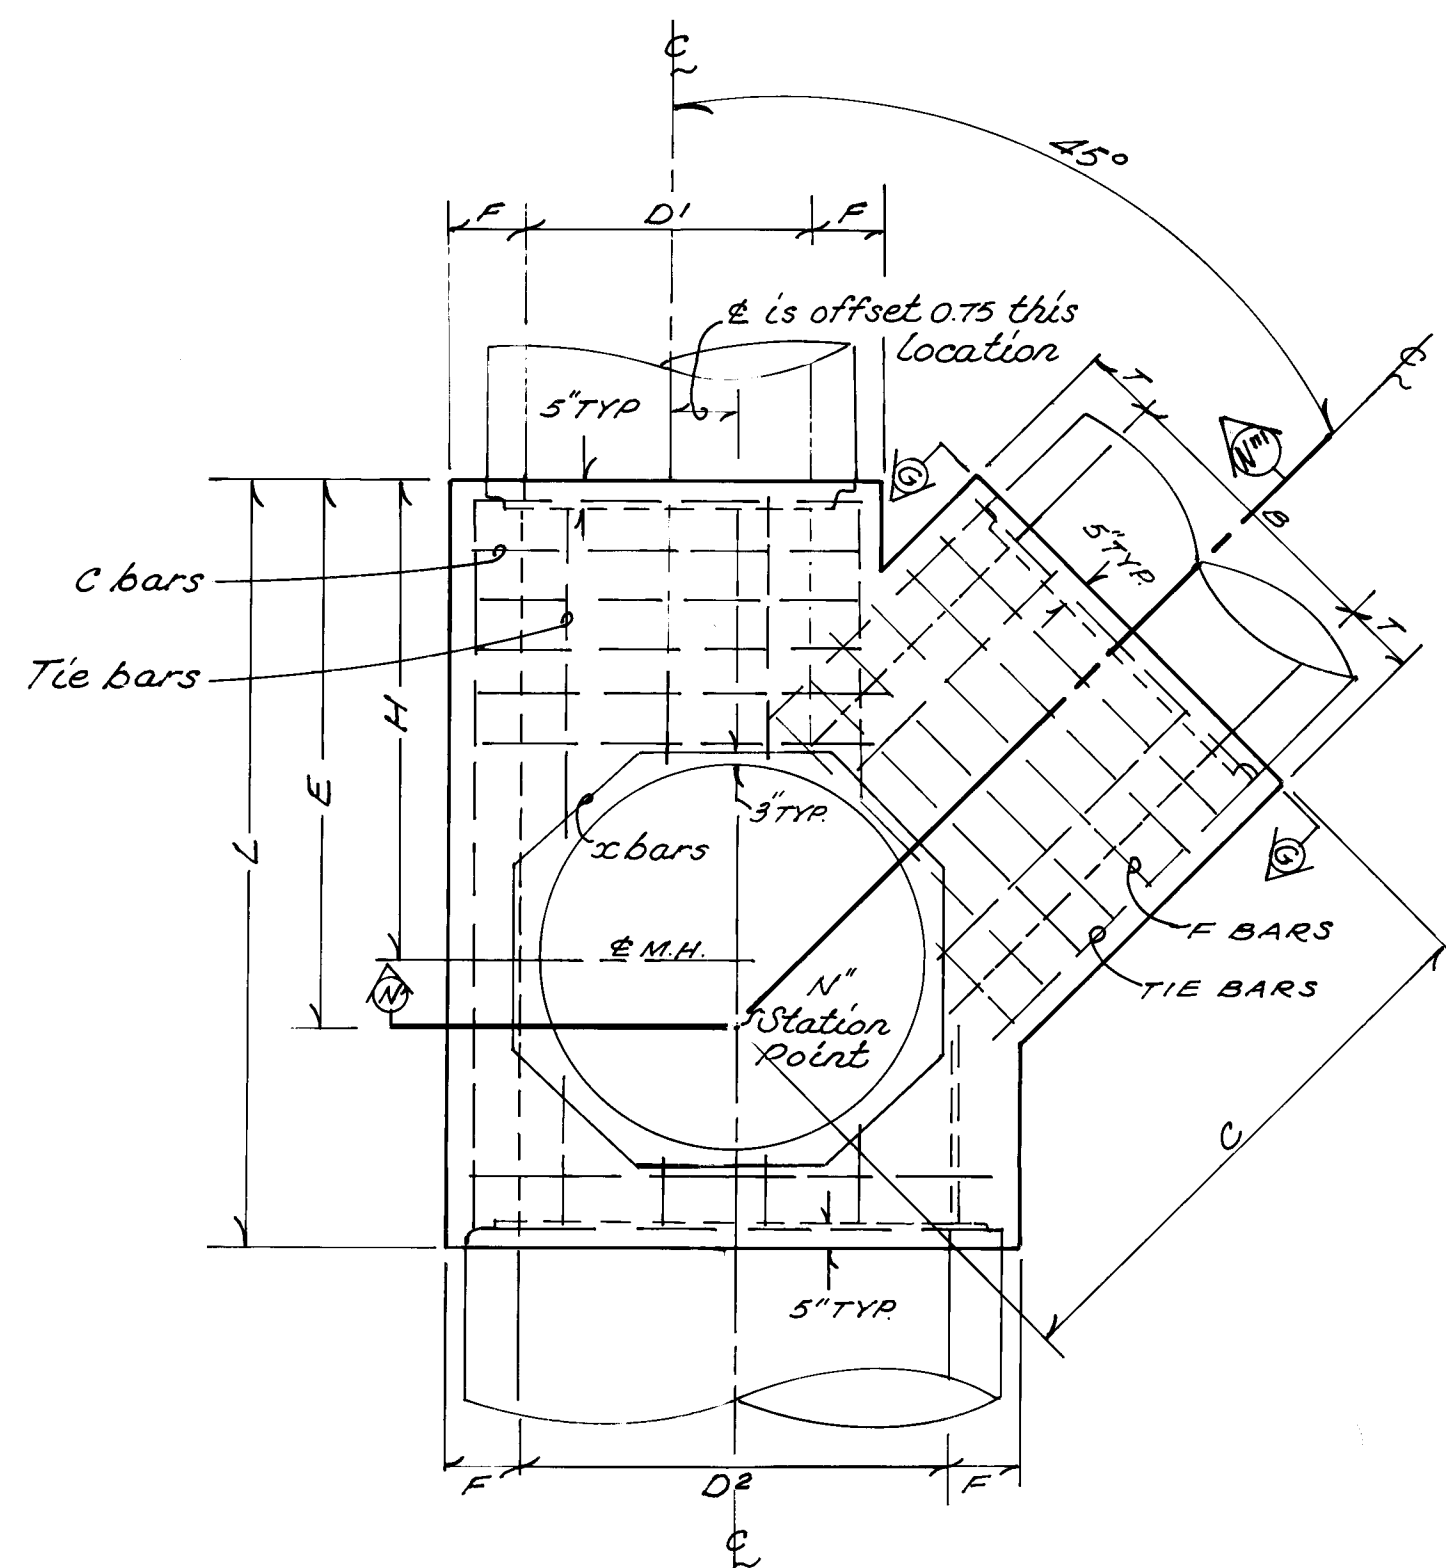


JUNCTION BOX SCHEDULE

D1	36"
D2	54"
B	36"
C	5'9"
L	8'0"
E	5'8"
H	5'0"
F	9"
T	9"
ELE. R	70.25
ELE. S	70.08
ELE. Q	70.08
ELE. U	68.58
TIE BARS	#4 @ 12" O.C.
C BARS	#6 @ 6" O.C.
X BARS	#4 BENT TO OCTAGON
F BARS	#6 @ 6" C.C.

PLAN
N.T.S.


Construct Standard
TYPE "C" M.H. (per city
standards)

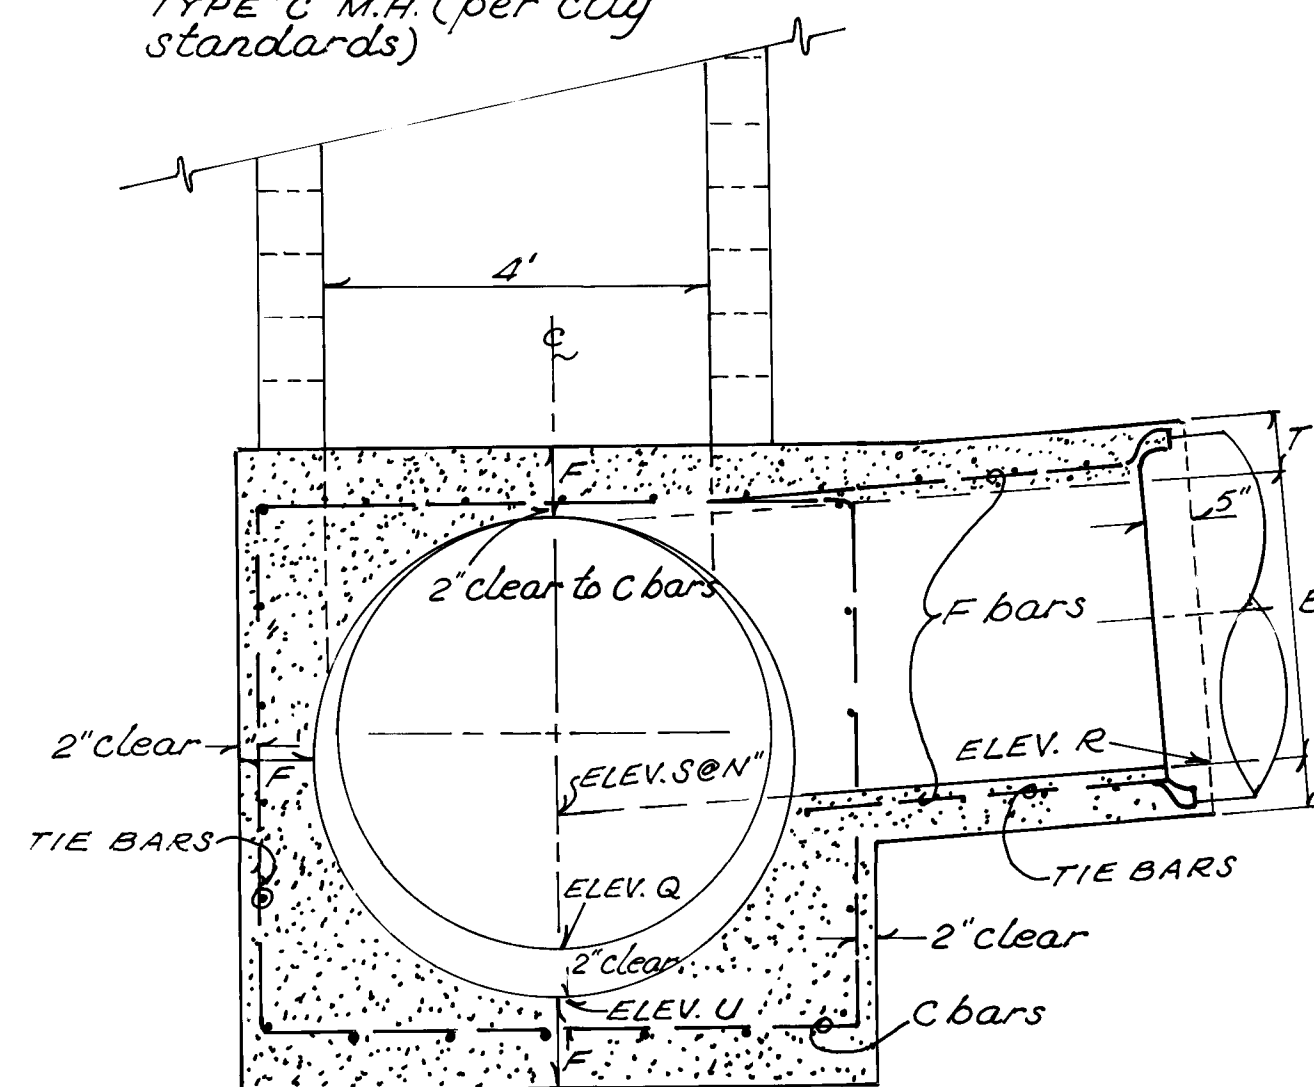


SECTION-N'N'
N.T.S.

JUNCTION BOX DETAILS

- All concrete shall have a 28 day compressive strength of 3000 psi min. with 3/4" coarse aggregate and 6% air entrainment.
- Inside junction box walls shall be steel trowel finished.
- All reinforcement shall be 40 ksi deformed bars.
- Junction structure shall be poured in one continuous operation except that the contractor shall have the option of placing a construction joint with a longitudinal keyway at the springline.
- Length "L" may be increased at option of contractor to meet pipe ends.

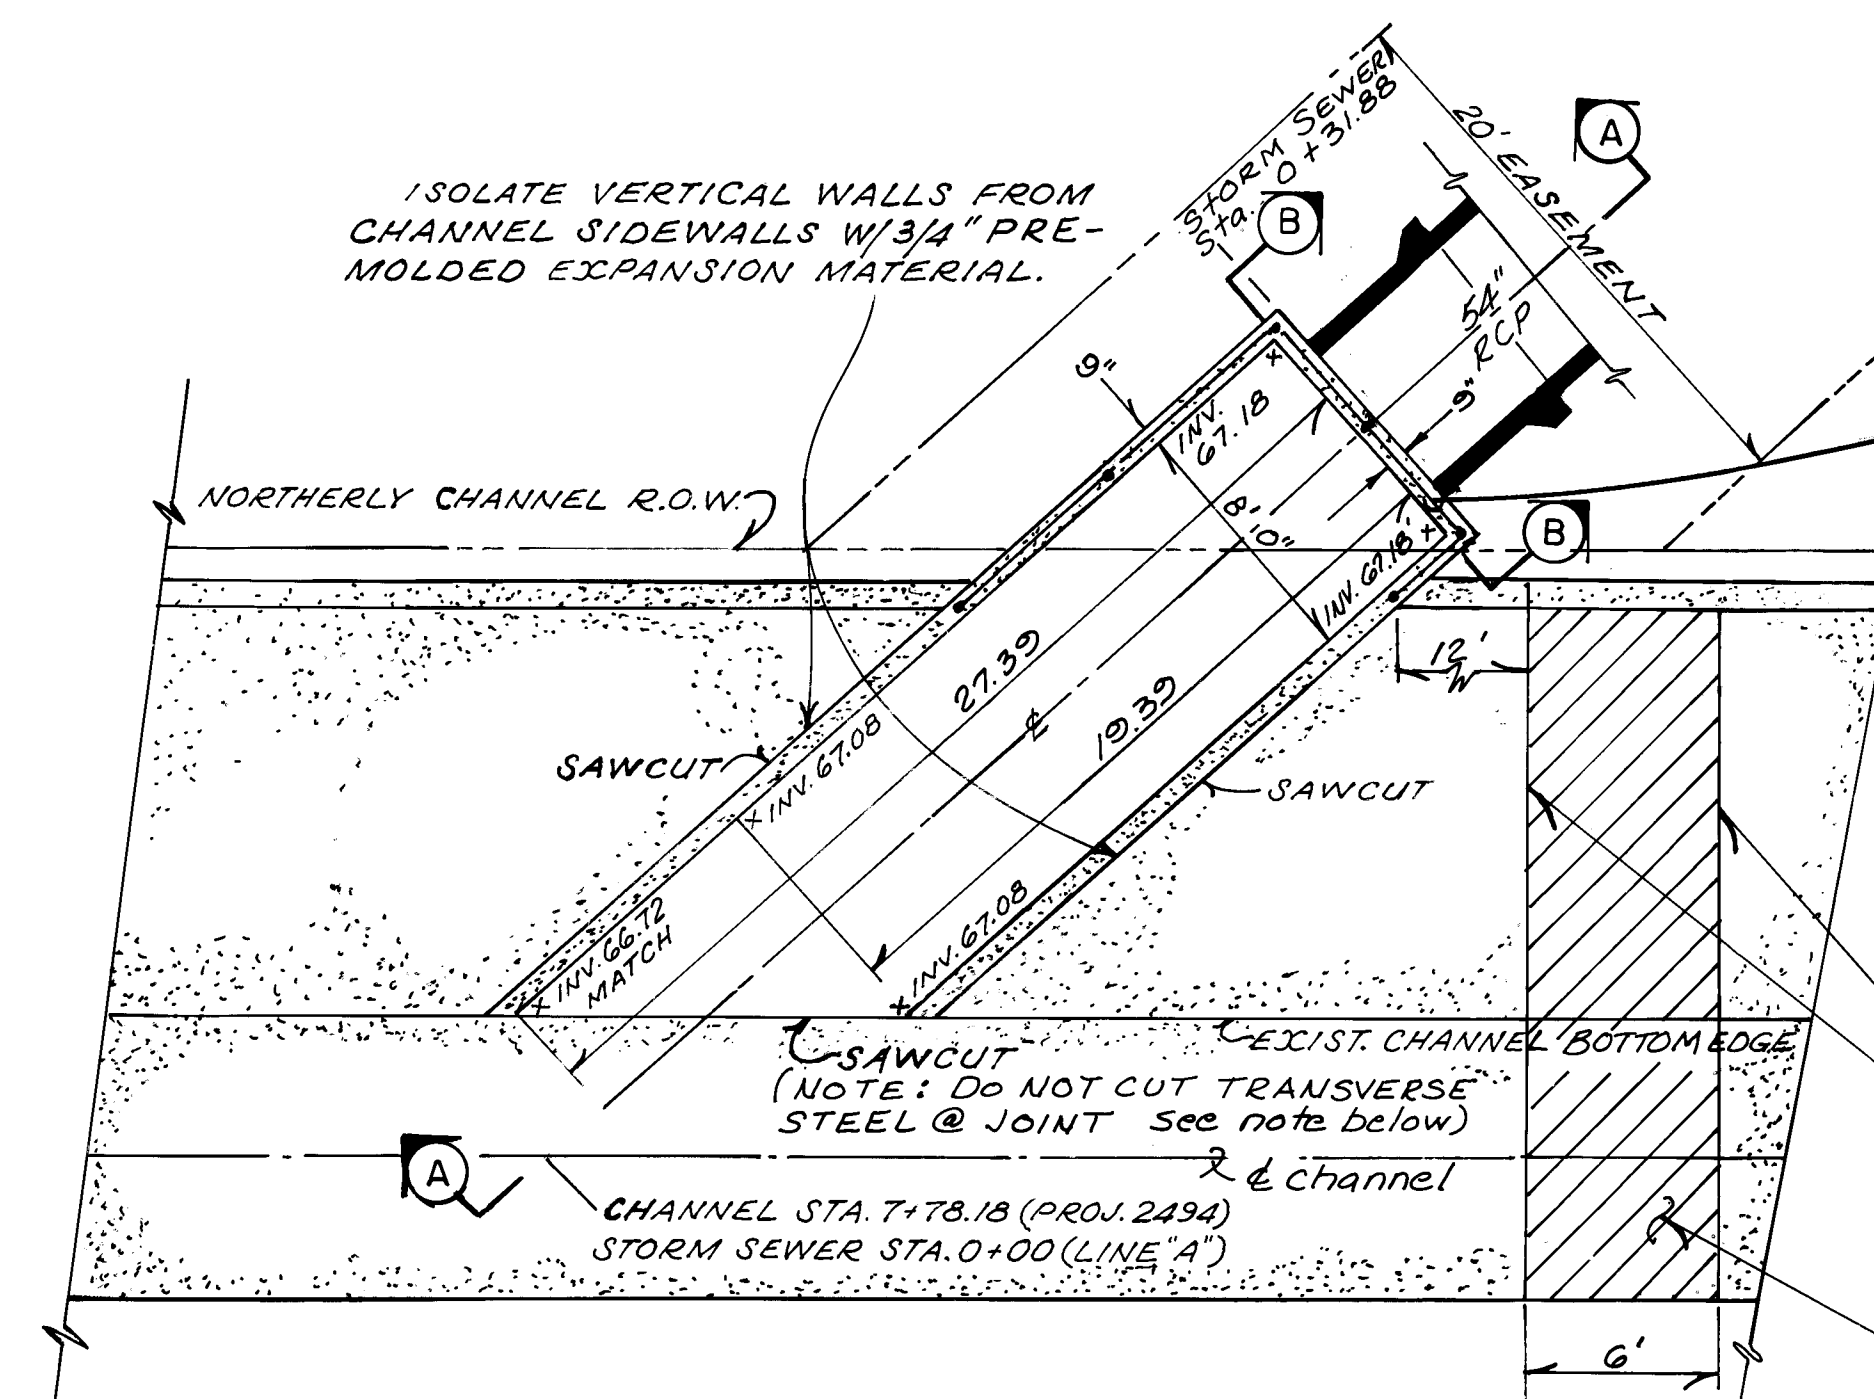


PLAN
N.T.S.

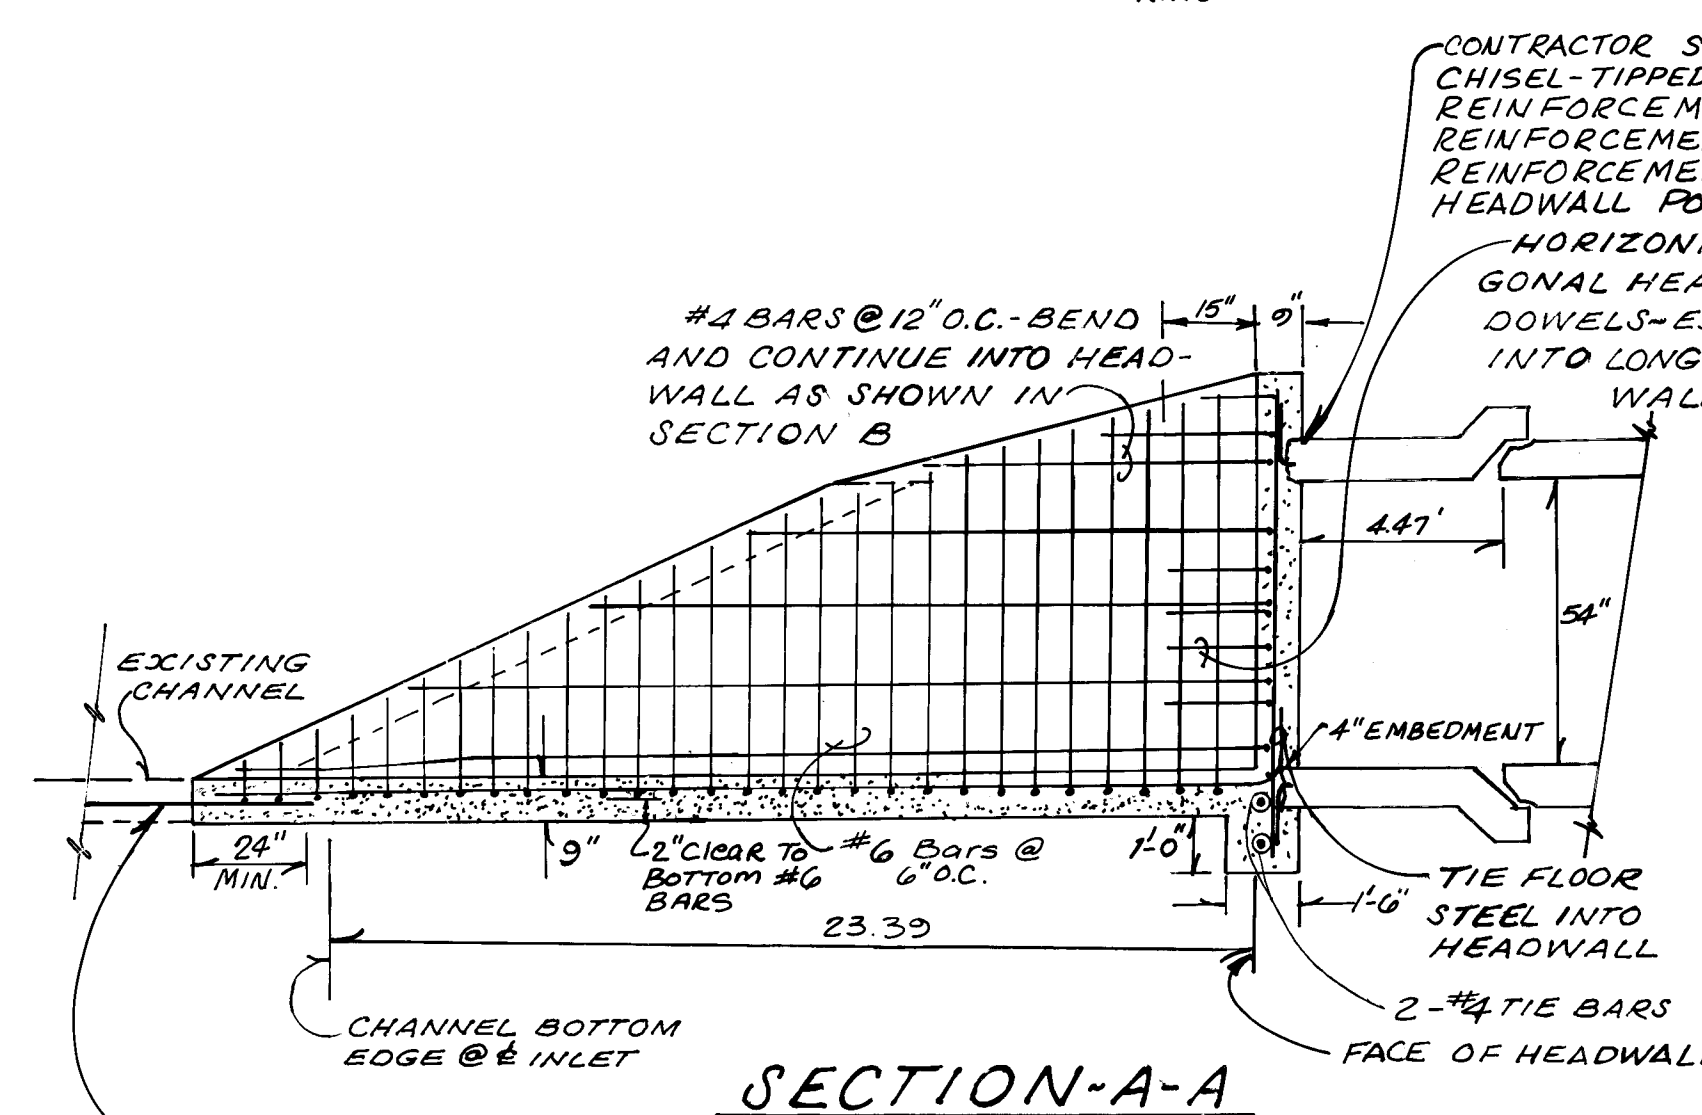

SECTION-A-A
N.T.S.


CONTRACTOR SHALL SAWCUT
ALONG EXISTING CHANNEL BOTTOM
EDGE TO A DEPTH OF 2" THEN JACK
HAMMER SIDEWALL CONCRETE TO
EXPOSE 24" OF TRANSVERSE STEEL.
INLET SHALL THEN BE TIED TO CHANNEL
BOTTOM BY CASTING EXPOSED TRANSVERSE
STEEL INTO POUR FOR INLET FLOOR.

PIPE INLET DETAILS N.T.S.

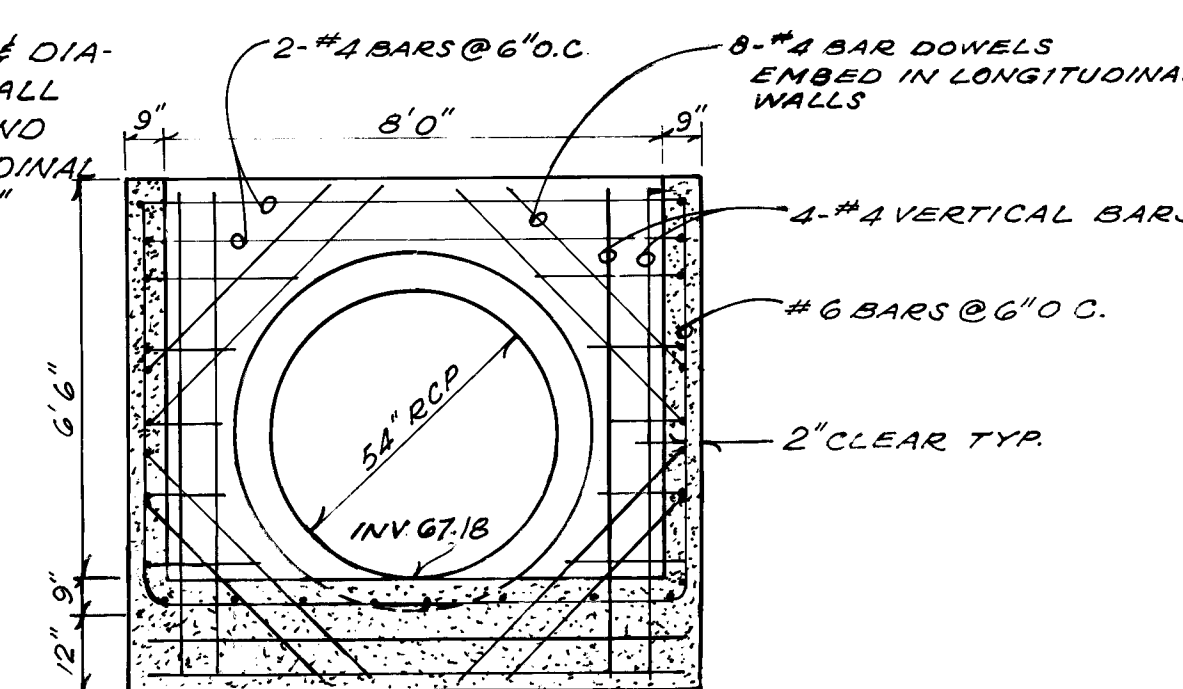

SECTION-B-B
N.T.S.

STORM DRAIN CHANNEL INLET DETAILS

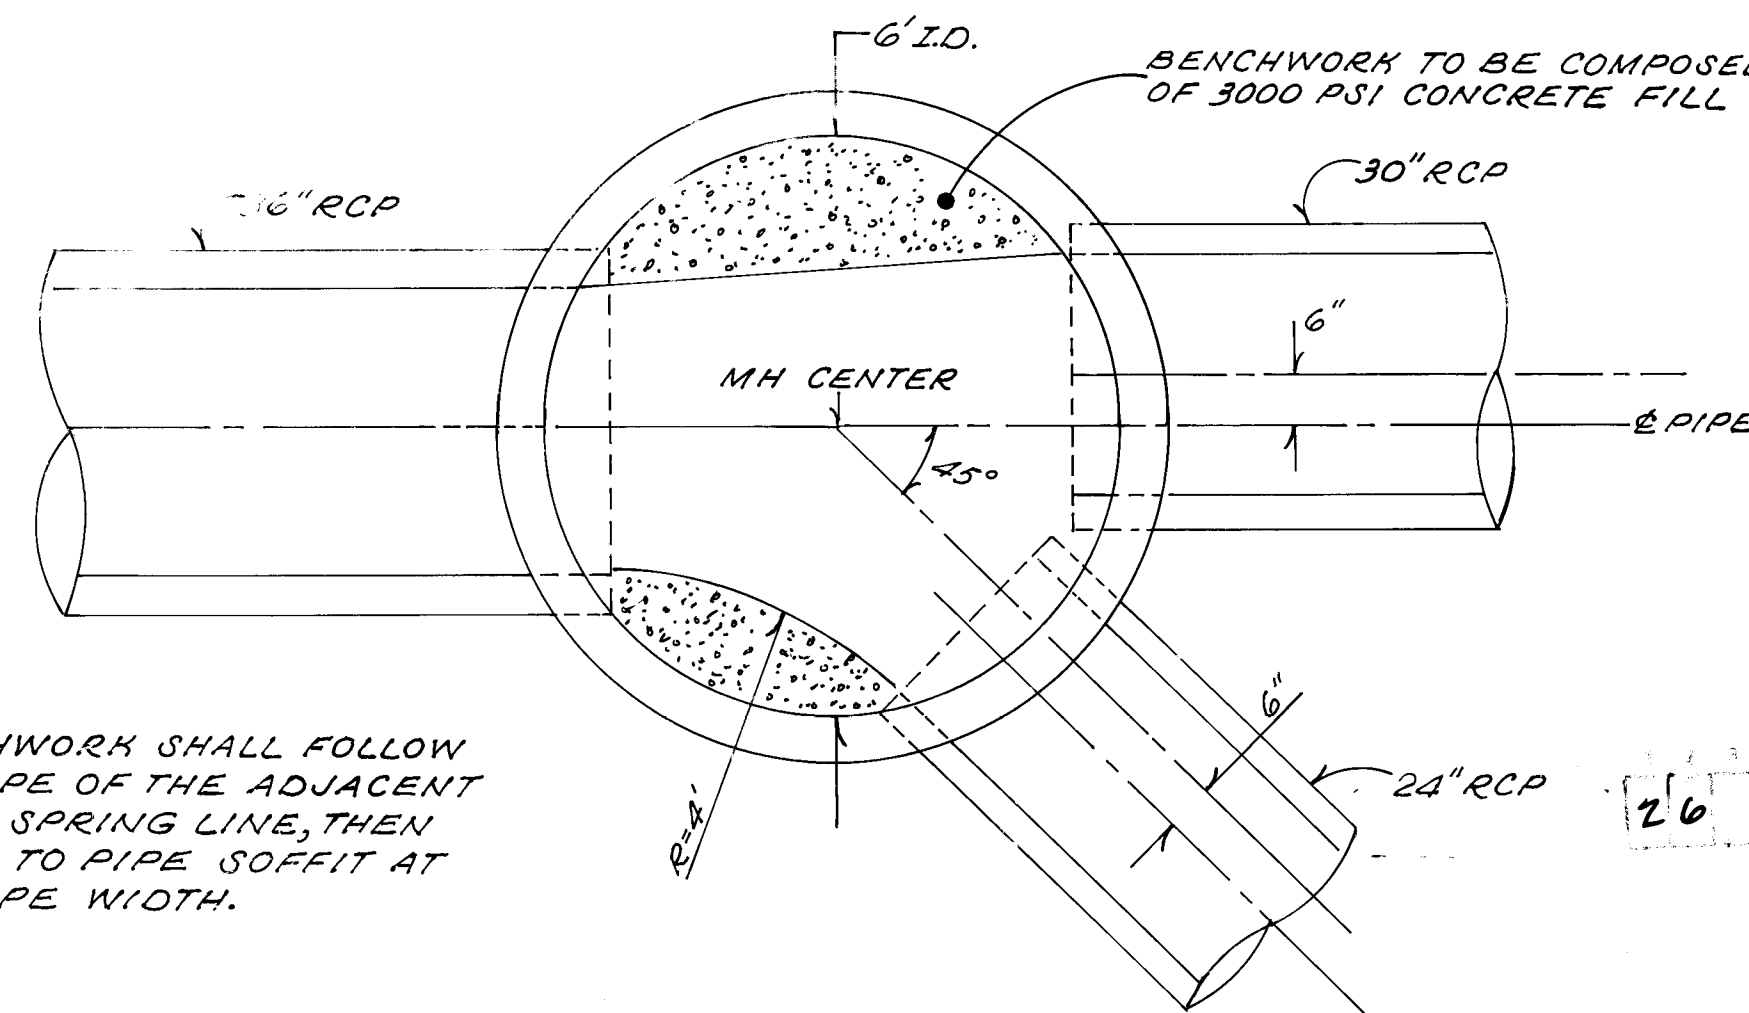

NOTE: BENCHWORK SHALL FOLLOW
THE SHAPE OF THE ADJACENT
PIPE TO SPRING LINE, THEN
EXTEND TO PIPE SOFFIT AT
FULL PIPE WIDTH.

BENCH WORK DETAIL ~ STORM MH @ STA. 2+38.74 LINE "B"
1" = 2'

RECORD DRAWING AS BUILT

SCALE:
AS NOTED

CITY OF ALBUQUERQUE
MUNICIPAL DEVELOPMENT DEPARTMENT
ENGINEERING DIVISION

TITLE: HERITAGE EAST-UNIT SIX

STORM SEWER DETAILS

APPROVALS	ENGINEER	DATE	APPROVALS	ENGINEER	DATE
City Engineer	Amith	6/29/07	Liquid Waste	Amith	4-22-07
A.C.E. - Design	"	"	Traffic	Amith	4-22-07
A.C.E. - Hydrology	Cam	4-12-07	Water	Amith	4-22-07

DRAWING NO.	MAP NO.	SHEET OF
3140	D-20	38 39

AS BUILT INFORMATION		BENCH MARKS		SURVEY INFORMATION		ENGINEER'S SEAL		REVISIONS	
CONTRACTOR	WYLE CORP.	SET IN THE	DATE	NO.	BY			DESIGN	DATE
WORK ORDER	GUTIERREZ	TOP OF CONCRETE POST FLUSH WITH GROUND AND	DATE	NO.	BY			REVISIONS	DATE
DATE	6-87	LOCATED AT THE NORTHEAST CORNER OF THE	DATE	NO.	BY			DESIGNED	DATE
DATE	6-87	INTERSECTION OF PASO DEL NORTE (LOS	DATE	NO.	BY			DRAWN BY	DATE
MICRO-FILM INFORMATION		FIELD ACCEPTANCE BY		DATE		CHECKED BY		DATE	
DATE		DATE		DATE		DATE		DATE	
DATE		DATE		DATE		DATE		DATE	

