




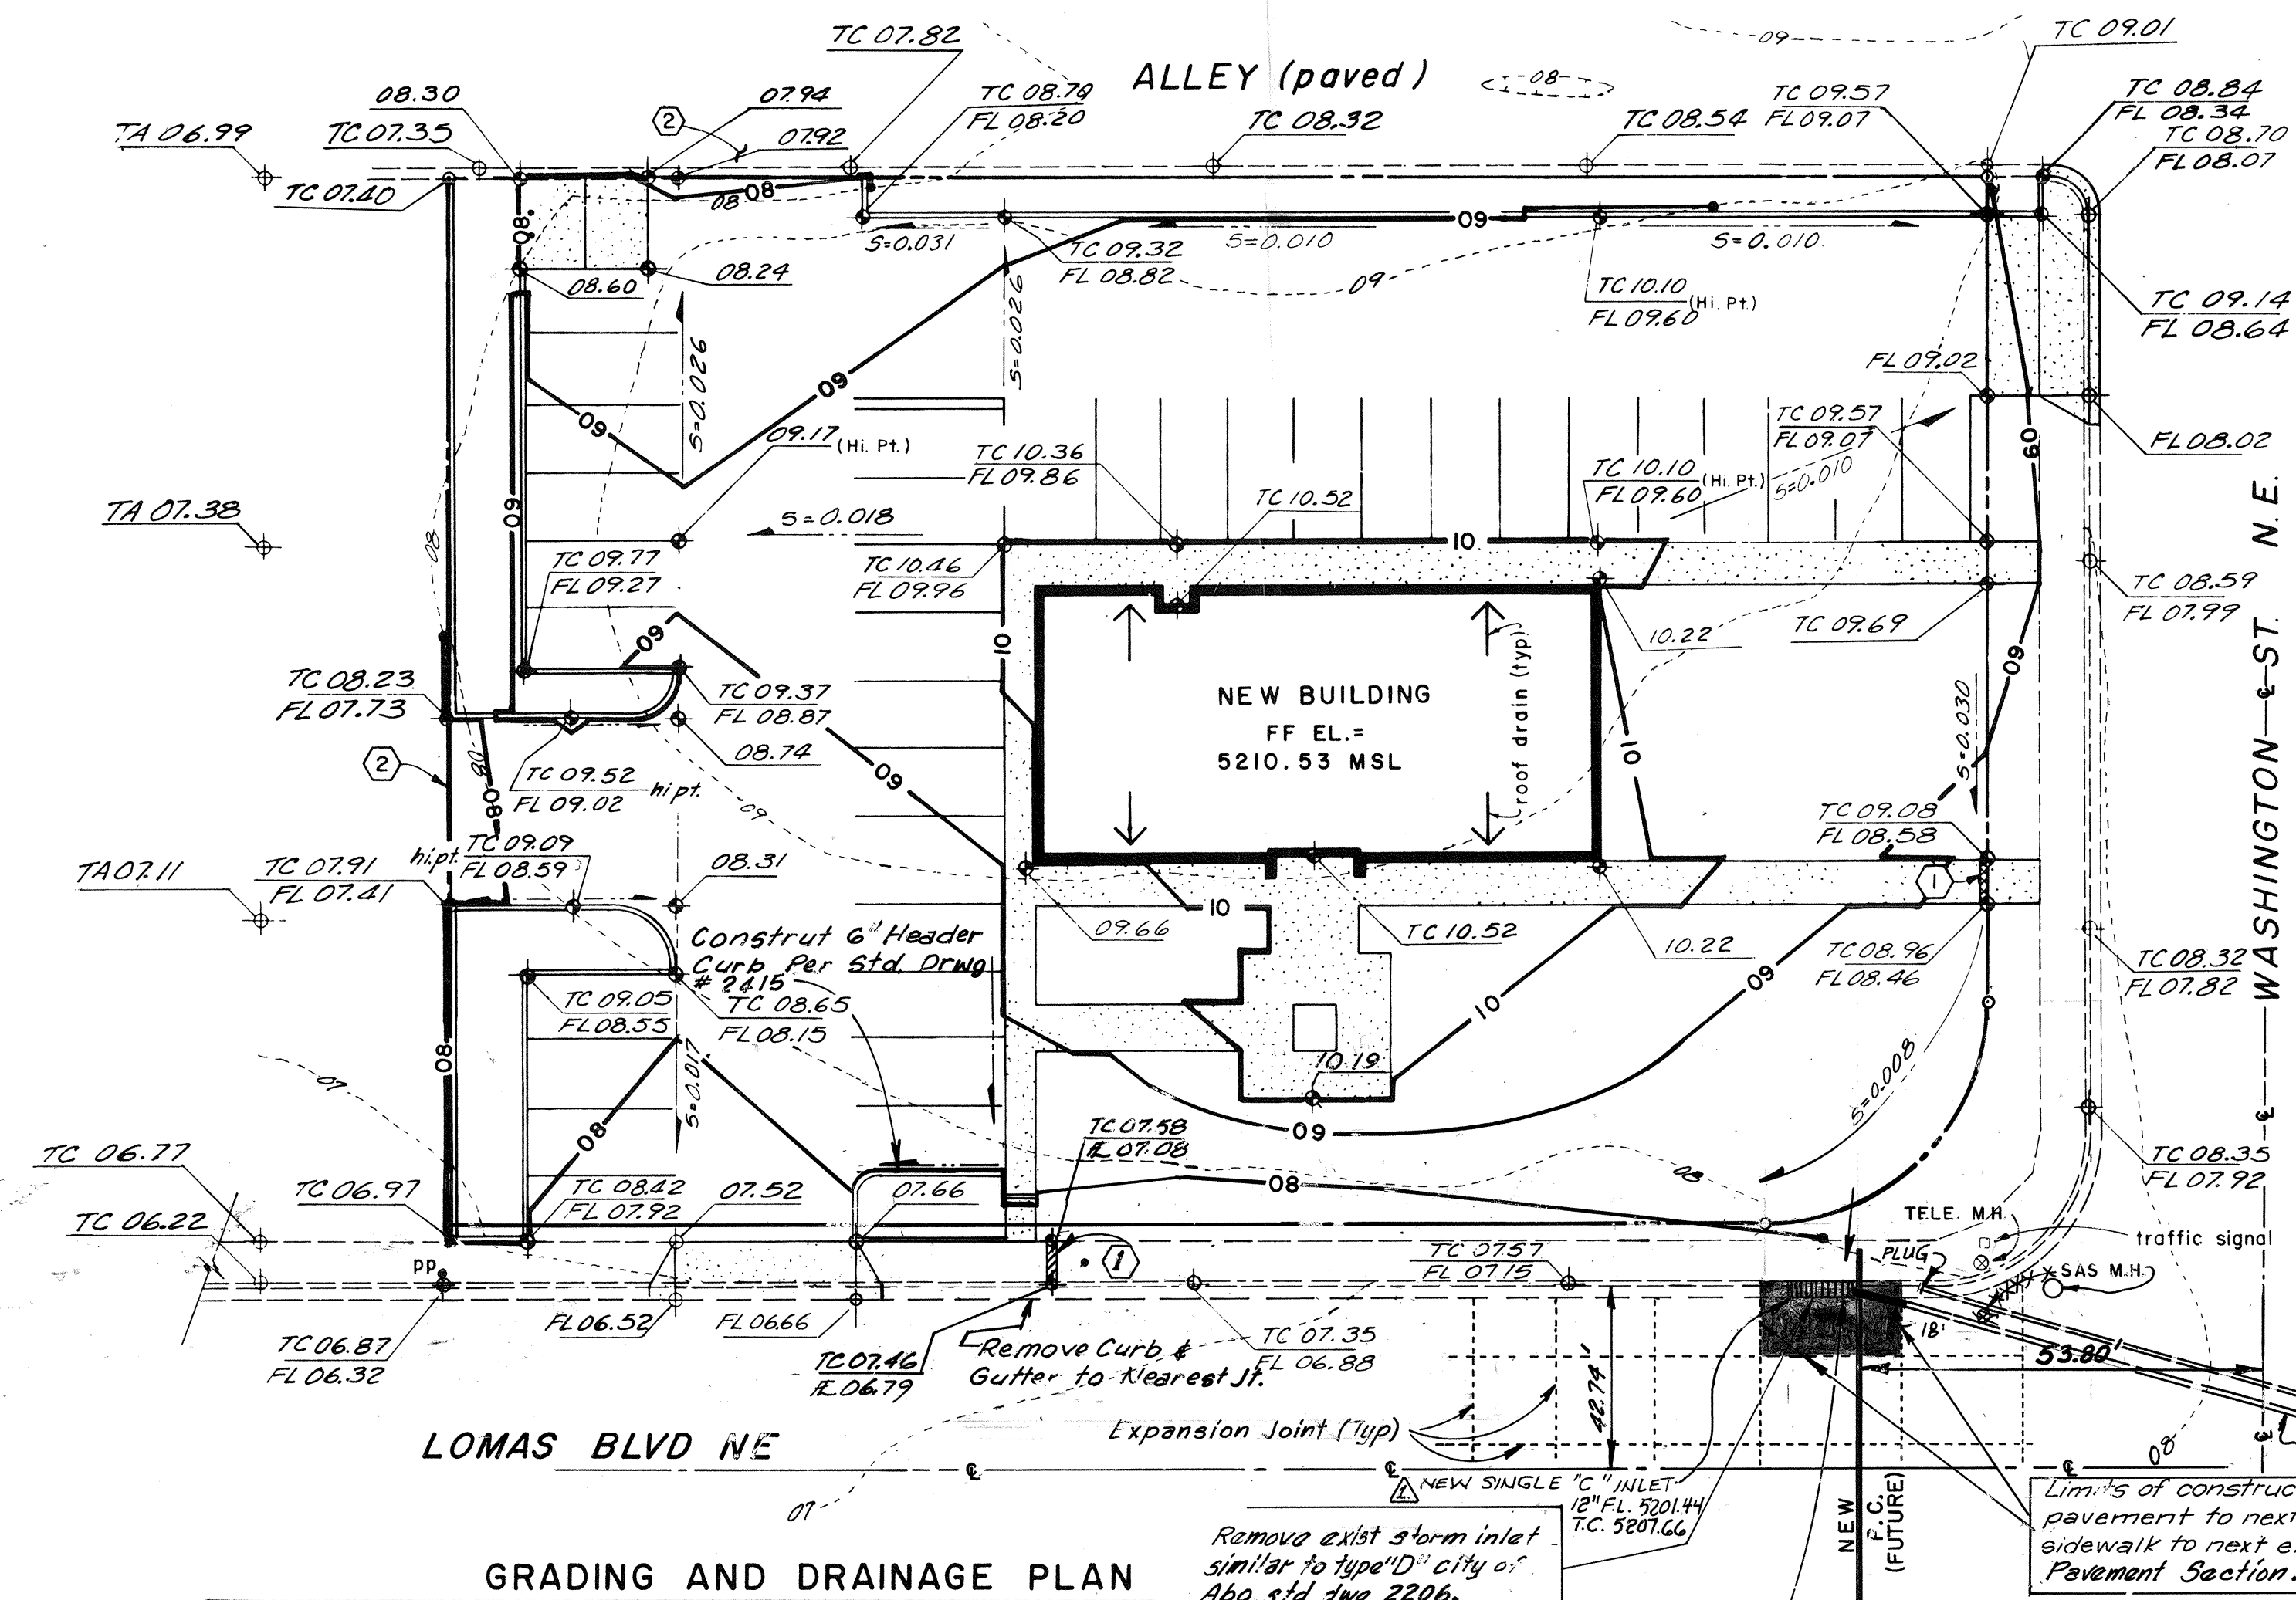


- LEGEND**
- PROPERTY LINE
 - CONTOUR (NEW)
 - CONTOUR (EXISTING)
 - SPOT ELEVATION (NEW)
 - SPOT ELEVATION (EXISTING)
 - EXPANSION JOINT (NEW)

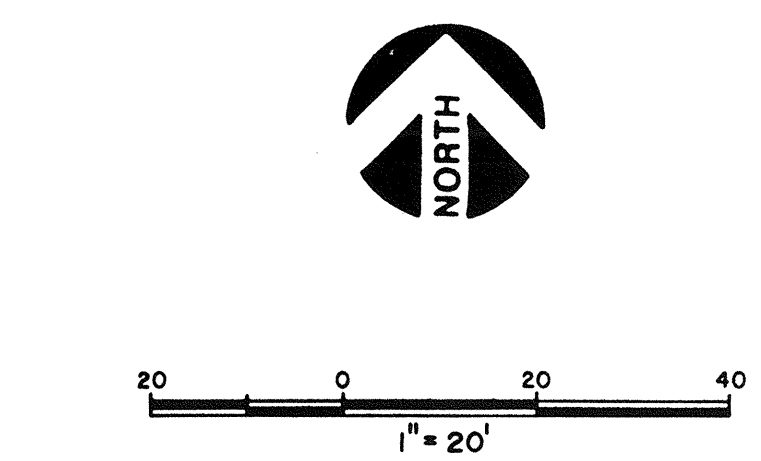

- CONSTRUCTION NOTES:**
- A. STANDARD CURB AND GUTTER.
 - B. STRAIGHT GRADE.
 - C. EXPANSION JOINT.
 - F. FOR FRAME & GRATE SEE DWG 2216, 2220 & 2221.
 - G. DIRECTION OF FLOW.
 - H. POINT OF MEASUREMENT FOR TOP OF GRATE ELEVATION.
 - J. PROVIDE 5 FEET TRANSITION EACH SIDE OF CATCH BASIN, WHEN INSTALLING AT SAG POINT IN INSTALLATIONS OTHER THAN AT CURB RETURN.

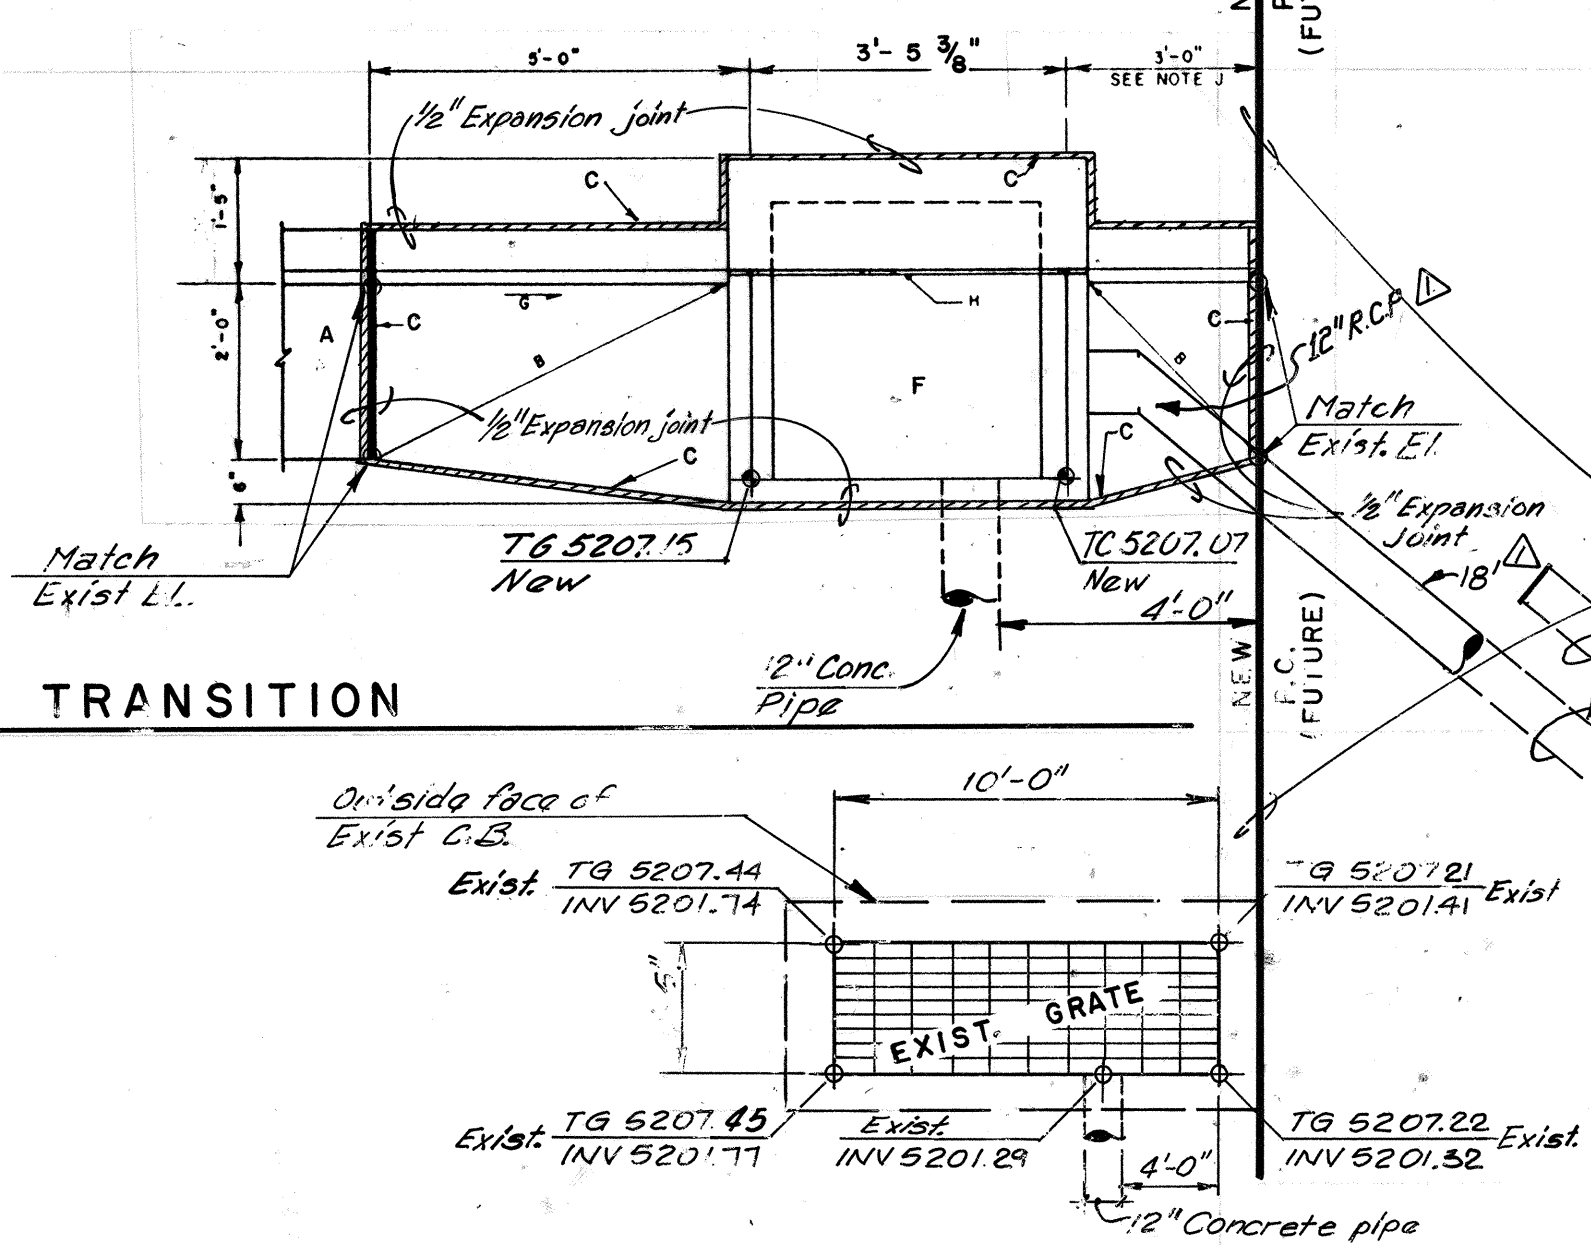

- Construction of Storm Drainage Improvement to consist of the following:**
1. Drainage storm inlet gutter transition, see city of Abq. std. dwg. 2207.
 2. Drainage storm inlet similar to single 'c' see city std. dwg. 2205.
 3. Frame & grate, see city std. dwg. 2216 & 2220.

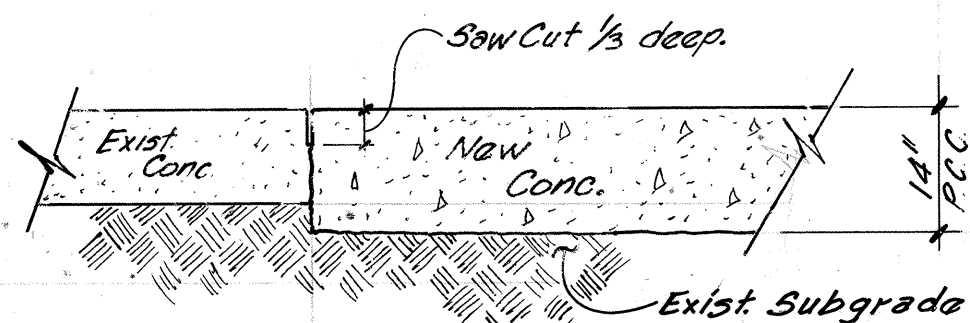

AS BUILT INFORMATION		BENCH MARKS		SURVEY INFORMATION		ENGINEER'S SEAL	
CONTRACTOR	MONTEVA CONSTRUCTION	DATE	12/15/87	NO.	1		REVISIONS
WORK BY	MONTEVA CONSTRUCTION	DATE	12/15/87	NO.	1		
INSPECTOR	MONTEVA CONSTRUCTION	DATE	12/15/87	NO.	1		
ACCEPTANCE BY	MONTEVA CONSTRUCTION	DATE	12/15/87	NO.	1		
DRAWINGS		DRAWN BY		DESIGNED BY		CHECKED BY	
DRAWING NO.		3152		MAP NO.		J-17-Z	
SHEET		1		OF		1	

LEGAL DESCRIPTION:
LOTS 30 THRU 37 OF JOSEPH L. DAILEY'S SUBDIVISION OF BLOCK 17-LA HACIENDA, ALBUQUERQUE, NEW MEXICO.

NOTICE TO CONTRACTOR

1. ALL WORK DETAILED ON THESE PLANS TO BE PERFORMED, EXCEPT AS OTHERWISE STATED OR PROVIDED HEREON, SHALL BE CONSTRUCTED IN ACCORDANCE WITH THE CITY OF ALBUQUERQUE INTERIM STANDARD SPECIFICATIONS FOR PUBLIC WORKS CONSTRUCTION, 1985.
2. TWO WORKING DAYS PRIOR TO ANY EXCAVATION, CONTRACTOR MUST CONTACT LINE LOCATING SERVICE, 765-1234, FOR LOCATION OF EXISTING UTILITIES.
3. PRIOR TO CONSTRUCTION, THE CONTRACTOR SHALL EXCAVATE AND VERIFY THE HORIZONTAL AND VERTICAL LOCATIONS OF ALL CONSTRUCTIONS. SHOULD A CONFLICT EXIST, THE CONTRACTOR SHALL NOTIFY THE ENGINEER SO THAT THE CONFLICT CAN BE RESOLVED WITH A MINIMUM AMOUNT OF DELAY.
4. BACKFILL COMPACTION SHALL BE ACCORDING TO ARTERIAL STREET USE.
5. ALL UTILITIES AND UTILITY SERVICE LINES SHALL BE INSTALLED PRIOR TO PAVING.
6. BACKFILL COMPACTION SHALL BE ACCORDING TO SPECIFIED STREET USE.
7. TACK COAT REQUIREMENTS SHALL BE DETERMINED BY THE CITY ENGINEER.
8. ALL STORM DRAINAGE FACILITIES SHALL BE COMPLETED PRIOR TO FINAL ACCEPTANCE.
9. CONTRACTOR IS RESPONSIBLE FOR EROSION CONTROL DURING THE CONSTRUCTION PHASE, INCLUDING ANY PROVISIONS THAT NEED TO BE TAKEN TO DIVERT ANY SEDIMENT FROM ENTERING THE CITY RIGHT-OF-WAY, I.E., WINDROWS, SILT FENCING, OR APPROVED EQUAL.
10. CURB AND GUTTER SHOWN AS EXISTING AND NOT TO BE REMOVED UNDER THE CONTRACT WHICH IS DAMAGED OR DISPLACED BY THE CONTRACTOR SHALL BE REMOVED AND REPLACED BY THE CONTRACTOR AT HIS EXPENSE.
11. WHEN CONSTRUCTION UNDER THIS PROJECT CONNECTS TO EXISTING IMPROVEMENTS, THE CONTRACTOR SHALL PROVIDE AN EASY RIDING CONNECTION.

TRAFFIC HANDLING NOTES:

1. CONTRACTOR MUST SUBMIT A CONSTRUCTION SIGNING AND BARRICADING PLAN TO TRAFFIC ENGINEERING DIVISION AND RECEIVE A BARRICADING PERMIT PRIOR TO CONSTRUCTION.
2. ALL CONSTRUCTION SIGNING AND BARRICADING TO COMPLY WITH MANUAL ON UNIFORM TRAFFIC CONTROL DEVICES, 1978 EDITION.

CITY OF ALBUQUERQUE MUNICIPAL DEVELOPMENT DEPARTMENT ENGINEERING DIVISION					
TITLE: 4407 LOMAS BLVD. NE JOSEPH L. DAILEY'S SUBDIVISION REMOVE & CONSTRUCT STORM INLET					
APPROVALS	ENGINEER	DATE	APPROVALS	ENGINEER	DATE
City Engineer	John S.	5/22/87	Liquid Waste	NA DWH	5/22/87
A.C.E. Design	" "	" "	Traffic	NA DWH	5/22/87
A.C.E. Hydrology	CHM	5-11-87	Water	NA DWH	5-22-87