

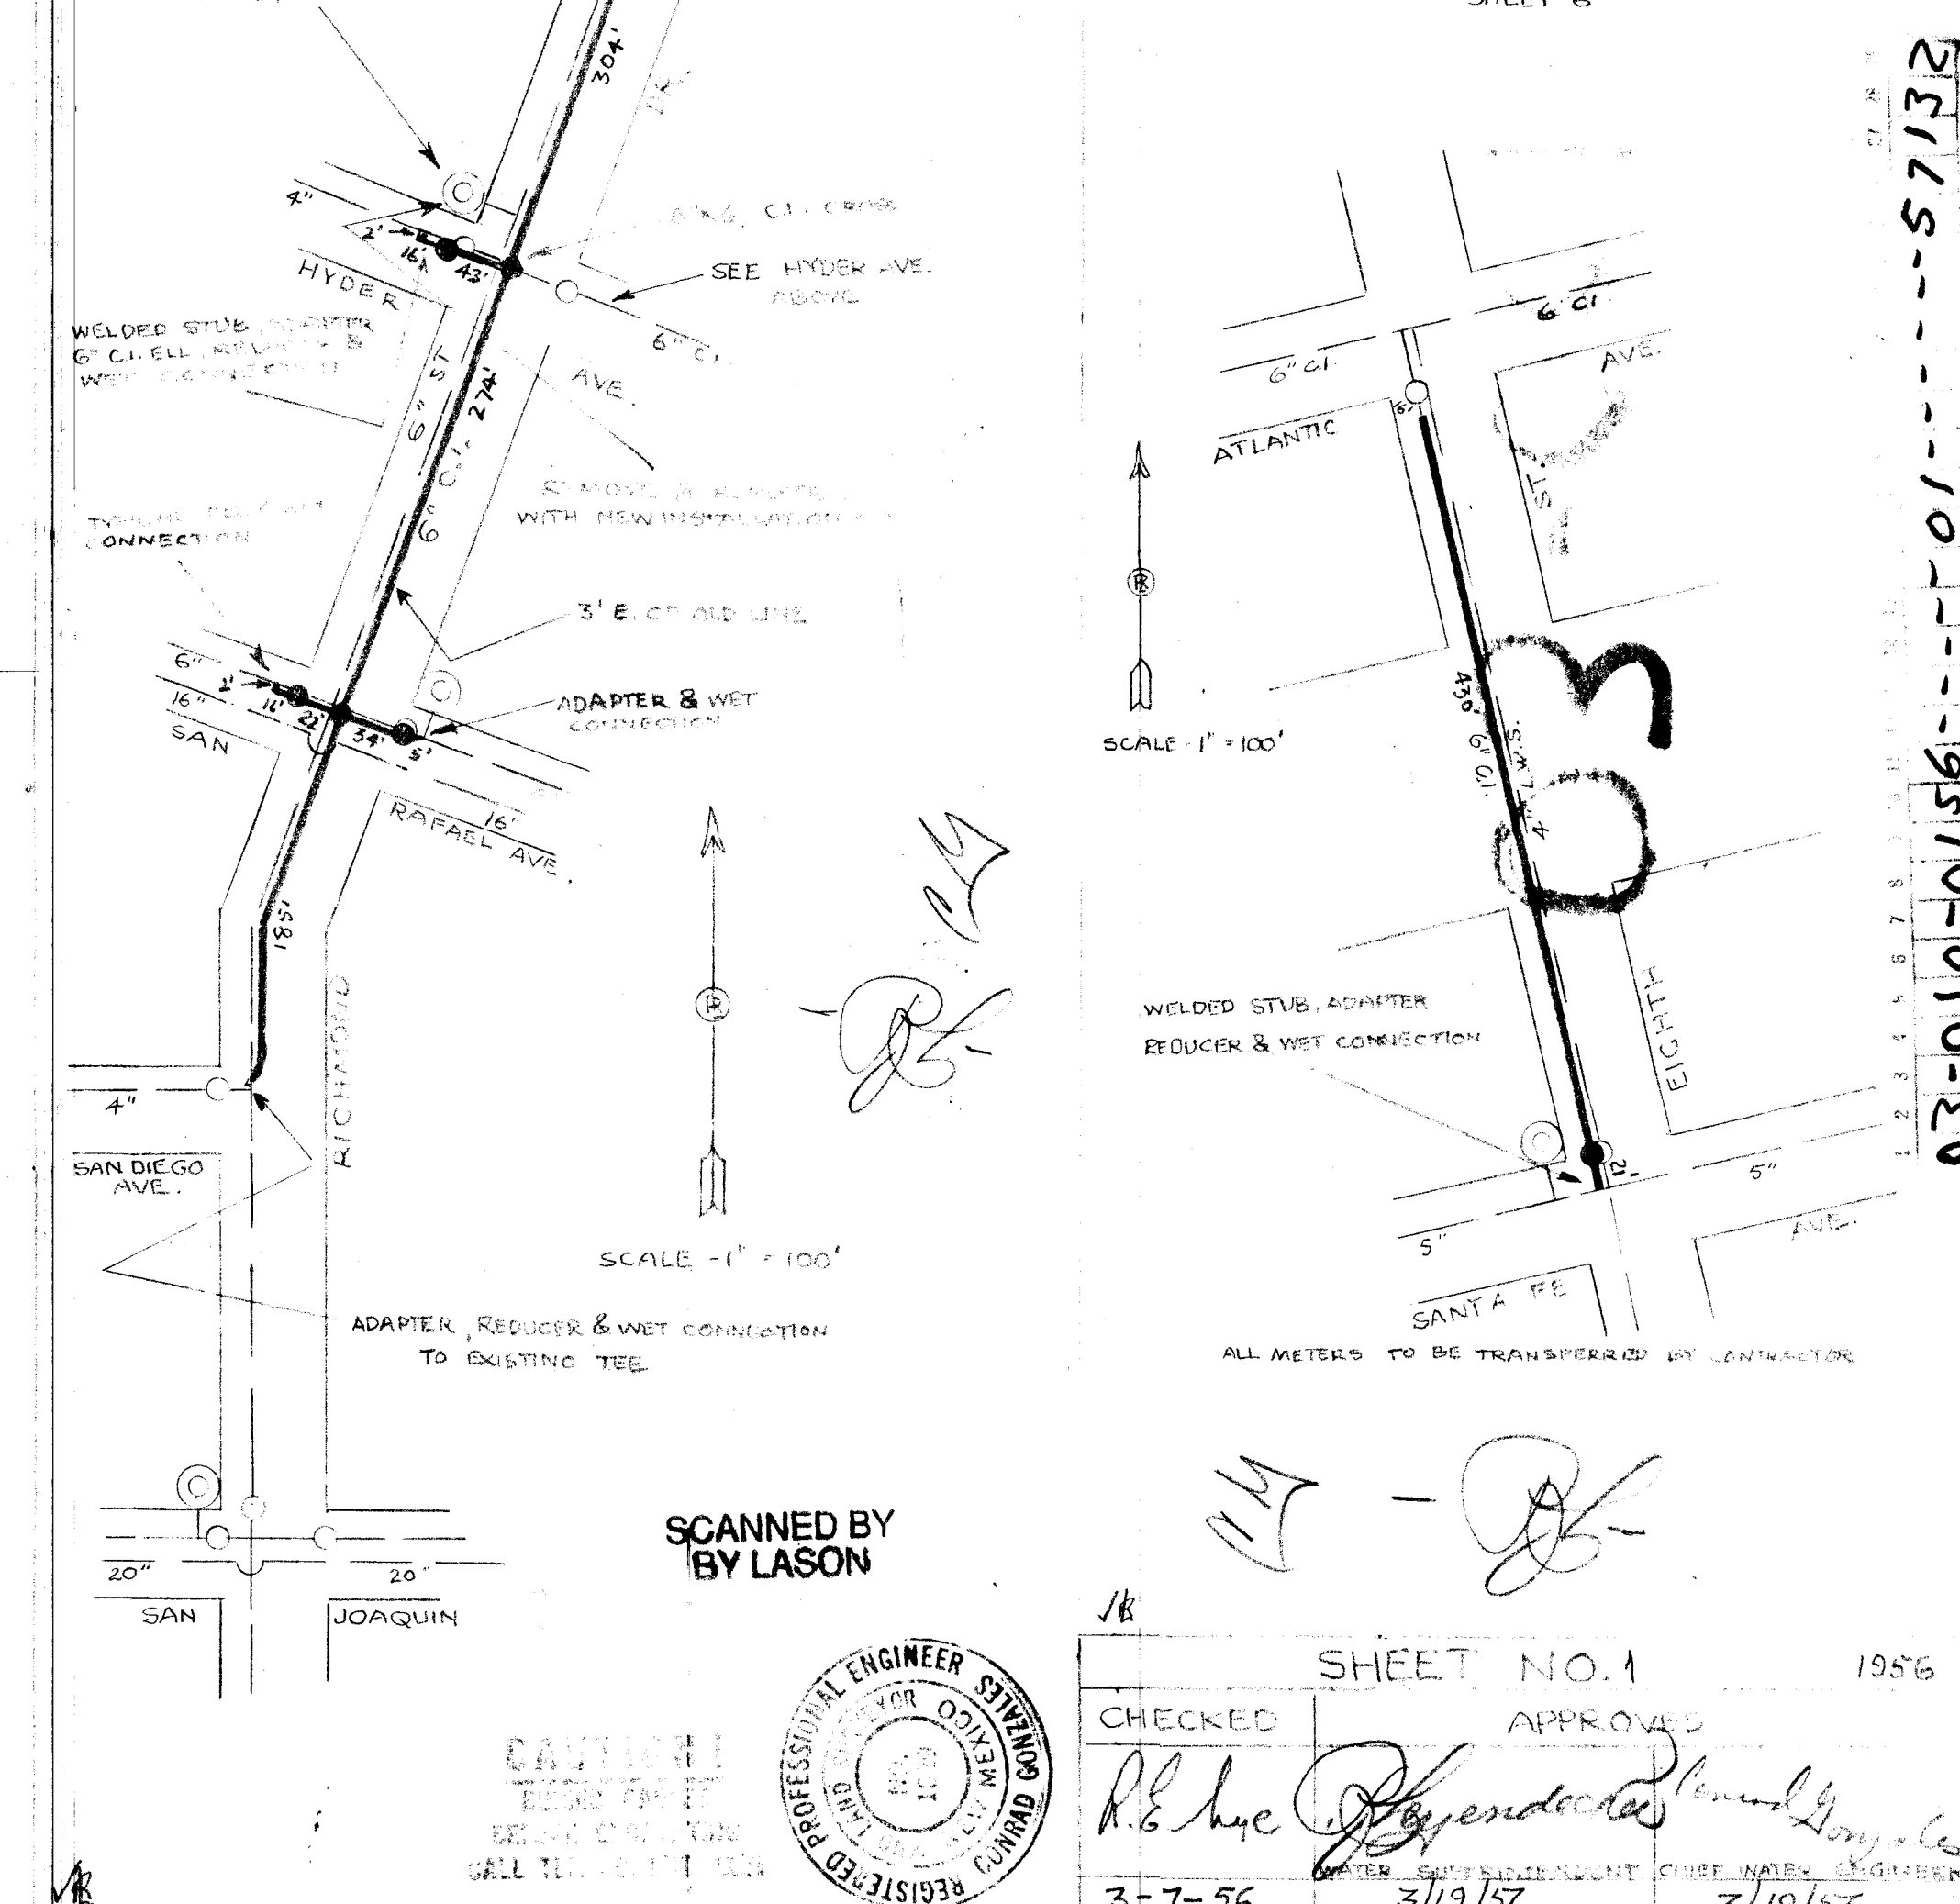
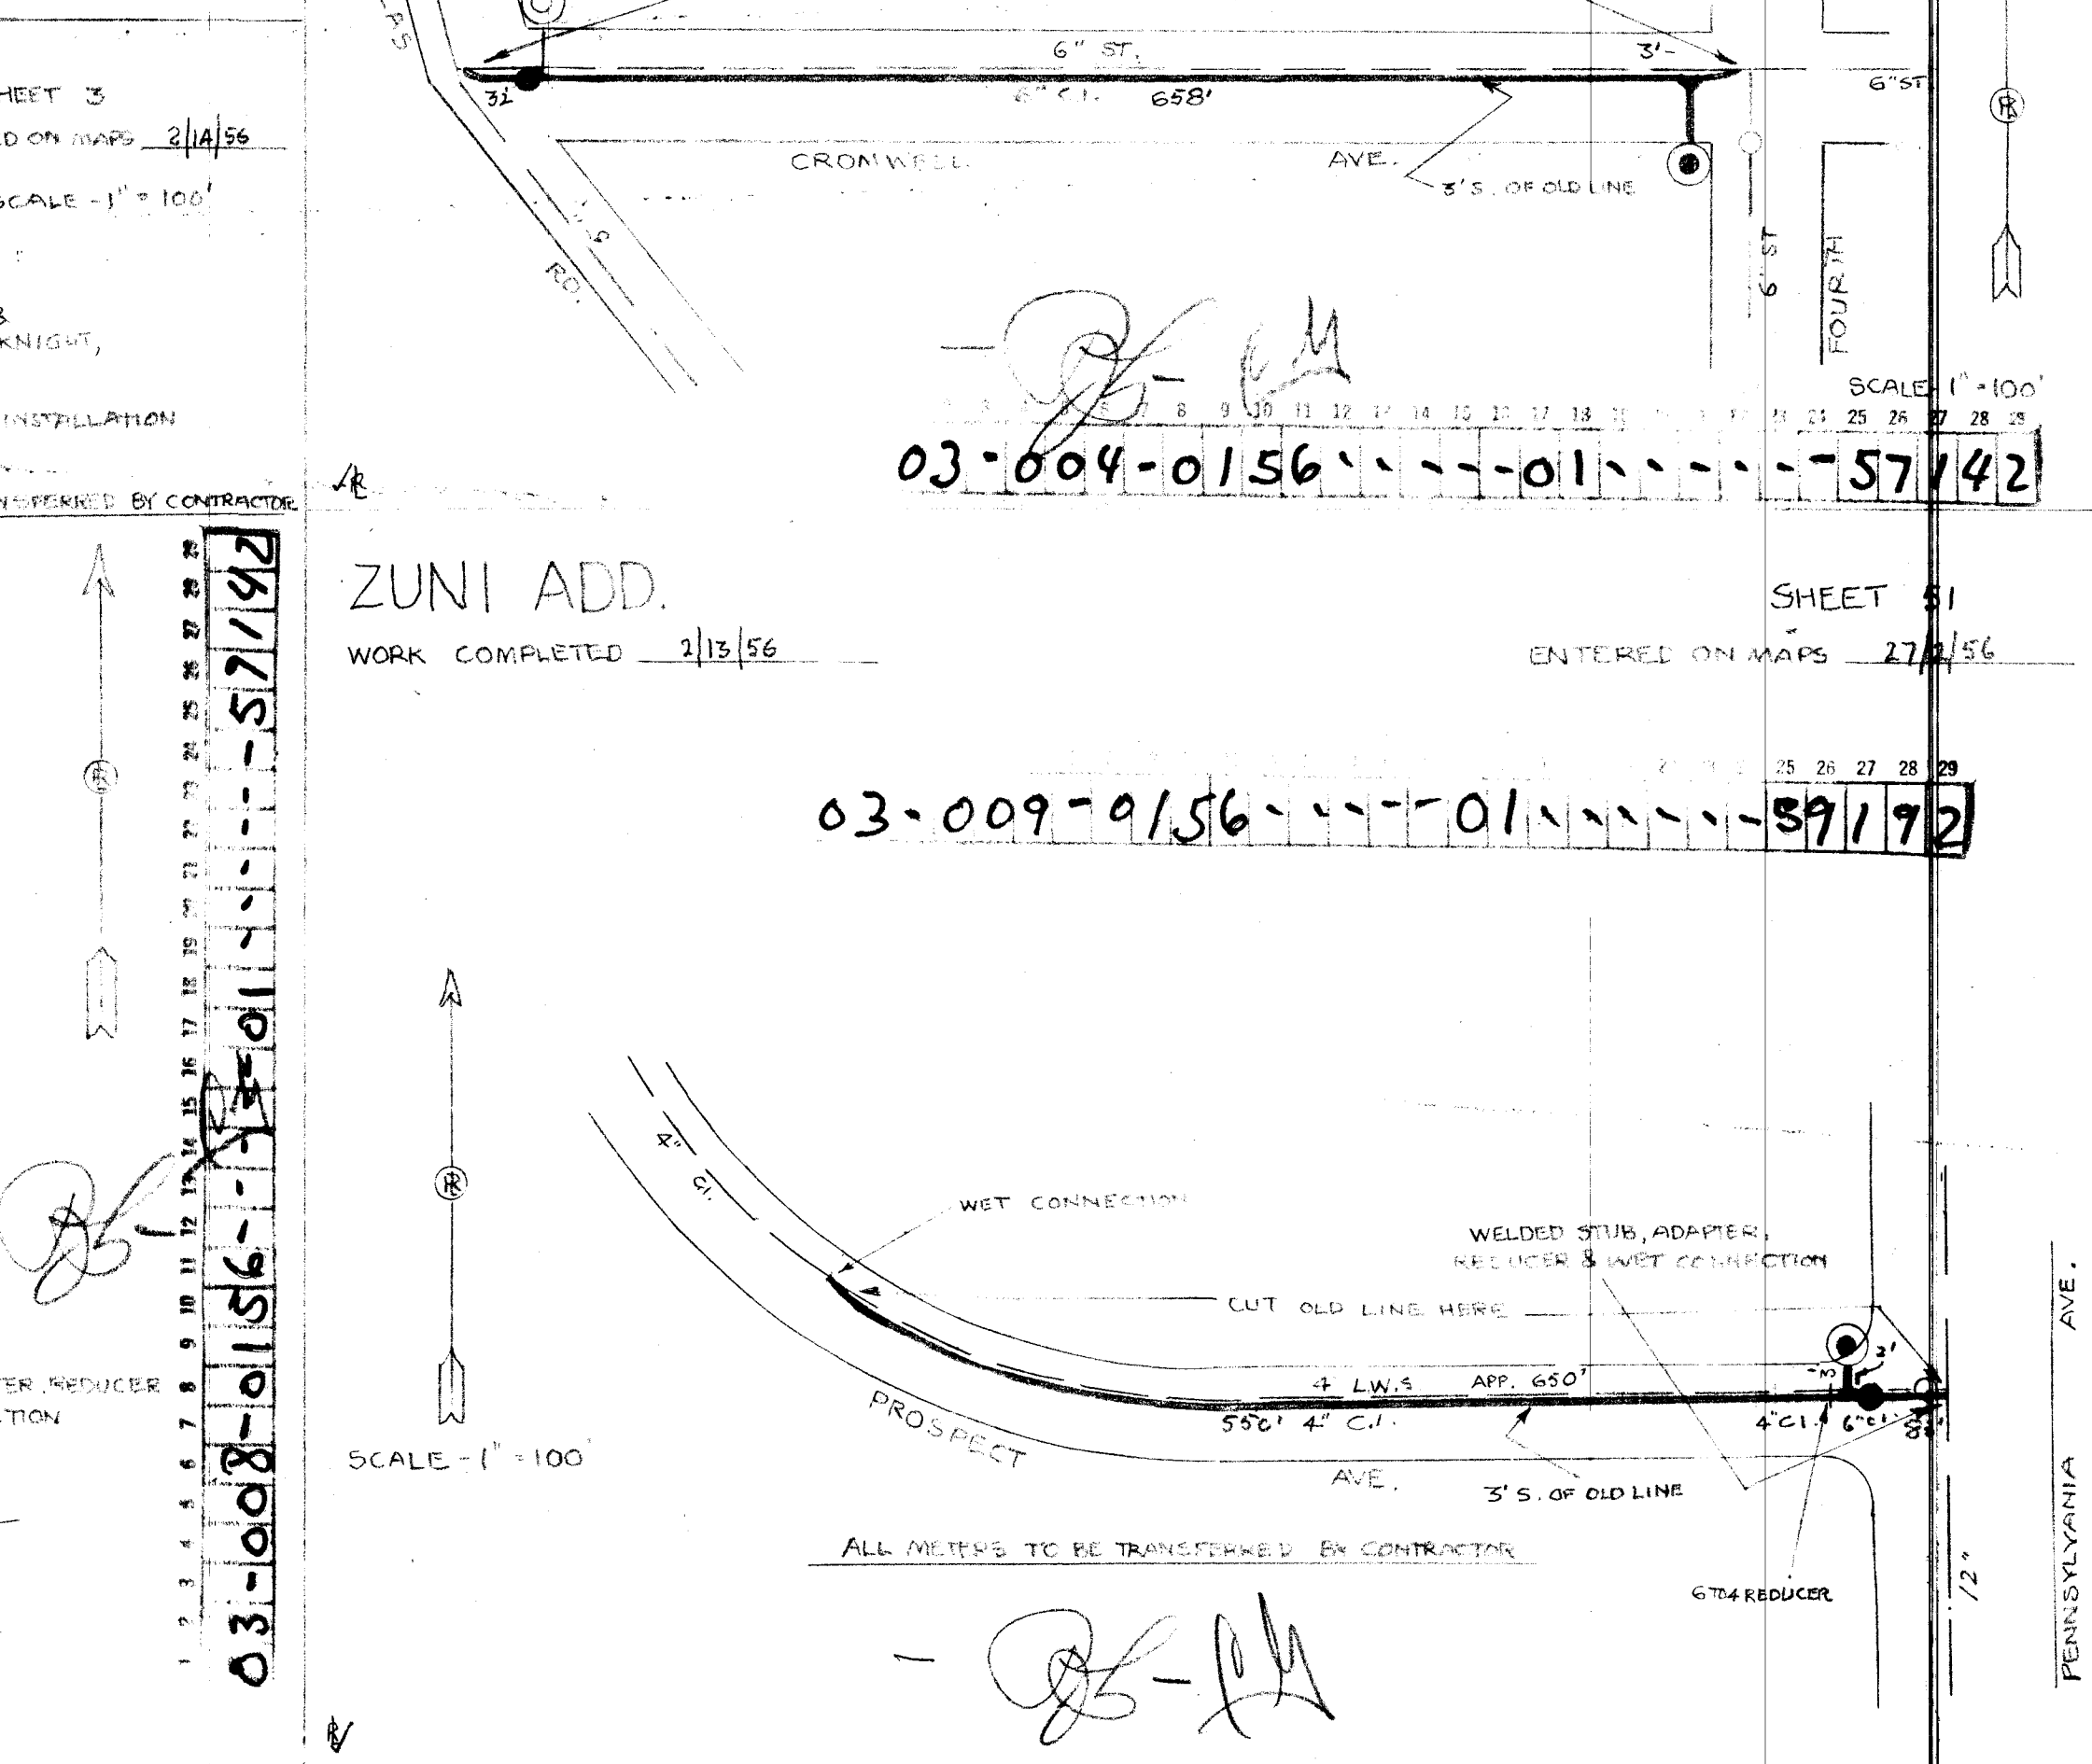
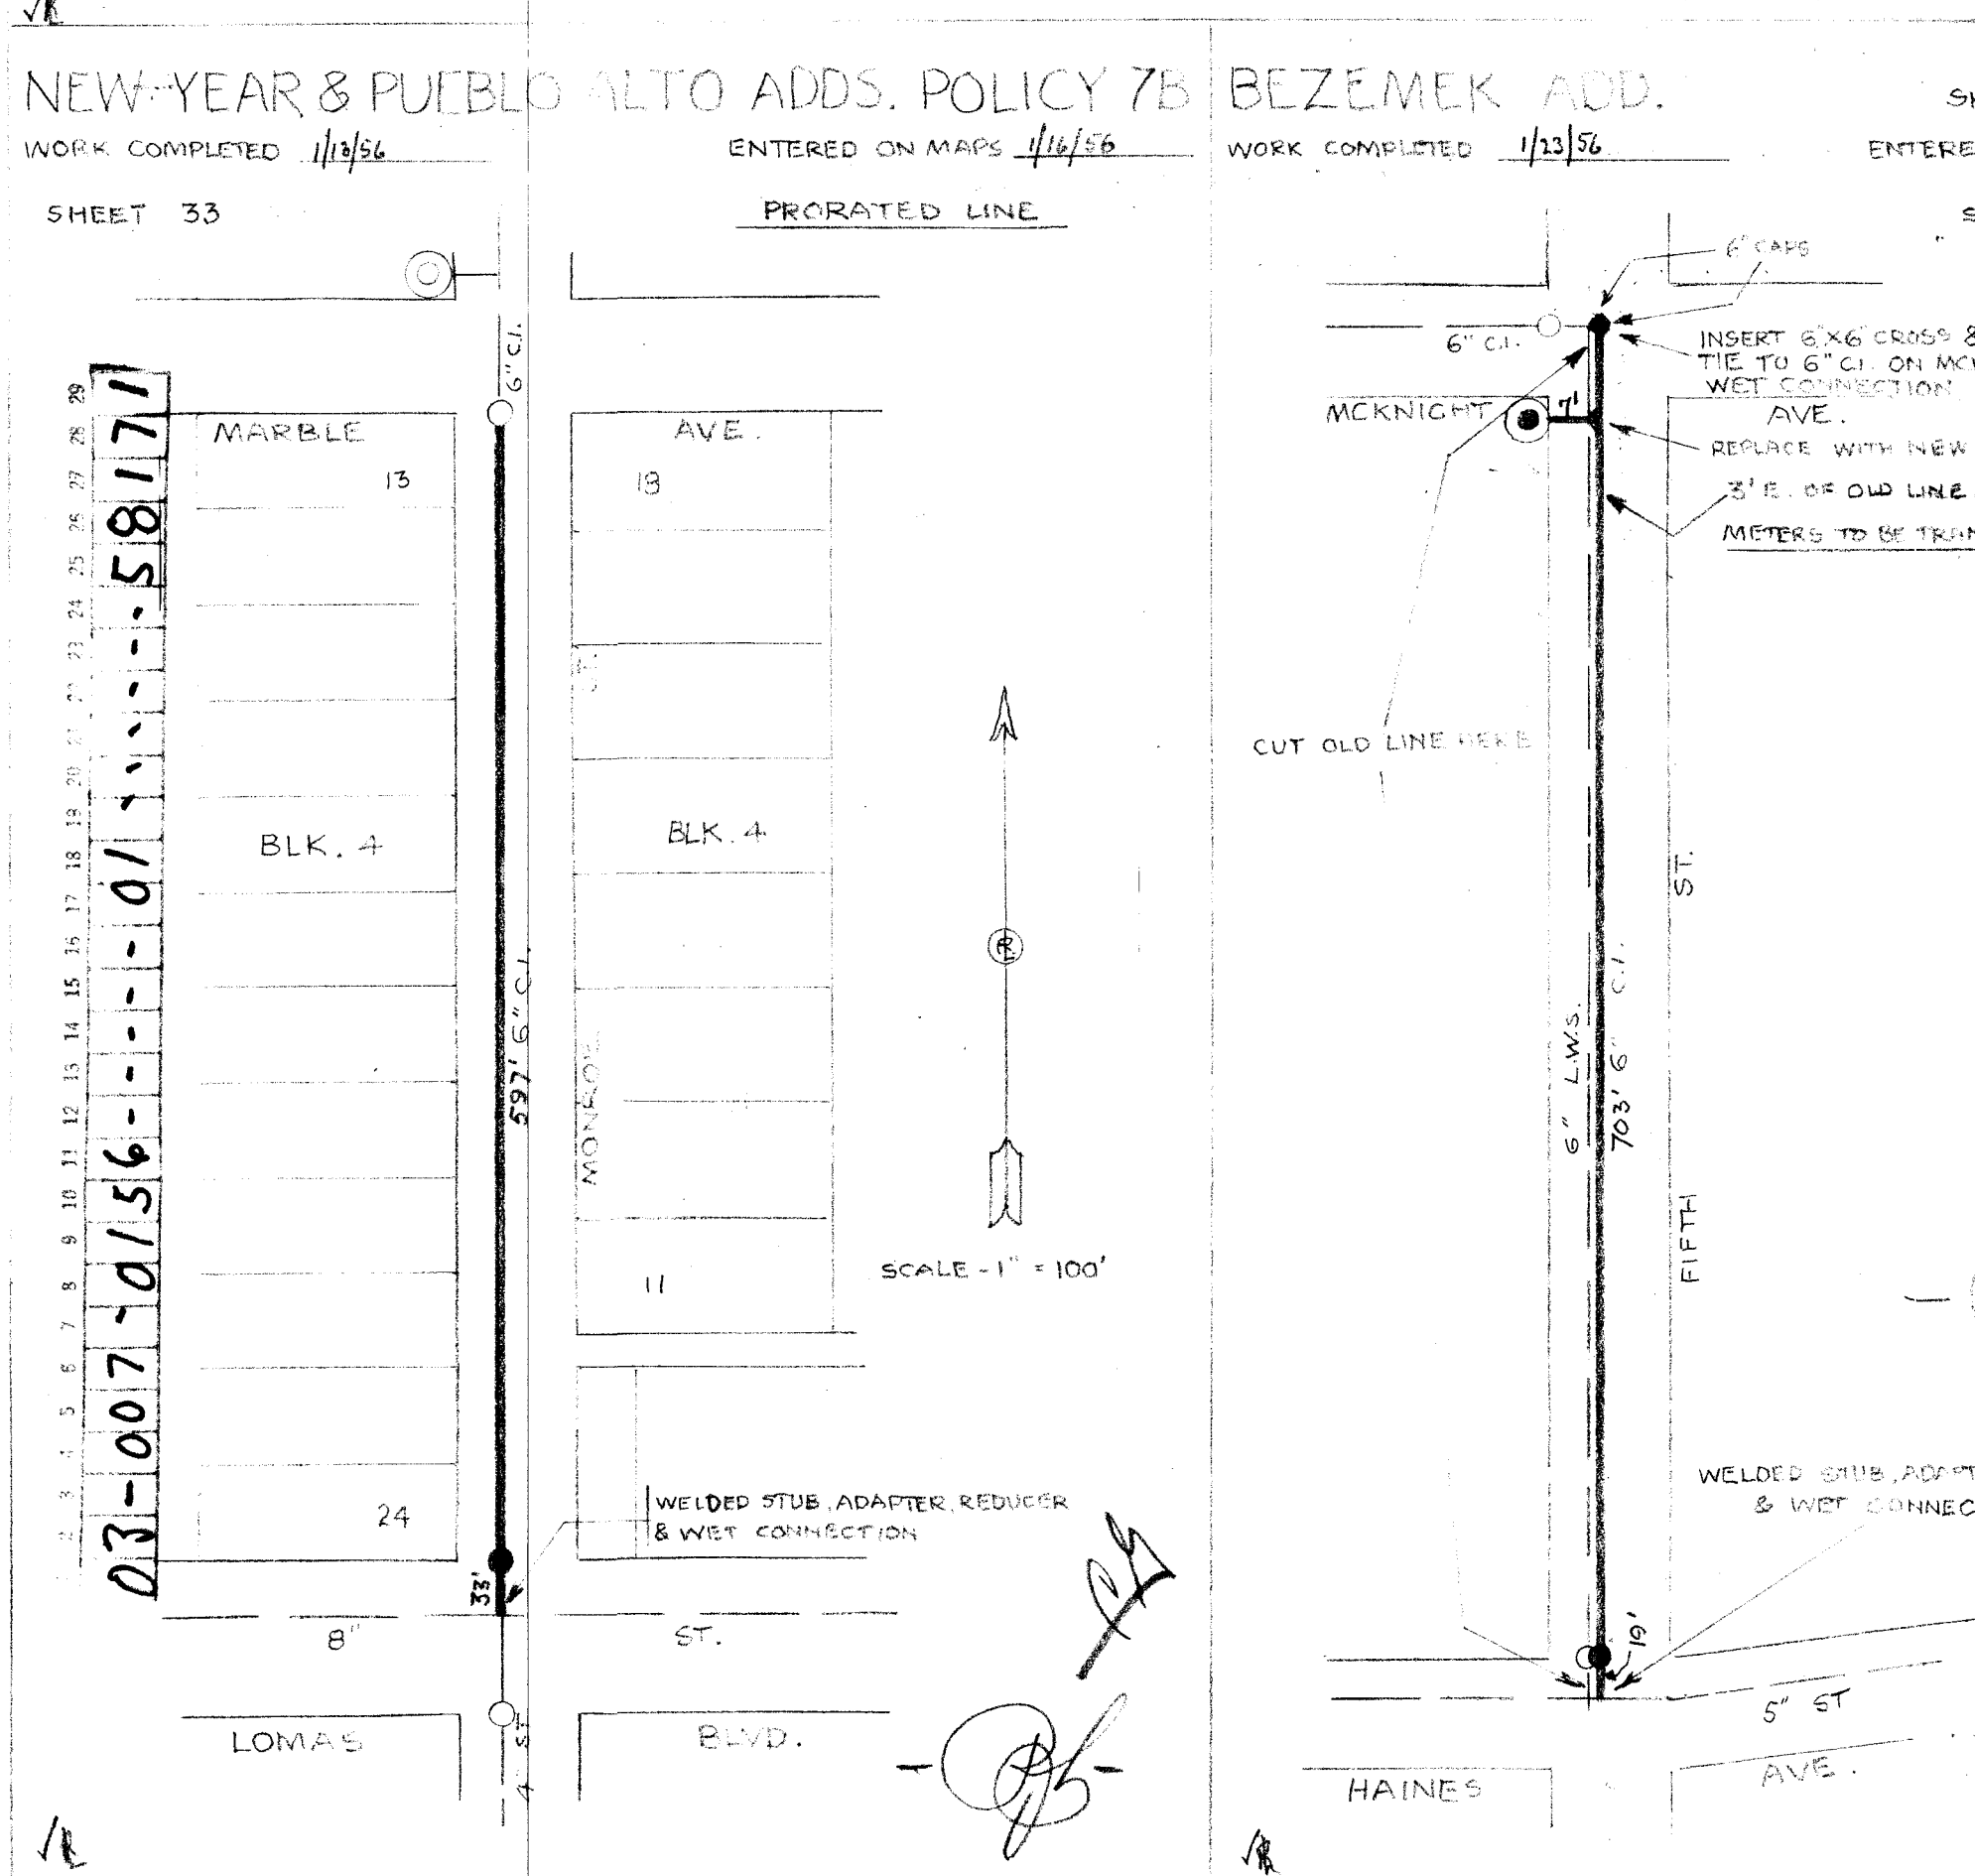
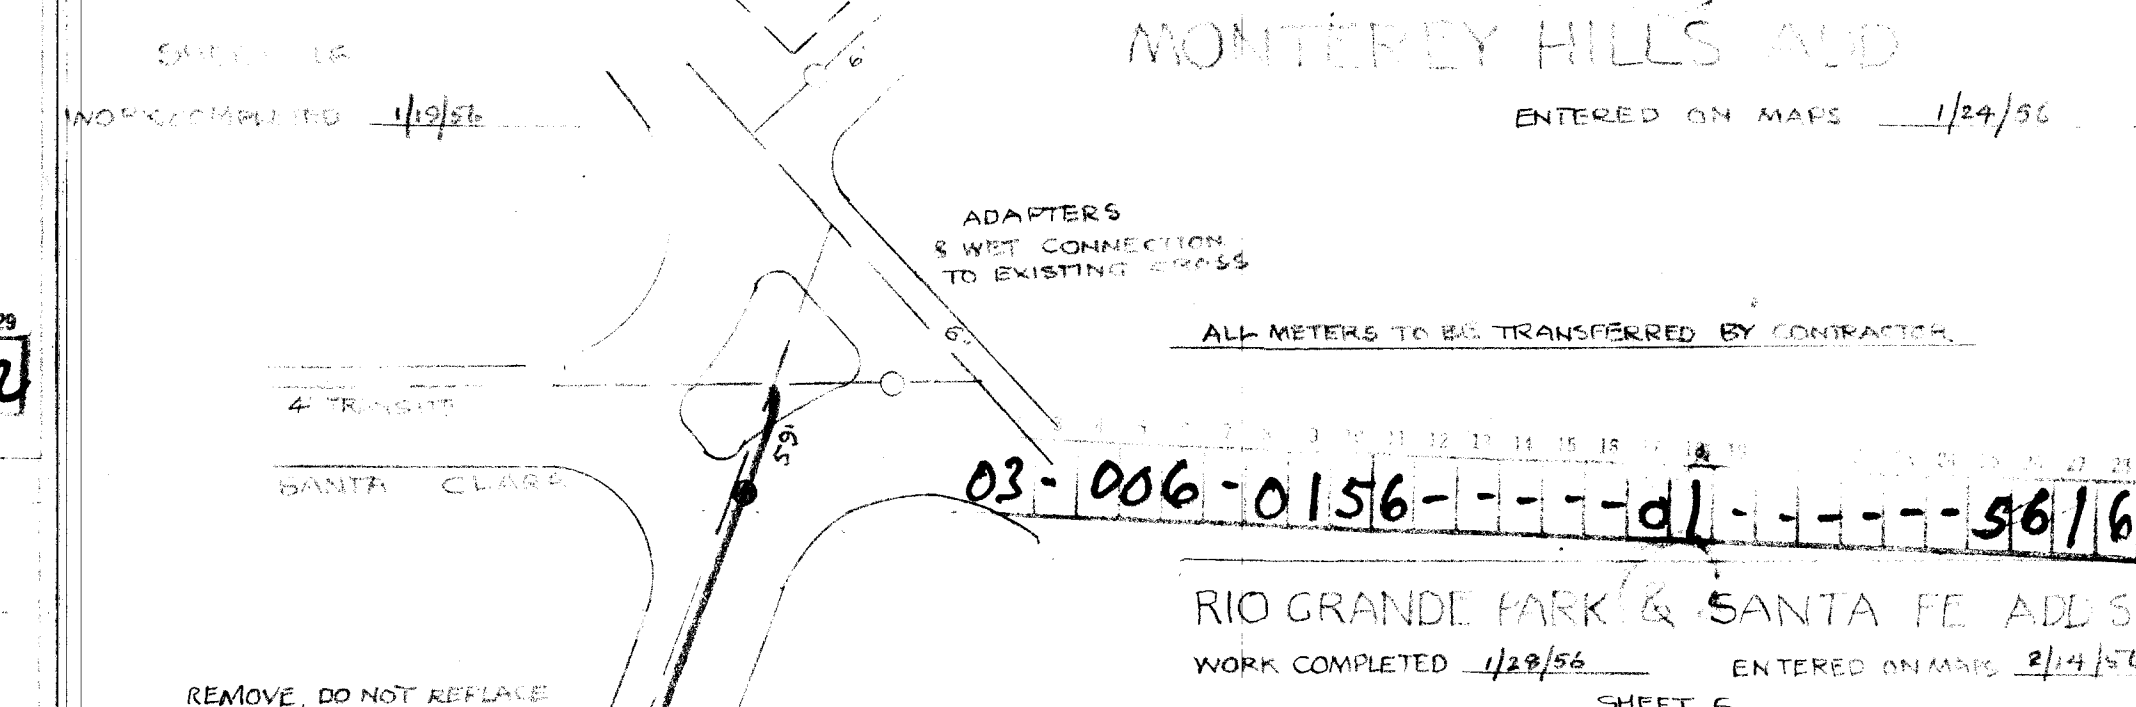
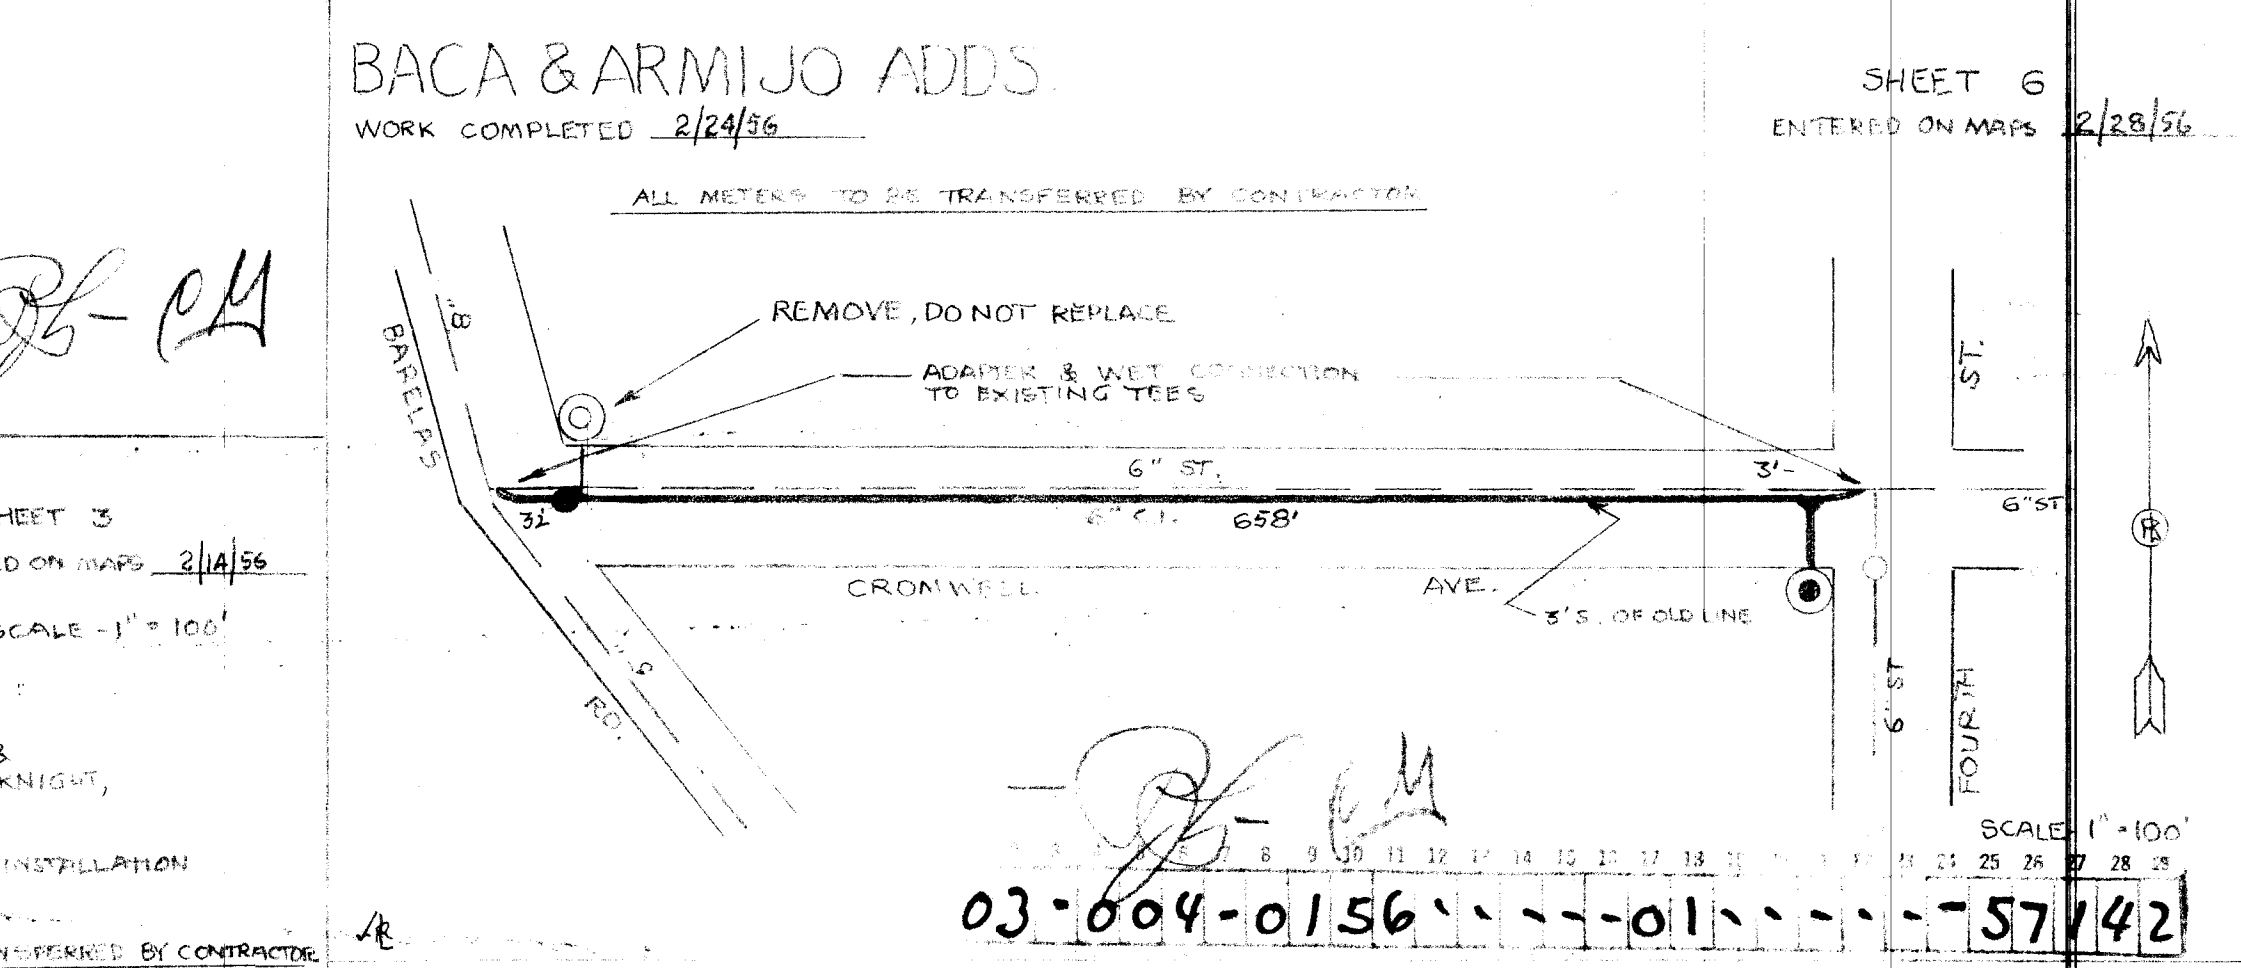
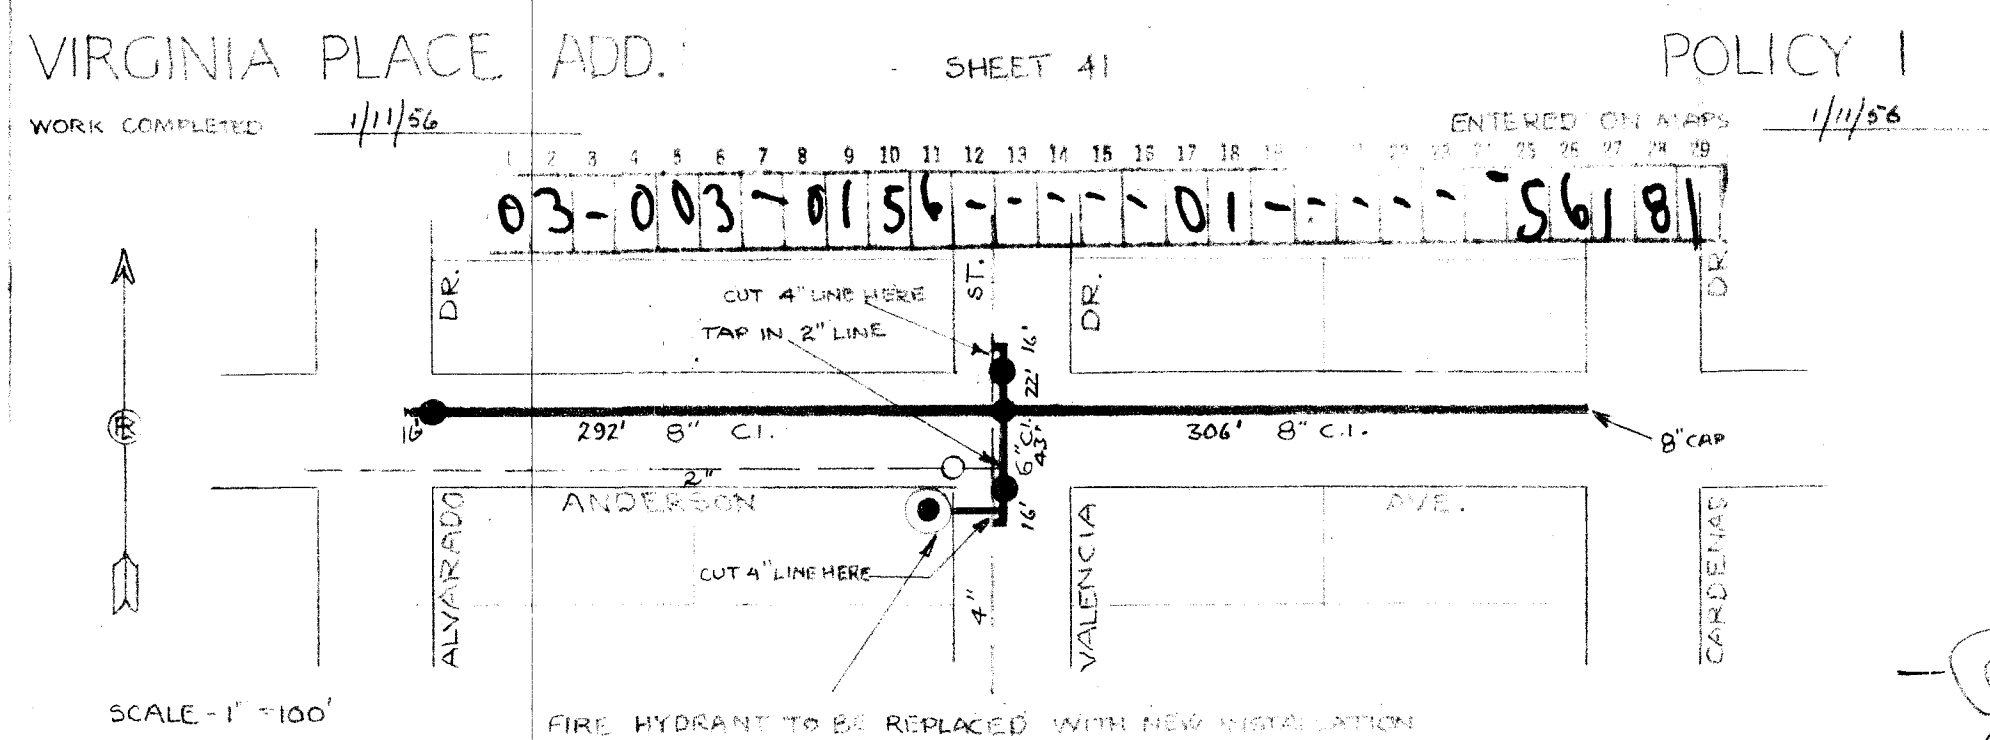
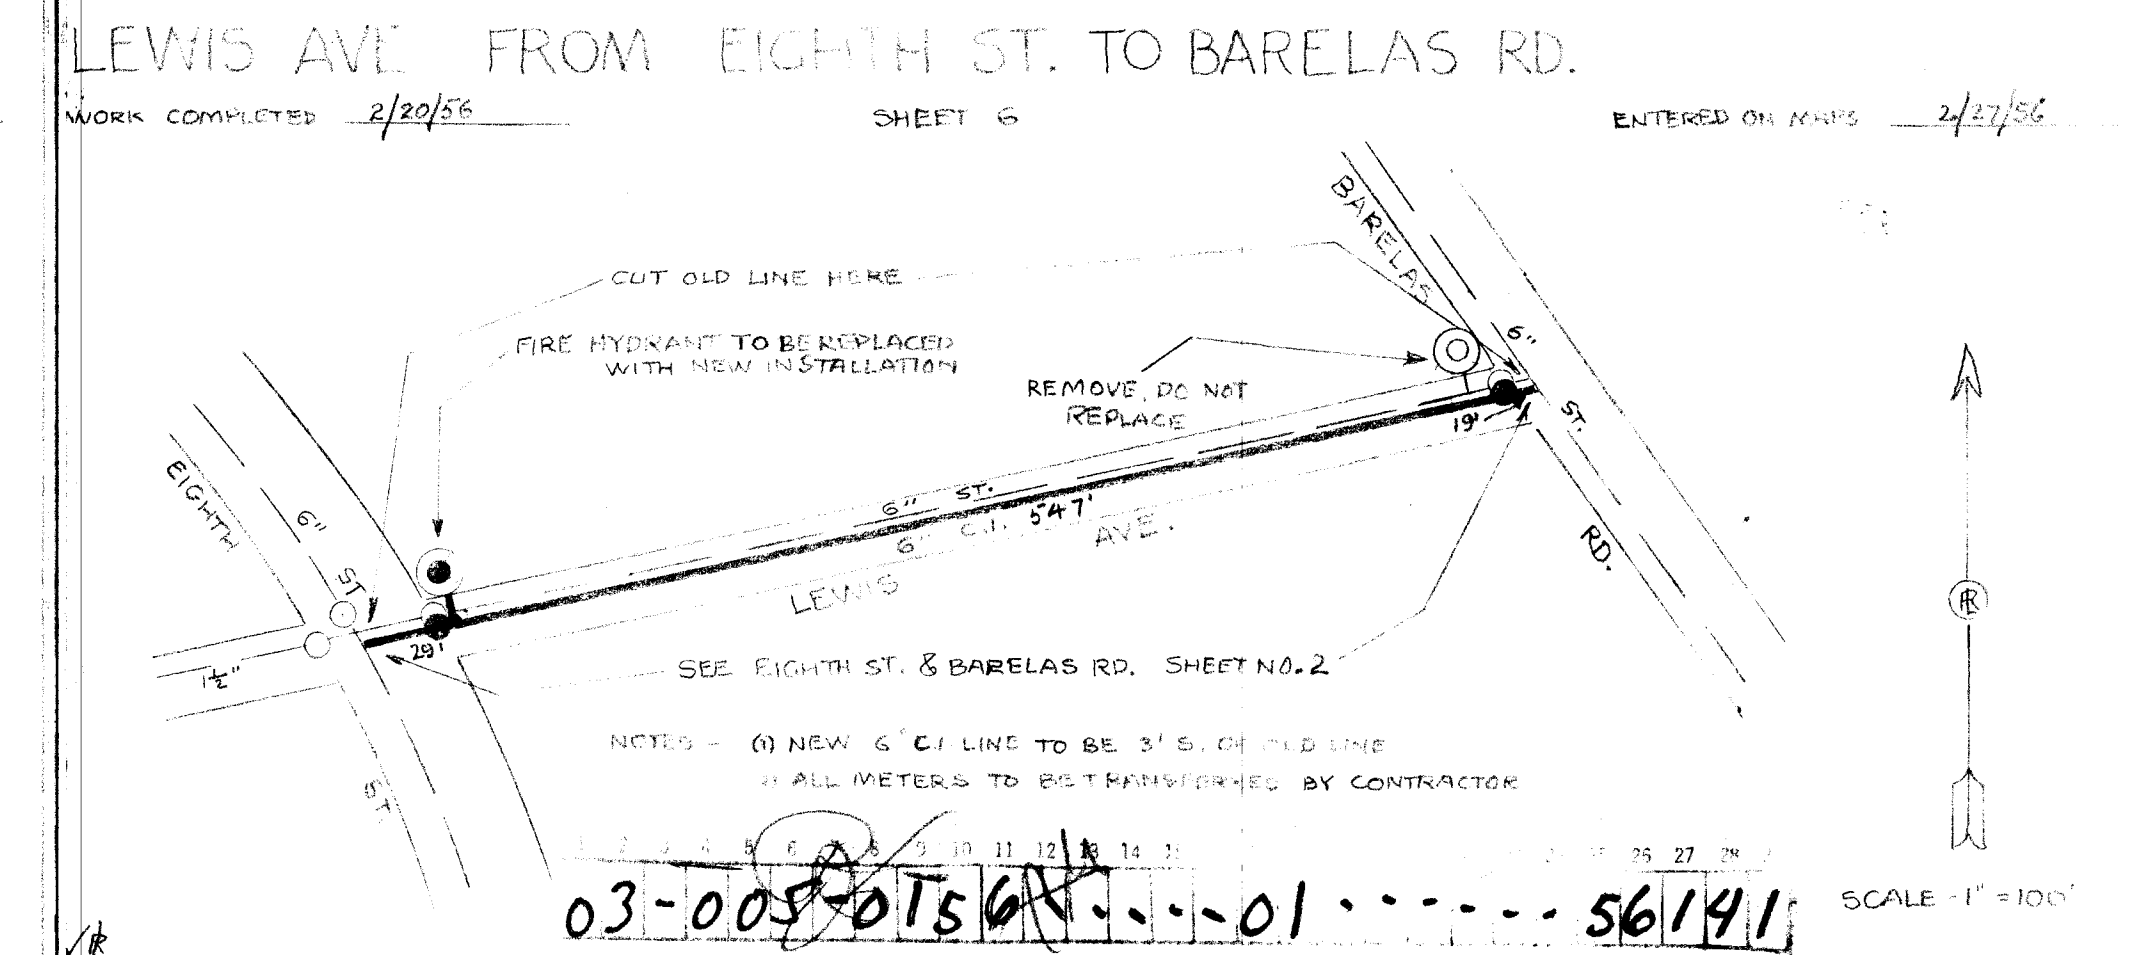
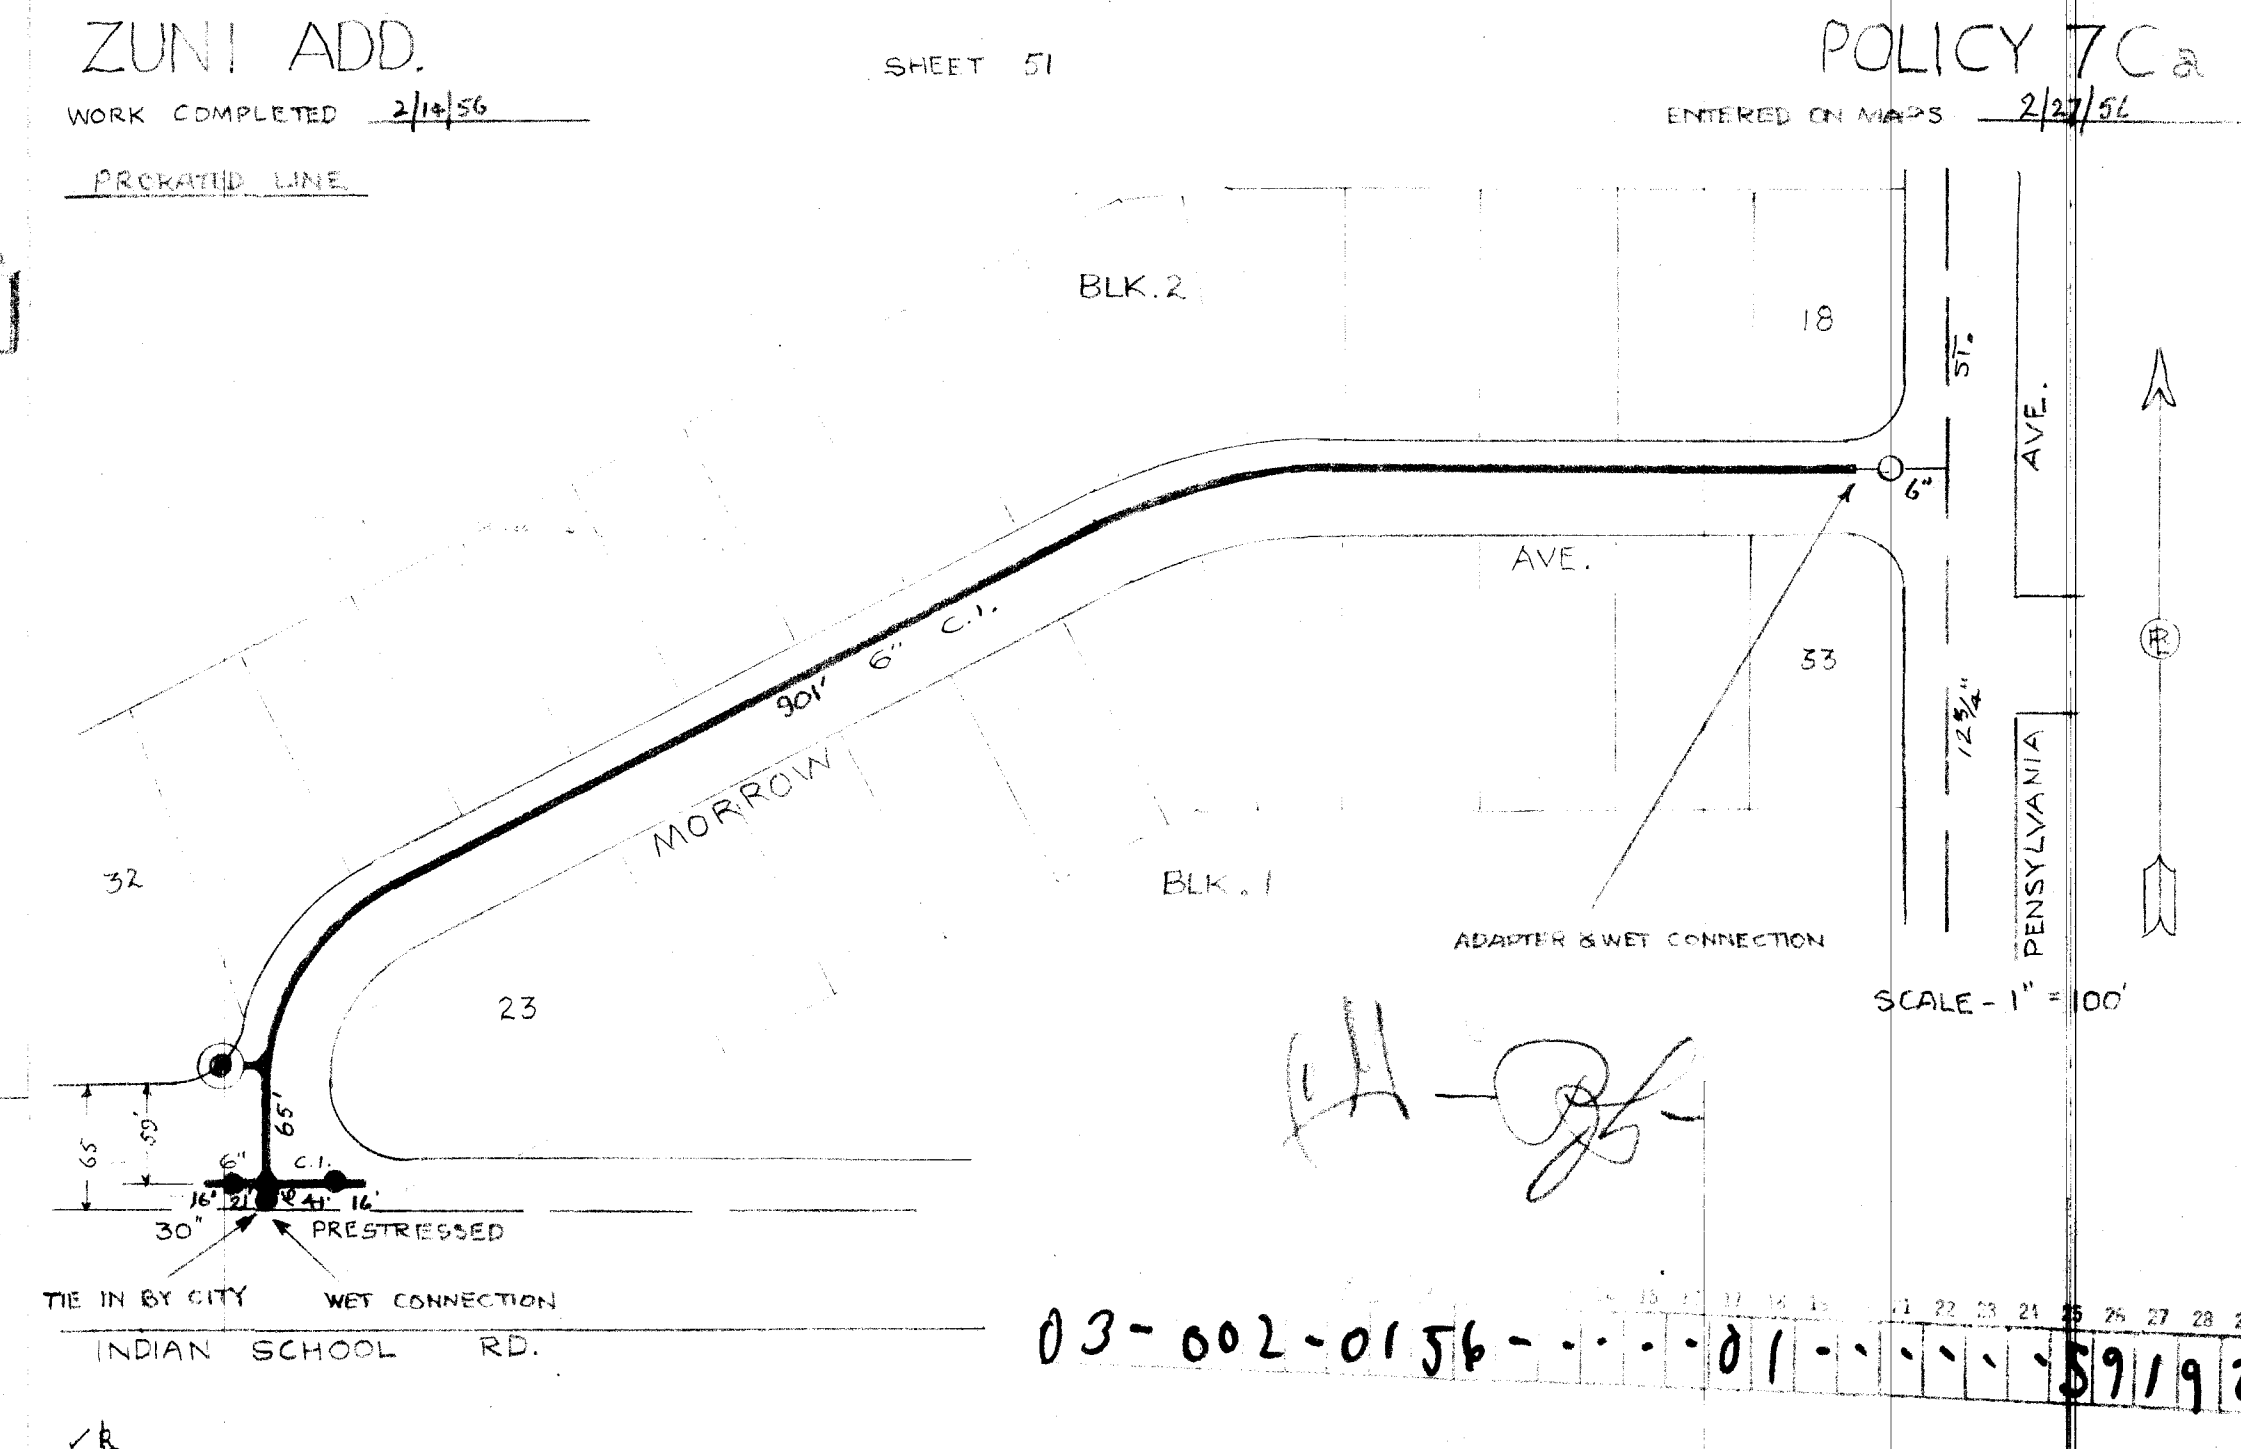


CONTINUATION
OF
PARTIAL PLANS ON COMBINATION SEWER & WATER CONTRACT
SCALE - 1" = 100'
PAVING DISTRICT 97 W.O.191a

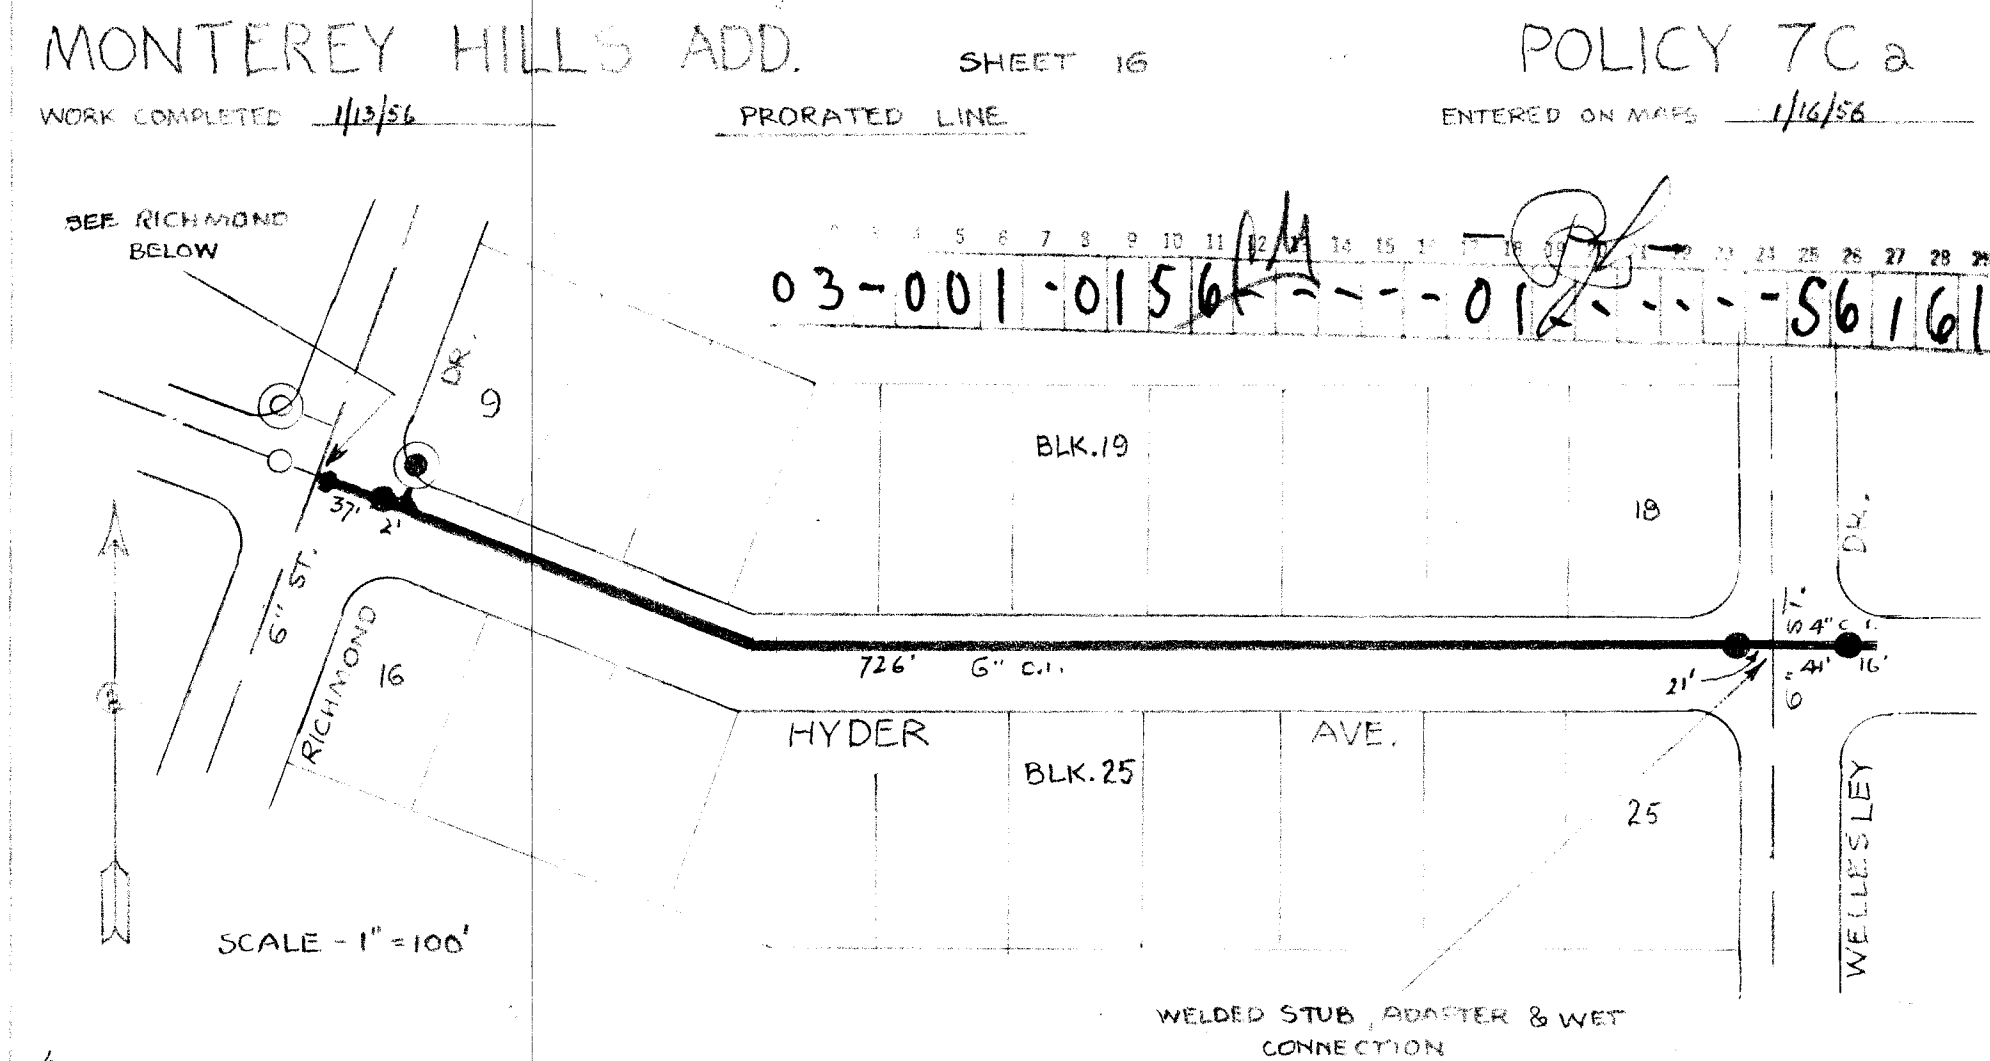

SCANNED BY
BY LASON

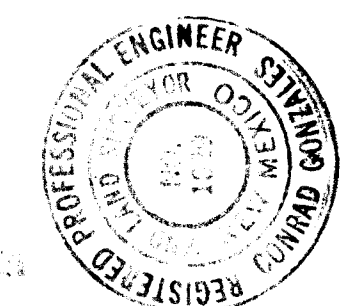

SHEET NO. 1	
CHECKED	APPROVED
R. B. Lason	R. B. Lason
3-7-56	3/19/56