


PLAN

PROFILE

SCALE
VERT. 1" = 5'
HORIZ. 1" = 20'

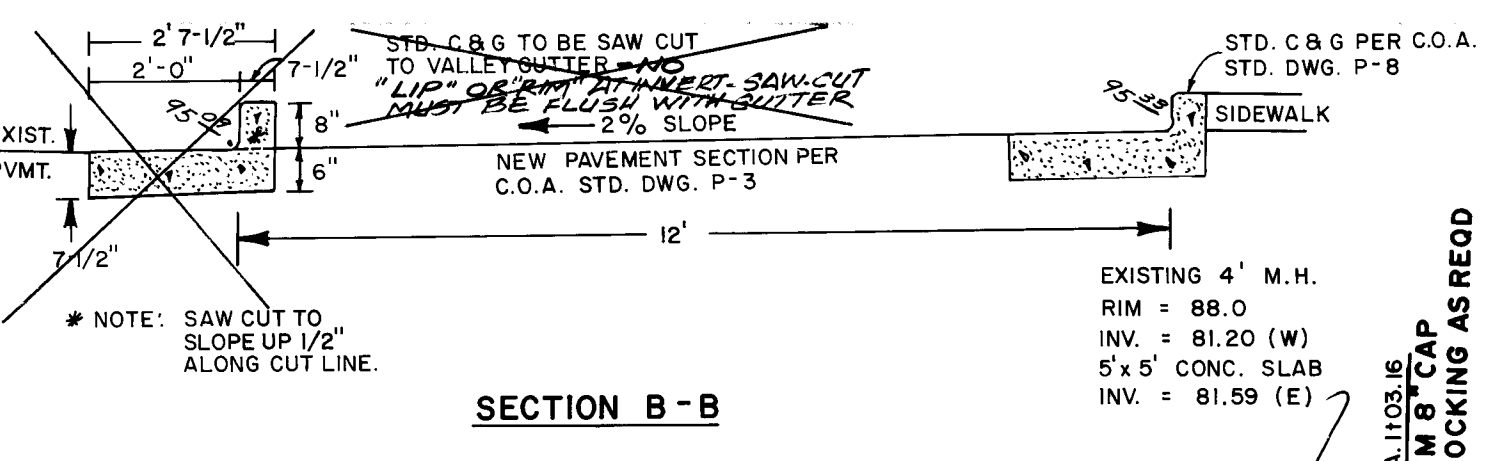


MONTGOMERY BUSINESS PARK
Lot 24 File Book C-21 Page 77-2
May 18, 1983


S 1/2 - SE 1/4 - SW 1/4 - SE 1/4 - SE 1/4
of Section 33, T11N, R4E, N.M.P.M.
Bernalillo County, New Mexico

CURVE DATA			
R	DELTA	T	L
150'	16° 29' 26"	21.73	43.17

MEDIAN OPENING 76'

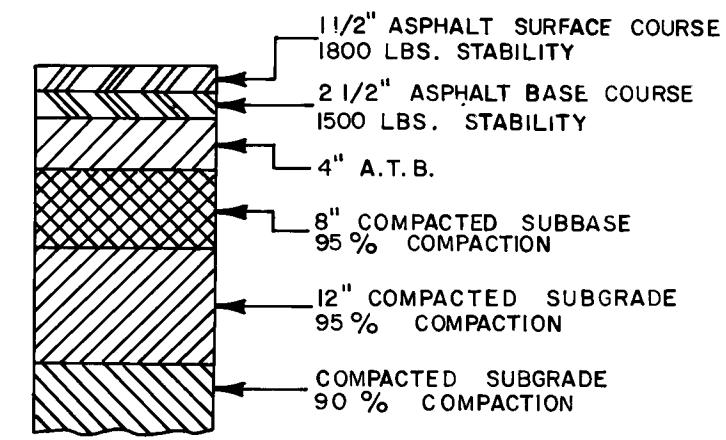

PAVEMENT SECTION
C.O.A. STD. P-3

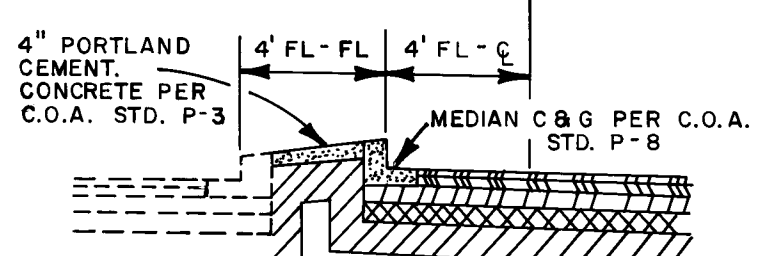

SECTION A-A

LEGEND

- TC 692.59 / FL 691.92 EXISTING SPOT ELEVATIONS
- EXISTING CURB
- PROPOSED CURB
- ARTERIAL PAVEMENT
- SEE SECTION ABOVE

NOTICE TO CONTRACTOR

- An excavation/construction permit will be required before beginning any work within City right-of-way. An approved copy of these plans must be submitted at the time of application for this permit.
- All work detailed on these plans to be performed, except as otherwise stated or provided herein, shall be constructed in accordance with City of Albuquerque Interim Standard Specifications for Public Works Construction, 1985.
- Two working days prior to any excavation, contractor must contact Line Locating Service, 765-1234, for location of existing utilities.
- Prior to construction, the contractor shall excavate and verify the horizontal and vertical locations of all constructions. Should a conflict exist, the contractor shall notify the engineer so that the conflict can be resolved with a minimum amount of delay.
- Backfill compaction shall be according to Arterial street use.

ACS STA. 21+ F-21

Located in existing median west side intersection of Tara & Montgomery Blvd.

X = 419,821.57

Y = 1,502,893.70

Z = 5,690.558

Δ = 0° 9' 15"

GD. = 09996352

9/16/87 Revised from as-built information E.N.

9/16/87 Revised from as-built information E.N.

D.L.C.

S.L.C.

R.R.B.

1/87

1/87

1/87

TURN BAY, DECELL LANE & WATERLINE
MINATO SQUARE
PROJECT # 3161

3/9/87
3/16/87
3-3-87

3161

F-21

1

1