


CITY OF ALBUQUERQUE, NEW MEXICO
PUBLIC WORKS DEPARTMENT

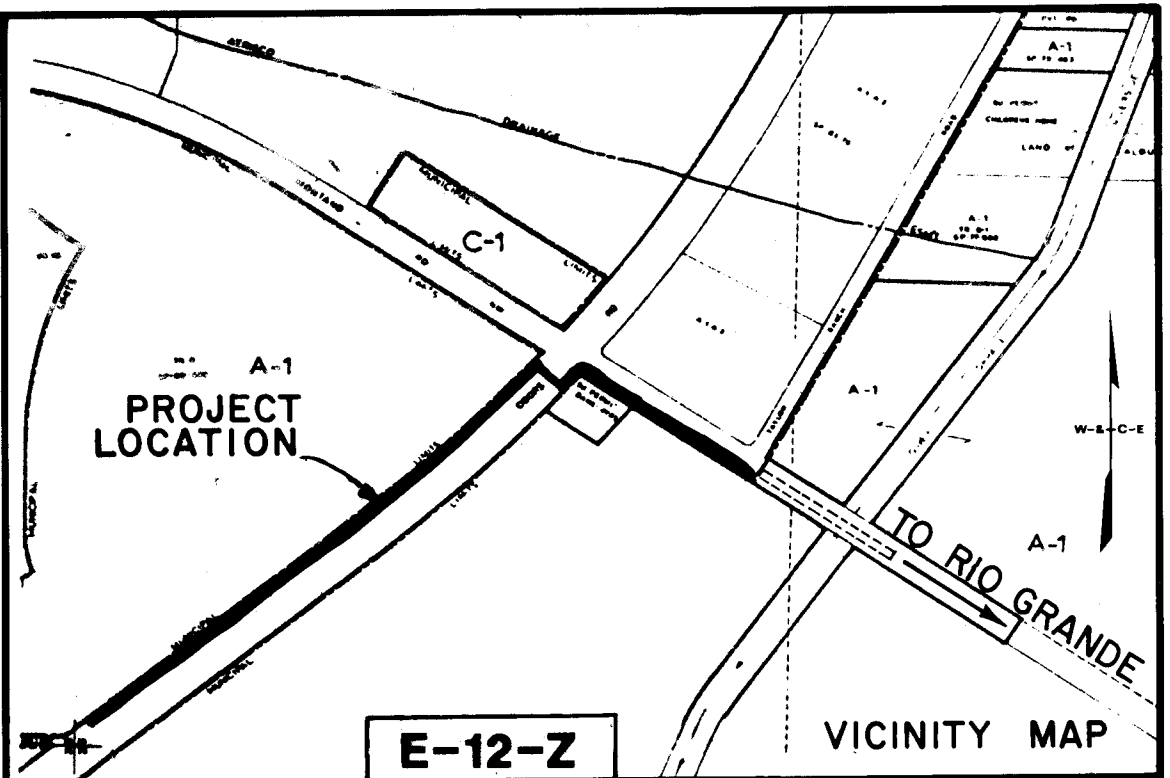

COORS ROAD
AND
MONTANO ROAD
DRAINAGE IMPROVEMENTS
MONTANO TO DELLYNE

NOTES

ALL WORK DETAILED ON THESE PLANS TO BE PERFORMED UNDER CONTRACT SHALL, EXCEPT AS OTHERWISE STATED OR PROVIDED FOR HEREON, BE CONSTRUCTED IN ACCORDANCE WITH THE C.O.A. INTERIM STD. SPECIFICATIONS FOR PUBLIC WORKS CONSTRUCTION - 1985 EDITION (REFERRED TO HEREIN AS THE STANDARD SPECIFICATIONS).

TWO (2) WORKING DAYS PRIOR TO ANY EXCAVATION, CONTRACTOR MUST CONTACT LINE LOCATING SERVICE, 765-1234, FOR LOCATION OF EXISTING UTILITIES.

PRIOR TO CONSTRUCTION, THE CONTRACTOR SHALL EXCAVATE AND VERIFY THE HORIZONTAL AND VERTICAL LOCATIONS OF ALL OBSTRUCTIONS. SHOULD A CONFLICT EXIST, THE CONTRACTOR SHALL NOTIFY THE ENGINEER OR SURVEYOR SO THAT THE CONFLICT CAN BE RESOLVED WITH MINIMUM AMOUNT OF DELAY.

NOTE:
PUBLIC WORKS DEPARTMENT AS SHOWN ON COVER SHEET SHALL APPLY TO ALL PLAN SHEETS.

INDEX


TITLE SHEET	1
GENERAL NOTES & LEGEND	2
STORM DRAIN PLAN & PROFILE	3-6
DETAIL SHEETS	7-8
TRAFFIC CONTROL PLAN	9
CROSS SECTIONS	10

1	2	3	4	5	6	7	8	9	10	11	12
26	31	63	01	89							

Handwritten signature: B. H. 101

1	2346789		12/1/87								
REV	SHEETS	CITY ENGR.	DATE	USER DEPT.	DATE	USER DEPT.	DATE				
APPROVAL OF REVISIONS											

RECORD DRAWINGS: This project was inspected by Tony Archuleta from the City of Albuquerque Inspection Dept.. These drawing have been revised in accordance with the As Built information furnished by Mr. Archuleta to reflect the construction as actually accomplished in the field.

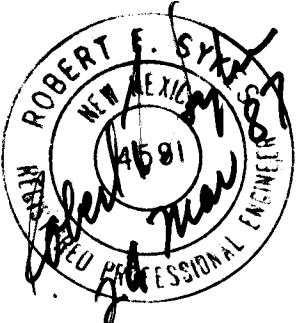

WILSON & COMPANY
ENGINEERS
ARCHITECTS
ALBUQUERQUE, NEW MEXICO


PROJECT No. **3163**

APPROVED FOR CONSTRUCTION
Handwritten signature
6-16-87

SHEET **1** OF **10**

GENERAL NOTES

- ALL UTILITY POLES ARE TO BE RELOCATED BY THE UTILITY COMPANY RESPONSIBLE.
- CURB AND GUTTER SHOWN AS EXISTING AND NOT TO BE REMOVED UNDER THIS CONTRACT WHICH IS DAMAGED OR DISPLACED BY THE CONTRACTOR SHALL BE REMOVED AND REPLACED BY THE CONTRACTOR AT HIS EXPENSE.
- WHEN ABUTTING NEW PAVEMENT TO EXISTING, SAW CUT EXISTING PAVEMENT TO A STRAIGHT LINE AS REQUIRED TO REMOVE ANY BROKEN OR CRACKED PAVEMENT AND MATCH NEW TO EXISTING.
- WHEN REMOVAL OF EXISTING CURB AND GUTTER OR SIDEWALK IS REQUIRED, REMOVE BACK TO NEAREST JOINT.
- ALL GAS VALVE BOXES, GAS MANHOLES, ELECTRICAL MANHOLES, AND TELEPHONE MANHOLES WILL BE ADJUSTED TO GRADE BY THE UTILITY COMPANY RESPONSIBLE FOR THOSE STRUCTURES.
- DELETED
- CONTRACTOR IS TO EXERCISE DUE CARE TO AVOID DISTURBING ANY EXISTING UNDERGROUND UTILITIES. IT SHALL BE HIS RESPONSIBILITY TO COORDINATE WITH THE UTILITY COMPANIES IN ORDER TO PREVENT ANY SERVICE DISRUPTION.
- DELETED
- ALL WATER VALVE BOXES AND SEWER MANHOLES IN THE CONSTRUCTION AREA ARE TO BE ADJUSTED TO FINISH GRADE UNDER THIS CONTRACT, AND WILL BE PAID FOR AT CONTRACT UNIT PRICES.
- SUBGRADE PREPARATION UNDER CURB AND GUTTER SHALL BE CONSIDERED INCIDENTAL TO THE CONSTRUCTION OF SUCH AND SHALL BE INCLUDED IN THE BID PRICE FOR SUCH ITEMS.
- A DISPOSAL SITE, COMPLYING WITH ALL CITY ORDINANCES, SHALL BE OBTAINED BY THE CONTRACTOR FOR THE DISPOSAL OF ALL EXCESS EXCAVATION MATERIAL, ASPHALTIC PAVEMENT, CONCRETE BARRIERS, AND OTHER WASTE MATERIALS. THE CONTRACTOR SHALL NOTIFY THE CITY OF ALBUQUERQUE THE LOCATION OF THE DISPOSAL SITE PRIOR TO THE REMOVAL AND ACTUAL DISPOSAL OF THE MATERIAL. ALL COSTS IN OBTAINING A DISPOSAL SITE AND HAUL THERETO SHALL BE CONSIDERED INCIDENTAL TO CONSTRUCTION AND NO DIRECT PAYMENT WILL BE MADE THEREFOR.
- THE CONTRACTOR WILL BE REQUIRED TO CONFINED HIS WORK WITHIN THE CONSTRUCTION LIMITS AND/OR R.O.W. TO PRESERVE EXISTING VEGETATION AND PRIVATE PROPERTY. OVERNIGHT PARKING OF CONSTRUCTION EQUIPMENT SHALL NOT OBSTRUCT DRIVEWAY OPENINGS OR DESIGNATED TRAFFIC LANES.
- ALL EXCAVATIONS FOR STORM DRAINS, AND OTHER EXCAVATIONS AS NECESSARY, SHALL BE GOVERNED BY THE CONSTRUCTION SAFETY AND HEALTH STANDARDS (TITLE 29, C.F.R. PART 1910 AS APPLICABLE TO CONSTRUCTION WORK - PUBLISHED IN THE FEDERAL REGISTER ON FEBRUARY 9, 1979).
- ALL EXISTING REGULATORY SIGNS AND SIGNALS THAT NEED TO BE REMOVED, RELOCATED OR REINSTALLED SHALL BE DONE BY THE CITY OF ALBUQUERQUE TRAFFIC ENGINEERING DIVISION 3 WORKING DAYS IN ADVANCE OF ANY REQUIRED WORK. CALL CITY PING YARD-TRAFFIC SHOP (823-4008).
- FIRE ALARM CABLES ARE TO BE ADJUSTED BY THE FIRE DEPARTMENT PERSONNEL. FOR INFORMATION CALL 243-6604.
- EXISTING MEDIAN CURB AND STANDARD CURB AND GUTTER, NOT DISTURBED BY THE CONTRACTOR, AND THAT IS OUT OF ALIGNMENT OR DISPLACED VERTICALLY OR IS BADLY BROKEN OR DETERIORATED WILL BE REPLACED AS DIRECTED BY THE FIELD ENGINEER, AND WILL BE PAID FOR AT CONTRACT UNIT PRICES.
- THE CONTRACTOR SHALL NOTIFY WATER SYSTEMS DIVISION AT LEAST 2 WORKING DAYS IN ADVANCE OF WHEN FIRE HYDRANTS WILL BE TAKEN OUT OF SERVICE AND RETURNED TO SERVICE.
- ALL TRAFFIC CONTROL DEVICES SHALL COMPLY WITH THE CURRENT EDITION OF MANUAL FOR UNIFORM TRAFFIC CONTROL DEVICES.
- ALL TRAFFIC CONTROL SIGNS MUST BE INSTALLED BEFORE CONSTRUCTION BEGINS FOR EACH PHASE OF THE WORK AS DIRECTED BY THE FIELD ENGINEER. ALL SIGN LOCATIONS WILL BE SELECTED IN THE FIELD AND APPROVED BY THE FIELD ENGINEER. SIGN HEIGHT SHALL BE 7 FT. ABOVE THE SIDEWALK LEVEL TO THE BOTTOM OF SIGN.
- ALL DRUMS USED FOR TRAFFIC CONTROL MAY BE FILLED WITH SAND OR WATER BALLAST LIMITED TO 100 LBS. MAXIMUM PER DRUM.
- THE CONTRACTOR SHALL MAINTAIN AND KEEP OPEN ONE ACCESS TO LOCAL BUSINESSES AT ALL TIMES.
- ALL ADVANCE WARNING SIGNS AND ALL BARRICADES SHALL BE EQUIPPED WITH FLASHING WARNING LIGHTS, TYPE A, EXCEPT ALL CHANNELIZING BARRICADES SHALL HAVE STEADY BURNING WARNING LIGHTS, TYPE C.
- ALL WATER LINES CONSTRUCTED AS A PART OF THIS PROJECT SHALL HAVE A MINIMUM OF 48" COVER FROM FINISHED GRADE TO TOP OF PIPE.
- DELETED.
- DELETED.
- CONCRETE BLOCKING WILL BE INSTALLED AS REQUIRED AND IN ACCORDANCE WITH CITY OF ALBUQUERQUE STANDARD DRAWINGS OR AS DIRECTED BY THE ENGINEER.
- MANHOLE RIM ELEVATIONS SHOWN ON THESE PLANS ARE APPROXIMATE AND WILL VARY IN ACCORDANCE WITH FINISHED PAVEMENT ELEVATIONS.
- CONTRACTOR SHALL FIELD VERIFY LOCATION AND TYPE OF EXISTING UTILITIES TO BE ADJUSTED OR EXTENDED.
- WARNING: THE CITY SHALL BE RESPONSIBLE FOR OBTAINING NECESSARY CLEARANCE FROM THE STATE HISTORICAL PRESERVATION OFFICER (SHPO) FOR THE TAYLOR RANCH SITE AND ANY OTHER ARCHAEOLOGICAL SITES LOCATED WITHIN THE PROJECT LIMITS. IN THE EVENT THE CONTRACTOR ENCOUNTERS A PREVIOUSLY UNDISCOVERED ARCHAEOLOGICAL SITE, THE CONTRACTOR SHALL TERMINATE ALL FURTHER OPERATIONS IN THE IMMEDIATE AREA UNTIL THE SHPO HAS HAD THE OPPORTUNITY TO SURVEY THE SITE. WORK SHALL NOT RESUME UNTIL THE SHPO HAS DETERMINED THAT NO FURTHER ARCHAEOLOGICAL INVESTIGATION IS NECESSARY. THIS TERMINATION SHALL NOT PRECLUDE CONTINUATION OF WORK IN OTHER AREAS NOR SHALL IT ENTITLE THE CONTRACTOR TO ADDITIONAL PAYMENT IN ANY FORM, OTHER THAN A POSSIBLE EXTENSION OF TIME, UNLESS THE CONTRACTOR IS SUBSTANTIALLY PRECLUDED FROM WORKING ON THE ENTIRE PROJECT. THE ENGINEER, WITH CONCURRENCE OF THE SHPO, WILL DETERMINE OTHER AREAS WHERE THE CONTRACTOR MAY CONTINUE TO WORK. NO PROJECT WORK BETWEEN THE MANHOLES AT STATIONS 13+05 AND 17+55 ON MONTANO ROAD CLEARANCE OF THE TAYLOR RANCH SITE HAS BEEN OBTAINED. BETWEEN STATIONS 9+30 AND 13+57, INITIAL EARTH MOVING STAGES OF CONSTRUCTION SHALL BE CONDUCTED UNDER THE DIRECTION AND SURVEILLANCE OF THE CITY'S ARCHAEOLOGIST AND NO WORK IS TO COMMENCE IN THIS AREA UNTIL THE ARCHAEOLOGIST IS PRESENT. REFER TO PHASING DIAGRAM ON THIS SHEET. ALL ENVIRONMENTAL, ARCHAEOLOGICAL AND LEGAL CLEARANCES THAT MAY BE REQUIRED FOR THE BORROW PIT SITE SHALL BE OBTAINED BY THE CONTRACTOR.
- DESIGN FLOWS (Qs) ARE BASED ON THE "NORTH COORS DRAINAGE MANAGEMENT PLAN" DONE BY SCALON & ASSOCIATES FOR AMAFCA IN OCTOBER 1984.
- ALL DATA SHOWN HEREIN CONCERNING EXISTING UTILITIES HAVE BEEN OBTAINED FROM THE OWNERS OF THE UTILITIES, FROM RECORDS OF THE CITY OF ALBUQUERQUE, AND FROM FIELD OBSERVATIONS. THESE MAY OR MAY NOT BE ACCURATE. THE CONTRACTOR IS CAUTIONED THAT HE IS RESPONSIBLE FOR DETERMINING THE EXACT LOCATIONS AND FOR PROTECTION OF ALL LINES DURING CONSTRUCTION. UTILITY RELOCATIONS REQUIRED BY THE CONSTRUCTION OF THIS PROJECT ARE TO BE COORDINATED BY THE CONTRACTOR. NO ADDITIONAL COMPENSATION WILL BE ALLOWED FOR DELAYS OR INCONVENIENCE CAUSED BY UTILITY COMPANY WORK CREWS. THE CONTRACTOR MAY BE REQUIRED TO RESCHEDULE HIS ACTIVITIES TO ALLOW UTILITY CREWS TO PERFORM THEIR REQUIRED WORK. ANY DAMAGE TO LINES, VALVES, METERS, ETC., WILL BE REPAIRED OR REPLACED BY THE CONTRACTOR AT HIS EXPENSE.

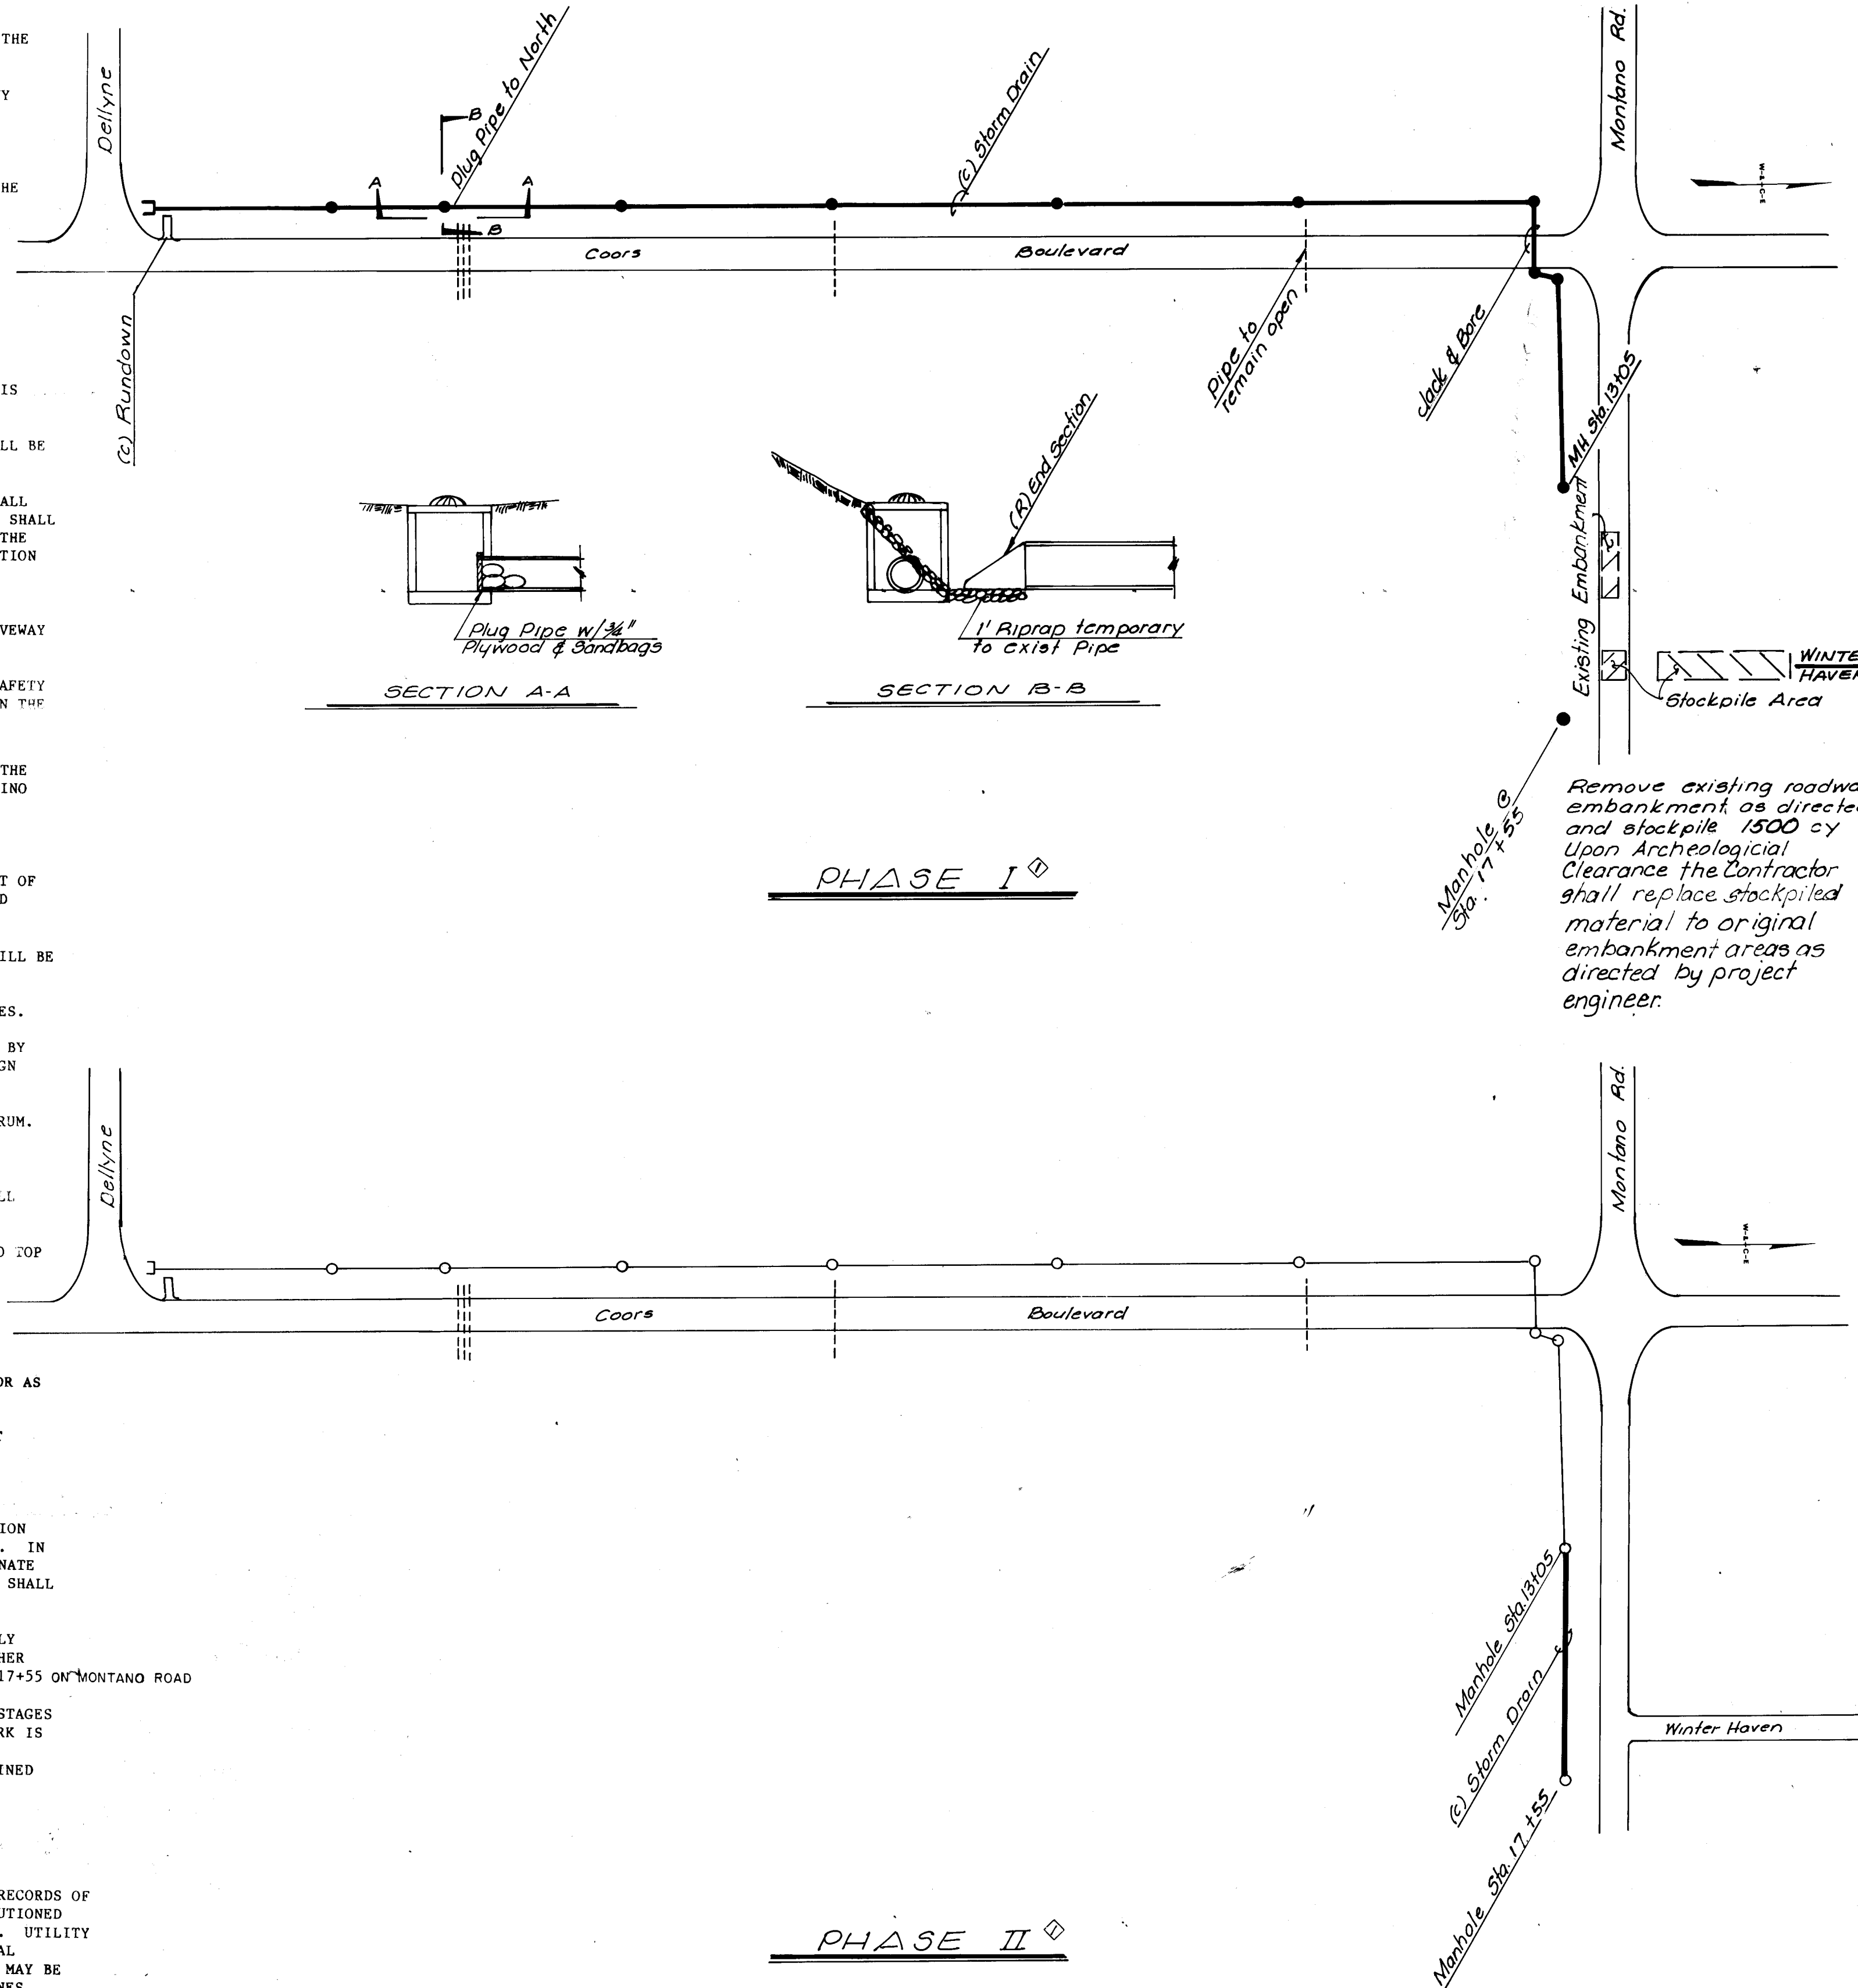

NOTE
Sandbagging of inlets and temporary plugs (new lines) shall remain until storm drain from Sta. 13+05 to Sta. 17+55 is installed. When storm drain is complete, the existing pipes under Coors Blvd. will be plugged. To be paid for as "Temporary Sandbagging, Plugging and Riprap" by the "Lump Sum". This item will only be required if the archaeological clearance is not done prior to the storm drain construction.

LEGEND


EXISTING UTILITIES	NEW
G — GAS	
W — WATER	
SAS — SANITARY SEWER	
SD — STORM DRAIN	
MH — MANHOLE	
WV — WATER VALVE	
UP — UTILITY POLE	
LP — LIGHT POLE	
FH — FIRE HYDRANT	
CB — CATCH BASIN	
TS — TRAFFIC SIGNAL	
UT — UNDERGROUND TEL. CABLE	
PB — PULL BOX	
SP — SIGN POST	
TCB — TRAFFIC CONTROL BOX	
WM — WATER METER	
UE — UNDERGROUND ELEC. CABLE	
CATV — UNDERGROUND CABLE T.V.	

PLAN

CONCRETE DRIVEPAD TO BE CONSTRUCTED	W =
VALLEY GUTTER TO BE CONSTRUCTED	
CONCRETE SIDEWALK TO BE CONSTRUCTED	
PAVEMENT TO BE REMOVED	
CONCRETE MEDIAN PAVEMENT TO BE CONSTRUCTED	
REMOVE	(R)
CONSTRUCT	(C)
INSTALL	(I)
FLOWLINE	E
CITY OF ALBUQUERQUE	C.O.A.
PAVEMENT GRADE	PG
TOP OF CURB	TC


1	2	3	4	5	6	7	8	9	10	11	12
26	31	63	02	89							

CITY OF ALBUQUERQUE			
TRANSPORTATION DEPARTMENT			
MONTANO ROAD			
GENERAL NOTES			
APPROVALS	ENGINEER	DATE	APPROVALS
City Engineer	W. J. W.	5/14/87	Liquid Waste
See Design	W. J. W.	5/14/87	Traffic
A.C.E. - Hydrology	W. J. W.	5/14/87	Water
DRAWING NO.	3163	MAY NO.	SHEET 2 OF 10

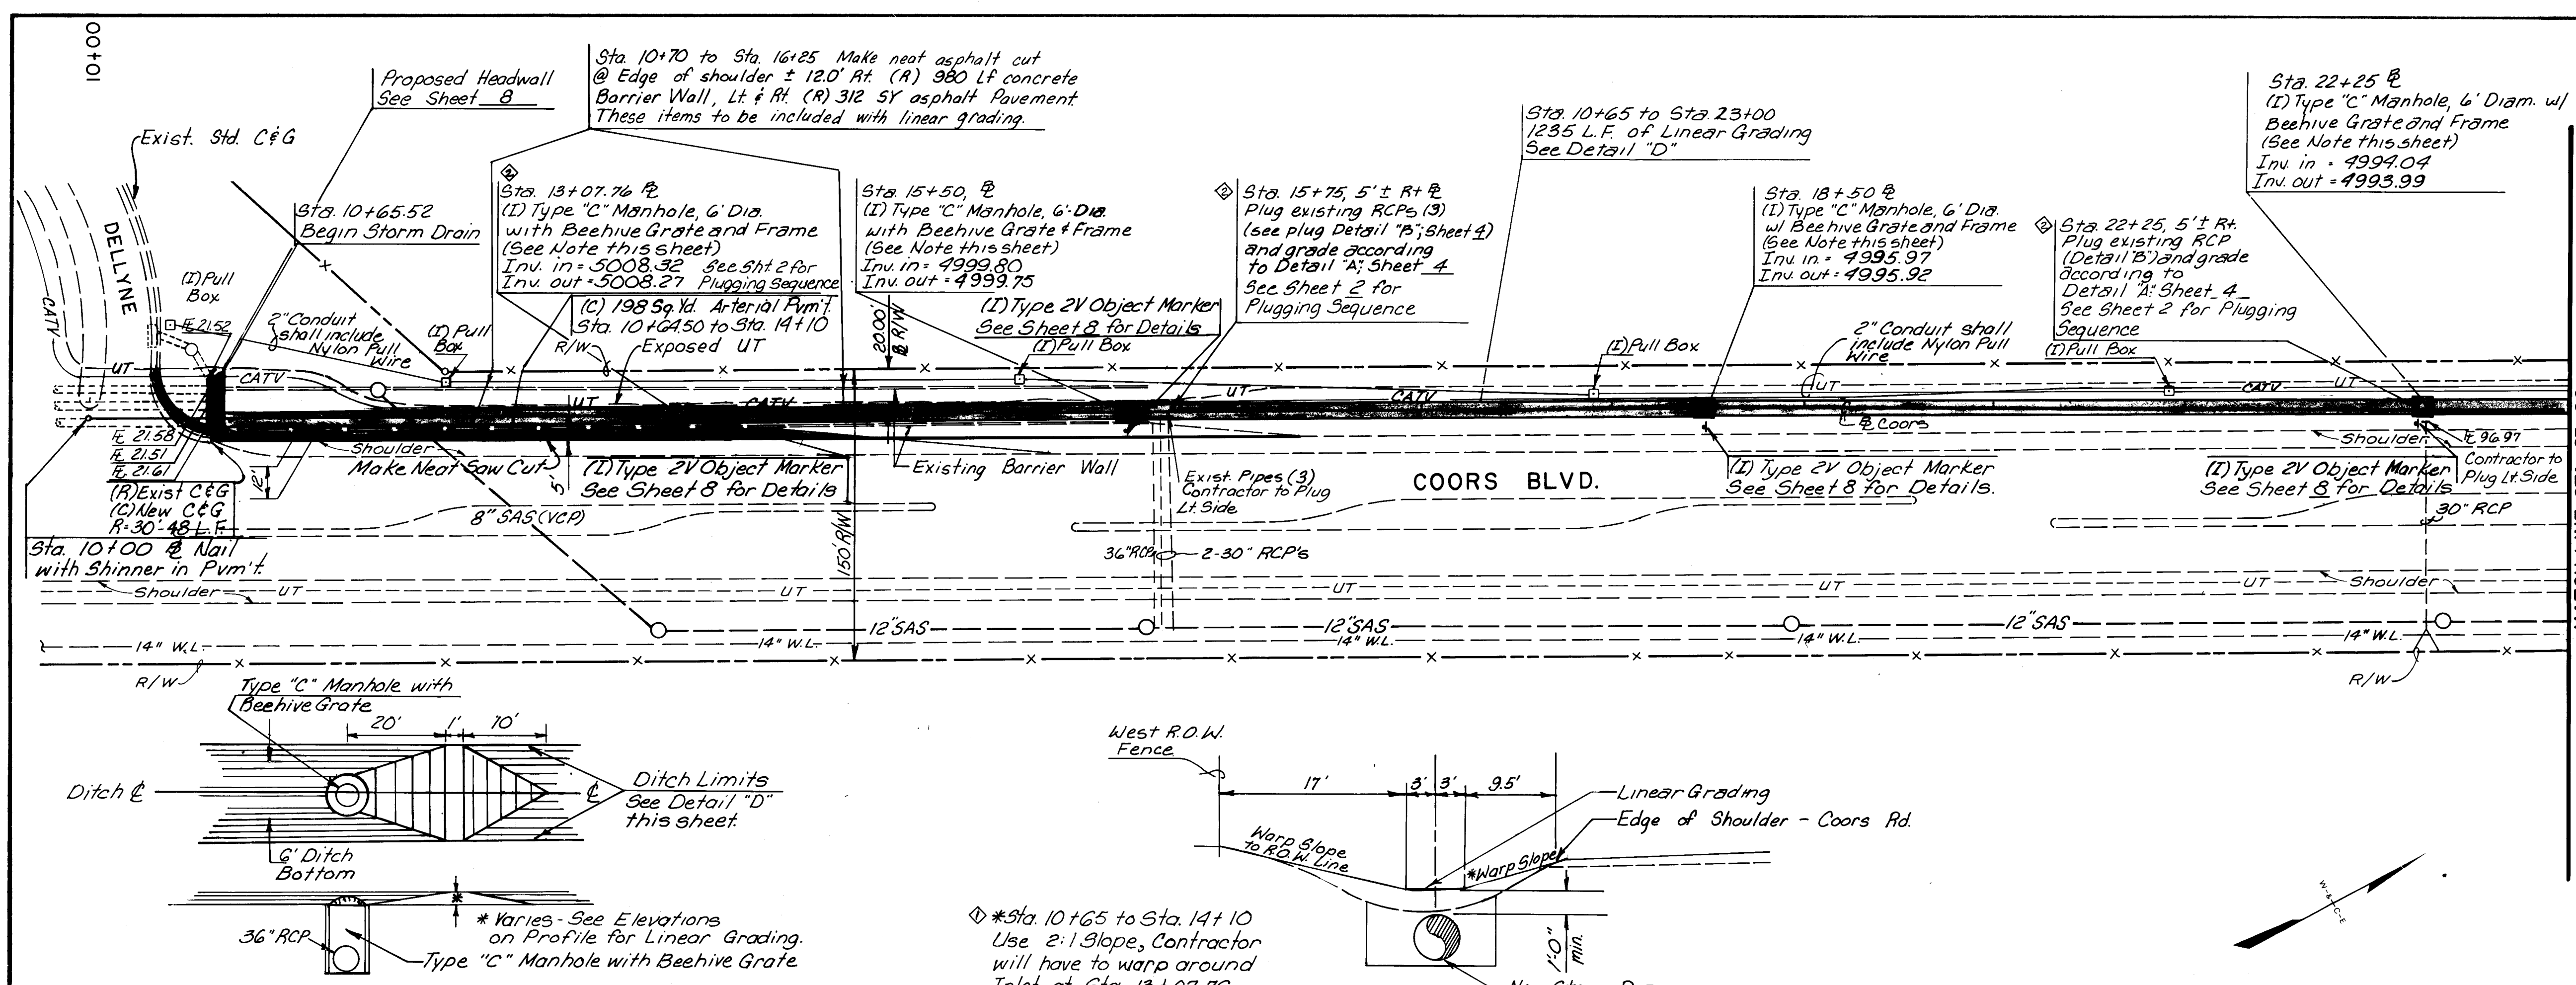


TYPICAL DYKE DETAIL

DETAIL "D"

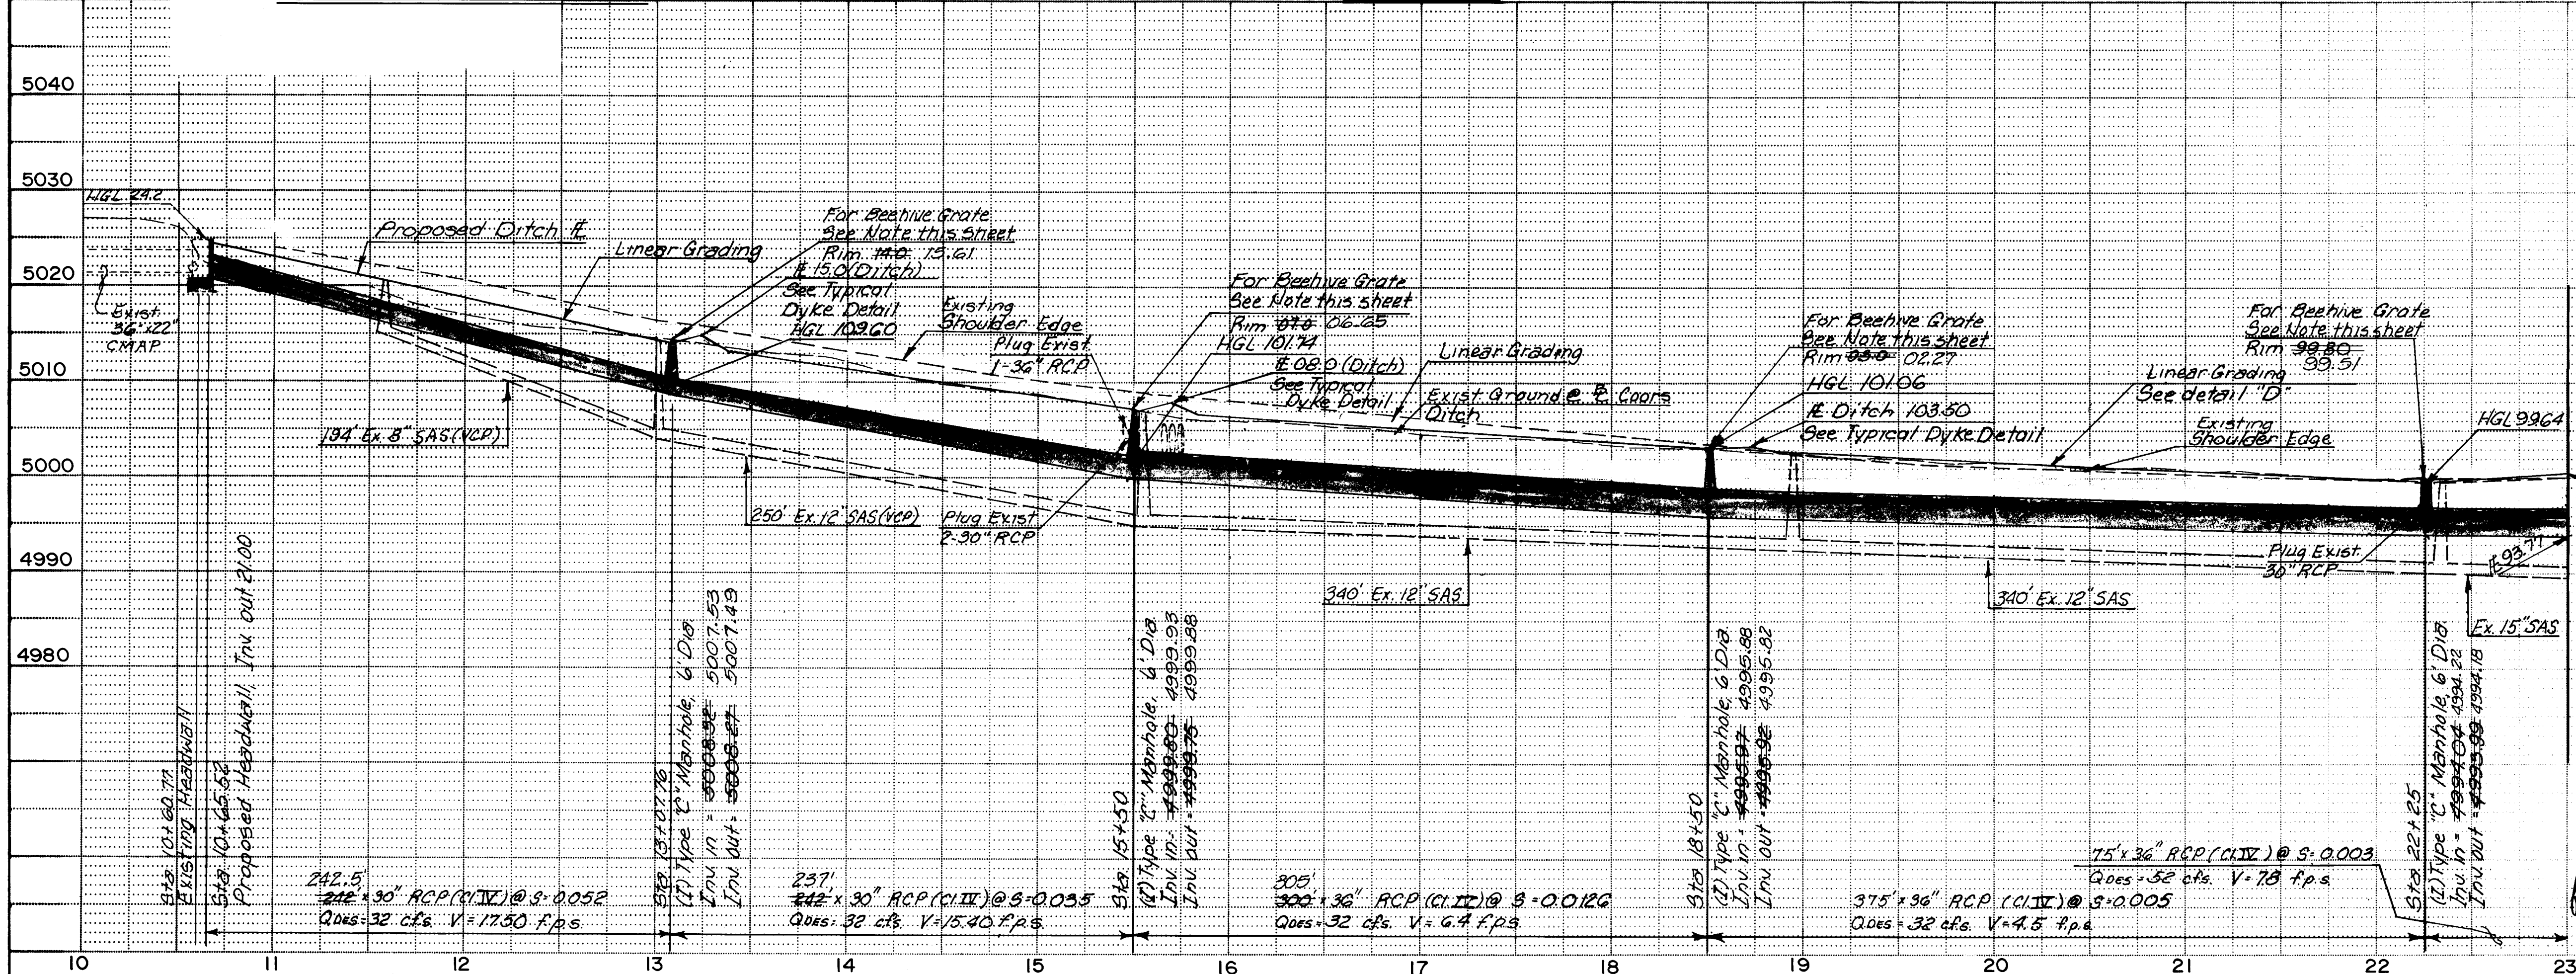

NOTE:
For Construction Phasing/
Sequence. See Sheet 2

AS BUILT INFORMATION CONTRACTOR: MOUNTAIN STATES CONST. DRAWING NO.: 12-15-88 DATE: 12-88 PROJECT: COORS BLVD. STORM DRAIN ELEV. 5058.89		BENCH MARKS A Brass Tablet Stamped "M448-64" In the median to the entrance to the La Luz Condominium										
ENGINEER'S SEAL 		REVISIONS <table border="1"> <thead> <tr> <th>NO.</th> <th>DATE</th> <th>REMARKS</th> </tr> </thead> <tbody> <tr> <td>1</td> <td>12/88</td> <td>Revised to Add Note to Refer to Plug Box Sht. 2</td> </tr> <tr> <td>2</td> <td>12/88</td> <td>Revised to Add Note for Inlet Sta. 13+07.76</td> </tr> </tbody> </table>		NO.	DATE	REMARKS	1	12/88	Revised to Add Note to Refer to Plug Box Sht. 2	2	12/88	Revised to Add Note for Inlet Sta. 13+07.76
NO.	DATE	REMARKS										
1	12/88	Revised to Add Note to Refer to Plug Box Sht. 2										
2	12/88	Revised to Add Note for Inlet Sta. 13+07.76										
CITY OF ALBUQUERQUE TRANSPORTATION DEPARTMENT COORS BLVD. STORM DRAIN MONTANO TO DELLYNE												
APPROVALS ENGINEER: [Signature] DATE: 12/87 A.C.E. Design: [Signature] DATE: 12/87 A.C.E. Hydrology: [Signature] DATE: 12/87		APPROVALS ENGINEER: [Signature] DATE: 5-14-87 A.C.E. Design: [Signature] DATE: 5-14-87 A.C.E. Hydrology: [Signature] DATE: 5-14-87										
DRAWING NO. 3163		MAP NO. E-12 SHEET 3 OF 10										

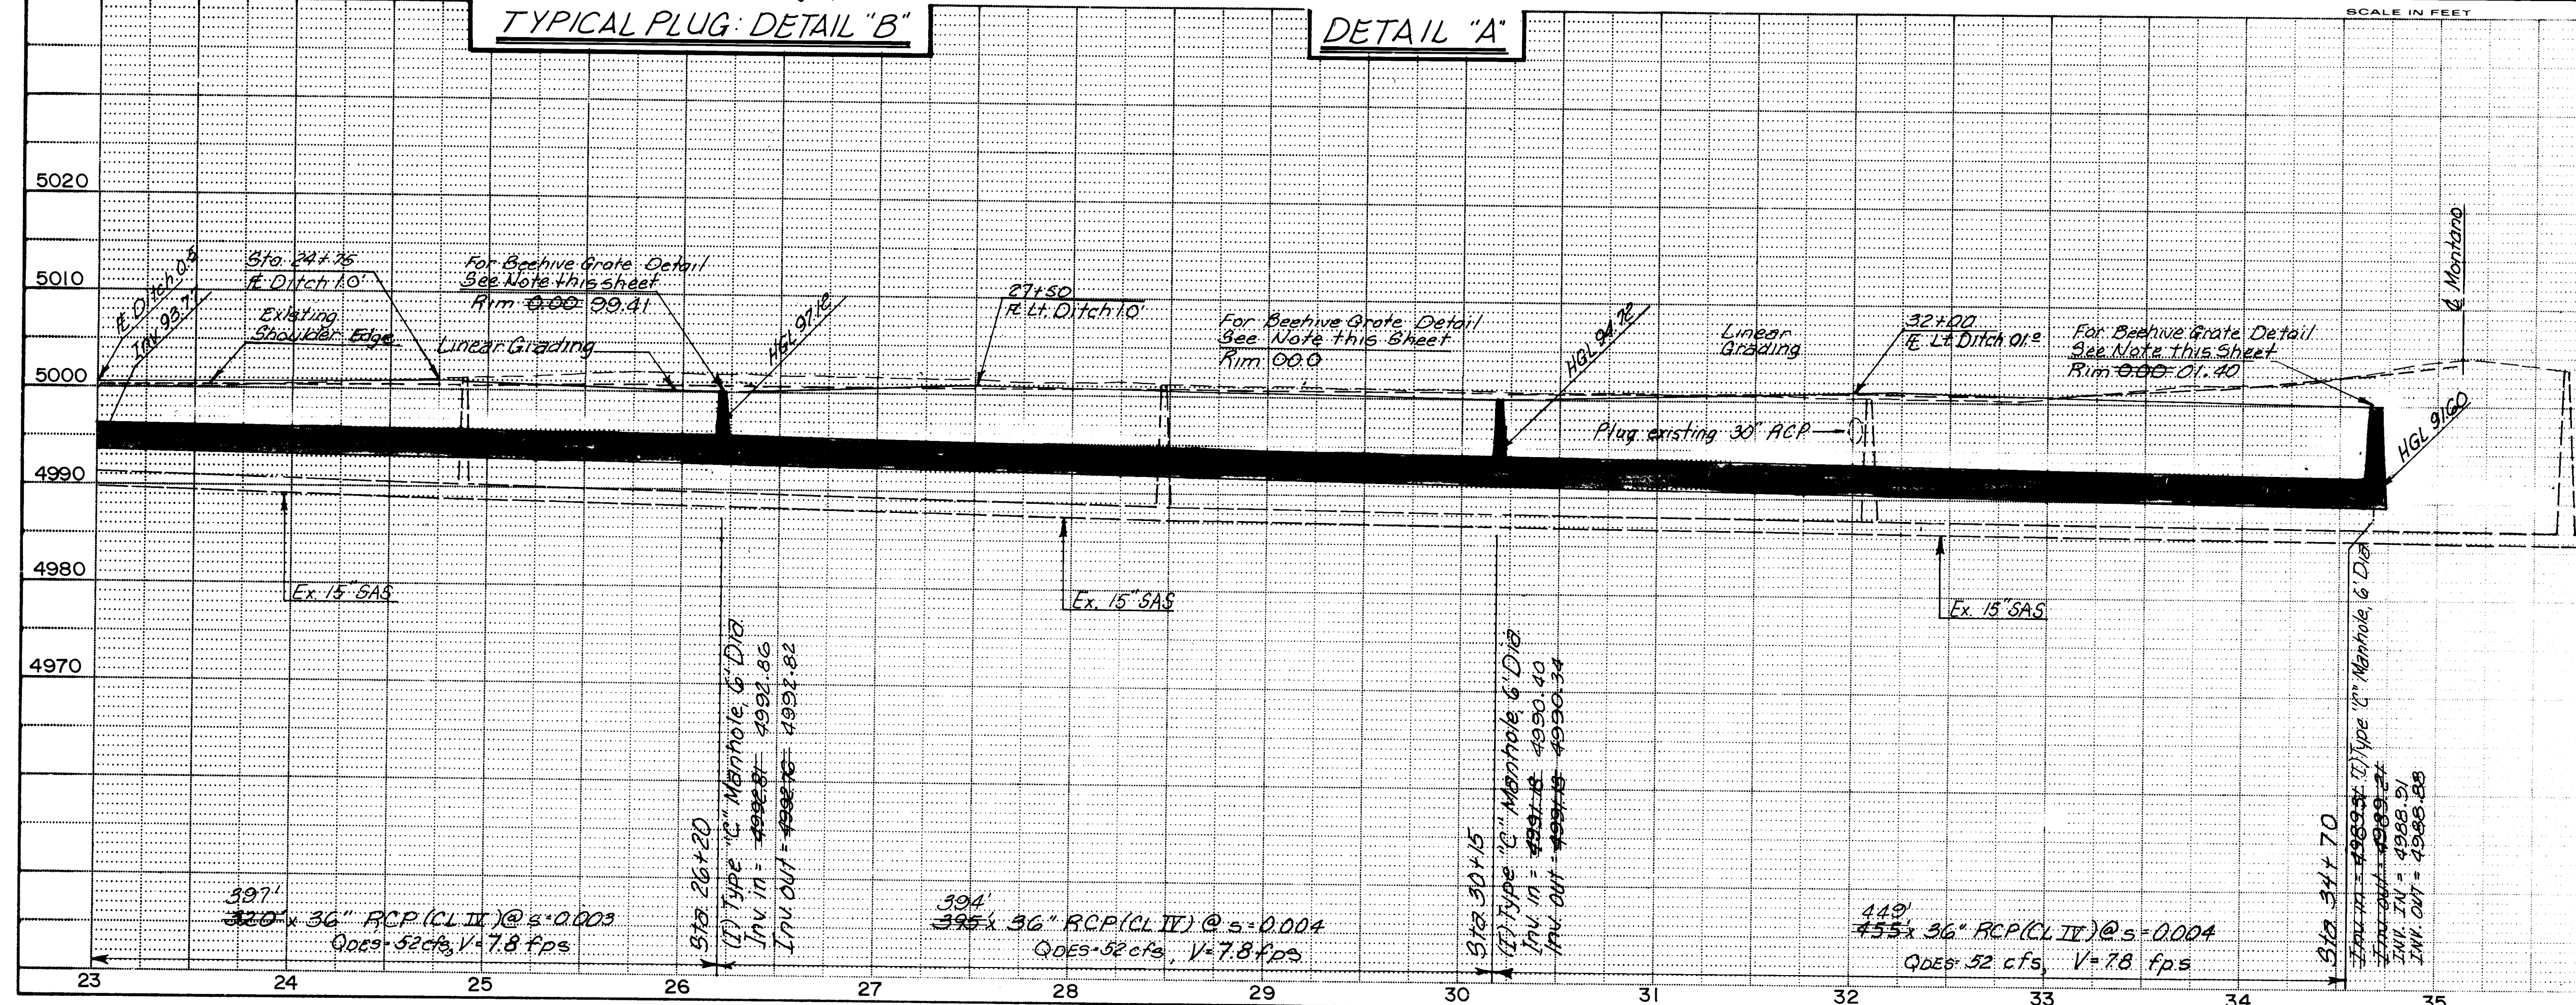


Contractor shall support existing utility lines in this area during construction time.

Note:
Manhole Frames and Covers
shall be High Beehive Grate
and Frame type.
Neenah Foundry Co. type
R-2561-A with Security Bolted
System or equal.

CITY OF ALBUQUERQUE					
TRANSPORTATION DEPARTMENT					
COORS BLVD. STORM DRAIN MONTANO TO DELLYNE					
APPROVALS	ENGINEER	DATE	APPROVALS	ENGINEER	DATE
City Engineer	<i>[Signature]</i>	6/10/87	Liquid Waste	W/W	5-19-87
CEE Design	<i>[Signature]</i>	6/14/87	Traffic	MA DWH	5/14/87
CEE - Hydrology	<i>[Signature]</i>	6/24/87	Water	W/W	5-19-87

Excavation Area
Stockpile Area

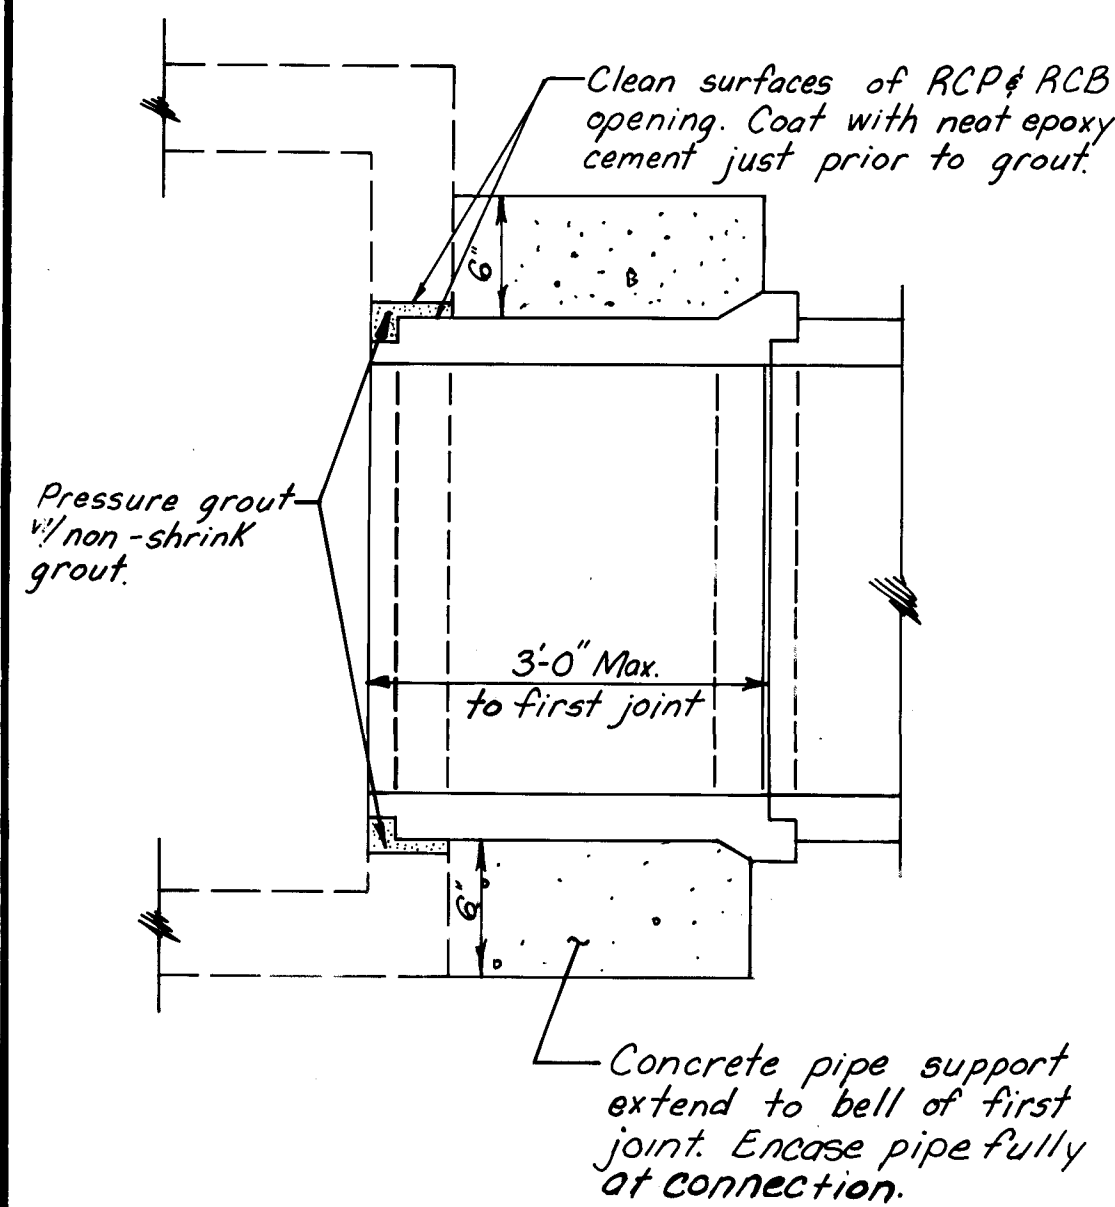

DETAIL "A"*

Connection Detail to CBC
*Note: AMAFCA shall be notified (2) Two Working Days Prior to Commencing Work on the C.B.C. (884-2215)

MATCH LINE STA. 12+50

Sta. 13+05 ~26' Rt & Const.
(1) Type "E" Manhole (6' dia.)
Inv. In. 4982.81
Inv. Out 4982.76
Rim El 4990.70±
(1) 450' x 36" RCP (E)(C.I. V)
S=0.0127
Build to Temporary Fill and Cap.

Sta. 15+50 to Sta. 17+85
(C.I.O.) Access Road for AMAFCA. See Cross Section Sheet 10 for details.
Borrow per Section 205 of Specifications, 95% Max. Density. Cost of construction shall be considered incidental to completion of project.

Sta. 17+55, 26' Rt. @ Con.
(1) Type "E" Manhole (6' Dia.)
Inv. In. = 4977.36, Inv. Out = 4976.86
Rim Elev. 4983.35±
(1) 20' x 42" R.C.P. (N)(C.I. V)
S=0.0127
Stub out 4' x 42" R.C.P. (S)(C.I. V)
Build to Temporary Fill Grade & Cap.


Remove, Stockpile and Replace roadway embankment 1800 cy. Removal of material to take place under the strict supervision of the City's archaeologist. Material to be replaced only after archaeological clearance by the SHPO has been granted. Stockpiling of the material is to take place at the intersection of Winter Haven Road & Montano Rd. or as directed by the Project Engineer.

Existing Type III Barricades to remain except for Temporary Removal during construction. Any signs damaged shall be replaced. Signs must be in place during nonworking hours.

Regrade Exist. M.H.
Rim Elev. 85.±
(A) 6' x 6' x 5" Concrete Slab @ Opening in CBC.
Contractor to dispose of Slab

Deflect Pipe to Max. Angle allowed without damaging the Existing C.B.C.

For Connection Details see Detail "A" this sheet.

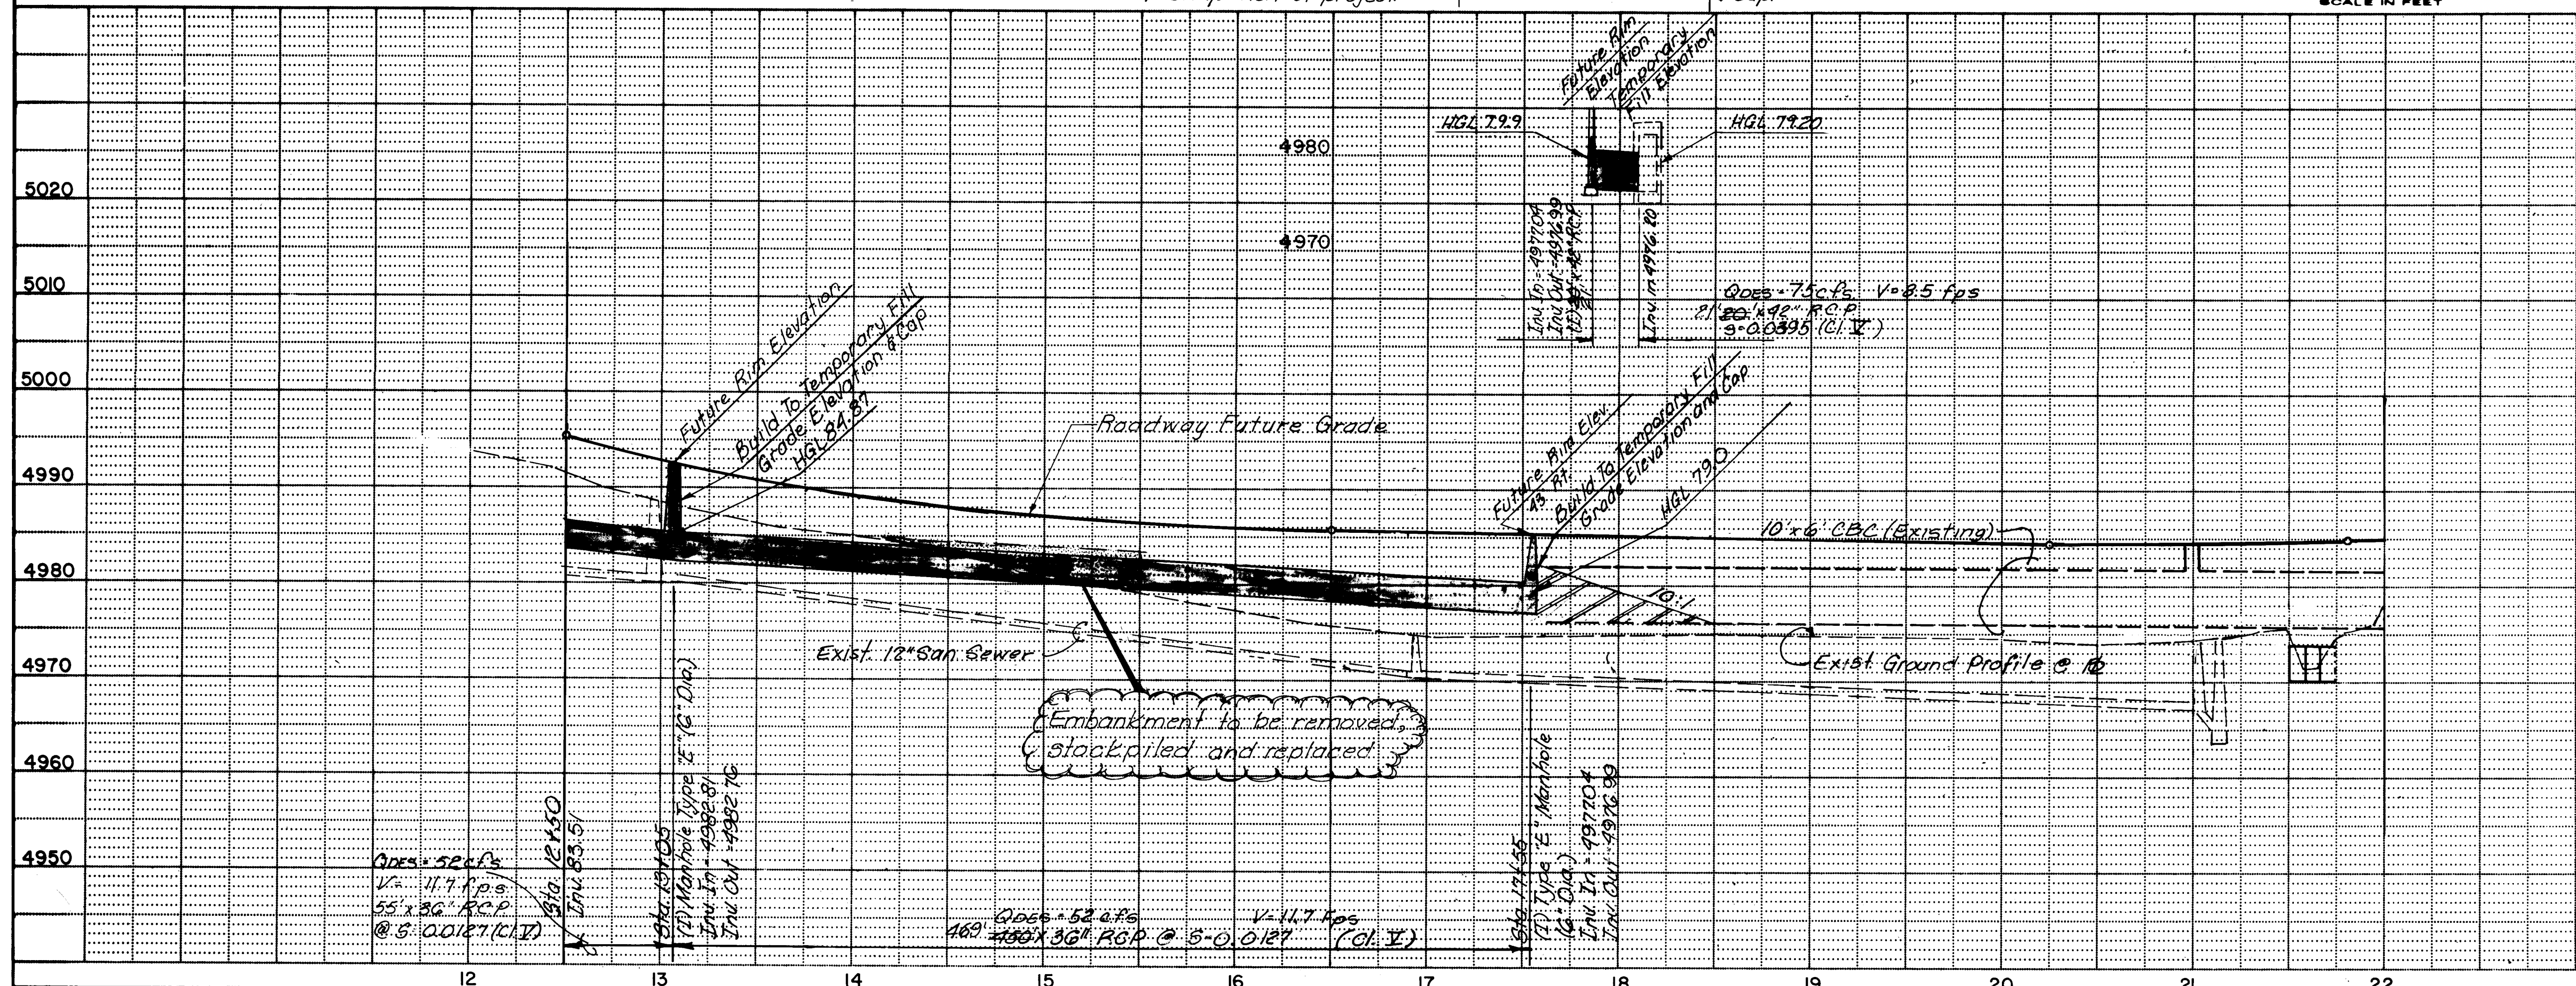

1 2 3 4 5 6 7 8 9 10 11 12
26 2 1 7 5 8 7

CITY OF ALBUQUERQUE
TRANSPORTATION DEPARTMENT


MONTANO ROAD
STORM DRAIN

APPROVALS	ENGINEER	DATE	APPROVALS	ENGINEER	DATE
City Engineer	[Signature]	6/1/87	Liquid Waste	WJW	5-18-87
A.C.E.-Design	[Signature]	6/1/87	Traffic	NADWH	5/4/87
A.C.E.-Hydrology	[Signature]	6/1/87	Water	WJW	5-18-87
AMAFCA Engineer	[Signature]	2/4/87			

DRAWING NO. 3163 MAP NO. E-12 SHEET 6 OF 10


WILSON & COMPANY
ENGINEERS & ARCHITECTS
ALBUQUERQUE, NEW MEXICO

12-15-88

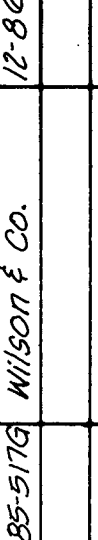ENGINEER'S SEAL		SURVEY INFORMATION		BENCH MARKS		AS BUILT INFORMATION	
		FIELD NOTES		A 3 1/4" ALUMINUM TABLET STAMPED		CONTRACTOR MONTANO STATES COR. 87.	
		NO.	BY	"NM 448-NW 1984" SET FLUSH WITH THE		WORK BY BARNARD SURVEYING DATE 88	
		95-5176	Wilson & Co.	NORTH CONCRETE MEDIAN NOSE AT THE		INSPECTED BY DATE 88	
				INTERSECTION OF COORS RD. & MONTANO		FIELD STAMPE BY Cor A DATE 0-88	
				VERIFICATION BY Cor A DATE 12-88		DRAWN BY Wilson & Co. DATE 12-88	
				ELEV. = 5006.41		MICRO-FILM INFORMATION	
						RECORDED BY DATE	
						NO	

SEE SHEET 5 FOR PROFILE

Sta. 7+80 to 8+30.35 Montano Road
(R) 140 L.F. Existing 18" CMP - PLUG LT. SIDE
(R) & (C) 80 L.F. Standard Curb & Gutter
(R) & (C) 95 SY Arterial Pavement
(R) & (C) 20 L.F. Mountable Curb - Roll Type
(R) & (C) 38 SY Patterned Concrete Median Pavement
(C) 2- Single Type "C" Catch Basins (8+00, Lt. & Rt.)
(I) 40' x 18" RCP (CI.I) - Connect Existing Catch Basins
(2) to new Type "C" Catch Basins
(I) 8' x 18" RCP (CI.I) - Connect New Type "C" Catch Basins
(I) 4' Dia. Type "E" Manhole (8+26.56 Rt.)
(I) 24' x 24" RCP (CI.I) - Connect Type "C" Catch Basin to New Manhole
Clean Debris from 2-Existing Catch Basins

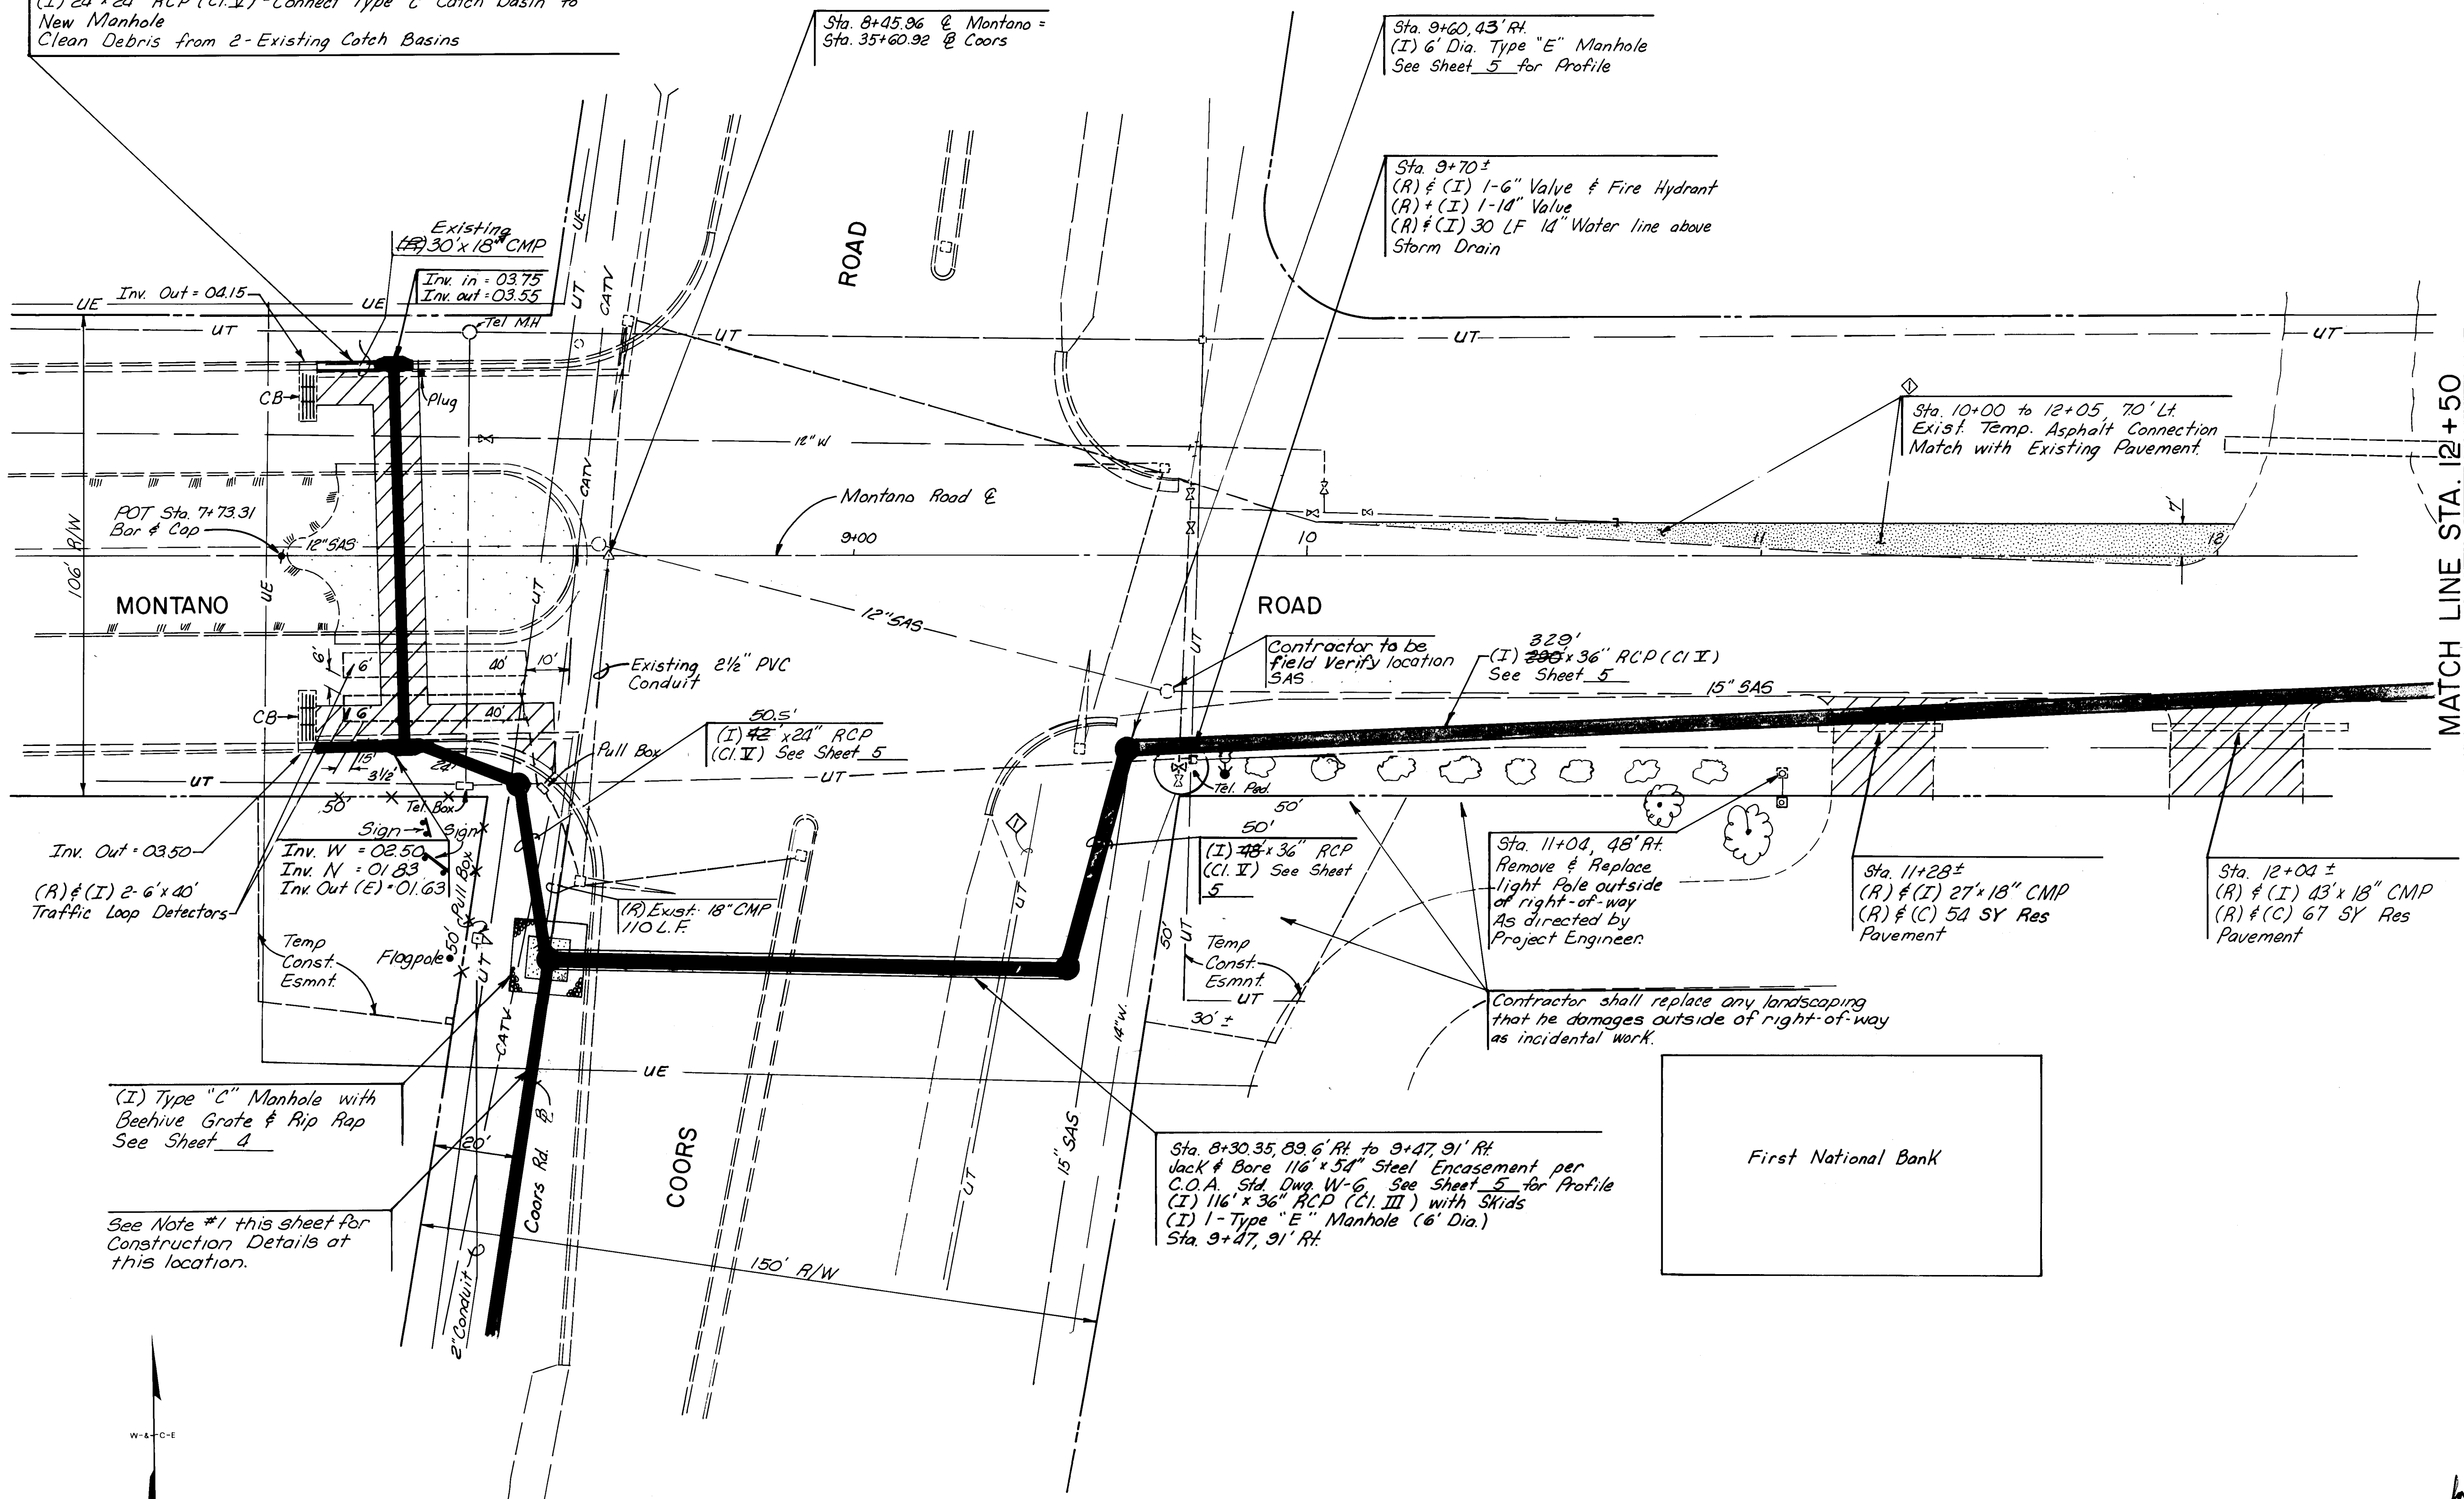

Scale = 1" = 20'

NOTES

- Possible relocation of underground Telephone cables, Television cables, Electric conduit and Traffic conduit & Poles shall be coordinated with Mountain Bell, Jones Inter-cable, PNM and City Traffic Engineering Respectively.
- One Access to the First National Bank shall be kept open and maintained at all times.
- Locate and adjust sanitary sewer and water service to First National Bank.
- Contractor shall replace fence, flagpole & signs to original condition if moved for construction.



AS BUILT INFORMATION			BENCH MARKS			SURVEY INFORMATION			ENGINEER'S SEAL		
CONTRACTOR	WILSON & COMPANY	DATE	12-15-88	STATION	12+50	NO.	5176	DATE	12-88	BY	Wilson & Co.
INSPECTOR	WILSON & COMPANY	DATE	12-88	STATION	12+50	NO.	5176	DATE	12-88	BY	Wilson & Co.
FIELD	WILSON & COMPANY	DATE	12-88	STATION	12+50	NO.	5176	DATE	12-88	BY	Wilson & Co.
VERIFICATION	WILSON & COMPANY	DATE	12-88	STATION	12+50	NO.	5176	DATE	12-88	BY	Wilson & Co.
MICRO-FILM INFORMATION			RECORDED BY			DATE			NO.		

1 2 3 4 5 6 7 8 9 10 11 12




26 3 1 6 3 0 7 8 9

CITY OF ALBUQUERQUE					
TRANSPORTATION DEPARTMENT					
MONTANO RD. / COORS BLVD.					
INTERSECTION PLAN					
APPROVALS	ENGINEER	DATE	APPROVALS	ENGINEER	DATE
City Engineer	W. B. B.	12/15/88	Liquid Waste	W. B. B.	5-14-87
A.C.E. Design	W. B. B.	12/15/88	Traffic	W. B. B.	5-14-87
A.C.E. Hydrology	W. B. B.	12/15/88	Water	W. B. B.	5-14-87
DRAWING NO.		MAP NO.		SHEET 7 OF 10	
3163		E-12			





WILSON & COMPANY
ENGINEERS & ARCHITECTS
ALBUQUERQUE, NEW MEXICO

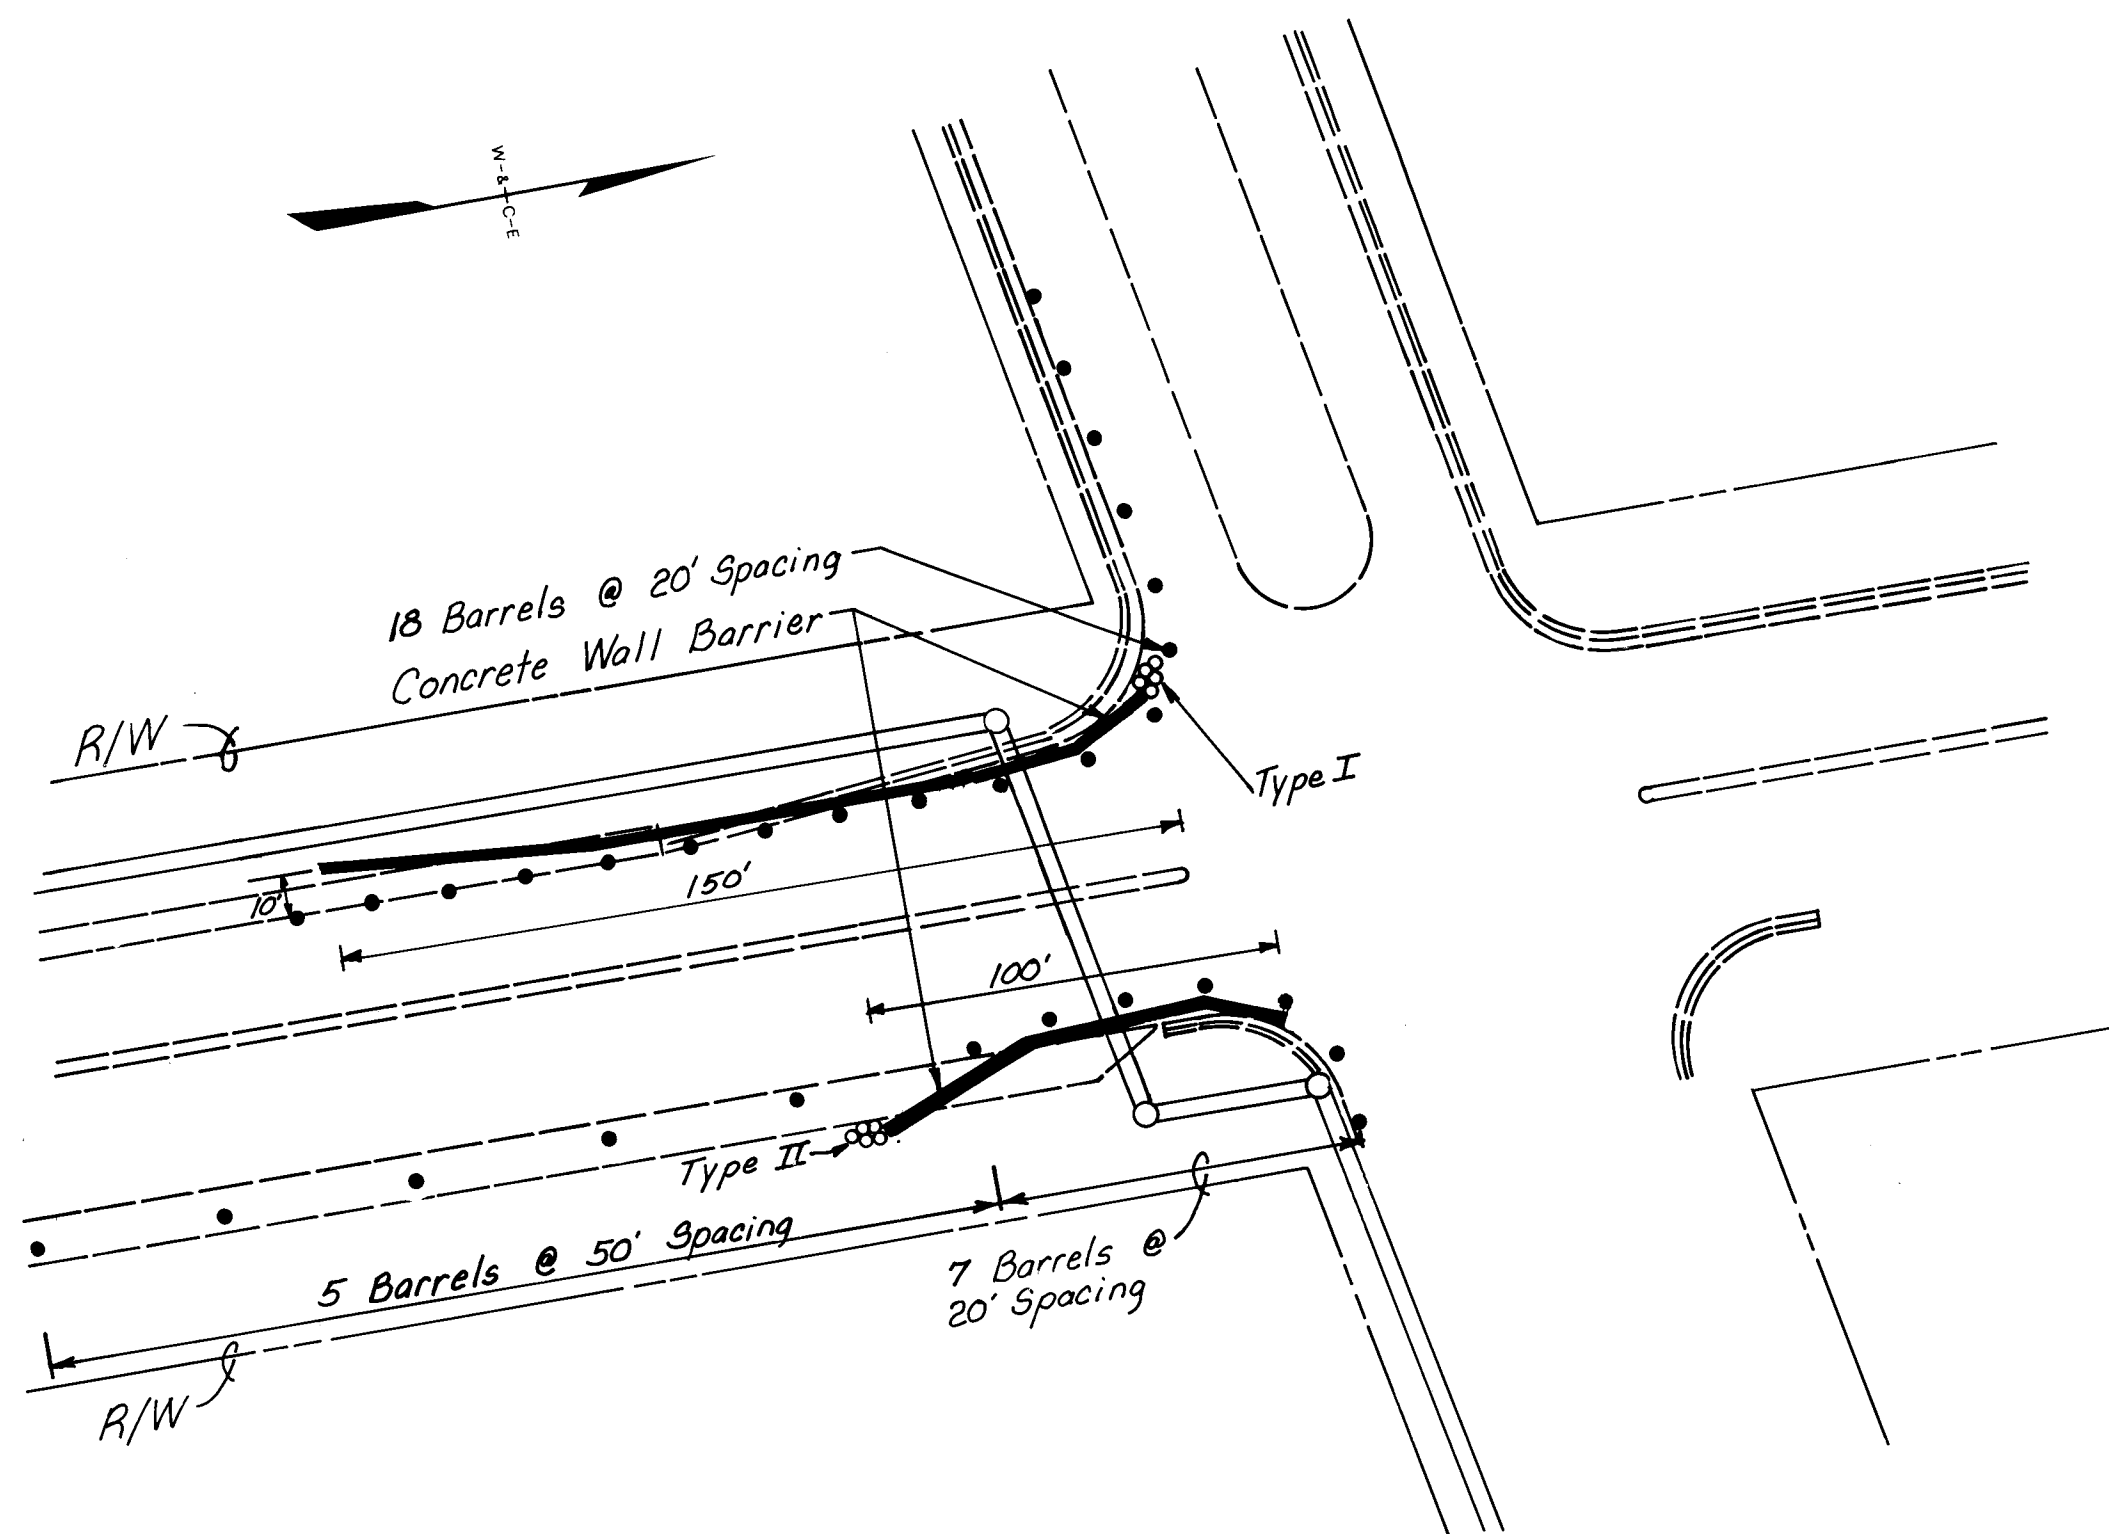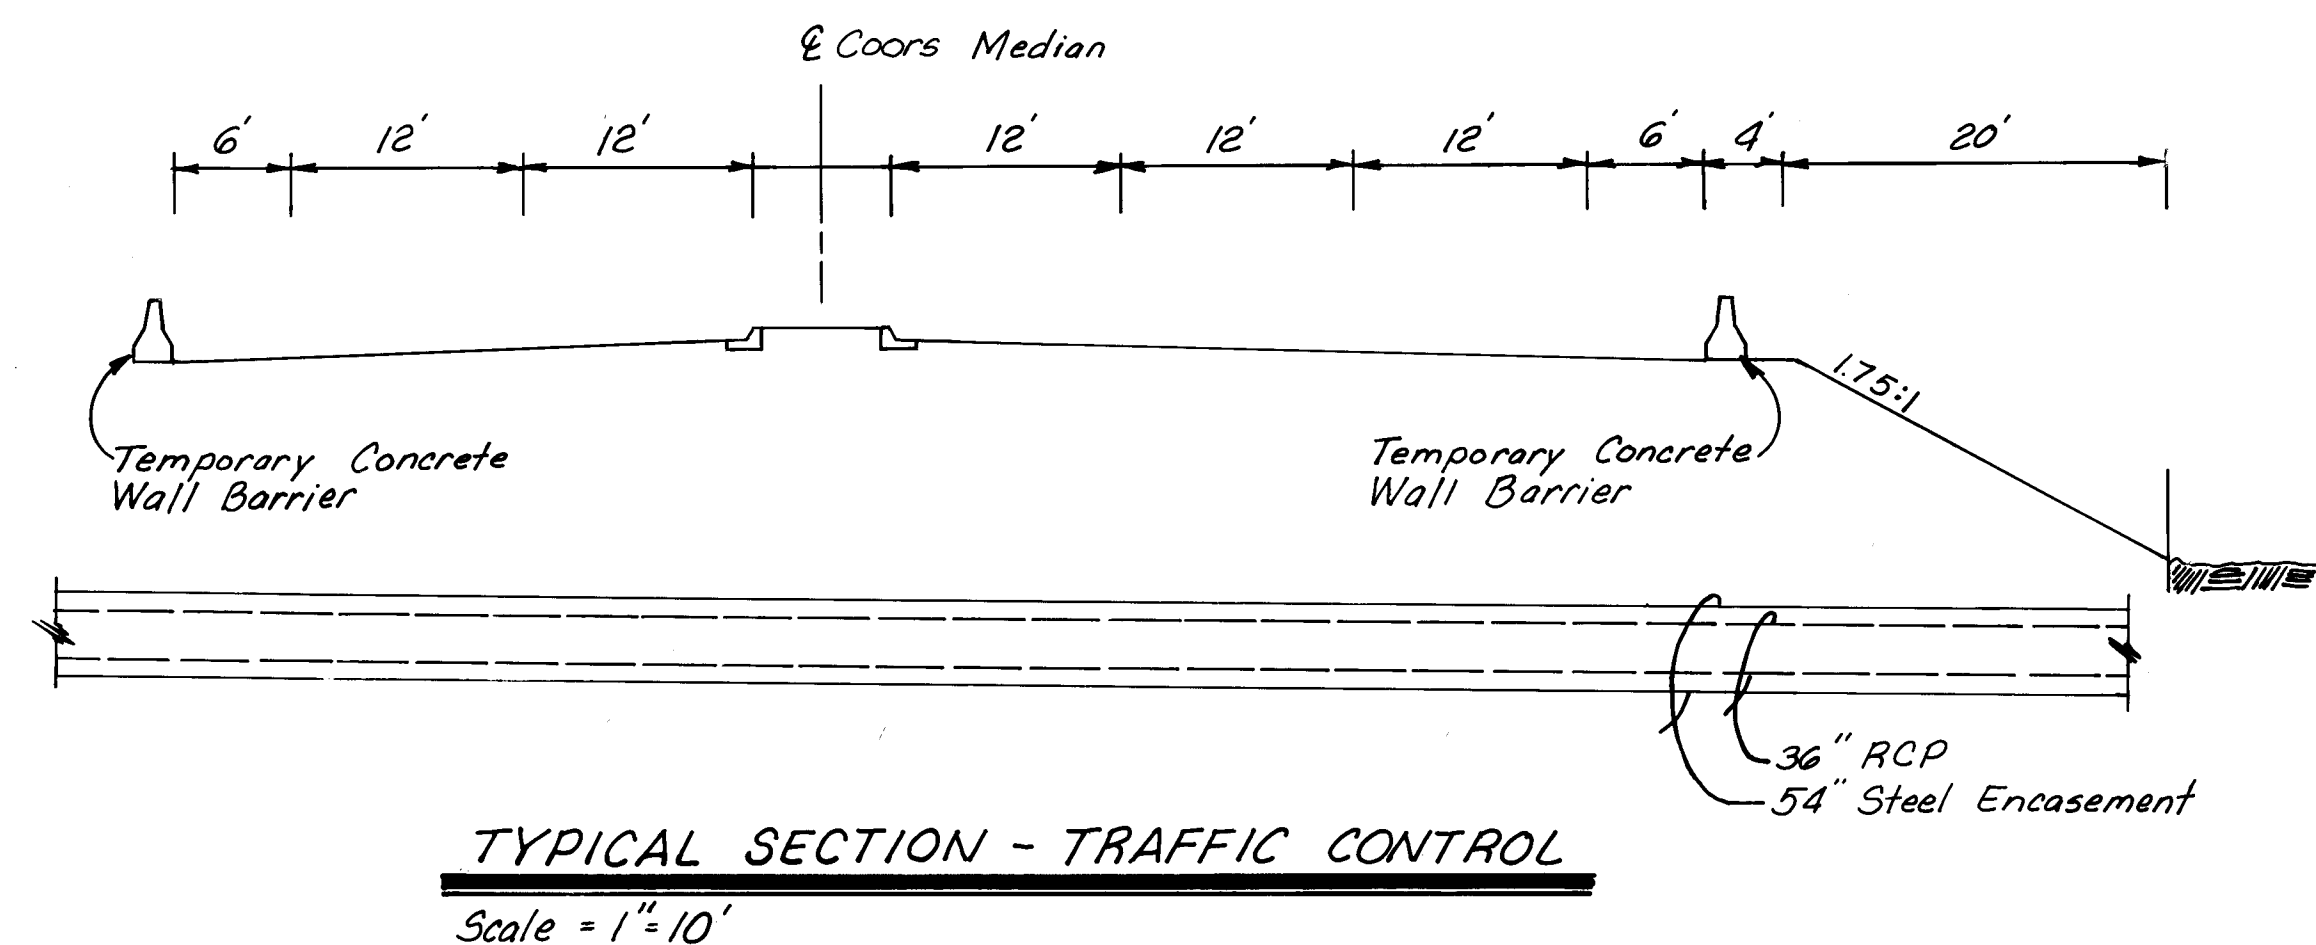

- LEGEND**
- Barrel
 - Sign
 - ⊗ Impact Attenuator

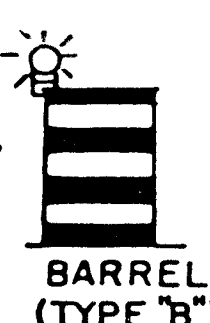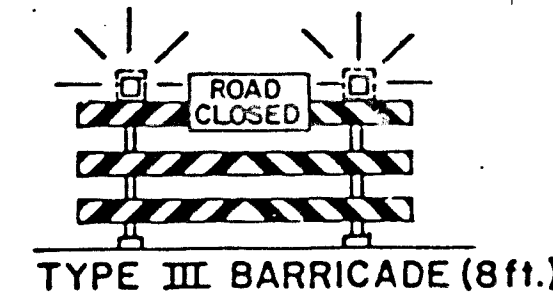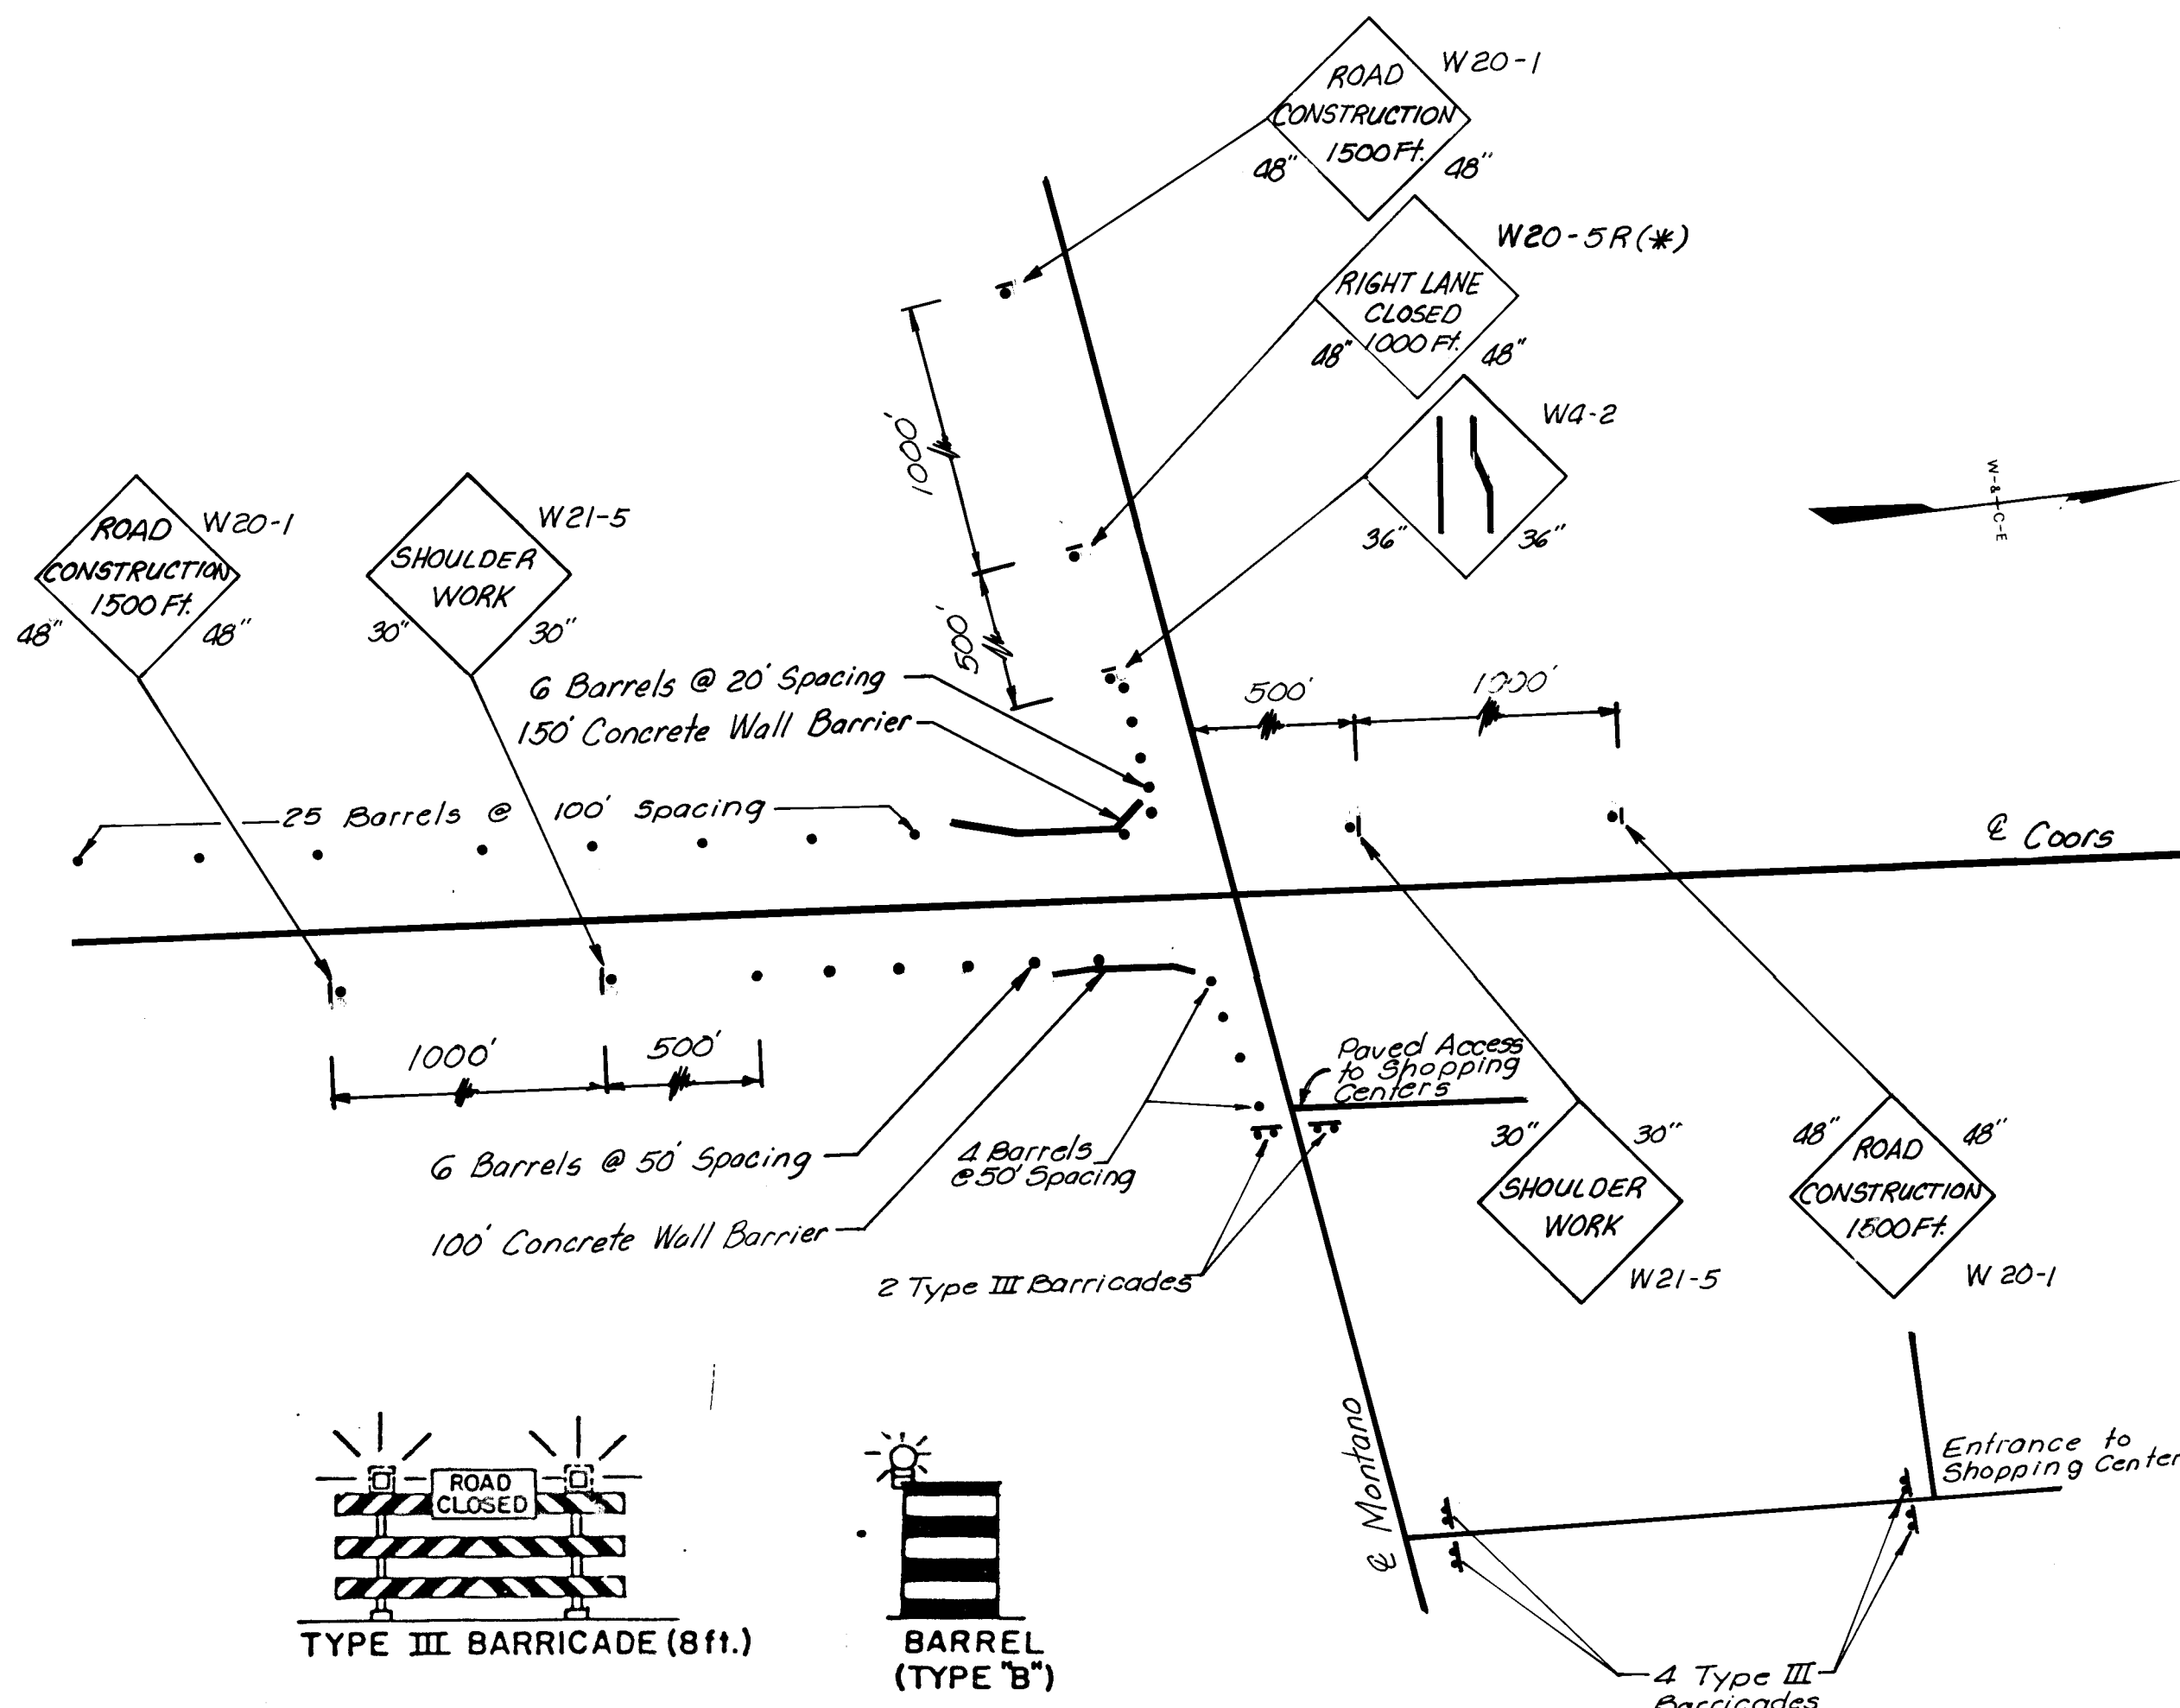

CONSTRUCTION SIGNING LAYOUT
Not to scale

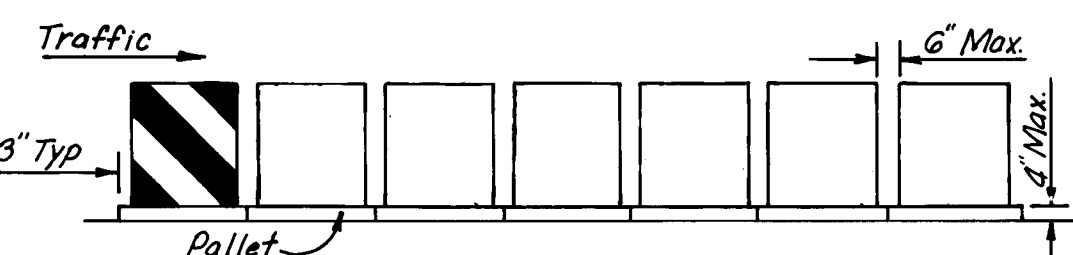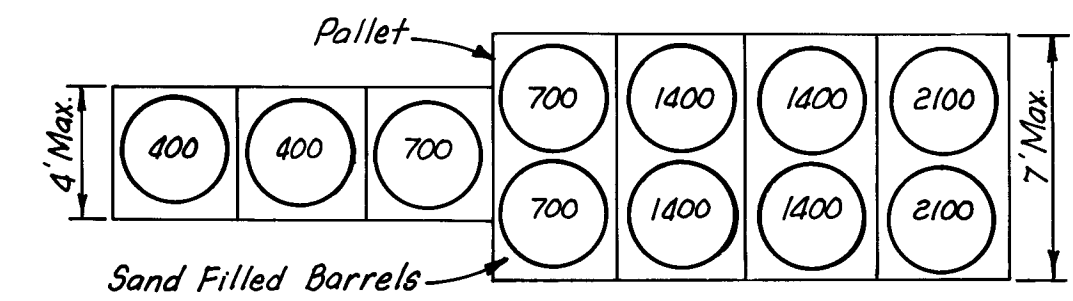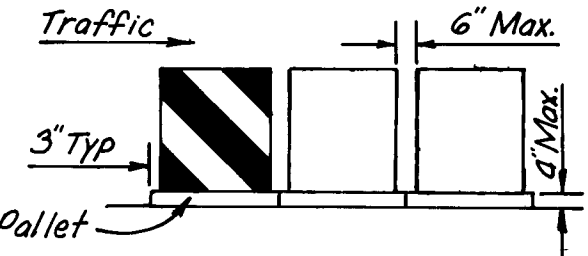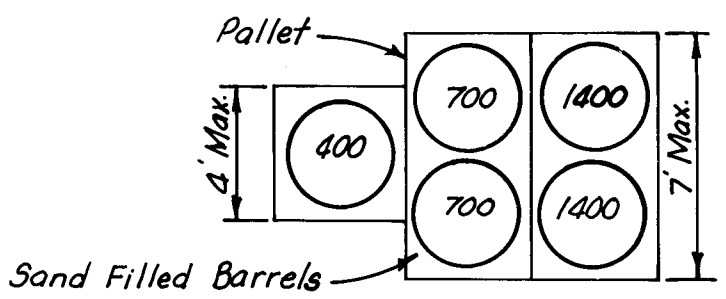

TRAFFIC CONTROL - LAYOUT
Scale = 1" = 50'

NOTES

1. All assembly, transportation to site, erection of the individual modules and the crash cushion as a whole shall be done in accordance with the manufacturers recommendations.
2. The color of the modules in an individual crash cushion shall be yellow unless otherwise indicated.
3. Sand shall be clean, dry granular sand.

TRAFFIC CONTROL NOTES

1. Coors Blvd. Traffic Lanes are not to be blocked by excavations, equipment, or materials at any time.
2. Montano Rd (West of Coors) is not to be closed to traffic at any time. If necessary, traffic can be detoured to one side of the median for short periods of time. The Contractor will be required to submit an appropriate barricading plan in order to obtain a permit for a temporary detour.

Weight of sand (lbs)	Height of cone (in.)	Module Diameter (in.)	Module Height (in.)
200	12.6"	35.7" Top 27.5" Bottom	36.2"
400	18"	"	"
700	8.0"	"	"
1400	"	"	"
2100	"	35.7" Top 30.25" Bottom	45.50"

MODULE COMPONENTS

1 2 3 4 5 6 7 8 9 10 11 12
36 31630989

CITY OF ALBUQUERQUE
TRANSPORTATION DEPARTMENT

**COORS BLVD. TRAFFIC CONTROL
MONTANO TO DELLYNE**

APPROVALS	ENGINEER	DATE	APPROVALS	ENGINEER	DATE
City Engineer	W. L. S.	6/12/87	Liquid Waste	W. L. S.	5-18-87
A.C.E.-Design	W. L. S.	6/12/87	Traffic	N. D. W. H.	5/14/87
A.C.E.-Hydrology	W. L. S.	6/12/87	Water	W. L. S.	5-18-87
			Traffic Control	W. L. S.	5-23-87












DRAWING NO. **3163** MAP NO. **E-12** SHEET **9** OF **10**

WILSON & COMPANY
ENGINEERS & ARCHITECTS
ALBUQUERQUE NEW MEXICO

85-5176

DATE	BY	FINAL SURVEY	NO
		NOTE BOOK	
		AREAS CHECKED	

DATE	BY	ORIGINAL SURVEY	NO
		NOTE BOOK	
		AREAS CHECKED	

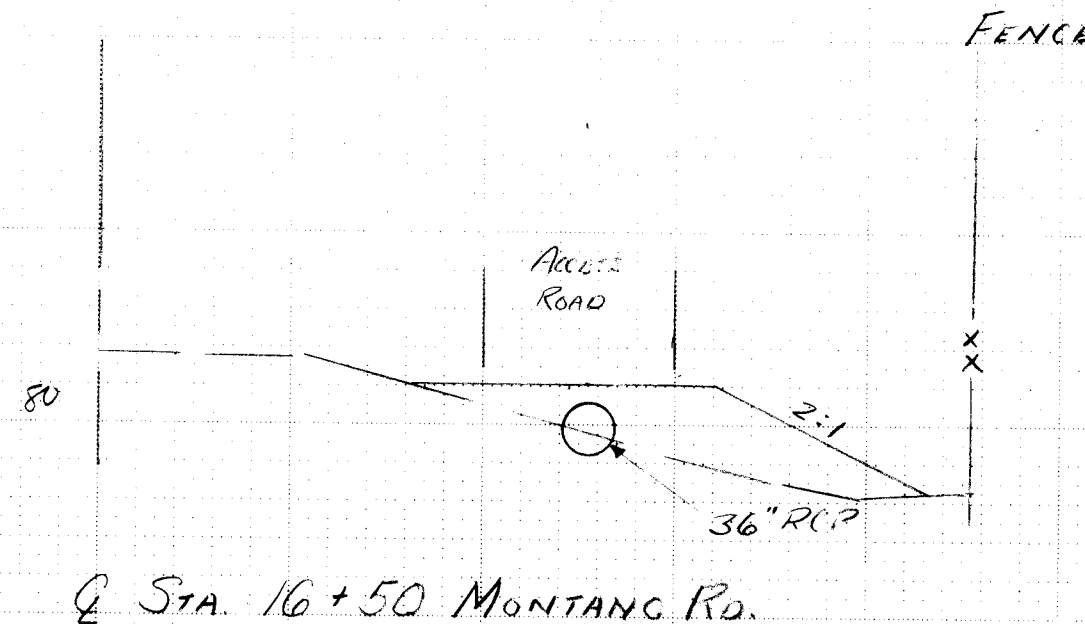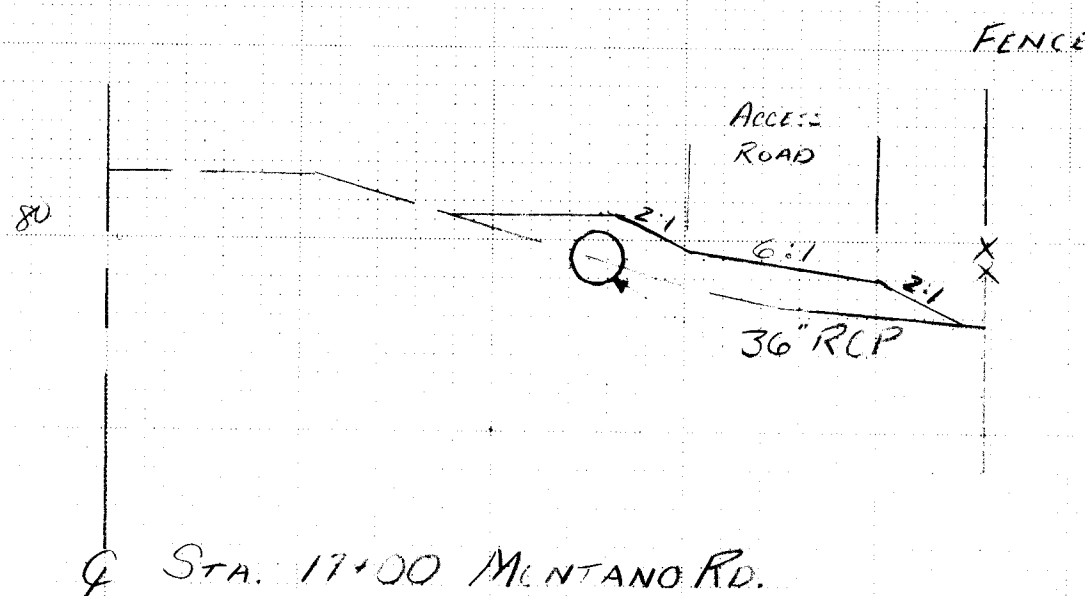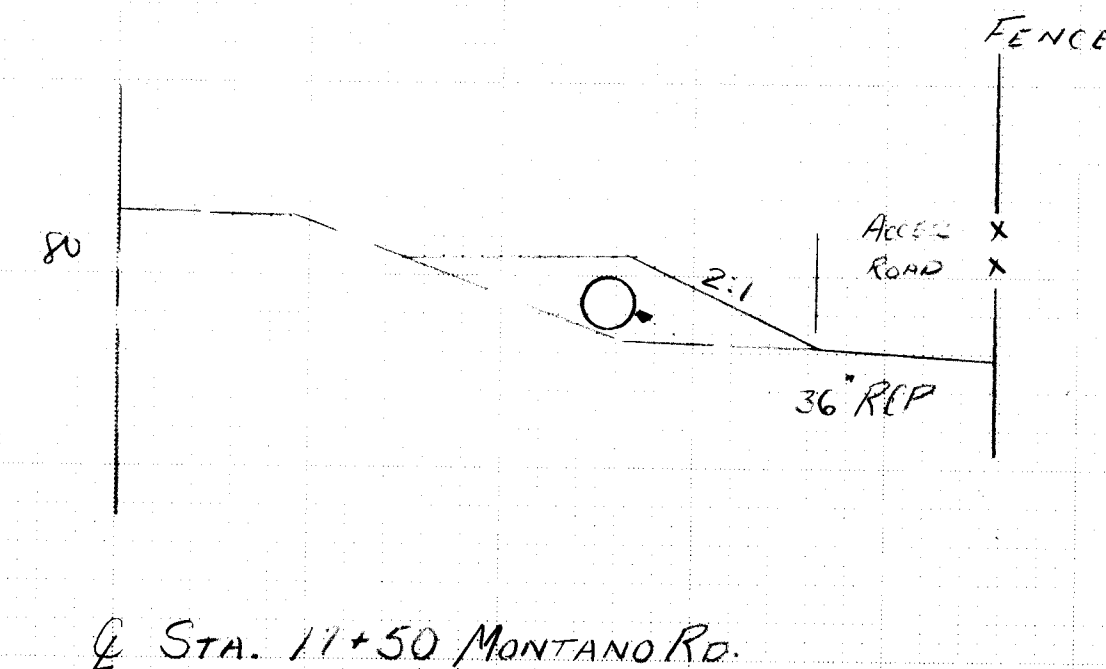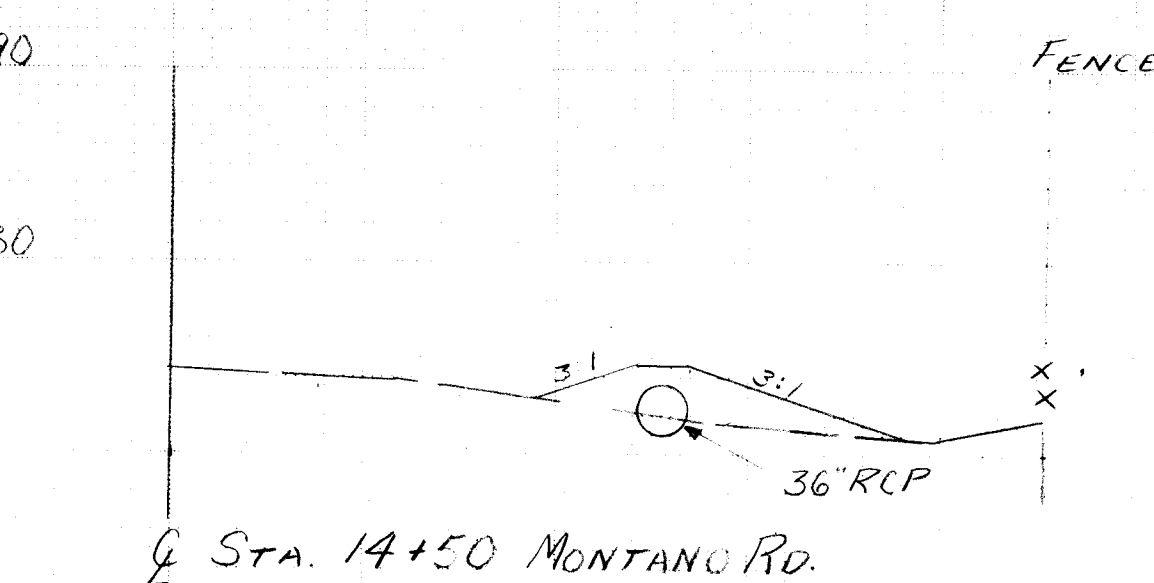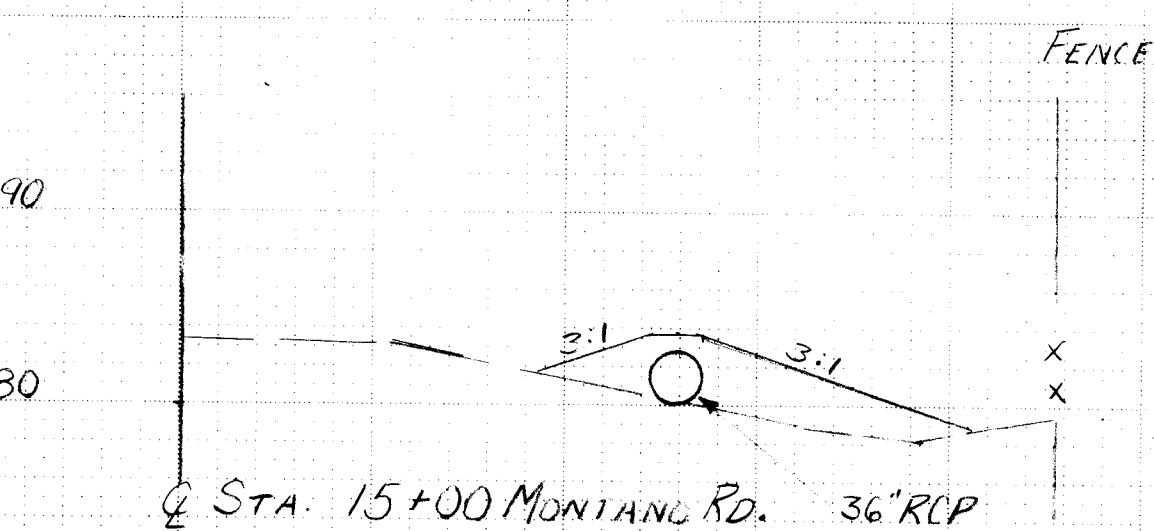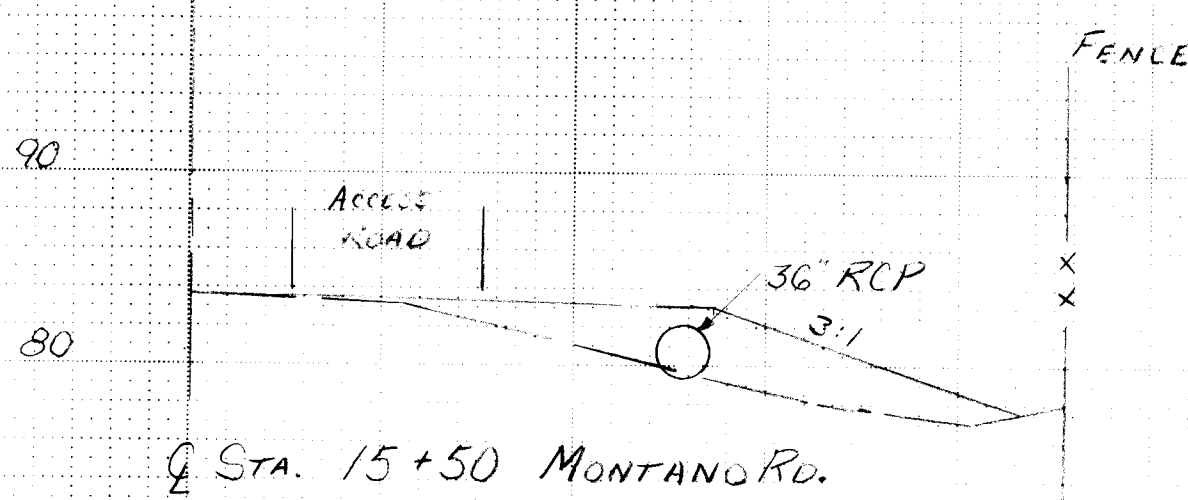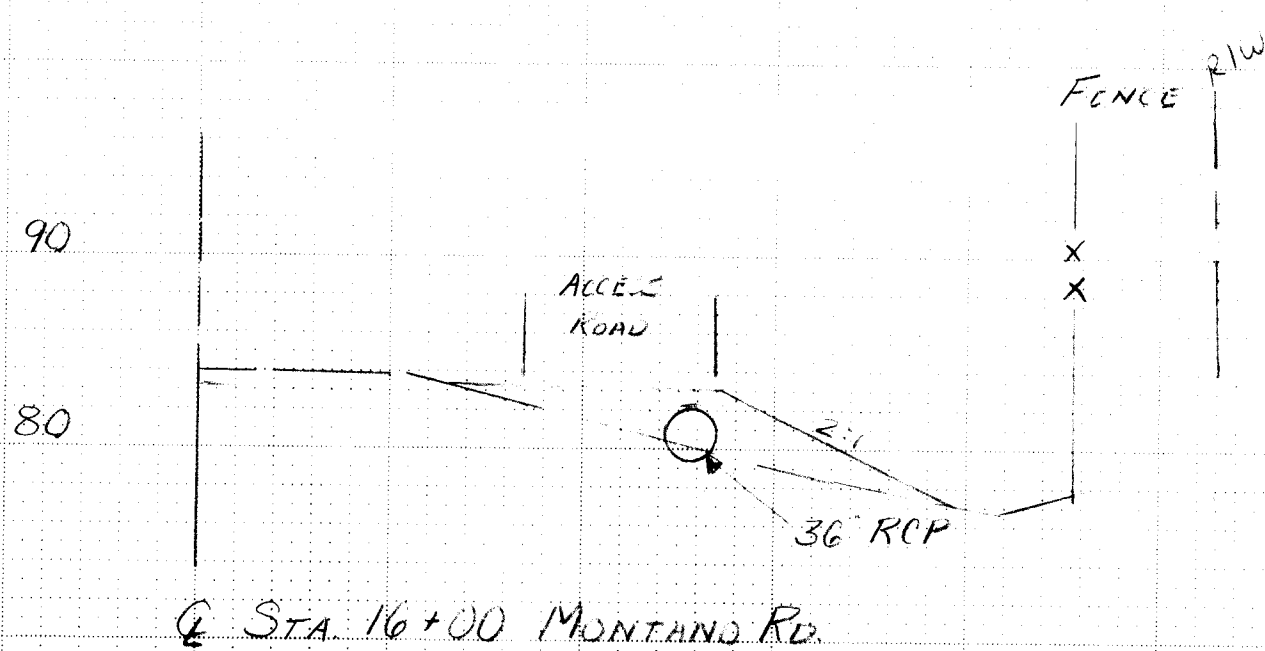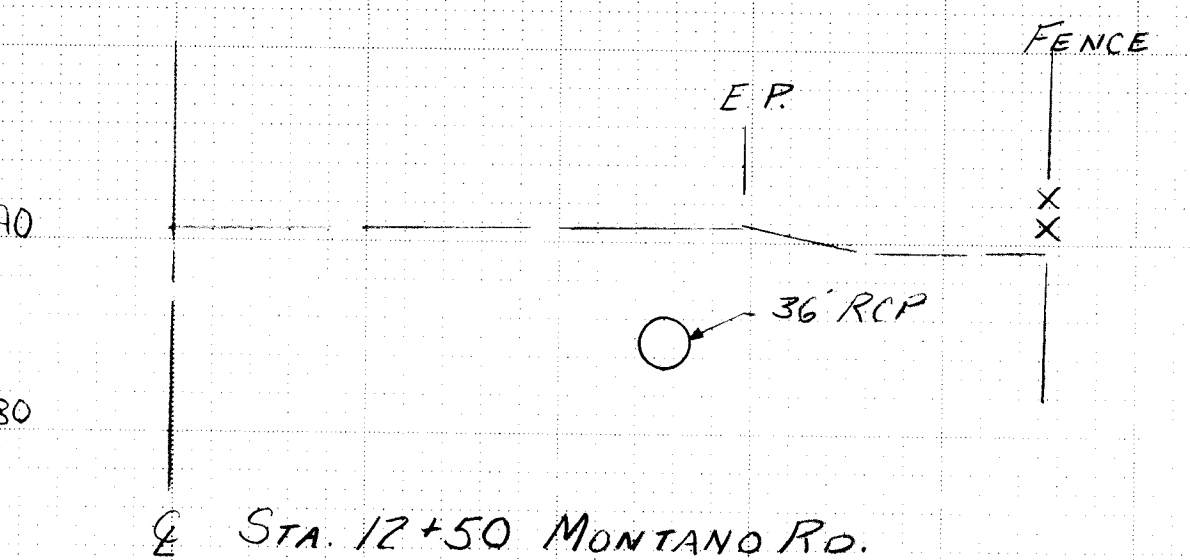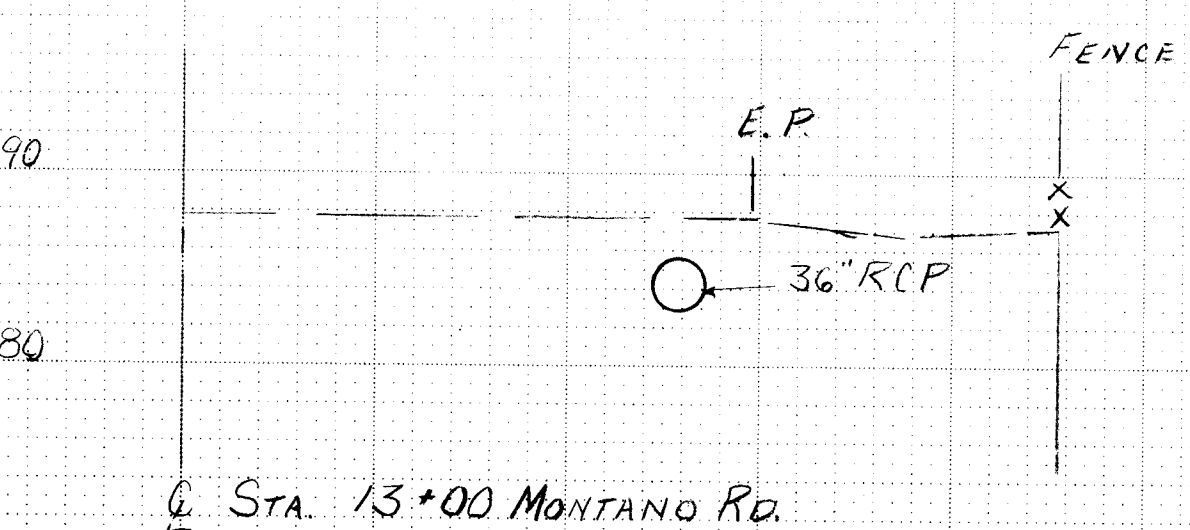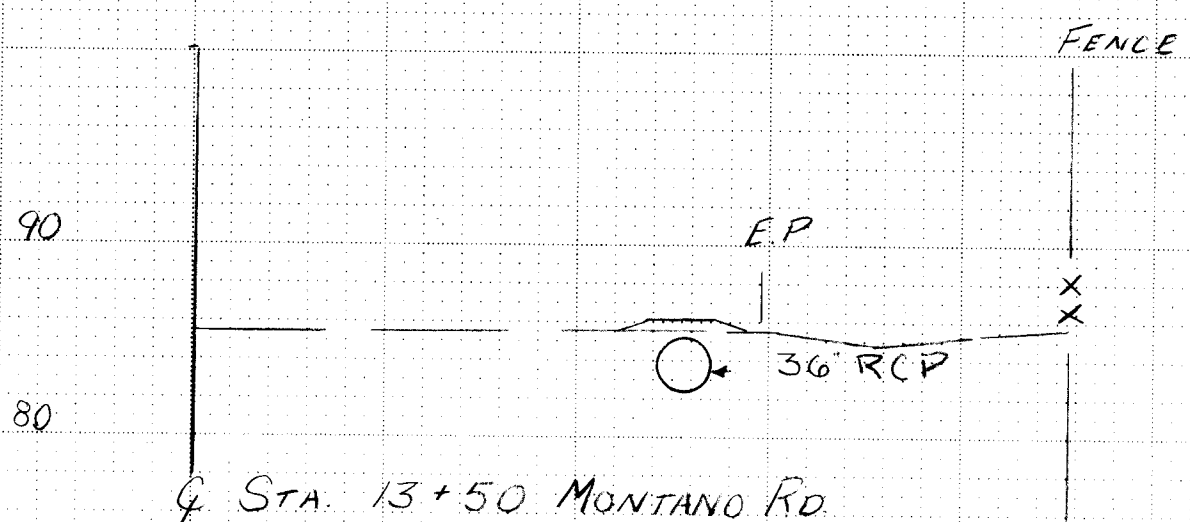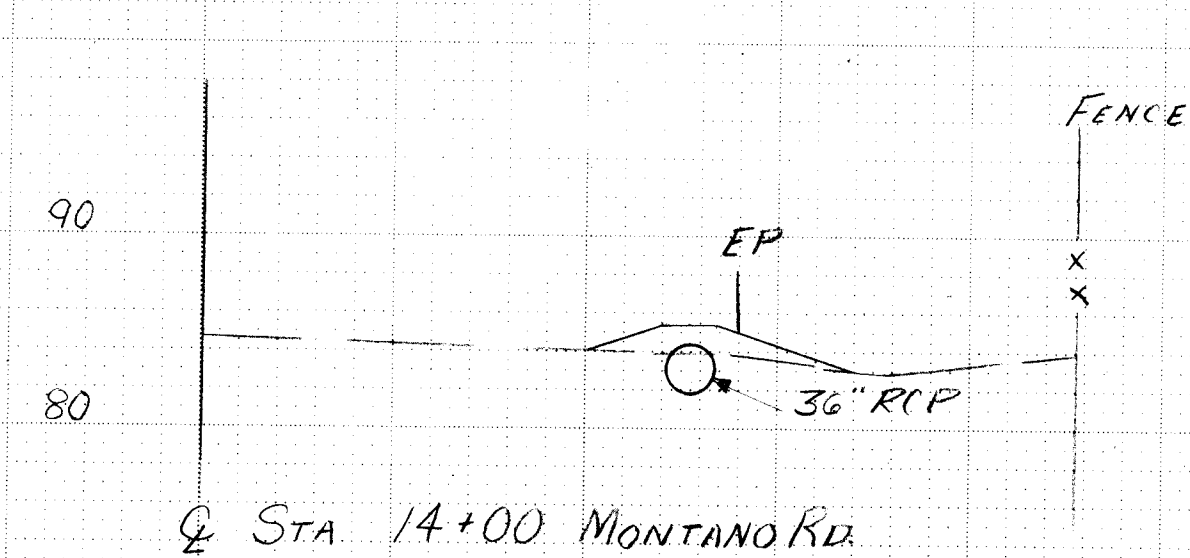

GENERAL NOTES

1. Contractor to maintain minimum cover over pipe of 1'.
2. Borrow Per Sections 205 of Specifications. (95% of Max. Density) Borrow shall be considered incidental to completion of Project.

LEGEND

--- Existing Ground

CITY OF ALBUQUERQUE					
TRANSPORTATION DEPARTMENT					
MONTANO ROAD CROSS SECTIONS					
APPROVALS	ENGINEER	DATE	APPROVALS	ENGINEER	DATE
City Engineer			Liquid Waste		
A.C.E. - Design			Traffic		
A.C.E. - Hydrology			Water		
DRAWING NO.	3163		MAP NO.	SHEET 10 OF 10	

12-15-88

WILSON & COMPANY
ENGINEERS ARCHITECTS
ALBUQUERQUE NEW MEXICO

85 - 517G