


RIO GRANDE HEIGHTS ADDITION

SUNSET GARDEN RD. SW.

NON-PRESS. CONN.
SEE DETAIL

STA. 10+00
NON-PRESS. CONN.
6" x 6" TEE
2-TRANSITION COUPLING
1-6" GATE VALVE
VALVE BOX TYPE "A"
BLOCKING

SCALE: 1" = 50'

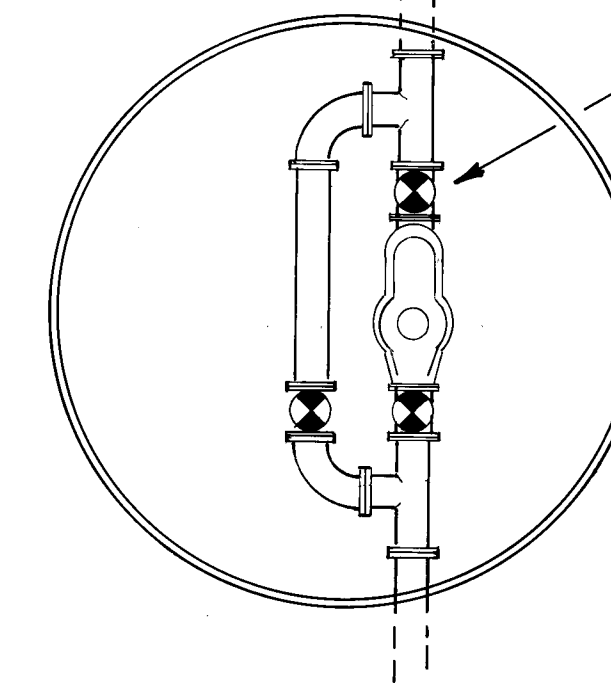

EXISTING 4" HERSEY COMPOUND WATER METER
REMOVE & RETURN TO CITY OF ALBU.
PLUS ALL VALVES AND FITTINGS
INSTALL 6" DIA. PIPE SLEEVE WITH COUPLINGS

DETAIL OF METER PIT

GENERAL NOTE

- All work detailed on these plans to be performed under contract shall, except as otherwise stated or provided for herein, be constructed in accordance with the City of Albuquerque Interim Standard Specifications for Public Works Construction, 1985.
- All work on this project shall be performed in accordance with applicable Federal, State, and local laws, rules and regulations concerning construction safety and health.
- The utility locations indicated are approximate. It shall be the contractor's responsibility to pot hold and field check to determine actual locations of lines, fittings or connections as an incidental requisite to the construction contract.
- The contractor must submit a construction signing and barricading plan to Traffic Engineering prior to construction to receive a barricading permit.
- Prior to construction, the contractor shall excavate and verify the horizontal and vertical locations of all obstruction. Should a conflict exist. The contractor shall notify the engineer or surveyor so that the conflict can be resolved with a minimum amount of delay.
- The contractor shall be responsible for protecting, supporting and maintaining in service all existing utilities.
- Any existing utilities service lines that do not require relocation and are damaged by the contractor shall be removed and replaced at the contractor's expense. This expense shall be considered incidental to the project and no separate payment shall be made.
- All utilities and utilities service lines shall be installed prior to paving.
- Backfill compaction shall be according to specified street use.
- Tack coat requirements shall be according to specified street use.
- Sidewalks and wheel chair ramps within the curb returns shall be constructed wherever a new curb return is constructed.
- If curb is depressed for a driveway or a handicap ramp the driveway or ramp shall be constructed prior to acceptance of the curb and gutter.
- All storm drainage facilities shall be completed prior to final acceptance.
- Only Water Systems Division Personnel are authorized to operate existing valves, fire hydrants etc. Three (3) full working days prior to proposed work shutdowns, contractor shall contact and coordinate with the Division Personnel at 823-4200.
- Bedding for waterline will be class #1 crush gravel.

- Water meter service lines installation to all lots per City of Albuquerque Interim Standard Specification for Public Works Construction DWG. W-10

NECESSARY TO CROSS UNDER
2" GAS MAIN

GRANADA VIEW MOBILE HOME SUBD.

CORREGIDOR PLACE SW.

SALVADOR RD. SW.

VISTA ALTA ADDITION

AS-BUILT INFORMATION		BENCH MARKS		SURVEY INFORMATION		ENGINEER'S SEAL	
CONTRACT NO.	INTER WEST LCB	9-K-11, LOCATED AT ENE CURB RETURN OF GONZALES RD. B	DATE	BY	DATE	REMARKS	DATE
WORK ORDER NO.	E.B. JENSEN DATE 7-87	53 RD. ST. SW. TOP OF CURB "X" CUT IN ELEV 500.279	DATE	BY	DATE	REVISIONS	DATE
INSPECTION BY	DATE		DATE	BY	DATE	DESIGN	DATE
VERIFICATION	DATE		DATE	BY	DATE	CHECKED BY	DATE
DRAWING NO.	L.G. DATE 3-88						
MICRO-FILM INFORMATION							
RECORDED BY	DATE						
NO.							

CITY OF ALBUQUERQUE PUBLIC WORKS DEPARTMENT					
TITLE: WATERLINE REPLACEMENT AT CITY VIEW MOBILE PARK.					
NOV. 1986					
APPROVALS	ENGINEER	DATE	APPROVALS	ENGINEER	DATE
City Engineer	<i>[Signature]</i>	3/12/87	Liquid Waste	<i>[Signature]</i>	3-19-87
A.C.E. Design	" "	" "	Traffic	<i>[Signature]</i>	3/19/87
A.C.E. Hydrology	" "	" "	Water	<i>[Signature]</i>	3-19-87
DRAWING NO.	3164	M.A.P. NO.	K-11	SHEET	15 OF 26
CHIEF ENGINEER	DATE				

APPROVED FOR
CONSTRUCTION

CHIEF ENGINEER

DATE