



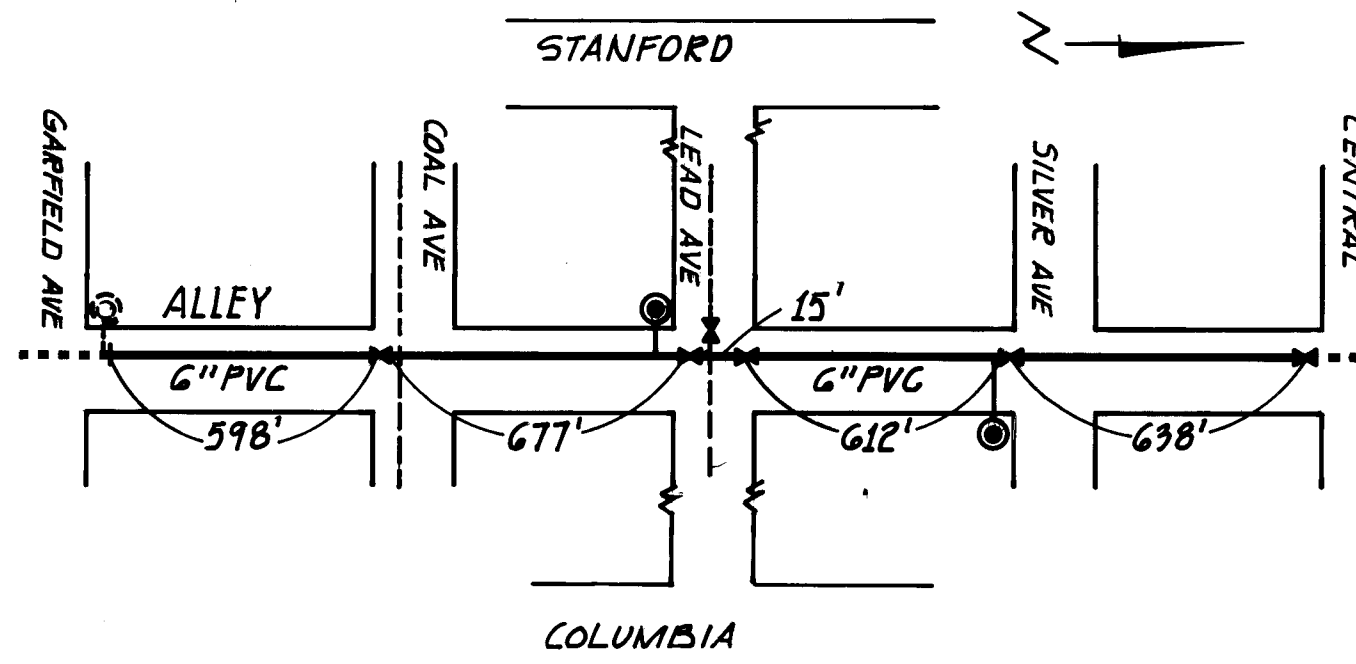

CENTRAL AVE.

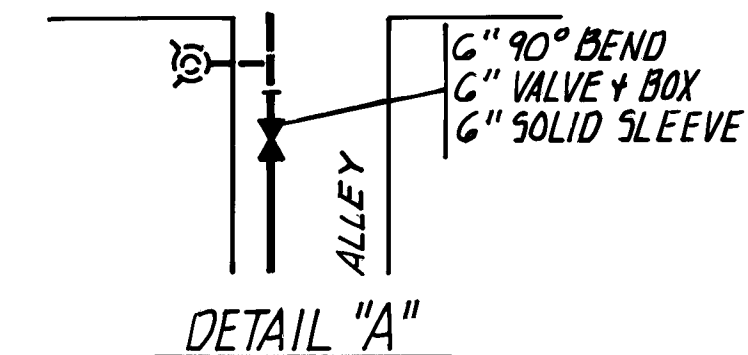


		MAP NO.- K-16		VICINITY MAP		SCALE-1"=100'	
NOTICE TO CONTRACTOR							
GENERAL NOTES:							
1. All work detailed on these plans to be performed under contract shall, except as otherwise stated or provided for herein, be constructed in accordance with the City of Albuquerque Standard Specifications for Public Works Construction 1986.							
2. Two (2) working days prior to any excavation, contractor must contact Line Locating Service, 765-1234, for location of existing utilities.							
3. Prior to construction, the contractor shall excavate and verify the horizontal and vertical locations of all obstructions. Should a conflict exist, the contractor shall notify the engineer or surveyor so that the conflict can be resolved with minimum amount of delay.							
4. Two (2) working days prior to construction, contractor shall provide Traffic Engineering Division (768-2780) with a construction traffic control plan for the application of a Barricading Permit.							
INDEX OF SHEETS							
SHEET NO.	DESCRIPTION						
1.	TITLE SHEET, VICINITY MAP, BENCHMARK.						
2.	LEGEND						
3.	WATERLINE REPLACEMENT NOTES.						
4.	PLAN - CENTRAL TO 180' S/O SILVER						
5.	PLAN - 180' S/O SILVER TO 430' S/O LEAD.						
6.	PLAN - 430' S/O LEAD TO GARFIELD.						
7.	DETAILS AND SECTIONS.						
8-11	WATERLINE SERVICE REPLACEMENT/TRANS-FER DATA.						
BENCH MARK 5-K16-A - STA. 13.24 BRASS TAPIT SET IN A A DRILLED HOLE ON TOP OF SIDEWALK STAMP-ED "5-K16-A, 1974 A.C.S." LOCATED 108.9 FT. WEST FROM THE EXTENSION OF E OF COLUMBIA DR. TO THE NORTH OF CENTRAL AVE. AND 413 FT. N. FROM E OF CENTRAL AVE. B-51138							
DESIGNED BY: Emmett Pang		DRAWN BY: M.J. Zamora		CHECKED BY: Pang		DATE: 2/87	
APPROVED FOR RECORD DRAWINGS		APPROVED FOR CONSTRUCTION		DATE: 3/87		DATE: 3/87	
ASST. CITY ENGINEER FIELD		DATE: 3/87		DATE: 3/87		DATE: 3/87	
CITY OF ALBUQUERQUE							
APPROVALS	ENGINEER	DATE	TITLE: W.L. REPLACEMENT IN ALLEY FROM CENTRAL TO GARFIELD E/O STANFORD				
D.R.C. CHAIRPERSON	4/27/87	4/27/87					
TRANS. DEV.	NADWH	4/8/87					
UTILITY DEV.	W. H. H. H.	4-14-87					
PARKS & REC. DEPT.							
USER DEPT.							
PROJECT NO. 3169		MAP NO. K-16		SHEET 1 OF 11			

MISCELLANEOUS UTILITIES		LEGEND		
GAS LINE	EXISTING	NEW		
UNDERGROUND TELEPHONE	UT			
UNDERGROUND ELECTRICAL	UE			
STORM DRAIN	SD			
STORM DRAIN MANHOLE				
STORM DRAIN INLET				
SANITARY SEWER				
SANITARY SEWER LINE	SAS			
SANITARY SEWER MANHOLE				
SAS SERVICE CONNECTIONS				
SAS CAP OR PLUG				
ENCASEMENT				
WATER				
WATER LINE	W			
WATER SERVICE CONNECTIONS				
GATE VALVE				
FIRE HYDRANT				
BUTTERFLY VALVE				
REDUCER				
WATER PRESSURE ZONE BOUNDARY				
WATER FITTINGS				
CAPS AND PLUGS				
ELBOW				
CROSS				
TEE				
CITY OF ALBUQUERQUE				
APPROVALS	ENGINEER	DATE	TITLE: W.L. REPLACEMENT IN ALLEY FROM CENTRAL TO GARFIELD E/O STANFORD.	
D.R.C. CHAIRPERSON	4/27/87	4/27/87		
TRANS. DEV.	NADWH	4/8/87		
UTILITY DEV.	W. H. H. H.	4-14-87		
PARKS & REC. DEPT.				
USER DEPT.				
PROJECT NO. 3169		MAP NO. K-16		SHEET 2 OF 11

WATERLINE REPLACEMENT NOTES:				
1. ALL PVC PIPES AS SPECIFIED IN THESE DRAWINGS SHALL MEET THE REQUIREMENTS OF AWWA C900.				
2. FITTINGS REQUIRED SHALL BE GRAY IRON OR DUCTILE IRON WITH MECHANICAL JOINTS IN CONFORMANCE WITH REQUIREMENTS OF AWWA C110 AND C111.				
3. WATER SERVICE LINES SPECIFIED FOR REPLACEMENT SHALL BE COPPER PIPE OR PLASTIC TUBING AND SHALL CONFORM TO SECTION 802.3 OF THE STANDARD SPECIFICATIONS.				
4. ELECTRONIC MARKER DISKS (EMD'S) SHALL BE INSTALLED PER SECTION 170 OF THE STANDARD SPECIFICATIONS.				
5. THE CONTRACTOR SHALL ARRANGE A CONSTRUCTION PROGRAM WHICH WILL MAINTAIN CONTINUOUS SERVICE TO WATER USERS FROM EXISTING FACILITIES TO THE FULLEST EXTENT POSSIBLE.				
6. THE CONTRACTOR SHALL OBTAIN PERMISSION OF THE 'ENGINEER' PRIOR TO MAKING ANY CONNECTION TO EXISTING MAINS.				
7. THE CONTRACTOR SHALL COMPLY WITH SECTION 701.4 OF THE STANDARD SPECIFICATIONS IN ASSISTING THE ENGINEER IN THE NOTIFICATION OF PROPERTY OWNERS OF FORTHCOMING CONSTRUCTION.				
8. THE CONTRACTOR SHALL OBSERVE TRENCH SAFETY REQUIREMENTS IN ACCORDANCE WITH OSHA PUBLICATIONS.				
9. FOR REMOVAL OF EXISTING PAVEMENT, SIDEWALK AND DRIVEWAY, CONTRACTOR'S ATTENTION IS DIRECTED TO SECTION 701.8 OF THE STANDARD SPECIFICATIONS.				
10. THE CONTRACTOR'S ATTENTION IS DIRECTED TO TABLE 701.17.8.2 OF THE STANDARD SPECIFICATIONS IN REGARDS TO ALLOWABLE MAXIMUM PAVEMENT CUT WIDTHS.				
11. CONTRACTORS SHALL REFER TO TABLE 701.3.5 OF THE STANDARD SPECIFICATIONS FOR CLASSIFICATIONS OF EMBODIMENT MATERIAL.				
12. EXISTING FOUNDATION MATERIAL SHALL BE USED. HOWEVER, WHEN UNSTABLE CONDITIONS ARE ENCOUNTERED, CONTRACTOR SHALL NOTIFY ENGINEER IMMEDIATELY. THE ENGINEER SHALL PROVIDE DIRECTION TO CONTRACTOR REGARDING STABILIZATION PRIOR TO LAYING PIPE.				
13. IN SITU MATERIAL SHALL BE USED FOR EMBODIMENT WHEREVER POSSIBLE AND IN COMPLIANCE WITH THE STANDARD SPECIFICATIONS. HOWEVER, UNDER NO CIRCUMSTANCES SHALL CLASS IV OR V SOILS BE UTILIZED.				
14. THE CONTRACTOR SHALL EXERCISE UTMOST CAUTION IN AVOIDING ELECTRICAL SHOCKS WHEN REMOVING EXISTING STEEL WATERLINES. ELECTRICAL BONDS OR JUMPERS SHOULD BE PROVIDED PRIOR TO SEPARATING METAL LINES.				
15. THE CONTRACTOR SHALL MAINTAIN CONTINUOUS ACCESS TO ALL ADJACENT PROPERTIES AT ALL TIMES, WHEN NO ALTERNATIVE ACCESS IS AVAILABLE.				
16. SOME EXISTING UNDERGROUND UTILITIES MAY NOT BE SHOWN IN THEIR EXACT LOCATION OR MAY NOT BE SHOWN AT ALL ON THESE DRAWINGS. THE INFORMATION SHOWN IS BASED ON THE BEST AVAILABLE RECORD DRAWINGS. IT IS THE CONTRACTOR'S FULL RESPONSIBILITY TO CONTACT THE UTILITY OWNERS AND DETERMINE THE EXACT LOCATION OF ALL UNDERGROUND UTILITIES, BEFORE TRENCHING OPERATIONS ARE INITIATED.				
17. WHEREVER POSSIBLE THE CONTRACTOR SHALL CONNECT TEMPORARY SHOEFLY LINE TO EXISTING FIRE HYDRANTS. IT SHALL BE THE CONTRACTOR'S RESPONSIBILITY TO NOTIFY THE FIRE MARSHALL'S OFFICE AND COORDINATE WATER TURN-ON OR SHUT-OFF WITH THE FIELD OPERATIONS OFFICE, OF THE WATER UTILITIES DIVISION IN ACCORDANCE WITH SECTION 18.3 OF THE STANDARD SPECIFICATIONS. PRIOR TO SERVICE CONNECTION, ALL SHOEFLY LINES SHALL BE FLUSHED AND DISINFECTED PER SECTION 801.17 AND 801.18 OF THE STD. SPECS.				
18. NO SERVICE SHALL BE SUPPLIED BY A SHOEFLY LINE FOR MORE THAN SEVEN CALENDAR DAYS.				
19. THE CONTRACTOR SHALL AVOID THE EXISTING 22" STEEL LINE ON SILVER AVE. AND SUPPORT SAME IN PLACE DURING CONSTRUCTION OF PROPOSED IMPROVEMENTS.				
20. THE CONTRACTOR SHALL CONTACT PLANNING/UTILITIES WHEN THE 16" STEEL LINE ON COAL AVE. IS EXPOSED SO THAT THE LINE CONDITION CAN BE ASSESSED.				
21. ALL TRAFFIC LANES SHALL REMAIN OPEN DURING THE HOURS BETWEEN 6:00 AM TO 9:00 AM AND 3:30 PM TO 6:00 PM MONDAY TO FRIDAY ON SILVER AVE., LEAD AVE., COAL AVE. AND GARFIELD AVE. A MINIMUM OF TWO LANES ON LEAD AVE. AND COAL AVE. AND ONE LANE IN EACH DIRECTION ON SILVER AND GARFIELD AVE. SHALL BE MAINTAINED OPEN ALL OTHER TIMES.				
22. THE CONTRACTOR SHALL, AT THE DIRECTION OF THE FIELD ENGINEER, REGRADE ENTIRE WIDTH OF THE ALLEY WITHIN THE PROJECT LIMITS SO THAT THE ALLEY WILL DRAIN UNIFORMLY BETWEEN INTERSECTIONS WITHOUT ANY LOCALIZED FLOODING.				
CITY OF ALBUQUERQUE				
APPROVALS	ENGINEER	DATE	TITLE: W.L. REPLACEMENT IN ALLEY FROM CENTRAL TO GARFIELD E/O STANFORD	
D.R.C. CHAIRPERSON	4/27/87	4/27/87		
TRANS. DEV.	NADWH	4/8/87		
UTILITY DEV.	W. H. H. H.	4-14-87		
PARKS & REC. DEPT.				
USER DEPT.				
PROJECT NO. 3169		MAP NO. K-16		SHEET 3 OF 11

WATERLINE REPLACEMENT NOTES:				
1. ALL PVC PIPES AS SPECIFIED IN THESE DRAWINGS SHALL MEET THE REQUIREMENTS OF AWWA C900.				
2. FITTINGS REQUIRED SHALL BE GRAY IRON OR DUCTILE IRON WITH MECHANICAL JOINTS IN CONFORMANCE WITH REQUIREMENTS OF AWWA C110 AND C111.				
3. WATER SERVICE LINES SPECIFIED FOR REPLACEMENT SHALL BE COPPER PIPE OR PLASTIC TUBING AND SHALL CONFORM TO SECTION 802.3 OF THE STANDARD SPECIFICATIONS.				
4. ELECTRONIC MARKER DISKS (EMD'S) SHALL BE INSTALLED PER SECTION 170 OF THE STANDARD SPECIFICATIONS.				
5. THE CONTRACTOR SHALL ARRANGE A CONSTRUCTION PROGRAM WHICH WILL MAINTAIN CONTINUOUS SERVICE TO WATER USERS FROM EXISTING FACILITIES TO THE FULLEST EXTENT POSSIBLE.				
6. THE CONTRACTOR SHALL OBTAIN PERMISSION OF THE 'ENGINEER' PRIOR TO MAKING ANY CONNECTION TO EXISTING MAINS.				
7. THE CONTRACTOR SHALL COMPLY WITH SECTION 701.4 OF THE STANDARD SPECIFICATIONS IN ASSISTING THE ENGINEER IN THE NOTIFICATION OF PROPERTY OWNERS OF FORTHCOMING CONSTRUCTION.				
8. THE CONTRACTOR SHALL OBSERVE TRENCH SAFETY REQUIREMENTS IN ACCORDANCE WITH OSHA PUBLICATIONS.				
9. FOR REMOVAL OF EXISTING PAVEMENT, SIDEWALK AND DRIVEWAY, CONTRACTOR'S ATTENTION IS DIRECTED TO SECTION 701.8 OF THE STANDARD SPECIFICATIONS.				
10. THE CONTRACTOR'S ATTENTION IS DIRECTED TO TABLE 701.17.8.2 OF THE STANDARD SPECIFICATIONS IN REGARDS TO ALLOWABLE MAXIMUM PAVEMENT CUT WIDTHS.				
11. CONTRACTORS SHALL REFER TO TABLE 701.3.5 OF THE STANDARD SPECIFICATIONS FOR CLASSIFICATIONS OF EMBODIMENT MATERIAL.				
12. EXISTING FOUNDATION MATERIAL SHALL BE USED. HOWEVER, WHEN UNSTABLE CONDITIONS ARE ENCOUNTERED, CONTRACTOR SHALL NOTIFY ENGINEER IMMEDIATELY. THE ENGINEER SHALL PROVIDE DIRECTION TO CONTRACTOR REGARDING STABILIZATION PRIOR TO LAYING PIPE.				
13. IN SITU MATERIAL SHALL BE USED FOR EMBODIMENT WHEREVER POSSIBLE AND IN COMPLIANCE WITH THE STANDARD SPECIFICATIONS. HOWEVER, UNDER NO CIRCUMSTANCES SHALL CLASS IV OR V SOILS BE UTILIZED.				
14. THE CONTRACTOR SHALL EXERCISE UTMOST CAUTION IN AVOIDING ELECTRICAL SHOCKS WHEN REMOVING EXISTING STEEL WATERLINES. ELECTRICAL BONDS OR JUMPERS SHOULD BE PROVIDED PRIOR TO SEPARATING METAL LINES.				
15. THE CONTRACTOR SHALL MAINTAIN CONTINUOUS ACCESS TO ALL ADJACENT PROPERTIES AT ALL TIMES, WHEN NO ALTERNATIVE ACCESS IS AVAILABLE.				
16. SOME EXISTING UNDERGROUND UTILITIES MAY NOT BE SHOWN IN THEIR EXACT LOCATION OR MAY NOT BE SHOWN AT ALL ON THESE DRAWINGS. THE INFORMATION SHOWN IS BASED ON THE BEST AVAILABLE RECORD DRAWINGS. IT IS THE CONTRACTOR'S FULL RESPONSIBILITY TO CONTACT THE UTILITY OWNERS AND DETERMINE THE EXACT LOCATION OF ALL UNDERGROUND UTILITIES, BEFORE TRENCHING OPERATIONS ARE INITIATED.				
17. WHEREVER POSSIBLE THE CONTRACTOR SHALL CONNECT TEMPORARY SHOEFLY LINE TO EXISTING FIRE HYDRANTS. IT SHALL BE THE CONTRACTOR'S RESPONSIBILITY TO NOTIFY THE FIRE MARSHALL'S OFFICE AND COORDINATE WATER TURN-ON OR SHUT-OFF WITH THE FIELD OPERATIONS OFFICE, OF THE WATER UTILITIES DIVISION IN ACCORDANCE WITH SECTION 18.3 OF THE STANDARD SPECIFICATIONS. PRIOR TO SERVICE CONNECTION, ALL SHOEFLY LINES SHALL BE FLUSHED AND DISINFECTED PER SECTION 801.17 AND 801.18 OF THE STD. SPECS.				
18. NO SERVICE SHALL BE SUPPLIED BY A SHOEFLY LINE FOR MORE THAN SEVEN CALENDAR DAYS.				
19. THE CONTRACTOR SHALL AVOID THE EXISTING 22" STEEL LINE ON SILVER AVE. AND SUPPORT SAME IN PLACE DURING CONSTRUCTION OF PROPOSED IMPROVEMENTS.				
20. THE CONTRACTOR SHALL CONTACT PLANNING/UTILITIES WHEN THE 16" STEEL LINE ON COAL AVE. IS EXPOSED SO THAT THE LINE CONDITION CAN BE ASSESSED.				
21. ALL TRAFFIC LANES SHALL REMAIN OPEN DURING THE HOURS BETWEEN 6:00 AM TO 9:00 AM AND 3:30 PM TO 6:00 PM MONDAY TO FRIDAY ON SILVER AVE., LEAD AVE., COAL AVE. AND GARFIELD AVE. A MINIMUM OF TWO LANES ON LEAD AVE. AND COAL AVE. AND ONE LANE IN EACH DIRECTION ON SILVER AND GARFIELD AVE. SHALL BE MAINTAINED OPEN ALL OTHER TIMES.				
22. THE CONTRACTOR SHALL, AT THE DIRECTION OF THE FIELD ENGINEER, REGRADE ENTIRE WIDTH OF THE ALLEY WITHIN THE PROJECT LIMITS SO THAT THE ALLEY WILL DRAIN UNIFORMLY BETWEEN INTERSECTIONS WITHOUT ANY LOCALIZED FLOODING.				
CITY OF ALBUQUERQUE				
APPROVALS	ENGINEER	DATE	TITLE: W.L. REPLACEMENT IN ALLEY FROM CENTRAL TO GARFIELD E/O STANFORD	
D.R.C. CHAIRPERSON	4/27/87	4/27/87		
TRANS. DEV.	NADWH	4/8/87		
UTILITY DEV.	W. H. H. H.	4-14-87		
PARKS & REC. DEPT.				
USER DEPT.				
PROJECT NO. 3169		MAP NO. K-16		SHEET 4 OF 11

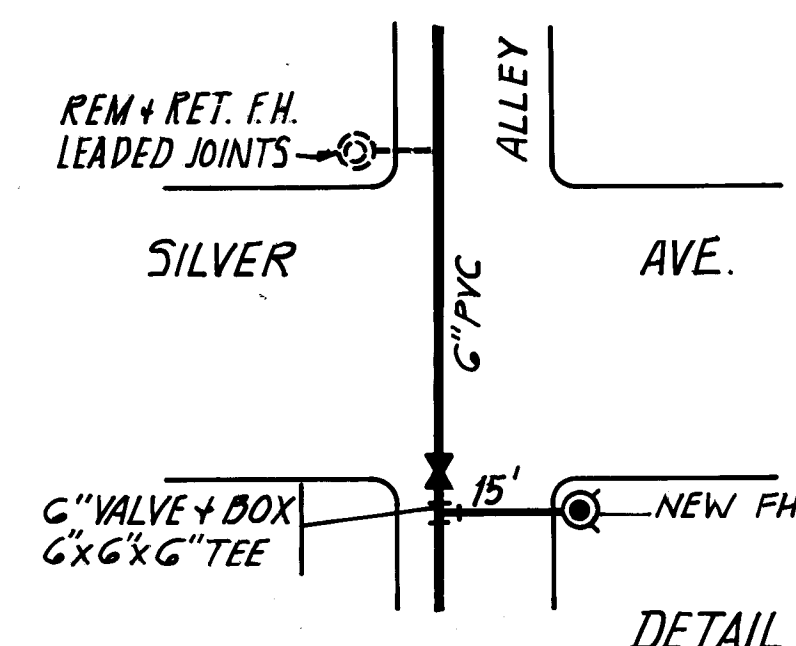

NOTE:
ALL ASPHALT CONCRETE PAVEMENT REMOVALS AS SHOWN HEREON SHALL BE SAWCUT TO A MINIMUM DEPTH OF 2"

26 31690188

SHEET -1

APPROVALS

D.R.C. CHAIRPERSON

ENGINEER

TRANS. DEV.

DATE

4/8/87

TITLE: W.L. REPLACEMENT
IN ALLEY E/O STANFORD.
FROM CENTRAL TO GARFIELD-
WATER METER REHABILITATION
& SERVICE LINE REPLACEMENT/
TRANSFER DATA.

PROJECT NO.

3169

MAP NO. K-16

SHEET 9 OF 11

CITY OF ALBUQUERQUE

NOTE: Contractor Shall Install Item(s) as Checked per House Number.

House Number	Street	* Service line replacement and transfer	SIZE	Adjust existing water meter and box to finisher Std. Deg. grade (12"±) W-14 & W-15
318	Stanford Drive, S.E.	X	3/4"	
320	"	X	3/4"	
322	"	X	3/4"	
324	"	X	3/4"	
2505	Coal Ave., S.E.	X	3/4"	
402	Stanford Drive, S.E.	X	3/4"	X
404	"	X	3/4"	
406	"	X	3/4"	
408	"	X	3/4"	
410	"	X	3/4"	
412	"	X	3/4"	
414	"	X	3/4"	
416	"	X	3/4"	
418	"	X	3/4"	
420	"	X	3/4"	
422	Columbia Drive, S.E.	X	3/4"	
501	"	X	3/4"	
503	"	X	3/4"	
509	"	X	3/4"	
515	"	X	3/4"	
425	"	X	3/4"	
421	"	X	3/4"	
419	"	X	3/4"	
417	"	X	3/4"	
415	"	X	3/4"	
413	"	X	3/4"	
411	"	X	3/4"	

* CITY TO FURNISH METER BOX & LID.

414 STANFORD X 3/4"

ALL NEW MTR. BOXES PLATES & COLLARS

NEW MTR.

NEW MTR.

NO 500 BLOCK

APPROVALS

D.R.C. CHAIRPERSON

ENGINEER

TRANS. DEV.

DATE

4/8/87

TITLE: W.L. REPLACEMENT
IN ALLEY E/O STANFORD.
FROM CENTRAL TO GARFIELD-
WATER METER REHABILITATION
& SERVICE LINE REPLACEMENT/
TRANSFER DATA.

PROJECT NO.

3169

MAP NO. K-16

SHEET 10 OF 11

CITY OF ALBUQUERQUE

NOTE: Contractor Shall Install Item(s) as Checked per House Number.

House Number	Street	* Service line replacement and transfer	SIZE	Adjust existing water meter and box to finisher Std. Deg. grade (12"±) W-14 & W-15
409	Columbia Drive, S.E.	X	3/4"	
407	"	X	3/4"	
405 1/2	"	X	3/4"	
405	"	X	3/4"	
403	"	X	3/4"	X
401	"	X	3/4"	
323	"	X	1"	
321	"	X	1"	
319	"	X	3/4"	X
317	"	X	3/4"	X
315	"	X	3/4"	X
313	"	X	3/4"	
311	"	X	3/4"	
309	"	X	3/4"	
307	"	X	3/4"	
305	"	X	3/4"	
303	"	X	3/4"	X
301 1/2	"	X	3/4"	X
223	"	X	3/4"	X
221	"	X	3/4"	
219	"	X	3/4"	
217	"	X	3/4"	
209	"	X	2"	
205	"	X	1 1/2"	
201	"	X	1 1/2"	X
191	"	X	3/4"	X
117	"	X	3/4"	X

* CITY TO FURNISH METER BOX & LID.

APPROVALS

D.R.C. CHAIRPERSON

ENGINEER

TRANS. DEV.

DATE

4/8/87

TITLE: W.L. REPLACEMENT
IN ALLEY E/O STANFORD.
FROM CENTRAL TO GARFIELD-
WATER METER REHABILITATION
& SERVICE LINE REPLACEMENT/
TRANSFER DATA.

PROJECT NO.

3169

MAP NO. K-16

SHEET 11 OF 11

CITY OF ALBUQUERQUE




NOTE: Contractor Shall Install Item(s) as Checked per House Number.

House Number	Street	* Service line replacement and transfer	SIZE	Adjust existing water meter and box to finisher Std. Deg. grade (12"±) W-14 & W-15
115	Columbia Drive, S.E.	X	1"	X
113	"	X	3/4"	X
111	"	X	3/4"	X
109	"	X	1"	X
107	"	X	3/4"	X

* CITY TO FURNISH METER BOX & LID.

SHEET -

87-2

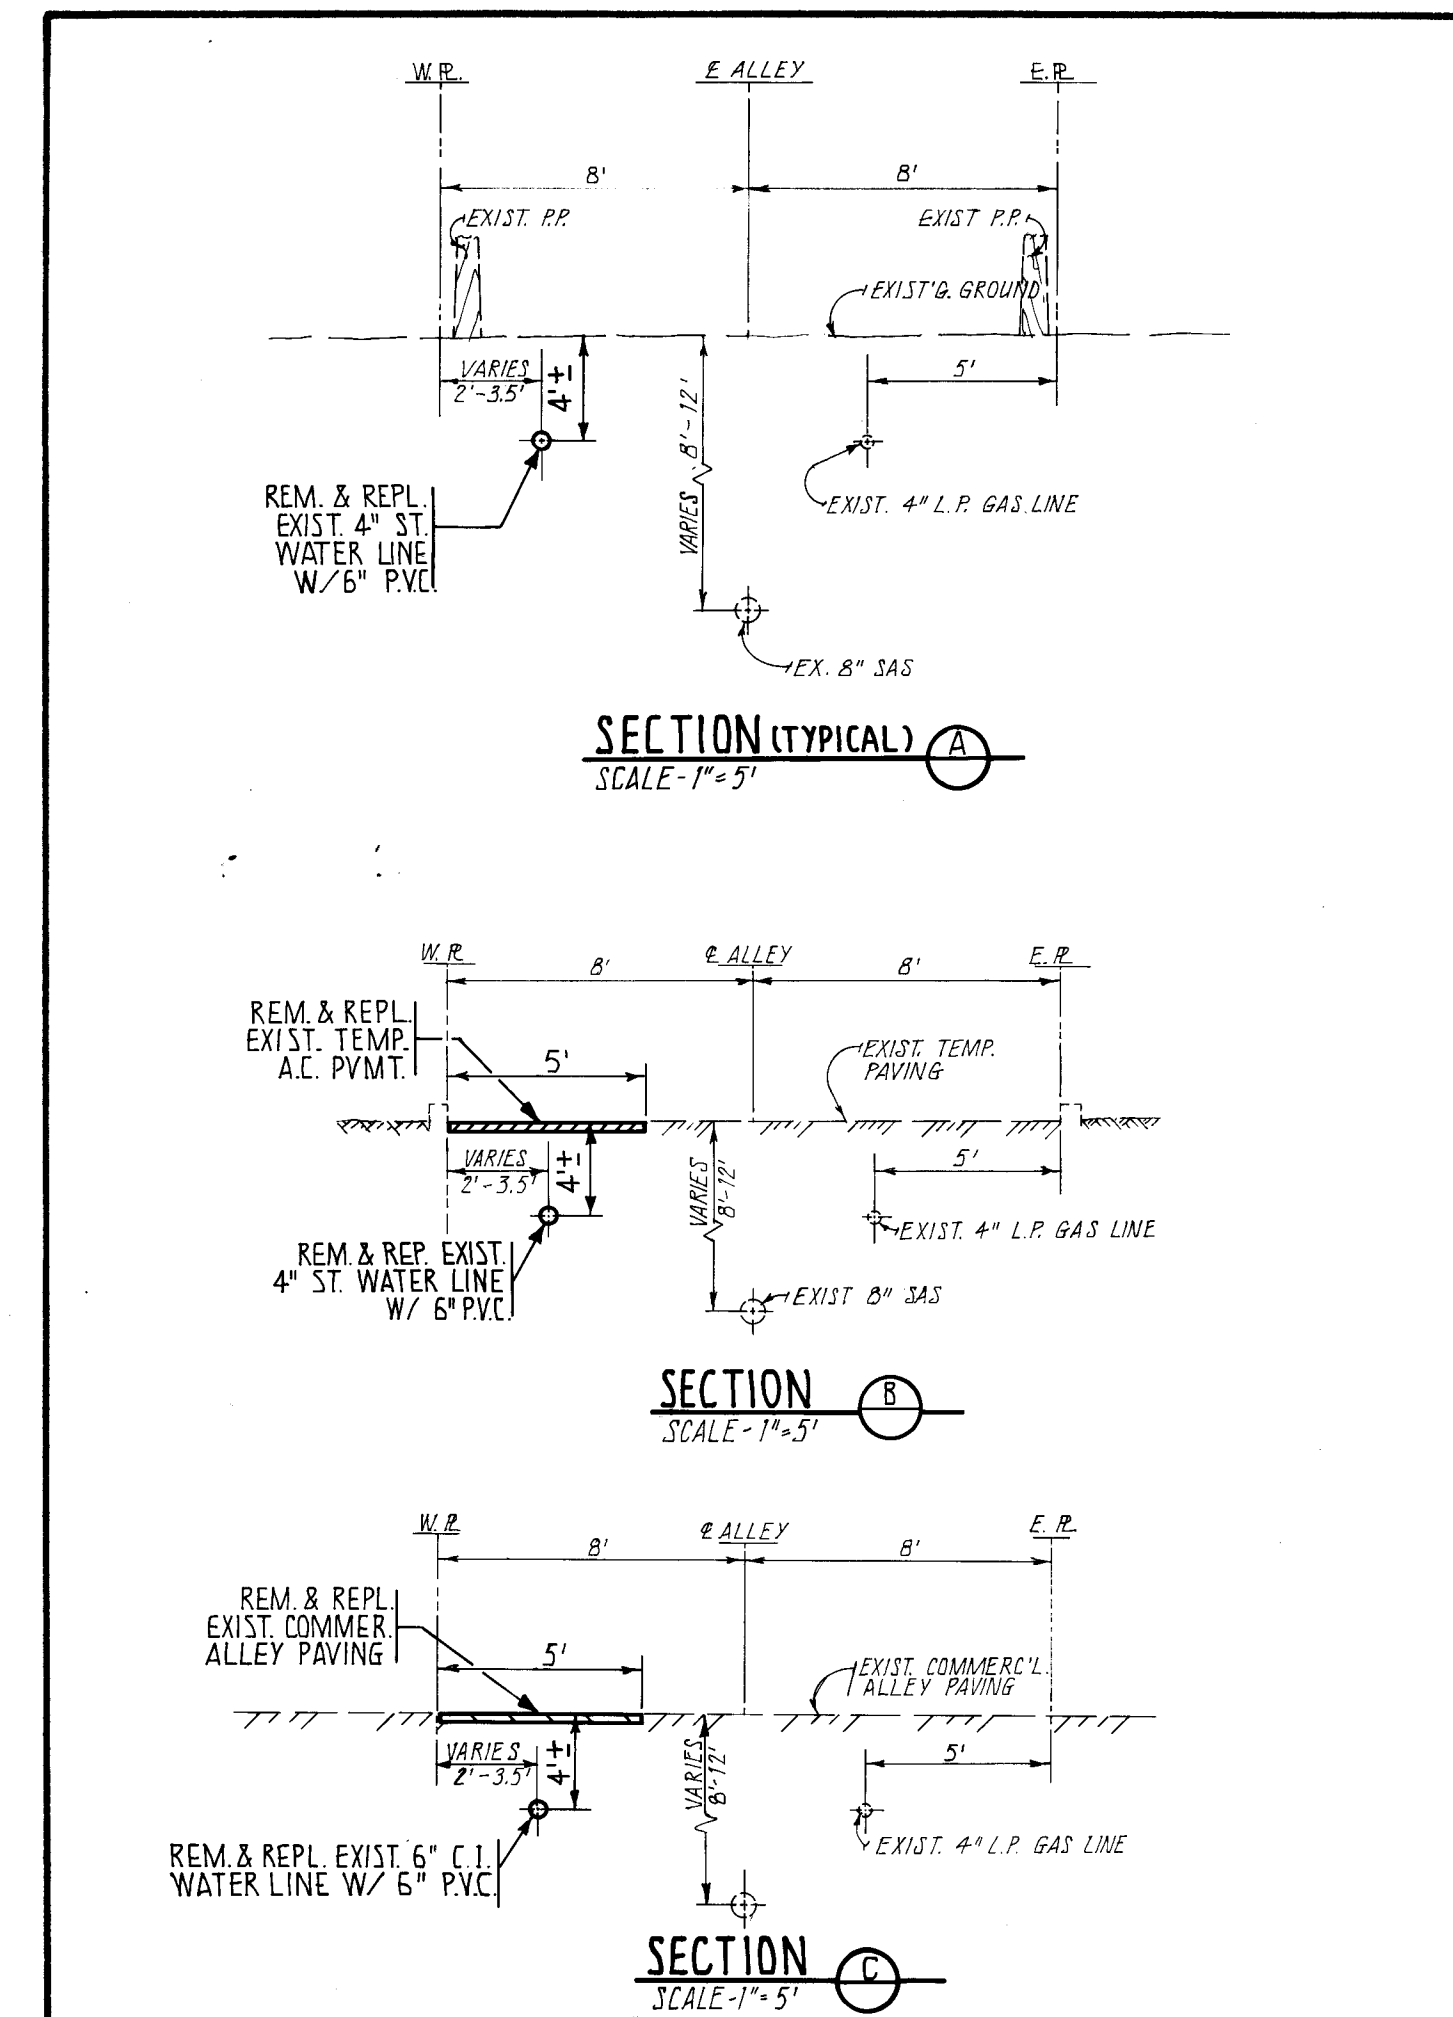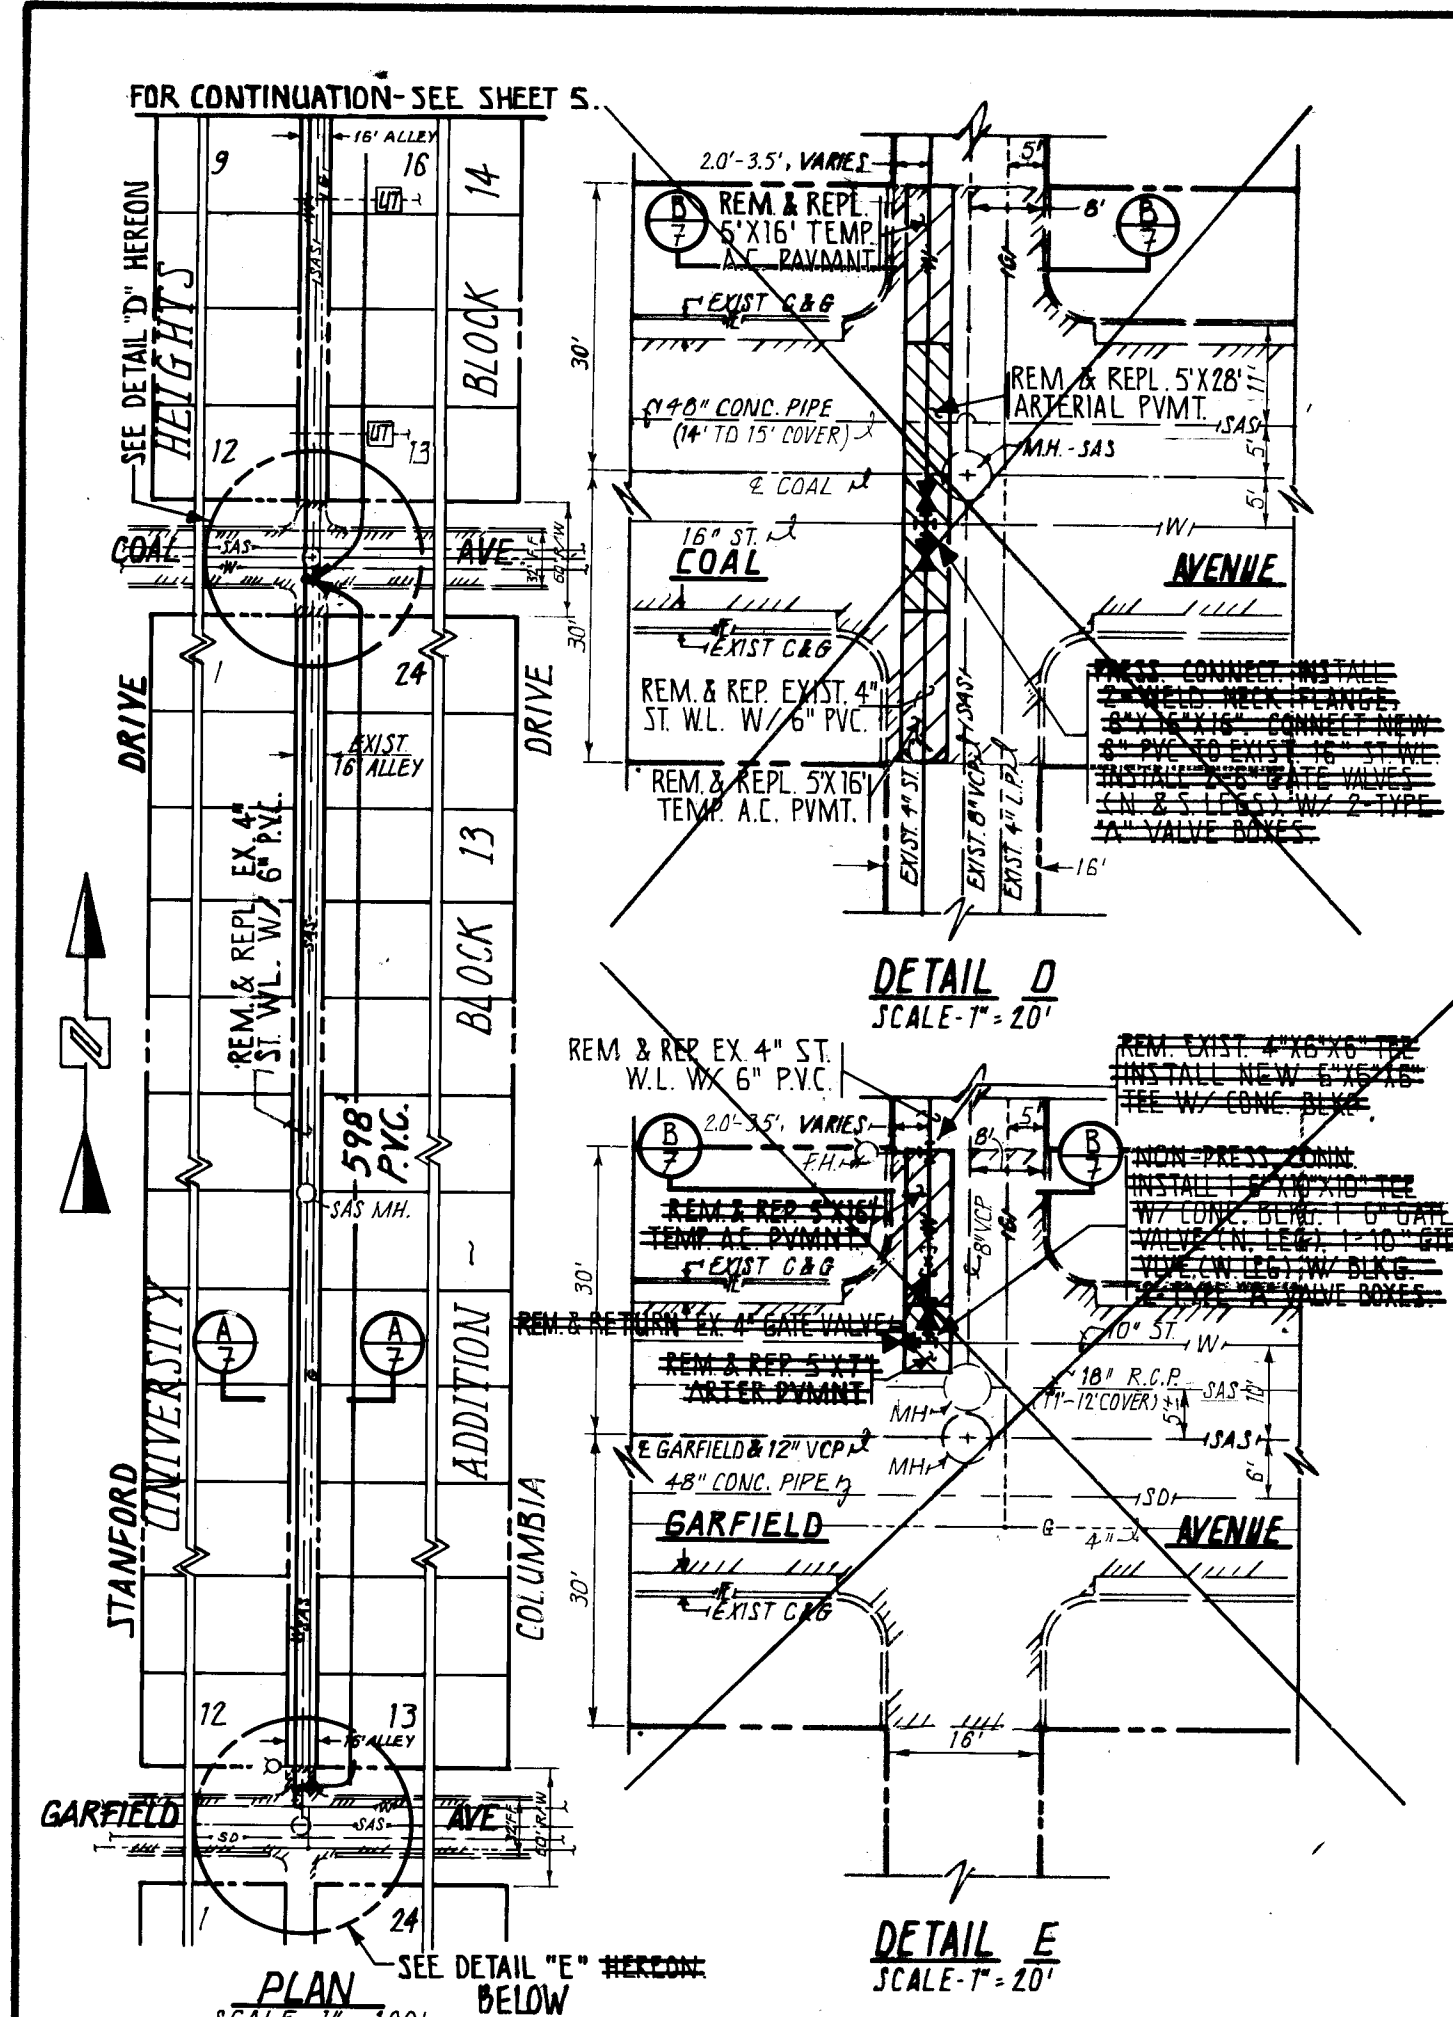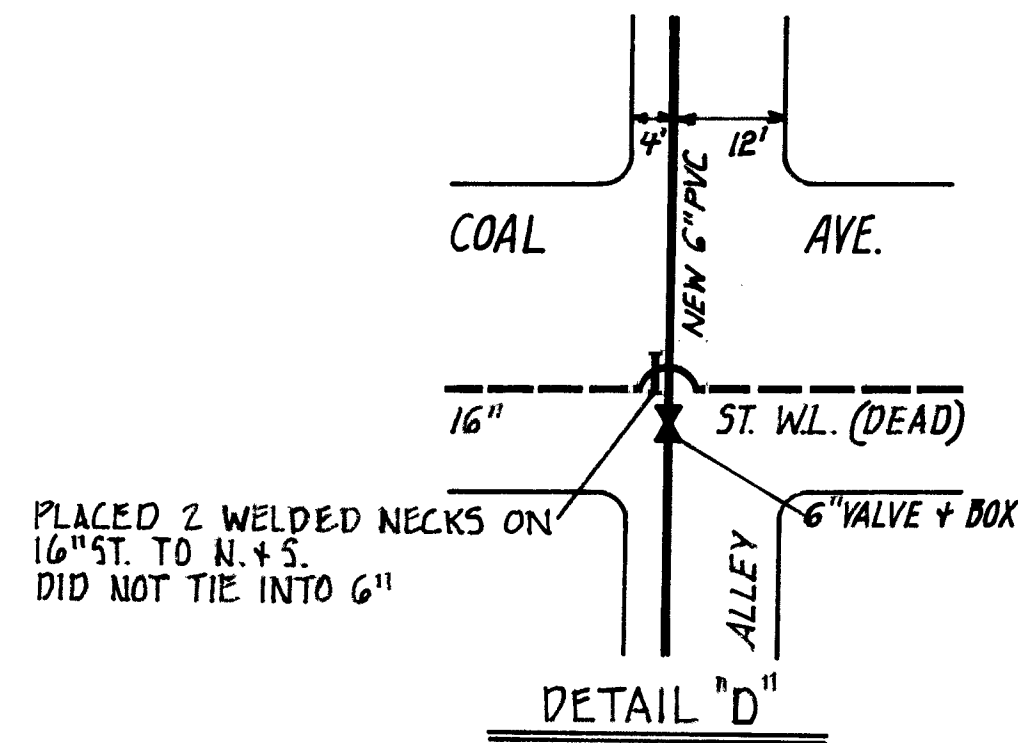

CITY OF ALBUQUERQUE			
APPROVALS	ENGINEER	DATE	TITLE: W.L. REPLACEMENT IN ALLEY E/O STANFORD, FROM CENTRAL TO GARFIELD PLAN-430' S/O LEAD TO GARFIELD.
D.R.C. CHAIRPERSON	<i>Michael</i>	4/27/92	PROJECT NO. 3169 MAP NO. K-16 SHEET 6 OF 11
TRANS. DEV.	<i>NADWH</i>	4/8/87	
UTILITY DEV.	<i>W. Michael</i>	2-19-87	
PARKS & REC. DEPT.			
USER DEPT.			

CITY OF ALBUQUERQUE			
APPROVALS	ENGINEER	DATE	TITLE: W.L. REPLACEMENT IN ALLEY E/O STANFORD, FROM CENTRAL TO GARFIELD DETAILS & SECTIONS
D.R.C. CHAIRPERSON	<i>[Signature]</i>	4/17/82	PROJECT NO. 3169 MAP NO. K-11 SHEET 7 OF 1
TRANS. DEV.	NA DENT	4/8/87	
UTILITY DEV.	<i>[Signature]</i>	4-1A-87	
PARKS & REC. DEPT.			
USER DEPT.			

NEW METER BOXES & PLATES & COLLARS

CITY OF ALBUQUERQUE

GAS STATION

NOTE: Contractor Shall Install Item(s) as Checked per House Number.

House Number	Street	* service line replacement and transfer	SIZE	Adjustment - estimate meter and box	
				not to finish per City Dept.	per City Dept.
112	Stanford Drive, S.E.	X	3/4"	X	
114	"	X	3/4"	X	
116	"	X	3/4"	X	
118	"	X	3/4"	X	
120	"	X	3/4"	X	
122	"	X	3/4"	X	
2511	Silver Ave., S.E.	X	3/4"	X	
124	Stanford Drive S.E.	X	3/4"	X	
202	"	X	3/4"	X	
204	"	X	3/4"	X	
206	"	X	3/4"	X	
208	"	X	3/4"	X	
210	"	X	3/4"	X	
212	"	X	3/4"	X	
214-B	"	X	3/4"	X	
214	"	X	3/4"	X	
216	"	X	3/4"	X	
218	"	X	3/4"	X	
220	"	X	3/4"	X	
2510	Lead Ave., S.E.	X	3/4"	X	
302	Stanford Dr., S.E.	X	3/4"	X	
306	"	X	3/4"	X	
308	"	X	3/4"	X	
310	"	X	3/4"	X	
312	"	X	3/4"	X	
314	"	X	3/4"	X	
316	"	X	3/4"	X	

HAD TO UPDATE BOXES & PLATES

HAD TO GET NEW

GAS STATION

