


FOUR HILLS VILLAGE
12th INSTALLMENT
WORK COMPLETED

ESTIMATE NO. W-19-74-2-1-A
PROJECT 74-4
SHIVER CONSTRUCTION
MAP NO. M-27-S

SHEET NO. 1

POLICY 6a
DATE ENTERED ON MAPS

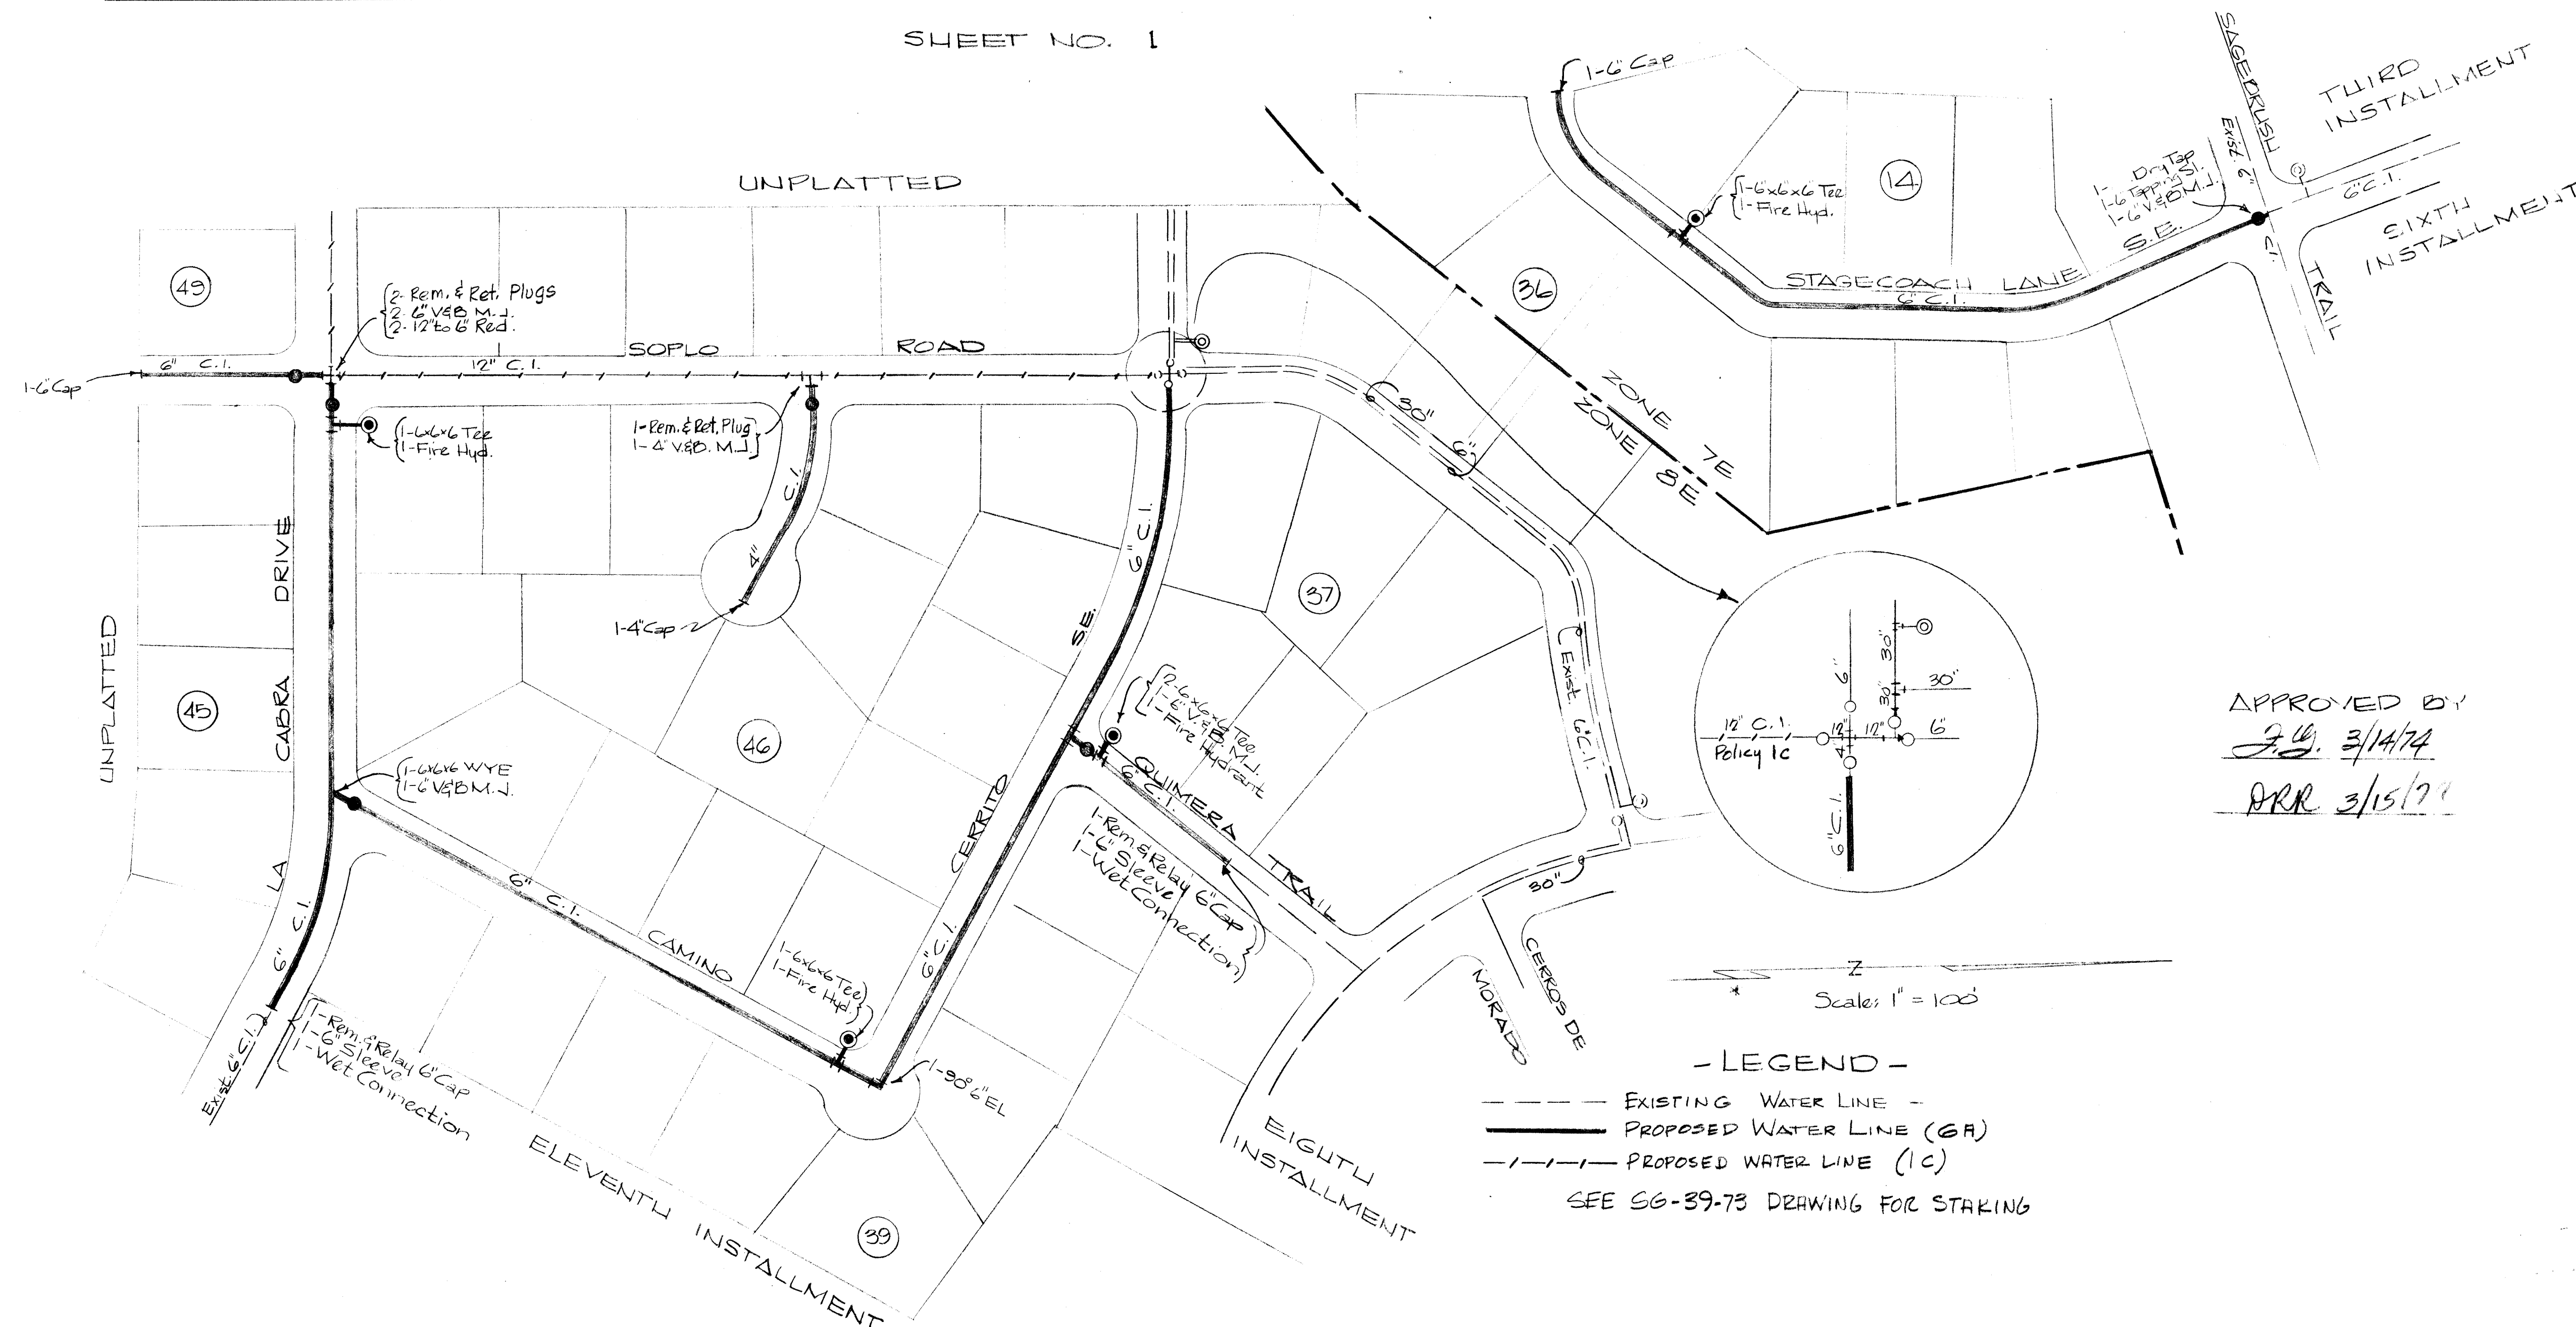

APPROVED BY
J.G. 3/14/74
PRR 3/15/74


- LEGEND -

- EXISTING WATER LINE ---
 - PROPOSED WATER LINE (6A) ---
 - - - PROPOSED WATER LINE (1C) - - -
- SEE SG-39-73 DRAWING FOR STAKING

FOUR HILLS VILLAGE
12th INSTALLMENT
WORK COMPLETED

ESTIMATE NO. W-19-74-2-2
AGREEMENT NO. 1425-74
KENT, NOWLIN
MAP NO. M-27-S
AGENDA ITEM NO. 8
SHEET NO. 1
CITY COMMISSION W.O. #609

POLICY 1C
DATE ENTERED ON MAPS

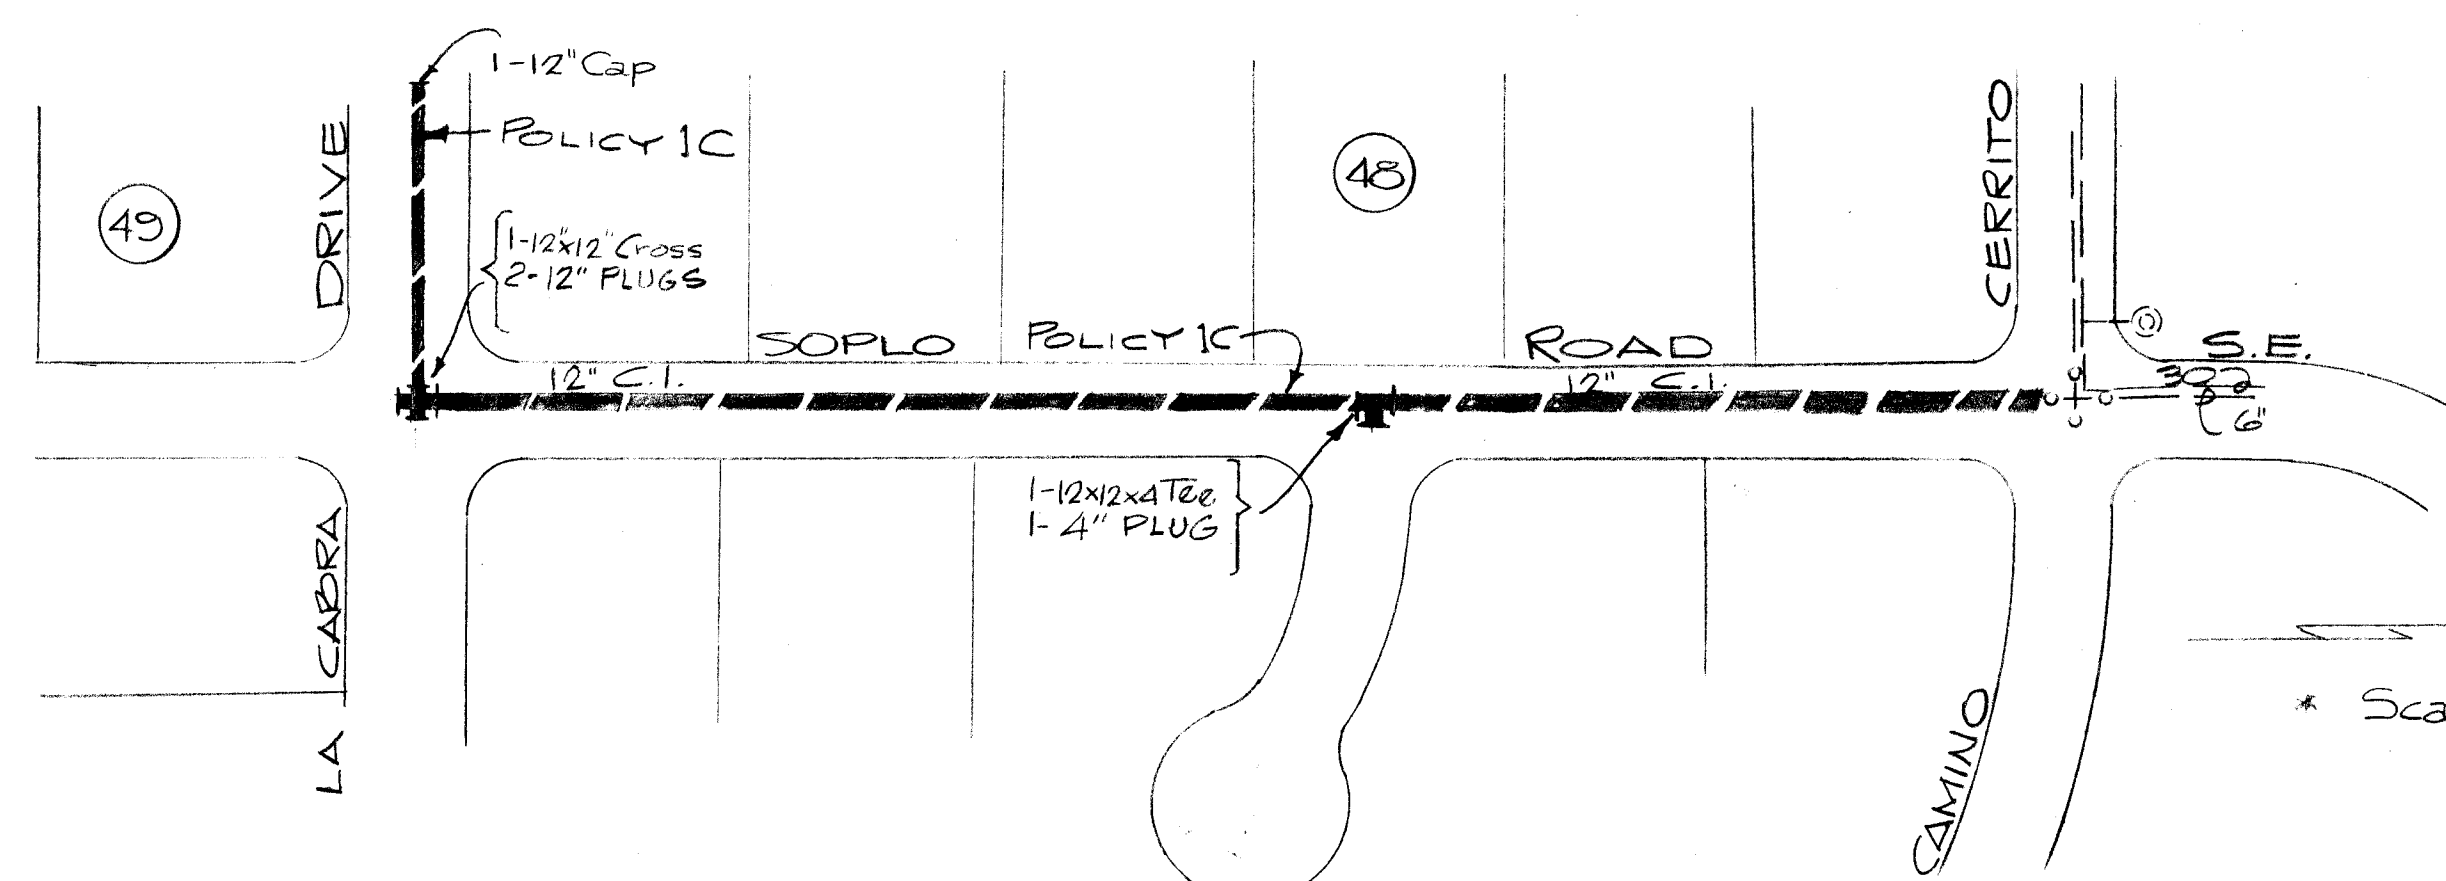

- LEGEND -

- EXISTING WATER LINE ---
- PROPOSED WATER LINE ---

SEE SG-39-73 DRAWING
FOR STAKING

APPROVED BY
J.G. 3/14/74

PRR 3/15/74

* Scale: 1" = 100'


1	2	3	4	5	6	7	8	9	10	11	12	13	14	15	16	17	18	19	20	21	22	23	24	25	26	27	28	29	30	31
03																					0174									

CITY OF ALBUQUERQUE PUBLIC WORKS DEPARTMENT ENGINEERING DIVISION		
TITLE BLK. TO BLK. 1974		
DESIGN	APPROVAL	AS BUILT
DESIGNED BY DATE DRAWN BY DATE CHECKED BY DATE	BY DATE BY DATE BY DATE	SUBMITTED BY DATE RECORDED BY DATE SHEET NO. SHEET
DRAWING NUMBER		

SCANNED BY
BY LASON

Sheet No. 1

POLICY 6a
ENTERED ON MAPS

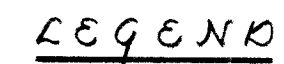

—W— Exist. water line
 (H) Exist. Fire Hydrant
 (●) Prop. Fire Hydrant

APPROVAL
F.G. 3/21/74

POLICY 8b
ENTERED ON MAPS



 Prop. Wtr. Line.
 — W — Exist. Wtr. Line

APPROVAL

CJ 9/30/14
HAR 5/30/14


WORK ORDER NO.
65

— LEGEND —
 Existing Waterline
 Proposed Waterline

APPROVED BY
F. B. 3/25/74
DRK 442/00

[illegible]

NO.	DATE	REMARKS				RECORDED BY	
REVISIONS							
CITY OF ALBUQUERQUE PUBLIC WORKS DEPARTMENT ENGINEERING DIVISION							
TITLE BLK TO BLK 74'							
DESIGN		APPROVAL			AS BUILT		
SUBMITTED BY		BY			SUBMITTED BY		
DATE TITLE		DATE TITLE			DATE TITLE		
DRAWN BY		BY			RECORDED BY		
DATE TITLE		DATE TITLE			DATE TITLE		
CHECKED BY		BY			SHEET NO. 27 OF		
DATE TITLE		DATE TITLE			SHEETS		
DRAWING NUMBER		SHT. 2					

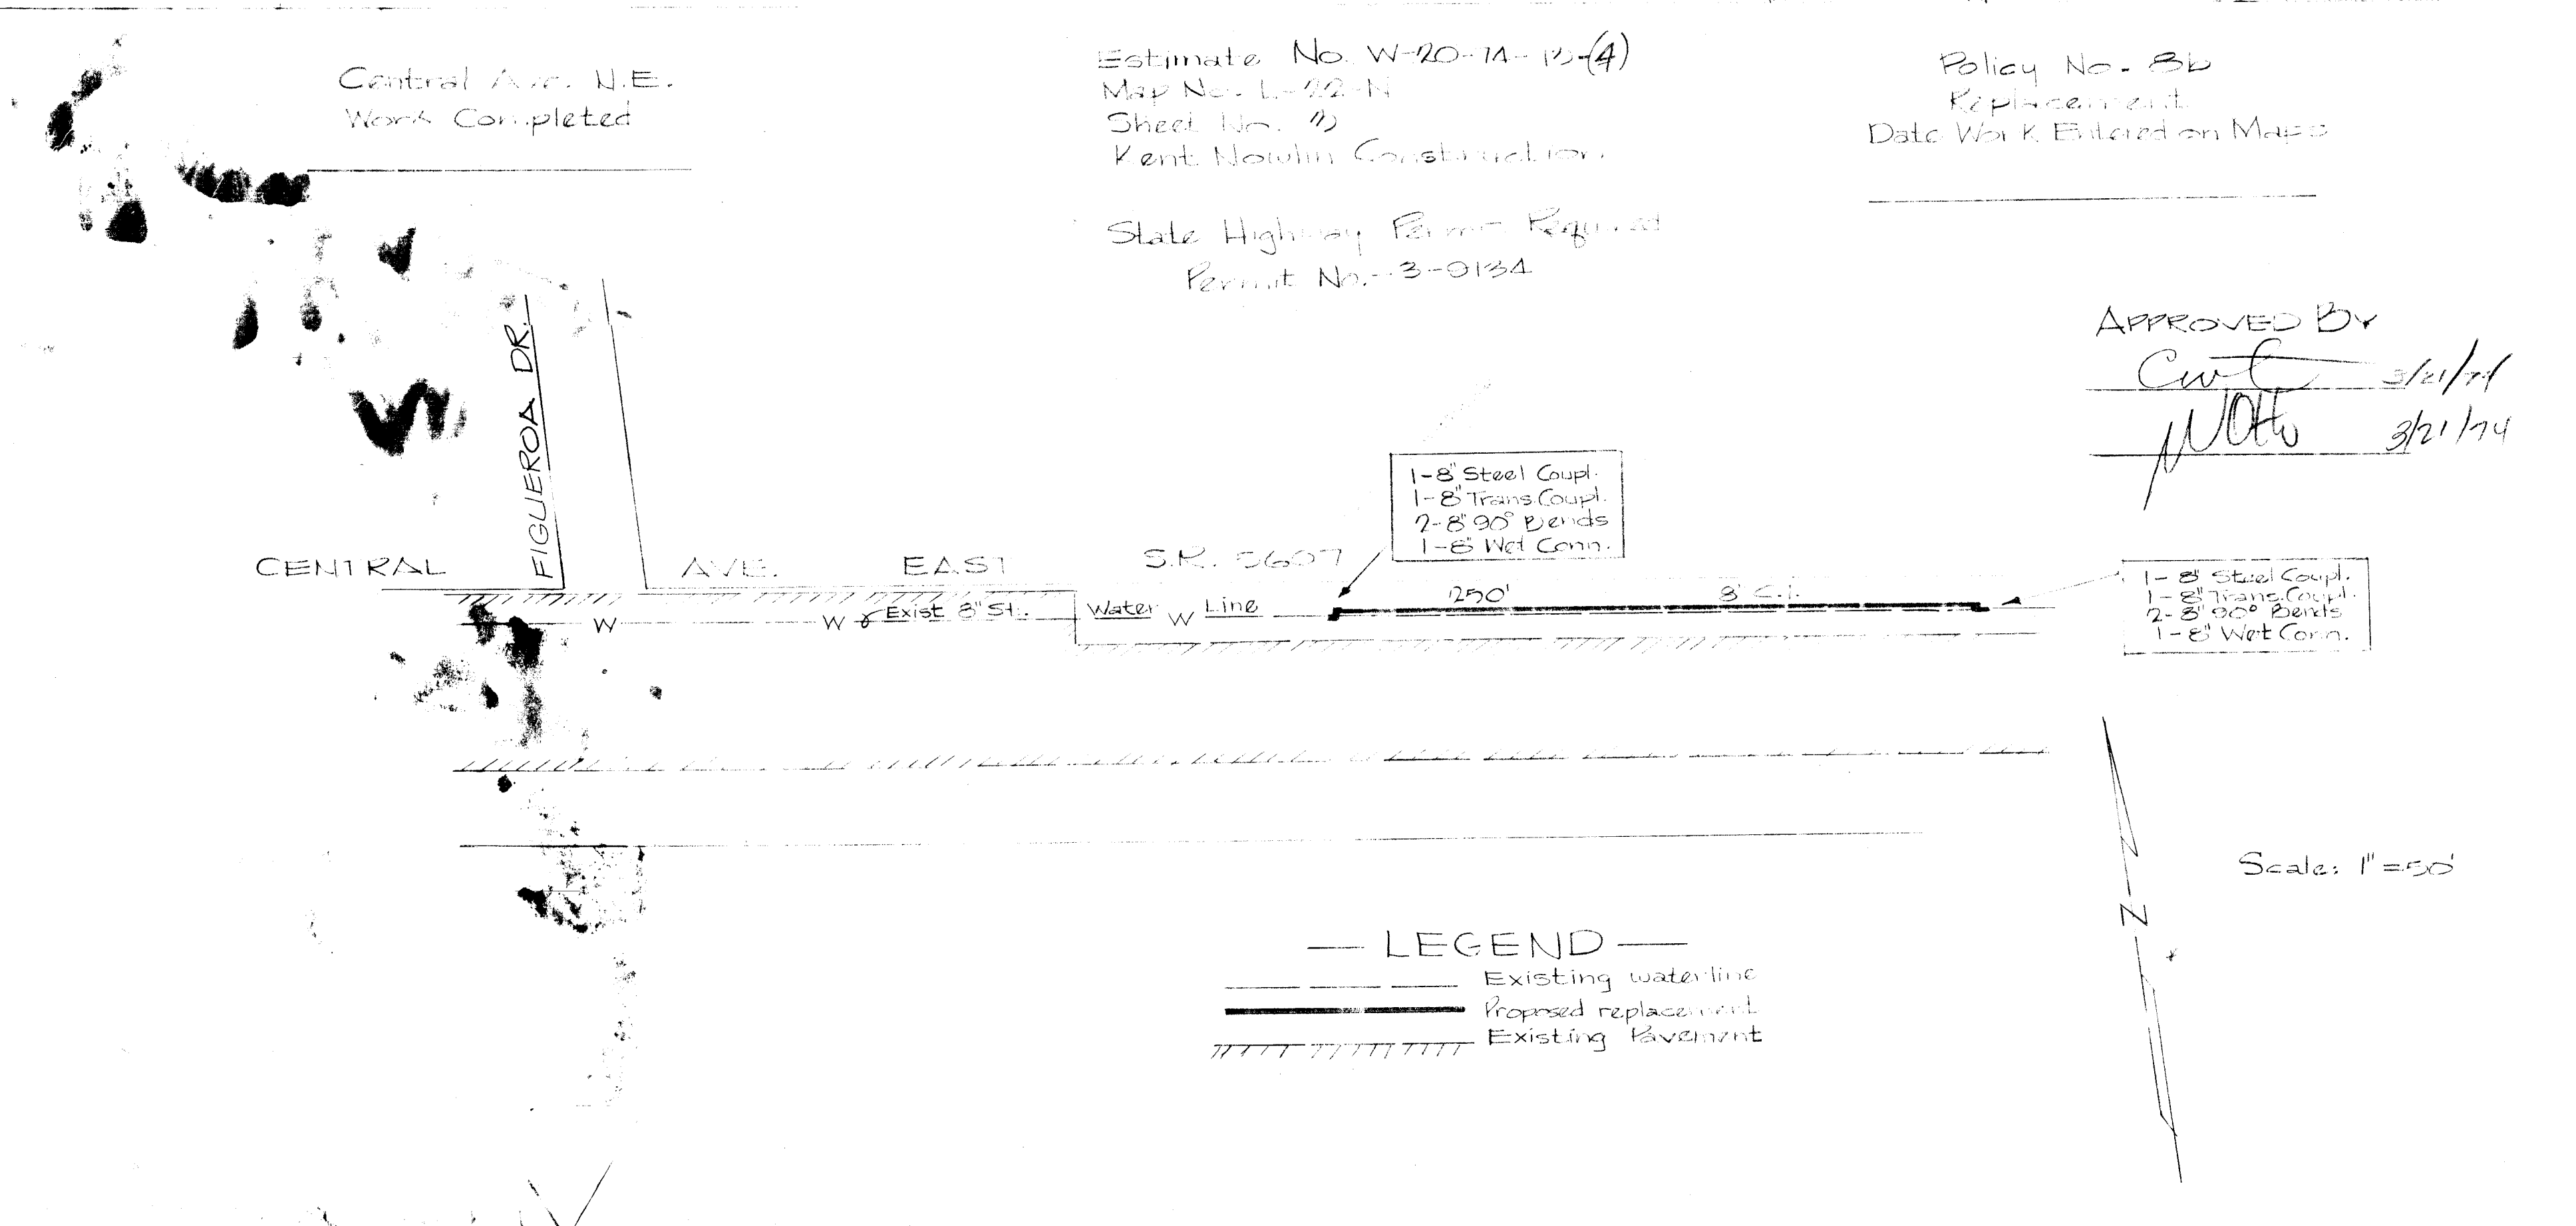

NO.	DATE	REMARKS		RECORDED BY
REVISIONS				
CITY OF ALBUQUERQUE PUBLIC WORKS DEPARTMENT ENGINEERING DIVISION				
TITLE				
BLK. TO BLK. 1974				
DESIGN		APPROVAL		AS BUILT
DESIGNED BY	BY	SUBMITTED BY		
DATE TITLE	DATE TITLE	DATE TITLE		
DRAWN BY <i>D. Howell</i>	DATE	RECORDED BY		
DATE <i>3/14</i> TITLE	DATE TITLE	DATE TITLE		
CHECKED BY	BY	SHEET NO. <i>5</i> OF		
DATE TITLE	DATE TITLE	SHEETS		
DRAWING NUMBER		Sheet No. <i>5</i>		


APPROVED BY

CWT 3/26/74

RRR 3/26/74

LEGEND

— PROP. WATER LINE
— W — EXIST. WATER LINE

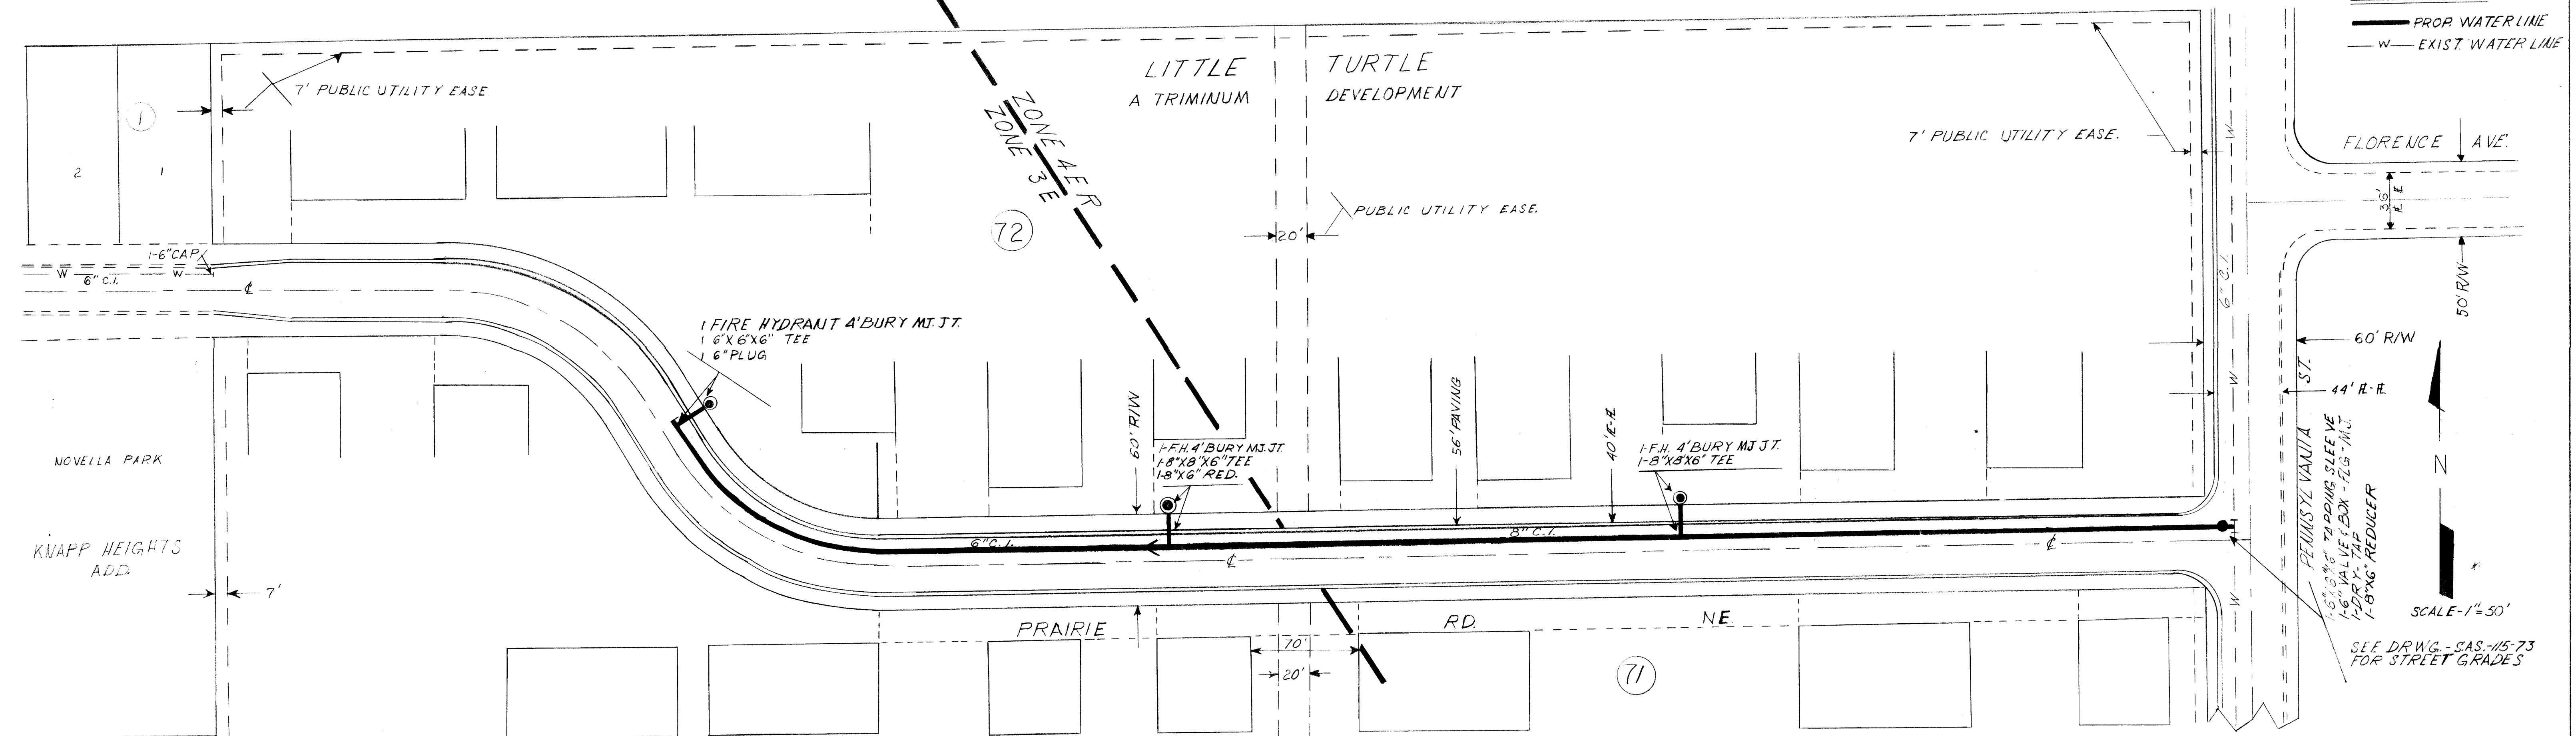


Switching Station Site
Public Service Co.
East of Trumby Blvd.
Date Work Completed

ESTIMATE NO. W-18-14-1-6
WATER ASSESSMENT NO. 1426-74
SHEET NO. 4
MAP NO. G-24-N

POLICY NO. 62.9 SL
DATE WORK ENTERED IN NAME

Approved By
Curt 4/16/71
J.R.R. 4/13/71

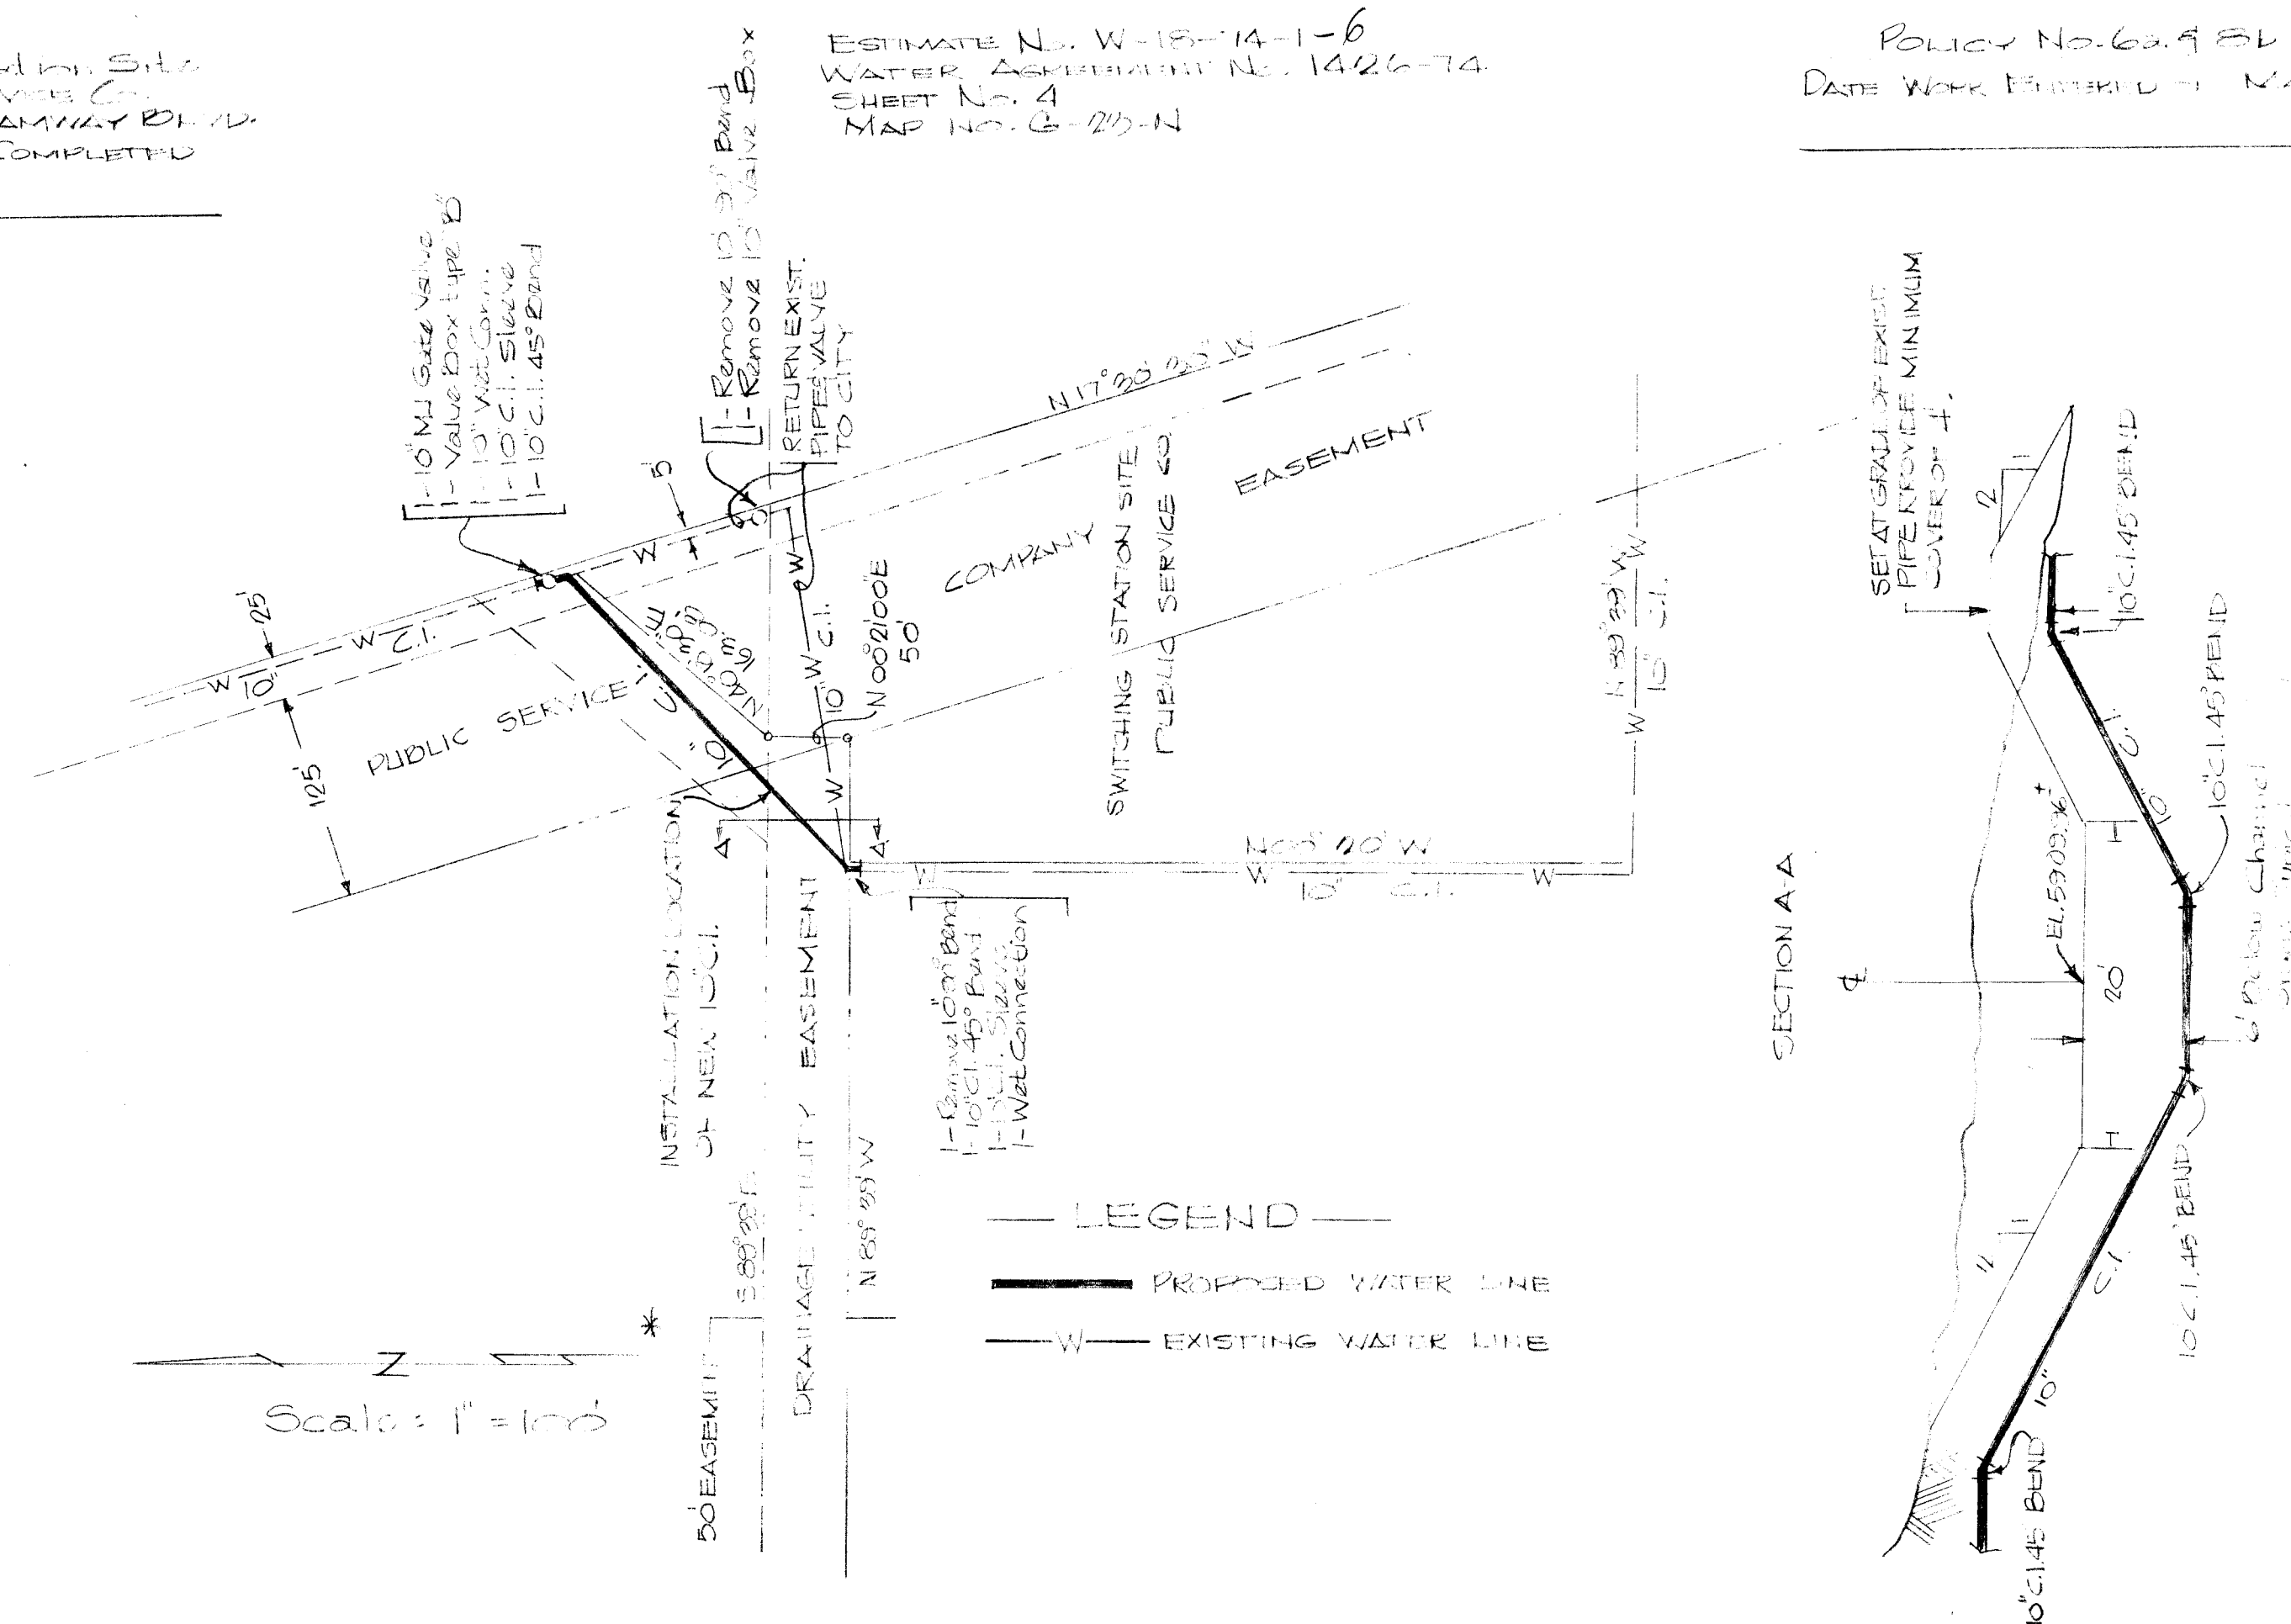[illegible]


CITY OF ALBUQUERQUE		
PUBLIC WORKS DEPARTMENT		
ENGINEERING DIVISION		
FILE BLK TO BLK-74		
SUBMITTED BY	APPROVED BY	PRELIMINARY DRAWING
DATE	DATE	DATE
DESIGNED BY	APPROVED BY	CONSTRUCTION DRAWING
DATE	DATE	DATE
DRAWN BY	APPROVED BY	AS BUILT DRAWING
DATE	DATE	DATE
CHECKED BY	APPROVED BY	PLS. NO.
DATE	DATE	
REV. BY	REVISIONS	
DATE		
PREP. BY	TRACES	SHEET NO. 4 OF 10
DATE		SHEETS:

SCANNED BY
BY LASON

BOARD OF EDUCATION
ADDITION
WORK COMPLETED

POLICY 8-b
ENTERED ON MAPS

ESTIMATE NO. W-86-74-76
MAP NO. 6-17-5
KENT NOWLIN CONSTRUCTION
SHEET NO. 5

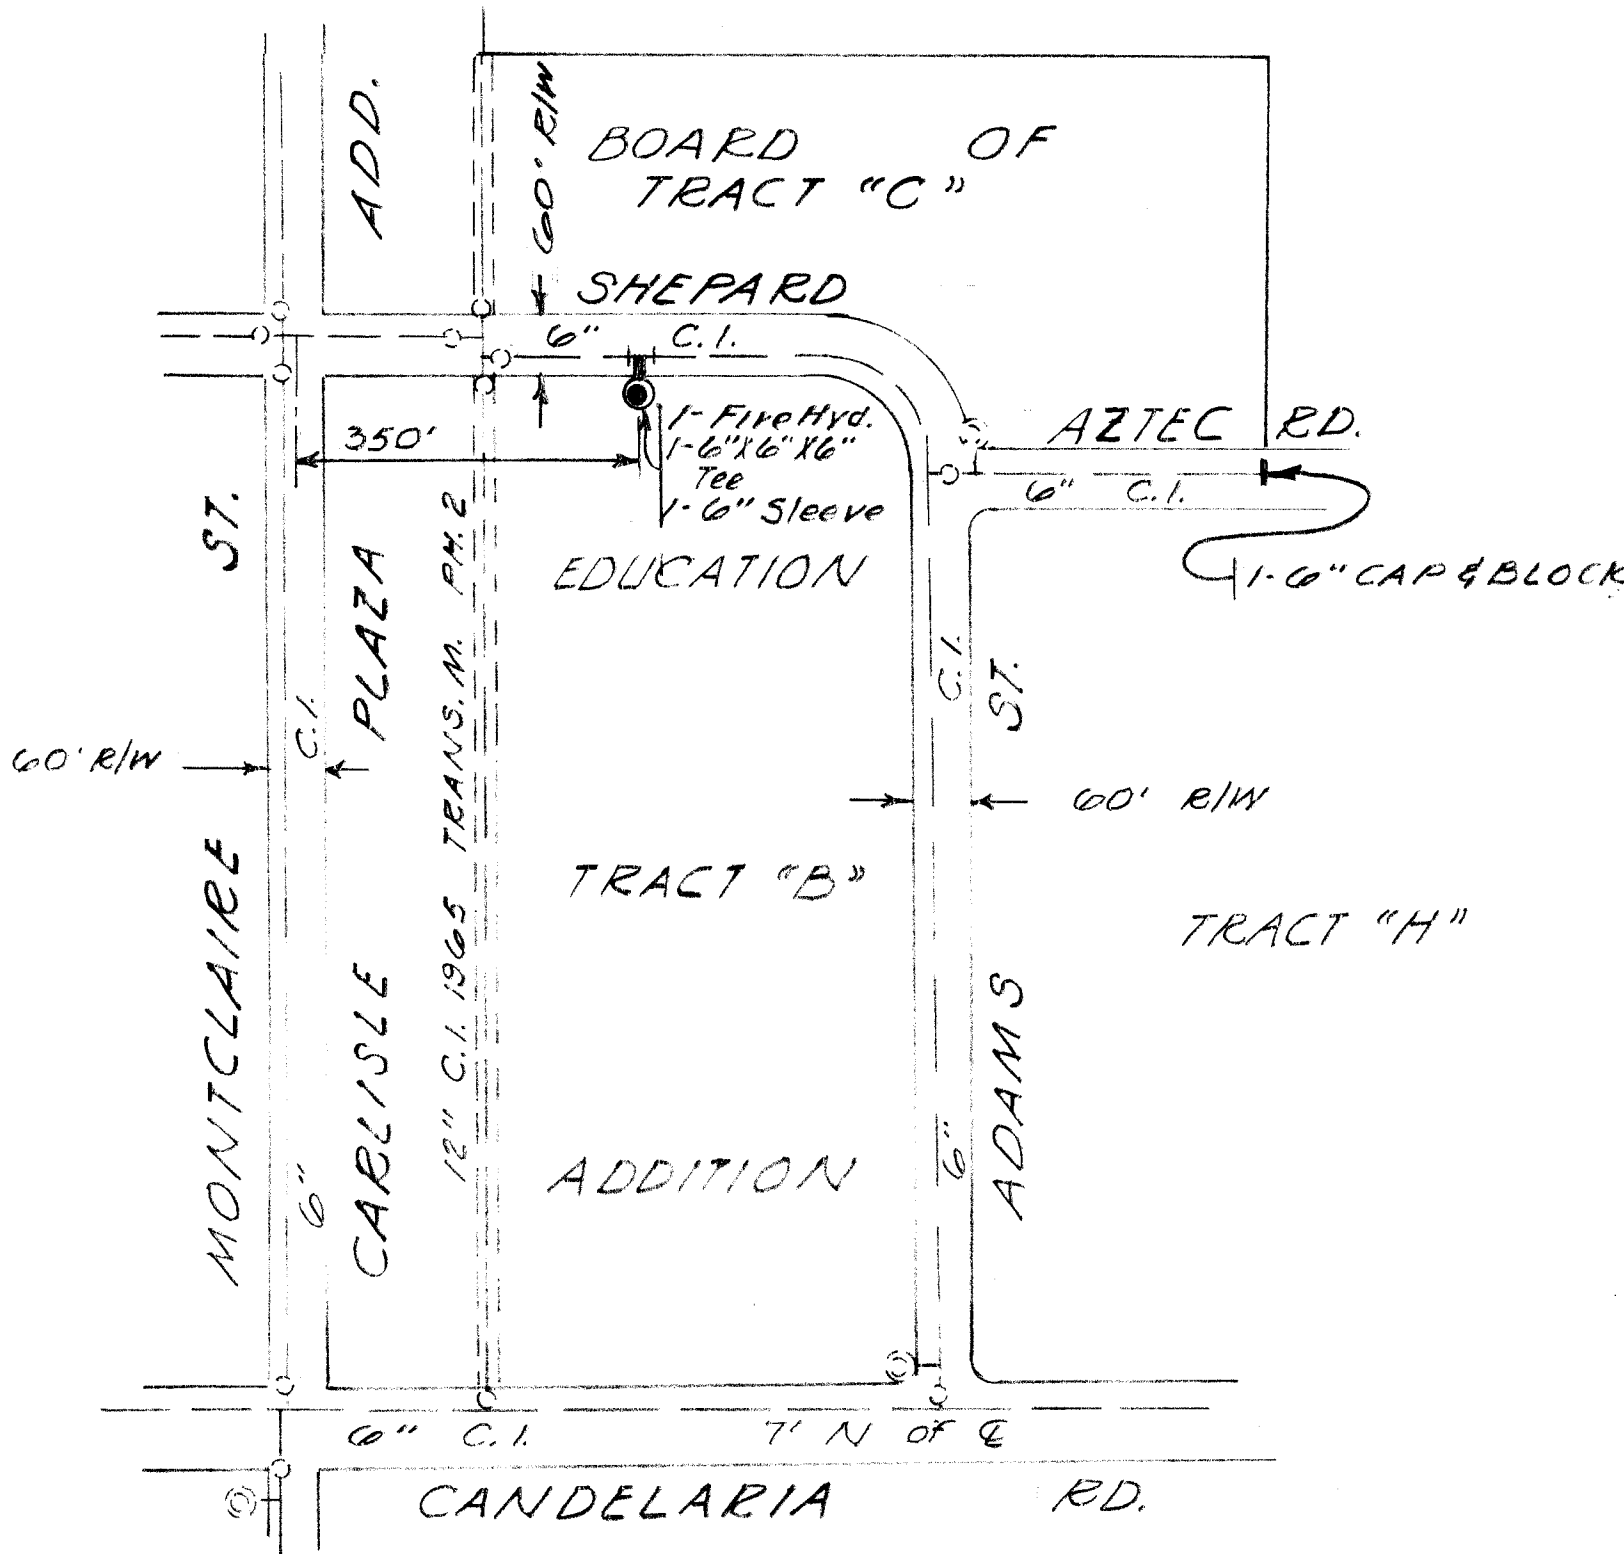

APPROVALS

OK 8/19/74
OK 8/10/74

LEGEND

PROPR. WATER
EXIST. WATER

SCALE - 1" = 200'

WORK ORDER NO. 55



INTERSTATE INDUSTRIAL TRACT
DATE WORK COMPLETED

ESTIMATE NO. W-176-72 (1D) (8-A)
MAP NO. E-17-N
SHEET NO. 5
CO-CON, INC.
REQUEST No 74-B

POLICY No. 6a
DATE WORK ENTERED ON MAPS

APPROVED BY
J. G. 4/8/74

OK 4/9/74

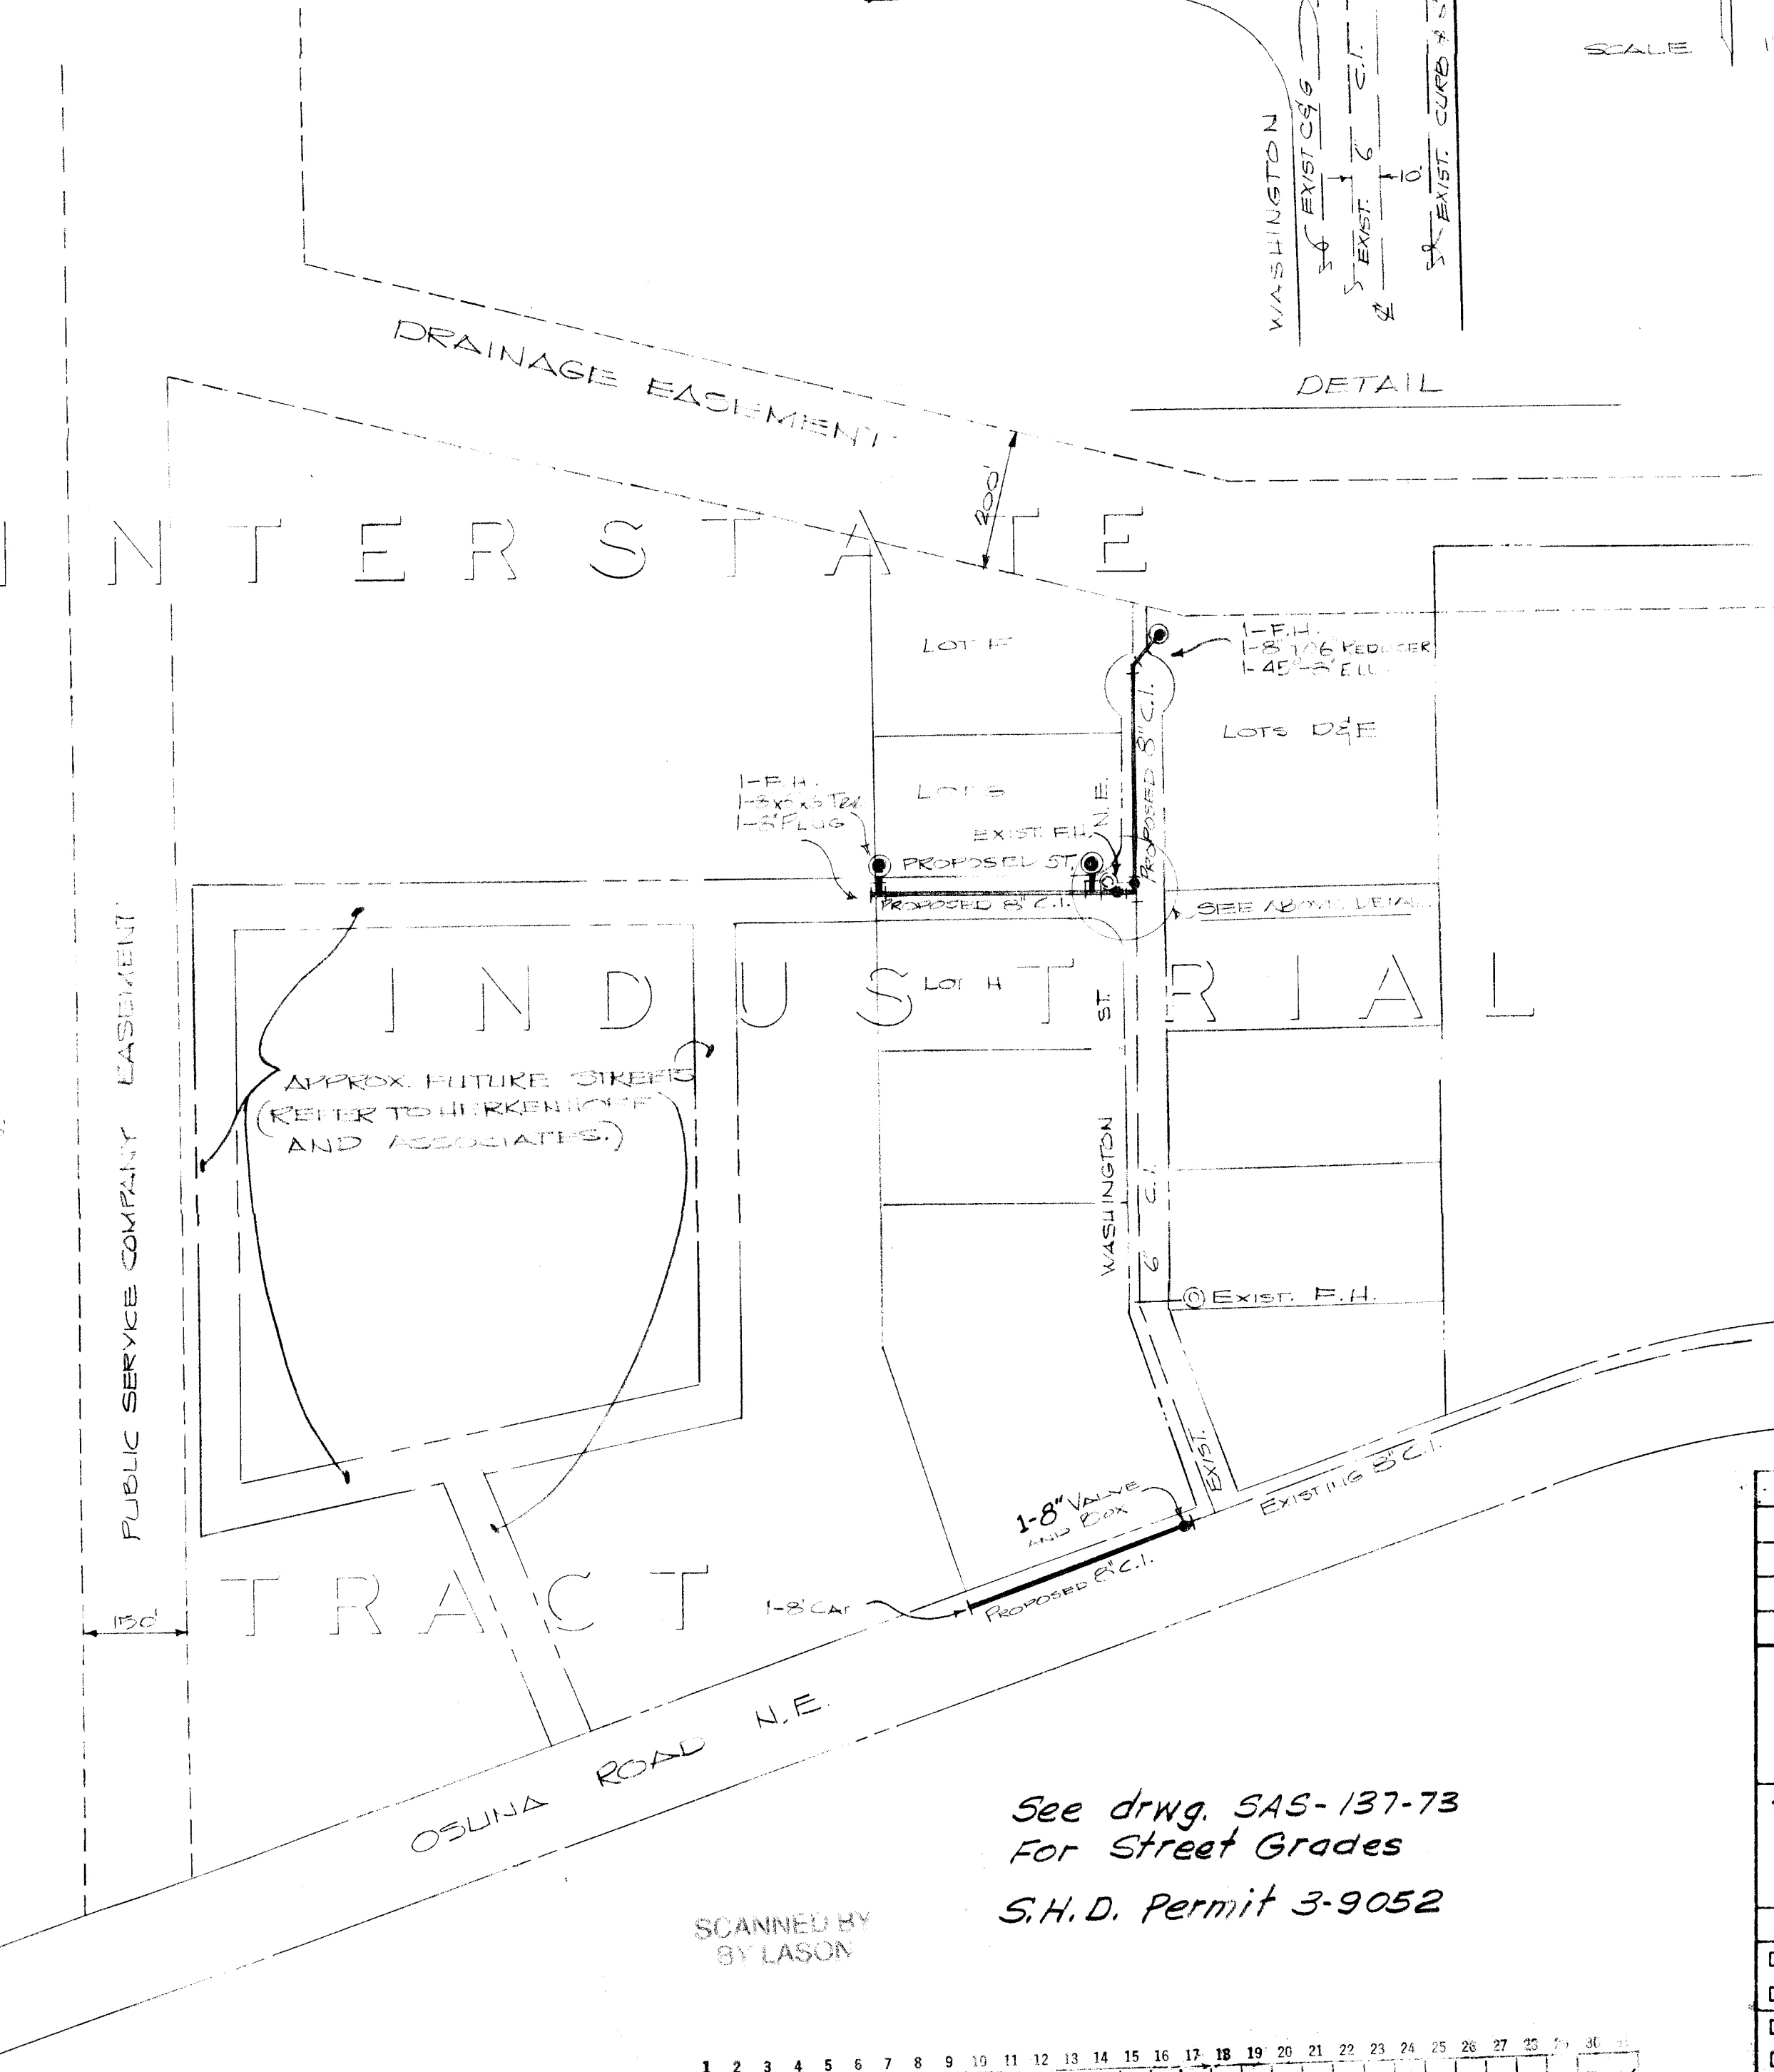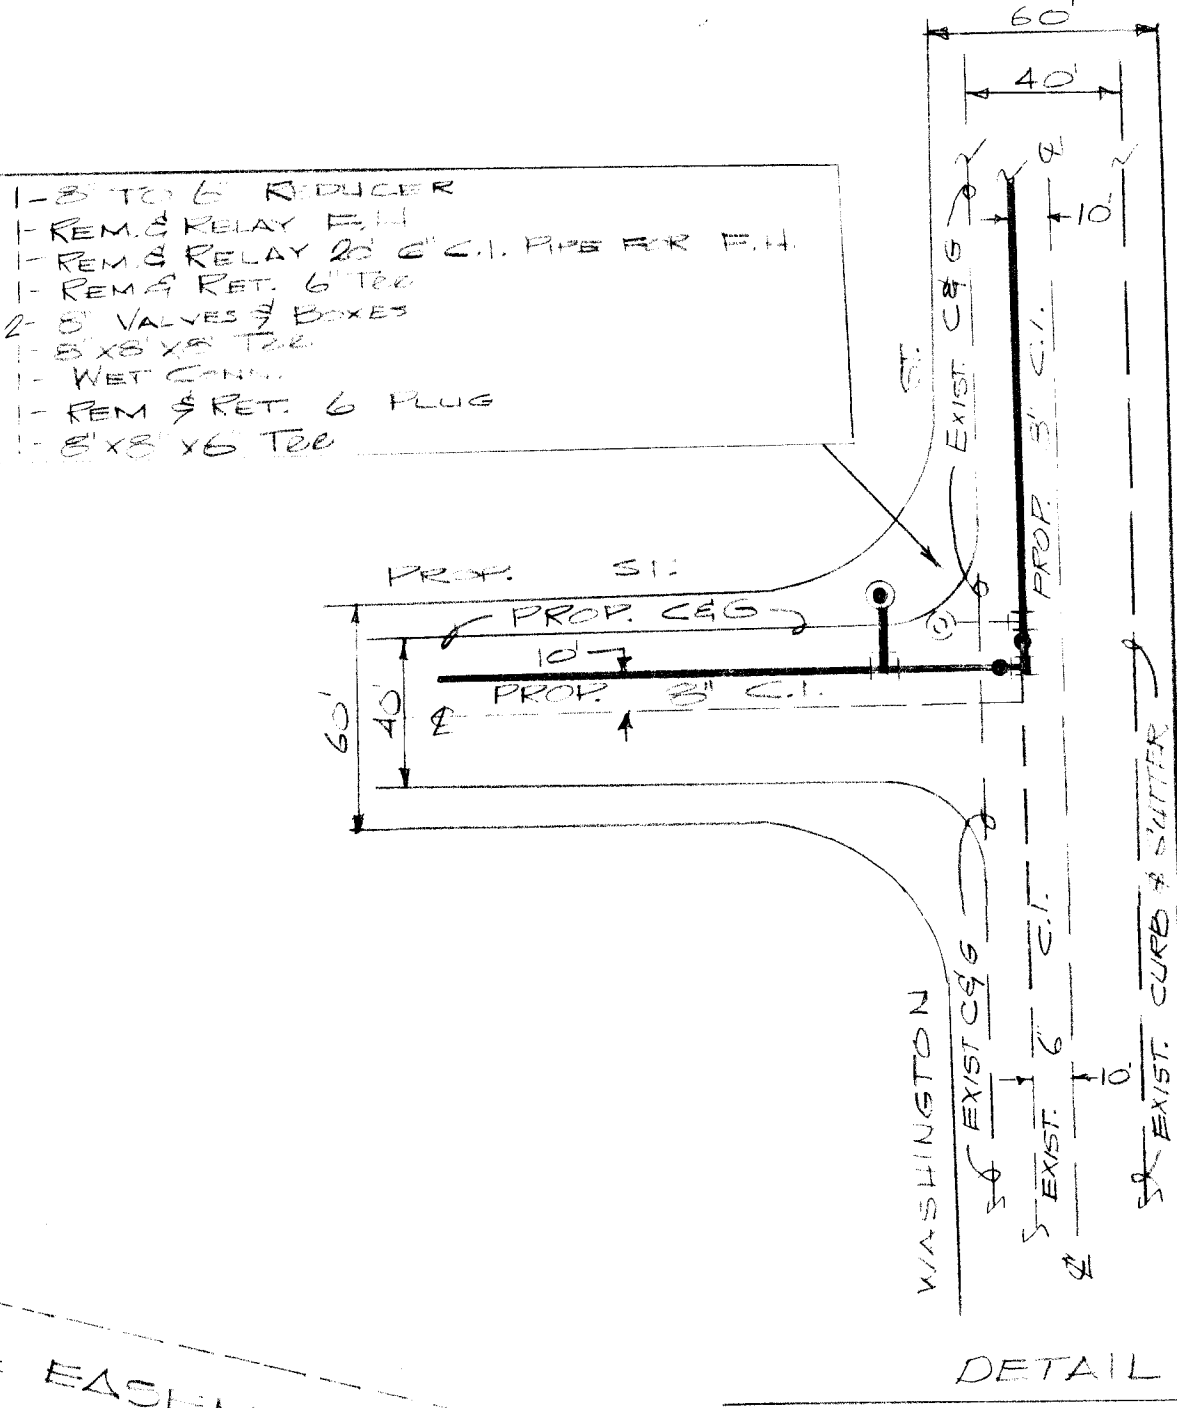

SCANNED BY LASON

03 0574 01 374

See drwg. SAS-137-73
For Street Grades
S.H.D. Permit 3-9052

NO.	DATE	REMARKS	RECORDED
CITY OF ALBUQUERQUE PUBLIC WORKS DEPARTMENT ENGINEERING DIVISION			
TITLE BLK. TO BLK. 74			
DESIGN		APPROVAL	AS BUILT
DESIGNED BY	BY	DATE	SUBMITTED BY
DATE	TITLE	DATE	TITLE
DRAWN BY B. Newell	BY	DATE	RECORDED BY
DATE 4/74	TITLE	DATE	TITLE
CHECKED BY	BY	DATE	SHEET NO. OF
DATE	TITLE	DATE	SHEETS
DRAWING NUMBER		SHEET No. 5	

LOS PASTORES
SHOPPING CENTER
WORK COMPLETED


ESTIMATE NO. W-2-74-10-11
MAP NO. F-19-S
WATER AGREEMENT NO. 1427-74
KENT NOWLIN CONST. INC.
SHEET NO. 6

POLICY 6a
ENTERED ON MAPS

APPROVALS
J.G. 4/23/74

APR 9/25/74

NOTE: STATE HIWAY PERMIT
REQUIRED. NO. 3-9133

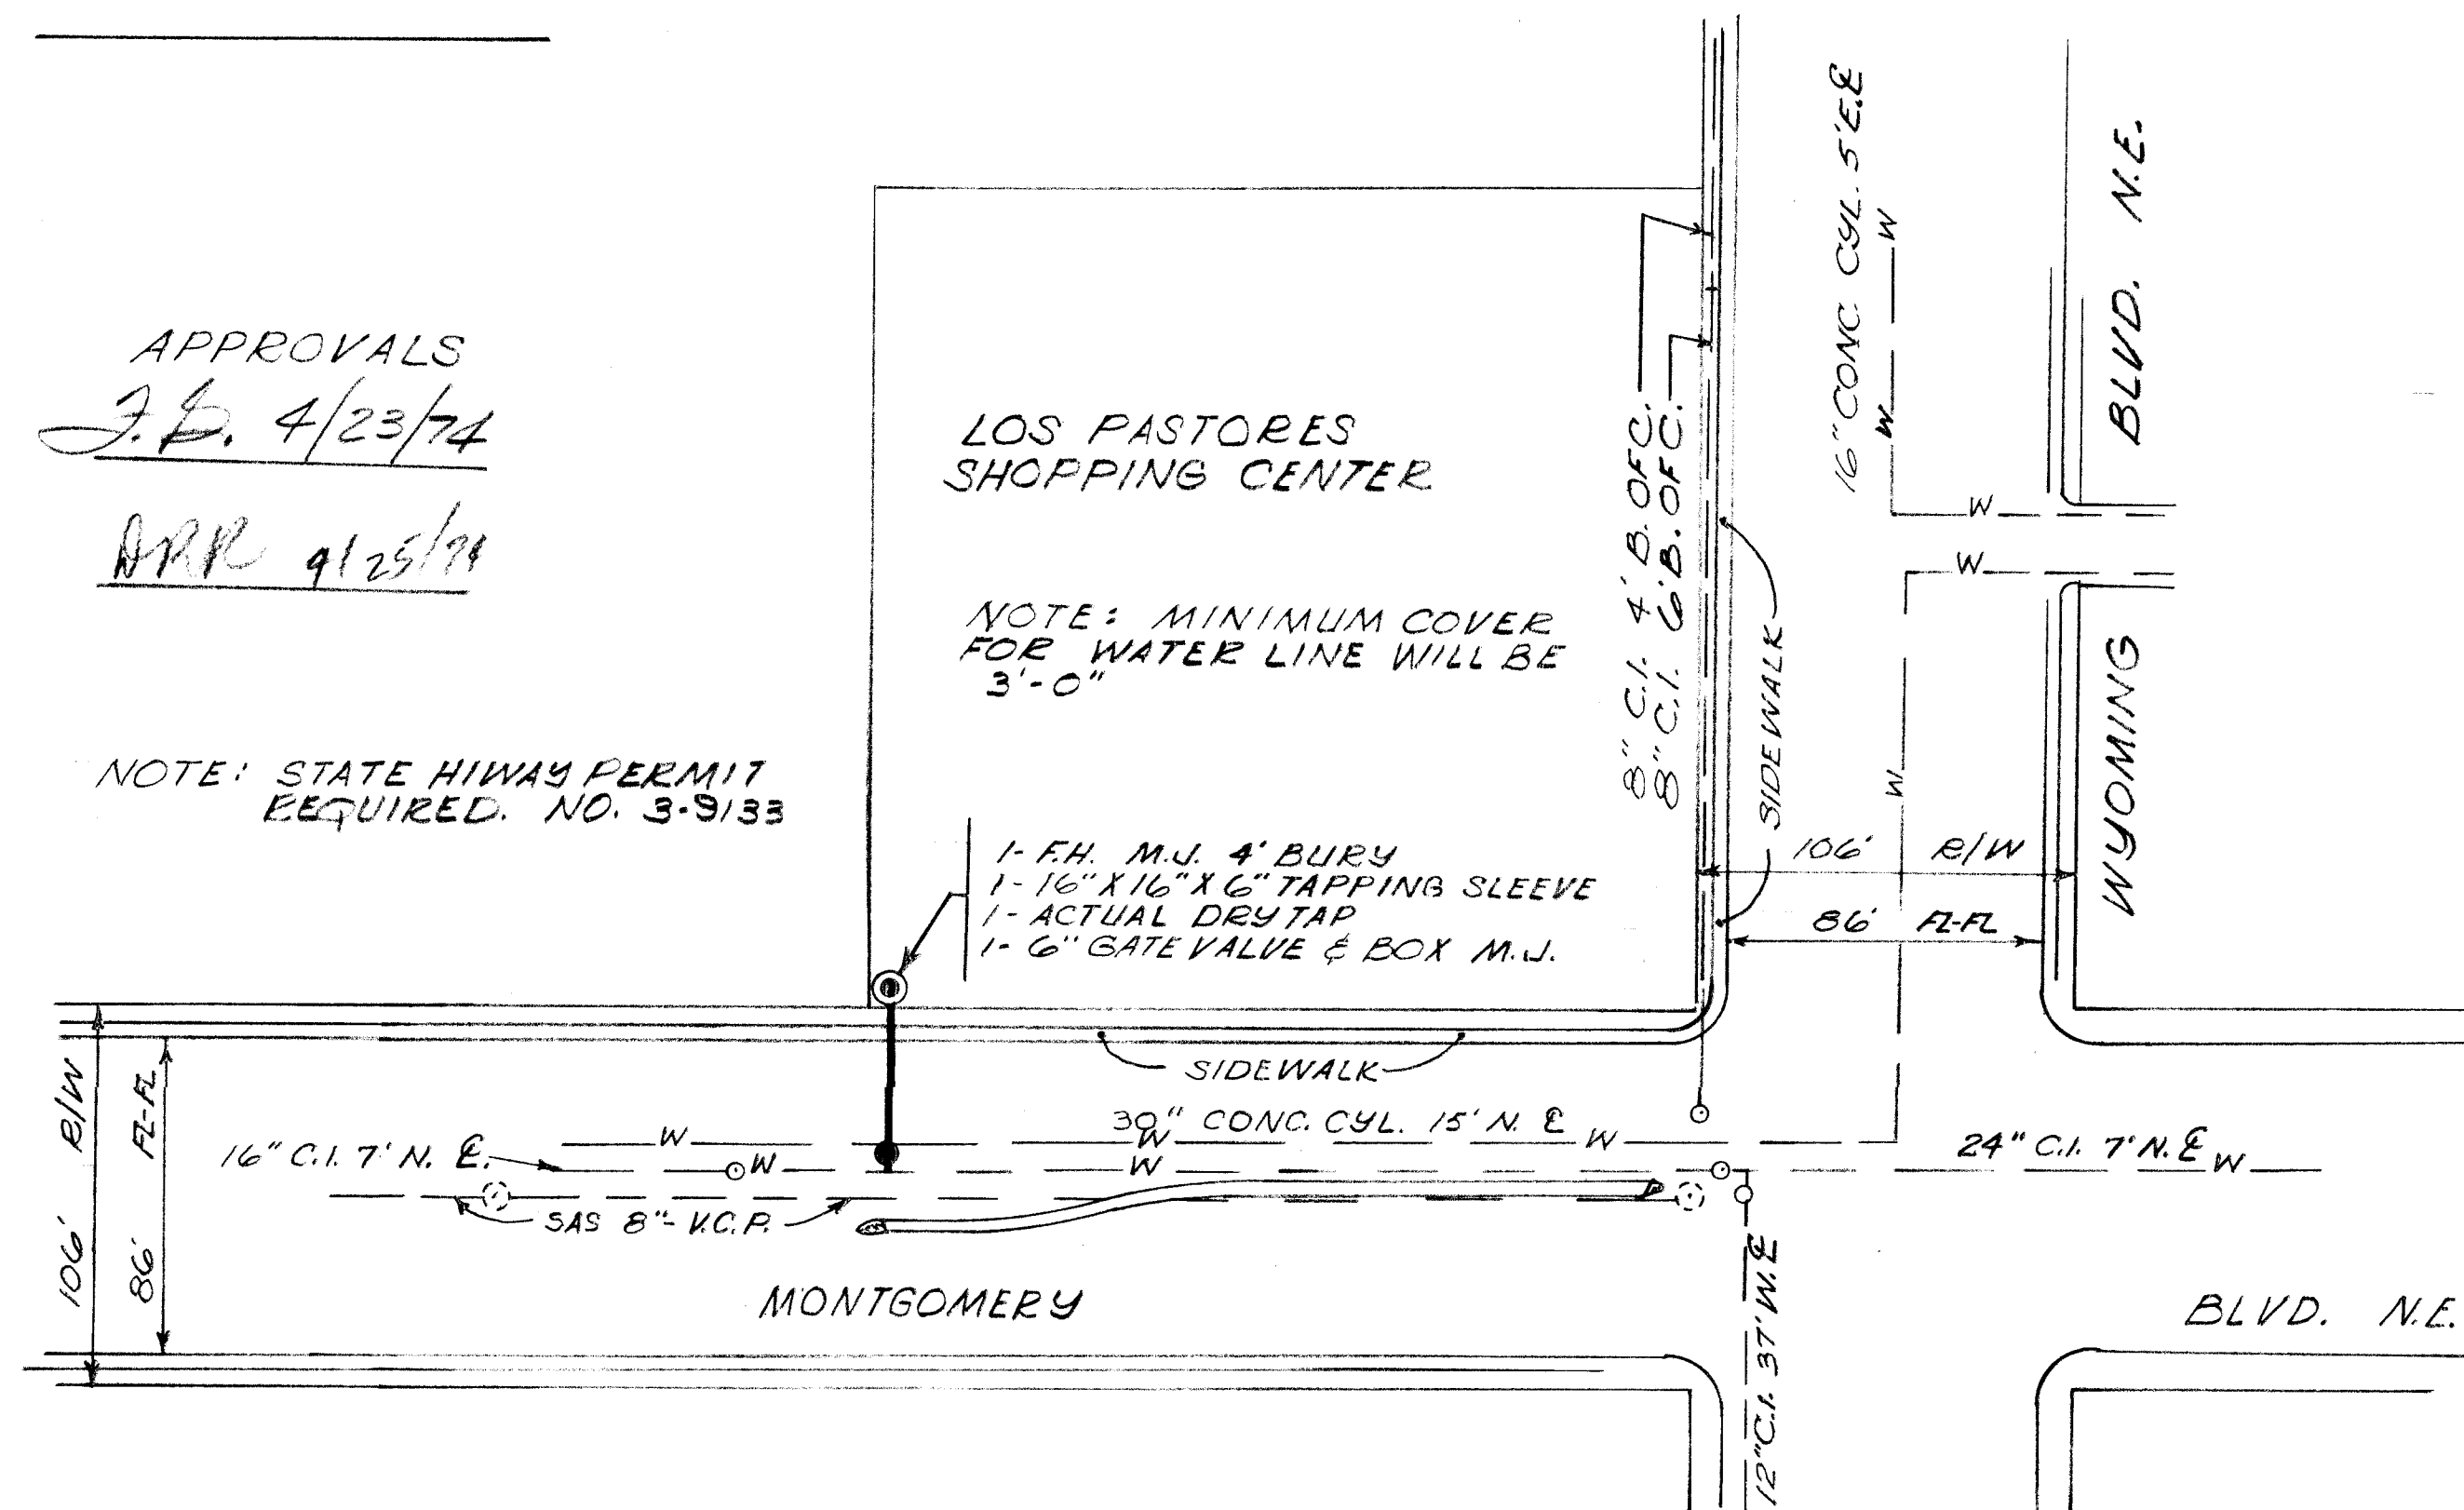

LEGEND

—W— PROP. F.H.
—W— EXIST. WATER LINE

SCALE 1" = 50'


REGINA ADDITION
WORK COMPLETED

ESTIMATE NO. W-22-74-22-7
MAP NO. U-11-S
KENT NOWLIN CONST. INC.
SHEET NO. 6

POLICY 5a
ENTERED ON MAPS

R E G I N A A D D .

FOR STAKING SEE DRWG SG-7-74

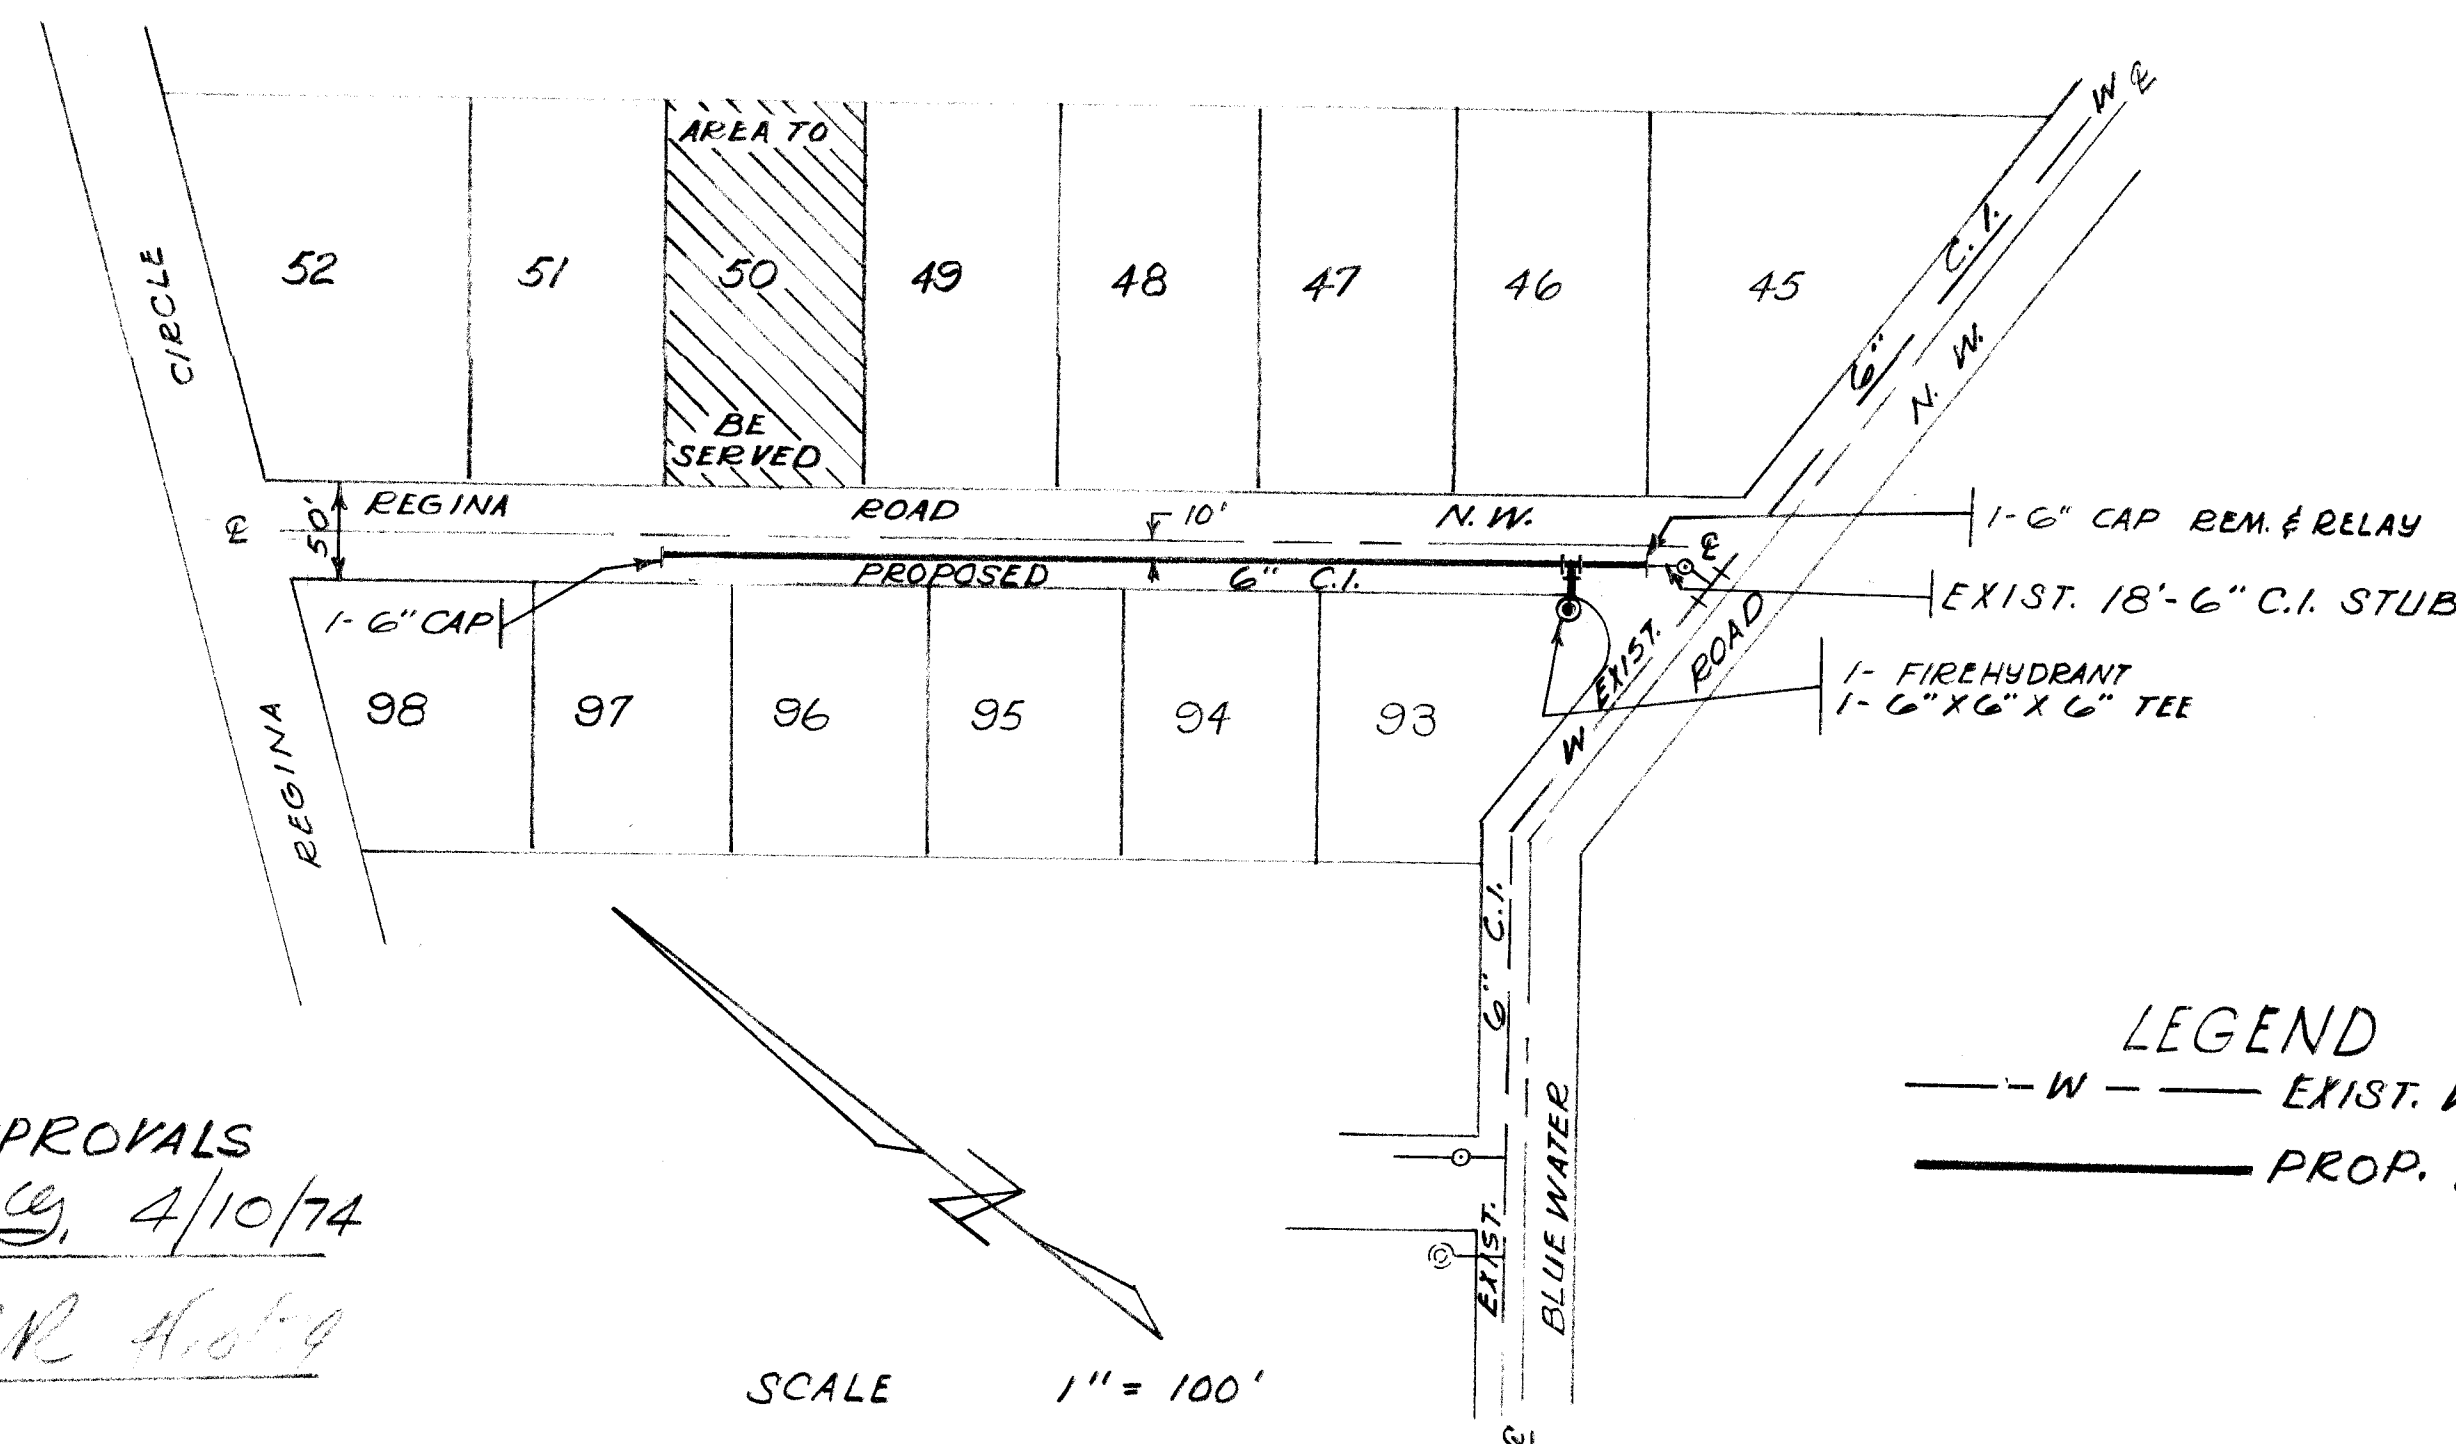

LEGEND

—W— EXIST. WATER LINE
—W— PROP. WATER LINE

SCALE 1" = 100'


APPROVALS
J.G. 4/10/74

APR 4/10/74

NORTHERN HEIGHTS ADDITION
WORK COMPLETED

ESTIMATE NO. W-37-74-27-10
MAP NO. J-10 & J-11S
WATER AGREEMENT NO. 1428-74
KENT NOWLIN CONST. INC.
SHEET NO. 6

POLICY 6a
ENTERED ON MAPS

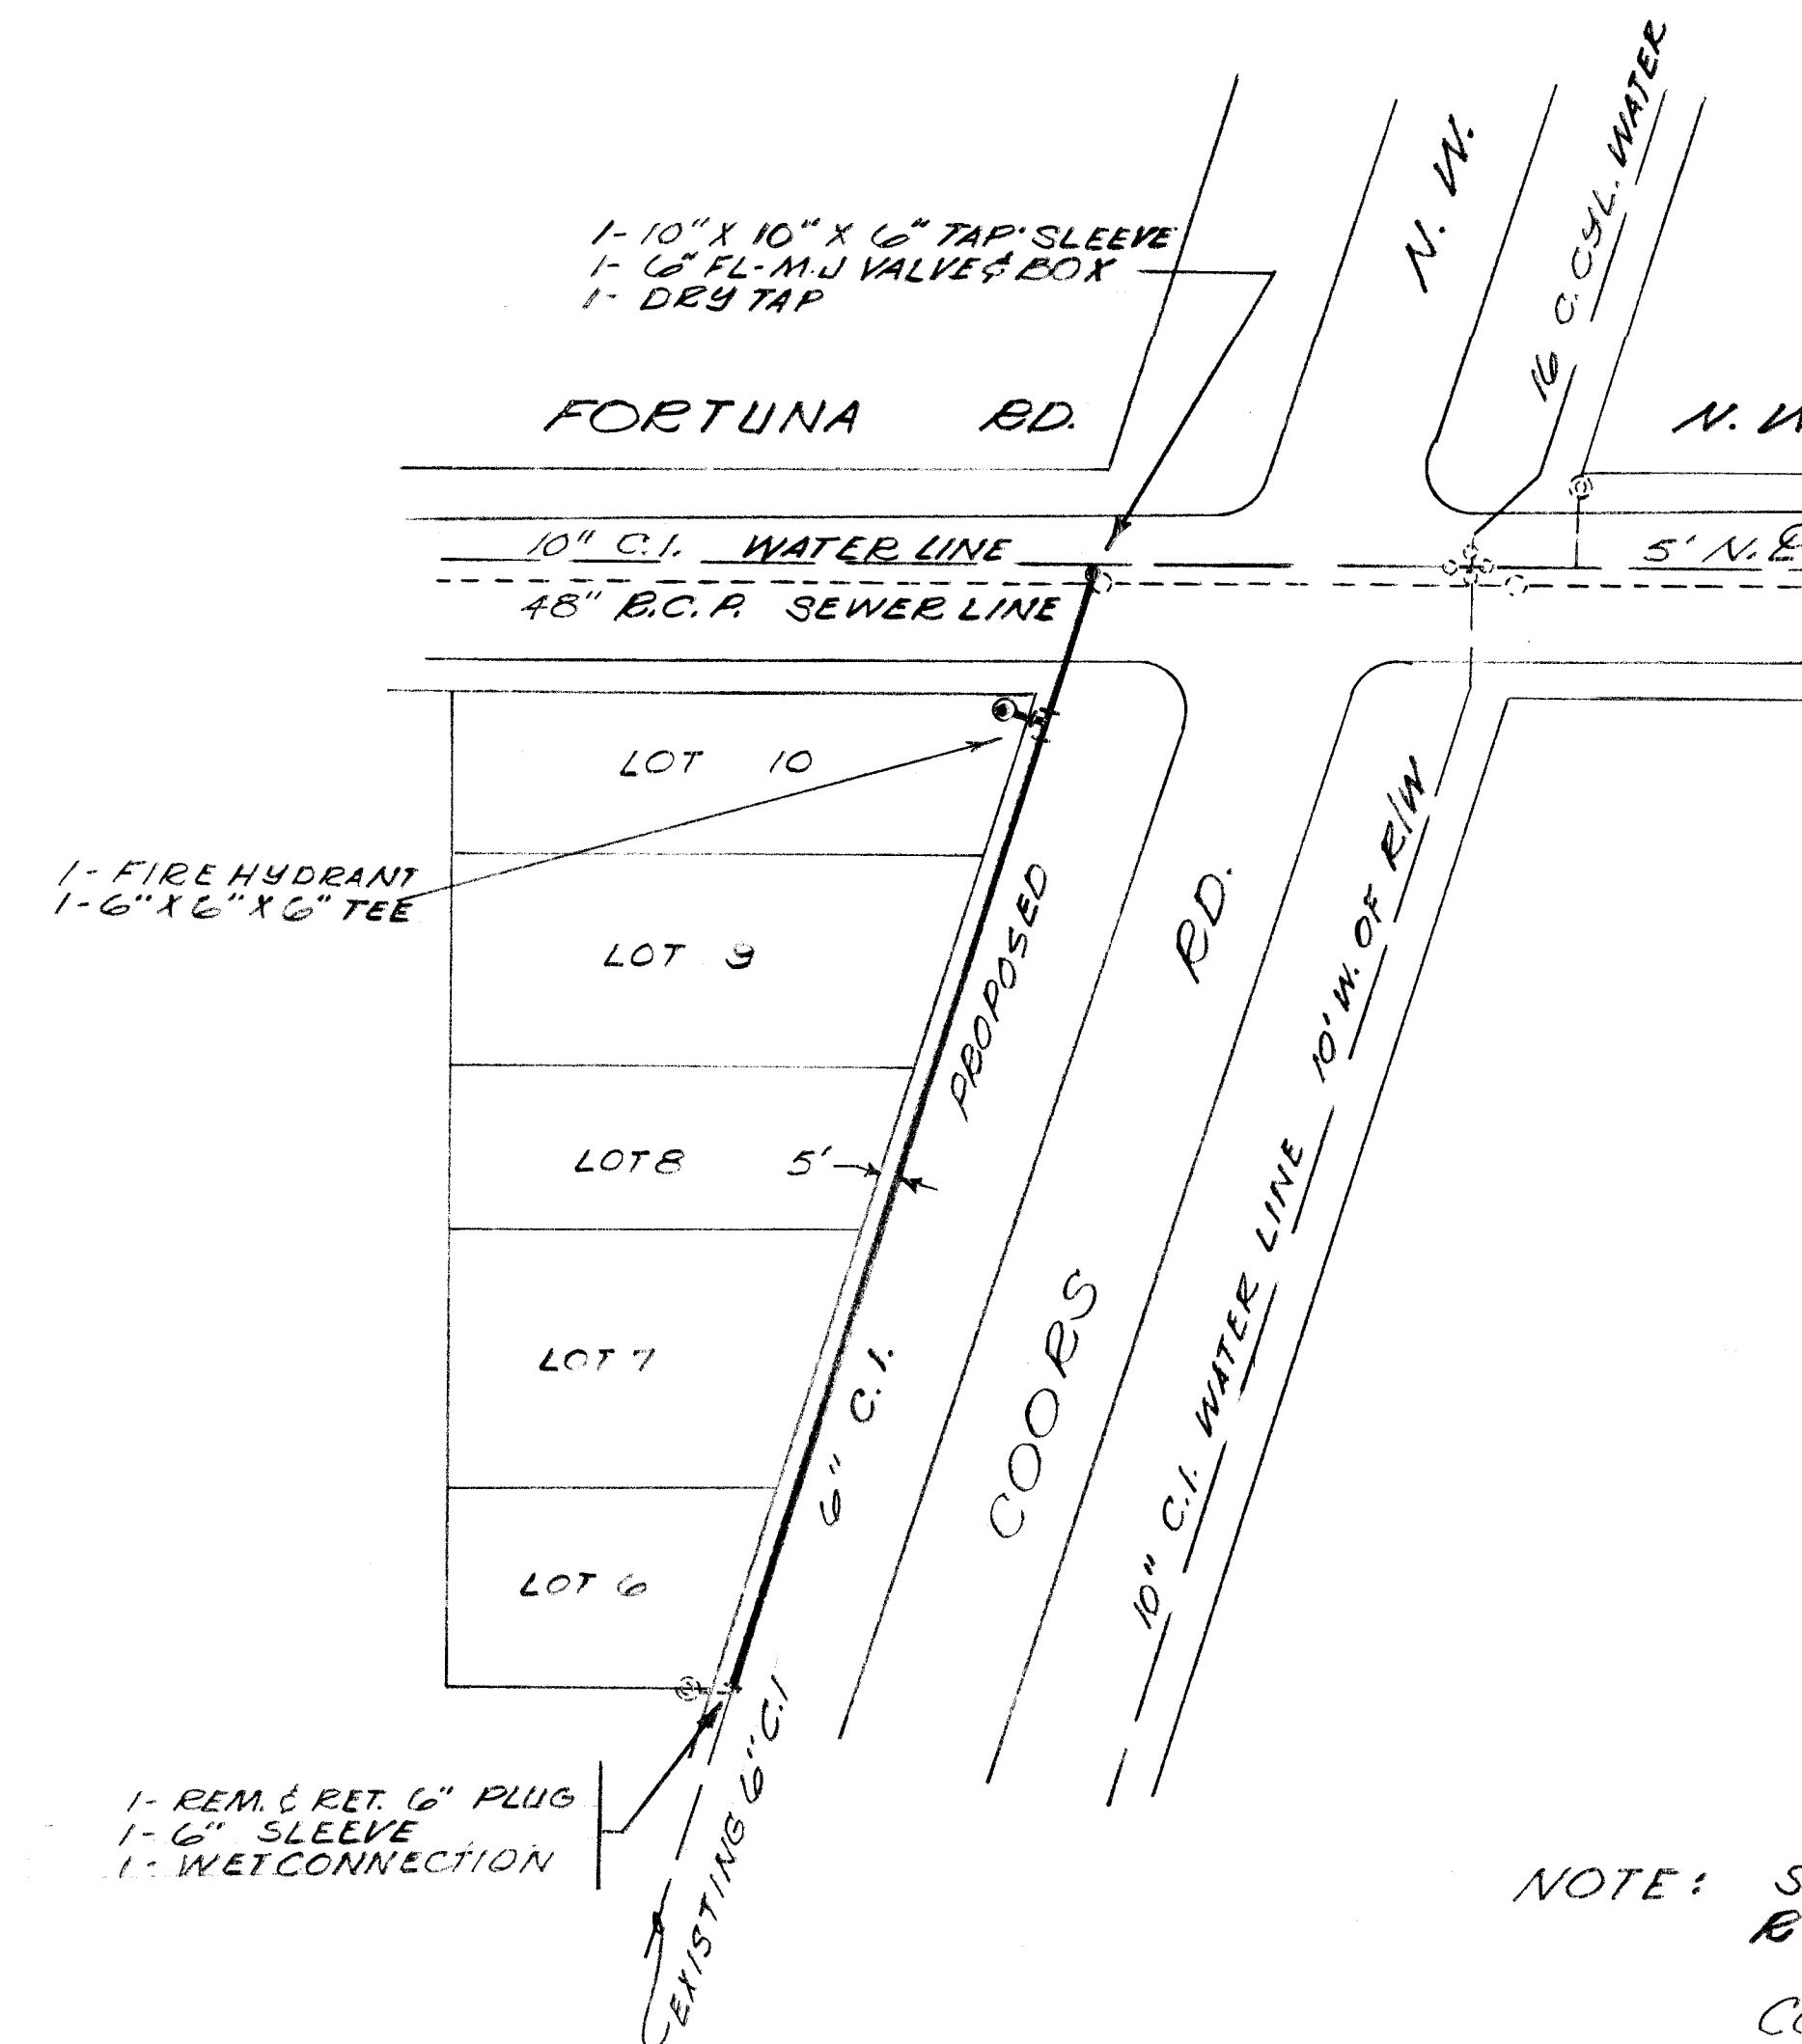

LEGEND

—W— PROPOSED WATER LINE
—W— EXISTING WATER LINE
--- EXISTING SAN. SEWER LINE

APPROVALS

J.G. 4/23/74

APR 4/23/74

SCANNED BY
BY LASON

03 06 74 01 374


NOTE: STATE HIWAY PERMIT
REQUIRED. NO. 3-8816
CONSTRUCT WATER LINE
WITH MIN. 3' COVER
FROM EXISTING GROUND

CITY OF ALBUQUERQUE PUBLIC WORKS DEPARTMENT ENGINEERING DIVISION			
TITLE BLK 10 BLK 1974			
DESIGN		APPROVAL	
DESIGNED BY	BY	SUBMITTED BY	
DATE	TITLE	DATE	TITLE
DRAWN BY J. Martinez		RECORDED BY	
DATE 4/23/74	TITLE	DATE	TITLE
CHECKED BY	BY	SHEET NO. 6 OF 6	
DATE	TITLE	DATE	TITLE
DRAWING NUMBER SHEET NO. 6			

CUIDAD VISTA SUBDIVISION
WORK COMPLETED

ESTIMATE NO. W-163-73A-155-12
MAP NO. K-23
PROJECT 74-10
SHIVER CONSTRUCTION COMPANY
SHEET NO. 7


NOTE: For Street Grades
See SAS-130-73

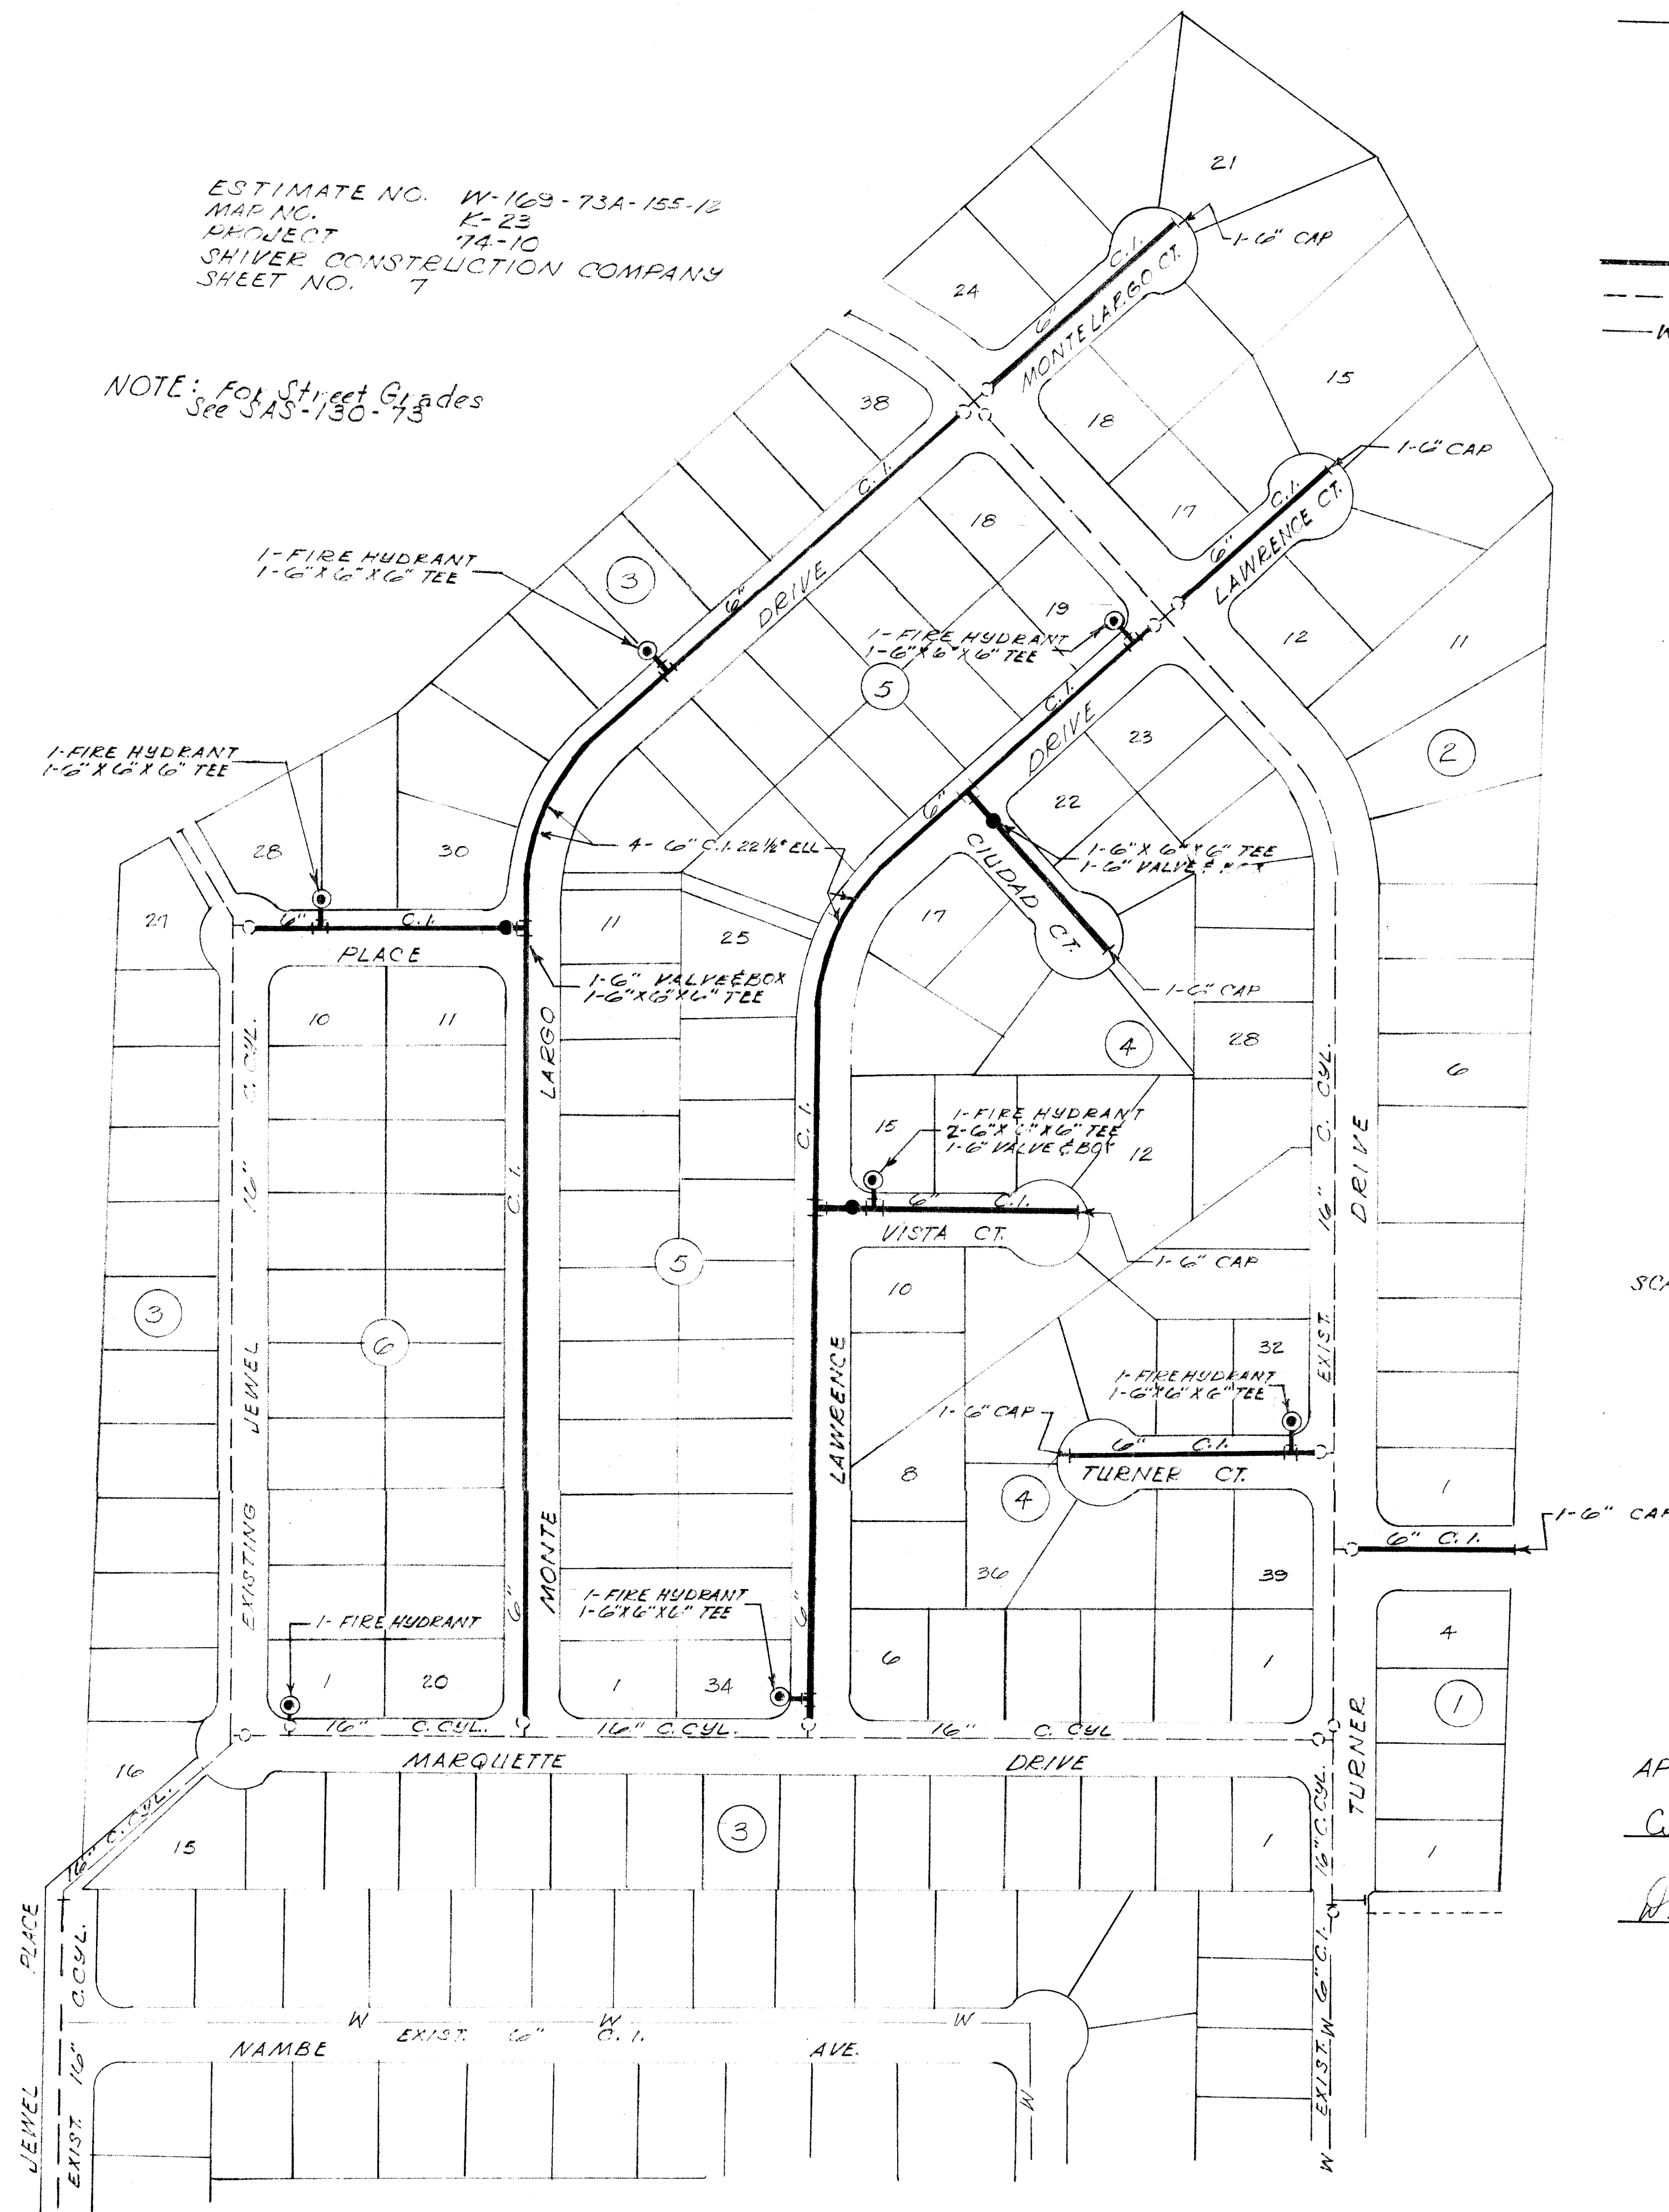

POLICY 6a
ENTERED ON MAPS

LEGEND

- PROPOSED WATER
- - - EXIST. 16\"/>
- W- EXIST. 6\"/>

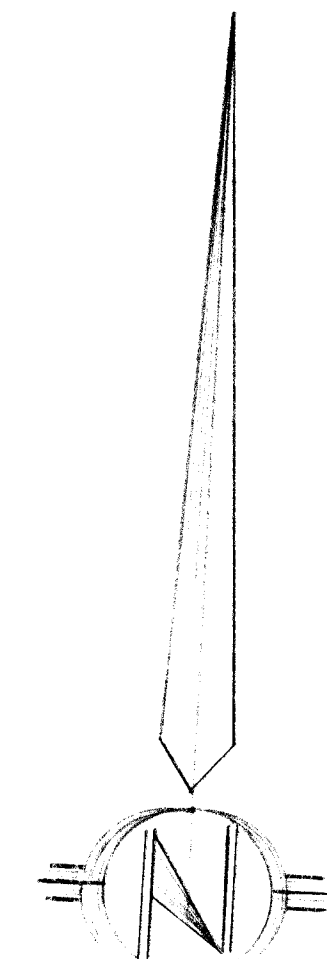

SCALE 1" = 100'

APPROVALS


City 4/24/74
DRR 4/26/74

NEWPORT OF ALBUQUERQUE
(MUNICIPAL ADD. NO. 9)
WORK COMPLETED

POLICY 6-b
ENTERED ON MAPS


ESTIMATE NO. W-63-74-55
MAP NO. M-16-N
WATER AGREEMENT NO. 1441-74
KENT NOWLIN CONSTRUCTION
SHEET NO. 7

WORK ORDER NO. 57

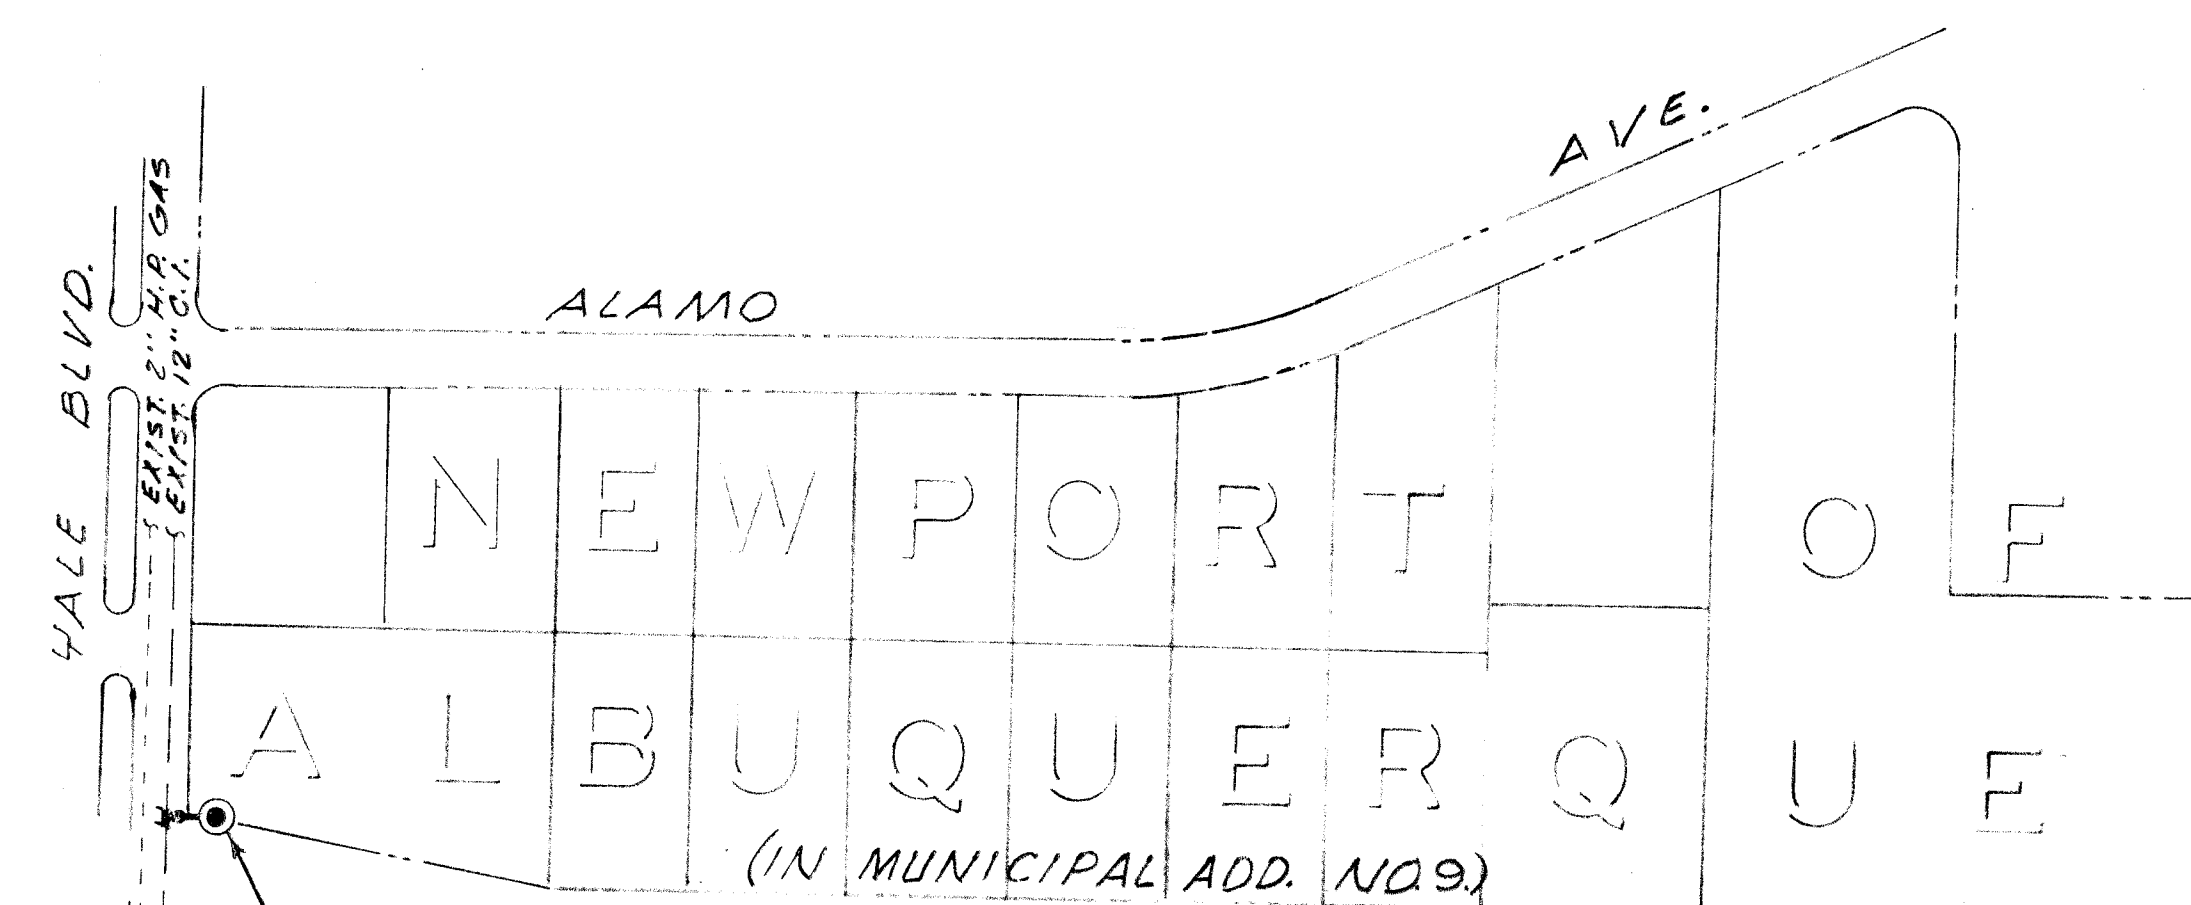

- 1-12"X12"X6" TAPPING SLEEVE
- 1-DRY TAP
- 1-6" FL. MJ. GATE VALVE
- 1-6" VALVE BOX TYPE 'A'
- 1- F.H. 4' BURY W/M.U. JT.

NOTE: ACTUAL LOCATION OF
FIRE HYDRANT TO BE
DETERMINED IN THE
FIELD.

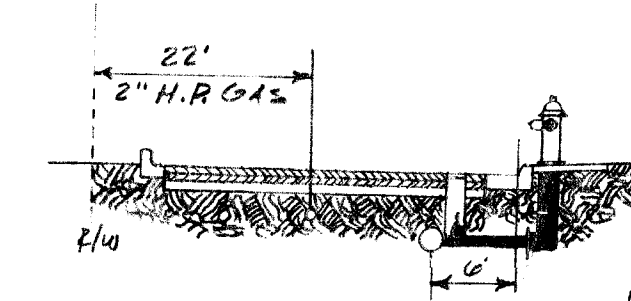

LEGEND

- PROP. HYDRANT
- - - EXIST. WATER
- - - EXIST. GAS

APPROVALS

City 8/22/74
DRR 8/21/74

1 2 3 4 5 6 7 8 9 10 11 12 13 14 15 16 17 18 19 20 21 22 23 24 25 26 27 28
0 3 0 7 7 4 0 1 3 7 4

NO.	DATE	REMARKS	RECORDED BY
REVISIONS			
CITY OF ALBUQUERQUE PUBLIC WORKS DEPARTMENT ENGINEERING DIVISION			
TITLE BLK 10 BLK 1974			
DESIGN	APPROVAL	AS BUILT	
DESIGNED BY	BY	SUBMITTED BY	
DATE	DATE	DATE	
DRAWN BY	BY	RECORDED BY	
DATE	DATE	DATE	
CHECKED BY	BY	SHEET NO.	
DATE	DATE	SHEETS	
DRAWING NUMBER SHEET NO. 7			

EL DORADO HEIGHTS SUBDIVISION
WORK COMPLETED

ESTIMATE NO. W-32-74-24-13-A
MAP NO. G-22-N
PROJECT 74-6
KENT MOWLIN CONST. INC.
SHEET NO. 8

APPROVALS

5/2/74


LEGEND

PROF. 6" POLICY 6a
PROF. 16" POLICY 1c
EXIST. WATER

POLICY 6a

ENTERED ON MAPS

EL DORADO HEIGHTS SUB'D

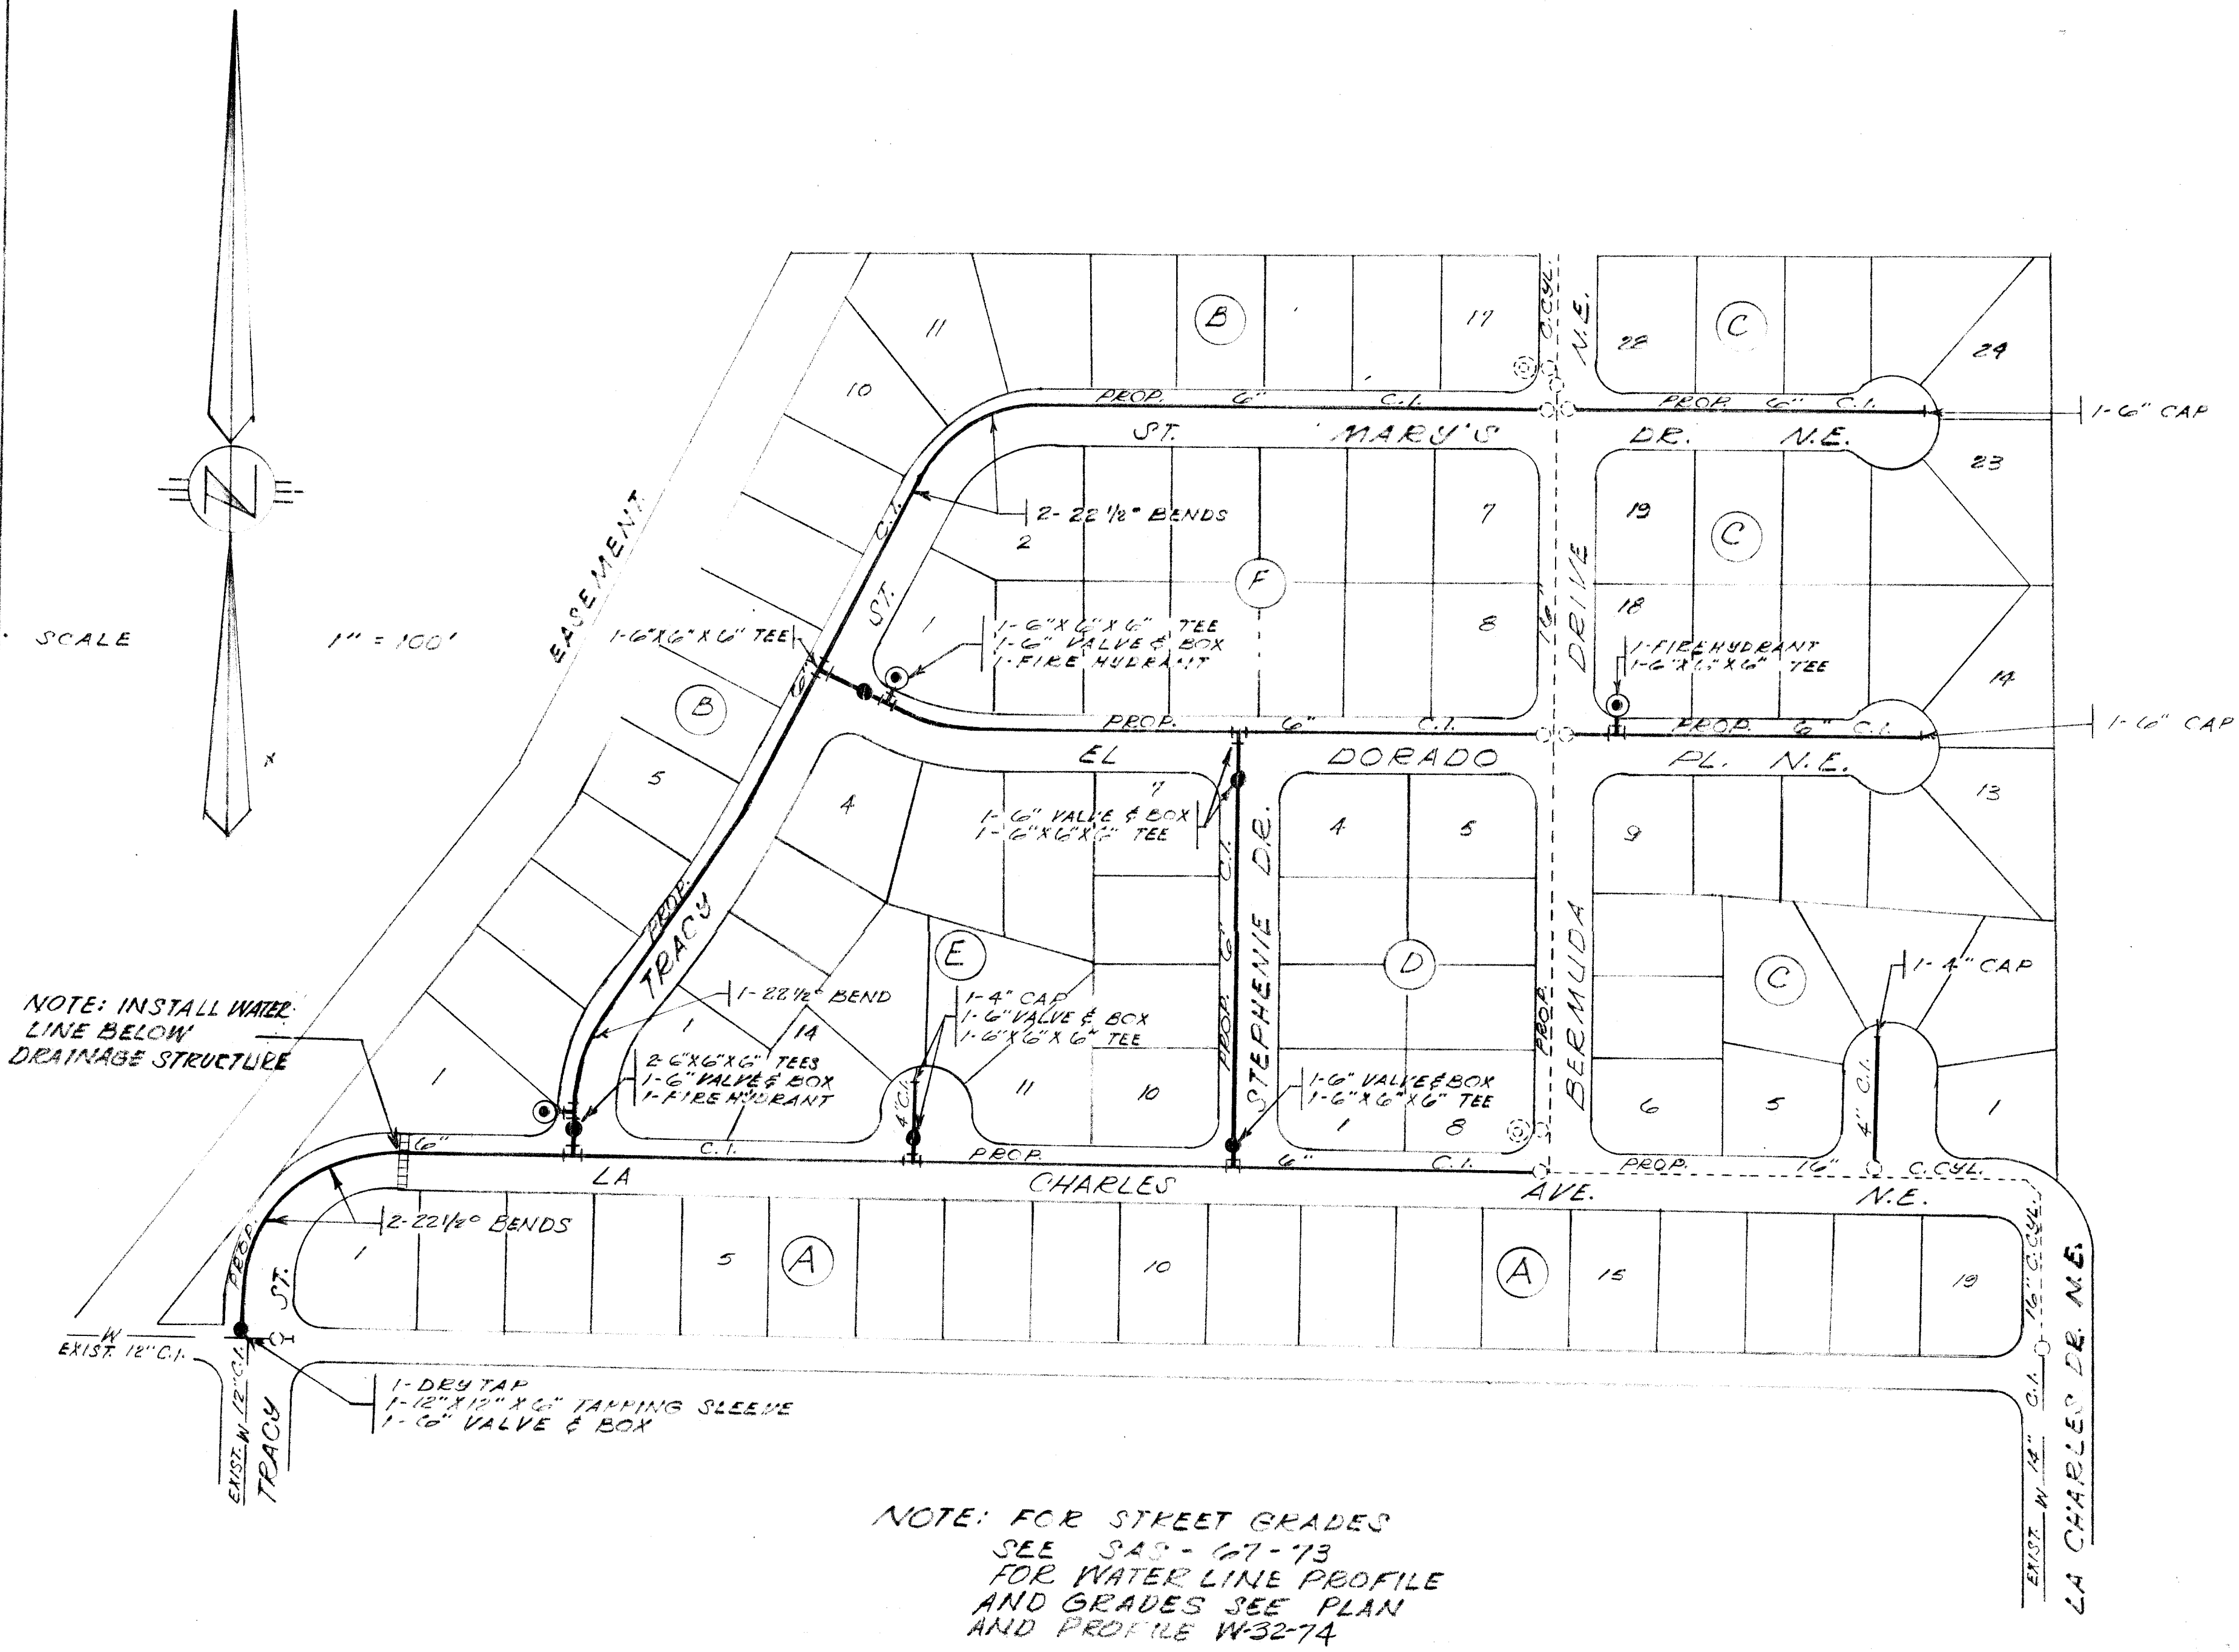

EL DORADO HEIGHTS
WORK COMPLETED

EST. NO. W-32-74-24-14
MAP NO. G-22-N
WATER AGREEMENT 1423-74
KENT MOWLIN CONST. INC.
SHEET 110. 8

POLICY 1-C
ENTERED ON MAPS


APPROVALS

5/2/74

LEGEND

PROF. 16" POLICY 1-C
PROF. 6" POLICY 6a
EXIST. WATER LINE

NOTE: FOR STREET GRADES
SEE SAS-67-73
FOR WATER LINE PROFILE
AND GRADES SEE PLAN
AND PROFILE W-32-74

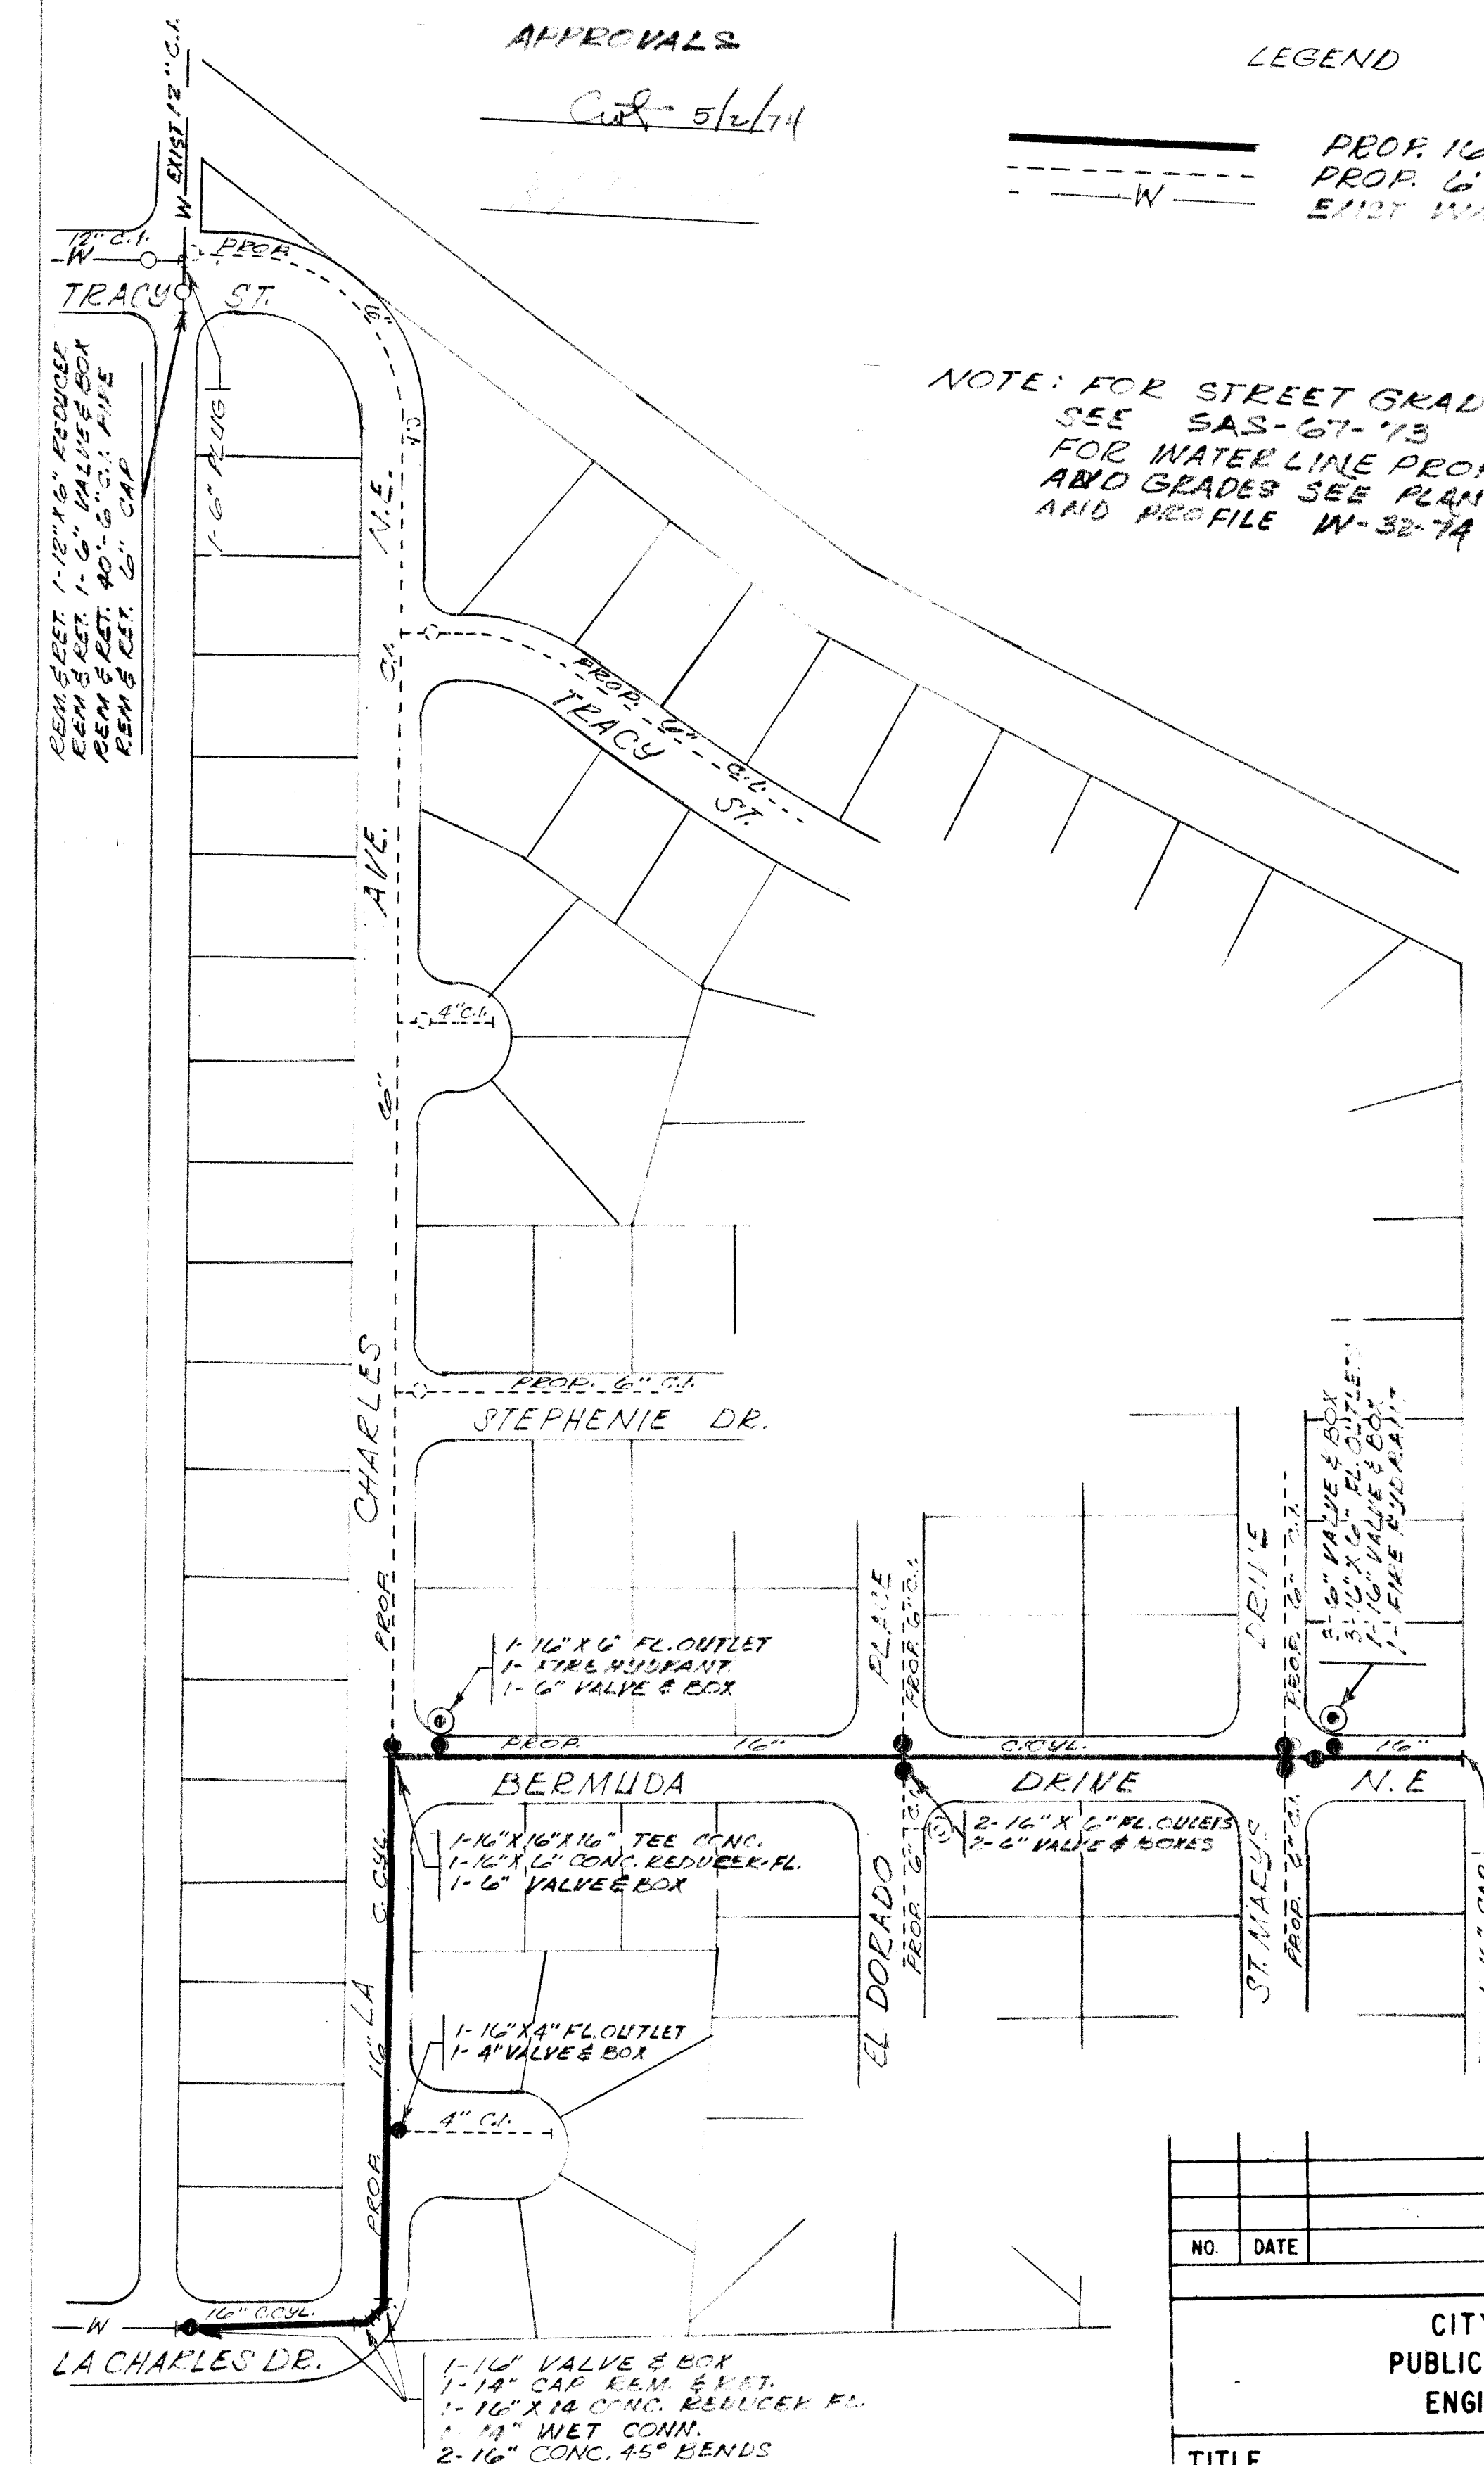

EL DORADO HEIGHTS


NO.		DATE		REMARKS	RECORDED BY
CITY OF ALBUQUERQUE PUBLIC WORKS DEPARTMENT ENGINEERING DIVISION					
TITLE BLK 10 BLK 1974					
DESIGN		APPROVAL		AS BUILT	
DESIGNED BY	DATE	BY	DATE	SUBMITTED BY	DATE
DRAWN BY	DATE	B	DATE	RECORDED BY	DATE
CHECKED BY	DATE	BY	DATE	SHEET NO.	OF SHEETS
DRAWING NUMBER SHEET NO. 8					

PROPOSED WATER EXTENSION IN THE
ST. JOSEPH'S COLLEGE ADD'N.

WORK COMPLETED

EST. NO. W-6-74-25-15
MAP NO. F-11-5 & G-11-11
SHEET NO. 9

POLICY NO. 6a
ENTERED ON MAPS

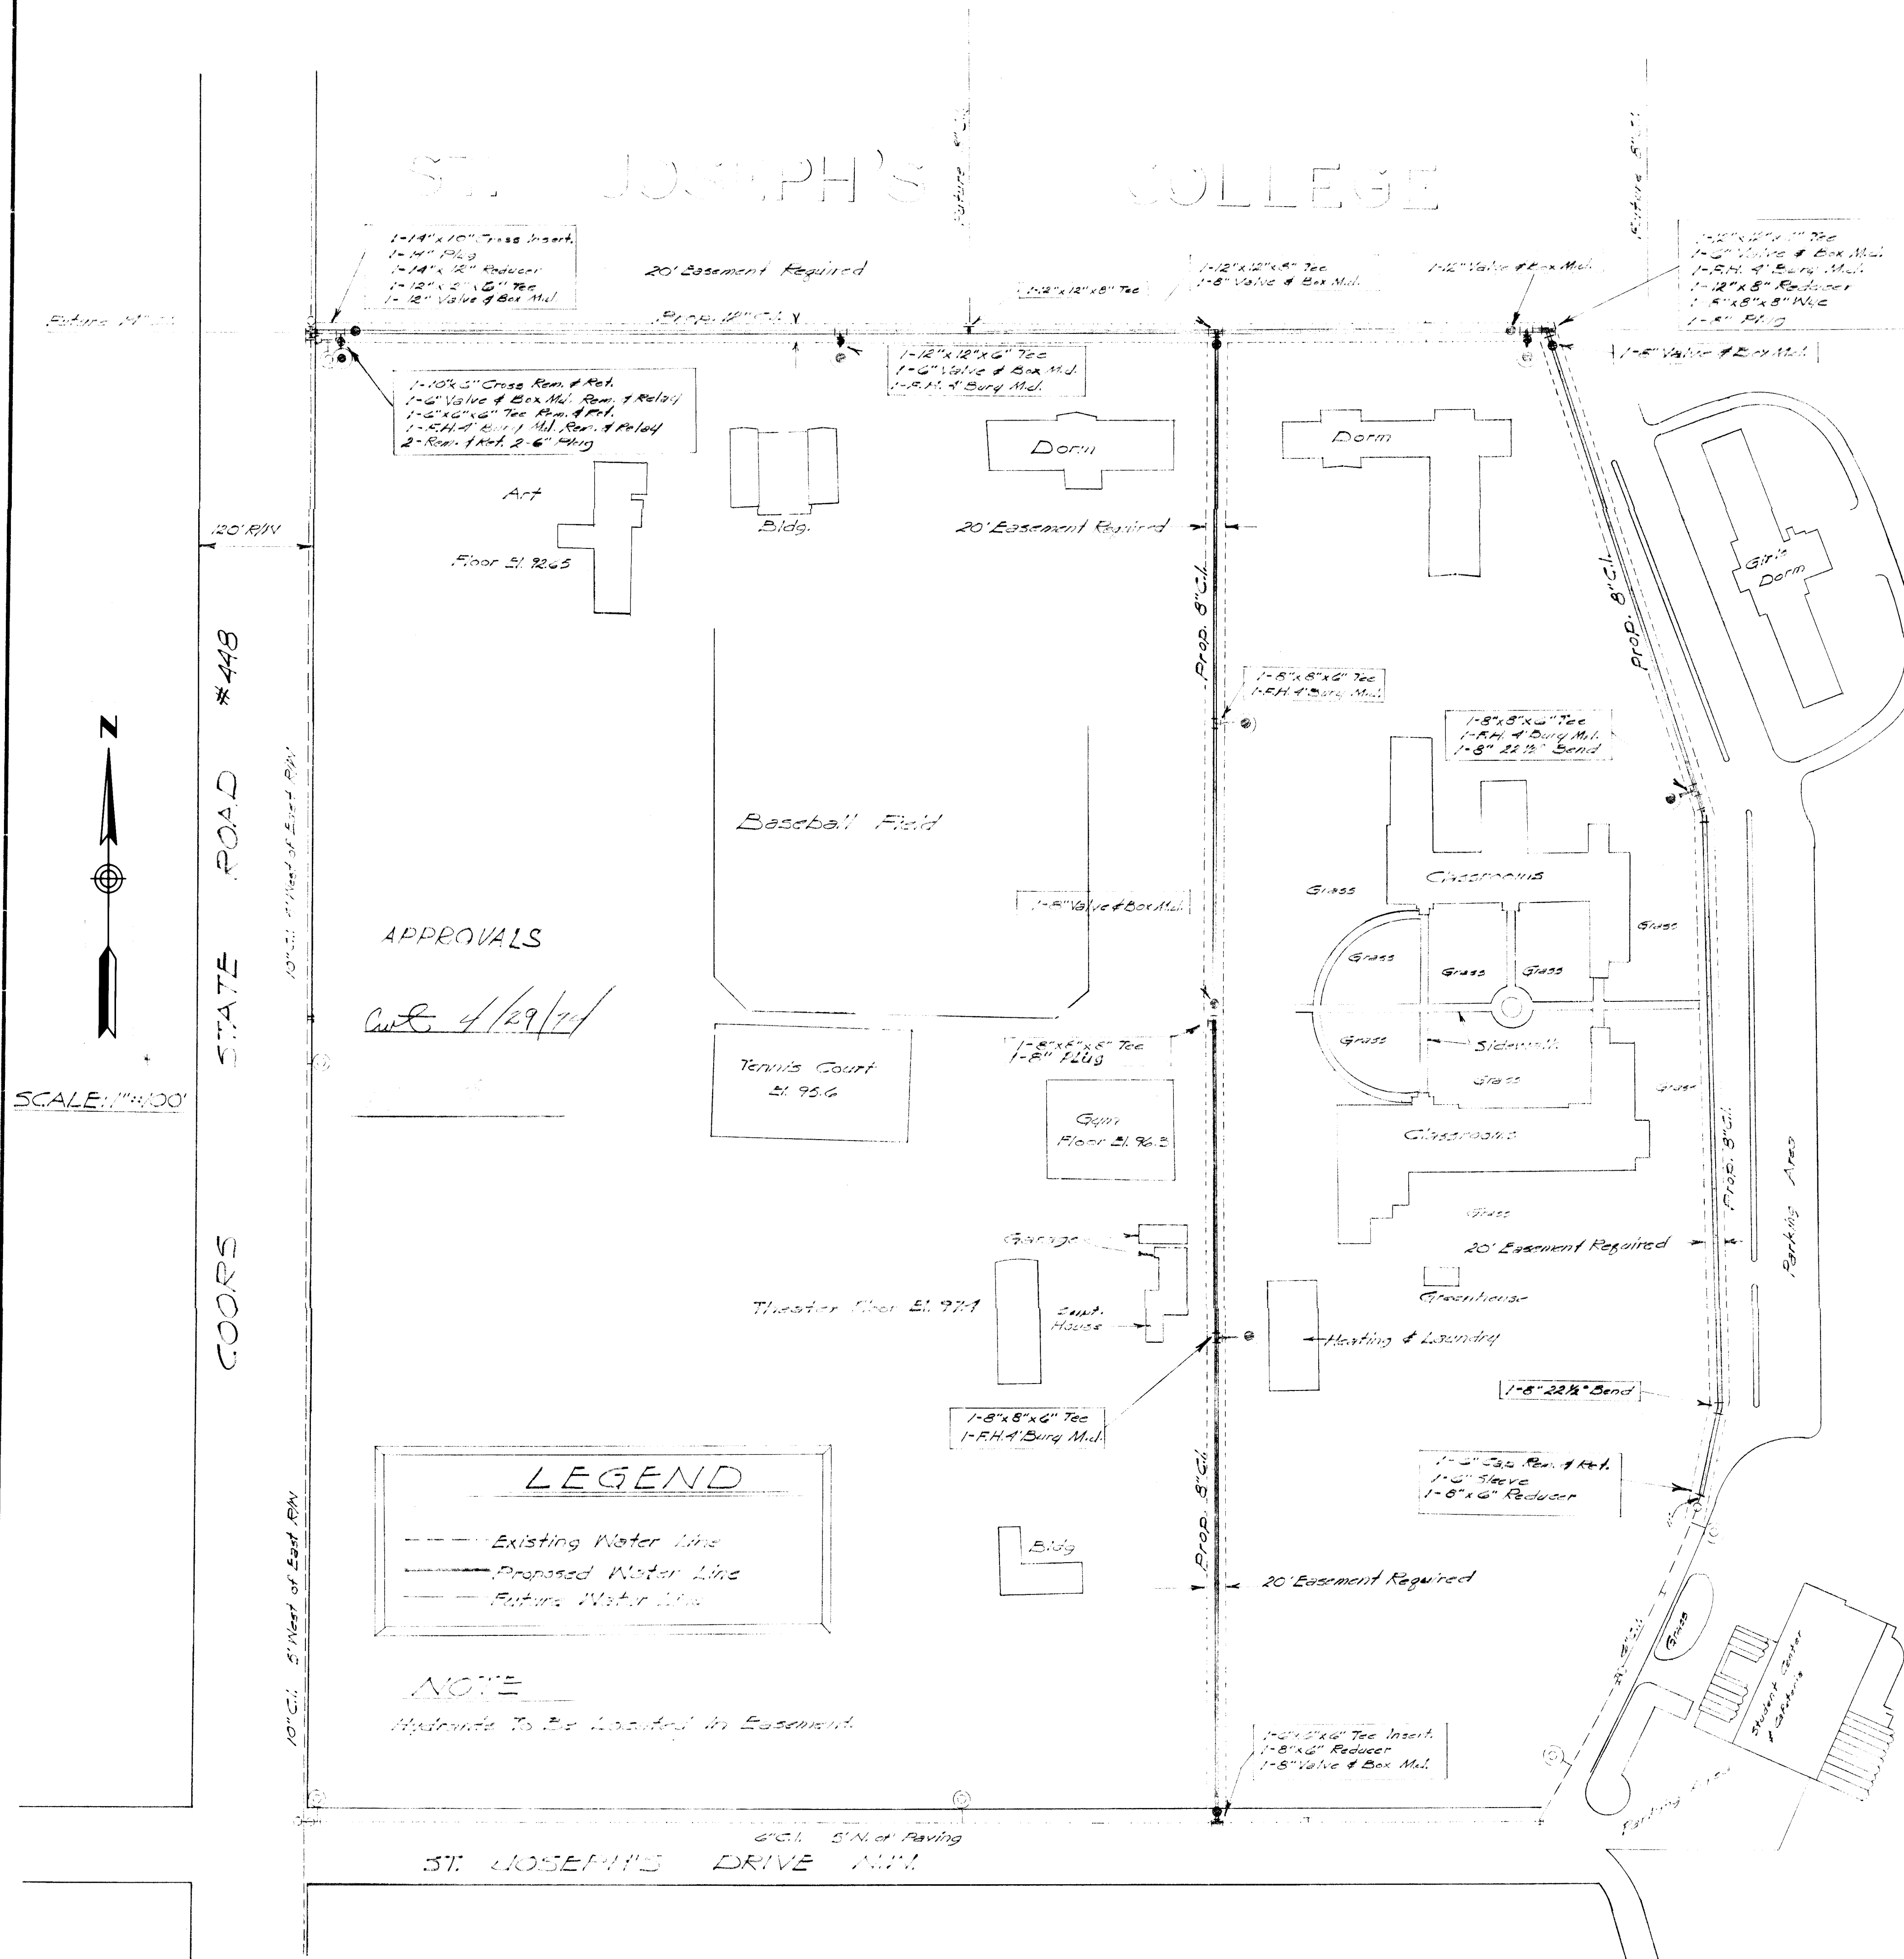


TERRACE ADDITION
WORK COMPLETED

ESTIMATE NO. W-93-74-84 #24-1974
MAP NO. E-15-5
KENT NOWLIN CONST. CO.
SHEET NO. 9

POLICY 86
REPLACEMENT
ENTERED ON MAPS

WORK ORDER NO.

75

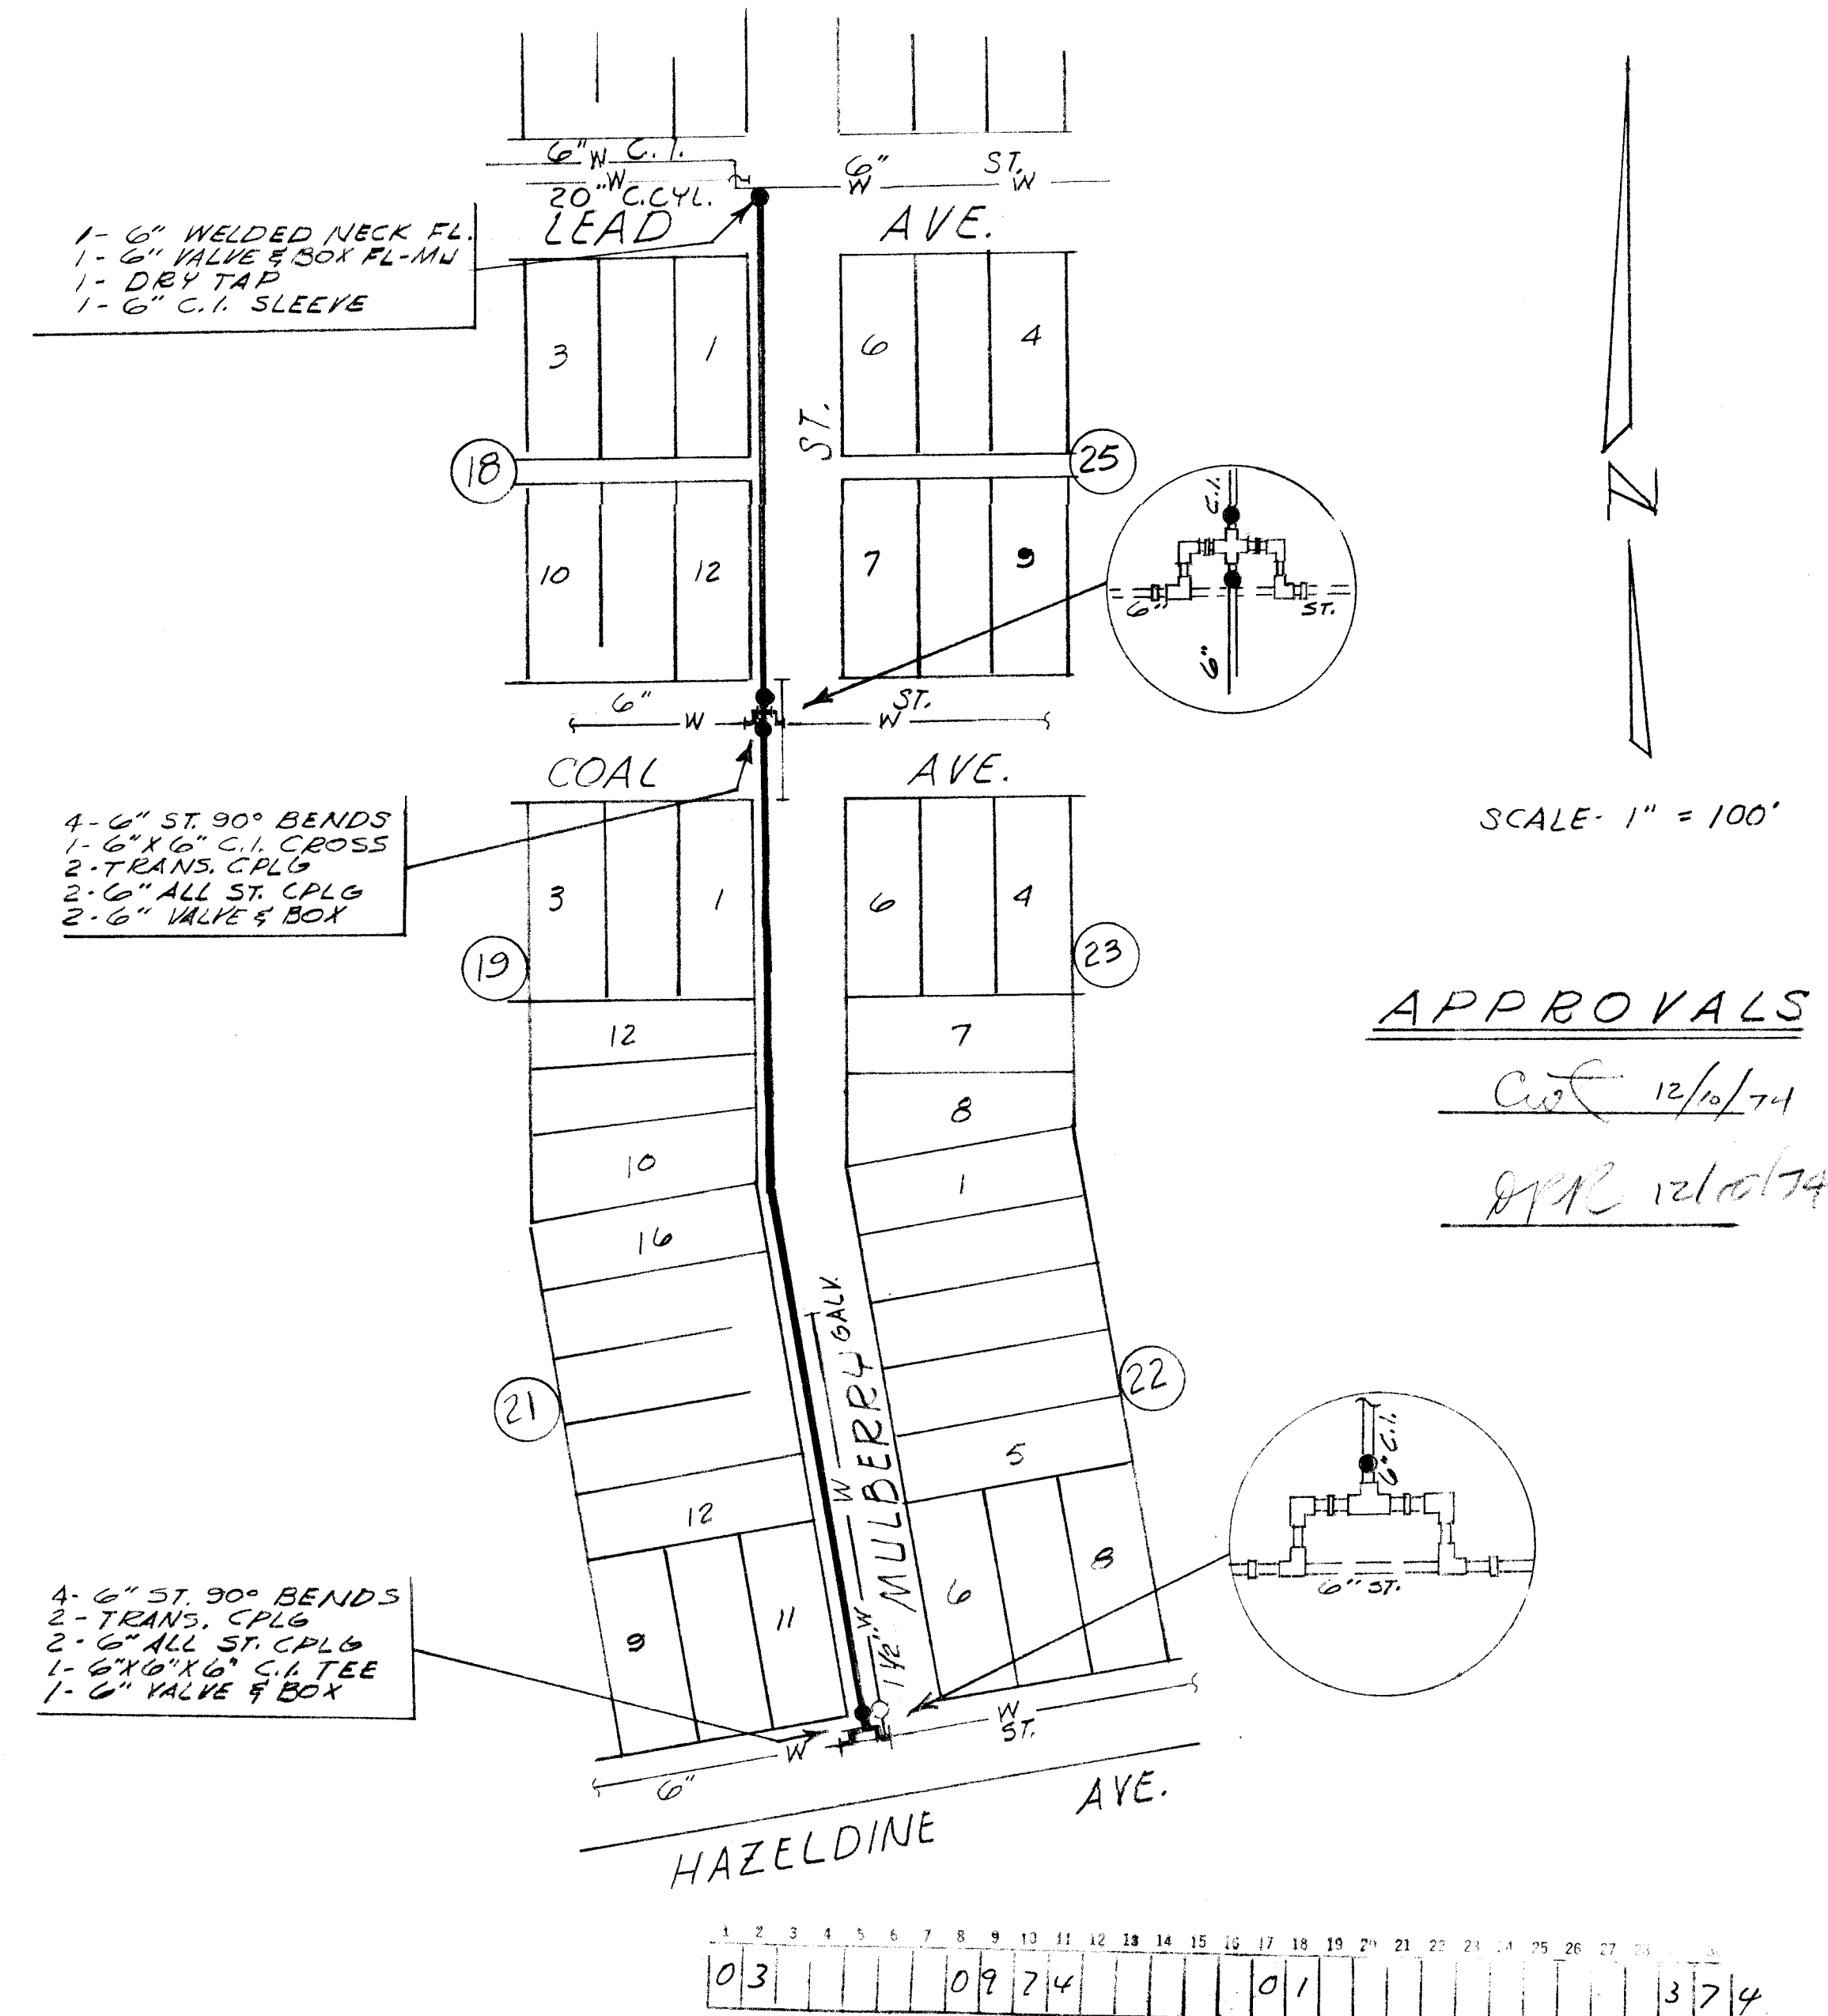

NOTE:
BURY PROPOSED WATER
LINE 3.67' FROM EXIST. TOP CURB.

LEGEND

— Proposed Water Line
— W — Existing Water Line

SCANNED BY
BY LASON

APPROVALS



C.E. 12/10/74

gpc 12/10/74

NO.		DATE		REMARKS		REVISIONS		RECORDED	
CITY OF ALBUQUERQUE PUBLIC WORKS DEPARTMENT ENGINEERING DIVISION									
TITLE BLK TO BLK 1974									
DESIGN			APPROVAL			AS BUILT			
DESIGNED BY			BY			SUBMITTED BY			
DATE			DATE			DATE			
DRAWN BY			BY			RECORDED BY			
DATE			DATE			DATE			
CHECKED BY			BY			SHEET NO.			
DATE			DATE						

PLAN	DATE
SURVEYED	BY
PLATTED	BY
ALIGNMENT CHECKED	BY
NOTE BOOK	NO

PROFILE	DATE
SURVEYED	BY
PLATTED	BY
NOTE BOOK	NO
STRUCTURE NOTED	NO

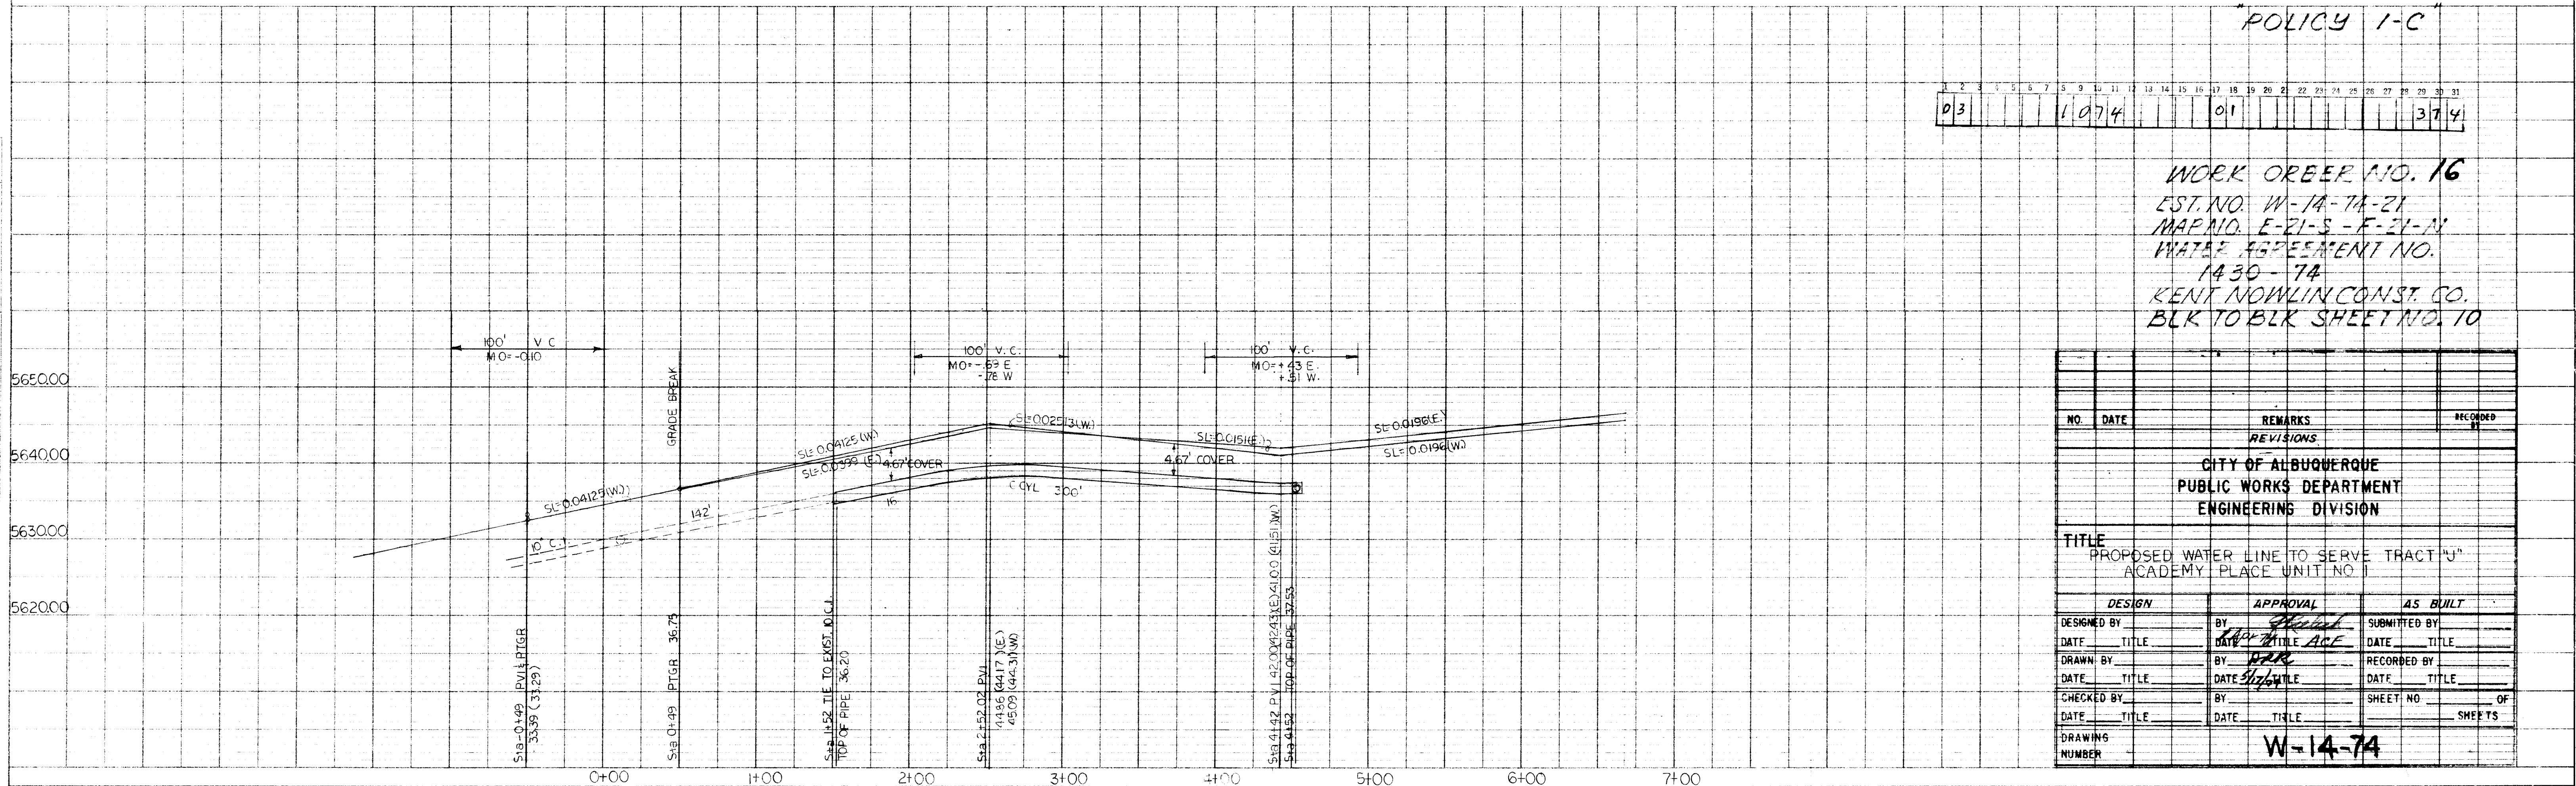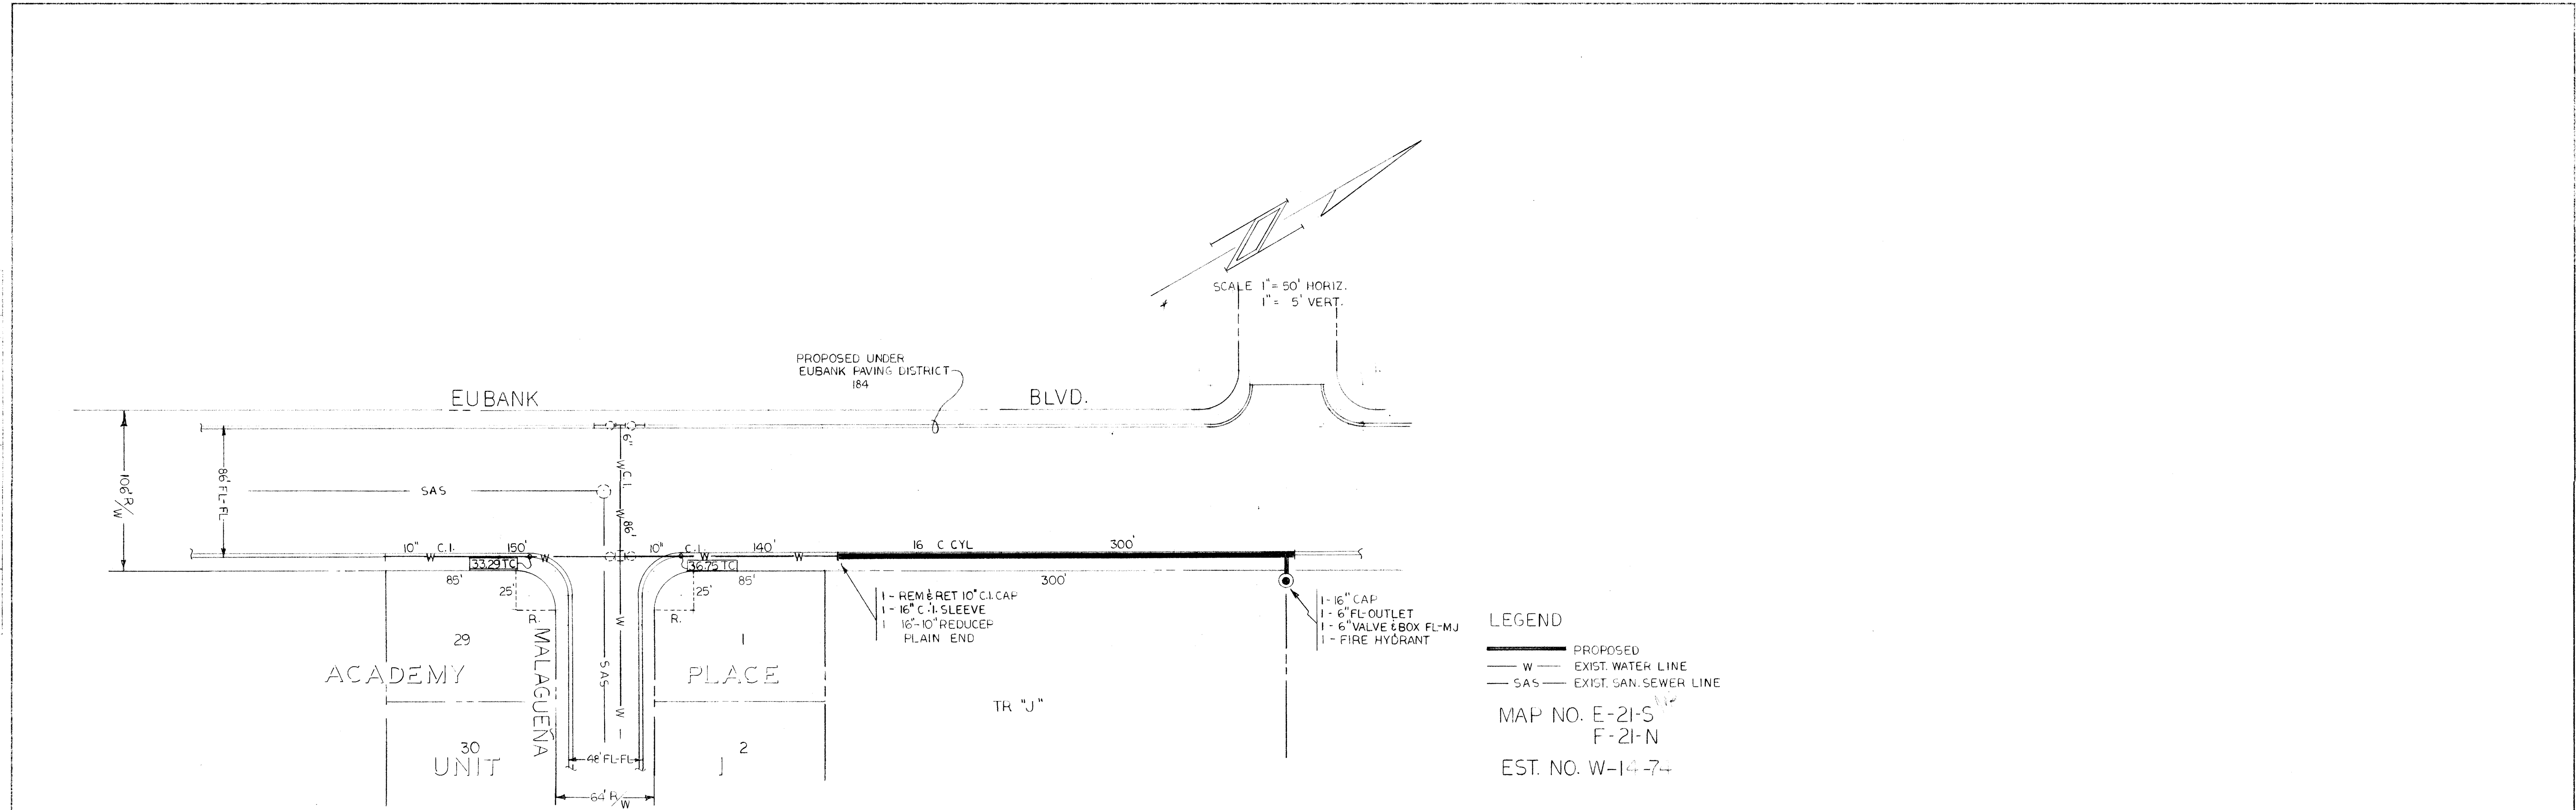

DL-51

DL-52

15114

State of New Mexico
County of Bernalillo
Filed for Record in
Book 15114
Page 15114
Attest: Clerk & Recorder
County Clerk

ACADEMY PLACE UNIT 4

BEING A PORTION OF SECTION 33, TOWNSHIP 11 NORTH,
RANGE 4 EAST, N.M.P.M. IN THE ELENA GALLEGOS
GRANT, BERNALILLO COUNTY, NEW MEXICO
NEW MEXICO SAVINGS & LOAN

WORK COMPLETED

APPROVALS

Cut 5/20/74


5/20/74

Legend

- Existing 16" C.C.I. Water Line
- Proposed 6" C.I. Water Line
- Proposed Fire Hydrant

1	2	3	4	5	6	7	8	9	10	11	12	13	14	15	16	17	18	19	20	21	22	23	24	25	26	27	28	29	30
03																													

ESTIMATE NO. W-36-74-28 17-A
MAP NO. F-21-N
PROJECT 74-13
SHIVER CONSTRUCTION COMPANY
SHEET NO. 11

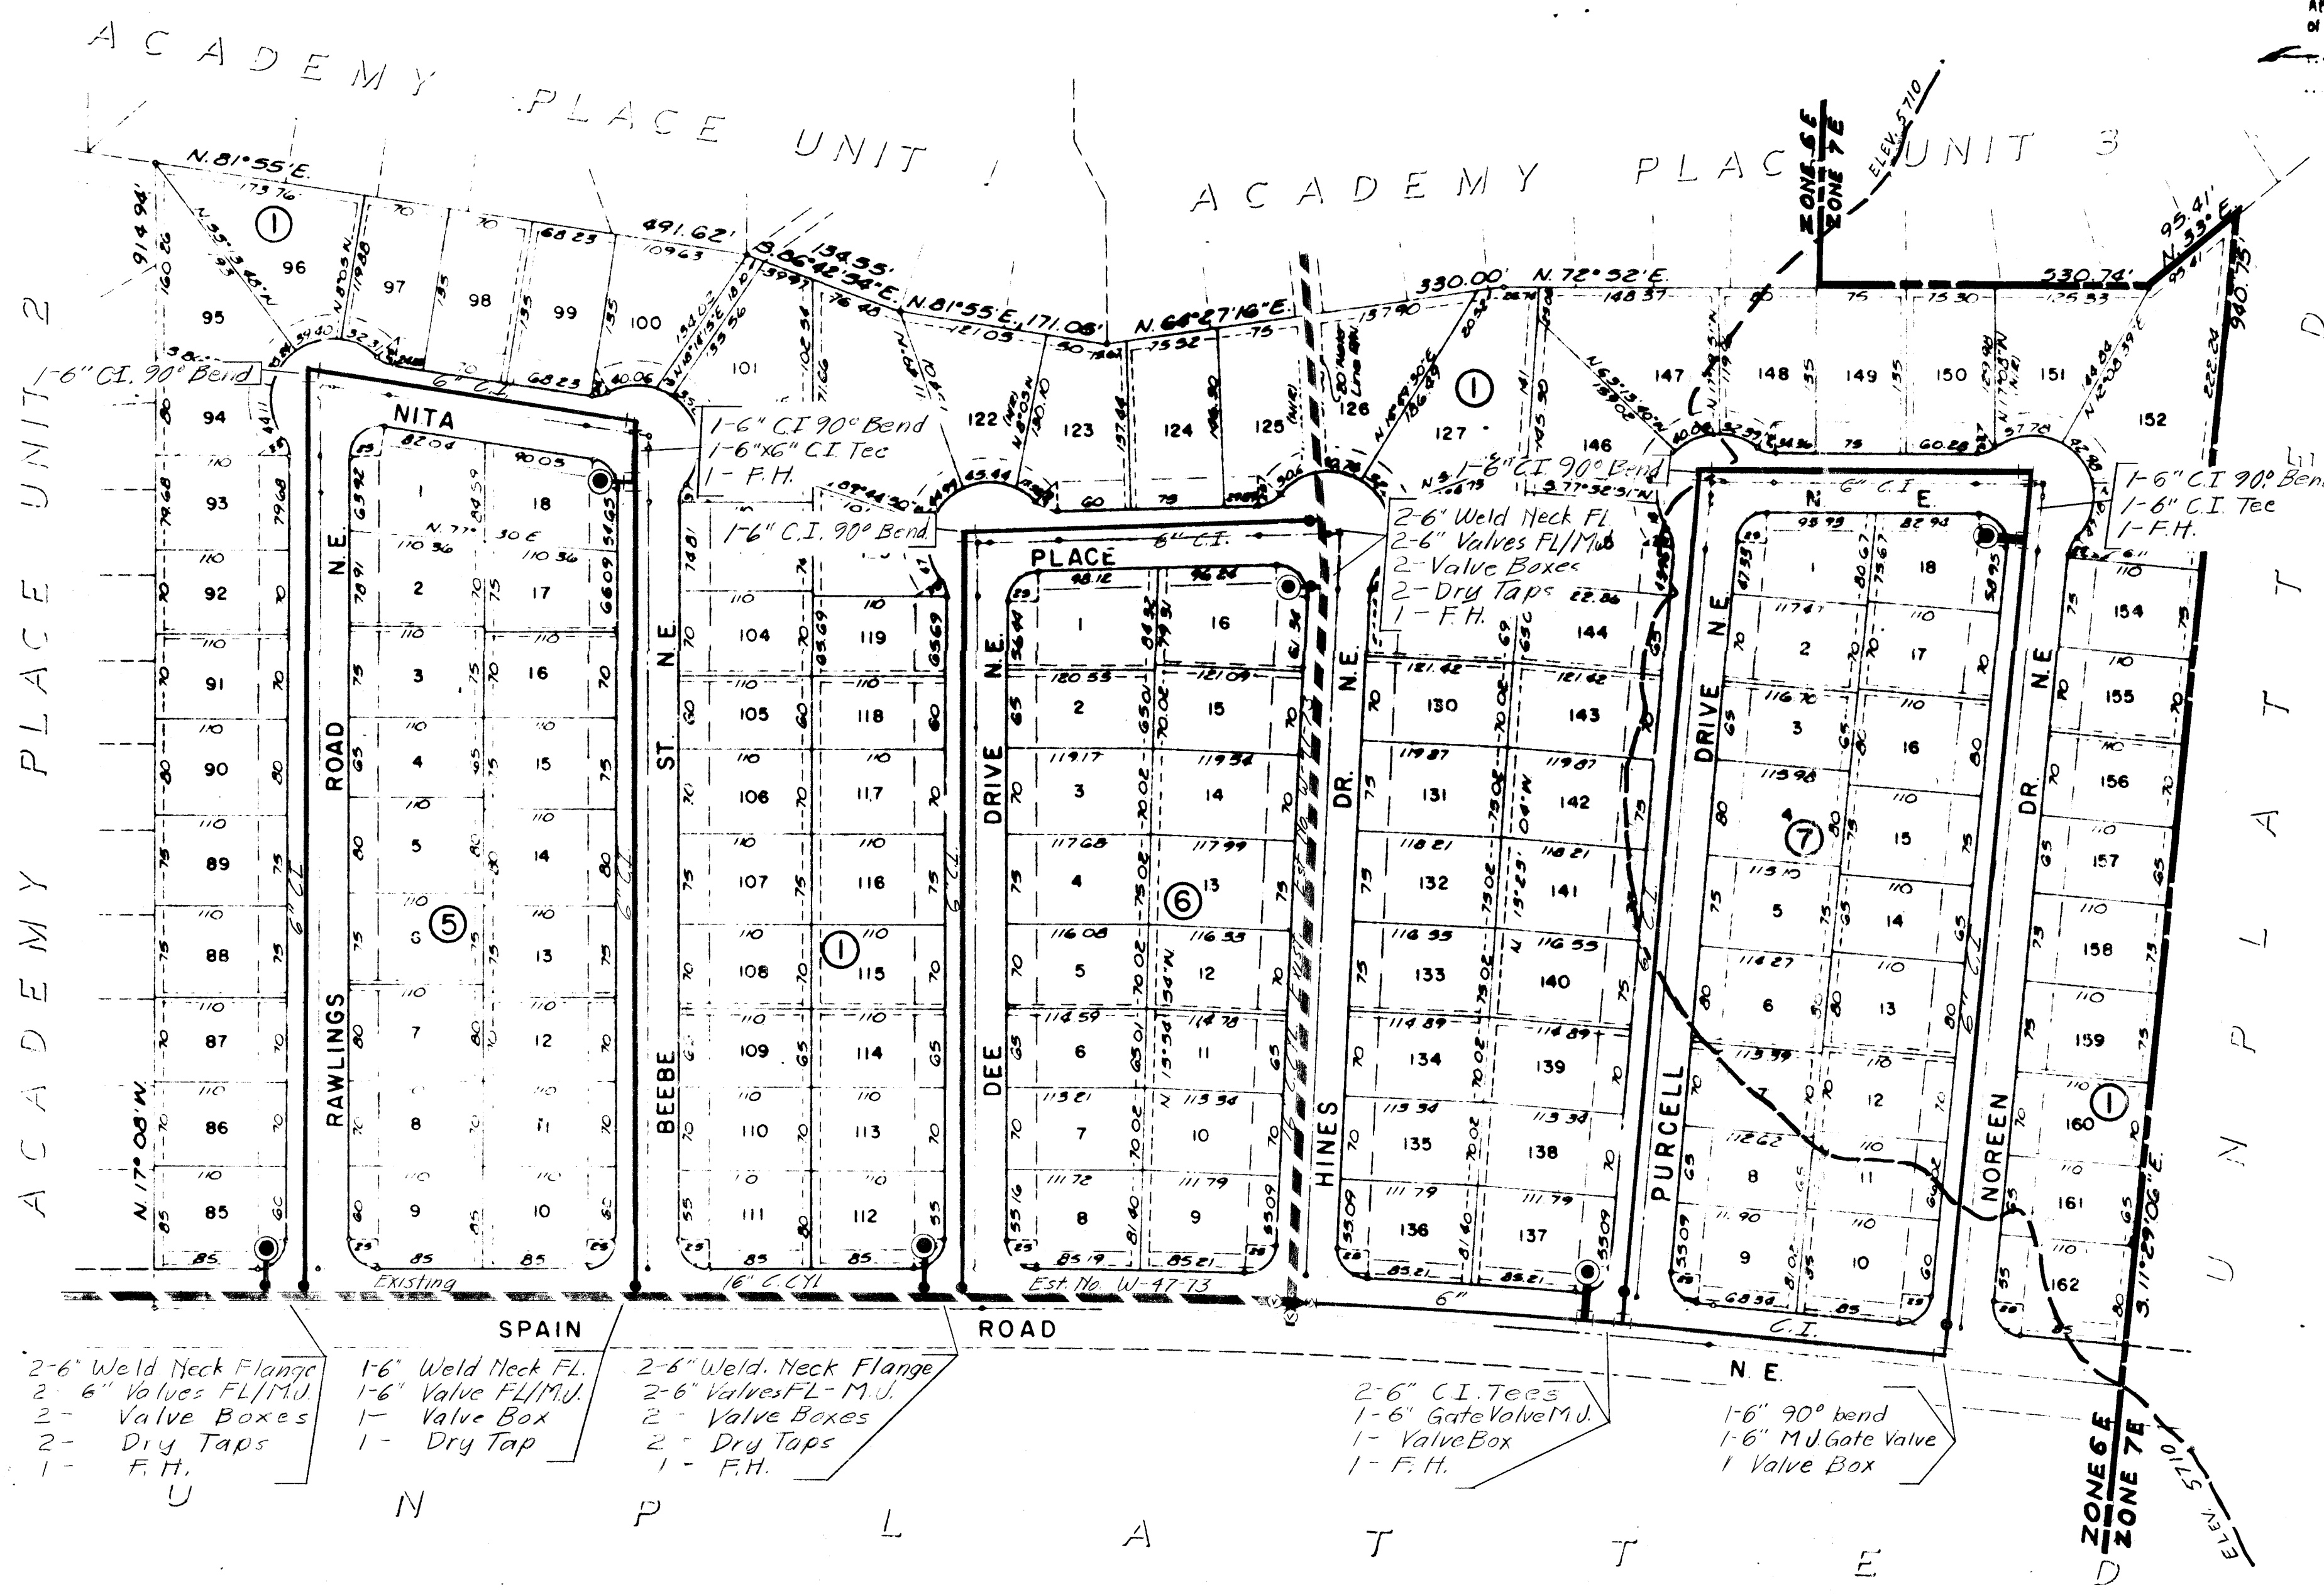

POLICY 6-8
ENTERED ON MAPS

SCANNED BY
BY LASON

NO.		DATE	REMARKS	RECORDED BY
REVISIONS				
CITY OF ALBUQUERQUE PUBLIC WORKS DEPARTMENT ENGINEERING DIVISION				
TITLE BLK 10 BLK-1974				
DESIGN		APPROVAL		AS BUILT
DESIGNED BY	BY	SUBMITTED BY		
DATE	TITLE	DATE		TITLE
DRAWN BY	BY	RECORDED BY		
DATE	TITLE	DATE		TITLE
CHECKED BY	BY	SHEET NO.		OF
DATE	TITLE	DATE		TITLE
DRAWING SHEET NO. 11				