

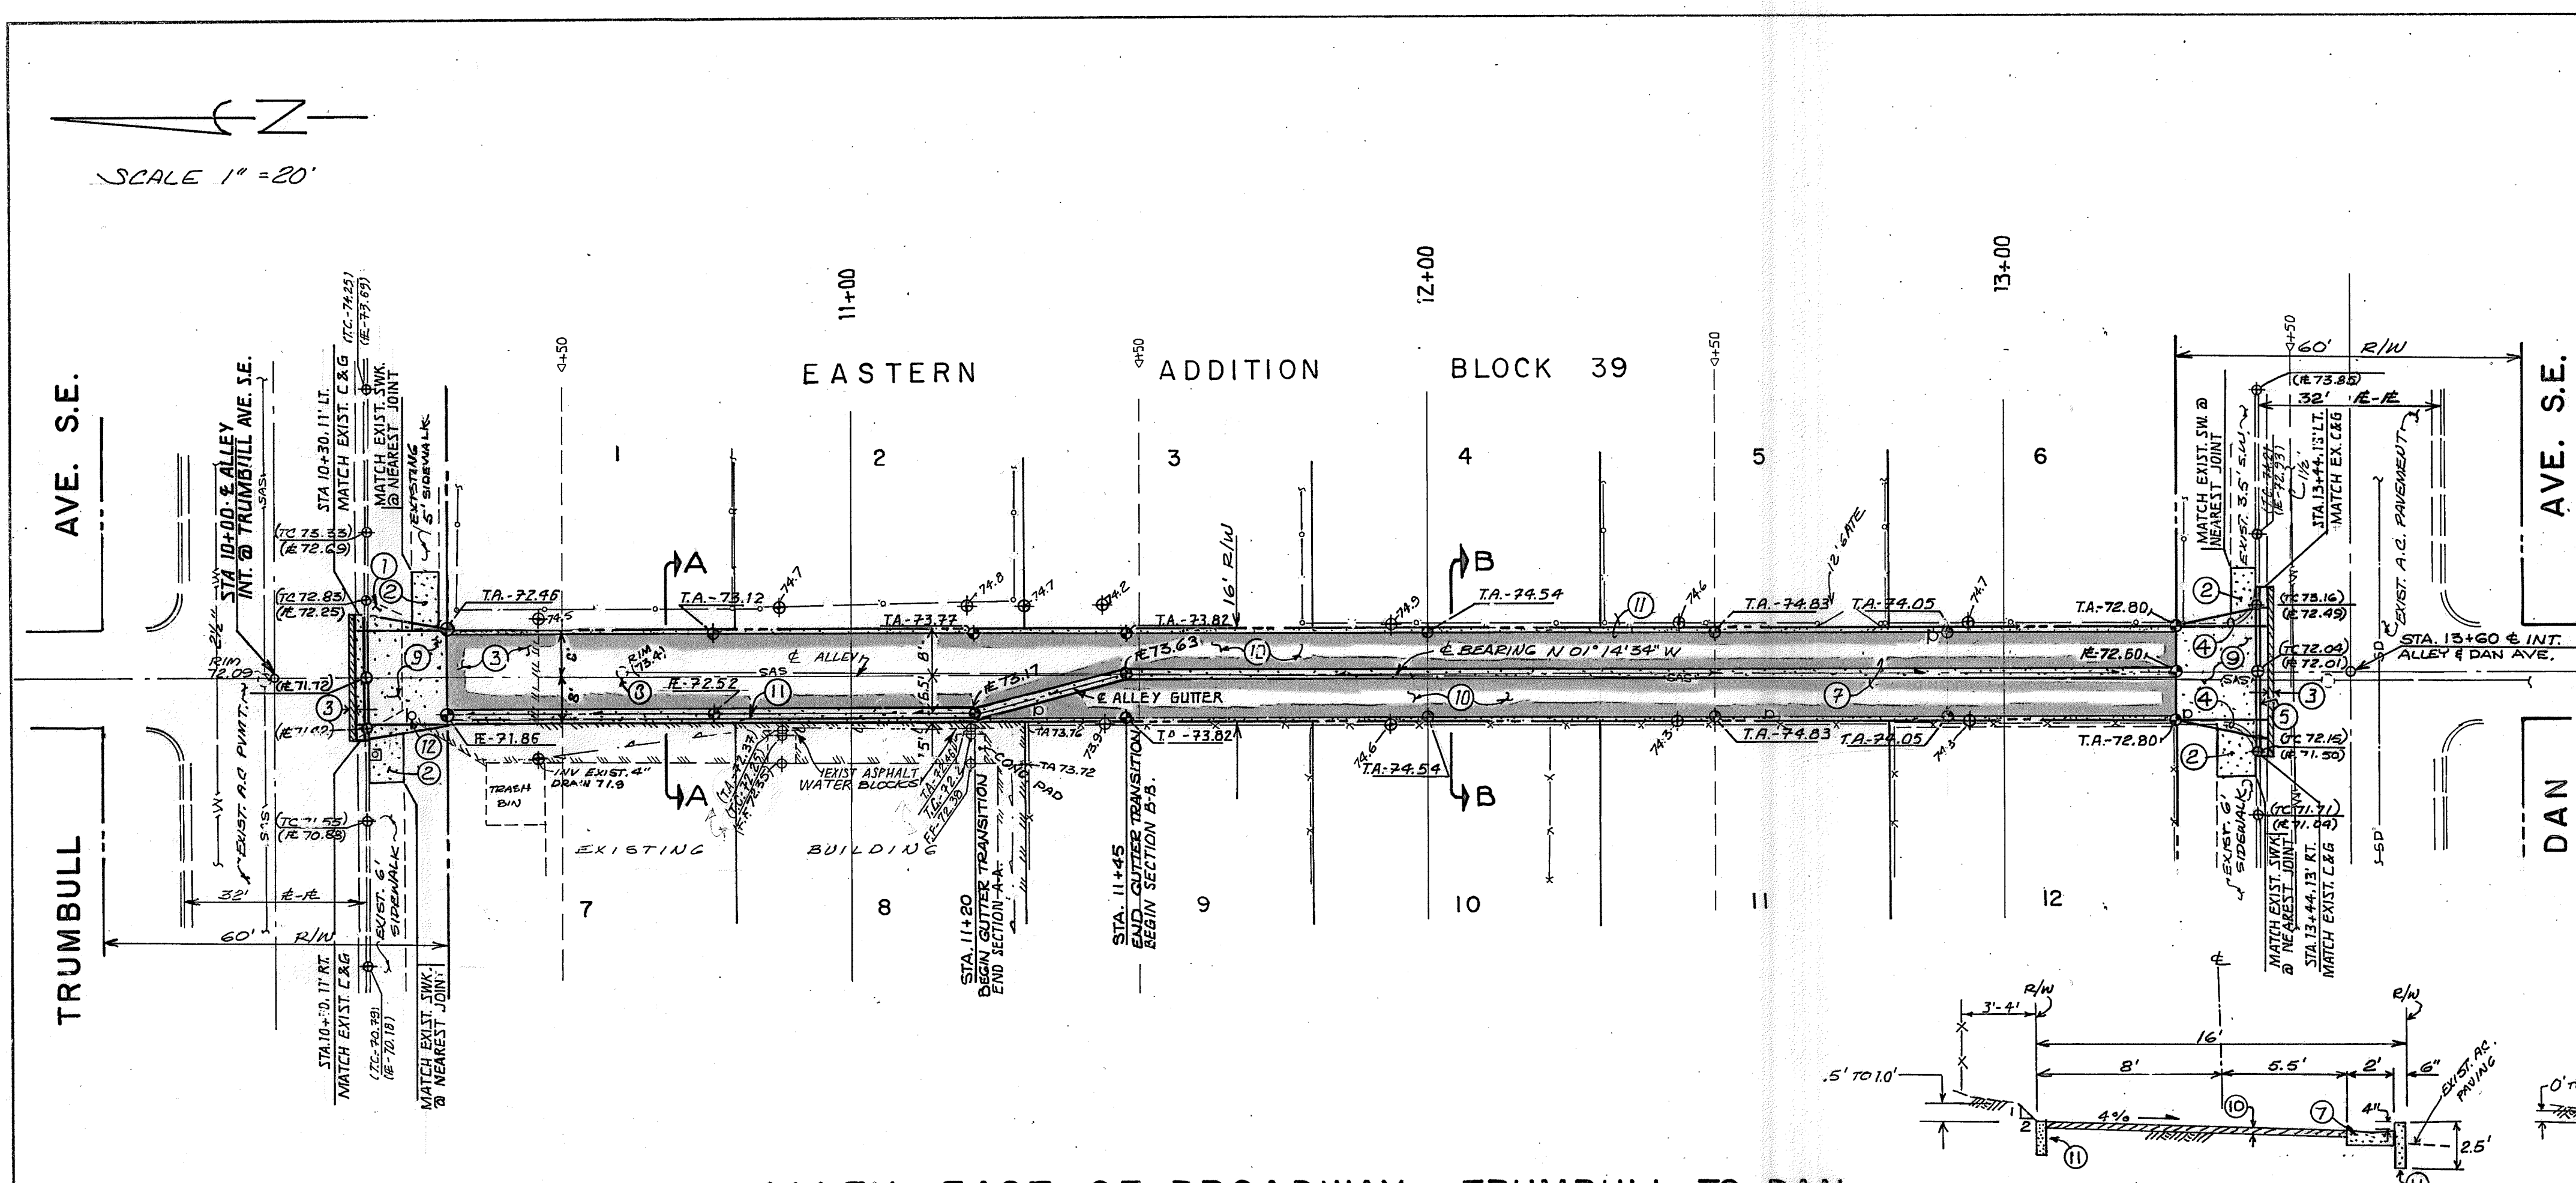


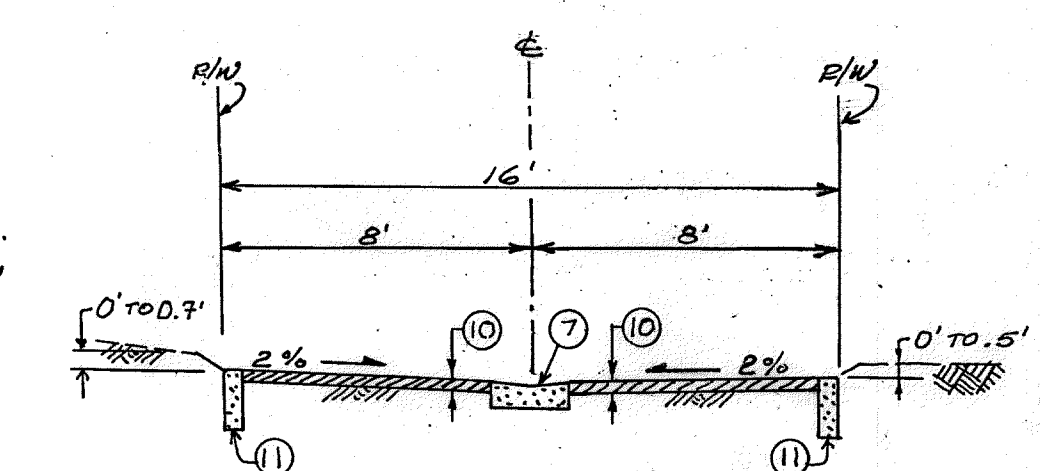


CONSTRUCTION NOTES

1. REMOVE EXISTING CONC. DRIVEPAD.
2. REMOVE AND REPLACE EXISTING 4" SIDEWALK TO ADJUST JOINT TO MATCH NEW ALLEY INTERSECTION.
3. REMOVE AND REPLACE EXISTING ARTERIAL PAVEMENT.
4. REMOVE AND DISPOSE OF EXISTING CURB & GUTTER.
5. REMOVE AND REPLACE STD. CURB & GUTTER PER STD. P-8.
6. CONSTRUCT NEW 4" SIDEWALK.
7. CONSTRUCT NEW 2' ALLEY GUTTER PER STD. P-8.
8. ADJUST MANHOLE COVER TO GRADE.
9. CONSTRUCT NEW ALLEY INTERSECTION PER CITY STD. DWS. P-12.
10. CONSTRUCT NEW COMMERCIAL TYPE PAVEMENT PER CITY STD. DWS. P-6.
11. CONSTRUCT 18"x6" CUT-OFF WALL OR TO DIMENSIONS AS SPECIFIED HEREON.
12. RELOCATE EXISTING STREET LIGHT BY UTILITY OWNER FROM STA 10+24.56' RT TO STA 10+24.11' RT.

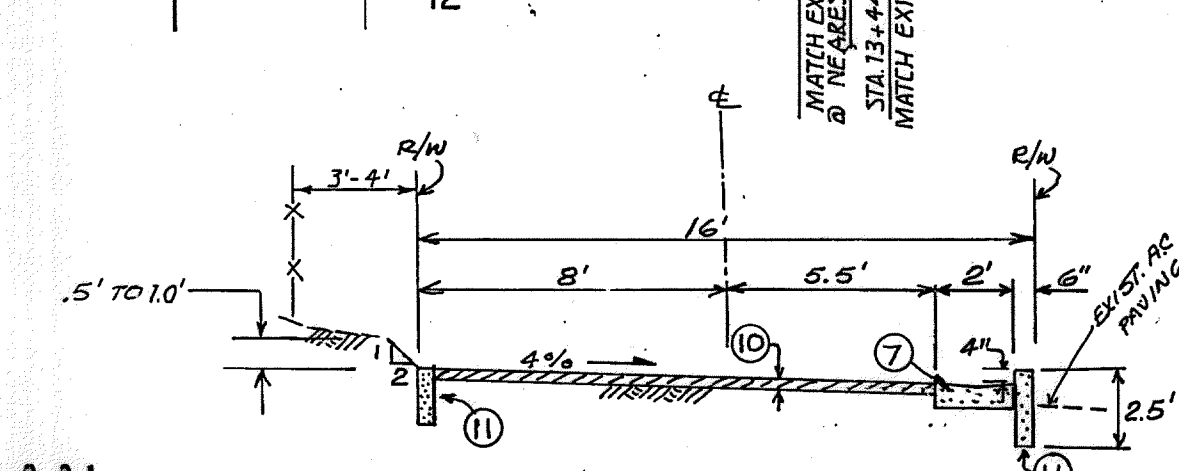

ALLEY EAST OF BROADWAY, TRUMBULL TO DAN

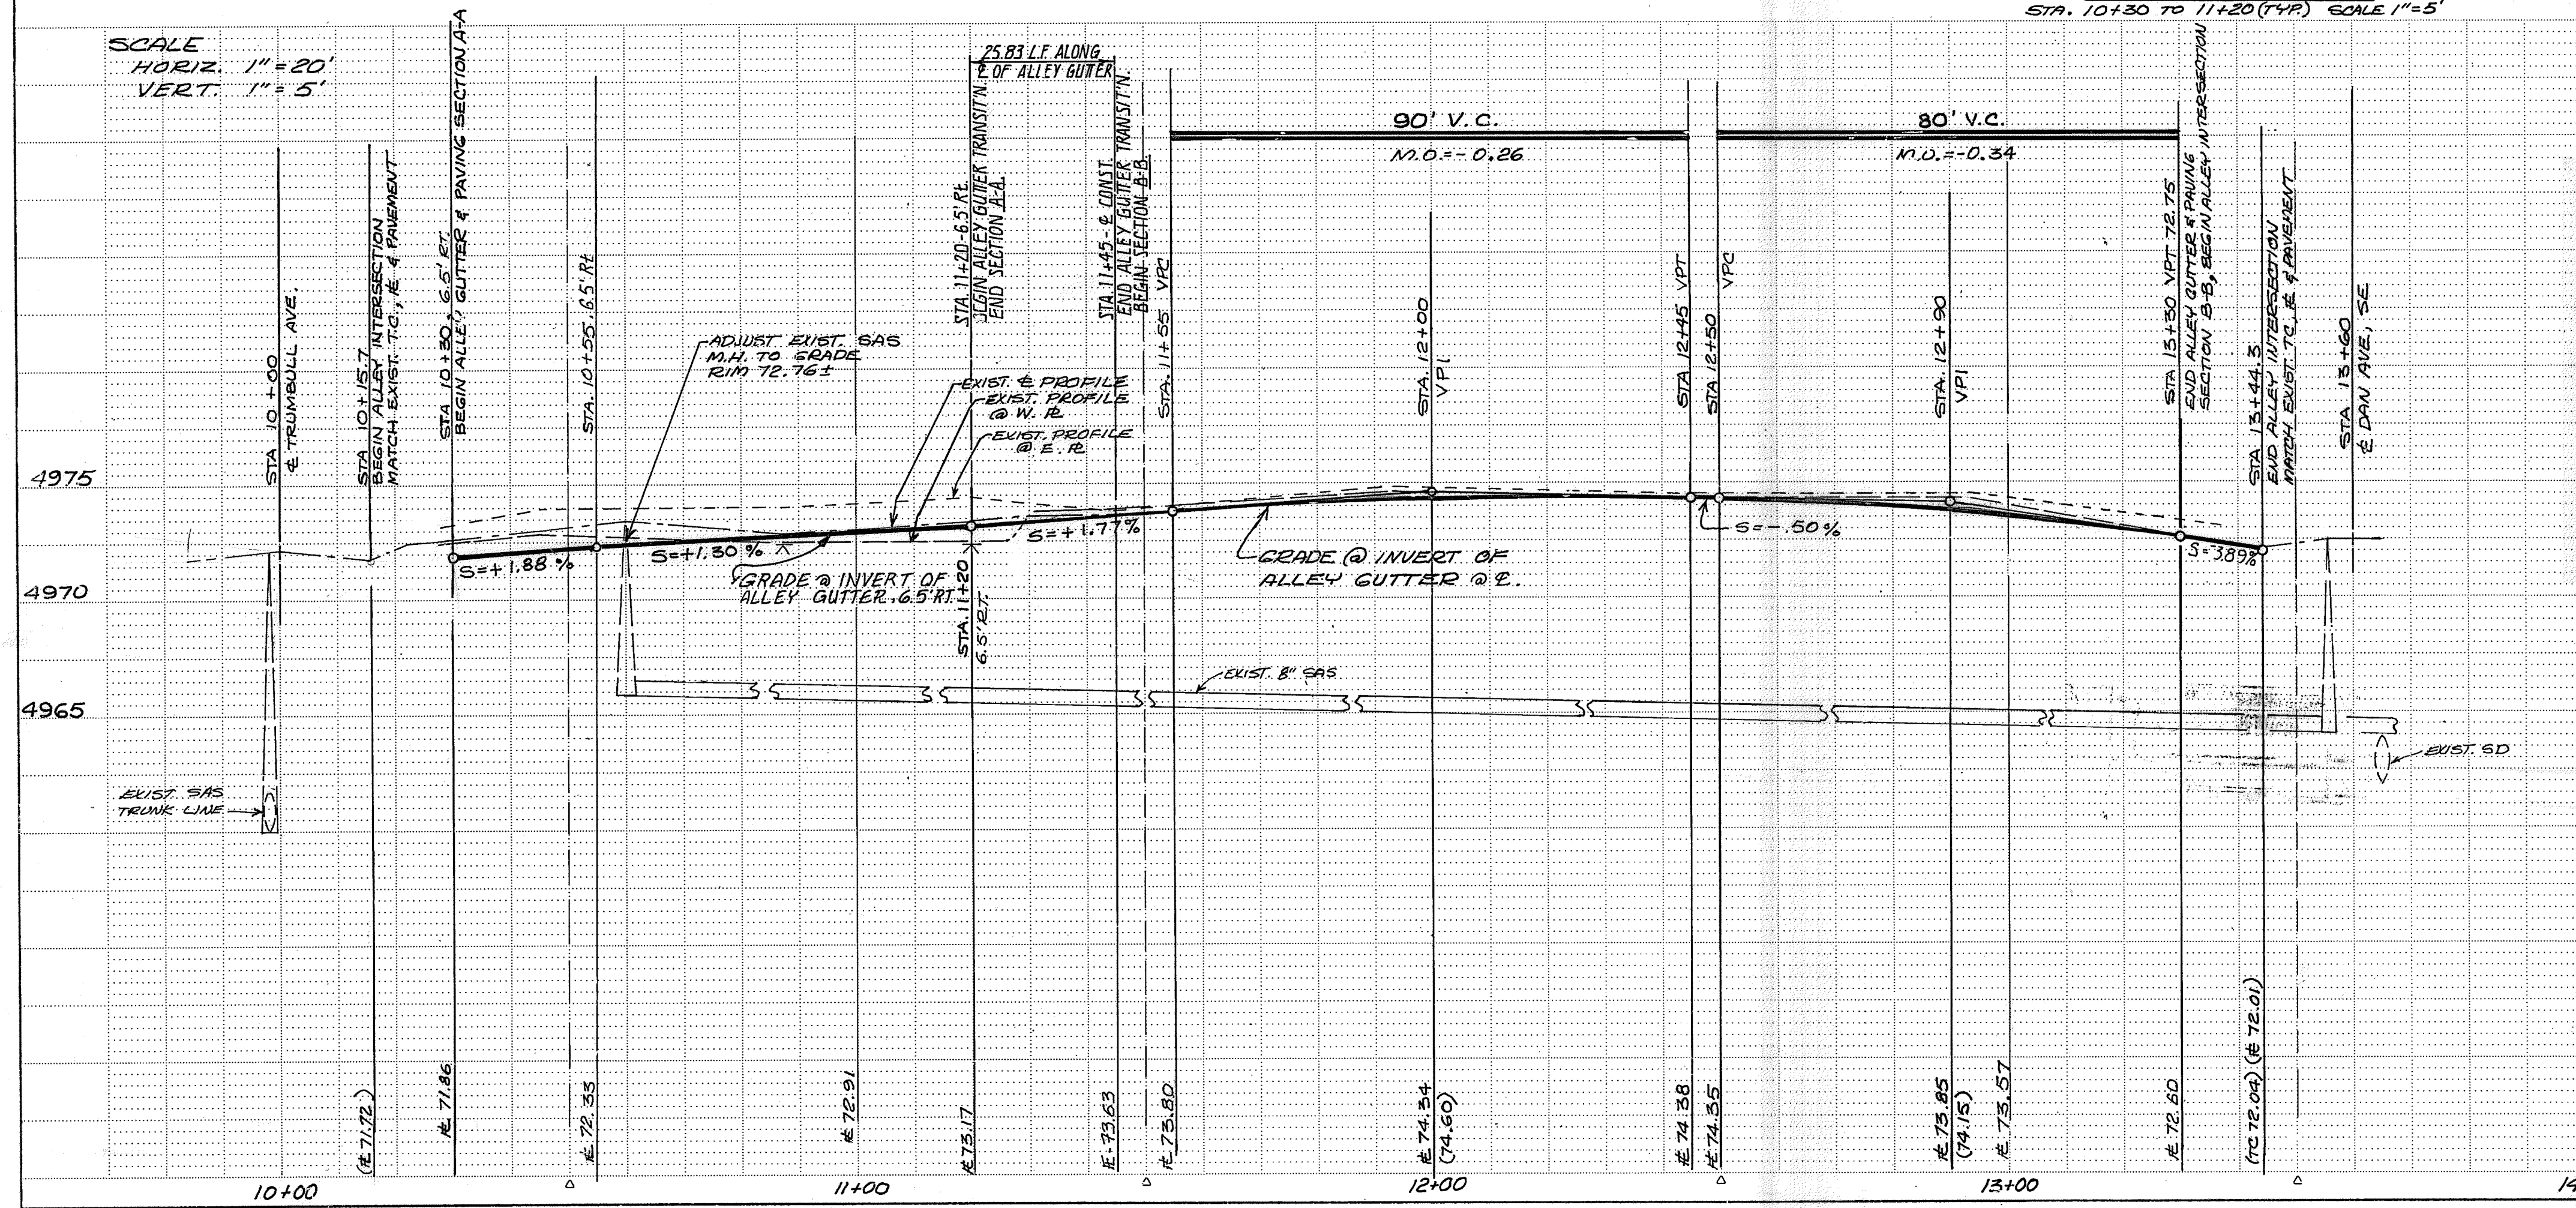

NOTE:
SOME EXISTING UNDERGROUND UTILITIES MAY NOT BE SHOWN IN THEIR EXACT LOCATION OR MAY NOT BE SHOWN AT ALL IN THESE DRAWINGS, DUE TO INACCURATE RECORD INFORMATION. IT IS THE CONTRACTOR'S FULL RESPONSIBILITY TO CONTACT THE UTILITY OWNERS AND DETERMINE THE EXACT LOCATION OF ALL UNDERGROUND UTILITIES, BEFORE INITIATING ANY COST OF LOCATION, REMOVAL AND RELOCATION OF UTILITIES NECESSARY FOR THE EXECUTION OF THIS PROJECT SHALL BE CONSIDERED AS INCIDENTAL TO THE CONSTRUCTION WORK; THEREFORE, IT SHALL BE PERFORMED AT NO ADDITIONAL COST TO THE OWNER.

FOR REFERENCE ONLY
APPROVAL OF AS-BUILT DRAWINGS
CHIEF CONSTRUCTION ENGINEER
[Signature]
DATE 7/30/99

GRADES ONLY

VICINITY MAP L-14

SCALE 1"=800'

NOTICE TO CONTRACTORS

1. All work detailed on these plans to be performed under contract shall, except as otherwise stated or provided for herein, be constructed in accordance with the City of Albuquerque Interim Standard Specifications for Construction 1985.

2. Two (2) working days prior to any excavation, the contractor must contact Line Locating Service, 765-1234, for location of existing utilities.

3. Prior to construction, the contractor shall excavate and verify the horizontal and vertical locations of all obstructions. Should a conflict exist, the contractor shall notify the engineer or surveyor so that the conflict can be resolved with minimum amount of delay.

THE FOLLOWING NOTES ALSO APPLY WHEN CHECKED

- ☐ All utilities and utility service lines shall be installed prior to paving.
- ☒ Backfill compaction shall be according to specified street use. (Arterial)
- ☒ Tack coat requirements shall be determined by the City Engineer.
- ☐ Sidewalks and wheelchair ramps within the curb returns shall be constructed wherever a new curb return is constructed.
- ☒ If curb is depressed for a driveway or a handicap ramp, the driveway or ramp shall be constructed prior to acceptance of the curb and gutter.
- ☐ All storm drainage facilities shall be completed prior to final acceptance.

LEGEND

- NEW STD. CURB & GUTTER, PER STD. P-8.
- EXISTING CURB & GUTTER
- NEW SPOT ELEVATION
- EXISTING SPOT ELEVATION
- EXISTING POWER POLE
- EXISTING FENCE
- SAS - EXISTING SANITARY SENSE LINE
- SD - EXISTING STORM DRAIN LINE
- W - EXISTING WATER LINE
- EXISTING STREET LIGHT
- NEW CUT-OFF WALL, PER STD. P-8
- LIMIT OF EXISTING PAVING
- NEW CONCRETE
- (TC 75.00) EXISTING TOP OF CURB ELEVATION
- NEW ASPHALT PAVEMENT
- TA - TOP OF PAVEMENT

CITY OF ALBUQUERQUE
MUNICIPAL DEVELOPMENT DEPARTMENT
ENGINEERING DIVISION

TITLE: GRADES FOR ALLEY EAST OF BROADWAY BLVD., S.E., FROM TRUMBULL AVE. TO DAN AVE.

APPROVALS	ENGINEER	DATE	APPROVALS	ENGINEER	DATE
City Engineer	<i>[Signature]</i>	2/26/87	Liquid Waste	<i>[Signature]</i>	2-6-87
A.C.E.-Design	<i>[Signature]</i>	2/13/87	Traffic	<i>[Signature]</i>	3/16/87
A.C.E.-Hydrology	<i>[Signature]</i>	"	Water	<i>[Signature]</i>	2-6-87

DESIGNED BY B. ENNETT / R. PANG DATE 12/29/86
DRAWN BY B. ENNETT DATE 12/29/86
CHECKED BY R. PANG DATE 12/29/86

AS BUILT INFORMATION	BENCH MARKS	SURVEY INFORMATION	ENGINEER'S SEAL
CONTRACTOR WORK DATE SCALE FIELD ACCEPTANCE BY DATE DRAWINGS CORRECTED BY DATE MICRO-FILM INFORMATION RECORDED BY DATE	15-K-14 CURB RETURN, INTER OF BROADWAY BLVD. SE & PAULINE AVE. SE ELEV. 4957.597 SEE ALLEY RET., INTER OF ALLEY AND DAN AVE., ELEV. 4975.30	NO. BY DATE DS 56 P. ADRIANE 12/24/86	NO. BY DATE REVISIONS DESIGN NO. DATE DATE 12/29/86 DATE 12/29/86