

CONSTRUCTION PLANS FOR

NOR ESTE ESTATES SUBDIVISION

DRAINAGE, GRADING, PAVING AND UTILITY
IMPROVEMENTS

SHEET INDEX

SHEET NO.

DESCRIPTION

SHEET NO.

DESCRIPTION

- 1 . . . COVER SHEET
2- 7 . . . PLAT SHEETS
8-13 . . . GRADING PLANS
14 . . . OVERALL PAVING PLAN
15 . . . OVERALL UTILITY PLAN

PAVING


- 16 . . . MODESTO AVE. N.E. 7+36.00 TO 18+00.00
17 . . . MODESTO AVE. N.E. 18+00.00 TO 28+00.00
18 . . . MODESTO AVE. N.E. 28+00.00 TO 38+05.39
19 . . . BARSTOW ST. N.E. 7+36.00 TO 17+00.00
20 . . . BARSTOW ST. N.E. 17+00.00 TO 27+00.00
21 . . . ALAMEDA BLVD. N.E. 8+35.00 TO 18+00.00
22 . . . ALAMEDA BLVD. N.E. 18+00.00 TO 28+00.00
23 . . . ALAMEDA BLVD. N.E. 28+00.00 TO 38+05.39
24 . . . WYOMING BLVD. N.E. 7+36.00 TO 17+00.00
25 . . . WYOMING BLVD. N.E. 17+00.00 TO 27+00.00
26 . . . OAKLAND AVE. N.E. 8+35.00 TO 18+00.00
27 . . . OAKLAND AVE. N.E. 18+00.00 TO 28+00.00
28 . . . OAKLAND AVE. N.E. 28+00.00 TO 36+59.69
29 . . . STEIDER ST. N.E. 10+00.00 TO 13+54.96
30 . . . MOYERS AVE. N.E. 10+79.98 TO 20+00.00
31 . . . MOYERS AVE. N.E. 20+00.00 TO 28+19.09
32 . . . O'KEEFFE DR. N.E. 10+00.00 TO 18+77.98
33 . . . HURD ST. N.E. 10+00.00 TO 12+50.00
34 . . . HURLEY ST. N.E. 11+65.00 TO 14+39.68
35 . . . WYETH DR. N.E. 10+00.00 TO 14+55.83
36 . . . BAMBROOK PL. N.E. 10+00.00 TO 15+57.47
37 . . . ELLIS CT. N.E. 10+00.00 TO 11+17.10
38 . . . EAGLE ROCK AVE. N.E. 8+35.00 TO 18+00.00
39 . . . EAGLE ROCK AVE. N.E. 18+00.00 TO 26+00.00
40 . . . EAGLE ROCK AVE. N.E. 26+00.00 TO 34+05.62
41 . . . GORMAN AVE. N.E. 10+00.00 TO 18+00.00
42 . . . GORMAN AVE. N.E. 18+00.00 TO 26+08.72
43 . . . EAGLE ROCK AVE. N.E. 26+08.72 TO 30+39.34
44 . . . SABO ST. N.E. 10+00.00 TO 11+76.24
45 . . . RIPPEL PL. N.E. 10+00.00 TO 16+84.29
46 . . . RIPPEL PL. N.E. 16+84.29 TO 25+49.56

STORM SEWER

- 44 . . . WYOMING BLVD. N.E. 17+65.00 TO 25+52.98
45 . . . ALAMEDA BLVD. N.E. 9+90.00 TO 11+30.00
46 . . . OAKLAND AVE. N.E. 9+90.00 TO 11+89.55
47 . . . STEIDER ST. N.E. 10+00.00 TO 10+71.83
48 . . . O'KEEFFE DR. N.E. 12+25.00 TO 12+50.00

WATER AND SEWER

- 49 . . . BARSTOW ST. N.E. 7+36.00 TO 17+00.00
50 . . . BARSTOW ST. N.E. 17+00.00 TO 27+00.00
51 . . . WYOMING BLVD. N.E. 7+36.00 TO 17+00.00
52 . . . WYOMING BLVD. N.E. 17+00.00 TO 27+00.00
53 . . . SANITARY SEWER LINE "A" 10+88.48 TO 16+23.37
54 . . . OAKLAND AVE. N.E. 8+35.00 TO 18+00.00
55 . . . OAKLAND AVE. N.E. 18+00.00 TO 28+00.00
56 . . . OAKLAND AVE. N.E. 28+00.00 TO 36+59.64
57 . . . STEIDER ST. N.E. 10+00.00 TO 13+54.96
58 . . . MOYERS AVE. N.E. 10+00.00 TO 20+00.00
59 . . . MOYERS AVE. N.E. 20+00.00 TO 28+40.33
60 . . . O'KEEFFE DR. N.E. 10+00.00 TO 18+77.98
61 . . . HURD ST. N.E. 10+00.00 TO 12+50.00
62 . . . HURLEY ST. N.E. 11+65.00 TO 14+39.68
63 . . . WYETH DR. N.E. 10+00.00 TO 14+55.83
64 . . . BAMBROOK PL. N.E. 10+00.00 TO 15+57.47
65 . . . ELLIS CT. N.E. 10+00.00 TO 11+17.10
66 . . . EAGLE ROCK AVE. N.E. 8+35.00 TO 18+00.00
67 . . . EAGLE ROCK AVE. N.E. 18+00.00 TO 26+00.00
68 . . . EAGLE ROCK AVE. N.E. 26+00.00 TO 34+05.62
69 . . . GORMAN AVE. N.E. 10+00.00 TO 18+00.00
70 . . . GORMAN AVE. N.E. 18+00.00 TO 26+08.72
71 . . . EAGLE ROCK AVE. N.E. 26+08.72 TO 30+39.94
72 . . . SABO ST. N.E. 10+00.00 TO 11+76.24
73 . . . RIPPEL PL. N.E. 10+00.00 TO 16+84.29
74 . . . RIPPEL PL. N.E. 16+84.29 TO 25+49.56
75 . . . GRADING DETAILS
76 . . . STREET SECTIONS
77 . . . PAVING DETAILS
78 . . . BRIDGE DETAILS
79 . . . MISCELLANEOUS DETAILS
80 . . . WYOMING BLVD N.E.-TEMPORARY CROSSING FACILITY

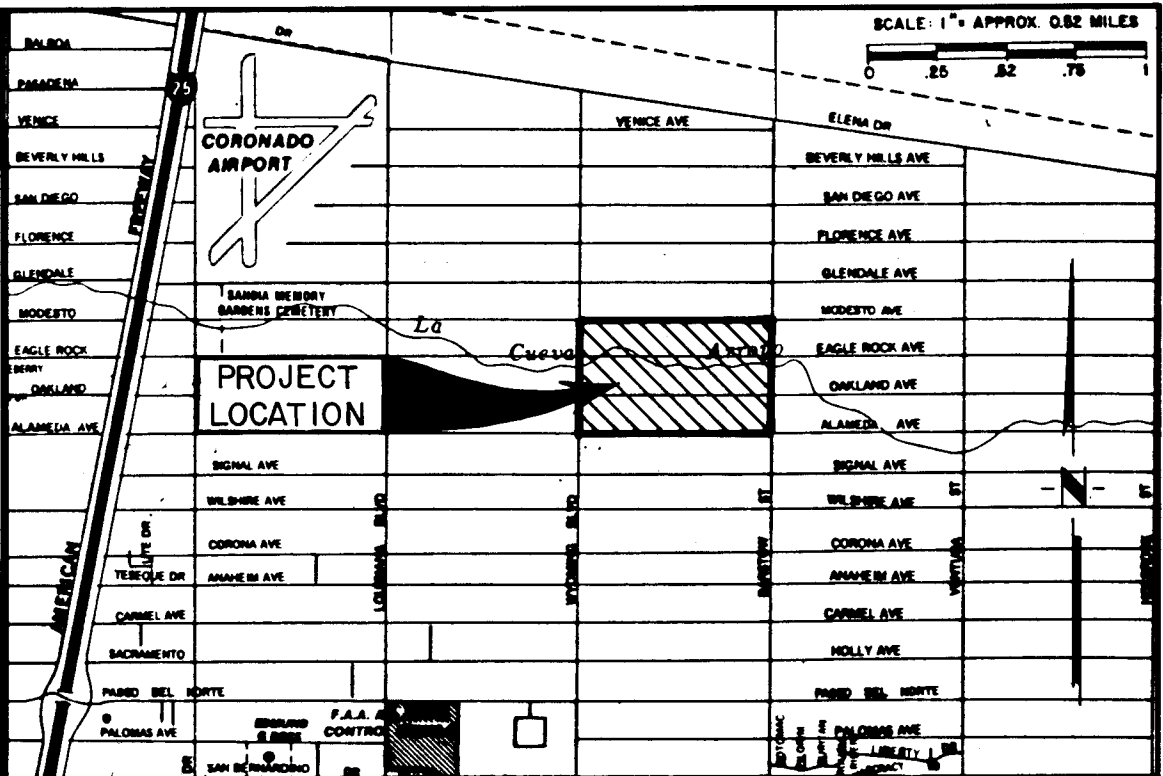

VICINITY MAP

C-19


GENERAL NOTES


- All work detailed on these plans to be performed under contract, and unless stated otherwise or provided for hereon, shall be constructed in accordance with the City of Albuquerque Standard Specifications, Public Works Construction, 1986 (referred herein as "Standard Specification").
- Two (2) working days prior to any excavation, Contractor must contact line locating service, 765-1234, for location of existing utilities.
- Prior to construction, the Contractor shall excavate and verify the horizontal and vertical locations of all potential obstructions. Should a conflict exist, the Contractor shall notify the Engineer so that the conflict can be resolved with a minimum amount of delay.
- All work on this project shall be performed in accordance with applicable Federal, State and Local laws, rules, and regulations concerning construction safety and health.
- Contractor shall maintain access to adjacent properties during construction.
- All gas, electric, telephone lines, cables, and appurtenances encountered during construction that require relocation, shall be coordinated with that utility. Contractor shall be responsible for coordination of all necessary utility adjustments.
- It will be the Contractor's responsibility to protect and maintain in service all existing utilities.
- The Contractor will be required to confine his work within the construction limits and/or public right-of-way to preserve existing vegetation and private property. Overnight parking of construction equipment shall not obstruct driveways or designated traffic lanes.
- A disposal site for all excess excavation material, asphaltic paving, concrete curbs and sidewalks, etc., shall be obtained by the Contractor in compliance with applicable environmental regulations and approved by the Field Engineer. All costs incurred in obtaining a disposal site and haul thereto shall be considered incidental to the project and no separate measurement or payment shall be made.
- When abutting new pavement to existing, sawcut existing pavement to a straight edge and at a right angle, or as approved by the Project Engineer, to remove any broken or cracked pavement.
- The Contractor must submit a construction signing and barricading plan to Traffic Engineering a minimum of three (3) working days prior to construction to receive a barricading permit.
- All trench backfill shall be compacted to a minimum 90% maximum density as per ASTM D-1557.

Brian Dolan
4/1/88

26 31860188

REV	SHEETS	CITY	ENGR.	DATE	USER	DEPT.	DATE	USER	DEPT.	DATE
APPROVAL OF REVISIONS										

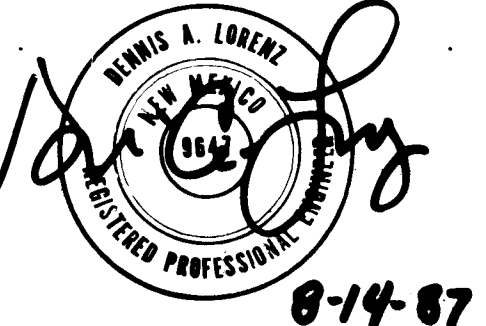ENGINEERS SEAL		eh	ESPEY, HUSTON & ASSOC., INC. Engineers • Planners • Surveyors 317 Commercial Street N.E. Albuquerque, New Mexico 87102 (505) 242-1909	APPROVED FOR CONSTRUCTION <i>[Signature]</i> C.E.	
					
PROJECT NUMBER			3186	SHEET 1 OF 77	

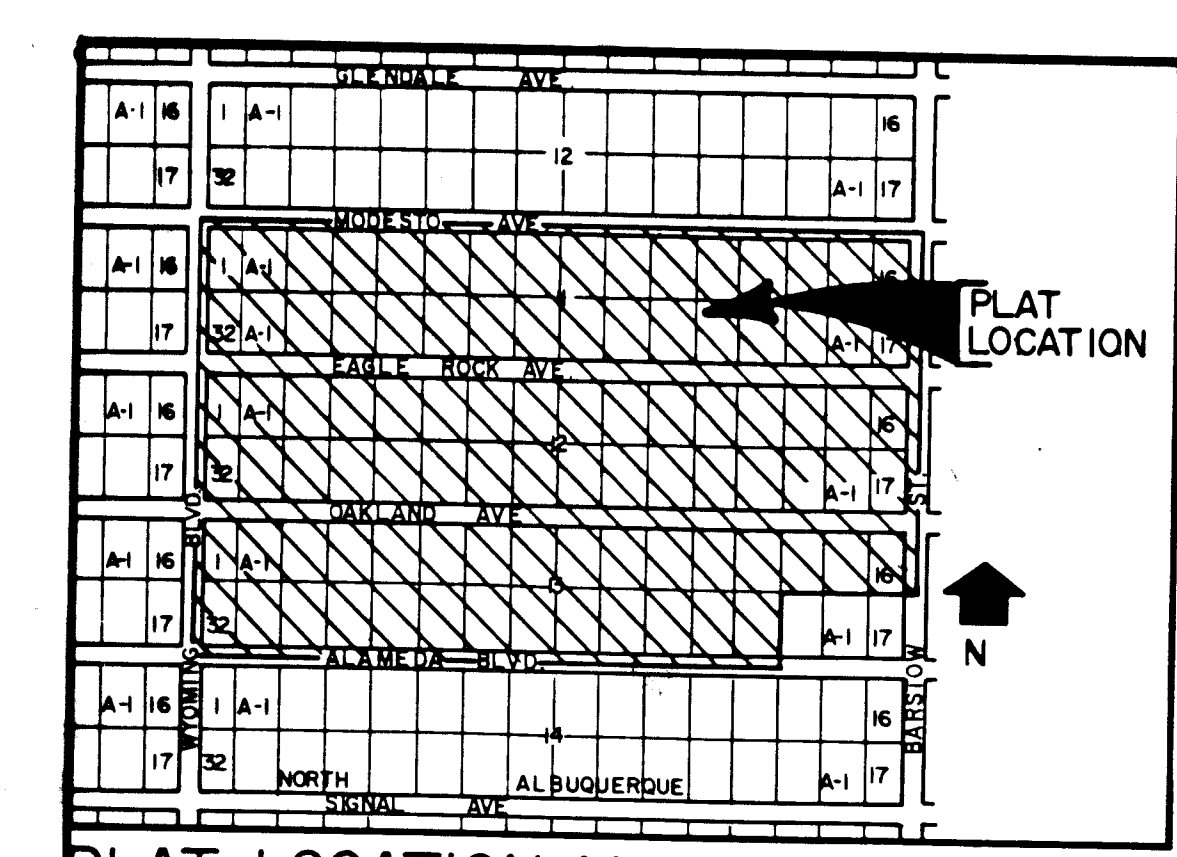

PLAT LOCATION MAP C-19
SCALE: 1"=800'

- SUBDIVISION DATA**
- DRB Case No. 87-168
 - Zone Atlas Index No. C-19
 - Total Number Lots Created: 348
 - Gross Subdivision Acreage: 92.9554 Acres
 - Total Mileage of Full Width Streets Created: 2.9077 Miles
 - Date of Survey: April 1, 1986 (F.B.#116)

- NOTES**
- Bearings are New Mexico State Plane Grid Bearings (Central Zone).
 - Distances are ground distances.
 - Unless otherwise indicated, all points marked with an open circle are set 5/8" rebar with plastic cap marked "N" and A.L.S. 7719.
 - Bearings and distances in parenthesis are records.
 - The subdivision shown hereon apparently affected by reservations contained in Patent from U.S.A. (Book 80, Page 353).
 - Centerline (in lieu of R/W monumentation) to be installed at all centerline (C.C.) points and street intersections prior to acceptance of subdivision street improvements and will consist of a standard four inch (4") aluminum alloy cap, stamped "City of Albuquerque", "Centerline Monumentation", "Survey Marker", "No Net Disturb", "NMS 7719", indicated hereon.
 - Lots noted with an asterisk (*) shall meet the setback and height limitations as noted in Sections 10-5-3-d and 40-C-1-g, respectively, of the City of Albuquerque Comprehensive City Zoning Code.
 - Lots noted with a darkened square (■) shall have a twenty (20) foot wide rear setback on the street side to conform to Section 10-5-2-a of the City of Albuquerque Comprehensive City Zoning Code.

GRANT OF DRAINAGE AND FLOOD CONTROL RIGHT-OF-WAY

Dedication to the Albuquerque Metropolitan Arroyo Flood Control Authority, its successors and assigns, of the lands, right-of-way, and easements designated hereon is with the full and free consent and in accordance with the desire of the undersigned owners. This dedication is for drainage, flood control, and the construction, operation, and maintenance of related facilities. Any portion of any lands, right-of-way, or easement dedicated or granted herein shall revert to the owner, its successors and assigns as to the extent said portion is declared unnecessary for flood control and drainage by the Board of Directors of the Albuquerque Metropolitan Arroyo Flood Control Authority. Any reversion shall be conveyed by quitclaim deed.

PRESLEY COMPANY OF NEW MEXICO, A New Mexico Corporation
Luis W. Wilk, President
15 June 87

STATE OF NEW MEXICO)
COUNTY OF BERNALILLO)
DENNIS A. LORENZ
Notary Public, State of New Mexico
My Commission Expires 7-19-91

On this 15th day of JUNE, 1987, the foregoing instrument was acknowledged before me. My commission expires 7-19-91.
Dennis A. Lorenz
Notary Public

SP-06-16-1789

PURPOSE OF THIS PLAT

- Vacate interior lotlines and streets as shown hereon.
- Dedicate street right-of-way and park areas to the City of Albuquerque.
- Dedicate A.M.A.F.C.A. drainage right-of-way.
- Grant public drainage, public utility, wall and landscape, park and landscape, park access, public utility easer and A.M.A.F.C.A. dike easements.
- To fulfill the requirements of SD-86-3, AX-86-11, Z-86-65 and V-87-67.

DESCRIPTION

A tract of land situated within projected Section 18, Township 11 North, Range 4 East, New Mexico Principal Meridian, within the Elise, Delgado, Green, City of Albuquerque, Bernalillo County, New Mexico being all of BLOCKS 11 through 12, LOTS 1 through 16 and LOTS 1 through 16 of BLOCK 13, NORTH ALBUQUERQUE ACRES, TRACT 2, UNIT 3, together with portions of EAGLE ROCK AVENUE N.E. and OAKLAND AVENUE N.E. all being the same as shown and designated on said plat filed for record in the office of the County Clerk of Bernalillo County, New Mexico on September 10th, 1931 (Book D-1, Page 20) and being more particularly described as follows:

BEGINNING at the northwest corner of the herein described tract, said point being the centerline intersection of WYOMING BOULEVARD N.E. and Modesto Avenue N.E. (see from the Albuquerque Control Survey Monument "B-19" bears N 45° 16' 17" E, 42.34 feet);

THENCE along the centerline of MODESTO AVENUE N.E. S 89° 36' 55" E, 2640.38 feet to the northeast corner, said point being the centerline intersection of MODESTO AVENUE N.E. and BARSTOW STREET N.E.;

THENCE along the centerline of BARSTOW STREET N.E. S 00° 09' 10" W, 1319.16 feet to a point;

THENCE leaving said centerline N 89° 36' 55" W, 494.63 feet to a point, said point being the northeast corner of LOT 19, BLOCK 13, NORTH ALBUQUERQUE ACRES, TRACT 2, UNIT No. 3;

THENCE S 00° 09' 10" W, 263.83 feet to a point, said point being on the centerline of ALAMEDA BOULEVARD N.E.;

THENCE along said centerline N 89° 36' 55" W, 2145.71 feet to the southeast corner, said point being the centerline intersection of WYOMING BOULEVARD N.E. and ALAMEDA BOULEVARD N.E.;

THENCE along the centerline of WYOMING BOULEVARD N.E. N 00° 09' 10" E, 1582.99 feet to the point of beginning and containing 92.9554 acres, more or less.

FREE CONSENT AND DEDICATION

The subdivision hereon described is with the free consent and in accordance with the desire of the undersigned owner and/or proprietor thereof. Said owner and/or proprietor do hereby grant Public Drainage, dedicate areas designated hereon as "PARK" including all street right-of-way to the City of Albuquerque, in fee simple. Said owner and/or proprietor hereby grants Public Utility Easements being ten (10) feet wide and granted for the common joint use and benefit of:

- The Public Service Company of New Mexico for the installation, maintenance and service of underground electrical lines, transformers, and other related equipment and facilities reasonably necessary to provide electrical service.
- The Gas Company of New Mexico for the installation, maintenance and service of natural gas lines, valves and other related equipment and facilities reasonably necessary to provide natural gas service.
- Mountain Bell Telephone for the installation, maintenance and service of underground telephone lines, switching equipment and facilities reasonably necessary to provide telephone service.
- Albuquerque Cable Television, Inc. for the installation, maintenance and service of underground cable television lines and other related equipment and facilities reasonably necessary to provide cable television service.

Said owner and/or proprietor grants Wall and Landscape Easements and consents to the vacation of interior lot lines and streets shown hereon.

PRESLEY COMPANY OF NEW MEXICO, A New Mexico Corporation
Luis W. Wilk, President
15 June 87

STATE OF NEW MEXICO)
COUNTY OF BERNALILLO)
DENNIS A. LORENZ
Notary Public, State of New Mexico
My Commission Expires 7-19-91

On this 15th day of JUNE, 1987, the foregoing instrument was acknowledged before me. My commission expires 7-19-91.
Dennis A. Lorenz
Notary Public

**PLAT FOR
NOR ESTE ESTATES
BLOCKS 1 THROUGH 11
CITY OF ALBUQUERQUE
BERNALILLO COUNTY, NEW MEXICO
JUNE 1987**

NOTICE: THE TOTAL NUMBER OF DWELLING UNITS WHICH MAY BE PERMITTED IS REGULATED THROUGH SPECIAL SECTOR PLAN REQUIREMENTS. TO DETERMINE THE NUMBER OF DWELLING UNITS ASSIGNED TO ANY PARCEL, CONTACT THE CITY PLANNING DEPARTMENT.

ALL LOTS ADJOINING MODESTO AVE., BARSTOW ST., ALAMEDA BLVD. AND WYOMING BLVD. SHALL NOT BE PERMITTED TO HAVE REARYARD ACCESS.

APPROVED AND ACCEPTED BY:

Subdivision Case No. _____

Planning Director, City of Albuquerque, New Mexico _____ Date _____

City Engineering Division, City of Albuquerque, New Mexico _____ Date _____

Albuquerque Metropolitan Arroyo Flood Control Authority _____ Date _____

Traffic Division, City of Albuquerque, New Mexico _____ Date _____

Water Utilities Department, City of Albuquerque, New Mexico _____ Date _____

Public Registration Department, City of Albuquerque, New Mexico _____ Date _____

Chief City Surveyor, City of Albuquerque, New Mexico _____ Date 06/16/87



Property Manager, City of Albuquerque, New Mexico _____ Date 6-24-87



Mountain Bell Telephone _____ Date 6/24/87

Public Service Company of New Mexico _____ Date _____

SURVEYOR'S CERTIFICATION

"I, Timothy Aldrich, a duly qualified Registered Professional Land Surveyor under the laws of the State of New Mexico, do hereby certify that this plat was prepared by me or under my supervision, shows all easements and restrictions as shown on the plat of record and noted in the title policies prepared by First National Title Insurance Company, DIO0552, DIO0555, DIO0556, DIO0557, DIO1817, DIO1

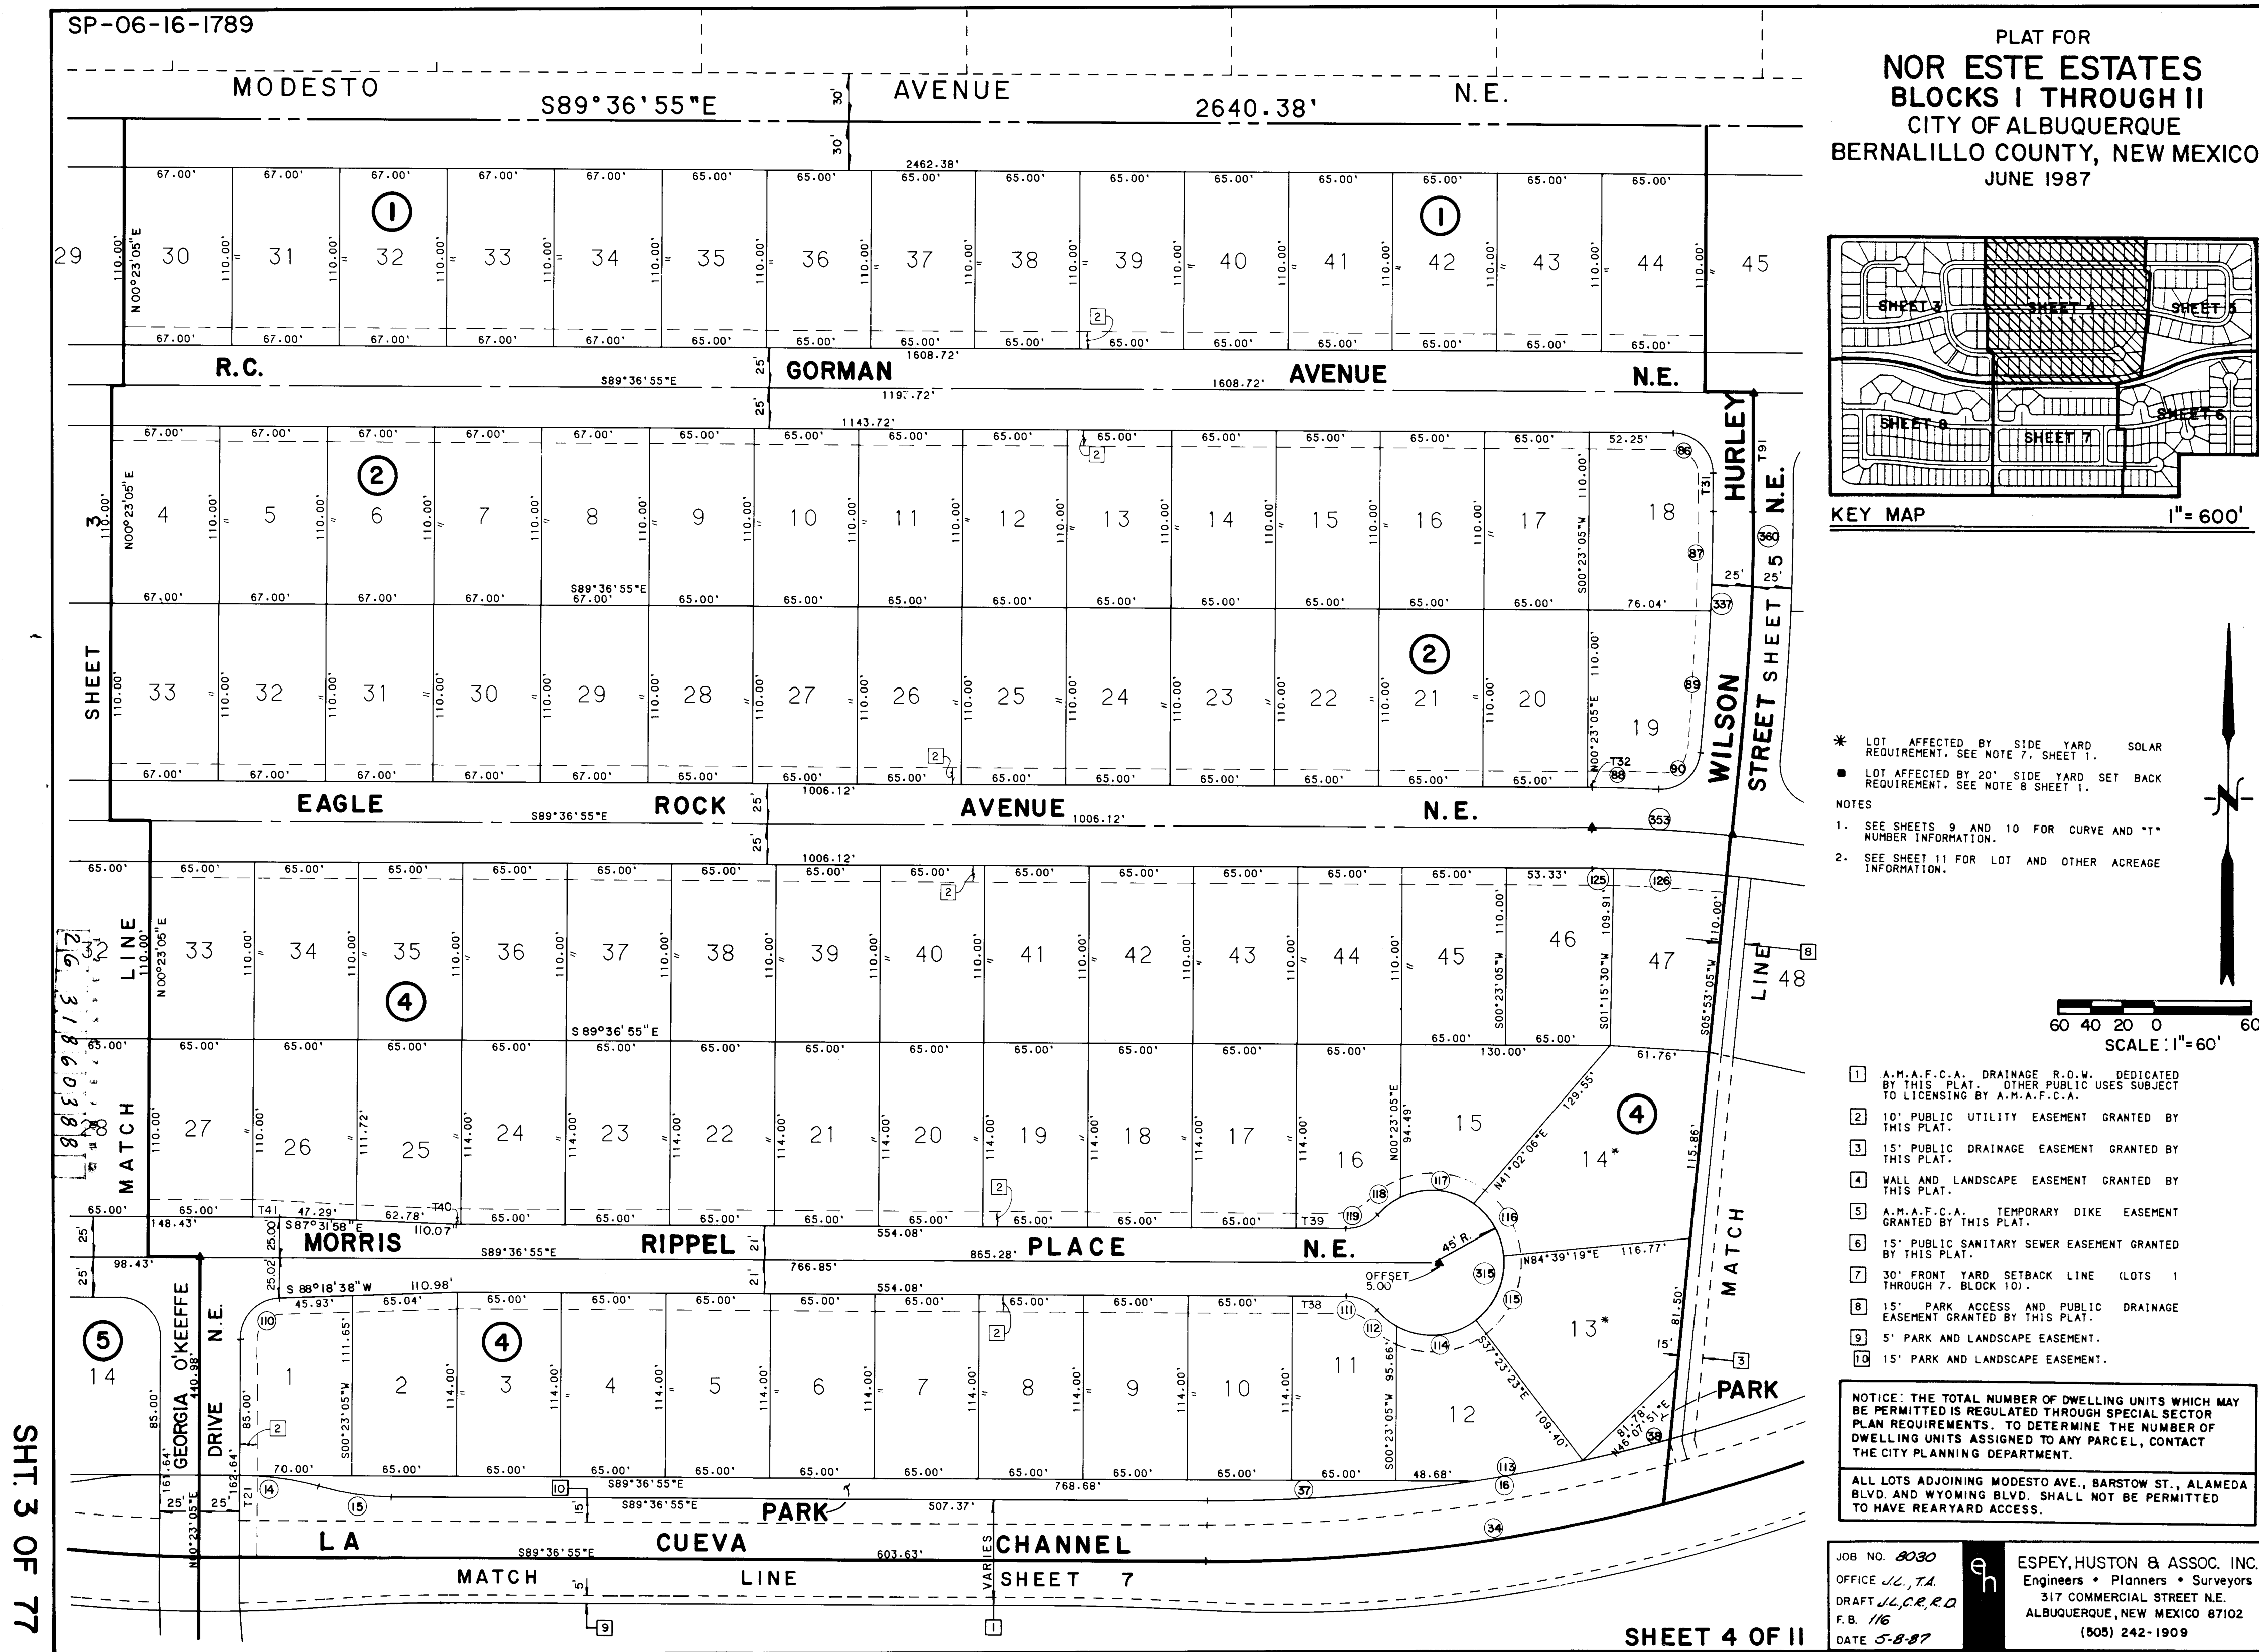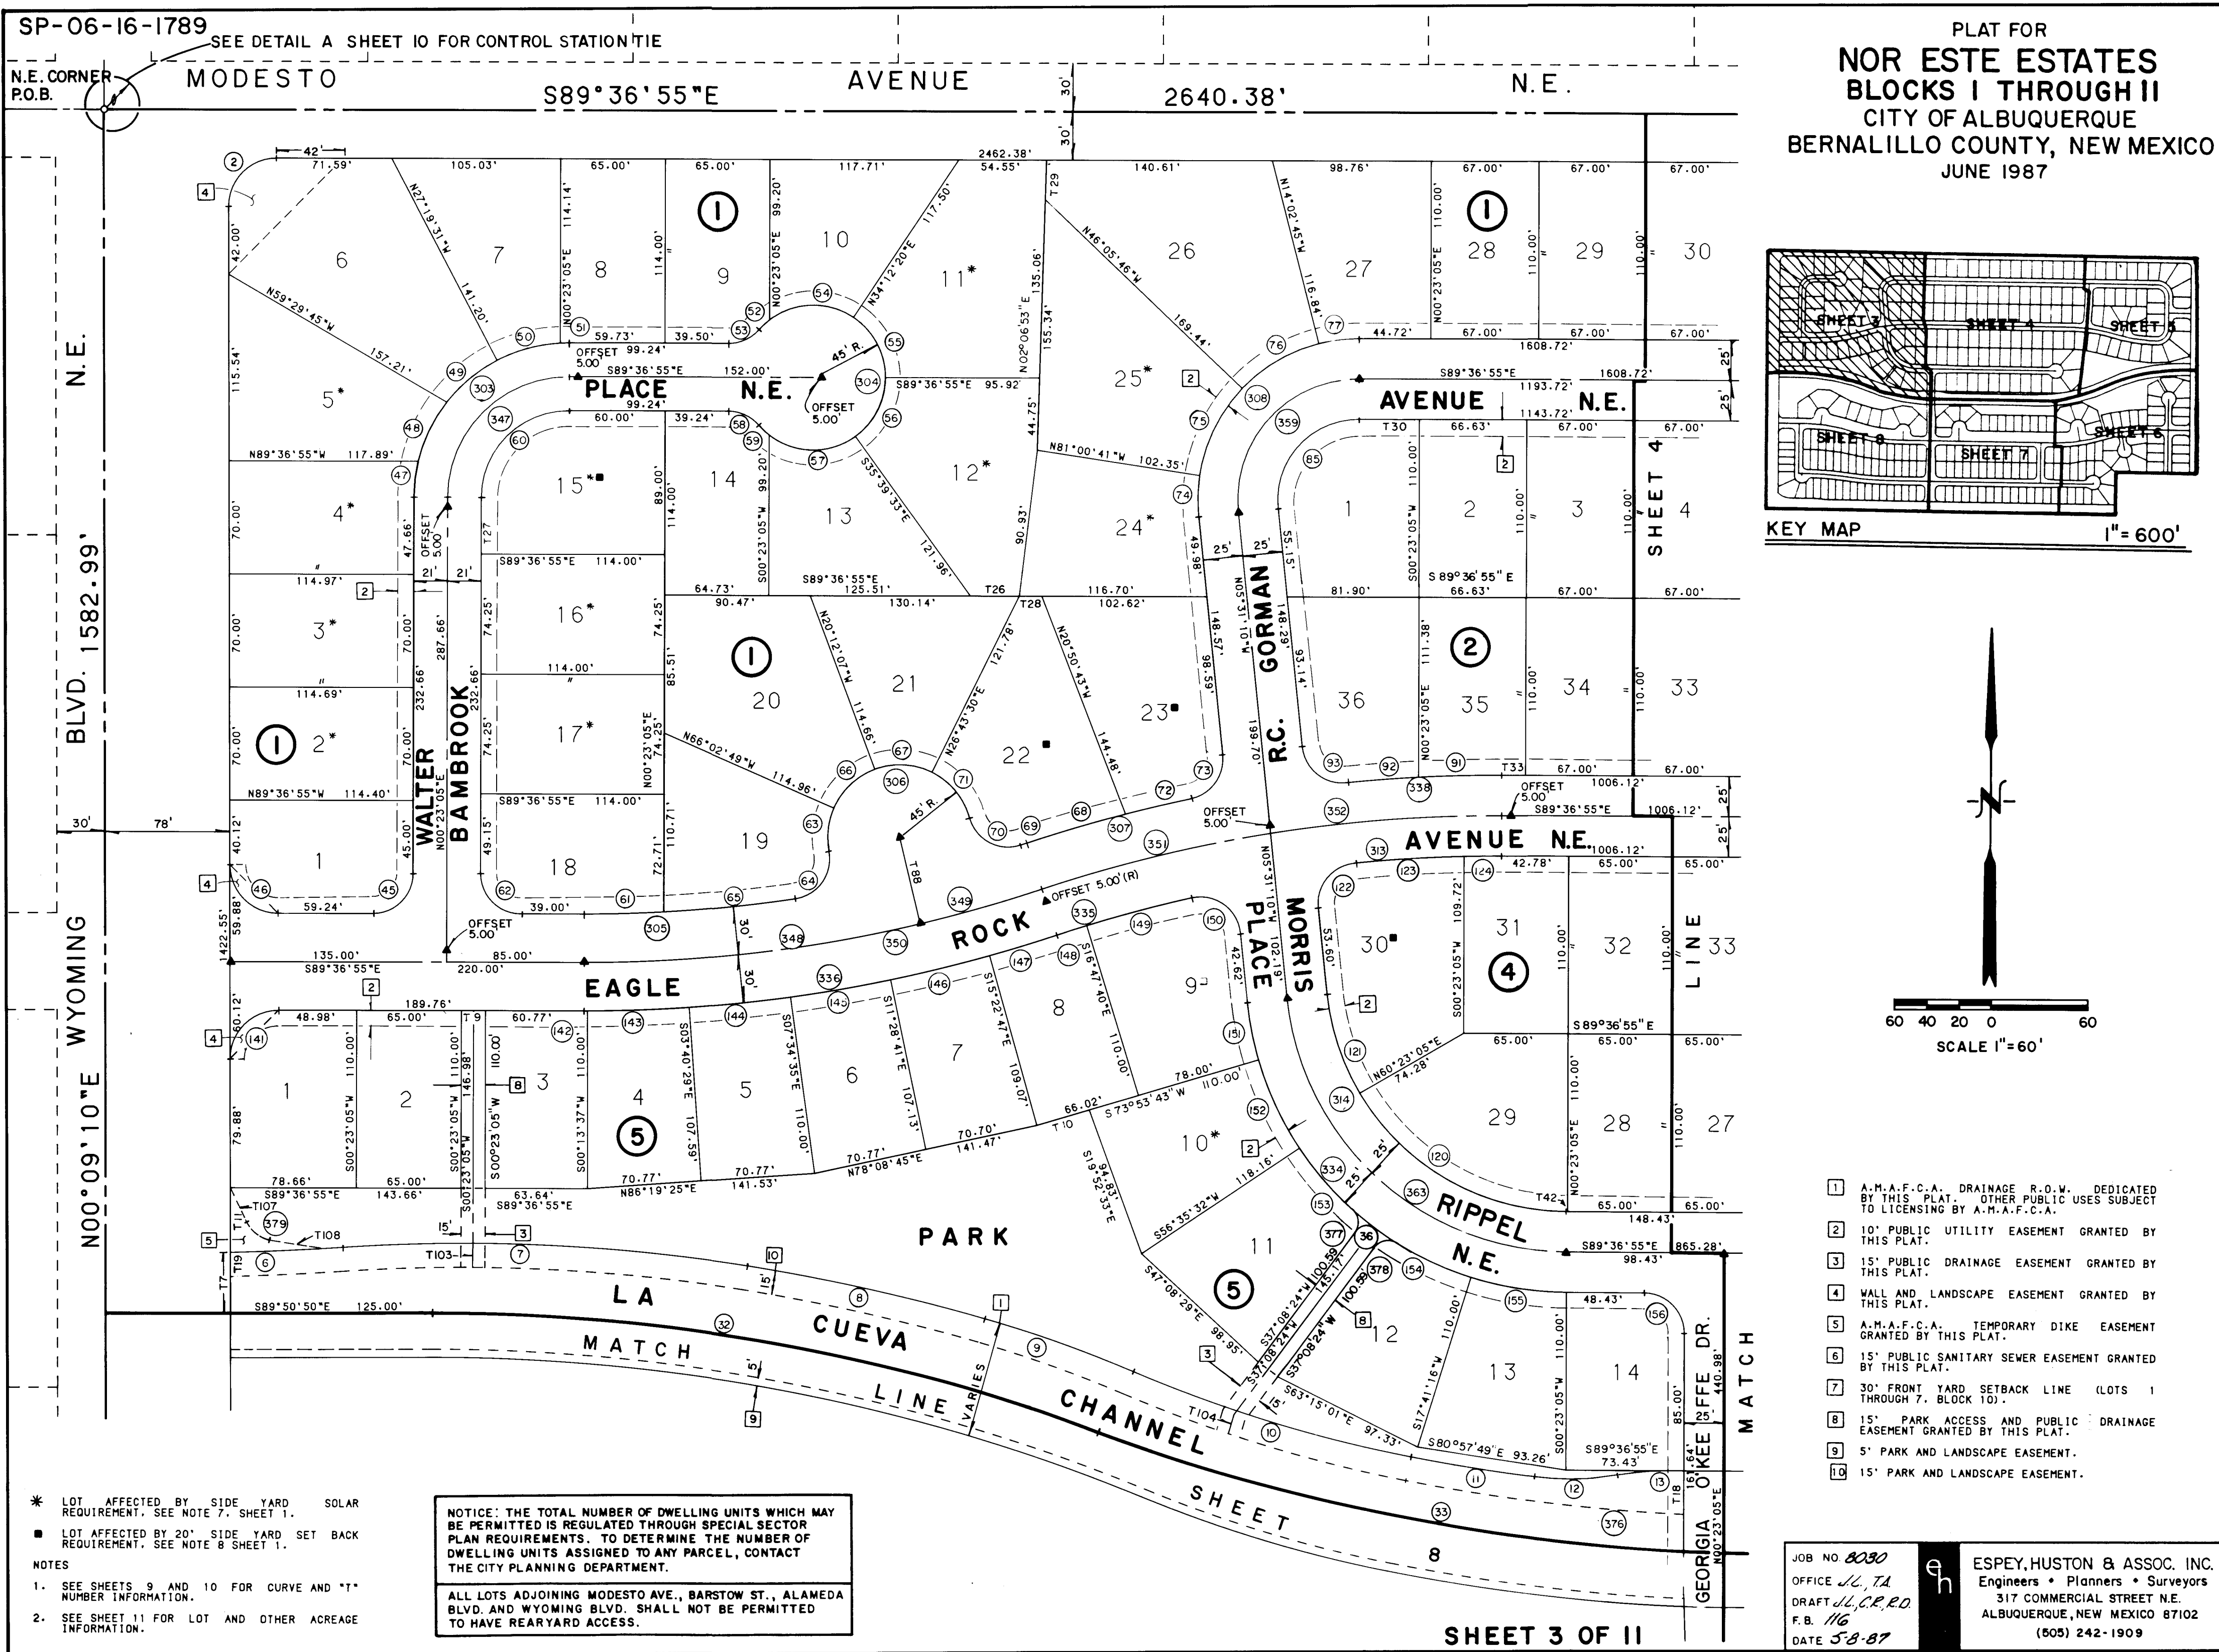

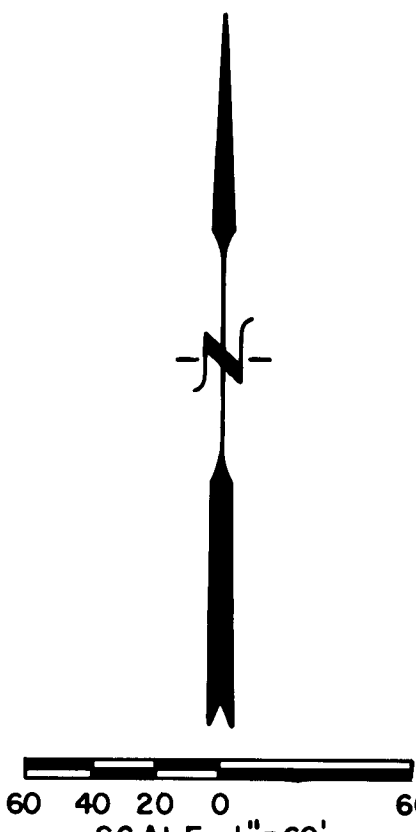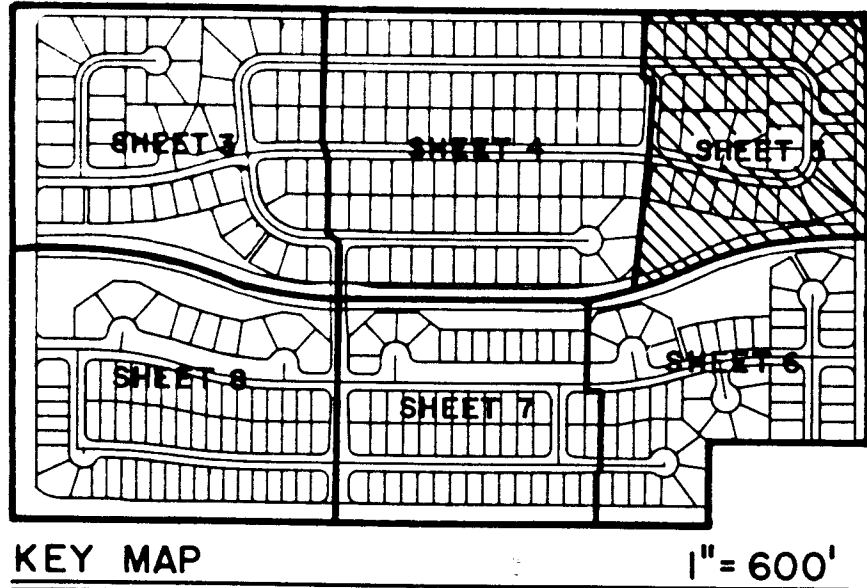



- 1 A.M.A.F.C.A. DRAINAGE R.O.W. DEDICATED BY THIS PLAT. OTHER PUBLIC USES SUBJECT TO LICENSING BY A.M.A.F.C.A.
- 2 10' PUBLIC UTILITY EASEMENT GRANTED BY THIS PLAT.
- 3 15' PUBLIC DRAINAGE EASEMENT GRANTED BY THIS PLAT.
- 4 WALL AND LANDSCAPE EASEMENT GRANTED BY THIS PLAT.
- 5 A.M.A.F.C.A. TEMPORARY DIKE EASEMENT GRANTED BY THIS PLAT.
- 6 15' PUBLIC SANITARY SEWER EASEMENT GRANTED BY THIS PLAT.
- 7 30' FRONT YARD SETBACK LINE (LOTS 1 THROUGH 7, BLOCK 10).
- 8 15' PARK ACCESS AND PUBLIC DRAINAGE EASEMENT GRANTED BY THIS PLAT.
- 9 5' PARK AND LANDSCAPE EASEMENT.
- 10 15' PARK AND LANDSCAPE EASEMENT.

NOTICE: THE TOTAL NUMBER OF DWELLING UNITS WHICH MAY BE PERMITTED IS REGULATED THROUGH SPECIAL SECTOR PLAN REQUIREMENTS. TO DETERMINE THE NUMBER OF DWELLING UNITS ASSIGNED TO ANY PARCEL, CONTACT THE CITY PLANNING DEPARTMENT.

ALL LOTS ADJOINING MODESTO AVE., BARSTOW ST., ALAMEDA BLVD. AND WYOMING BLVD. SHALL NOT BE PERMITTED TO HAVE REARYARD ACCESS.

JOB NO. 8030
OFFICE J.L.T.A.
DRAFT J.L.C.R., R.D.
F.B. 116
DATE 5-8-87

ESPEY, HUSTON & ASSOC. INC.
Engineers • Planners • Surveyors
317 COMMERCIAL STREET N.E.
ALBUQUERQUE, NEW MEXICO 87102
(505) 242-1909

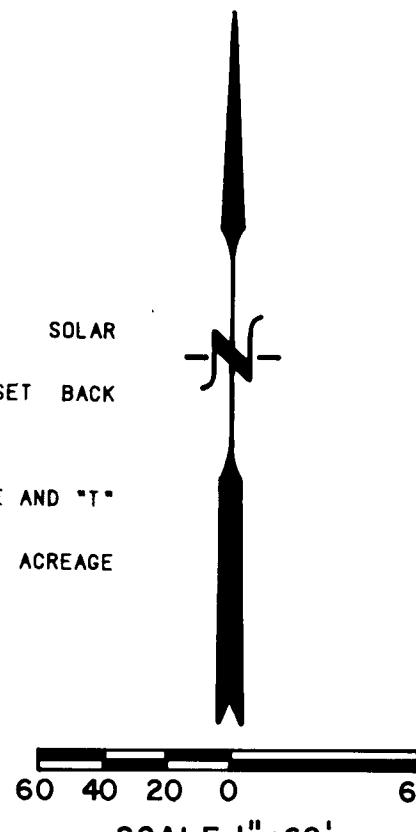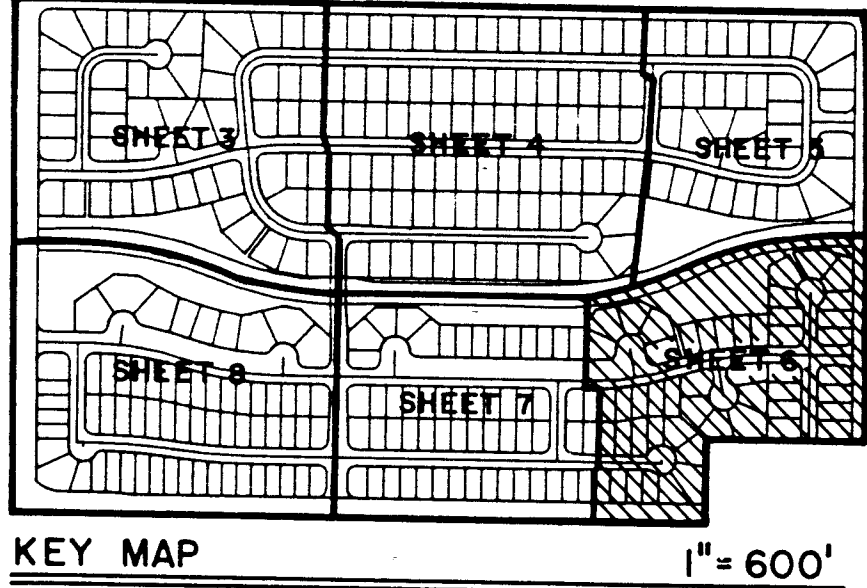

- * LOT AFFECTED BY SIDE YARD SOLAR REQUIREMENT. SEE NOTE 7, SHEET 1.
 - LOT AFFECTED BY 20' SIDE YARD SET BACK REQUIREMENT. SEE NOTE 8 SHEET 1.
- NOTES
1. SEE SHEETS 9 AND 10 FOR CURVE AND "T" NUMBER INFORMATION.
 2. SEE SHEET 11 FOR LOT AND OTHER ACREAGE INFORMATION.

- 1 A.M.A.F.C.A. DRAINAGE R.O.W. DEDICATED BY THIS PLAT. OTHER PUBLIC USES SUBJECT TO LICENSING BY A.M.A.F.C.A.
- 2 10' PUBLIC UTILITY EASEMENT GRANTED BY THIS PLAT.
- 3 15' PUBLIC DRAINAGE EASEMENT GRANTED BY THIS PLAT.
- 4 WALL AND LANDSCAPE EASEMENT GRANTED BY THIS PLAT.
- 5 A.M.A.F.C.A. TEMPORARY DIKE EASEMENT GRANTED BY THIS PLAT.
- 6 15' PUBLIC SANITARY SEWER EASEMENT GRANTED BY THIS PLAT.
- 7 30' FRONT YARD SETBACK LINE (LOTS 1 THROUGH 7, BLOCK 10).
- 8 15' PARK ACCESS AND PUBLIC DRAINAGE EASEMENT GRANTED BY THIS PLAT.
- 9 5' PARK AND LANDSCAPE EASEMENT.
- 10 15' PARK AND LANDSCAPE EASEMENT.



NOTICE: THE TOTAL NUMBER OF DWELLING UNITS WHICH MAY BE PERMITTED IS REGULATED THROUGH SPECIAL SECTOR PLAN REQUIREMENTS. TO DETERMINE THE NUMBER OF DWELLING UNITS ASSIGNED TO ANY PARCEL, CONTACT THE CITY PLANNING DEPARTMENT.

ALL LOTS ADJOINING MODESTO AVE., BARSTOW ST., ALAMEDA BLVD. AND WYOMING BLVD. SHALL NOT BE PERMITTED TO HAVE REARYARD ACCESS.

JOB NO. 8030
OFFICE J.L.T.A.
DRAFT J.L.C.R., R.D.
F.B. 116
DATE 5-8-87

ESPEY, HUSTON & ASSOC. INC.
Engineers • Planners • Surveyors
317 COMMERCIAL STREET N.E.
ALBUQUERQUE, NEW MEXICO 87102
(505) 242-1909

PLAT FOR
NOR ESTE ESTATES
BLOCKS I THROUGH II
CITY OF ALBUQUERQUE
BERNALILLO COUNTY, NEW MEXICO
JUNE 1987

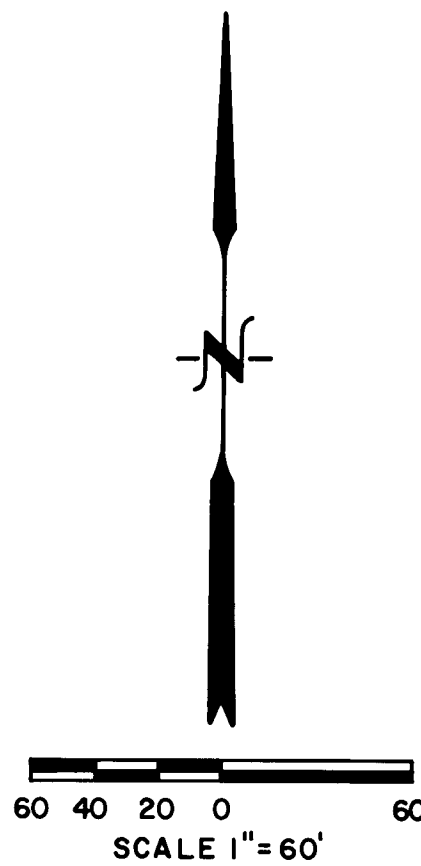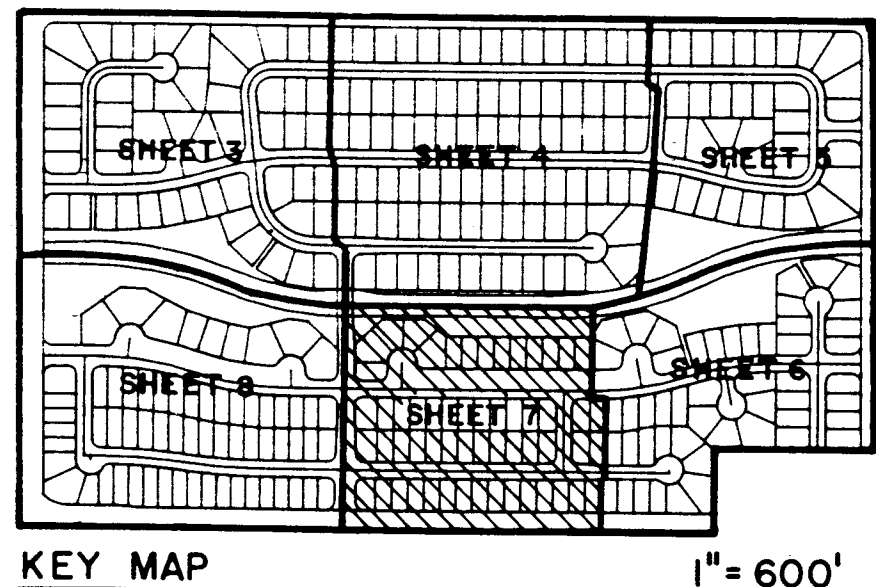

- 1 A.M.A.F.C.A. DRAINAGE R.O.W. DEDICATED BY THIS PLAT. OTHER PUBLIC USES SUBJECT TO LICENSING BY A.M.A.F.C.A.
- 2 10' PUBLIC UTILITY EASEMENT GRANTED BY THIS PLAT.
- 3 15' PUBLIC DRAINAGE EASEMENT GRANTED BY THIS PLAT.
- 4 WALL AND LANDSCAPE EASEMENT GRANTED BY THIS PLAT.
- 5 A.M.A.F.C.A. TEMPORARY DIKE EASEMENT GRANTED BY THIS PLAT.
- 6 15' PUBLIC SANITARY SEWER EASEMENT GRANTED BY THIS PLAT.
- 7 30' FRONT YARD SETBACK LINE (LOTS 1 THROUGH 7, BLOCK 10).
- 8 15' PARK ACCESS, AND PUBLIC DRAINAGE EASEMENT GRANTED BY THIS PLAT.
- 9 5' PARK AND LANDSCAPE EASEMENT.
- 10 15' PARK AND LANDSCAPE EASEMENT.

NOTICE: THE TOTAL NUMBER OF DWELLING UNITS WHICH MAY BE PERMITTED IS REGULATED THROUGH SPECIAL SECTOR PLAN REQUIREMENTS. TO DETERMINE THE NUMBER OF DWELLING UNITS ASSIGNED TO ANY PARCEL, CONTACT THE CITY PLANNING DEPARTMENT.

ALL LOTS ADJOINING MODESTO AVE., BARSTOW ST., ALAMEDA BLVD. AND WYOMING BLVD. SHALL NOT BE PERMITTED TO HAVE REARYARD ACCESS.

JOB NO. 8030
OFFICE J.L.T.A.
DRAFT J.L.C.R., R.D.
F.B. 1/6
DATE 5-8-87
ESPEY, HUSTON & ASSOC., INC.
Engineers • Planners • Surveyors
317 COMMERCIAL STREET N.E.
ALBUQUERQUE, NEW MEXICO 87102
(505) 242-1909



SHEET 7 OF 11

- * LOT AFFECTED BY SIDE YARD SOLAR REQUIREMENT. SEE NOTE 7, SHEET 1.
- LOT AFFECTED BY 20' SIDE YARD SET BACK REQUIREMENT. SEE NOTE 8 SHEET 1.

- NOTES
1. SEE SHEETS 9 AND 10 FOR CURVE AND "T" NUMBER INFORMATION.
 2. SEE SHEET 11 FOR LOT AND OTHER ACREAGE INFORMATION.

SP-06-16-1789

PLAT FOR
NOR ESTE ESTATES
BLOCKS I THROUGH II
CITY OF ALBUQUERQUE
BERNALILLO COUNTY, NEW MEXICO
JUNE 1987

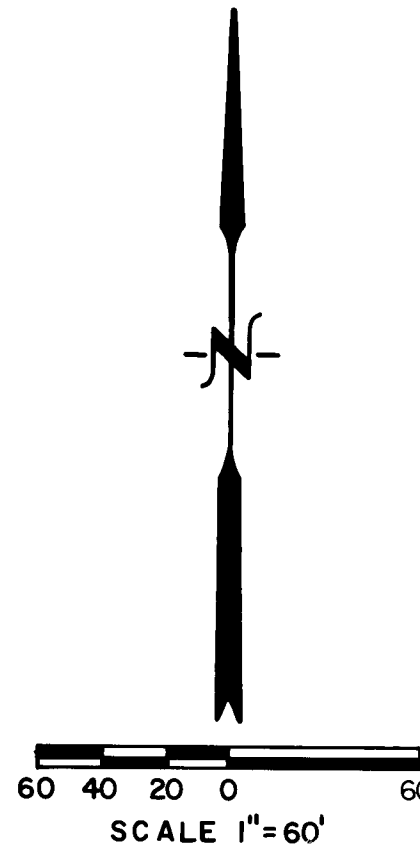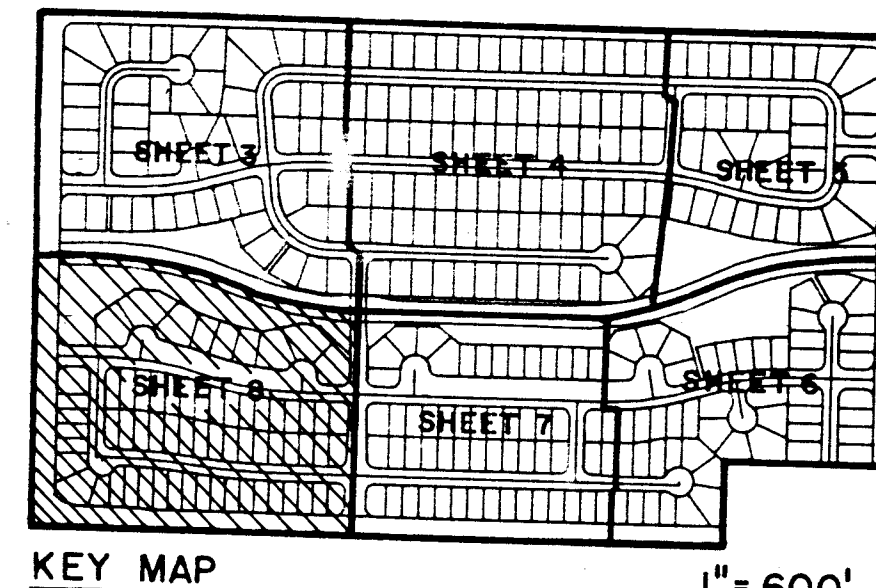

- 1 A.M.A.F.C.A. DRAINAGE R.O.W. DEDICATED BY THIS PLAT. OTHER PUBLIC USES SUBJECT TO LICENSING BY A.M.A.F.C.A.
- 2 10' PUBLIC UTILITY EASEMENT GRANTED BY THIS PLAT.
- 3 15' PUBLIC DRAINAGE EASEMENT GRANTED BY THIS PLAT.
- 4 WALL AND LANDSCAPE EASEMENT GRANTED BY THIS PLAT.
- 5 A.M.A.F.C.A. TEMPORARY DIKE EASEMENT GRANTED BY THIS PLAT.
- 6 15' PUBLIC SANITARY SEWER EASEMENT GRANTED BY THIS PLAT.
- 7 30' FRONT YARD SETBACK LINE (LOTS 1 THROUGH 7, BLOCK 10).
- 8 15' PARK ACCESS, AND PUBLIC DRAINAGE EASEMENT GRANTED BY THIS PLAT.
- 9 5' PARK AND LANDSCAPE EASEMENT.
- 10 15' PARK AND LANDSCAPE EASEMENT.

NOTICE: THE TOTAL NUMBER OF DWELLING UNITS WHICH MAY BE PERMITTED IS REGULATED THROUGH SPECIAL SECTOR PLAN REQUIREMENTS. TO DETERMINE THE NUMBER OF DWELLING UNITS ASSIGNED TO ANY PARCEL, CONTACT THE CITY PLANNING DEPARTMENT.

ALL LOTS ADJOINING MODESTO AVE., BARSTOW ST., ALAMEDA BLVD. AND WYOMING BLVD. SHALL NOT BE PERMITTED TO HAVE REARYARD ACCESS.

JOB NO. 8030
OFFICE J.L.T.A.
DRAFT J.L.C.R., R.D.
F.B. 1/6
DATE 5-8-87
ESPEY, HUSTON & ASSOC., INC.
Engineers • Planners • Surveyors
317 COMMERCIAL STREET N.E.
ALBUQUERQUE, NEW MEXICO 87102
(505) 242-1909

SHEET 8 OF 11

CURVE DATA

CURVE NO.	DELTA	RADIUS	LENGTH	CHORD	TAN	CH-BEARING
1	89°46'11"	30.00	47.00	42.34	29.88	N 44°43'50"W
2	90°0'0"	30.00	47.00	42.34	29.88	S 45°16'10"E
3	46°30'9"	103.68	81.15	81.86	30.12	N 66°21'57"E
4	9°56'11"	308.00	53.41	53.35	26.77	S 84°38'50"E
5	1°23'38"	292.00	8.75	8.75	17.79	N 84°38'50"E
6	2°30'57"	1585.00	69.59	69.59	34.80	N 87°41'2"
7	12°47'35"	1130.50	251.75	251.75	127.79	N 77°10'56"E
8	6°59'11"	1244.67	151.77	151.68	75.98	N 77°10'56"E
9	11°50'13"	875.92	180.82	180.82	49.00	N 70°20'47"E
10	4°10'51"	1162.00	84.79	84.77	42.41	N 80°48'27"E
11	17°20'38"	51.75	51.75	51.75	25.88	N 80°48'27"E
12	10°37'36"	189.00	35.05	35.00	17.58	N 85°04'17"E
13	15°25'51"	171.00	46.05	45.91	23.17	N 81°53'59"E
14	15°25'51"	171.00	46.05	45.91	23.17	N 81°53'59"E
15	7°53'37"	1062.00	365.77	363.97	184.72	N 80°31'4"
16	12°50'31"	1046.10	200.04	199.62	100.44	N 69°10'42"E
17	14°33'18"	1072.50	272.45	271.72	136.96	N 82°52'37"E
18	14°33'18"	1072.50	272.45	271.72	136.96	N 82°52'37"E
19	7°53'36"	1062.00	365.77	363.97	184.72	N 80°31'4"
20	12°50'31"	1046.10	200.04	199.62	100.44	N 69°10'42"E
21	14°33'18"	1072.50	272.45	271.72	136.96	N 82°52'37"E
22	14°33'18"	1072.50	272.45	271.72	136.96	N 82°52'37"E
23	7°53'36"	1062.00	365.77	363.97	184.72	N 80°31'4"
24	12°50'31"	1046.10	200.04	199.62	100.44	N 69°10'42"E
25	14°33'18"	1072.50	272.45	271.72	136.96	N 82°52'37"E
26	14°33'18"	1072.50	272.45	271.72	136.96	N 82°52'37"E
27	7°53'36"	1062.00	365.77	363.97	184.72	N 80°31'4"
28	12°50'31"	1046.10	200.04	199.62	100.44	N 69°10'42"E
29	14°33'18"	1072.50	272.45	271.72	136.96	N 82°52'37"E
30	14°33'18"	1072.50	272.45	271.72	136.96	N 82°52'37"E
31	7°53'36"	1062.00	365.77	363.97	184.72	N 80°31'4"
122	14°33'18"	1072.50	272.45	271.72	136.96	N 82°52'37"E
123	7°53'36"	1062.00	365.77	363.97	184.72	N 80°31'4"
124	12°50'31"	1046.10	200.04	199.62	100.44	N 69°10'42"E
125	14°33'18"	1072.50	272.45	271.72	136.96	N 82°52'37"E

CURVE DATA CONTINUED SHEET 10

ADDITIONAL COURSES

DEVI NO.	DELTA	RADIUS	LENGTH	CHORD	TAN	CH-BEARING
251	3° 4' 45"	871.50	46.83	46.83	23.42	S 84° 43' 16"E
252	3° 5' 52"	871.50	47.12	47.11	23.57	S 84° 43' 16"E
253	3° 5' 52"	871.50	47.12	47.11	23.57	S 84° 43' 16"E
254	3° 5' 55"	871.50	47.35	47.35	23.78	S 84° 31' 13"E
255	1° 43' 52"	871.50	26.33	26.33	13.17	S 72° 55' 36"E
256	2° 59' 16"	925.00	48.24	48.23	24.12	S 74° 56' 34"E
257	2° 55' 28"	925.00	47.21	47.21	23.83	S 77° 54' 45"E
258	2° 55' 28"	925.00	46.91	46.90	23.46	S 83° 45' 36"E
259	2° 55' 28"	925.00	46.91	46.90	23.46	S 83° 45' 36"E
260	2° 55' 39"	925.00	24.26	24.26	12.13	S 88° 51' 50"E
261	2° 55' 39"	925.00	24.26	24.26	12.13	S 88° 51' 50"E
262	88° 52' 27"	25.00	40.12	39.44	20.14	S 40° 20' 21"E
263	88° 52' 27"	25.00	39.44	34.76	24.18	S 40° 20' 21"E
264	1° 30' 23"	1775.00	46.67	46.66	23.28	N 89° 32' 31"E
265	1° 30' 23"	1775.00	46.70	46.70	23.35	N 89° 12' 30"E
266	1° 30' 23"	1775.00	46.70	46.70	23.35	N 89° 12' 30"E
267	1° 30' 23"	1775.00	46.70	46.70	23.35	N 89° 12' 30"E
268	1° 30' 23"	1775.00	46.70	46.70	23.35	N 89° 12' 30"E
269	1° 30' 23"	1775.00	46.70	46.70	23.35	N 89° 12' 30"E
270	1° 30' 23"	1775.00	46.70	46.70	23.35	N 89° 12' 30"E
271	0° 0' 0"	1775.00	46.70	46.70	23.35	N 89° 12' 30"E
272	0° 8' 26"	1775.00	4.35	4.35	2.18	N 81° 50' 40"E
273	1° 28' 00"	1825.00	46.90	46.90	23.45	N 83° 51' 51"E
274	1° 28' 00"	1825.00	46.90	46.90	23.45	N 83° 51' 51"E
275	1° 28' 00"	1825.00	46.90	46.90	23.45	N 83° 51' 51"E
276	1° 28' 00"	1825.00	46.90	46.90	23.45	N 83° 51' 51"E
277	0° 0' 0"	1825.00	46.90	46.90	23.45	N 83° 51' 51"E
278	0° 0' 0"	1825.00	46.90	46.90	23.45	N 83° 51' 51"E
399	0° 0					

BLOCK 1		
LOT 1	=	0.1761 ACRES
LOT 2	=	0.1845 ACRES
LOT 3	=	0.1854 ACRES
LOT 4	=	0.2282 ACRES
LOT 5	=	0.3470 ACRES
LOT 6	=	0.2009 ACRES
LOT 7	=	0.1672 ACRES
LOT 8	=	0.1846 ACRES
LOT 9	=	0.2801 ACRES
LOT 10	=	0.2478 ACRES
LOT 11	=	0.1538 ACRES
LOT 12	=	0.1664 ACRES
LOT 13	=	0.2186 ACRES
LOT 14	=	0.1943 ACRES
LOT 15	=	0.1904 ACRES
LOT 16	=	0.1944 ACRES
LOT 17	=	0.2805 ACRES
LOT 18	=	0.2042 ACRES
LOT 19	=	0.2418 ACRES
LOT 20	=	0.2446 ACRES
LOT 21	=	0.2050 ACRES
LOT 22	=	0.2883 ACRES
LOT 23	=	0.3311 ACRES
LOT 24	=	0.2143 ACRES
LOT 25	=	0.1692 ACRES
LOT 26	=	0.1692 ACRES
LOT 27	=	0.1692 ACRES
LOT 28	=	0.1692 ACRES
LOT 29	=	0.1692 ACRES
LOT 30	=	0.1692 ACRES
LOT 31	=	0.1692 ACRES
LOT 32	=	0.1692 ACRES
LOT 33	=	0.1692 ACRES
LOT 34	=	0.1641 ACRES
LOT 35	=	0.1641 ACRES
LOT 36	=	0.1641 ACRES
LOT 37	=	0.1641 ACRES
LOT 38	=	0.1641 ACRES
LOT 39	=	0.1641 ACRES
LOT 40	=	0.1641 ACRES
LOT 41	=	0.1641 ACRES
LOT 42	=	0.1641 ACRES
LOT 43	=	0.1641 ACRES
LOT 44	=	0.1641 ACRES
LOT 45	=	0.1641 ACRES
LOT 46	=	0.1641 ACRES
LOT 47	=	0.1641 ACRES
LOT 48	=	0.1641 ACRES
LOT 49	=	0.1641 ACRES
LOT 50	=	0.1641 ACRES
LOT 51	=	0.1781 ACRES
LOT 52	=	0.2101 ACRES
LOT 53	=	0.3480 ACRES
LOT 54	=	0.2261 ACRES
LOT 55	=	0.1708 ACRES
TOTAL	=	10.8622 ACRES

BLOCK 2		
LOT 1	=	0.2056 ACRES
LOT 2	=	0.1692 ACRES
LOT 3	=	0.1692 ACRES
LOT 4	=	0.1692 ACRES
LOT 5	=	0.1692 ACRES
LOT 6	=	0.1692 ACRES
LOT 7	=	0.1692 ACRES
LOT 8	=	0.1768 ACRES
LOT 9	=	0.1635 ACRES
LOT 10	=	0.1635 ACRES
LOT 11	=	0.2333 ACRES
LOT 12	=	0.1818 ACRES
LOT 13	=	0.2487 ACRES
LOT 14	=	0.1946 ACRES
TOTAL	=	2.5910 ACRES

BLOCK 4		
LOT 1	=	0.1745 ACRES
LOT 2	=	0.1634 ACRES
LOT 3	=	0.1701 ACRES
LOT 4	=	0.1701 ACRES
LOT 5	=	0.1701 ACRES
LOT 6	=	0.1701 ACRES
LOT 7	=	0.1701 ACRES
LOT 8	=	0.1641 ACRES
LOT 9	=	0.1701 ACRES
LOT 10	=	0.1641 ACRES
LOT 11	=	0.1651 ACRES
LOT 12	=	0.1819 ACRES
LOT 13	=	0.1588 ACRES
LOT 14	=	0.2974 ACRES
LOT 15	=	0.1917 ACRES
LOT 16	=	0.1641 ACRES
LOT 17	=	0.1701 ACRES
LOT 18	=	0.1701 ACRES
LOT 19	=	0.1701 ACRES
LOT 20	=	0.1701 ACRES
LOT 21	=	0.1701 ACRES
LOT 22	=	0.1701 ACRES
LOT 23	=	0.1701 ACRES
LOT 24	=	0.1701 ACRES
LOT 25	=	0.1685 ACRES
LOT 26	=	0.1651 ACRES
LOT 27	=	0.1641 ACRES
LOT 28	=	0.1641 ACRES
LOT 29	=	0.1641 ACRES
LOT 30	=	0.2473 ACRES
LOT 31	=	0.1641 ACRES
LOT 32	=	0.1641 ACRES
LOT 33	=	0.1641 ACRES
LOT 34	=	0.1641 ACRES
LOT 35	=	0.1641 ACRES
LOT 36	=	0.1641 ACRES
LOT 37	=	0.1641 ACRES
LOT 38	=	0.1641 ACRES
LOT 39	=	0.1641 ACRES
LOT 40	=	0.1641 ACRES
LOT 41	=	0.1641 ACRES
LOT 42	=	0.1641 ACRES
LOT 43	=	0.1641 ACRES
LOT 44	=	0.1641 ACRES
LOT 45	=	0.1641 ACRES
LOT 46	=	0.1663 ACRES
LOT 47	=	0.1677 ACRES
LOT 48	=	0.1750 ACRES
LOT 49	=	0.1734 ACRES
LOT 50	=	0.1641 ACRES
LOT 51	=	0.1690 ACRES
LOT 52	=	0.1641 ACRES
LOT 53	=	0.1860 ACRES
LOT 54	=	0.2160 ACRES
LOT 55	=	0.2709 ACRES
LOT 56	=	0.2902 ACRES
LOT 57	=	0.1974 ACRES
TOTAL	=	10.2792 ACRES

BLOCK 5		
LOT 1	=	0.1947 ACRES
LOT 2	=	0.1641 ACRES
LOT 3	=	0.1603 ACRES
LOT 4	=	0.1668 ACRES
LOT 5	=	0.1668 ACRES
LOT 6	=	0.1664 ACRES
LOT 7	=	0.1656 ACRES
LOT 8	=	0.1623 ACRES
LOT 9	=	0.2102 ACRES
LOT 10	=	0.1981 ACRES
LOT 11	=	0.2023 ACRES
LOT 12	=	0.1935 ACRES
LOT 13	=	0.1894 ACRES
LOT 14	=	0.1924 ACRES
TOTAL	=	2.5231 ACRES

BLOCK 6		
LOT 1	=	0.1247 ACRES
LOT 2	=	0.1826 ACRES
LOT 3	=	0.1575 ACRES
LOT 4	=	0.1678 ACRES
LOT 5	=	0.2011 ACRES
LOT 6	=	0.1148 ACRES
LOT 7	=	0.1148 ACRES
LOT 8	=	0.1148 ACRES
LOT 9	=	0.1148 ACRES
LOT 10	=	0.1148 ACRES
LOT 11	=	0.1148 ACRES
LOT 12	=	0.1148 ACRES
LOT 13	=	0.1148 ACRES
LOT 14	=	0.1148 ACRES
LOT 15	=	0.1148 ACRES
LOT 16	=	0.1869 ACRES
LOT 17	=	0.1741 ACRES
LOT 18	=	0.1667 ACRES
LOT 19	=	0.1621 ACRES
LOT 20	=	0.1257 ACRES
LOT 21	=	0.1231 ACRES
LOT 22	=	0.1231 ACRES
LOT 23	=	0.1231 ACRES
LOT 24	=	0.1231 ACRES
LOT 25	=	0.1396 ACRES
LOT 26	=	0.1376 ACRES
LOT 27	=	0.1319 ACRES
LOT 28	=	0.1742 ACRES
LOT 29	=	0.1973 ACRES
LOT 30	=	0.1957 ACRES
LOT 31	=	0.1272 ACRES
LOT 32	=	0.1396 ACRES
LOT 33	=	0.1323 ACRES
TOTAL	=	4.7720 ACRES

BLOCK 7		
LOT 1	=	0.1552 ACRES
LOT 2	=	0.1148 ACRES
LOT 3	=	0.1148 ACRES
LOT 4	=	0.1148 ACRES
LOT 5	=	0.1148 ACRES
LOT 6	=	0.1148 ACRES
LOT 7	=	0.1148 ACRES
LOT 8	=	0.1148 ACRES
LOT 9	=	0.1148 ACRES
LOT 10	=	0.1148 ACRES
LOT 11	=	0.1148 ACRES
LOT 12	=	0.1232 ACRES
LOT 13	=	0.1232 ACRES
LOT 14	=	0.1148 ACRES
LOT 15	=	0.1148 ACRES
LOT 16	=	0.1148 ACRES
LOT 17	=	0.1148 ACRES
LOT 18	=	0.1148 ACRES
LOT 19	=	0.1148 ACRES
LOT 20	=	0.1148 ACRES
LOT 21	=	0.1148 ACRES
LOT 22	=	0.1148 ACRES
LOT 23	=	0.1148 ACRES
LOT 24	=	0.1481 ACRES
TOTAL	=	2.8457 ACRES

BLOCK 8		
LOT 1	=	0.1302 ACRES
LOT 2	=	0.1148 ACRES
LOT 3	=	0.1148 ACRES
LOT 4	=	0.1148 ACRES
LOT 5	=	0.1148 ACRES
LOT 6	=	0.1148 ACRES
LOT 7	=	0.1148 ACRES
LOT 8	=	0.1148 ACRES
LOT 9	=	0.1148 ACRES
LOT 10	=	0.1148 ACRES
LOT 11	=	0.1148 ACRES
LOT 12	=	0.1148 ACRES
LOT 13	=	0.1148 ACRES
LOT 14	=	0.1148 ACRES
LOT 15	=	0.1171 ACRES
LOT 16	=	0.1193 ACRES
LOT 17	=	0.1194 ACRES
LOT 18	=	0.1194 ACRES
LOT 19	=	0.1148 ACRES
LOT 20	=	0.1426 ACRES
LOT 21	=	0.2508 ACRES
LOT 22	=	0.1597 ACRES
LOT 23	=	0.1731 ACRES
LOT 24	=	0.1120 ACRES
LOT 25	=	0.1359 ACRES
LOT 26	=	0.1148 ACRES
LOT 27	=	0.1194 ACRES
LOT 28	=	0.1148 ACRES
LOT 29	=	0.1237 ACRES
LOT 30	=	0.1232 ACRES
LOT 31	=	0.1151 ACRES
LOT 32	=	0.1179 ACRES
LOT 33	=	0.1180 ACRES
LOT 34	=	0.1156 ACRES
LOT 35	=	0.1156 ACRES
LOT 36	=	0.1379 ACRES
LOT 37	=	0.1785 ACRES
LOT 38	=	0.1785 ACRES
LOT 39	=	0.1785 ACRES
LOT 40	=	0.2508 ACRES
LOT 41	=	0.1707 ACRES
LOT 42	=	0.1185 ACRES
LOT 43	=	0.1415 ACRES
LOT 44	=	0.1724 ACRES
LOT 45	=	0.1326 ACRES
LOT 46	=	0.1659 ACRES
LOT 47	=	0.1381 ACRES
LOT 48	=	0.1360 ACRES
LOT 49	=	0.1360 ACRES
LOT 50	=	0.1402 ACRES
TOTAL	=	6.7772 ACRES

BLOCK 9		
LOT 1	=	0.2843 ACRES
LOT 2	=	0.3460 ACRES
LOT 3	=	0.2767 ACRES
LOT 4	=	0.1707 ACRES
LOT 5	=	0.1774 ACRES
LOT 6	=	0.1774 ACRES
LOT 7	=	0.2724 ACRES
LOT 8	=	0.2814 ACRES
LOT 9	=	0.2582 ACRES
TOTAL	=	2.2485 ACRES

BLOCK 10		
LOT 1	=	0.1277 ACRES
LOT 2	=	0.1350 ACRES
LOT 3	=	0.1347 ACRES
LOT 4	=	0.1344 ACRES
LOT 5	=	0.1313 ACRES
LOT 6	=	0.1276 ACRES
LOT 7	=	0.1231 ACRES
LOT 8	=	0.1231 ACRES
LOT 9	=	0.1143 ACRES
LOT 10	=	0.1107 ACRES
LOT 11	=	0.1097 ACRES
LOT 12	=	0.1086 ACRES
LOT 13	=	0.1072 ACRES
LOT 14	=	0.1033 ACRES
LOT 15	=	0.1033 ACRES
LOT 16	=	0.1325 ACRES
LOT 17	=	0.1254 ACRES
LOT 18	=	0.1033 ACRES
LOT 19	=	0.1033 ACRES
LOT 20	=	0.1071 ACRES
LOT 21	=	0.1071 ACRES
LOT 22	=	0.1095 ACRES
LOT 23	=	0.1136 ACRES
LOT 24	=	0.1161 ACRES
LOT 25	=	0.1185 ACRES
LOT 26	=	0.1238 ACRES
LOT 27	=	0.1271 ACRES
LOT 28	=	0.1288 ACRES
LOT 29	=	0.1297 ACRES
LOT 30	=	0.1320 ACRES
LOT 31	=	0.1329 ACRES
LOT 32	=	0.1153 ACRES
TOTAL	=	3.9434 ACRES

BLOCK 11		
LOT 1	=	0.1900 ACRES
LOT 2	=	0.1043 ACRES
LOT 3	=	0.1041 ACRES
LOT 4	=	0.1039 ACRES
LOT 5	=	0.1038 ACRES
LOT 6	=	0.1588 ACRES
LOT 7	=	0.2440 ACRES
LOT 8	=	0.1157 ACRES
LOT 9	=	0.1238 ACRES
LOT 10	=	0.1313 ACRES
LOT 11	=	0.1336 ACRES
LOT 12	=	0.1314 ACRES
LOT 13	=	0.1267 ACRES
LOT 14	=	0.1209 ACRES
LOT 15	=	0.1151 ACRES
LOT 16	=	0.1104 ACRES
LOT 17	=	0.1070 ACRES
LOT 18	=	0.1047 ACRES
LOT 19	=	0.1036 ACRES
LOT 20	=	0.1032 ACRES
LOT 21	=	0.1033 ACRES
LOT 22	=	0.1033 ACRES
LOT 23	=	0.1033 ACRES
LOT 24	=	0.1187 ACRES
TOTAL	=	2.9649 ACRES

TOTAL PUBLIC STREET RIGHT-OF-WAY
DEDICATED BY THIS PLAT

26.0378 ACRES

PUBLIC PARK AREA
DEDICATED BY THIS PLAT

6.9043 ACRES

PUBLIC PARK EASEMENT AREA

1.1836 ACRES

TOTAL PUBLIC PARK AREA

8.0879 ACRES

TOTAL A.M.A.F.C.A. DRAINAGE
RIGHT-OF-WAY DEDICATED
BY THIS PLAT

4.2069 ACRES

TOTAL SUBDIVISION ACREAGE

TEMPORARY EROSION CONTROL NOTES

1. EROSION CONTROL BERMS TO BE CONSTRUCTED IN ACCORDANCE WITH THE DETAIL SHOWN ON SHT. 12 OF 77 AND IN THE LOCATIONS AS SHOWN ON THE GRADING PLAN.
2. BERMS WILL CONTROL MINOR FLOWS AND PROHIBIT SEDIMENT FROM ENTERING THE LA CUEVA CHANNEL, ADJACENT STREETS, OR FROM LEAVING THE SITE DURING ANY CONSTRUCTION ACTIVITY.
3. THE CONTRACTOR SHALL OBTAIN A TOPSOIL DISTURBANCE PERMIT FROM THE ENVIRONMENTAL HEALTH DIVISION PRIOR TO PERFORMING ANY EARTHWORK OPERATIONS.
4. THE CONTRACTOR SHALL OBTAIN A SEPARATE PERMIT FROM CODE ADMINISTRATION FOR ALL RETAINING WALL CONSTRUCTION.
5. EARTHWORK SHALL BE PERFORMED IN ACCORDANCE WITH THE GEOTECHNICAL ENGINEERING EVALUATION - NOR ESTE SUBDIVISION, ALBUQUERQUE, NEW MEXICO (JOB NO. 986-1087 - DATED MARCH 2, 1987 AND SUPPLEMENT #1 - NOR ESTE SUBDIVISION, ALBUQUERQUE, NEW MEXICO (DATED MAY 5, 1987) PREPARED BY WESTERN TECHNOLOGIES, INC.

APPROVED FOR ROUGH GRADING:
Roger J. Green 7-10-87
ROGER GREEN, P.E.
C.O.A. HYDROLOGY

REVISIONS

1. Revised grades at Modesto south R.O.W. line to allow adjacent lots to drain to subdivision and show limits of 3:1 slope.
2. Revised grades at Wyoming to show limits of 3:1 slope.
3. Revised grades in rear yards of lots adjacent to park.
4. Revised width of private drainage easements.
5. Revised grades and finished floor elevations on Ellis Court.
6. Revised grades and finished floor elevations and added retaining wall.
7. Revised rear yard grades along Wyoming and Alameda.
8. Added sidewalk culvert.

LEGEND

- SPOT ELEVATIONS
- TOP OF CURB ELEVATION
- FLOWLINE ELEVATION
- DRAINAGE SWALE
- RETAINING WALLS
- PAD ELEVATION
- PROPOSED CURB & GUTTER
- CENTERLINE OF STREET
- RIGHT-OF-WAY LINE
- PAD
- PROPERTY LINE
- TEMPORARY EROSION CONTROL BERM

ESPEY,
HUSTON,
ASSOCIATES, INC.
Engineering & Environmental Consultants
317 COMMERCIAL ST. N.E.
ALBUQUERQUE, NEW MEXICO 87102
PHONE: (505) 242-1909


CITY OF ALBUQUERQUE
PUBLIC WORKS DEPARTMENT
ENGINEERING DIVISION

TITLE: NOR ESTE ESTATES
GRADING PLAN

APPROVALS	ENGINEER	DATE	APPROVALS	ENGINEER	DATE
City Engineer	<i>[Signature]</i>	10/5/87	Liquid Waste	<i>[Signature]</i>	8/31/87
A.C.E. - Design	<i>[Signature]</i>	9-1-87	Traffic	<i>[Signature]</i>	9/24/87
A.C.E. - Hydrology	<i>[Signature]</i>	9-1-87	Water	<i>[Signature]</i>	9/31/87

DRAWING NO. 3186 MAP NO. C-19 SHEET 8 OF 77

SCALE: 1" = 50'

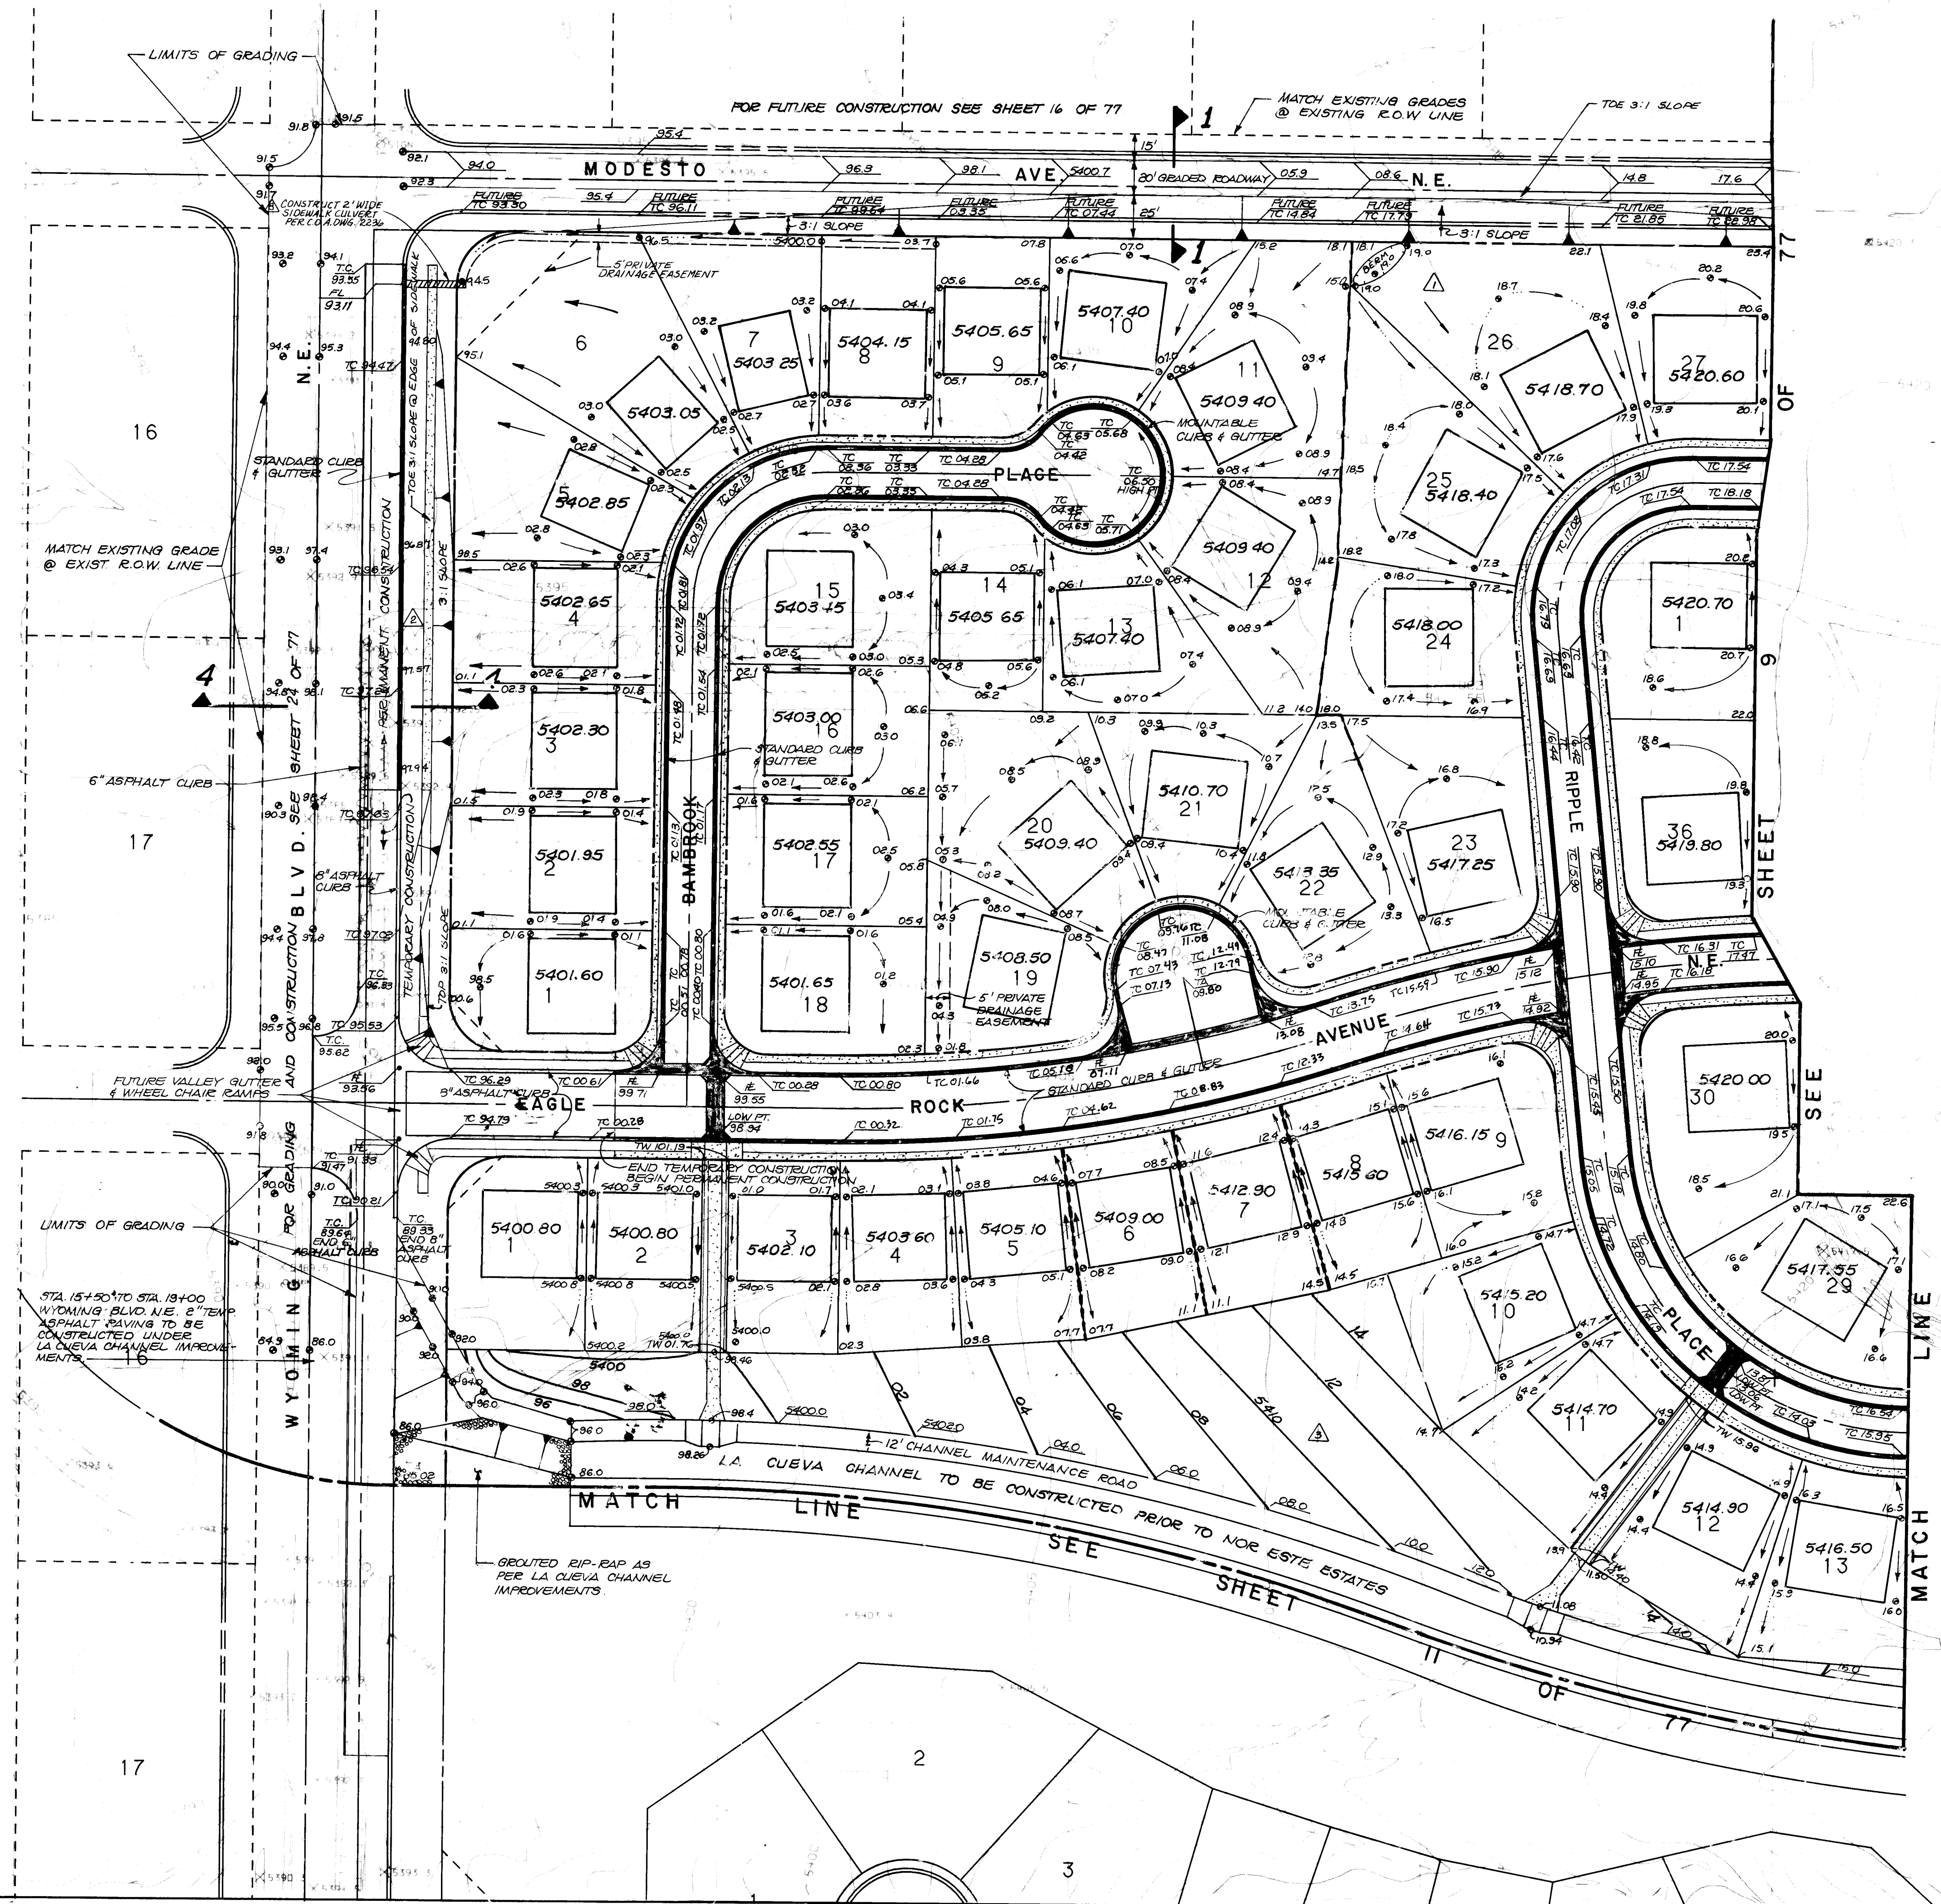


AS BUILT INFORMATION

ENGINEER'S SEAL

REVISIONS

NO.	DATE	BY	REMARKS
1	6-12-87	DL	REMOVED REAR LOT CURBS
2	6-29-87	DL	ADD EASEMENT & CULVERT
3	6-29-87	DL	TIME LOT GRADING REVISIONS FOR 2.10"

DESIGNED BY: J.T.G. DATE: 6/12/87
DRAWN BY: RD DATE: 6/12/87
CHECKED BY: DL DATE: 6/14/87

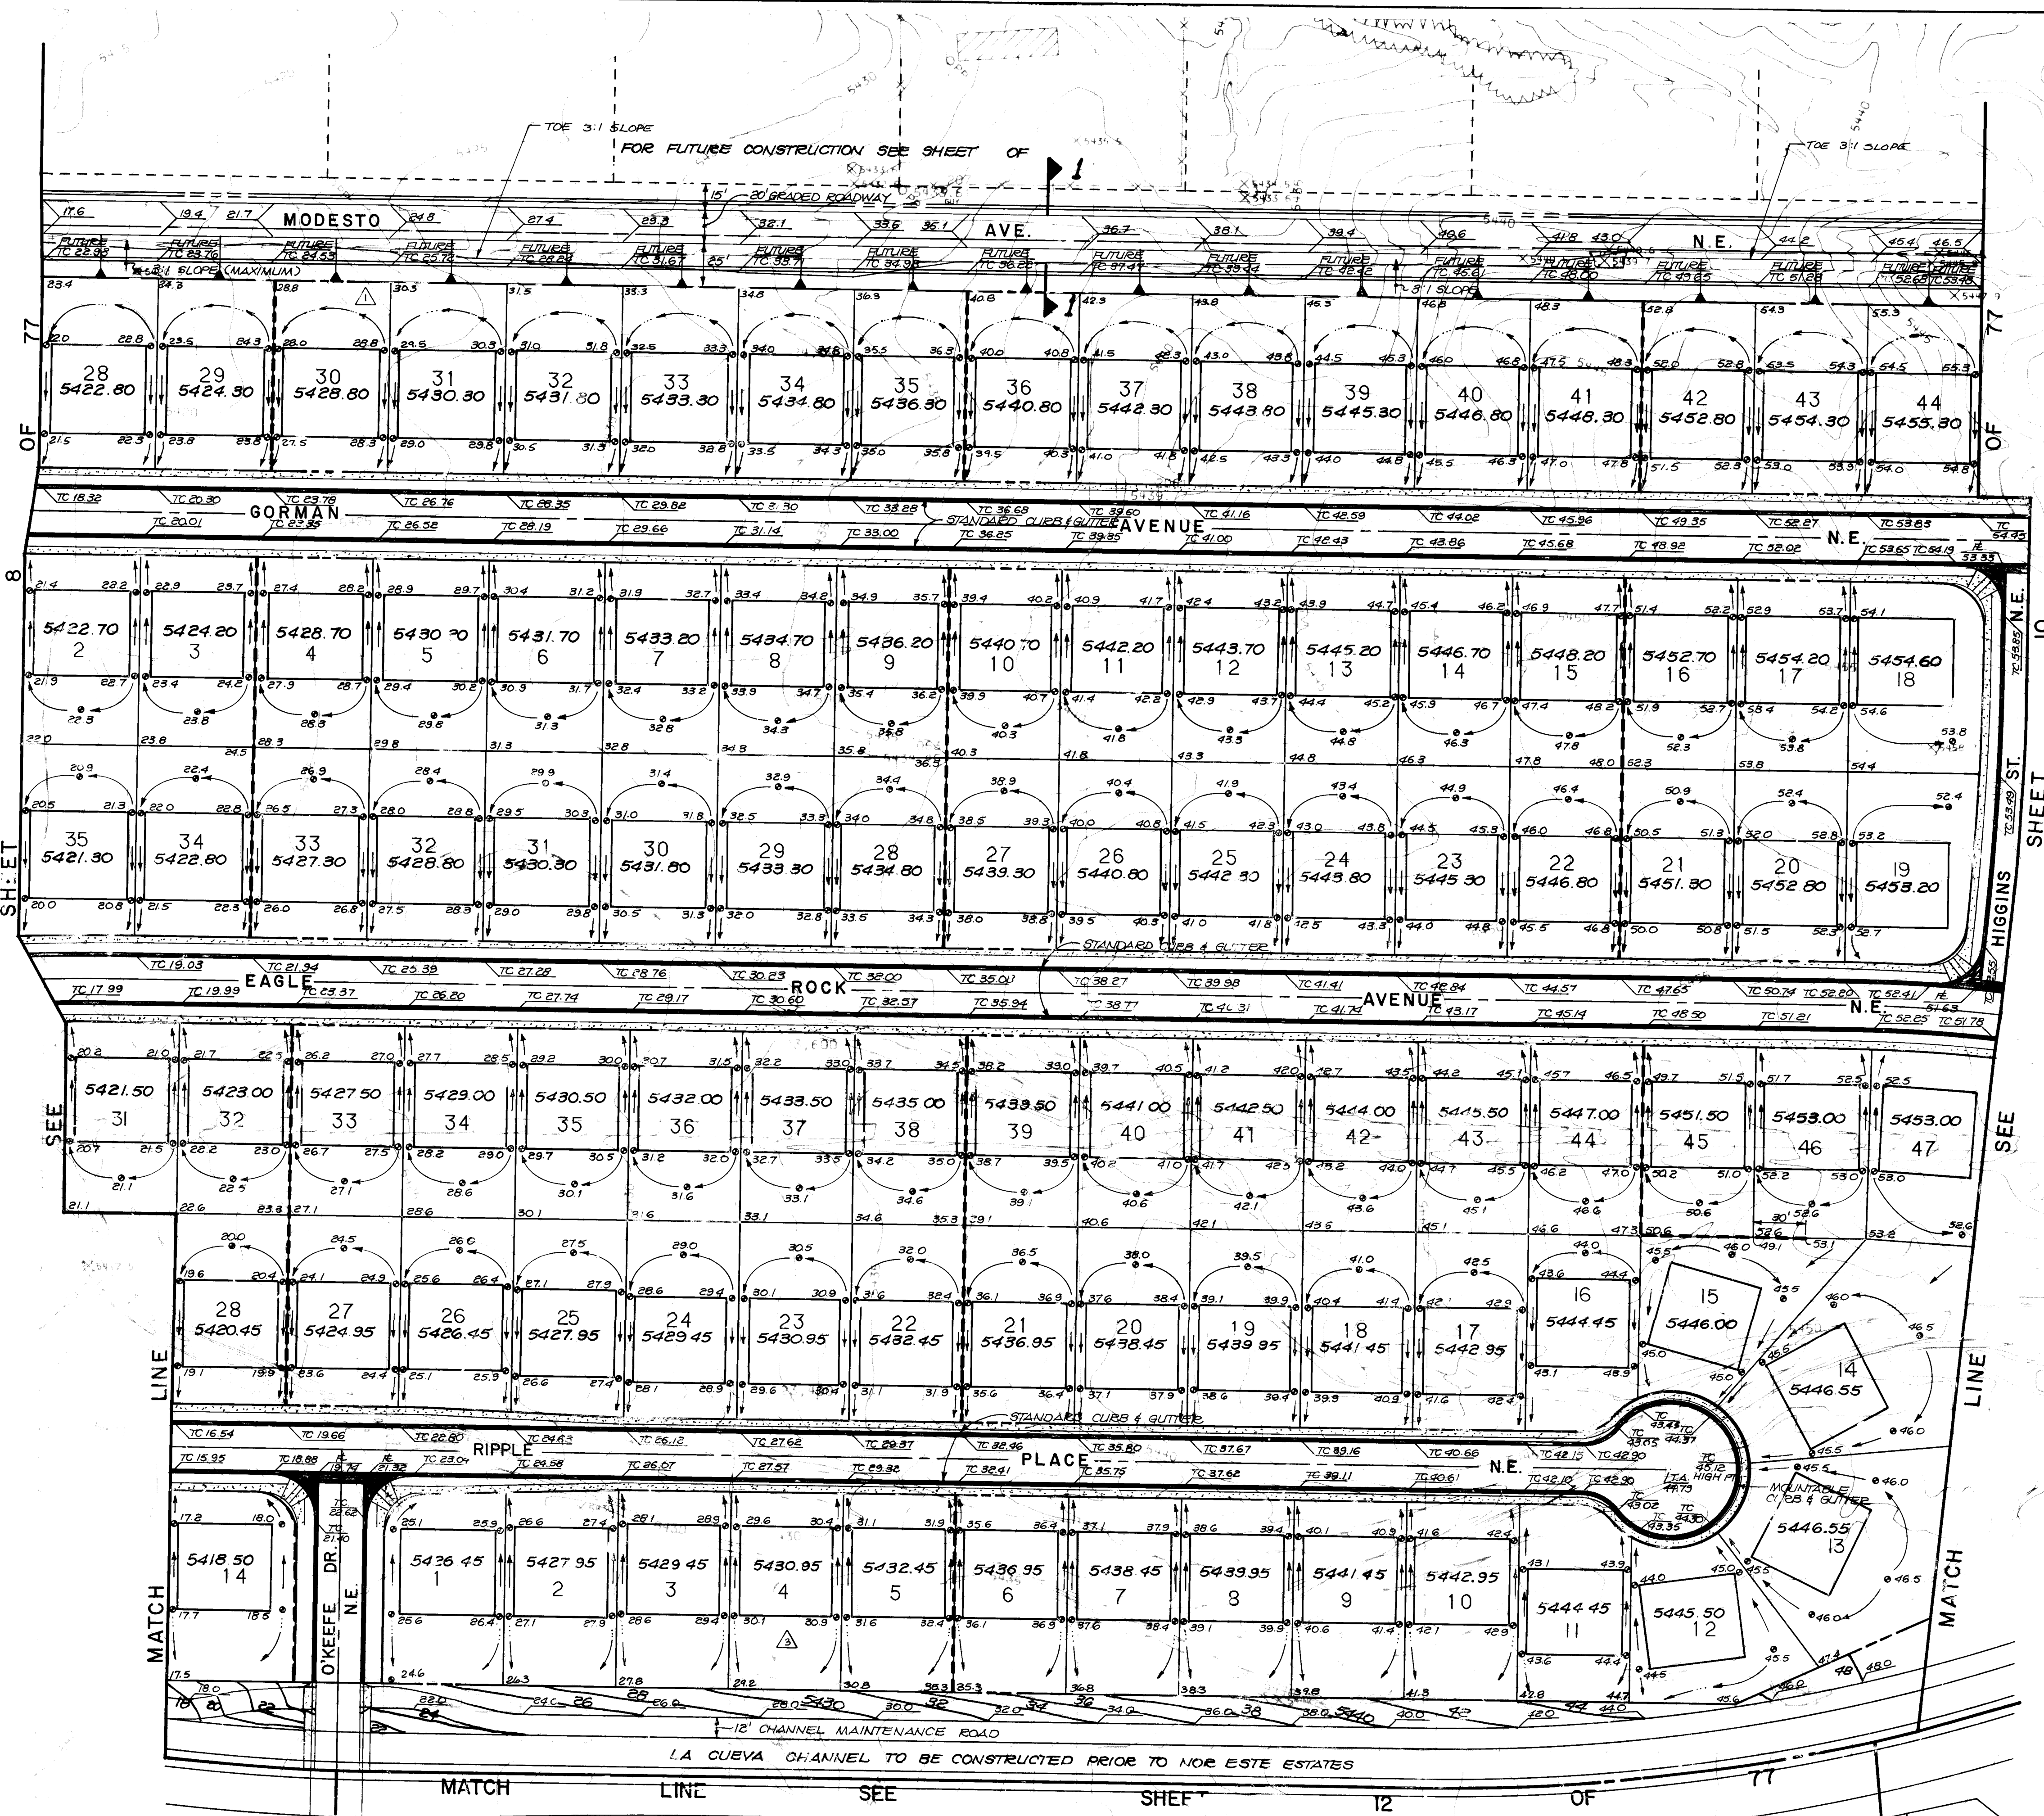

SCALE: 1"=50'

TEMPORARY EROSION CONTROL NOTES

- 1. EROSION CONTROL BERM TO BE CONSTRUCTED IN ACCORDANCE WITH THE DETAIL SHOWN ON SHEET 77 & IN THE LOCATIONS AS SHOWN ON THE GRADING PLAN.
- 2. BERMS WILL CONTROL MINOR FLOWS AND PROHIBIT SEDIMENT FROM ENTERING THE LA CUEVA CHANNEL, ADJACENT STREETS, OR FROM LEAVING THE SITE DURING ANY CONSTRUCTION ACTIVITY.
- 3. THE CONTRACTOR SHALL OBTAIN A TOPSOIL DISTURBANCE PERMIT FROM THE ENVIRONMENTAL HEALTH DIVISION PRIOR TO PERFORMING ANY EARTHWORK OPERATIONS.
- 4. THE CONTRACTOR SHALL OBTAIN A SEPARATE PERMIT FROM CODE ADMINISTRATION FOR ALL RETAINING WALL CONSTRUCTION.
- 5. EARTHWORK SHALL BE PERFORMED IN ACCORDANCE WITH THE GEOTECHNICAL ENGINEERING EVALUATION - NOR ESTE SUBDIVISION, ALBUQUERQUE, NEW MEXICO (JOB NO. 3226J087 - DATED MARCH 8, 1987) AND SUPPLEMENT #1 - NOR ESTE SUBDIVISION, ALBUQUERQUE, NEW MEXICO (DATED MAY 5, 1987) PREPARED BY WESTERN TECHNOLOGIES, INC.

APPROVED FOR ROUGH GRADING:
Roger J. Geary 7-10-87
ROGER GEARY, P.E.
C.O.A. HYDROLOGY

REVISIONS

- 1. Revised grades of Modesto south R.O.W. line to allow adjacent lots to drain to subdivision and show limits of 3:1 slope.
- 2. Revised grades at Wyoming to show limits of 3:1 slope.
- 3. Revised grades in rear yards of lots adjacent to park.
- 4. Revised width of private drainage easements.
- 5. Revised grades and finished floor elevations on Ellis Court.
- 6. Revised grades and finished floor elevations and added retaining wall.

LEGEND

- 13.7 SPOT ELEVATIONS
- TC TOP OF CURB ELEVATION
- FE FLOWLINE ELEVATION
- DRAINAGE SWALE
- RETAINING WALLS
- PAD ELEVATION
- PROPOSED CURB & GUTTER
- CENTERLINE OF STREET
- RIGHT-OF-WAY LINE
- PAD
- PROPERTY LINE
- 9.8 BOTTOM OF POND ELEVATION

ESPEY, HUSTON & ASSOCIATES, INC.
Engineering & Environmental Consultants
317 COMMERCIAL ST. N.E.
ALBUQUERQUE, NEW MEXICO 87102
PHONE: (505) 242-1909

CITY OF ALBUQUERQUE
PUBLIC WORKS DEPARTMENT
ENGINEERING DIVISION

TITLE: NOR ESTE ESTATES
GRADING PLAN

APPROVALS	ENGINEER	DATE	APPROVALS	ENGINEER	DATE
City Engineer	<i>[Signature]</i>	10/5/87	Liquid Waste	<i>[Signature]</i>	8/21/87
A.C.E. Design	<i>[Signature]</i>	9-1-87	Traffic	<i>[Signature]</i>	7/21/87
A.C.E. Hydrology	<i>[Signature]</i>	9-1-87	Water	<i>[Signature]</i>	8/21/87

DRAWING NO. 3186 MAP NO. C-19 SHEET 9 OF 77

AS BUILT INFORMATION	
CONTRACTOR	DATE
WORK ORDER NO.	DATE
INSPECTED BY	DATE
FIELD NO.	DATE
FIELD LOCATION BY	DATE
DRAWINGS CORRECTED BY	DATE
STATION MARK IS A STANDARD ACS BRASS TABLET	RECORDED BY
STAMPED "1" "B20" SET IN TOP OF A CONCRETE POST PROJECTING 0.1 FEET ABOVE GROUND	NO.
WSD ELEVATION: 5474.55	

BENCH MARKS	
THE STATION IS LOCATED 9 MILES NORTHEAST OF DOWNTOWN ALBUQUERQUE TO REACH THE STATION FROM THE INTERSECTION OF LOUISIANA BLVD. AND LOS ANGELES DRIVE, GO EAST ON LOS ANGELES DRIVE 10 MILES TO BARSTOW ST., THEN NORTH ON BARSTOW ST. 1.0 MILES TO ALAMEDA AVE. THE STATION IS LOCATED IN THE NORTHEAST QUADRANT OF THE INTERSECTION. THE STATION MARK IS A STANDARD ACS BRASS TABLET	


SURVEY INFORMATION	
FIELD NOTES	DATE
BY	
NO.	

ENGINEER'S SEAL	
<i>[Seal]</i>	

REVISIONS	
NO.	DATE
1	6-12-87
2	6-12-87
3	6-12-87

REMARKS	
NO.	DATE
1	6-12-87
2	6-12-87
3	6-12-87

DESIGN	
DESIGNED BY	DATE
DRAWN BY	DATE
CHECKED BY	DATE

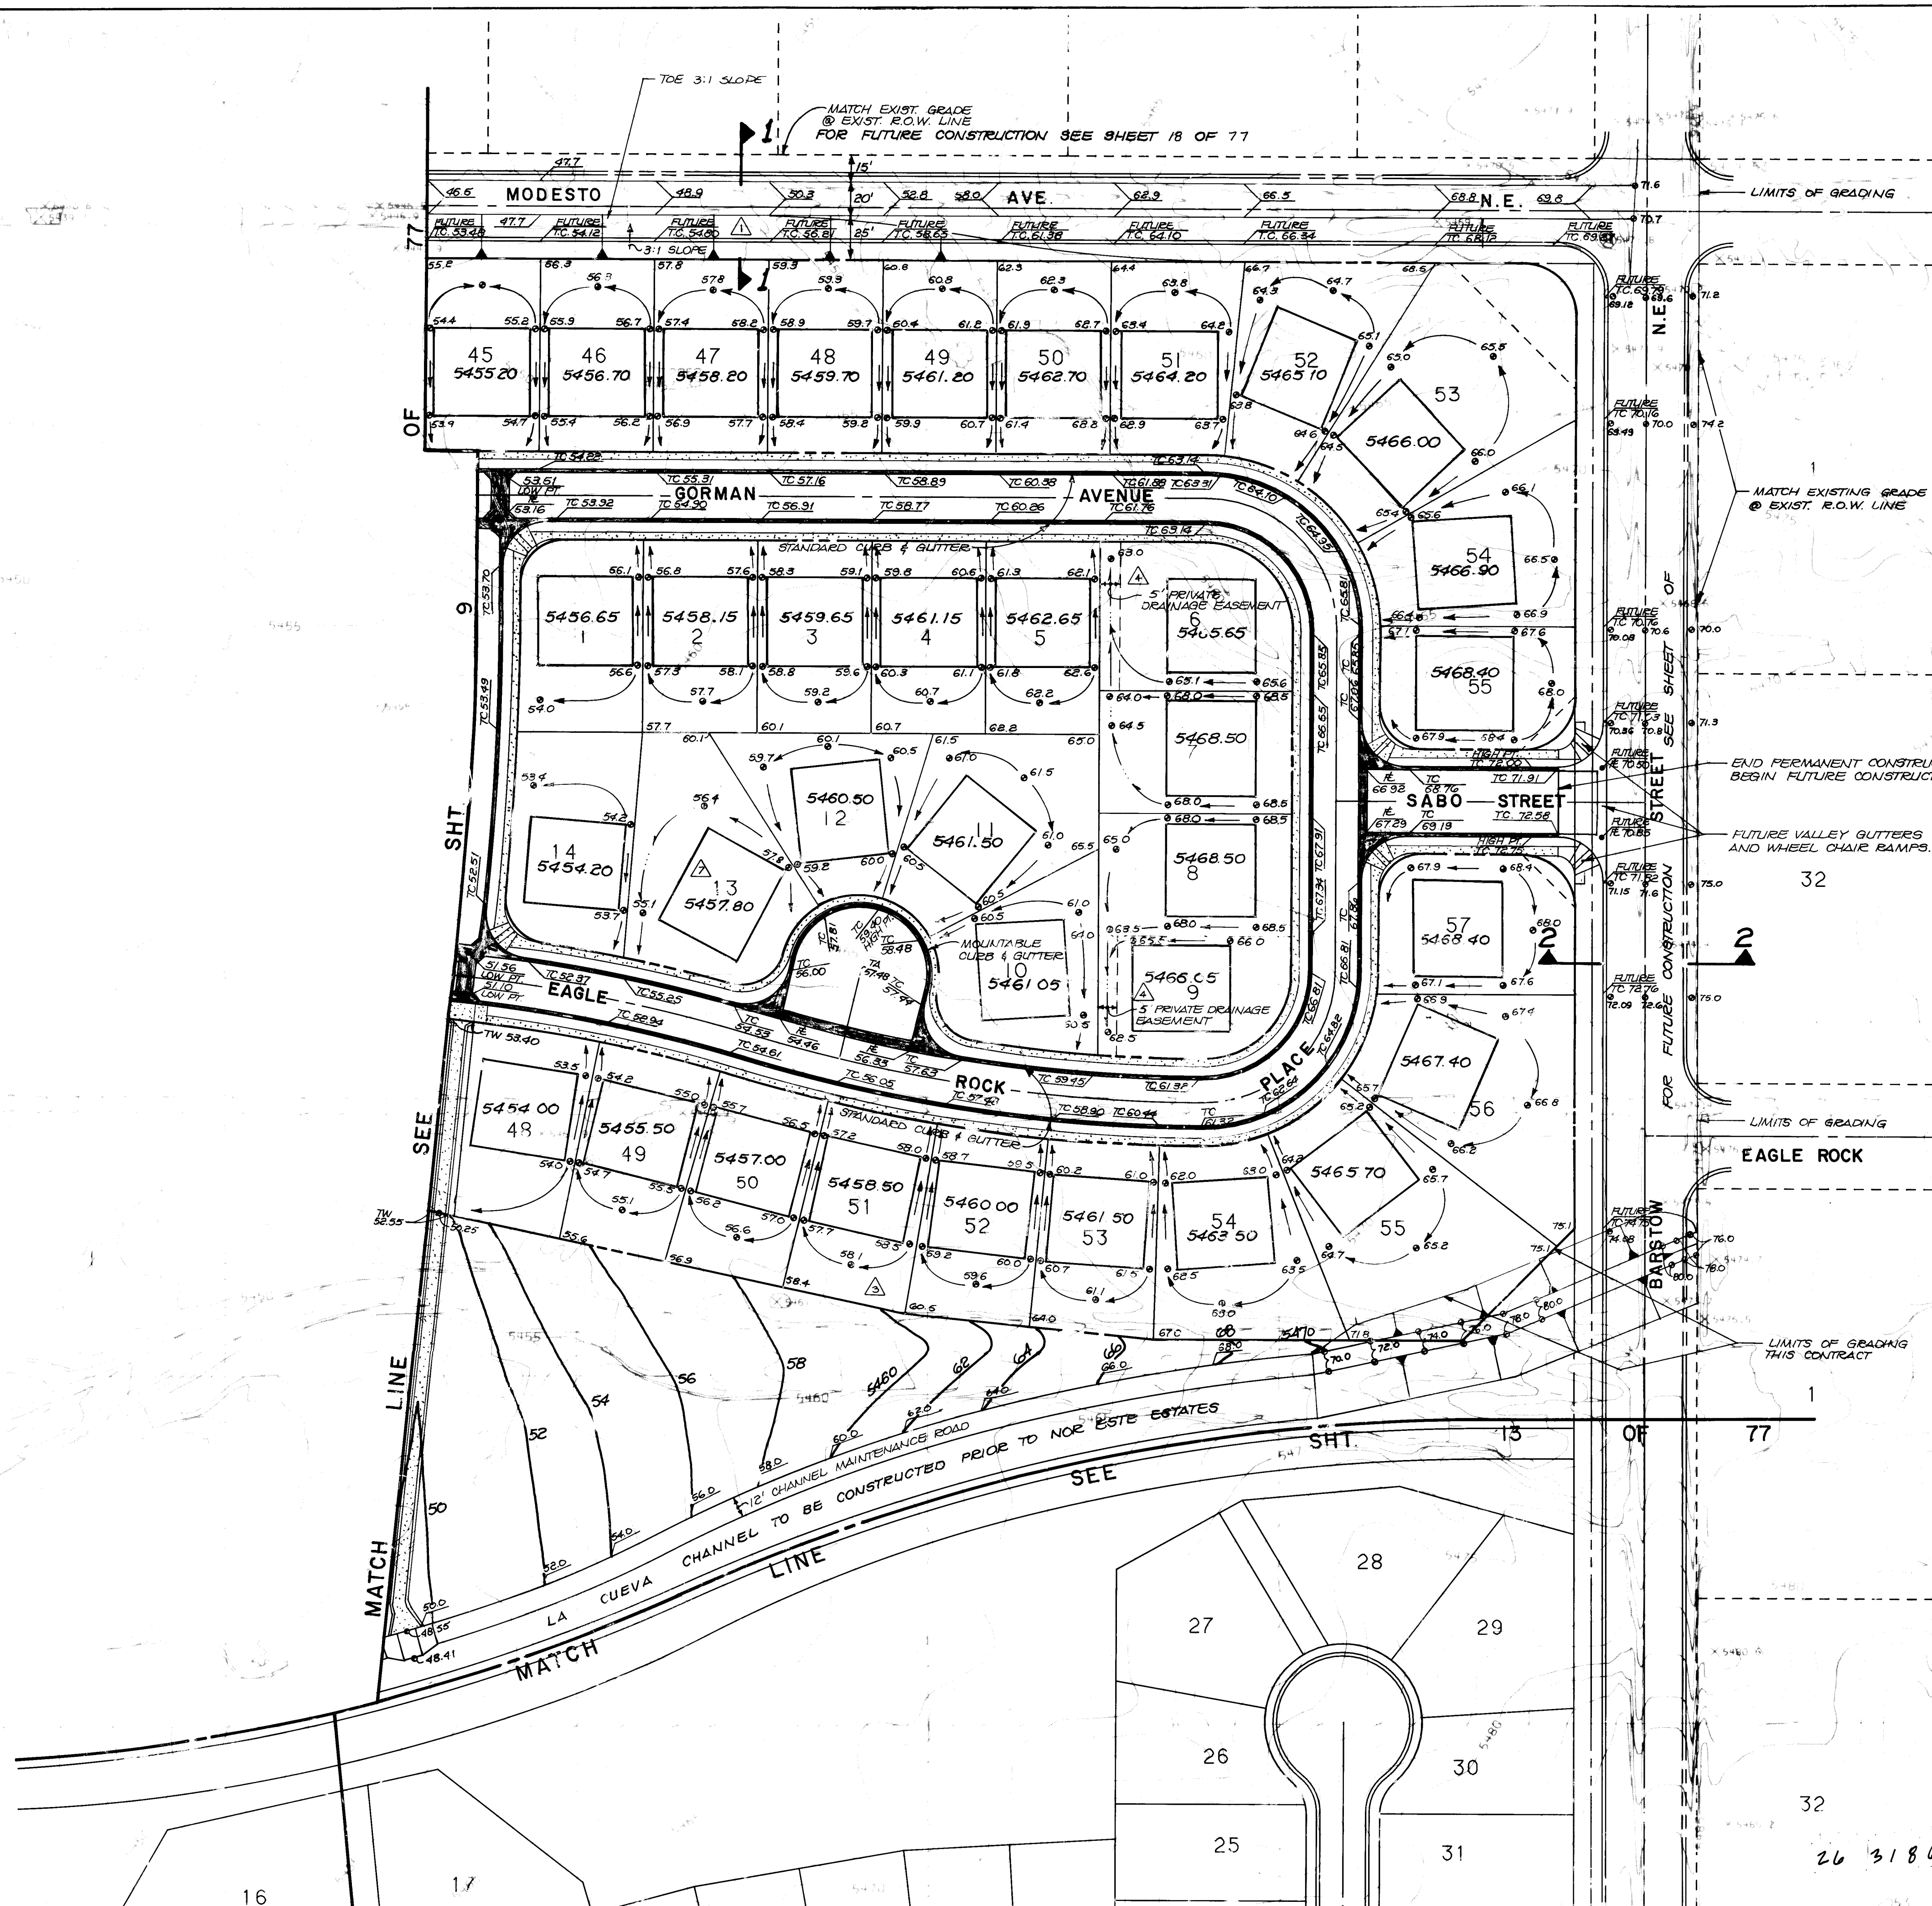

SCALE: 1" = 50'

TEMPORARY EROSION CONTROL NOTES

- 1. EROSION CONTROL BEAMS TO BE CONSTRUCTED IN ACCORDANCE WITH THE DETAIL SHOWN ON SHEET 72 OF 77 AND IN THE LOCATIONS AS SHOWN ON THE GRADING PLAN.
- 2. BEAMS WILL CONTROL MAJOR FLOWS AND PREVENT SEDIMENT FROM ENTERING THE LA CUEVA CHANNEL, ADJACENT STREETS, OR FROM LEAVING THE SITE DURING ANY CONSTRUCTION ACTIVITY.
- 3. THE CONTRACTOR SHALL OBTAIN A TOPSOIL DISTURBANCE PERMIT FROM THE ENVIRONMENTAL HEALTH DIVISION PRIOR TO PERFORMING ANY EARTHWORK OPERATIONS.
- 4. THE CONTRACTOR SHALL OBTAIN A SEPARATE PERMIT FROM CODE ADMINISTRATION FOR ALL RETAINING WALL CONSTRUCTION.
- 5. EARTHWORK SHALL BE PERFORMED IN ACCORDANCE WITH THE GEOTECHNICAL ENGINEERING EVALUATION - NOR ESTE SUBDIVISION, ALBUQUERQUE, NEW MEXICO (JOB NO. 2226087 - DATED MARCH 2, 1987) AND SUPPLEMENT #1 - NOR ESTE SUBDIVISION, ALBUQUERQUE, NEW MEXICO (DATED MAY 5, 1987) PREPARED BY WESTERN TECHNOLOGIES, INC.

APPROVED FOR ROUGH GRADING:
Roger A. Green 7-10-87
ROGER GREEN, P.E.
C.O.A. HYDROLOGY

- REVISIONS
- 1. Revised grades at Modesto south R.O.W. line to allow adjacent lots to drain to subdivision and show limits of 3:1 slope.
 - 2. Revised grades at Wyoming to show limits of 3:1 slope.
 - 3. Revised grades in rear yards of lots adjacent to park.
 - 4. Revised width of private drainage easements.
 - 5. Revised grades and finished floor elevations on Ellis Court.
 - 6. Revised grades and finished floor elevations and added retaining wall.

LEGEND

- 13.7 SPOT ELEVATIONS
- TC TOP OF CURB ELEVATION
- FE FLOWLINE ELEVATION
- DR DRAINAGE SHALE
- RETAINING WALLS
- 5402.10 RAD ELEVATION
- PROPOSED CURB & GUTTER
- CENTERLINE OF STREET
- RIGHT-OF-WAY LINE
- RAD
- PROPERTY LINE
- BOTTOM OF ROAD ELEV.
- TEMPORARY EROSION CONTROL BEAM

ESPEY, HUSTON & ASSOCIATES, INC.
Engineering & Environmental Consultants
317 COMMERCIAL ST. N.E.
ALBUQUERQUE, NEW MEXICO 87102
PHONE: (505) 242-1909

CITY OF ALBUQUERQUE
PUBLIC WORKS DEPARTMENT
ENGINEERING DIVISION

TITLE: NOR ESTE ESTATES GRADING PLAN

APPROVALS	ENGINEER	DATE	APPROVALS	ENGINEER	DATE
City Engineer	<i>[Signature]</i>	10/5/87	Liquid Waste	<i>[Signature]</i>	8/3/87
A.C.E. - Design	<i>[Signature]</i>	"	Traffic	<i>[Signature]</i>	9/24/87
A.C.E. - Hydrology	<i>[Signature]</i>	7-1-87	Water	<i>[Signature]</i>	8/31/87

DRAWING NO. 3186 MAP NO. C-19 SHEET 10 OF 77

AS BUILT INFORMATION		BENCH MARKS		SURVEY INFORMATION		FIELD NOTES		ENGINEER'S SEAL	
CONTRACTOR	DATE	STATION	DATE	NO.	DATE	NO.	DATE	NO.	DATE
INSPECTOR	DATE	STATION	DATE	NO.	DATE	NO.	DATE	NO.	DATE
FIELD ENGINEER	DATE	STATION	DATE	NO.	DATE	NO.	DATE	NO.	DATE
RECORDING	DATE	STATION	DATE	NO.	DATE	NO.	DATE	NO.	DATE
RECORDING	DATE	STATION	DATE	NO.	DATE	NO.	DATE	NO.	DATE

DESIGNED BY: J.T.O. DATE: 6/12/87
DRAWN BY: R.D. DATE: 6/12/87
CHECKED BY: D.L. DATE: 8/14/87

TEMPORARY EROSION CONTROL NOTES

1. EROSION CONTROL BERMS TO BE CONSTRUCTED IN ACCORDANCE WITH THE DETAIL SHOWN ON SH. 77 OF 77 AND IN THE LOCATIONS AS SHOWN ON THE GRADING PLANS.

2. BERMS WILL CONTROL MINOR FLOWS AND PROHIBIT SEDIMENT FROM ENTERING THE LA CUEVA CHANNEL, ADJACENT STREETS, OR FROM LEAVING THE SITE DURING ANY CONSTRUCTION ACTIVITY.

3. THE CONTRACTOR SHALL OBTAIN A TOPSOIL DISTURBANCE PERMIT FROM THE ENVIRONMENTAL HEALTH DIVISION PRIOR TO PERFORMING ANY EARTHWORK OPERATIONS.

4. THE CONTRACTOR SHALL OBTAIN A SEPARATE PERMIT FROM CODE ADMINISTRATION FOR ALL RETAINING WALL CONSTRUCTION.

5. EARTHWORK SHALL BE PERFORMED IN ACCORDANCE WITH THE GEOTECHNICAL ENGINEERING EVALUATION - NOR ESTE SUBDIVISION, ALBUQUERQUE, NEW MEXICO (JOB NO. 2226J087 - DATED MARCH 2, 1987 AND SUPPLEMENT #1 - NOR ESTE SUBDIVISION, ALBUQUERQUE, NEW MEXICO (DATED MAY 5, 1987) PREPARED BY WESTERN TECHNOLOGIES, INC.

APPROVED FOR ROUGH GRADING:

Roger A. Green 7-10-87
ROGER GREEN, P.E.
C.O.A. HYDROLOGY

REVISIONS

1. Revised grades at modesto south R.O.W. line to allow adjacent lots to drain to subdivision and show limits of 3:1 slope.

2. Revised grades at Wyoming to show limits of 3:1 slope.

3. Revised grades in rear yards of lots adjacent to park.

4. Revised width of private drainage easements.

5. Revised grades and finished floor elevations on Ellis Court.

6. Revised grades and finished floor elevations and added retaining wall.

7. Revised rear yard grades along Wyoming and Alameda.

LEGEND

SPOT ELEVATIONS

TOP OF CURB ELEVATION

FLOWLINE ELEVATION

DRAINAGE SWALE

RETAINING WALLS

RAD ELEVATION

PROPOSED CURB & GUTTER

CENTERLINE OF STREET

RIGHT-OF-WAY LINE

PAD

PROPERTY LINE

BOTTOM OF POND ELEV.

TEMPORARY EROSION CONTROL BERM

ENGINEER'S SEAL

ESPEY
HUSTON &
ASSOCIATES, INC.
Engineering & Environmental Consultants
317 COMMERCIAL ST. N.E.
ALBUQUERQUE, NEW MEXICO 87102
PHONE: (505) 242-1909

AS BUILT INFORMATION

THE STATION IS LOCATED 9 MILES NORTHEAST OF DOWNTOWN ALBUQUERQUE, NEW MEXICO, AT THE INTERSECTION OF LOS ANGELES DRIVE, 10 MILES TO BARSTOW ST., THEN NORTH ON BARSTOW ST. 10 MILES TO ALAMEDA AVE. THE STATION IS LOCATED IN THE NORTHEAST QUADRANT OF THE INTERSECTION. THE STATION MARK IS A STANDARD ACS BRASS TABLE STAMPED "1-820" SET IN TOP OF A CONCRETE POST PROJECTING 0.1 FEET ABOVE GROUND.

MSL ELEVATION: 5474.53'

SURVEY INFORMATION

DATE: 7-10-87
BY: ROGER GREEN, P.E.
NO.: 2226J087

ENGINEER'S SEAL

6-12-87
6-12-87
6-12-87

REVISIONS

NO.	DATE	REMARKS
1	7-10-87	APPROVED FOR ROUGH GRADING


CITY OF ALBUQUERQUE
PUBLIC WORKS DEPARTMENT
ENGINEERING DIVISION


TITLE: NOR ESTE ESTATES
GRADING PLAN

APPROVALS	ENGINEER	DATE	APPROVALS	ENGINEER	DATE
City Engineer	<i>[Signature]</i>	7/15/87	Liquid Waste	REE	8/31/87
A.C.E. - Design	<i>[Signature]</i>	7-1-87	Traffic	NADWA	9/24/87
A.C.E. - Hydrology	<i>[Signature]</i>	7-1-87	Water	REE	8/31/87

DRAWING NO.	MAP NO.	SHEET	OF
3186	C-19	11	77


The figure is a detailed grading plan for the Nor Este Estates. It shows a grid of 32 lots, numbered 1 through 32. The lots are arranged in a roughly rectangular pattern, with some irregular shapes. The plan includes several streets: Oakland Ave running horizontally across the middle, Steider St running vertically on the left, Wyoming Blvd running vertically on the far left, and Alameda Ave running horizontally at the bottom. There are also several smaller streets and alleys, including La Cueva Channel, Bike Trail, and various unnamed streets. The plan shows various elevation points, including spot elevations, top of curb elevations, and flowline elevations. It also includes various engineering notes, such as "LIMITS OF GRADING THIS CONTRACT", "END TEMPORARY CONSTRUCTION BEGIN PERMANENT CONSTRUCTION", and "MOUNTAIN VIEW & GUTTER". The plan is divided into sections by "MATCH LINE" and "SEE SHEET" labels. The overall layout is a typical subdivision plan for a residential development.

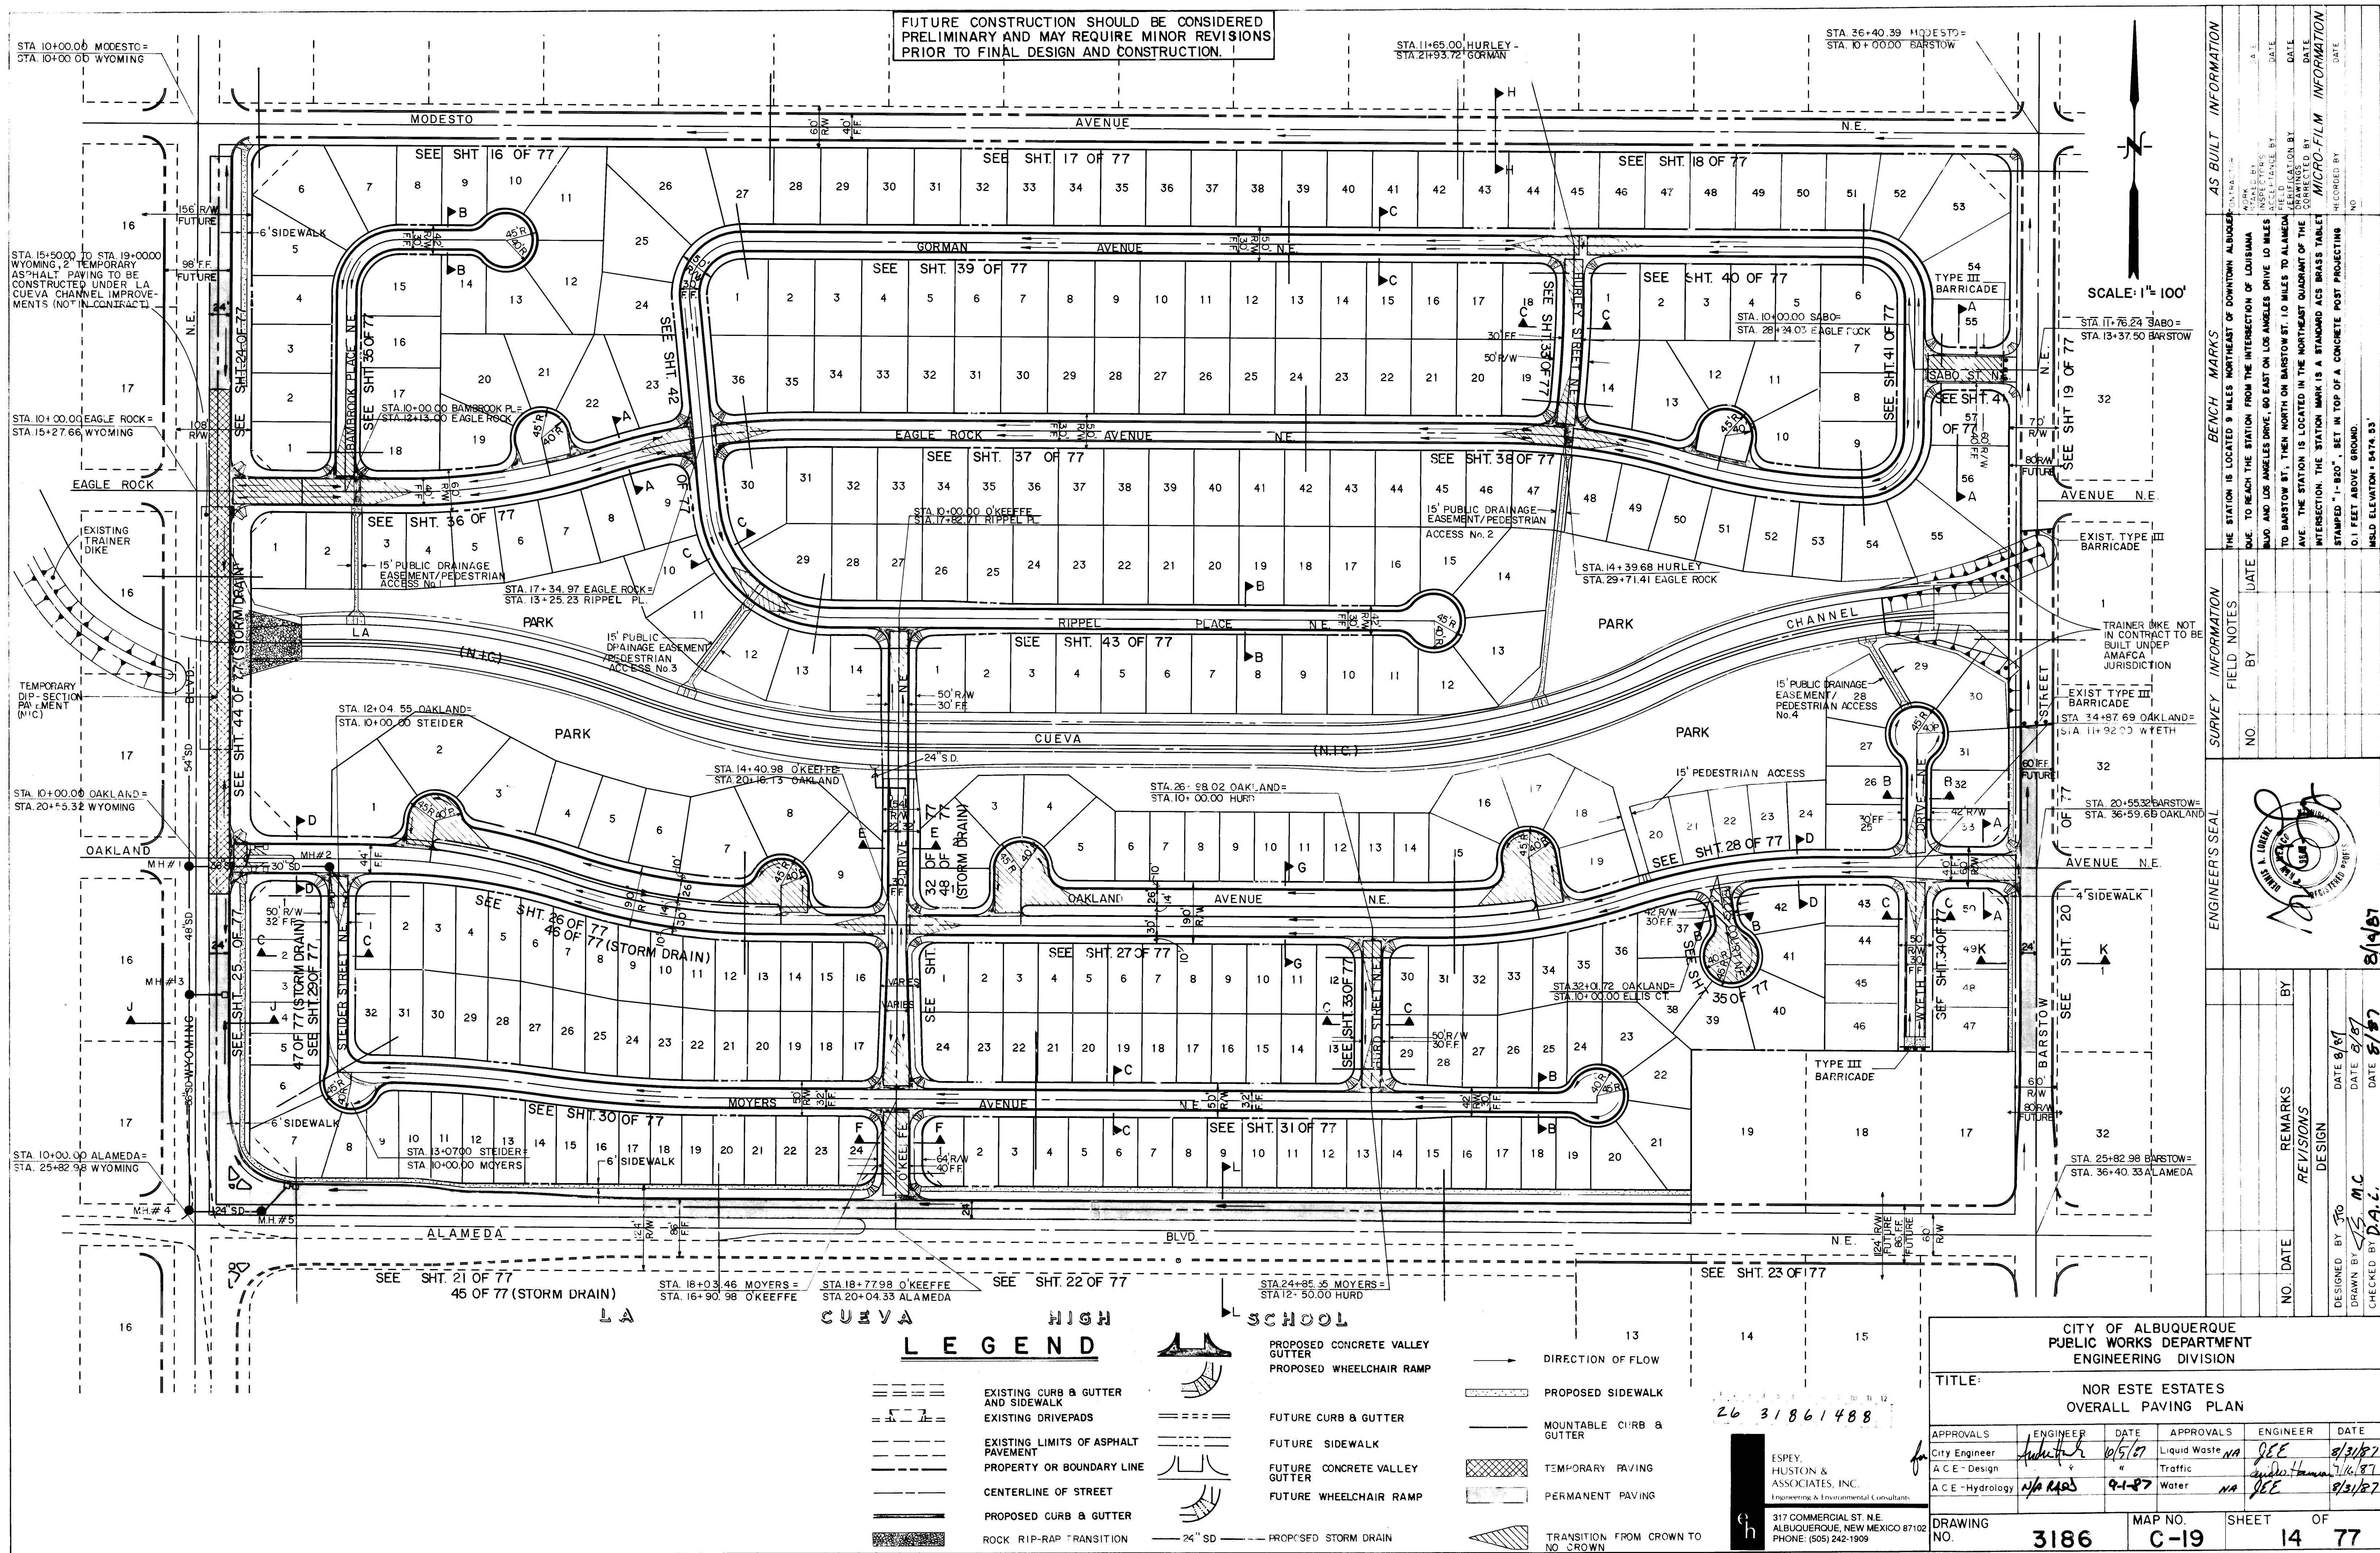

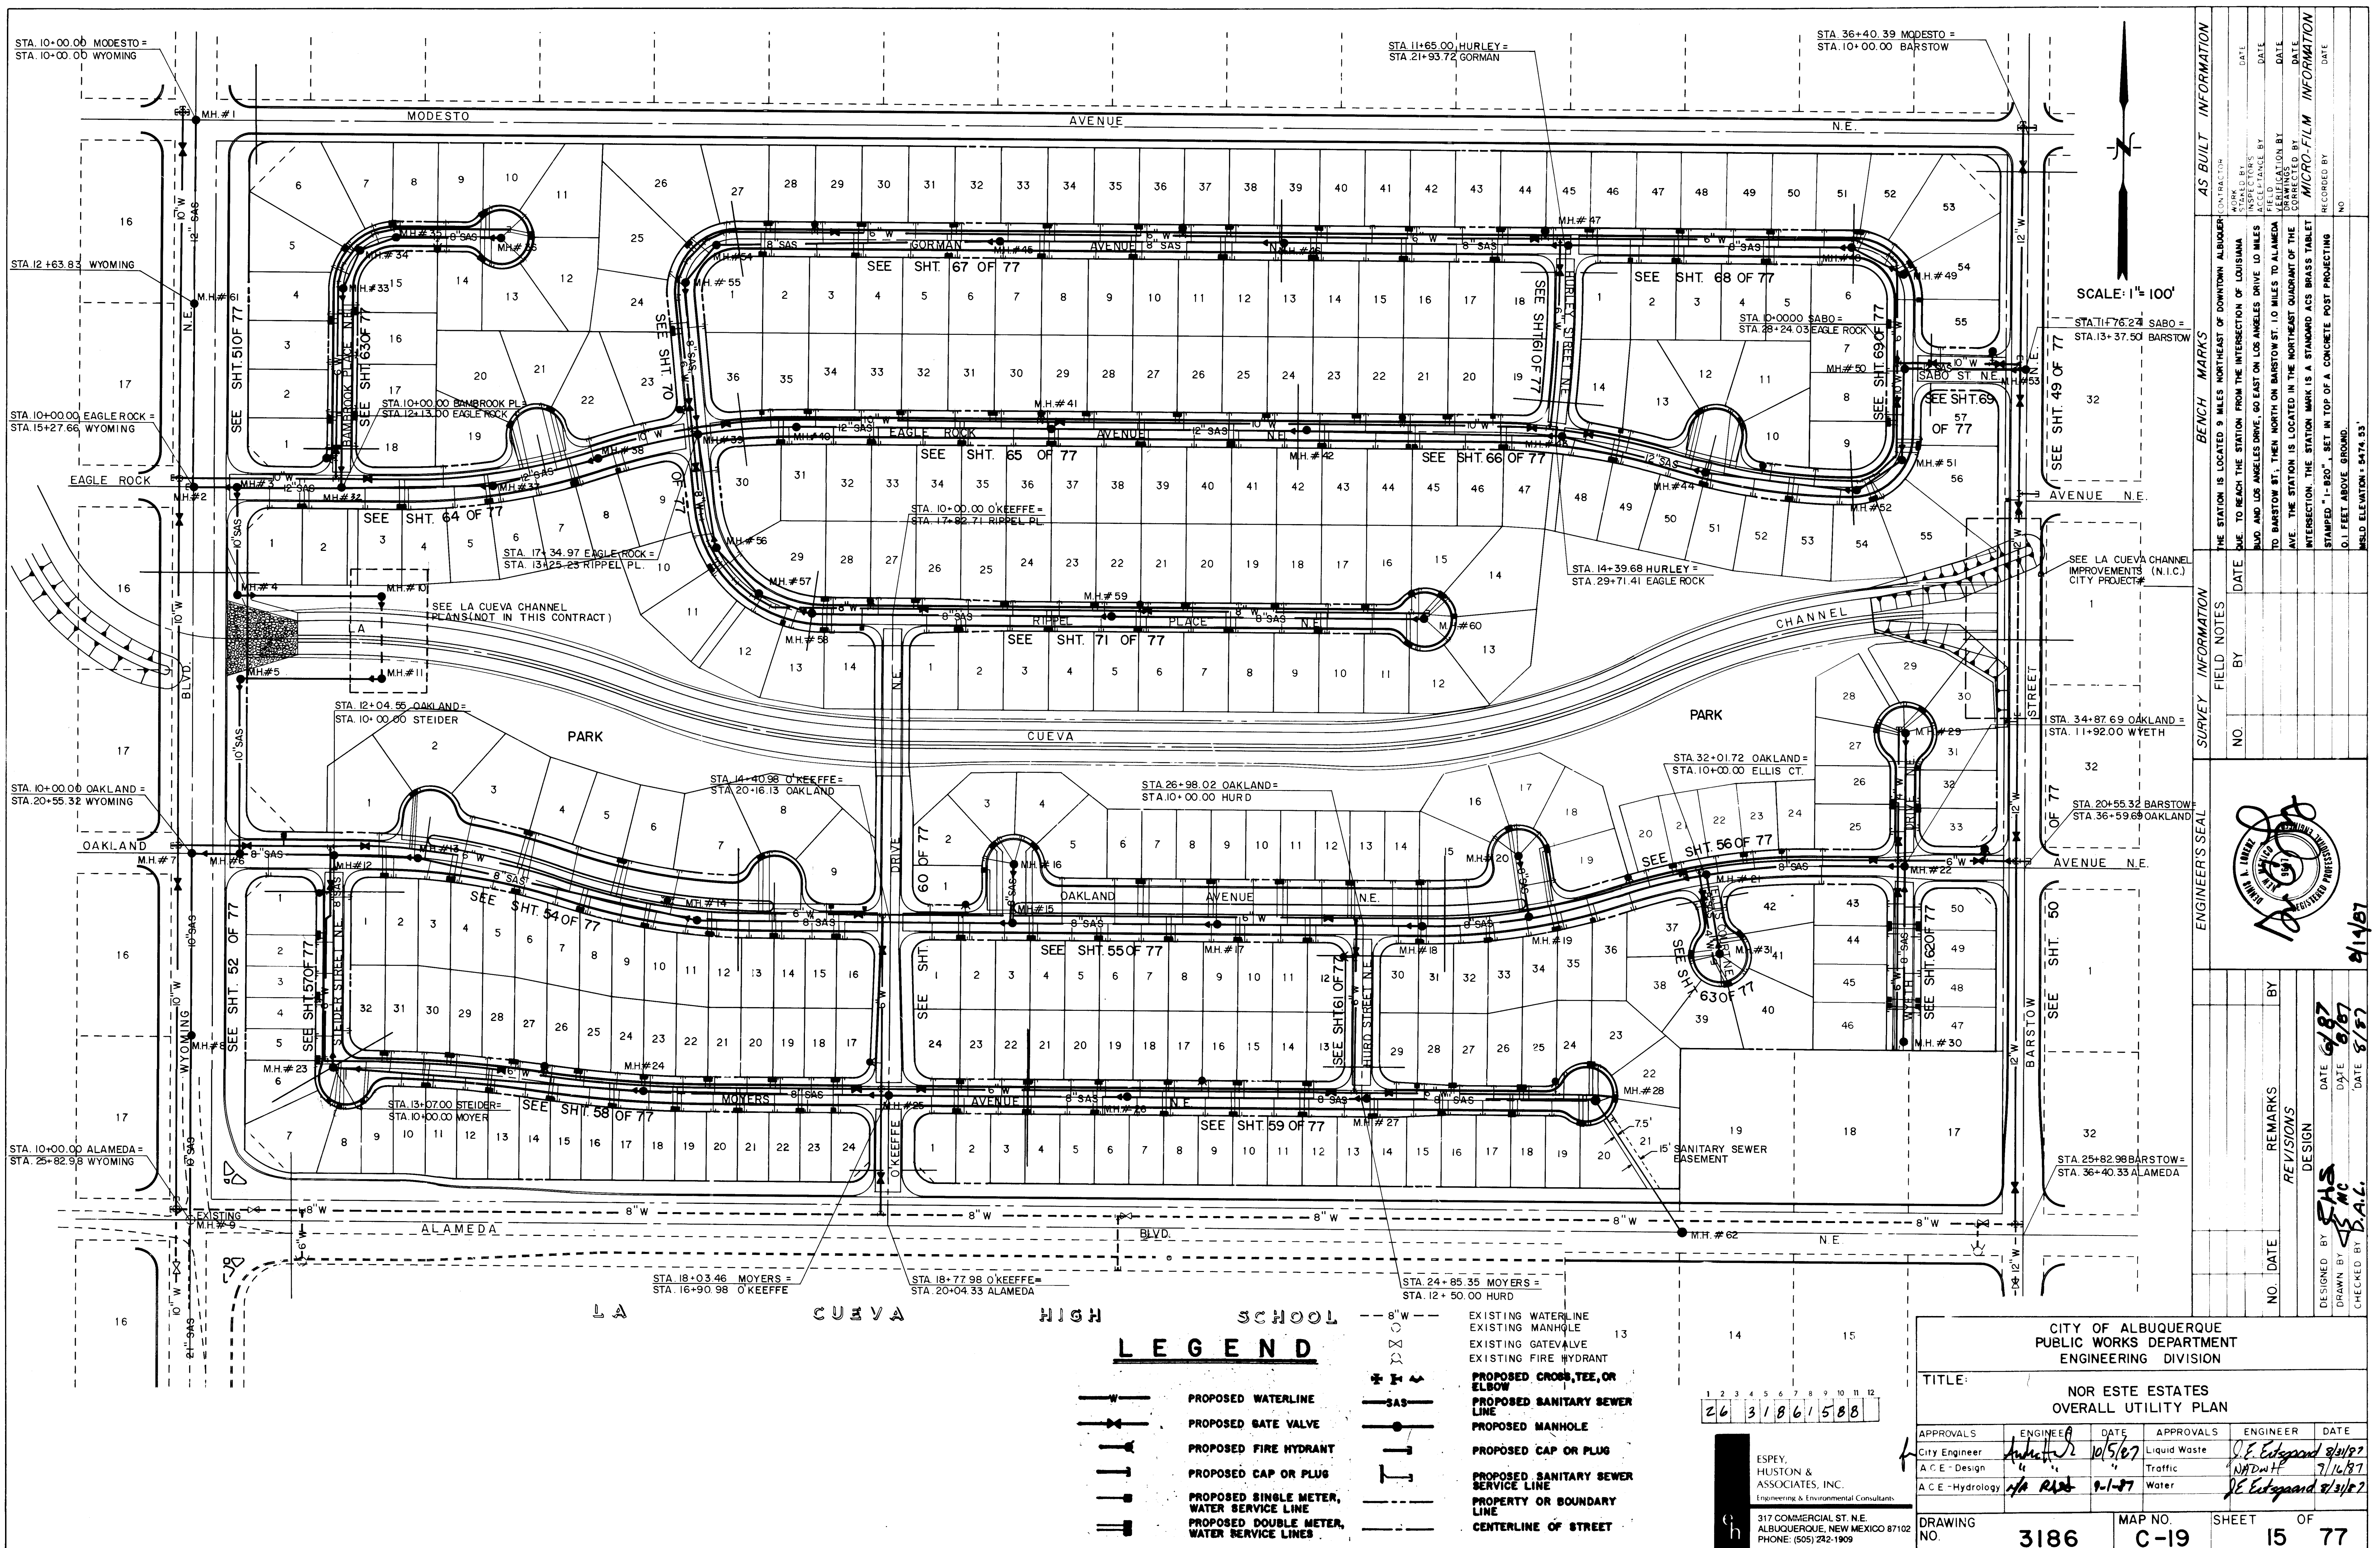


TRACT 1
NORTH
ALBUQUERQUE
UNIT NO. 3
ACRES

FUTURE CONSTRUCTION SHOULD BE CONSIDERED
PRELIMINARY AND MAY REQUIRE MINOR REVISIONS
PRIOR TO FINAL DESIGN AND CONSTRUCTION.

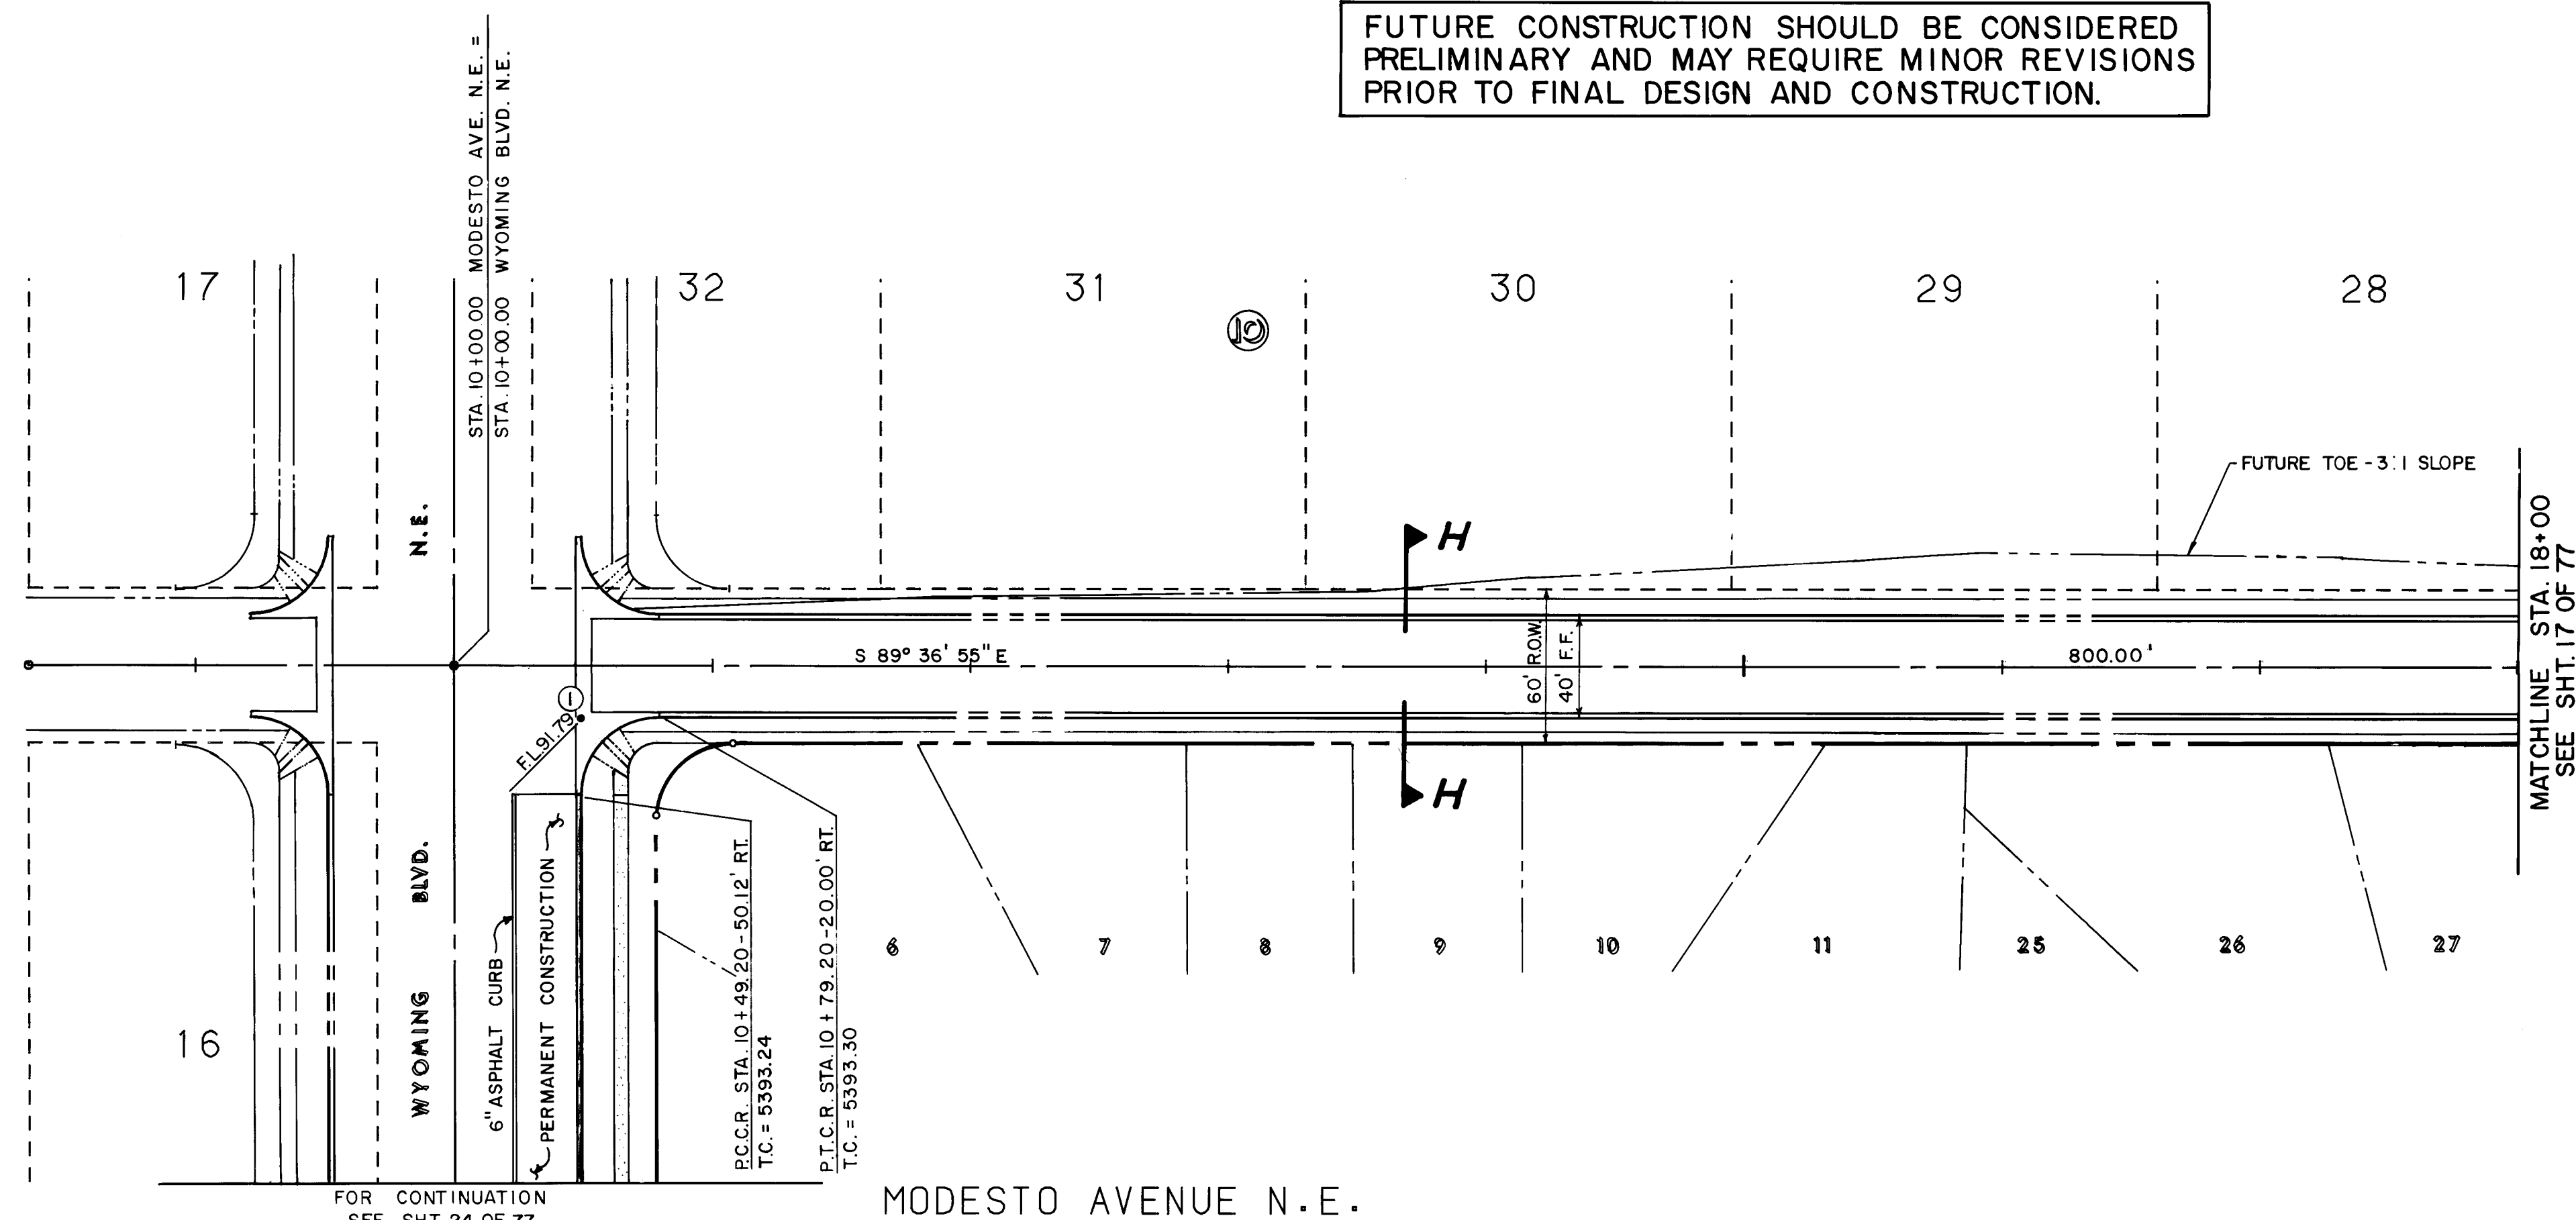

FUTURE CONSTRUCTION — NOT IN CONTRACT

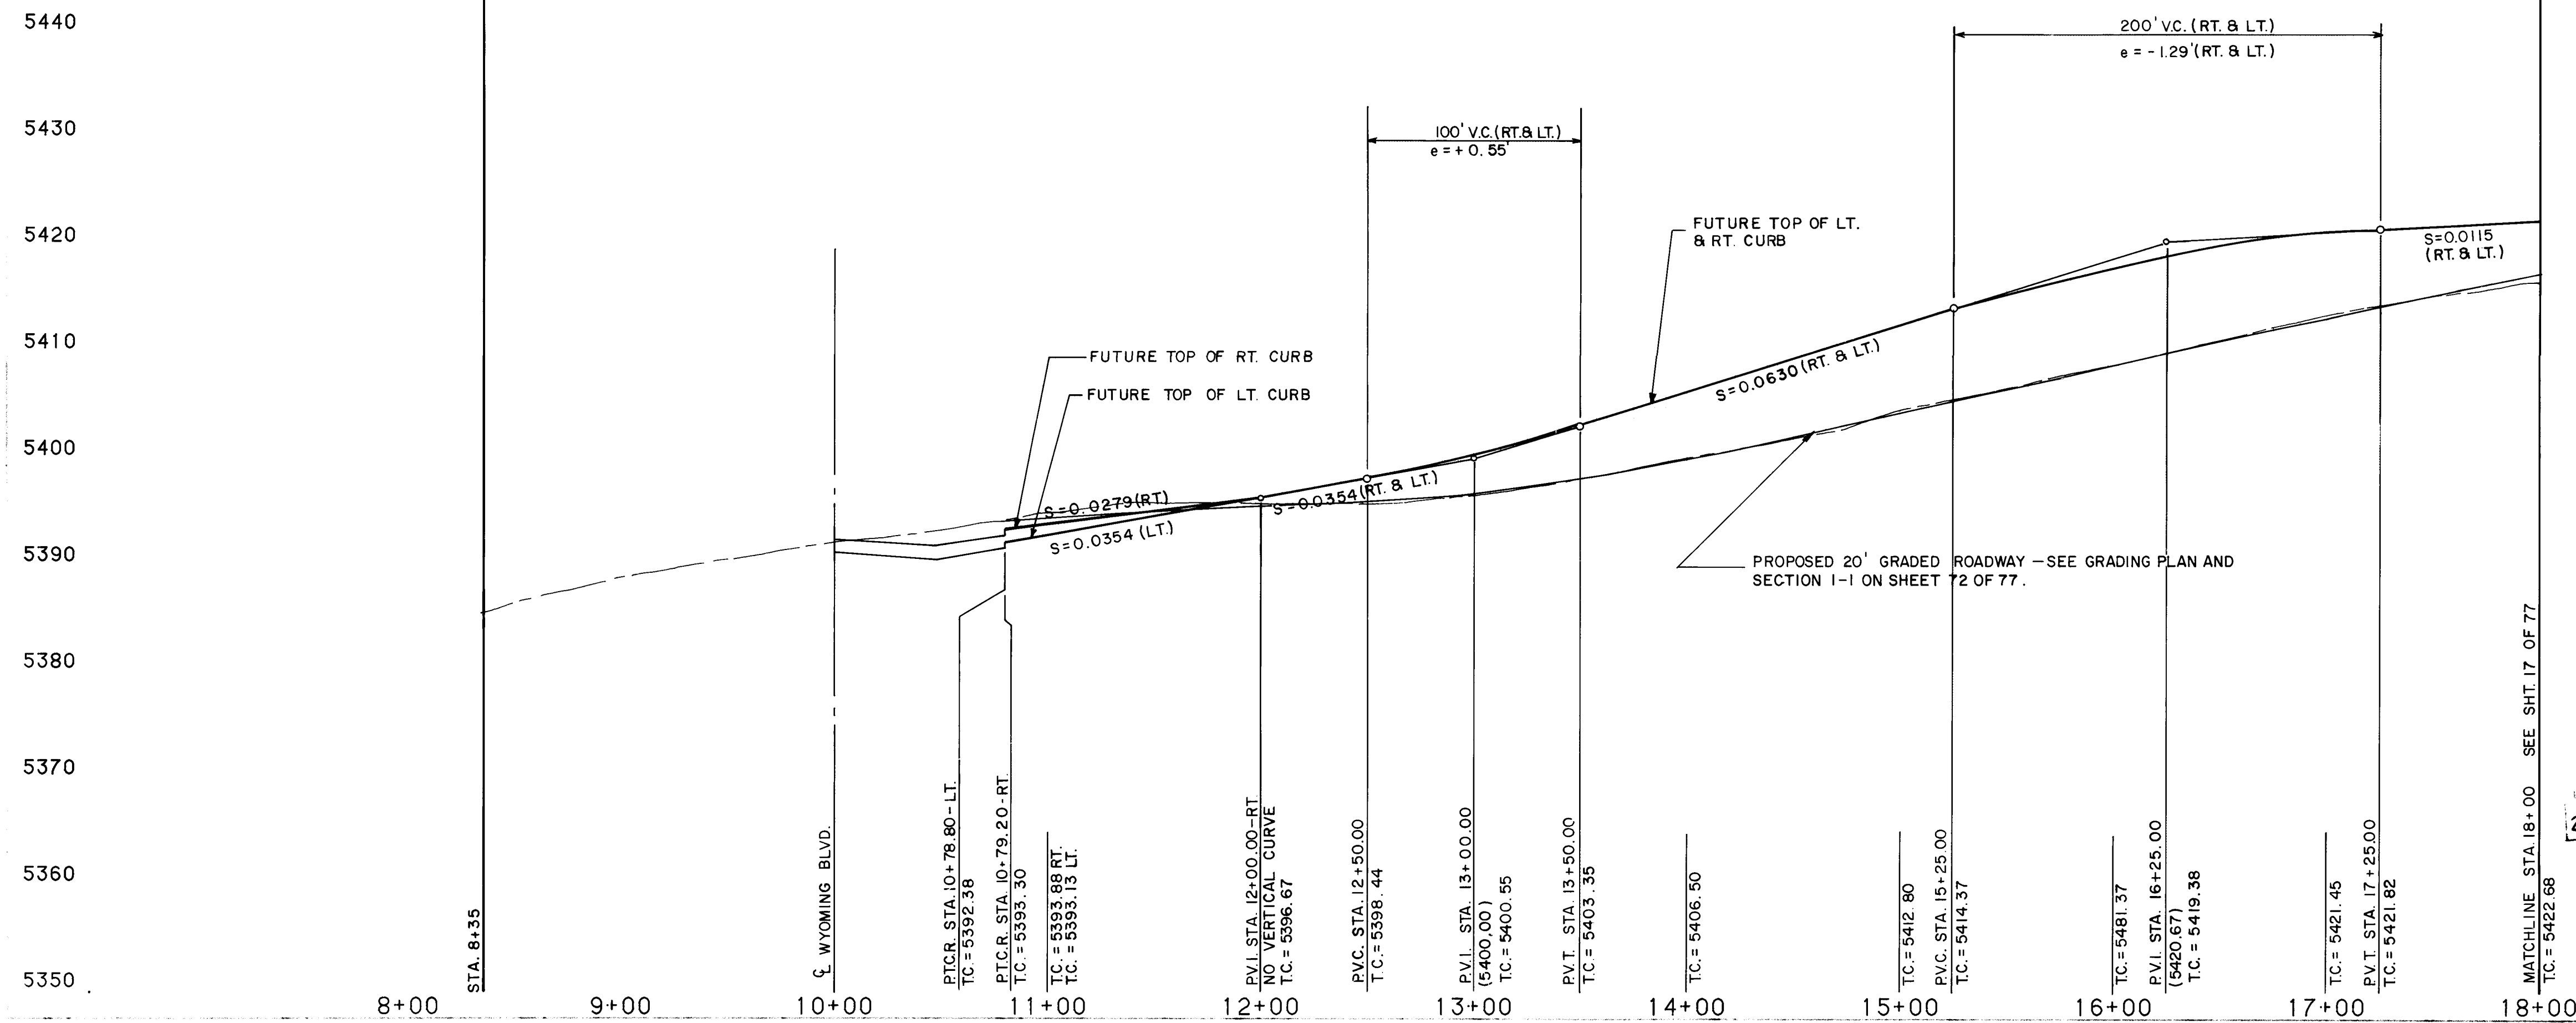

NO.	DELTA	RADIUS	LENGTH	TAN
1	90°13'55"	30.00	47.25	30.12

- ALL STATIONING AND OFFSET DIMENSIONS ARE BASED ON CENTERLINE OF RIGHT-OF-WAY.
- THE FOLLOWING CITY OF ALBUQUERQUE STANDARD DRAWINGS ARE APPLICABLE TO THE PAVING CONSTRUCTION:

2401	2415	2422
2405	2418	2430
2407	2420	2440
2408	2421	2441

THE STATION IS LOCATED 9 MILES NORTHEAST OF DOWNTOWN ALBUQUERQUE. TO REACH THE STATION FROM THE INTERSECTION OF LOUISIANA BLVD. AND LOS ANGELES DRIVE, GO EAST ON LOS ANGELES DRIVE 10 MILES TO BARSTOW ST., THEN NORTH ON BARSTOW ST. 1.0 MILES TO ALAMEDA AVE. THE STATION IS LOCATED IN THE NORTHEAST QUADRANT OF THE INTERSECTION. THE STATION MARK IS A STANDARD ACS BRASS TABLET STAMPED "1-820". SET IN TOP OF A CONCRETE POST PROJECTING 0.1 FEET ABOVE GROUND. MSLD ELEVATION = 5474.53'

SCALE:
HORIZ. 1" = 50'
VERT. 1" = 10'

LEGEND

- EXISTING CURB & GUTTER AND SIDEWALK
- EXISTING DRIVEPADS
- EXISTING LIMITS OF ASPHALT PAVEMENT
- PROPERTY OR BOUNDARY LINE
- CENTERLINE OF STREET
- PROPOSED CURB & GUTTER
- PROPOSED SIDEWALK
- PROPOSED CONCRETE VALLEY GUTTER
- PROPOSED WHEELCHAIR RAMP
- FUTURE CURB & GUTTER
- FUTURE SIDEWALK
- FUTURE CONCRETE VALLEY GUTTER
- FUTURE WHEELCHAIR RAMP

ESPEY,
HUSTON &
ASSOCIATES, INC.
Engineering & Environmental Consultants
317 COMMERCIAL ST. N.E.
ALBUQUERQUE, NEW MEXICO 87102
PHONE: (505) 242-1909

NOR ESTE ESTATES
MODESTO AVENUE N.E.
PAVING - STA.7+36 TO STA.18+00


Hydrology N/A RWS
9-1-87

UNIT 3
ACRES

PAVING

1. ALL STATIONING AND OFFSET DIMENSIONS ARE BASED ON CENTERLINE OF RIGHT-OF-WAY.
2. THE FOLLOWING CITY OF ALBUQUERQUE STANDARD DRAWINGS ARE APPLICABLE TO THE PAVING CONSTRUCTION:


2401	2415	2422
2405	2418	2430
2407	2420	2440
2408	2421	2441

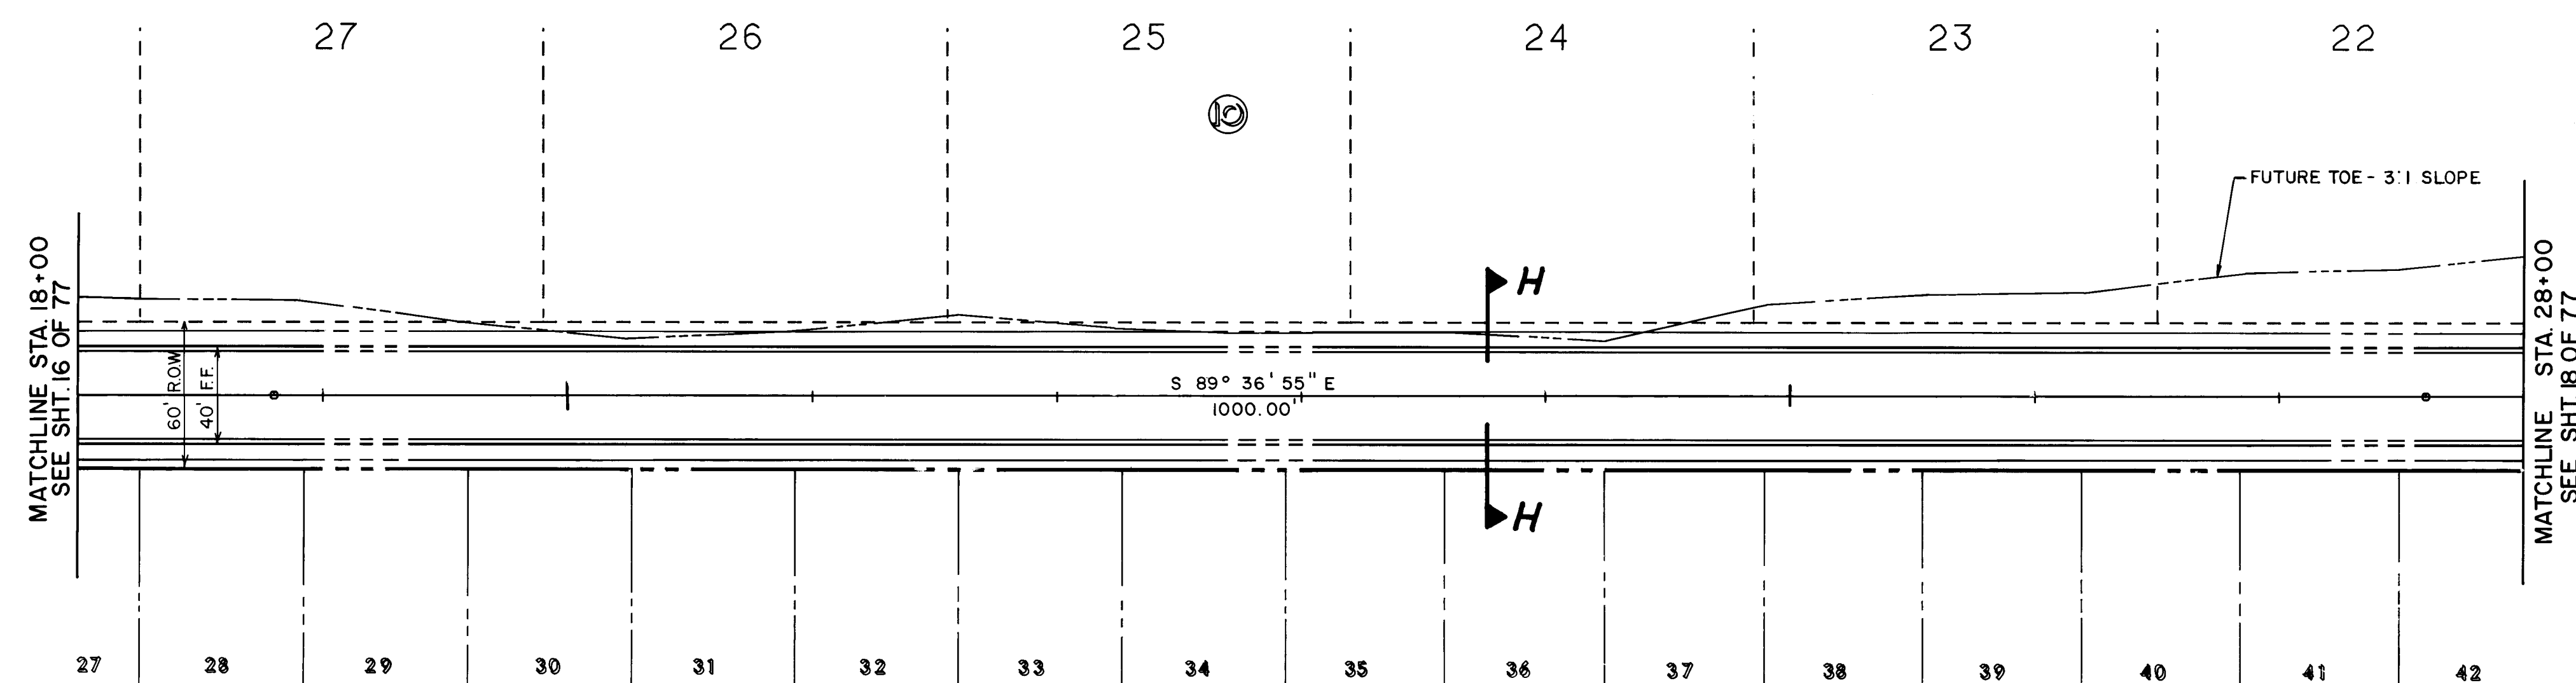

THE STATION IS LOCATED 9 MILES NORTHEAST OF DOWNTOWN ALBUQUERQUE. TO REACH THE STATION FROM THE INTERSECTION OF LOUISIANA, OKLAHOMA, AND LOS ANGELES DRIVE, GO EAST ON LOS ANGELES DRIVE, 10 MILES TO BARTON ST., THEN NORTH ON BARTON ST. 10 MILES TO ALAMEDA DRIVE. THE STATION IS LOCATED IN THE NORTHEAST QUADRANT OF THE INTERSECTION. THE STATION MARK IS A STANDARD ACS BRASS TABLET STAMPED "1-B20", SET IN TOP OF A CONCRETE POST PROJECTING 0.1 FEET ABOVE GROUND. INSID. ELEVATION: 5474.53'.


MODESTO AVENUE N.E.

FUTURE CONSTRUCTION — NOT IN CONTRACT

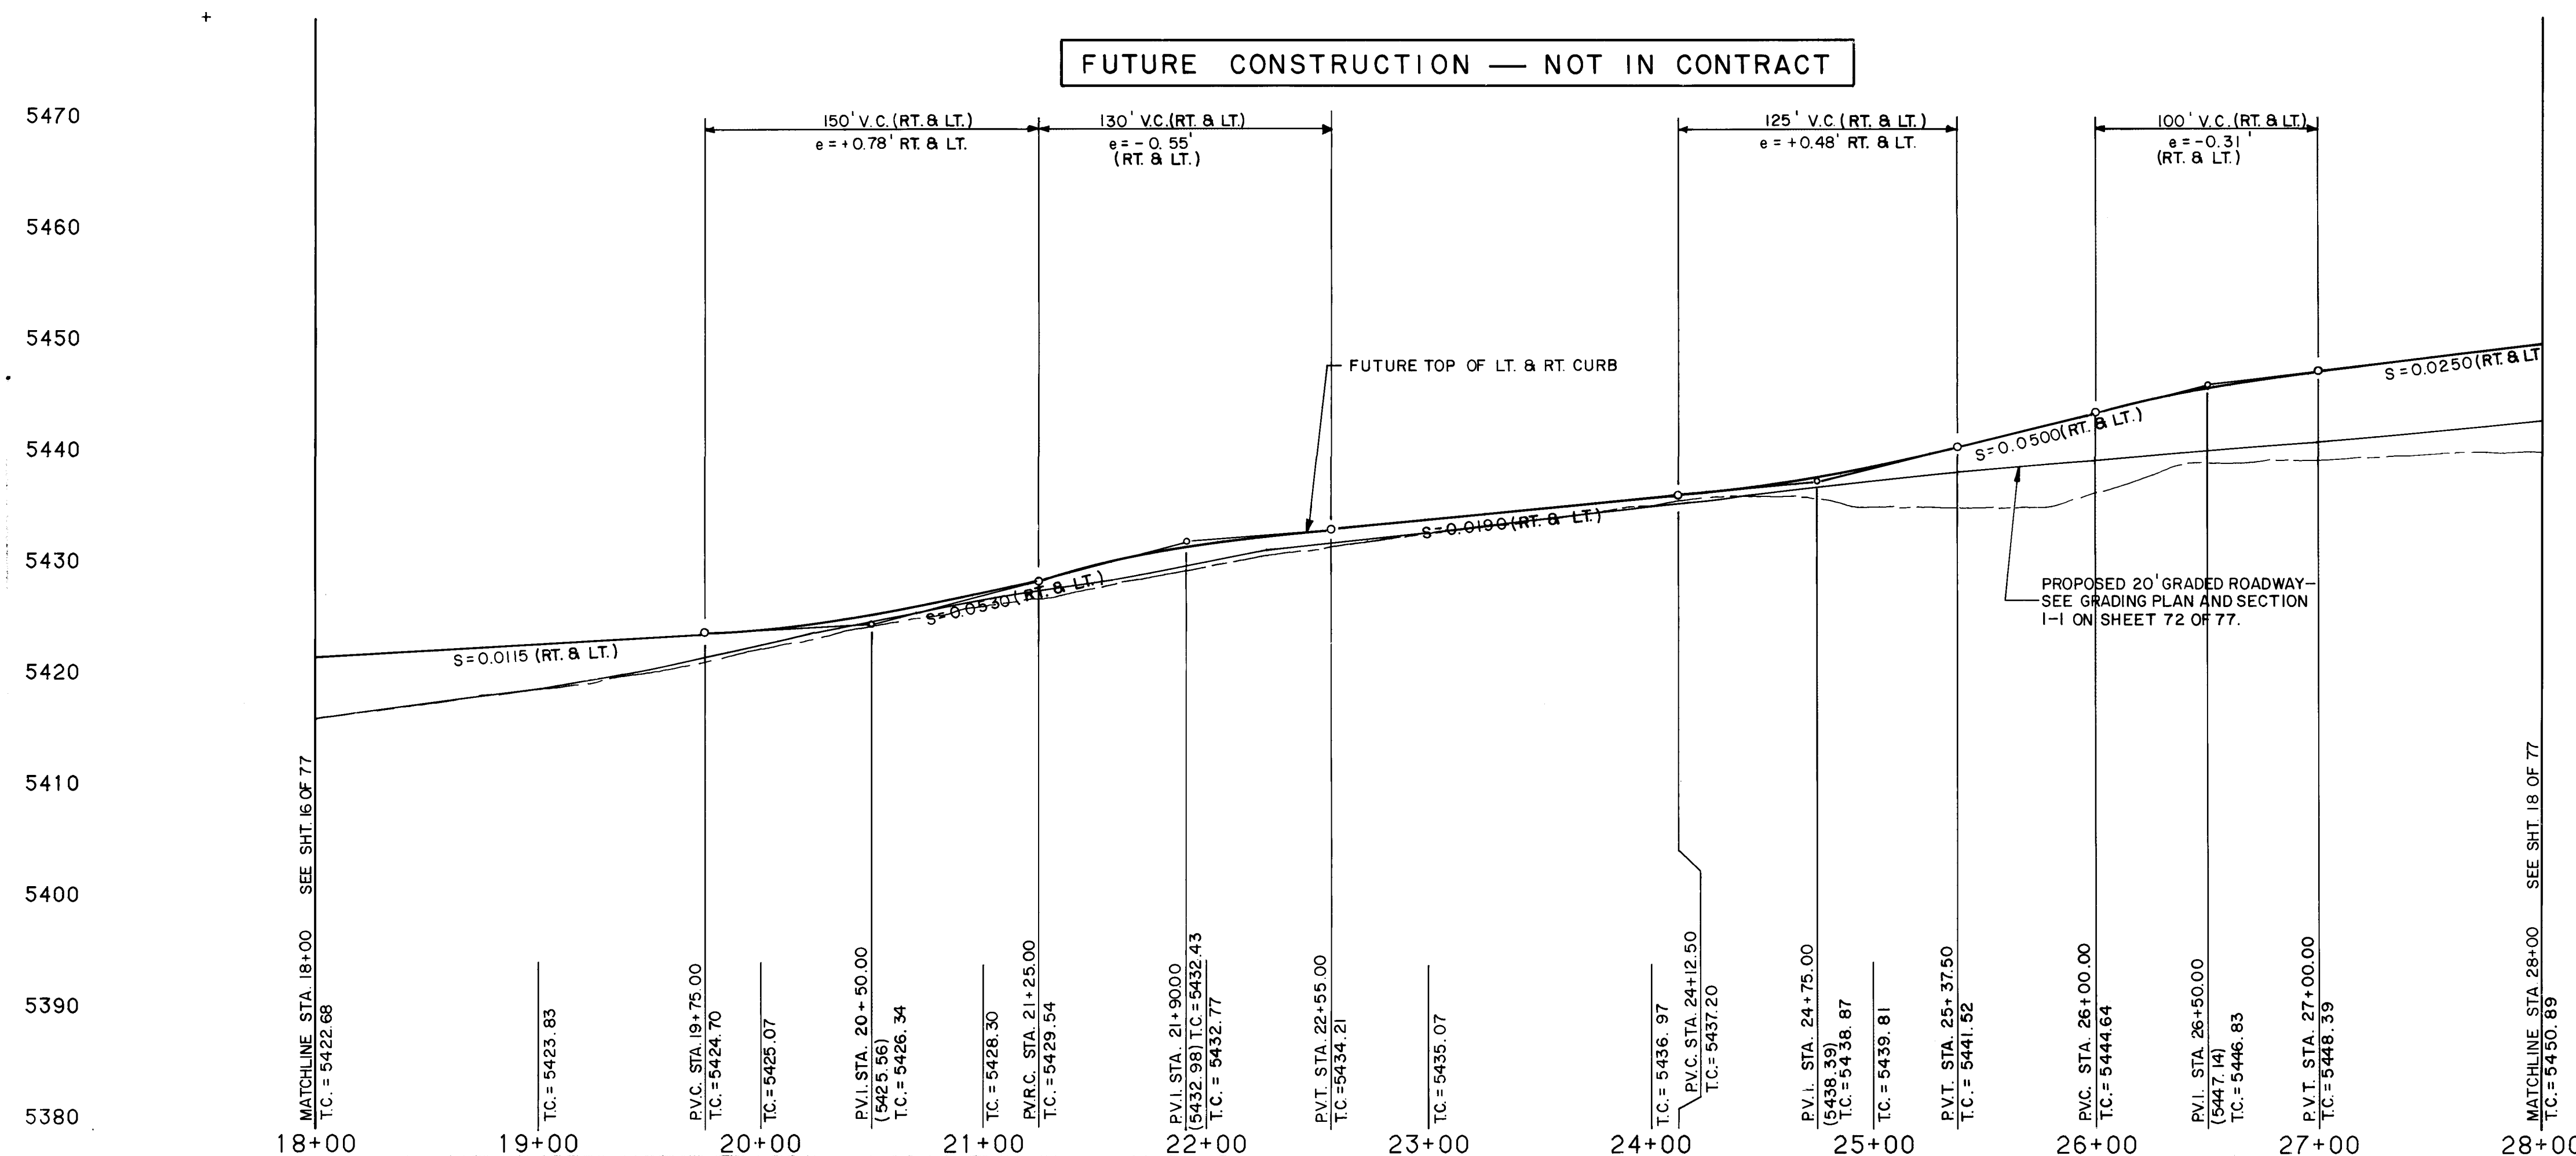

SCALE:
HORIZ. 1" = 50'
VERT. 1" = 10'

LEGEND

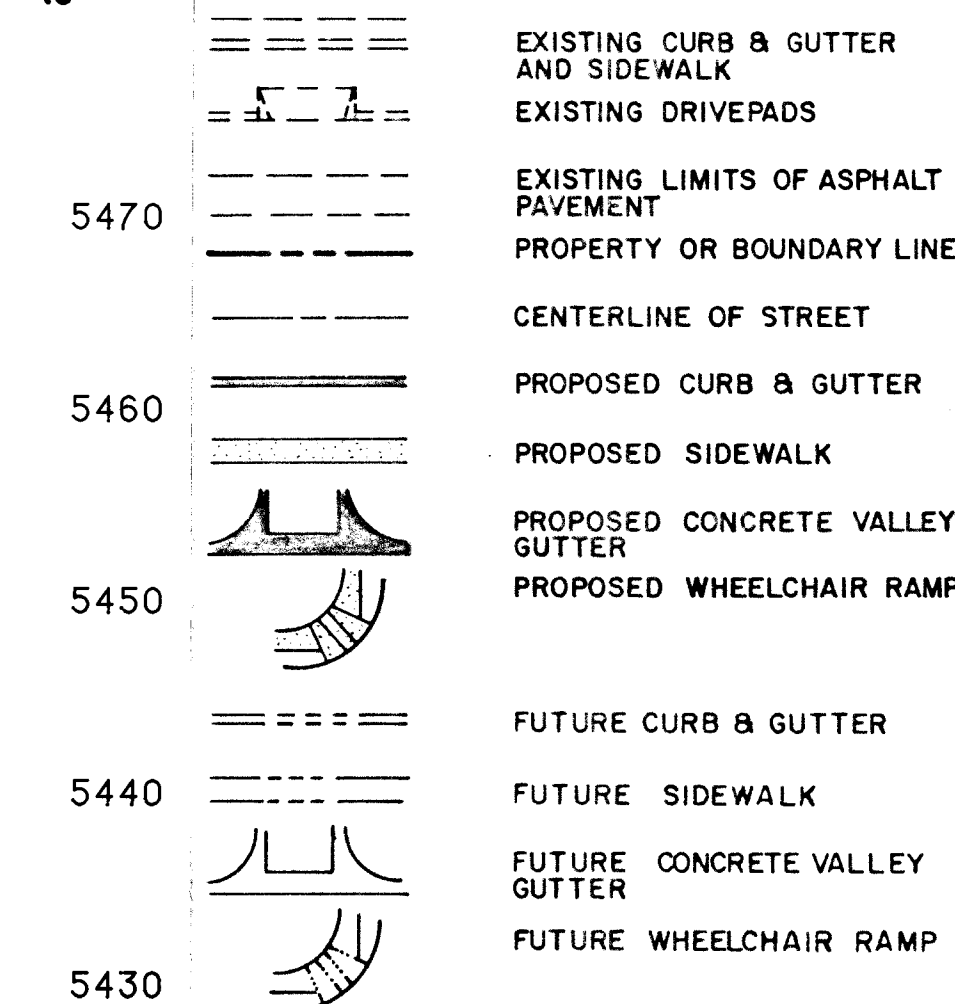

8/8/87
8/8/87
8/8/87

JB MC
D.A.L.

ESPEY,
HUSTON &
ASSOCIATES, INC.
Engineering & Environmental Consultants


317 COMMERCIAL ST. N.E.
ALBUQUERQUE, NEW MEXICO 8
PHONE: (505) 242-1909

NOR ESTE ESTATES
MODESTO AVENUE N.E.
PAVING STA. 18+00 TO STA. 28+00

HYDRO NA JEE N/A R121 10/5/81 1/24/81 8/31/81 9-1-81


TRACT 1
NORTH
ALBUQUERQUE
UNIT NO. 3
ACRES

FUTURE CONSTRUCTION SHOULD BE CONSIDERED
PRELIMINARY AND MAY REQUIRE MINOR REVISIONS
PRIOR TO FINAL DESIGN AND CONSTRUCTION.

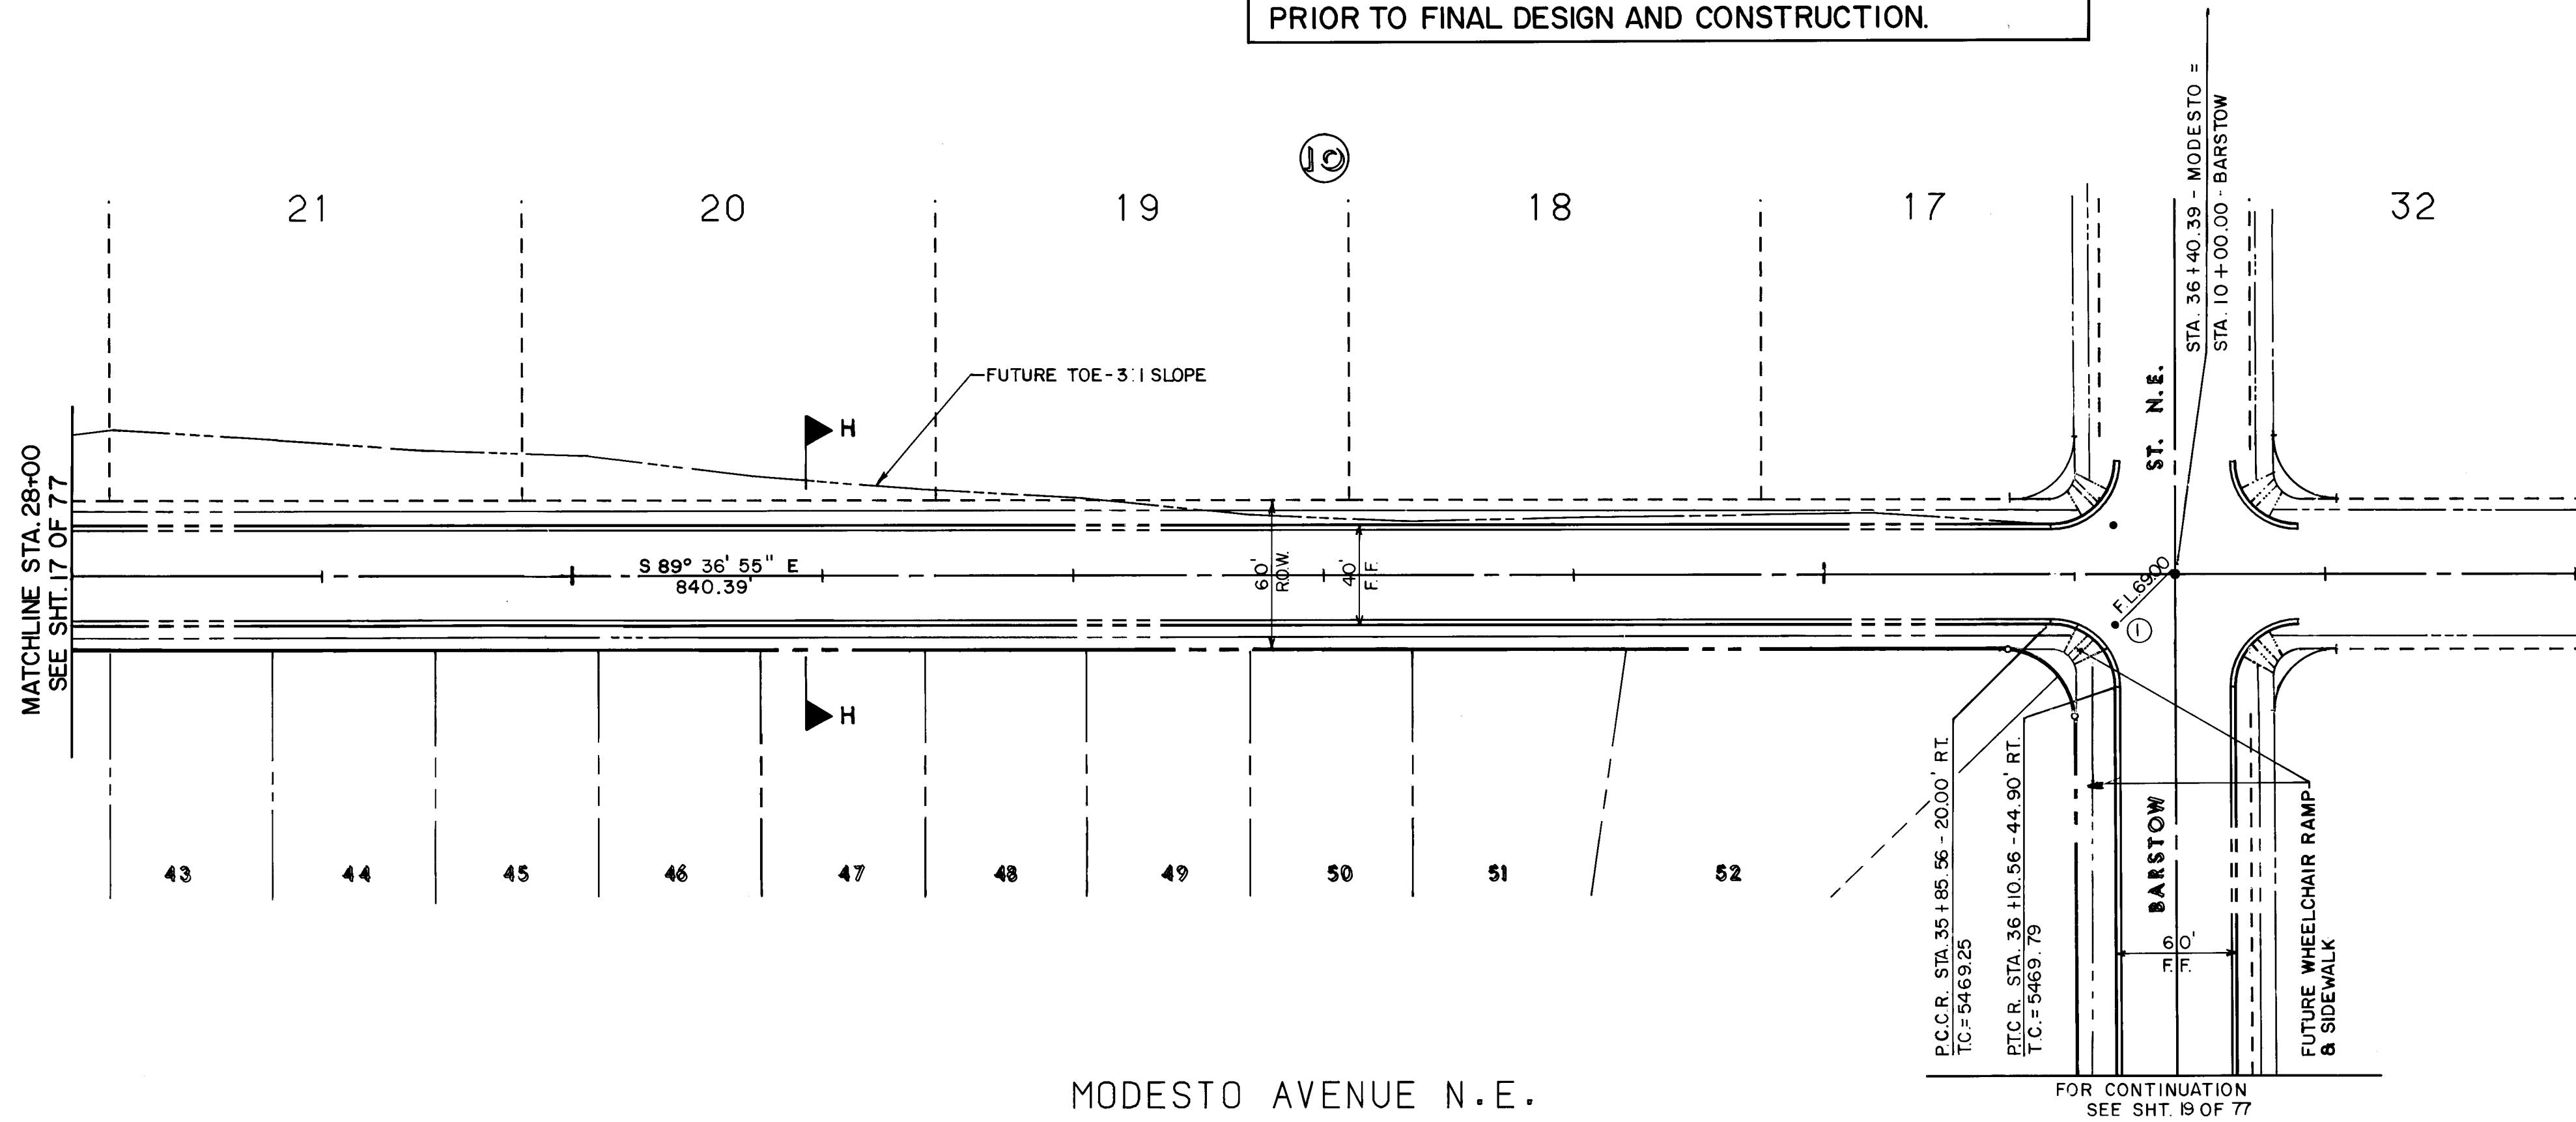

MODESTO AVENUE N.E.

FUTURE CONSTRUCTION — NOT IN CONTRACT

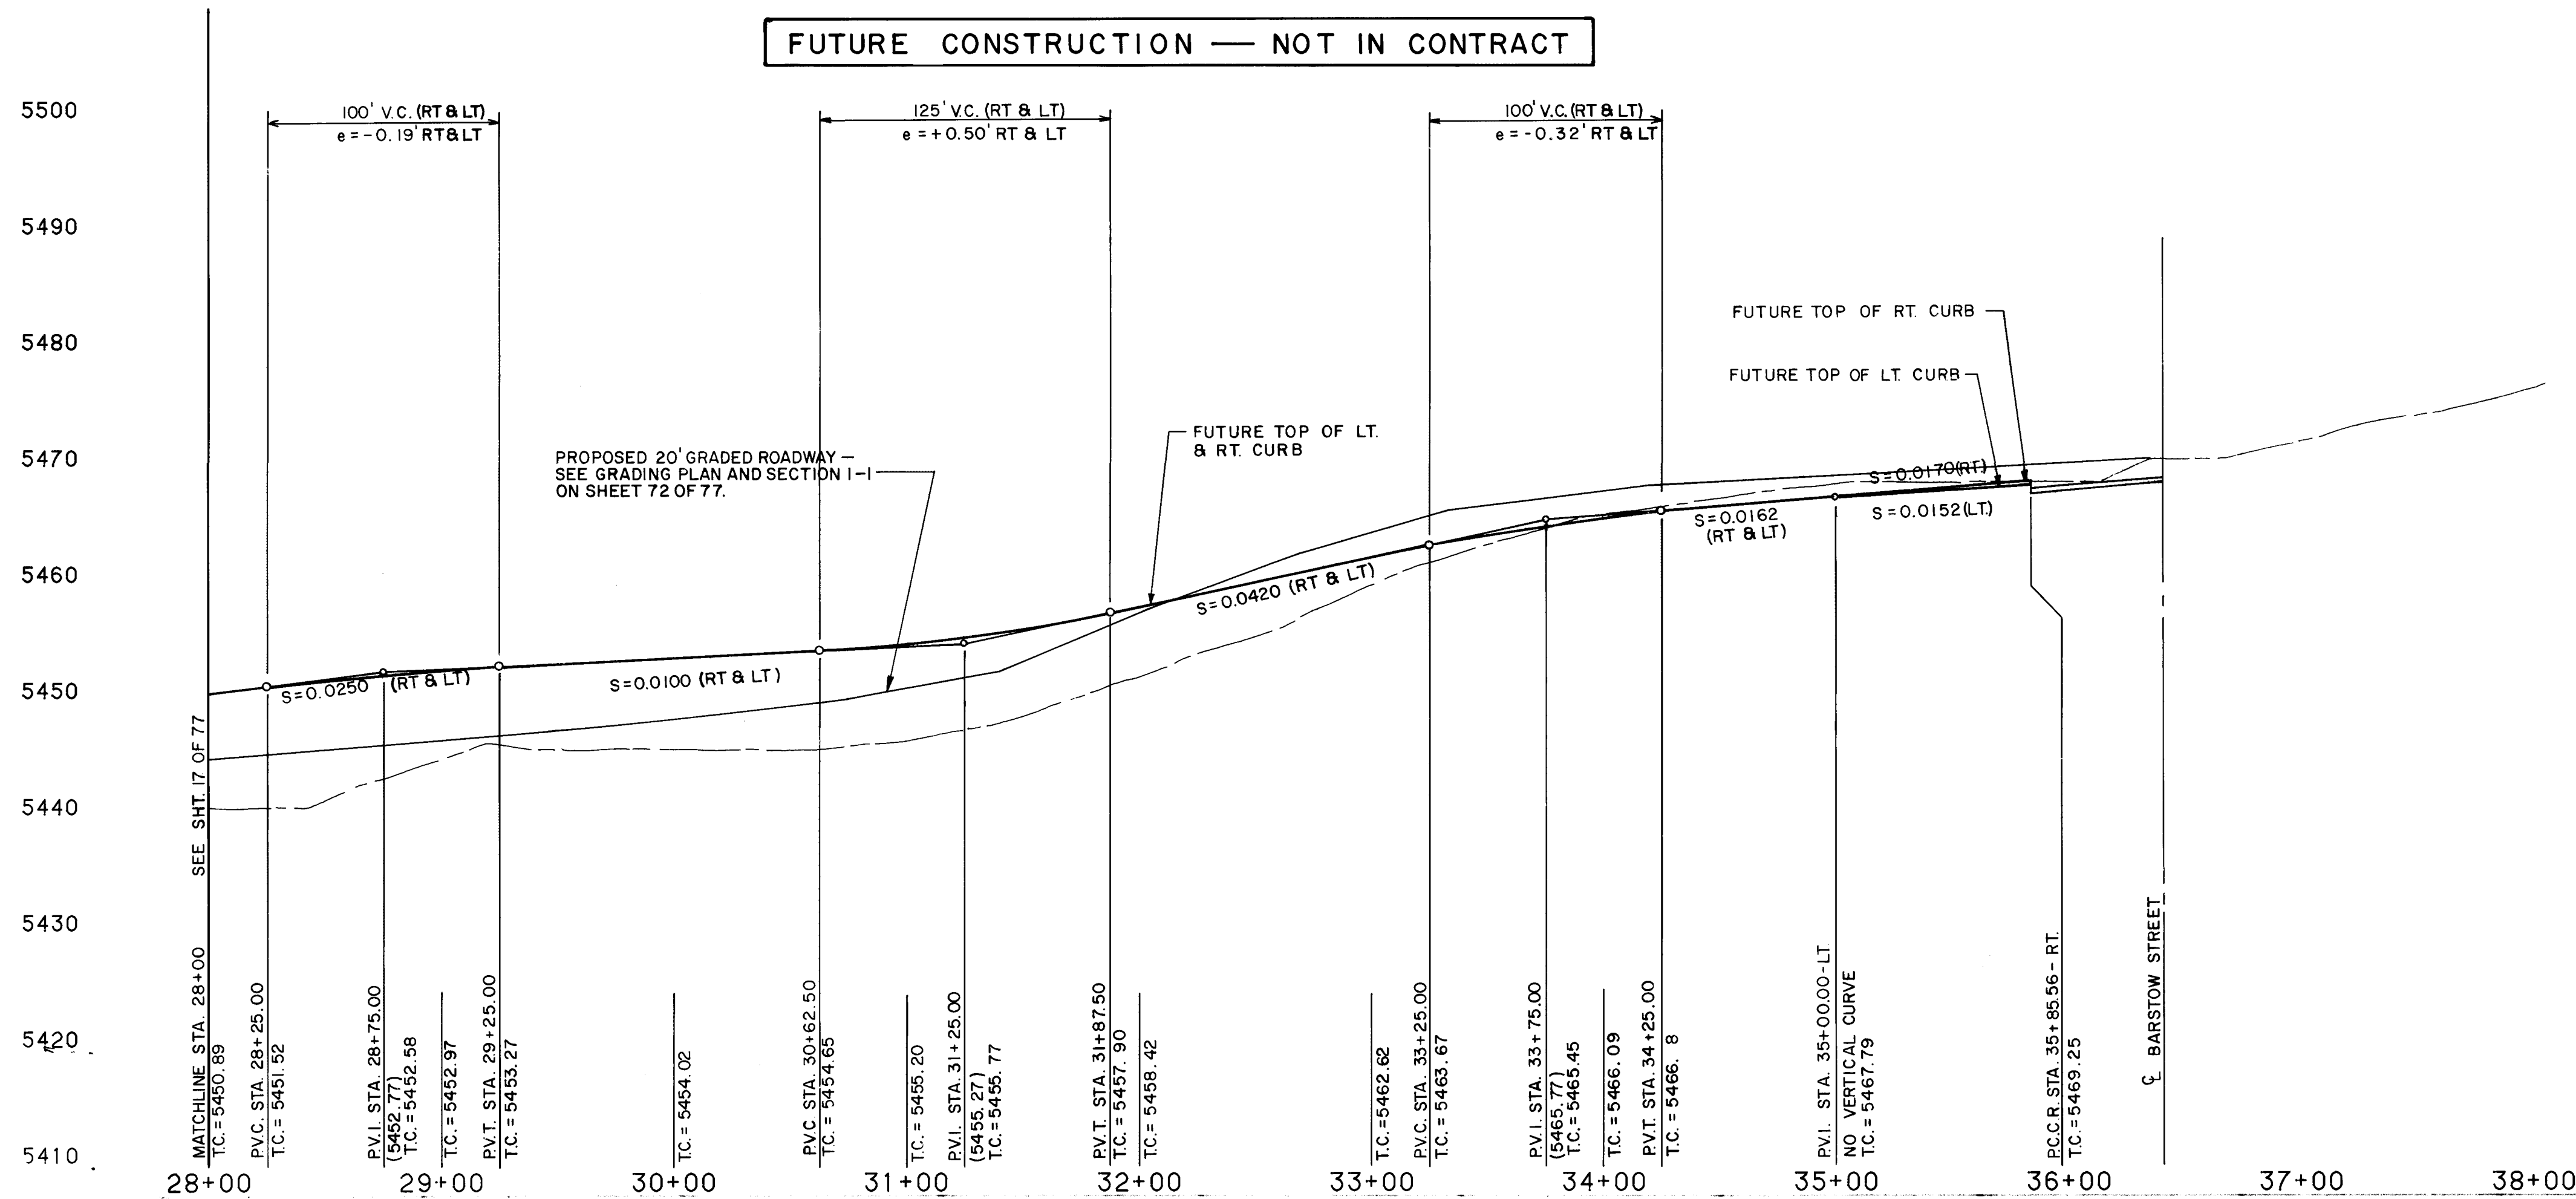

NO.	DELTA	RADIUS	LENGTH	TAN
1	89°46'11"	25.00	39.17	24.90

PAVING

- ALL STATIONING AND OFFSET DIMENSIONS ARE BASED ON CENTERLINE OF RIGHT-OF-WAY.
- THE FOLLOWING CITY OF ALBUQUERQUE STANDARD DRAWINGS ARE APPLICABLE TO THE PAVING CONSTRUCTION:

2401	2415	2422
2405	2418	2430
2407	2420	2440
2408	2421	2441

THE STATION IS LOCATED 9 MILES NORTHEAST OF DOWNTOWN ALBUQUERQUE. TO REACH THE STATION FROM THE INTERSECTION OF LOUISIANA BLVD. AND LOS ANGELES DRIVE, GO EAST ON LOS ANGELES DRIVE 10 MILES TO BARSTOW ST., THEN NORTH ON BARSTOW ST. 10 MILES TO ALAMEDA AVE. THE STATION IS LOCATED IN THE NORTHEAST QUADRANT OF THE INTERSECTION. THE STATION MARK IS A STANDARD ACS BRASS TABLET STAMPED "1-820", SET IN TOP OF A CONCRETE POST PROJECTING 0.1 FEET ABOVE GROUND.
MSL ELEVATION = 5474.33'

SCALE:
HORIZ. 1"=50'
VERT. 1"=10'


LEGEND

- EXISTING CURB & GUTTER AND SIDEWALK
- EXISTING DRIVEPADS
- EXISTING LIMITS OF ASPHALT PAVEMENT
- PROPERTY OR BOUNDARY LINE
- CENTERLINE OF STREET
- PROPOSED CURB & GUTTER
- PROPOSED SIDEWALK
- PROPOSED CONCRETE VALLEY GUTTER
- PROPOSED WHEELCHAIR RAMP
- FUTURE CURB & GUTTER
- FUTURE SIDEWALK
- FUTURE CONCRETE VALLEY GUTTER
- FUTURE WHEELCHAIR RAMP

ESPEY,
HUSTON &
ASSOCIATES, INC.
Engineering & Environmental Consultants
317 COMMERCIAL ST. N.E.
ALBUQUERQUE, NEW MEXICO 87102
PHONE: (505) 242-1909

NOR ESTE ESTATES
MODESTO AVENUE N.E.
PAVING STA. 28+00 TO STA. 38+05.39

10/5/87
David W. Hamer
DEC 9/3/87
RAB 9-1-87

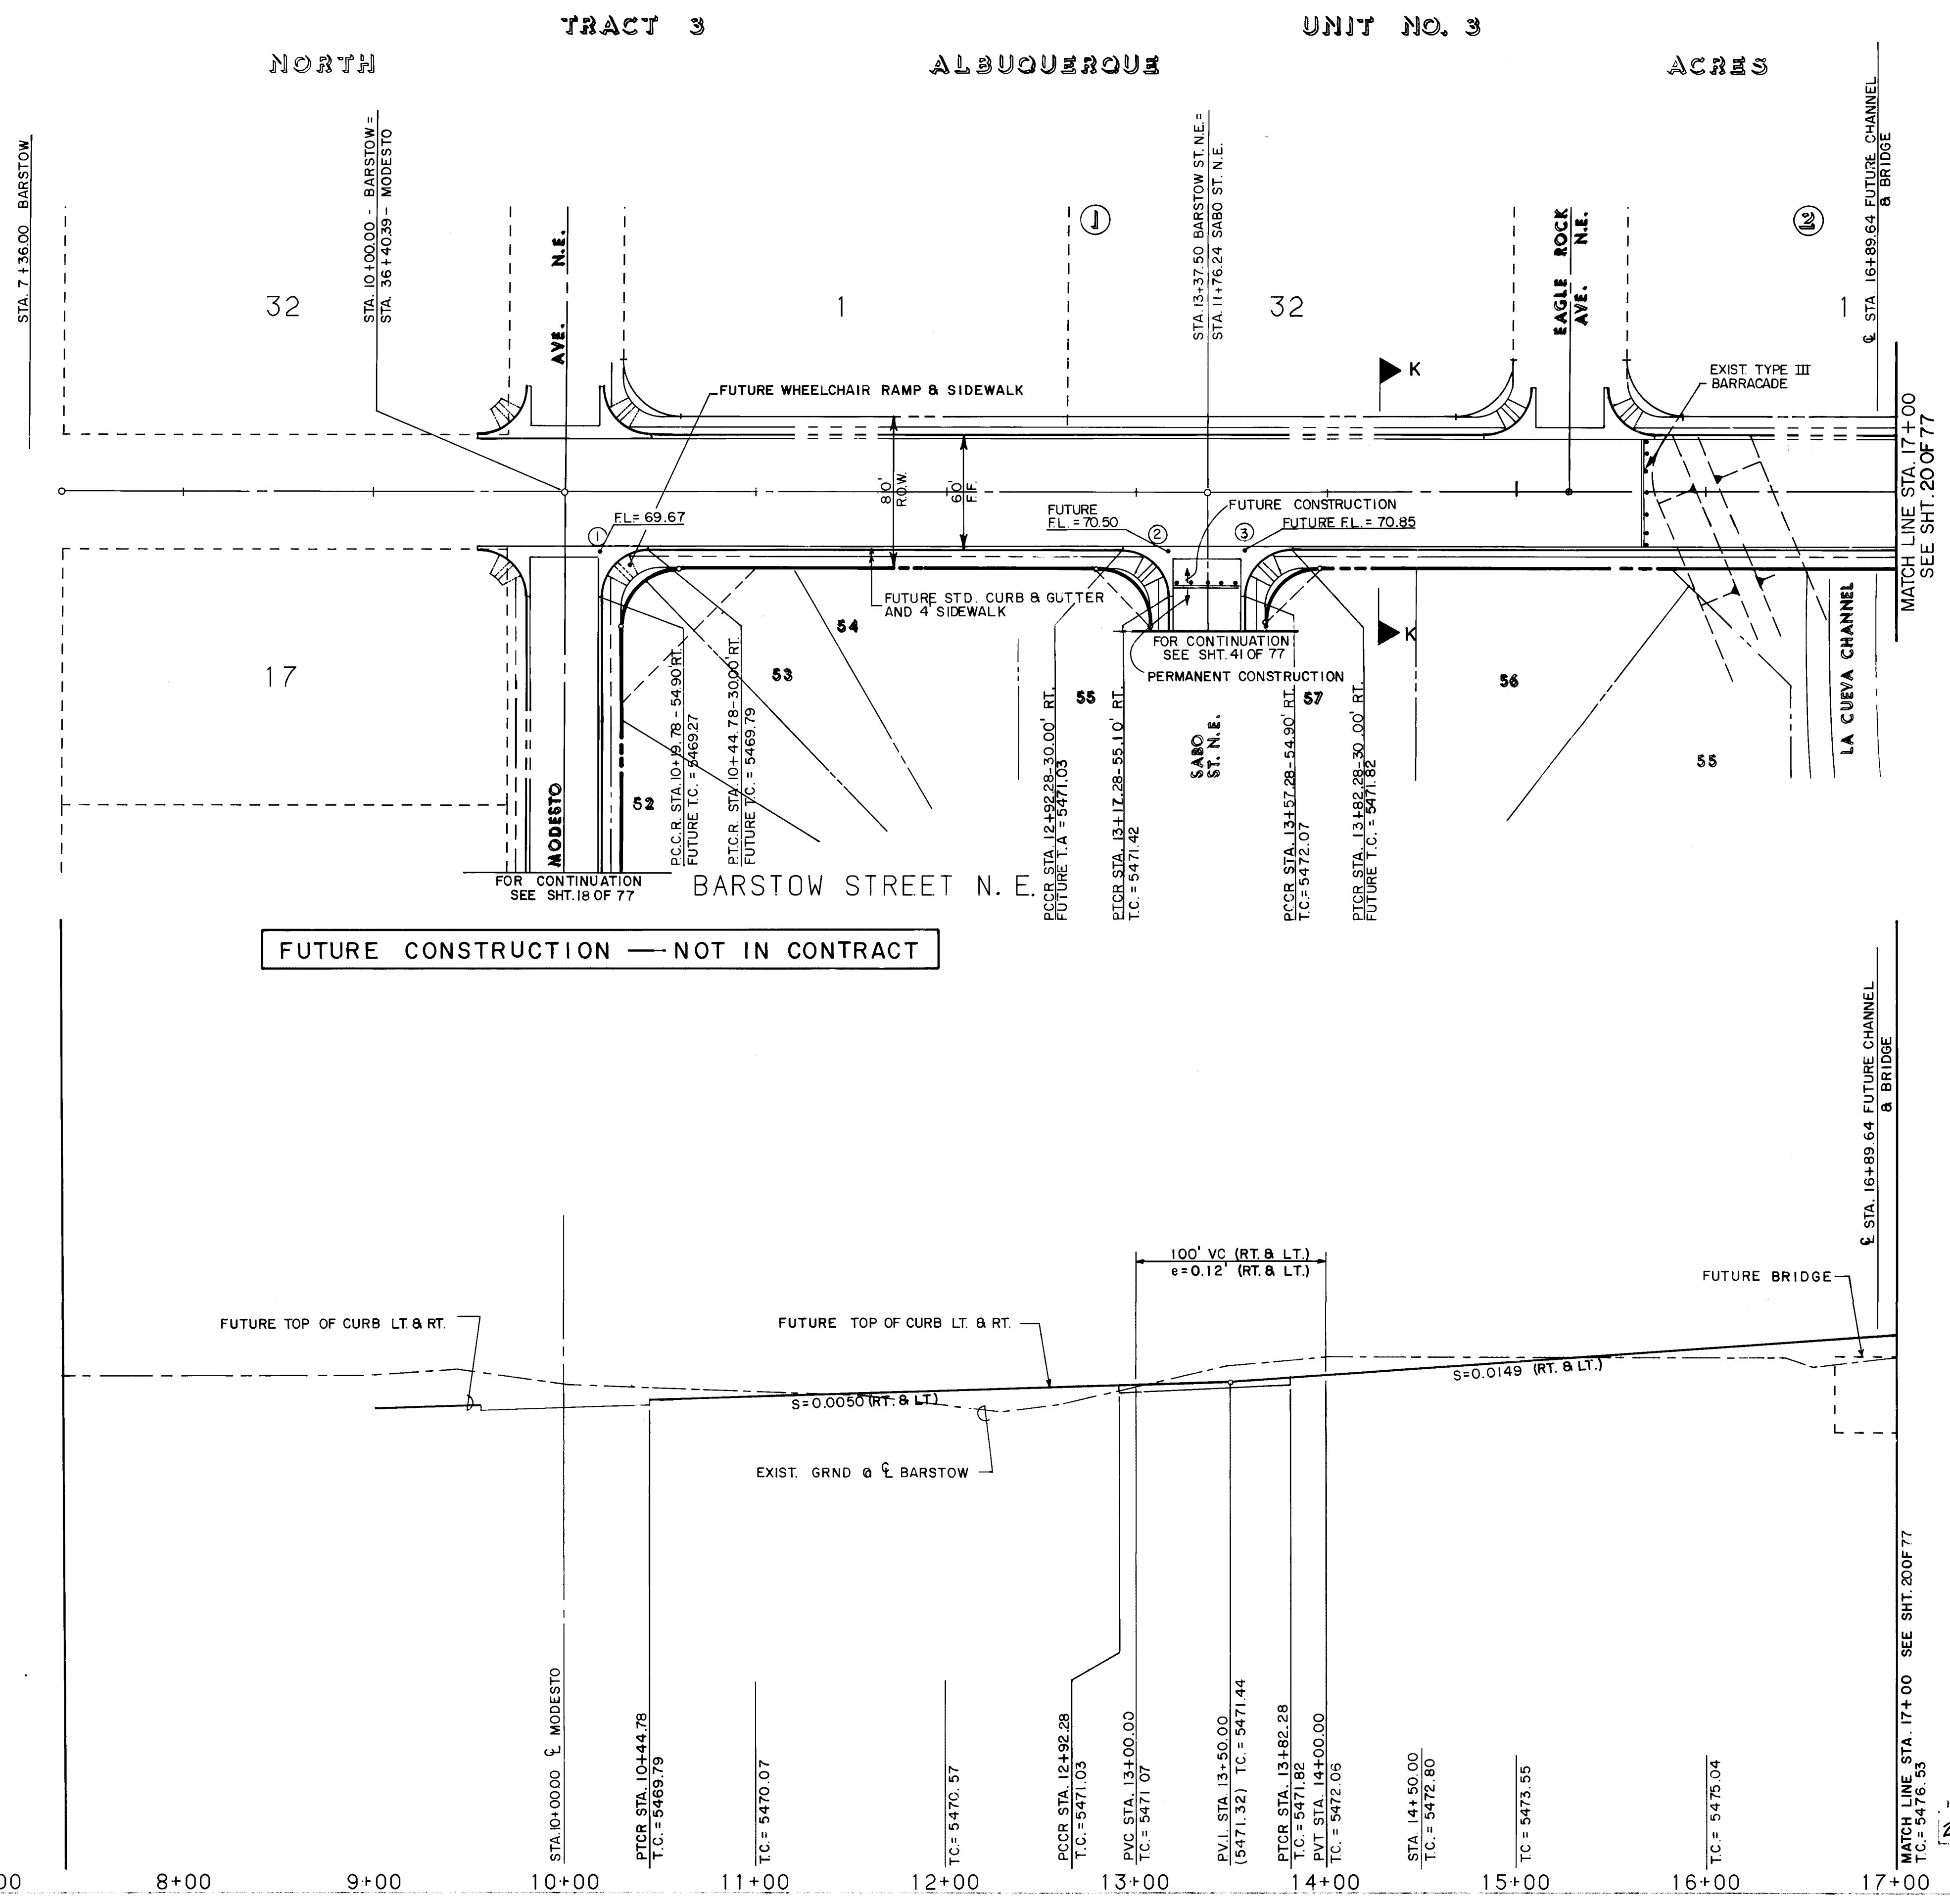

NO.	DELTA	RADIUS	LENGTH	TAN
1	89°46'11"	25.00	39.17	24.90
2	90°13'49"	25.00	39.37	25.10
3	90°13'49"	25.00	39.37	25.10
4	89°46'11"	25.00	39.17	24.90
5	89°46'11"	25.00	39.17	24.90
6	90°13'49"	25.00	39.37	25.10

- PAVING**
- ALL STATIONING AND OFFSET DIMENSIONS ARE BASED ON CENTERLINE OF RIGHT-OF-WAY.
 - THE FOLLOWING CITY OF ALBUQUERQUE STANDARD DRAWINGS ARE APPLICABLE TO THE PAVING CONSTRUCTION:
- | | | |
|------|------|------|
| 2401 | 2415 | 2422 |
| 2405 | 2418 | 2430 |
| 2407 | 2420 | 2440 |
| 2408 | 2421 | 2441 |

RECORD DRAWING

This drawing as modified shows public improvements as constructed. These modifications have been made using information and measurements obtained by EH&A's field survey crew, the Contractor and City Inspector. The modifications conform to the minimum requirements for record drawing criteria as required by the City of Albuquerque per Development Process Manual, Section 25. To the best of my knowledge and belief.

Dennis A. Lorenz
Dennis A. Lorenz P.E. 8647
Date 1-14-88

UNIVERSAL NEW CONCEPTS
EH&A
87'
89'
88'


- LEGEND**
- | | |
|-----|-------------------------------------|
| --- | EXISTING CURB & GUTTER AND SIDEWALK |
| --- | EXISTING DRIVEPADS |
| --- | EXISTING LIMITS OF ASPHALT PAVEMENT |
| --- | PROPERTY OR BOUNDARY LINE |
| --- | CENTERLINE OF STREET |
| --- | PROPOSED CURB & GUTTER |
| --- | PROPOSED SIDEWALK |
| --- | PROPOSED CONCRETE VALLEY GUTTER |
| --- | PROPOSED WHEELCHAIR RAMP |
| --- | FUTURE CURB & GUTTER |
| --- | FUTURE SIDEWALK |
| --- | FUTURE CONCRETE VALLEY GUTTER |
| --- | FUTURE WHEELCHAIR RAMP |

ESPEY, HUSTON & ASSOCIATES, INC.
Engineering & Environmental Consultants
317 COMMERCIAL ST. N.E.
ALBUQUERQUE, NEW MEXICO 87102
PHONE: (505) 242-1909


NOR ESTE ESTATES
BARSTOW STREET N.E.
PAVING - STA. 7+36 TO STA. 17+00


Handwritten notes and signatures:
10/5/87
David Hammer 7/16/87
JEE 8/2/87
H4000 H4000 9-1-87

THE STATION IS LOCATED 9 MILES NORTHEAST OF DOWNTOWN ALBUQUERQUE. TO REACH THE STATION FROM THE INTERSECTION OF LOUISIANA BLVD. AND LOS ANGELES DRIVE, GO EAST ON LOS ANGELES DRIVE 10 MILES TO BARSTOW ST., THEN NORTH ON BARSTOW ST. 1.0 MILES TO ALAMEDA AVE. THE STATION IS LOCATED IN THE NORTHEAST QUADRANT OF THE INTERSECTION. THE STATION MARK IS A STANDARD ACS BRASS TABLET STAMPED "1-820". SET IN TOP OF A CONCRETE POST PROJECTING 0.1 FEET ABOVE GROUND.
MSL ELEVATION - 5474.53'

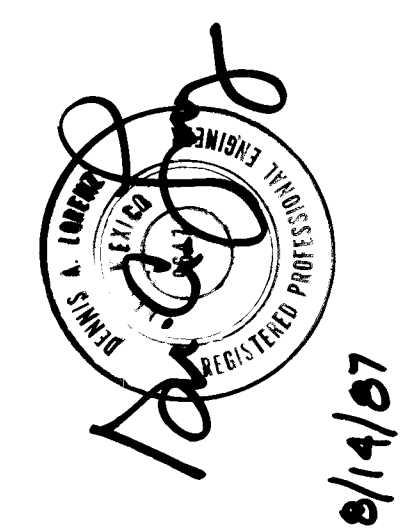

Handwritten notes:
8/14/87
8/2/87
8/2/87
JTB MC DAL

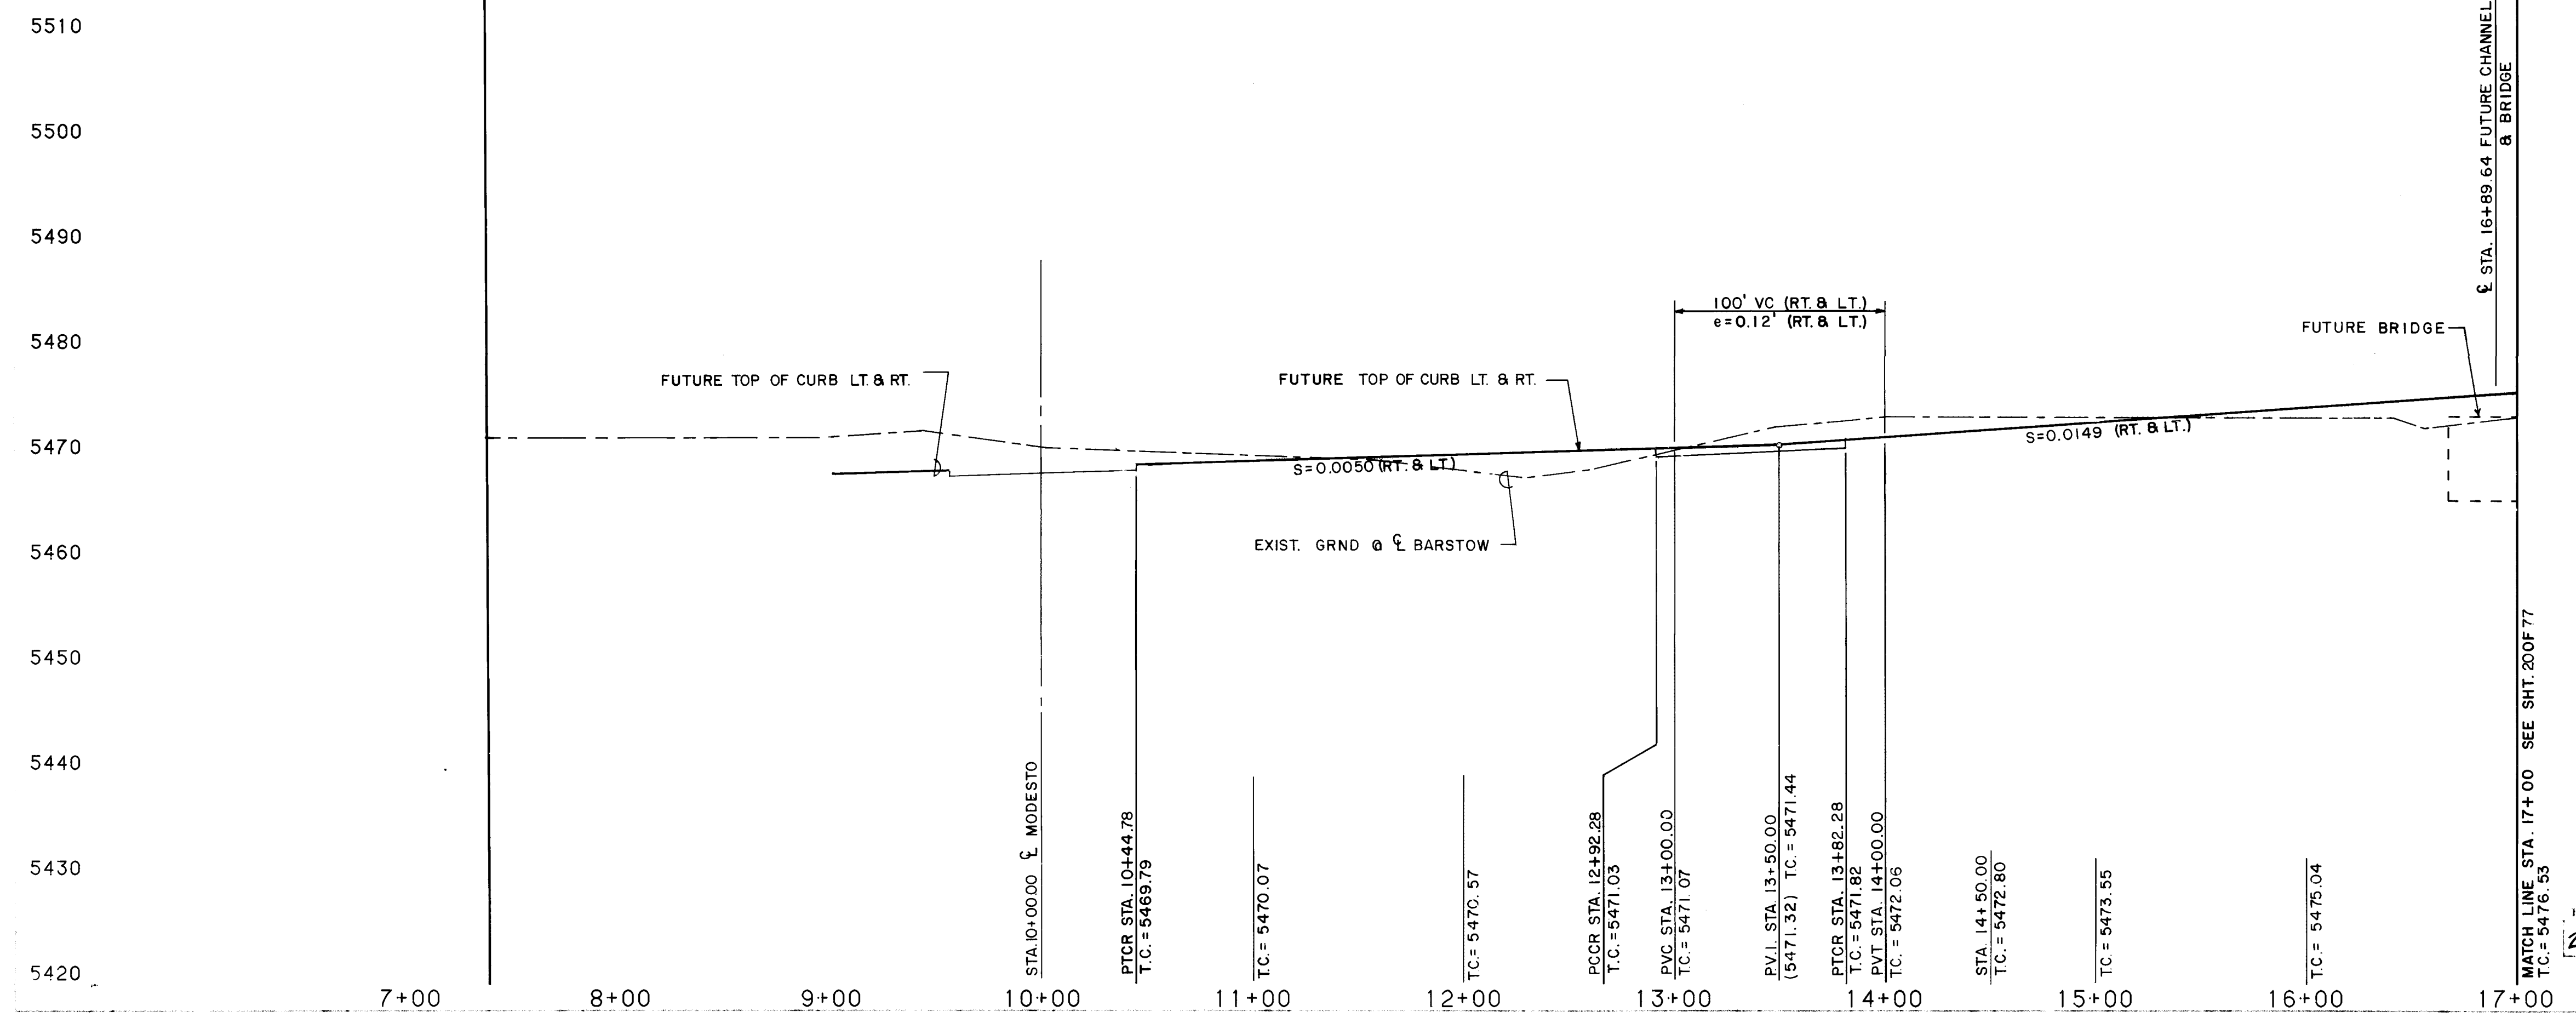

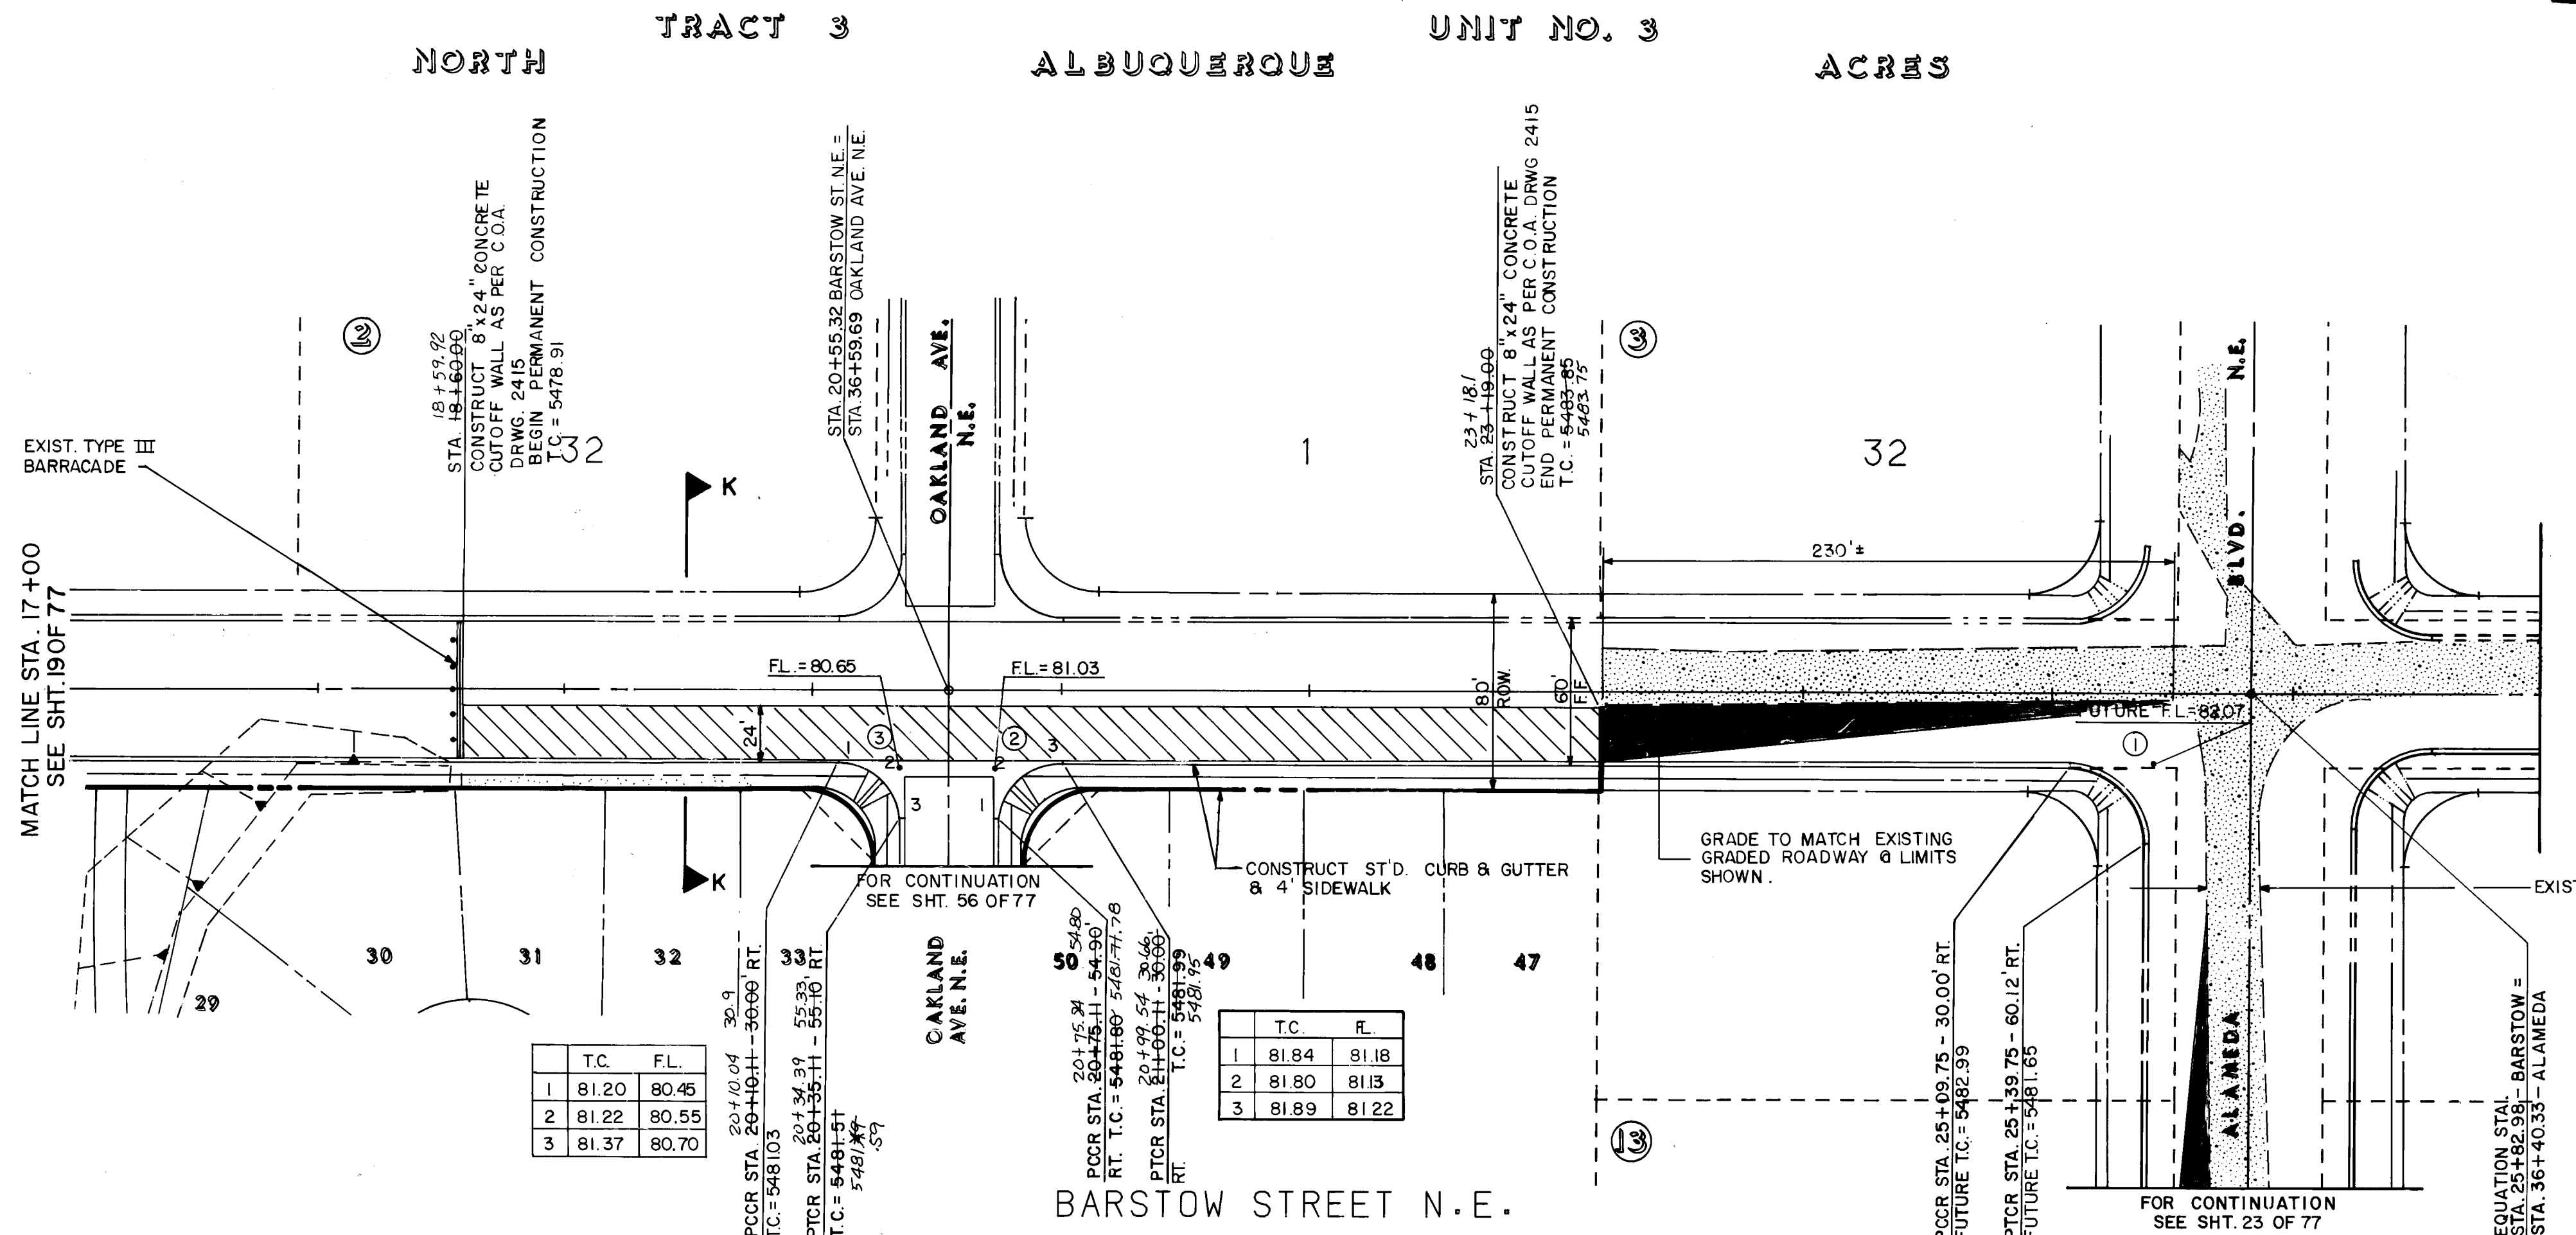

NO.	DELTA	RADIUS	LENGTH	TAN
1	4°26'21"	1000.00	77.48	38.76
2	4°26'21"	1000.00	77.48	38.76
3	89°46'11"	25.00	39.17	24.90
4	90°13'49"	25.00	39.37	25.10

PAVING

- ALL STATIONING AND OFFSET DIMENSIONS ARE BASED ON CENTERLINE OF RIGHT-OF-WAY.
- THE FOLLOWING CITY OF ALBUQUERQUE STANDARD DRAWINGS ARE APPLICABLE TO THE PAVING CONSTRUCTION:

2401	2415	2422
2405	2418	2430
2407	2420	2440
2408	2421	2441

RECORD DRAWING


This drawing as modified shows public improvements as constructed. These modifications have been made using information and measurements obtained by E&H's field survey crew, the Contractor and City Inspector. The modifications conform to the minimum requirements for record drawing criteria as required by the City of Albuquerque. The best of my knowledge and belief.

Dennis A. Lorenz
Dennis A. Lorenz P.E. 3647

Dr. C. J. Lopez
Date 11-14-88

LEGEND


- SCALE:
HORIZ. 1" = 50'
VERT. 1" = 10'
- EXISTING CURB & GUTTER AND SIDEWALK
 - EXISTING DRIVEPADS
 - EXISTING LIMITS OF ASPHALT PAVEMENT
 - PROPERTY OR BOUNDARY LINE
 - CENTERLINE OF STREET
 - PROPOSED CURB & GUTTER
 - PROPOSED SIDEWALK
 - PROPOSED CONCRETE VALLEY GUTTER
 - PROPOSED WHEELCHAIR RAMP
 - FUTURE CURB & GUTTER
 - FUTURE SIDEWALK
 - FUTURE CONCRETE VALLEY GUTTER
 - FUTURE WHEELCHAIR RAMP
 - NEW ARTERIAL PAVING

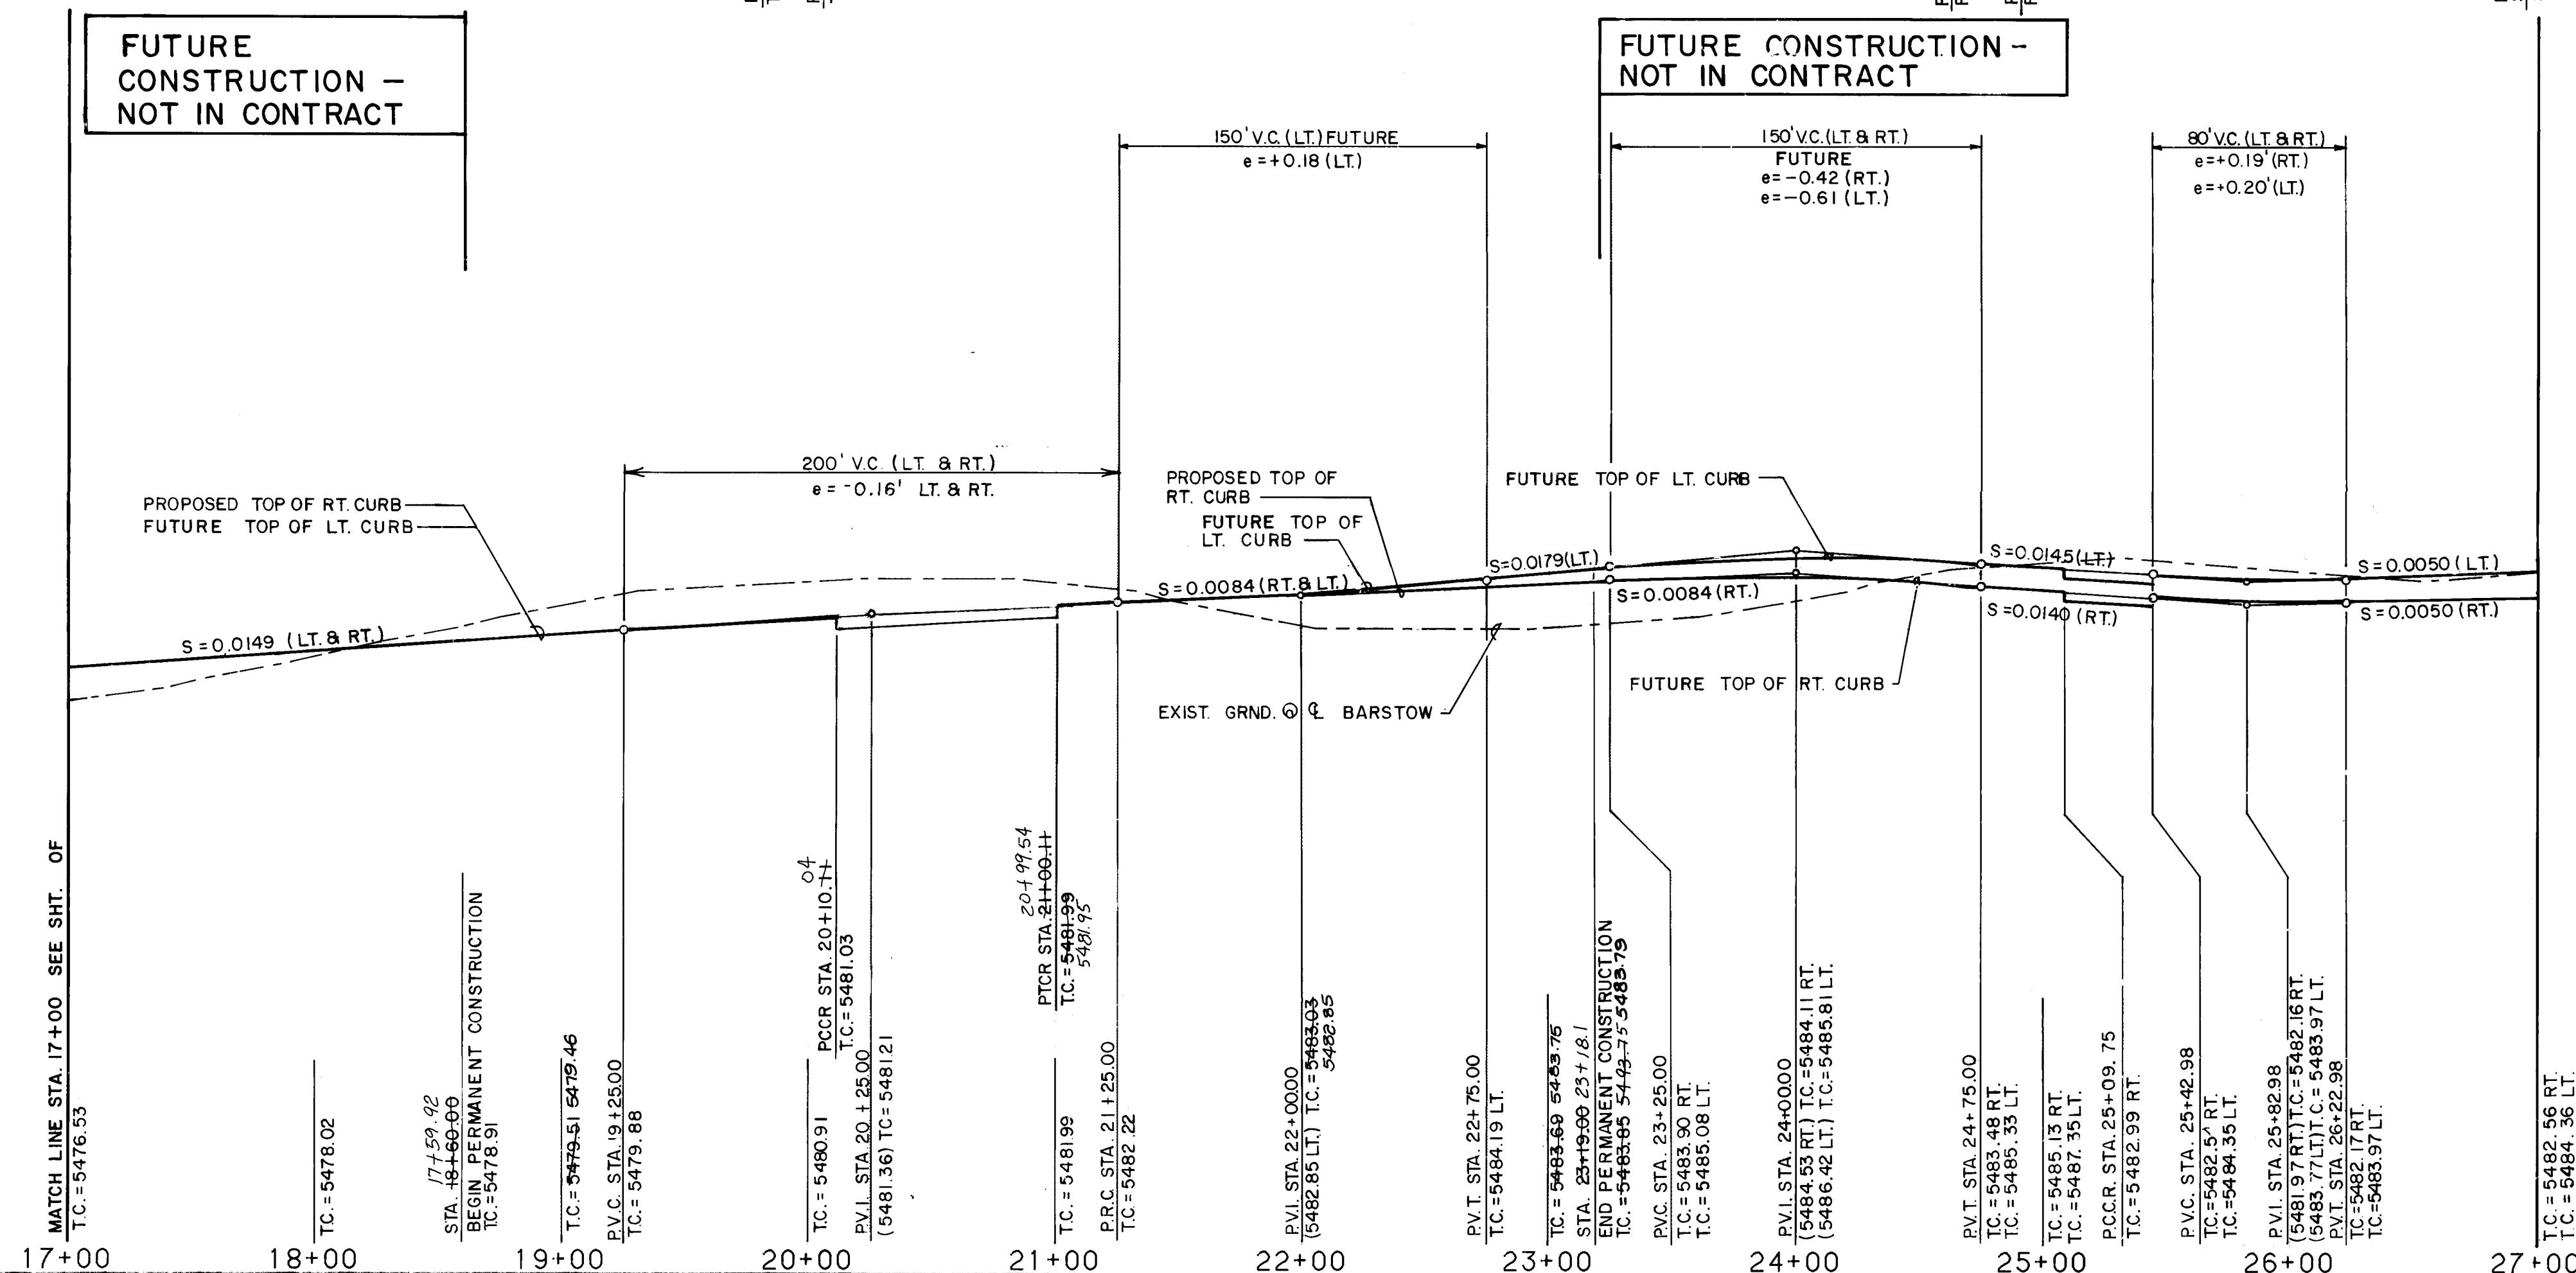

ESPEY,
HUSTON &
ASSOCIATES, INC.
Engineering & Environmental Consultants
317 COMMERCIAL ST. N.E.
ALBUQUERQUE, NEW MEXICO 87102
PHONE: (505) 242-1909

NOR ESTE ESTATES
BARSTOW STREET N.E.
PAVING - STA 17+00 TO STA. 27+00

And H. Lopez
Dennis A. Lorenz
Hydro
1/4 RAB
9.1.87

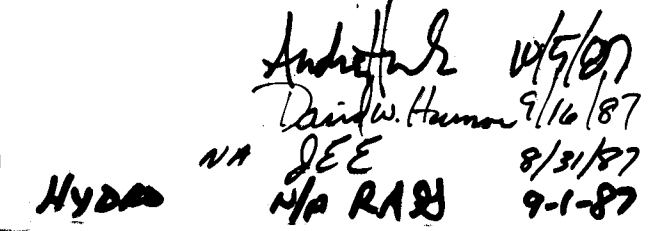

NEW CONCEPTS



EH 9A '87,'88

EH 9A '88

EH 9A '88

QUE. TO REACH THE STATION FROM THE INTERSECTION OF LOUISIANA
BLVD. AND LOS ANGELES DRIVE, GO EAST ON LOS ANGELES DRIVE 10 MILES
TO BARNSTOW ST., THEN NORTH ON BARNSTOW ST. 1.0 MILES TO ALAMEDA
AVE. THE STATION IS LOCATED IN THE NORTHEAST QUADRANT OF THE
INTERSECTION. THE STATION MARK IS A STANDARD ACS BRASS TABLET
STAMPED "1-820", SET IN TOP OF A CONCRETE POST PROJECTING
0.1 FEET ABOVE GROUND.
MSLD ELEVATION = 5474.53'

55

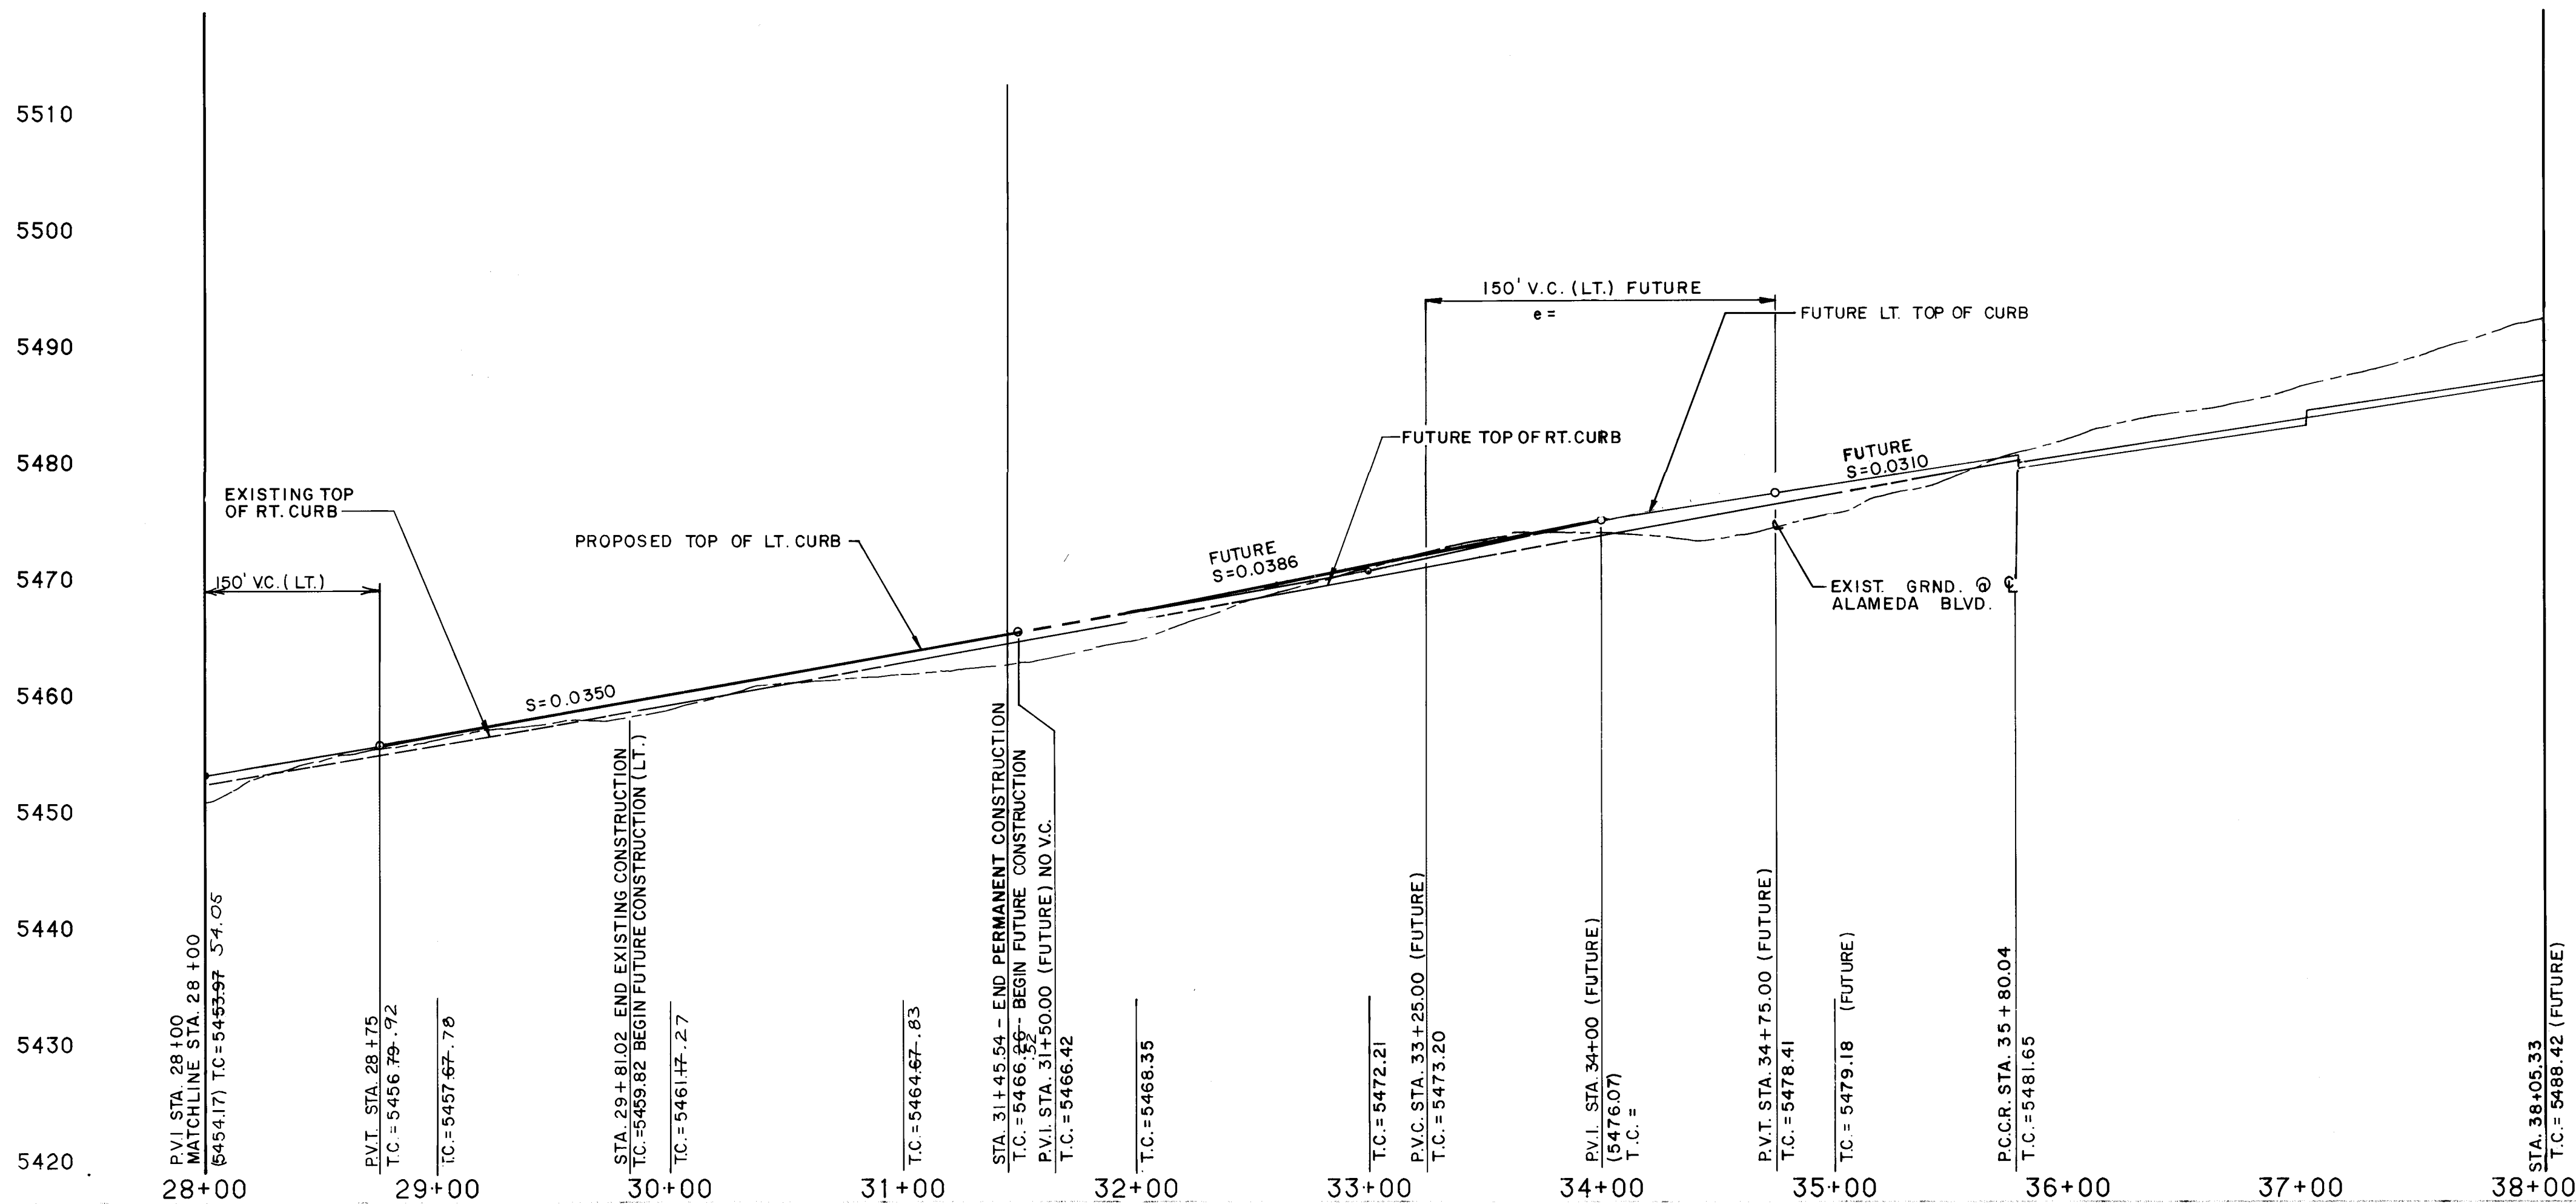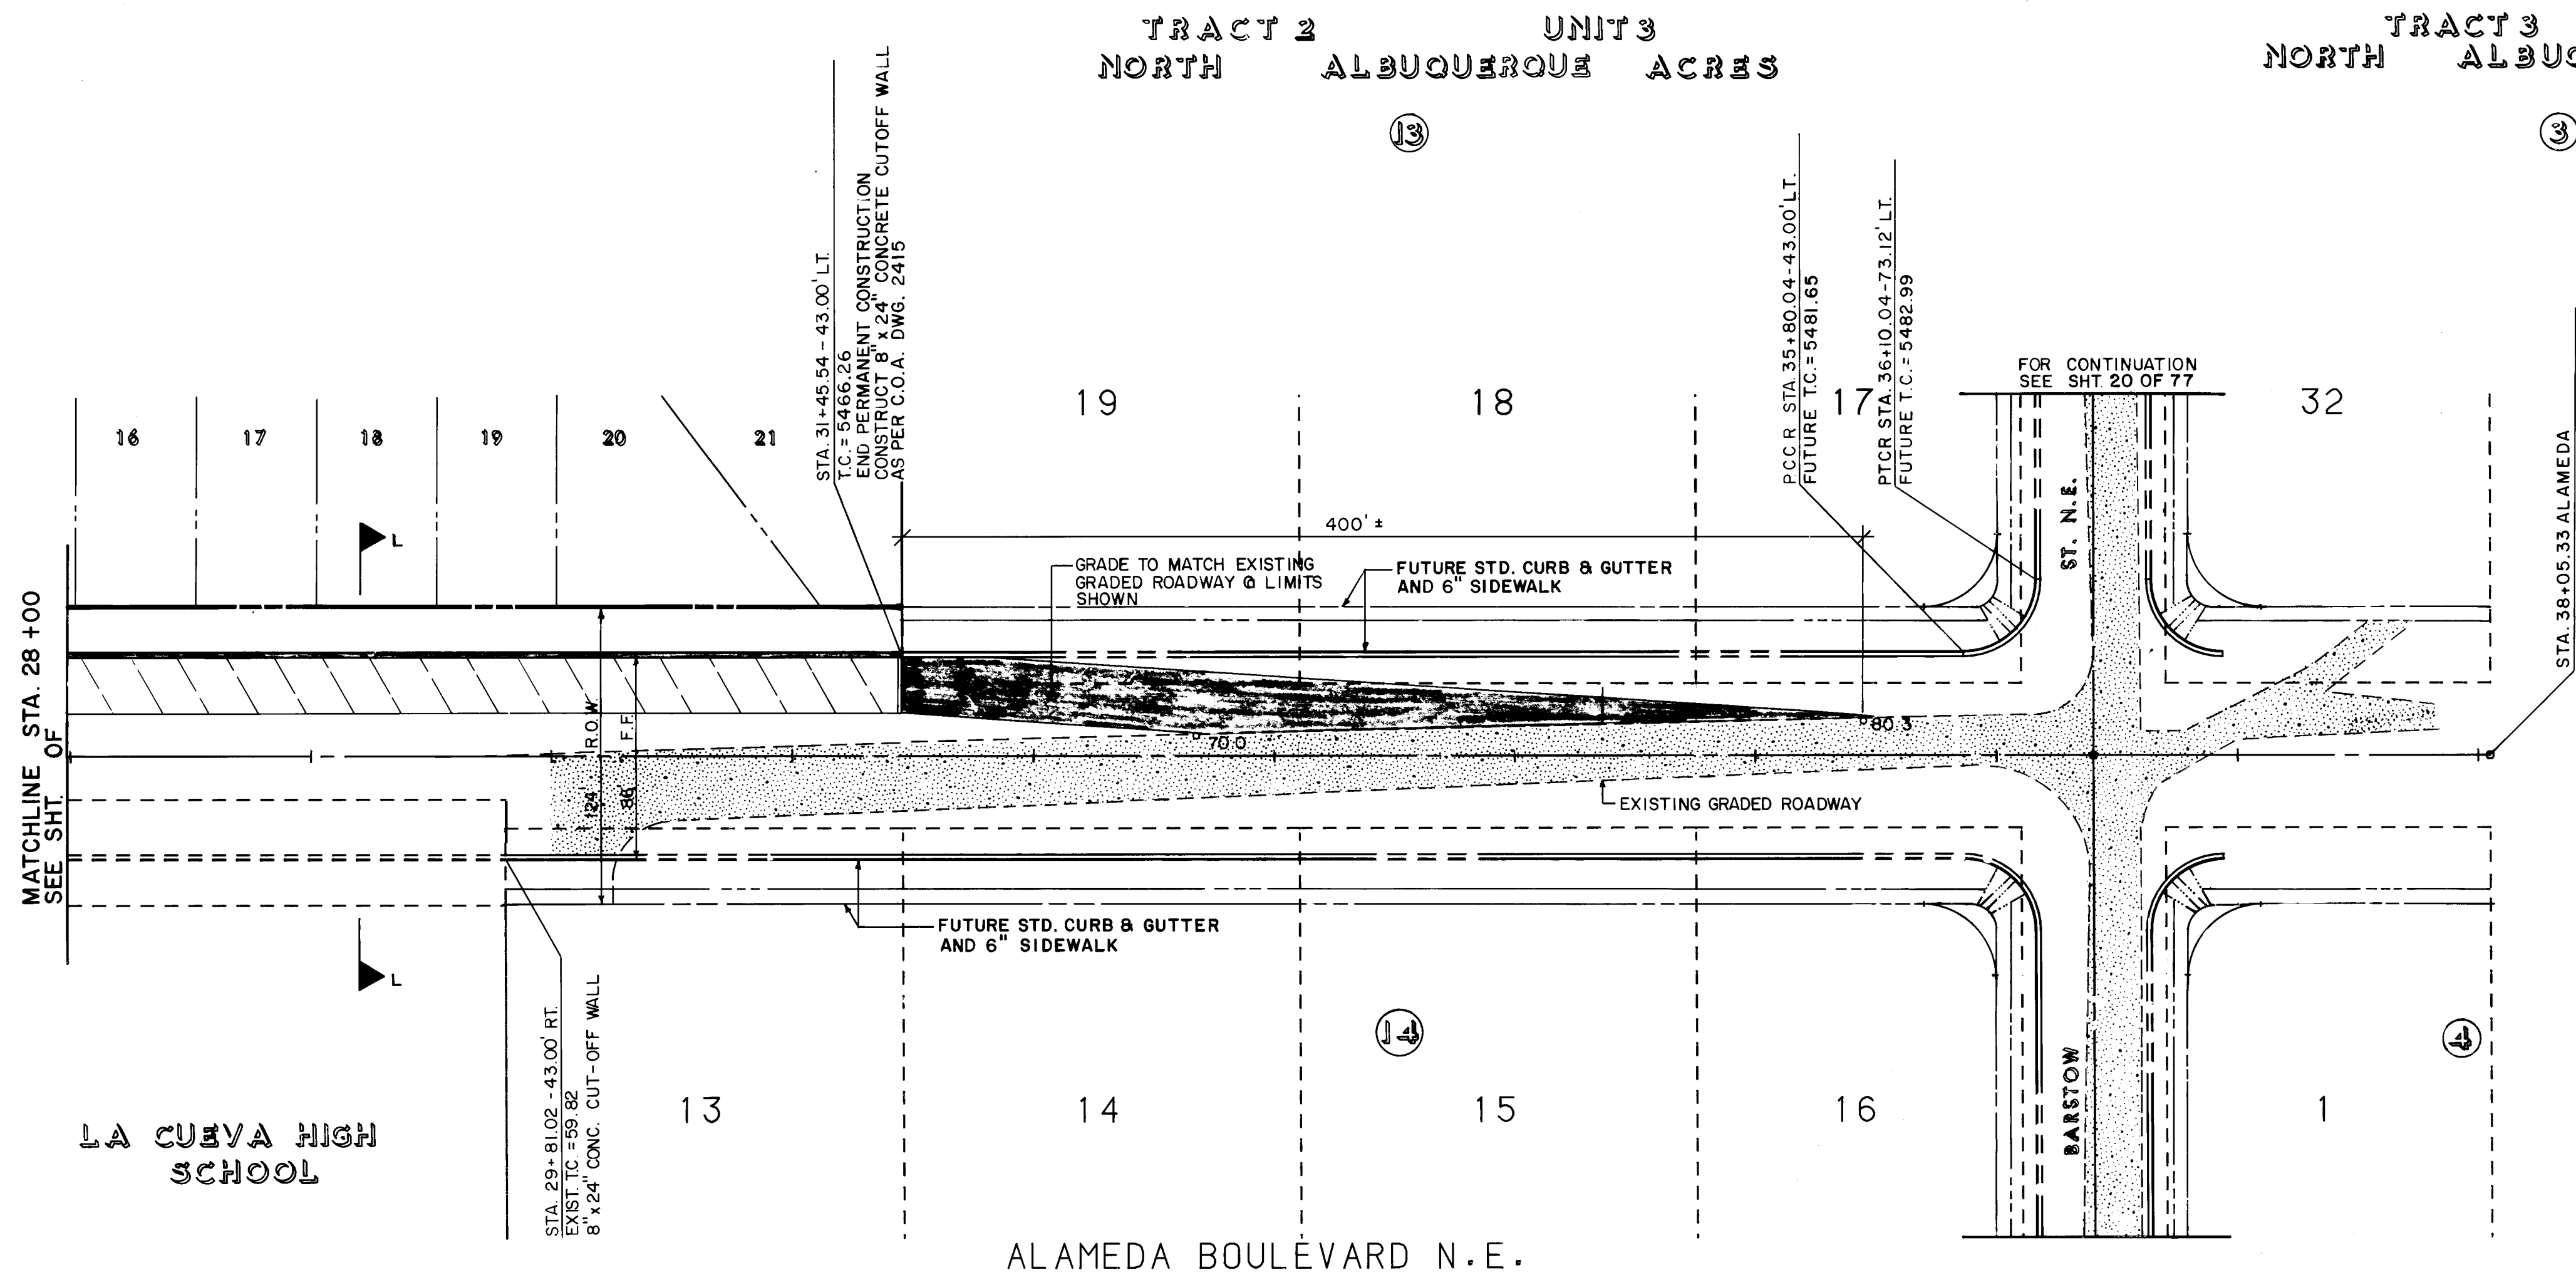

RECORD DRAWING

This drawing as modified shows public improvements as constructed. These modifications have been made using information and measurements obtained by EHA's field survey crew, the Contractor and City Inspector. The modifications are made to the original drawing to reflect the actual construction. The Engineer's Office is not responsible for the accuracy of the original drawing or the field survey. The Engineer's Office is not responsible for the accuracy of the original drawing or the field survey. The Engineer's Office is not responsible for the accuracy of the original drawing or the field survey.

Date: 8-14-88

Dennis A. Lorenz P.E.

PAVING

- ALL STATIONING AND OFFSET DIMENSIONS ARE BASED ON CENTERLINE OF RIGHT-OF-WAY.
- THE FOLLOWING CITY OF ALBUQUERQUE STANDARD DRAWINGS ARE APPLICABLE TO THE PAVING CONSTRUCTION:

2401	2415	2422
2405	2418	2430
2407	2420	2440
2408	2421	2441

LEGEND

SCALE:
HORIZ. 1"= 50'
VERT. 1"= 10'

- EXISTING CURB & GUTTER AND SIDEWALK
- EXISTING DRIVEPADS
- EXISTING LIMITS OF ASPHALT PAVEMENT
- PROPERTY OR BOUNDARY LINE
- CENTERLINE OF STREET
- PROPOSED CURB & GUTTER
- PROPOSED SIDEWALK
- PROPOSED CONCRETE VALLEY GUTTER
- PROPOSED WHEELCHAIR RAMP
- FUTURE CURB & GUTTER
- FUTURE SIDEWALK
- FUTURE CONCRETE VALLEY GUTTER
- FUTURE WHEELCHAIR RAMP

ESPEY, HUSTON & ASSOCIATES, INC.
Engineering & Environmental Consultants
317 COMMERCIAL ST. N.E.
ALBUQUERQUE, NEW MEXICO 87102
PHONE: (505) 242-1909

NOR ESTE ESTATES
ALAMEDA BOULEVARD N.E.
PAVING STA. 28+00 TO STA. 38+05.33

Hydro NA 10/5/87
DEE 9/16/87
N/A RAB 8/21/87
9-1-87


THE STATION IS LOCATED 9 MILES NORTHEAST OF DOWNTOWN ALBUQUERQUE. TO REACH THE STATION FROM THE INTERSECTION OF LOUISIANA BLVD. AND LOS ANGELES DRIVE, GO EAST ON LOS ANGELES DRIVE 10 MILES TO BARSTOW ST., THEN NORTH ON BARSTOW ST. 1.0 MILES TO ALAMEDA AVE. THE STATION IS LOCATED IN THE NORTHEAST QUADRANT OF THE INTERSECTION. THE STATION MARK IS A STANDARD ACS BRASS TABLET STAMPED "1-B20", SET IN TOP OF A CONCRETE POST PROJECTING 0.1 FEET ABOVE GROUND. MSLD ELEVATION = 5474.53'

NEW CONCEPTS
EH 1A '82, '88
EH 1A '88
EH 1A '88


RECORD DRAWING
This drawing as modified shows public improvements as shown on the plan and profile views. The information and measurements obtained by EMM's field survey crew, the Contractor and City Inspectors, the modifications conform to the minimum standards of the record drawing Development Process Manual, Section 27, to the best of my knowledge and belief.
Dennis A. Lorenz P.E. 8/17/88
Date

5430
5420
5410
5400
5390
5380
5370
5360
5350
5340

7+00 8+00 9+00 10+00 11+00 12+00 13+00 14+00 15+00 16+00 17+00

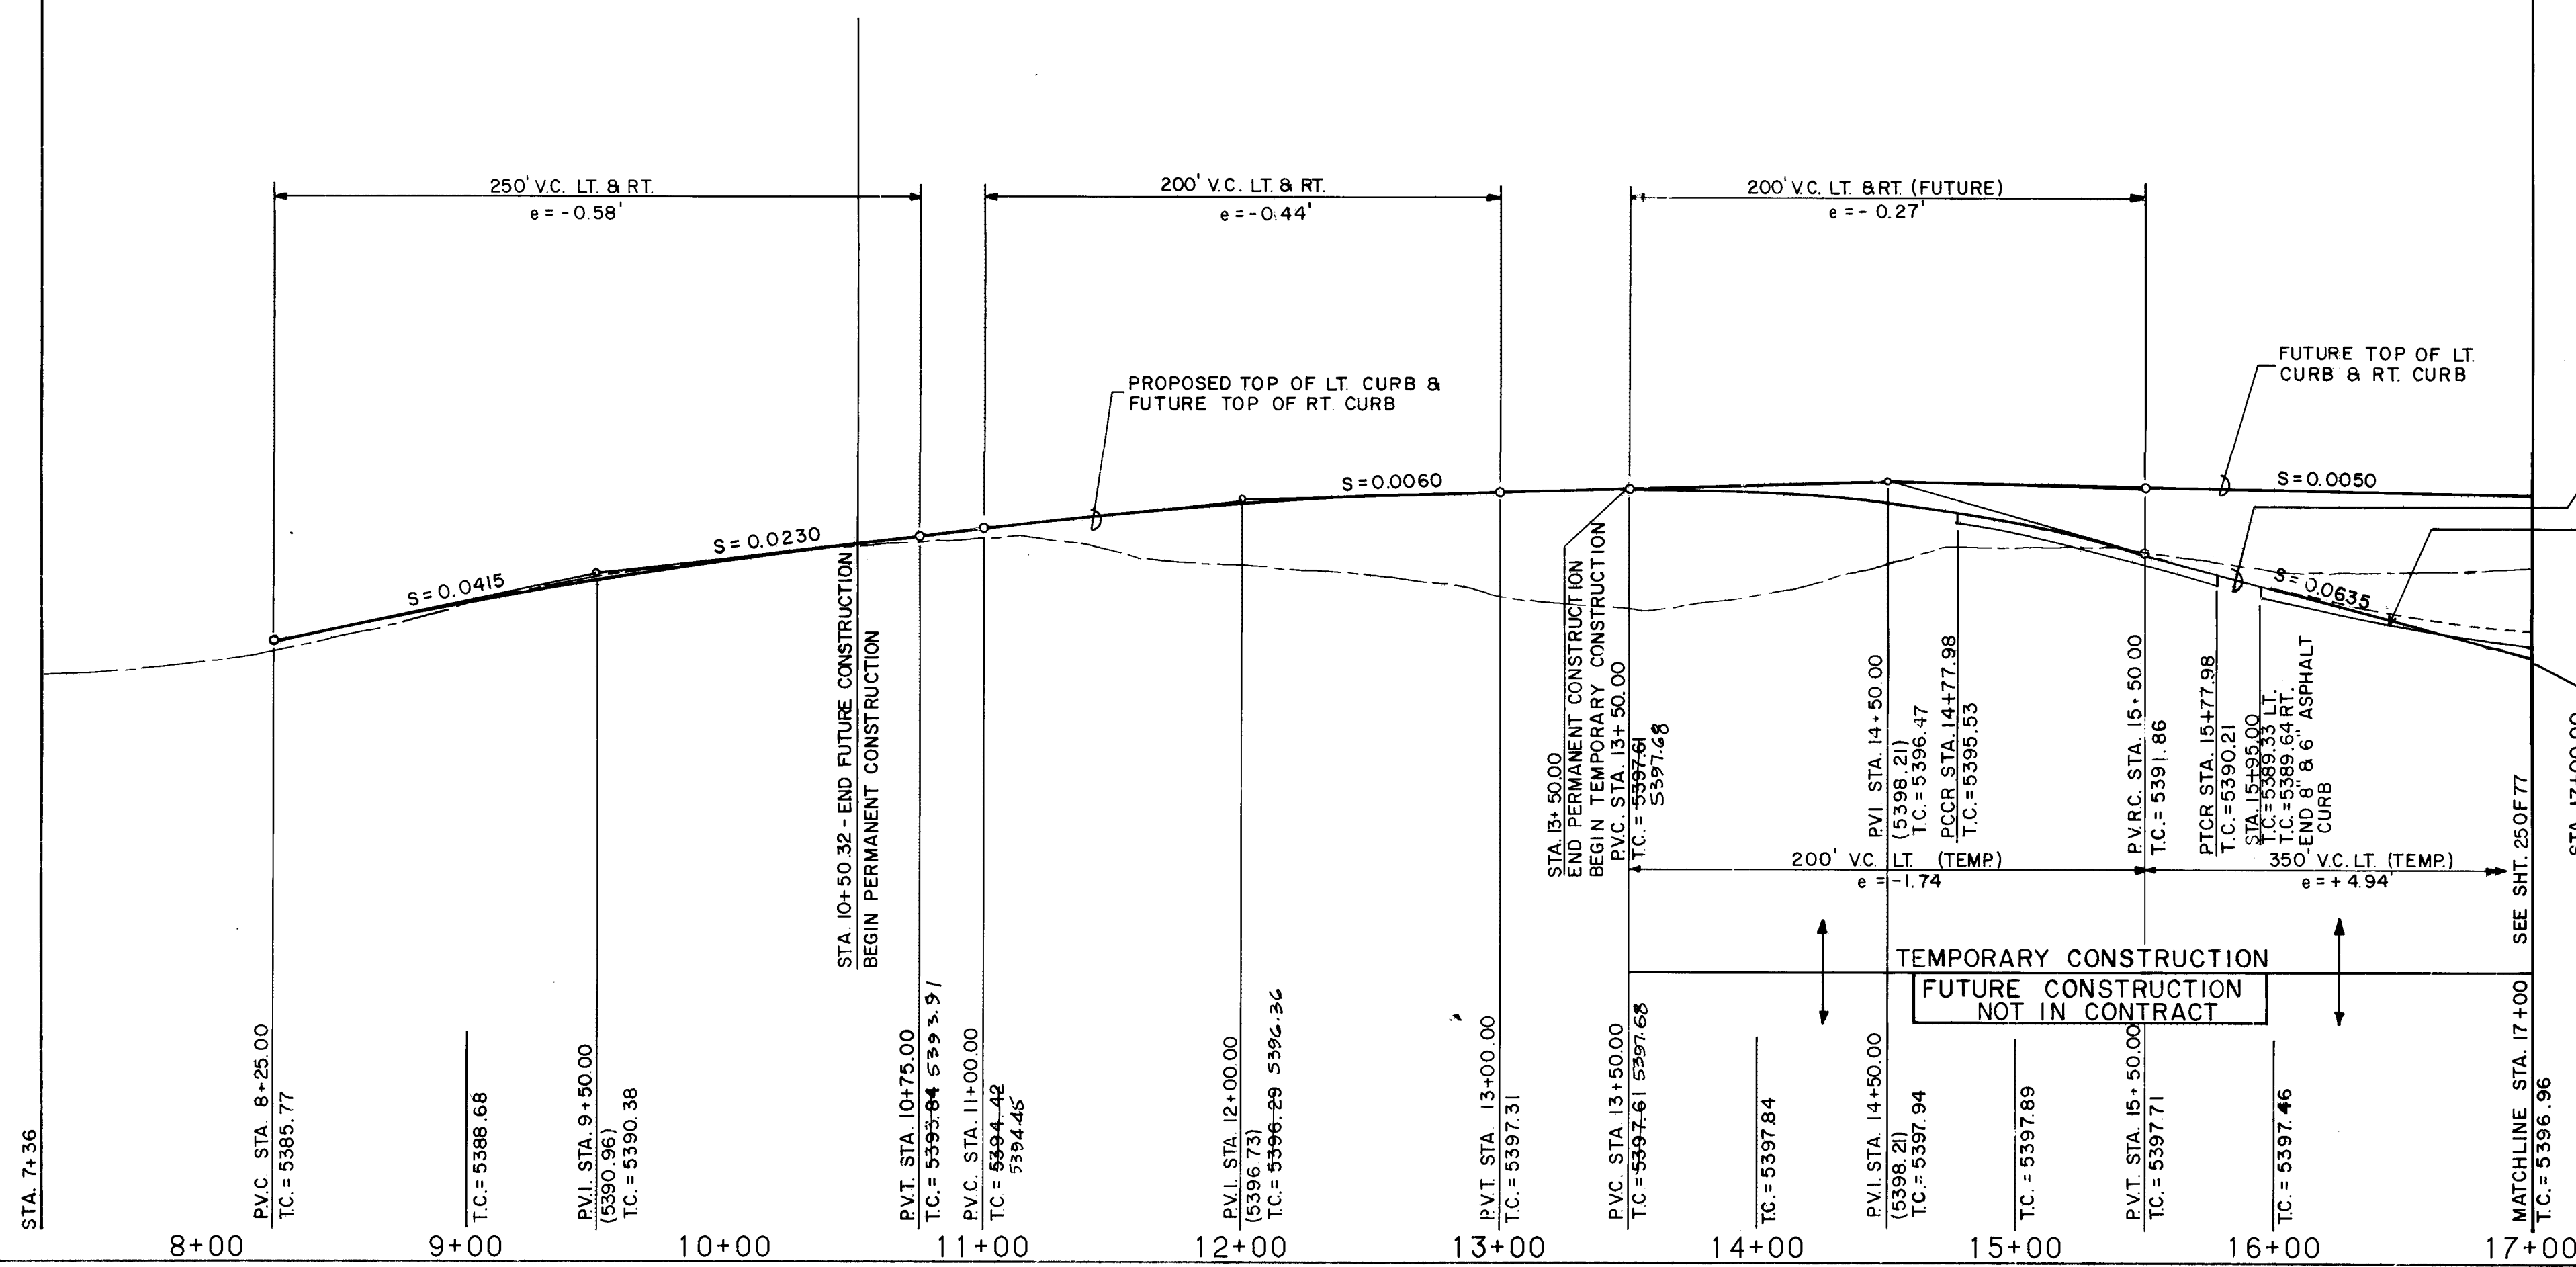

STA 7+36.00 - WYOMING

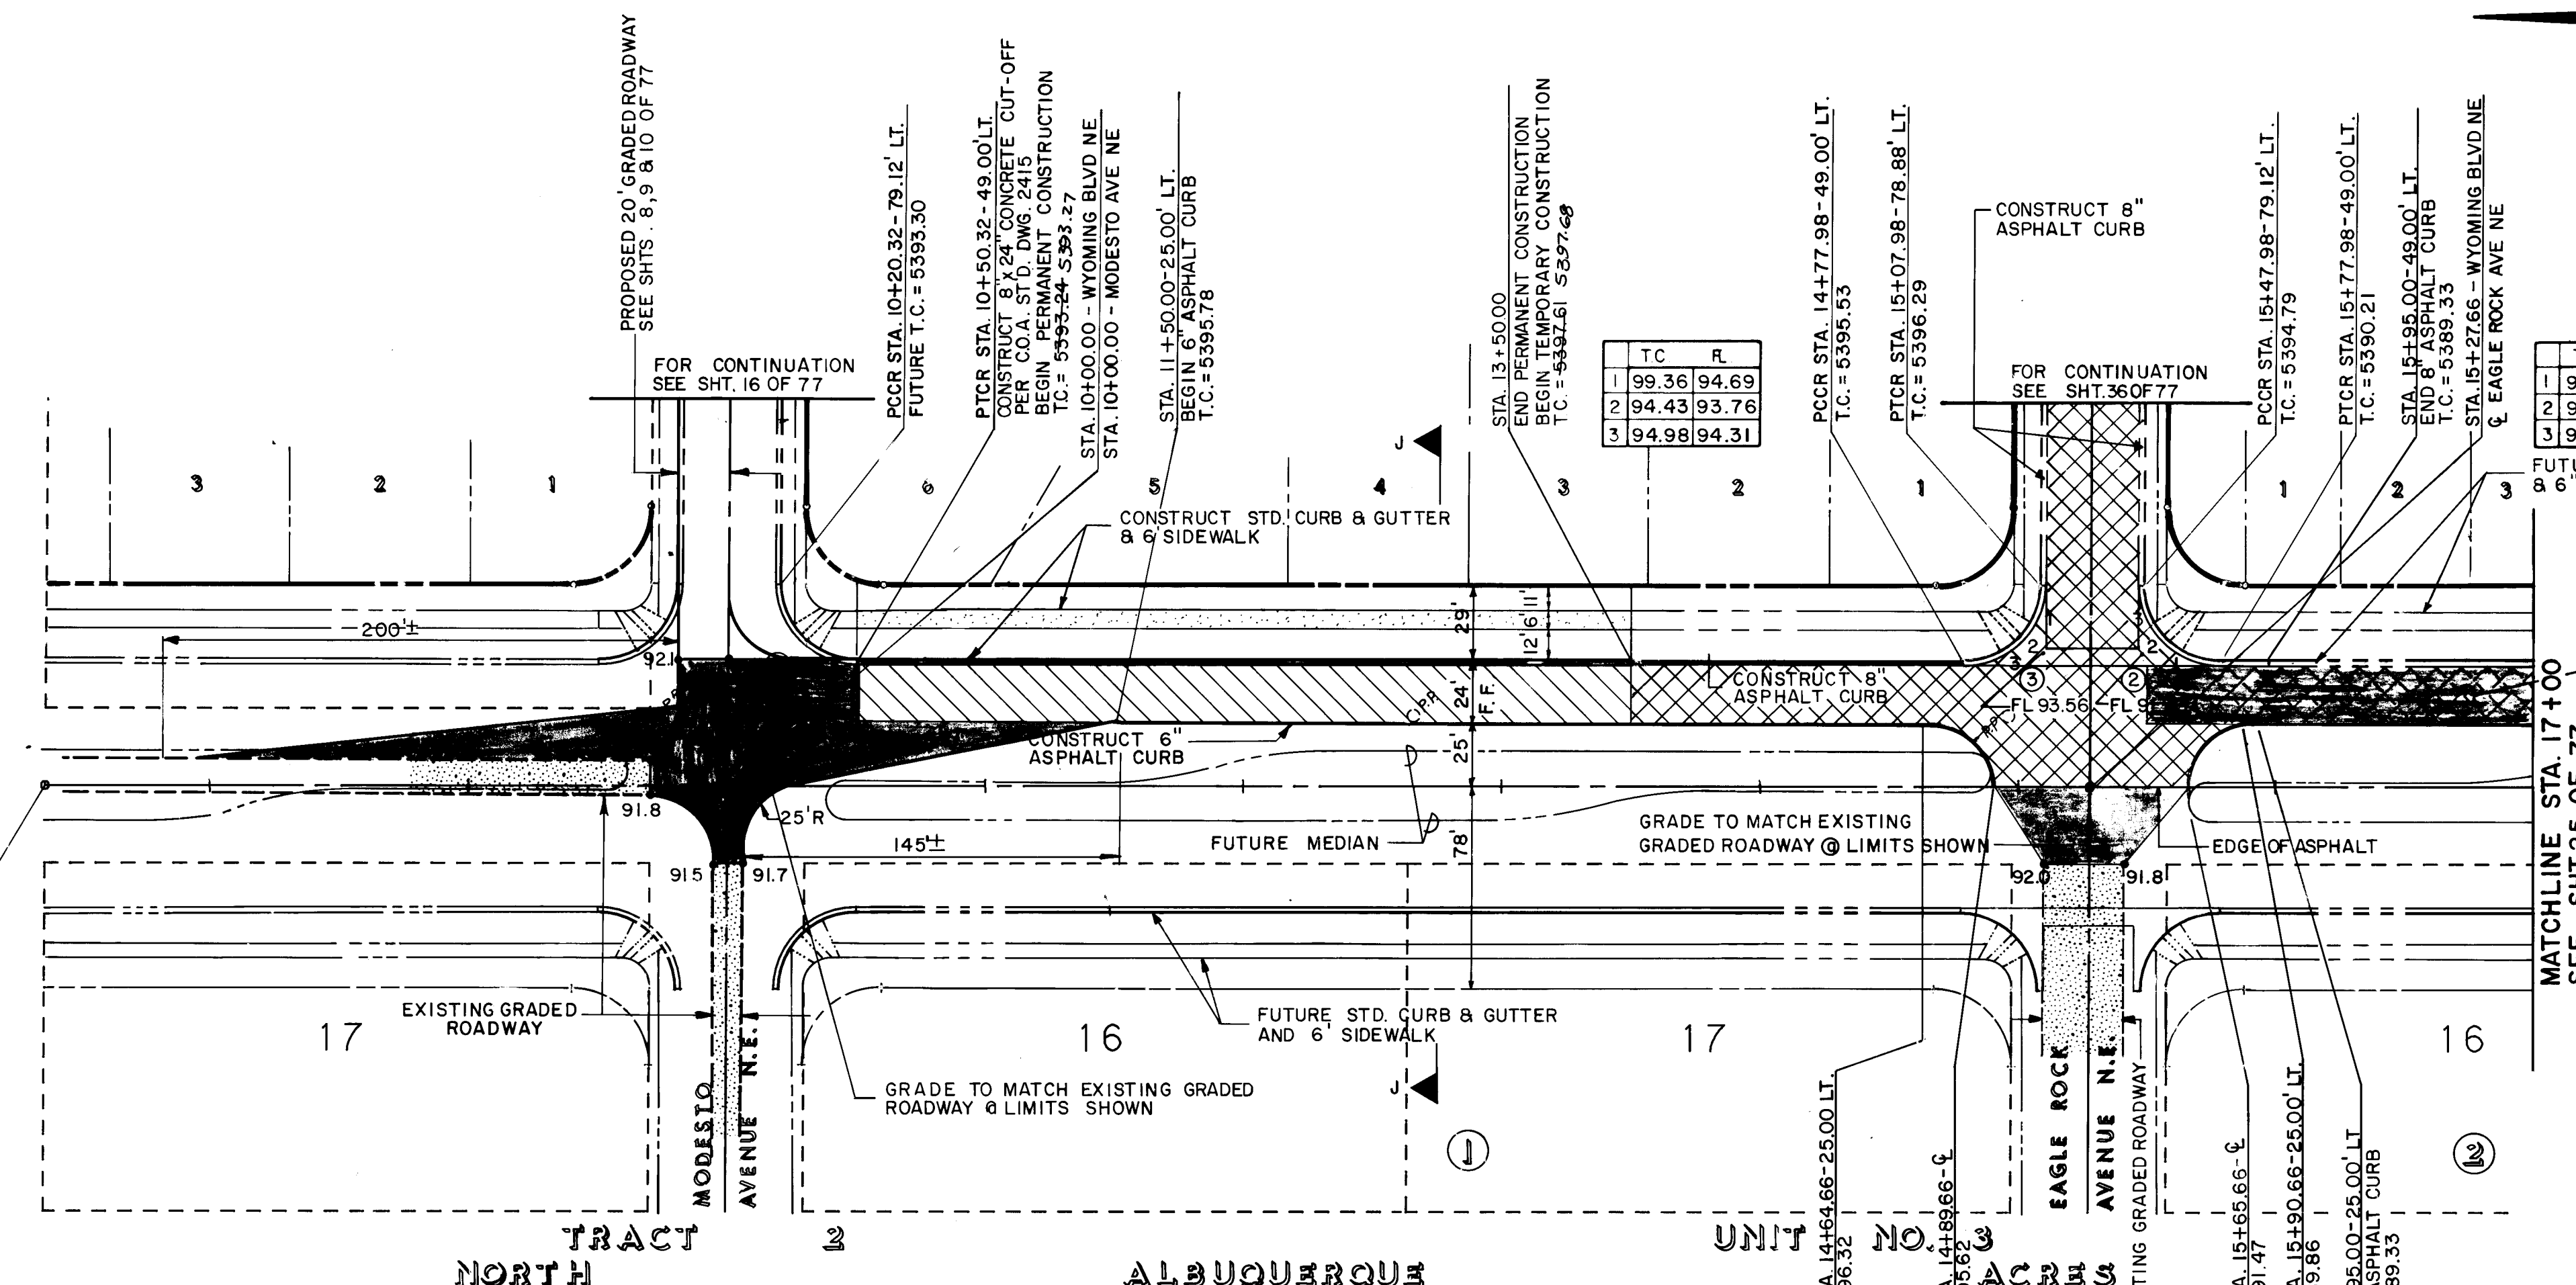

SCALE:
HORIZ. 1" = 50'
VERT. 1" = 10'

LEGEND

- EXISTING CURB & GUTTER AND SIDEWALK
- EXISTING DRIVEPADS
- EXISTING LIMITS OF ASPHALT PAVEMENT
- PROPERTY OR BOUNDARY LINE
- CENTERLINE OF STREET
- PROPOSED CURB & GUTTER
- PROPOSED SIDEWALK
- PROPOSED CONCRETE VALLEY GUTTER
- PROPOSED WHEELCHAIR RAMP
- FUTURE CURB & GUTTER
- FUTURE SIDEWALK
- FUTURE CONCRETE VALLEY GUTTER
- FUTURE WHEELCHAIR RAMP
- EXISTING GRADED ROADWAY
- NEW TEMPORARY PAVING
- EXIST. TEMPORARY PAVING
- NEW ARTERIAL PAVING
- PROPOSED TRANSITION TO GRADED ROADWAY

ESPEY, HUSTON & ASSOCIATES, INC.
Engineering & Environmental Consultants
317 COMMERCIAL ST. N.E.
ALBUQUERQUE, NEW MEXICO 87102
PHONE: (505) 242-1909

NOR ESTE ESTATES
WYOMING BOULEVARD N.E.
PAVING - STA. 7+36 TO STA. 17+00

DRAWING NO 3186 C-19

NO. DELTA RADIUS LENGTH TAN
1 90°13'55" 30.00 47.25 30.12
2 90°13'55" 30.00 47.25 30.12
3 89°46'05" 30.00 47.00 29.88

PAVING
1. ALL STATIONING AND OFFSET DIMENSIONS ARE BASED ON CENTERLINE OF RIGHT-OF-WAY.
2. THE FOLLOWING CITY OF ALBUQUERQUE STANDARD DRAWINGS ARE APPLICABLE TO THE PAVING CONSTRUCTION:
2401 2415 2422
2405 2418 2430
2407 2420 2440
2408 2421 2441

THE STATION IS LOCATED 9 MILES NORTHEAST OF DOWNTOWN ALBUQUERQUE. TO REACH THE STATION FROM THE INTERSECTION OF LOUISIANA BLVD. AND LOS ANGELES DRIVE, GO EAST ON LOS ANGELES DRIVE 10 MILES TO BARSTOW ST., THEN NORTH ON BARSTOW ST. 10 MILES TO ALAMEDA AVE. THE STATION IS LOCATED IN THE NORTHEAST QUADRANT OF THE INTERSECTION. THE STATION MARK IS A STANDARD ACS BRASS TABLET STAMPED "1-B20", SET IN TOP OF A CONCRETE POST PROJECTING 0.1 FEET ABOVE GROUND. MSLD ELEVATION = 5474.53'


NEW CONCEPTS
EHA 87/88
EHA 88/89
EHA 89/90

Don C. Jorgensen
8/14/87

8/87
8/87
8/87

JS
G.S. MC.
D.A.L.

Hydro NA 10/5/87
David W. Hummer 9/14/87
JEE 8/31/87
JH RAB 9-1-87

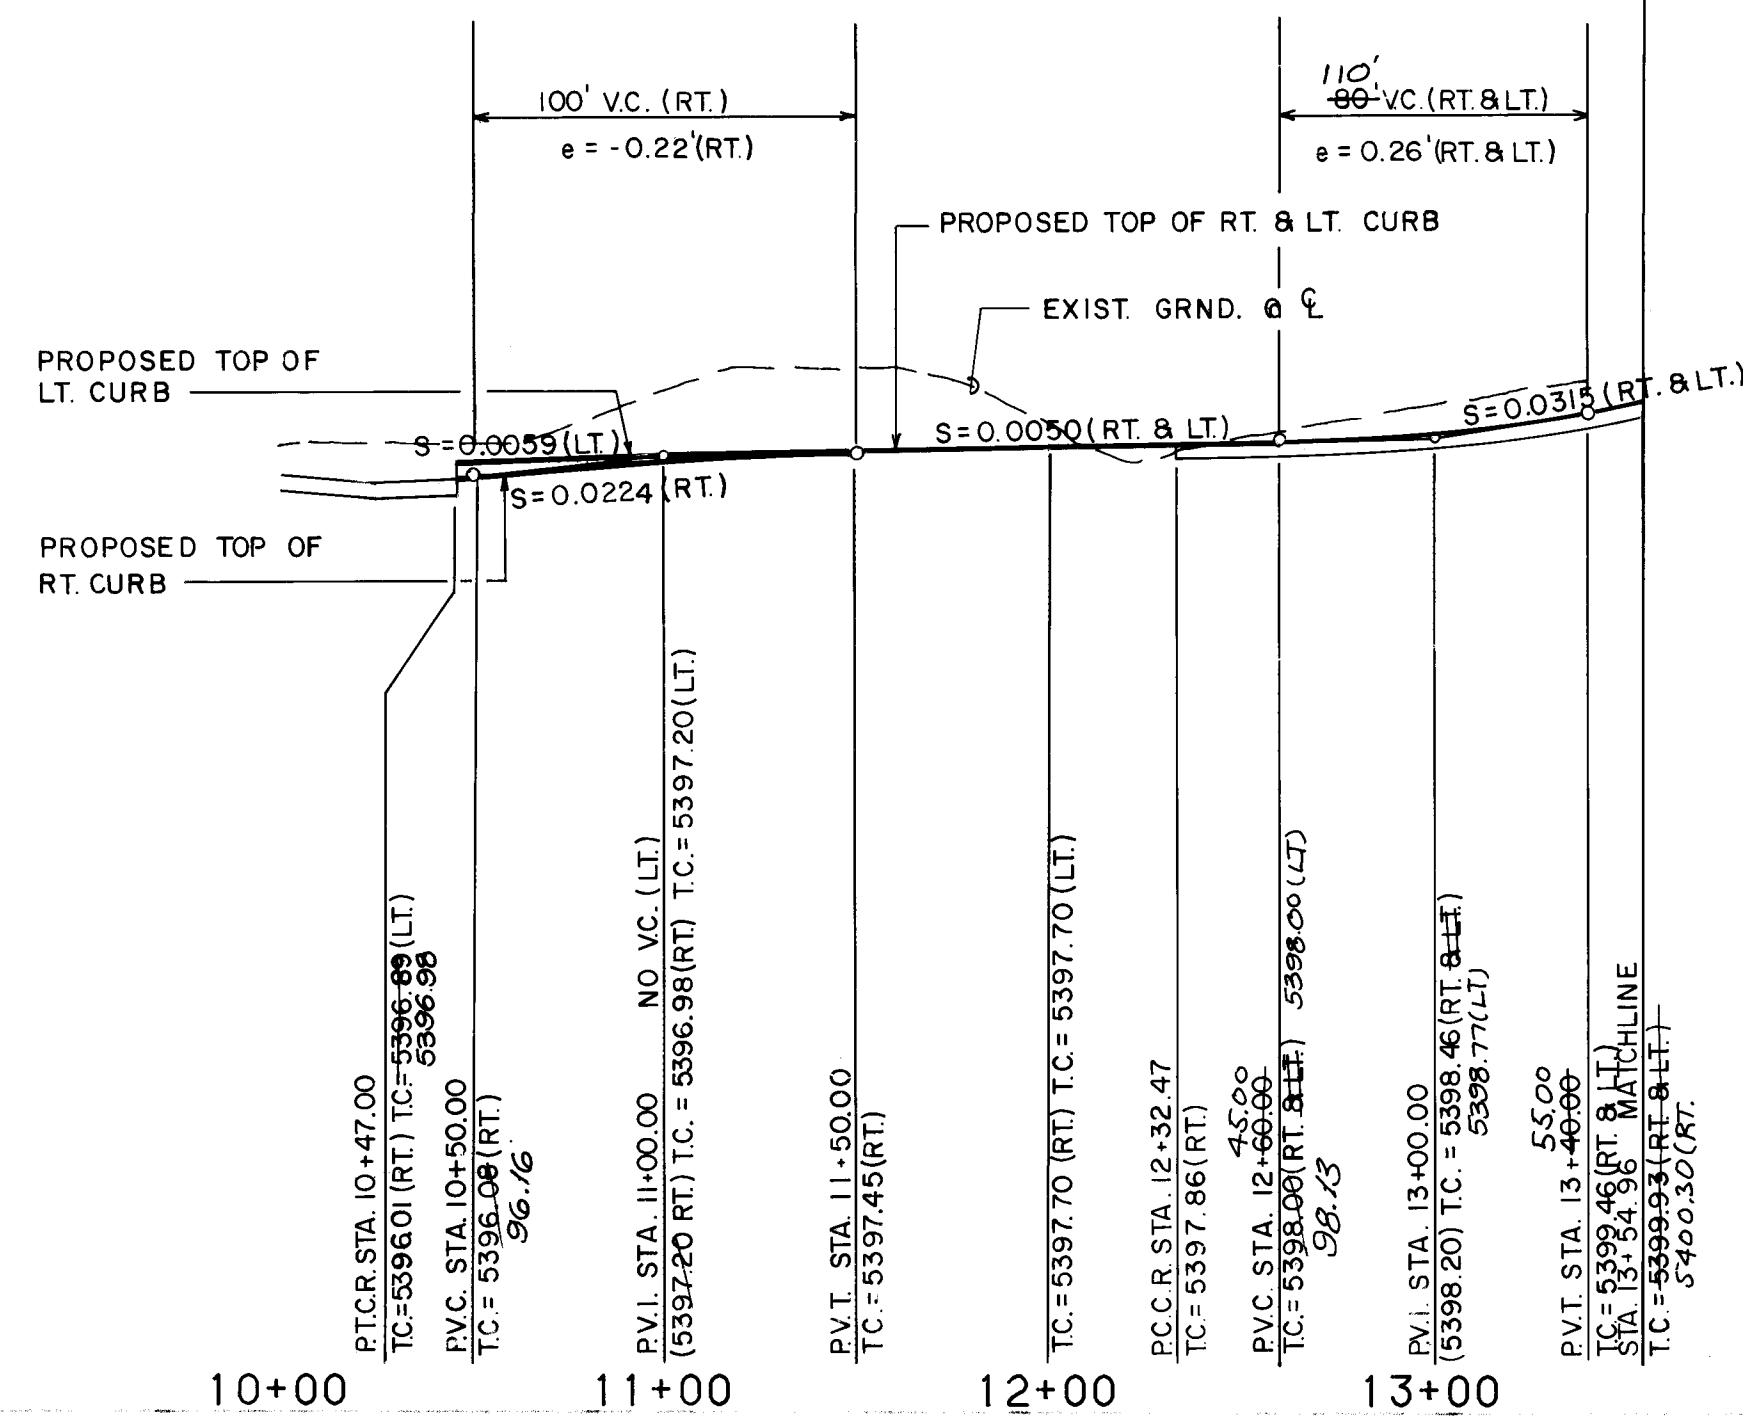

Knowledge and Skill
Pr. Co. Inc.
 Dennis A. Lorenz P.E. 6647
 3-14-88
 MECHANICAL ENGINEER
 N.E. 112160
 1984
 REBORN
 Date

1. ALL STATIONING AND OFFSET DIMENSIONS ARE BASED ON CENTERLINE OF RIGHT-OF-WAY.
2. THE FOLLOWING CITY OF ALBUQUERQUE STANDARD DRAWINGS ARE APPLICABLE TO THE PAVING CONSTRUCTION:

2401	2415	2422
2405	2418	2430
2407	2420	2440
2408	2421	2441

SCALE:	=====	EXISTING CURB & GUTTER AND SIDEWALK
HORIZ. 1"= 50'	== 5' == 7' ==	EXISTING DRIVEPADS
VERT. 1"= 10'	-----	EXISTING LIMITS OF ASPHALT PAVEMENT
	-----	PROPERTY OR BOUNDARY LINE
	-----	CENTERLINE OF STREET
5440	=====	PROPOSED CURB & GUTTER
	=====	PROPOSED SIDEWALK
5430		PROPOSED CONCRETE VALLEY GUTTER
		PROPOSED WHEELCHAIR RAMP
5420	=====	FUTURE CURB & GUTTER
	-----	FUTURE SIDEWALK
		FUTURE CONCRETE VALLEY GUTTER
5410		FUTURE WHEELCHAIR RAMP
5400		TRANSITION FROM CROWN TO NO CROWN

NOR ESTE ESTATES
STEIDER ST. N.E.
STA.10+00.00 TO STA. 13+54.96

Hydro NA JEE 8/31/87
NA RAZ 9-1-87

DEPARTMENT OF DEFENSE
OFFICE OF THE INSPECTOR GENERAL
1995
10/10/95

8/19/87

8/27

AS MC

5450
5440
5430
5420
5410
5400
5390
5380
5370
5360

10+00

12+00

13+00

14+00

15+00


16+00

17+00

18+00

19+00

20+00

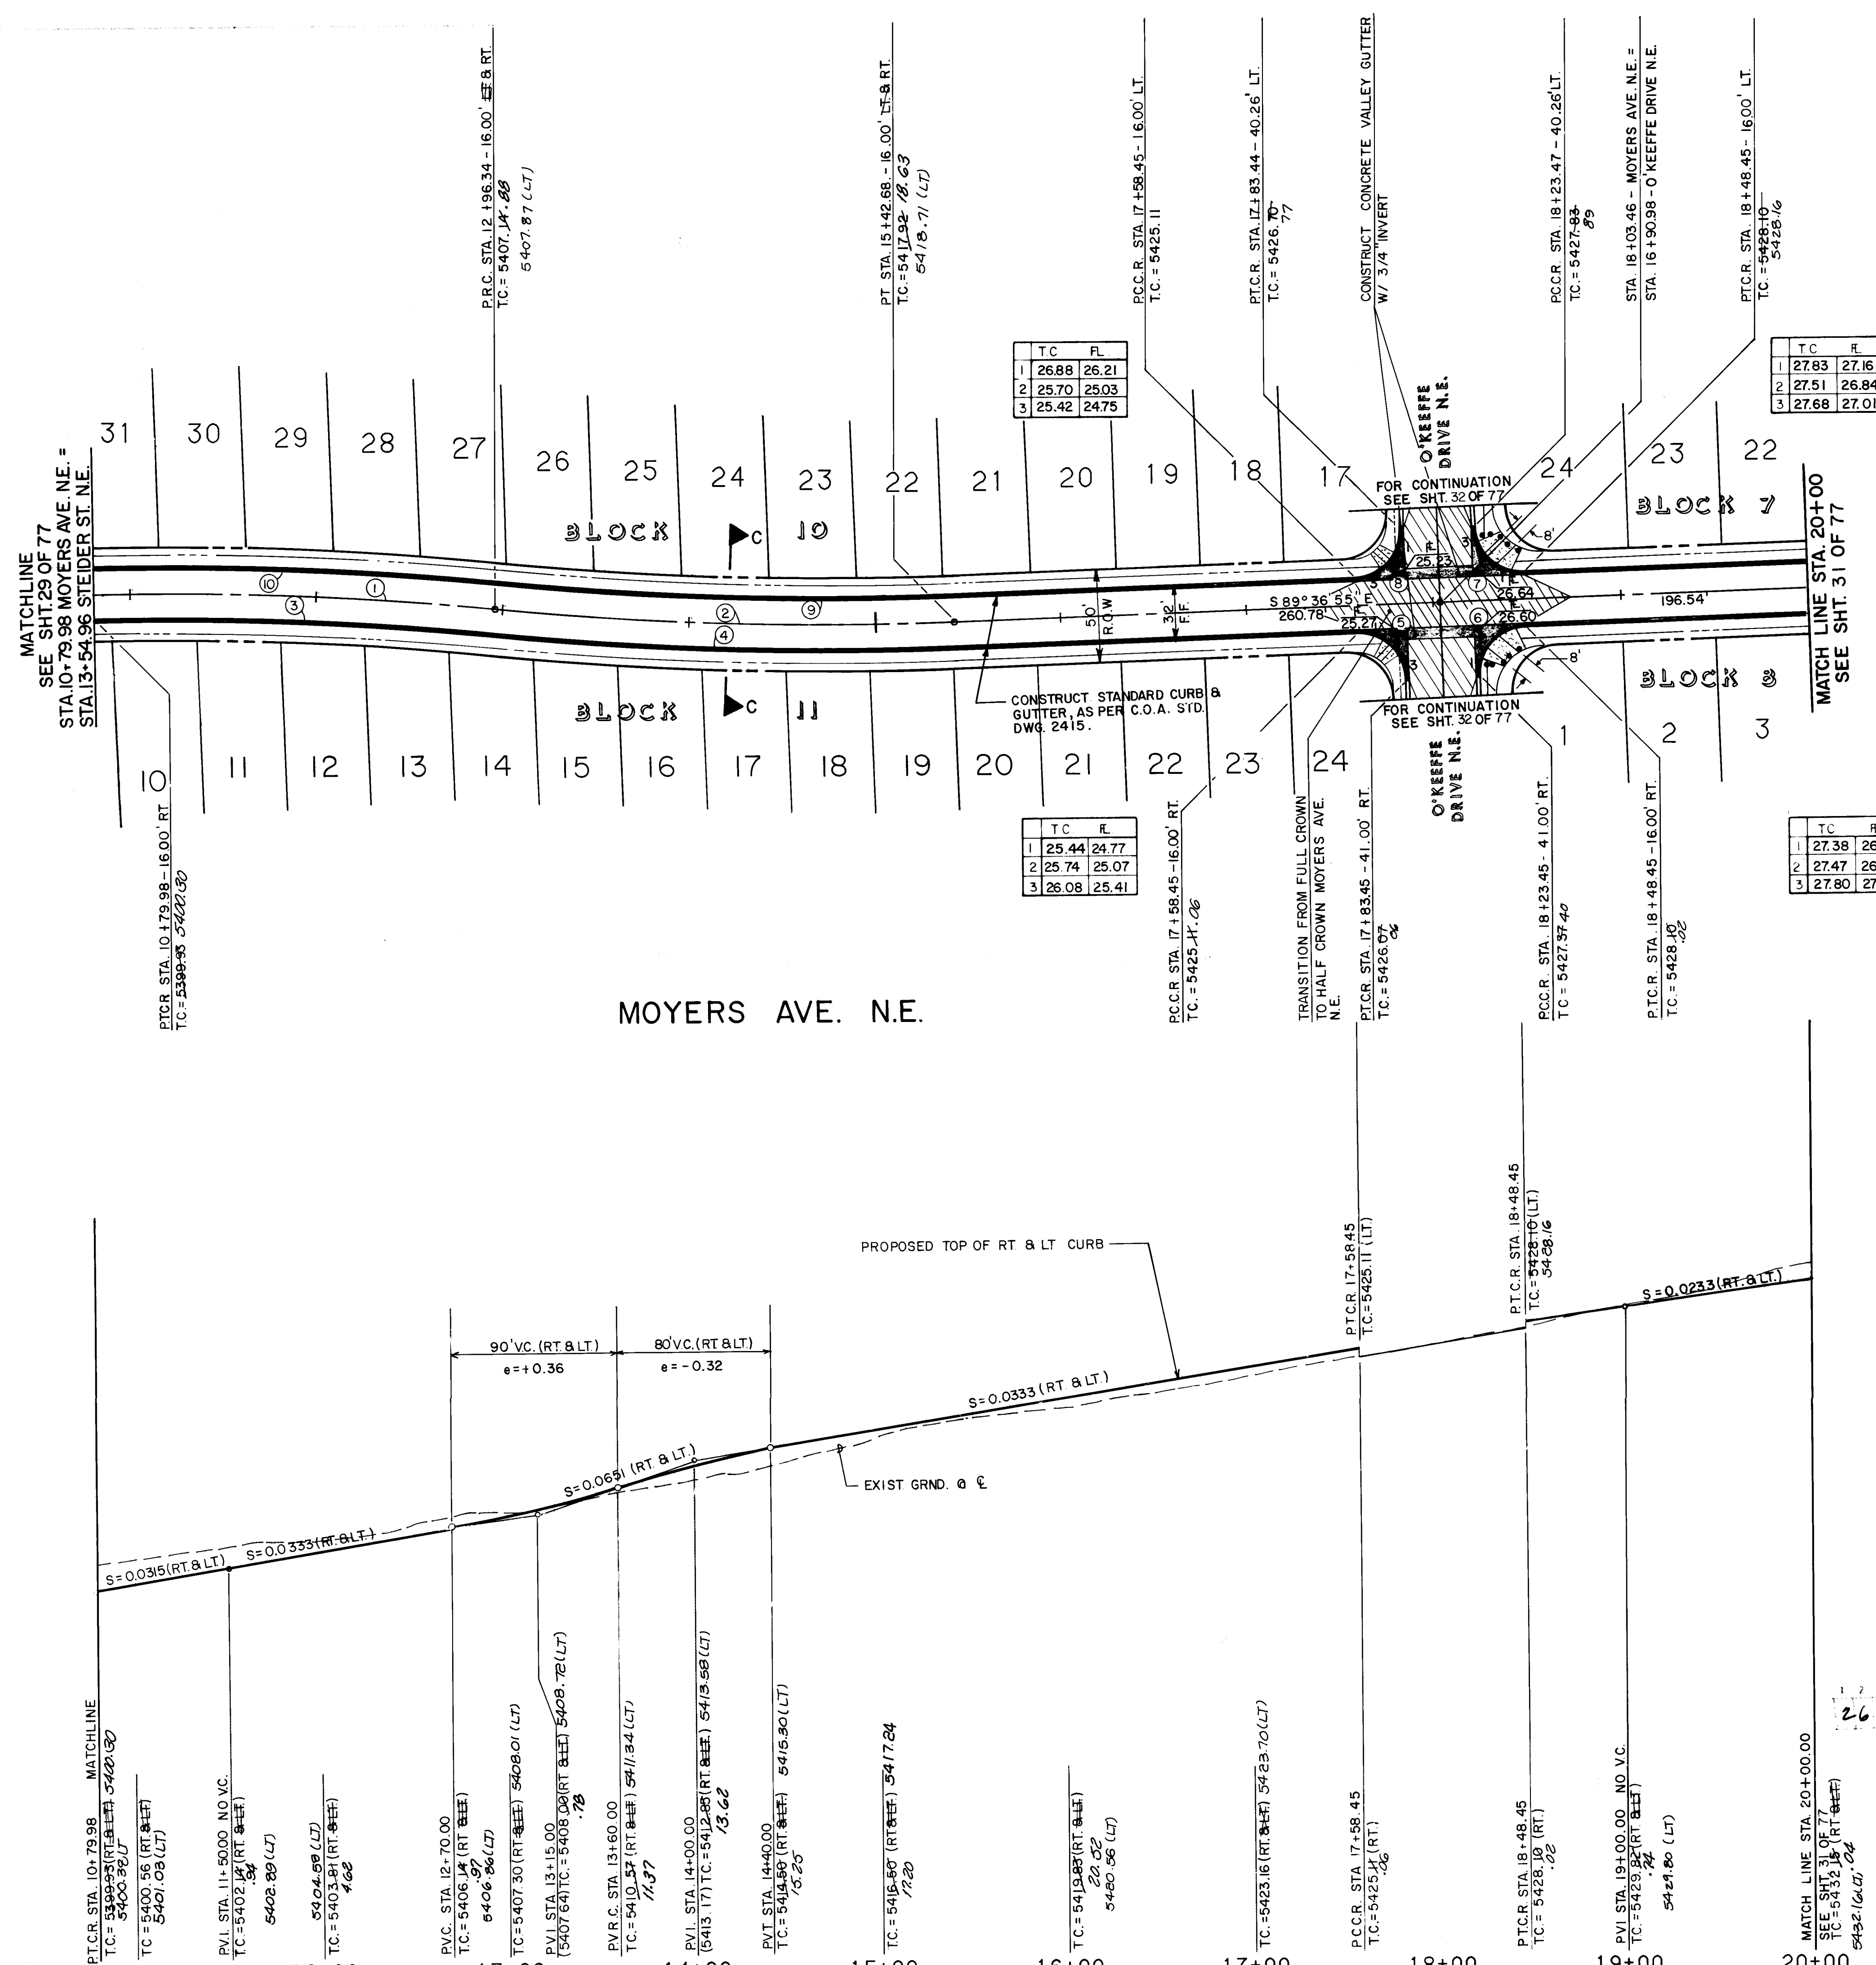

RECORD DRAWING

SCALE:
HORIZ. = 1" = 50'
VERT. = 1" = 10'

- LEGEND**
- EXISTING CURB & GUTTER AND SIDEWALK
 - EXISTING DRIVEPADS
 - EXISTING LIMITS OF ASPHALT PAVEMENT
 - PROPERTY OR BOUNDARY LINE
 - CENTERLINE OF STREET
 - PROPOSED CURB & GUTTER
 - PROPOSED SIDEWALK
 - PROPOSED CONCRETE VALLEY GUTTER
 - PROPOSED WHEELCHAIR RAMP
 - FUTURE CURB & GUTTER
 - FUTURE SIDEWALK
 - FUTURE CONCRETE VALLEY GUTTER
 - FUTURE WHEELCHAIR RAMP
 - TRANSITION FROM CROWN TO NO CROWN

ESPEY, HUSTON & ASSOCIATES, INC.
Engineering & Environmental Consultants
317 COMMERCIAL ST. N.E.
ALBUQUERQUE, NEW MEXICO 87102
PHONE: (505) 242-1909

NOR ESTE ESTATES
MOYERS AVE. N.E.
STA. 10+79.98 TO STA. 20+00.00

Hydro 1/14/87
JEE 1/14/87
JMA 1/14/87
9-1-87

NO.	DELTA	RADIUS	LENGTH	TANGENT
1	6°54'04"	1800.00	216.80	108.53
2	7°50'28"	1800.00	246.34	123.36
3	6°54'04"	1800.00	216.80	108.53
4	7°50'28"	1800.00	246.34	123.36
5	6°54'04"	1800.00	216.80	108.53
6	7°50'28"	1800.00	246.34	123.36
7	6°54'04"	1800.00	216.80	108.53
8	7°50'28"	1800.00	246.34	123.36
9	6°54'04"	1800.00	216.80	108.53
10	7°50'28"	1800.00	246.34	123.36



- PAVING**
- ALL STATIONING AND OFFSET DIMENSIONS ARE BASED ON CENTERLINE OF RIGHT-OF-WAY.
 - THE FOLLOWING CITY OF ALBUQUERQUE STANDARD DRAWINGS ARE APPLICABLE TO THE PAVING CONSTRUCTION:

2401	2415	2422
2405	2418	2430
2407	2420	2440
2408	2421	2441

THE STATION IS LOCATED 9 MILES NORTHEAST OF DOWNTOWN ALBUQUERQUE TO REACH THE STATION FROM THE INTERSECTION OF LOS ANGELES BLVD. AND LOS ANGELES DRIVE, GO EAST ON LOS ANGELES DRIVE 10 MILES TO BARTOW ST., THEN NORTH ON BARTOW ST. 10 MILES TO ALAMEDA AVE. THE STATION IS LOCATED IN THE NORTHEAST QUADRANT OF THE INTERSECTION. THE STATION MARK IS A STANDARD ACS BRASS TABLET STAMPED "1-820", SET IN TOP OF A CONCRETE POST PROJECTING 0.1 FEET ABOVE GROUND. MSLD ELEVATION = 5474.53'

NEW CONCEPTS
8/1/88
8/1/88
8/1/88
8/1/88

REMARKS:
REVISIONS:
1. 8/1/87
2. 8/1/87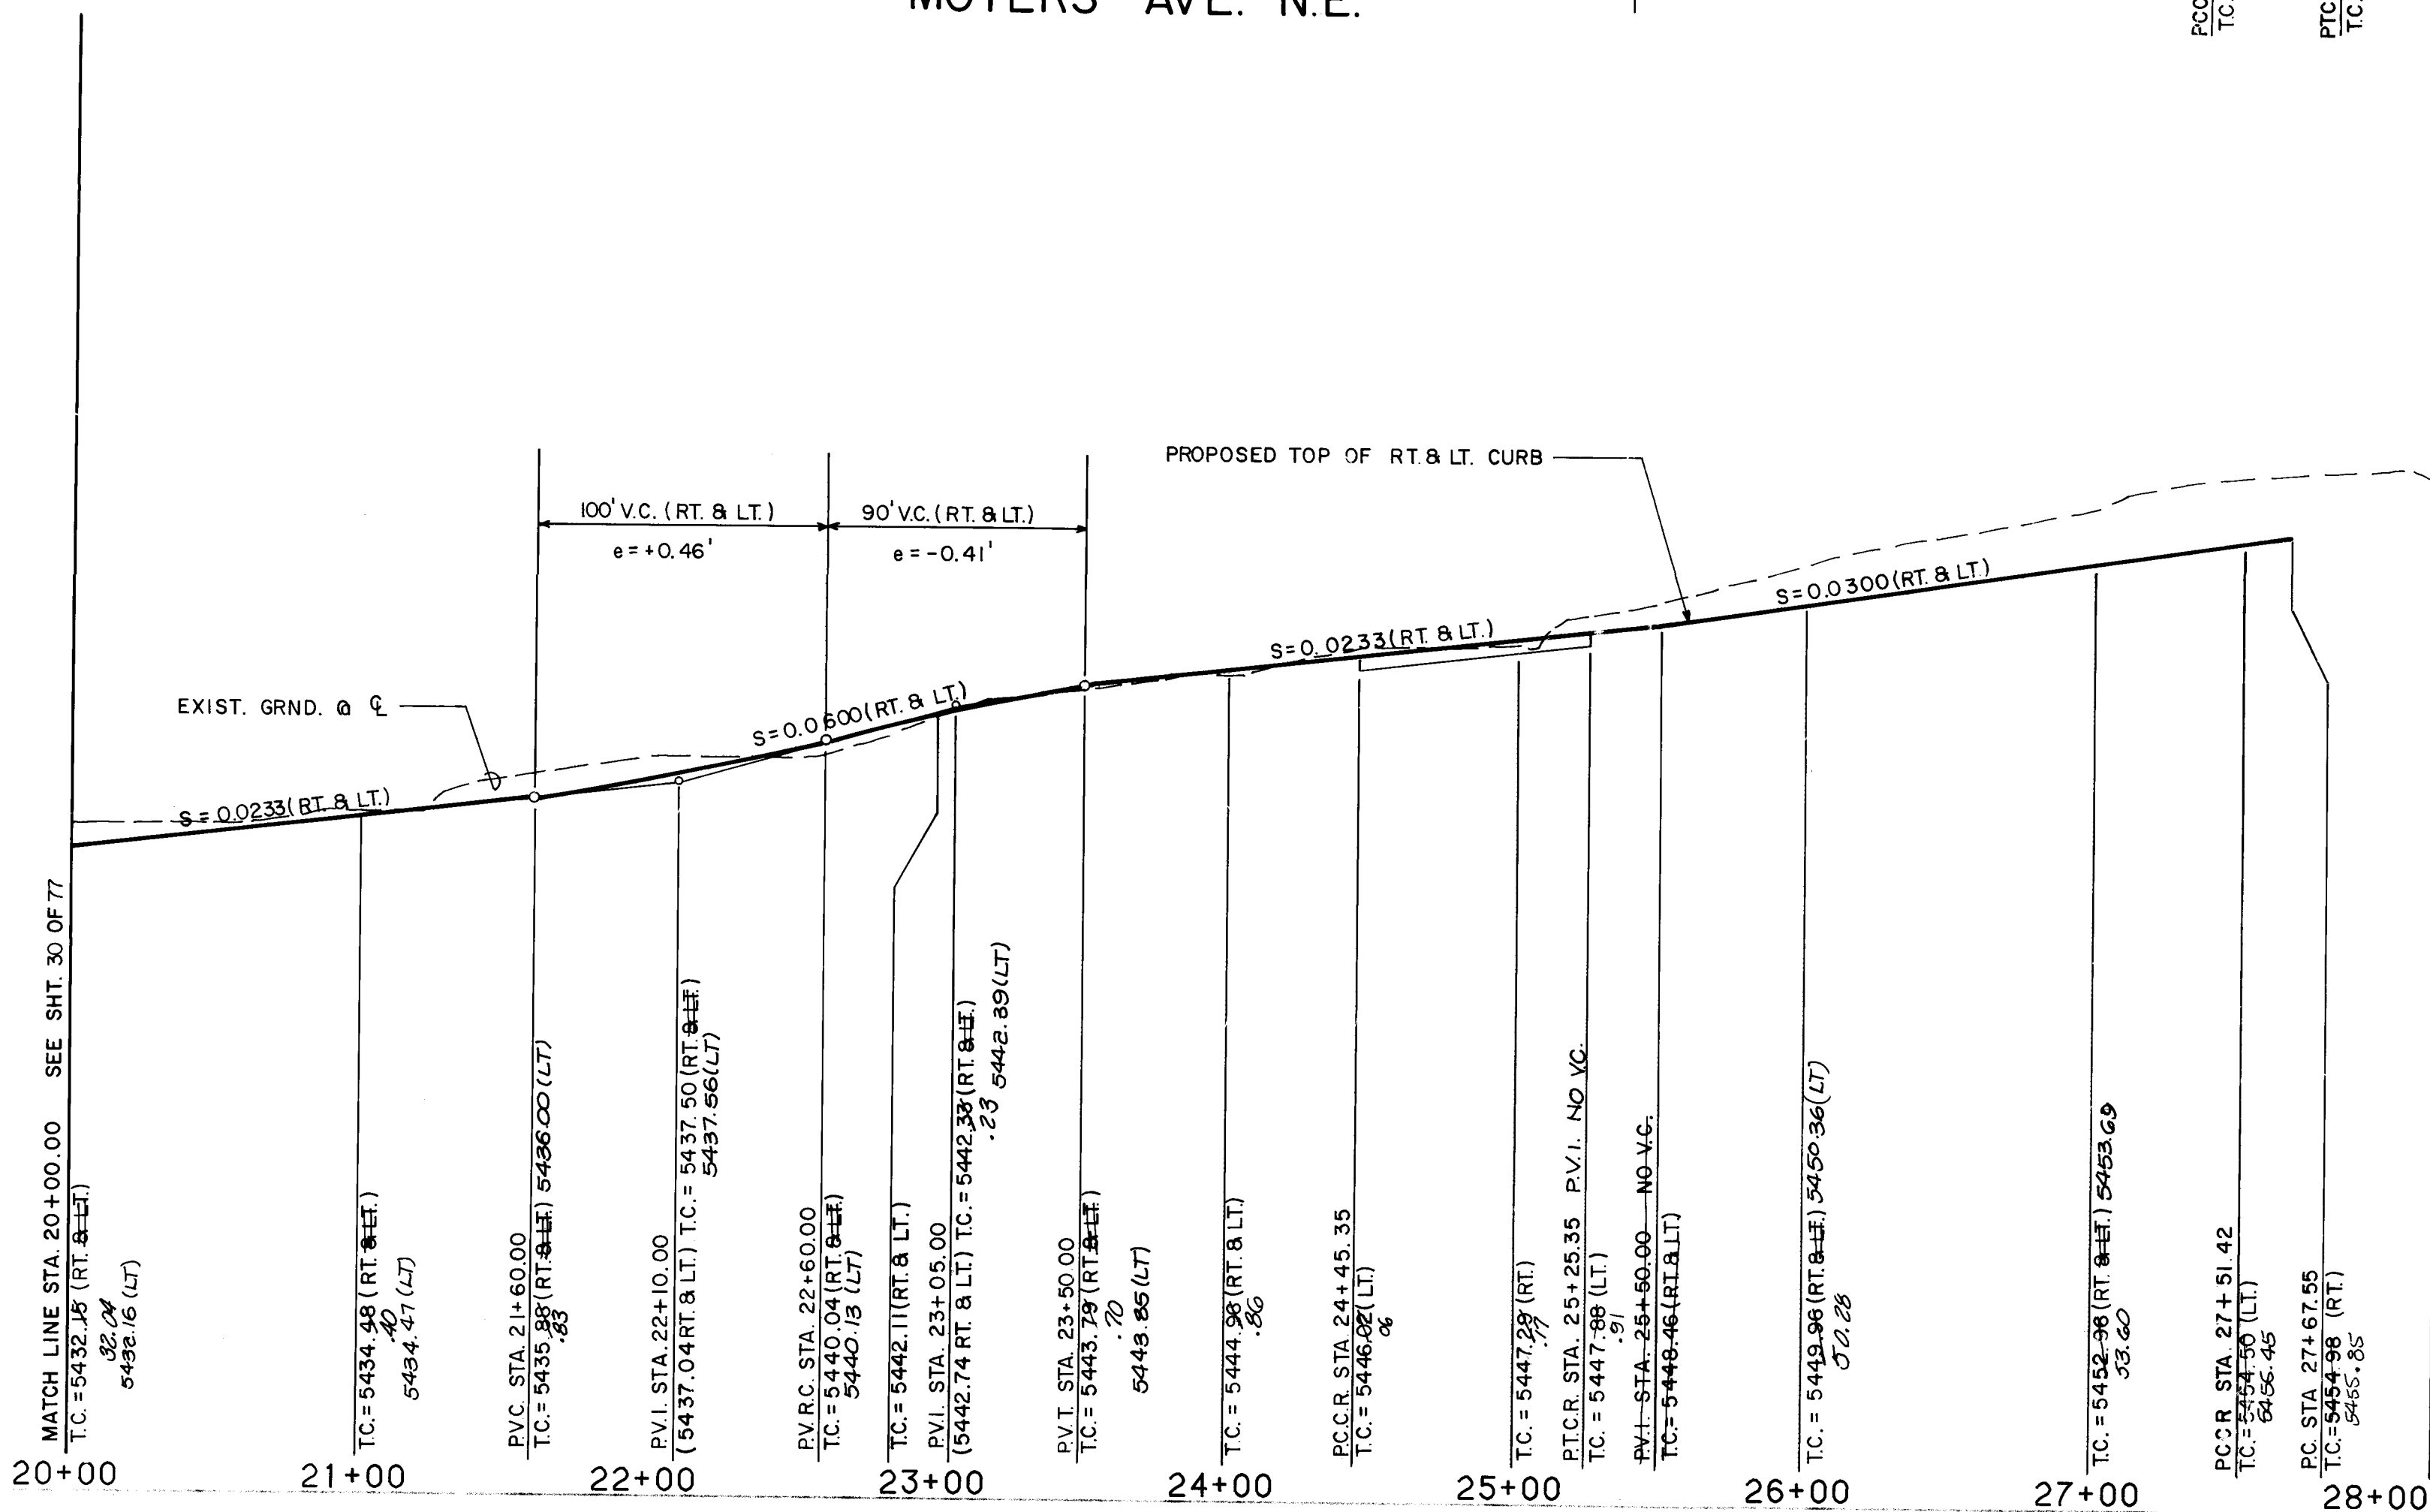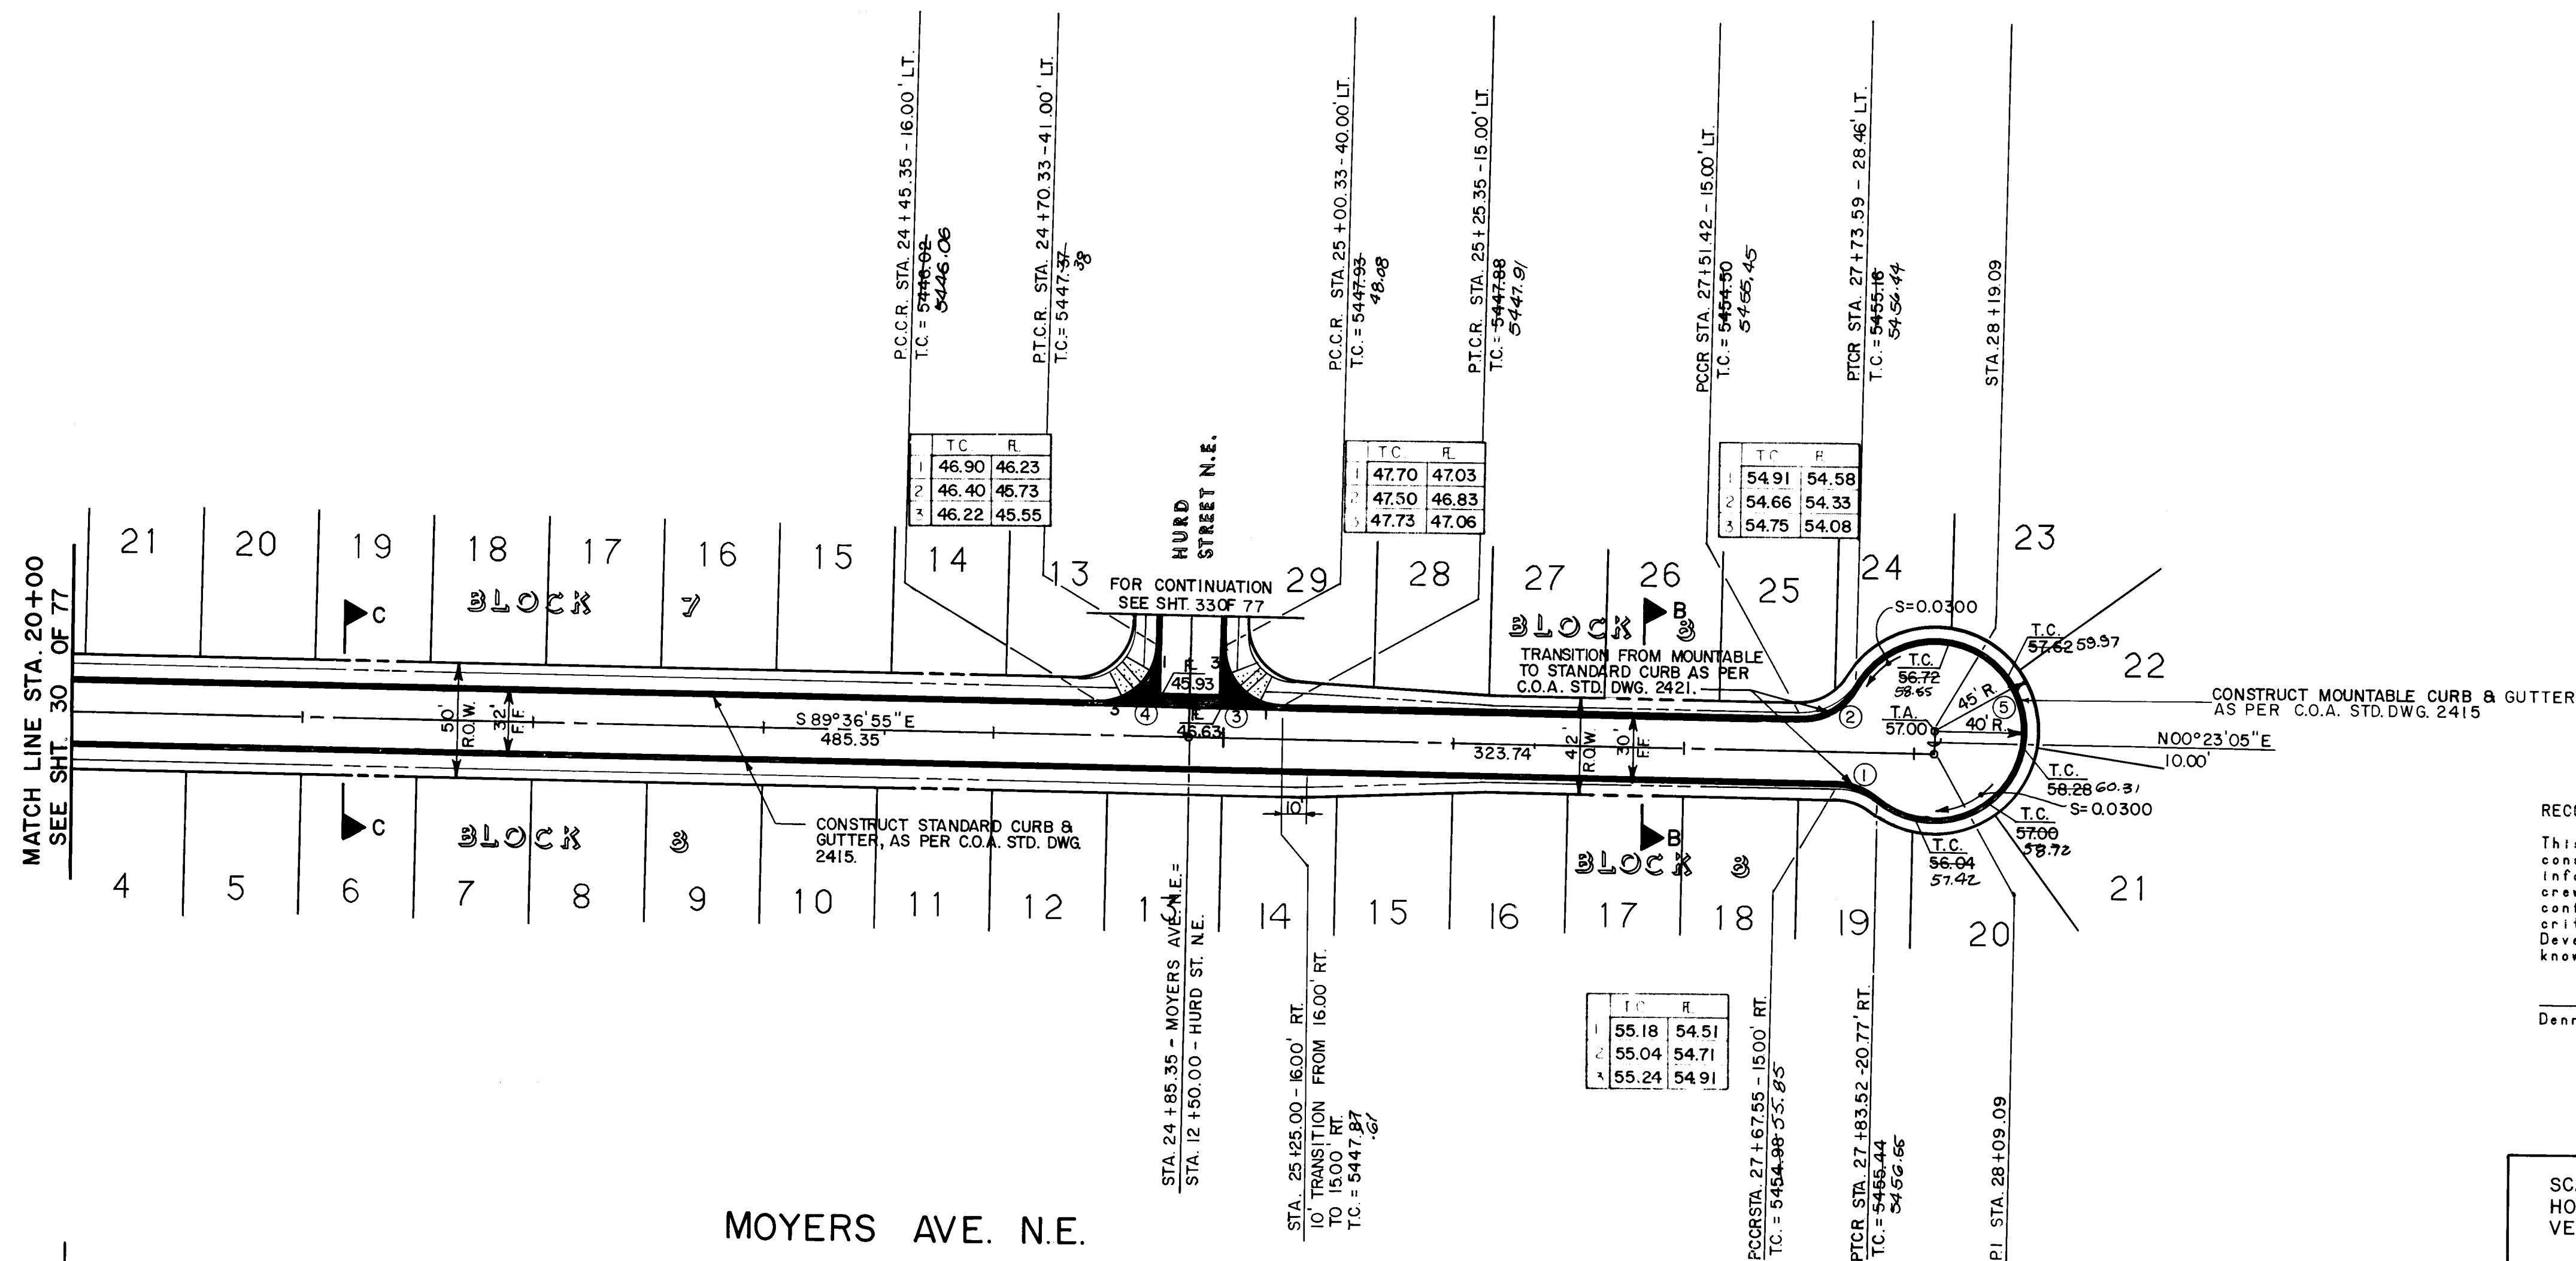
NO.	DELTA	RADIUS	LENGTH	TAN
1	39°42'54"	25.00	17.33	9.03
2	62°30'49"	25.00	27.28	15.17
3	90°00'00"	25.00	39.27	25.00
4	90°00'00"	25.00	39.27	25.00
5	282°13'43"	40.00	197.03	999999.98

PAVING

- ALL STATIONING AND OFFSET DIMENSIONS ARE BASED ON CENTERLINE OF RIGHT-OF-WAY.
- THE FOLLOWING CITY OF ALBUQUERQUE STANDARD DRAWINGS ARE APPLICABLE TO THE PAVING CONSTRUCTION:

2401	2415	2422
2405	2418	2430
2407	2420	2440
2408	2421	2441

RECORD DRAWING

This drawing as modified shows public improvements as constructed. These modifications have been made using information and measurements obtained by EHA's field survey crew, the Contractor and City Inspector. The modifications conform to the minimum requirements for record drawing criteria as required by the City of Albuquerque per knowledge and better judgment of the Engineer to the best of my knowledge and belief.


Dennis A. Lorenz P.E. 9547 3-14-88 Date

LEGEND


- SCALE: HORIZ. 1" = 50' VERT. 1" = 10'
- EXISTING CURB & GUTTER AND SIDEWALK
 - EXISTING DRIVEPADS
 - EXISTING LIMITS OF ASPHALT PAVEMENT
 - PROPERTY OR BOUNDARY LINE
 - CENTERLINE OF STREET
 - PROPOSED CURB & GUTTER
 - PROPOSED SIDEWALK
 - PROPOSED CONCRETE VALLEY GUTTER
 - PROPOSED WHEELCHAIR RAMP
 - FUTURE CURB & GUTTER
 - FUTURE SIDEWALK
 - FUTURE CONCRETE VALLEY GUTTER
 - FUTURE WHEELCHAIR RAMP
 - TRANSITION FROM CROWN TO NO CROWN

ESPEY, HUSTON & ASSOCIATES, INC.
Engineering & Environmental Consultants
317 COMMERCIAL ST. N.E.
ALBUQUERQUE, NEW MEXICO 87102
PHONE: (505) 242-1909

NOR ESTE ESTATES
MOYERS AVE. N.E.
STA. 20+00.00 TO STA. 28+19.09

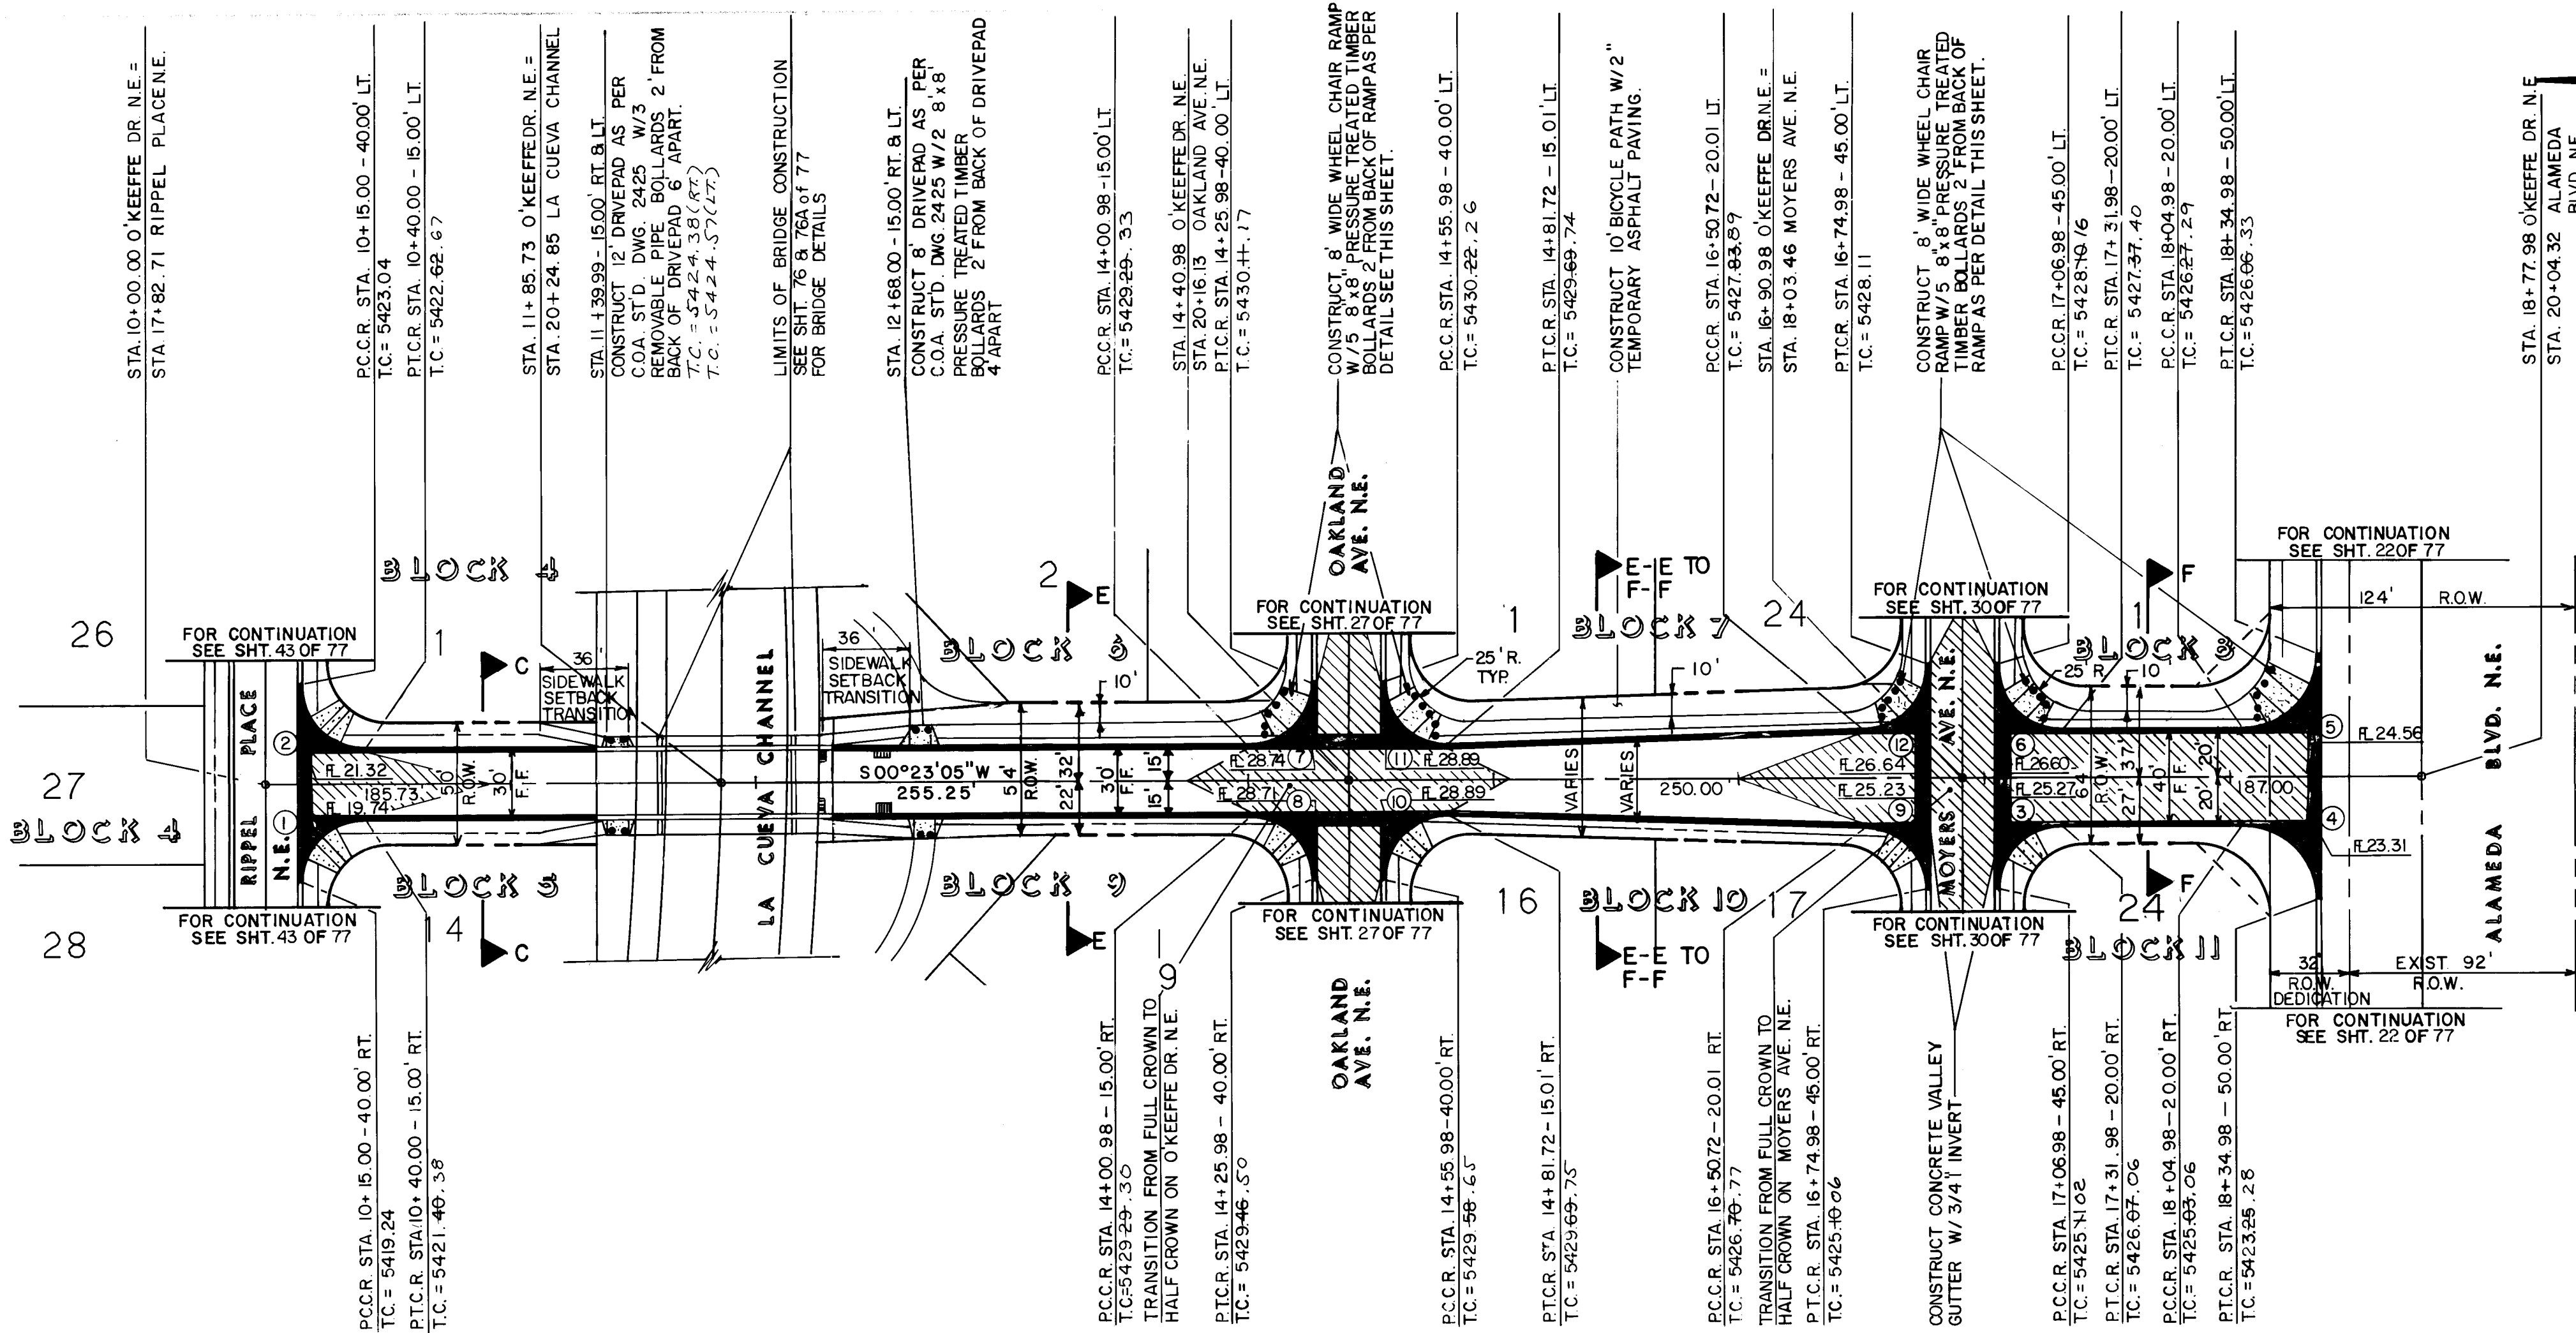

O'KEEFFE DRIVE N.E.

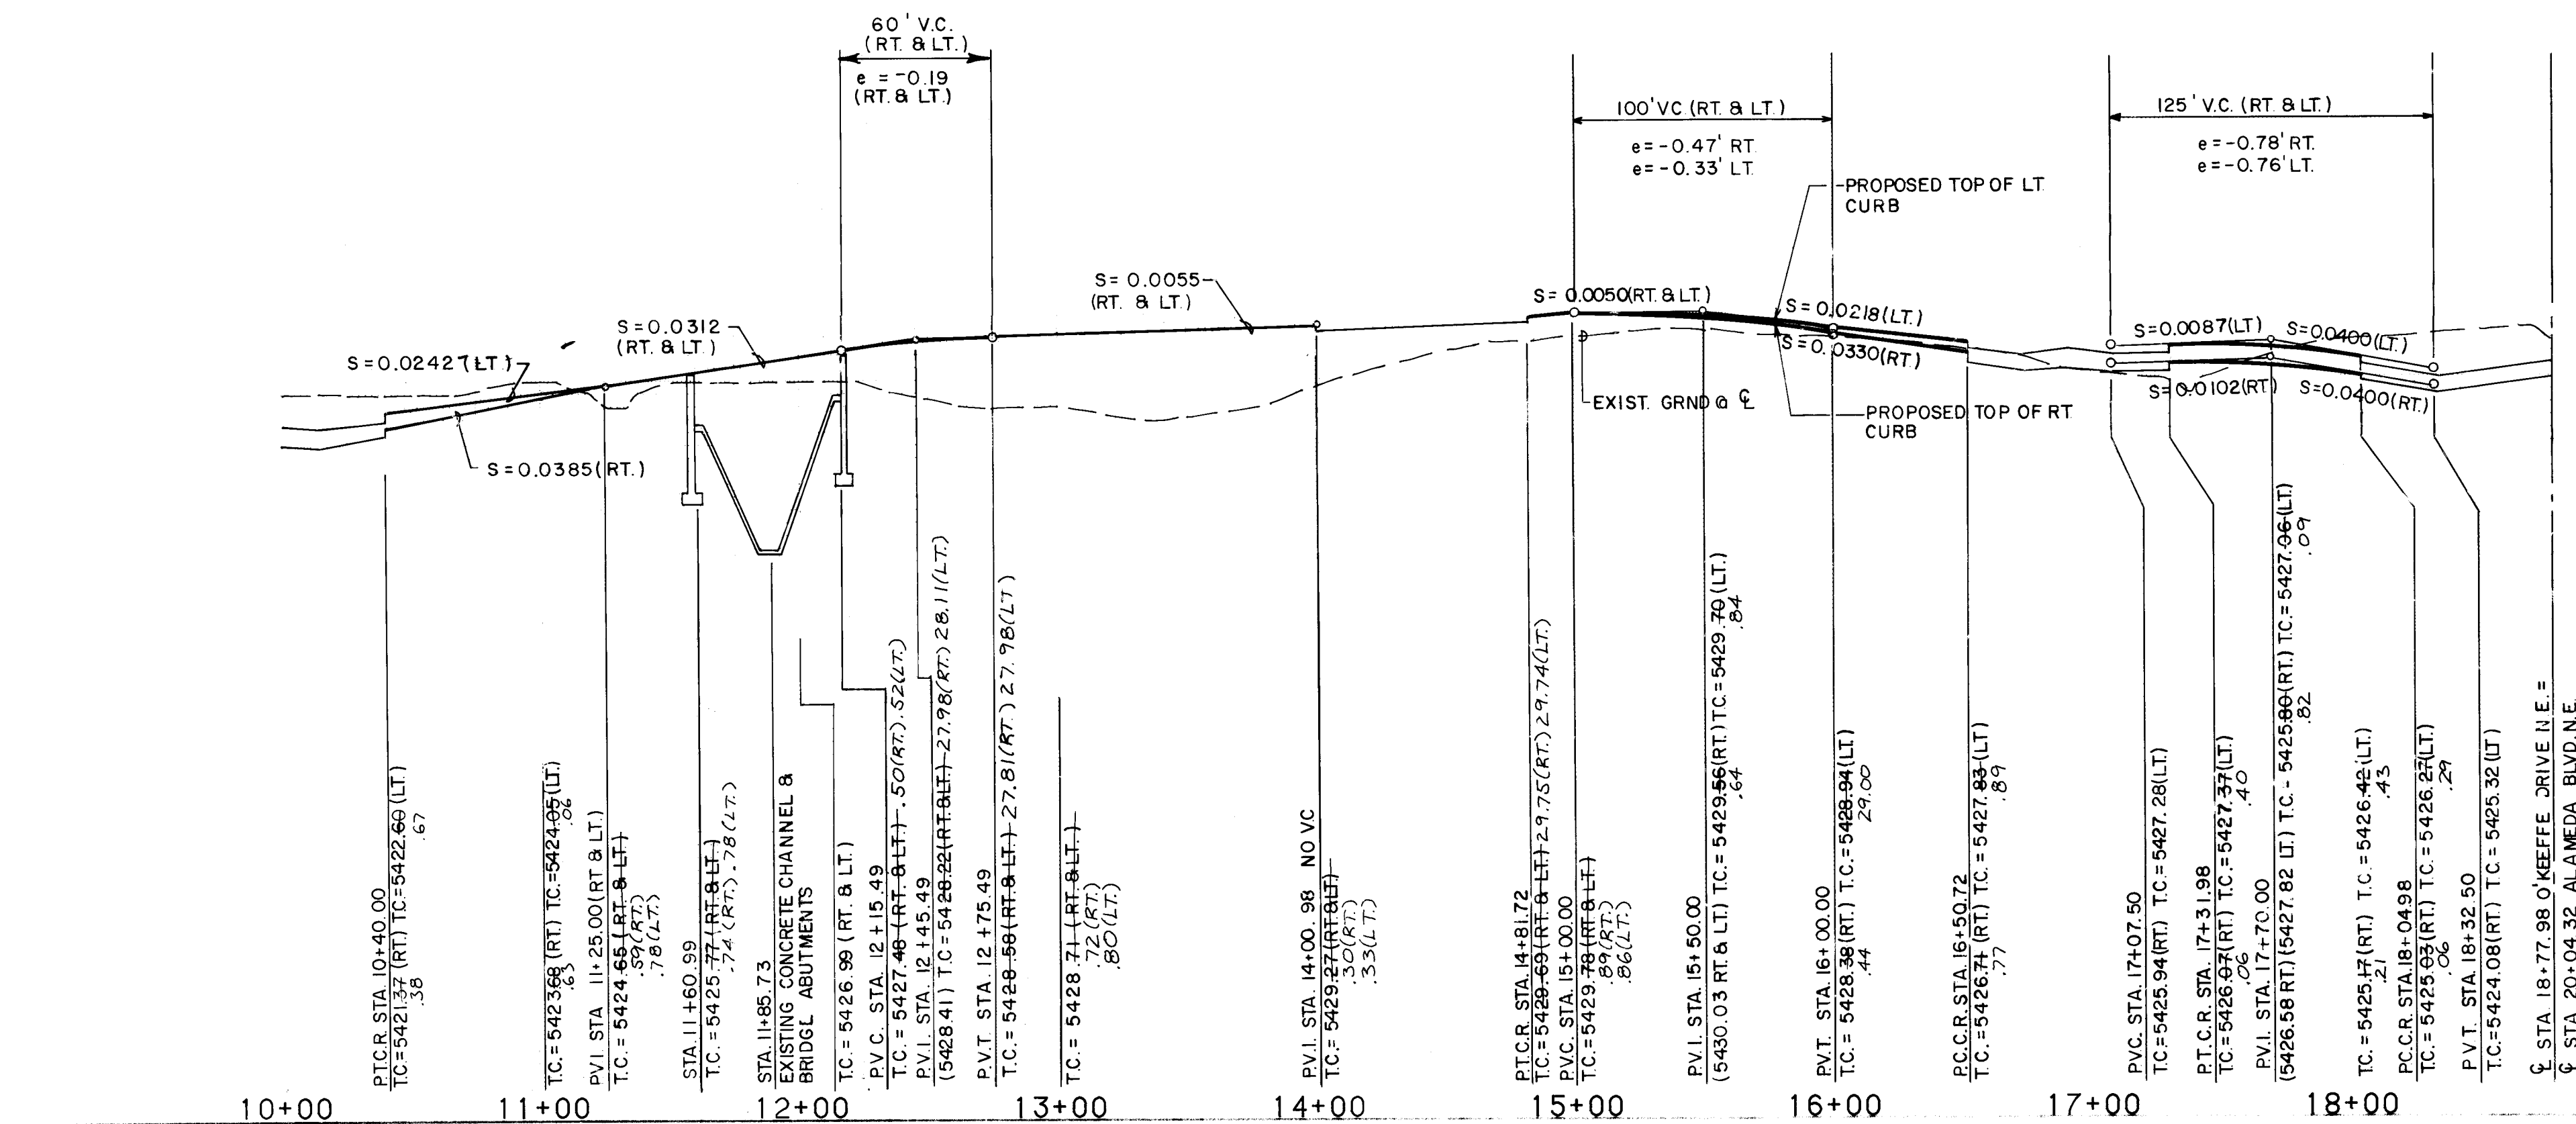


26 31863288

NO.	DELTA	RADIUS	LENGTH	TAN
1	90°00'00"	25.00	39.27	25.00
2	90°00'00"	25.00	39.27	25.00
3	90°00'00"	25.00	39.27	25.00
4	90°00'00"	25.00	39.27	25.00
5	90°00'00"	25.00	39.27	25.00
6	90°00'00"	25.00	39.27	25.00
7	90°00'00"	25.00	39.27	25.00
8	90°00'00"	25.00	39.27	25.00
9	90°00'00"	25.00	39.27	25.00
10	90°00'00"	25.00	39.27	25.00
11	90°00'00"	25.00	39.27	25.00
12	90°00'00"	25.00	39.27	25.00

- ALL STATIONING AND OFFSET DIMENSIONS ARE BASED ON CENTERLINE OF RIGHT-OF-WAY.
- THE FOLLOWING CITY OF ALBUQUERQUE STANDARD DRAWINGS ARE APPLICABLE TO THE PAVING CONSTRUCTION:

2401	2415	2422
2405	2418	2430
2407	2420	2440
2408	2421	2441

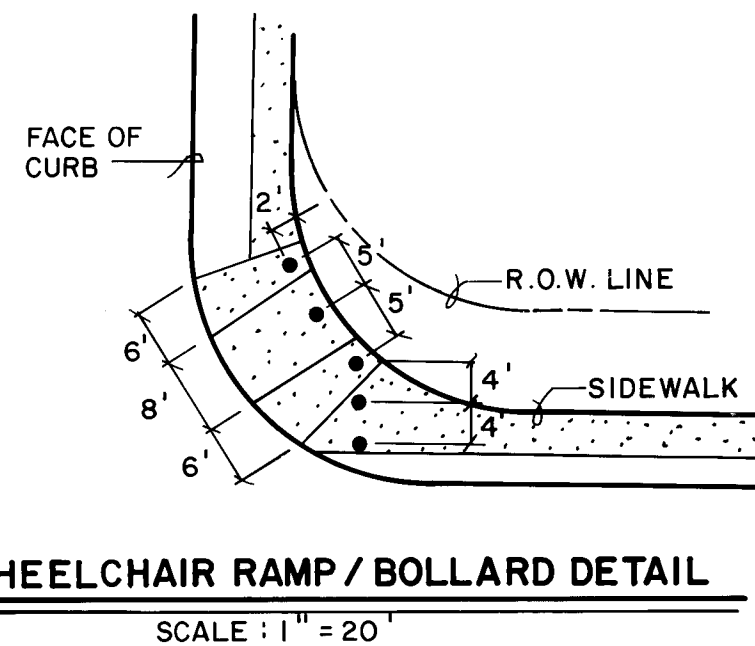

RECORD DRAWING
This drawing as modified shows public improvements as constructed. These modifications have been made using information and measurements obtained by EHA's field survey crew, the Contractor and City Inspector. The modifications conform to the minimum requirements of the City of Albuquerque Development Process Manual Section 10.1.1. The best of my knowledge and belief, this drawing is a true and correct representation of the work shown.

Dennis A. Lorenz P.E. 547
Professional Engineer
3-14-00
Date

LEGEND


- SCALE:
HORIZ. 1" = 50'
VERT. 1" = 10'
- EXISTING CURB & GUTTER AND SIDEWALK
 - EXISTING DRIVEPADS
 - EXISTING LIMITS OF ASPHALT PAVEMENT
 - PROPERTY OR BOUNDARY LINE
 - CENTERLINE OF STREET
 - PROPOSED CURB & GUTTER
 - PROPOSED SIDEWALK
 - PROPOSED CONCRETE VALLEY GUTTER
 - PROPOSED WHEELCHAIR RAMP
 - FUTURE CURB & GUTTER
 - FUTURE SIDEWALK
 - FUTURE CONCRETE VALLEY GUTTER
 - FUTURE WHEELCHAIR RAMP
 - TRANSITION FROM CROWN TO NO CROWN

ESPEY, HUSTON & ASSOCIATES, INC.
Engineering & Environmental Consultants
317 COMMERCIAL ST. N.E.
ALBUQUERQUE, NEW MEXICO 87102
PHONE: (505) 242-1909

NOR ESTE ESTATES
O'KEEFFE DRIVE N.E.
STA. 10+00.00 TO STA. 18+77.98

Hydro 11
3186
C-19
32 77

THE STATION IS LOCATED 9 MILES NORTHEAST OF DOWNTOWN ALBUQUERQUE TO REACH THE STATION FROM THE INTERSECTION OF LOUISIANA BLVD AND LOS ANGELES DRIVE, GO EAST ON LOS ANGELES DRIVE 10 MILES TO BARSTOW ST., THEN NORTH ON BARSTOW ST. 10 MILES TO ALAMEDA AVE. THE STATION IS LOCATED IN THE NORTHEAST QUADRANT OF THE INTERSECTION. THE STATION MARK IS A STANDARD ACS MASS TABLET STAMPED "1-820", SET IN TOP OF A CONCRETE POST PROJECTING 0.1 FEET ABOVE GROUND.
MSLD ELEVATION = 5474.53'

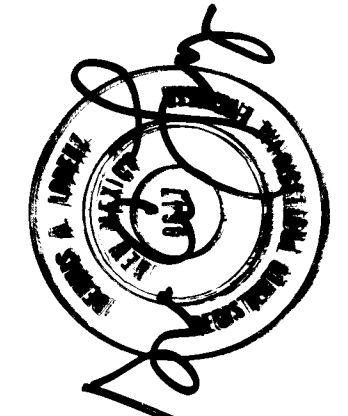


8/19/07

8/8/07


8/8/07

REMARKS:
REVISIONS
DATE
BY
D.A.L.

5520
5510
5500
5490
5480
5470
5460
5450
5440
5430

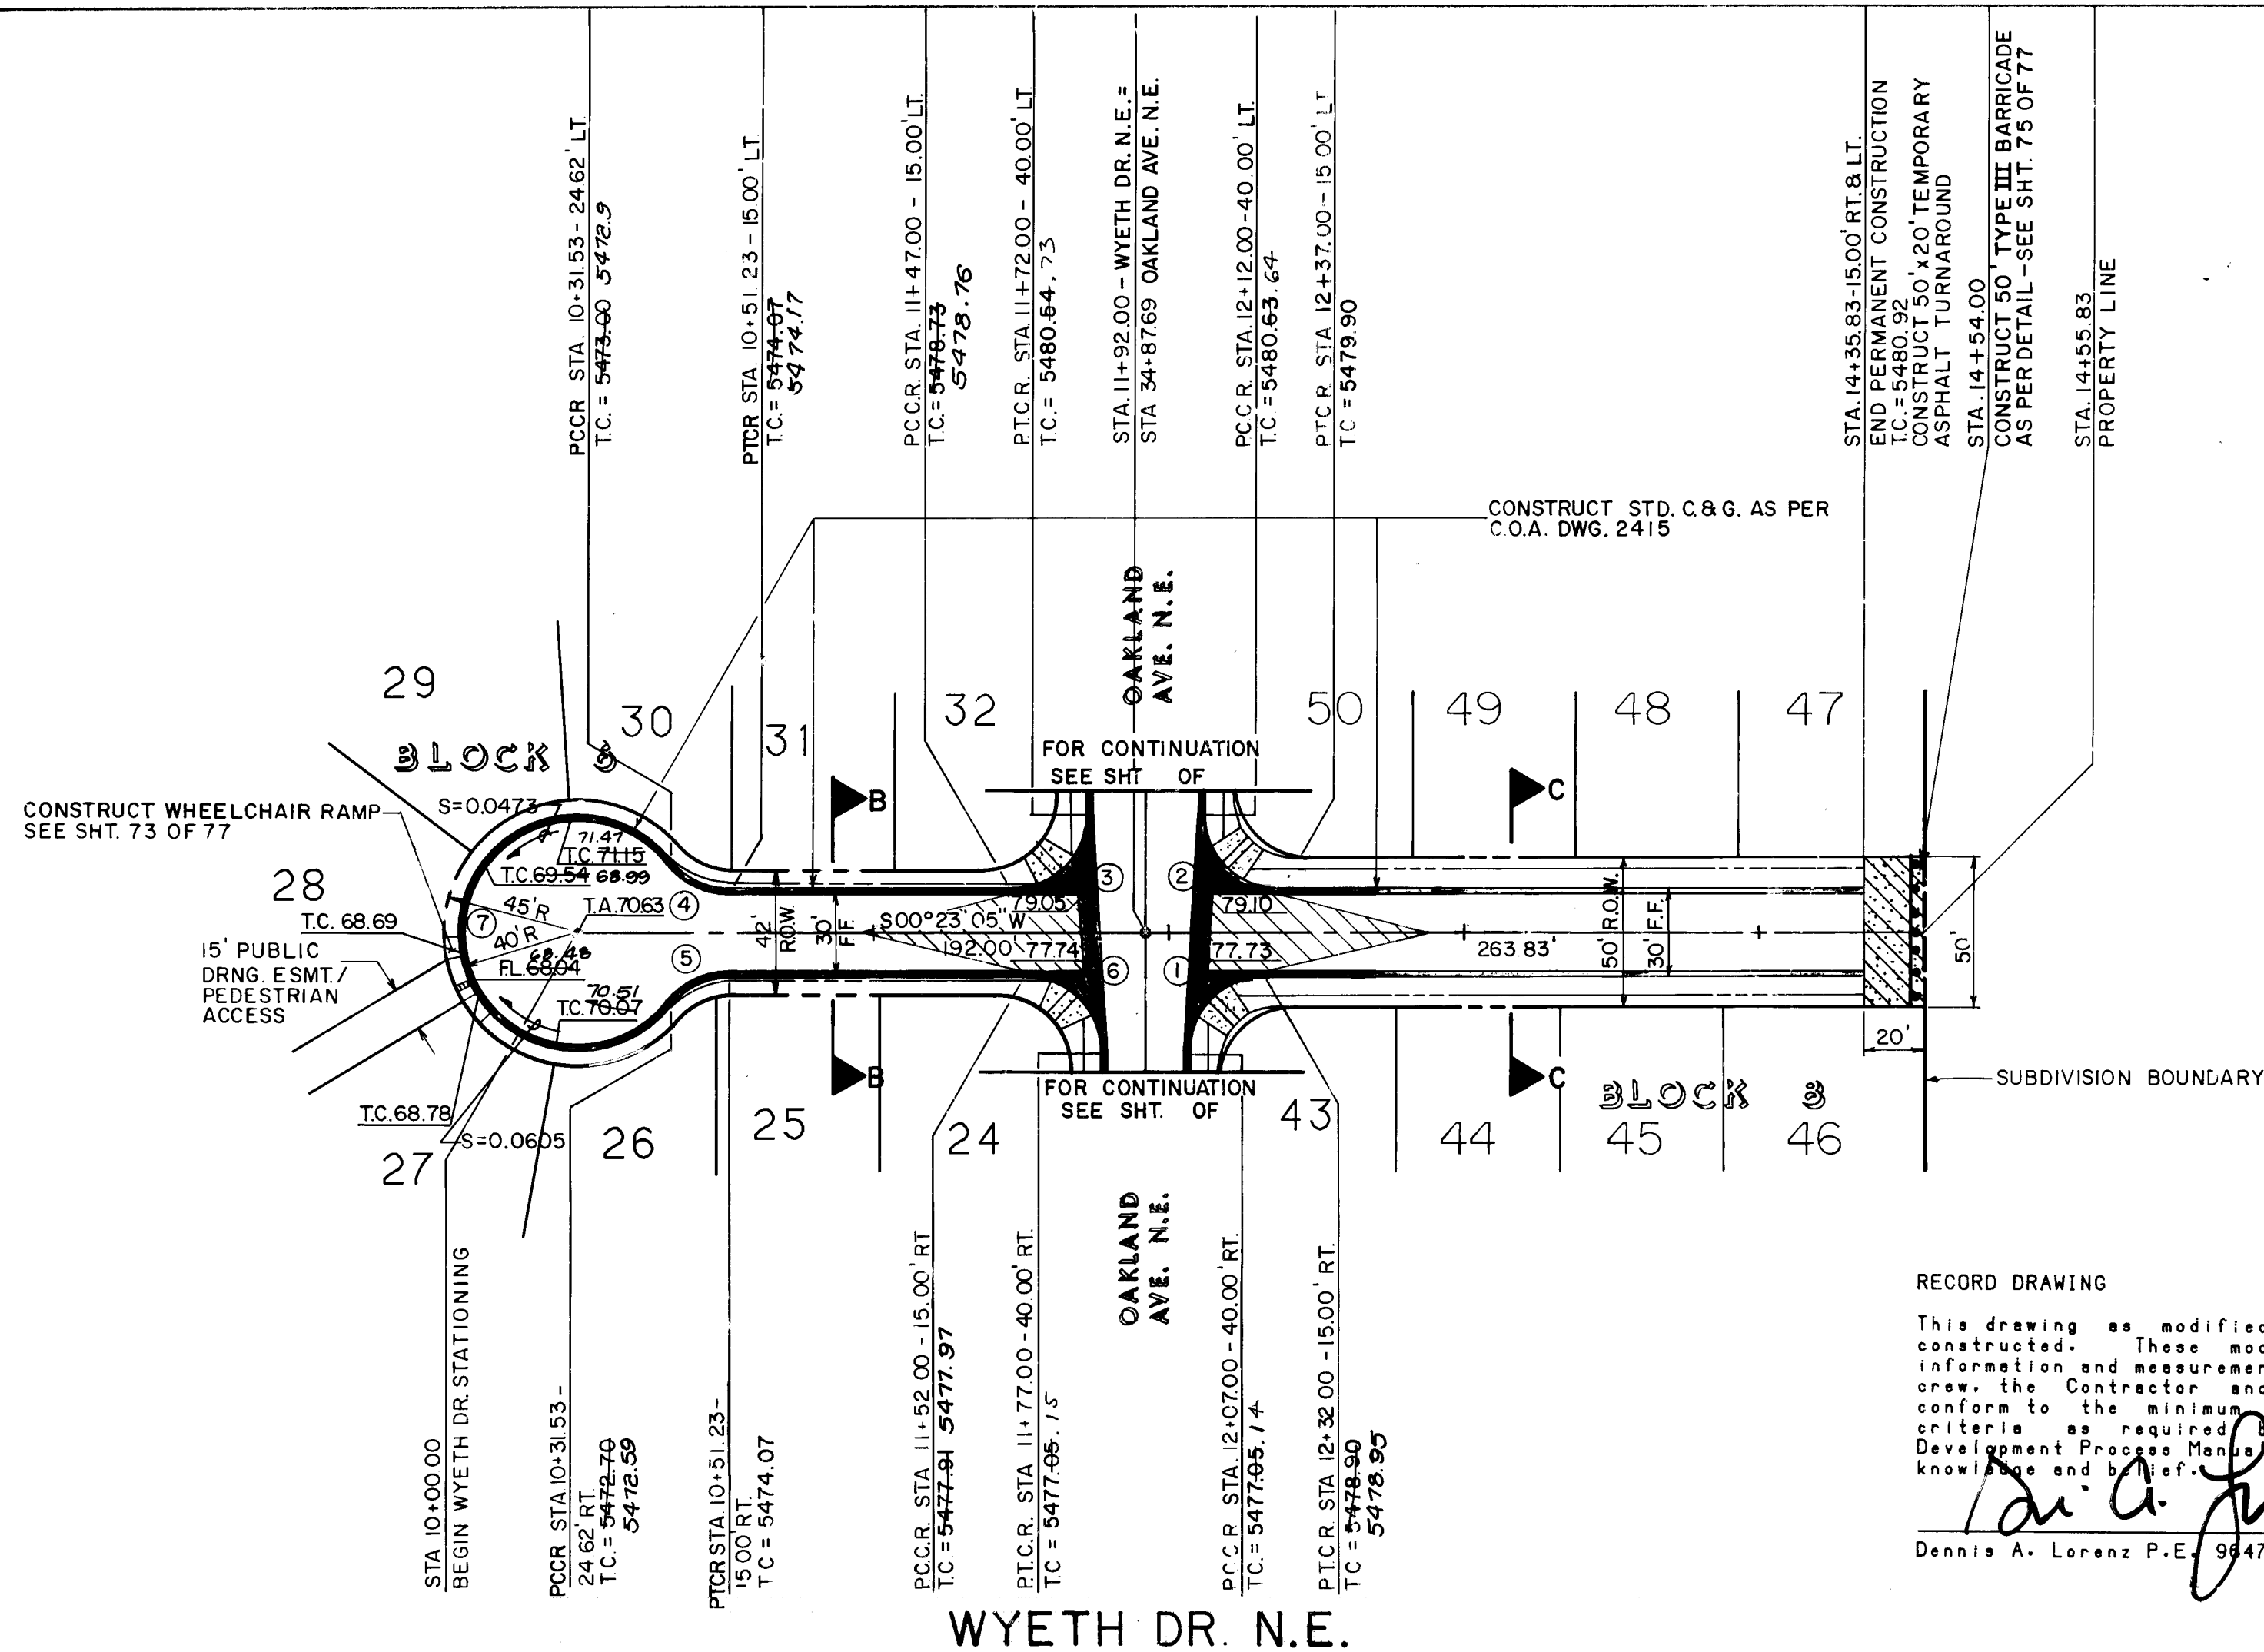

RECORD DRAWING
This drawing as modified shows public improvements as constructed. These modifications have been made using information and measurements obtained from the field survey crew, the Contractor and City. The modifications conform to the minimum requirements of the record drawing criteria as required by the City of Albuquerque per Development Process Manual Section 2.4.4 to the best of my knowledge and belief.
Dennis A. Lorenz
Dennis A. Lorenz P.E. 9847 Date 3-14-88

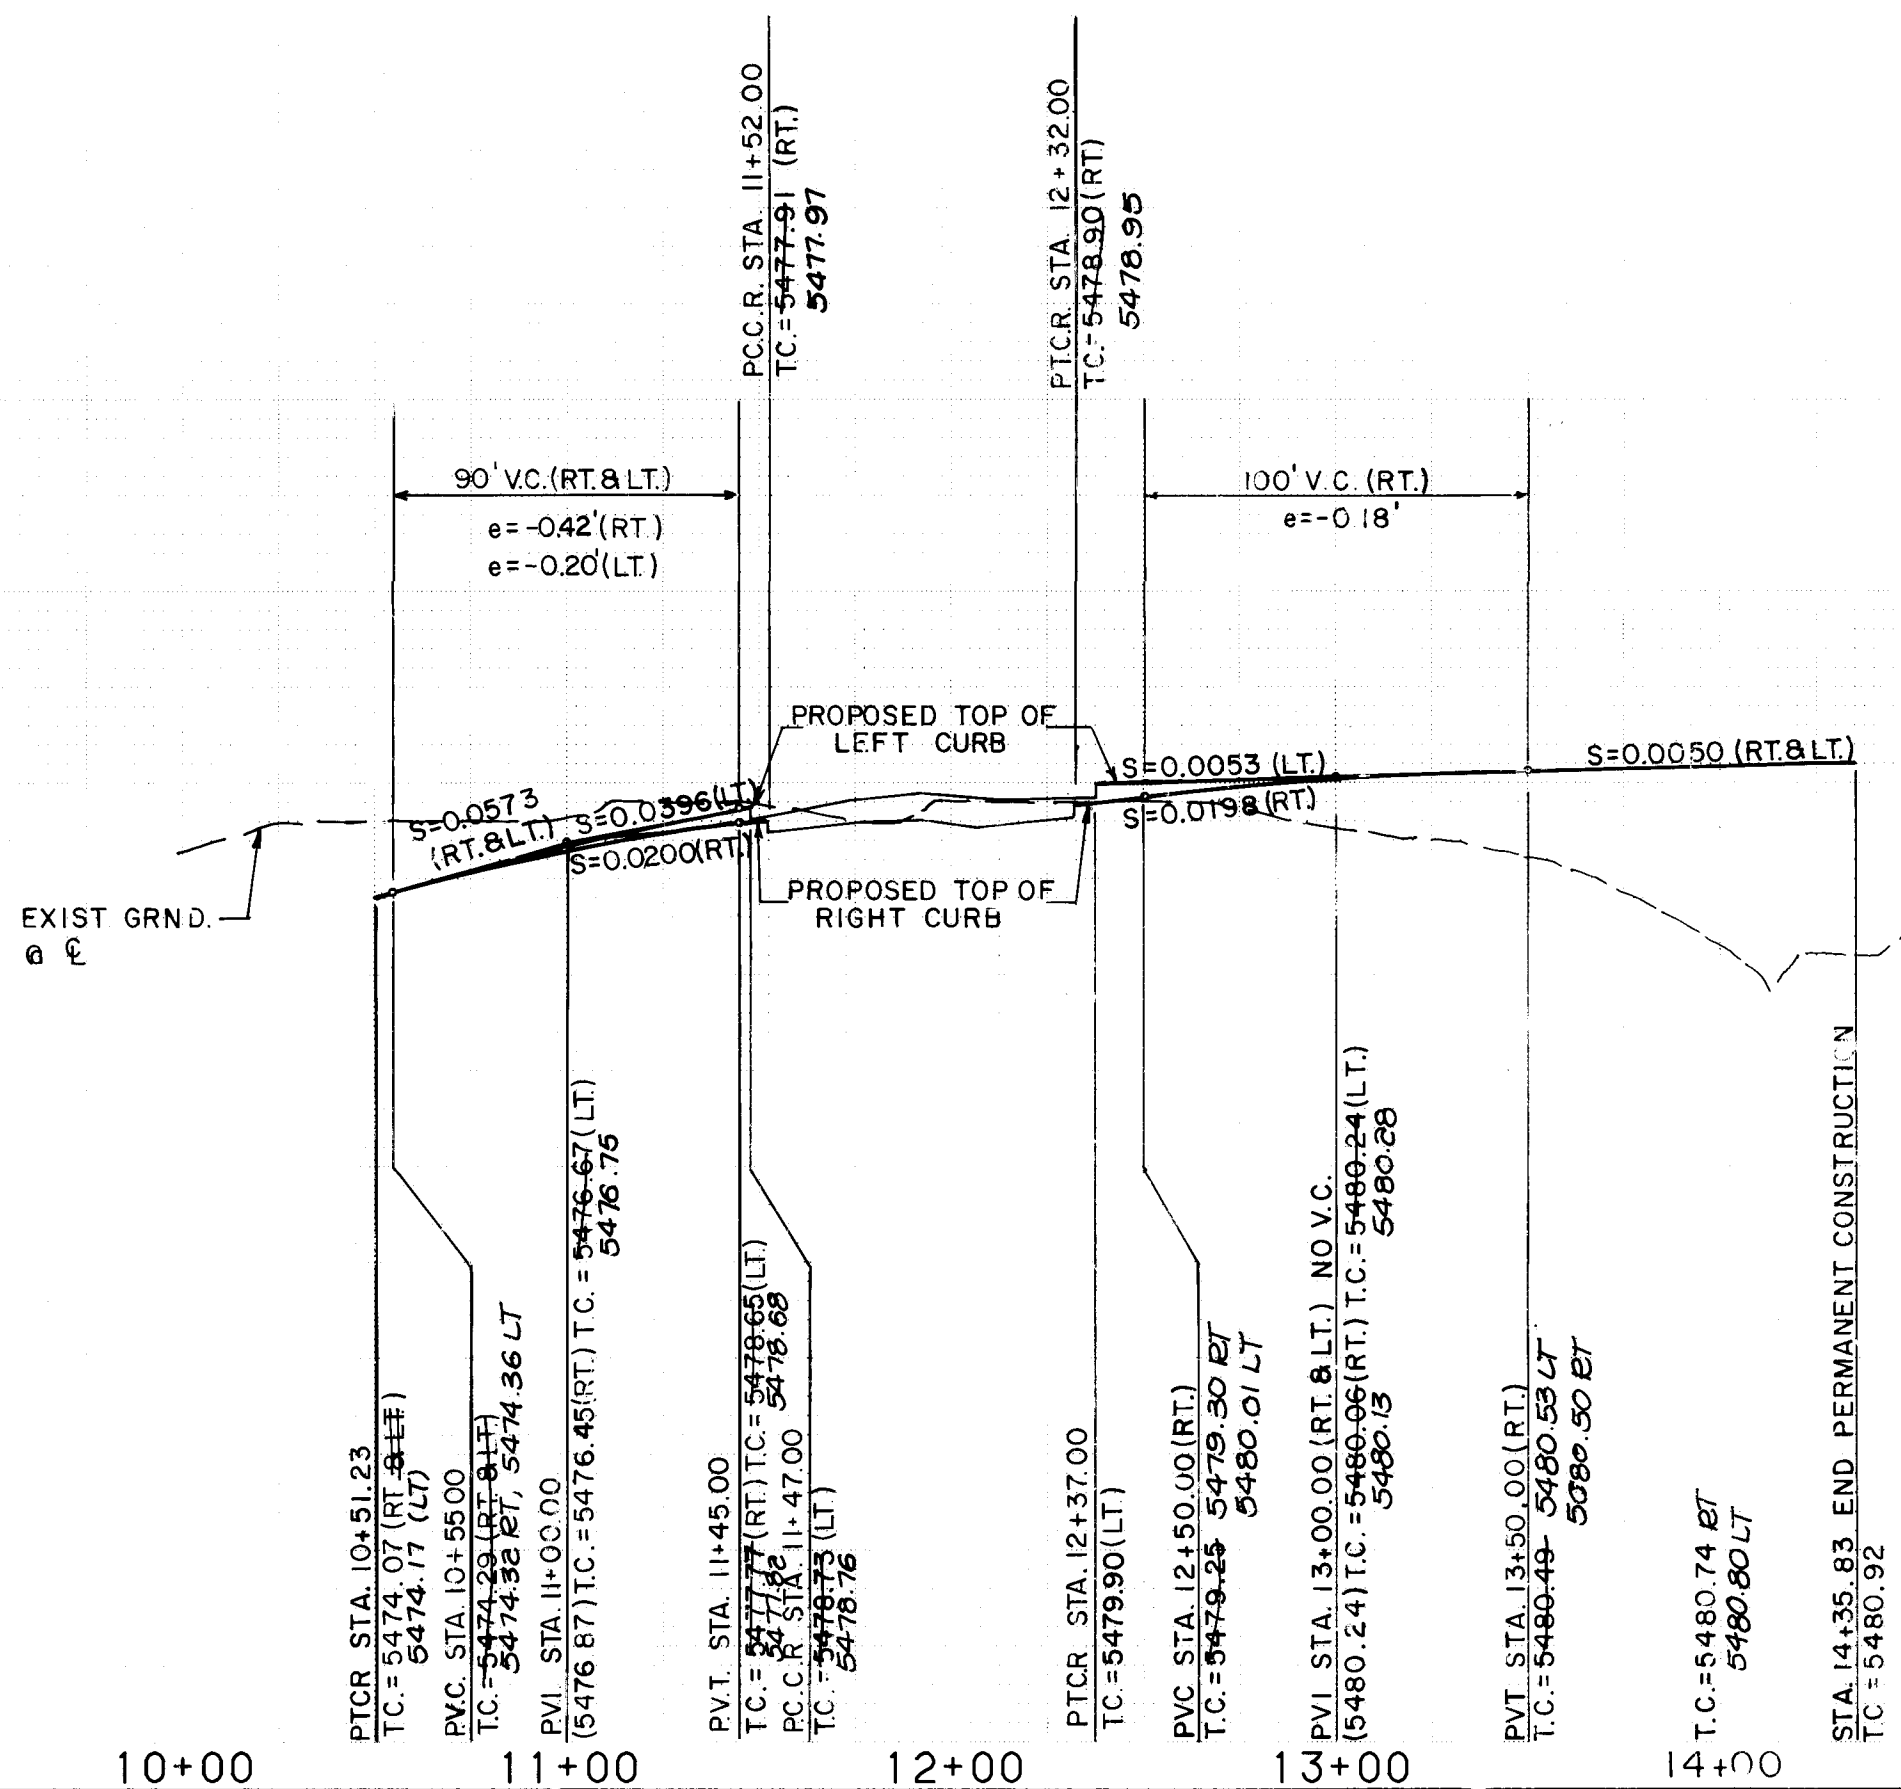

1 2 3 4 5 6 7 8 9 10 11 12
26 3 1 8 6 3 4 8 8

NO.	DELTA	RADIUS	LENGTH	TAN
1	90°00'00"	25.00	39.27	25.00
2	90°00'00"	25.00	39.27	25.00
3	90°00'00"	25.00	39.27	25.00
4	90°00'00"	25.00	39.27	25.00
5	90°00'00"	25.00	39.27	25.00
6	90°00'00"	25.00	39.27	25.00
7	284°02'25"	40.00	198.30	999999.98

PAVING

- ALL STATIONING AND OFFSET DIMENSIONS ARE BASED ON CENTERLINE OF RIGHT-OF-WAY.
- THE FOLLOWING CITY OF ALBUQUERQUE STANDARD DRAWINGS ARE APPLICABLE TO THE PAVING CONSTRUCTION:

2401	2415	2422
2405	2418	2430
2407	2420	2440
2408	2421	2441

LEGEND

	EXISTING CURB & GUTTER AND SIDEWALK
	EXISTING DRIVEWAYS
	EXISTING LIMITS OF ASPHALT PAVEMENT
	PROPERTY OR BOUNDARY LINE
	CENTERLINE OF STREET
	PROPOSED CURB & GUTTER
	PROPOSED SIDEWALK
	PROPOSED CONCRETE VALLEY GUTTER
	PROPOSED WHEELCHAIR RAMP
	FUTURE CURB & GUTTER
	FUTURE SIDEWALK
	FUTURE CONCRETE VALLEY GUTTER
	FUTURE WHEELCHAIR RAMP
	TEMPORARY PAVING

ESPEY,
HUSTON &
ASSOCIATES, INC.
Engineering & Environmental Consultants
317 COMMERCIAL ST. N.E.
ALBUQUERQUE, NEW MEXICO 87102
PHONE: (505) 242-1909

CITY OF ALBUQUERQUE
PUBLIC WORKS DEPARTMENT
ENGINEERING DIVISION

TITLE: NOR ESTE ESTATES
WYETH DR. N.E.
STA. 10+00.00 TO STA. 14+55.83

APPROVALS	ENGINEER	DATE	APPROVALS	ENGINEER	DATE
City Engineer	<i>[Signature]</i>	10/5/87	Liquid Waste	<i>[Signature]</i>	8/3/87
A.C.E. - Design			Traffic	<i>[Signature]</i>	7/16/87
A.C.E. - Hydrology	<i>[Signature]</i>	9-1-87	Water	<i>[Signature]</i>	8/3/87

DRAWING NO. 3186 MAP NO. C-19 SHEET 34 OF 77

AS BUILT INFORMATION
NEW CONCEPTS
EHA 87.88
EHA 88.88
EHA 89.88
EHA 990.88
EHA



L E G E N D

EXISTING CURB & GUTTER
AND SIDEWALK

EXISTING DRIVEPADS

EXISTING LIMITS OF ASPHALT
PAVEMENT

PROPERTY OR BOUNDARY LINE

CENTERLINE OF STREET

PROPOSED CURB & GUTTER

PROPOSED SIDEWALK

PROPOSED CONCRETE VALLEY
GUTTER

PROPOSED WHEELCHAIR RAMP

FUTURE CURB & GUTTER

FUTURE SIDEWALK

FUTURE CONCRETE VALLEY
GUTTER



FUTURE WHEELCHAIR RAMP

TRANSITION FROM CROWN TO
NO CROWN

CITY OF ALBUQUERQUE
PUBLIC WORKS DEPARTMENT
ENGINEERING GROUP

10/5/87	10/16/87	8/24/87	9-2-87
---------	----------	---------	--------

DRAWING NO	3186	MAP NO	C-19	SHEET	35	OF	77
---------------	------	--------	------	-------	----	----	----

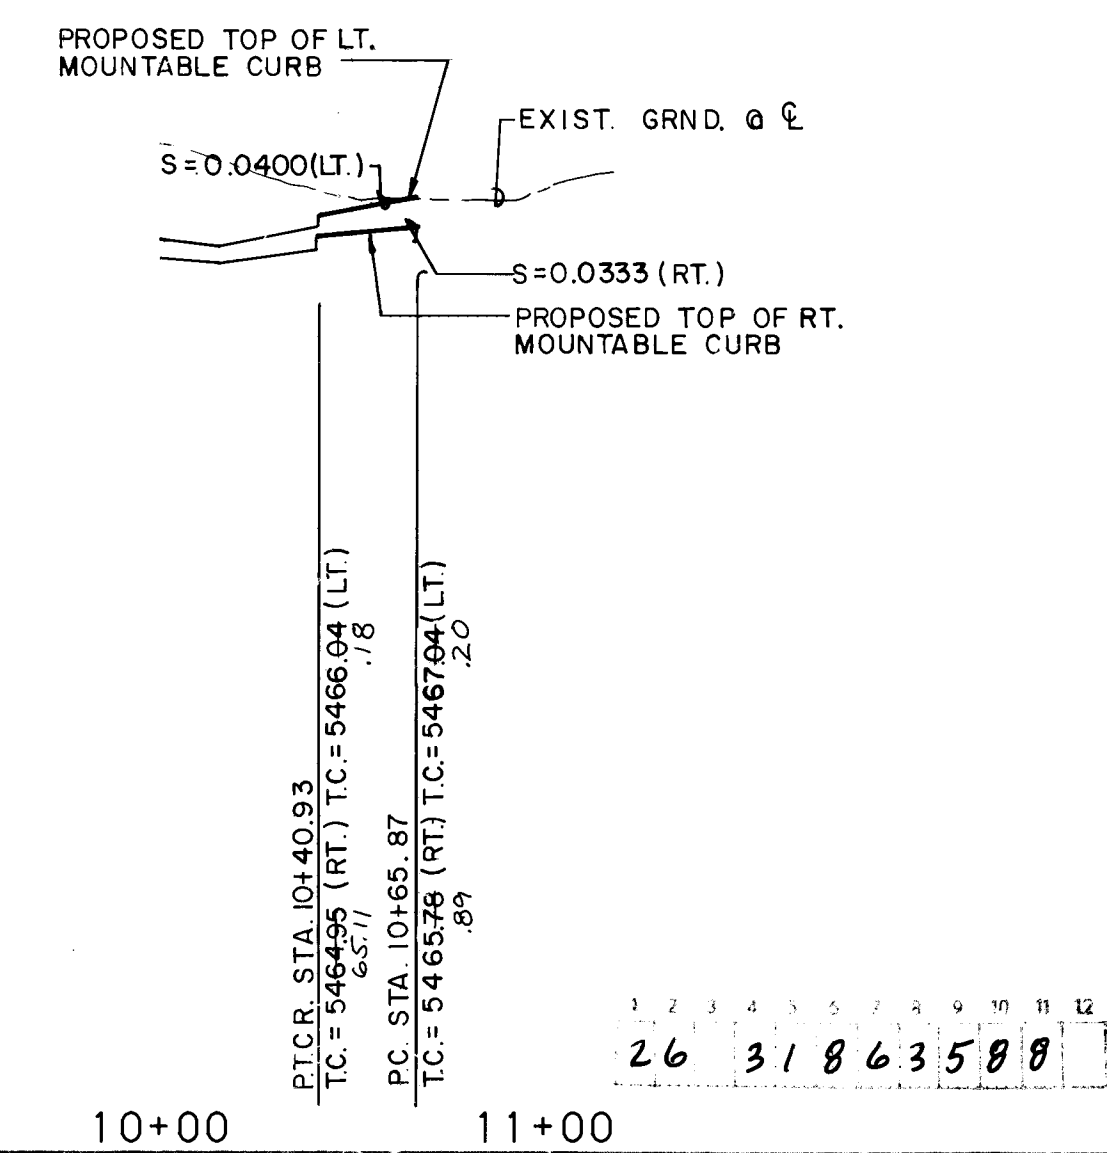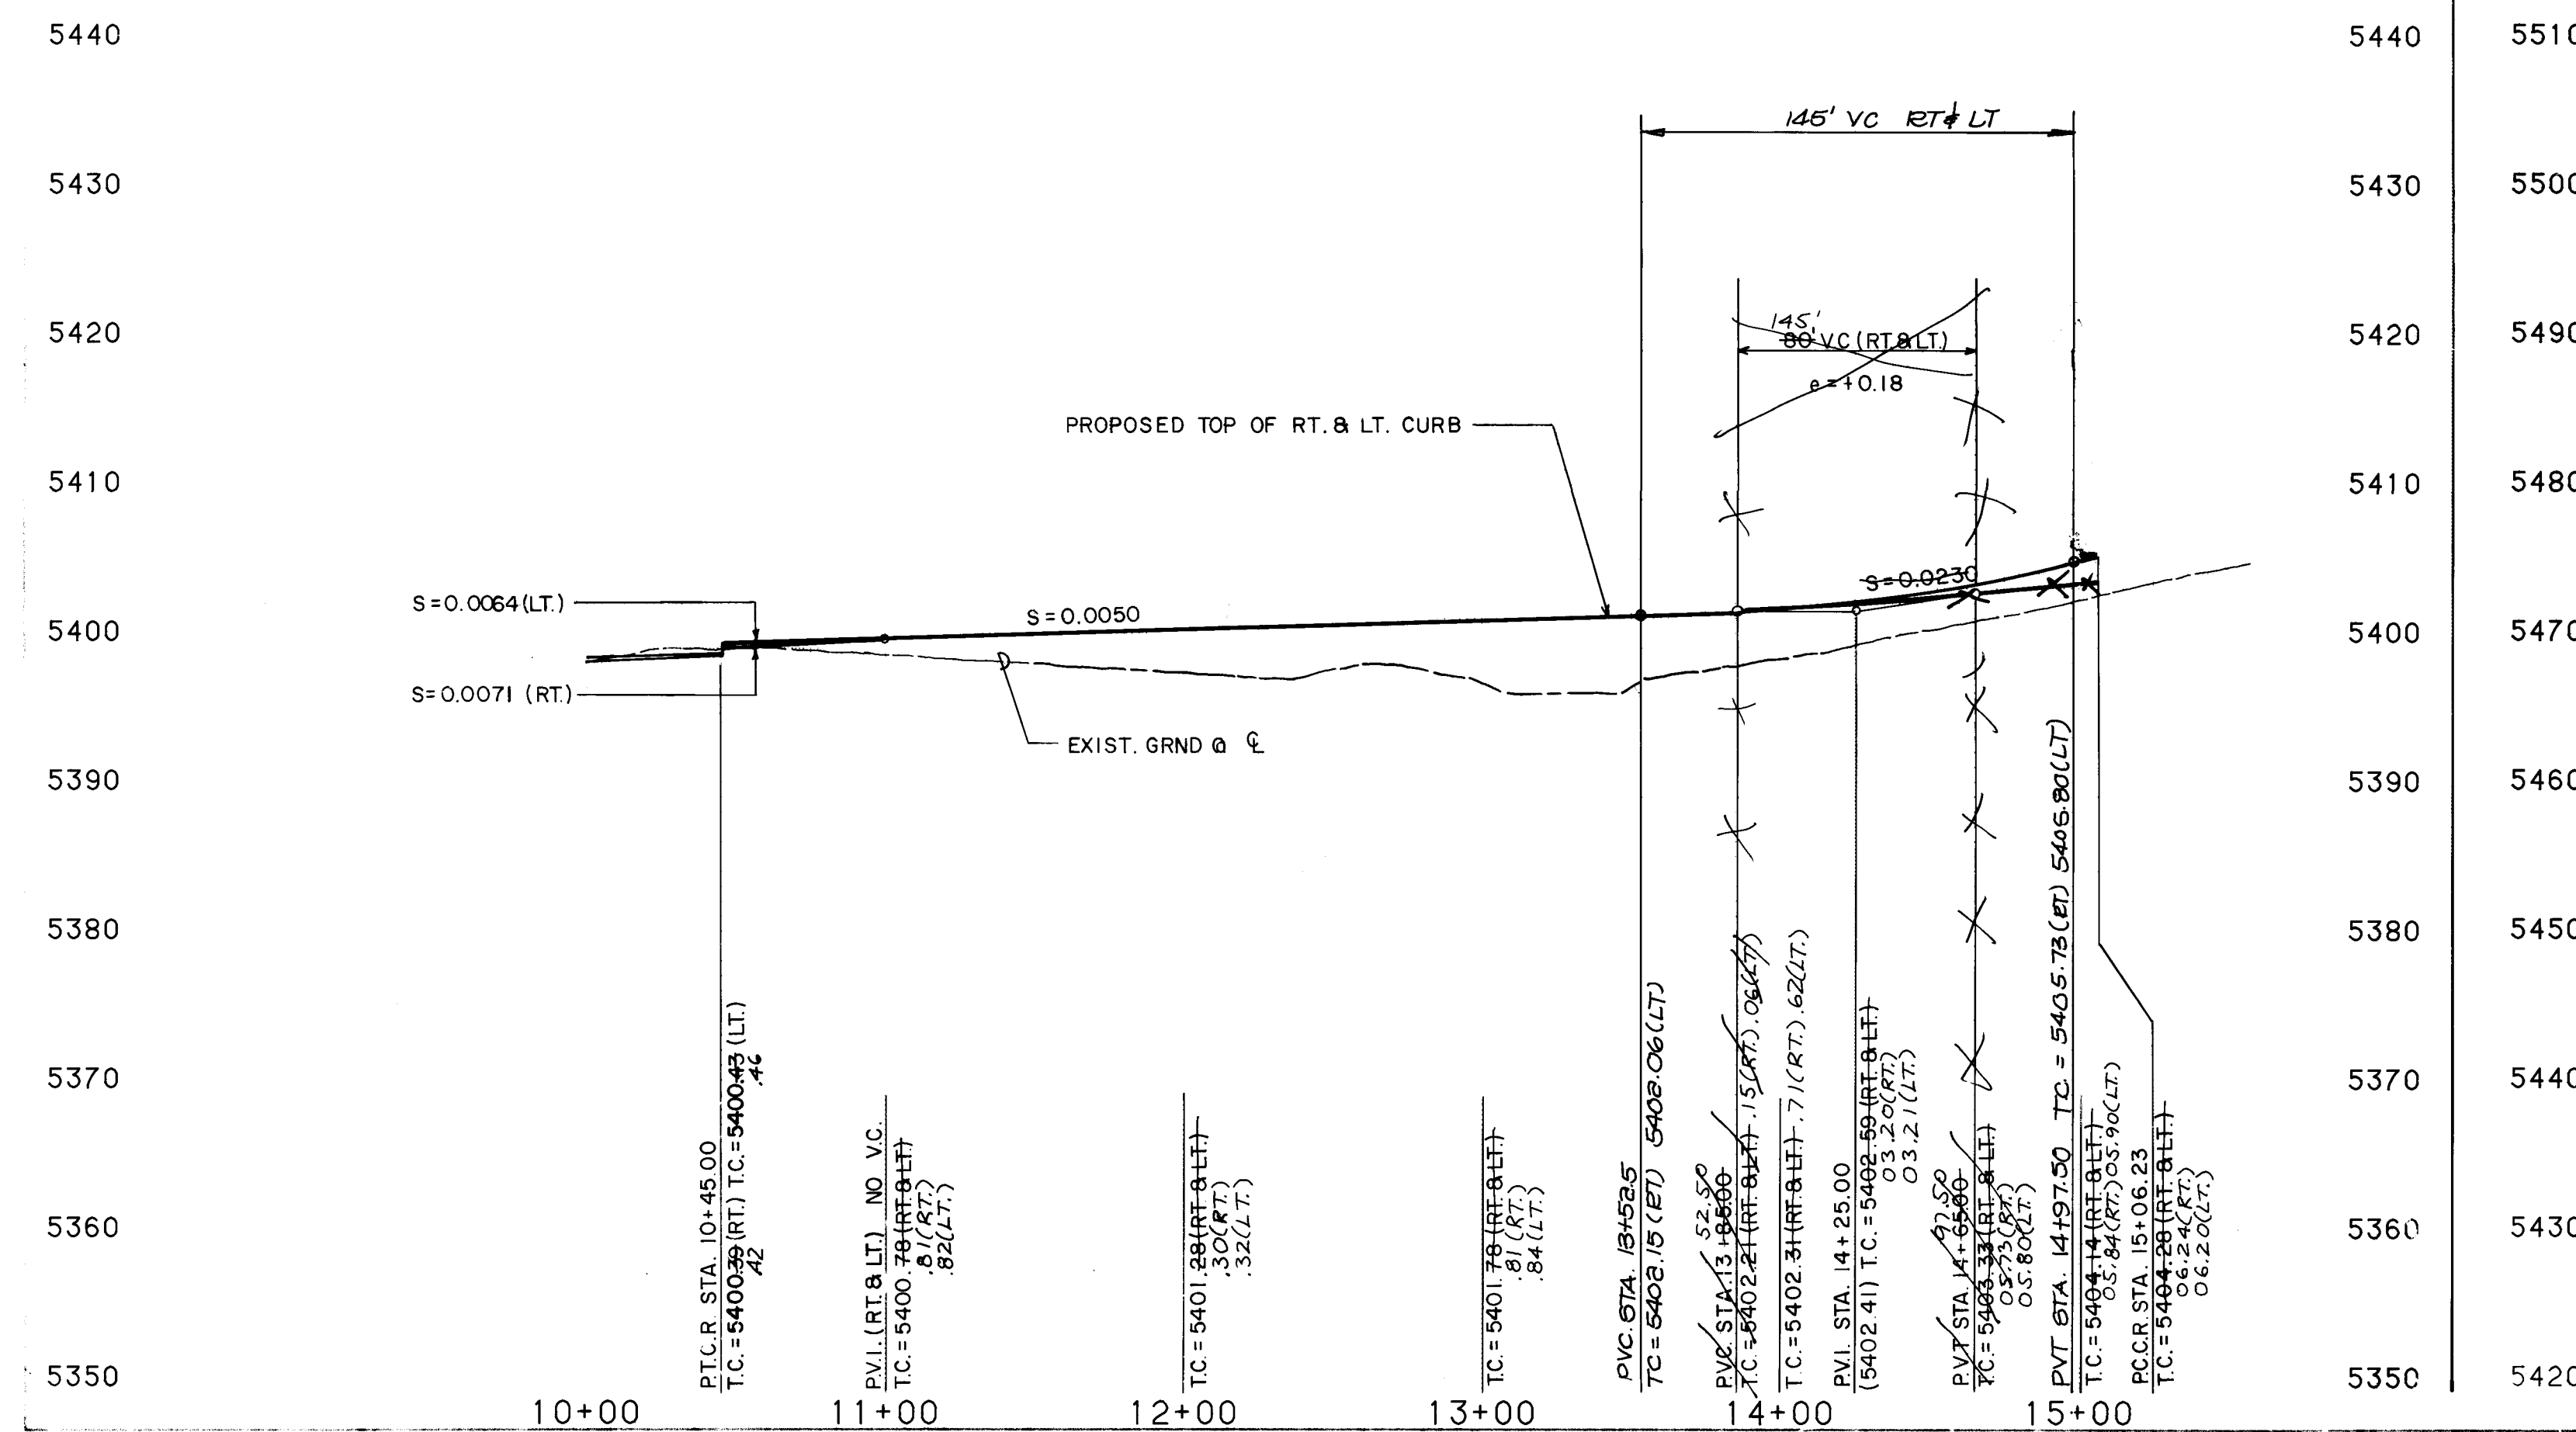

5440
5430
5420
5410
5400
5390
5380
5370
5360
5350

8+00

9+00

10+00

11+00

12+00

13+00


14+00

15+00

16+00

17+00

18+00

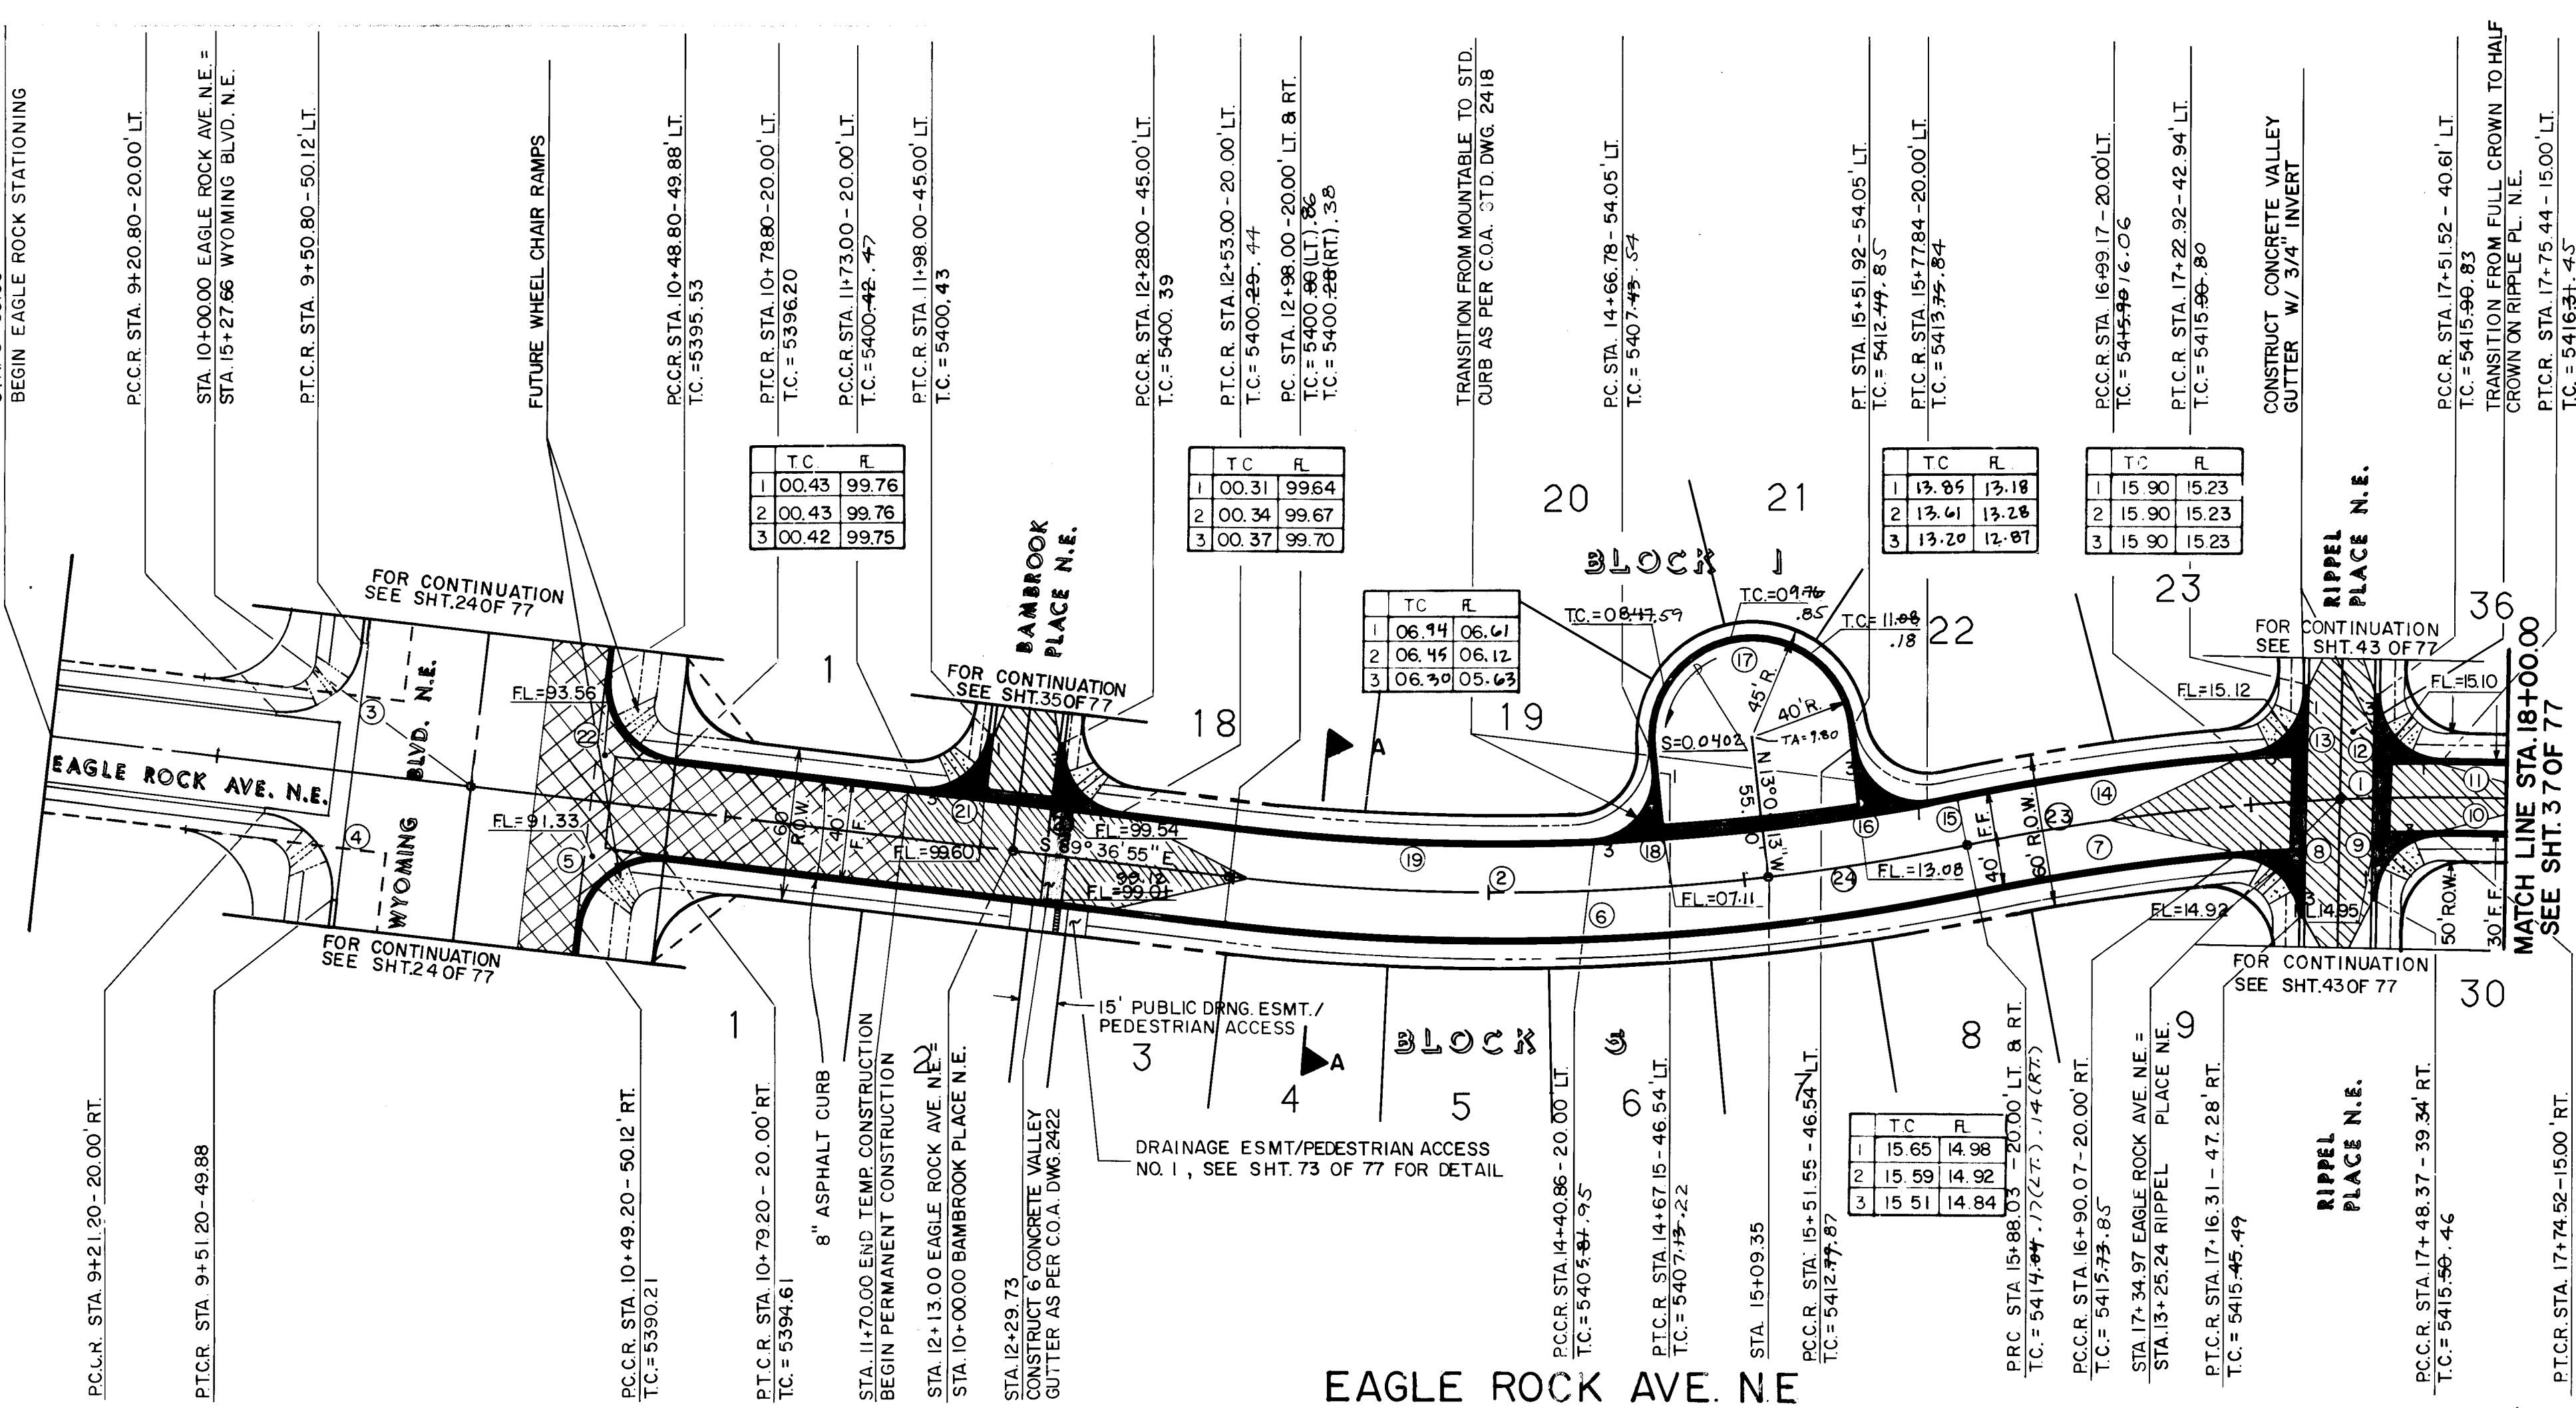

EAGLE ROCK AVE. NE

RECORD DRAWING
This drawing shows modified public improvements as constructed. These modifications have been made using the original drawings and field notes. The modifications conform to the minimum requirements for record drawing as required by the City of Albuquerque per the Engineering Department. The best of my knowledge and belief, this drawing is true and correct.
Dennis A. Lorenz P.E. 1967
Date


SCALE:
HORIZ. 1" = 50'
VERT. 1" = 10'

LEGEND				
---	EXISTING CURB & GUTTER AND SIDEWALK			
---	EXISTING DRIVEPADS			
---	EXISTING LIMITS OF ASPHALT PAVEMENT			
---	PROPERTY OR BOUNDARY LINE			
---	CENTERLINE OF STREET			
---	PROPOSED CURB & GUTTER			
---	PROPOSED SIDEWALK			
---	PROPOSED CONCRETE VALLEY GUTTER			
---	PROPOSED WHEELCHAIR RAMP			
---	FUTURE CURB & GUTTER			
---	FUTURE SIDEWALK			
---	FUTURE CONCRETE VALLEY GUTTER			
---	FUTURE WHEELCHAIR RAMP			
---	TRANSITION FROM CROWN TO NO CROWN			
---	TEMPORARY PAVING			
---	ESPEY, HUSTON & ASSOCIATES, INC. Engineering & Environmental Consultants 317 COMMERCIAL ST. N.E. ALBUQUERQUE, NEW MEXICO 87102 PHONE: (505) 242-1909			
---	NOR ESTE ESTATES EAGLE ROCK AVE. N.E. STA. 8+35.00 TO STA. 18+00.00			

NO.	DELTA	RADIUS	LENGTH	TAN
1	4°08'24"	900.00	65.03	32.53
2	13°27'18"	900.00	211.35	106.16
3	90°13'55"	30.00	47.25	30.12
4	89°48'05"	30.00	47.00	29.88
5	90°13'55"	30.00	47.25	30.12
6	18°27'51"	920.00	296.48	149.54
7	6°29'44"	880.00	99.77	49.94
8	86°10'51"	920.00	41.92	27.80
9	89°18'43"	920.00	36.92	24.70
10	1°37'21"	885.00	25.06	12.53
11	1°33'50"	915.00	24.98	12.48
12	80°37'46"	25.00	39.54	25.71
13	84°30'54"	25.00	36.88	25.28
14	7°04'30"	920.00	113.60	56.87
15	0°38'57"	880.00	9.97	4.98
16	84°21'36"	25.00	41.17	26.98
17	94°05'42"	880.00	139.69	69.99
18	90°00'00"	25.00	39.27	25.00
19	89°46'05"	30.00	47.00	29.88
20	9°21'16"	900.00	146.94	73.63
21	5°00'33"	900.00	78.68	39.37

PAVING			
1. ALL STATIONING AND OFFSET DIMENSIONS ARE BASED ON CENTERLINE OF RIGHT-OF-WAY.			
2. THE FOLLOWING CITY OF ALBUQUERQUE STANDARD DRAWINGS ARE APPLICABLE TO THE PAVING CONSTRUCTION:			
2401	2415	2422	
2405	2418	2430	
2407	2420	2440	
2408	2421	2441	

THE STATION IS LOCATED 9 MILES NORTHEAST OF DOWNTOWN ALBUQUERQUE TO REACH THE STATION FROM THE INTERSECTION OF LOUISIANA BLVD. AND LOS ANGELES DRIVE, GO EAST ON LOS ANGELES DRIVE 10 MILES TO BARSTOW ST., THEN NORTH ON BARSTOW ST. 10 MILES TO ALAMEDA AVE. THE STATION IS LOCATED IN THE NORTHEAST QUADRANT OF THE INTERSECTION. THE STATION MARK IS A STANDARD ACS BRASS TABLET STAMPED "1-820", SET IN TOP OF A CONCRETE POST PROJECTING 0.1 FEET ABOVE GROUND.
FIELD ELEVATION = 5474.53'

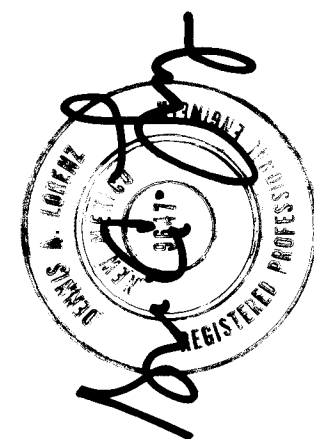

9/1/07

9/07
8/8/07



JP
D.A.C.

26 3 1 8 6 3 6 8

3186

C-19

36 77

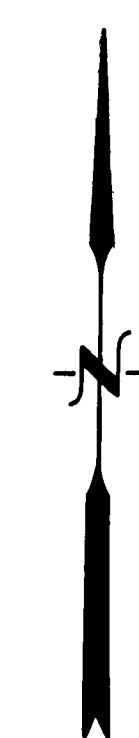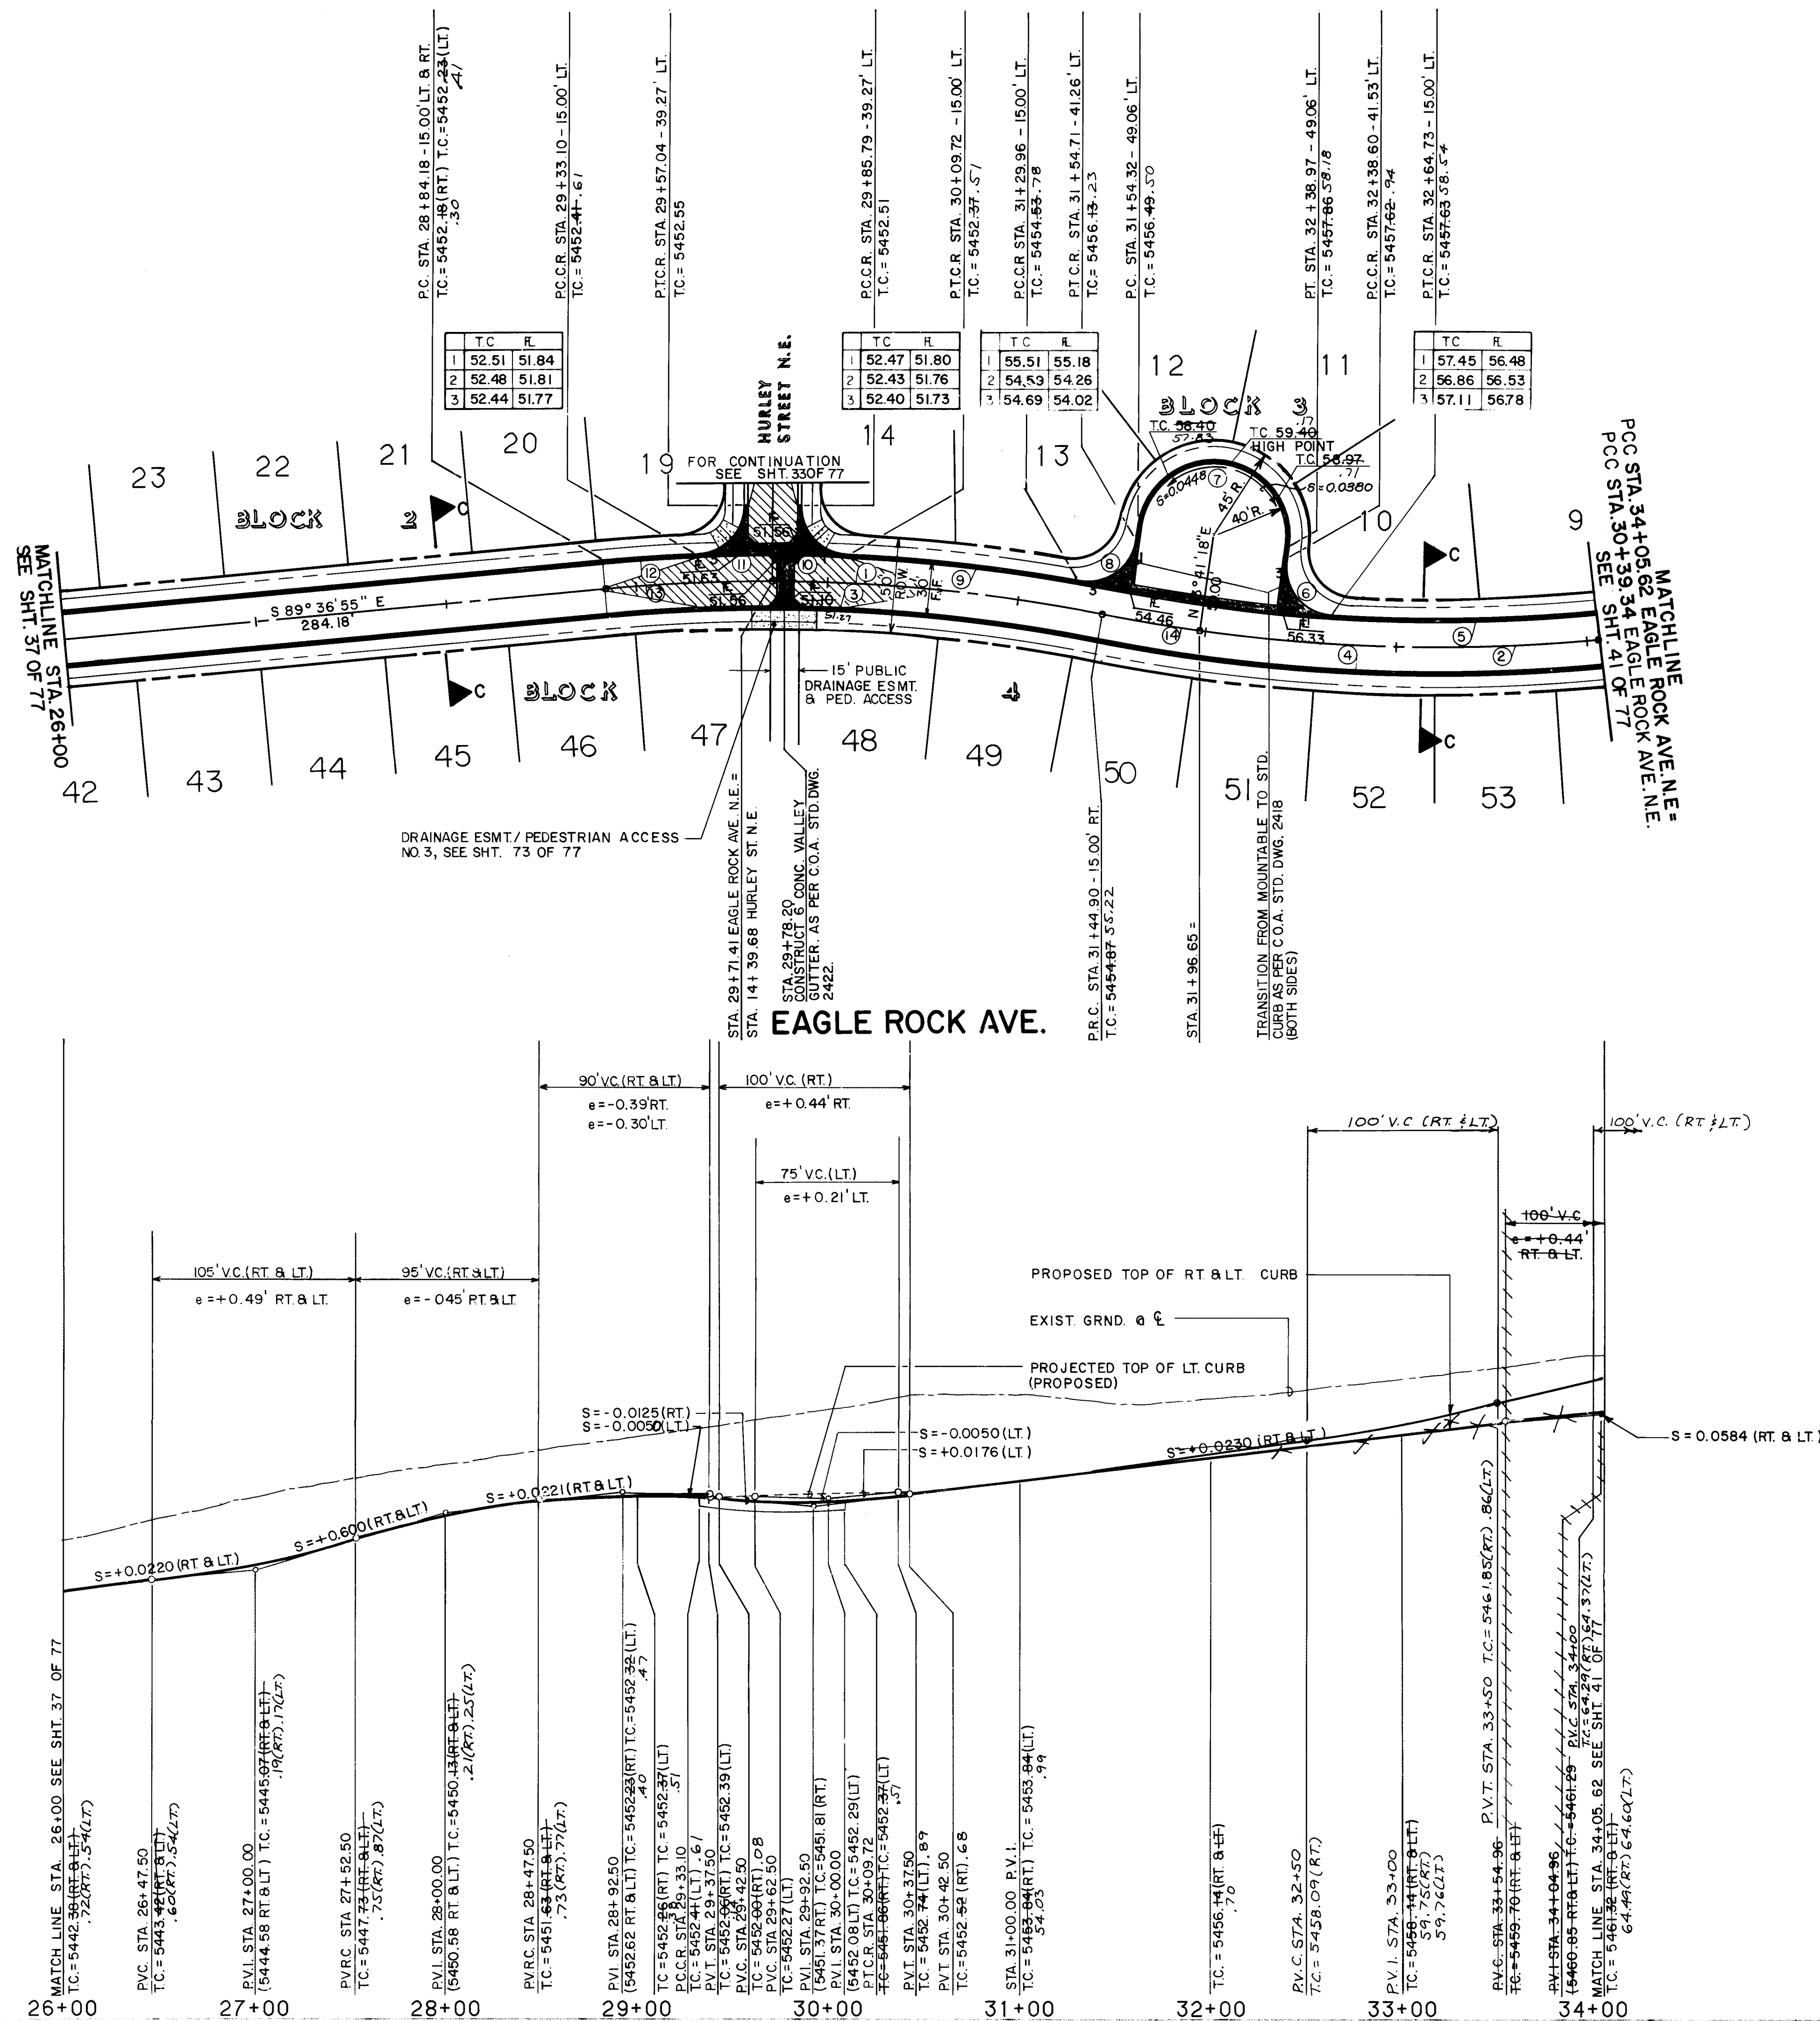

NO.	DELTA	RADIUS	LENGTH	TAN
1	11°02'40"	900.00	173.49	87.01
2	13°18'13"	900.00	208.97	104.96
3	16°35'52"	885.00	256.37	129.09
4	16°35'52"	915.00	265.06	133.47
5	8°58'08"	885.00	138.54	69.41
6	94°20'05"	25.00	41.16	26.97
7	180°00'00"	40.00	125.66	999999.98
8	92°20'36"	25.00	40.29	26.04
9	7°39'17"	915.00	122.24	61.21
10	87°33'40"	25.00	38.21	23.96
11	87°33'40"	25.00	38.21	23.96
12	3°08'52"	915.00	49.74	24.88
13	5°33'12"	900.00	87.23	43.55
14	3°17'39"	900.00	51.75	25.88

PAVING

- ALL STATIONING AND OFFSET DIMENSIONS ARE BASED ON CENTERLINE OF RIGHT-OF-WAY.
- THE FOLLOWING CITY OF ALBUQUERQUE STANDARD DRAWINGS ARE APPLICABLE TO THE PAVING CONSTRUCTION:

2401	2415	2422
2405	2418	2430
2407	2420	2440
2408	2421	2441

LEGEND

SCALE:
HORIZ. 1" = 50'
VERT. 1" = 10'

- EXISTING CURB & GUTTER AND SIDEWALK
- EXISTING DRIVEPADS
- EXISTING LIMITS OF ASPHALT PAVEMENT
- PROPERTY OR BOUNDARY LINE
- CENTERLINE OF STREET
- PROPOSED CURB & GUTTER
- PROPOSED SIDEWALK
- PROPOSED CONCRETE VALLEY GUTTER
- PROPOSED WHEELCHAIR RAMP
- FUTURE CURB & GUTTER
- FUTURE SIDEWALK
- FUTURE CONCRETE VALLEY GUTTER
- FUTURE WHEELCHAIR RAMP
- TRANSITION FROM CROWN TO NO CROWN

1	2	3	4	5	6	7	8	9	10	11	12
26	3	1	8	6	3	8	8	8	8	8	8

ESPEY, HUSTON & ASSOCIATES, INC.
Engineering & Environmental Consultants

317 COMMERCIAL ST. N.E.
ALBUQUERQUE, NEW MEXICO 87102
PHONE: (505) 242-1909


NOR ESTE ESTATES
EAGLE ROCK AVE. N.E.
STA 26+00.00 TO STA. 34+05.62

RECORD DRAWING
This drawing as modified shows public improvements as constructed. These modifications have been made using the original drawings and field notes. The modifications are the property of the City of Albuquerque and are not to be used for any other purpose without the written consent of the City of Albuquerque.
Dennis A. Lorenz P.E. 8/17/07


THE STATION IS LOCATED 9 MILES NORTHEAST OF DOWNTOWN ALBUQUERQUE. TO REACH THE STATION FROM THE INTERSECTION OF LOUISIANA BLVD. AND LOS ANGELES DRIVE, GO EAST ON LOS ANGELES DRIVE 10 MILES TO BARSTOW ST. THEN NORTH ON BARSTOW ST. 1.0 MILES TO ALAMEDA AVE. THE STATION IS LOCATED IN THE NORTHEAST QUADRANT OF THE INTERSECTION. THE STATION MARK IS A STANDARD ACS BRASS TABLET STAMPED "1-820" SET IN TOP OF A CONCRETE POST PROJECTING 0.1 FEET ABOVE GROUND.
MSLD ELEVATION: 5474.53'

REMARKS
REVISED
DESIGN
8/19/07
8/19/07
8/19/07
JF
AS MC
D.A.C.

5470
5460
5450
5440
5430
5420
5410
5400
5390
5380

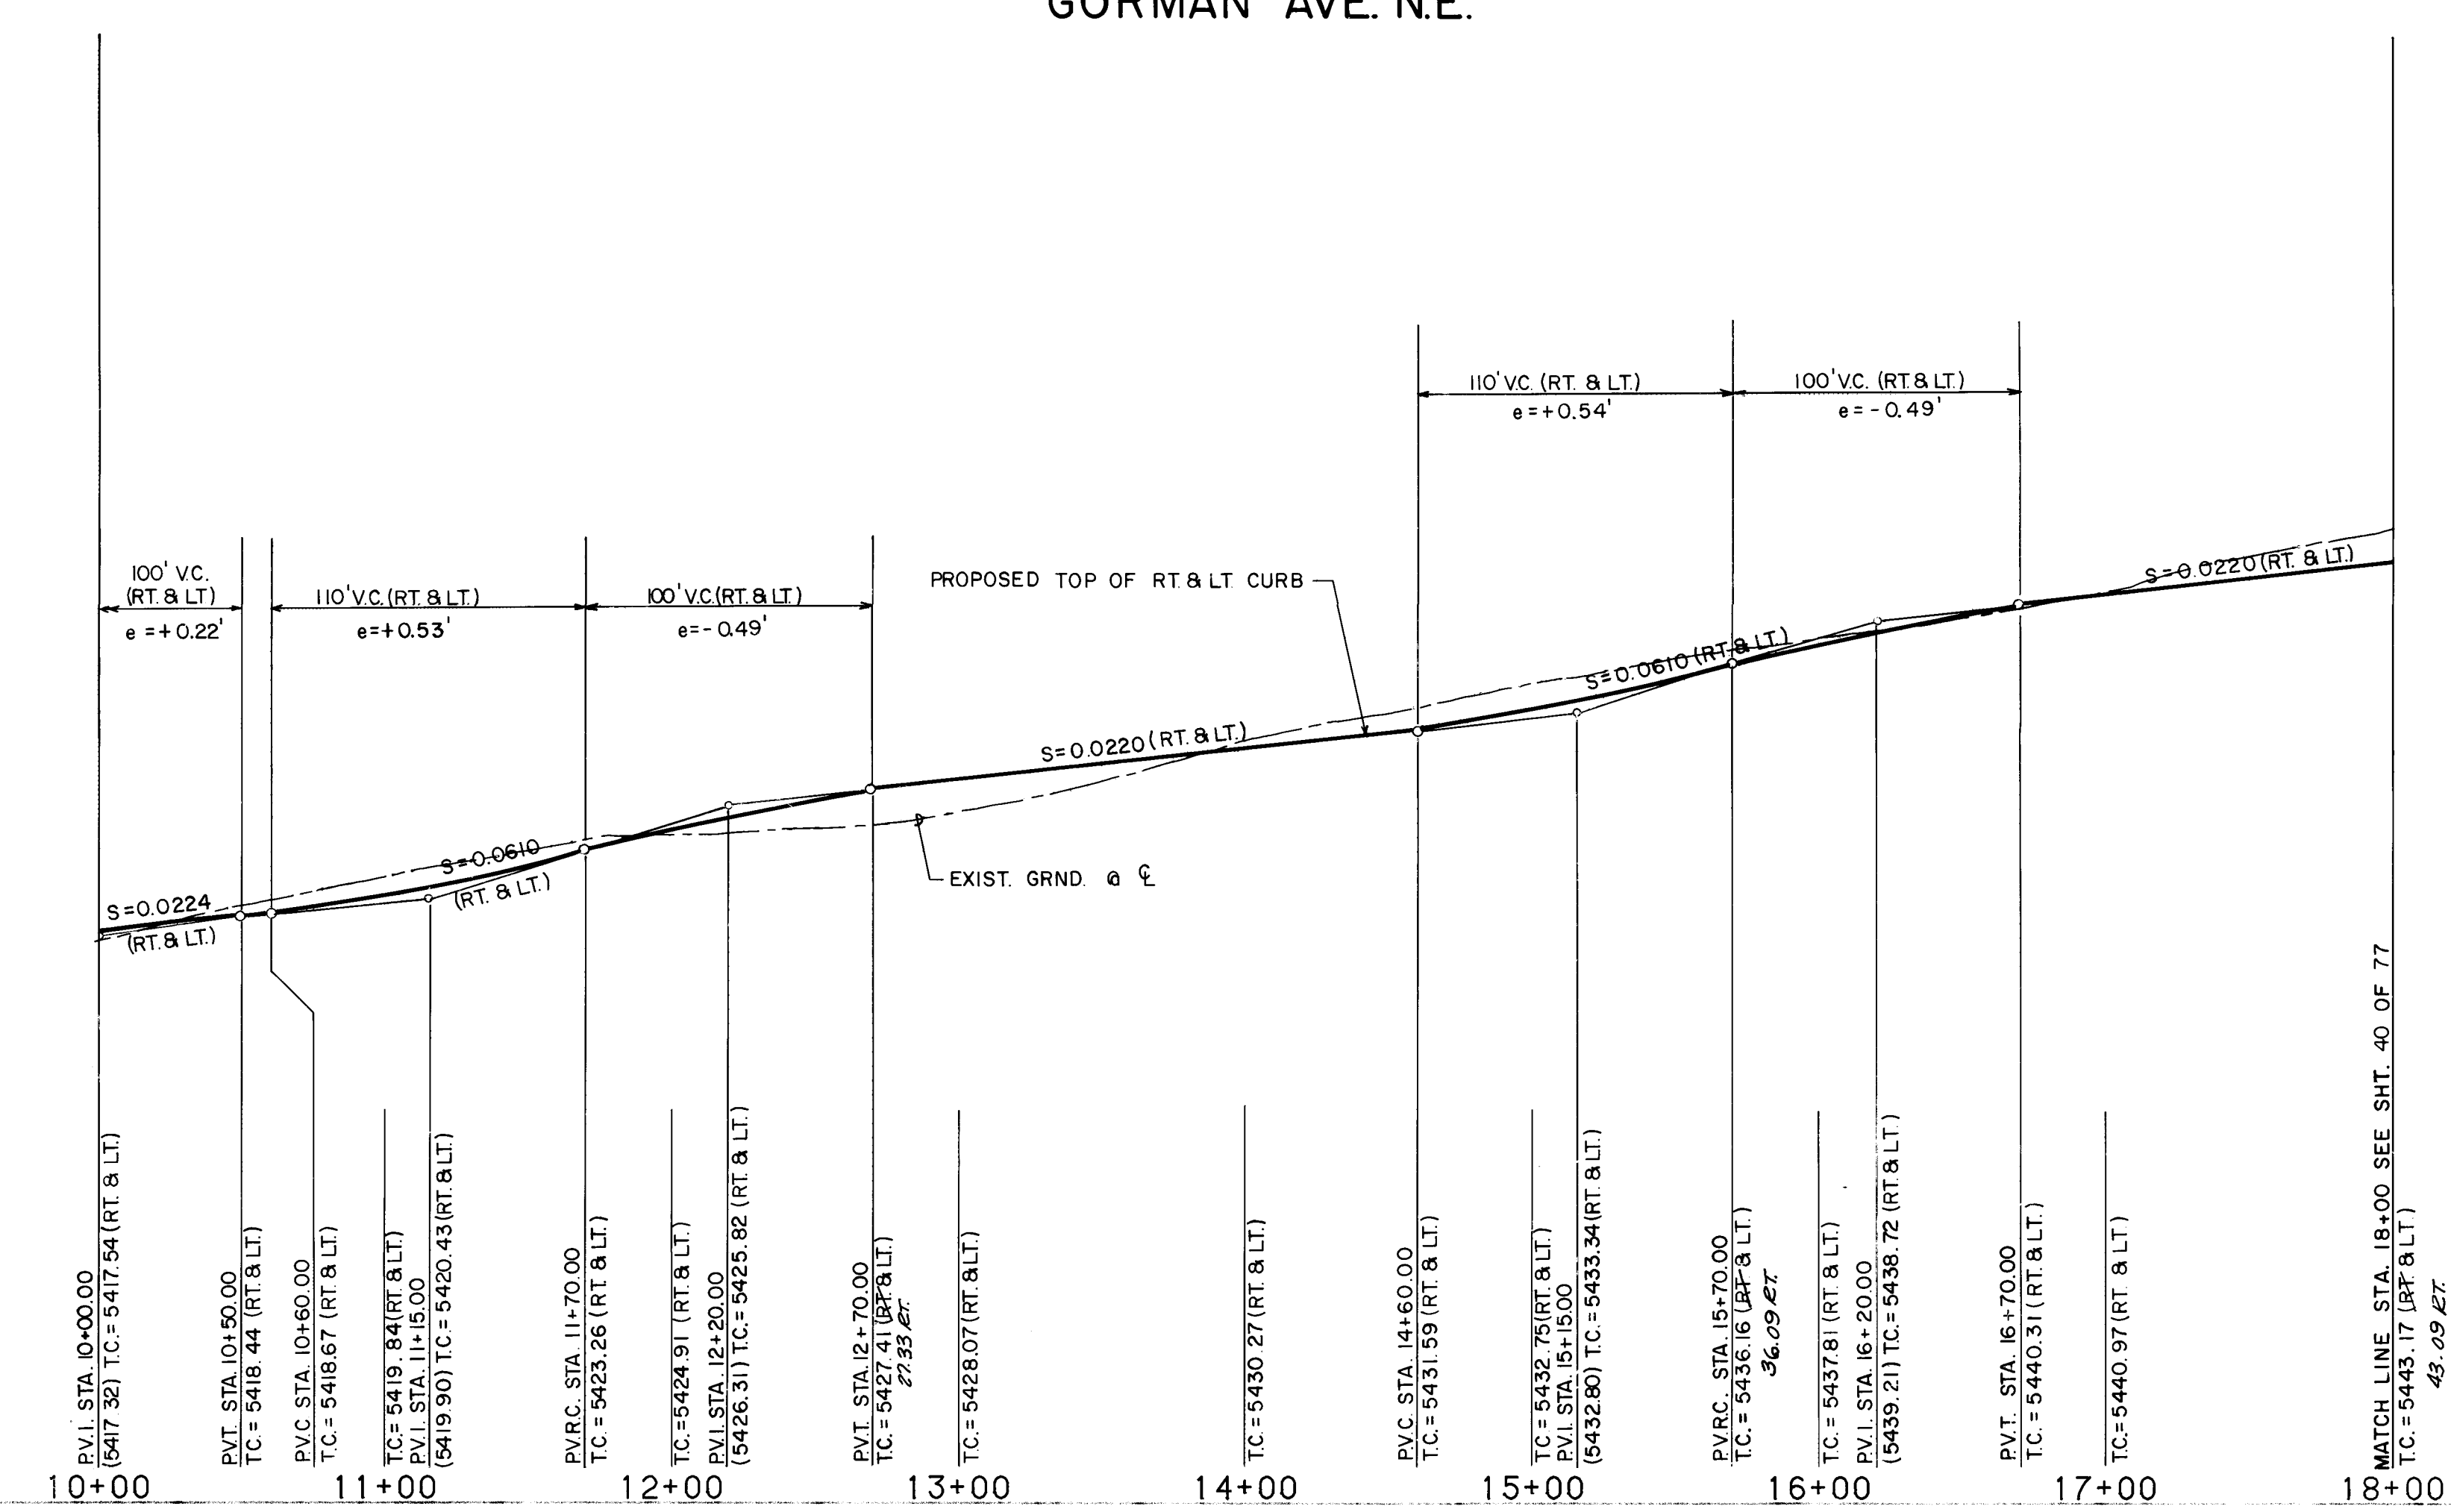

GORMAN AVE. N.E.

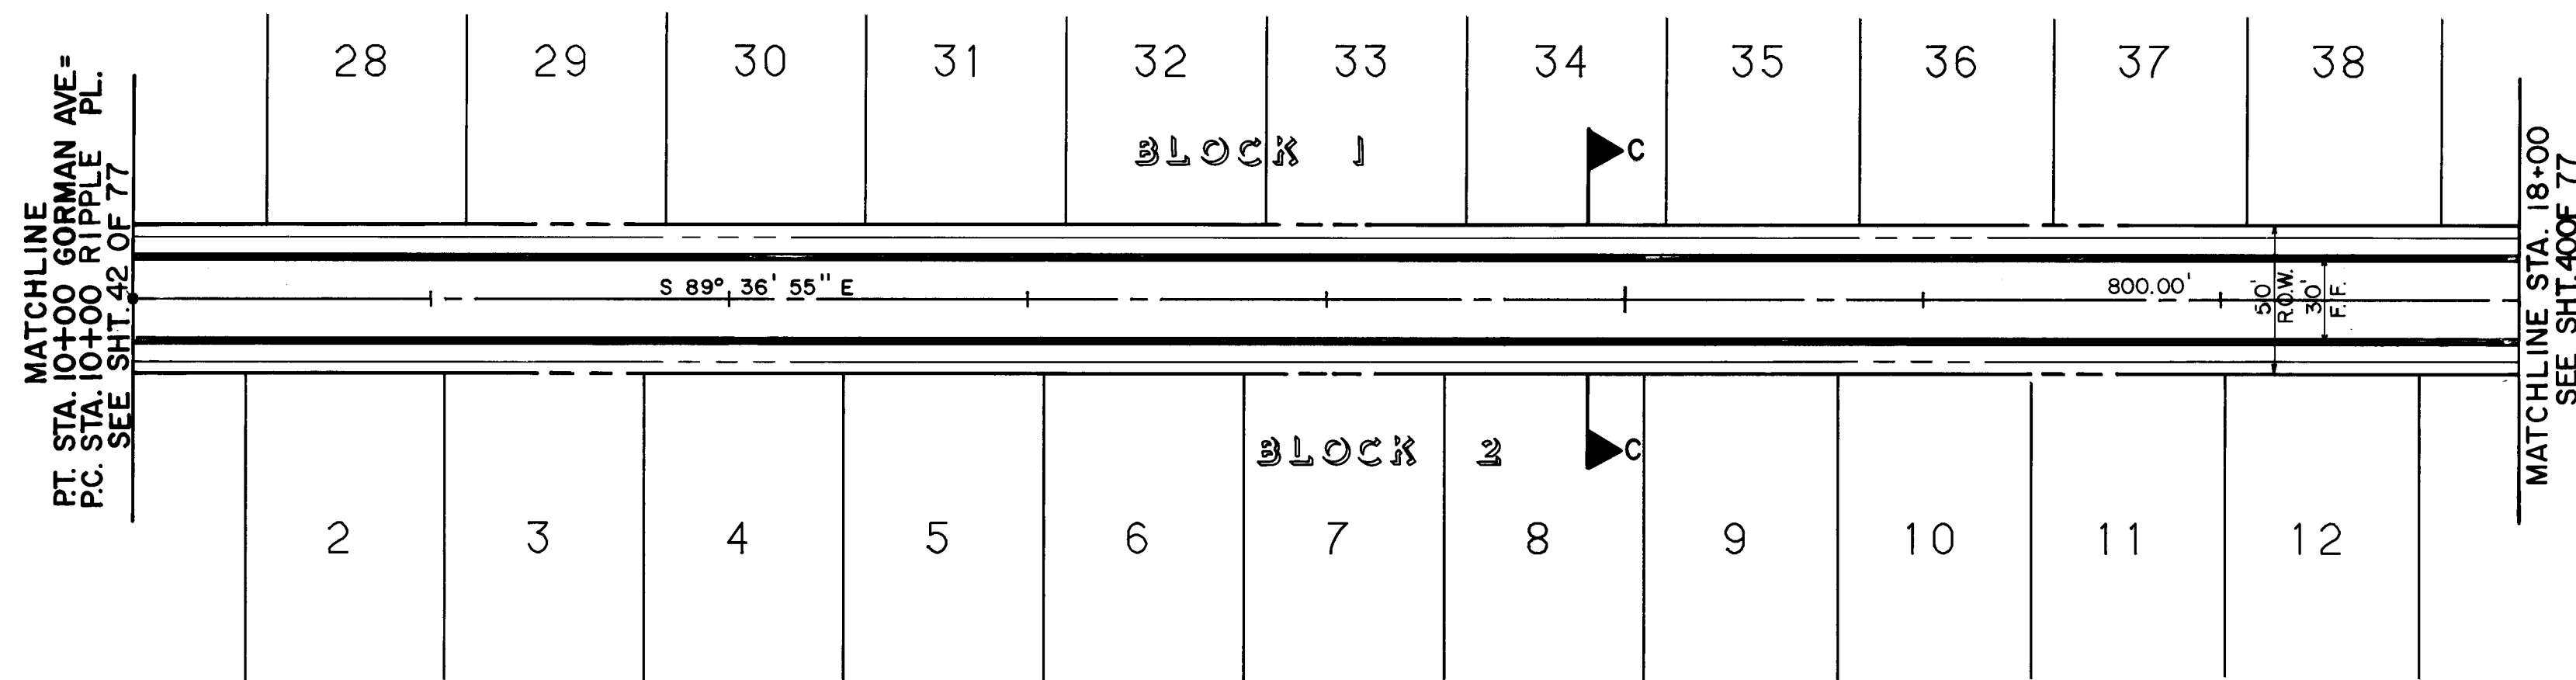

- PAVING
- ALL STATIONING AND OFFSET DIMENSIONS ARE BASED ON CENTERLINE OF RIGHT-OF-WAY.
 - THE FOLLOWING CITY OF ALBUQUERQUE STANDARD DRAWINGS ARE APPLICABLE TO THE PAVING CONSTRUCTION:
- | 2401 | 2415 | 2422 |
|------|------|------|
| 2405 | 2418 | 2430 |
| 2407 | 2420 | 2440 |
| 2408 | 2421 | 2441 |

LEGEND

- SCALE:
HORIZ: 1" = 50'
VERT: 1" = 10'
- EXISTING CURB & GUTTER AND SIDEWALK
 - EXISTING DRIVEPADS
 - EXISTING LIMITS OF ASPHALT PAVEMENT
 - PROPERTY OR BOUNDARY LINE
 - CENTERLINE OF STREET
 - PROPOSED CURB & GUTTER
 - PROPOSED SIDEWALK
 - PROPOSED CONCRETE VALLEY GUTTER
 - PROPOSED WHEELCHAIR RAMP
 - FUTURE CURB & GUTTER
 - FUTURE SIDEWALK
 - FUTURE CONCRETE VALLEY GUTTER
 - FUTURE WHEELCHAIR RAMP

RECORD DRAWING

This drawing as modified shows public improvements as constructed. These modifications have been made using the City of Albuquerque's standard drawings and measurements obtained by EHA's field survey over the City of Albuquerque. The modifications conform to the minimum requirements for the City of Albuquerque as required by the City of Albuquerque per knowledge and belief to the best of my knowledge and belief.

Dennis A. Lorenz P.E. 3/7/88


Date

ESPEY, HUSTON & ASSOCIATES, INC.
Engineering & Environmental Consultants
317 COMMERCIAL ST. N.E.
ALBUQUERQUE, NEW MEXICO 87102
PHONE: (505) 242-1909

NOR ESTE ESTATES
GORMAN AVE. N.E.
STA. 10+00.00 TO STA. 18+00.00

THE STATION IS LOCATED 9 MILES NORTHEAST OF DOWNTOWN ALBUQUERQUE TO REACH THE STATION FROM THE INTERSECTION OF LOUISIANA BLVD. AND LOS ANGELES DRIVE, GO EAST ON LOS ANGELES DRIVE 10 MILES TO BARSTOW ST., THEN NORTH ON BARSTOW ST. 10 MILES TO ALAMEDA AVE. THE STATION IS LOCATED IN THE NORTHEAST QUADRANT OF THE INTERSECTION. THE STATION MARK IS A STANDARD ACS BRASS TABLET STAMPED "1-820", SET IN TOP OF A CONCRETE POST PROJECTING 0.1 FEET ABOVE GROUND.
MSLD ELEVATION = 5474.53'

5490
5480
5470
5460
5450
5440
5430
5420
5410
5400

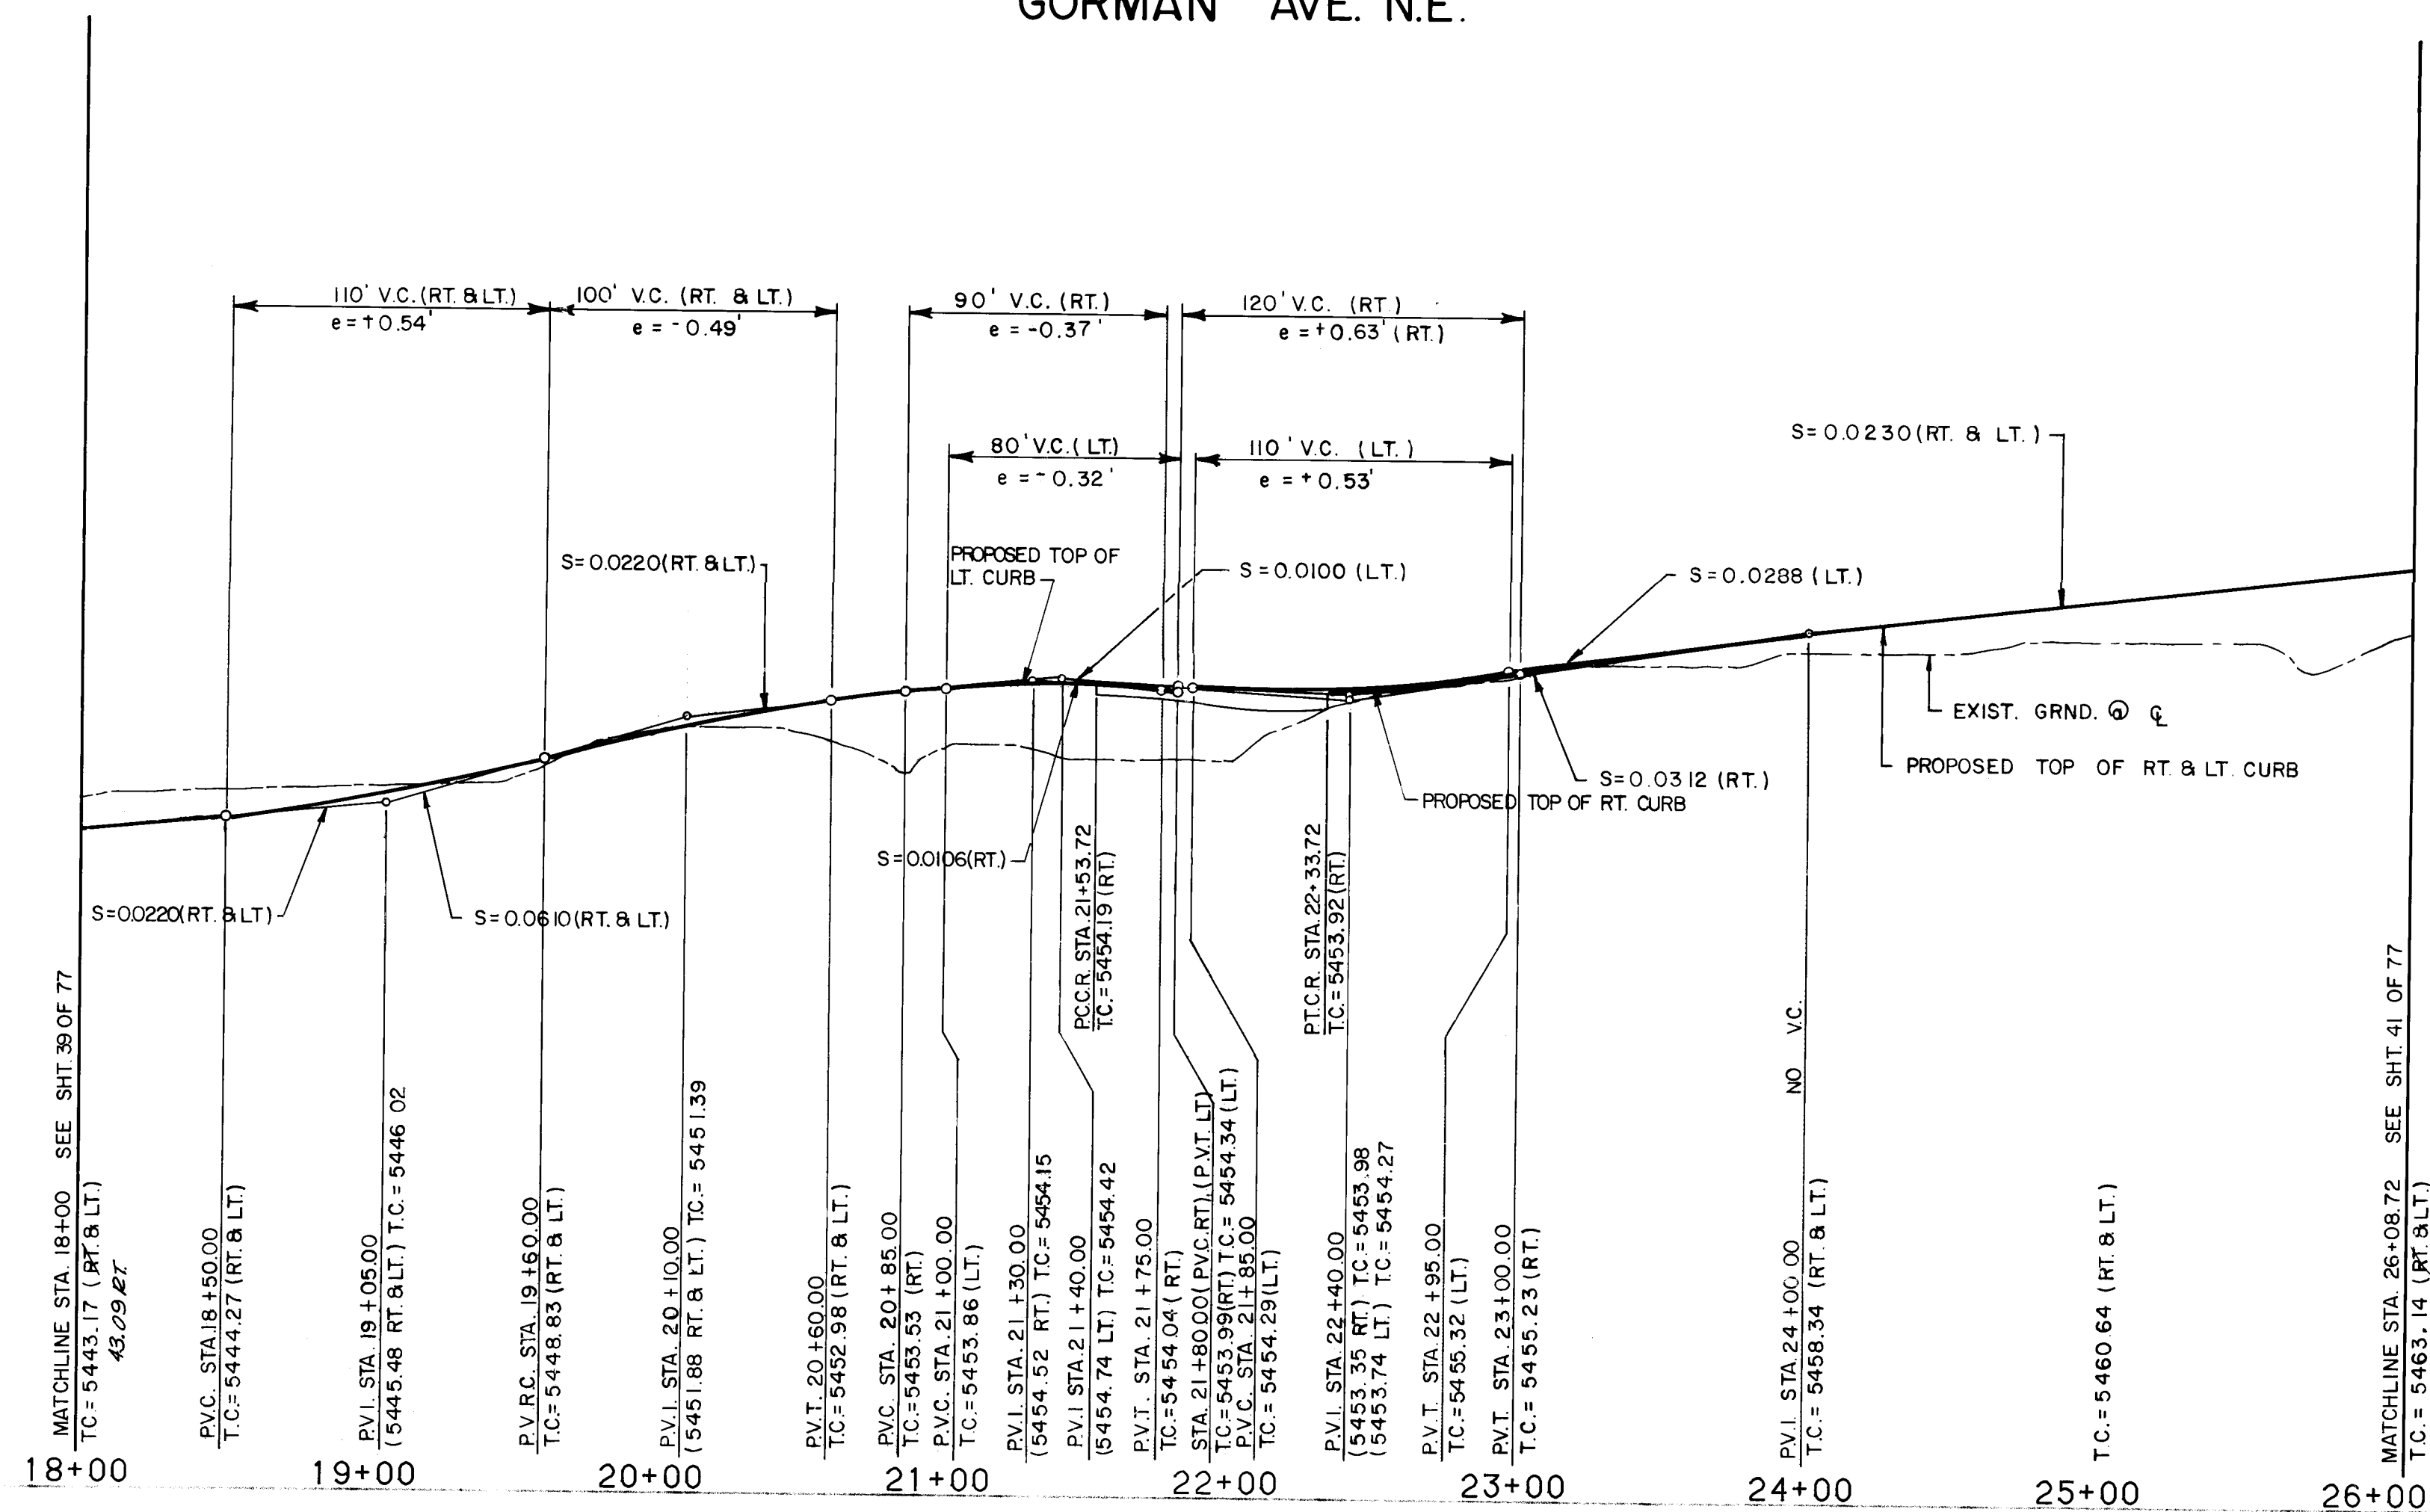

TC	RL
1	54.10 53.43
2	54.01 53.34
3	53.92 53.25

TC	RL
1	53.74 53.07
2	53.80 53.13
3	53.86 53.19

GORMAN AVE. N.E.

RECORD DRAWING
This drawing is modified from those public improvements as constructed. The information and measurements obtained by EHA's field survey crew, the Contractor and City Inspector. The modifications are made to the drawing as required by the City of Albuquerque Department of Public Works, Engineering & Environmental Consultants, to the best of my knowledge and belief.
Dennis A. Lorenz P.E.
Date: 8/17/88
Stamp: ENGINEERED PROFESSIONAL SEAL
Stamp: 317 COMMERCIAL ST. N.E. ALBUQUERQUE, NEW MEXICO 87102 PHONE: (505) 242-1909

- SCALE
HORIZ 1"=50'
VERT 1"=10'
- LEGEND
- EXISTING CURB & GUTTER AND SIDEWALK
 - EXISTING DRIVEPADS
 - EXISTING LIMITS OF ASPHALT PAVEMENT
 - PROPERTY OR BOUNDARY LINE
 - CENTERLINE OF STREET
 - PROPOSED CURB & GUTTER
 - PROPOSED SIDEWALK
 - PROPOSED CONCRETE VALLEY GUTTER
 - PROPOSED WHEELCHAIR RAMP
 - FUTURE CURB & GUTTER
 - FUTURE SIDEWALK
 - FUTURE CONCRETE VALLEY GUTTER
 - FUTURE WHEELCHAIR RAMP
 - TRANSITION FROM CROWN TO NO CROWN
- REVISIONS
DATE
BY
CHECKED BY
DESIGN
- ESPEY, HUSTON & ASSOCIATES, INC.
Engineering & Environmental Consultants
317 COMMERCIAL ST. N.E.
ALBUQUERQUE, NEW MEXICO 87102
PHONE: (505) 242-1909




NO.	DELTA	RADIUS	LENGTH	TAN
1	90°00'00"	25.00	39.27	25.00
2	90°00'00"	25.00	39.27	25.00

PAVING

- ALL STATIONING AND OFFSET DIMENSIONS ARE BASED ON CENTERLINE OF RIGHT-OF-WAY.
- THE FOLLOWING CITY OF ALBUQUERQUE STANDARD DRAWINGS ARE APPLICABLE TO THE PAVING CONSTRUCTION:

2401	2415	2422
2405	2418	2430
2407	2420	2440
2408	2421	2441

THE STATION IS LOCATED 9 MILES NORTHEAST OF DOWNTOWN ALBUQUERQUE TO REACH THE STATION FROM THE INTERSECTION OF LOUISIANA BLVD. AND LOS ANGELES DRIVE, GO EAST ON LOS ANGELES DRIVE 10 MILES TO BARSTOW ST., THEN NORTH ON BARSTOW ST. 10 MILES TO ALAMEDA AVE. THE STATION IS LOCATED IN THE NORTHEAST QUADRANT OF THE INTERSECTION. THE STATION MARK IS A STANDARD ACS BRASS TABLET STAMPED "1-820", SET IN TOP OF A CONCRETE POST PROJECTING 0.1 FEET ABOVE GROUND. MILD ELEVATION = 5474.33'

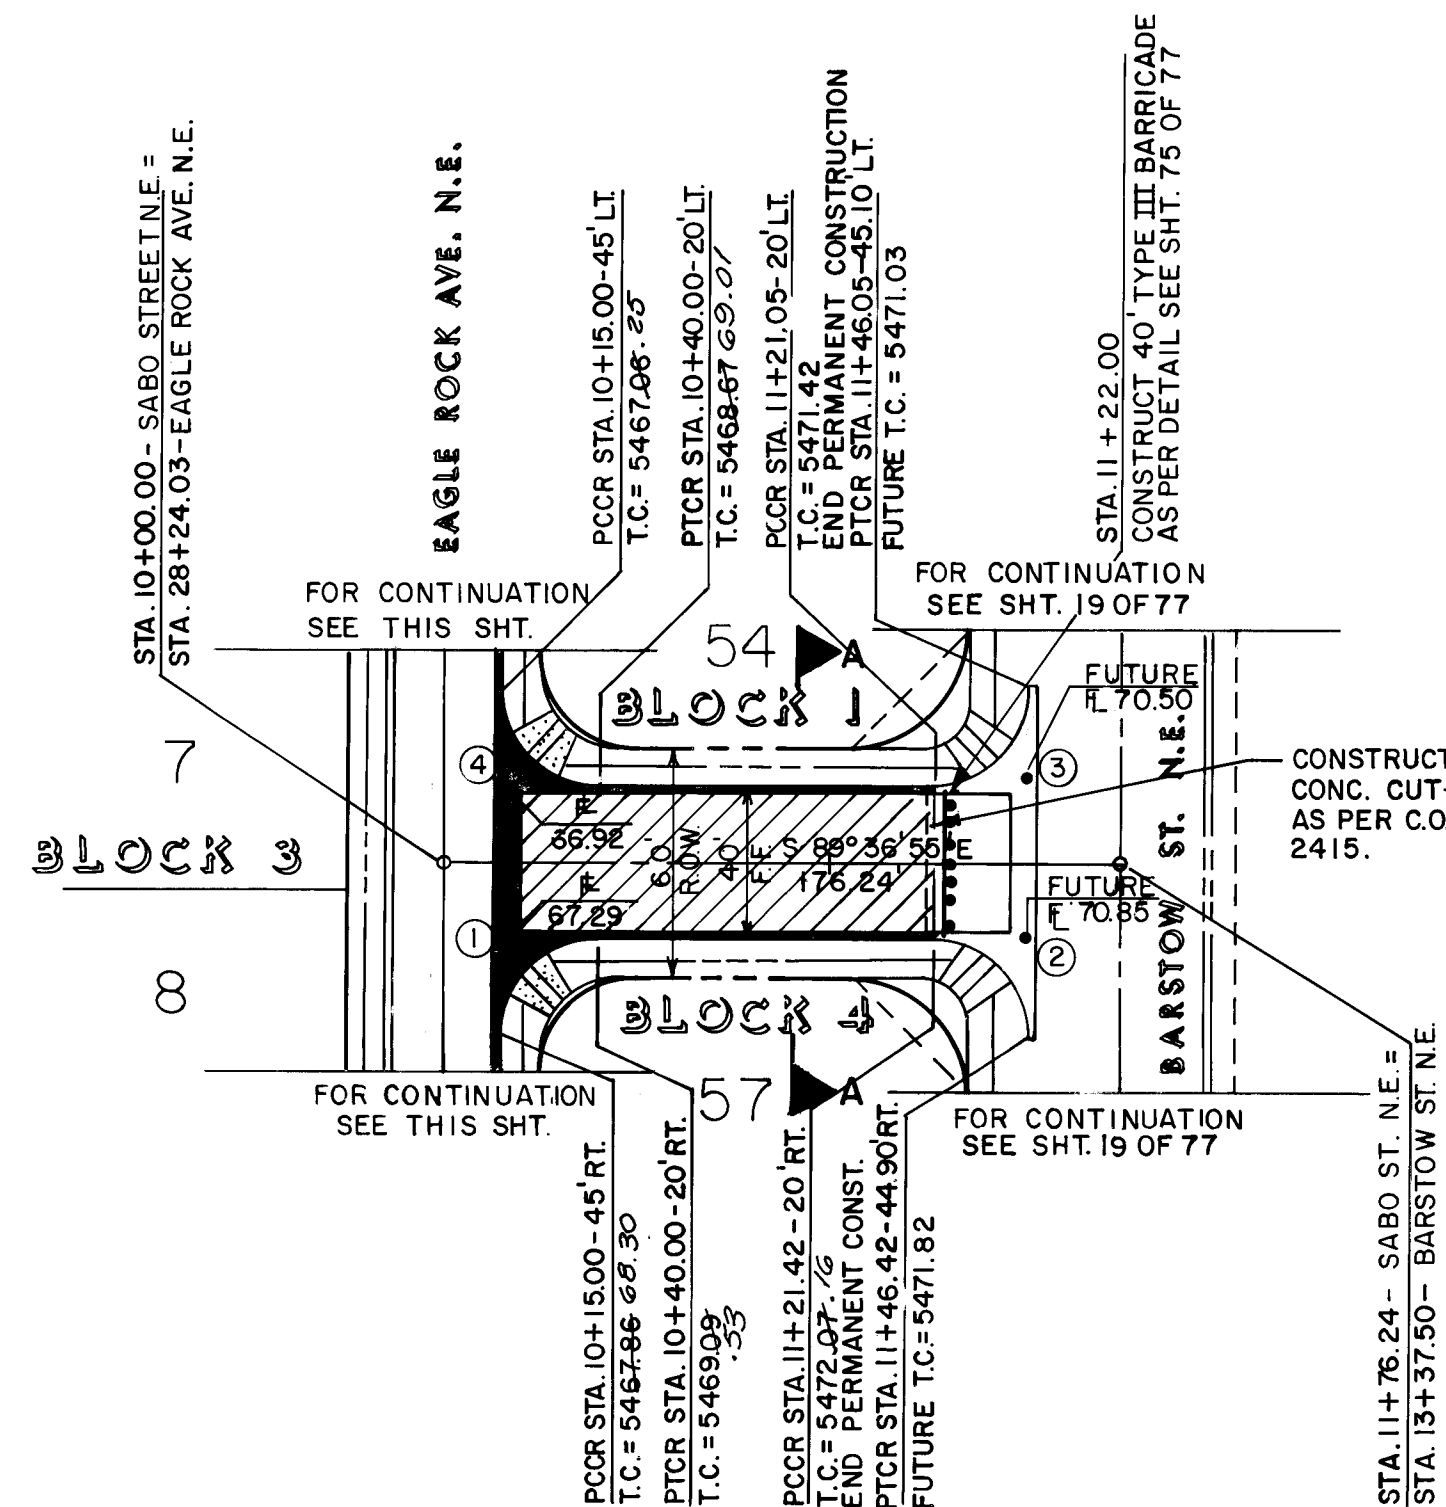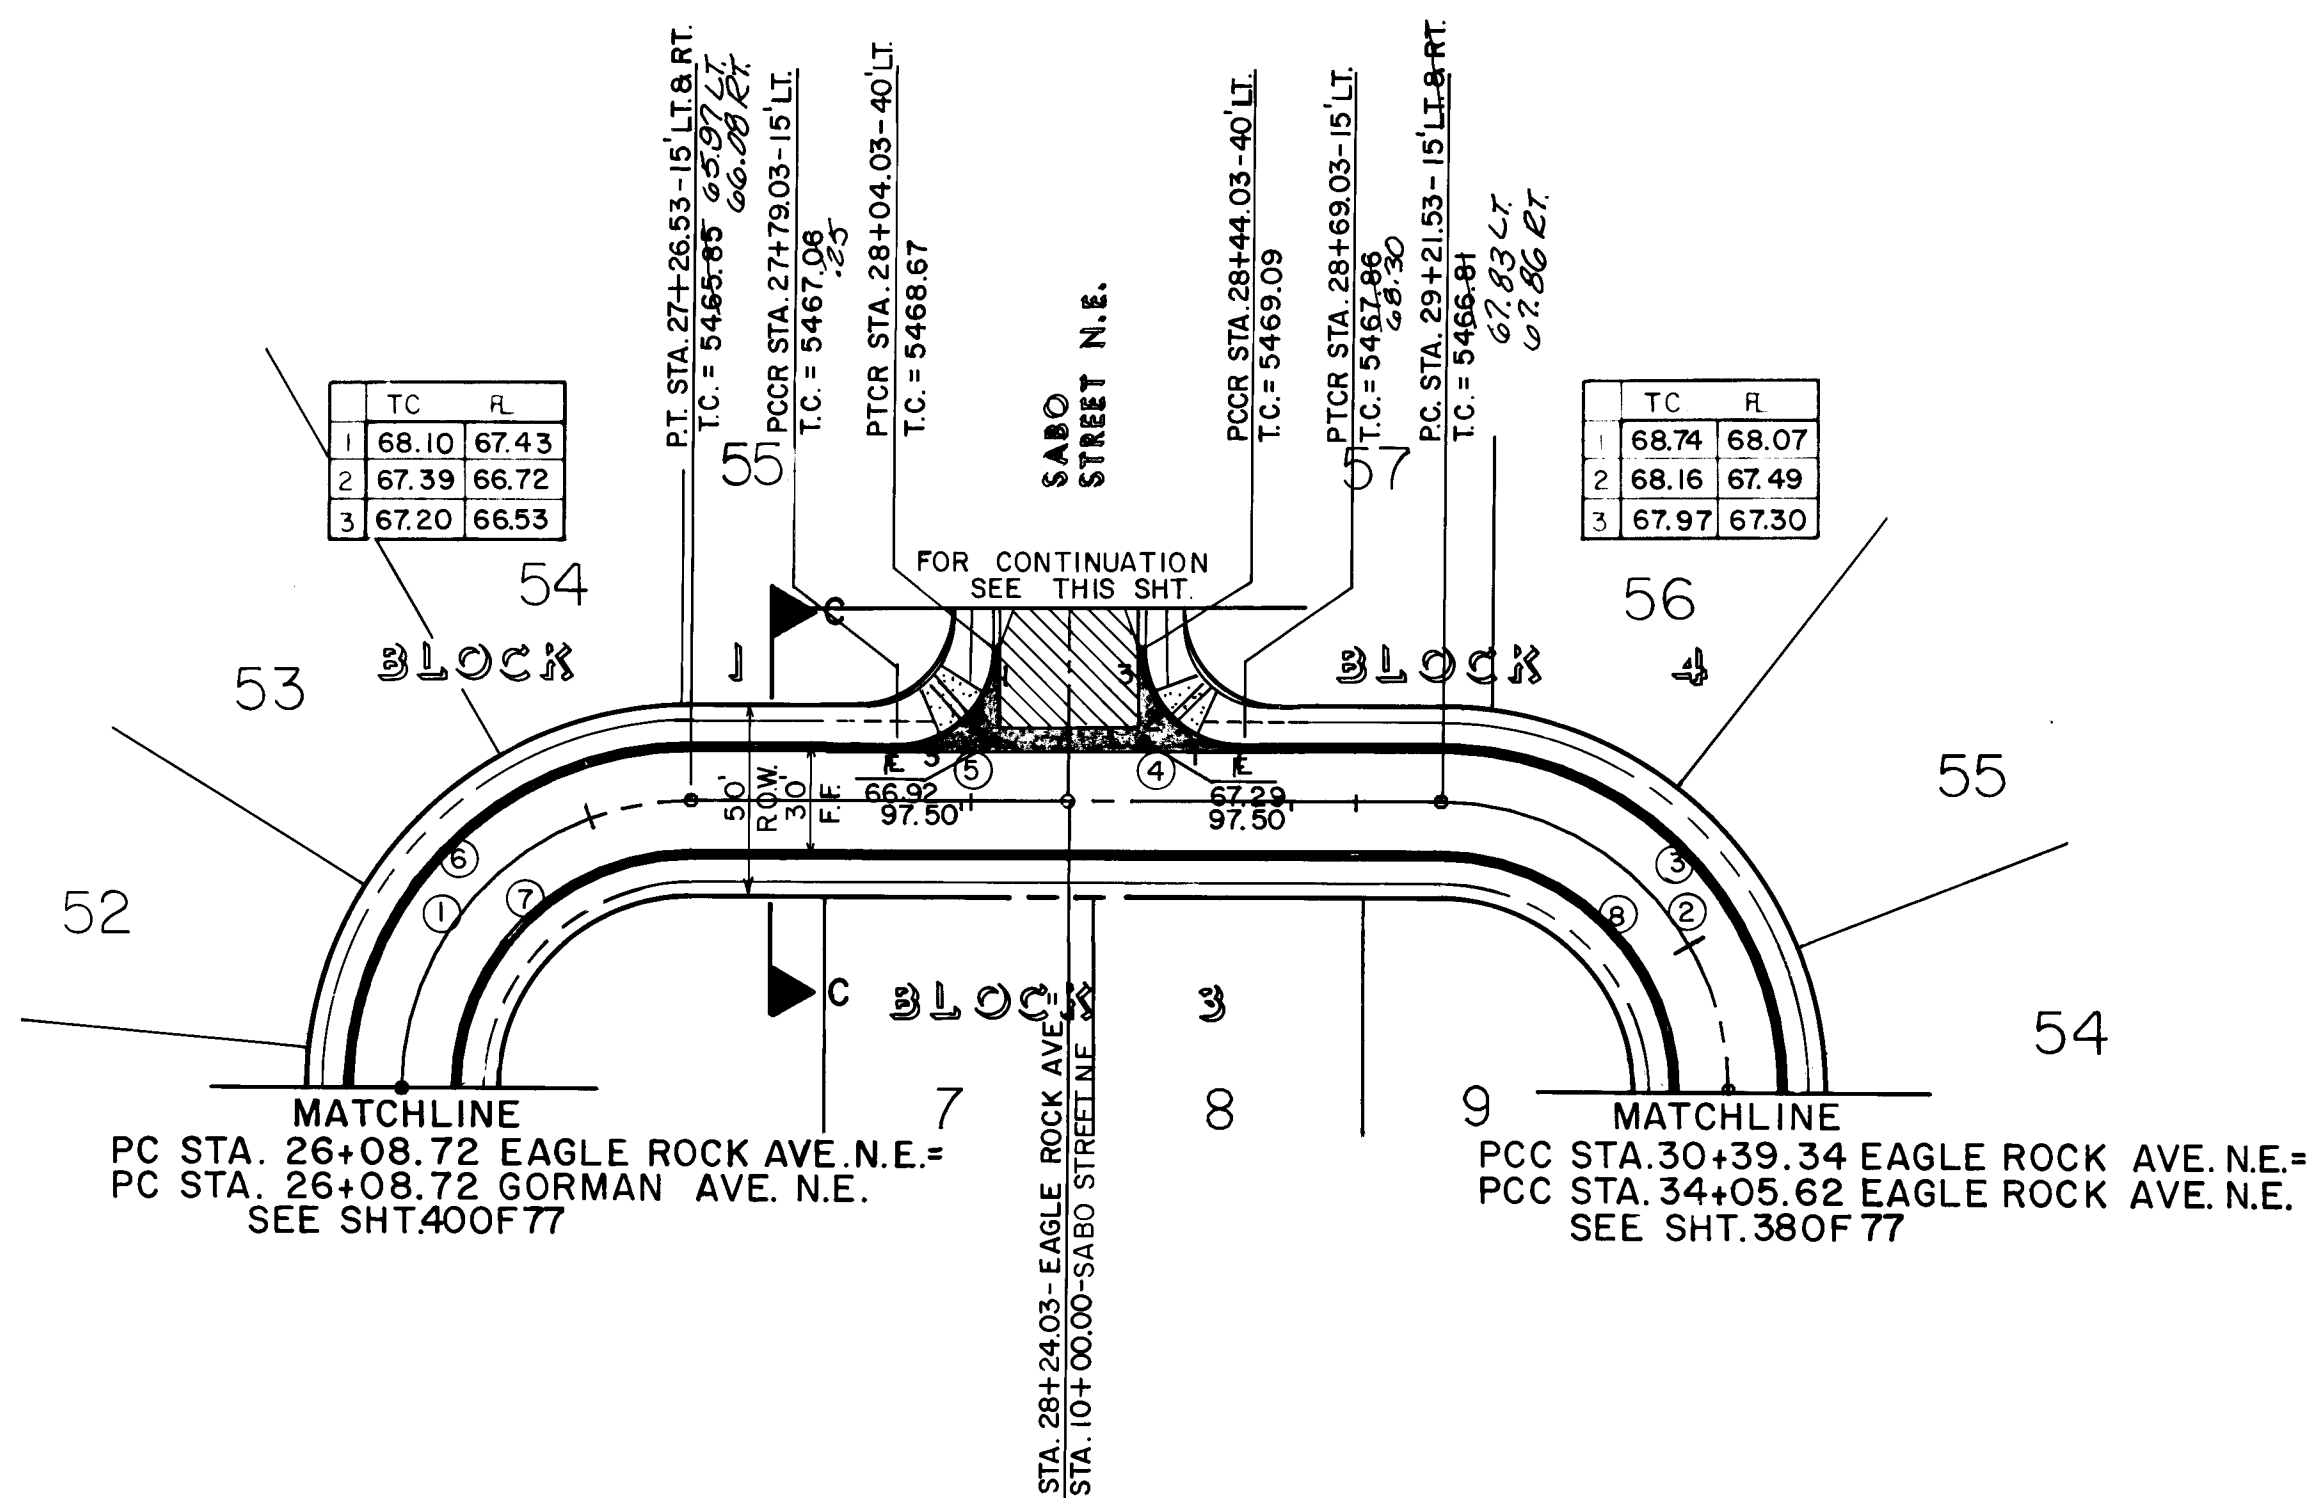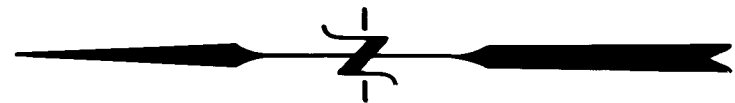

GORMAN AVE. N.E.				
NO.	DELTA	RADIUS	LENGTH	TAN
1	90°00'00"	75.00	117.81	75.00
2	90°00'00"	75.00	117.81	75.00
3	90°00'00"	90.00	141.37	90.00
4	90°00'00"	25.00	39.27	25.00
5	90°00'00"	25.00	39.27	25.00
6	90°00'00"	90.00	141.37	90.00
7	90°00'00"	30.00	94.25	60.00
8	90°00'00"	30.00	94.25	60.00

SABO STREET N.E.				
NO.	DELTA	RADIUS	LENGTH	TAN
1	90°00'00"	25.00	39.27	25.00
2	89°46'11"	25.00	39.17	24.90
3	90°13'49"	25.00	39.37	25.10
4	90°00'00"	25.00	39.27	25.00


- PAVING**
- ALL STATIONING AND OFFSET DIMENSIONS ARE BASED ON CENTERLINE OF RIGHT-OF-WAY.
 - THE FOLLOWING CITY OF ALBUQUERQUE STANDARD DRAWINGS ARE APPLICABLE TO THE PAVING CONSTRUCTION:

2401	2415	2422
2405	2418	2430
2407	2420	2440
2408	2421	2441


THE STATION IS LOCATED 9 MILES NORTHWEST OF DOWNTOWN ALBUQUERQUE TO REACH THE STATION FROM THE INTERSECTION OF LOUISIANA BLVD. AND LOS ANGELES DRIVE, GO EAST ON LOS ANGELES DRIVE 10 MILES TO BARSTOW ST., THEN NORTH ON BARSTOW ST. 10 MILES TO ALAMEDA AVE. THE STATION IS LOCATED IN THE NORTHEAST QUADRANT OF THE INTERSECTION. THE STATION MARK IS A STANDARD ACS BRASS TABLET STAMPED "1-820", SET IN TOP OF A CONCRETE POST PROJECTING 0.1 FEET ABOVE GROUND.

MAID ELEVATION = 5474.93'

EAGLE ROCK AVE. N.E.

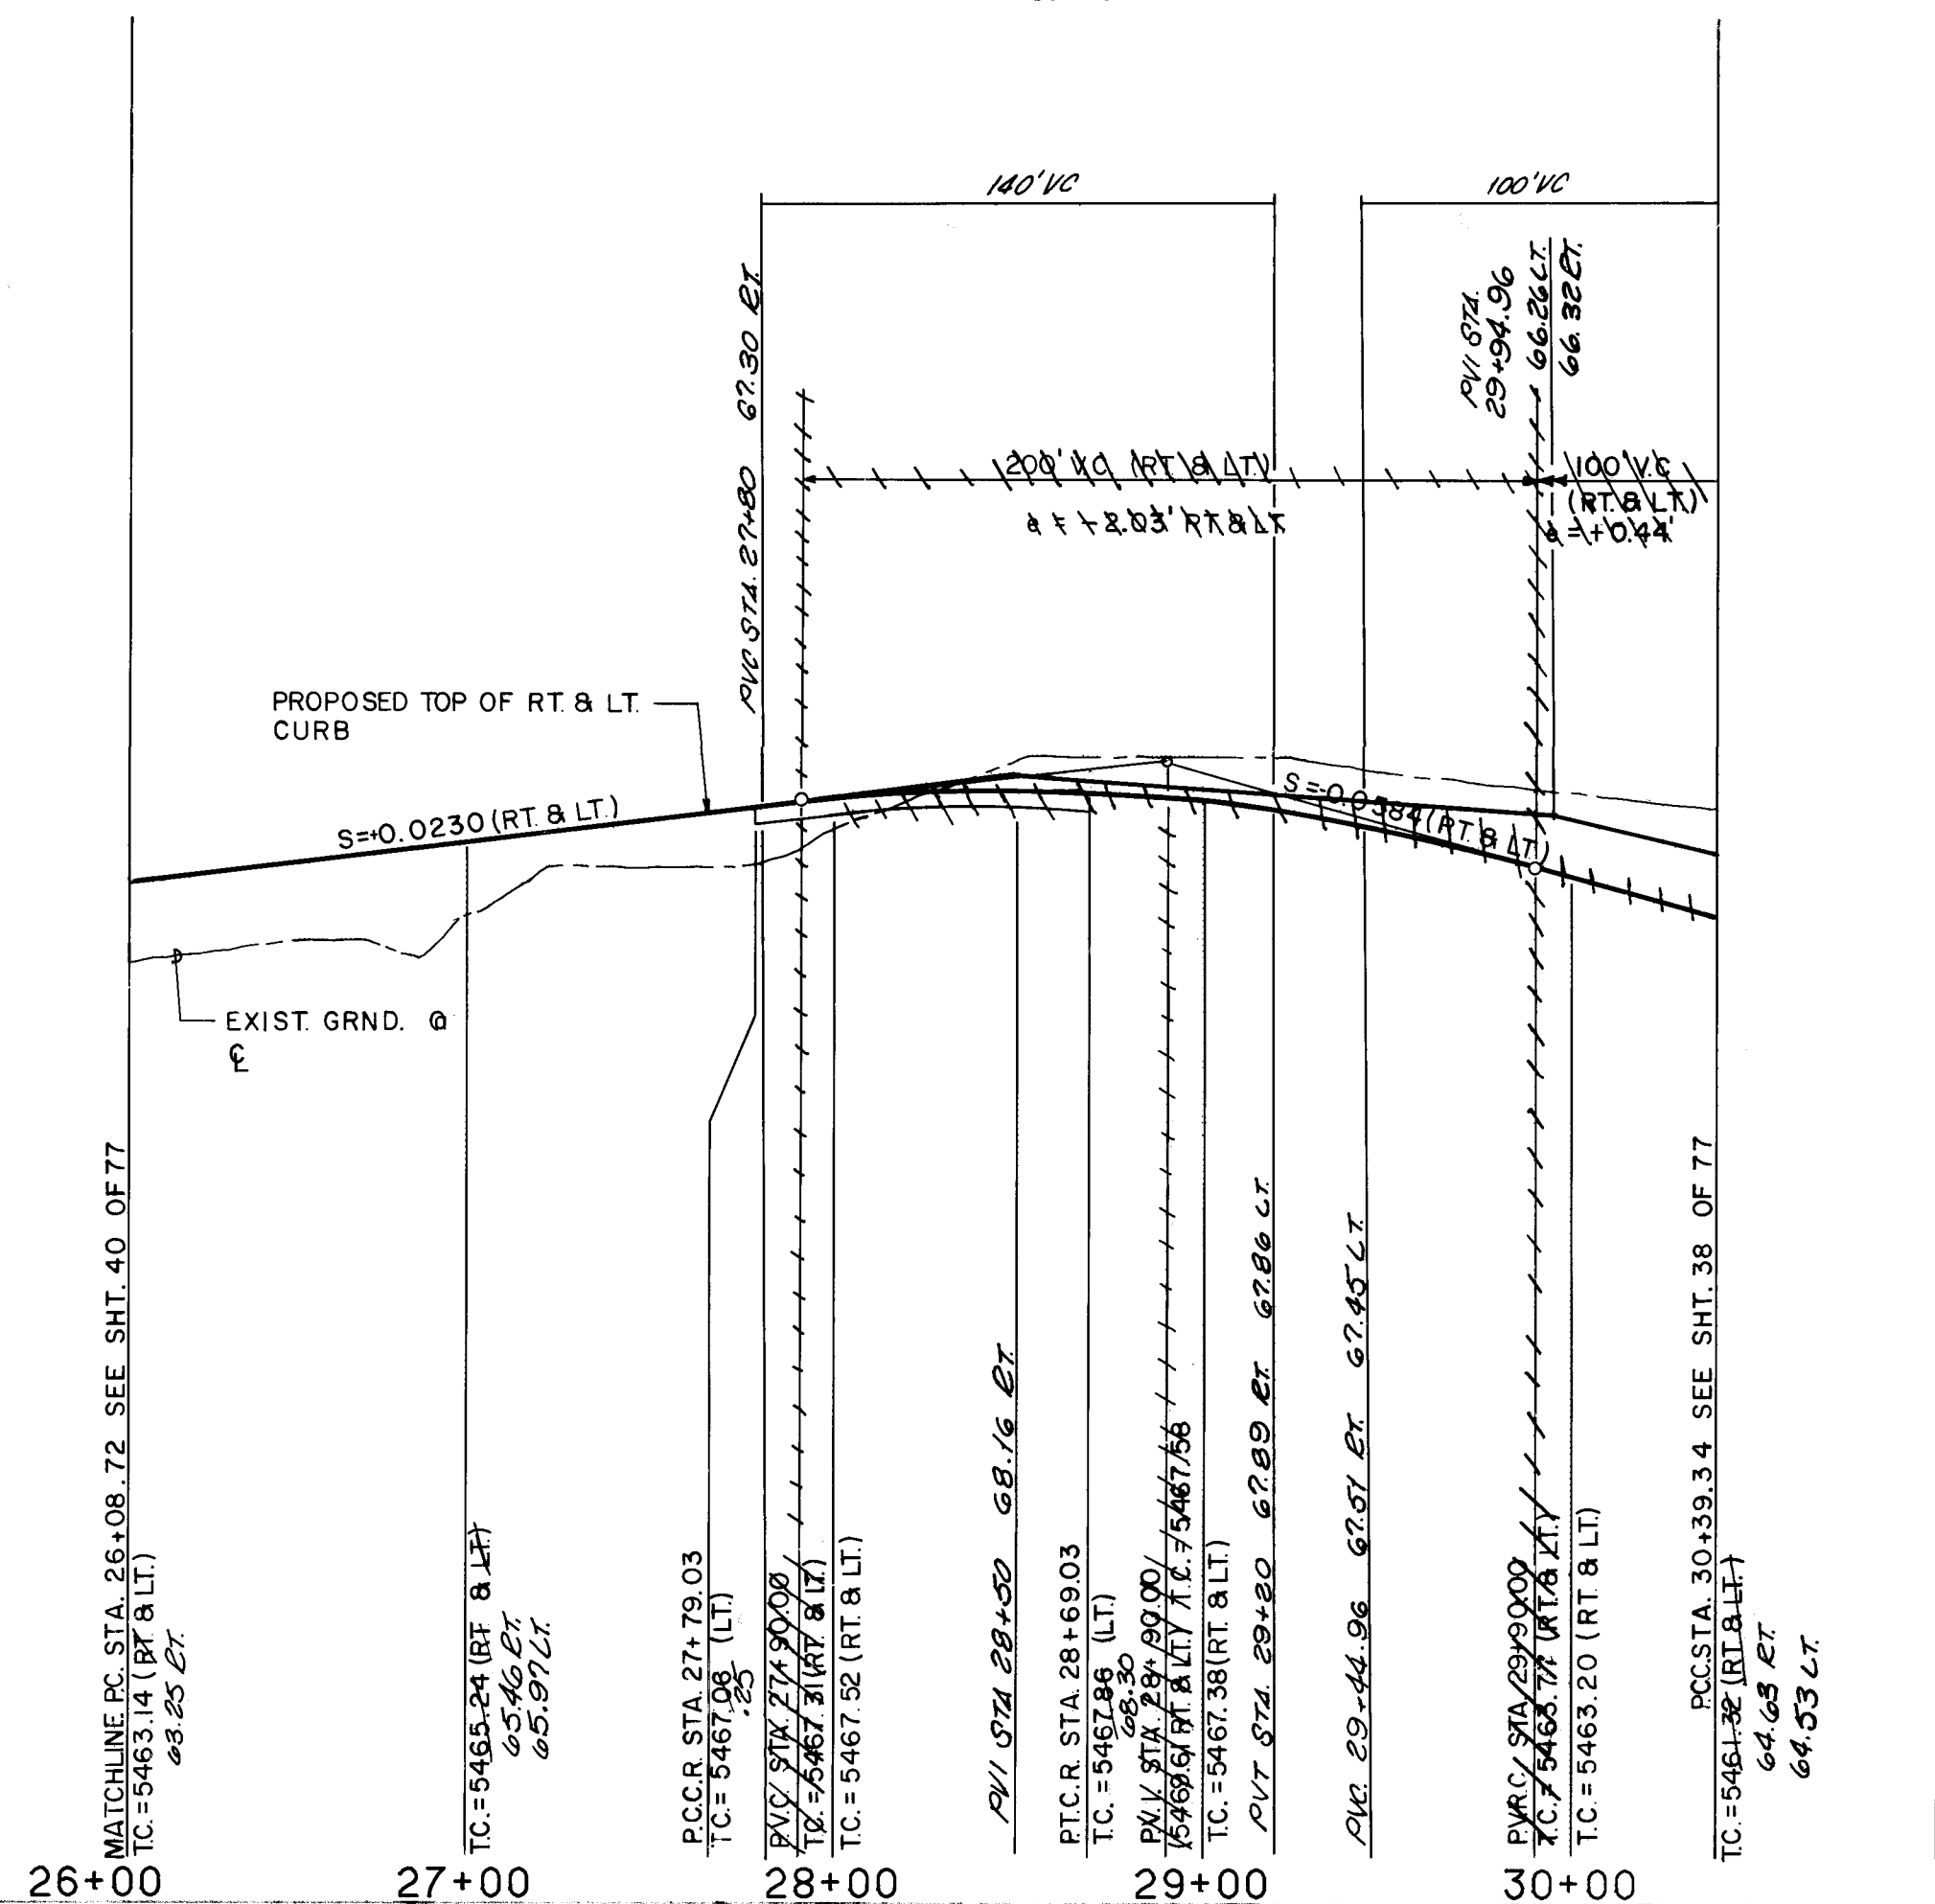

SABO STREET N.E.

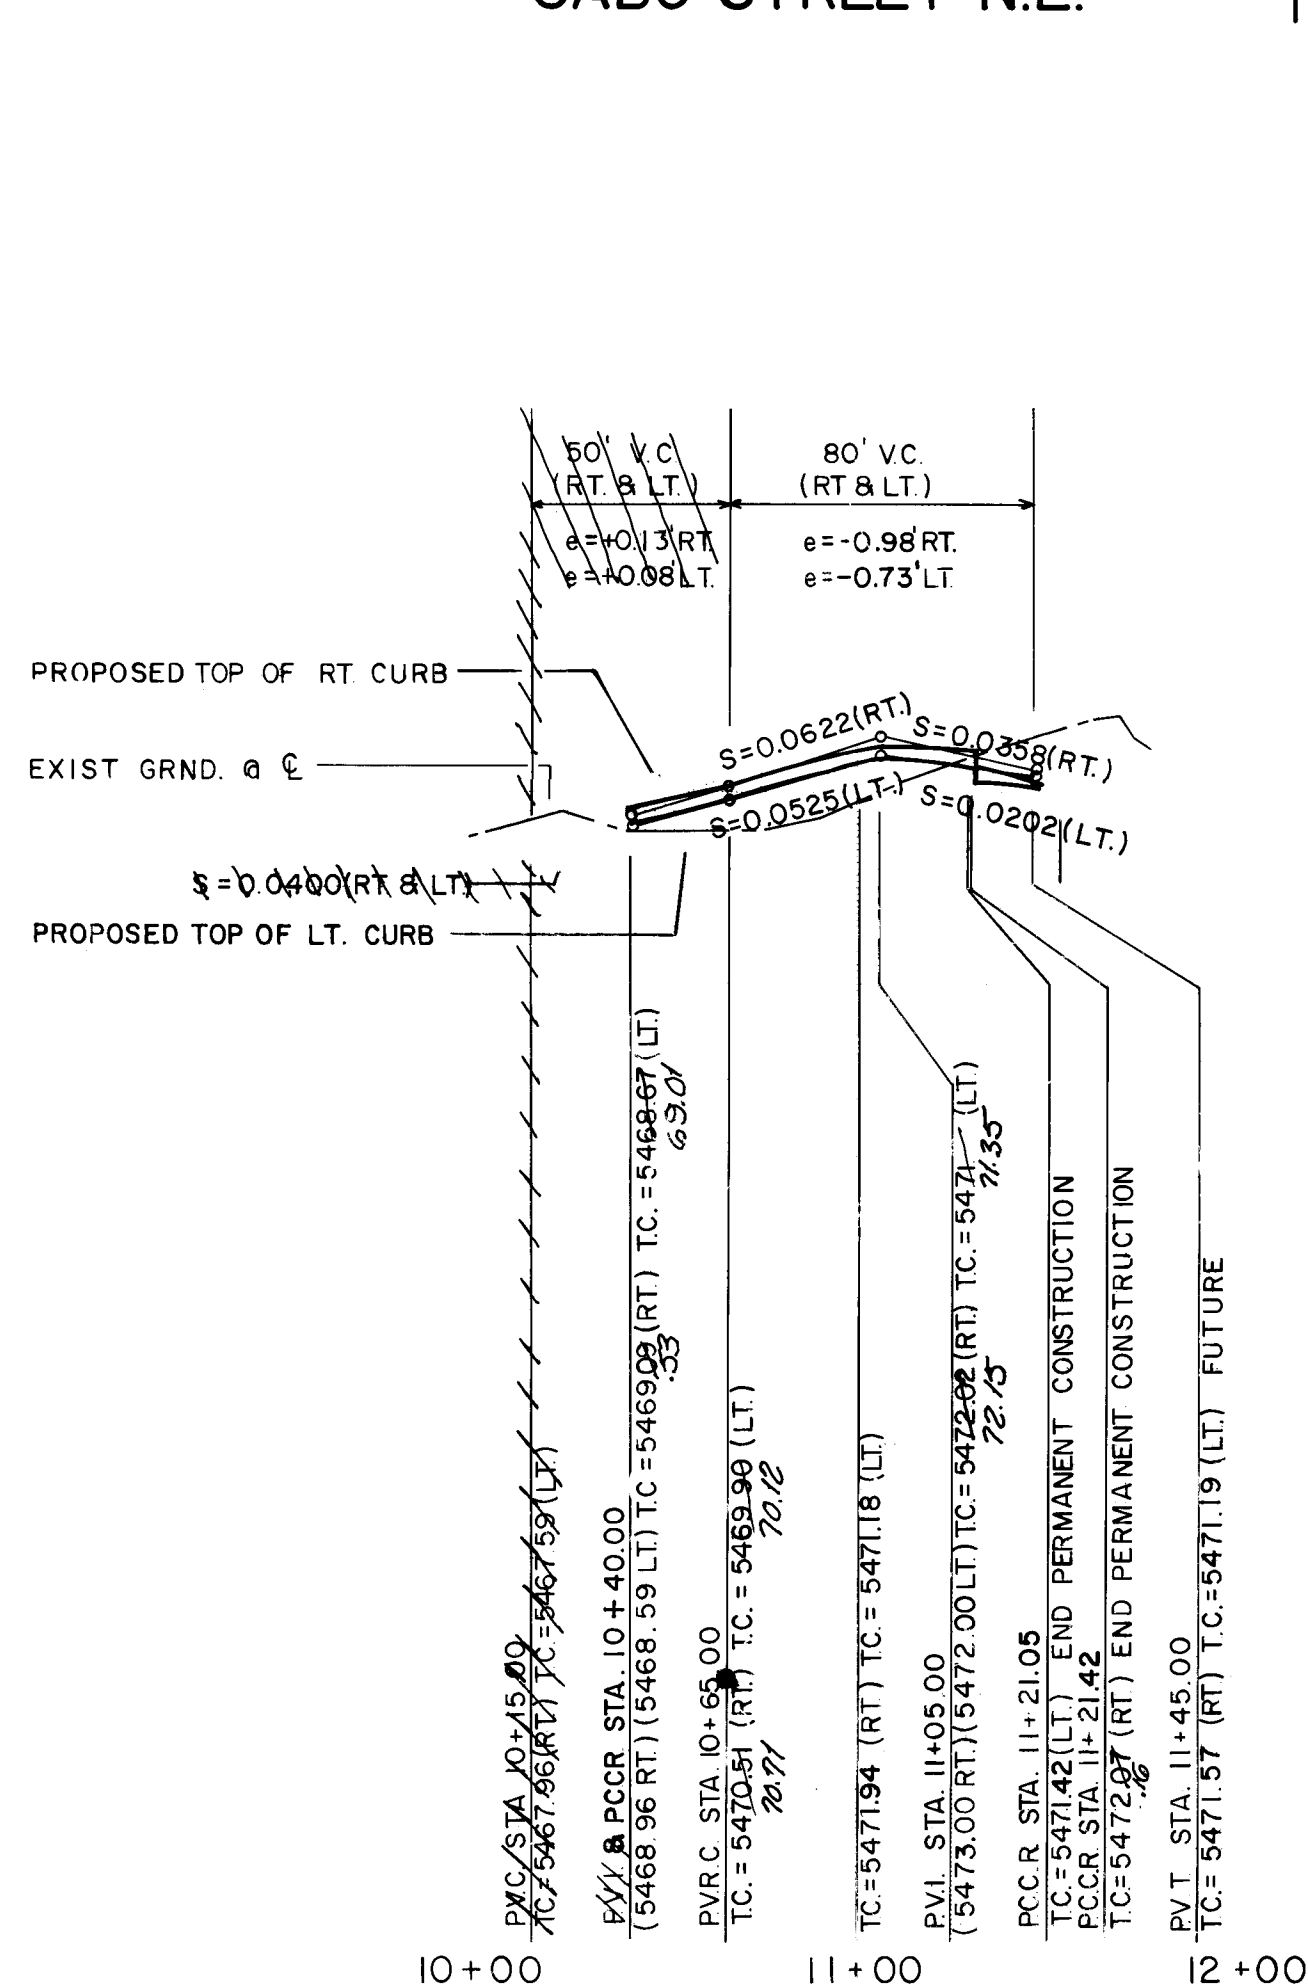

LEGEND



- SCALE:
HORIZ: 1" = 50'
VERT: 1" = 10'
- EXISTING CURB & GUTTER AND SIDEWALK
 - EXISTING DRIVEPADS
 - EXISTING LIMITS OF ASPHALT PAVEMENT
 - PROPERTY OR BOUNDARY LINE
 - CENTERLINE OF STREET
 - PROPOSED CURB & GUTTER
 - PROPOSED SIDEWALK
 - PROPOSED CONCRETE VALLEY GUTTER
 - PROPOSED WHEELCHAIR RAMP
 - FUTURE CURB & GUTTER
 - FUTURE SIDEWALK
 - FUTURE CONCRETE VALLEY GUTTER
 - FUTURE WHEELCHAIR RAMP
 - TRANSITION FROM CROWN TO NO CROWN

26 318 641 88

ESPEY, HUSTON & ASSOCIATES, INC.
Engineering & Environmental Consultants
317 COMMERCIAL ST. N.E.
ALBUQUERQUE, NEW MEXICO 87102
PHONE: (505) 242-1909

NOR ESTE ESTATES
EAGLE ROCK AVE N.E. / SABO STREET N.E.
STA. 26+08.72 TO STA. 30+39.34 / STA. 10+00.00 TO STA. 11+76.24

Handwritten notes and signatures are present in the bottom right corner of the drawing.

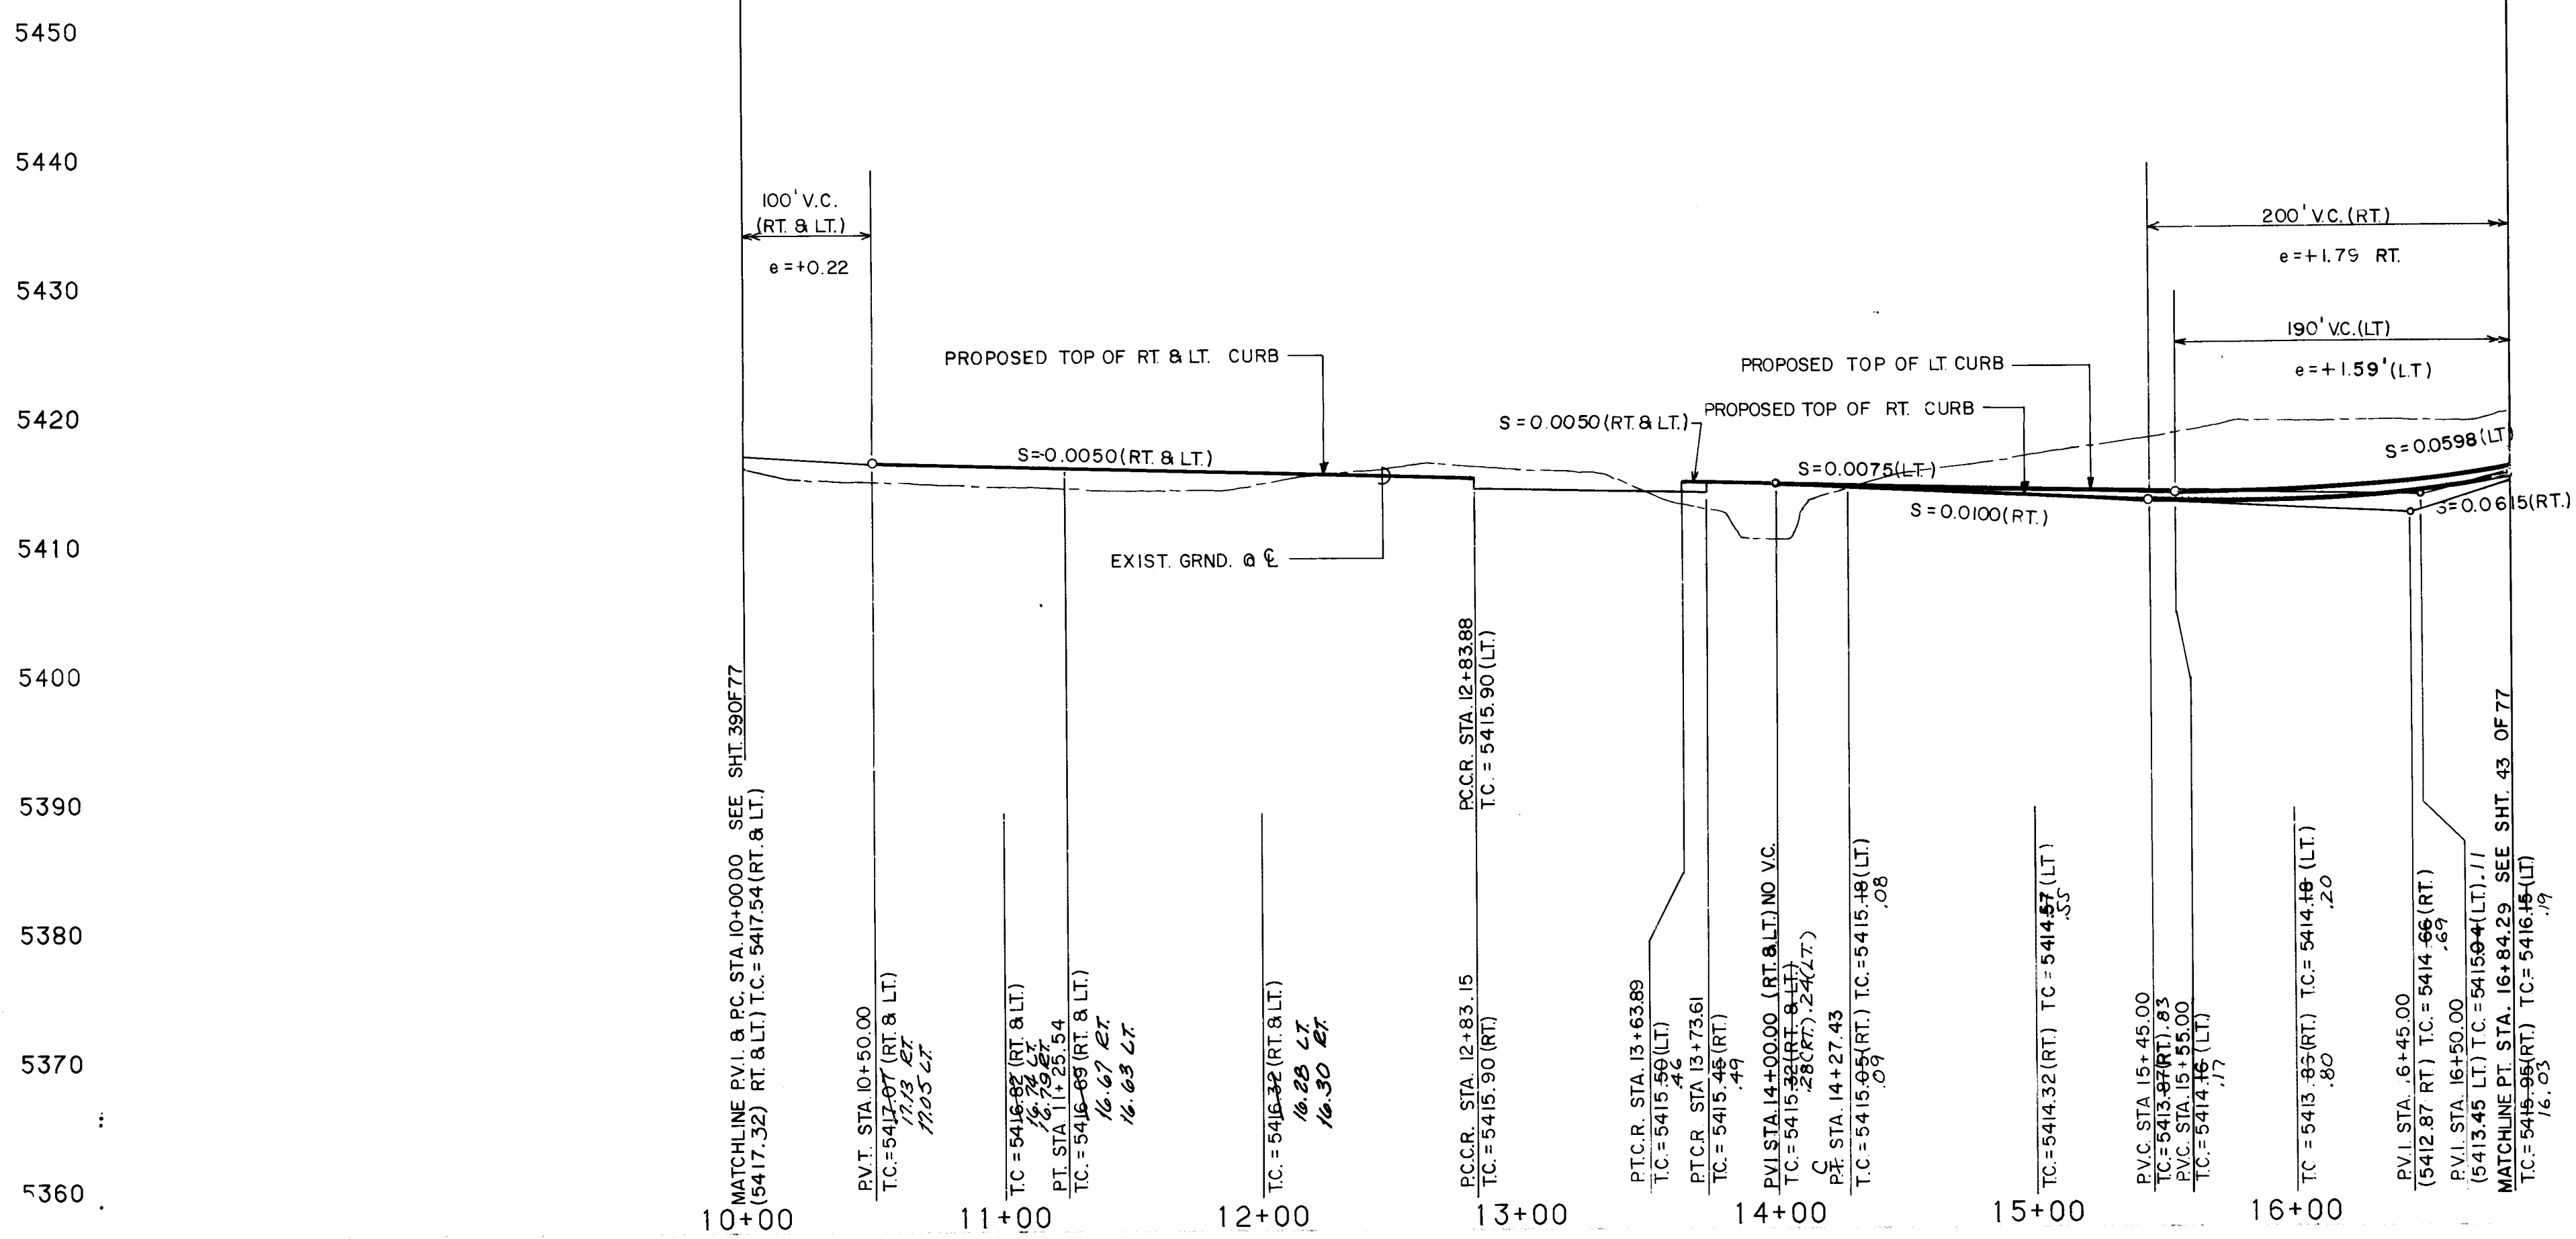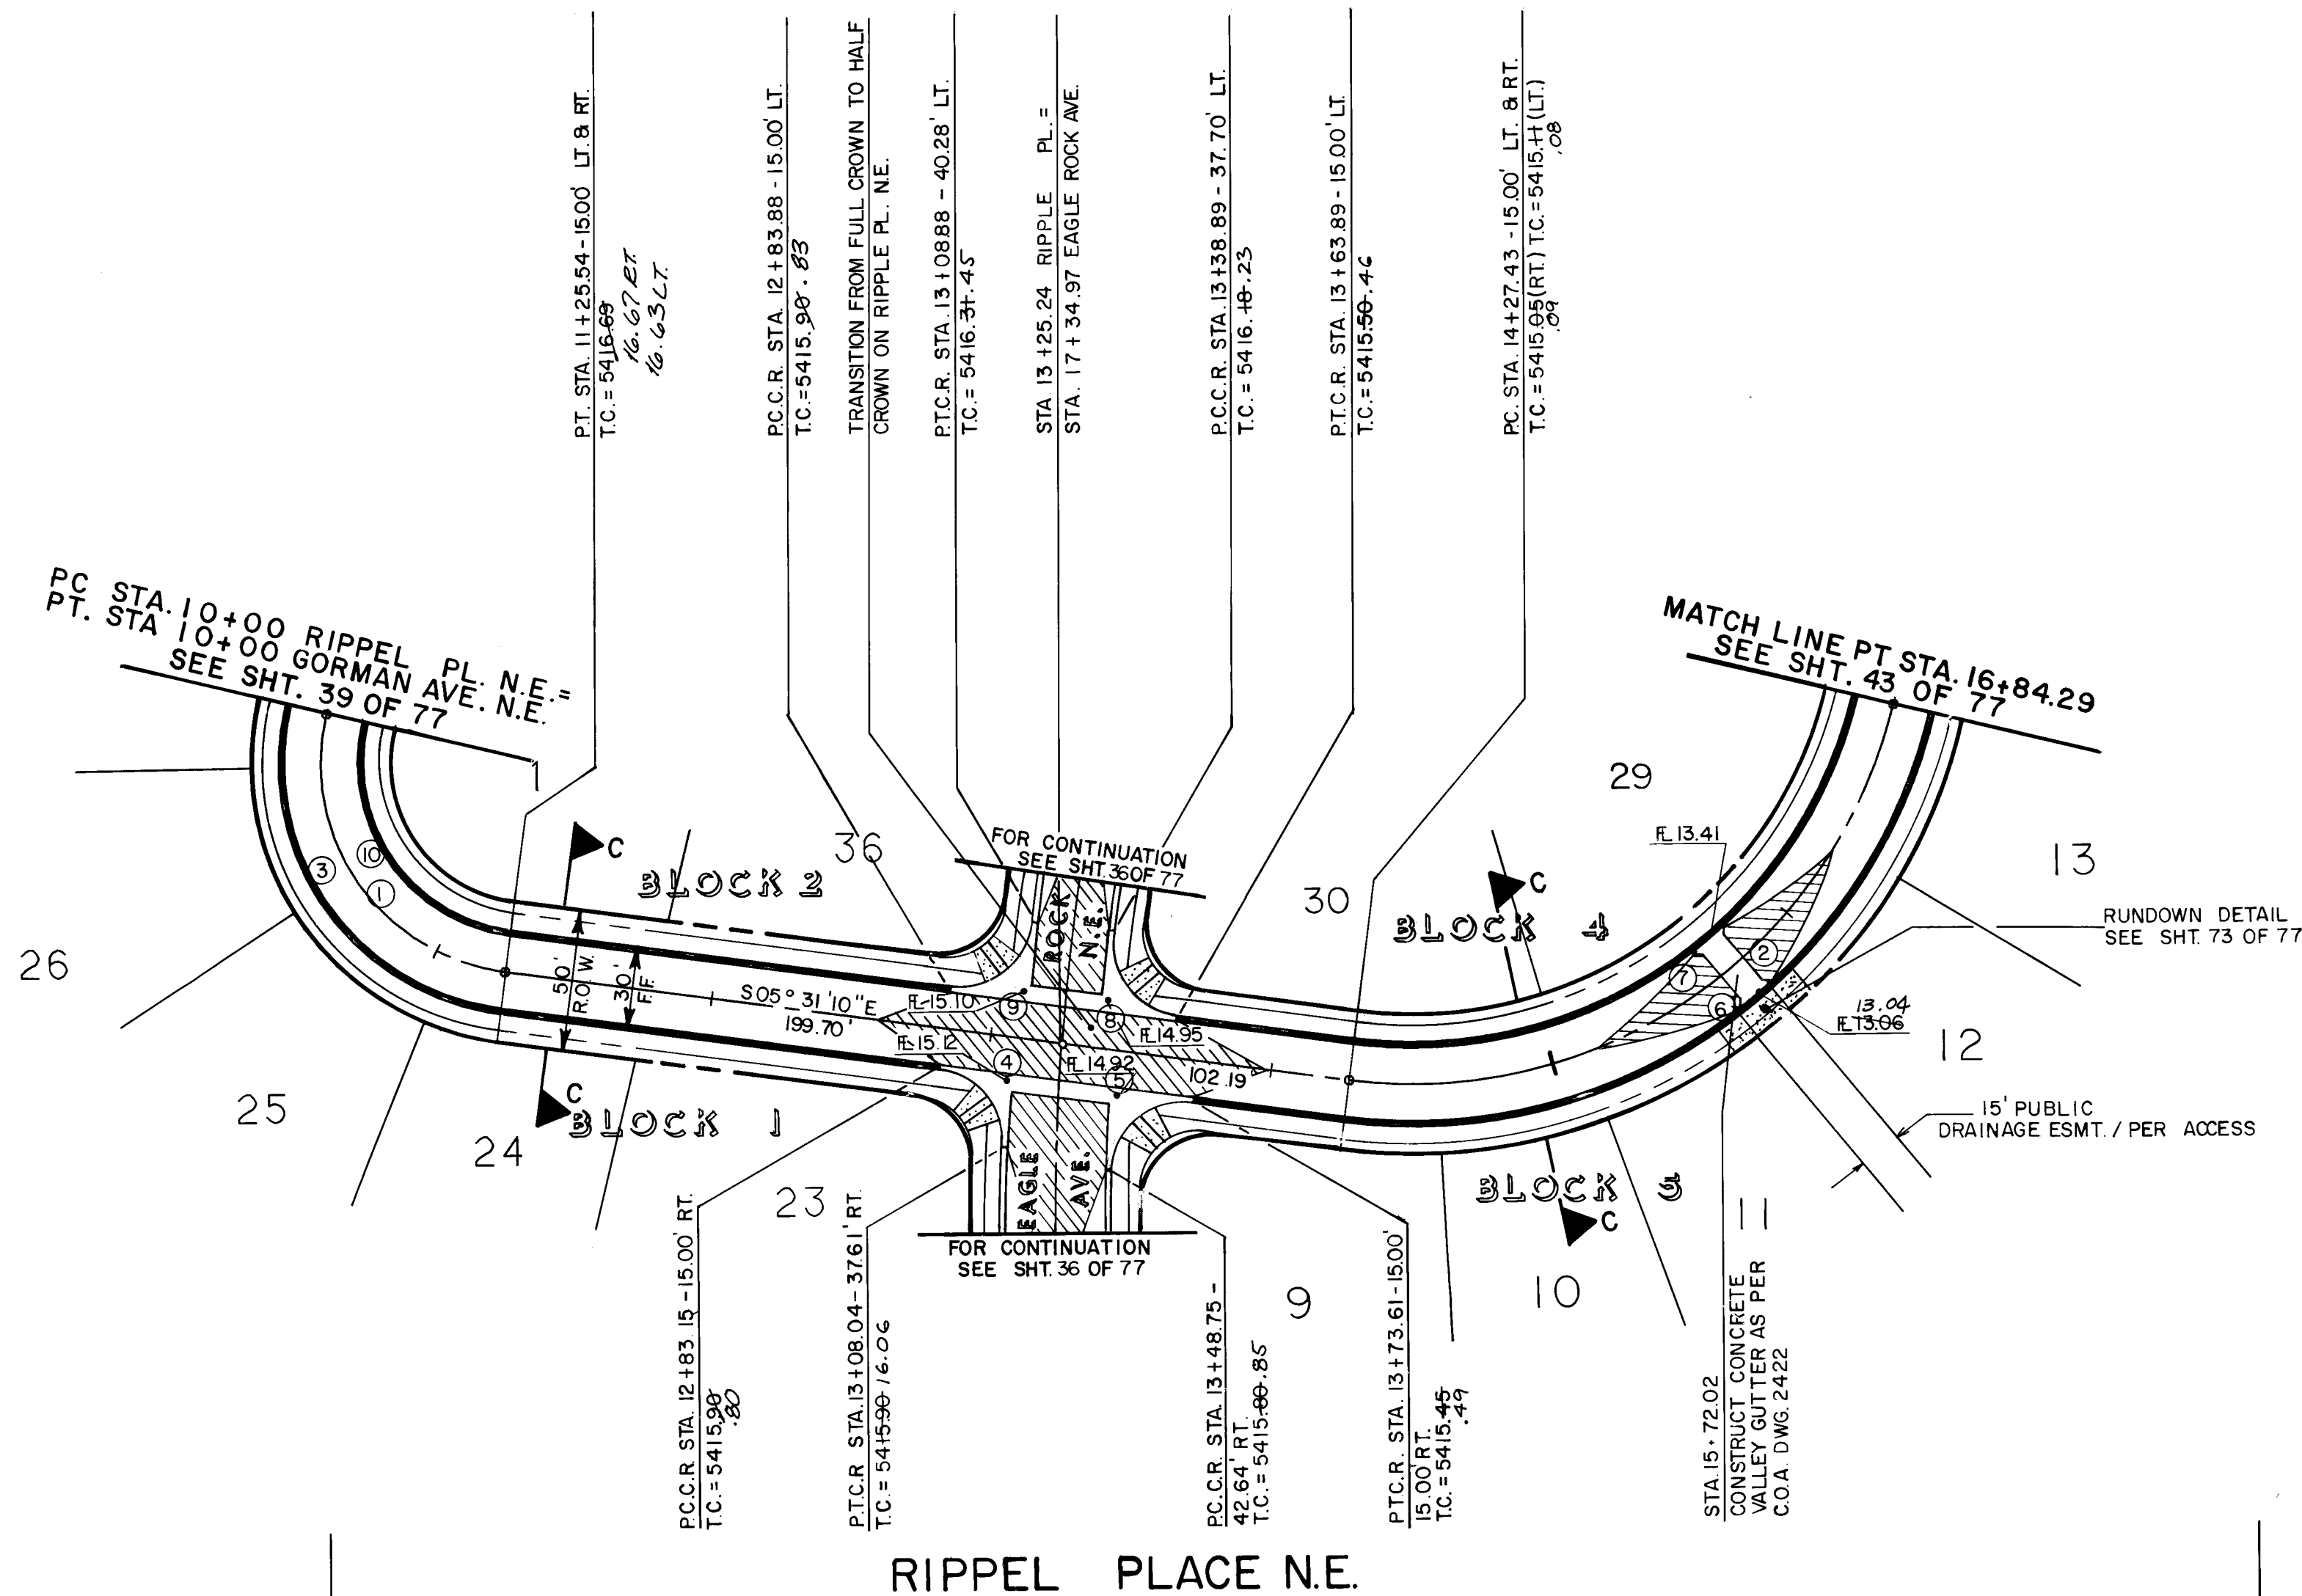

NO.	DELTA	RADIUS	LENGTH	TAN
1	95°54'15"	75.00	125.54	83.16
2	84°05'45"	175.00	256.86	137.84
3	95°54'15"	90.00	150.65	99.79
4	84°30'54"	25.00	36.88	22.71
5	96°03'51"	25.00	41.92	27.80
6	84°05'45"	190.00	278.87	171.36
7	84°05'45"	160.00	234.84	144.31
8	89°18'43"	25.00	38.97	24.70
9	90°37'46"	25.00	39.54	25.28
10	95°54'15"	60.00	100.43	66.52

- PAVING**
- ALL STATIONING AND OFFSET DIMENSIONS ARE BASED ON CENTERLINE OF RIGHT-OF-WAY.
 - THE FOLLOWING CITY OF ALBUQUERQUE STANDARD DRAWINGS ARE APPLICABLE TO THE PAVING CONSTRUCTION:
- | | | |
|------|------|------|
| 2401 | 2415 | 2422 |
| 2405 | 2418 | 2430 |
| 2407 | 2420 | 2440 |
| 2408 | 2421 | 2441 |

THE STATION IS LOCATED 9 MILES NORTHEAST OF DOWNTOWN ALBUQUERQUE. TO REACH THE STATION FROM THE INTERSECTION OF LOUISIANA BLVD. AND LOS ANGELES DRIVE, GO EAST ON LOS ANGELES DRIVE 10 MILES TO BARSTOW ST., THEN NORTH ON BARSTOW ST. 10 MILES TO ALAMEDA AVE. THE STATION IS LOCATED IN THE NORTHEAST QUADRANT OF THE INTERSECTION. THE STATION MARK IS A STANDARD ACS BRASS TABLET STAMPED "1-880", SET IN TOP OF A CONCRETE POST PROJECTING 0.1 FEET ABOVE GROUND. MSLD ELEVATION = 5474.53'


LEGEND

SCALE:
HORIZ. 1"=50'
VERT. 1"=10'

EXISTING CURB & GUTTER AND SIDEWALK	EXISTING DRIVEPADS	EXISTING LIMITS OF ASPHALT PAVEMENT	PROPERTY OR BOUNDARY LINE	CENTERLINE OF STREET	PROPOSED CURB & GUTTER	PROPOSED SIDEWALK	PROPOSED CONCRETE VALLEY GUTTER	PROPOSED WHEELCHAIR RAMP	FUTURE CURB & GUTTER	FUTURE SIDEWALK	FUTURE CONCRETE VALLEY GUTTER	FUTURE WHEELCHAIR RAMP	TRANSITION FROM CROWN TO NO CROWN
-------------------------------------	--------------------	-------------------------------------	---------------------------	----------------------	------------------------	-------------------	---------------------------------	--------------------------	----------------------	-----------------	-------------------------------	------------------------	-----------------------------------

26 31 06 42 88


ESPEY, HUSTON & ASSOCIATES, INC.
Engineering & Environmental Consultants
317 COMMERCIAL ST. N.E.
ALBUQUERQUE, NEW MEXICO 87102
PHONE: (505) 242-1909

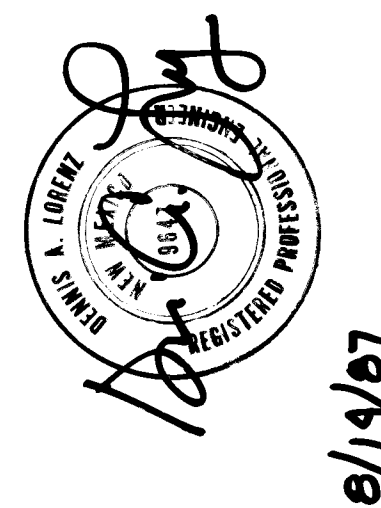

REMARKS:
NO VISUALS
1-500'
JTS
SS MC
D.A.L.
9/87
8/87
8/87

NOR ESTE ESTATES
RIPPELE PLACE N.E.
STA. 10+00.00 TO STA. 16+84.29

Hydro NA
10/5/87
Dennis A. Lorenz
8/24/87
9-1-87

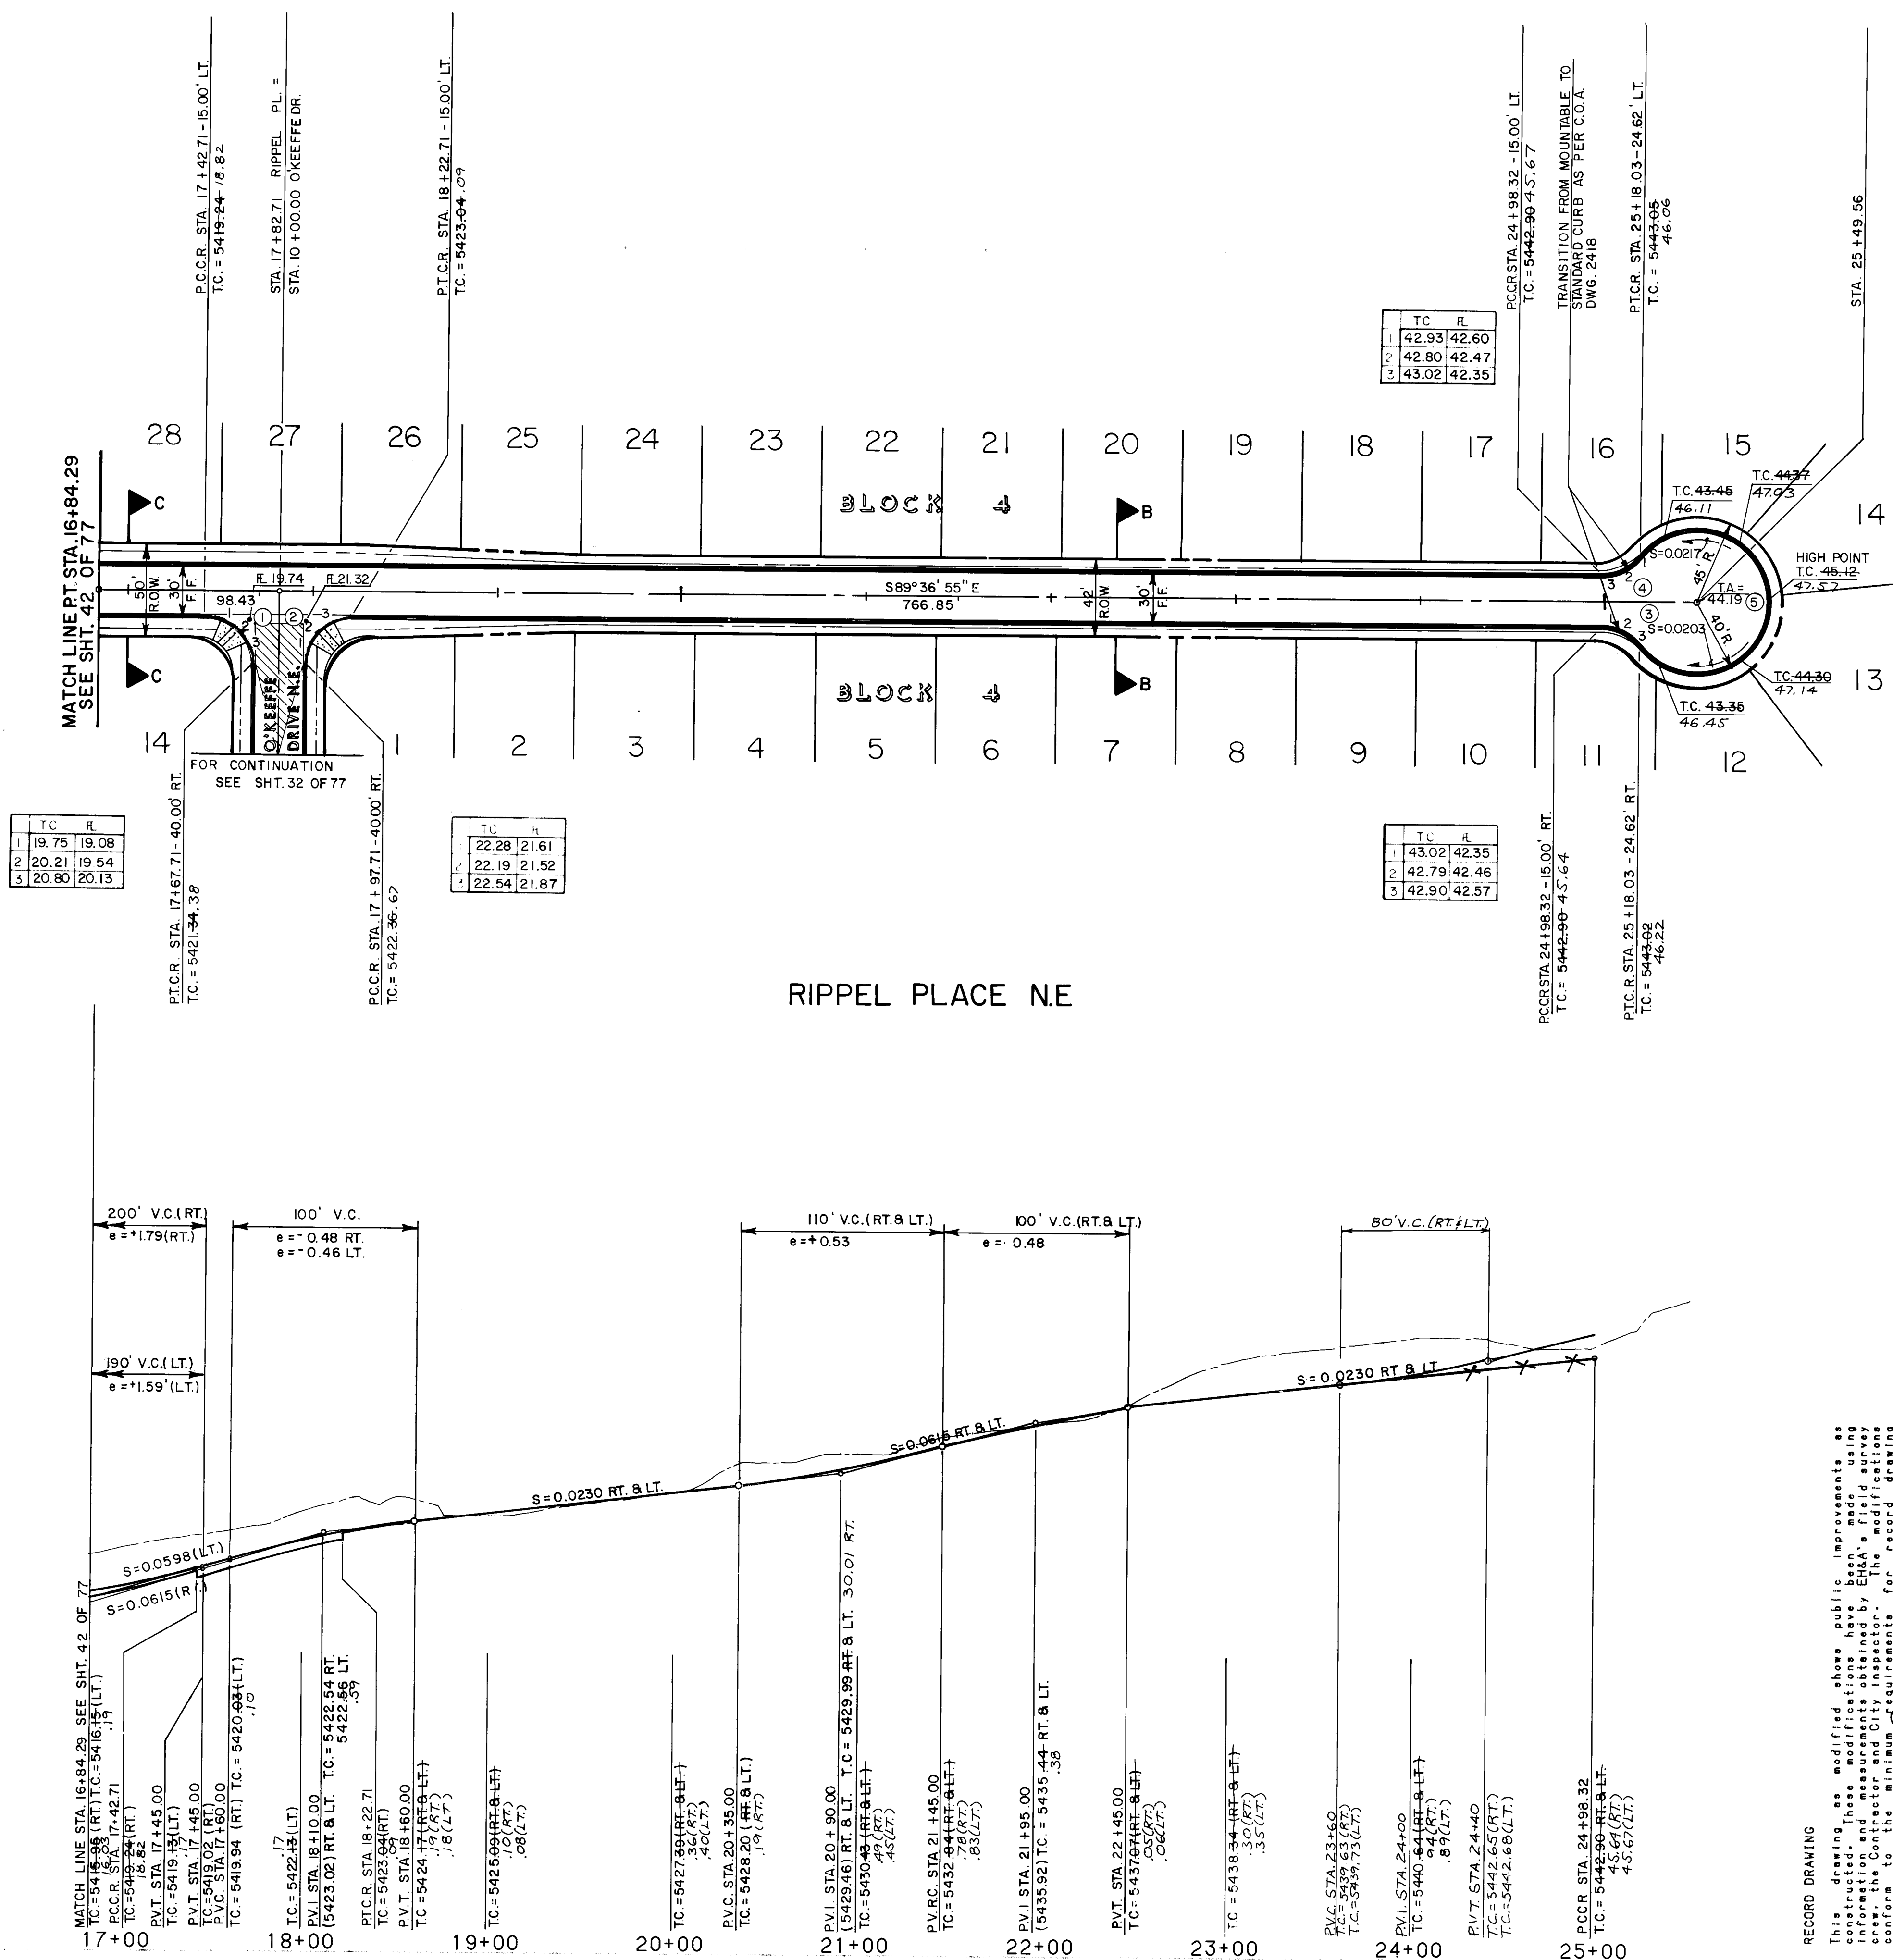

NO.	DELTA	RADIUS	LENGTH	TAN
1	90°00'00"	25.00	39.27	25.00
2	90°00'00"	25.00	39.27	25.00
3	52°01'12"	25.00	22.70	12.20
4	52°01'12"	25.00	22.70	12.20
5	284°02'25"	40.00	198.30	999999.98

PAVING

1. ALL STATIONING AND OFFSET DIMENSIONS ARE BASED ON CENTERLINE OF RIGHT-OF-WAY.
2. THE FOLLOWING CITY OF ALBUQUERQUE STANDARD DRAWINGS ARE APPLICABLE TO THE PAVING CONSTRUCTION:

2401	2415	2422
2405	2418	2430
2407	2420	2440
2408	2421	2441

LEGEND

SCALE:
HORIZ. 1"=50'
VERT. 1"=10'

- | | | |
|-------|---|-------------------------------------|
| = 50' | | EXISTING CURB & GUTTER |
| = 10' | | EXISTING SIDEWALK |
| | | EXISTING DRIVEPADS |
| | | EXISTING LIMITS OF ASPHALT PAVEMENT |
| | | PROPERTY OR BOUNDARY LINE |
| | | CENTERLINE OF STREET |
| 5470 | | PROPOSED CURB & GUTTER |
| | | PROPOSED SIDEWALK |
| 5460 | | PROPOSED CONCRETE VALLEY GUTTER |
| | | PROPOSED WHEELCHAIR RAMP |
| | | FUTURE CURB & GUTTER |
| 5450 | | FUTURE SIDEWALK |
| | | FUTURE CONCRETE VALLEY GUTTER |
| 5440 | | FUTURE WHEELCHAIR RAMP |
| | | TRANSITION FROM CROWN TO NO CROWN |
| 5430 | | |
| | <div style="border: 1px solid black; padding: 5px; text-align: center;"> 1 2 3 4 5 6 7 8 9 10 11 12
 26 31864388 </div> | |
| 5420 | <div style="background-color: black; color: white; padding: 10px;"> <p>ESPEY,
HUSTON &
ASSOCIATES, INC.
Engineering & Environmental Consultants.</p> </div> | |
| 5410 | <div style="background-color: black; color: white; padding: 10px;"> <p>317 COMMERCIAL ST. N.E.
ALBUQUERQUE, NEW MEXICO 87102
PHONE: (505) 242-1909</p> </div> | |

[illegible]

Donors A. 100000 P.F. 9647	Date
--------------------------------	------

NOR ESTE ESTATES
RIPPEL PLACE N.E.
STA.16+84.20 TO STA.25+49.56

Hydro

3186



C-19

43 OF 77

NEW CONCEPTS
EH : A
'87-'88

THE STATION IS LOCATED 9 MILES NORTHEAST OF DOWNTOWN ALBUQUERQUE. TO REACH THE STATION FROM THE INTERSECTION OF LOUISIANA, ARIZONA, AND LOS ANGELES DRIVE, GO EAST ON LOS ANGELES DRIVE 10 MILES TO BARBOW ST., THEN NORTH ON BARBOW ST. 1.0 MILES TO ALAMEDA AVE. THE STATION IS LOCATED IN THE NORTHEAST QUADRANT OF THE INTERSECTION. THE STATION MARK IS A STANDARD CASE BRASS TABLET STAMPED "1-B20", SET IN TOP OF A CONCRETE POST PROJECTING 0.1 FEET ABOVE GROUND.

MEAD ELEVATION = 5474.33'

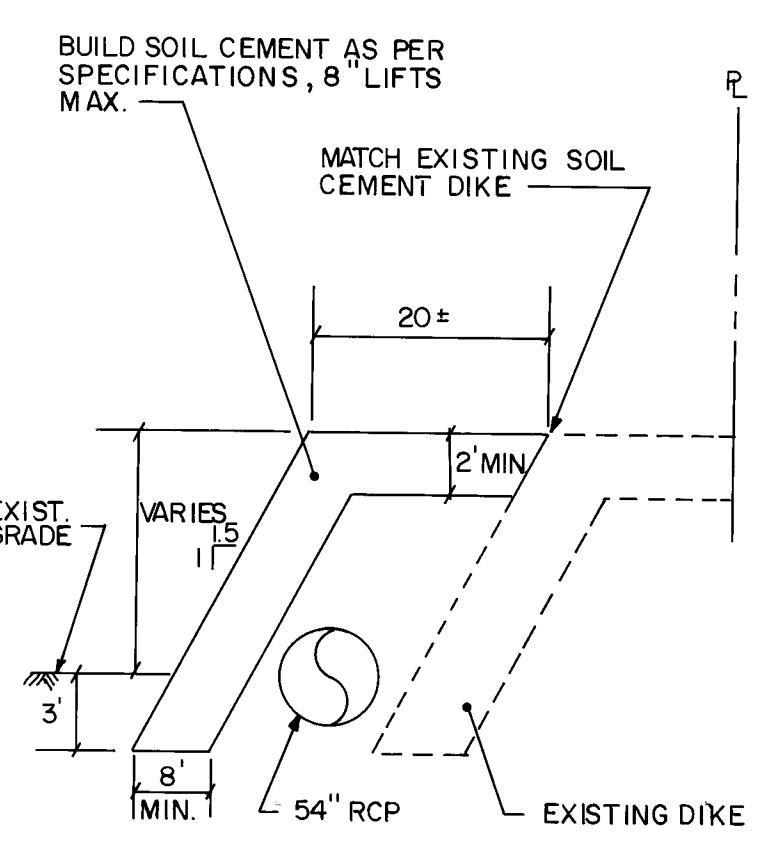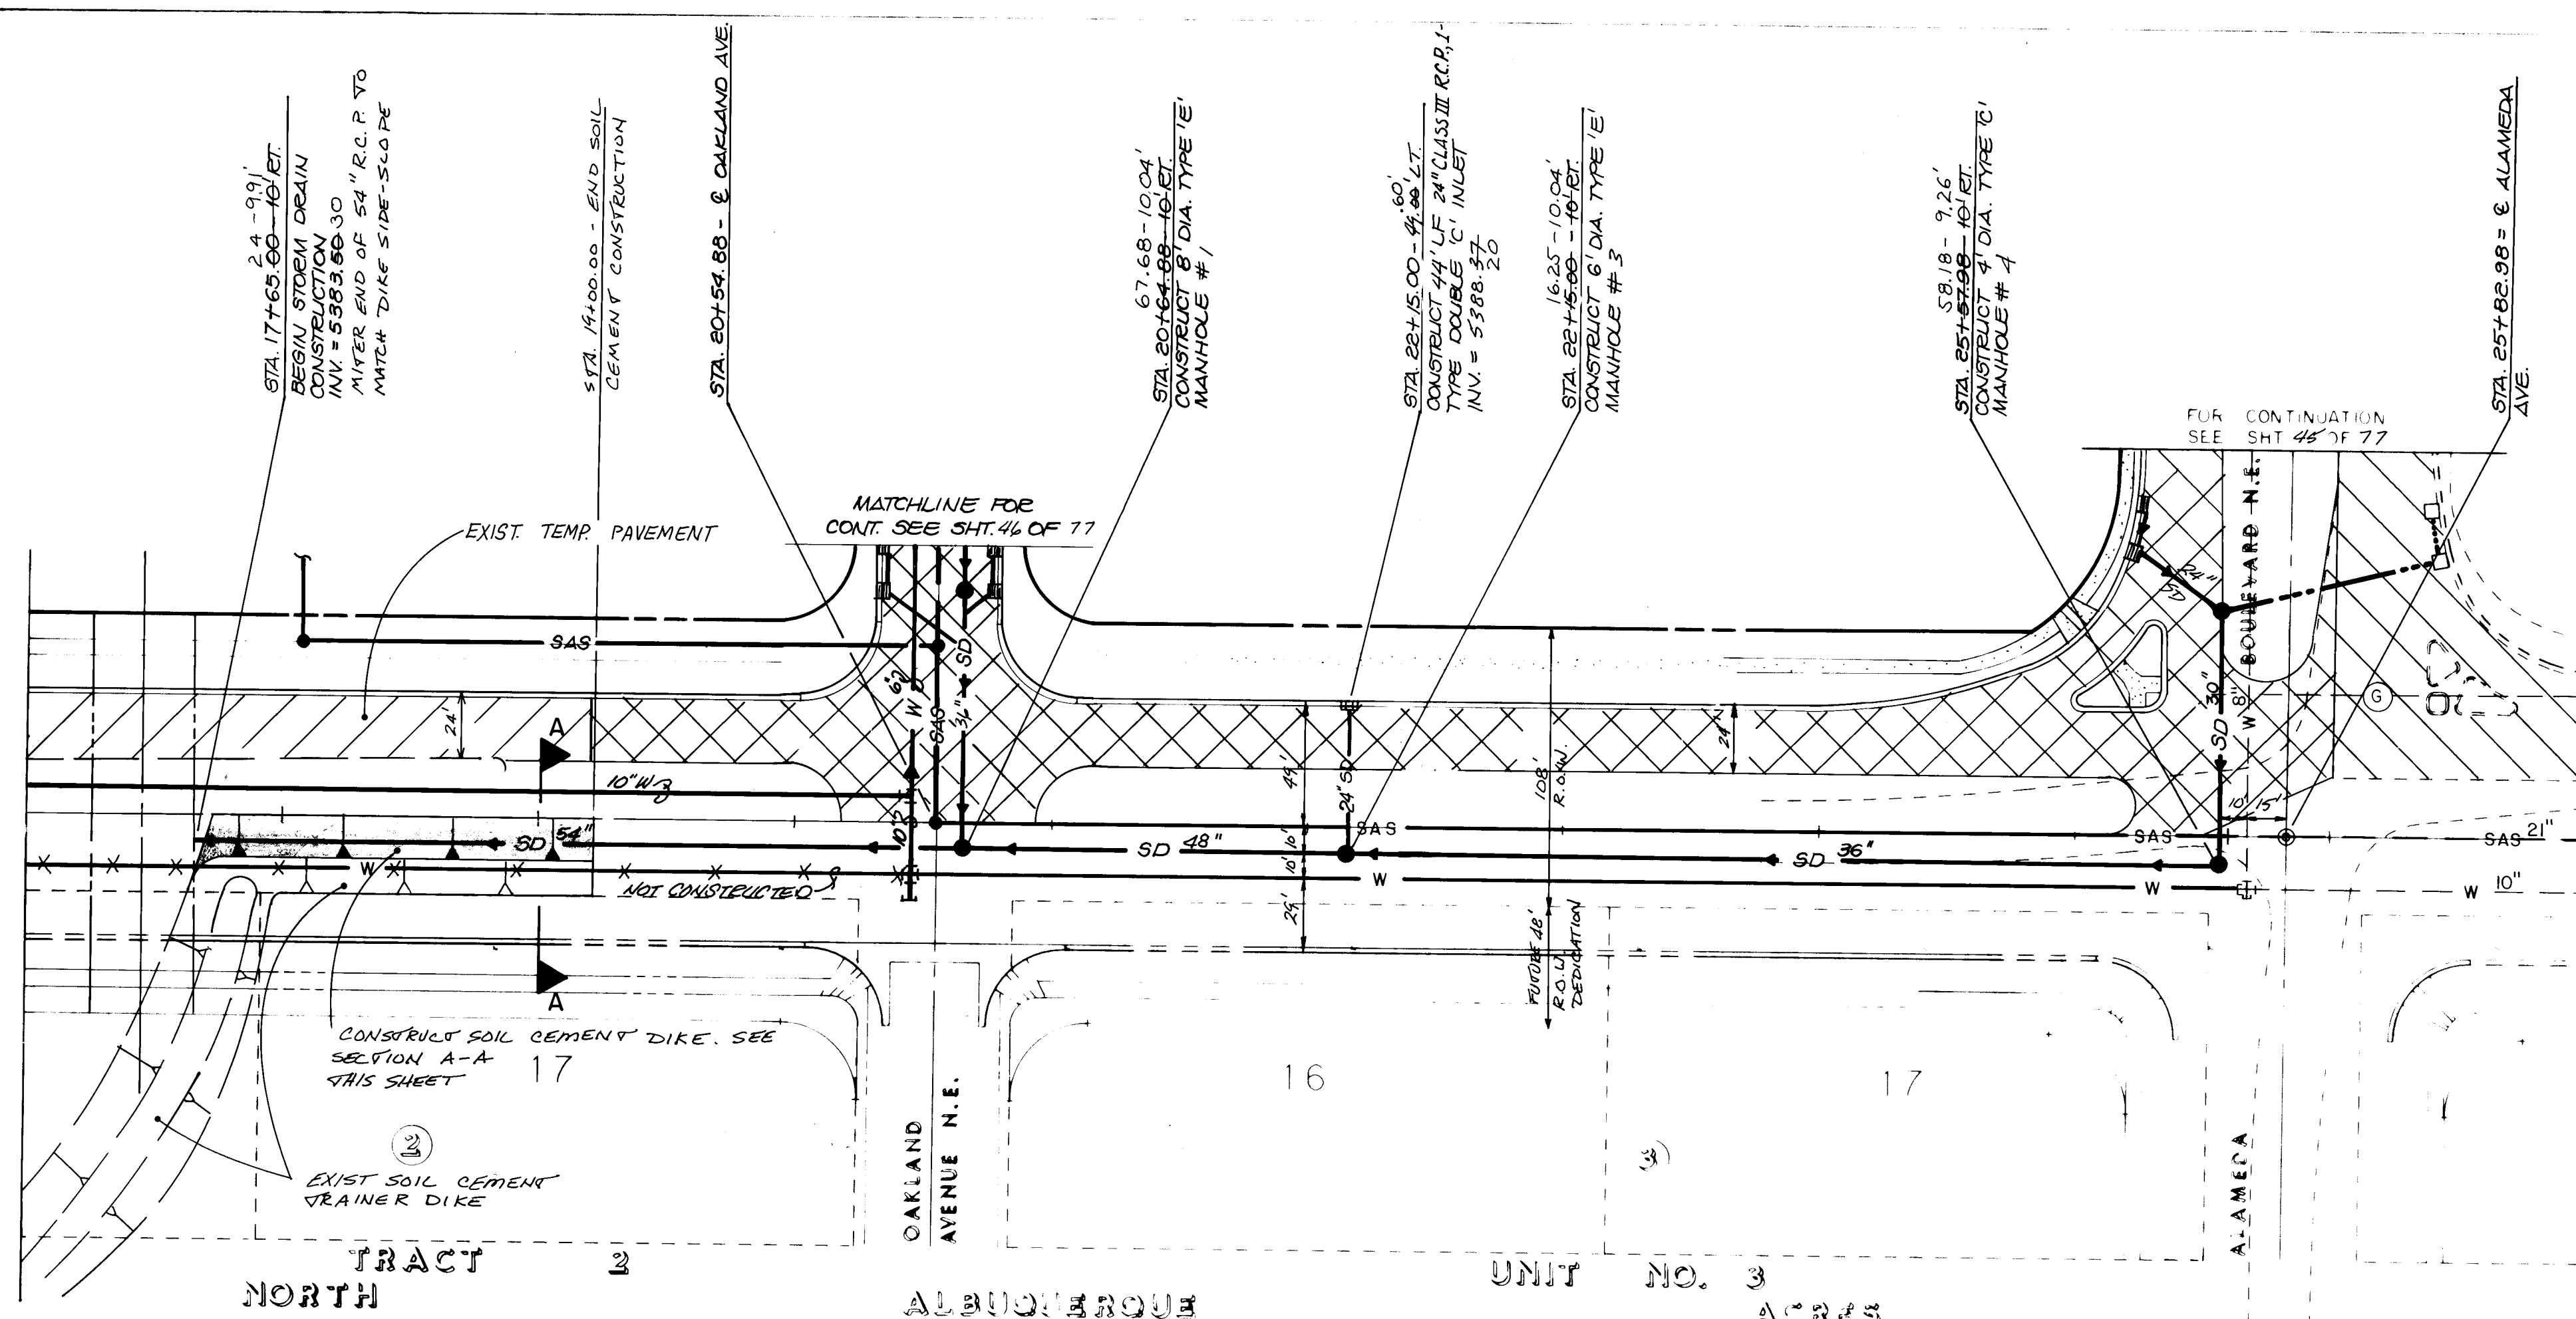

- ALL STATIONING AND OFFSET DIMENSIONS ARE BASED ON CENTERLINE OF RIGHT-OF-WAY.
 - THE FOLLOWING CITY OF ALBUQUERQUE STANDARD DRAWINGS ARE APPLICABLE TO THE STORM DRAINAGE CONSTRUCTION:
- | | | |
|------|------|------|
| 2102 | 2203 | 2236 |
| 2110 | 2207 | |
| 2201 | 2216 | |
| 2202 | 2220 | |

LEGEND


- PROPOSED SOIL CEMENT DIKE
- PROPOSED PAVING
- EXISTING PAVING
- PROPOSED WATERLINE
- PROPOSED GATE VALVE
- PROPOSED FIRE HYDRANT
- PROPOSED CAP OR PLUG
- PROPOSED CROSS, TEE, OR ELBOW
- PROPOSED SANITARY SEWER LINE
- PROPOSED MANHOLE
- PROPERTY OR BOUNDARY LINE
- CENTERLINE OF STREET
- CURB AND GUTTER
- SIDEWALK
- EXISTING WATERLINE
- EXISTING SANITARY SEWER LINE
- EXISTING CAP OR PLUG
- EXISTING MANHOLE
- FUTURE STORM DRAIN
- FUTURE INLET

SCALE:
HORIZ. 1"=50'
VERT. 1"=10'

RECORD DRAWING
This drawing as modified shows public improvements as constructed. It is the responsibility of the engineer to verify information and measurements obtained by EHA's field crew, the Contractor and City Inspector. The modifications conform to the minimum requirements for record drawings as set forth in the City of Albuquerque Engineering Department Process Manual. The Engineer shall be responsible for the accuracy of the information shown on this drawing.
Dennis A. Lorenz P.E. 3-14-88
Date


ESPEY, HUSTON & ASSOCIATES, INC.
Engineering & Environmental Consultants
317 COMMERCIAL ST. N.E.
ALBUQUERQUE, NEW MEXICO 87102
PHONE: (505) 242-1909

CITY OF ALBUQUERQUE PUBLIC WORKS DEPARTMENT ENGINEERING GROUP	
TITLE NOR ESTE ESTATES WYOMING BOULEVARD N.E. STORM SEWER - STA. 17+00 TO STA. 27+00	
APPROVALS	DATE
D.R.C. Chief	10/5/87
Trans. Div.	7/6/87
Utility Div.	8/1/87
DRAWING NO.	3186
MAP NO.	C-19
SHEET	44
OF	77

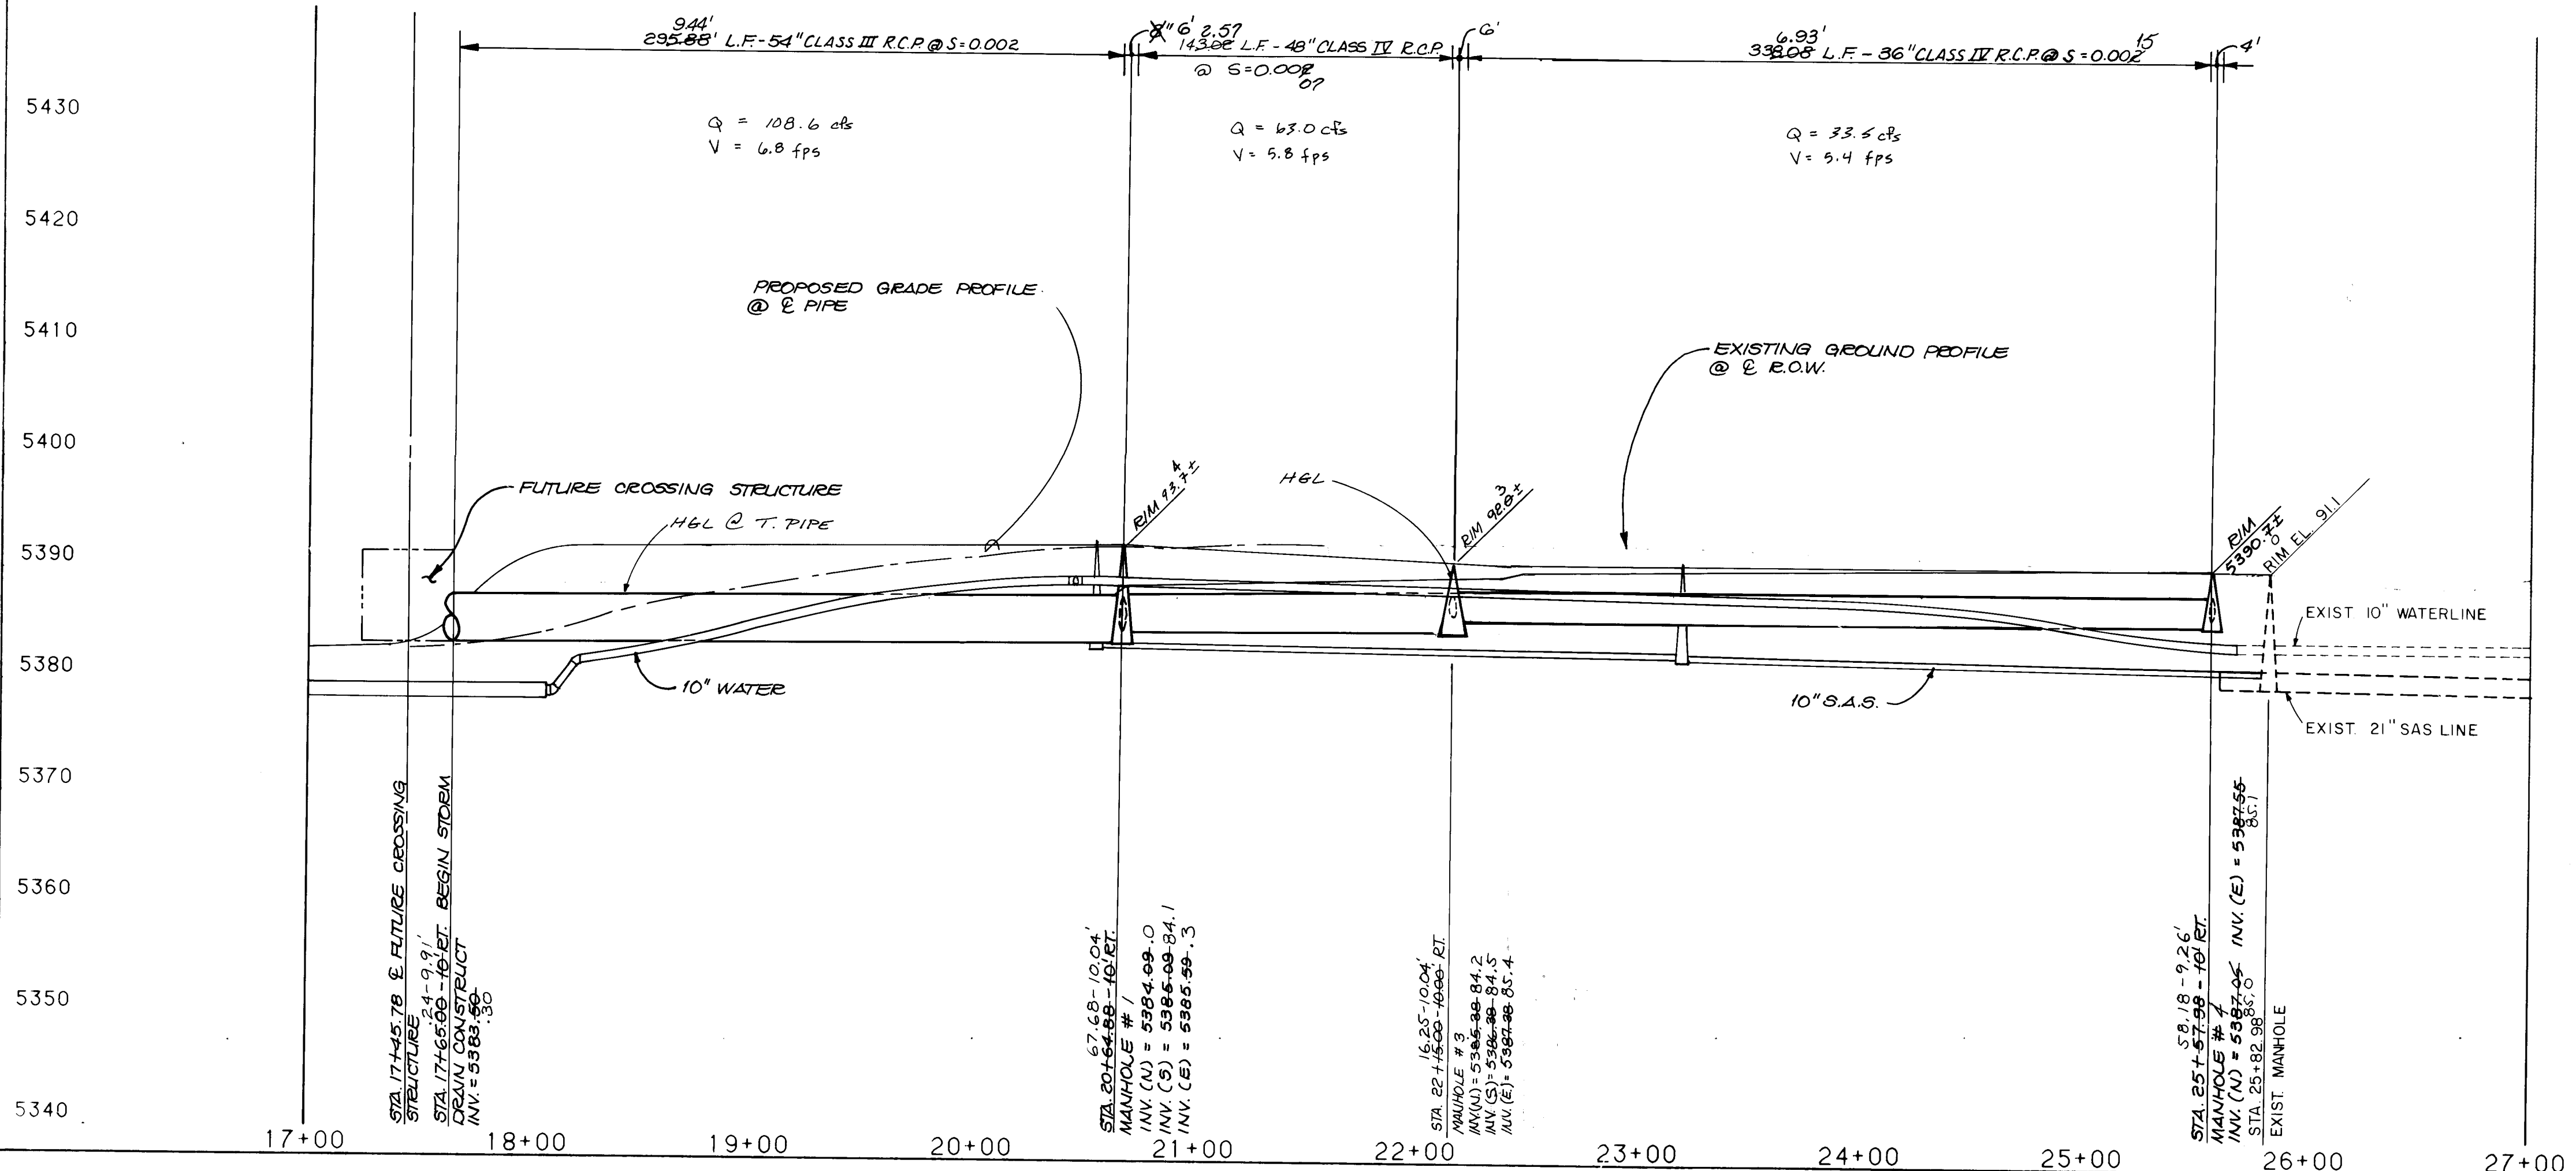

THE STATION IS LOCATED 9 MILES NORTHEAST OF DOWNTOWN ALBUQUERQUE TO REACH THE STATION FROM THE INTERSECTION OF LOUISIANA BLVD. AND LOS ANGELES DRIVE, GO EAST ON LOS ANGELES DRIVE 10 MILES TO BARSTOW ST., THEN NORTH ON BARSTOW ST. 10 MILES TO ALAMEDA AVE. THE STATION IS LOCATED IN THE NORTHEAST QUADRANT OF THE INTERSECTION. THE STATION MARK IS A STANDARD ACS BRASS TABLET, STAMPED "1-B20", SET IN TOP OF A CONCRETE POST PROJECTING 0.1 FEET ABOVE GROUND.
MSL ELEVATION = 5474.53'

6/87
8/87
8/87
RHS
P.A.L.
DATE

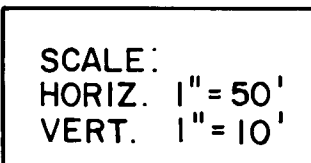

STORM DRAINAGE		AS BUILT INFORMATION	
1.	ALL STATIONING AND OFFSET DIMENSIONS ARE BASED ON CENTERLINE OF RIGHT-OF-WAY.	2.	THE FOLLOWING CITY OF ALBUQUERQUE STANDARD DRAWINGS ARE APPLICABLE TO THE STORM DRAINAGE CONSTRUCTION:
2102	2203	2236	
2110	2207		
2201	2216		
2202	2220		

RECORD DRAWING

This drawing as modified shows public improvements as constructed. These modifications have been made using information and measurements obtained by EHA's field survey crew, the Contractor and City Inspector. The modifications conform to the minimum requirements of the City of Albuquerque Development Process Manual, Section 27.4 to the best of my knowledge and belief.



Dennis A. Loranzo
Dennis A. Loranzo P.E. 19647


BENCH MARKS

THE STATION IS LOCATED 9 MILES NORTHEAST OF DOWNTOWN ALBUQUERQUE. TO REACH THE STATION FROM THE INTERSECTION OF LOUISIANA BLVD. AND LOS ANGELES DRIVE, GO EAST ON LOS ANGELES DRIVE 10 MILES TO BARSTOW ST., THEN NORTH ON BARSTOW ST. 1.0 MILES TO ALAMEDA AVE. THE STATION IS LOCATED IN THE NORTHEAST QUADRANT OF THE INTERSECTION. THE STATION MARK IS A STANDARD ACS BRASS TABLET STAMPED "1-820", SET IN TOP OF A CONCRETE POST PROJECTING 0.1 FEET ABOVE GROUND.

LEGEND

	PROPOSED WATERLINE
	PROPOSED GATE VALVE
	PROPOSED FIRE HYDRANT
	PROPOSED CAP OR PLUG
	PROPOSED CROSS, TEE, OR ELBOW
	PROPOSED SANITARY SEWER LINE
	PROPOSED MANHOLE
	PROPERTY OR BOUNDARY LINE
	CENTERLINE OF STREET
	CURB AND GUTTER
	SIDEWALK
	EXISTING WATERLINE
	EXISTING SANITARY SEWER LINE
	EXISTING CAP OR PLUG
	EXISTING MANHOLE
	EXISTING PAVING
	PROPOSED PAVING

ENGINEER'S SEAL

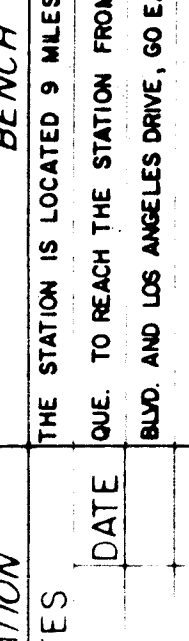

Dennis A. Loranzo
Dennis A. Loranzo P.E. 19647

DESIGN

DATE: 6/87
BY: R.H.S.
CHECKED BY: D.M.C.
DATE: 8/87

REVISIONS

NO.	DATE	REMARKS

ESPEY, HUSTON & ASSOCIATES, INC.
Engineering & Environmental Consultants

317 COMMERCIAL ST. N.E.
ALBUQUERQUE, NEW MEXICO 87102
PHONE: (505) 242-1909

CITY OF ALBUQUERQUE
PUBLIC WORKS DEPARTMENT
ENGINEERING GROUP

TITLE: NOR ESTE ESTATES
ALAMEDA BOULEVARD N.E.
STORM SEWER - STA.8+35 TO STA.18+00


DATE: 6/87
BY: R.H.S.
CHECKED BY: D.M.C.
DATE: 8/87

APPROVALS	ENGINEER	DATE	APPROVALS	DATE
DRC Chair	<i>[Signature]</i>	10/5/97		
Trans. Dev	N.A. DWH	9/16/87		
Utility Dev	REE	8/3/87		
Hydrology	<i>[Signature]</i>	9-1-87		

DRAWING NO. 3186

MAP NO. C-19

SHEET 45 OF 77

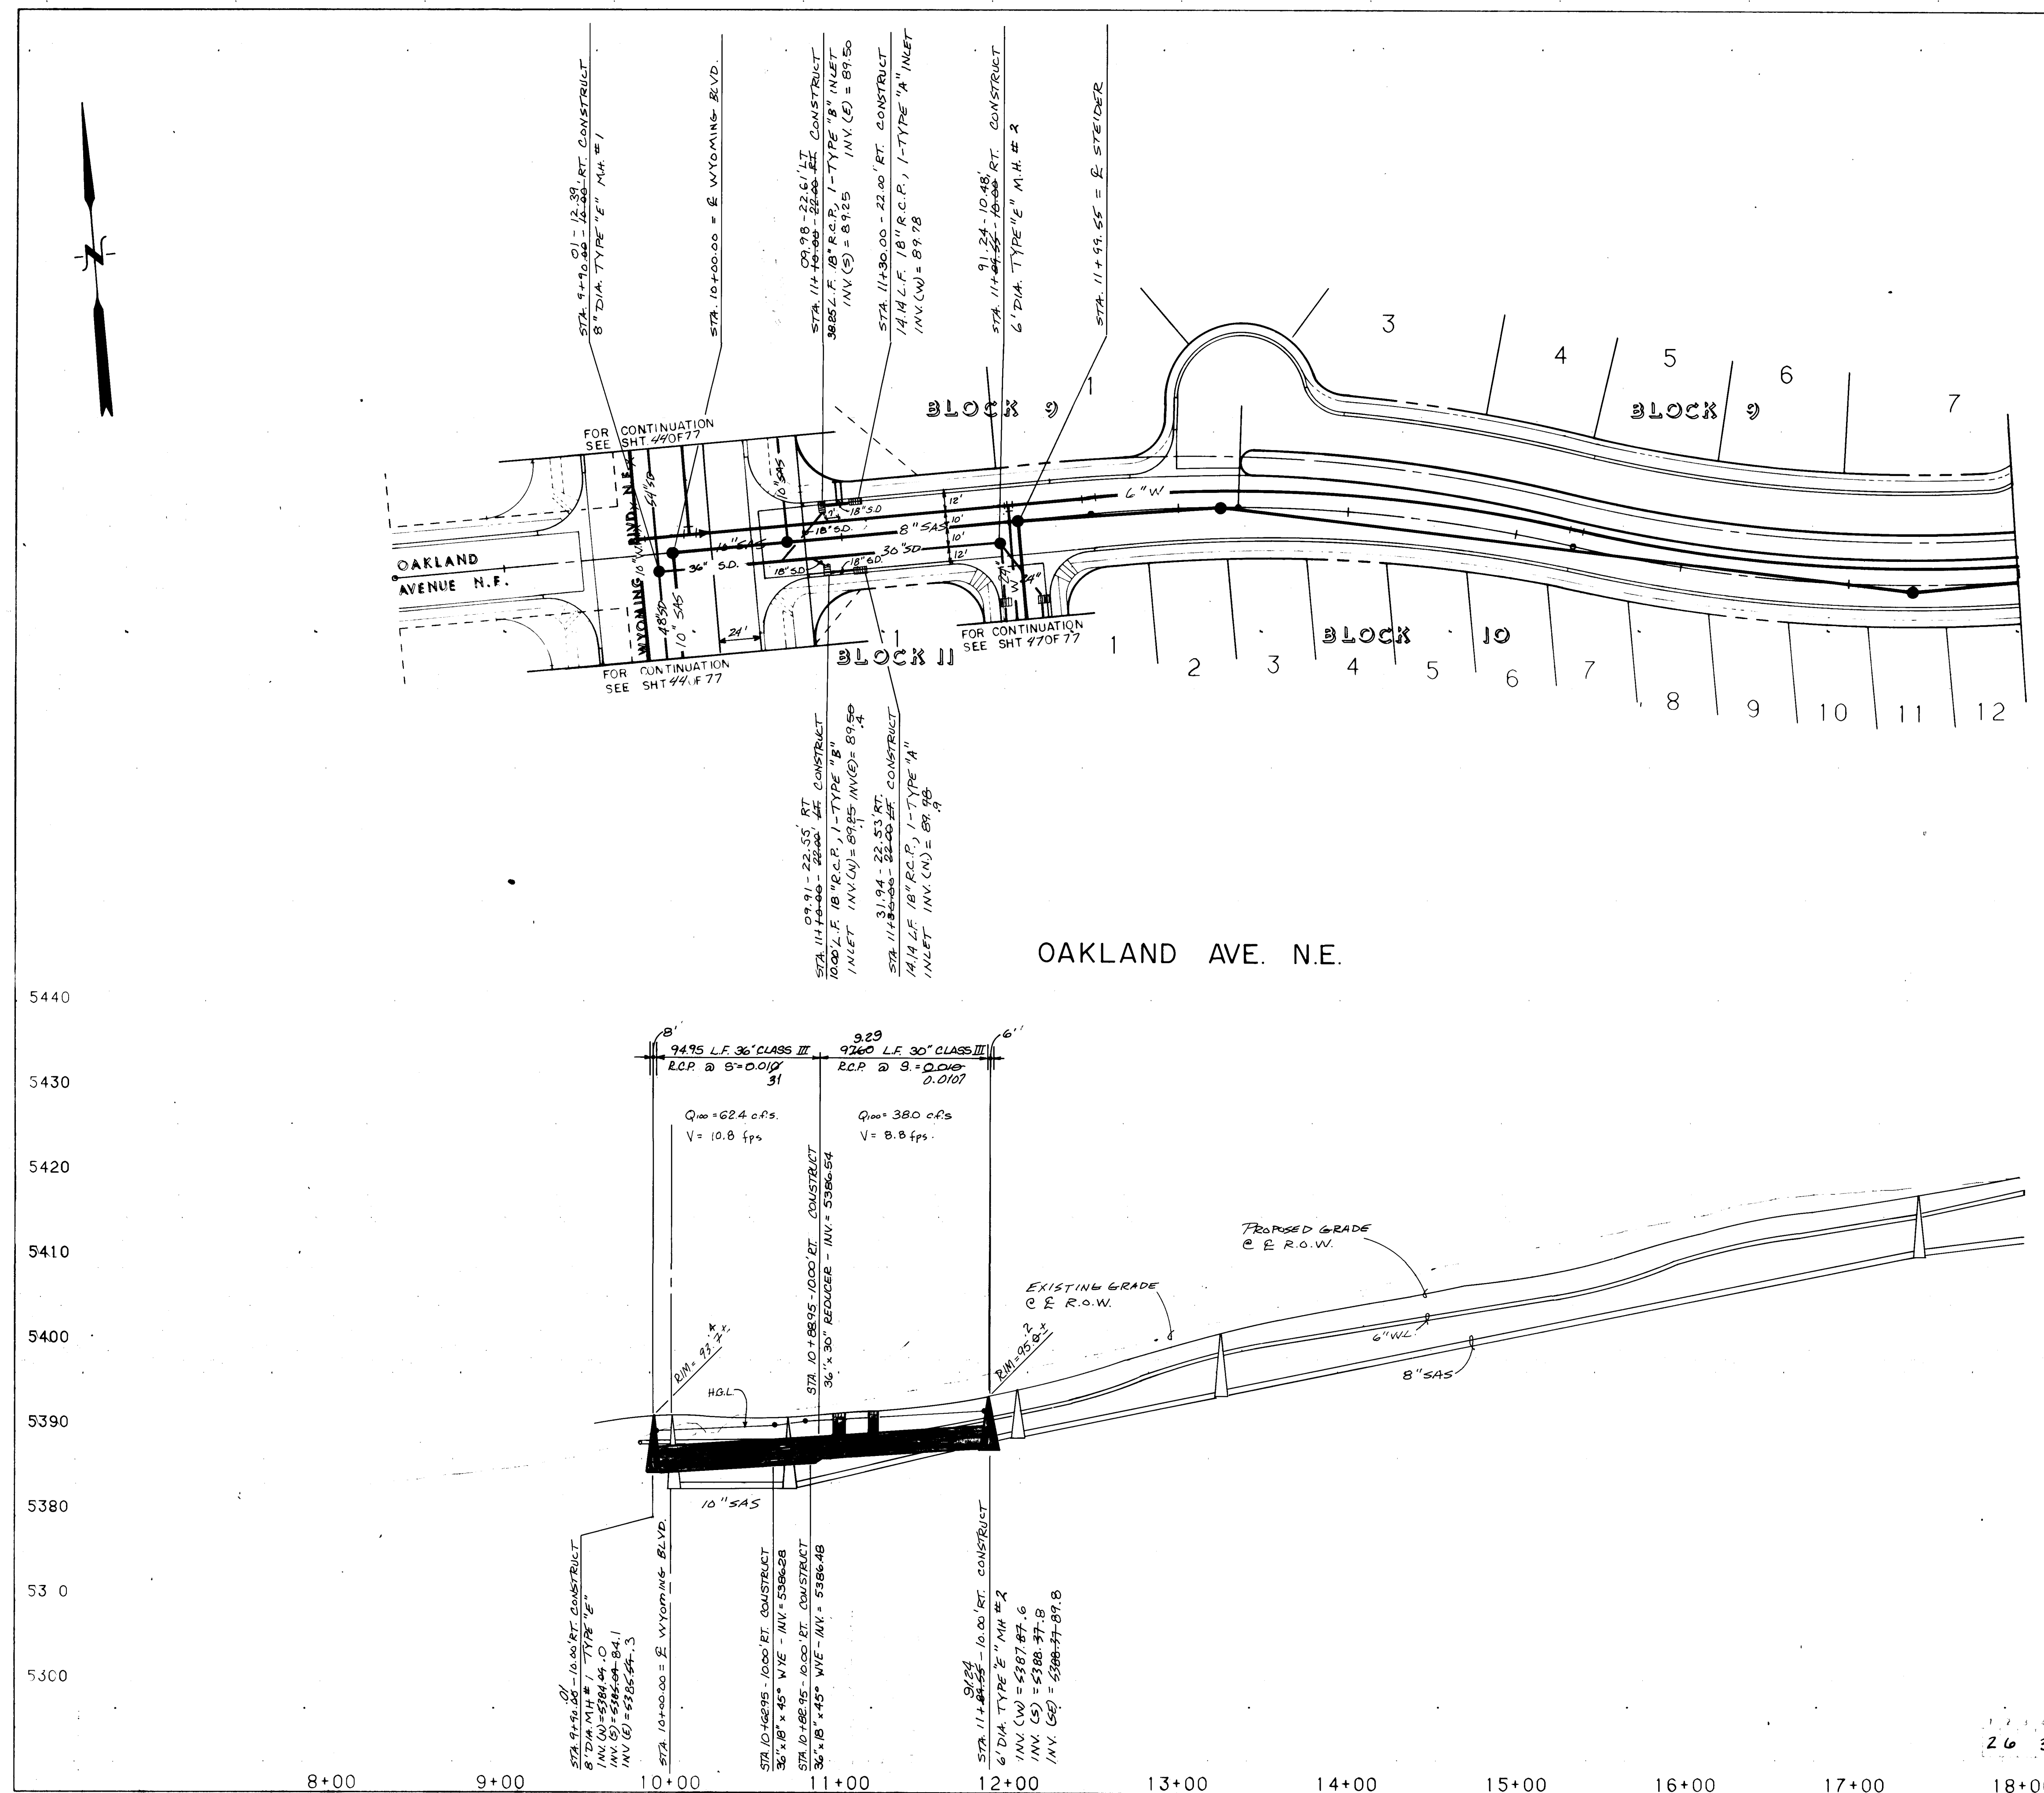

SCALE :
HORIZ. 1" = 50'
VERT. 1" = 10'

- | | |
|---|---|
|  | PROPOSED WATERLINE |
|  | PROPOSED GATE VALVE |
|  | PROPOSED FIRE HYDRANT |
|  | PROPOSED CAP OR PLUG |
|  | PROPOSED SINGLE METER,
WATER SERVICE LINE |
|  | PROPOSED DOUBLE METER,
WATER SERVICE LINES |
|  | PROPOSED CROSS, TEE, OR
ELBOW |
|  | PROPOSED SANITARY SEWER
LINE |
|  | PROPOSED MANHOLE |
|  | PROPOSED CAP OR PLUG |
|  | PROPOSED SANITARY SEWER
SERVICE LINE |
|  | PROPERTY OR BOUNDARY
LINE |
|  | CENTERLINE OF STREET |
|  | CURB AND GUTTER |
|  | SIDEWALK |

**ESPEY,
HUSTON &
ASSOCIATES, INC.**
Engineering & Environmental Consultants


**317 COMMERCIAL ST. N.E.
ALBUQUERQUE, NEW MEXICO 87102
PHONE: (505) 242-1909**

CITY OF ALBUQUERQUE
PUBLIC WORKS DEPARTMENT
ENGINEERING GROUP

TITLE	NOR ESTE ESTATES OAKLAND AVE. N.E. STORM SEWER STA. 9+9000 TO STA. 11+89.55
-------	---

APPROVAL	DATE	DATE	APPROVAL	DATE
Chief, Dept.	<i>John Doe</i>	10/5/67		
Training Dept.	SA DWH	7/14/67		
Officer, Dept.	DEE	8/31/67		
<i>Hypocrit</i>	<i>Ken J. Doe</i>	9-1-67		

DRAWING NO	3186	MAP NO C-19	SHEET 46	OF 77
---------------	------	----------------	-------------	----------

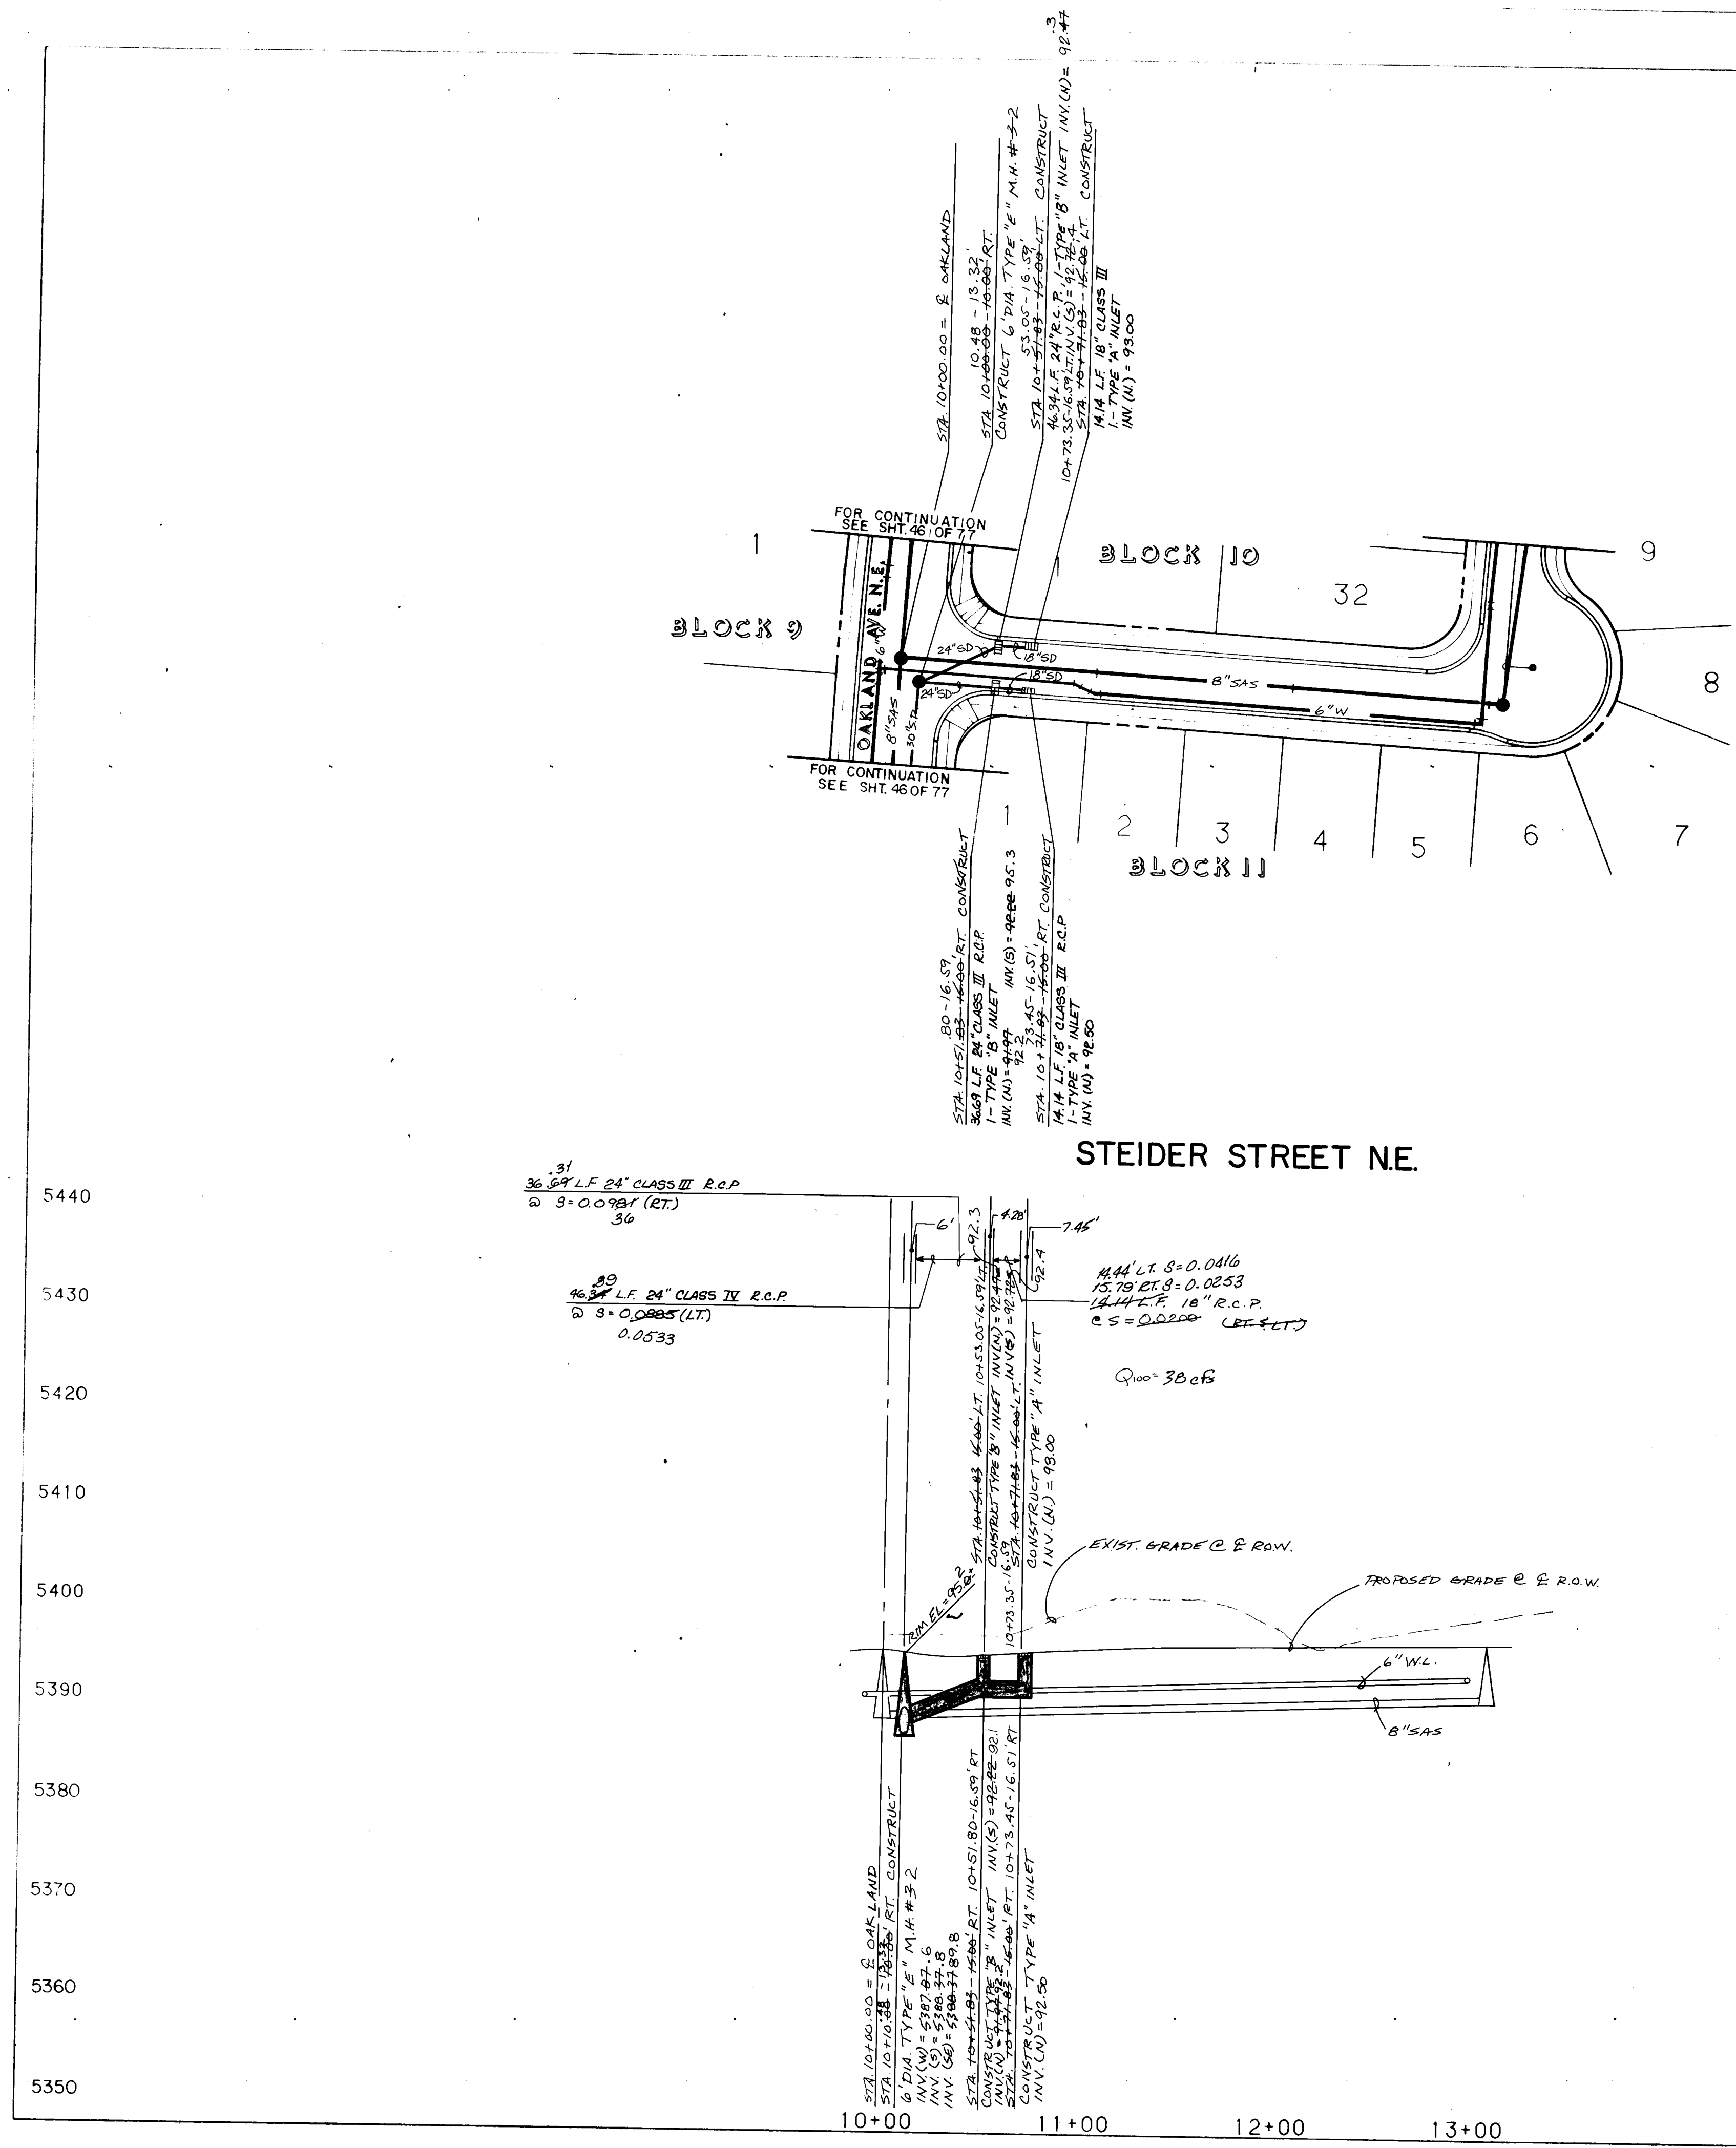

SCALE:
HORIZ. 1" = 50'
VERT. 1" = 10'

LEGEND

- W PROPOSED WATERLINE
- X PROPOSED GATE VALVE
- H PROPOSED FIRE HYDRANT
- I PROPOSED CAP OR PLUG
- PROPOSED SINGLE METER, WATER SERVICE LINE
- PROPOSED DOUBLE METER, WATER SERVICE LINES
- + F + PROPOSED CROSS, TEE, OR ELBOW
- SAS PROPOSED SANITARY SEWER LINE
- PROPOSED MANHOLE
- I PROPOSED CAP OR PLUG
- PROPOSED SANITARY SEWER SERVICE LINE
- PROPERTY OR BOUNDARY LINE
- CENTERLINE OF STREET
- == CURB AND GUTTER
- SIDEWALK

ESPEY,
HUSTON &
ASSOCIATES, INC.
Engineering & Environmental Consultants
317 COMMERCIAL ST. N.E.
ALBUQUERQUE, NEW MEXICO 87102
PHONE: (505) 242-1908

CITY OF ALBUQUERQUE PUBLIC WORKS DEPARTMENT ENGINEERING GROUP	
TITLE NOR ESTE ESTATES STEIDER ST. N.E. STORM SEWER STA. 10+00.00 TO STA. 13+40.66	
APPROVAL	DATE
DRC: <i>[Signature]</i>	10/5/87
Trans. Div.	1/6/87
Utility Div.	2/4/87
Hydrology	9-1-87
DRAWING NO.	MAP NO.
3186	C-19
SHEET 47 OF 77	

- #### STORM DRAINAGE
- ALL STATIONING AND OFFSET DIMENSIONS ARE BASED ON CENTERLINE OF RIGHT-OF-WAY.
 - THE FOLLOWING CITY OF ALBUQUERQUE STANDARD DRAWINGS ARE APPLICABLE TO THE STORM DRAINAGE CONSTRUCTION:
- | | | |
|------|------|------|
| 2102 | 2203 | 2236 |
| 2110 | 2207 | |
| 2201 | 2216 | |
| 2202 | 2220 | |


RECORD DRAWING
This drawing, as modified, shows public improvements as constructed. It is the responsibility of the Engineer to verify the information and measurements obtained from the field and to ensure that the construction conforms to the minimum standards of the City of Albuquerque. The Engineer shall be responsible for the accuracy of the information and measurements obtained from the field and for the accuracy of the construction. The Engineer shall be responsible for the accuracy of the information and measurements obtained from the field and for the accuracy of the construction. The Engineer shall be responsible for the accuracy of the information and measurements obtained from the field and for the accuracy of the construction.

[Signature]
Dennis A. Lorenz, P.E.
10-14-88





AS BUILT INFORMATION
THE STATION IS LOCATED 9 MILES NORTHEAST OF DOWNTOWN ALBUQUERQUE TO REACH THE STATION FROM THE INTERSECTION OF LOUISIANA AND LOS ANGELES DRIVE, GO EAST ON LOS ANGELES DRIVE 10 MILES TO BAIRSTON ST., THEN NORTH ON BAIRSTON ST. 10 MILES TO ALAMEDA AVE. THE STATION IS LOCATED IN THE NORTHEAST QUADRANT OF THE INTERSECTION. THE STATION MARK IS A STANDARD ACS BRASS TABLET STAMPED "1-880", SET IN TOP OF A CONCRETE POST PROJECTING 0.1 FEET ABOVE GROUND. FIELD ELEVATION = 5479.53'

ENGINEER'S SEAL
[Signature]
10/14/87

REMARKS
REV. NO. 1
DATE 9/1/87
BY 55 MC BAL.

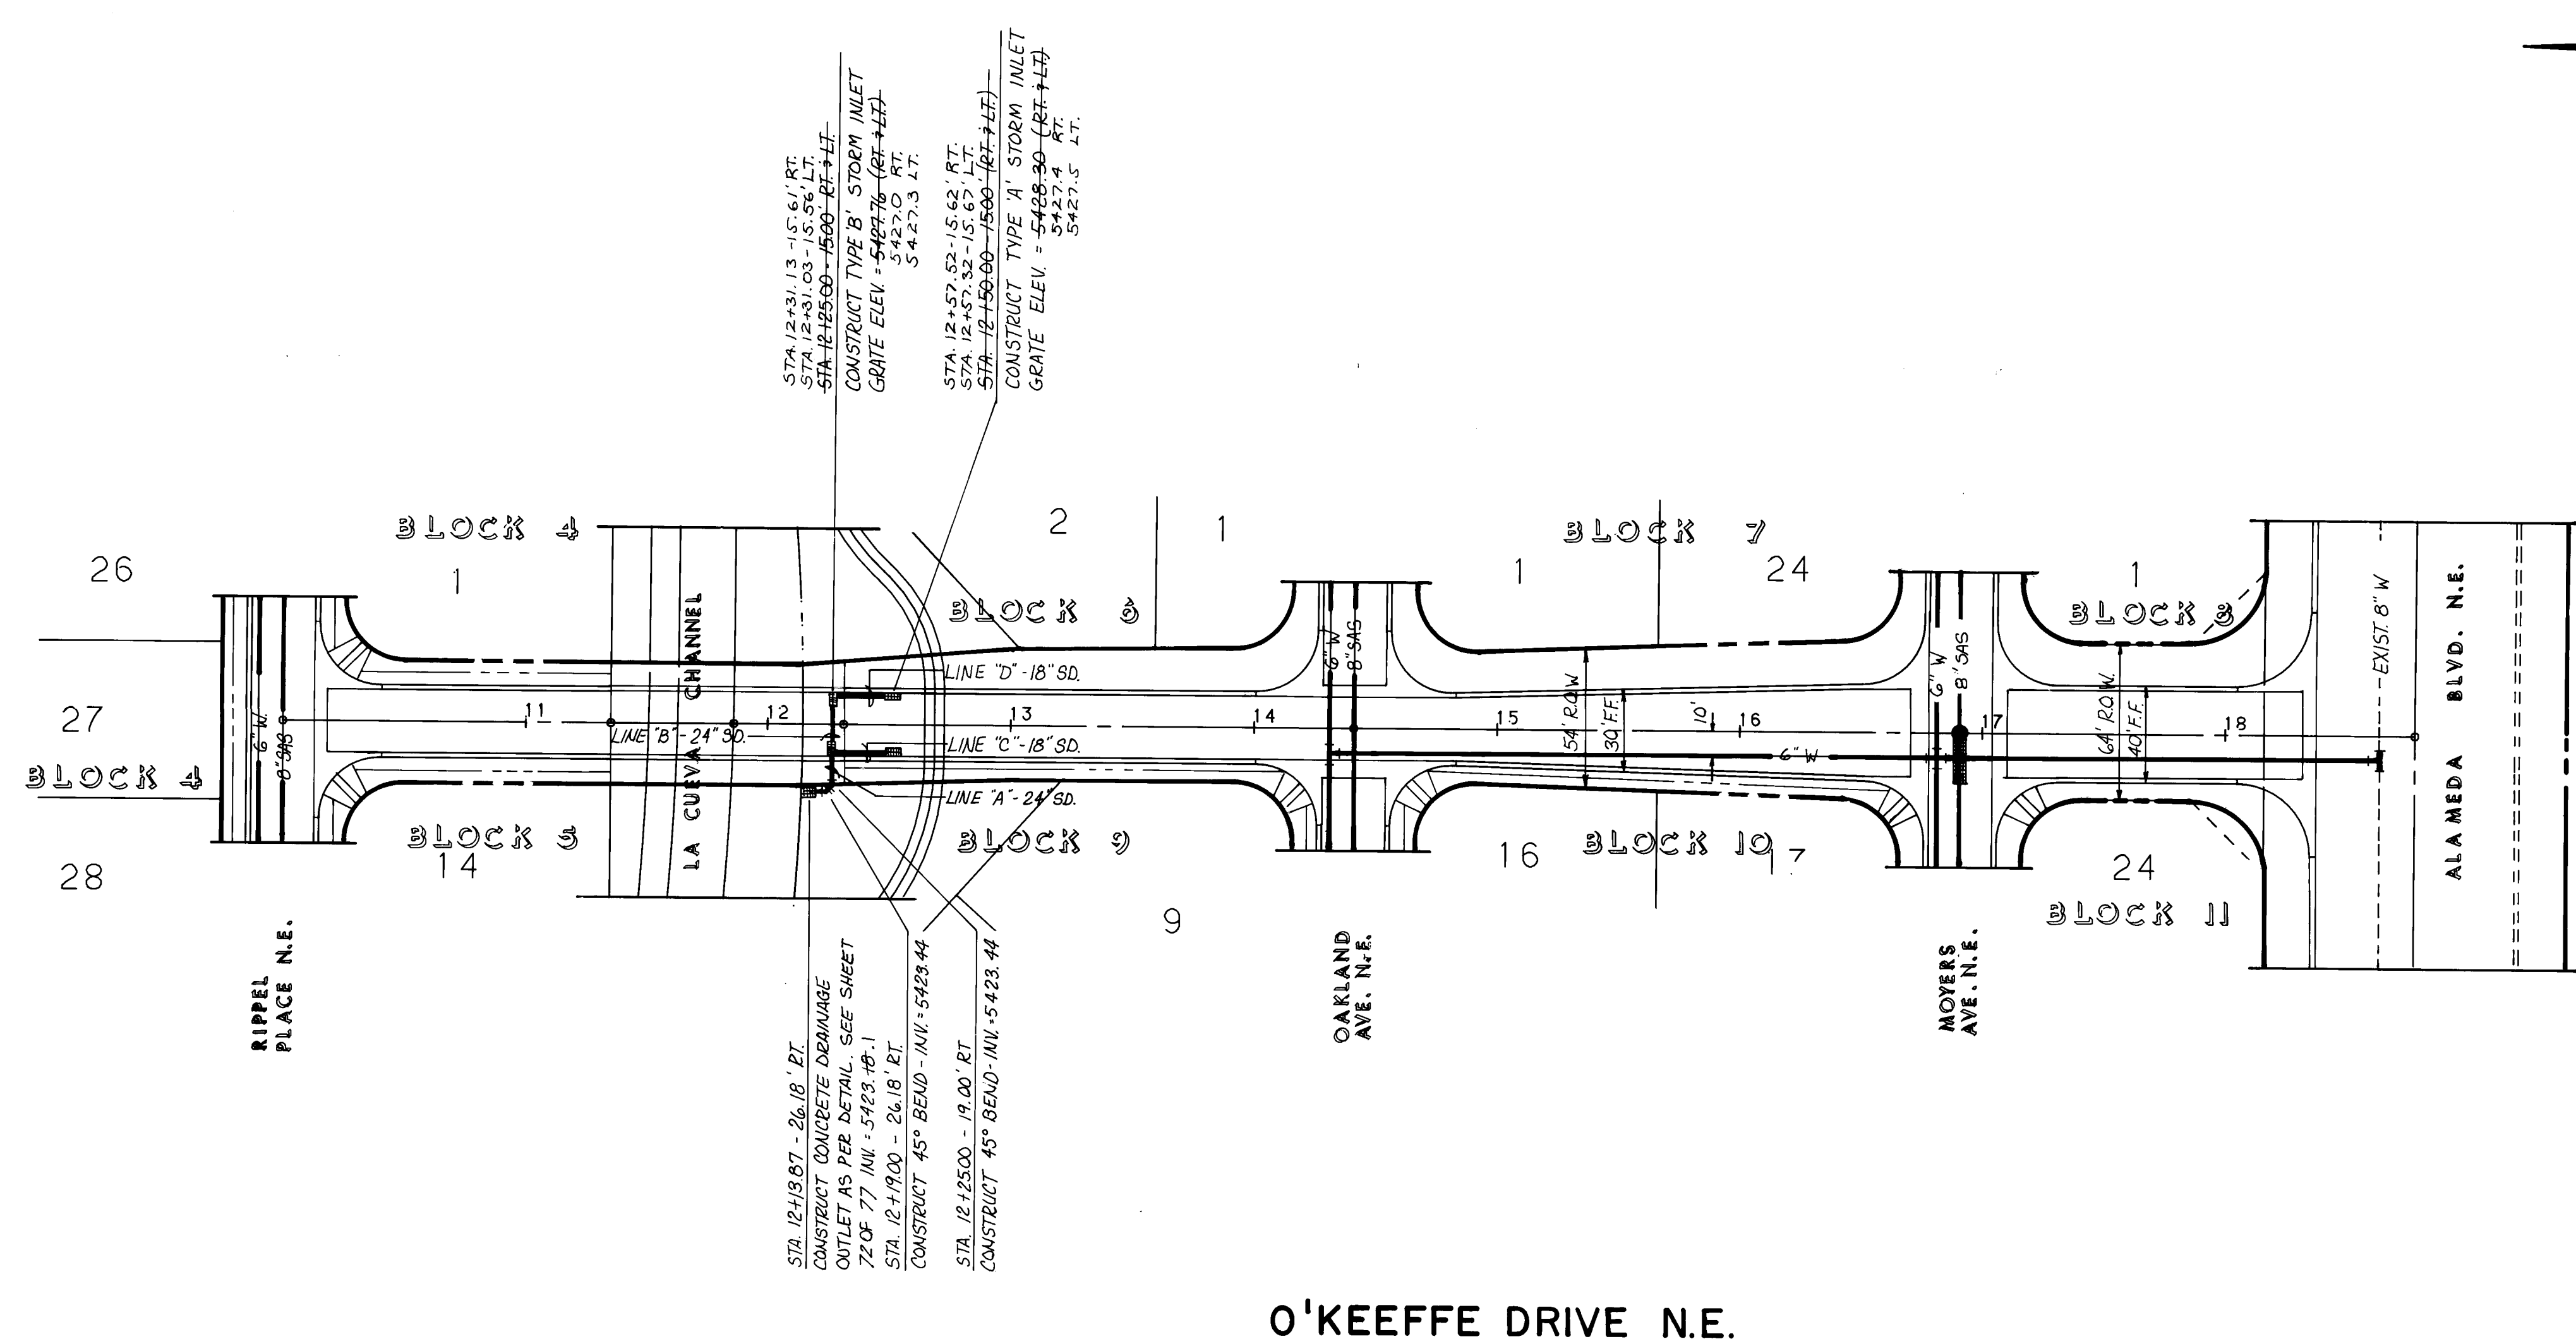

O'KEEFFE DRIVE N.E.

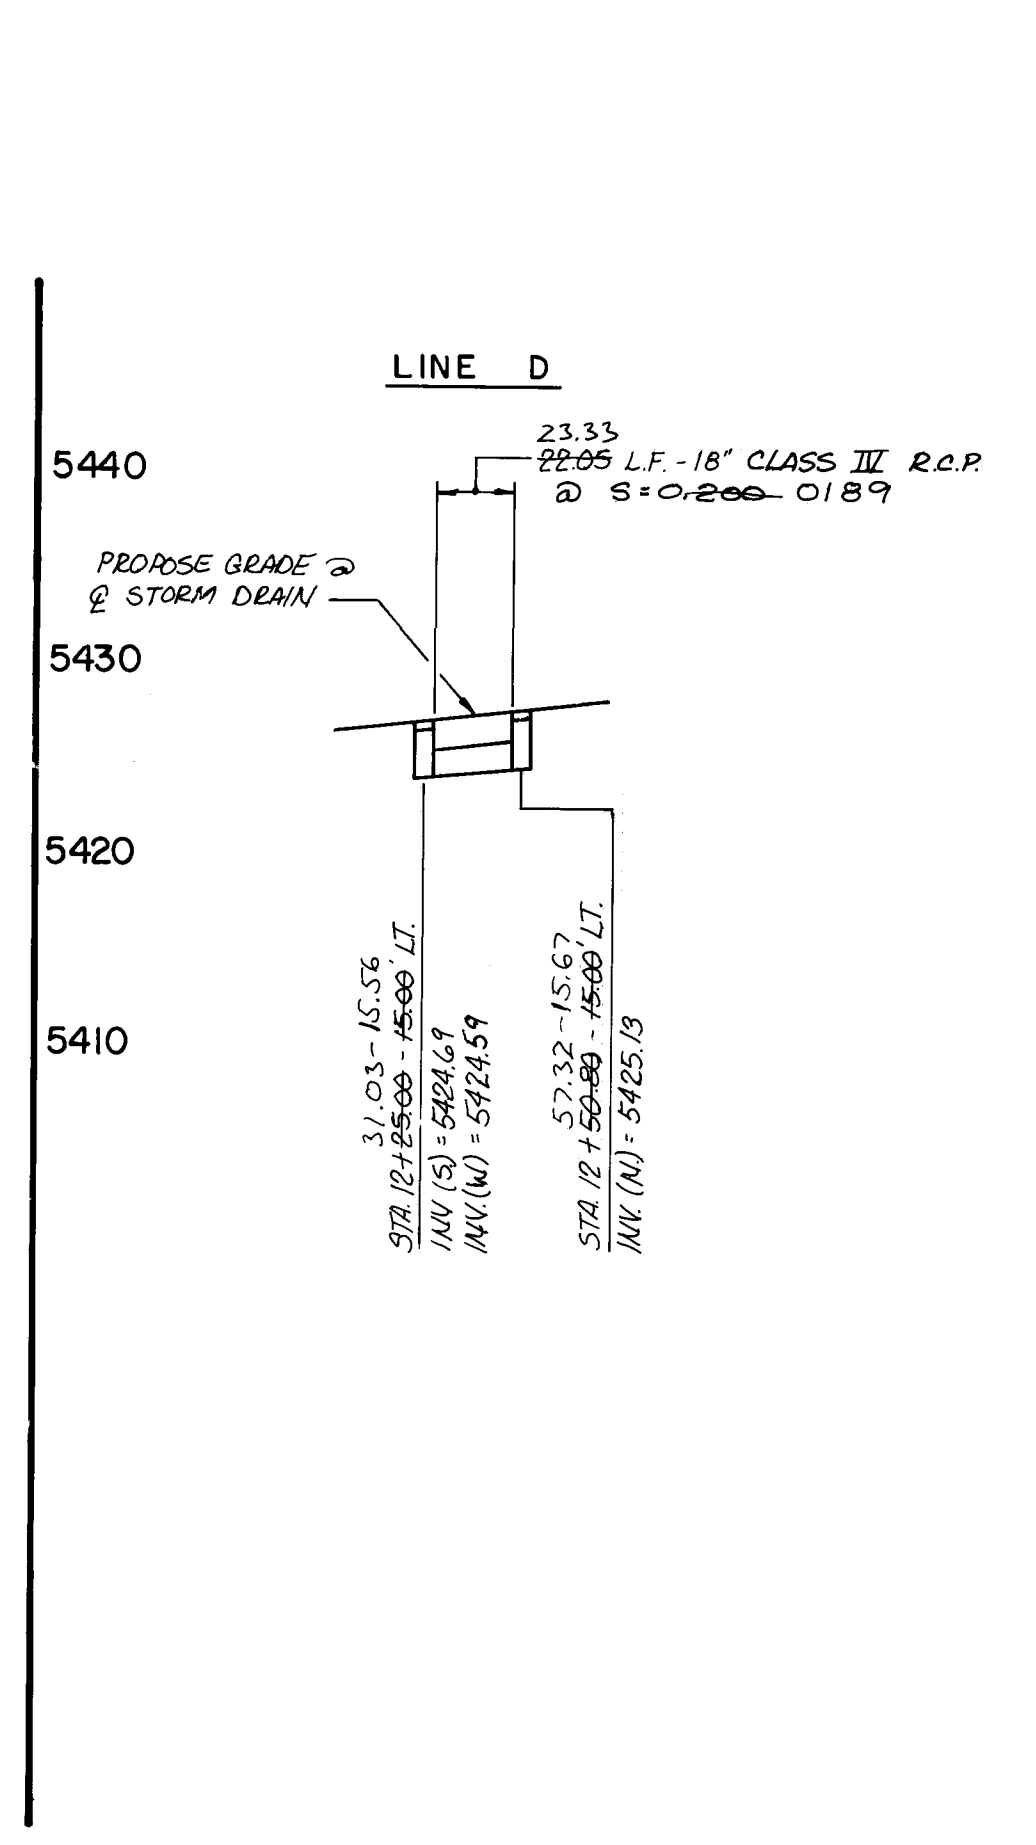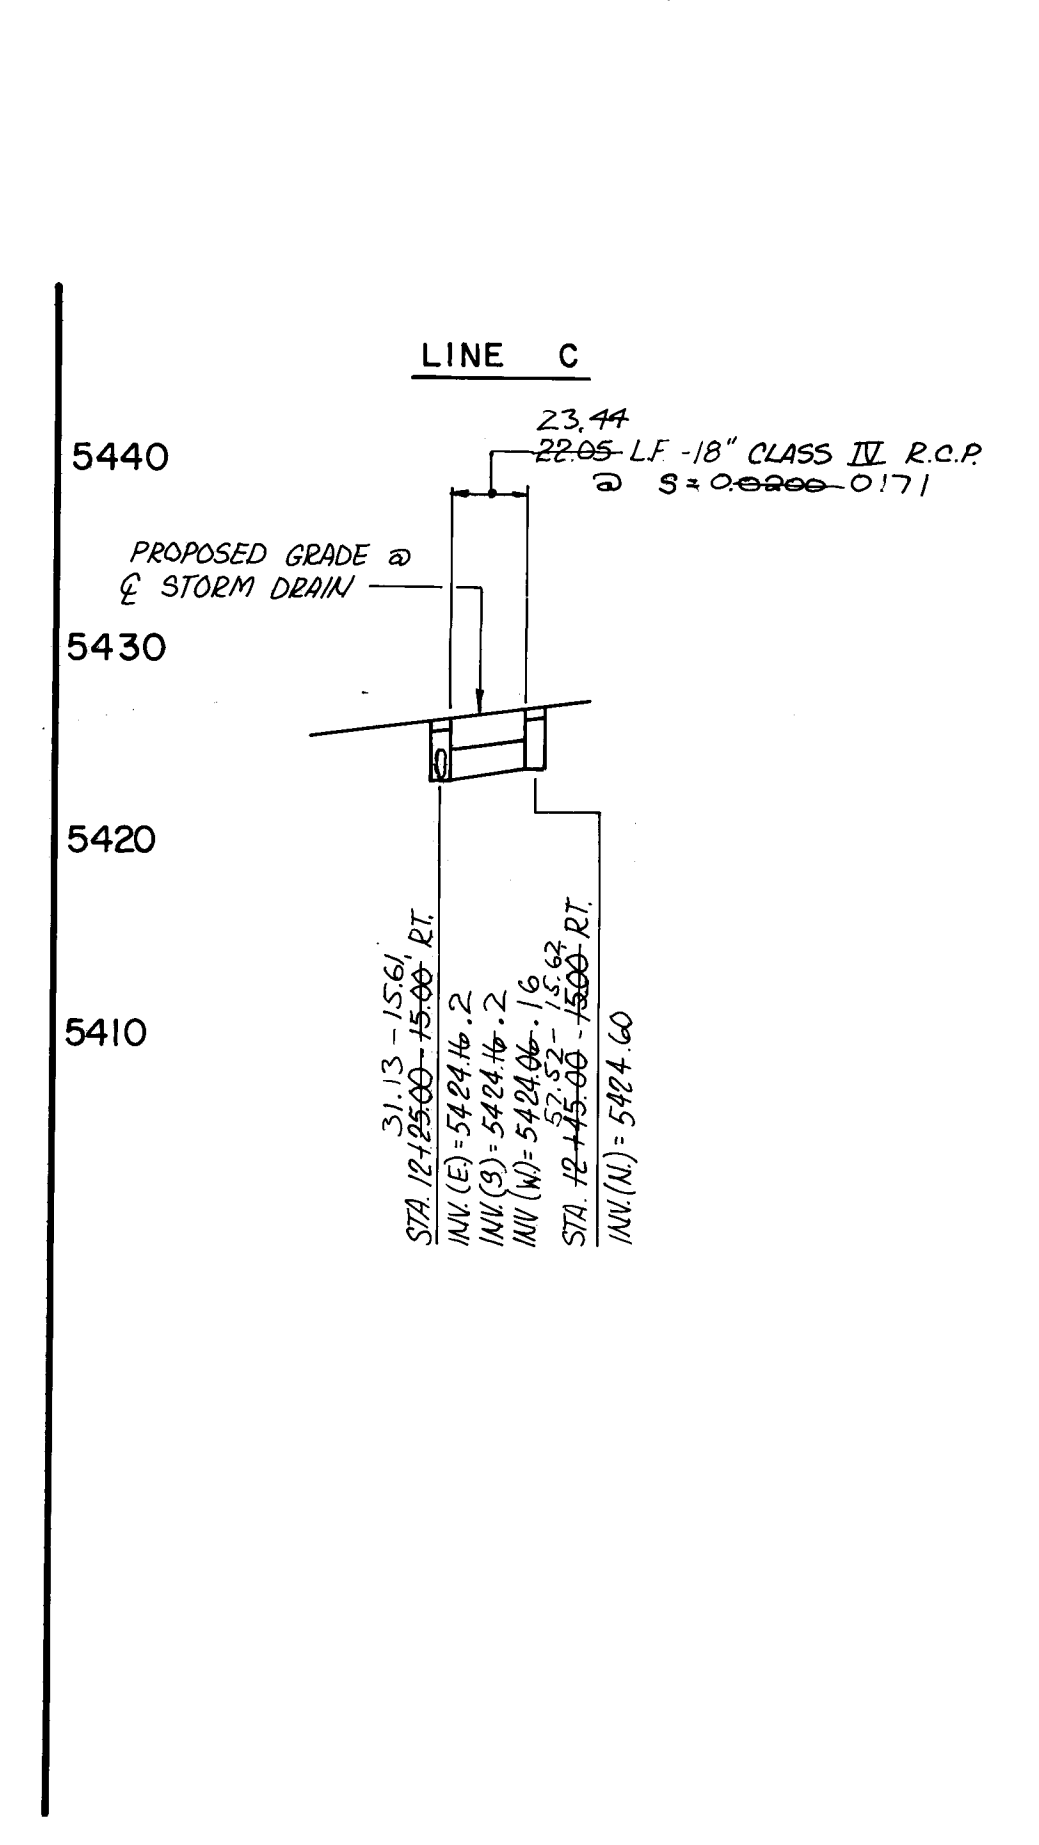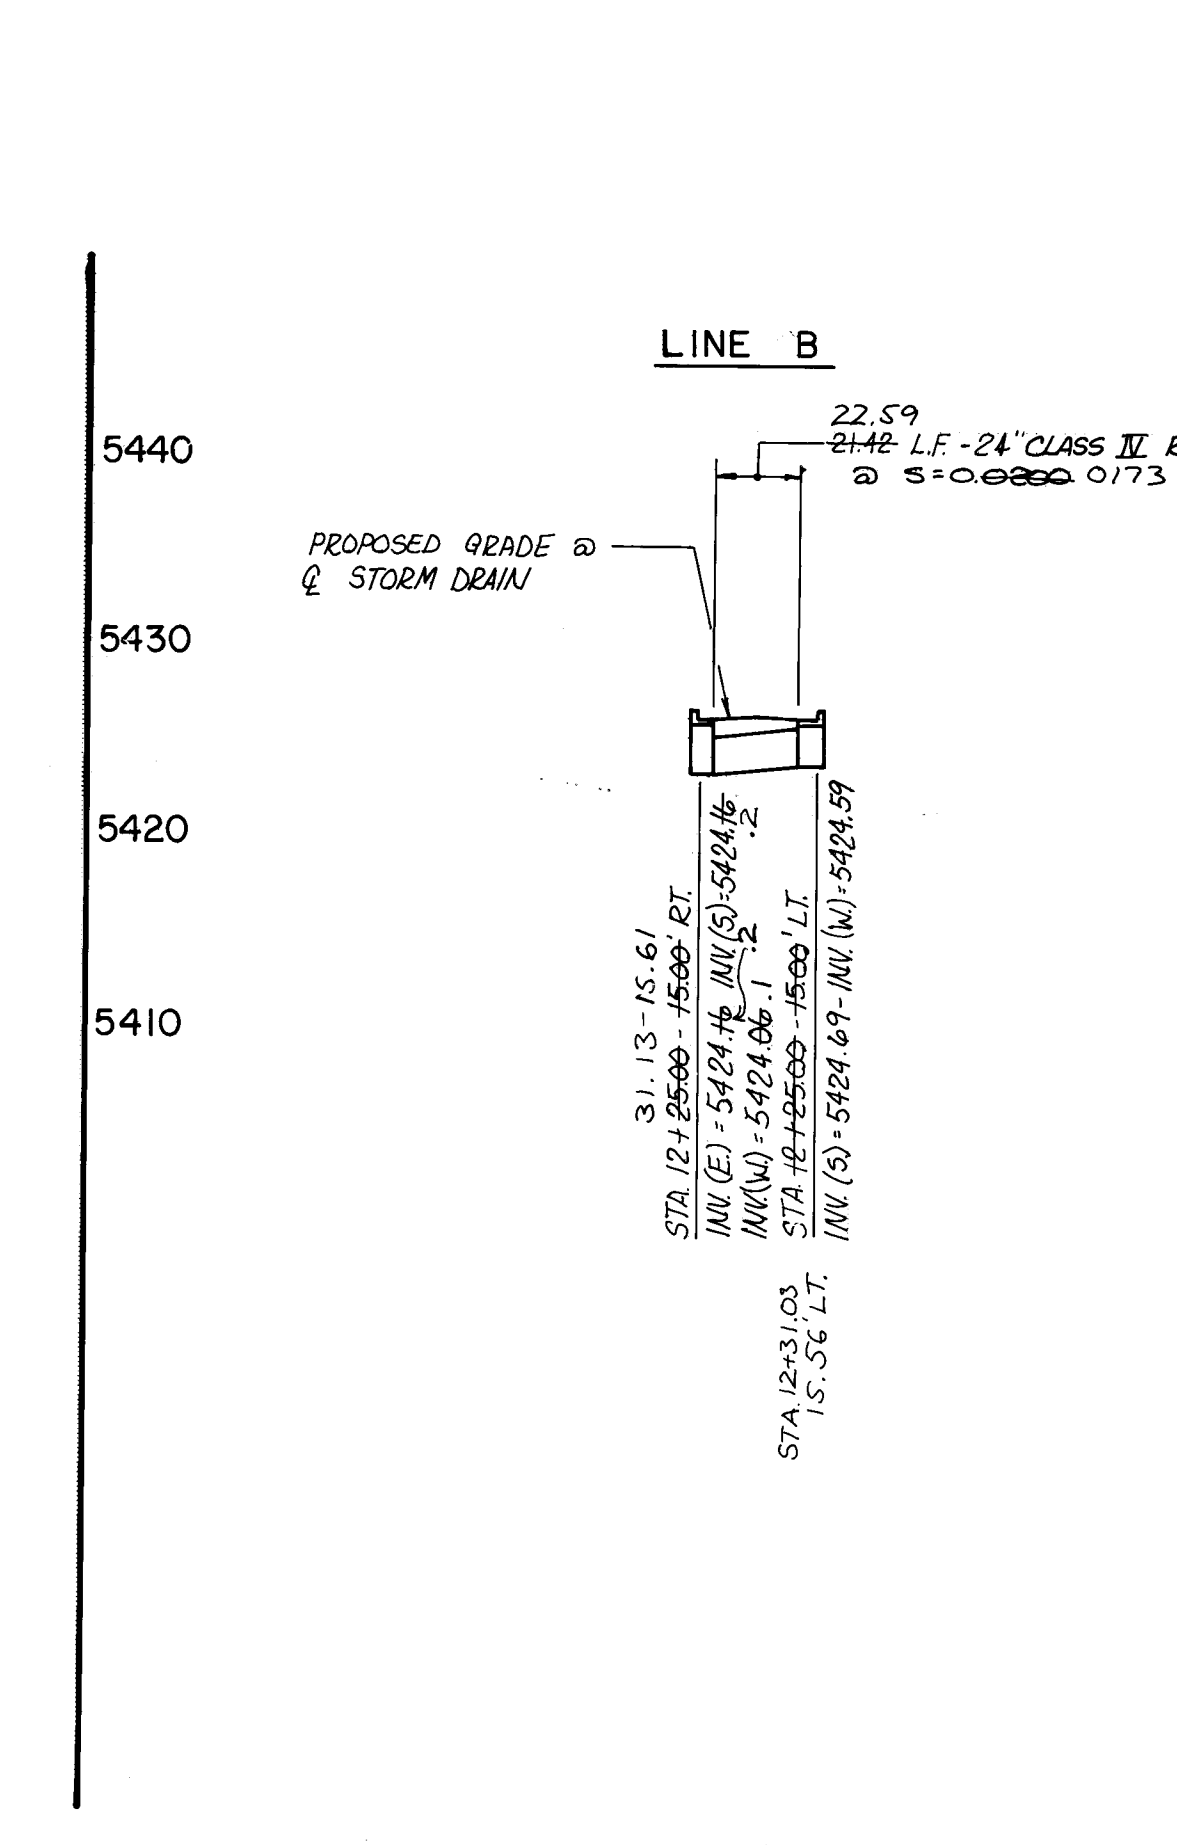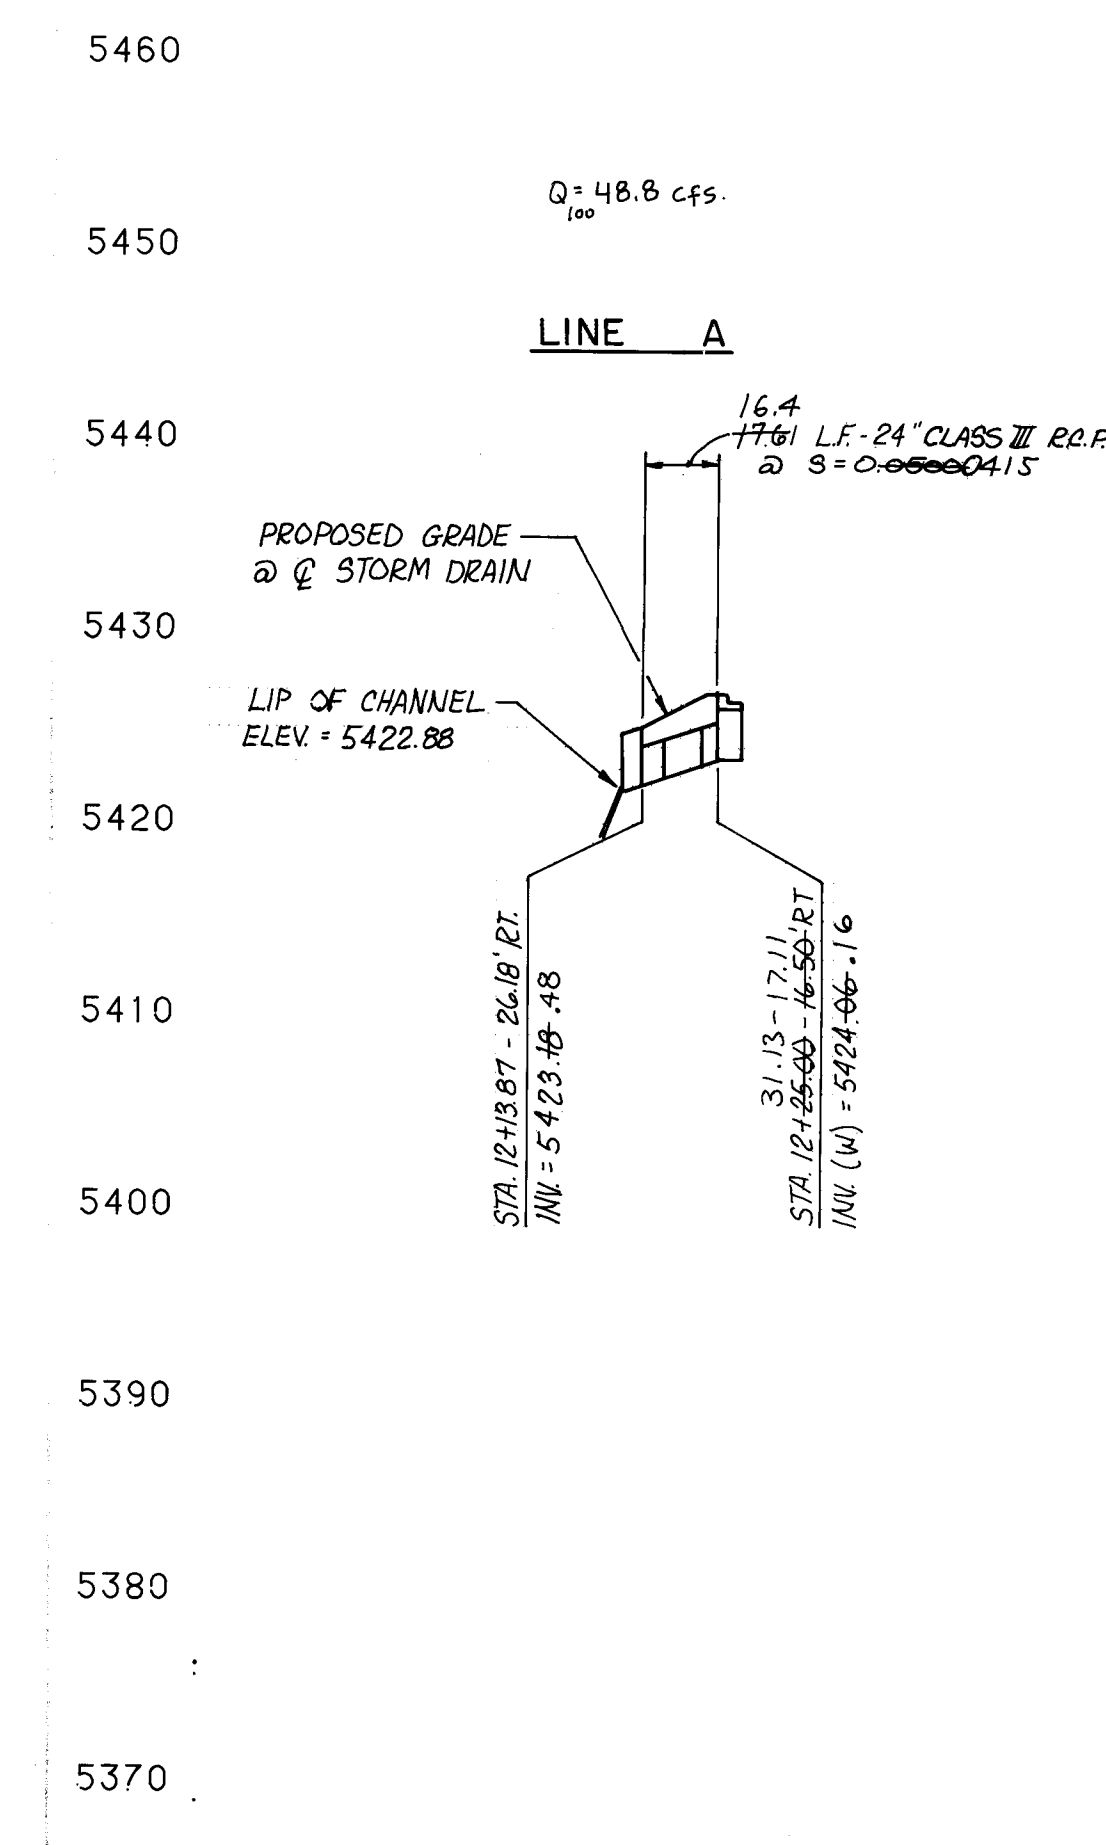

- STORM DRAINAGE**
- ALL STATIONING AND OFFSET DIMENSIONS ARE BASED ON CENTERLINE OF RIGHT-OF-WAY.
 - THE FOLLOWING CITY OF ALBUQUERQUE STANDARD DRAWINGS ARE APPLICABLE TO THE STORM DRAINAGE CONSTRUCTION:
- | | | |
|------|------|------|
| 2102 | 2203 | 2236 |
| 2110 | 2207 | |
| 2201 | 2216 | |
| 2202 | 2220 | |

RECORD DRAWING

This drawing as modified shows public improvements as constructed. These modifications have been made using the original drawings and field survey data. The survey was conducted by the City of Albuquerque, New Mexico, and the City Engineer, Dennis A. Lorenz, P.E., has approved the modifications. The City Engineer's office is located at 317 Commercial St. N.E., Albuquerque, New Mexico 87102. Phone: (505) 242-1909.

3-14-88



Dennis A. Lorenz, P.E.

- LEGEND**
- PROPOSED WATERLINE
 - PROPOSED GATE VALVE
 - PROPOSED FIRE HYDRANT
 - PROPOSED CAP OR PLUG
 - PROPOSED CROSS, TEE, OR ELBOW
 - PROPOSED SANITARY SEWER LINE
 - PROPOSED MANHOLE
 - PROPERTY OR BOUNDARY LINE
 - CENTERLINE OF STREET
 - CURB AND GUTTER
 - SIDEWALK
 - EXISTING WATERLINE
 - EXISTING SANITARY SEWER LINE
 - EXISTING CAP OR PLUG
 - EXISTING MANHOLE

ESPEY, HUSTON & ASSOCIATES, INC.
Engineering & Environmental Consultants
317 COMMERCIAL ST. N.E.
ALBUQUERQUE, NEW MEXICO 87102
PHONE: (505) 242-1909

NOR ESTE ESTATES
O'KEEFFE DRIVE N.E.
STORM SEWER - STA. 12+25.00 TO STA. 12+50.00

Hydrology
D.A. DWH
SEE
Reginald
9-1-87

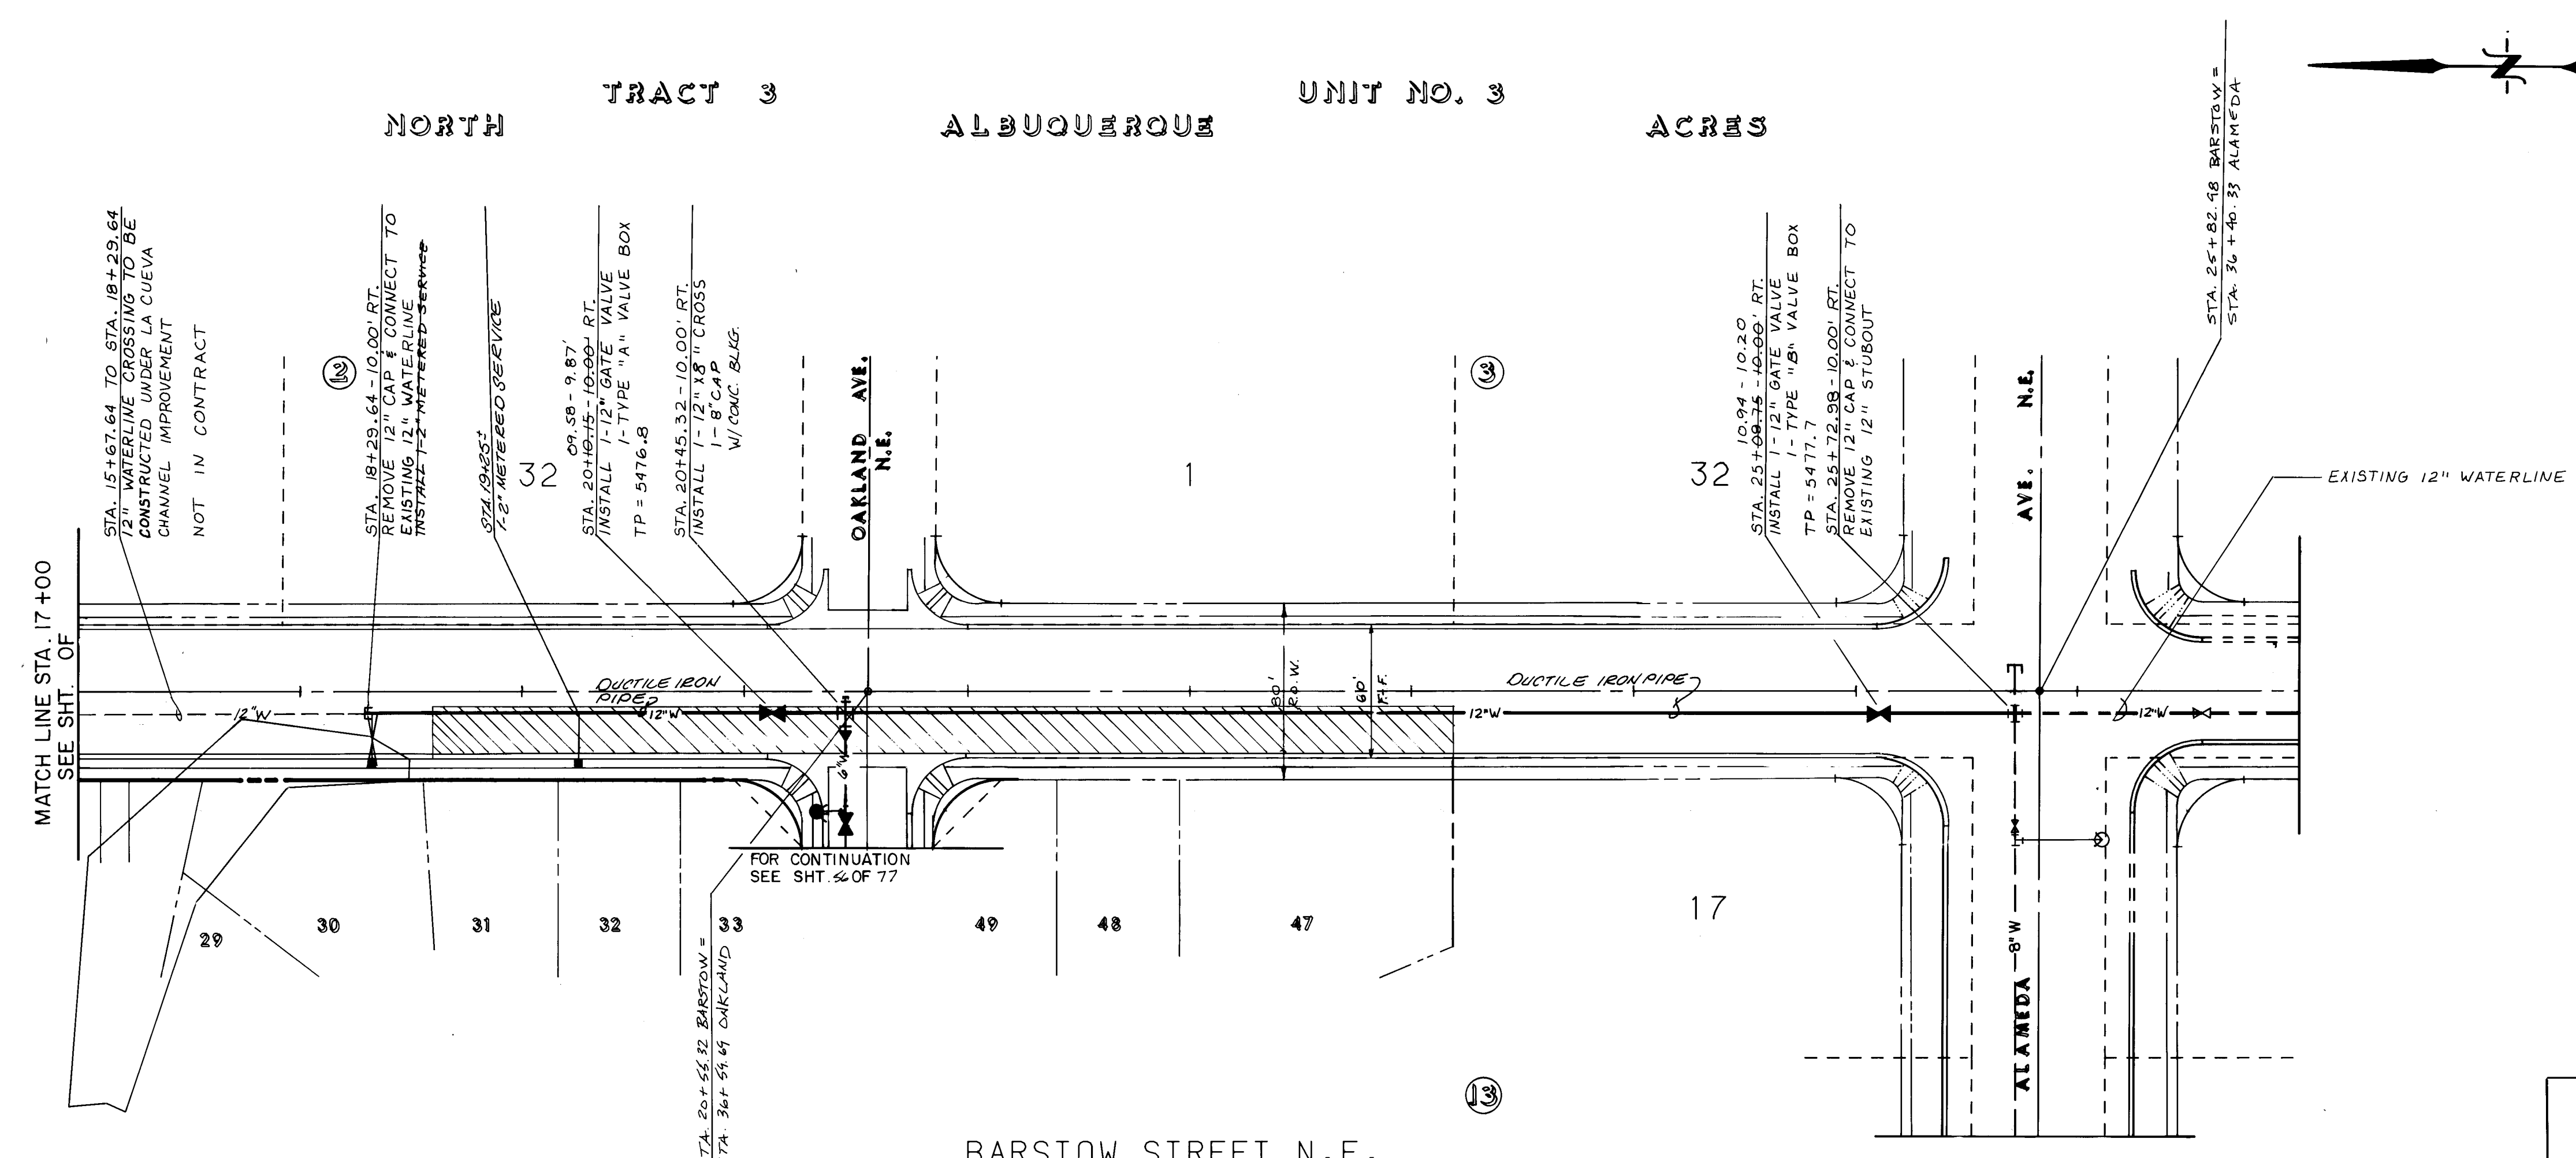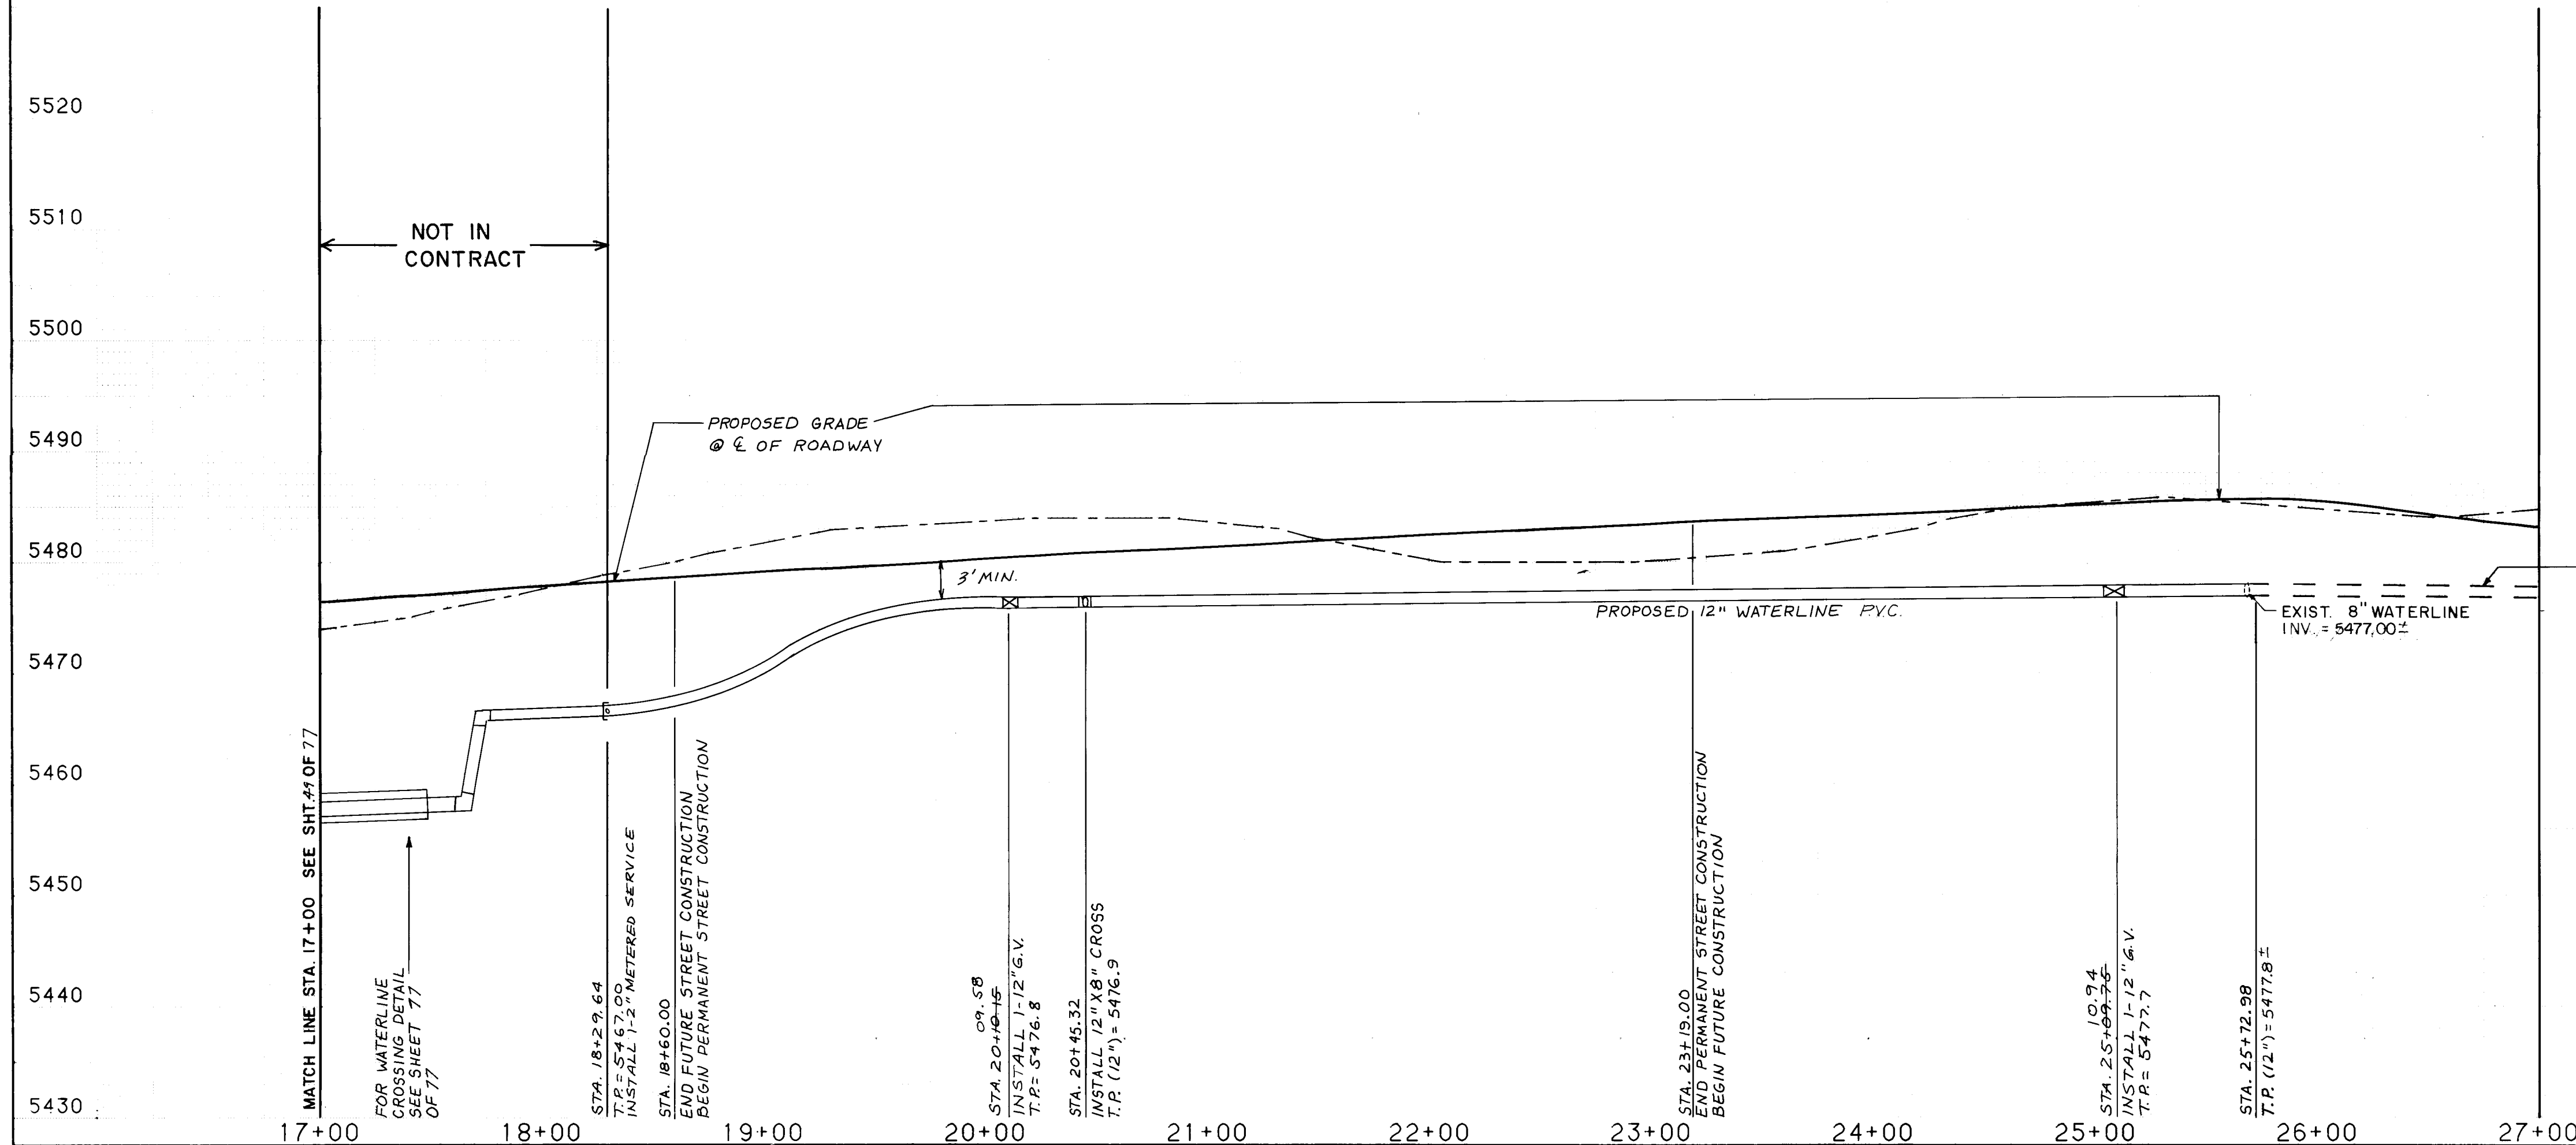

SCALE:
HORIZ. 1" = 50'
VERT. 1" = 10'


LEGEND

- W PROPOSED WATERLINE
- X PROPOSED GATE VALVE
- ▲ PROPOSED FIRE HYDRANT
- ⊥ PROPOSED CAP OR PLUG
- ✕ PROPOSED CROSS, TEE, OR ELBOW
- SAS PROPOSED SANITARY SEWER LINE
- PROPOSED MANHOLE
- PROPERTY OR BOUNDARY LINE
- CENTERLINE OF STREET
- == CURB AND GUTTER
- SIDEWALK
- W EXISTING WATERLINE
- SAS EXISTING SANITARY SEWER LINE
- ⊥ EXISTING CAP OR PLUG
- EXISTING MANHOLE
- NEW ARTERIAL PAVING

ESPEY,
HUSTON &
ASSOCIATES, INC.
Engineering & Environmental Consultants
317 COMMERCIAL ST. N.E.
ALBUQUERQUE, NEW MEXICO 87102
PHONE: (505) 242-1909

CITY OF ALBUQUERQUE PUBLIC WORKS DEPARTMENT ENGINEERING GROUP			
TITLE: SEWER & WATER - STA. 17+00 TO STA. 27+00			
APPROVALS	ENGINEER	DATE	APPROVALS
D.R.C. Chair	<i>[Signature]</i>	10/5/87	ENGINEER
Trans. Dev	<i>[Signature]</i>	7/14/87	
Utility Dev	<i>[Signature]</i>	9-1-87	
DESIGNED BY <i>[Signature]</i> DATE 6/87			
DRAWN BY <i>[Signature]</i> DATE 8/87			
CHECKED BY <i>[Signature]</i> DATE 8/87			
DRAWING NO.	3186	MAP NO.	C-19
SHEET 50		OF 77	

WATER AND SANITARY SEWER			
1. ALL STATIONING AND OFFSET DIMENSIONS ARE BASED ON CENTERLINE OF RIGHT-OF-WAY.			
2. THE FOLLOWING CITY OF ALBUQUERQUE STANDARD DRAWINGS ARE APPLICABLE TO THE WATER AND SANITARY SEWER CONSTRUCTION:			
2102	2145	2326	2344
2110	2315	2328	2347
2118	2320	2335	2360
2125	2325	2340	2361
2362	2366	2368	2369
RECORD DRAWING This drawing as modified shows public improvements as constructed. These modifications have been made using information and measurements furnished by the City of Albuquerque. The modifications conform to the minimum standards for record drawings as required by the City of Albuquerque. The best of my knowledge and belief, this drawing is true and correct. Dennis A. Lorenz P.E. 9-1-87 Date 3-14-88			
BENCH MARKS THE STATION IS LOCATED 9 MILES NORTHEAST OF DOWNTOWN ALBUQUERQUE. TO REACH THE STATION FROM THE INTERSECTION OF LOUISIANA BLVD. AND LOS ANGELES DRIVE, GO EAST ON LOS ANGELES DRIVE 10 MILES TO BARSTOW ST., THEN NORTH ON BARSTOW ST. 10 MILES TO ALAMEDA AVE. THE STATION IS LOCATED IN THE NORTHEAST QUADRANT OF THE INTERSECTION. THE STATION MARK IS A STANDARD ACS BRASS TABLET STAMPED "1-B20", SET IN TOP OF A CONCRETE POST PROJECTING 0.1 FEET ABOVE GROUND. MSL ELEVATION = 5474.53'			
SURVEY INFORMATION FIELD NOTES NO. BY DATE			
ENGINEER'S SEAL <i>[Seal]</i> 8-14-87			
REVISIONS NO. DATE BY			
DESIGNED BY <i>[Signature]</i> DATE 6/87			
DRAWN BY <i>[Signature]</i> DATE 8/87			
CHECKED BY <i>[Signature]</i> DATE 8/87			

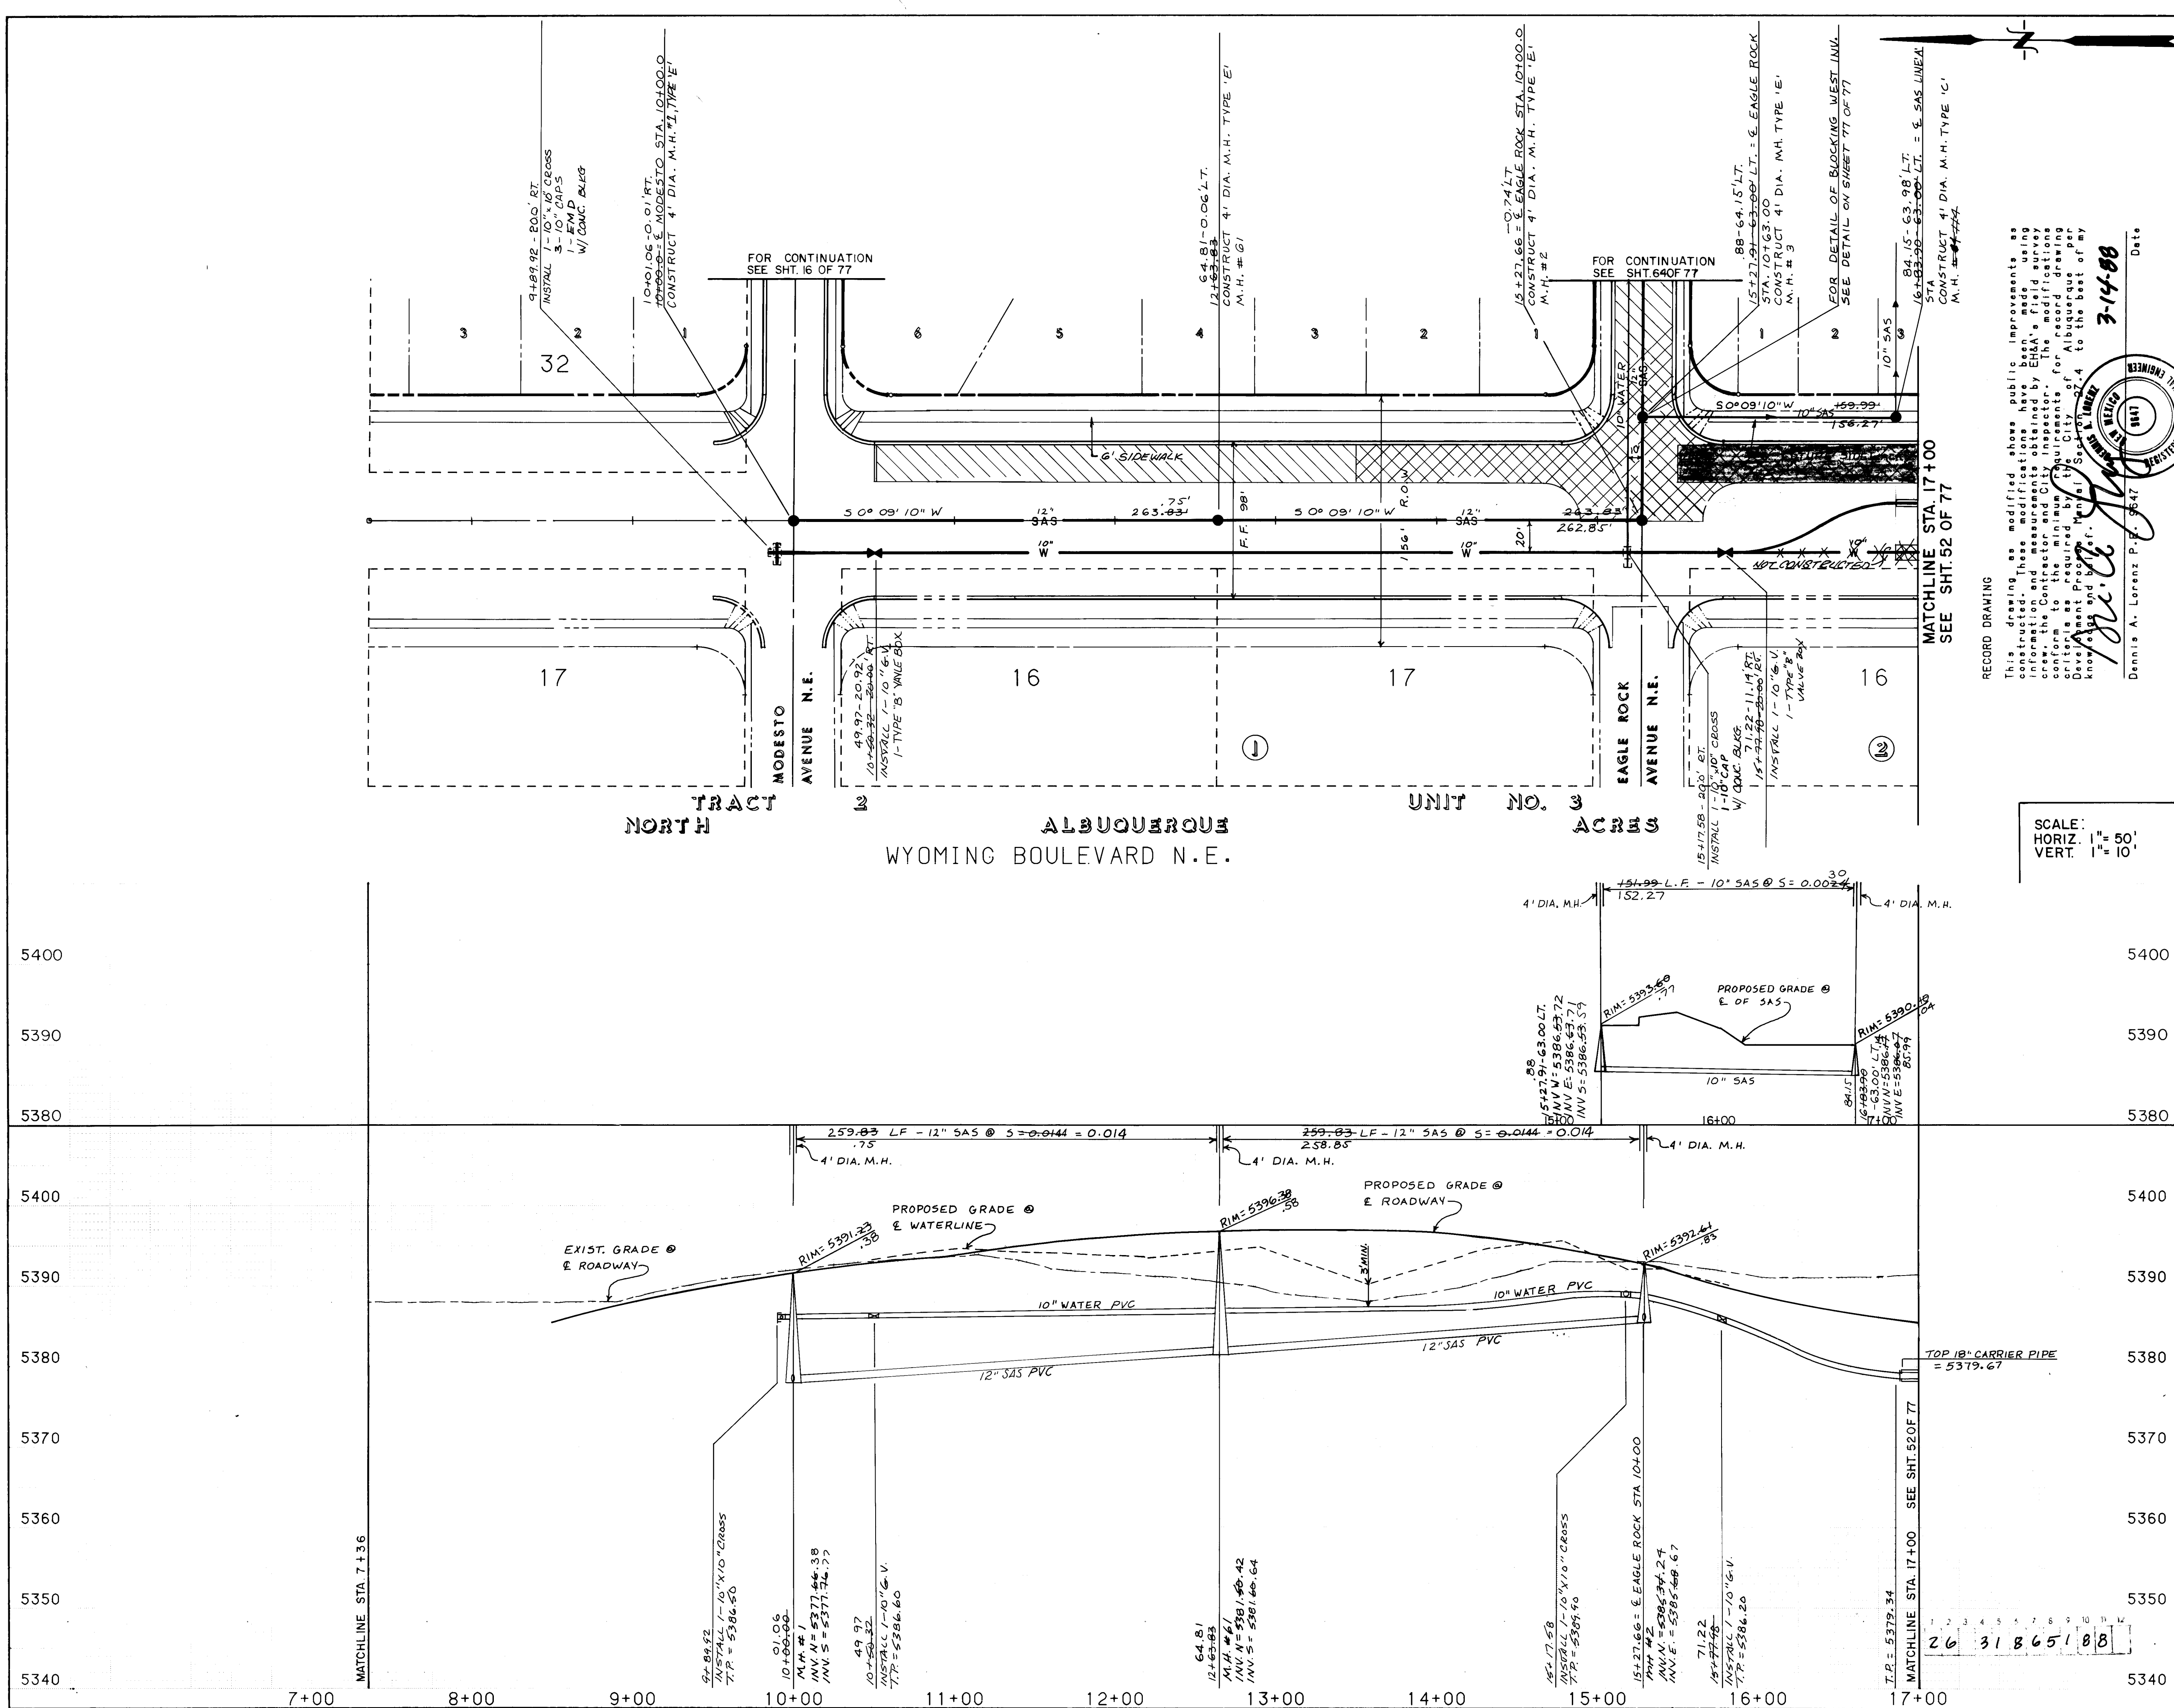

WATER AND SANITARY SEWER

1. ALL STATIONING AND OFFSET DIMENSIONS ARE BASED ON CENTERLINE OF RIGHT-OF-WAY.

2. THE FOLLOWING CITY OF ALBUQUERQUE STANDARD DRAWINGS ARE APPLICABLE TO THE WATER AND SANITARY SEWER CONSTRUCTION:

2102	2145	2326	2344	2362
2110	2318	2328	2347	2366
2118	2320	2335	2360	2368
2125	2325	2340	2361	2369

LEGEND

- NEW TEMPORARY PAVING
- EXIST. TEMPORARY PAVING
- NEW ARTERIAL PAVING
- PROPOSED WATERLINE
- PROPOSED GATE VALVE
- PROPOSED FIRE HYDRANT
- PROPOSED CAP OR PLUG
- PROPOSED CROSS-TEE, OR ELBOW
- PROPOSED SANITARY SEWER LINE
- PROPOSED MANHOLE
- PROPERTY OR BOUNDARY LINE
- CENTERLINE OF STREET
- CURB AND GUTTER
- SIDEWALK
- EXISTING WATERLINE
- EXISTING SANITARY SEWER LINE
- EXISTING CAP OR PLUG
- EXISTING MANHOLE

ESPEY, HUSTON & ASSOCIATES, INC.
Engineering & Environmental Consultants
317 COMMERCIAL ST. N.E.
ALBUQUERQUE, NEW MEXICO 87102
PHONE: (505) 242-1909

CITY OF ALBUQUERQUE
PUBLIC WORKS DEPARTMENT
ENGINEERING GROUP

TITLE: NOR ESTE ESTATES
WYOMING BOULEVARD N.E.
SEWER & WATER - STA. 7+36 TO STA. 17+00

APPROVALS	ENGINEER	DATE	APPROVALS	ENGINEER	DATE
D.R.C. Chair	hust	8/5/87			
Trans. Dev.	W.D.W.H.	9/16/87			
Utility Dev.	W.D.W.H.	9/16/87			

DRAWING NO. 3186
MAP NO. C-19
SHEET 51 OF 77

AS BUILT INFORMATION

CONTRACTOR: NEW CONCESSIONS
WORK: SEWER & WATER
STATIONED BY: DATE: 8/18/87
ACCURACY: BY: DATE: 8/18/87
FIELD: DATE: 8/18/87
DRAWINGS: DATE: 8/18/87
MICRO-FILM INFORMATION
RECORDED BY: DATE: 8/18/87
NO. 01

BENCH MARKS

THE STATION IS LOCATED 9 MILES NORTHEAST OF DOWNTOWN ALBUQUERQUE, NEW MEXICO, ON THE INTERSECTION OF LOS ANGELES DRIVE AND BARSTOW ST. THE STATION IS LOCATED IN THE NORTHWEST QUADRANT OF THE INTERSECTION. THE STATION MARK IS A STANDARD ACS BRASS TABLET STAMPED "1-820" SET IN TOP OF A CONCRETE POST PROJECTING 0.1 FEET ABOVE GROUND. MSLD ELEVATION: 5474.53'


ENGINEER'S SEAL

8/14/87

REVISIONS

NO.	DATE	REVISIONS
1	8/18/87	DESIGN

DESIGNED BY: E.H.S.
DRAWN BY: P.A.L.
CHECKED BY: P.A.L.

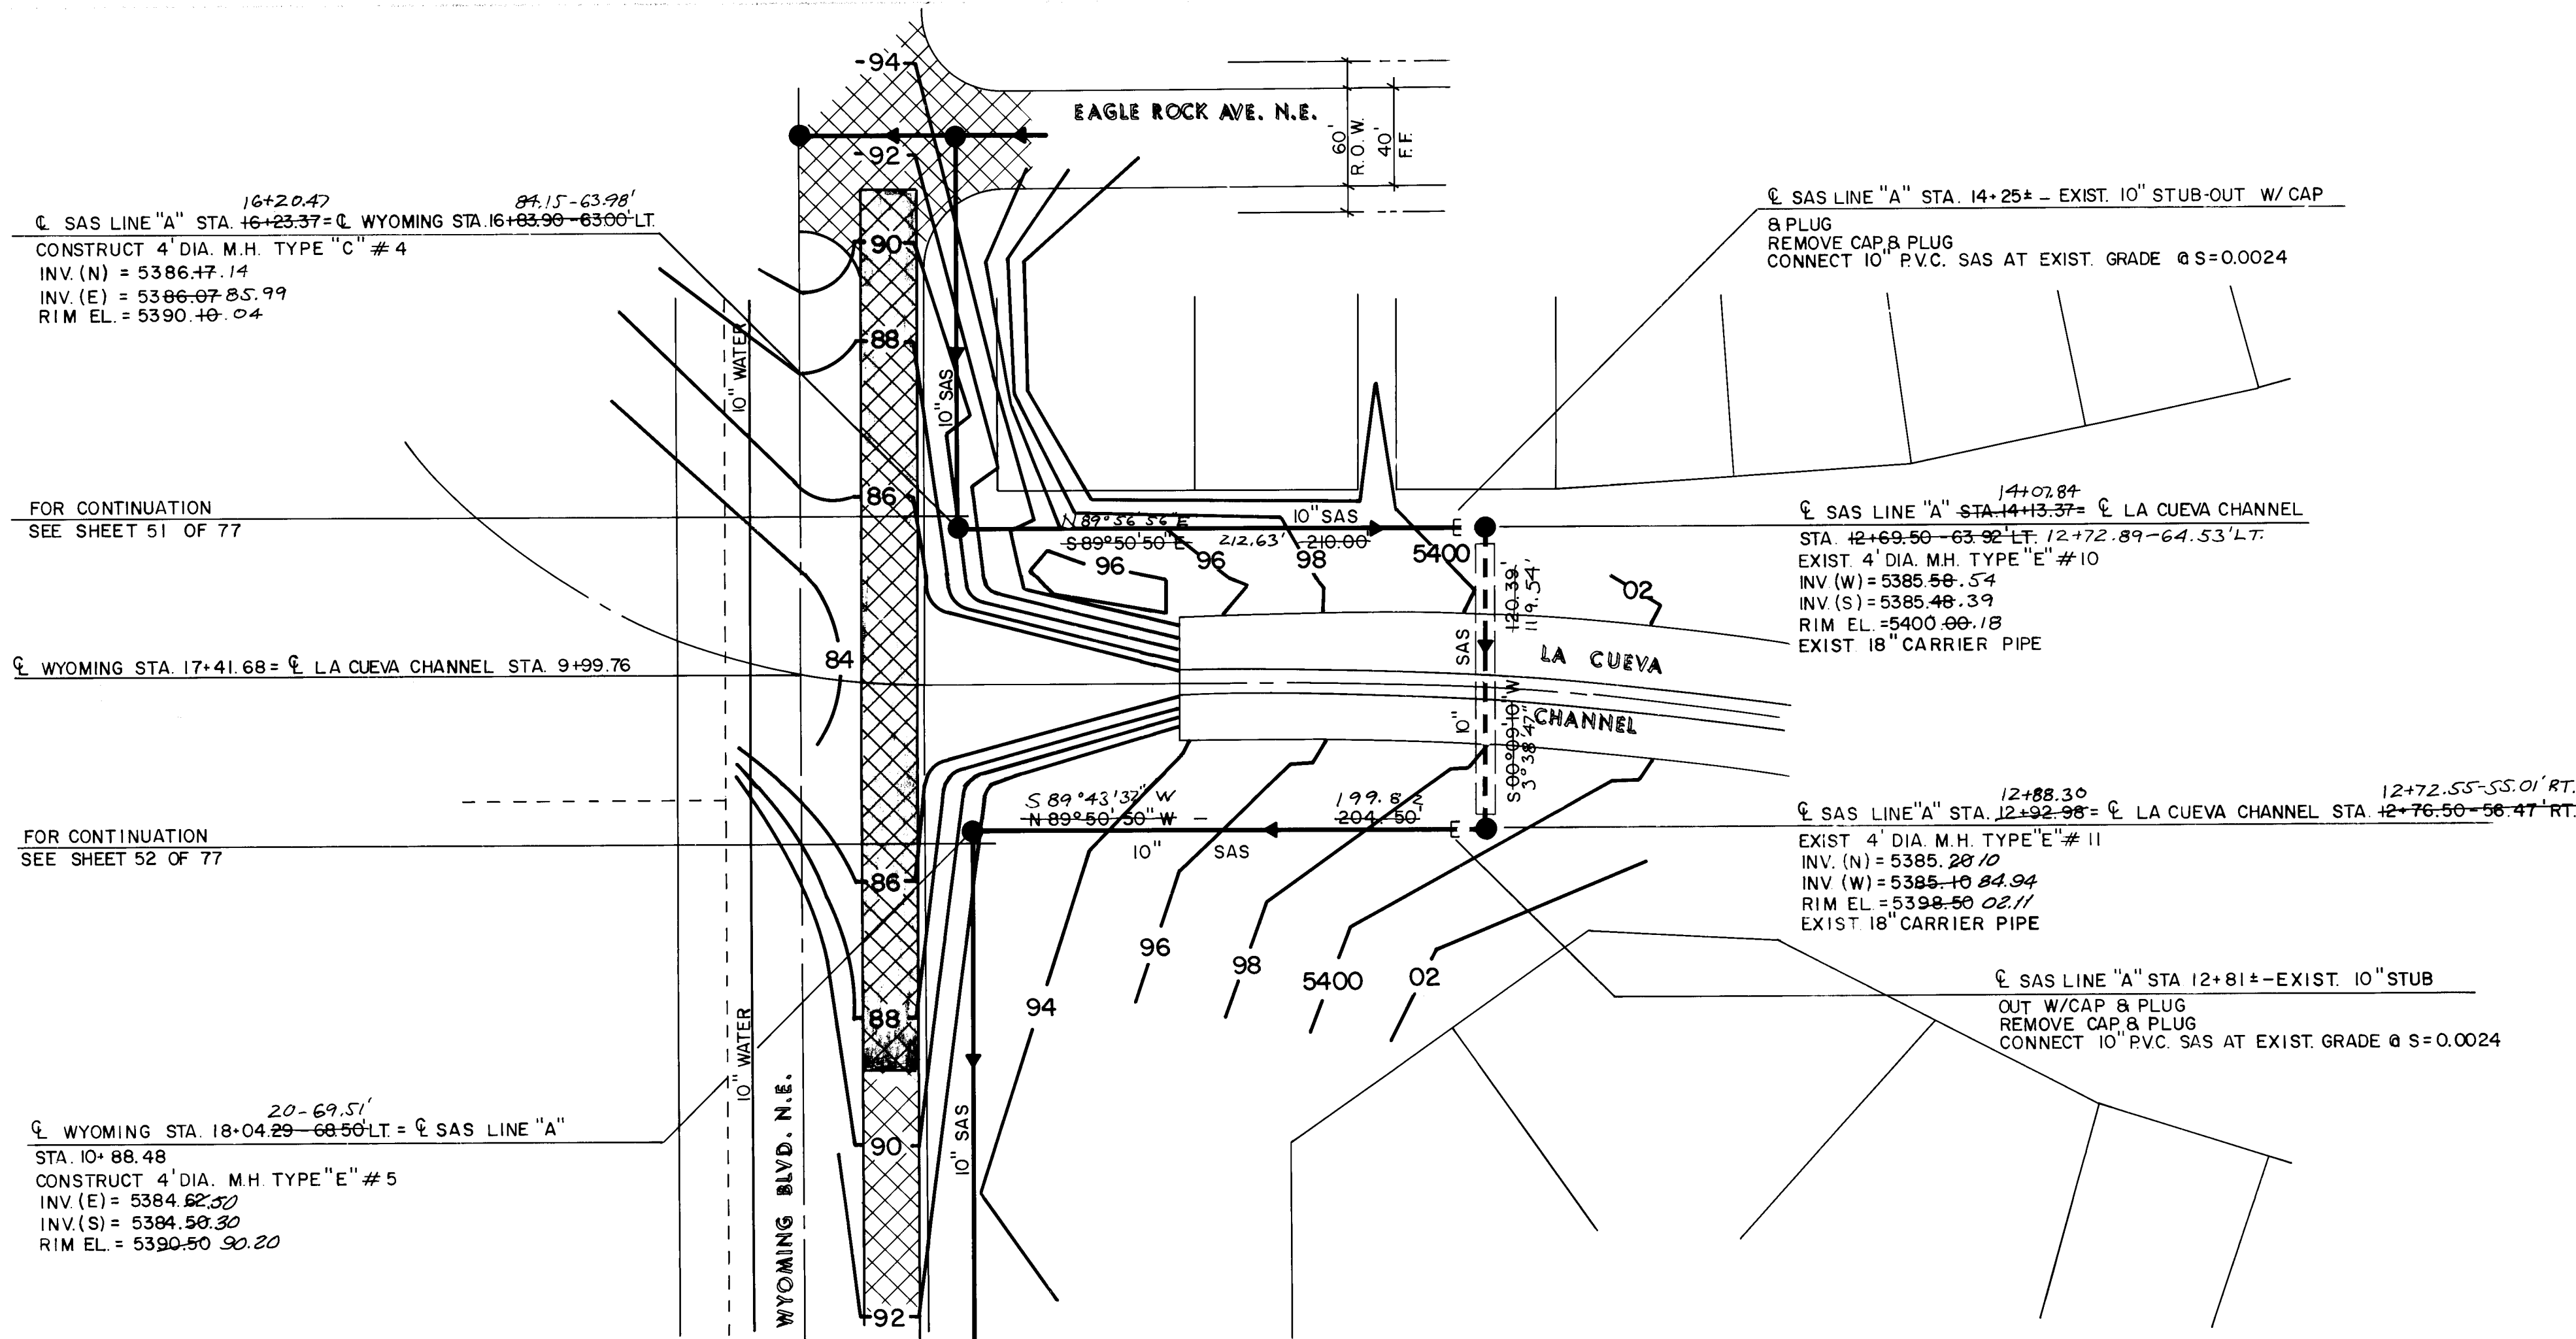

SCALE:
HORIZ. 1"= 50'
VERT. 1"= 10'

WATER AND SANITARY SEWER

- ALL STATIONING AND OFFSET DIMENSIONS ARE BASED ON CENTERLINE OF RIGHT-OF-WAY.
- THE FOLLOWING CITY OF ALBUQUERQUE STANDARD DRAWINGS ARE APPLICABLE TO THE WATER AND SANITARY SEWER CONSTRUCTION:

2102	2145	2326	2344	2362
2110	2315	2328	2347	2366
2118	2320	2335	2360	2368
2125	2325	2340	2361	2369


RECORD DRAWING

This drawing as modified shows public improvements as constructed, and these modifications have been made using the original drawings and field notes. The modifications conform to the minimum standards of the City of Albuquerque Department of Public Works, Engineering Division. The Engineer's Office is responsible for the accuracy of the data and the design of the work.

Dennis A. Lorenz P.E. 9947

Date: 8-14-88

THE STATION IS LOCATED 9 MILES NORTHEAST OF DOWNTOWN ALBUQUERQUE. TO REACH THE STATION FROM THE INTERSECTION OF LOUISIANA BLVD AND LOS ANGELES DRIVE, GO EAST ON LOS ANGELES DRIVE 10 MILES TO BARSTOW ST., THEN NORTH ON BARSTOW ST. 1.0 MILES TO ALAMEDA AVE. THE STATION IS LOCATED IN THE NORTHEAST QUADRANT OF THE INTERSECTION. THE STATION MARK IS A STANDARD ACS BRASS TABLET STAMPED "1-820", SET IN TOP OF A CONCRETE POST PROJECTING 0.1 FEET ABOVE GROUND. MSLD ELEVATION: 5474.53'

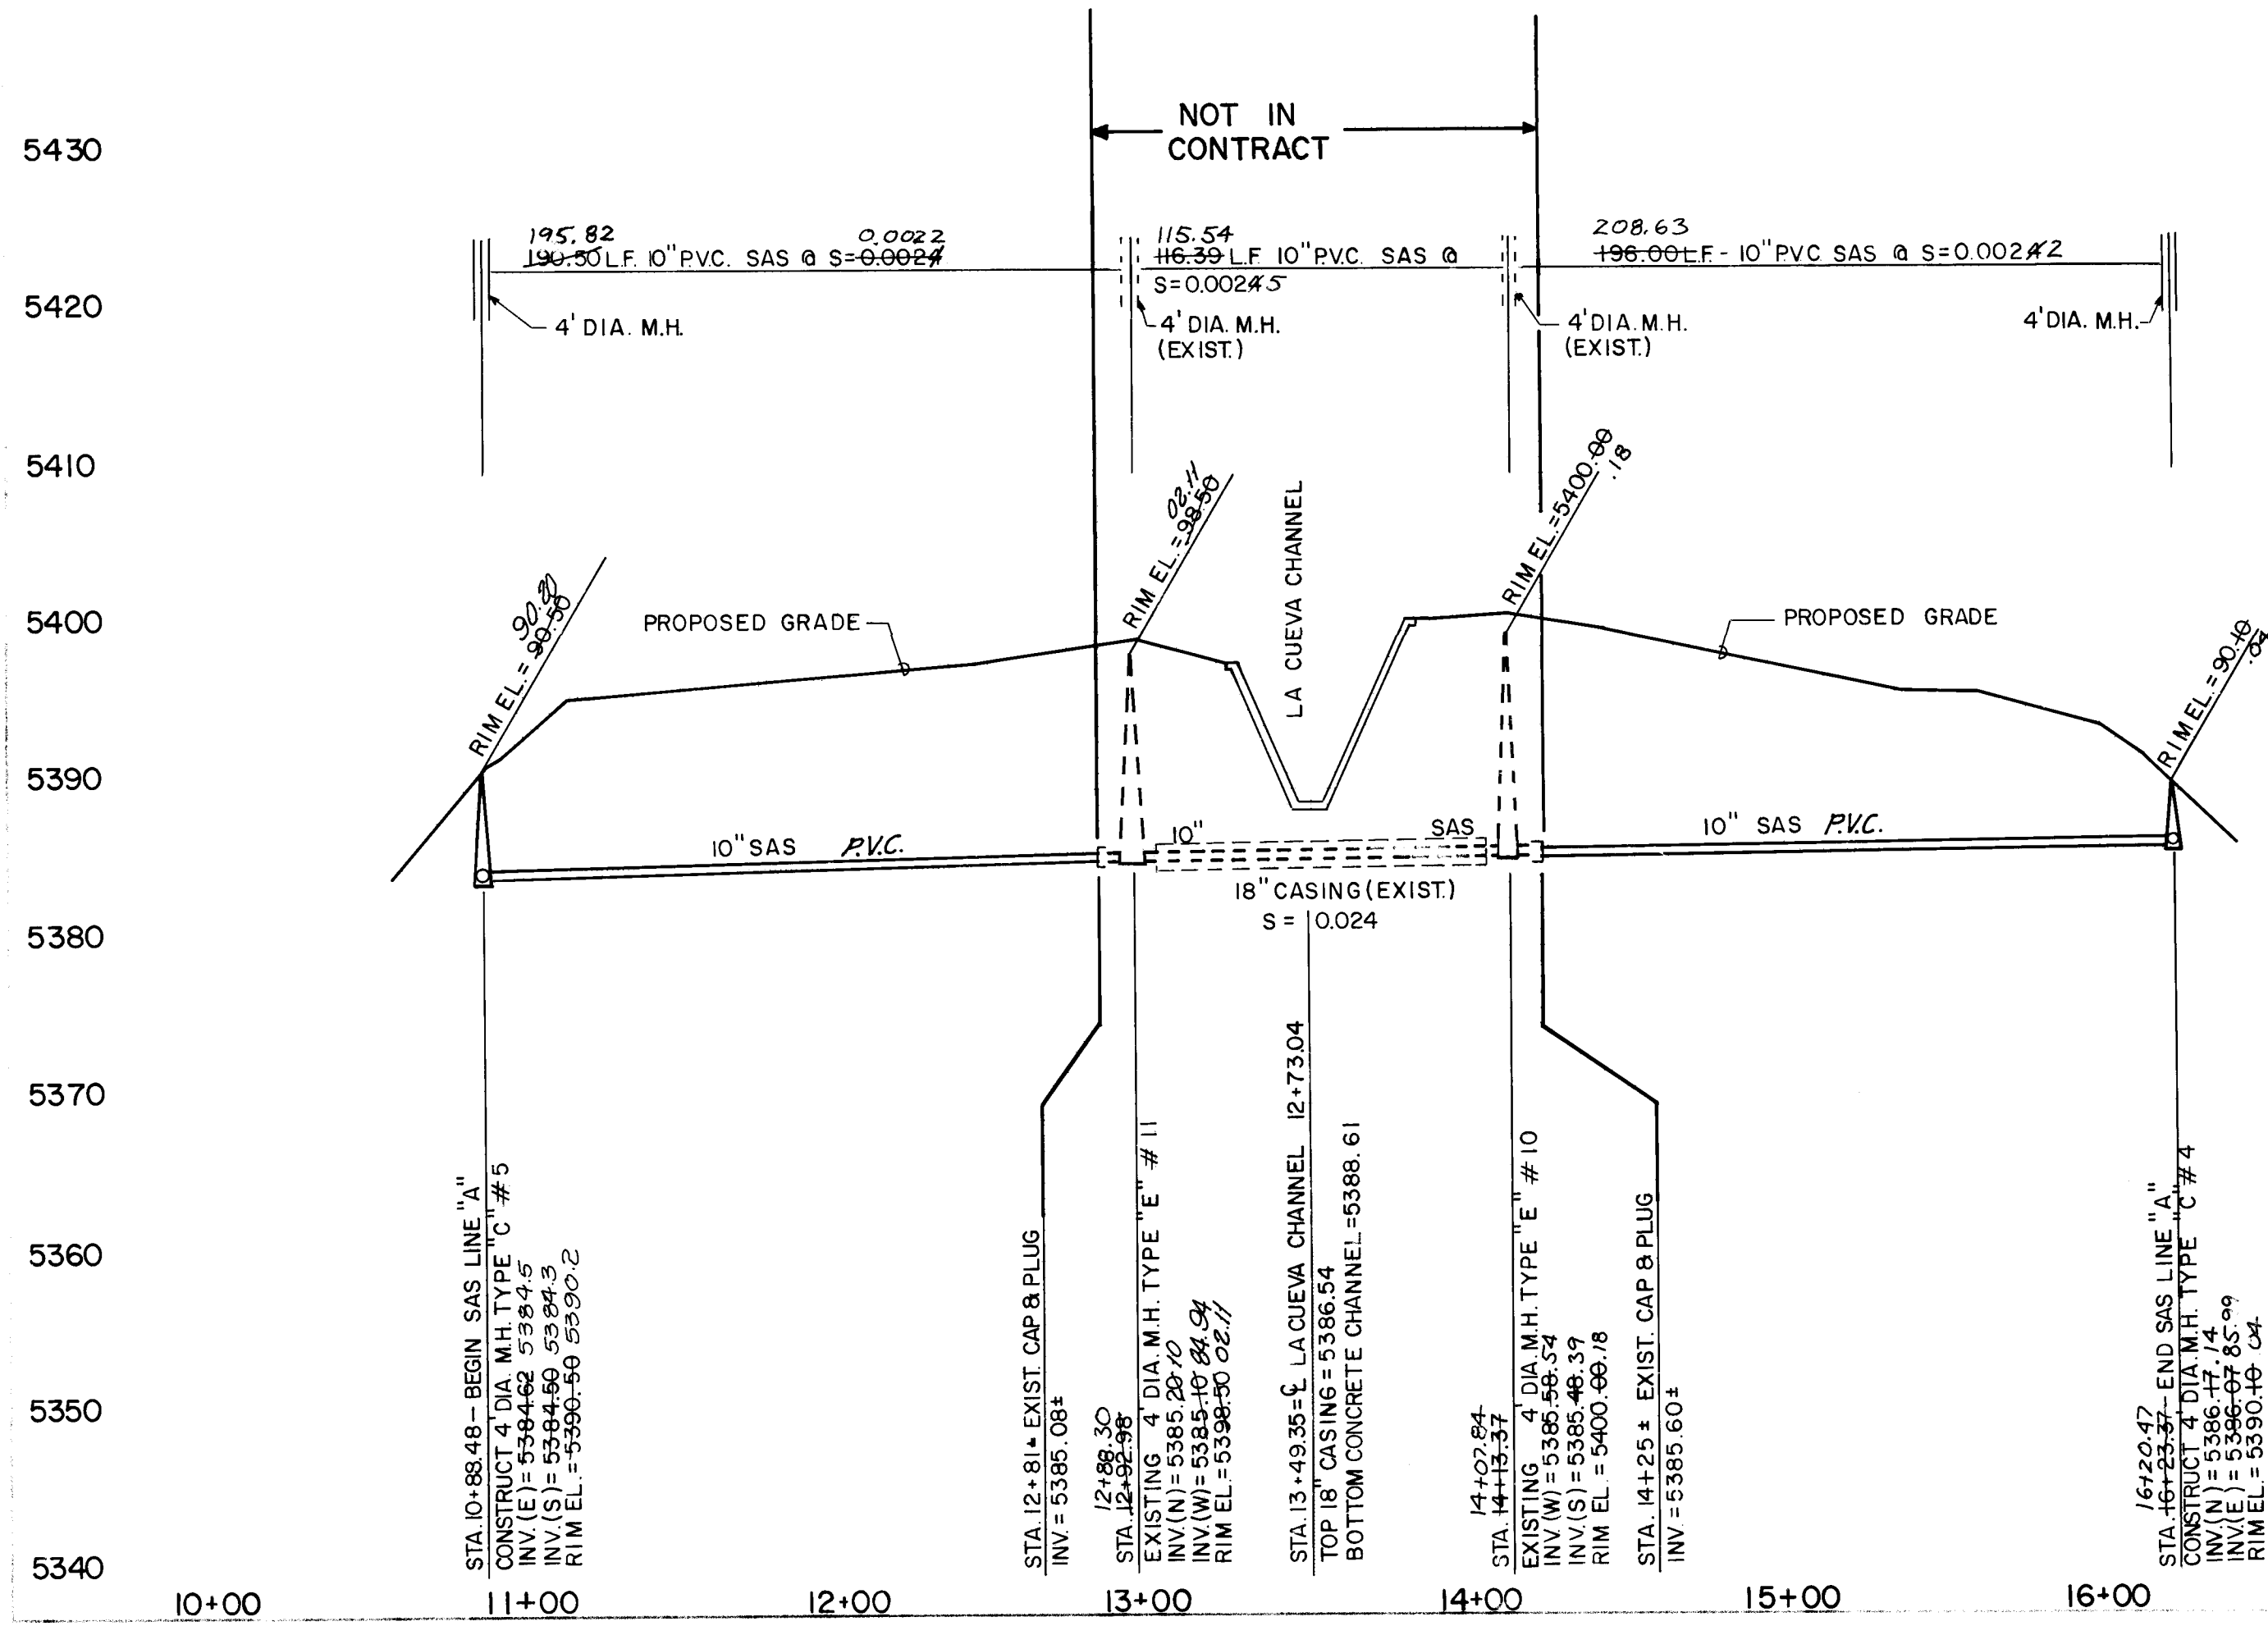

26 31 86 53 88

5430

5420

5410

5400

5390

5380

5370

5360

5350

5340

10+00 11+00 12+00 13+00 14+00 15+00 16+00

NOT IN CONTRACT

PROPOSED GRADE

LA CUEVA CHANNEL

10" SAS PVC

18" CASING (EXIST.) S=0.0024

4" DIA. M.H. (EXIST.)

4" DIA. M.H. (EXIST.)

4" DIA. M.H. (EXIST.)

4" DIA. M.H. (EXIST.)

STA. 10+88.48 - BEGIN SAS LINE "A" CONSTRUCT 4" DIA. M.H. TYPE "C" #5 INV (E) = 5384.62, 5384.5 INV (S) = 5384.60, 5384.5 RIM EL. = 5390.50, 5390.2

STA. 12+88.30 EXISTING 4" DIA. M.H. TYPE "E" #11 INV (N) = 5385.20, 5385.2 INV (S) = 5385.40, 5385.4 RIM EL. = 5390.50, 5390.2

STA. 13+49.35 - LA CUEVA CHANNEL 12+73.04 TOP 18" CASING = 5386.54 BOTTOM CONCRETE CHANNEL = 5388.61

STA. 14+25.81 EXISTING 4" DIA. M.H. TYPE "E" #10 INV (N) = 5385.40, 5385.4 INV (S) = 5385.40, 5385.4 RIM EL. = 5400.00, 5400.0

STA. 16+20.47 CONSTRUCT 4" DIA. M.H. TYPE "C" #4 INV (E) = 5385.40, 5385.4 INV (S) = 5385.40, 5385.4 RIM EL. = 5390.40, 5390.4

ESPEY, HUSTON & ASSOCIATES, INC.
Engineering & Environmental Consultants
317 COMMERCIAL ST. N.E.
ALBUQUERQUE, NEW MEXICO 87102
PHONE: (505) 242-1909

NOR ESTE ESTATES
SANITARY SEWER LINE "A"
PLAN AND PROFILE

10/5/87
NADWH
8/31/87
MA RLS


3186 C-19 53 77

8/14/87

8/1/87

8/1/87

REMARKS
AS NOTED
BY SIGN
E.H.S.
P.A.L.

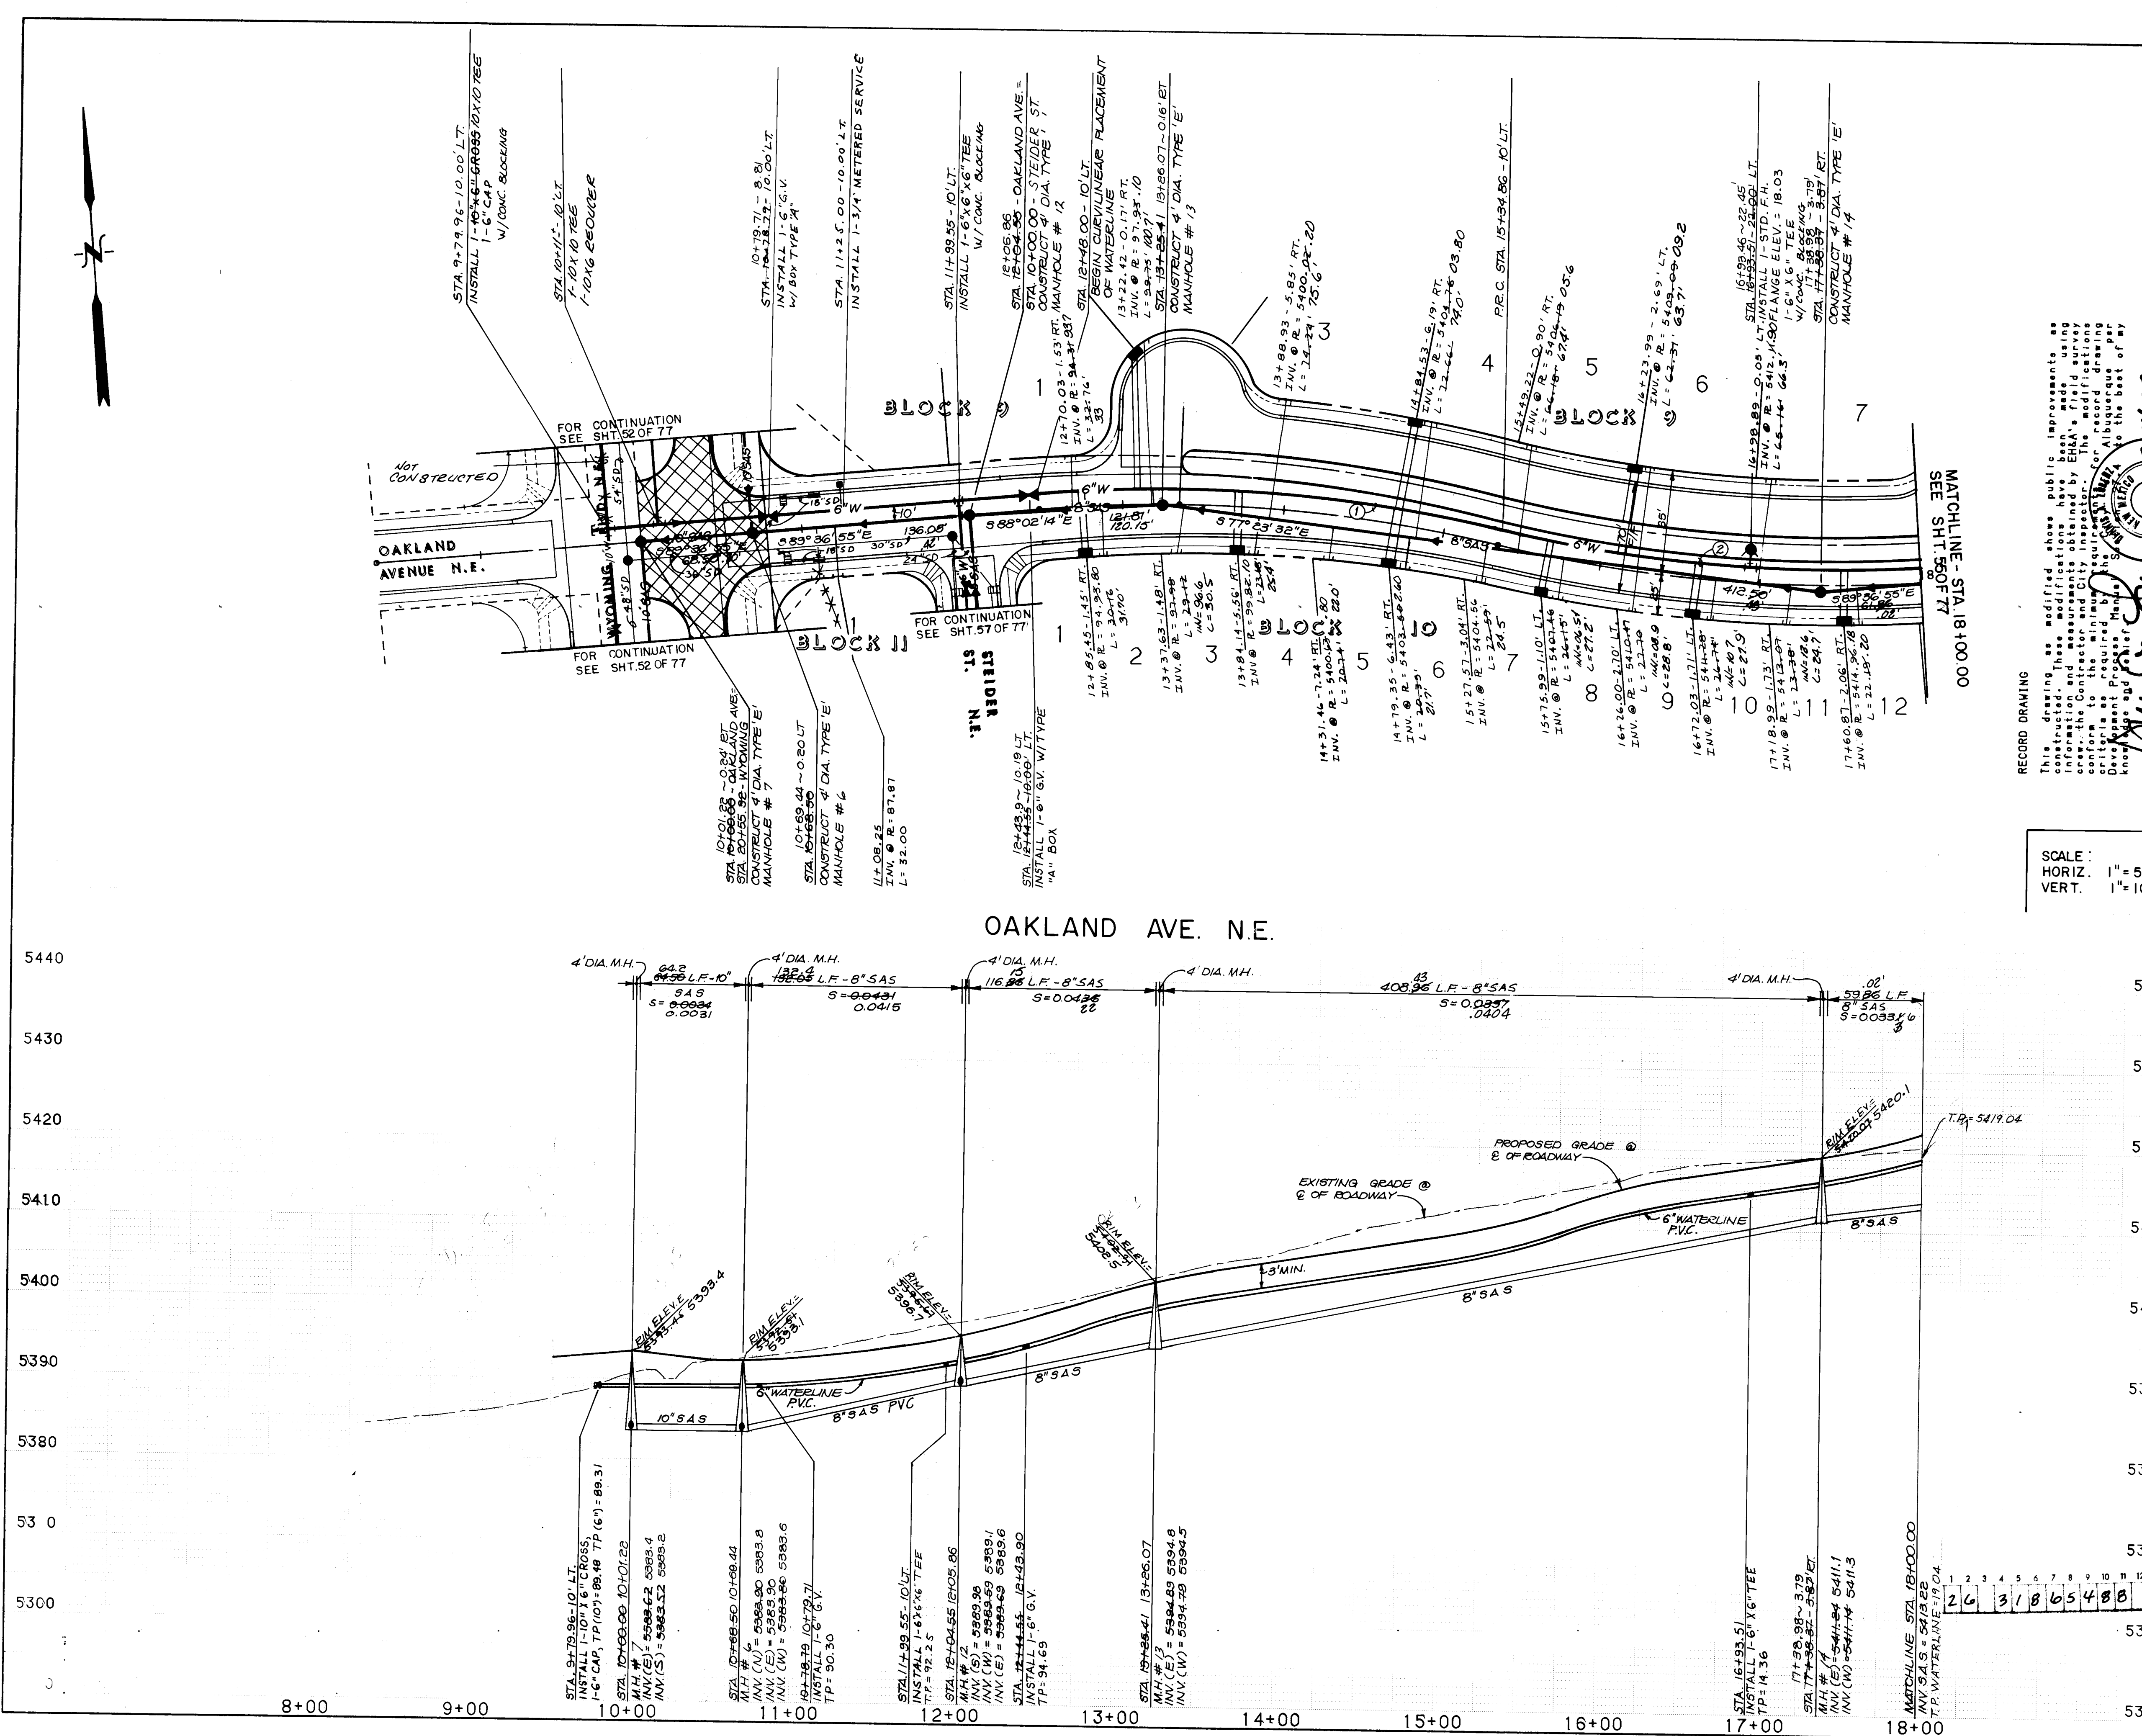

RECORD DRAWING

This drawing is modified where public improvements are constructed. These modifications have been made by the City Engineer and the City Engineer's Office. The modifications are shown on this drawing by the City Engineer's Office. The modifications are shown on this drawing by the City Engineer's Office. The modifications are shown on this drawing by the City Engineer's Office.

DATE: 8/14/87

BY: [Signature]

DATE: 8/14/87

BY: [Signature]

WATER AND SANITARY SEWER		AS BUILT INFORMATION	
1. ALL STATIONING AND OFFSET DIMENSIONS ARE BASED ON CENTERLINE OF RIGHT-OF-WAY.		2. THE FOLLOWING CITY OF ALBUQUERQUE STANDARD DRAWINGS ARE APPLICABLE TO THE WATER AND SANITARY SEWER CONSTRUCTION:	
2102	2145	2326	2344
2110	2315	2328	2347
2118	2320	2335	2360
2125	2325	2340	2369

LEGEND	
PROPOSED WATERLINE	
PROPOSED GATE VALVE	
PROPOSED FIRE HYDRANT	
PROPOSED CAP OR PLUG	
PROPOSED SINGLE METER, WATER SERVICE LINE	
PROPOSED DOUBLE METER, WATER SERVICE LINES	
PROPOSED CROSS, TEE, OR ELBOW	
PROPOSED SANITARY SEWER LINE	
PROPOSED MANHOLE	
PROPOSED CAP OR PLUG	
PROPOSED SANITARY SEWER SERVICE LINE	
PROPERTY OR BOUNDARY LINE	
CENTERLINE OF STREET	
CURB AND GUTTER	
FUTURE SIDEWALK	
TEMP. PAVING	


ENGINEER'S SEAL	
[Signature]	
DESIGNED BY	DATE
DRAWN BY	DATE
CHECKED BY	DATE

CITY OF ALBUQUERQUE PUBLIC WORKS DEPARTMENT ENGINEERING GROUP	
TITLE: NOR ESTE ESTATES OAKLAND AVE. N.E. STA. 8+35.00 TO STA. 18+00.00	
APPROVALS	ENGINEER
D.R.C. Chair	DATE
Trans. Dev.	DATE
Utility Dev.	DATE

REVISIONS	
NO.	DATE
1	8/14/87
2	8/14/87
3	8/14/87
4	8/14/87
5	8/14/87
6	8/14/87
7	8/14/87
8	8/14/87
9	8/14/87
10	8/14/87
11	8/14/87
12	8/14/87

DRAWING NO. 3186	
MAP NO. C-19	
SHEET 54 OF 77	

5480
5470
5460
5450
5440
5430
5420
5410
5400
5390

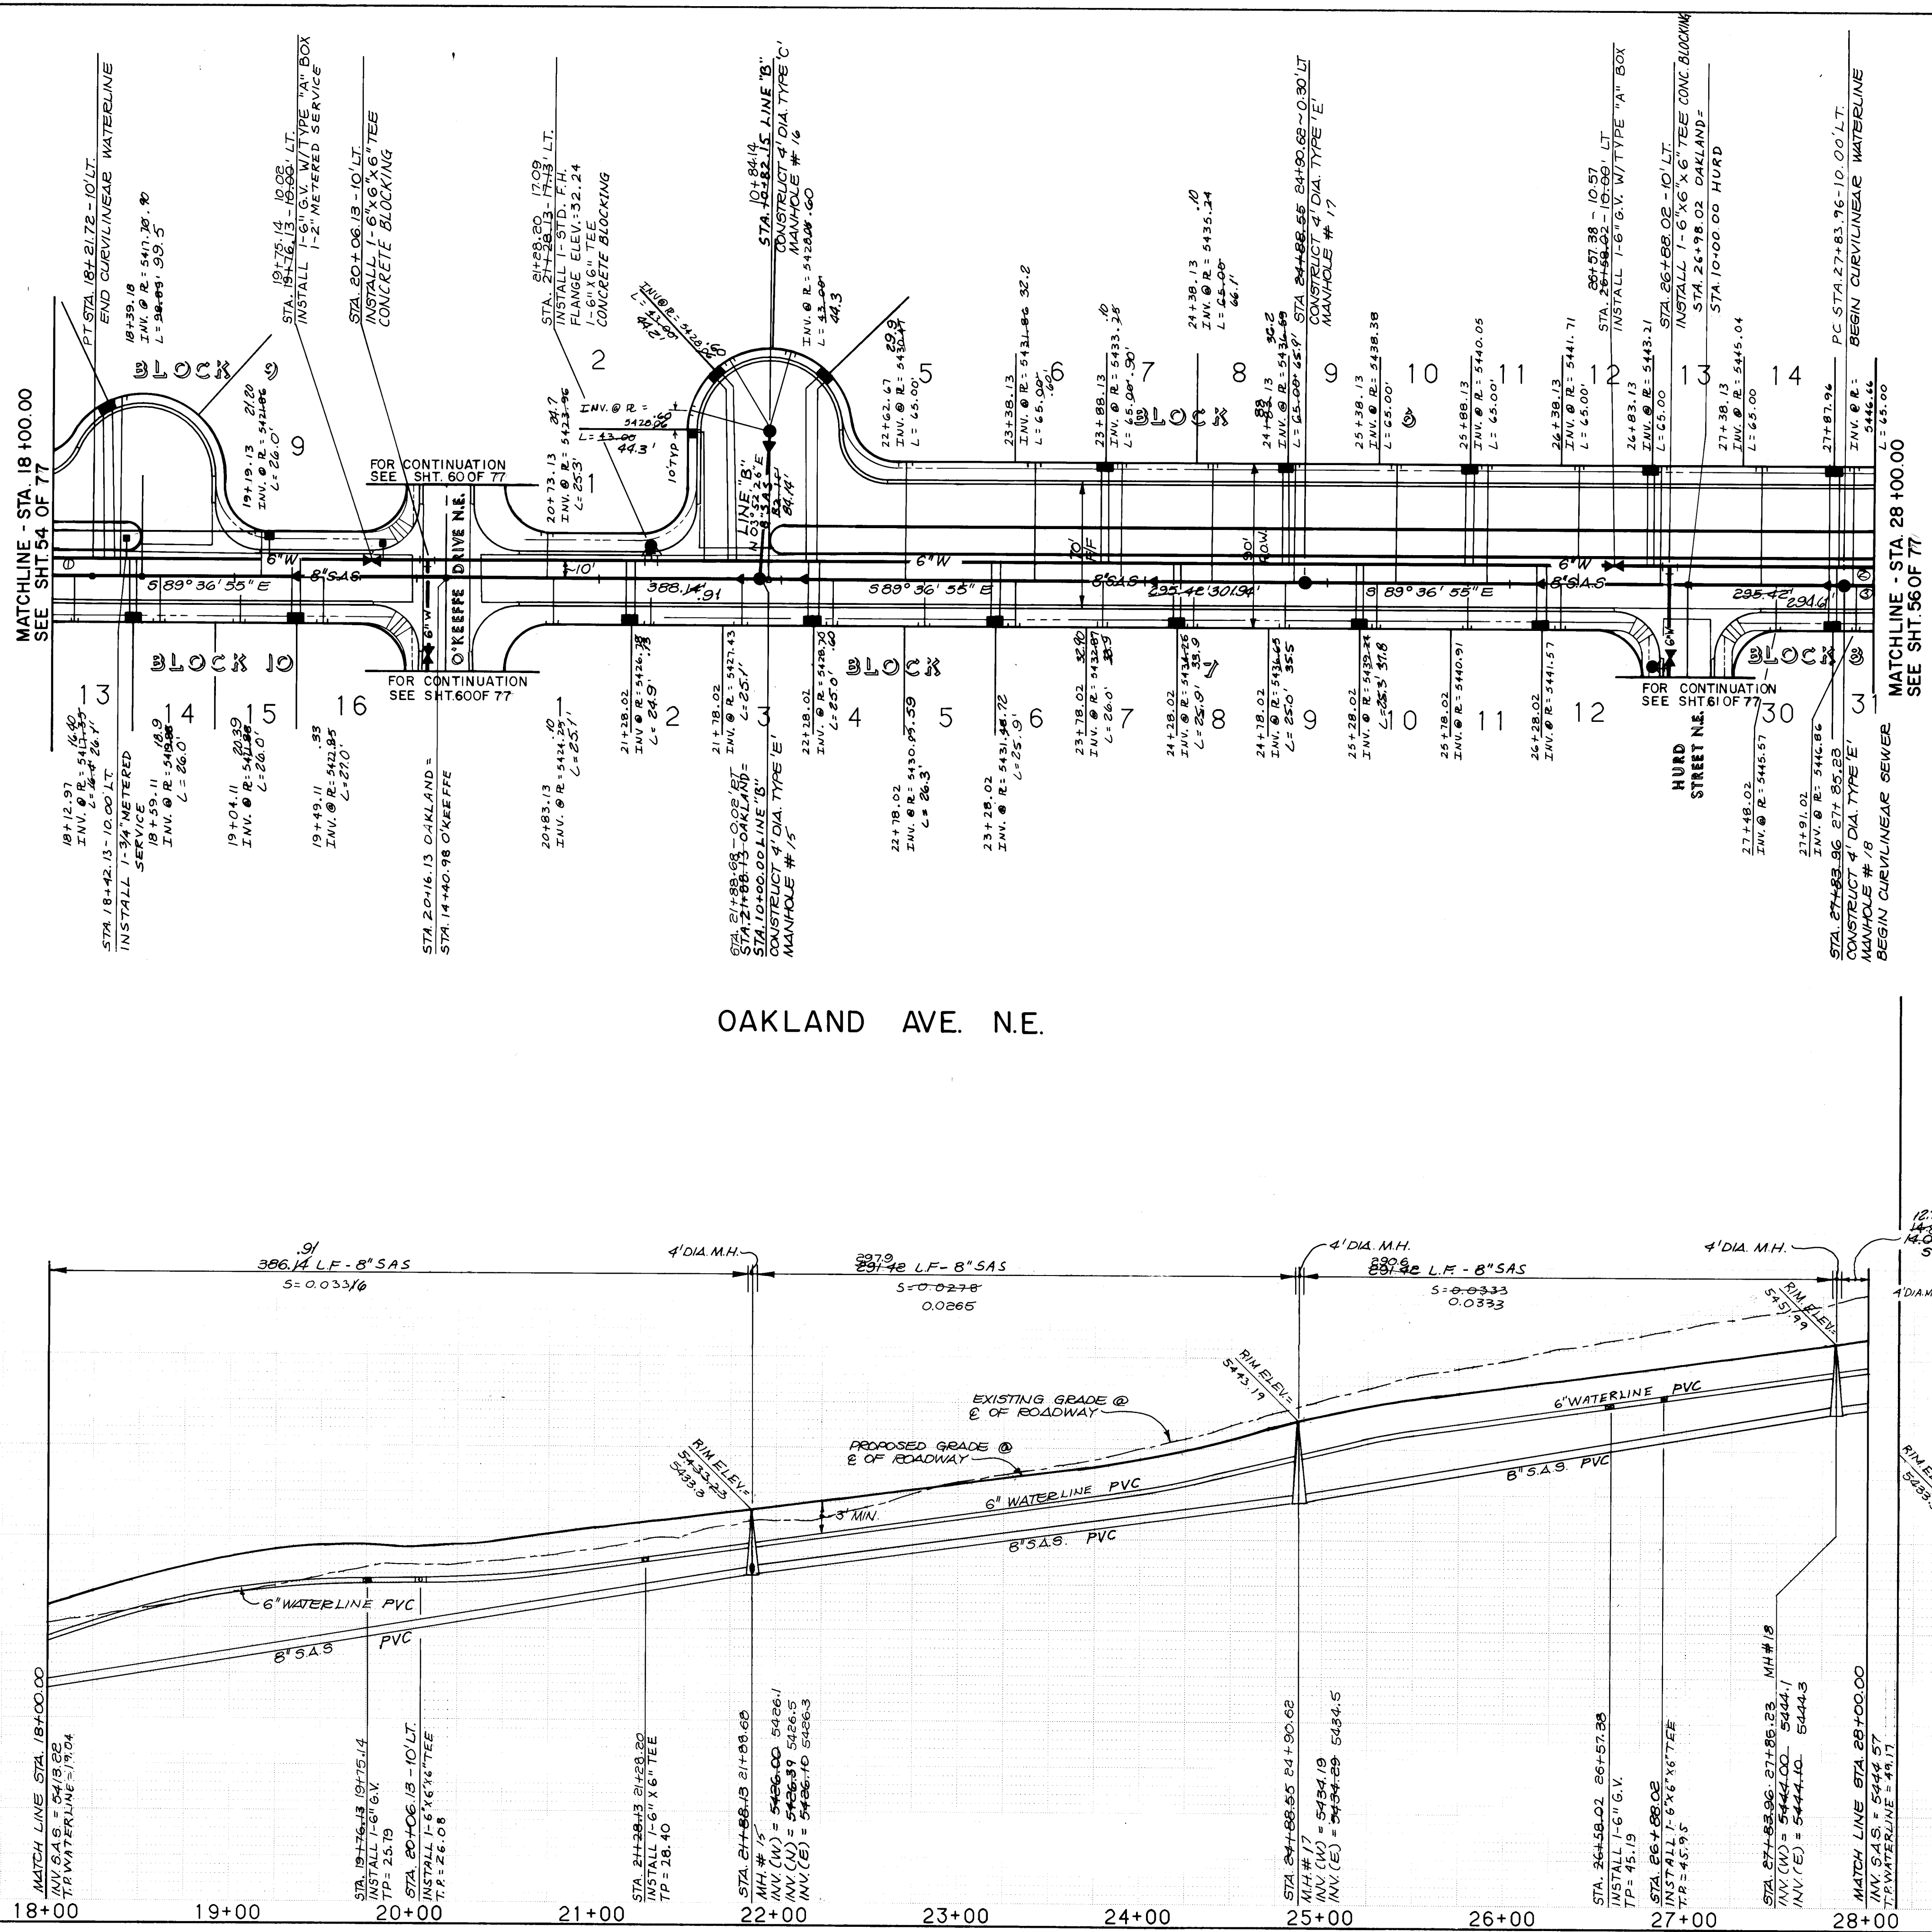

LINE "B"

SCALE:
HORIZ. 1" = 50'
VERT. 1" = 10'

- LEGEND**
- PROPOSED WATERLINE
 - PROPOSED GATE VALVE
 - PROPOSED FIRE HYDRANT
 - PROPOSED CAP OR PLUG
 - PROPOSED SINGLE METER, WATER SERVICE LINE
 - PROPOSED DOUBLE METER, WATER SERVICE LINES
 - PROPOSED CROSS, TEE, OR ELBOW
 - PROPOSED SANITARY SEWER LINE
 - PROPOSED MANHOLE
 - PROPOSED CAP OR PLUG
 - PROPOSED SANITARY SEWER SERVICE LINE
 - PROPERTY OR BOUNDARY LINE
 - CENTERLINE OF STREET
 - CURB AND GUTTER
 - SIDEWALK

26 318 665 88

ESPEY, HUSTON & ASSOCIATES, INC.
Engineering & Environmental Consultants
317 COMMERCIAL ST. N.E.
ALBUQUERQUE, NEW MEXICO 87102
PHONE: (505) 242-1909

CITY OF ALBUQUERQUE
PUBLIC WORKS DEPARTMENT
ENGINEERING GROUP

TITLE: NOR ESTE ESTATES
OAKLAND AVE. N.E.
STA. 18+00.00 TO STA. 28+00.00

APPROVALS	ENGINEER	DATE	APPROVALS	ENGINEER	DATE
D.R.C. Chair		10/5/87			
Trans. Dev.		9/16/87			
Utility Dev.		8/14/87			

DESIGNED BY: S.H.S.
DRAWN BY: S.H.S.
CHECKED BY: P.A.L.

DATE: 6/87
DATE: 8/87
DATE: 8/87

DRAWING NO. 3186 MAP NO. C-19 SHEET 55 OF 77

RECORD DRAWING

This drawing is modified to show public improvements as shown on the attached sheet. The modifications are for information and measurement only. The Engineer's field notes, the Contractor's field notes, and the City of Albuquerque's field notes are the basis for this drawing. The modifications are for information and measurement only. The Engineer's field notes, the Contractor's field notes, and the City of Albuquerque's field notes are the basis for this drawing.

3-14-88

Dennis A. Lorenz P.E. 7647

NO. DELTA				RADIUS	LENGTH	TAN
1	1°22'53"	890.00	21.48	10.74		
2	1°01'14"	890.00	15.85	7.93		
3	1°01'14"	900.00	16.00	8.02		

WATER AND SANITARY SEWER

1. ALL STATIONING AND OFFSET DIMENSIONS ARE BASED ON CENTERLINE OF RIGHT-OF-WAY.

2. THE FOLLOWING CITY OF ALBUQUERQUE STANDARD DRAWINGS ARE APPLICABLE TO THE WATER AND SANITARY SEWER CONSTRUCTION:

2102	2145	2326	2344	2362
2110	2315	2328	2347	2366
2118	2320	2335	2360	2368
2125	2325	2340	2361	2369

ALL SERVICES THIS SHEET = 25' UNLESS OTHERWISE NOTED

NO. DELTA				RADIUS	LENGTH	TAN
1	1°22'53"	890.00	21.48	10.74		
2	1°01'14"	890.00	15.85	7.93		
3	1°01'14"	900.00	16.00	8.02		

AS BUILT INFORMATION

CONTRACTOR: NEW CONCEPTS

DATE: 8/88

INSPECTOR: E.H.A.

DATE: 8/88

RECORDED BY: E.H.A.


DATE: 8/88

FILED BY: E.H.A.

DATE: 8/88

STAMPED: 1-880, SET IN TOP OF A CONCRETE POST PROJECTING 0.1 FEET ABOVE GROUND.

FIELD ELEVATION: 5474.93'

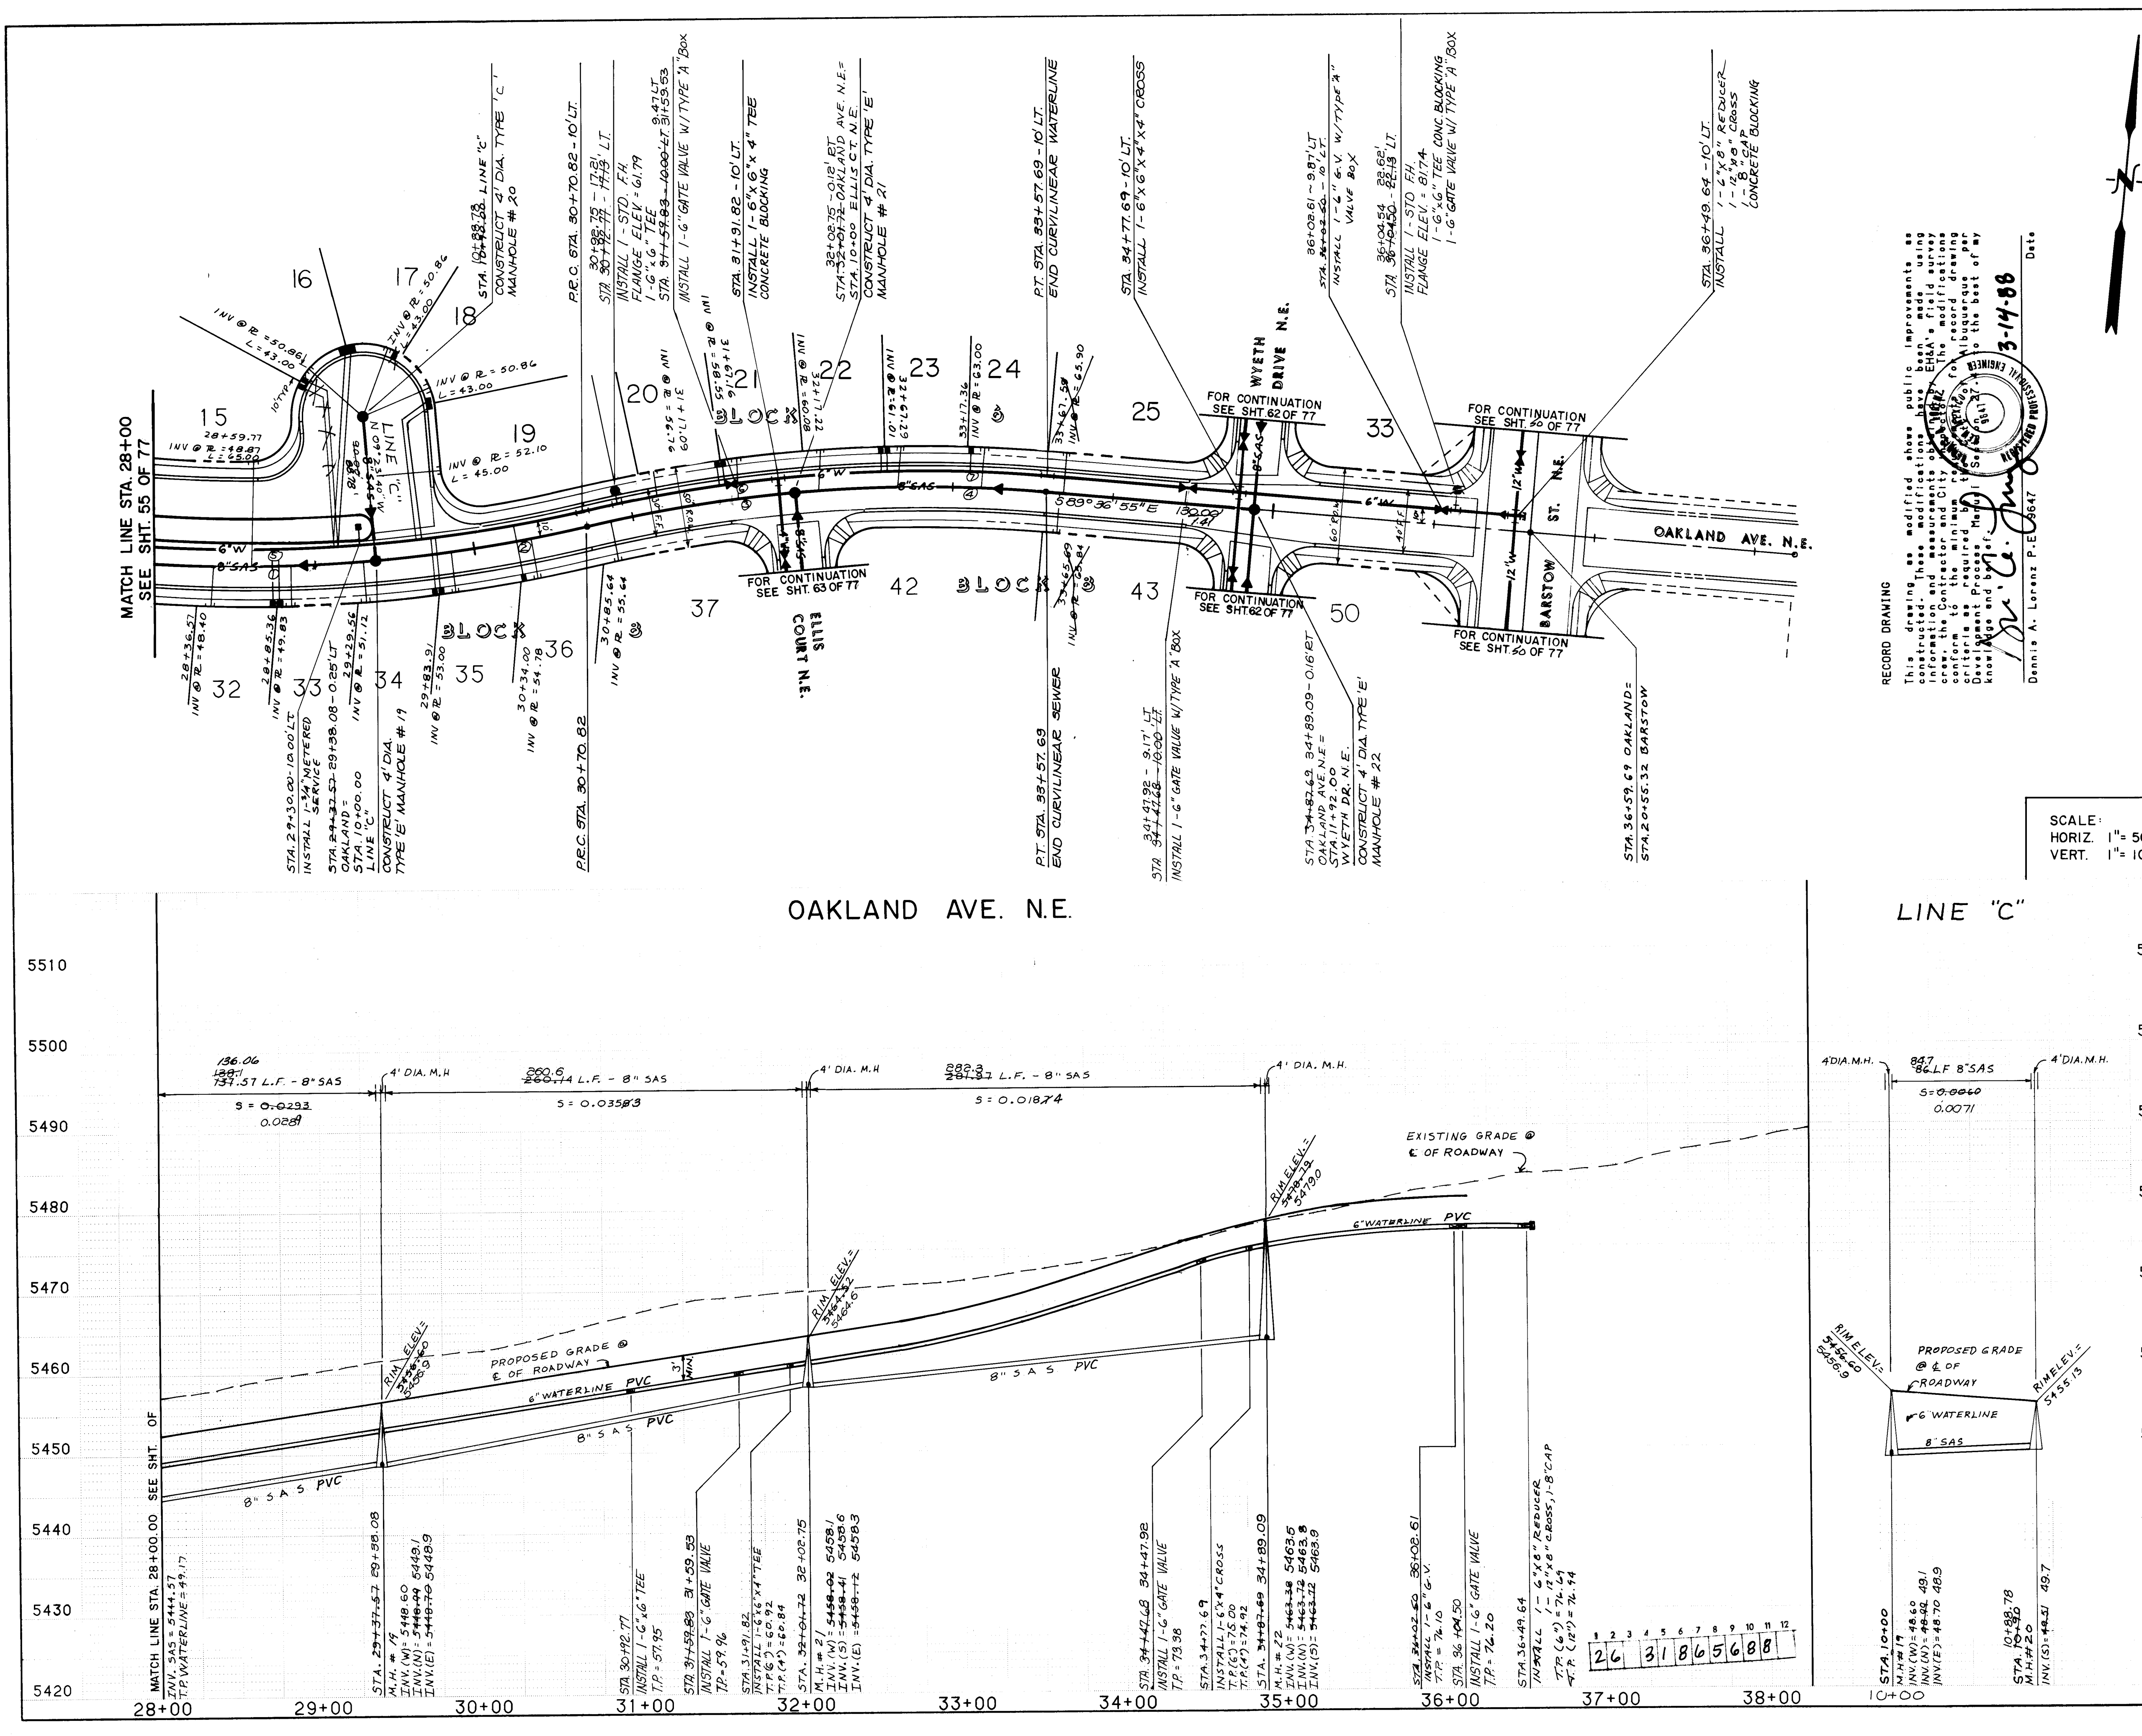

NO.	DELTA	RADIUS	LENGTH	TAN
1	8°45'31"	900.00	134.06	68.92
2	8°28'58"	900.00	133.25	66.75
3	8°19'56"	900.00	132.54	65.56
4	9°55'46"	900.00	152.94	78.18
5	8°45'31"	890.00	136.05	68.16
6	7°42'10"	910.00	122.34	61.26
7	10°33'32"	910.00	167.71	84.09

WATER AND SANITARY SEWER				
1. ALL STATIONING AND OFFSET DIMENSIONS ARE BASED ON CENTERLINE OF RIGHT-OF-WAY.				
2. THE FOLLOWING CITY OF ALBUQUERQUE STANDARD DRAWINGS ARE APPLICABLE TO THE WATER AND SANITARY SEWER CONSTRUCTION:				
2102	2145	2326	2344	2362
2110	2315	2328	2347	2366
2118	2320	2335	2360	2368
2125	2325	2340	2361	2369

ALL SERVICES THIS SHEET = 24' UNLESS NOTED OTHERWISE

LEGEND

- PROPOSED WATERLINE
- PROPOSED GATE VALVE
- PROPOSED FIRE HYDRANT
- PROPOSED CAP OR PLUG
- PROPOSED SINGLE METER, WATER SERVICE LINE
- PROPOSED DOUBLE METER, WATER SERVICE LINES
- PROPOSED CROSS, TEE, OR ELBOW
- PROPOSED SANITARY SEWER LINE
- PROPOSED MANHOLE
- PROPOSED CAP OR PLUG
- PROPOSED SANITARY SEWER SERVICE LINE
- PROPERTY OR BOUNDARY LINE
- CENTERLINE OF STREET
- CURB AND GUTTER
- SIDEWALK

ESPEY, HUSTON & ASSOCIATES, INC.
Engineering & Environmental Consultants
317 COMMERCIAL ST. N.E.
ALBUQUERQUE, NEW MEXICO 87102
PHONE: (505) 242-1909

CITY OF ALBUQUERQUE
PUBLIC WORKS DEPARTMENT
ENGINEERING GROUP

TITLE: NOR ESTE ESTATES
OAKLAND AVE. N.E.
STA. 28+00.00 TO STA. 36+59.64

APPROVALS	ENGINEER	DATE	APPROVALS	ENGINEER	DATE
D.R. Chair	W.D.W.H.	10/5/87			
Trans. Dev	W.D.W.H.	7/16/87			
Utility Dev	W.D.W.H.	7/16/87			

DRAWING NO. 3186 MAP NO. C-19 SHEET 56 OF 77

AS BUILT INFORMATION

CONTRACTOR: NEW CONCEPTS
STAKED BY: E.H.4
DATE: 8/87

INSPECTOR: FIELD
DATE: 8/87

VERIFICATION BY: E.H.4
DATE: 8/87

CORRECTION BY: E.H.4
DATE: 8/87

MICRO-FILM INFORMATION

RECORDED BY: NO
DATE:

SURVEY INFORMATION

FIELD NOTES

NO. BY DATE

DATE: 8-14-87

ENGINEER'S SEAL

ESPEY, HUSTON & ASSOCIATES, INC.
Engineering & Environmental Consultants
317 COMMERCIAL ST. N.E.
ALBUQUERQUE, NEW MEXICO 87102
PHONE: (505) 242-1909

REVISIONS

DESIGN

DATE: 6/87


DATE: 8/87

DATE: 8/87

DESIGNED BY: E.H.S.

DRAWN BY: E.H.S.

CHECKED BY: D.A.L.

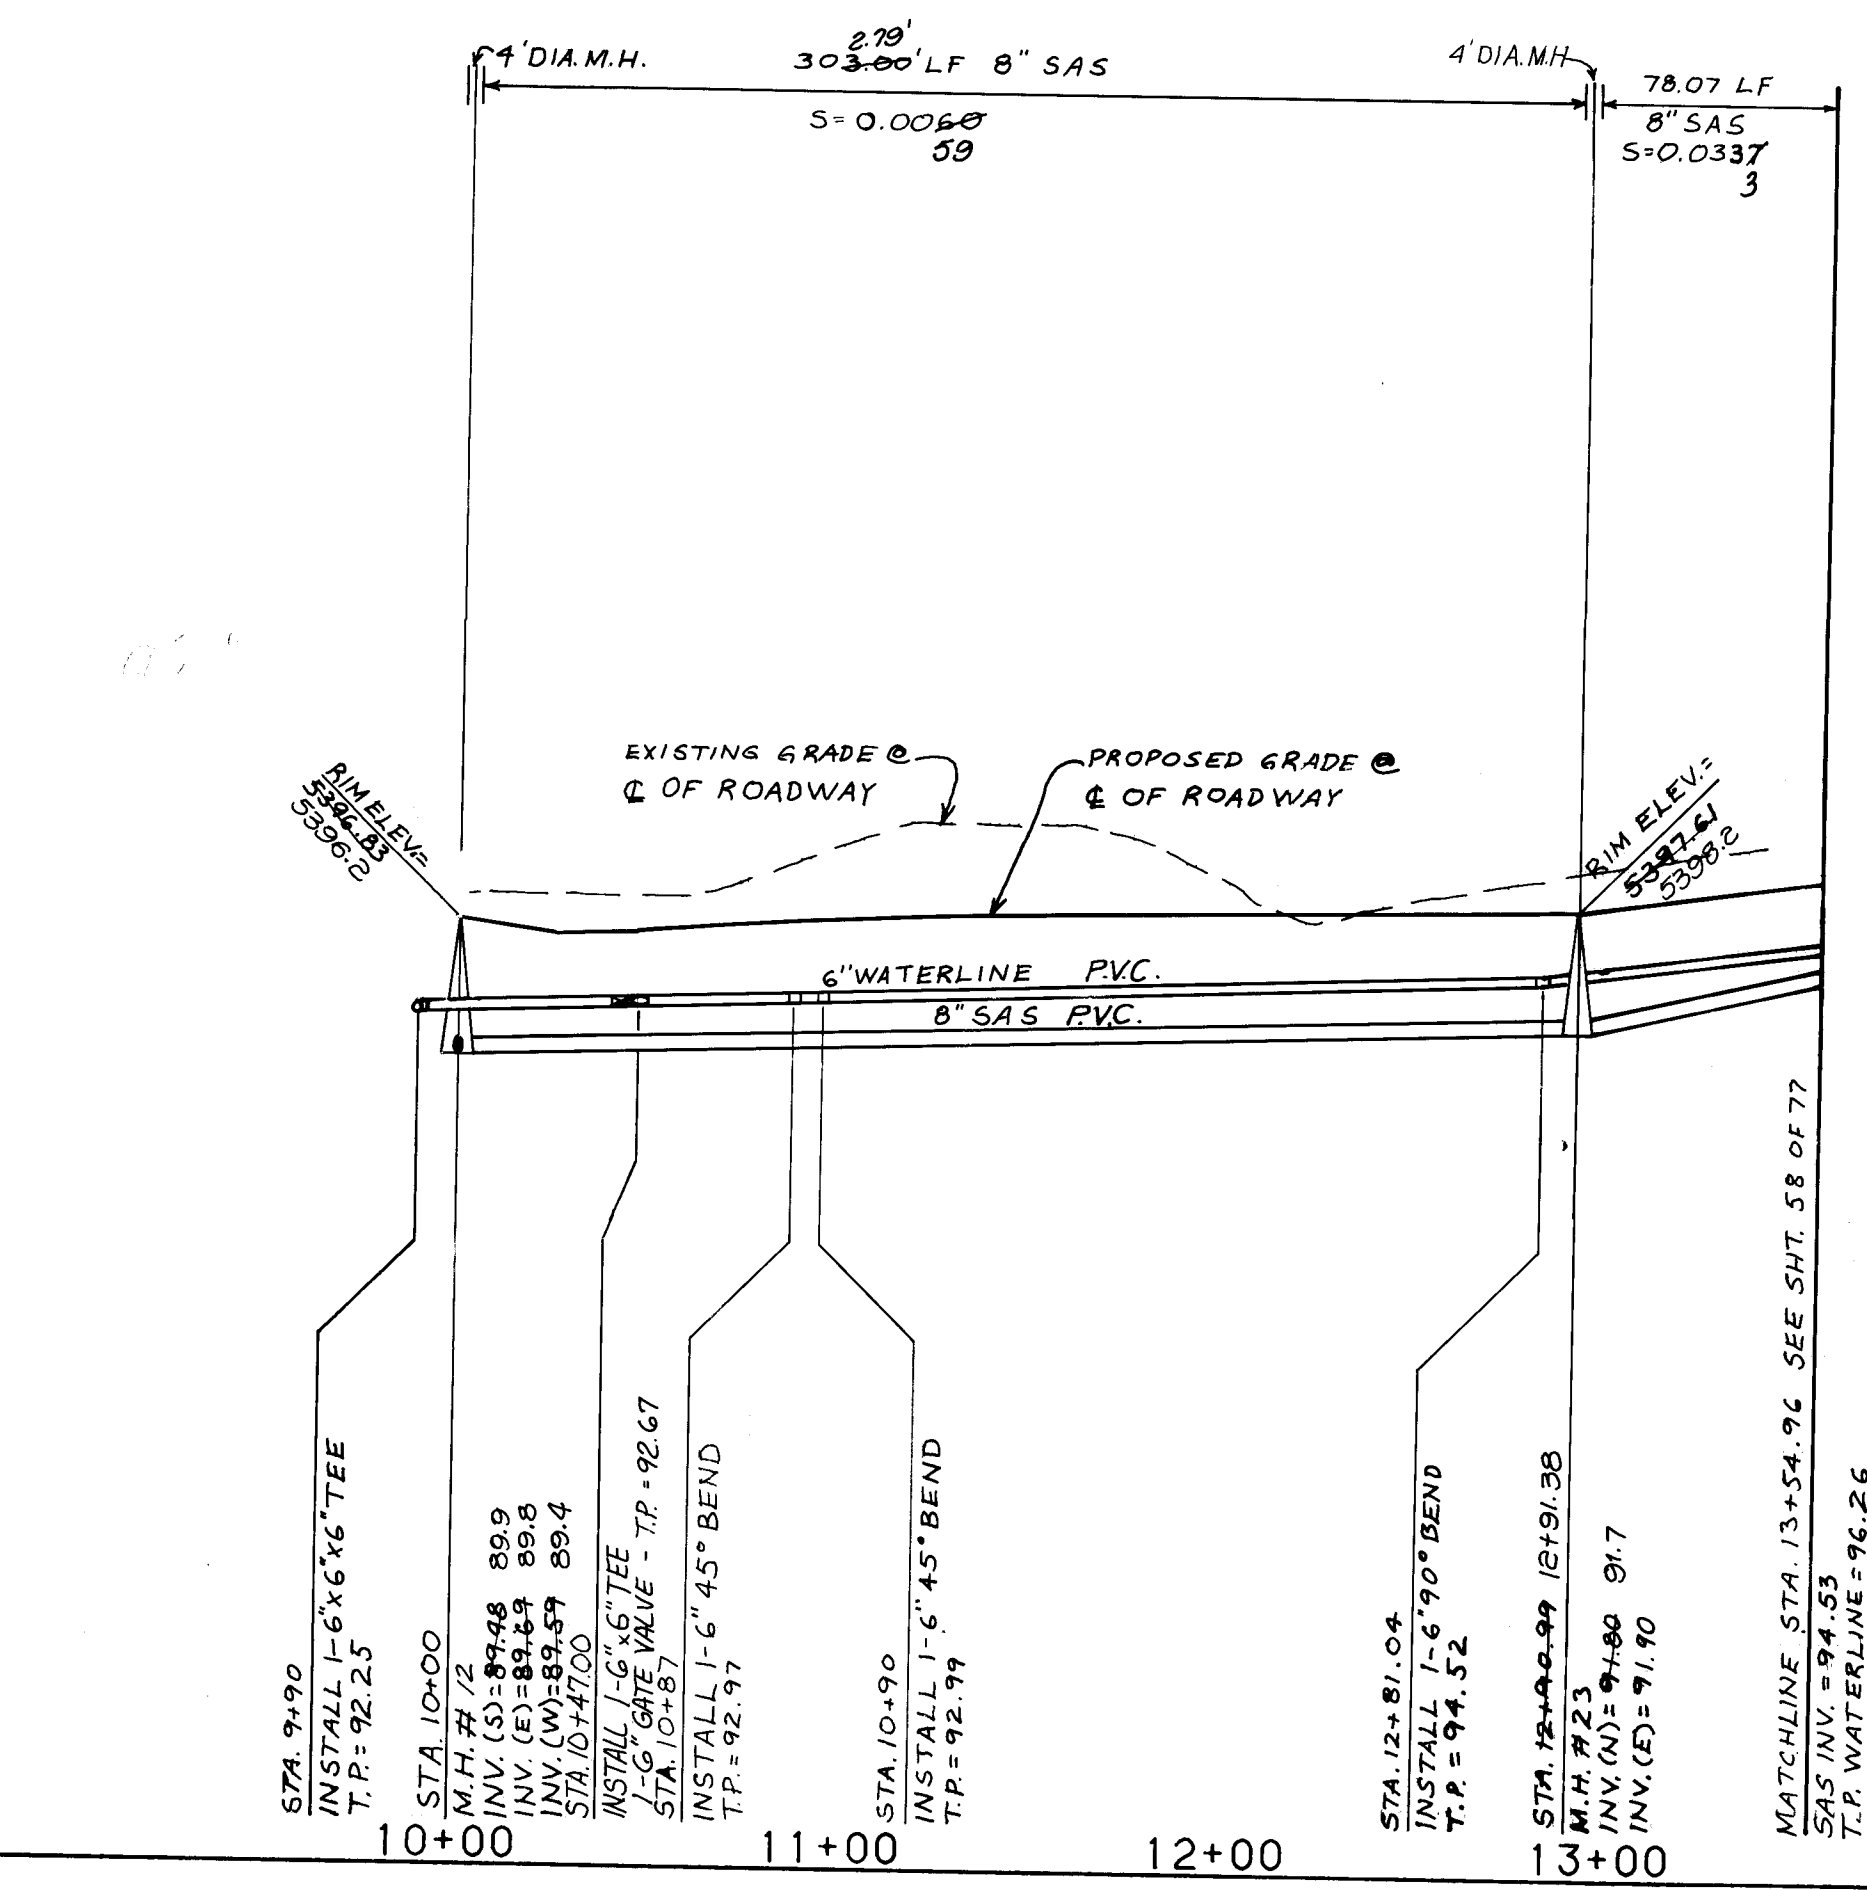

D. A. Jones

Donnie A. Lorenz P.E. 96087 PROFESSIONAL ENGINEER
 1964
 3-14-88 Date

2102	2145	2326	2344	2362
2110	2315	2328	2347	2366
2118	2320	2335	2360	2368
2125	2325	2340	2361	2369

	PROPOSED WATERLINE
	PROPOSED GATE VALVE
	PROPOSED FIRE HYDRANT
	PROPOSED CAP OR PLUG
	PROPOSED SINGLE METER, WATER SERVICE LINE
	PROPOSED DOUBLE METER, WATER SERVICE LINES
	PROPOSED CROSS,TEE,OR ELBOW
	PROPOSED SANITARY SEWER LINE
	PROPOSED MANHOLE
	PROPOSED CAP OR PLUG
	PROPOSED SANITARY SEWER SERVICE LINE
	PROPERTY OR BOUNDARY LINE
	CENTERLINE OF STREET
	CURB AND GUTTER
	SIDEWALK


DRAWING NO.	3186	MAP NO.	C-19	SHEET	57	OF	77
-------------	------	---------	------	-------	----	----	----

NO.	DATE	REMARKS	BY
<u>REVISIONS</u>			
<u>DESIGN</u>			
[] DRAWN BY		[] DATE	
[] CHECKED BY		[] DATE	
[] APPROVED BY		[] DATE	

DESIGNED BY	DATE
RHS	6/87

DRAWN BY	DATE
VS/SMC	8/87

CHECKED BY	DATE
DAI	8/87

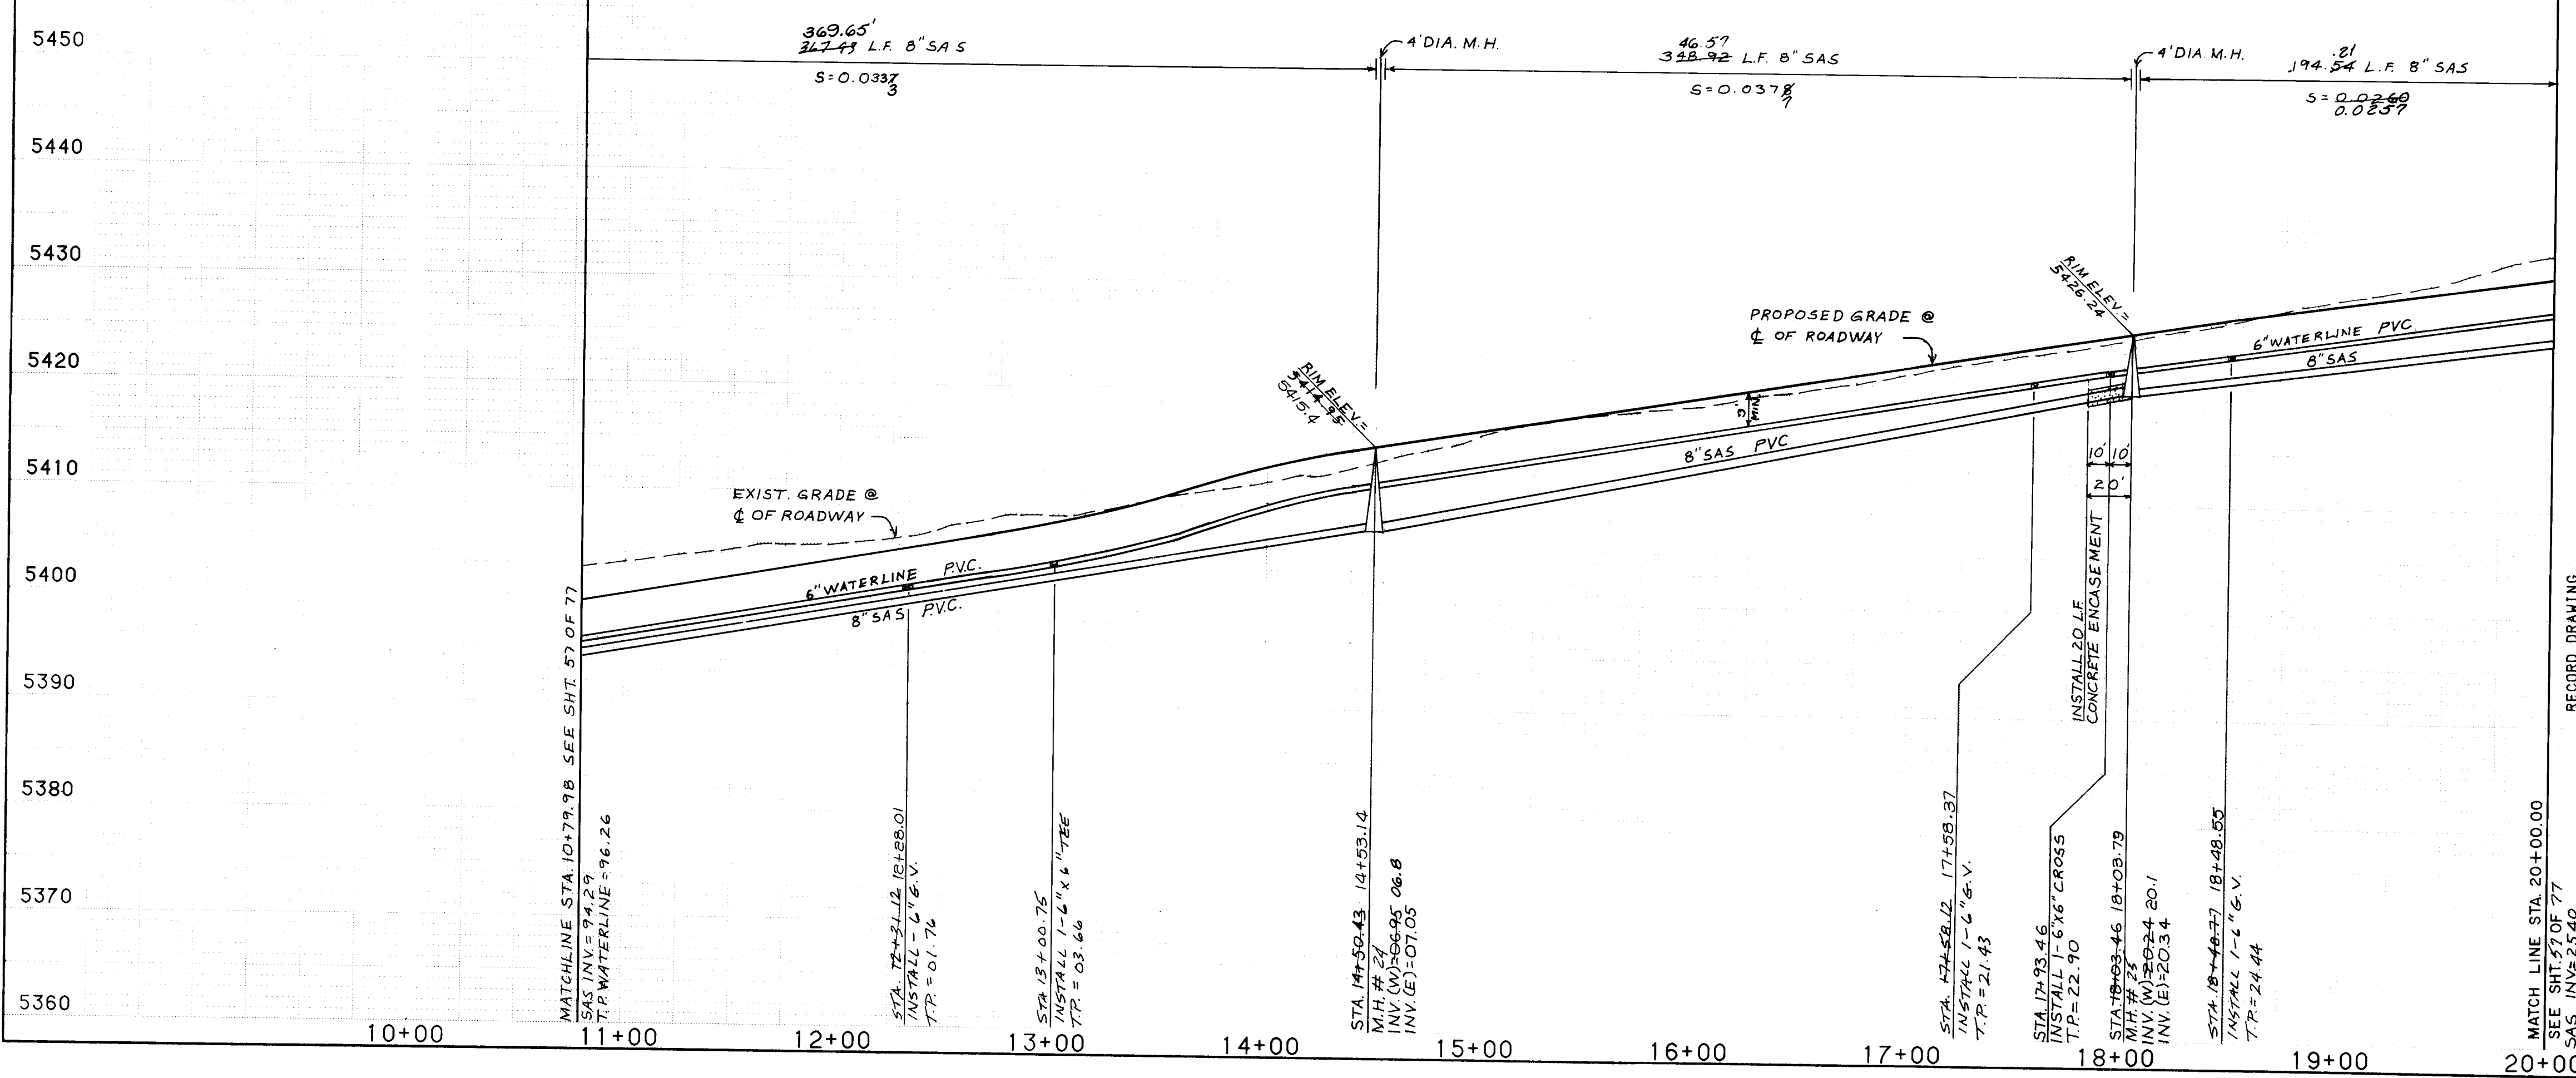

* S.A.S. SERVICES, AS-BUILT BY CONTRACTOR R. NOT E.H.A.

RECORD DRAWING
This drawing, as modified, shows public improvements, as constructed. The information and measurements obtained by E.H.A.'s field survey crew, the Contractor and the City Engineer, are hereby acknowledged. The modifications are the responsibility of the Engineer. The record drawing shall be the basis for the final construction. The Engineer's seal is required for the record drawing. The Engineer's seal is required for the record drawing. The Engineer's seal is required for the record drawing.

SCALE:
HORIZ. = 1" = 50'
VERT. = 1" = 10'

LEGEND

- PROPOSED WATERLINE
- PROPOSED GATE VALVE
- PROPOSED FIRE HYDRANT
- PROPOSED CAP OR PLUG
- PROPOSED SINGLE METER, WATER SERVICE LINE
- PROPOSED DOUBLE METER, WATER SERVICE LINES
- PROPOSED CROSS, TEE, OR ELBOW
- PROPOSED SANITARY SEWER LINE
- PROPOSED MANHOLE
- PROPOSED CAP OR PLUG
- PROPOSED SANITARY SEWER SERVICE LINE
- PROPERTY OR BOUNDARY LINE
- CENTERLINE OF STREET
- CURB AND GUTTER
- SIDEWALK

ESPEY, HUSTON & ASSOCIATES, INC.
Engineering & Environmental Consultants
317 COMMERCIAL ST. N.E.
ALBUQUERQUE, NEW MEXICO 87102
PHONE: (505) 242-1909

CITY OF ALBUQUERQUE PUBLIC WORKS DEPARTMENT ENGINEERING GROUP					
TITLE: NOR ESTE ESTATES MOYERS AVE. N.E. STA 10+79.98 TO STA 20+00.00					
APPROVALS	ENGINEER	DATE	APPROVALS	ENGINEER	DATE
D.R.C. Chair	Adrian J.	10/5/07			
Trans. Dev	DAWN H.	9/16/07			
Utility Dev	JE. Euteneier	9/16/07			
Drawn	MA R.H.	9-1-07			
DRAWING NO. 3186			MAP NO. C-19		
SHEET 58			OF 77		


WATER AND SANITARY SEWER				
1. ALL STATIONING AND OFFSET DIMENSIONS ARE BASED ON CENTERLINE OF RIGHT-OF-WAY.				
2. THE FOLLOWING CITY OF ALBUQUERQUE STANDARD DRAWINGS ARE APPLICABLE TO THE WATER AND SANITARY SEWER CONSTRUCTION:				
2102	2145	2326	2344	2362
2110	2315	2328	2347	2366
2118	2320	2335	2360	2368
2125	2325	2340	2361	2369

NO. DELTA		RADIUS		LENGTH		TAN.	
1 6°53'12"		1810.00		217.55		108.91	
2 7°50'28"		1790.00		244.97		122.68	
ALL SERVICES THIS SHEET = 25' UNLESS NOTED OTHERWISE.							

AS BUILT INFORMATION	
THE STATION IS LOCATED 9 MILES NORTHEAST OF DOWNTOWN ALBUQUERQUE, NEW MEXICO.	
ONE TO REACH THE STATION FROM THE INTERSECTION OF LOUISIANA BLVD. AND LOS ANGELES DRIVE, GO EAST ON LOS ANGELES DRIVE 10 MILES TO BARSTOW ST., THEN NORTH ON BARSTOW ST. 10 MILES TO ALAMEDA AVE. THE STATION IS LOCATED IN THE NORTHEAST QUADRANT OF THE INTERSECTION. THE STATION MARK IS A STANDARD ACS BRASS TABLET STAMPED "1-820", SET IN TOP OF A CONCRETE INT. PROTECTING O.I. FEET ABOVE GROUND. WELD ELEVATION: 5474.93'	

SURVEY INFORMATION	
FIELD NOTES	
NO.	DATE

ENGINEER'S SEAL	
NO. DATE	
REVISIONS	
DESIGN	DATE 6/87
DRAWN BY	DATE 8/07
CHECKED BY	DATE 9/07

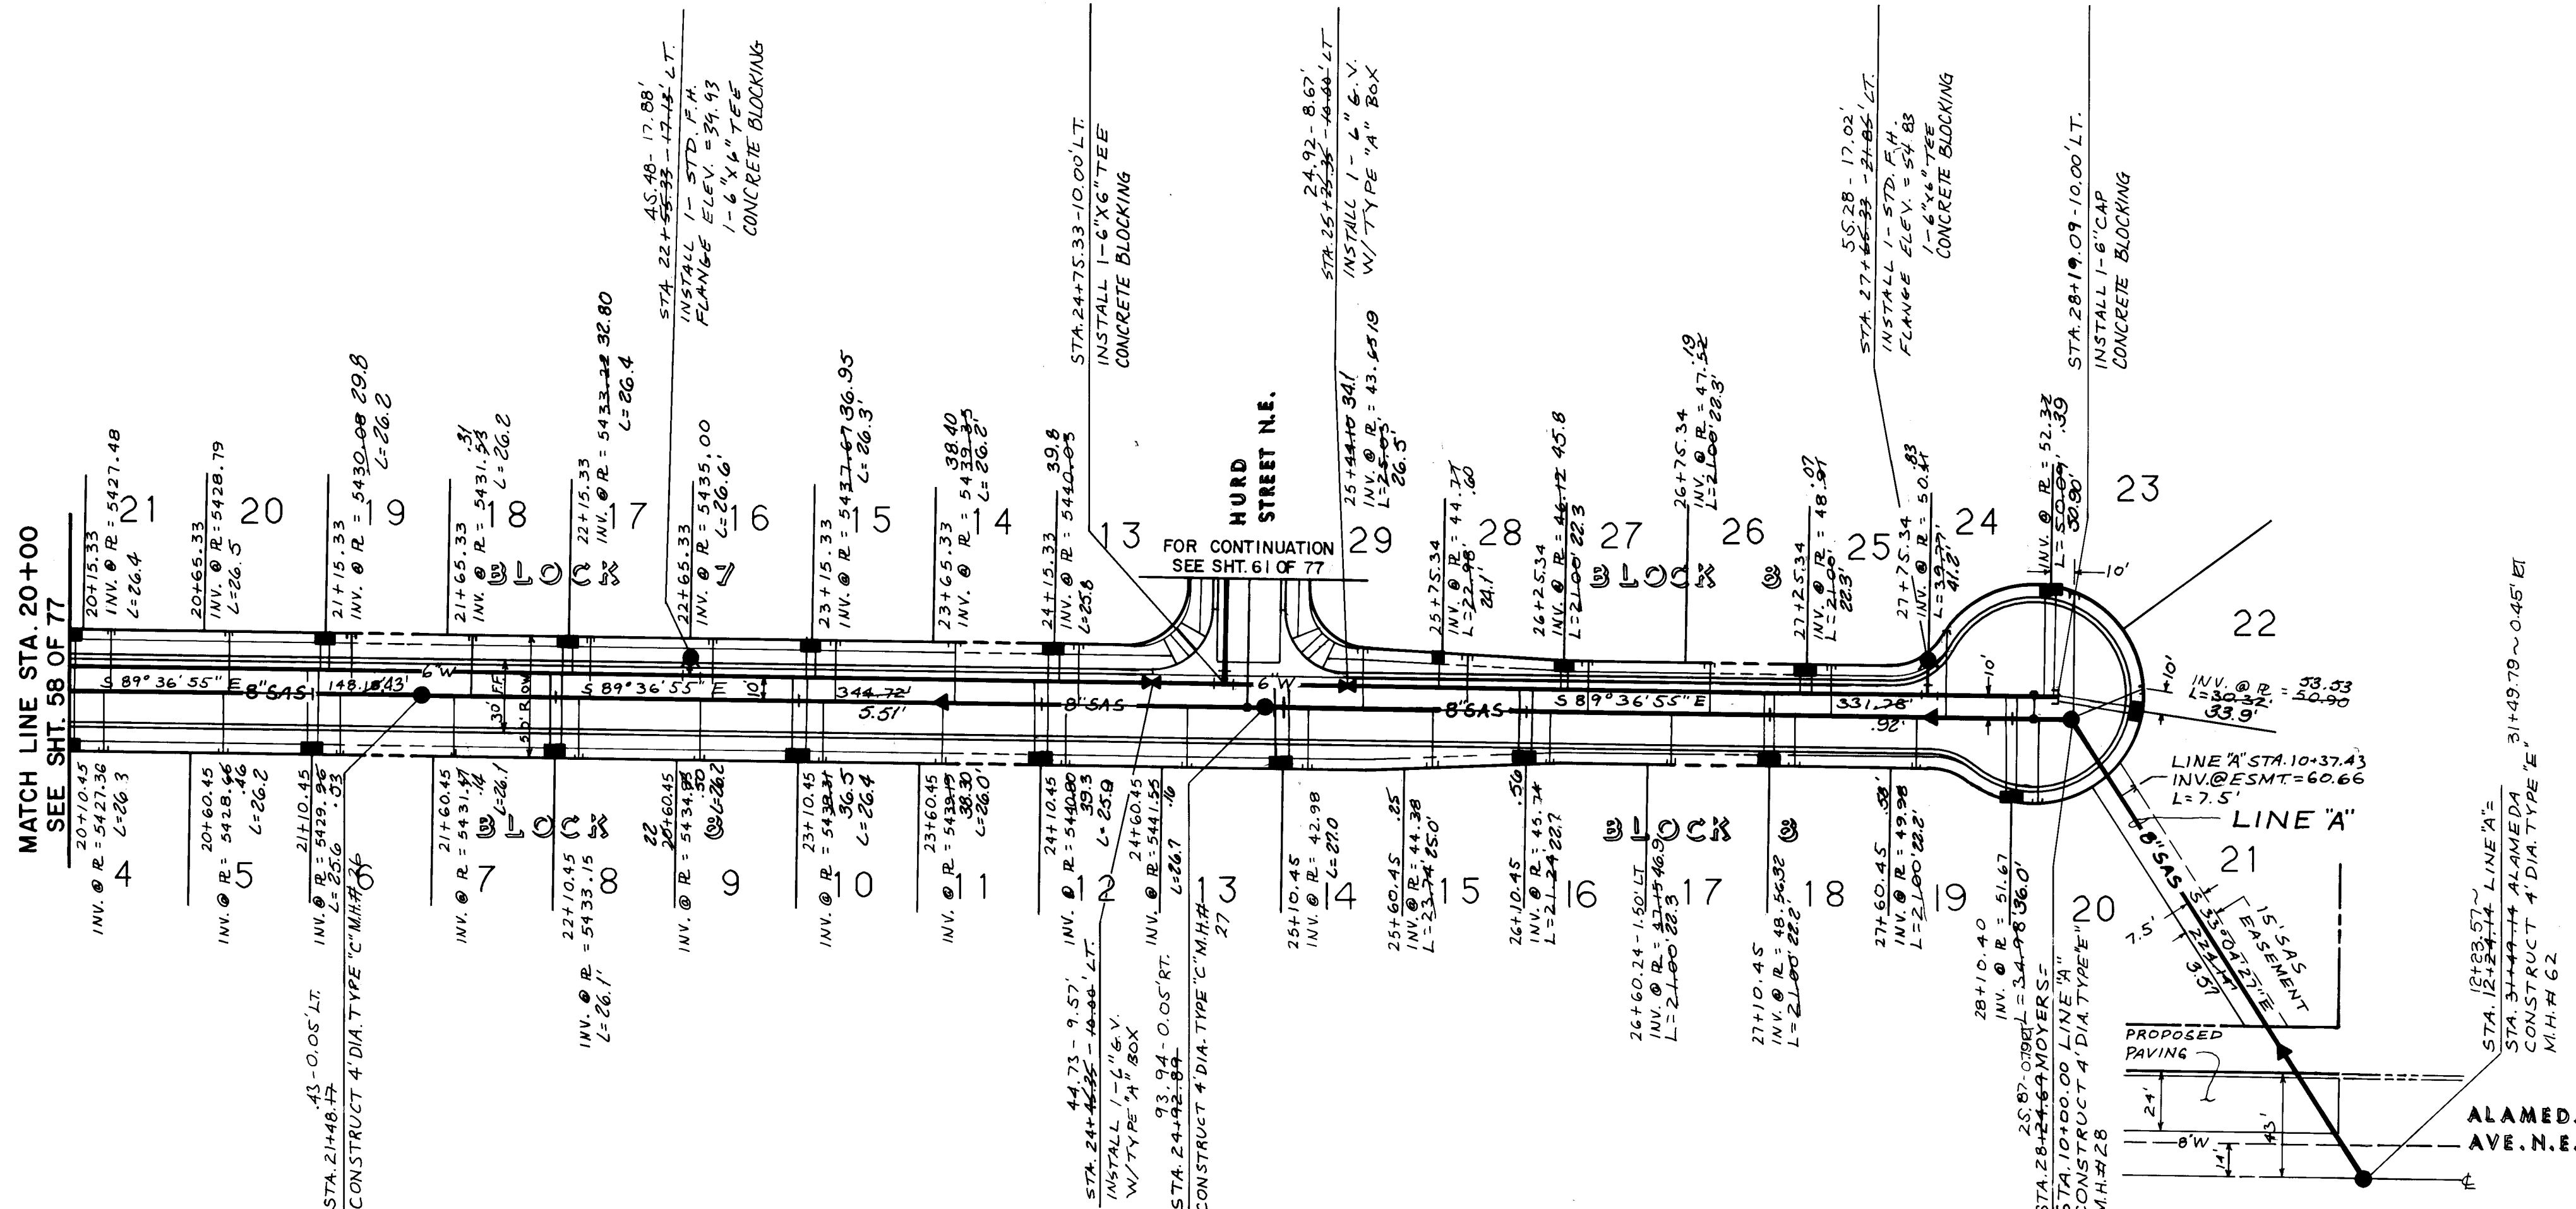



	PROPOSED WATERLINE
	PROPOSED GATE VALVE
	PROPOSED FIRE HYDRANT
	PROPOSED CAP OR PLUG
	PROPOSED SINGLE METER, WATER SERVICE LINE
	PROPOSED DOUBLE METER, WATER SERVICE LINES
	PROPOSED CROSS, TEE, OR ELBOW
	PROPOSED SANITARY SEWER LINE
	PROPOSED MANHOLE
	PROPOSED CAP OR PLUG
	PROPOSED SANITARY SEWER SERVICE LINE
	PROPERTY OR BOUNDARY LINE
	CENTERLINE OF STREET
	CURB AND GUTTER
	SIDEWALK

**ESPEY,
HUSTON &
ASSOCIATES, INC.**
Engineering & Environmental Consultants

**317 COMMERCIAL ST. N.E.
ALBUQUERQUE, NEW MEXICO 87102
PHONE: (505) 242-1909**

CITY OF ALBUQUERQUE
PUBLIC WORKS DEPARTMENT
ENGINEERING GROUP

TITLE:	NOR ESTE ESTATES MOYERS AVE. N.E. STA.20+00.00 TO STA. 28+40.33
--------	---

APPROVALS	ENGINEER	DATE	APPROVALS	ENGINEER	DATE
D.R.C Chair	<i>Andie Hink</i>	10/5/07			
Trans Dev	WADWH	9/16/07			
Utility Dev	<i>JE Estepand</i>	8/31/07			
Hydro	WADWH	9-1-07			

DRAWING NO.	MAP NO.	SHEET OF
3186	C-19	59 77

WATER AND SANITARY SEWER					DATE
DATE					
1.	ALL STATIONING AND OFFSET DIMENSIONS ARE BASED ON CENTERLINE OF RIGHT-OF-WAY.				
2.	THE FOLLOWING CITY OF ALBUQUERQUE STANDARD DRAWINGS ARE APPLICABLE TO THE WATER AND SANITARY SEWER CONSTRUCTION:				
2102	2145	2326	2344	2362	
2110	2315	2328	2347	2366	
2118	2320	2335	2360	2368	
2125	2325	2340	2361	2369	

RECORD DRAWING

This drawing as modified shows public improvements as constructed and as shown on this drawing. All engineering information and measurements obtained by EHA's field surveys were the property of EHA and are to be used only for the project created by the Contractor and City Inspector. The modifications conform to the mining requirements for record drawing Development Projects. EHA's field surveys are to be used only for knowledge and belief. EHA is not responsible for the accuracy of the information.

ALL SERVICES THIS SHEET "C" 25'
UNLESS NOTED OTHERWISE.

DATE 3-14-88

Dennis A. Lorenz P.E. 9647

REGISTERED PROFESSIONAL ENGINEER
STATE OF CALIFORNIA
NO. 9647

INFORMATION

FIELD NOTES

DATE

BY


BENCH MARKS

THE STATION IS LOCATED 9 MILES NORTHEAST OF DOWNTOWN ALBUQUERQUE. TO REACH THE STATION FROM THE INTERSECTION OF LOUISIANA BLVD. AND LOS ANGELES DRIVE, GO EAST ON LOS ANGELES DRIVE 10 MILES TO BARTOW ST., THEN NORTH ON BARTOW ST. 1.0 MILES TO ALAMEDA AVE. THE STATION IS LOCATED IN THE NORTHEAST QUADRANT OF THE INTERSECTION. THE STATION MARK IS A STANDARD ACS BRASS TABLET STAMPED "1-820", SET IN TOP OF A CONCRETE POST PROJECTING 0.1 FEET ABOVE GROUND.

NO. 9647

LEGEND

 —W— PROPOSED WATERLINE

	PROPOSED GATE VALVE	
	PROPOSED FIRE HYDRANT	
	PROPOSED CAP OR PLUG	
	PROPOSED SINGLE METER, WATER SERVICE LINE	
	PROPOSED DOUBLE METER, WATER SERVICE LINES	
	PROPOSED CROSS, TEE, OR ELBOW	
	PROPOSED SANITARY SEWER LINE	
	PROPOSED MANHOLE	


		PROPOSED CAP OR PLUG PROPOSED SANITARY SEWER SERVICE LINE PROPERTY OR BOUNDARY LINE CENTERLINE OF STREET CURB AND GUTTER SIDEWALK	
1 2 3 4 5 6 7 8 9 10 11 12 26 31865988 A B C D E F G H I J K L M N O P Q R S T U V W X Y Z		DESIGNED BY EHS DRAWN BY MS/SP/NC CHECKED BY BA	
ESPEY, HUSTON & ASSOCIATES, INC. Engineering & Environmental Consultants.		317 COMMERCIAL ST. N.E. ALBUQUERQUE, NEW MEXICO 87102 PHONE: (505) 242-1909	
NO. DATE		REMARKS REVISIONS DESIGN	
BY		DATE	
6/18/7		DATE	
8/18/7		DATE	

CITY OF ALBUQUERQUE
PUBLIC WORKS DEPARTMENT
ENGINEERING GROUP

TITLE:	NOR ESTE ESTATES MOYERS AVE. N.E. STA.20+00.00 TO STA. 28+40.33
--------	---

APPROVALS	ENGINEER	DATE	APPROVALS	ENGINEER	DATE
D.R.C Chair	<i>Andie Hink</i>	10/5/07			
Trans Dev	WADWH	9/16/07			
Utility Dev	<i>JE Estepand</i>	8/31/07			
Hydro	WADWH	9-1-07			

DRAWING NO.	MAP NO.	SHEET OF
3186	C-19	59 77

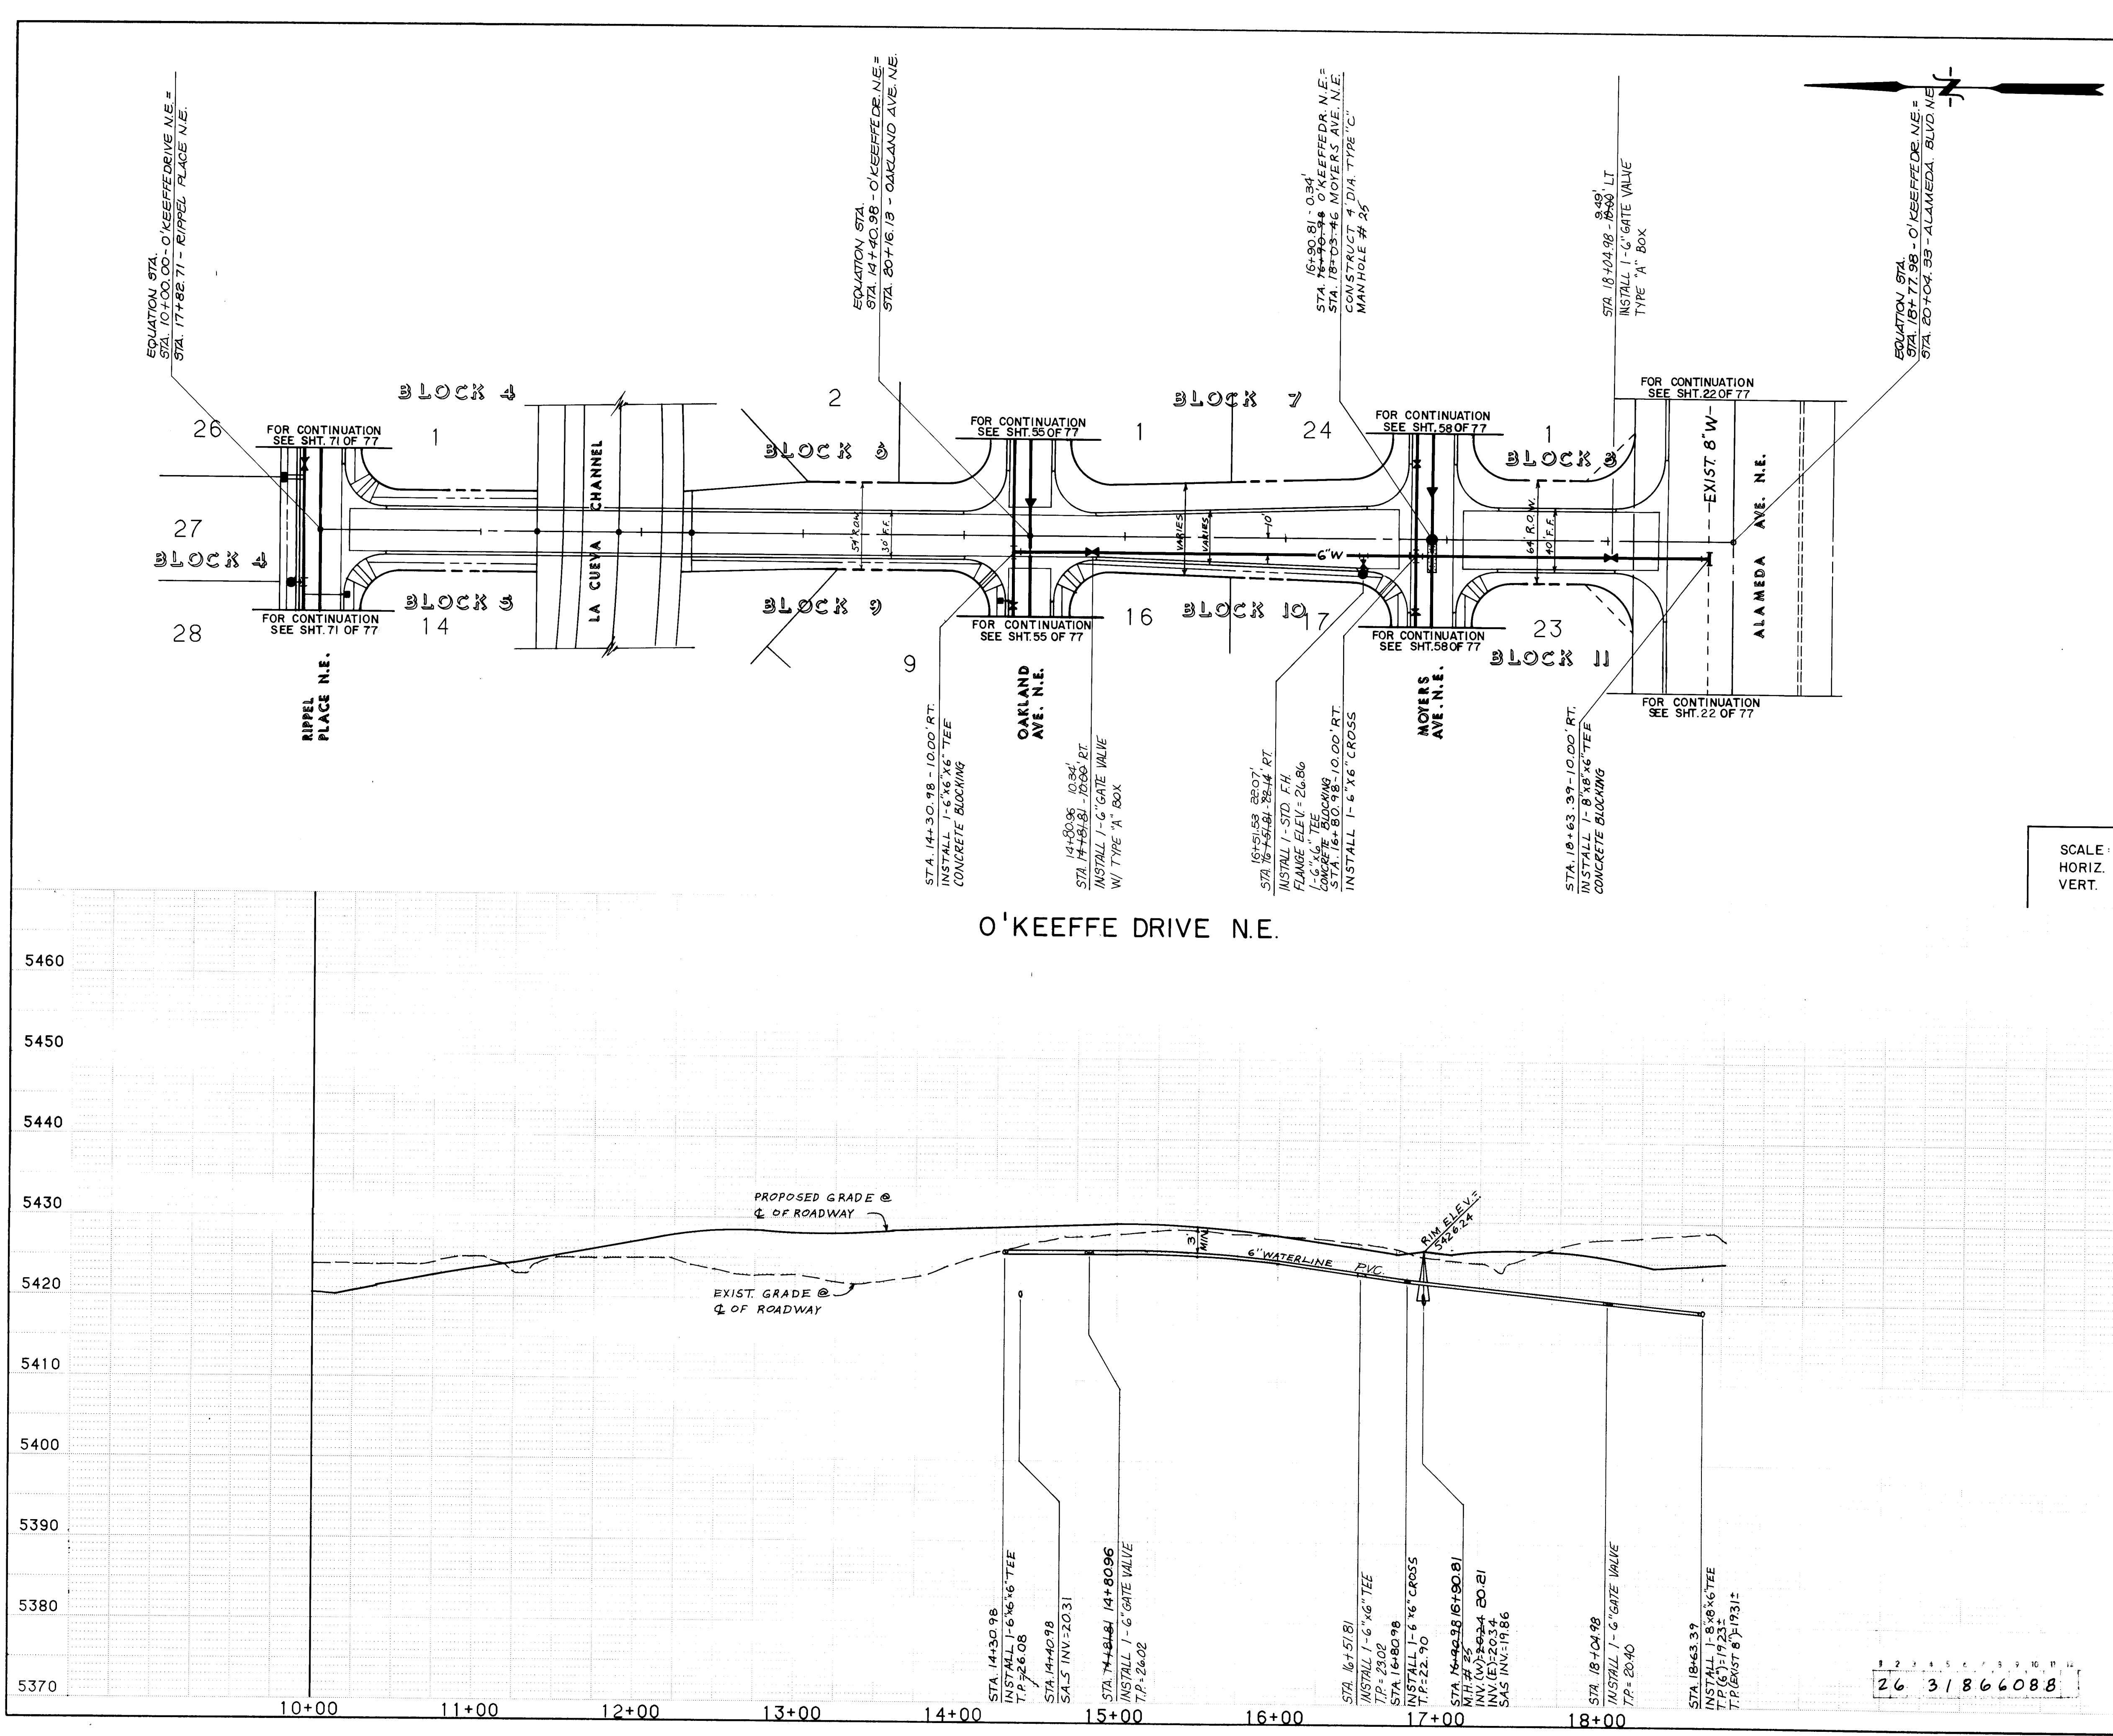

WATER AND SANITARY SEWER

1. ALL STATIONING AND OFFSET DIMENSIONS ARE BASED ON CENTERLINE OF RIGHT-OF-WAY.

2. THE FOLLOWING CITY OF ALBUQUERQUE STANDARD DRAWINGS ARE APPLICABLE TO THE WATER AND SANITARY SEWER CONSTRUCTION:

2102	2145	2326	2344	2362
2110	2315	2328	2347	2366
2118	2320	2335	2360	2368
2125	2325	2340	2361	2369

RECORD DRAWING

This drawing as modified shows public improvements as constructed. These modifications have been made using information and measurements obtained by EHA's field survey information. The modifications are for the purpose of conforming to the minimum requirements of the City of Albuquerque as required by the City of Albuquerque per the City Engineer and the City Engineer's Office.

Dennis A. Lorenz
Dennis A. Lorenz P.E. 3617

DATE: 3-14-88

LEGEND

—W—	PROPOSED WATERLINE
—X—	PROPOSED GATE VALVE
—F—	PROPOSED FIRE HYDRANT
—C—	PROPOSED CAP OR PLUG
—S—	PROPOSED SINGLE METER, WATER SERVICE LINE
—D—	PROPOSED DOUBLE METER, WATER SERVICE LINES
—SAS—	PROPOSED CROSS, TEE, OR ELBOW
—S—	PROPOSED SANITARY SEWER LINE
—M—	PROPOSED MANHOLE
—C—	PROPOSED CAP OR PLUG
—S—	PROPOSED SANITARY SEWER SERVICE LINE
---	PROPERTY OR BOUNDARY LINE
---	CENTERLINE OF STREET
---	CURB AND GUTTER
---	SIDEWALK

SCALE:
HORIZ. 1" = 50'
VERT. 1" = 10'

ENGINEER'S SEAL

Dennis A. Lorenz
Dennis A. Lorenz P.E. 3617

ESPEY, HUSTON & ASSOCIATES, INC.
Engineering & Environmental Consultants
317 COMMERCIAL ST. N.E.
ALBUQUERQUE, NEW MEXICO 87102
PHONE: (505) 242-1909



CITY OF ALBUQUERQUE
PUBLIC WORKS DEPARTMENT
ENGINEERING GROUP

TITLE: NOR ESTE ESTATES
O'KEEFFE DRIVE N.E.
STA. 10+00.00 TO STA. 18+77.98

APPROVALS	ENGINEER	DATE	APPROVALS	ENGINEER	DATE
D.R.C. Chair	<i>[Signature]</i>	01/5/87			
Trans. Dev.	<i>[Signature]</i>	7/16/87			
Utility Dev.	<i>[Signature]</i>	8/1/87			

DESIGNED BY: *[Signature]*
DRAWN BY: *[Signature]*
CHECKED BY: *[Signature]*

DRAWING NO. 3186
MAP NO. C-19
SHEET 60 OF 77

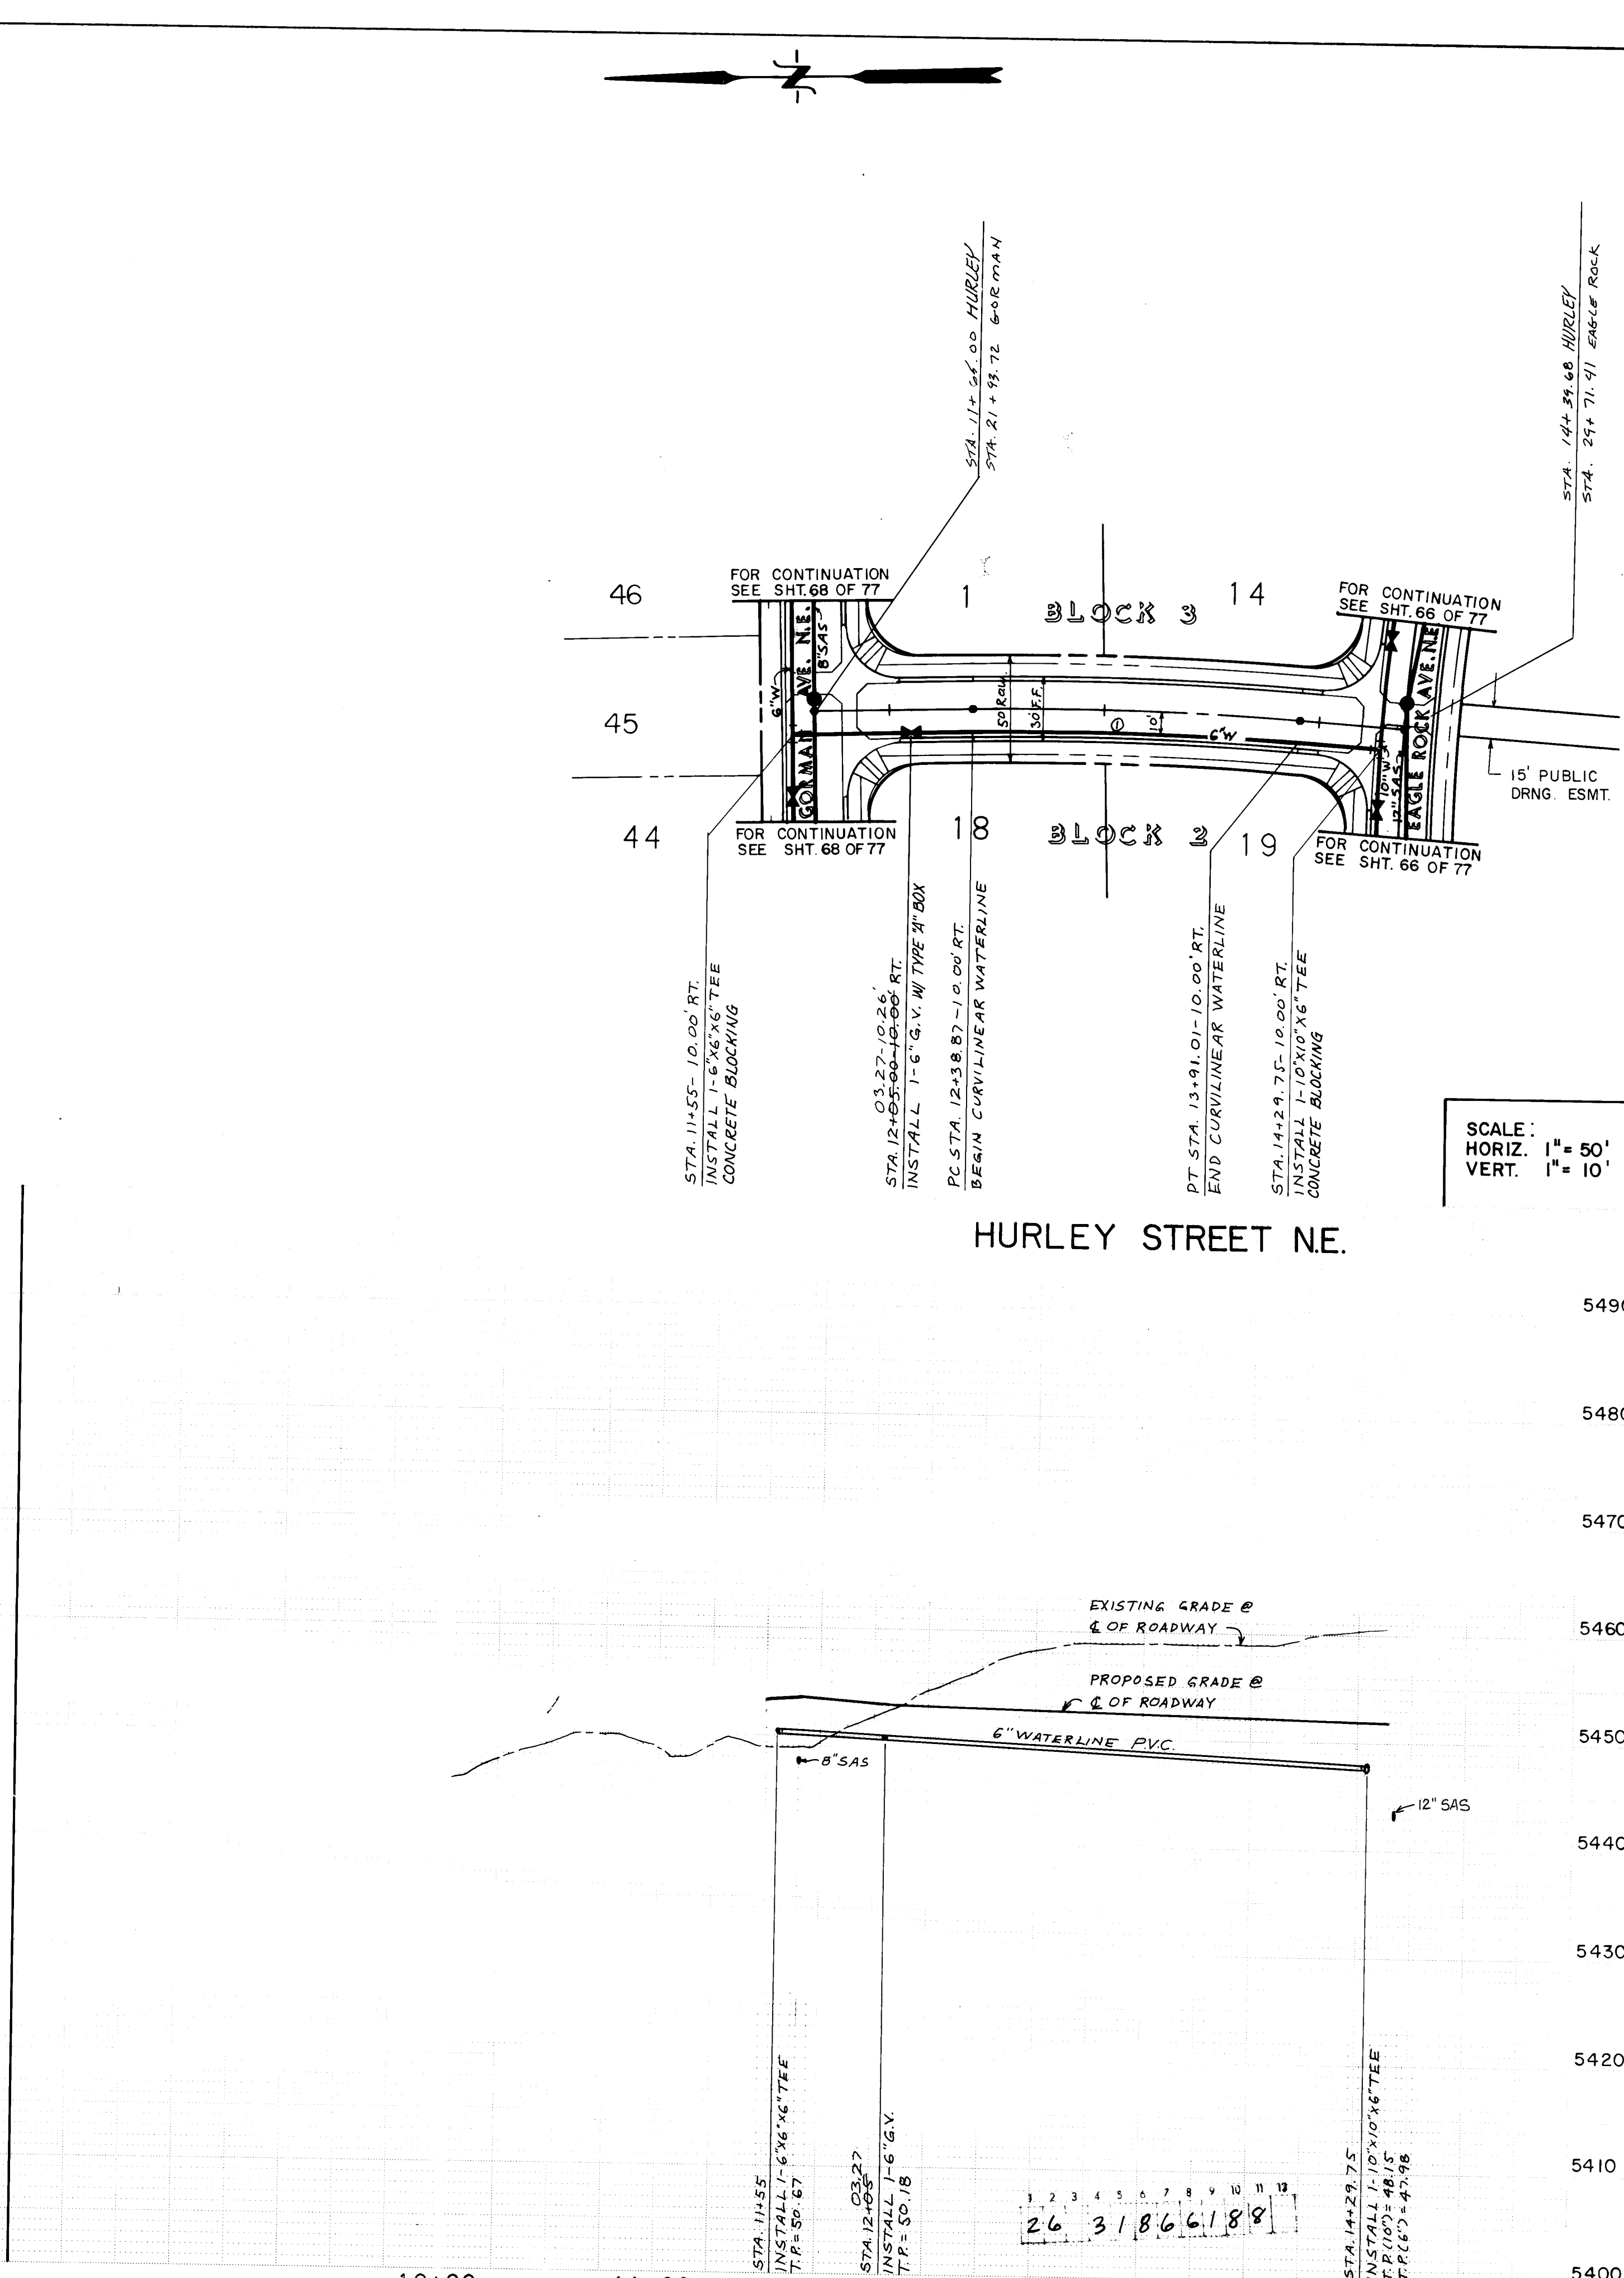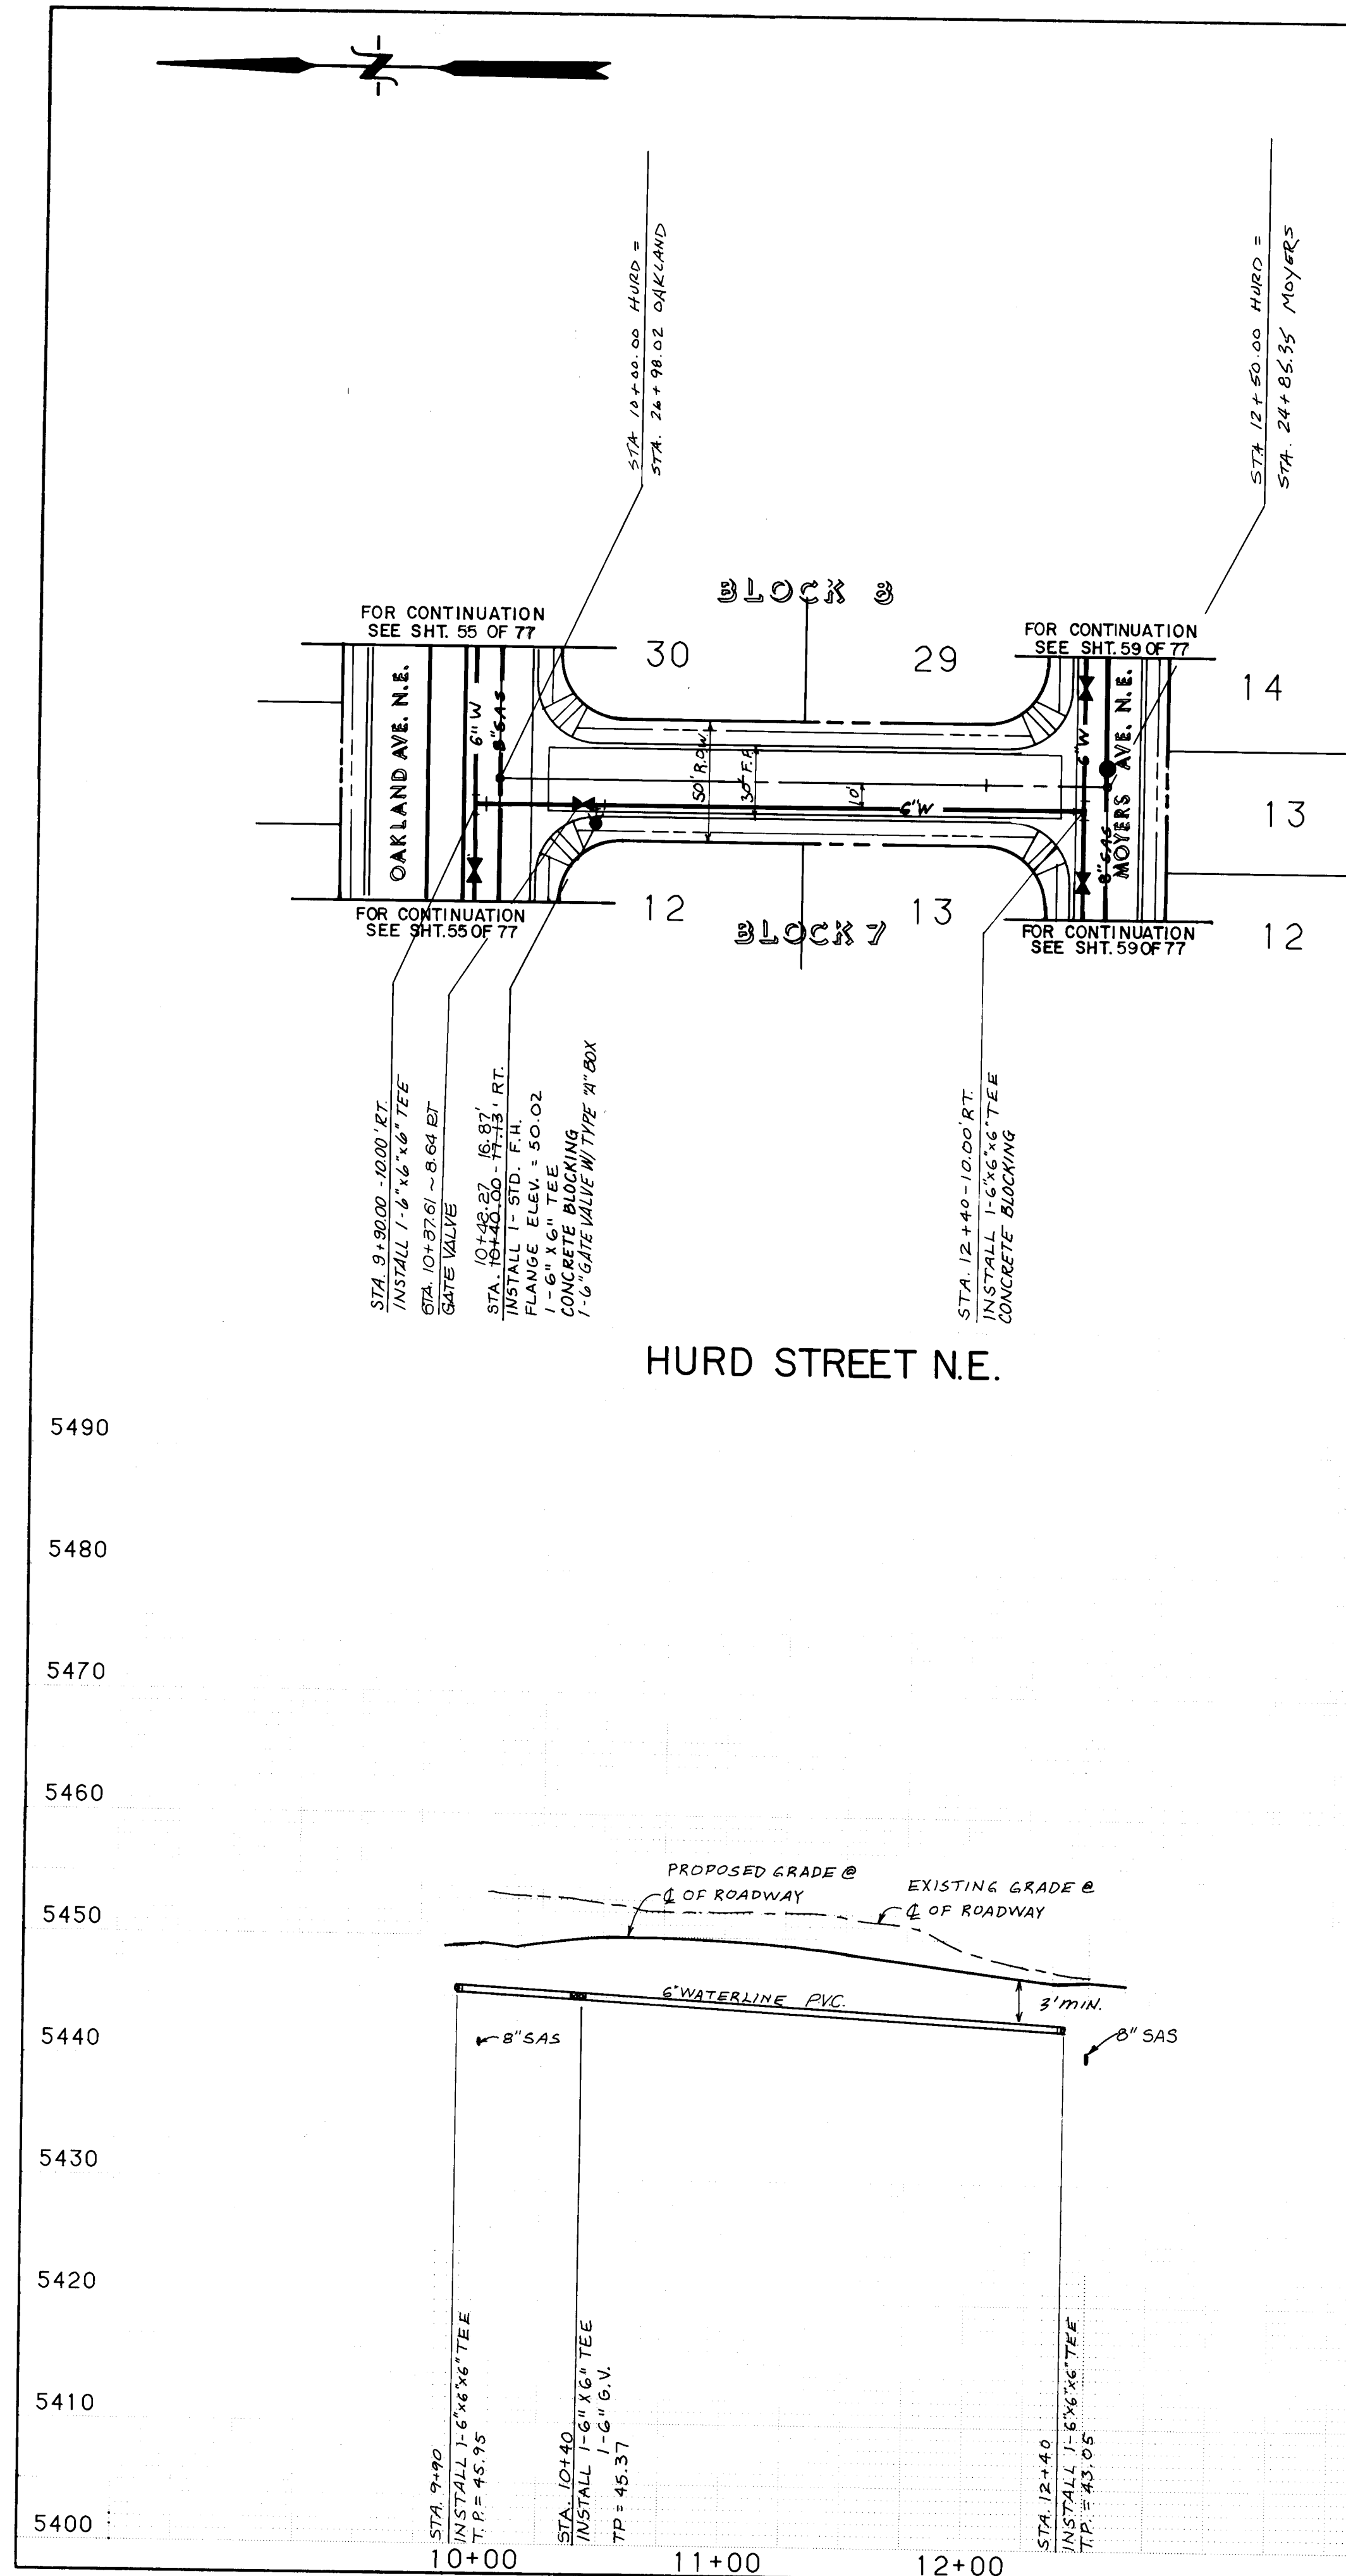

NO. DELTA 5°33'12" RADIUS 1559.61 LENGTH 151.16 TAN. 75°64'

WATER AND SANITARY SEWER

1. ALL STATIONING AND OFFSET DIMENSIONS ARE BASED ON CENTERLINE OF RIGHT-OF-WAY.

2. THE FOLLOWING CITY OF ALBUQUERQUE STANDARD DRAWINGS ARE APPLICABLE TO THE WATER AND SANITARY SEWER CONSTRUCTION:

2102	2145	2326	2344	2362
2110	2315	2328	2347	2366
2118	2320	2335	2360	2368
2125	2325	2340	2361	2369

RECORD DRAWING

This drawing as modified shows public improvements as constructed. These modifications have been made using information and measurements obtained by EHA's field survey and the City of Albuquerque's engineering department. The modifications are subject to the City of Albuquerque's engineering department's review and approval. The City of Albuquerque's engineering department is not responsible for any errors or omissions in this drawing.

Dennis A. Lorenz P.E. 3-14-88

LEGEND

PROPOSED WATERLINE	PROPOSED GATE VALVE	PROPOSED FIRE HYDRANT	PROPOSED CAP OR PLUG	PROPOSED SINGLE METER, WATER SERVICE LINE	PROPOSED DOUBLE METER, WATER SERVICE LINES	PROPOSED CROSS, TEE, OR ELBOW	PROPOSED SANITARY SEWER LINE	PROPOSED MANHOLE	PROPOSED CAP OR PLUG	PROPOSED SANITARY SEWER SERVICE LINE	PROPERTY OR BOUNDARY LINE	CENTERLINE OF STREET	CURB AND GUTTER	SIDEWALK
--------------------	---------------------	-----------------------	----------------------	---	--	-------------------------------	------------------------------	------------------	----------------------	--------------------------------------	---------------------------	----------------------	-----------------	----------

ESPEY, HUSTON & ASSOCIATES, INC.
Engineering & Environmental Consultants
317 COMMERCIAL ST. N.E.
ALBUQUERQUE, NEW MEXICO 87102
PHONE: (505) 242-1909

CITY OF ALBUQUERQUE
PUBLIC WORKS DEPARTMENT
ENGINEERING GROUP


TITLE: NOR ESTE ESTATES
HURD STREET N.E. / HURLEY STREET N.E.
STA. 10+00.00 TO STA. 12+50.00 / STA. 11+65.00 TO STA. 14+39.68

APPROVALS	ENGINEER	DATE	APPROVALS	ENGINEER	DATE
D.R.C. Chair	10/5/87				
Trans. Dev.	9/14/87				
Utility Dev.	9/14/87				

DESIGNED BY: EHA
DRAWN BY: S.S. SANCHEZ
CHECKED BY: P.A.L.

DATE: 6/87
DATE: 8/87
DATE: 8/87

DRAWING NO. 3186 MAP NO. C-19 SHEET 61 OF 77

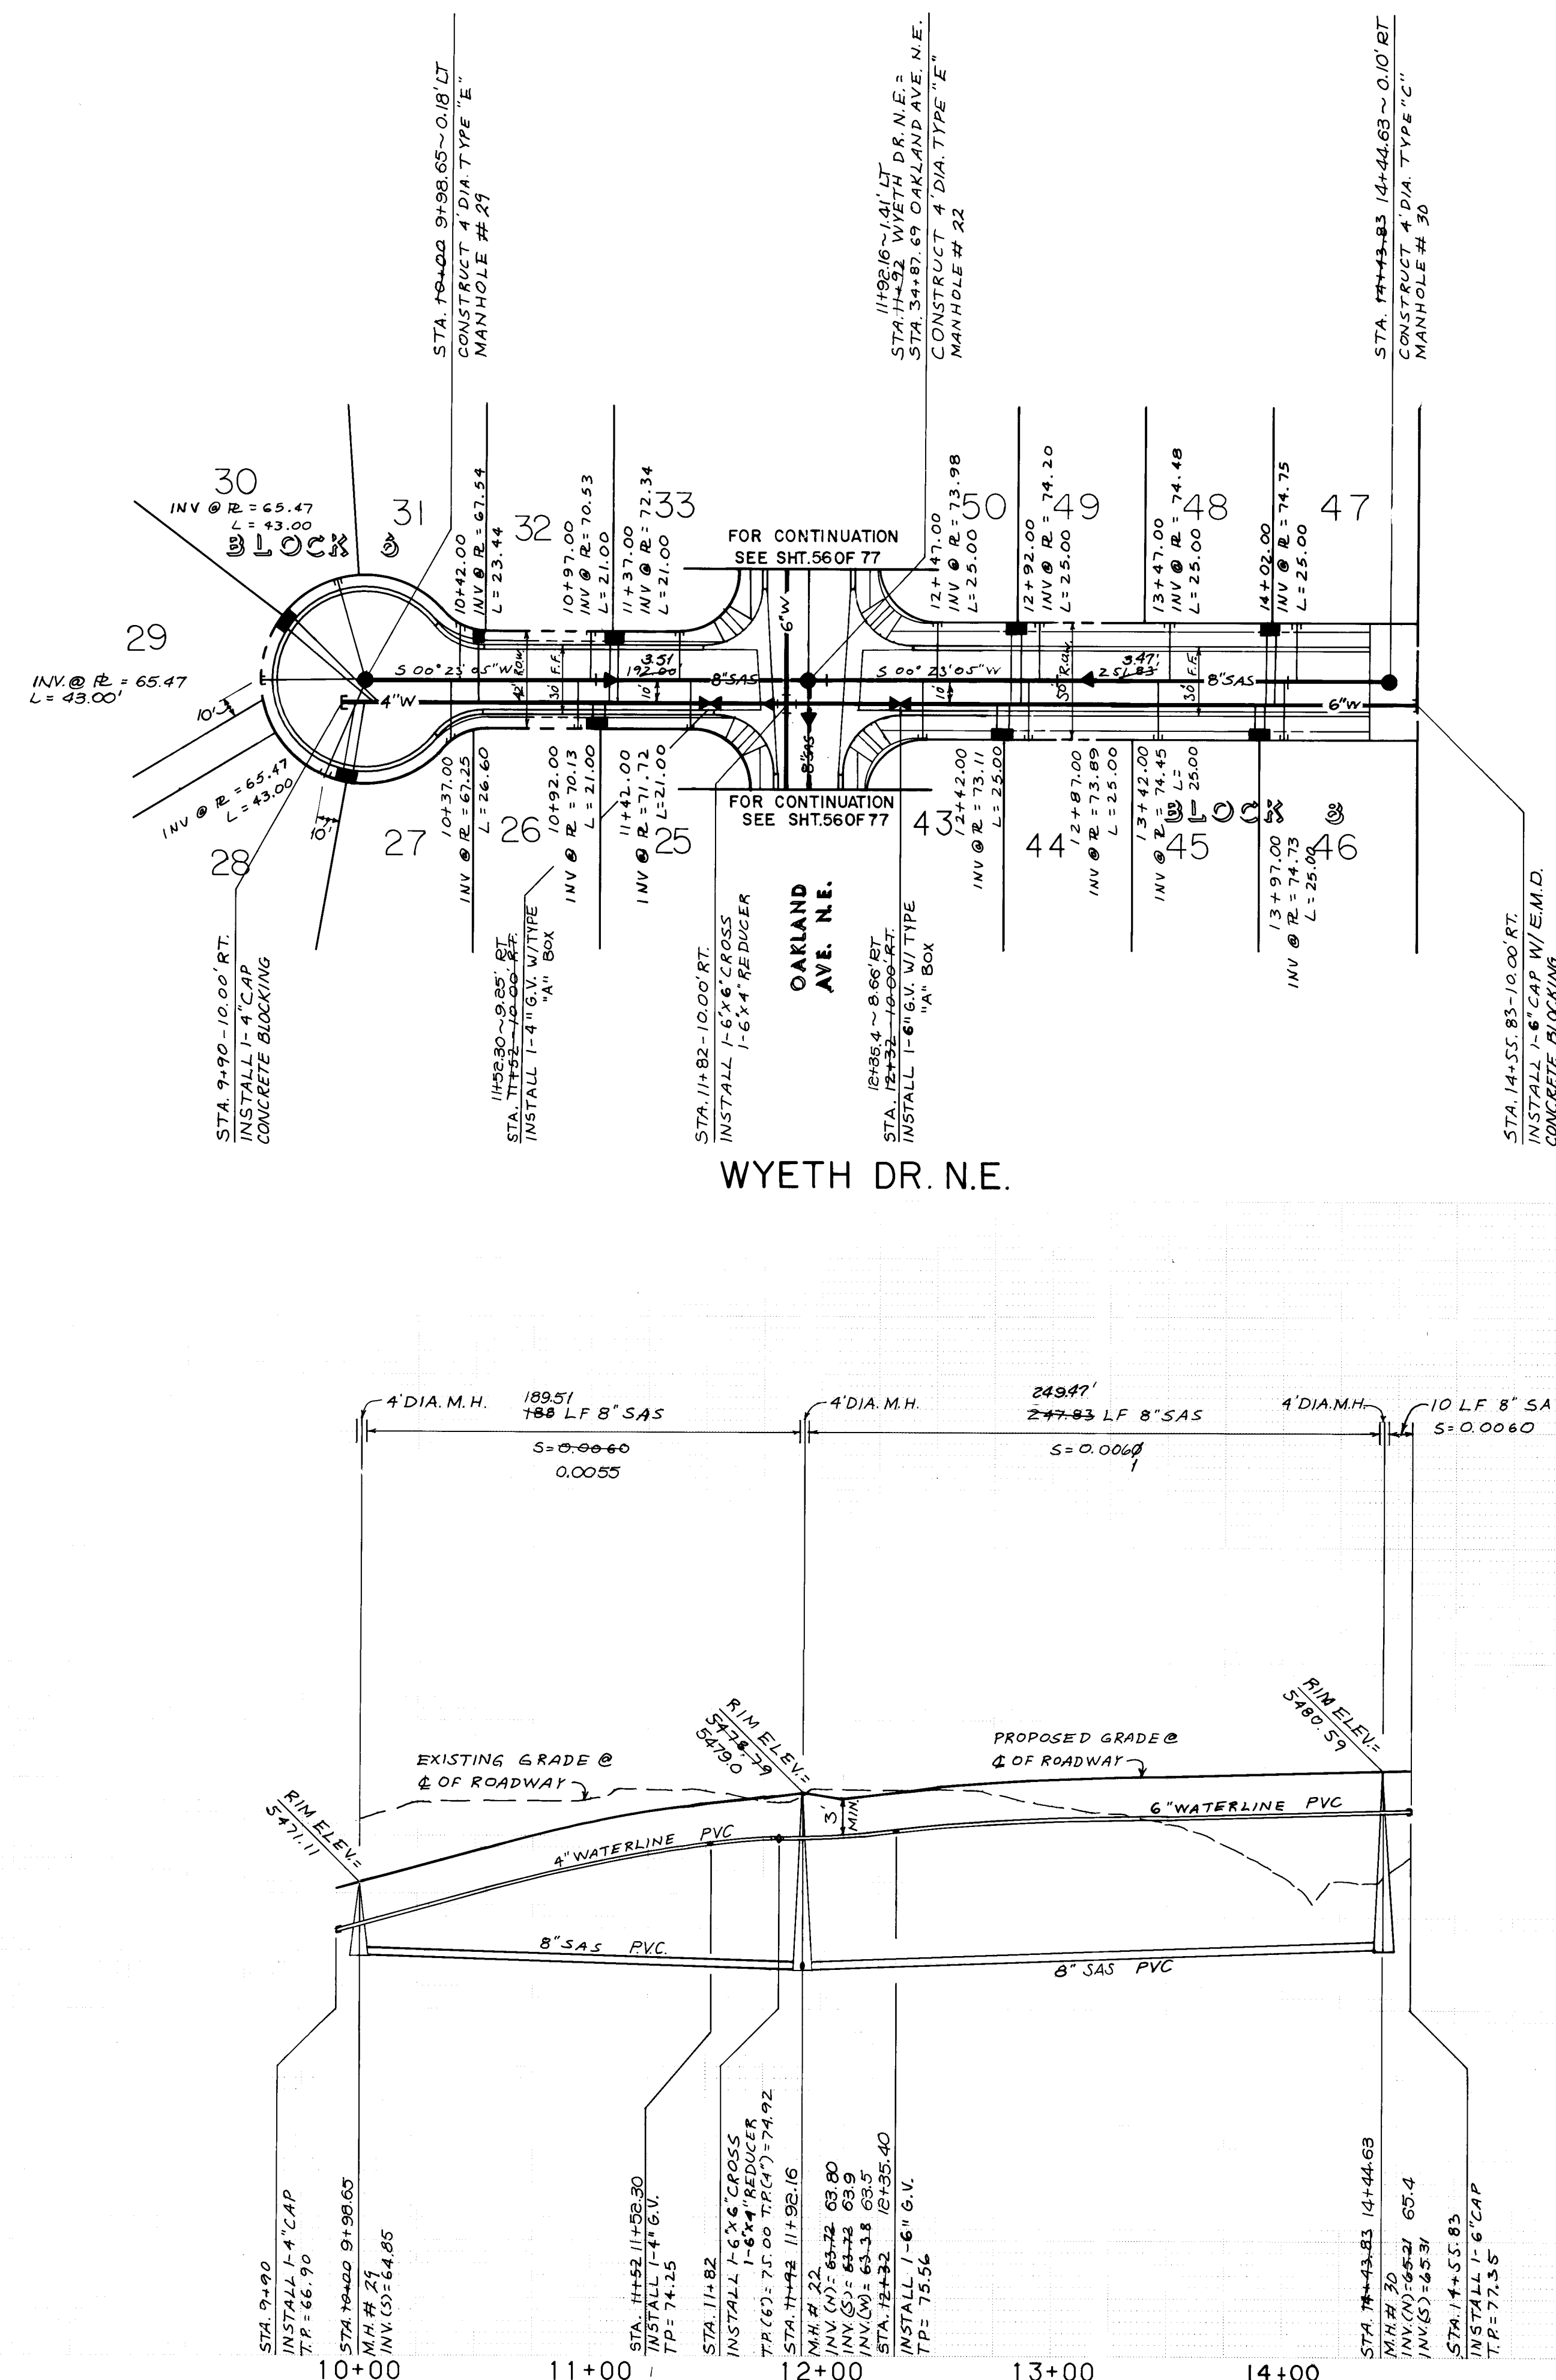

WYETH DR. N.E.

SCALE :
HORIZ. 1" = 50'
VERT. 1" = 10'

1	2	3	4	5	6	7	8	9	10	11	12
26	31	8	6	6	2	8	8				

WATER AND SANITARY SEWER

1. ALL STATIONING AND OFFSET DIMENSIONS ARE BASED ON CENTERLINE OF RIGHT-OF-WAY.
2. THE FOLLOWING CITY OF ALBUQUERQUE STANDARD DRAWINGS ARE APPLICABLE TO THE WATER AND SANITARY SEWER CONSTRUCTION:

2102	2145	2326	2344	2362
2110	2315	2328	2347	2366
2118	2320	2335	2360	2368
2125	2325	2340	2361	2369

ALL SERVICES THIS SHEET = 25'
UNLESS NOTED OTHERWISE.

RECORD DRAWING

This drawing as modified shows public improvements as constructed. These modifications have been made using information and measurements obtained by CH&A's field survey of the project. The modifications were made in accordance with the minimum requirements for record drawing criteria as required by the City of Albuquerque. Overlaid on this drawing is the C-74 of Albuquerque, New Mexico, Ordinance 1997-001.

100-443887-100
Dennis A. Lorenz P.E. 9647
3-14-88
Date

LEGEND

- | | |
|---|---|
|  | PROPOSED WATERLINE |
|  | PROPOSED GATE VALVE |
|  | PROPOSED FIRE HYDRANT |
|  | PROPOSED CAP OR PLUG |
|  | PROPOSED SINGLE METER,
WATER SERVICE LINE |
|  | PROPOSED DOUBLE METER,
WATER SERVICE LINES |
|  | PROPOSED CROSS, TEE, OR
ELBOW |
|  | PROPOSED SANITARY SEWER
LINE |
|  | PROPOSED MANHOLE |
|  | PROPOSED CAP OR PLUG |
|  | PROPOSED SANITARY SEWER
SERVICE LINE |
|  | PROPERTY OR BOUNDARY
LINE |
|  | CENTERLINE OF STREET |
|  | CURB AND GUTTER |
|  | SIDEWALK |

ESPEY,
HUSTON &
ASSOCIATES, INC.
Engineering & Environmental Consultants



317 COMMERCIAL ST. N.E.
ALBUQUERQUE, NEW MEXICO 87102
PHONE: (505) 242-1909

CITY OF ALBUQUERQUE
PUBLIC WORKS DEPARTMENT
ENGINEERING DIVISION


TITLE:	NOR ESTE ESTATES WYETH DR. N.E. STA.10+00.00 TO STA.14+55.83
--------	--

5440	APPROVALS	ENGINEER	DATE	APPROVALS	ENGINEER	DATE
f	City Engineer	<i>[Signature]</i>	10/5/87	Liquid Waste	<i>JE Eubank</i>	8/31/87
	A C E - Design	" "	" "	Traffic	<i>NADWH</i>	9/16/87
5430	ACE Hydrology	<i>N/A RAB</i>	9-1-87	Water	<i>JE Eubank</i>	8/31/87

DRAWING NO.	3186	MAP NO.	C-19	SHEET	62	OF	77
----------------	------	---------	------	-------	----	----	----

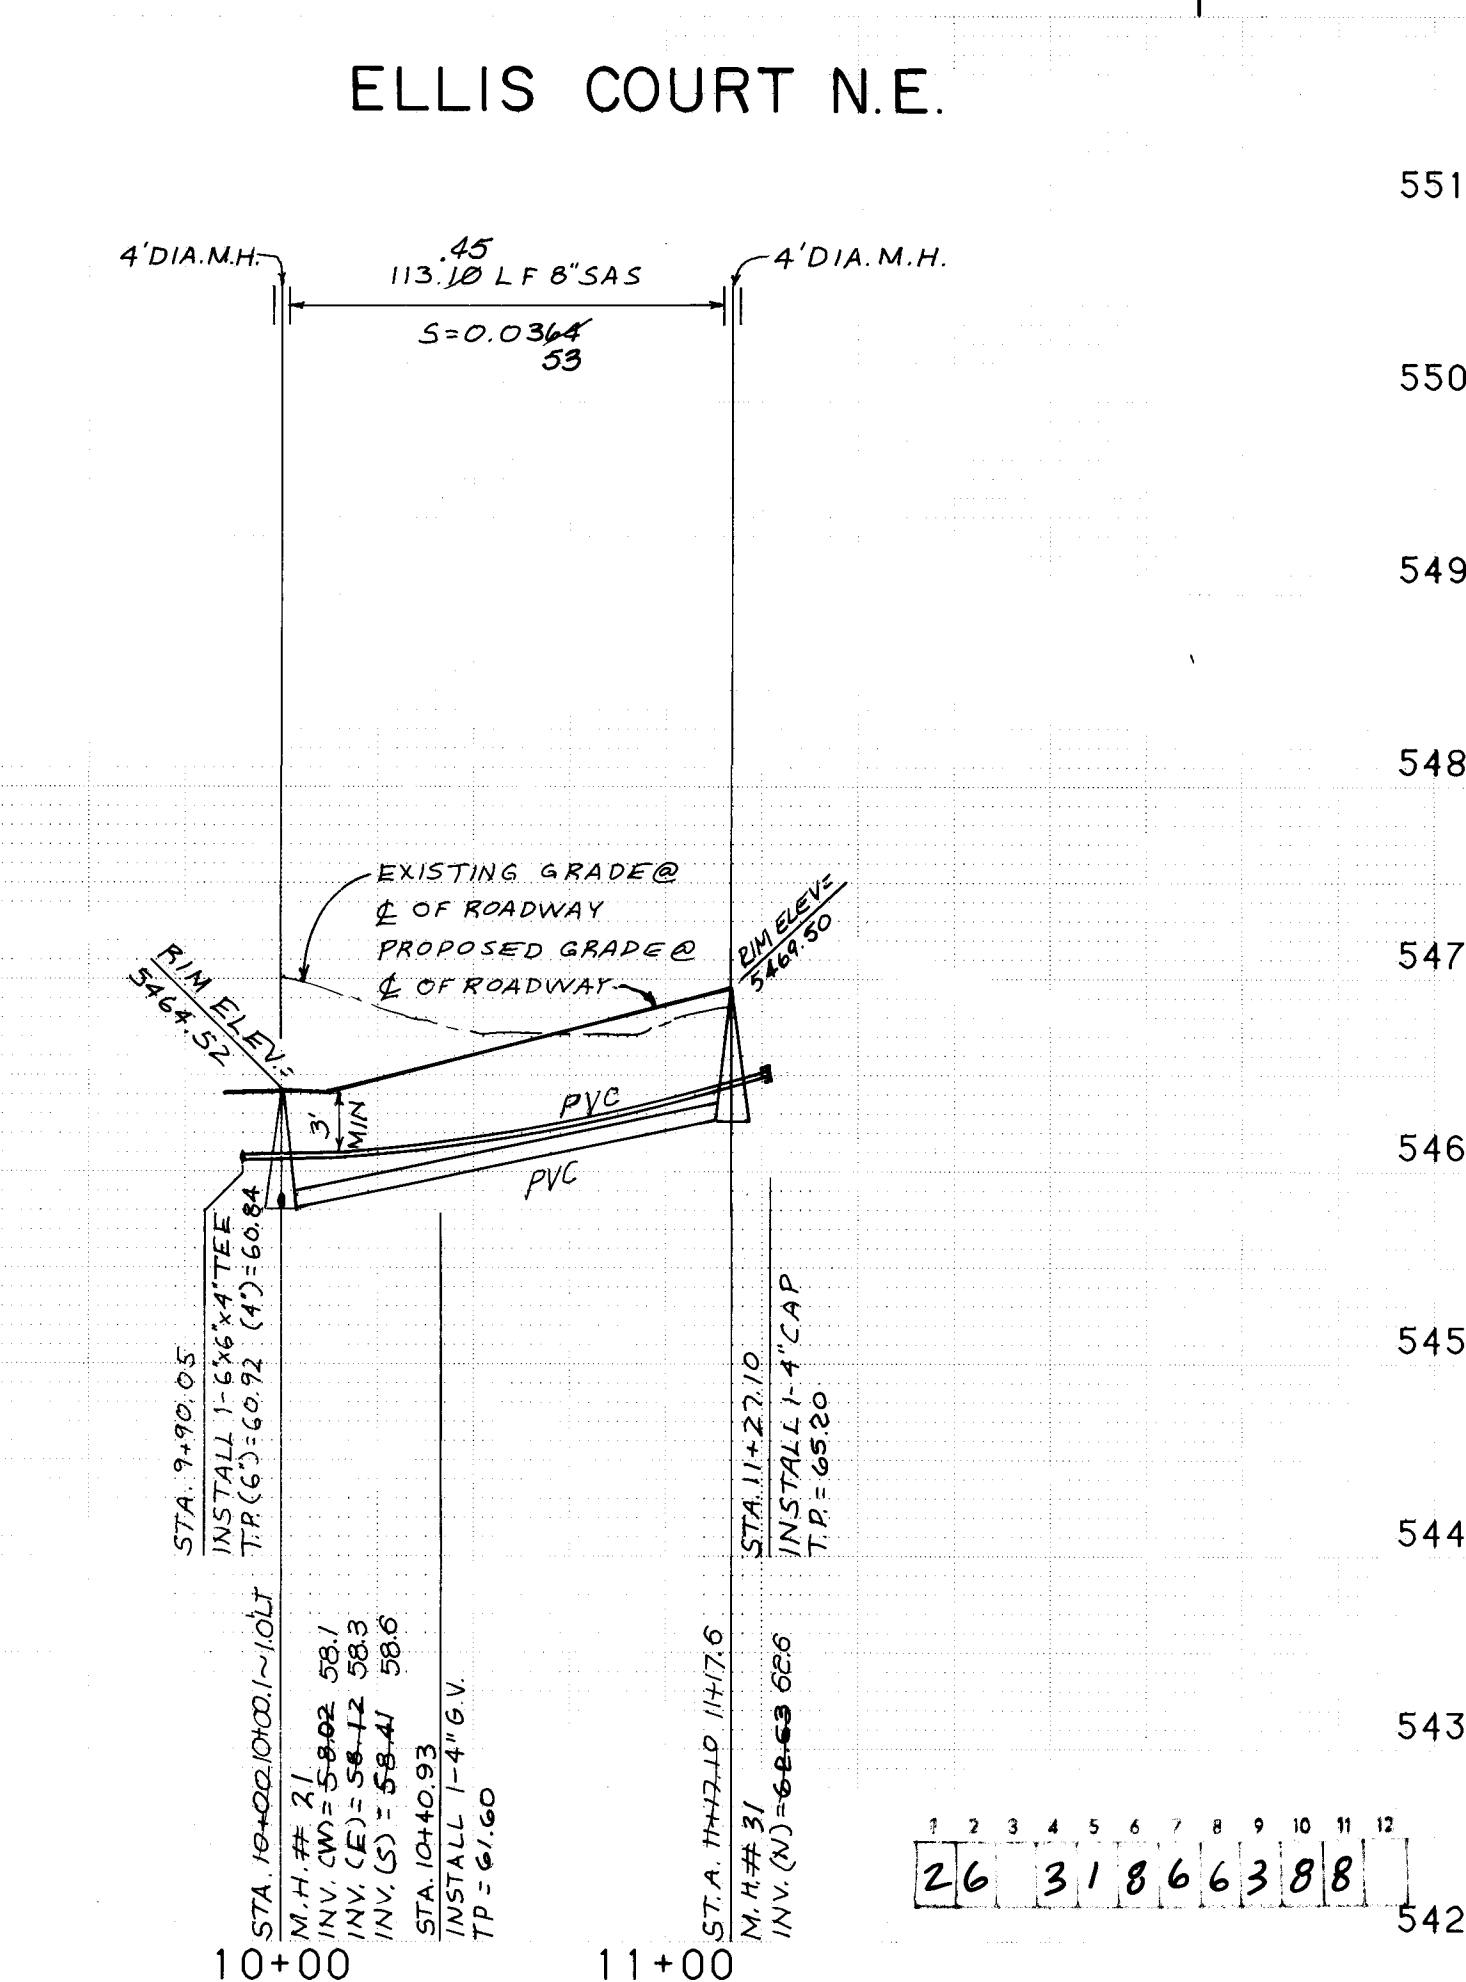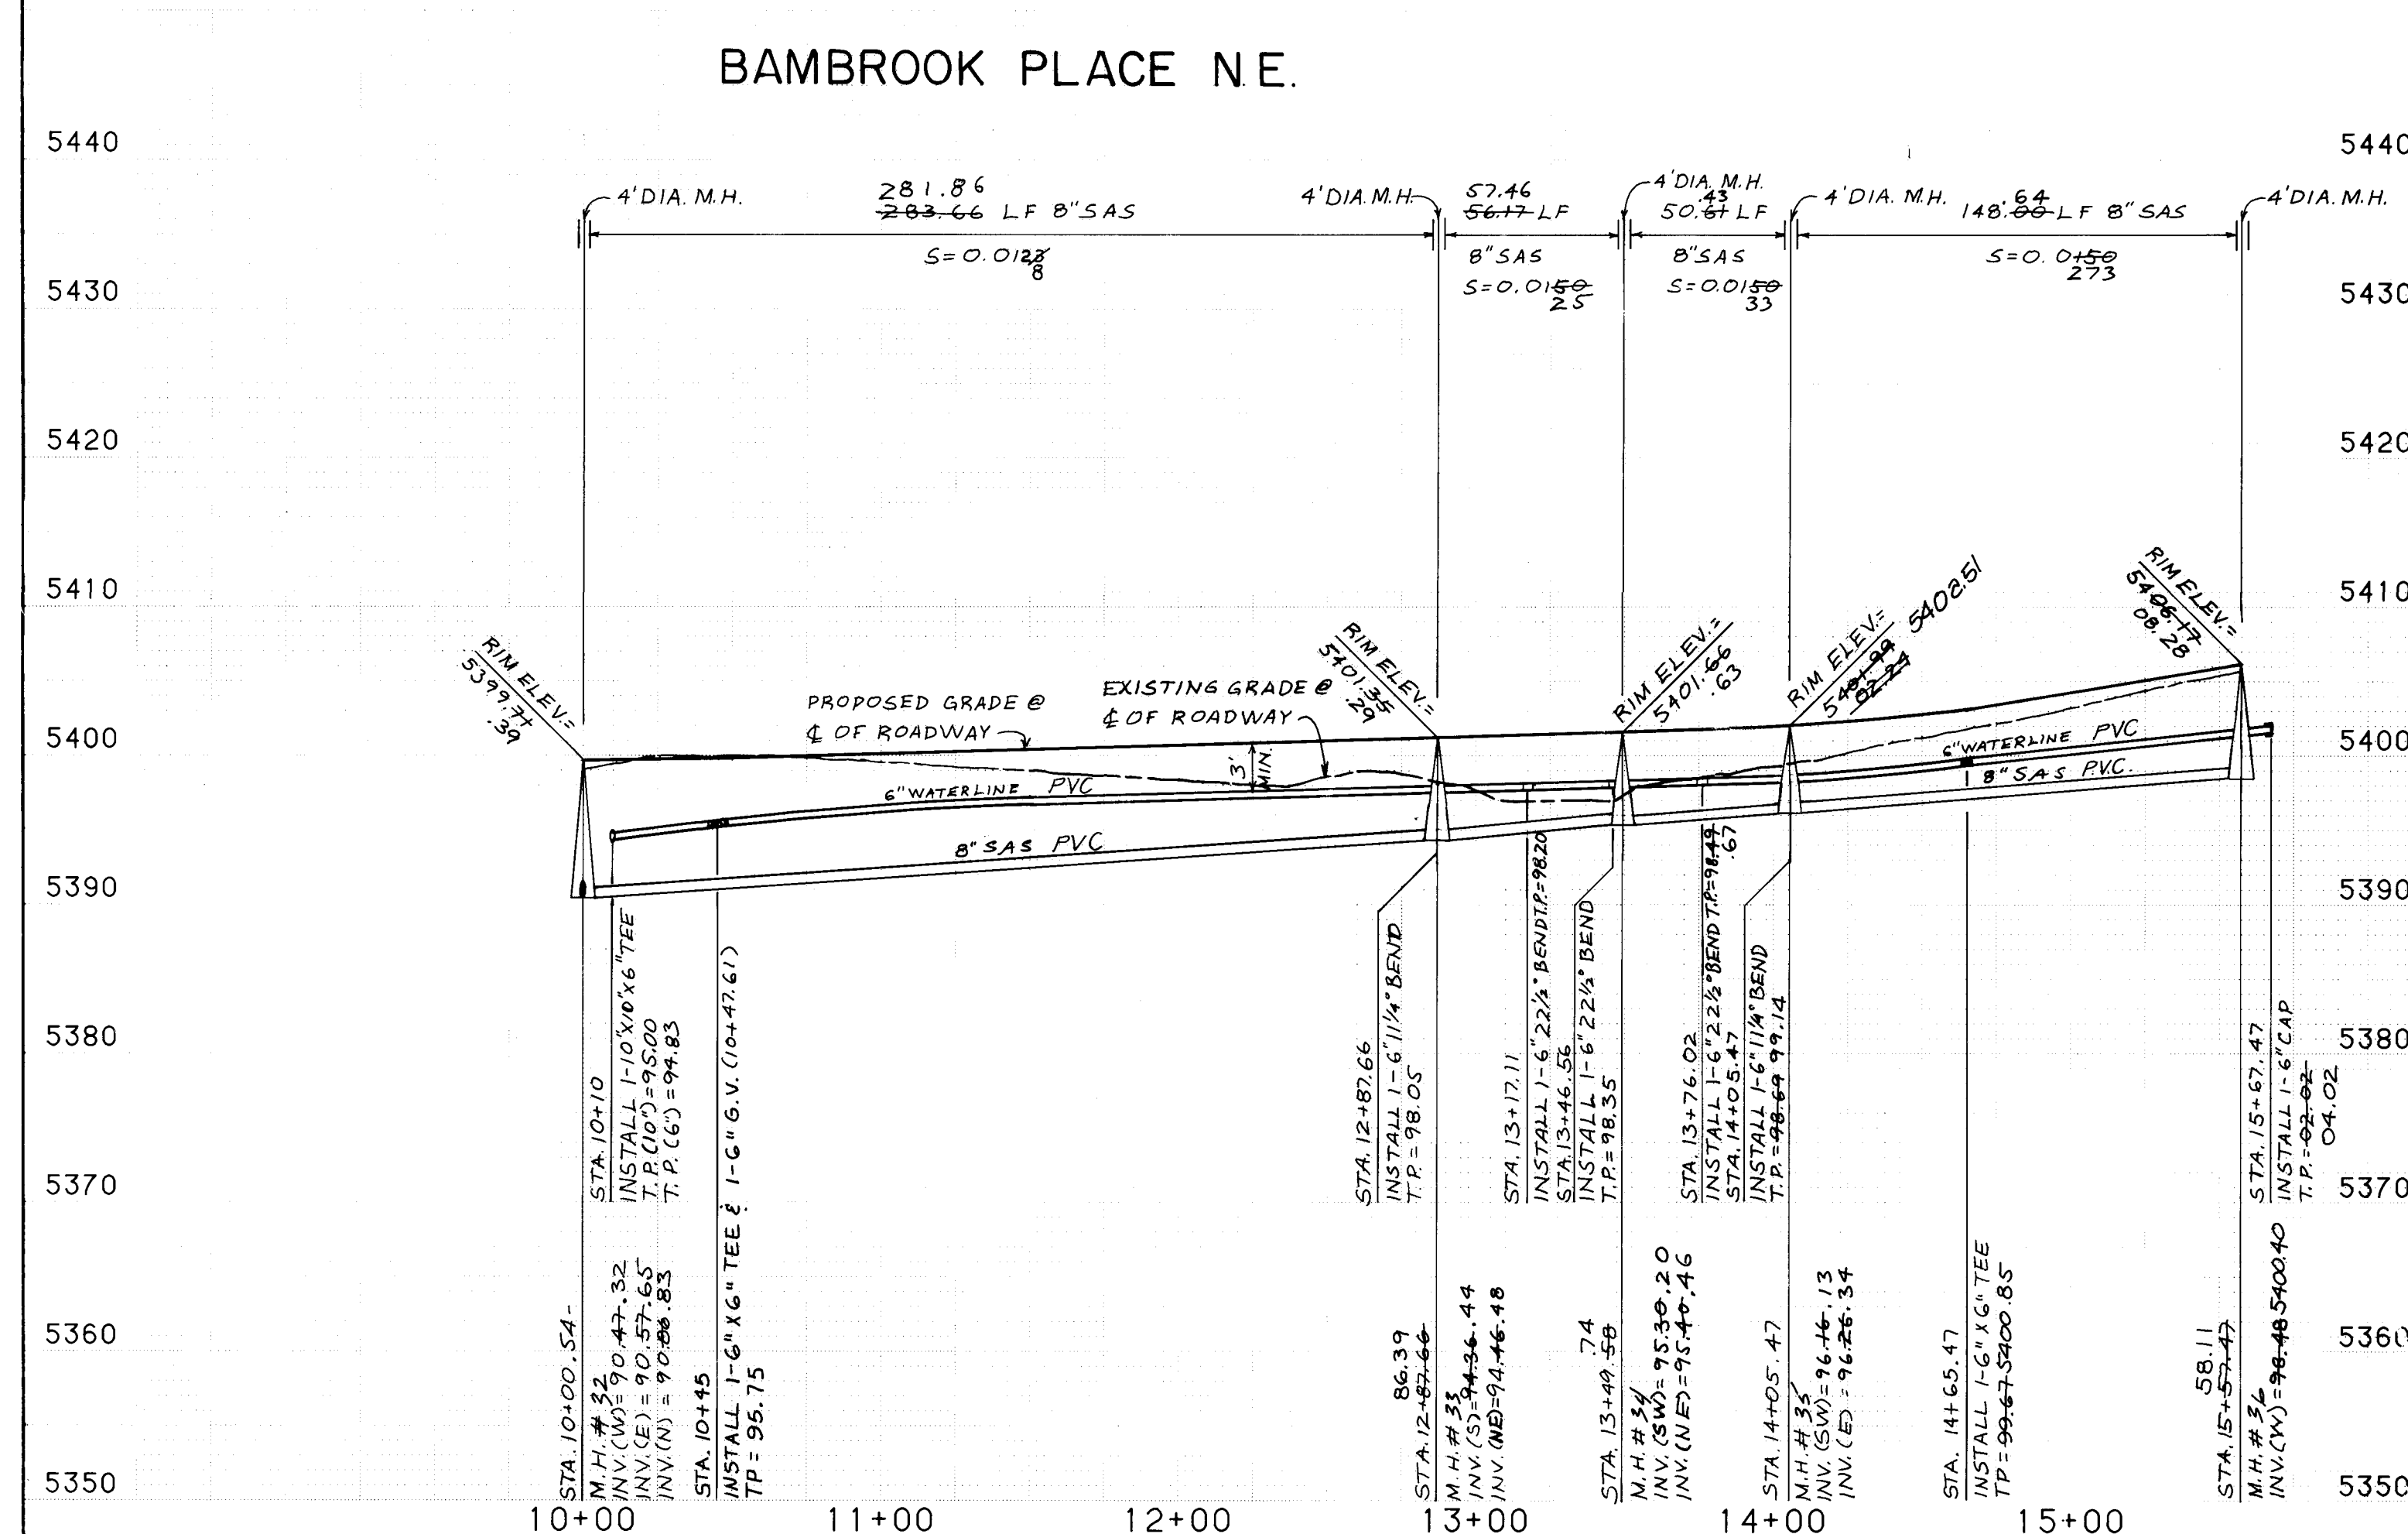

APPROVALS	ENGINEER	DATE	APPROVALS	ENGINEER	DATE
D.R.C. Chair	<i>[Signature]</i>	10/5/87			
Trans. Dev	W.A. DuH	9/16/87			
Utility Dev	<i>[Signature]</i>	8/24/87			
<i>[Signature]</i>	W.A. DuH	9-1-87			
DRAWING NO. 3186	MAP NO. C-19	SHEET 63 OF 77			

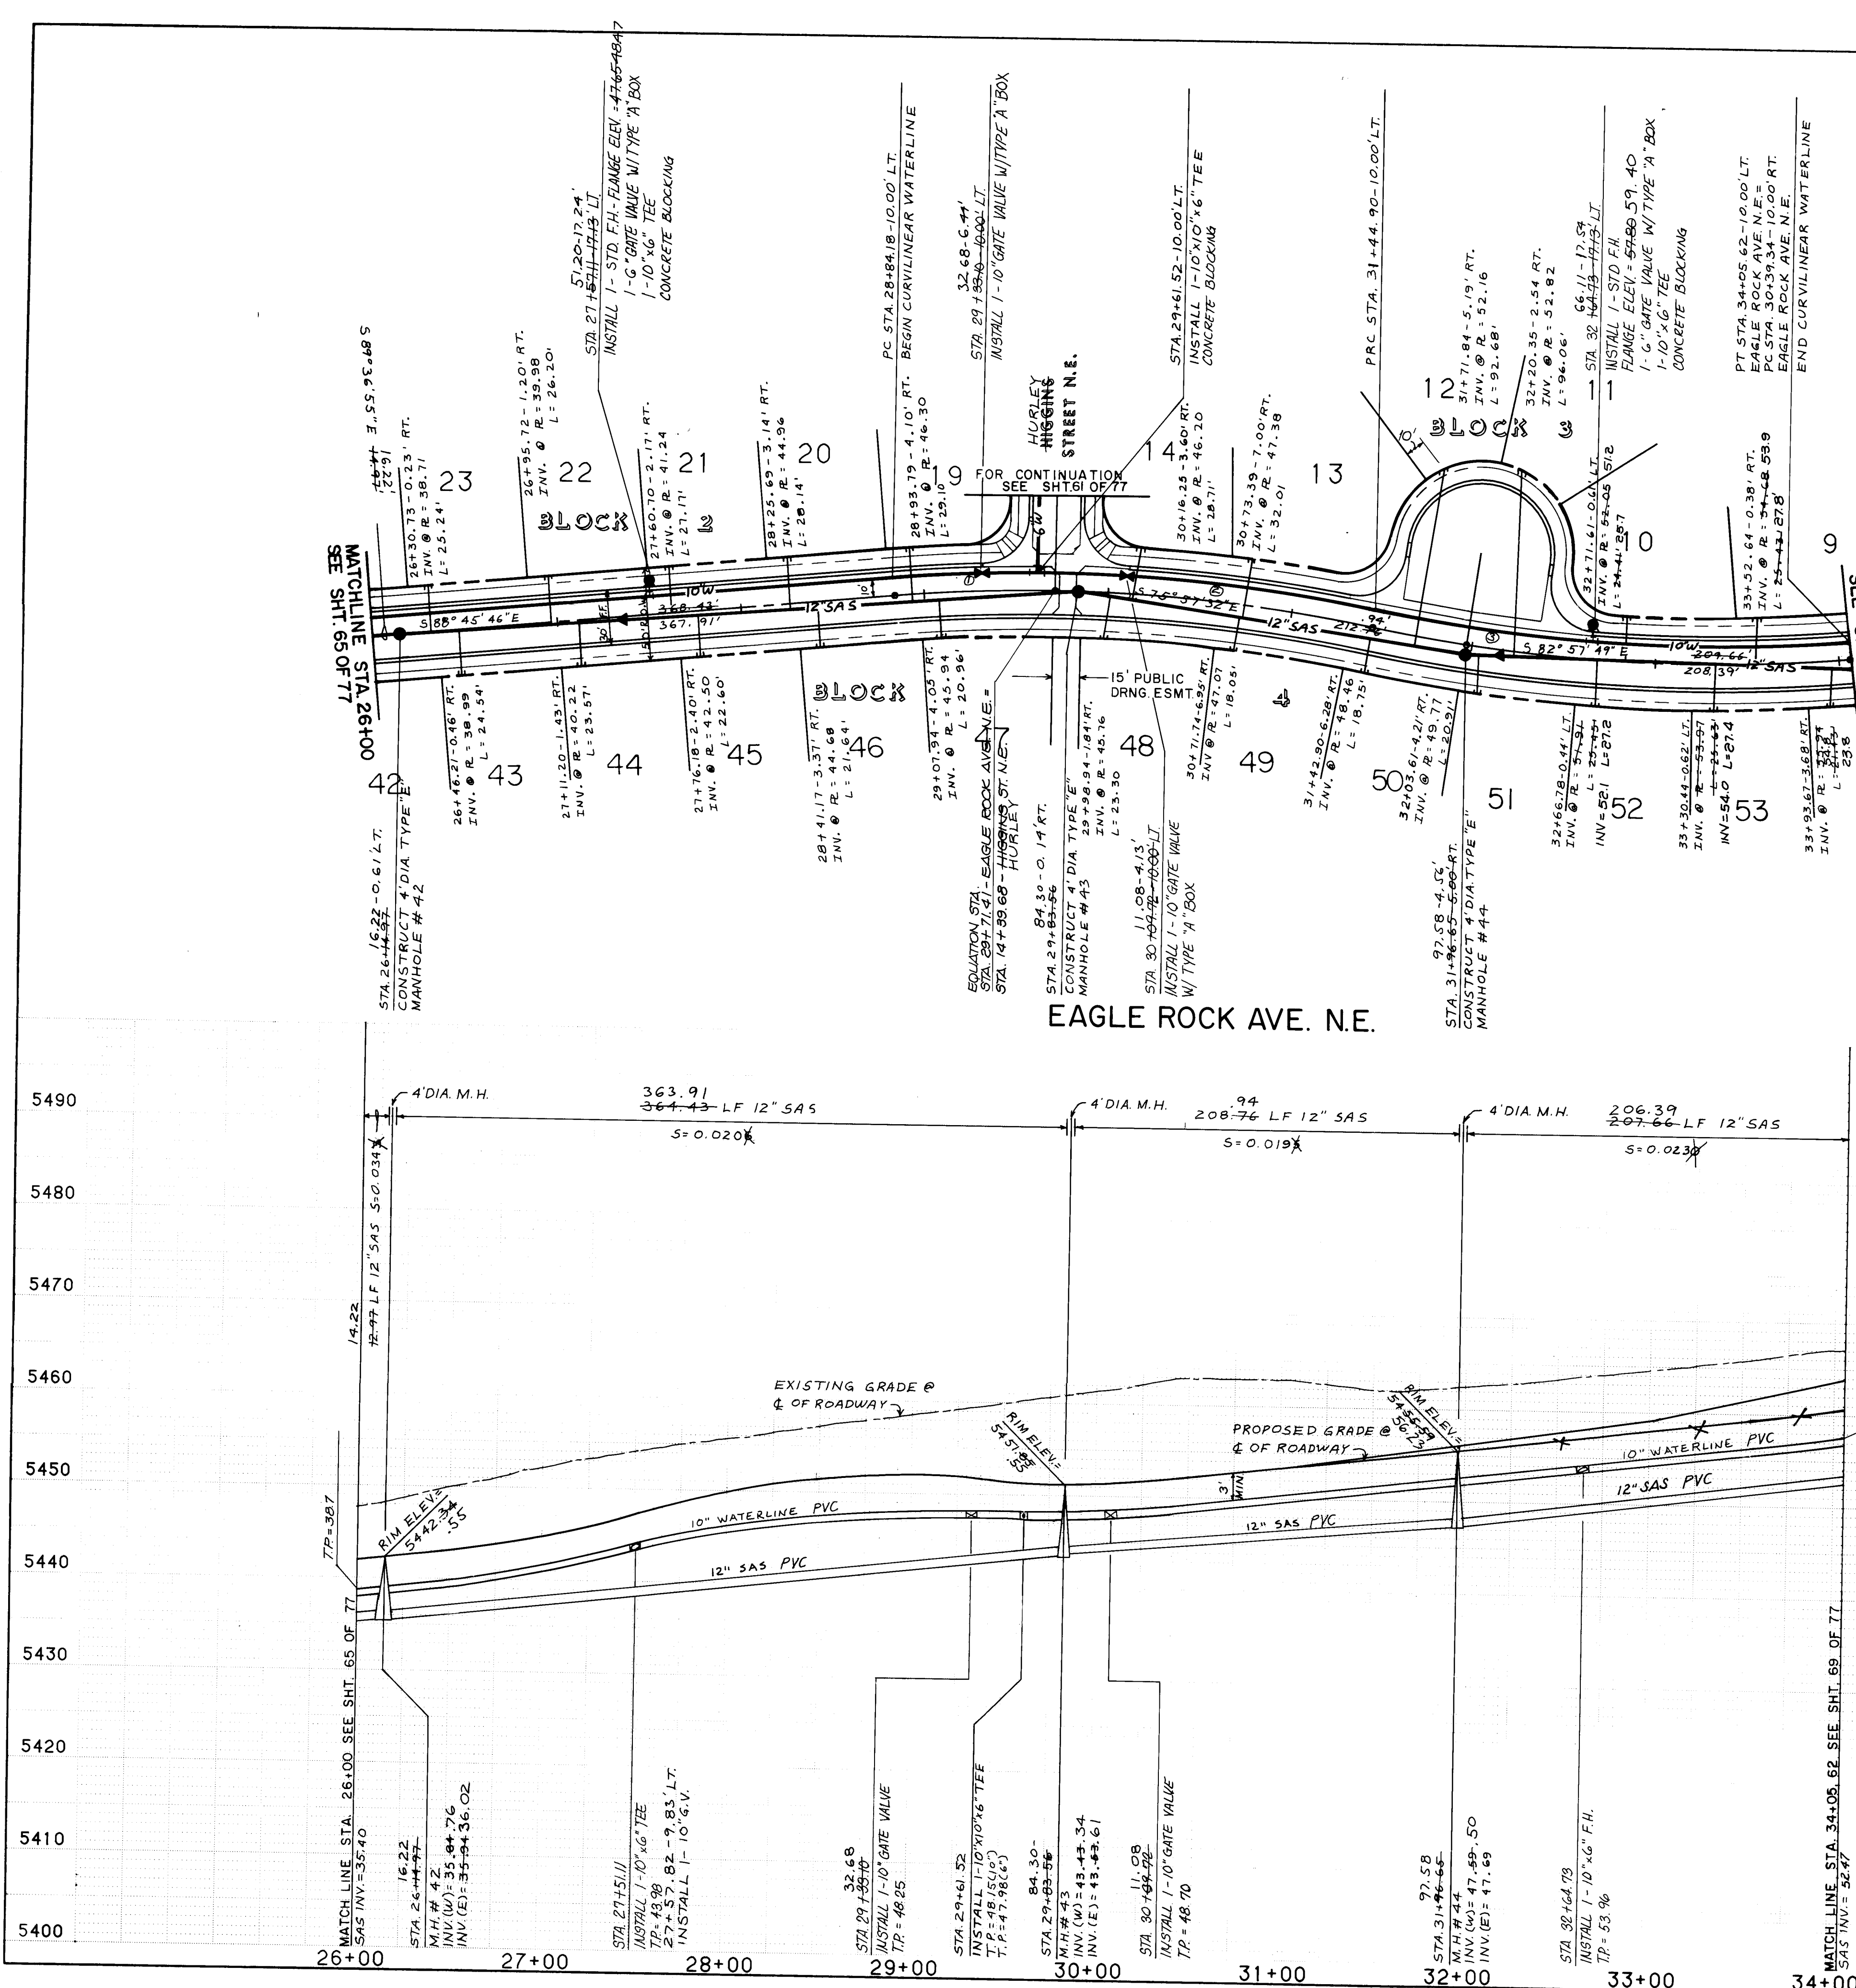

RECORD DRAWING
This drawing as modified shows public improvements as shown on this drawing. These modifications have been made using information and measurements furnished by the field survey crew. The Contractor and City Inspector, EHA's field survey crew, shall be responsible for the accuracy of the field measurements. The Engineer shall be responsible for the accuracy of the design and calculations. The Contractor shall be responsible for the construction of the improvements in accordance with the approved plans and specifications. The Engineer shall be responsible for the inspection and approval of the construction. The Contractor shall be responsible for the maintenance of the improvements after completion.

DATE: 3-17-88
Dennis A. Lorenz P.E. 3617

SCALE:
HORIZ. 1" = 50'
VERT. 1" = 10'

- ### LEGEND
- PROPOSED WATERLINE
 - PROPOSED GATE VALVE
 - PROPOSED FIRE HYDRANT
 - PROPOSED CAP OR PLUG
 - PROPOSED SINGLE METER, WATER SERVICE LINE
 - PROPOSED DOUBLE METER, WATER SERVICE LINES
 - PROPOSED CROSS,TEE,OR ELBOW
 - PROPOSED SANITARY SEWER LINE
 - PROPOSED MANHOLE
 - PROPOSED CAP OR PLUG
 - PROPOSED SANITARY SEWER SERVICE LINE
 - PROPERTY OR BOUNDARY LINE
 - CENTERLINE OF STREET
 - CURB AND GUTTER
 - SIDEWALK

ESPEY, HUSTON & ASSOCIATES, INC.
Engineering & Environmental Consultants
317 COMMERCIAL ST. N.E.
ALBUQUERQUE, NEW MEXICO 87102
PHONE: (505) 242-1909

CITY OF ALBUQUERQUE PUBLIC WORKS DEPARTMENT ENGINEERING GROUP					
TITLE: NOR ESTE ESTATES EAGLE ROCK AVE. N.E. STA. 26+00.00 TO STA. 34+05.62					
APPROVALS	ENGINEER	DATE	APPROVALS	ENGINEER	DATE
D.R.C. Chair	<i>[Signature]</i>	10/5/87			
Trans. Dev	<i>[Signature]</i>	9/16/87			
Utility Dev	<i>[Signature]</i>	8/31/87			
DESIGNED BY	ESPEY	DATE 6/87	REVISIONS	BY	DATE
DRAWN BY	ESPEY	DATE 8/87	DESIGN		
CHECKED BY	D.A.L.	DATE 8/87			


NO. DELTA				RADIUS	LENGTH	TAN.
1	4°55'25"	910.00	78.20	39.13		
2	11°40'27"	910.00	185.41	93.03		
3	16°35'52"	870.00	257.82	129.82		

WATER AND SANITARY SEWER				
1.	ALL STATIONING AND OFFSET DIMENSIONS ARE BASED ON CENTERLINE OF RIGHT-OF-WAY.			
2.	THE FOLLOWING CITY OF ALBUQUERQUE STANDARD DRAWINGS ARE APPLICABLE TO THE WATER AND SANITARY SEWER CONSTRUCTION:			
2102	2145	2326	2344	2362
2110	2315	2328	2347	2364
2118	2320	2335	2360	2368
2125	2325	2340	2361	2369

ALL SERVICES THIS SHEET = 25' UNLESS NOTED OTHERWISE

CONTRACTOR		NEW		CONCEPTS	
DATE	DATE	DATE	DATE	DATE	DATE
DATE	DATE	DATE	DATE	DATE	DATE

CONTRACTOR		NEW		CONCEPTS	
DATE	DATE	DATE	DATE	DATE	DATE
DATE	DATE	DATE	DATE	DATE	DATE

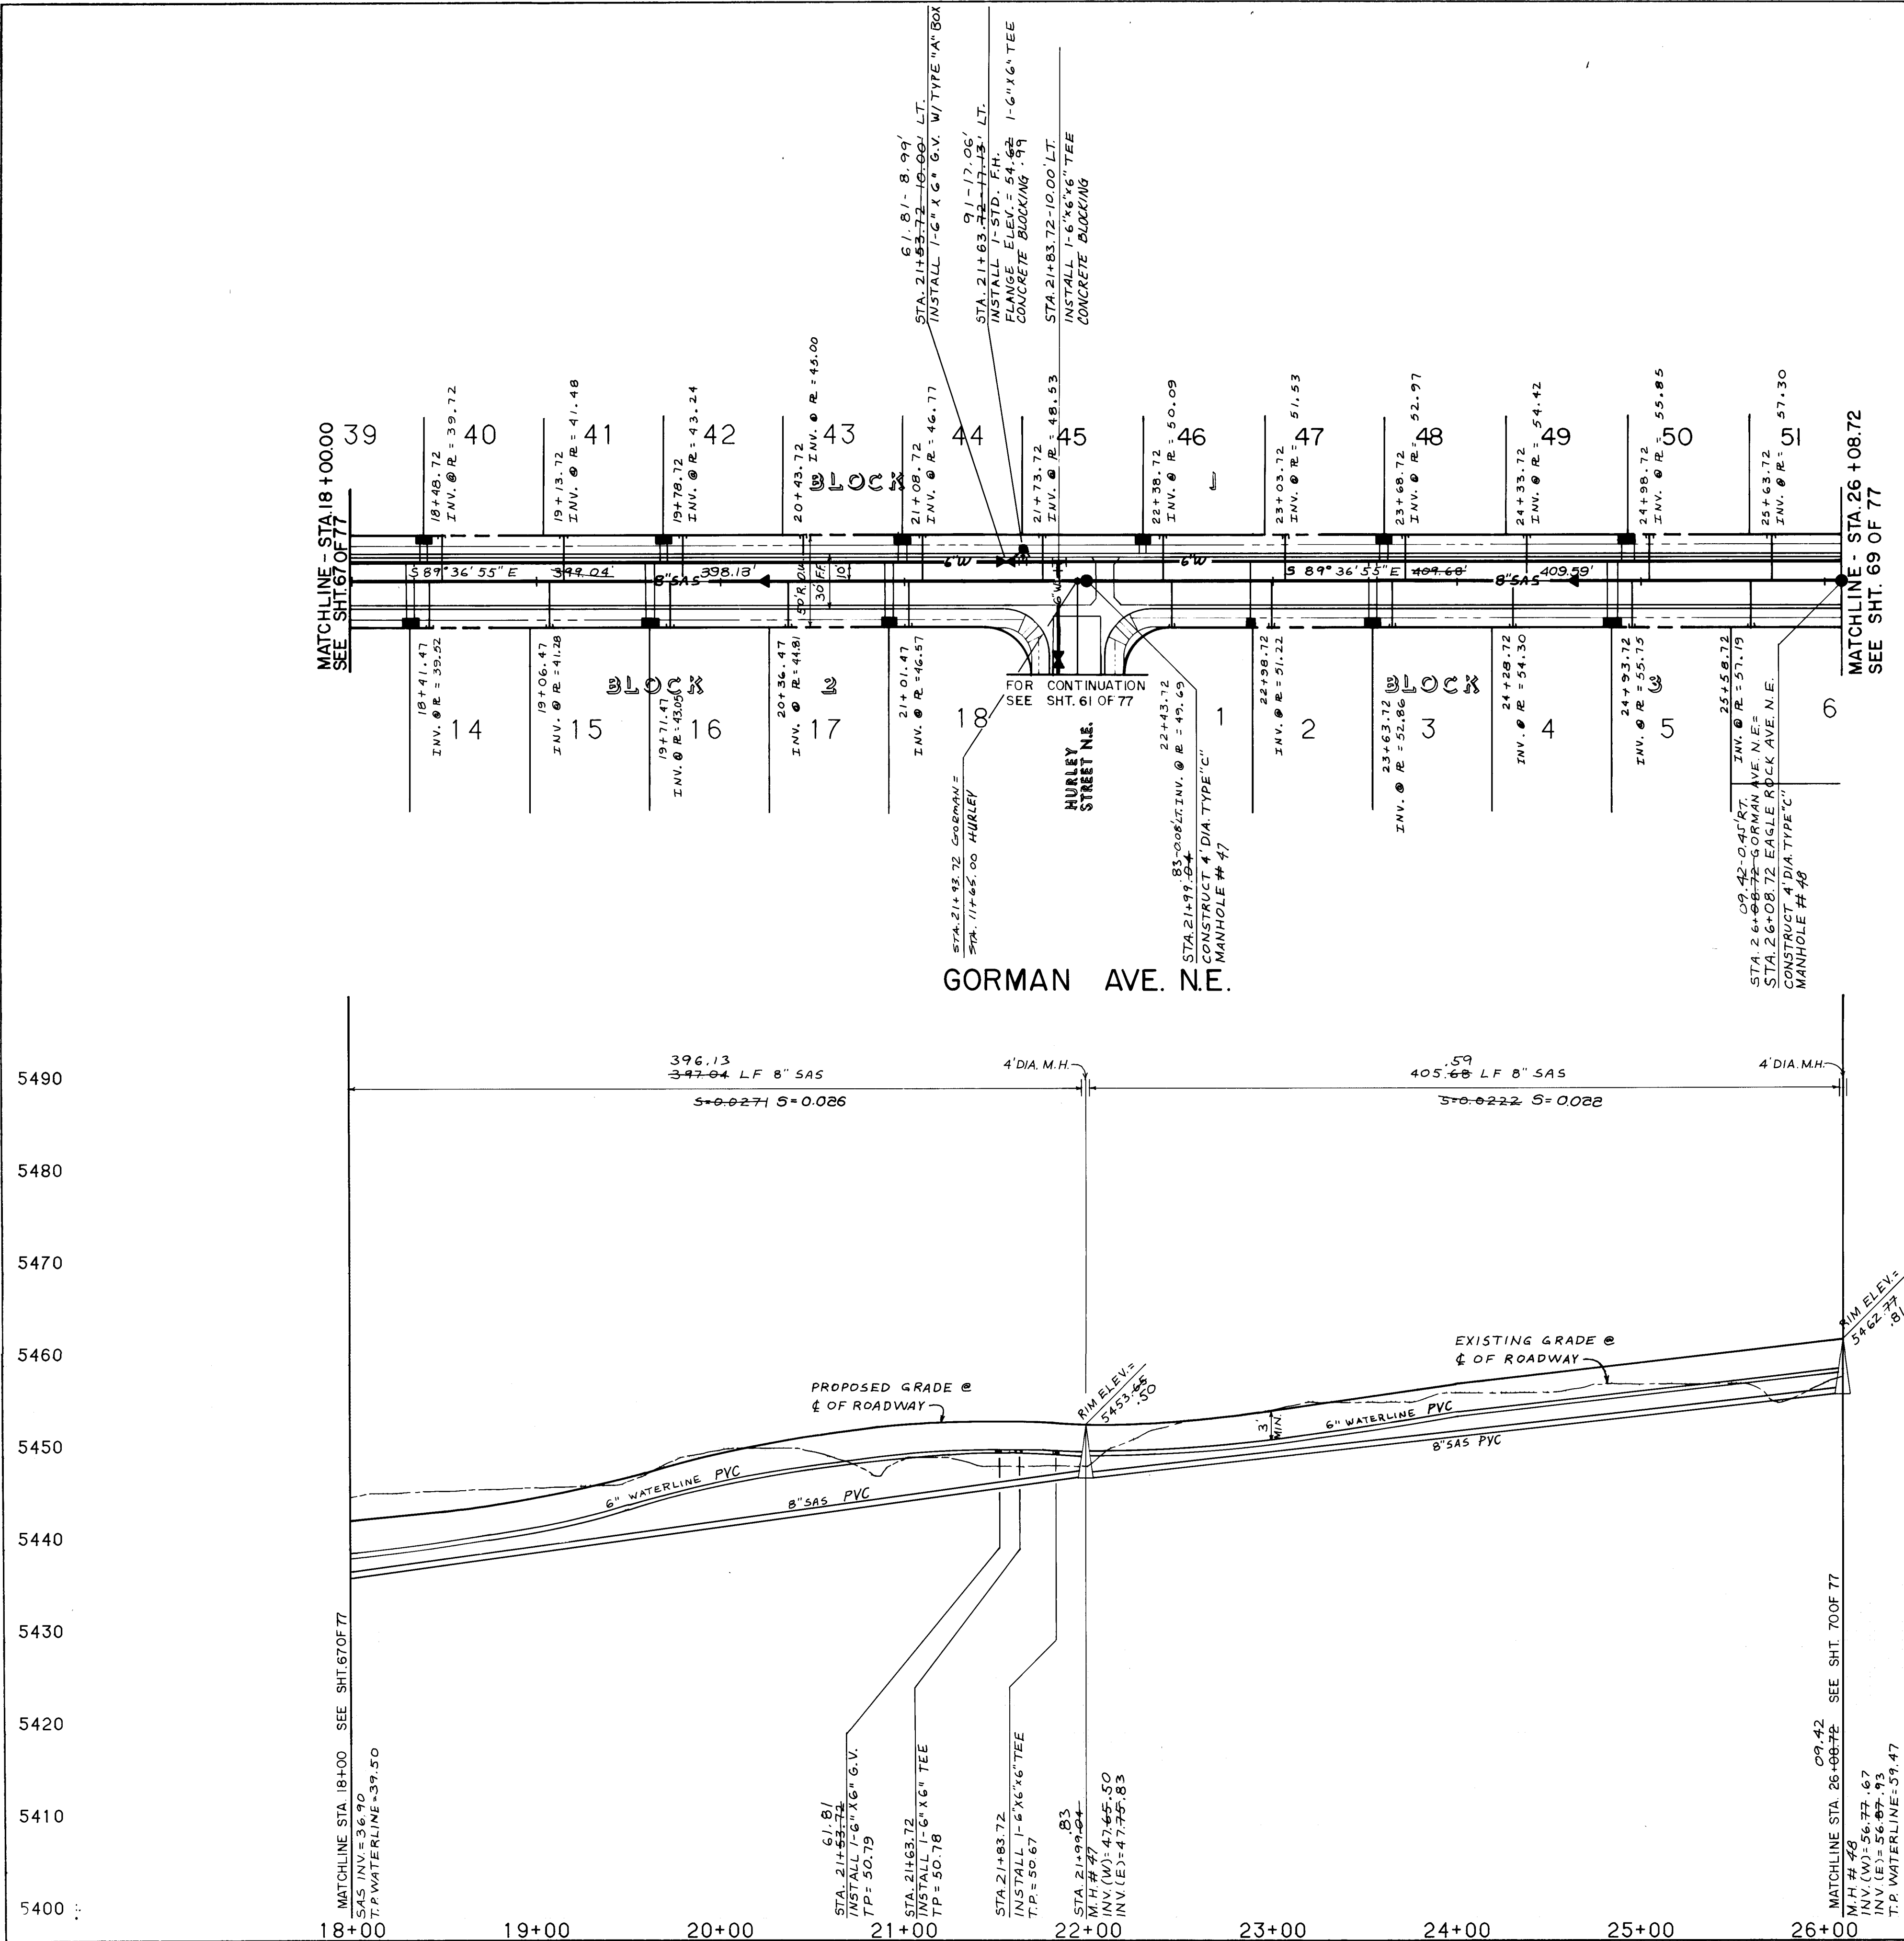

SCALE:
HORIZ. 1"=50'
VERT. 1"=10'

- LEGEND**
- PROPOSED WATERLINE
 - PROPOSED GATE VALVE
 - PROPOSED FIRE HYDRANT
 - PROPOSED CAP OR PLUG
 - PROPOSED SINGLE METER, WATER SERVICE LINE
 - PROPOSED DOUBLE METER, WATER SERVICE LINES
 - PROPOSED CROSS, TEE, OR ELBOW
 - PROPOSED SANITARY SEWER LINE
 - PROPOSED MANHOLE
 - PROPOSED CAP OR PLUG
 - PROPOSED SANITARY SEWER SERVICE LINE
 - PROPERTY OR BOUNDARY LINE
 - CENTERLINE OF STREET
 - CURB AND GUTTER
 - SIDEWALK

ESPEY,
HUSTON &
ASSOCIATES, INC.
Engineering & Environmental Consultants
317 COMMERCIAL ST. N.E.
ALBUQUERQUE, NEW MEXICO 87102
PHONE: (505) 242-1909

CITY OF ALBUQUERQUE
PUBLIC WORKS DEPARTMENT
ENGINEERING GROUP

TITLE: NOR ESTE ESTATES
GORMAN AVE. N.E.
STA. 18+00.00 TO STA. 26+08.72

APPROVALS	ENGINEER	DATE	APPROVALS	ENGINEER	DATE
D.R.C. Chair	<i>[Signature]</i>	10/5/07			
Trans. Dev.	<i>[Signature]</i>	9/16/07			
Utility Dev.	<i>[Signature]</i>	9/11/07			

DRAWING NO. 3186 MAP NO. C-19 SHEET 68 OF 77

WATER AND SANITARY SEWER					
1. ALL STATIONING AND OFFSET DIMENSIONS ARE BASED ON CENTERLINE OF RIGHT-OF-WAY.					
2. THE FOLLOWING CITY OF ALBUQUERQUE STANDARD DRAWINGS ARE APPLICABLE TO THE WATER AND SANITARY SEWER CONSTRUCTION:					
2102	2145	2326	2344	2362	
2110	2315	2328	2347	2366	
2118	2320	2335	2360	2368	
2125	2325	2340	2361	2369	

RECORD DRAWING
This drawing is modified from public information. These modifications have been made using information and measurements obtained by EHA's field survey crew. The Contractor and City Inspector are responsible for verifying the accuracy of the information. The City of Albuquerque is not responsible for the accuracy of the information. The City of Albuquerque is not responsible for the accuracy of the information. The City of Albuquerque is not responsible for the accuracy of the information.



DATE: 10/5/07
BY: [Signature]
DATE: 10/5/07
BY: [Signature]

SURVEY INFORMATION		BENCH MARKS	
NO.	DATE	CONTRACTOR	NEW CONCEPTS
		DATE: 10/5/07	

ENGINEER'S SEAL
[Seal of Dennis A. Lorenz, P.E., 9877]

REVISIONS		DESIGN	
NO.	DATE	BY	DATE
1	10/5/07	ESPEY, HUSTON & ASSOCIATES, INC.	10/5/07
2	9/16/07	ESPEY, HUSTON & ASSOCIATES, INC.	9/16/07
3	9/11/07	ESPEY, HUSTON & ASSOCIATES, INC.	9/11/07

5500
5490
5480
5470
5460
5450
5440
5430
5420
5410

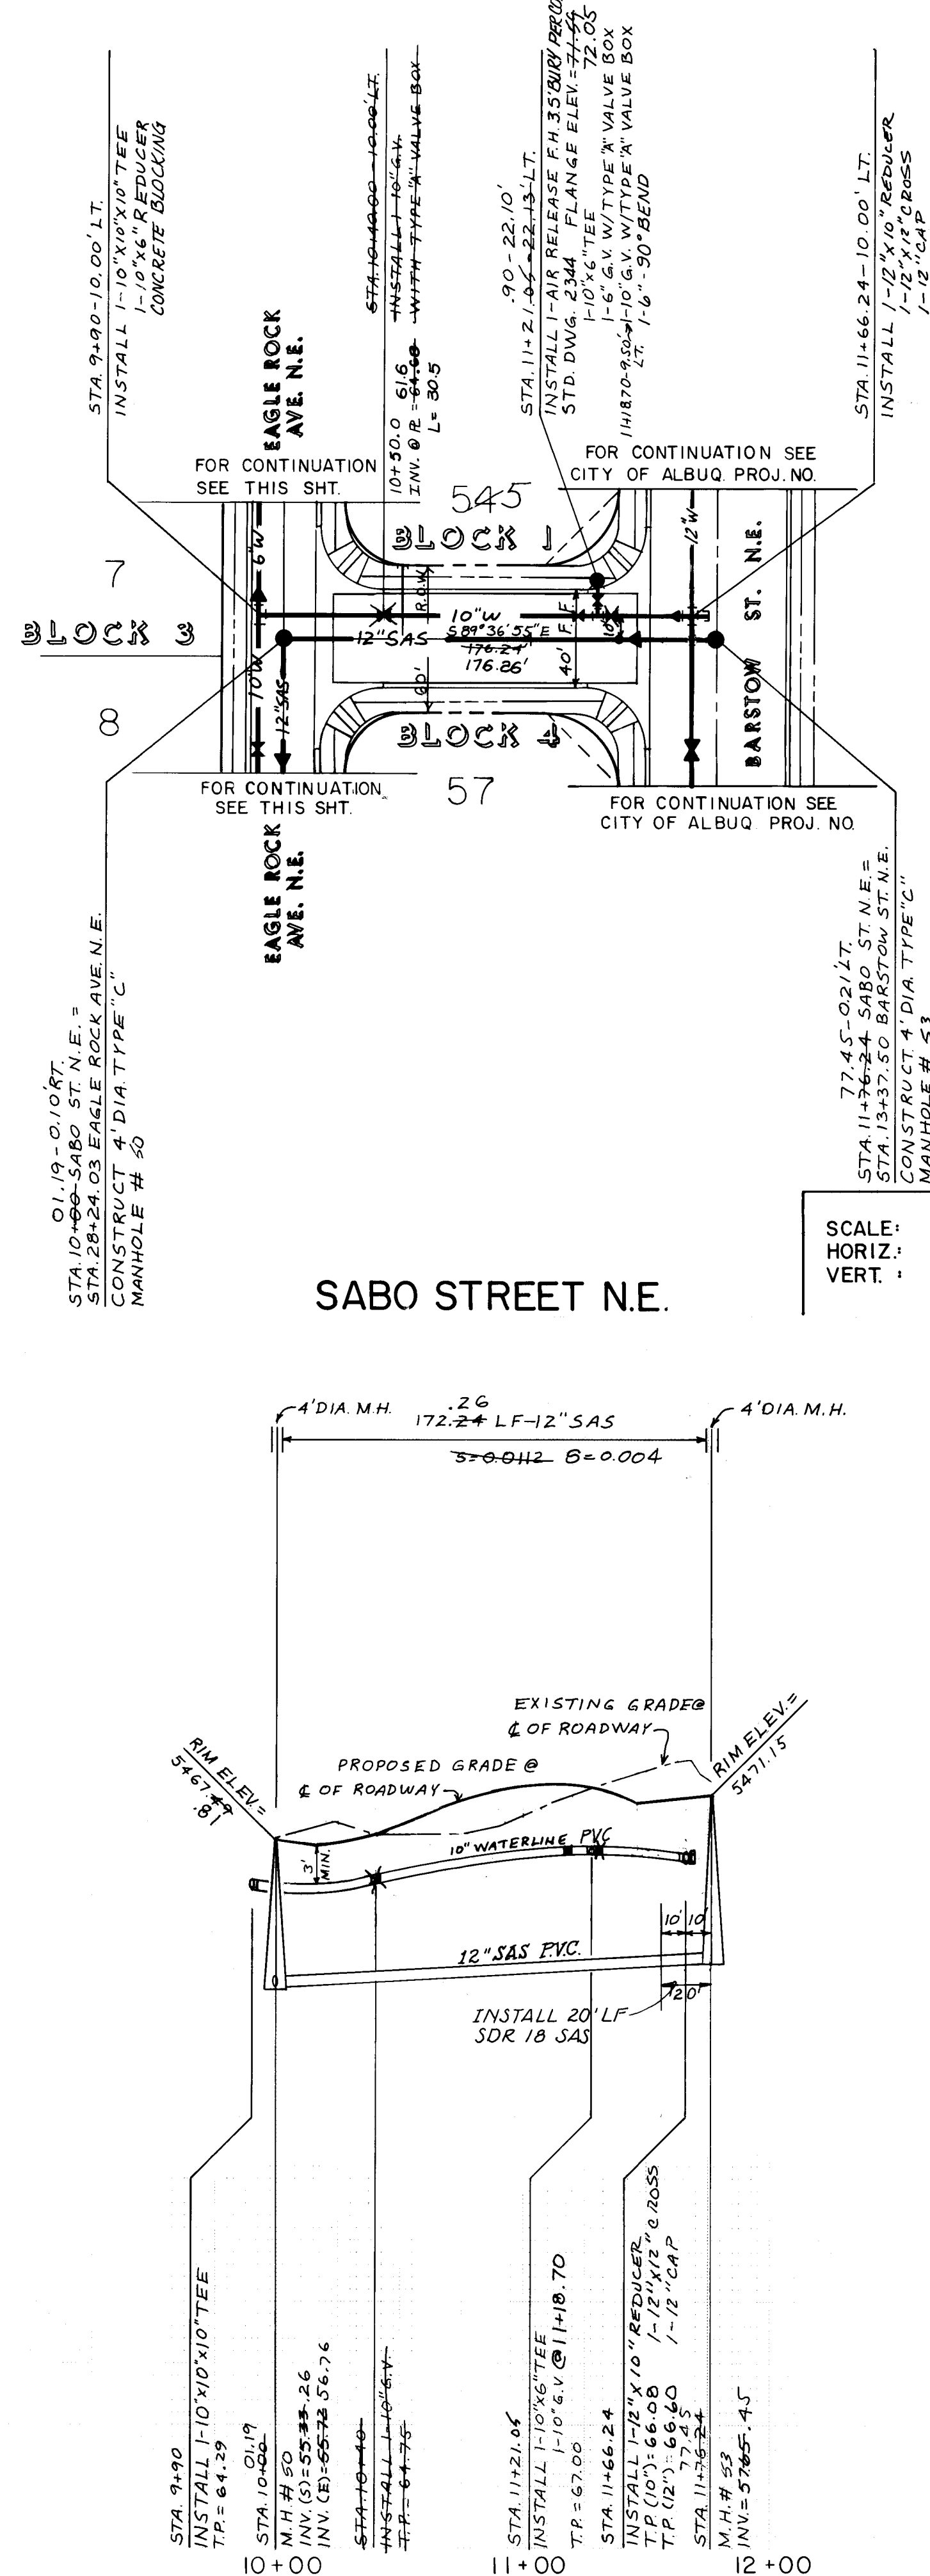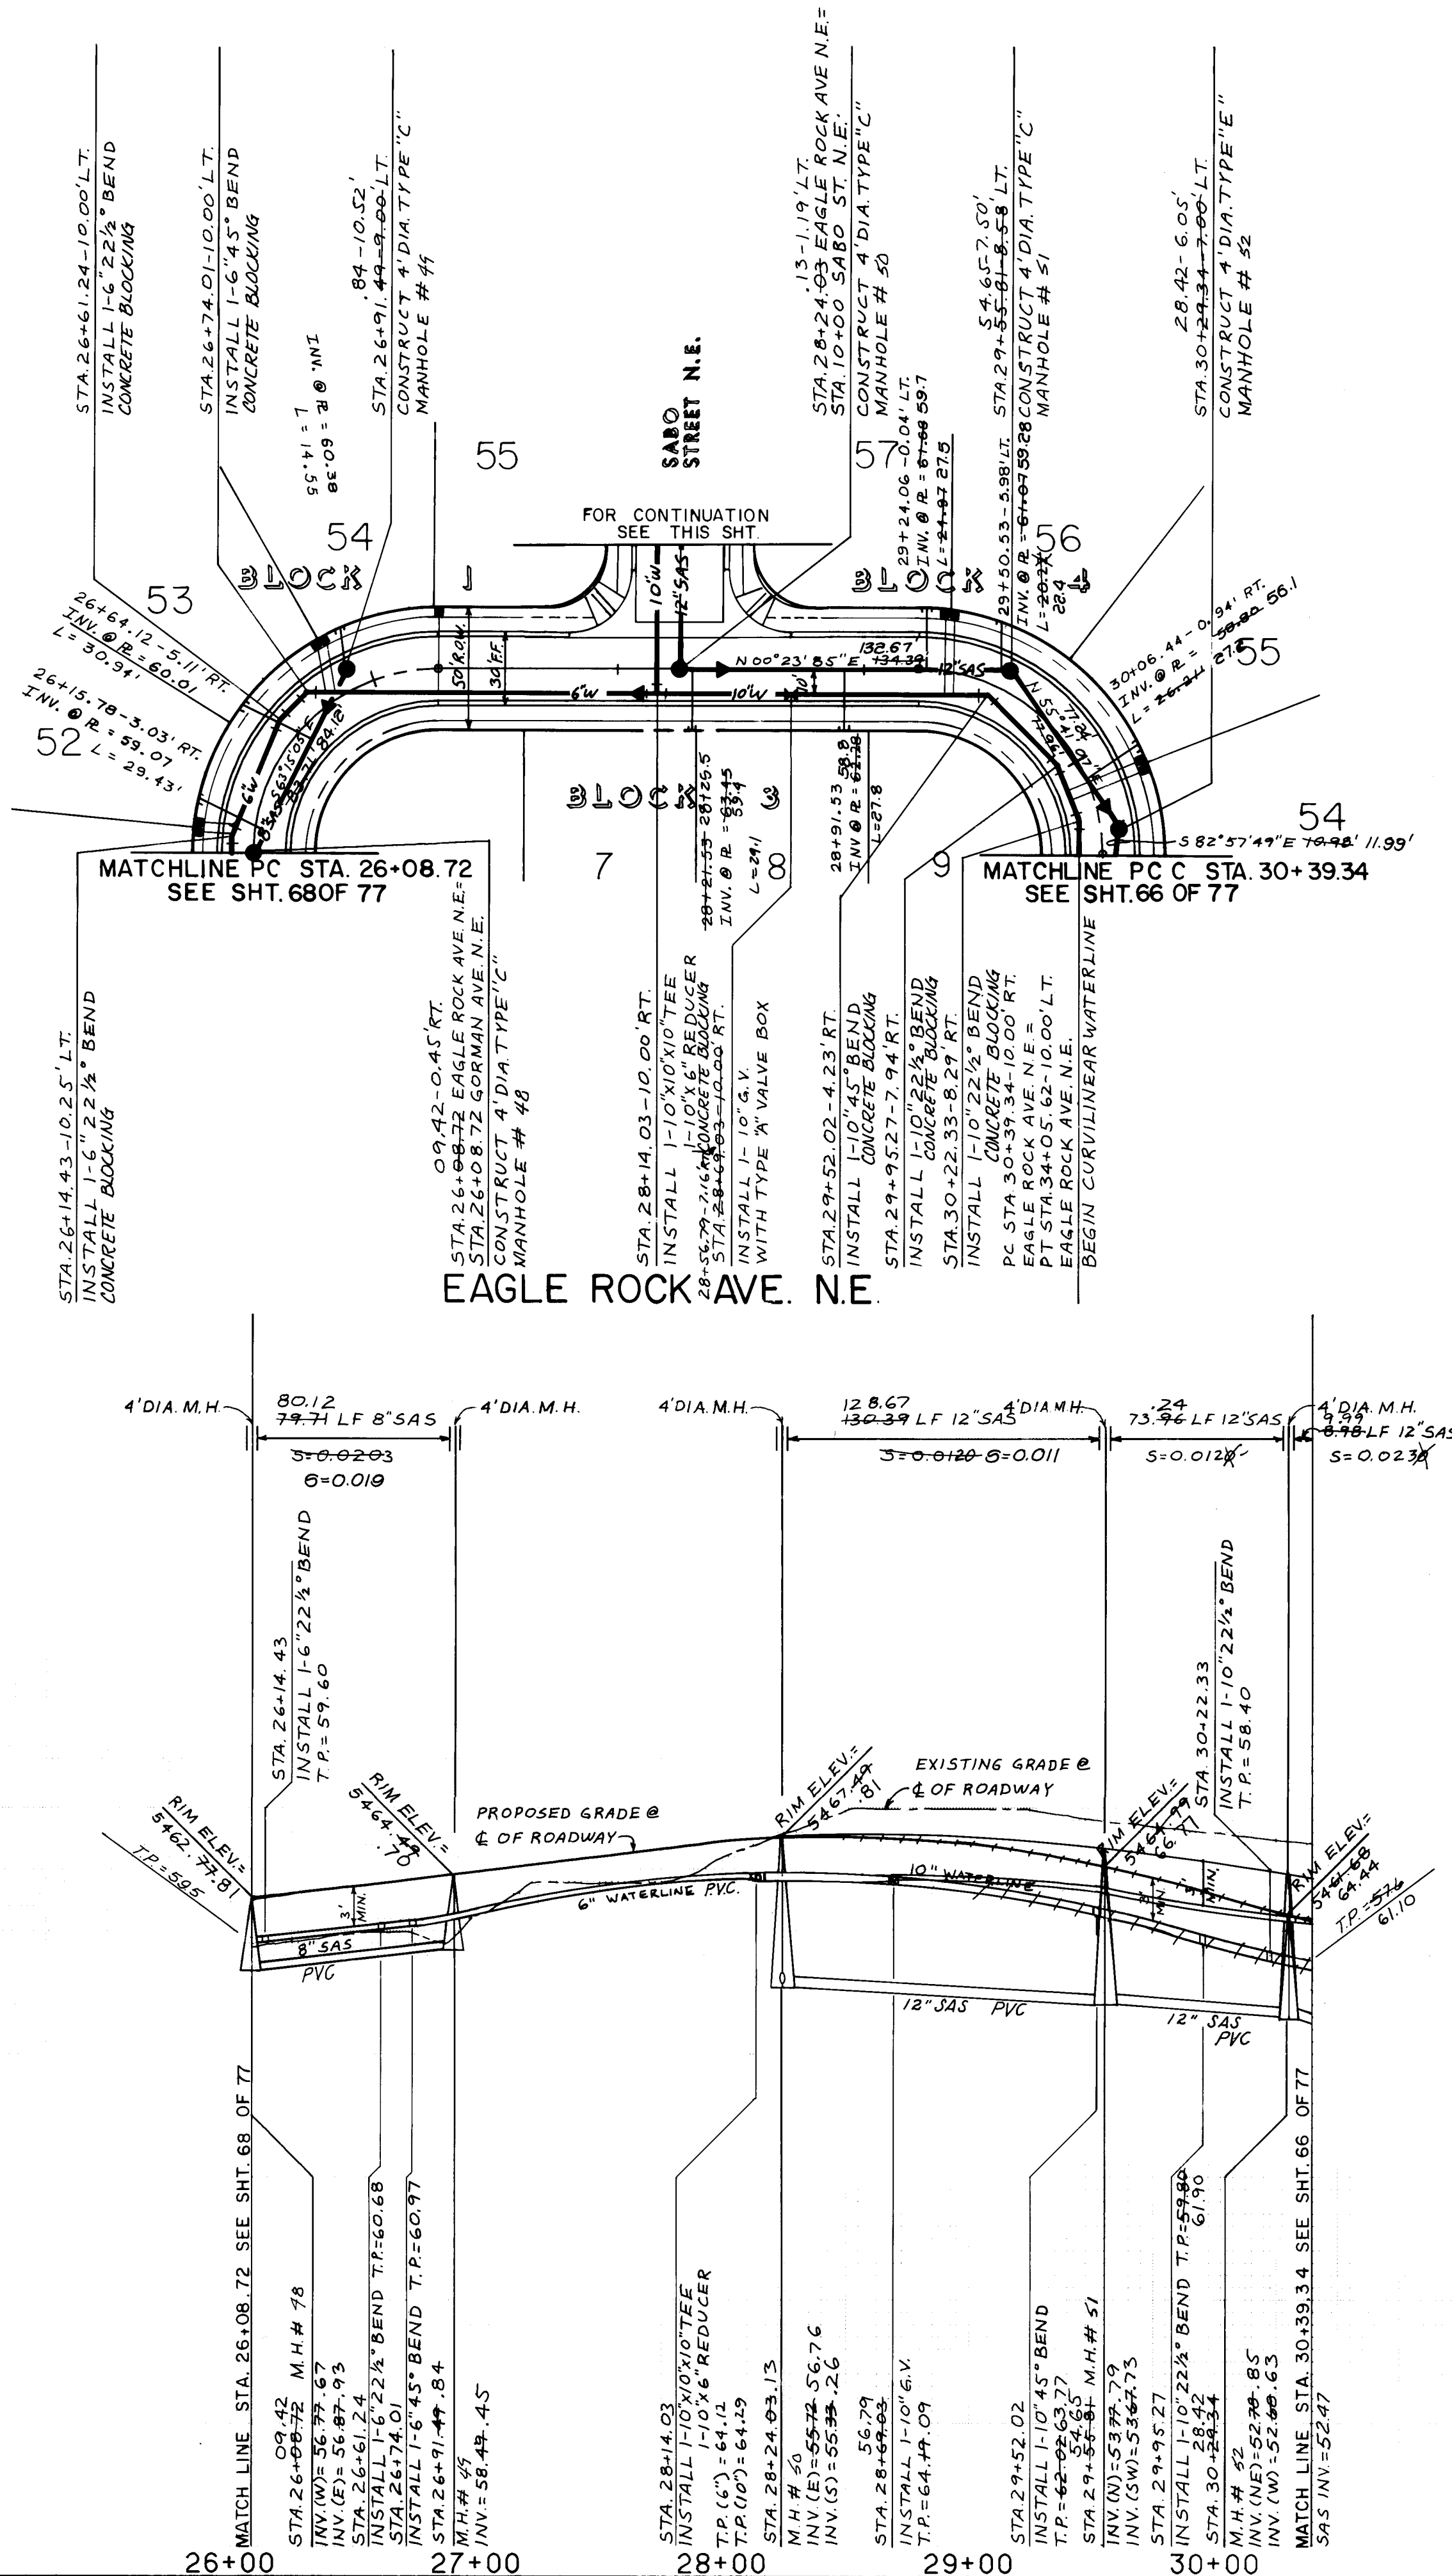

WATER AND SANITARY SEWER

1. ALL STATIONING AND OFFSET DIMENSIONS ARE BASED ON CENTERLINE OF RIGHT-OF-WAY.

2. THE FOLLOWING CITY OF ALBUQUERQUE STANDARD DRAWINGS ARE APPLICABLE TO THE WATER AND SANITARY SEWER CONSTRUCTION:

2102	2145	2326	2344	2362
2110	2315	2328	2347	2366
2118	2320	2335	2360	2368
2125	2325	2340	2361	2369

ALL SERVICES THIS SHEET = 76' UNLESS NOTED OTHERWISE.

RECORD DRAWING

This drawing as modified shows public improvements as constructed. These modifications have been made using information and measurements obtained by EHA's field survey crew, the Contractor and City Inspector for the proposed construction. The Contractor and City Inspector for the proposed construction are responsible for the accuracy of the field data and the design of the improvements. The City of Albuquerque is not responsible for the accuracy of the field data and the design of the improvements.

Dennis A. Lorenz P.E. 8/14/07

LEGEND

- PROPOSED WATERLINE
- PROPOSED GATE VALVE
- PROPOSED FIRE HYDRANT
- PROPOSED CAP OR PLUG
- PROPOSED SINGLE METER, WATER SERVICE LINE
- PROPOSED DOUBLE METER, WATER SERVICE LINES
- PROPOSED CROSS,TEE,OR ELBOW
- PROPOSED SANITARY SEWER LINE
- PROPOSED MANHOLE
- PROPOSED CAP OR PLUG
- PROPOSED SANITARY SEWER SERVICE LINE
- PROPERTY OR BOUNDARY LINE
- CENTERLINE OF STREET
- CURB AND GUTTER
- SIDEWALK

ESPEY, HUSTON & ASSOCIATES, INC.
Engineering & Environmental Consultants
317 COMMERCIAL ST. N.E.
ALBUQUERQUE, NEW MEXICO 87102
PHONE: (505) 242-1909


CITY OF ALBUQUERQUE
PUBLIC WORKS DEPARTMENT
ENGINEERING GROUP

TITLE: NOR ESTE ESTATES
EAGLE ROCK AVE NE / SABO STREET N.E.
STA 26+08.72 TO STA 30+ 39.34 / STA 10+00.00 TO STA 11+76.24

APPROVALS	ENGINEER	DATE	APPROVALS	ENGINEER	DATE
D.R.C. Chair	DATE	10/5/07			
Trans. Dev	DATE	9/16/07			
Utility Dev	DATE	8/31/07			

DESIGNED BY: P.H.L.
DRAWN BY: P.H.L.
CHECKED BY: P.H.L.

NO. 3186 MAP NO. C-19 SHEET 69 OF 77

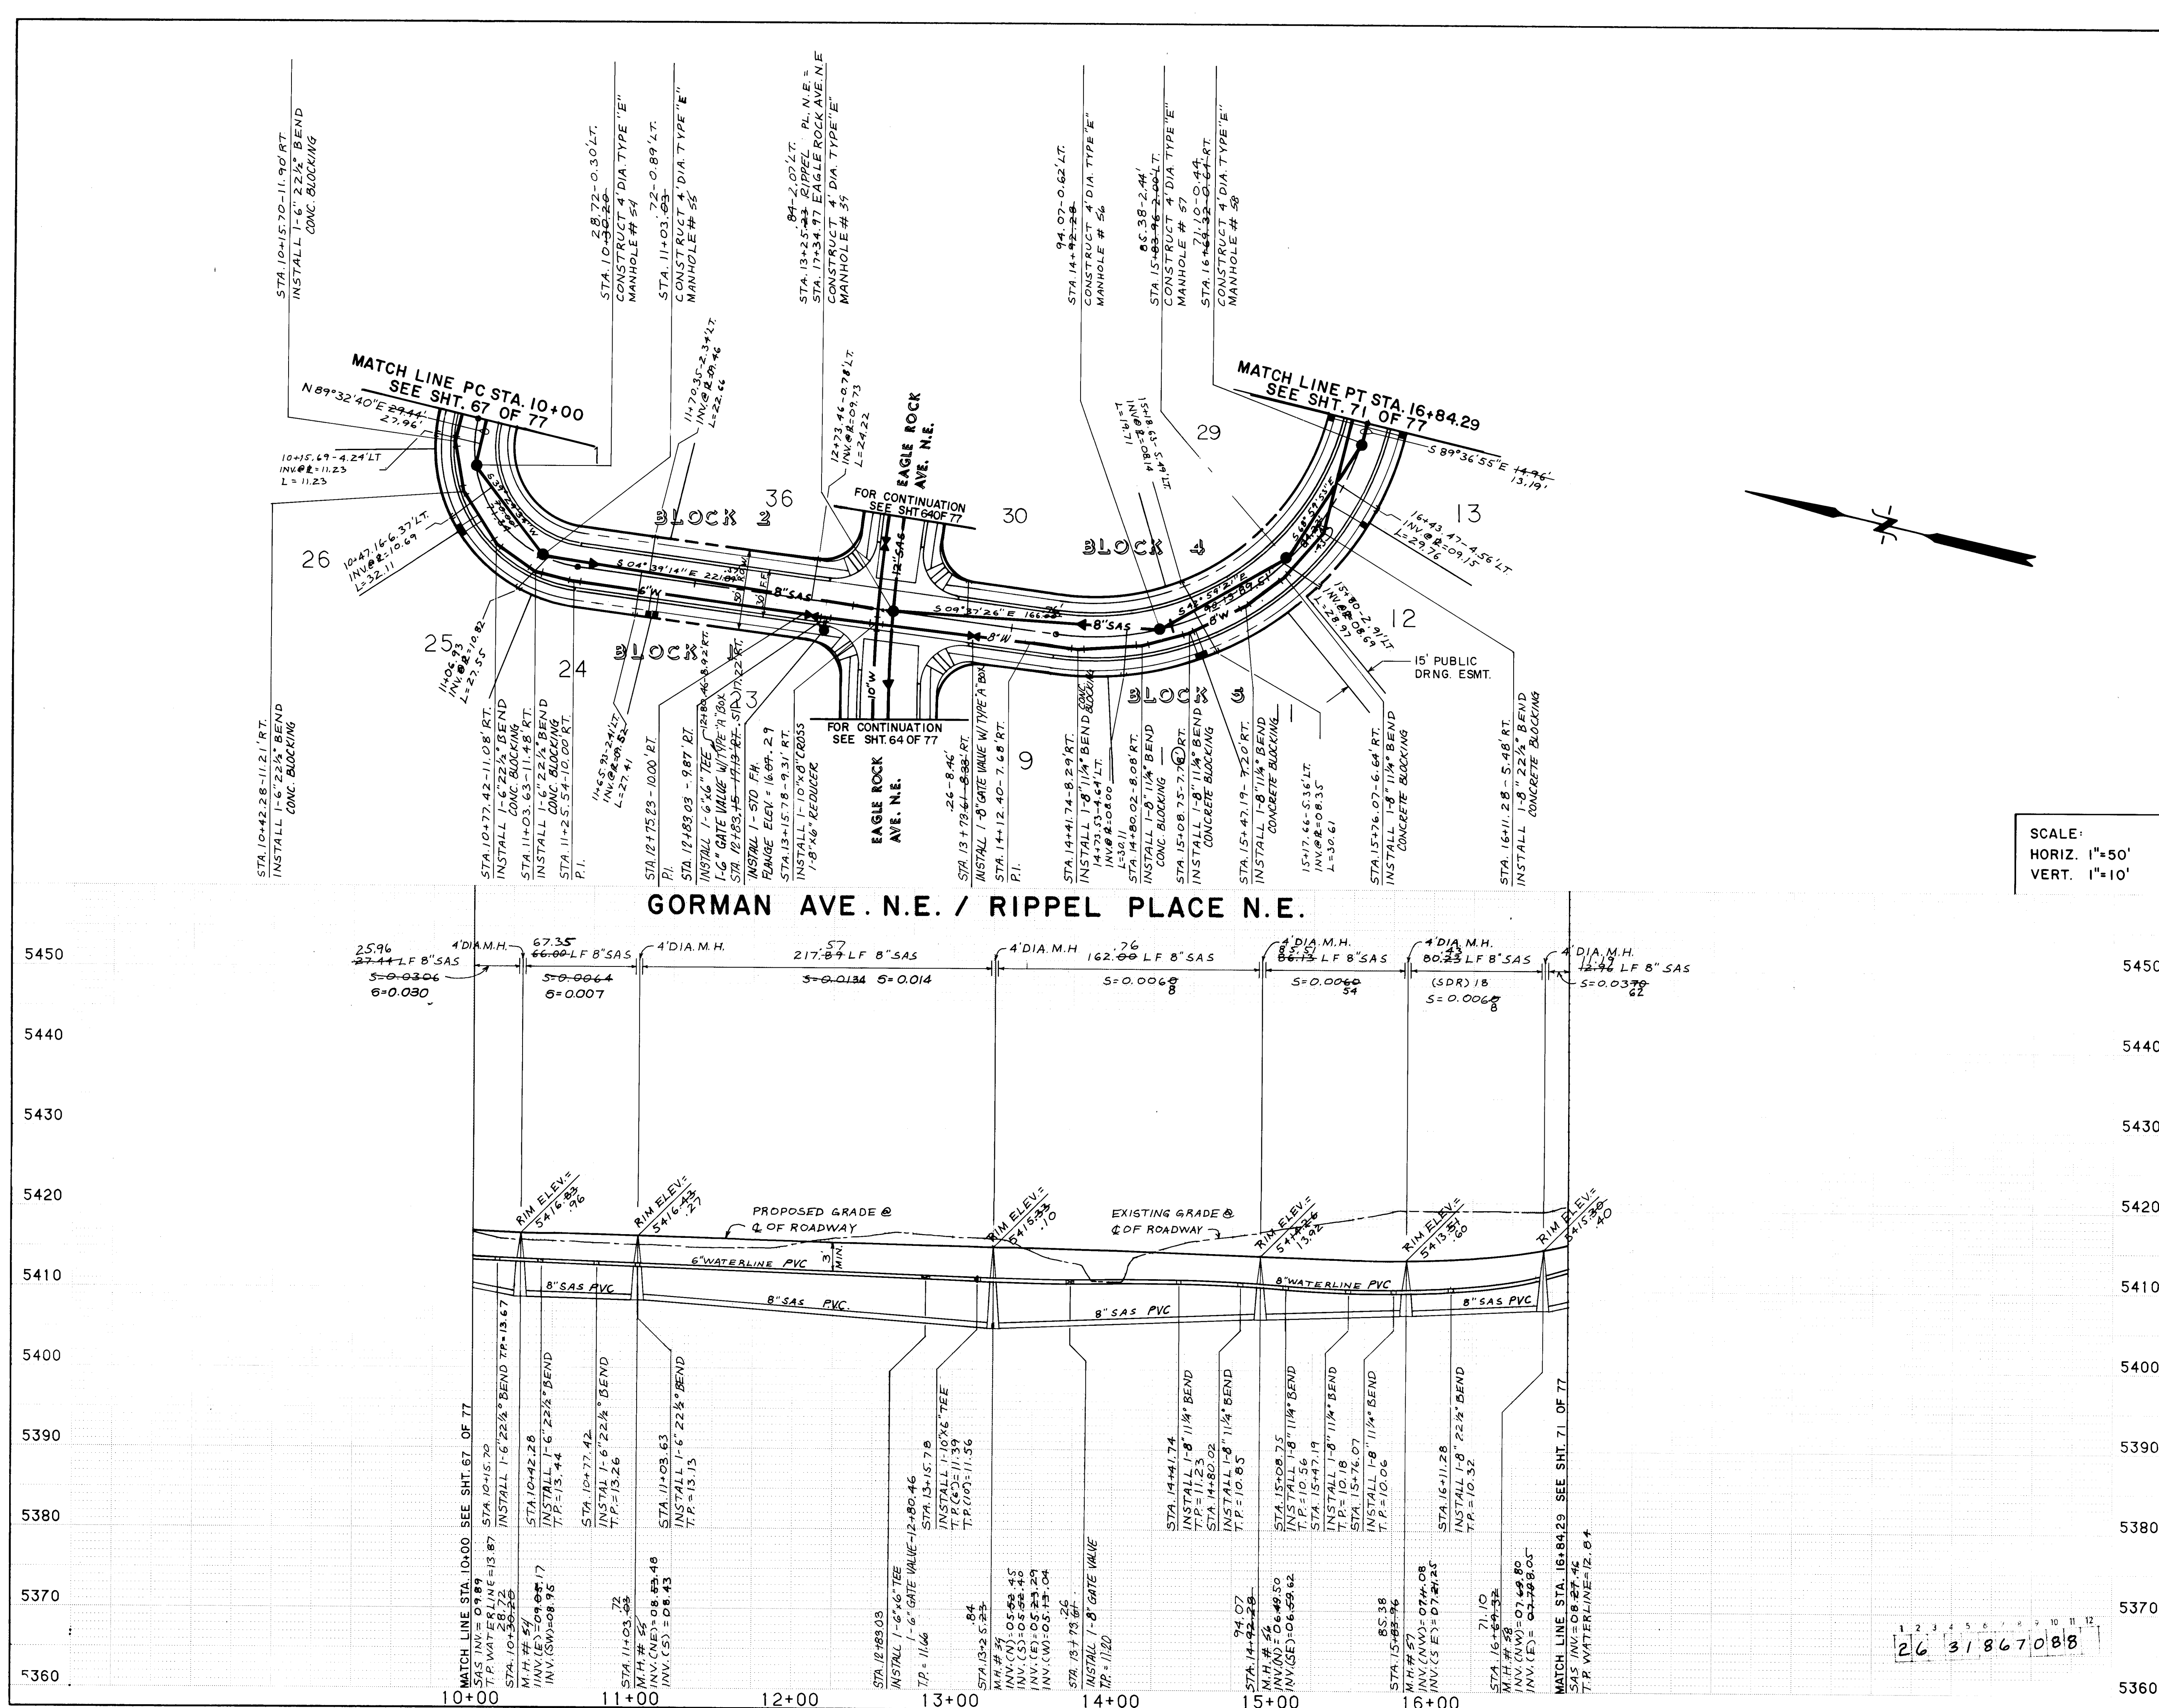

SCALE:
HORIZ. 1"=50'
VERT. 1"=10'

LEGEND

- PROPOSED WATERLINE
- PROPOSED GATE VALVE
- PROPOSED FIRE HYDRANT
- PROPOSED CAP OR PLUG
- PROPOSED SINGLE METER, WATER SERVICE LINE
- PROPOSED DOUBLE METER, WATER SERVICE LINES
- PROPOSED CROSS, TEE, OR ELBOW
- PROPOSED SANITARY SEWER LINE
- PROPOSED MANHOLE
- PROPOSED CAP OR PLUG
- PROPOSED SANITARY SEWER SERVICE LINE
- PROPERTY OR BOUNDARY LINE
- CENTERLINE OF STREET
- CURB AND GUTTER
- SIDEWALK

ESPEY,
HUSTON &
ASSOCIATES, INC.
Engineering & Environmental Consultants
317 COMMERCIAL ST. N.E.
ALBUQUERQUE, NEW MEXICO 87102
PHONE: (505) 242-1909


CITY OF ALBUQUERQUE PUBLIC WORKS DEPARTMENT ENGINEERING GROUP					
TITLE: NOR ESTE ESTATES RIPPELE PLACE N.E. STA. 10+00.00 TO STA. 16+84.29					
APPROVALS	ENGINEER	DATE	APPROVALS	ENGINEER	DATE
D.R.C. Chair	<i>[Signature]</i>	10/5/07			
Trans. Dev	<i>[Signature]</i>	1/16/07			
Utility Dev	<i>[Signature]</i>	1/16/07			
DESIGNED BY <i>[Signature]</i> DATE 6/8/07 DRAWN BY <i>[Signature]</i> DATE 6/8/07 CHECKED BY <i>[Signature]</i> DATE 8/8/07					
DRAWING NO.	3186	MAP NO.	C-19	SHEET	70 OF 77

WATER AND SANITARY SEWER				
1. ALL STATIONING AND OFFSET DIMENSIONS ARE BASED ON CENTERLINE OF RIGHT-OF-WAY.				
2. THE FOLLOWING CITY OF ALBUQUERQUE STANDARD DRAWINGS ARE APPLICABLE TO THE WATER AND SANITARY SEWER CONSTRUCTION:				
2102	2145	2326	2344	2362
2110	2315	2328	2347	2365
2118	2320	2335	2360	2368
2125	2325	2340	2361	2369


RECORD DRAWING
This drawing is modified from public improvements as shown on the plan and profile sheets. The information and measurements obtained by EHA's field survey are the basis for the design. The modifications conform to the minimum standards for the design of water and sanitary sewer systems. The design is based on the best of my knowledge and belief.

[Signature]
Dennis A. Lorenz P.E.
3-17-88





BENCH MARKS	
THE STATION IS LOCATED 9 MILES NORTHEAST OF DOWNTOWN ALBUQUERQUE	CONTRACTOR NEW
DATE TO REACH THE STATION FROM THE INTERSECTION OF LOS ANGELES	DATE 07/08/07
BLVD AND LOS ANGELES DRIVE, GO EAST ON LOS ANGELES DRIVE 10 MILES	INSPECTORS FIELD
TO BARTON ST., THEN NORTH ON BARTON ST. 10 MILES TO ALBUQUERQUE	DATE 07/08/07
AVE. THE STATION IS LOCATED IN THE NORTHEAST QUADRANT OF THE	DATE 07/08/07
INTERSECTION "1-B20", SET IN TOP OF A CONCRETE POST PROJECTING	DATE 07/08/07
0.1 FEET ABOVE GROUND.	DATE 07/08/07
MSLD ELEVATION 5474.53'	DATE 07/08/07

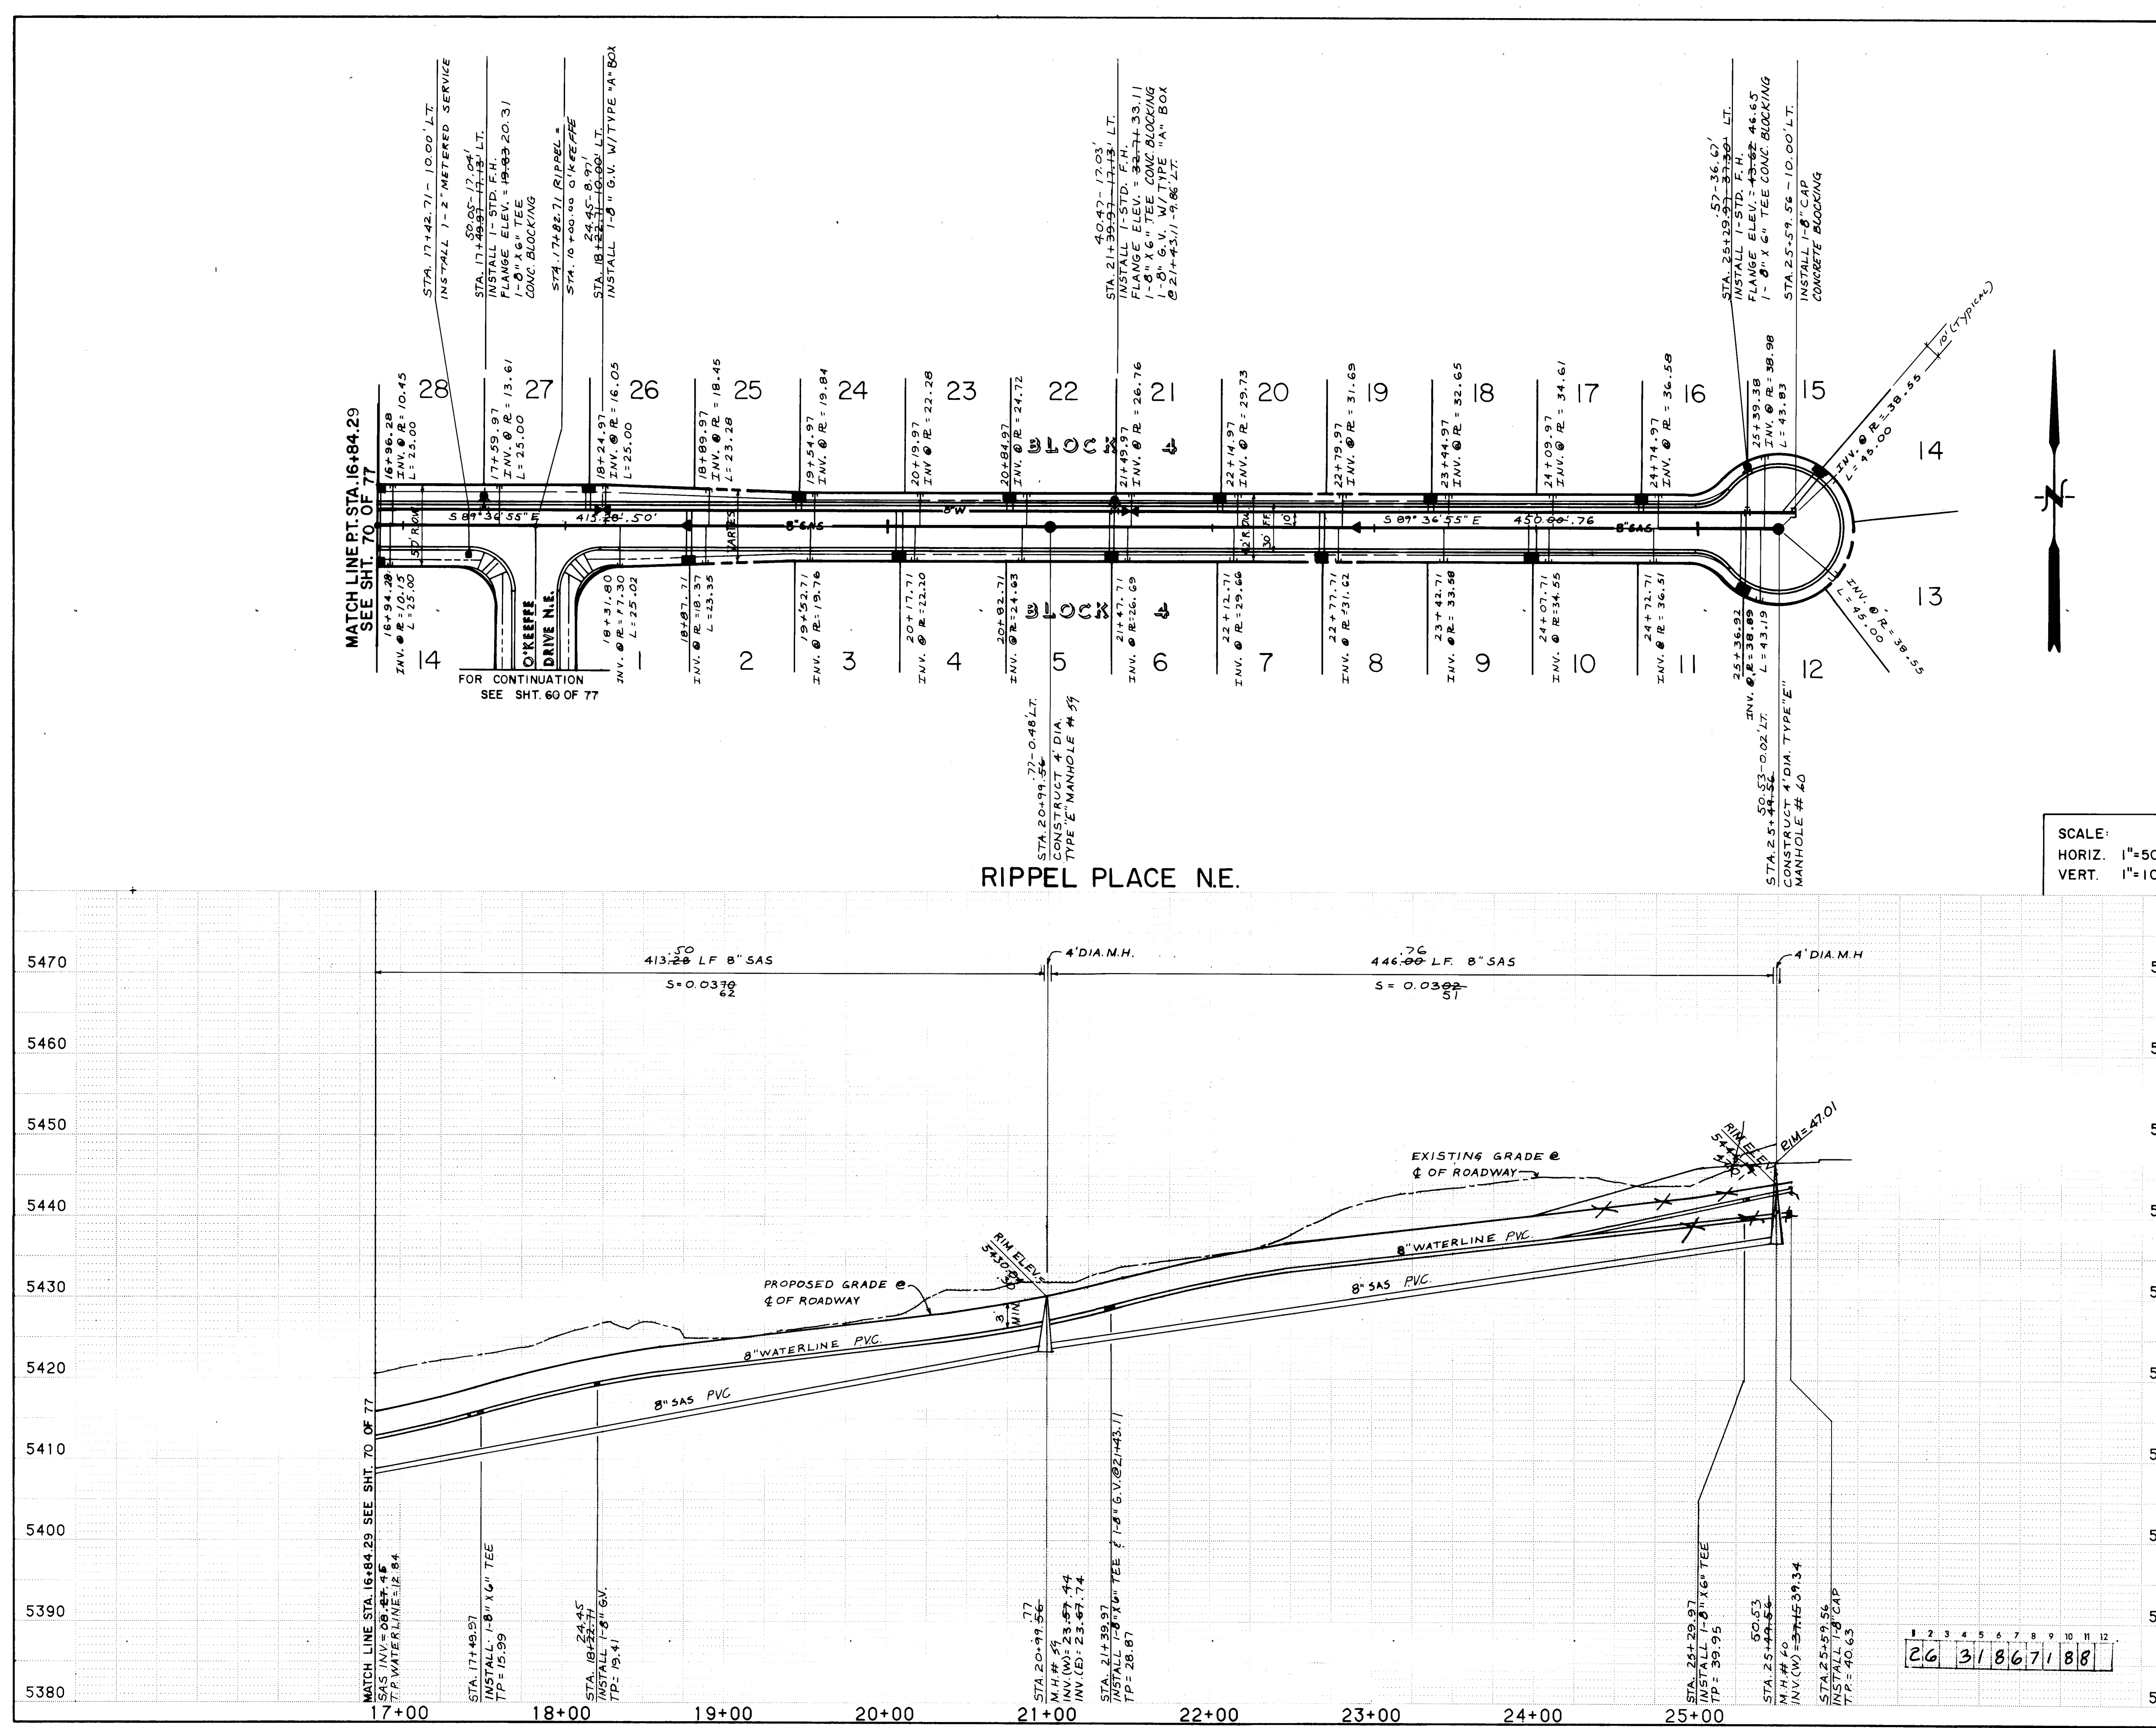[illegible]

CITY OF ALBUQUERQUE PUBLIC WORK DEPARTMENT ENGINEERING DIVISION					
TITLE: NOR ESTE ESTATES GRADING DETAILS					
APPROVALS	ENGINEER	DATE	APPROVALS	ENGINEER	DATE
City Engineer	<i>[Signature]</i>	10/5/87	Liquid Waste	<i>NH</i>	JEE 8/31/87
A.C.E. - Design			Traffic		NADWA 7/16/87
A.C.E. - Hydrology	<i>[Signature]</i>	9-18-87	Water	<i>NH</i>	JEE 8/31/87
A.M.A.F.C.A.	<i>[Signature]</i>	8/24/87			
DRAWING NO.	3186		MAP NO.	C-19	
			SHEET	72	OF 77

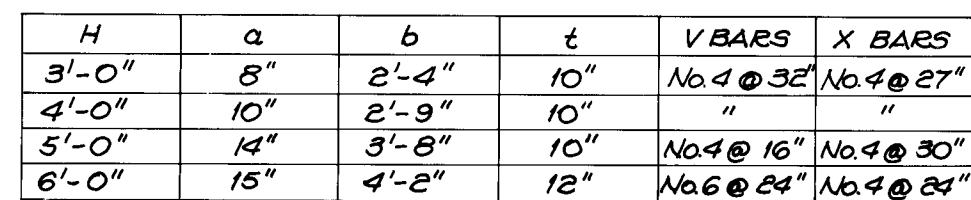


CMU RETAINING WALL DETAIL

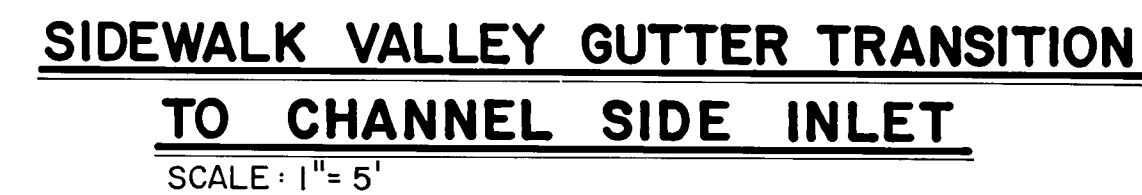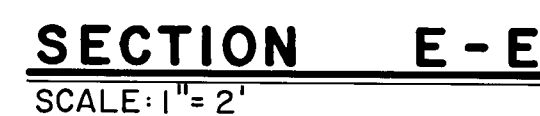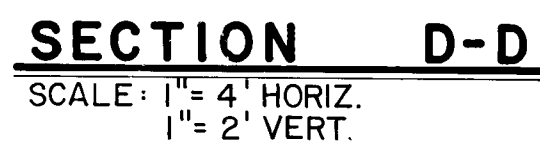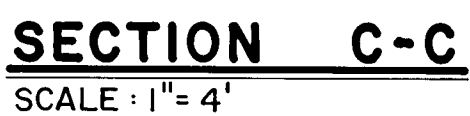


1	2	3	4	5	6	7	8	9	10
26	31	86	73	88					

CITY OF ALBUQUERQUE PUBLIC WORKS DEPARTMENT ENGINEERING DIVISION	
TITLE:	NOR ESTE ESTATES GRADING DETAILS


APPROVALS	ENGINEER	DATE	APPROVALS	ENGINEER	DATE
City Engineer	<i>[Signature]</i>	10/5/67	Liquid Waste	<i>[Signature]</i>	8/31/67
A.C.E - Design			Traffic	<i>[Signature]</i>	9/11/67
A.C.E - Hydrology	<i>[Signature]</i>	9-1-67	Water	<i>[Signature]</i>	8/31/67
A.M.A.F.C.A.	<i>[Signature]</i>	8/27/67			
DRAWING NO.	3186	MAP NO.	C-19	SHEET	73 OF 77

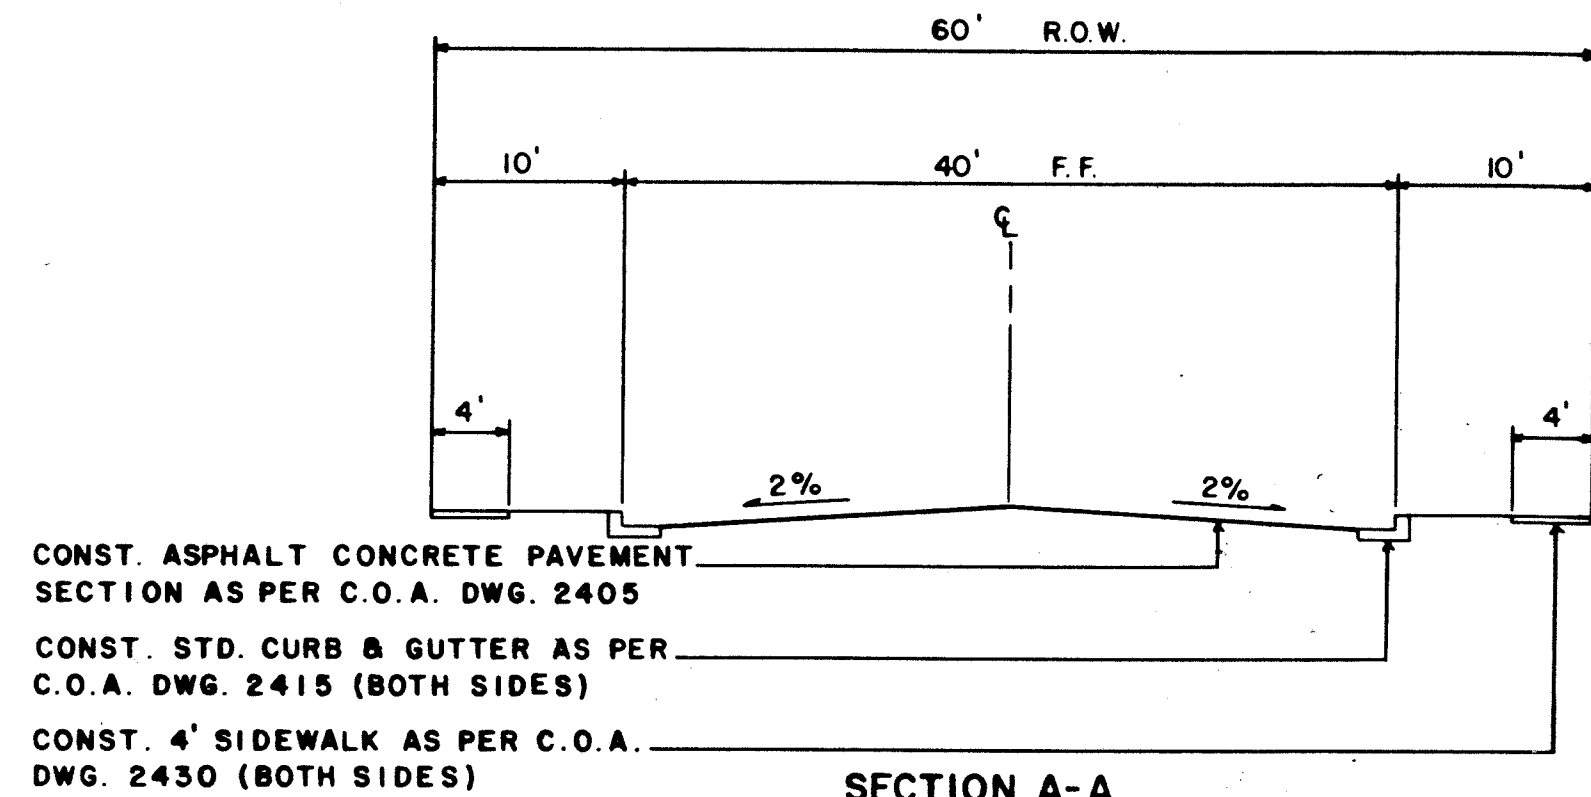


SECTION A-A
 SCALE: 1" = 10'

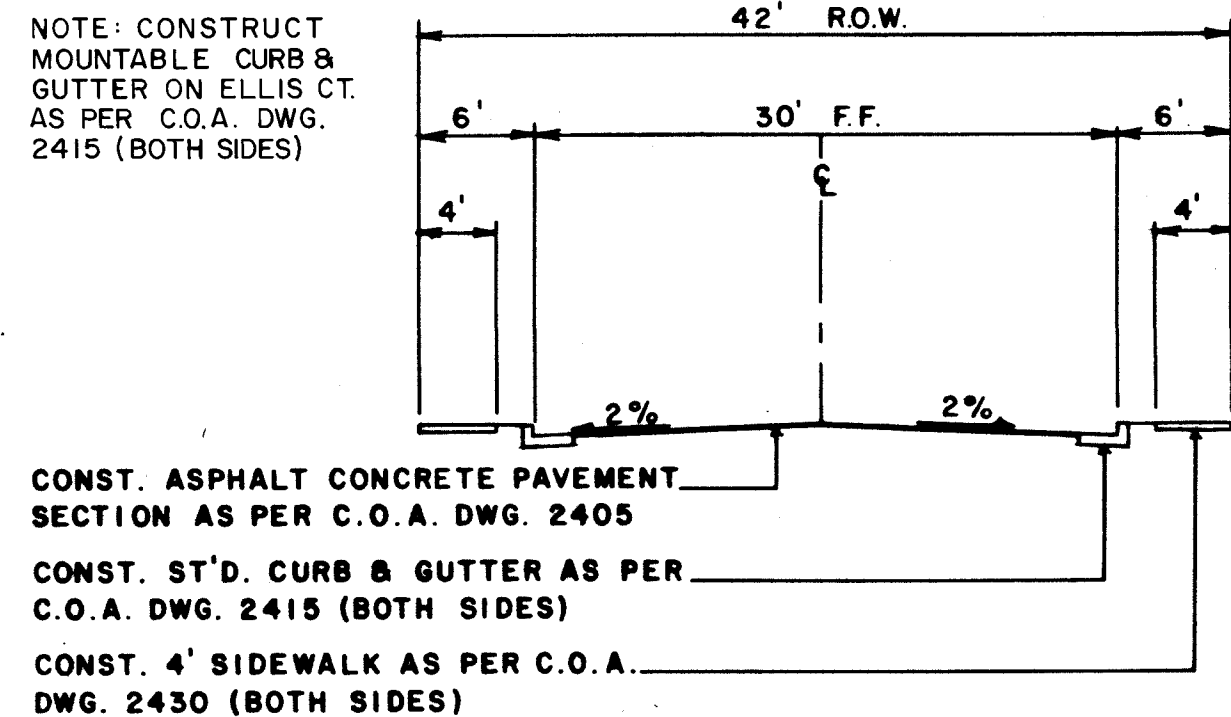


SECTION B-B
 SCALE: 1" = 10'

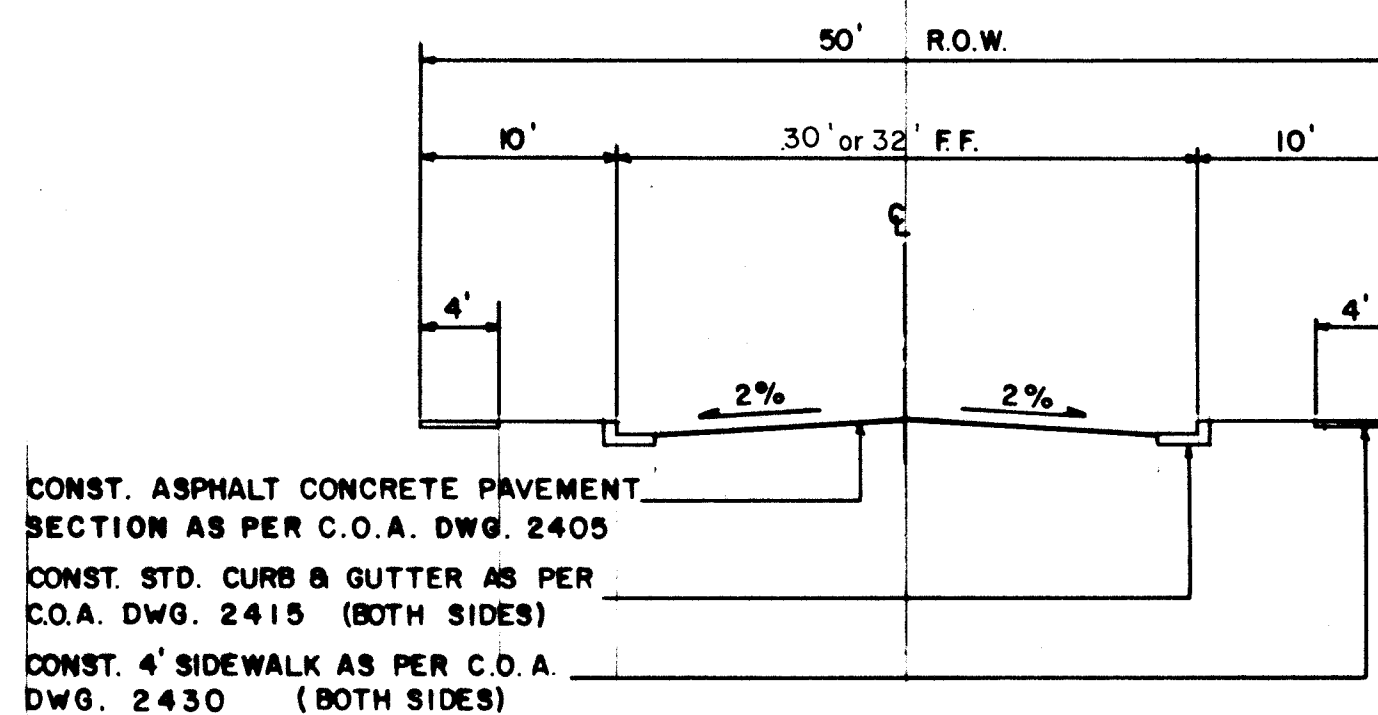


SECTION C-C
 SCALE: 1" = 10'

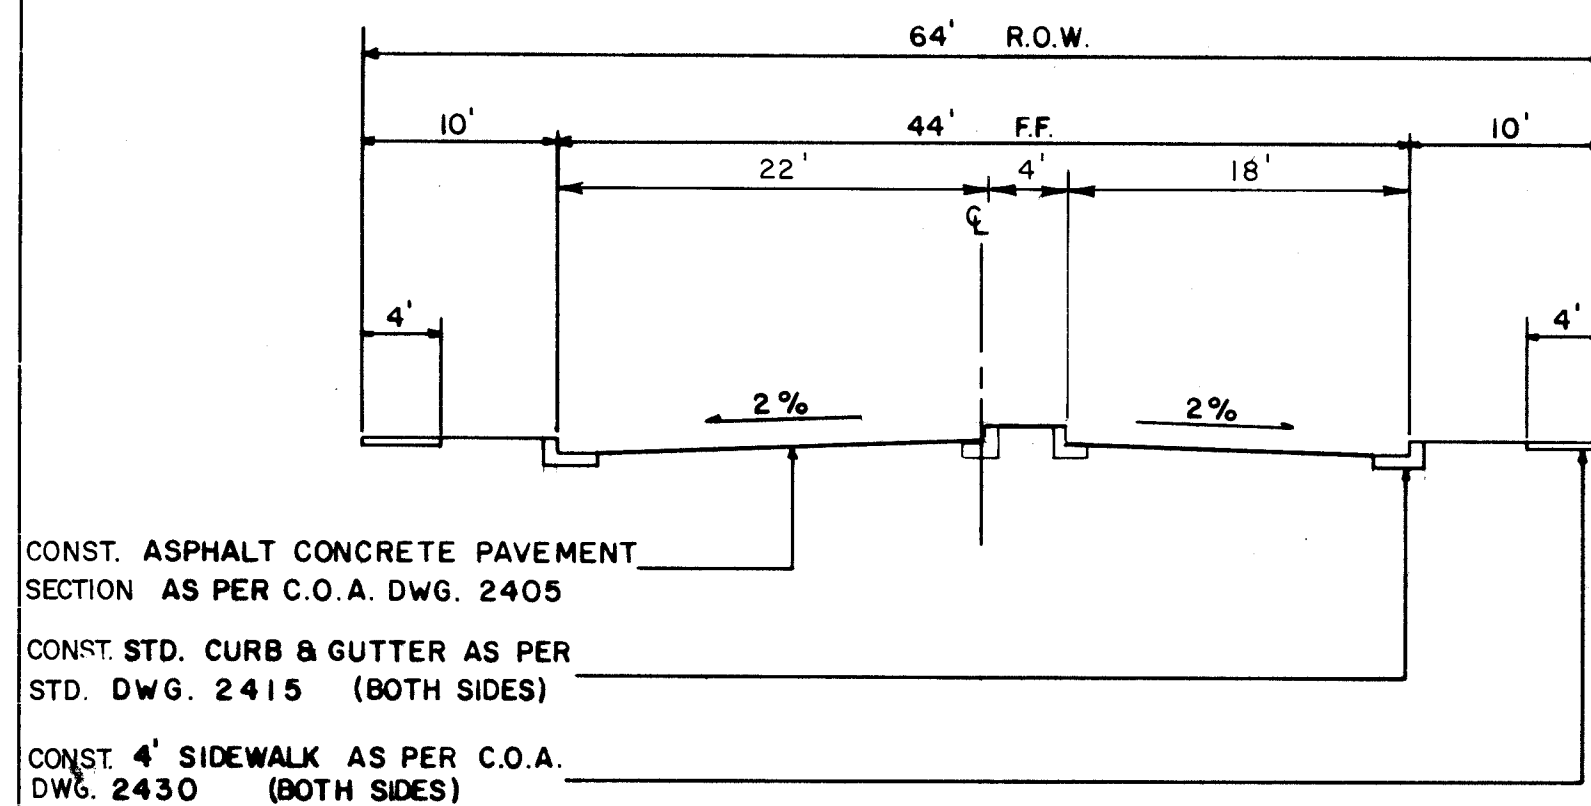


SECTION D-D
 SCALE: 1" = 10'

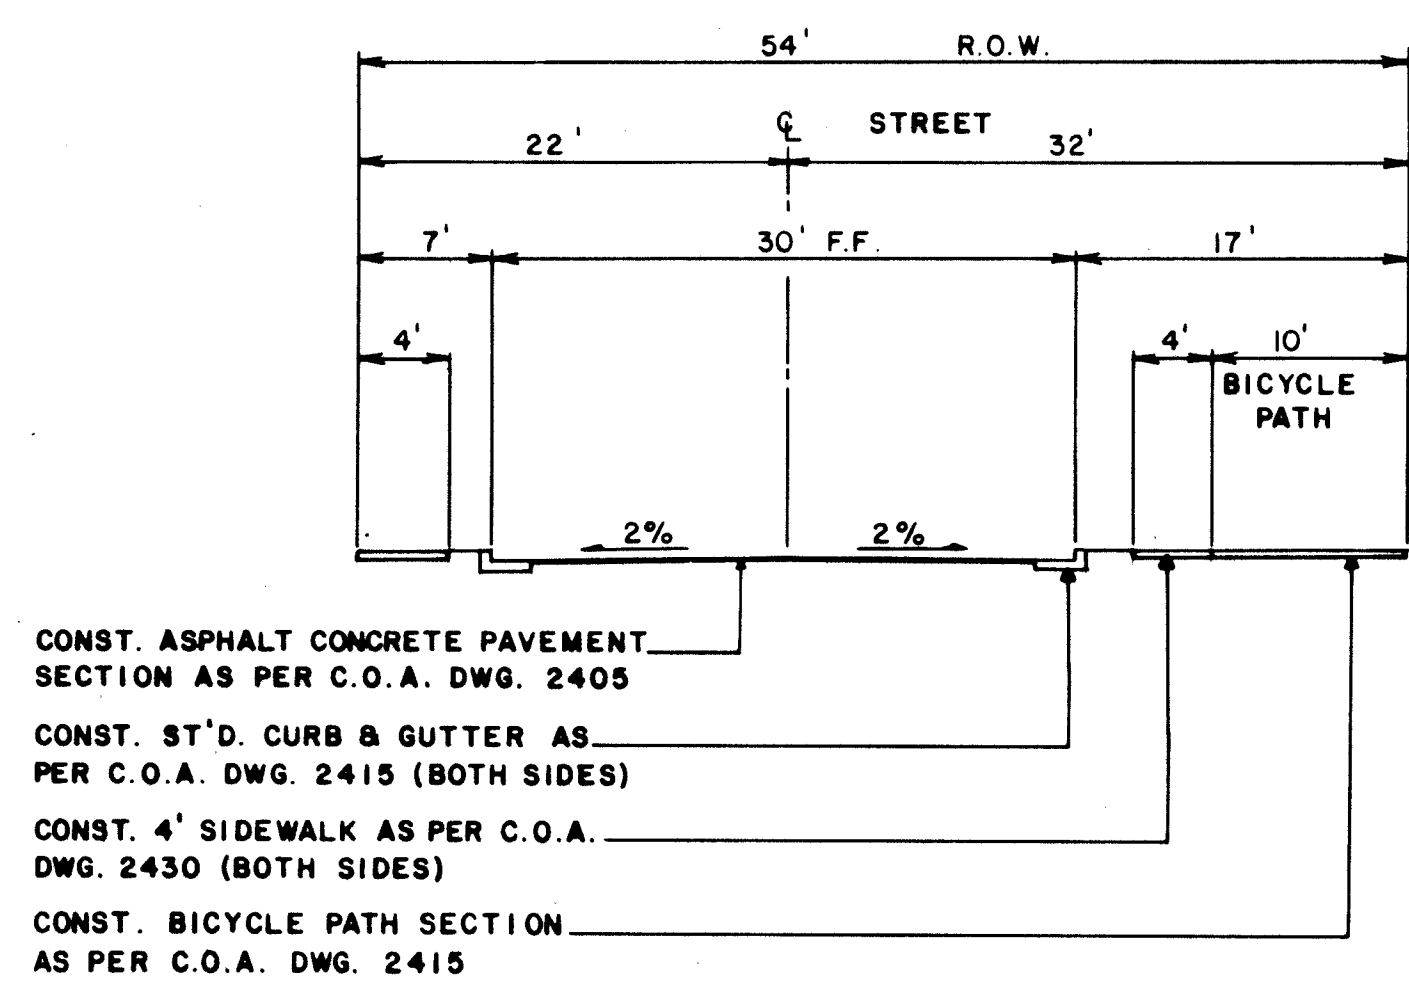


SECTION E-E
 SCALE: 1" = 10'

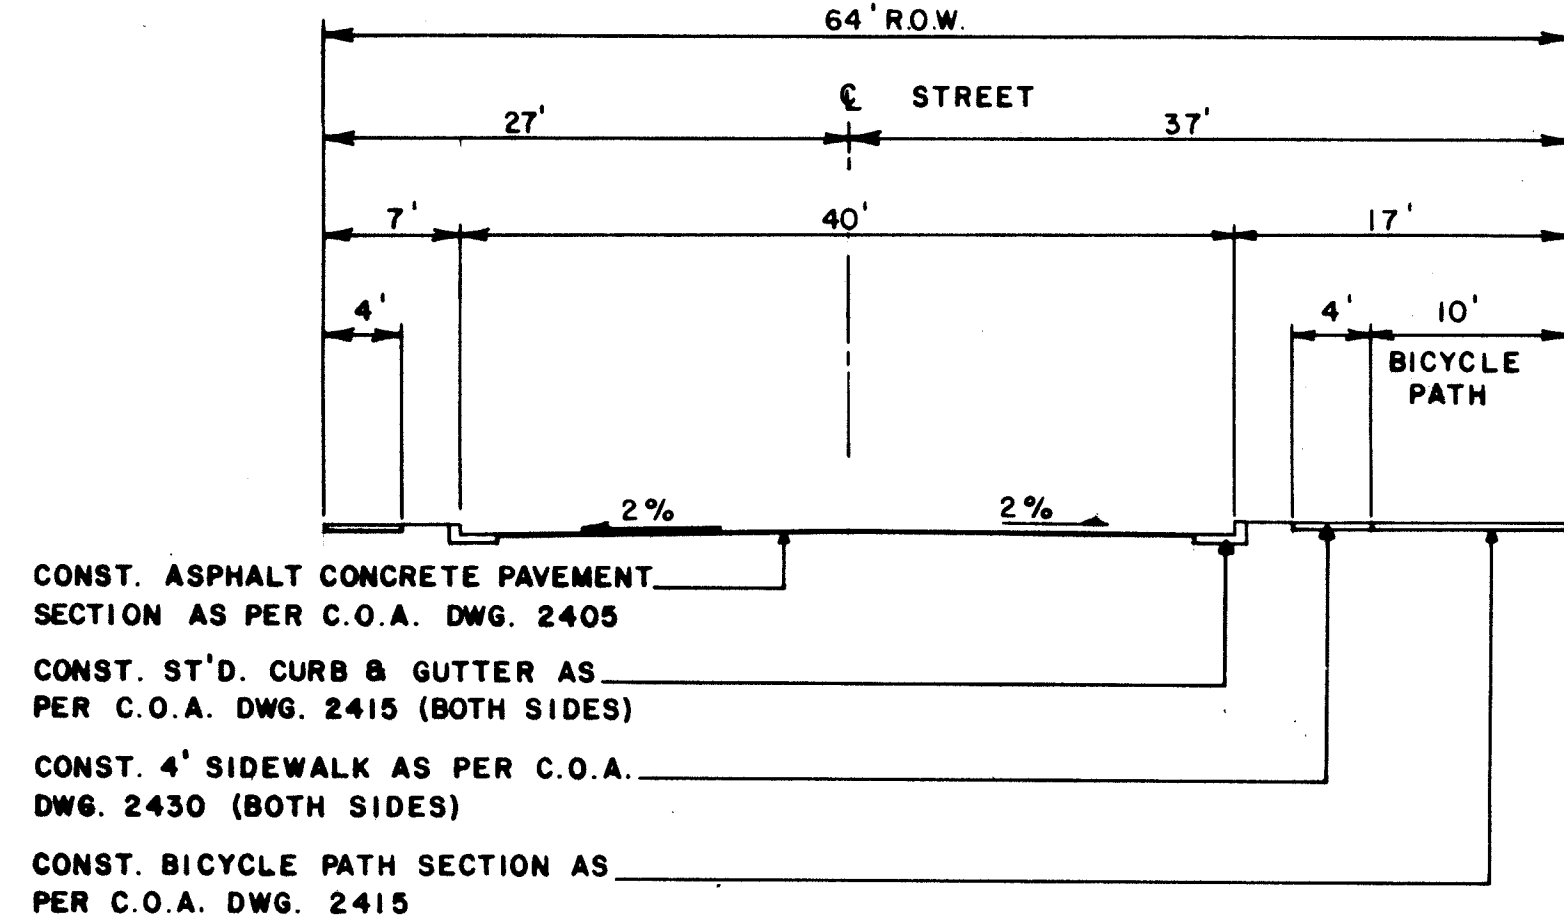


SECTION F-F
 SCALE: 1" = 10'

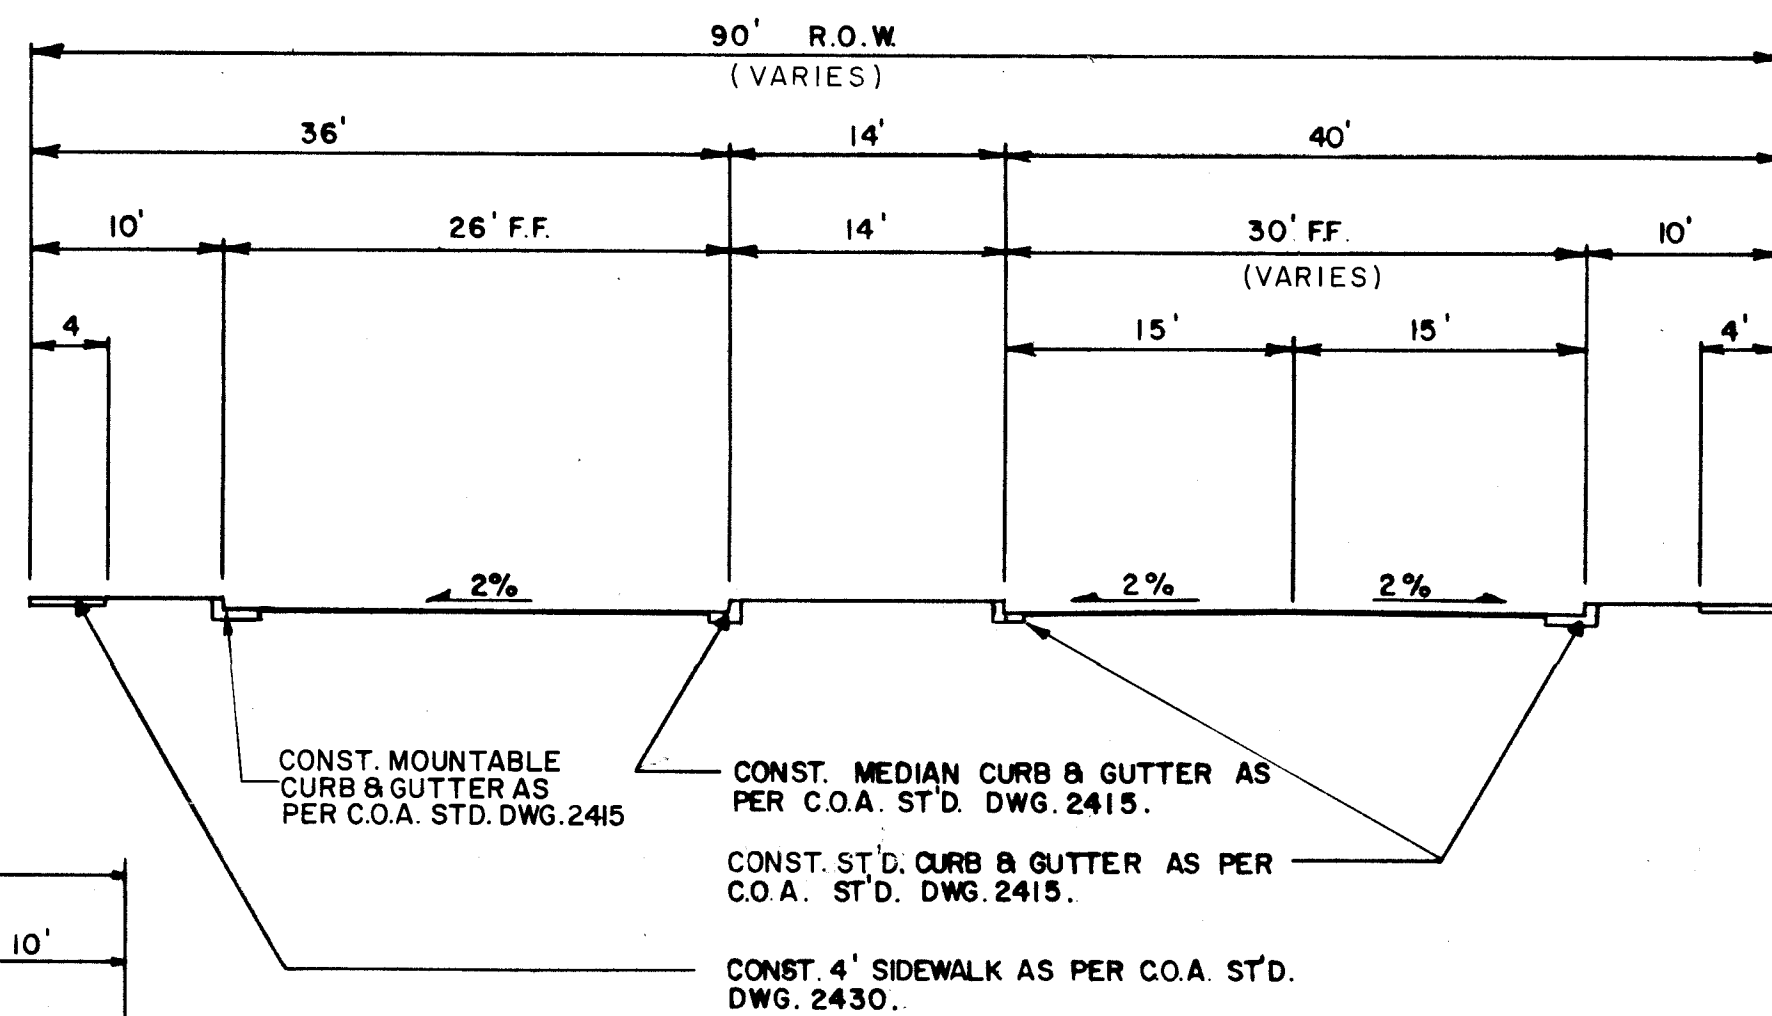


SECTION G-G
 SCALE: 1" = 10'

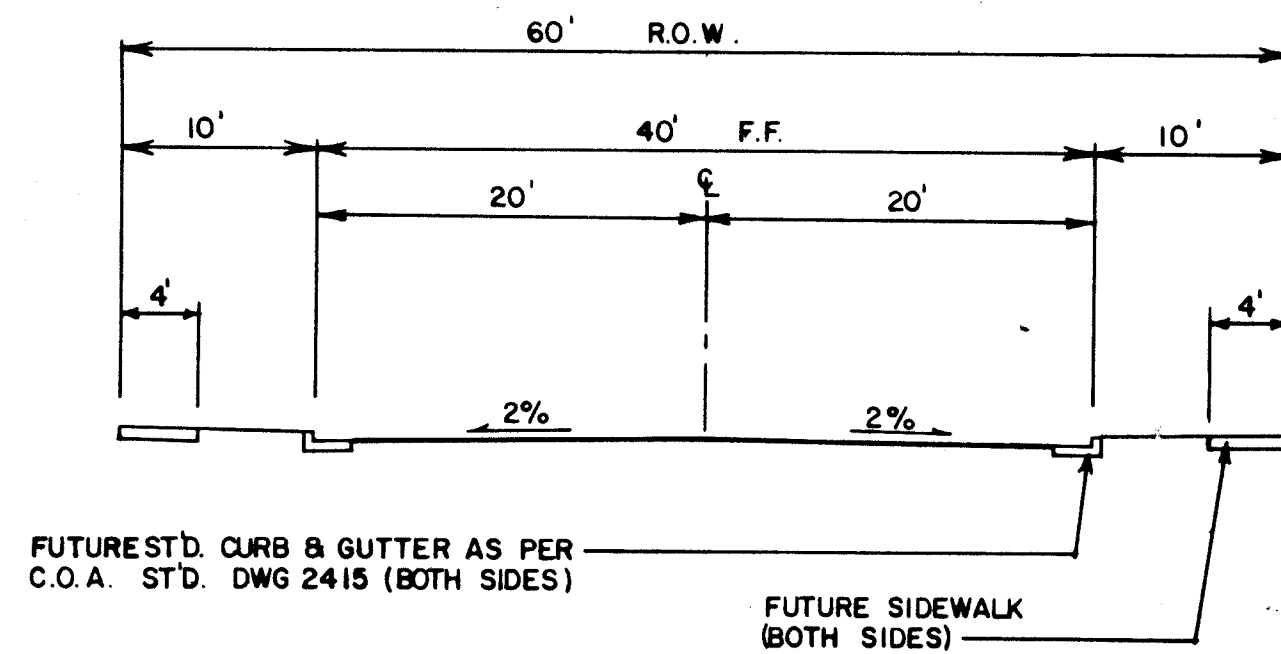


SECTION H-H (FUTURE N.I.C.)
 SCALE: 1" = 10'

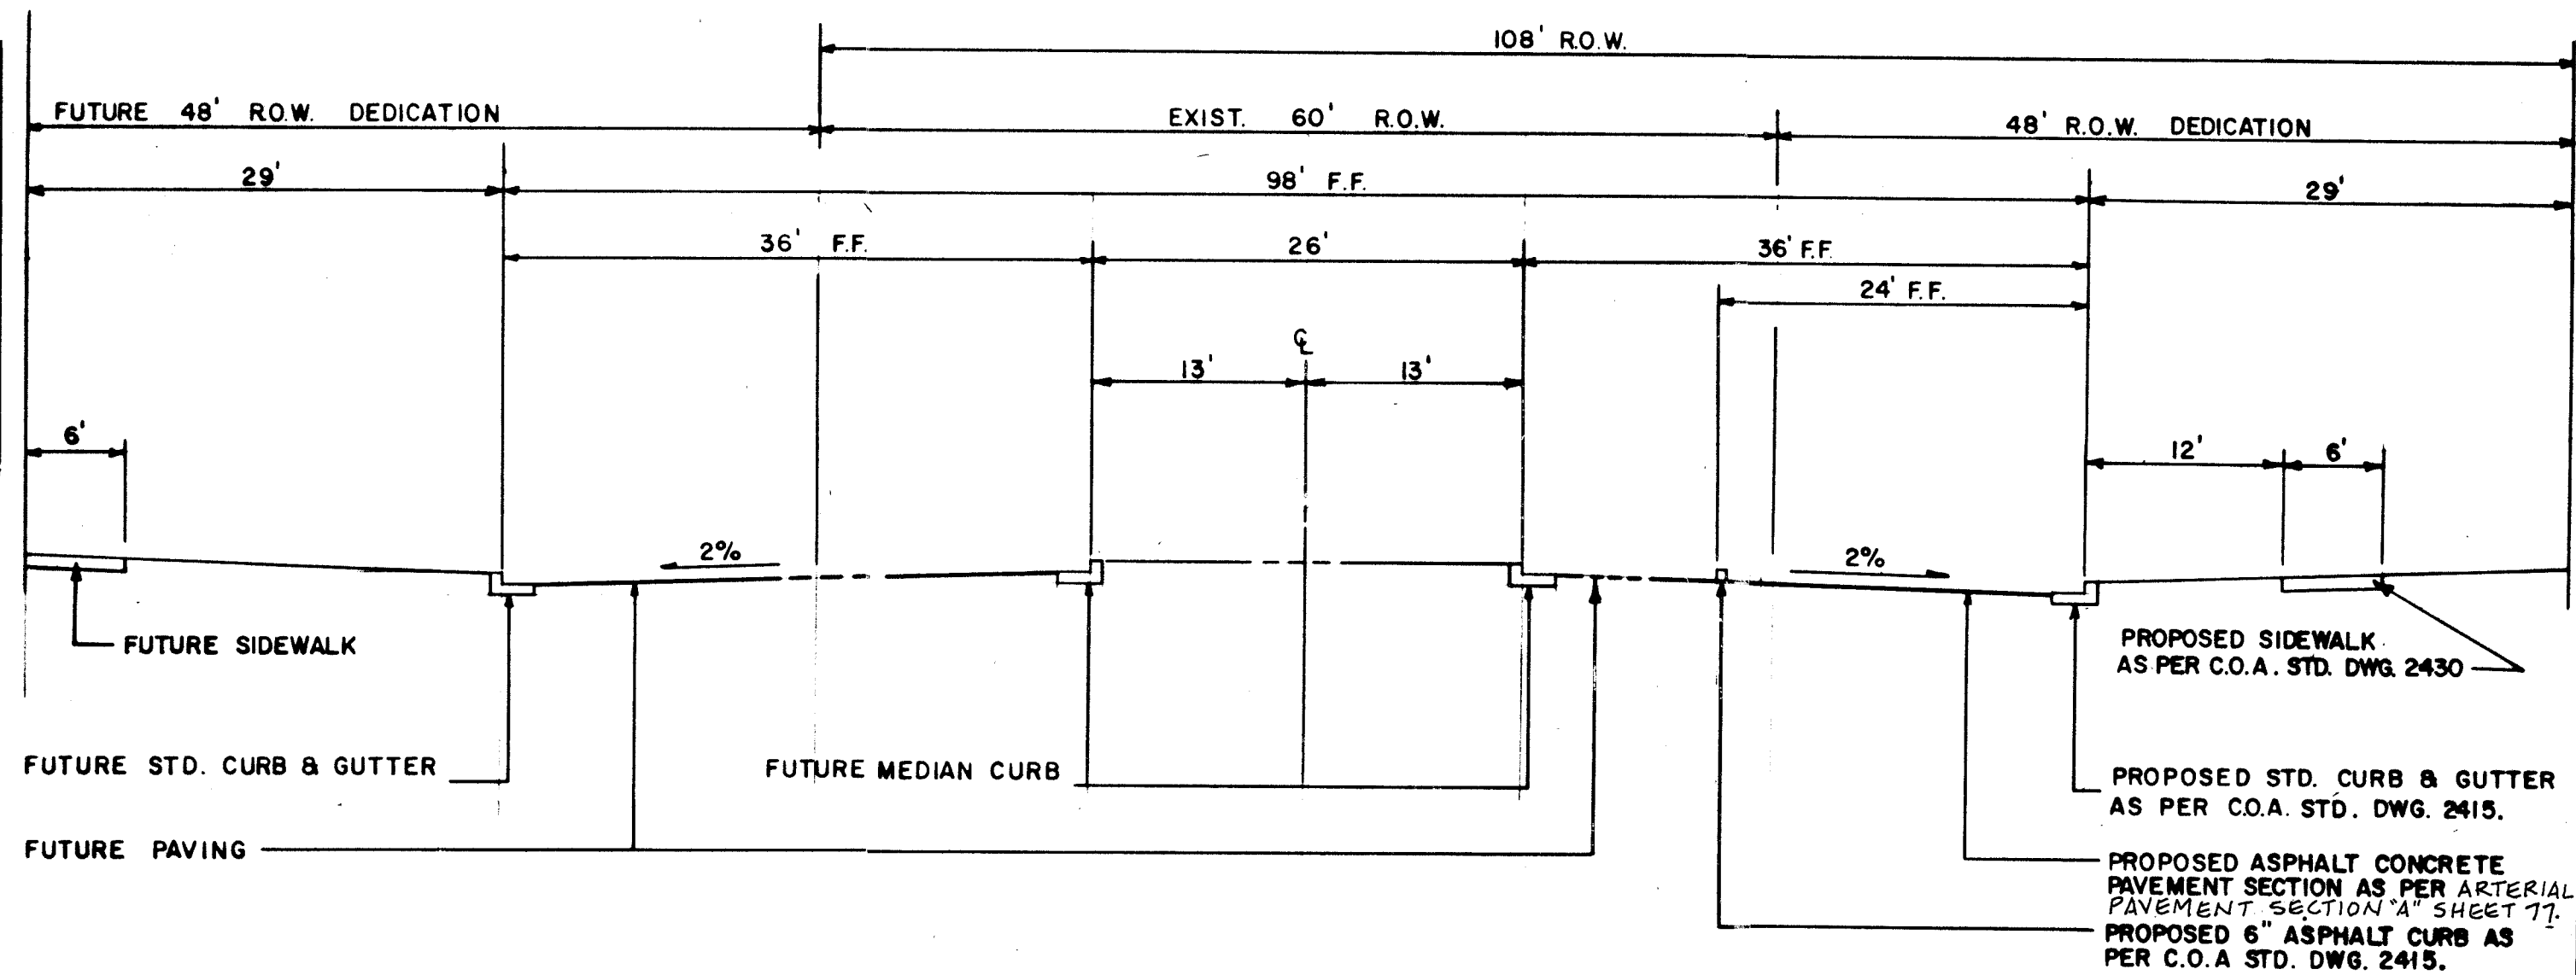

SECTION J-J
 SCALE: 1" = 10'

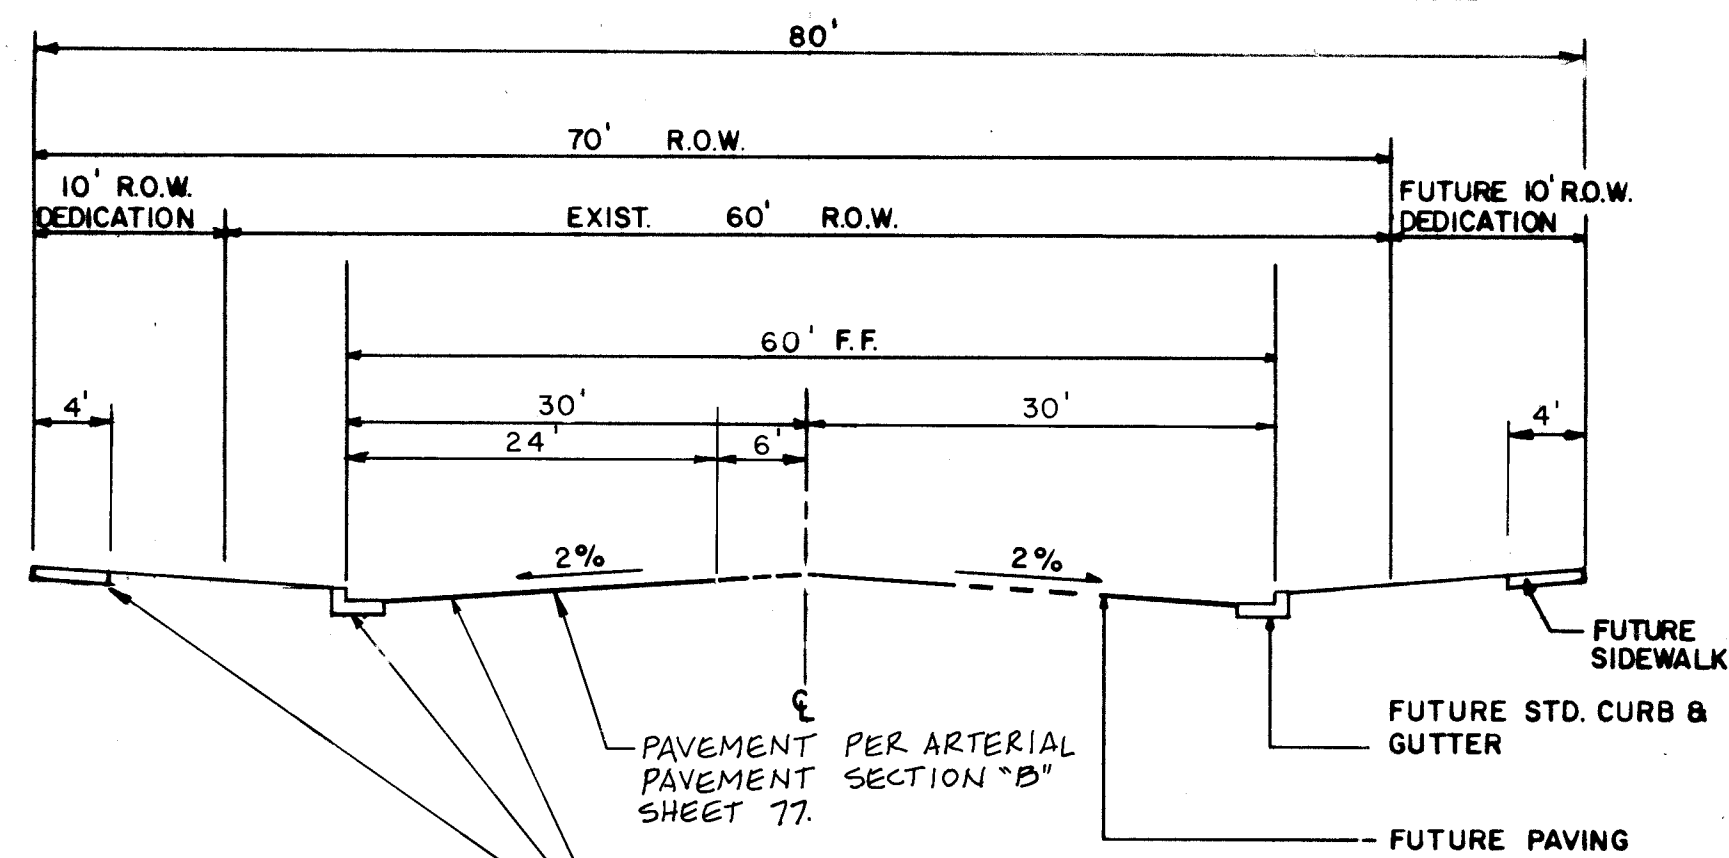

SECTION K-K
 SCALE: 1" = 10'

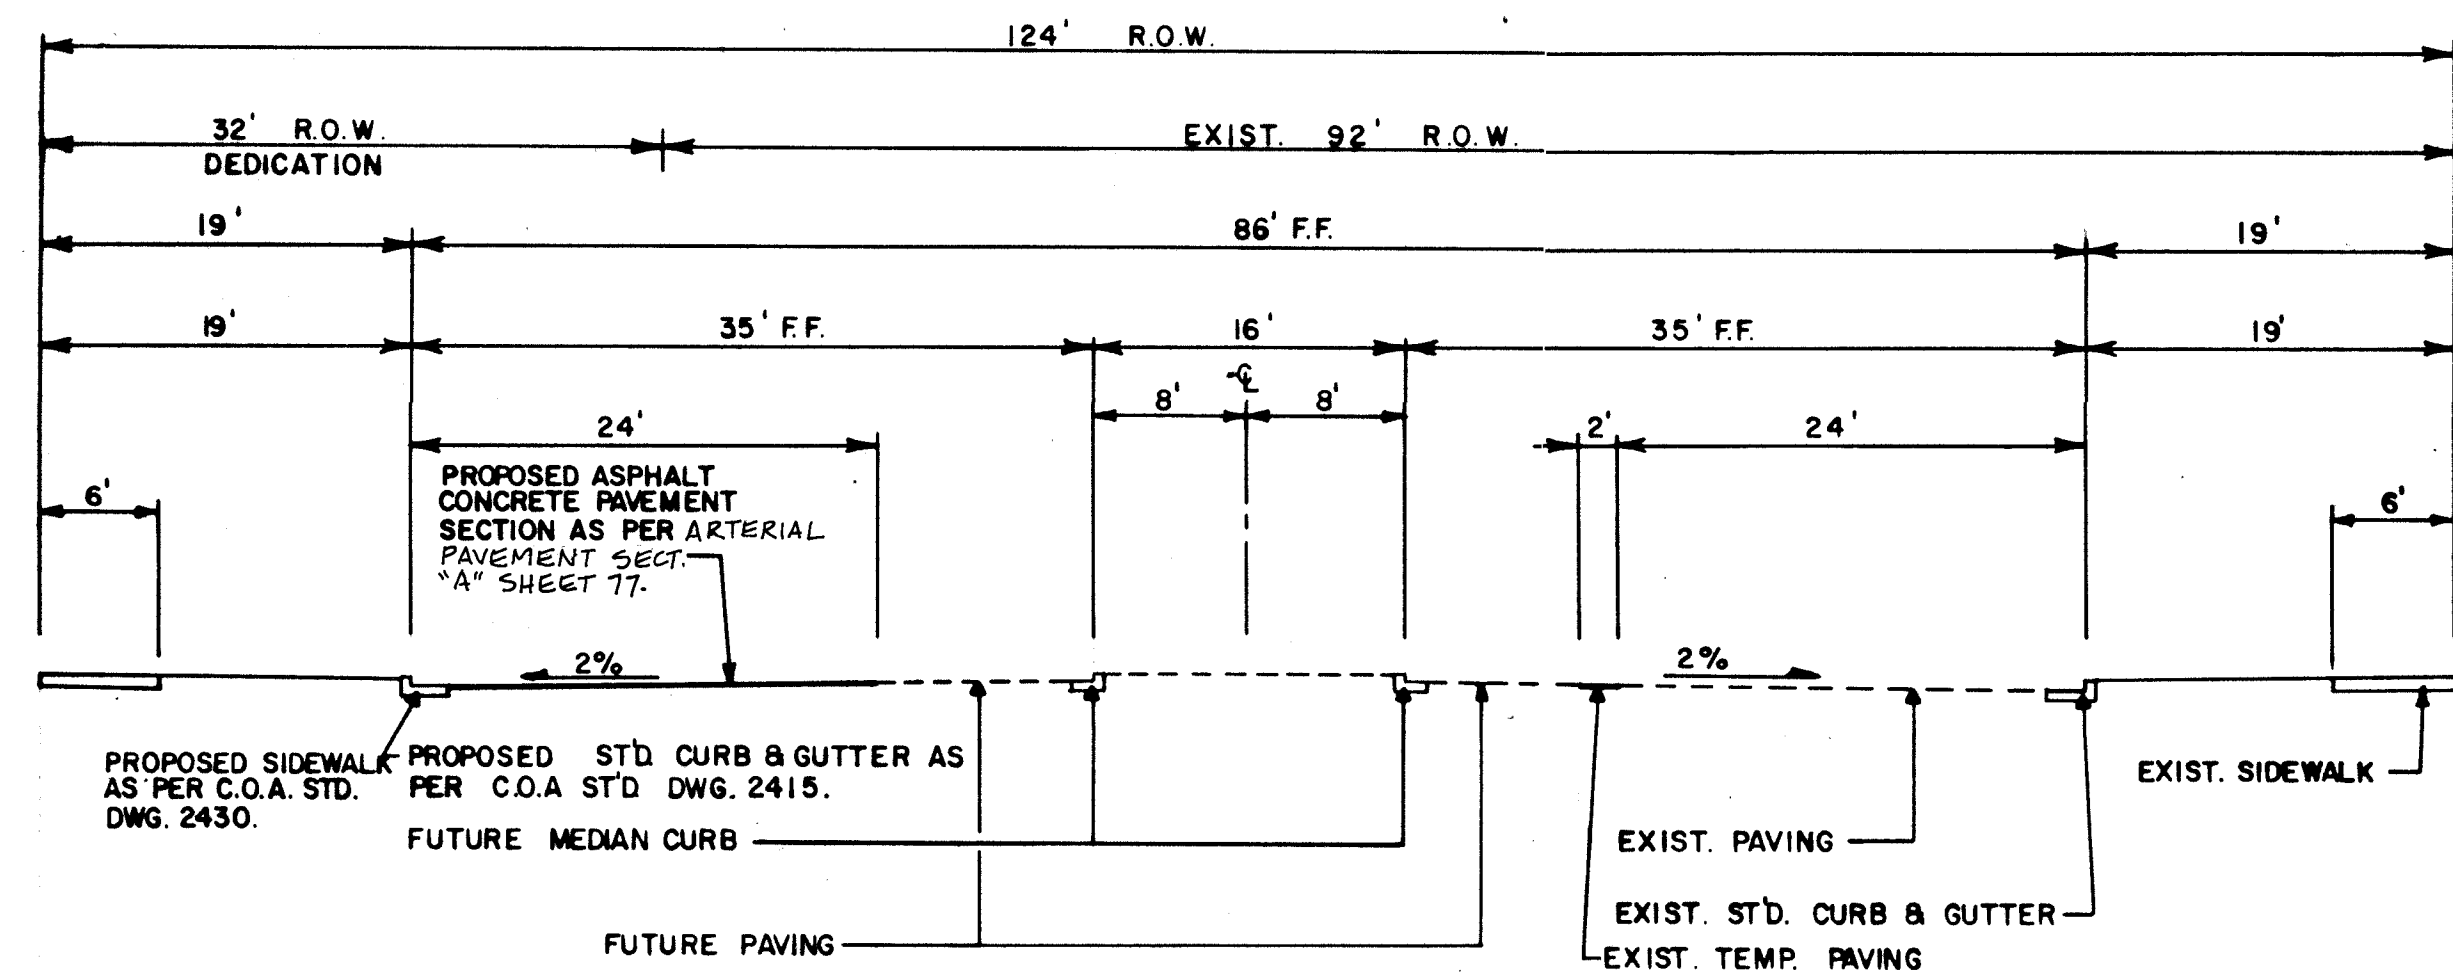

SECTION L-L
 SCALE: 1" = 10'


AS BUILT INFORMATION				BENCH MARKS				SURVEY INFORMATION				ENGINEER'S SEAL				
CONTRACTOR	DATE	BY	NO.	CONTRACTOR	DATE	BY	NO.	NO.	DATE	BY	NO.	NO.	DATE	BY	NO.	

REVISIONS			
NO.	DATE	REMARKS	BY
1	8/1/07	DESIGN	AS MC
2	8/1/07	DESIGN	AS MC



CITY OF ALBUQUERQUE MUNICIPAL DEVELOPMENT DEPARTMENT ENGINEERING DIVISION					
TITLE: NOR ESTE ESTATES STREET SECTIONS					
APPROVALS	ENGINEER	DATE	APPROVALS	ENGINEER	DATE
City Engineer	<i>[Signature]</i>	10/5/07	Liquid Waste	<i>[Signature]</i>	8/31/07
A.C.E. - Design	<i>[Signature]</i>	9-1-07	Traffic	<i>[Signature]</i>	8/31/07
A.C.E. - Hydrology	<i>[Signature]</i>	9-1-07	Water	<i>[Signature]</i>	8/31/07

DRAWING NO.	MAP NO.	SHEET OF
3186	C-19	74 77

26 3186.7488

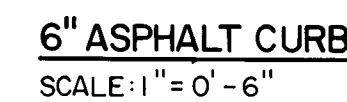

CURVE DATA				
NO.	DELTA	RADIUS	LENGTH	TAN
1	89° 46' 05"	5.00	7.83	4.98
2	147° 29' 53"	2.00	5.15	6.86
3	11° 32' 16"	81.00	16.31	8.18
4	10° 28' 50"	81.00	14.82	7.43
5	148° 59' 50"	3.00	7.80	10.82
6	04° 14' 42"	81.00	6.00	3.00
7	48° 15' 23"	60.00	50.53	26.87

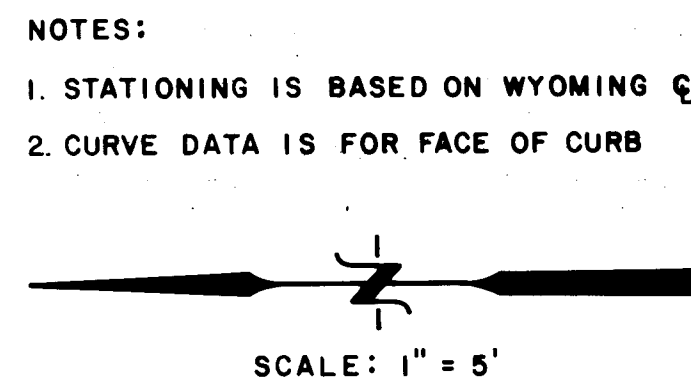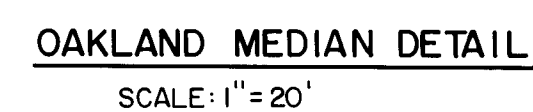

WYOMING BOULEVARD N.E.

CROSSWALK ISLAND DETAIL

ALAMEDA BOULEVARD N. E.

RECORD DRAWING

This drawing as modified shows public improvements as constructed. These modifications have been made on the basis of information and measurements obtained by EKA's field survey crew, the Contractor and City Inspector. The modifications were made to the minimum requirements for record drawing as set forth in the City of Los Angeles Development Process Manual. The City Engineer's knowledge and best professional judgment are hereby certified to be correct.

3-14-88

IN REPLY TO: 3401

DATE: 3-14-88

Dennis A. Lorenz P.E. 6847


1	2	3	4	5	6	7	8	9	10	11	12
26	31	8	6	7	5	8	8				

CITY OF ALBUQUERQUE
PUBLIC WORKS DEPARTMENT
ENGINEERING DIVISION


TITLE: NOR ESTE ESTATES
PAVING DETAIL

APPROVALS	ENGINEER	DATE	APPROVALS	ENGINEER	DATE
City Engineer	<i>[Signature]</i>	10/5/87	Liquid Waste <i>NA</i>	<i>JEE</i>	8/31/87
A C E - Design	" "	"	Traffic	<i>David W. Hansen</i>	9/16/87
A C E - Hydrology	<i>MA RAN</i>	9-1-87	Water <i>NA</i>	<i>JEE</i>	8/31/87


DRAWING NO.	3186	MAP NO.	C-19	SHEET	75	OF	77
-------------	------	---------	------	-------	----	----	----

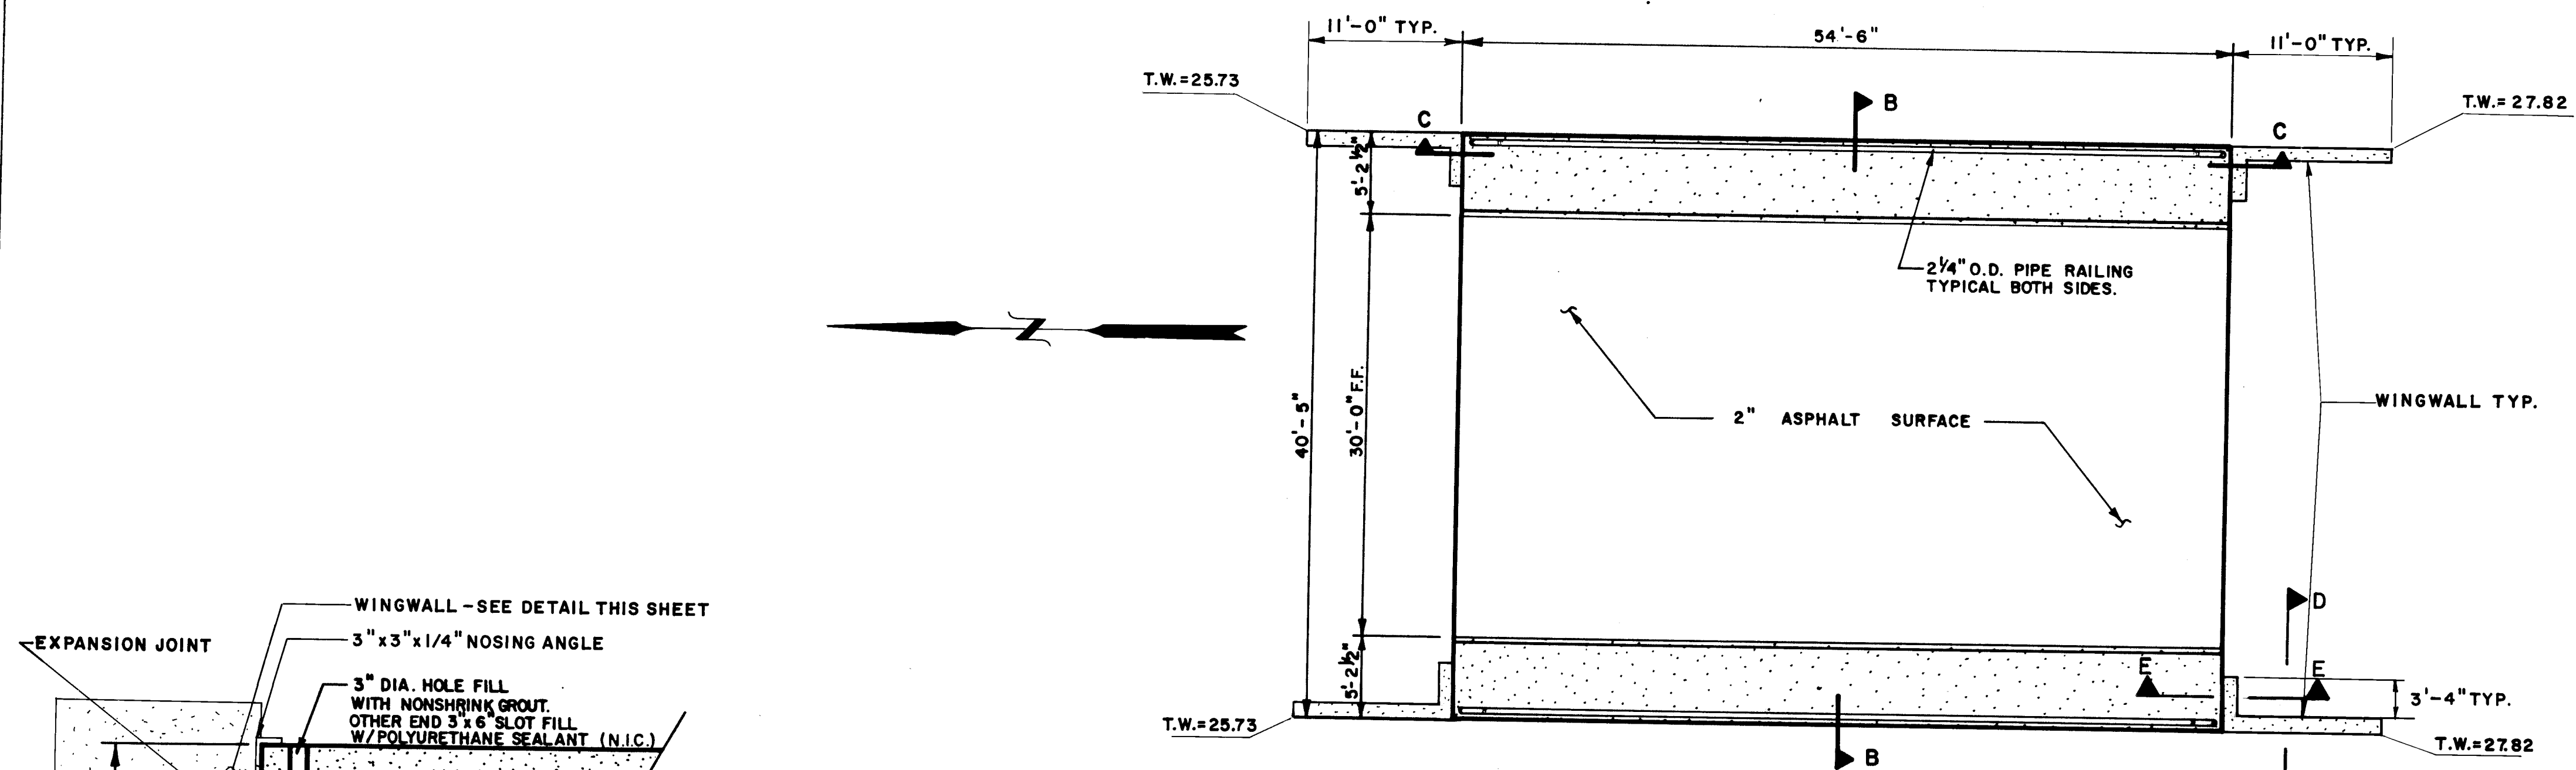


PLAN VIEW OF BRIDGE
SCALE: 1/8" = 1'-0"

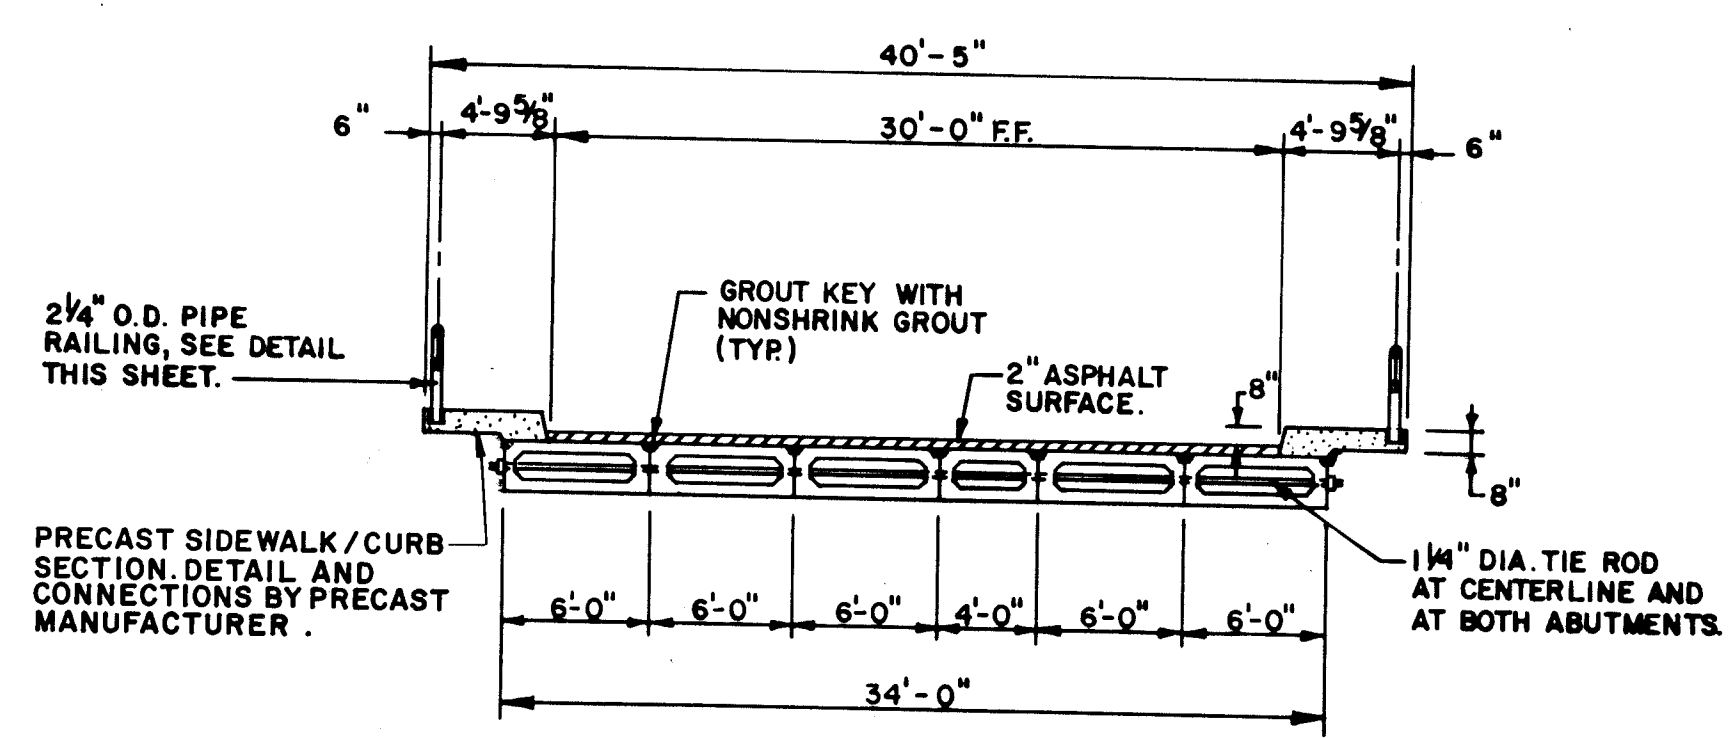


SECTION B-B
SCALE: 1/8" = 1'-0"

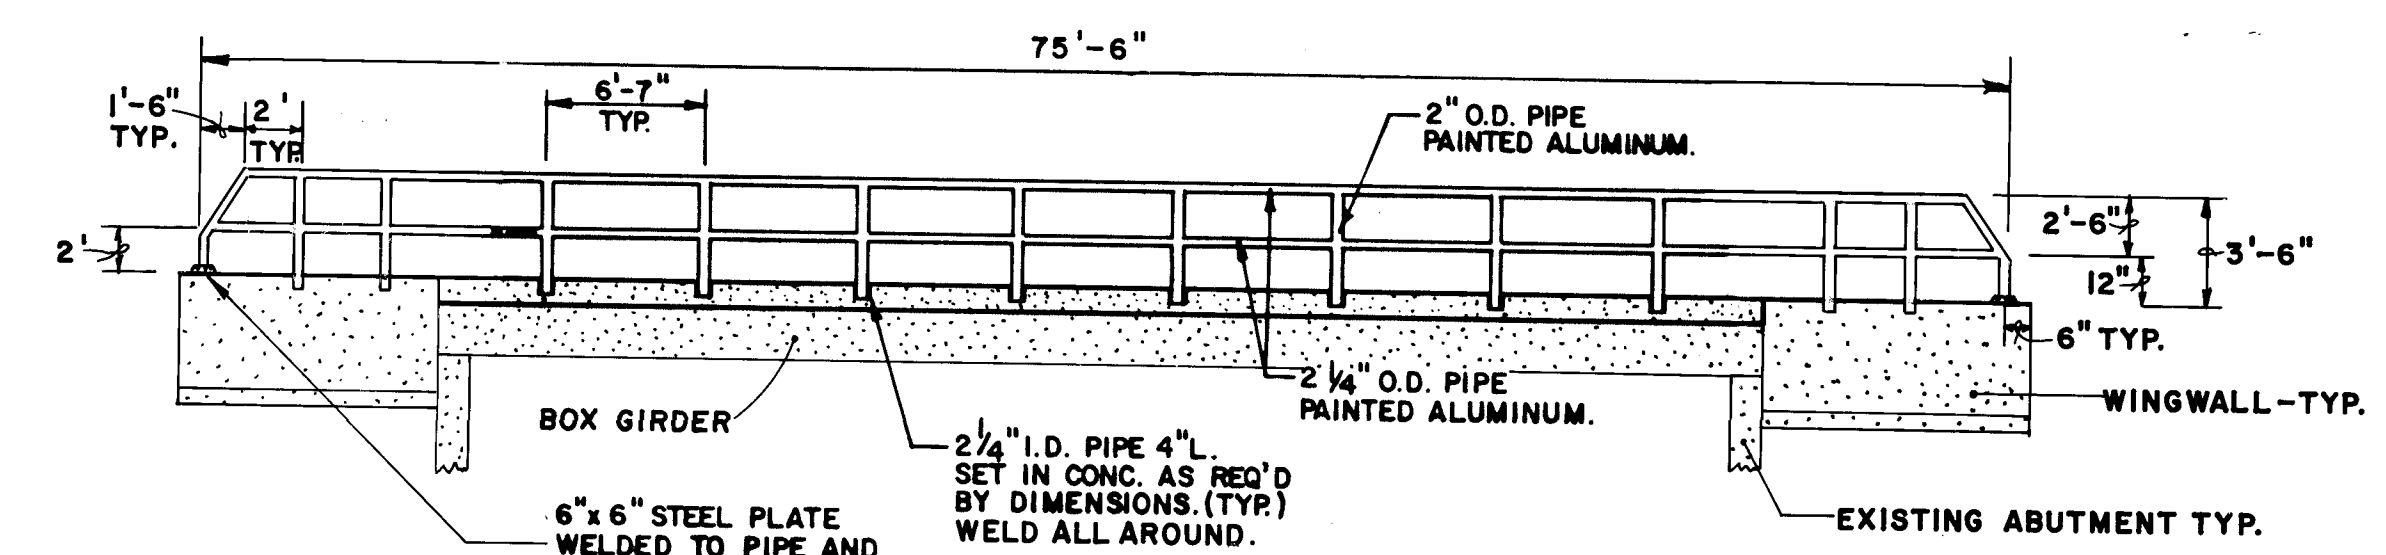

SECTION C-C
SCALE: 1/8" = 1'-0"

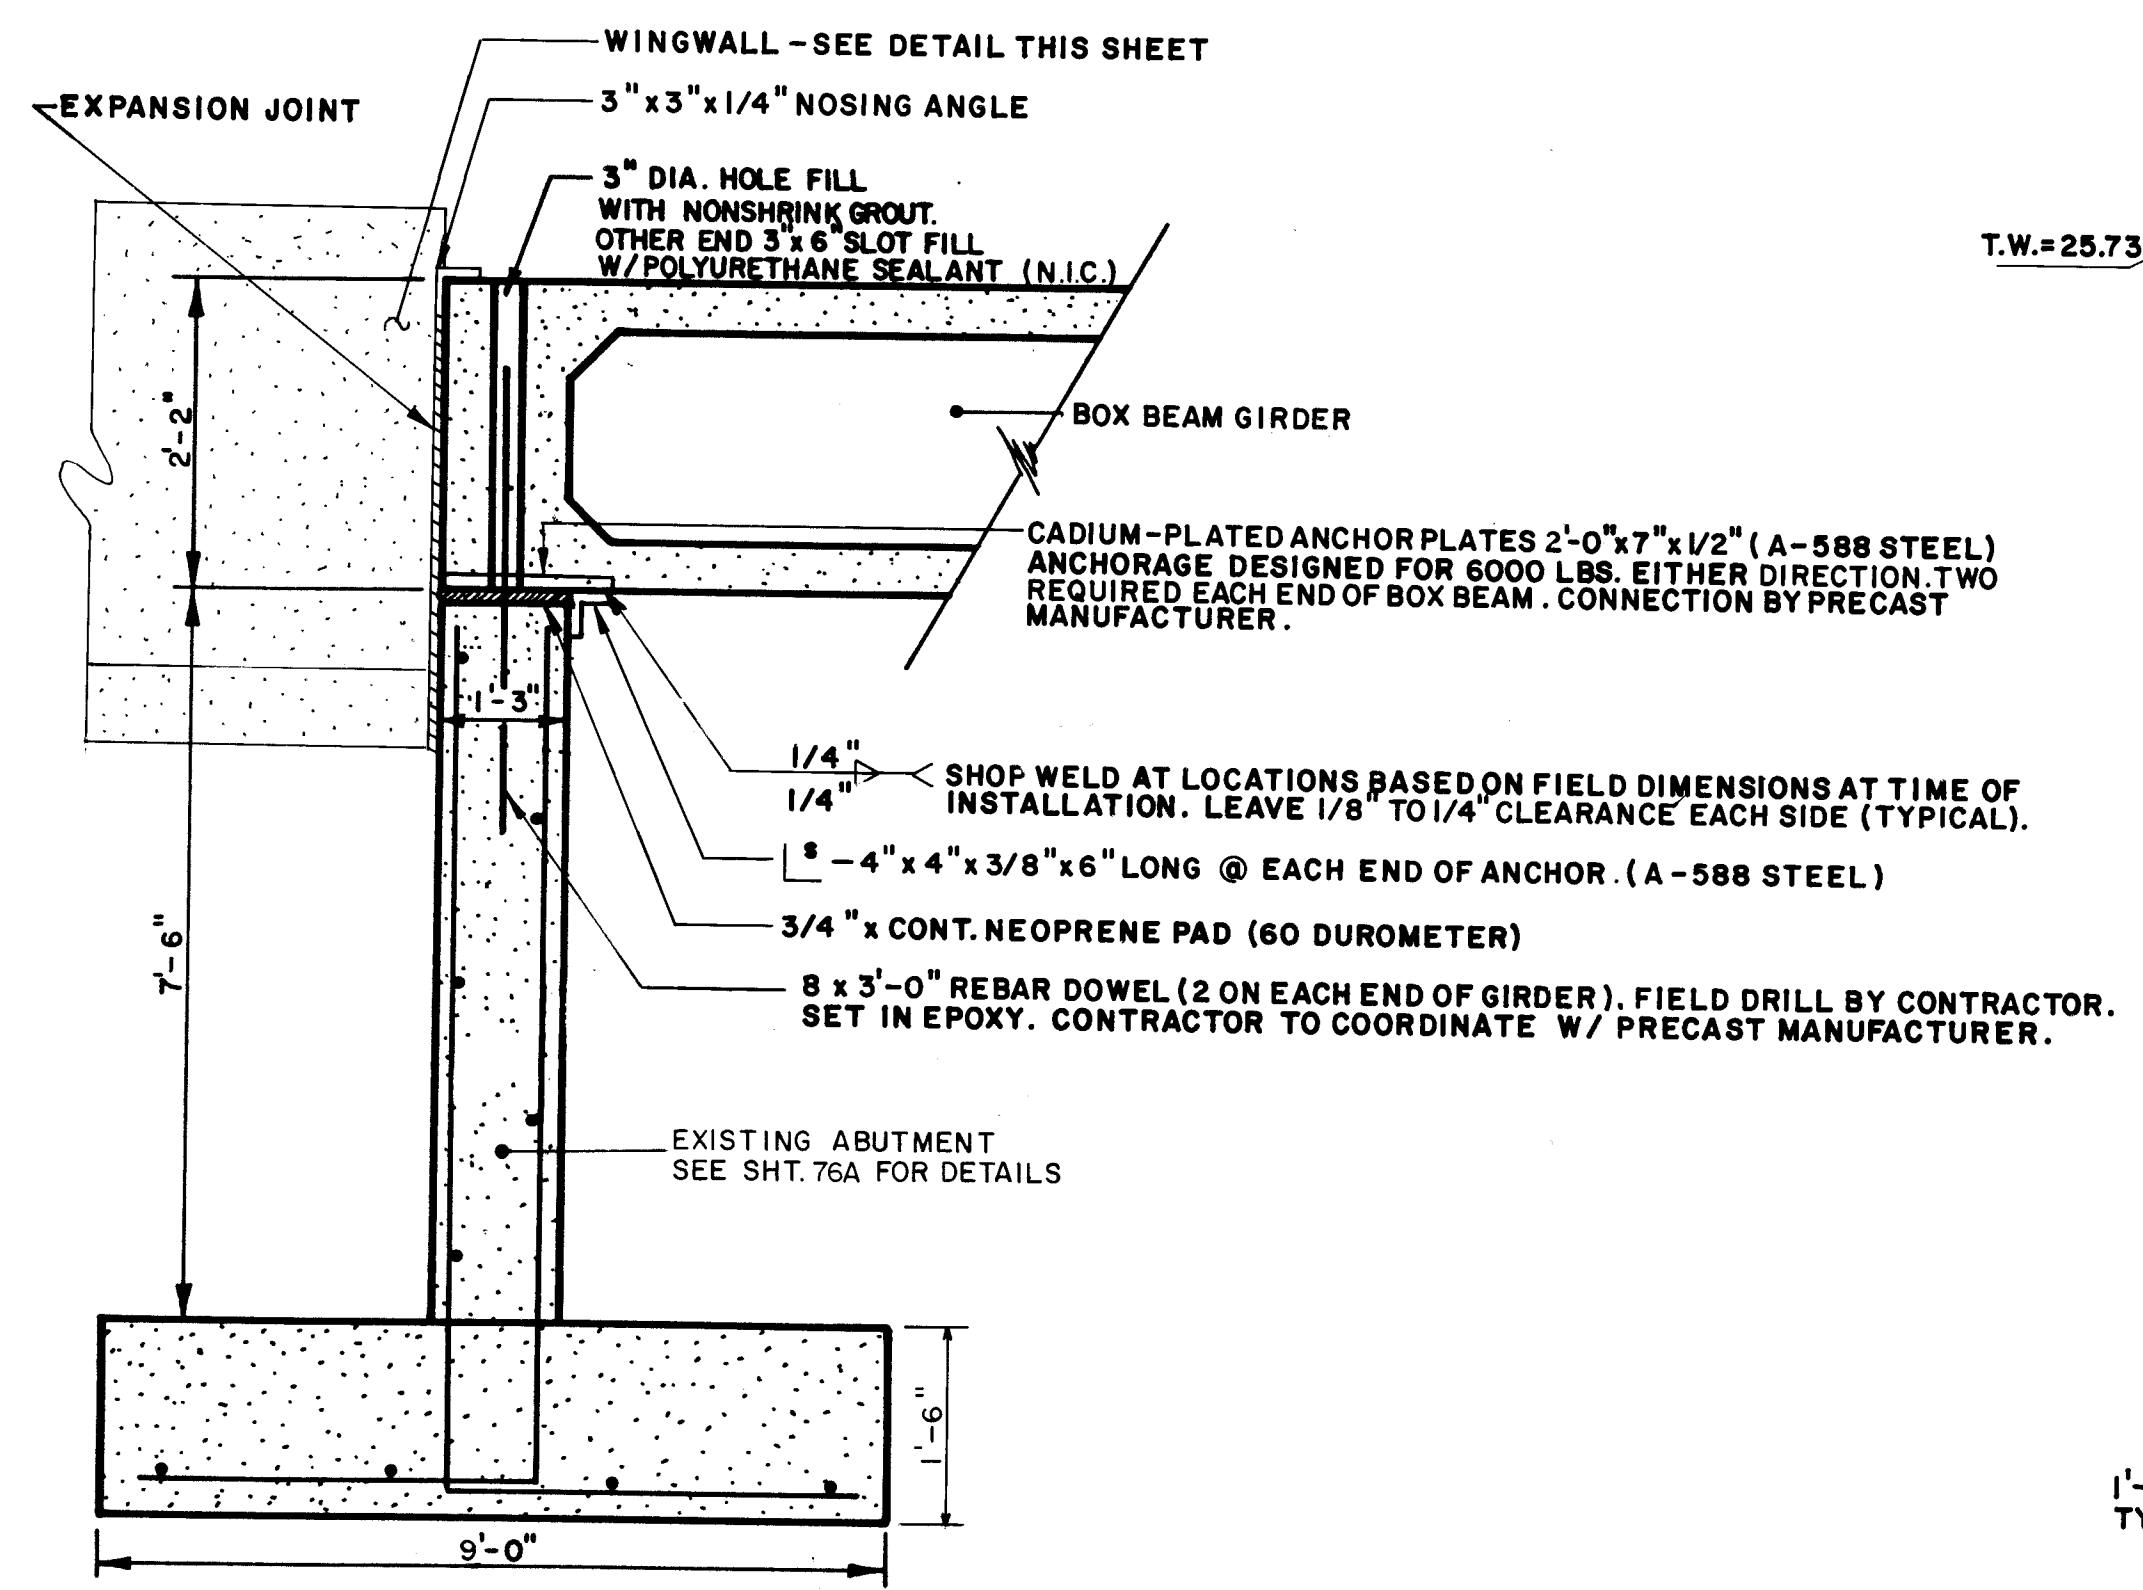


DETAIL A
SCALE: 1/2" = 1'-0"

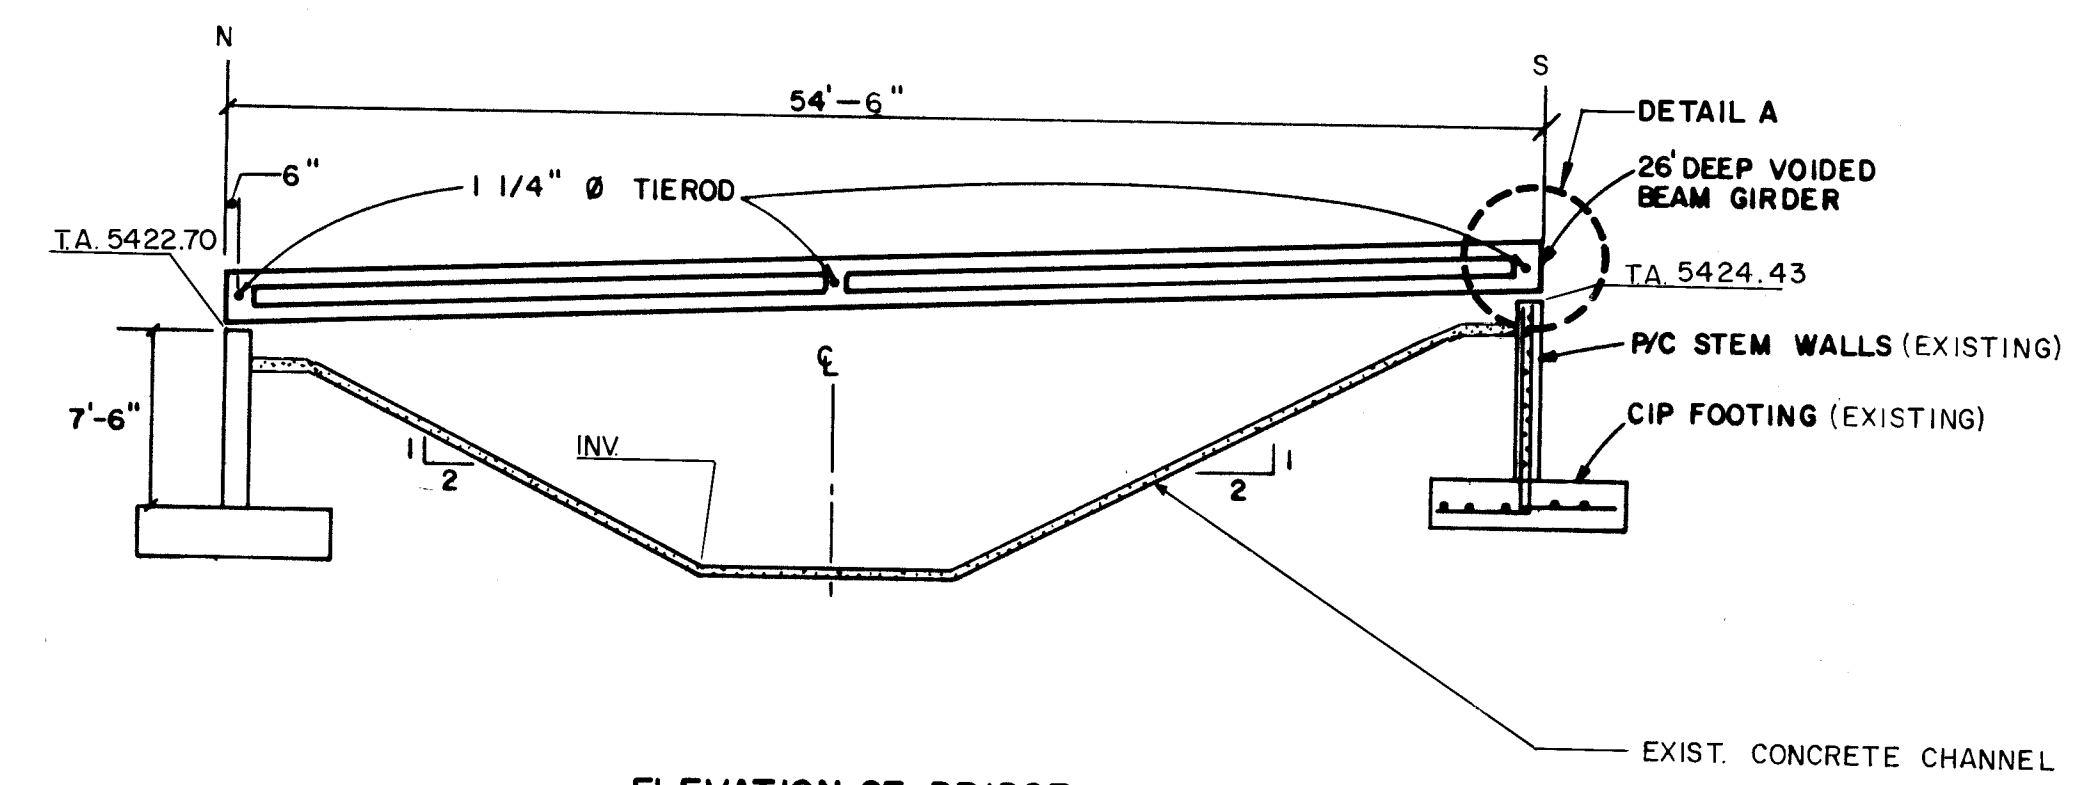


ELEVATION OF BRIDGE
STA 20+24.85 (℄ CHANNEL)

SCALE: 1/8" = 1'-0"
SUPPLIER TO DESIGN FOR HS20-44 LOADING - NON-COMPOSITE BOX GIRDER WITH 2" WEARSURFACE

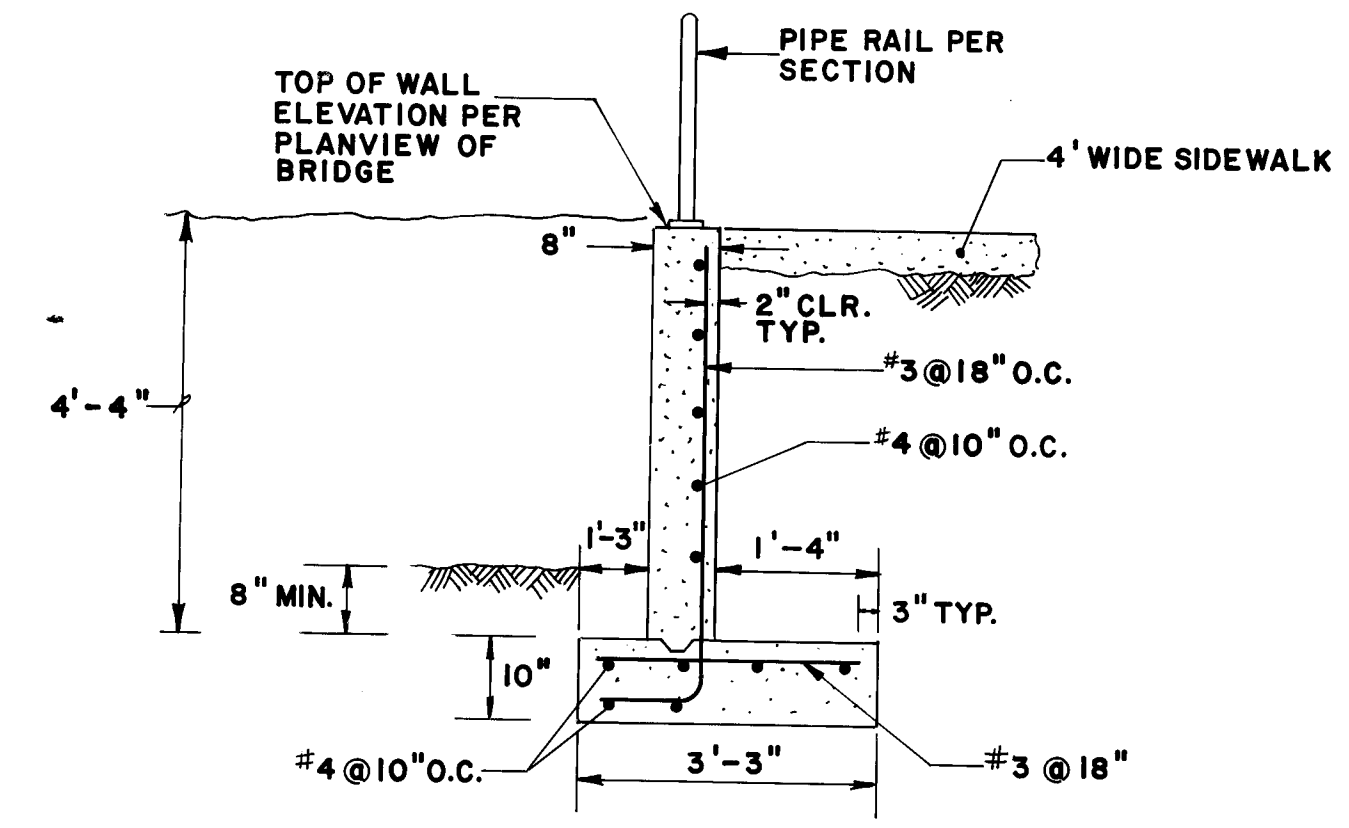

WINGWALL SECTION D-D
SCALE: 1/2" = 1'-0"

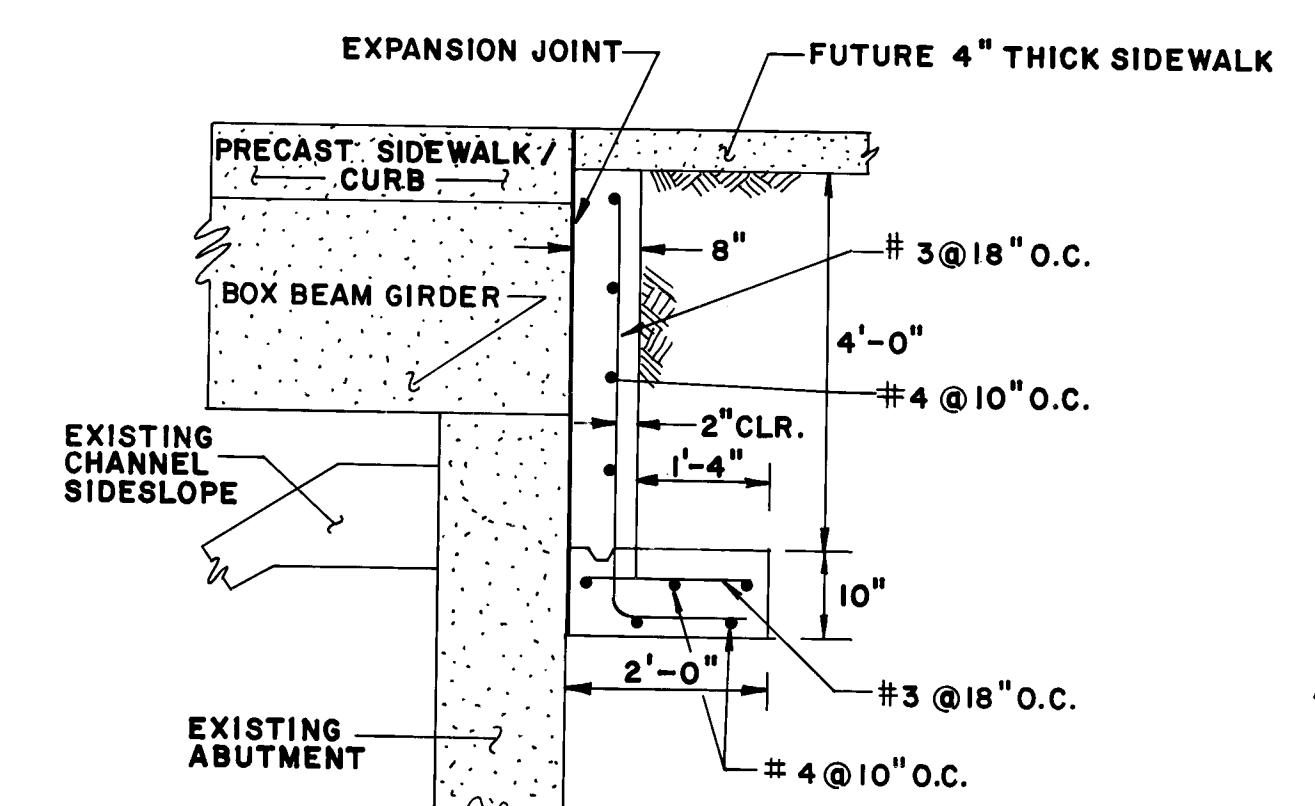





WINGWALL SECTION E-E
SCALE: 1/2" = 1'-0"

NOTE :
BRIDGE PRECAST ELEMENTS SHALL BE COMPLETE IN PLACE PRIOR TO PLACEMENT OF WINGWALLS.

AS BUILT INFORMATION			BENCH MARKS			SURVEY INFORMATION			ENGINEER'S SEAL			REVISIONS			DESIGNED BY			DRAWN BY			CHECKED BY		
CONTRACTOR	DATE	NO.	CONTRACTOR	DATE	NO.	NO.	BY	DATE	DATE	DATE	DATE	NO.	DATE	DATE	DESIGNED BY	DATE	DATE	DRAWN BY	DATE	DATE	CHECKED BY	DATE	DATE

26 31867688


CITY OF ALBUQUERQUE PUBLIC WORKS DEPARTMENT ENGINEERING DIVISION					
TITLE: NOR ESTE ESTATES BRIDGE DETAILS					
APPROVALS	ENGINEER	DATE	APPROVALS	ENGINEER	DATE
City Engineer	10/5/97	10/5/97	Liquid Waste	10/5/97	10/5/97
A.C.E. - Design	10/5/97	10/5/97	Traffic	10/5/97	10/5/97
A.C.E. - Hydrology	10/5/97	10/5/97	Water	10/5/97	10/5/97
DRAWING NO.	3186	MAP NO.	C-19	SHEET	76 OF 77

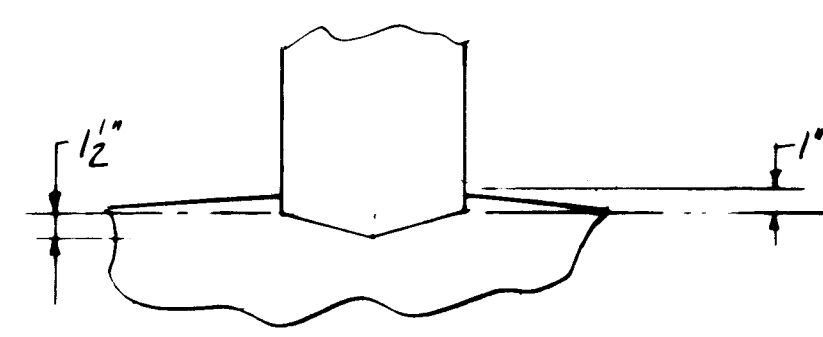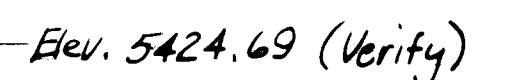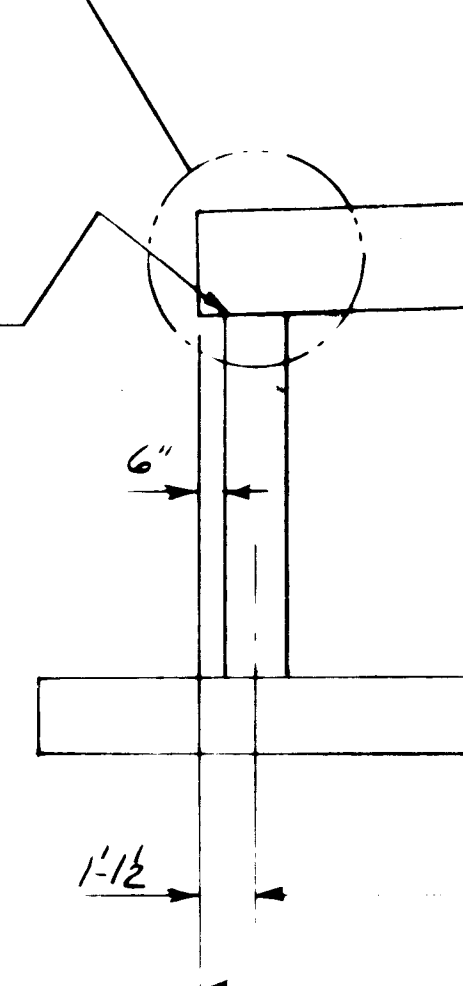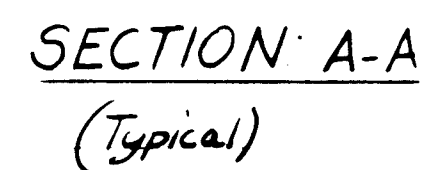

Alternate Joint at Bottom of Backwall

Reinforcing Required for One Abutment

Mark	Size	No. Reqd.	Shape	Length
A601	#6	77	—	8'-6
A602	#6	9	—	38'-0
A503	#5	39	—	8'-6
A504	#5	5	—	38'-0
A505	#5	72	J	9'-3
A406	#4	96	—	5'-5
A807	#8	12	—	3'-0

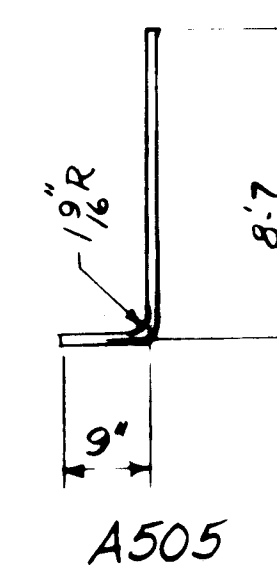

- [illegible]

NOT IN CONTRACT
SHOWN FOR INFORMATION
ONLY

1	2	3	4	5	6	7	8	9	10	11	12
26			31	86	76	88	84				

HYDROCONDUIT CORPORATION


LA CUEVA ARROYO CHANNEL CROSSING
BRIDGE CROSSING @ P.D.C. STA. 20+24.85

ABUTMENT DETAILS

**GORDAN AND ASSOCIATES
CONSULTING ENGINEERS
1300 LUISA ST. SUITE 21
SANTA FE, NEW MEXICO 87501
505-836-2807**




76A of 7

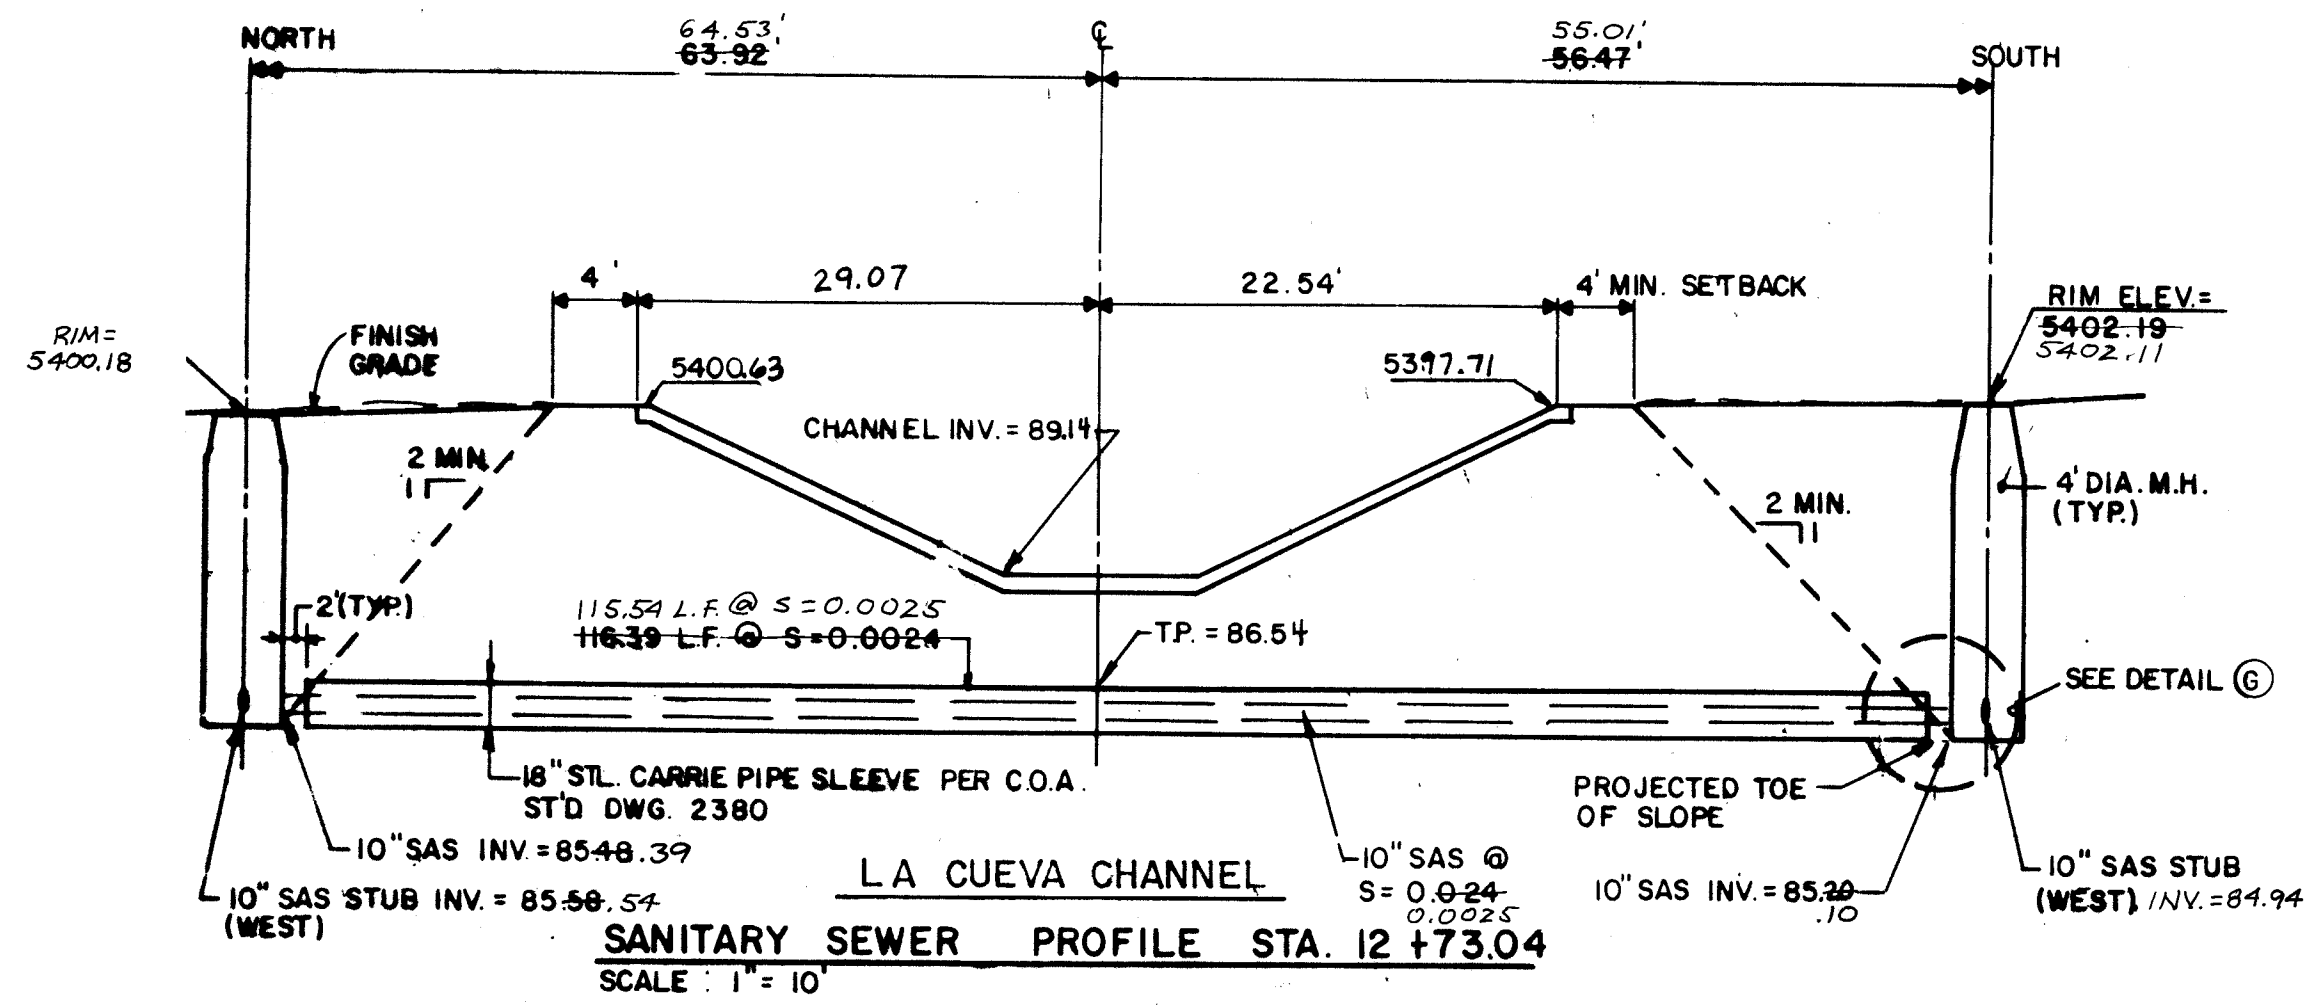



LINE 'A' SANITARY SEWER CROSSING

NOT IN CONTRACT

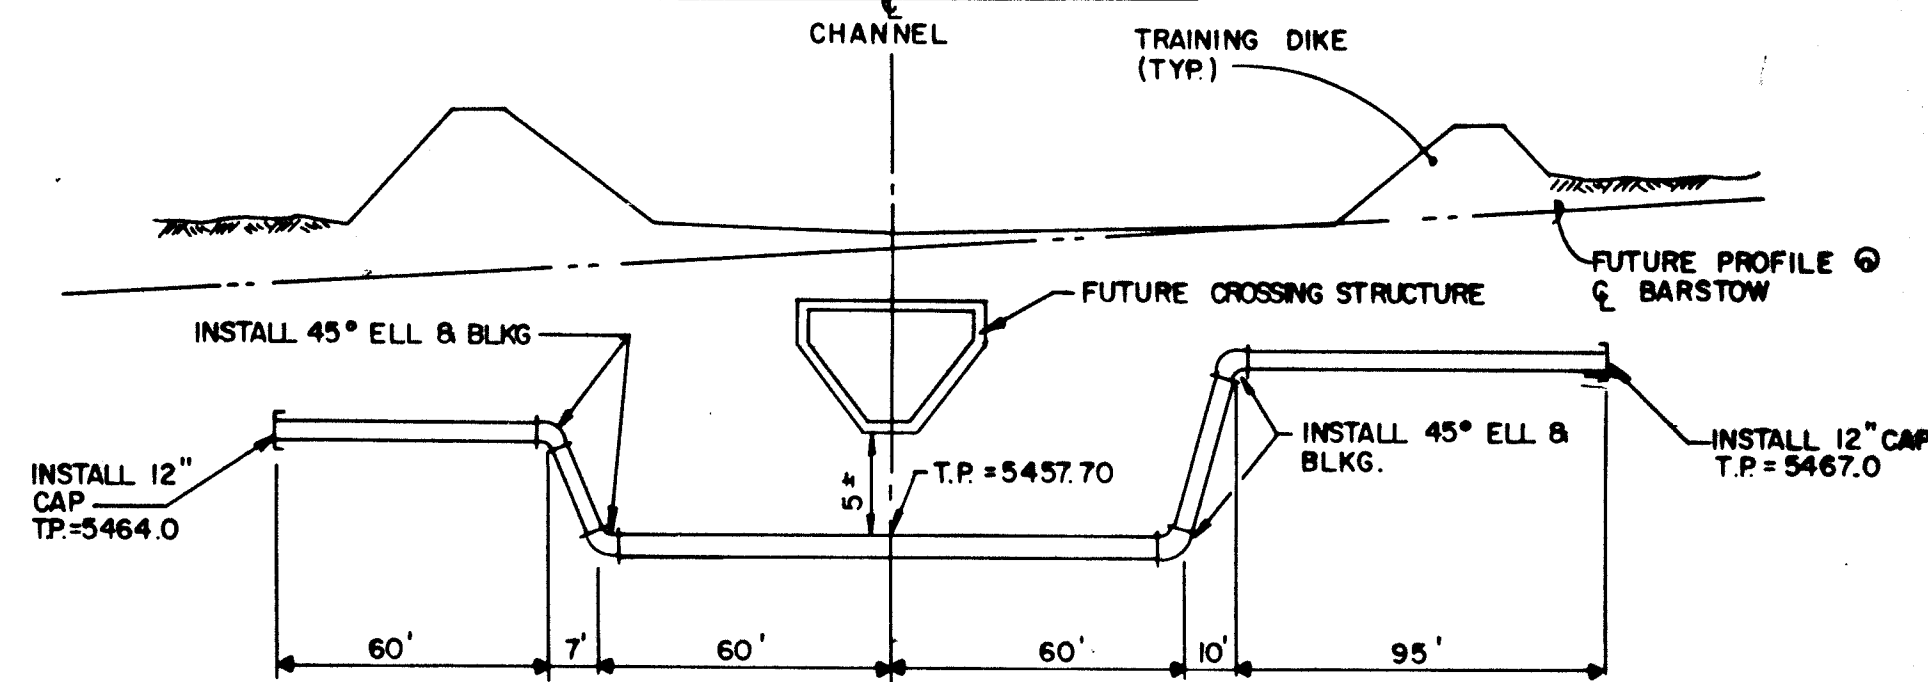



BARSTOW STREET WATERLINE CROSSING

NOT IN CONTRACT

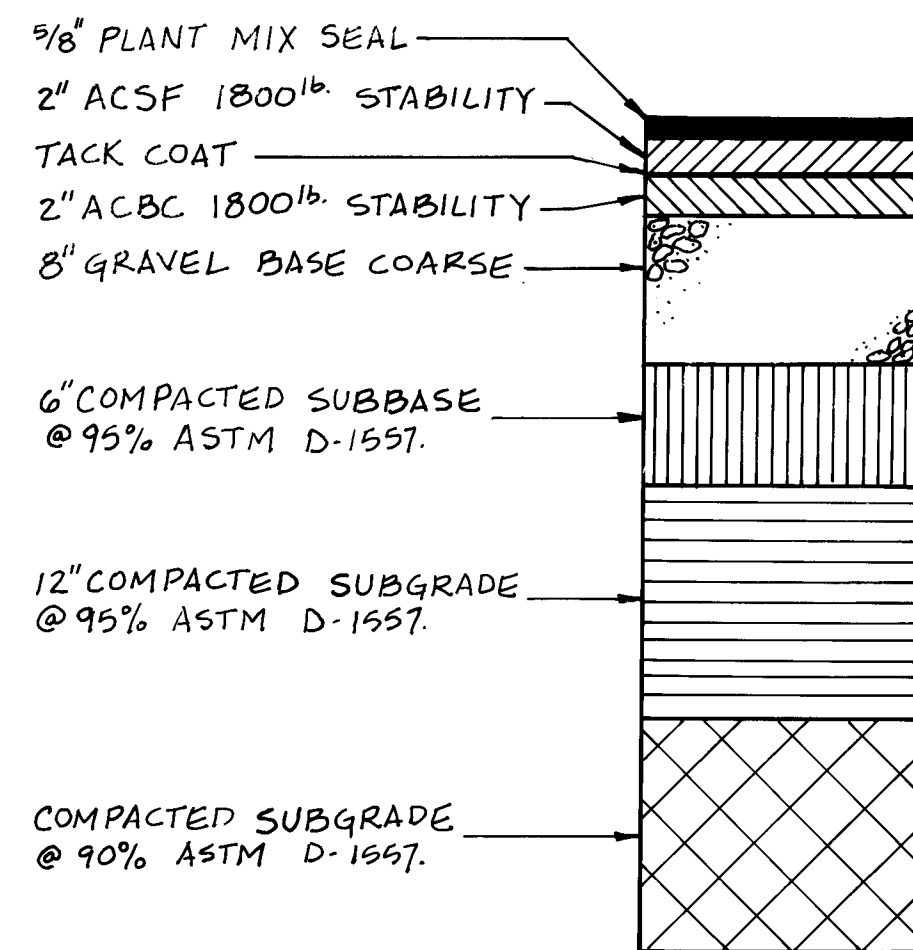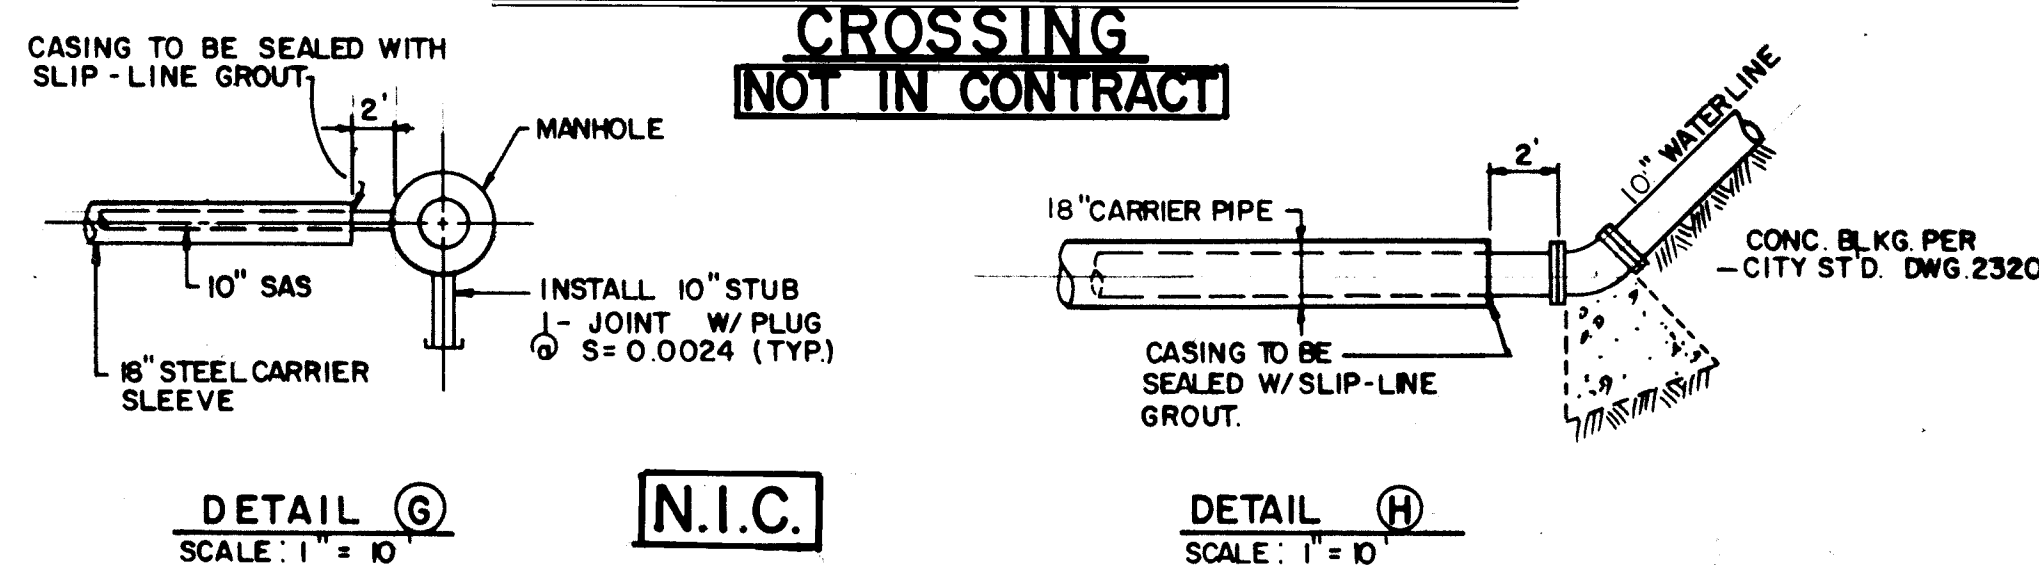

- NOTES:
1. CONSTRUCT WEST INVERT WITH BELL END OF 12\"/>

MANHOLE DETAIL
SCALE: 1\"/>

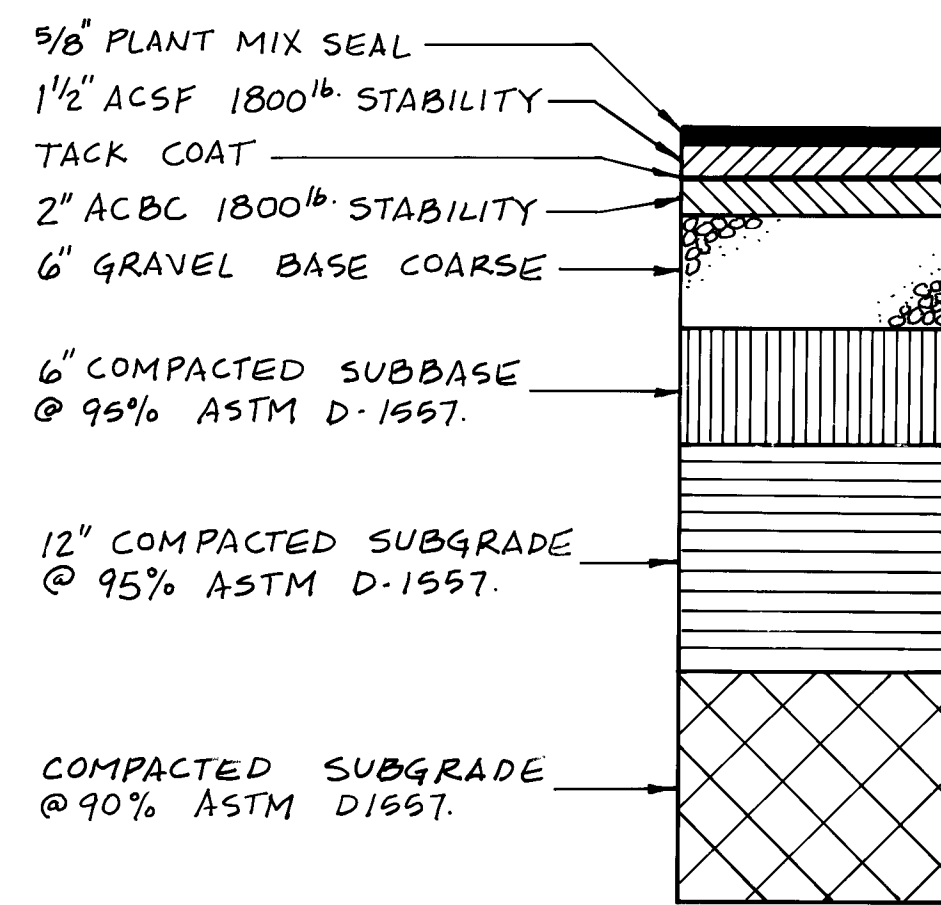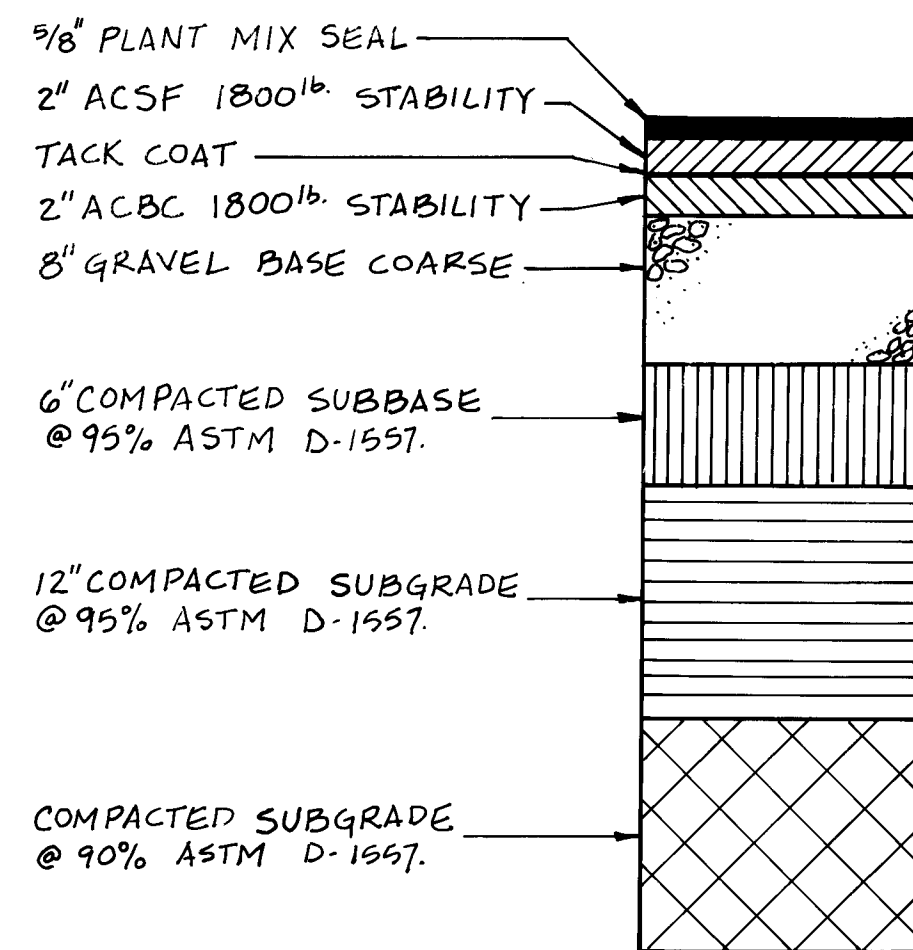

WYOMING BLVD. & ALAMEDA AVE. ARTERIAL PAVEMENT SECTION 'A'

BARSTOW ST. ARTERIAL PAVEMENT SECTION 'B'

RECORD DRAWING
This drawing as modified shows public improvements as constructed. Modifications have been made using information and measurements furnished by the contractor, the Contractor and City Inspector. The modifications conform to the minimum requirements for the Record Drawing. The Engineer's Seal is required for the Record Drawing. The Engineer's Seal is required for the Record Drawing. The Engineer's Seal is required for the Record Drawing.

AS BUILT INFORMATION			BENCH MARKS			SURVEY INFORMATION			ENGINEER'S SEAL		
CONTRACTOR	NEW	CONCEPTS	NO.	DATE	BY	NO.	DATE	BY	NO.	DATE	BY
WORK	DATE	DATE	NO. <td>DATE</td> <td>BY <td>NO. <td>DATE</td> <td>BY <td>NO. <td>DATE</td> <td>BY</td> </td></td></td></td>	DATE	BY <td>NO. <td>DATE</td> <td>BY <td>NO. <td>DATE</td> <td>BY</td> </td></td></td>	NO. <td>DATE</td> <td>BY <td>NO. <td>DATE</td> <td>BY</td> </td></td>	DATE	BY <td>NO. <td>DATE</td> <td>BY</td> </td>	NO. <td>DATE</td> <td>BY</td>	DATE	BY
FIELD	DATE	DATE	NO. <td>DATE</td> <td>BY <td>NO. <td>DATE</td> <td>BY <td>NO. <td>DATE</td> <td>BY</td> </td></td></td></td>	DATE	BY <td>NO. <td>DATE</td> <td>BY <td>NO. <td>DATE</td> <td>BY</td> </td></td></td>	NO. <td>DATE</td> <td>BY <td>NO. <td>DATE</td> <td>BY</td> </td></td>	DATE	BY <td>NO. <td>DATE</td> <td>BY</td> </td>	NO. <td>DATE</td> <td>BY</td>	DATE	BY
CORRECTED	DATE	DATE	NO. <td>DATE</td> <td>BY <td>NO. <td>DATE</td> <td>BY <td>NO. <td>DATE</td> <td>BY</td> </td></td></td></td>	DATE	BY <td>NO. <td>DATE</td> <td>BY <td>NO. <td>DATE</td> <td>BY</td> </td></td></td>	NO. <td>DATE</td> <td>BY <td>NO. <td>DATE</td> <td>BY</td> </td></td>	DATE	BY <td>NO. <td>DATE</td> <td>BY</td> </td>	NO. <td>DATE</td> <td>BY</td>	DATE	BY
RECORDED	DATE	DATE	NO. <td>DATE</td> <td>BY <td>NO. <td>DATE</td> <td>BY <td>NO. <td>DATE</td> <td>BY</td> </td></td></td></td>	DATE	BY <td>NO. <td>DATE</td> <td>BY <td>NO. <td>DATE</td> <td>BY</td> </td></td></td>	NO. <td>DATE</td> <td>BY <td>NO. <td>DATE</td> <td>BY</td> </td></td>	DATE	BY <td>NO. <td>DATE</td> <td>BY</td> </td>	NO. <td>DATE</td> <td>BY</td>	DATE	BY



DESIGNED BY: **AS.M.C.** DATE: **8/27**
 DRAWN BY: **D.A.L.** DATE: **8/27**
 CHECKED BY: **D.A.L.** DATE: **8/27**

CITY OF ALBUQUERQUE
PUBLIC WORKS DEPARTMENT
ENGINEERING DIVISION


TITLE: **NOR ESTE ESTATES
MISCELLANEOUS DETAILS**

APPROVALS	ENGINEER	DATE	APPROVALS	ENGINEER	DATE
City Engineer	<i>[Signature]</i>	10/5/07	Liquid Waste	<i>[Signature]</i>	9/14/07
A.C.E. - Design	<i>[Signature]</i>		Traffic	<i>[Signature]</i>	7/16/07
A.C.E. - Hydrology	<i>[Signature]</i>		Water	<i>[Signature]</i>	9/14/07

DRAWING NO. **3186** MAP NO. **C-19** SHEET **77** OF **77**

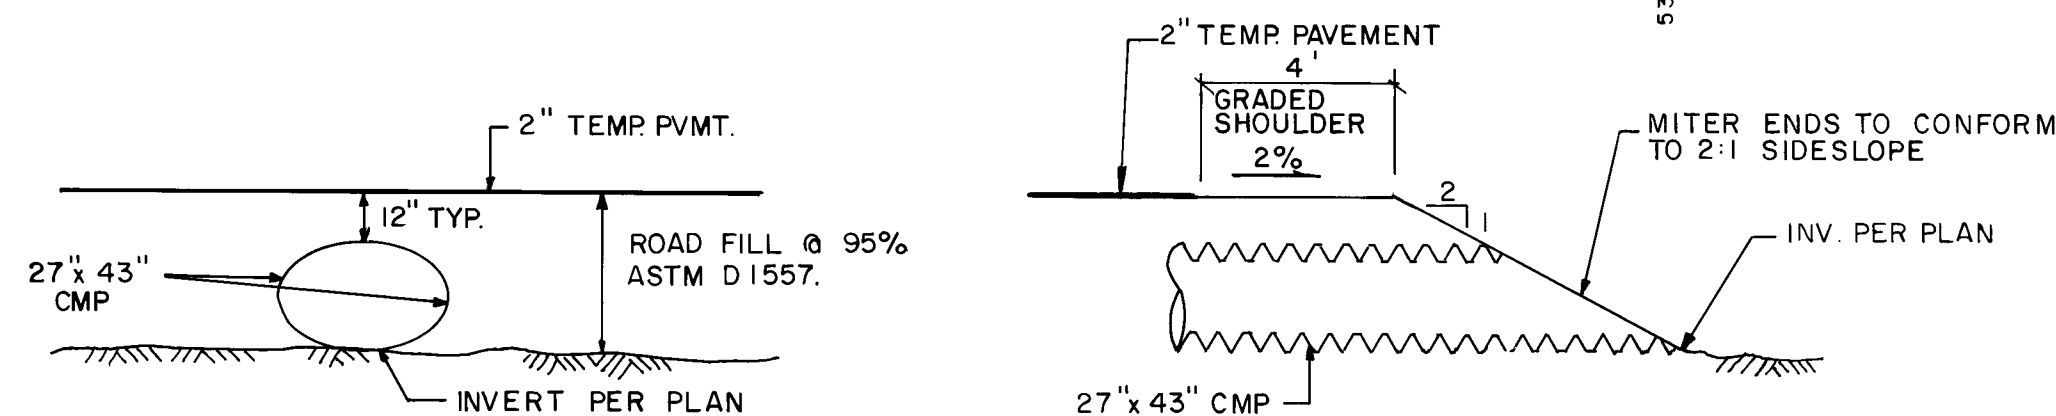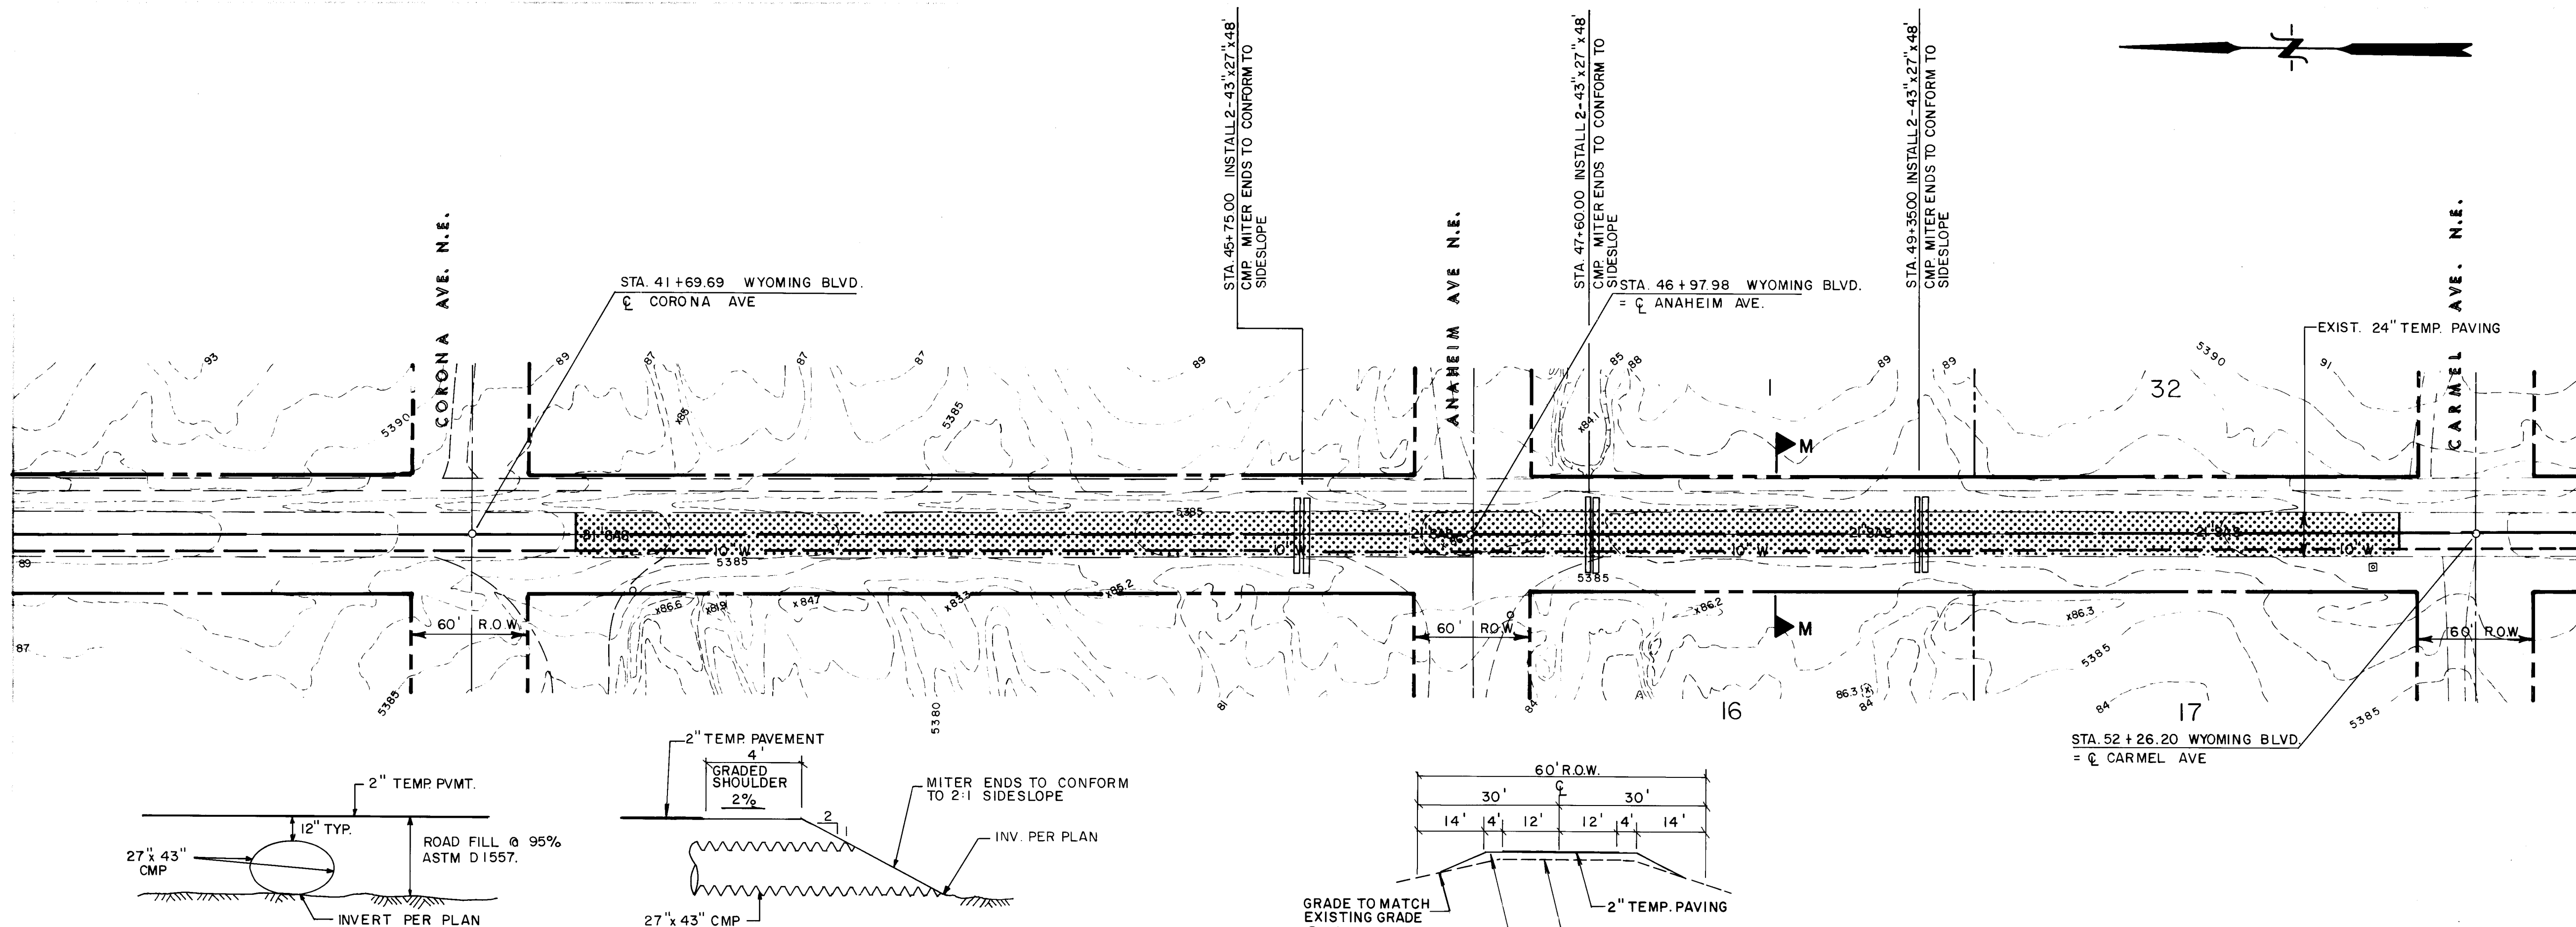

TYPICAL CMP INSTALLATION DETAILS
SCALE: 1" = 4'

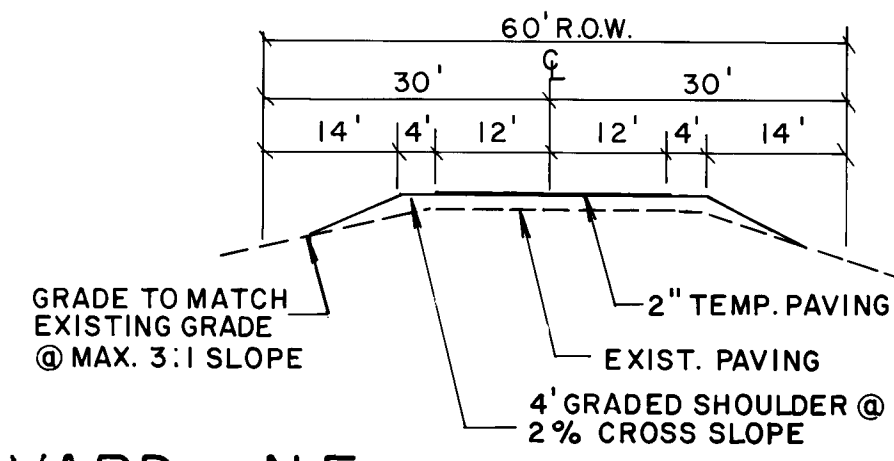

WYOMING BOULEVARD NE. SECTION M-M
SCALE: 1" = 20'

SCALE:
HORIZ: 1" = 50'
VERT: 1" = 10'

LEGEND

- REMOVE & REPLACE TEMPORARY PVMT.
- CMP CULVERT
- EXIST. WATERLINE
- EXIST. SANITARY SEWER
- SAS MANHOLE



WYOMING BOULEVARD NE.
TEMPORARY CROSSING FACILITY

REMARK
DESIGN
DATE
10/5/87
1/6/87
3/31/87
2-1-87

THE STATION IS LOCATED 9 MILES NORTHEAST OF DOWNTOWN ALBUQUERQUE TO REACH THE STATION FROM THE INTERSECTION OF LOUISIANA BLVD AND LOS ANGELES DRIVE, GO EAST ON LOS ANGELES DRIVE 10 MILES TO BARSTOW ST., THEN NORTH ON BARSTOW ST. 1.0 MILES TO ALAMEDA AVE. THE STATION IS LOCATED IN THE NORTHEAST QUADRANT OF THE INTERSECTION. THE STATION MARK IS A STANDARD ACS BRASS TABLET STAMPED "1-850", SET IN TOP OF A CONCRETE POST PROJECTING 0.1 FEET ABOVE GROUND.
MSLD ELEVATION = 5474.53'



D.A.L.
M.E.C.
D.A.L.
5/87
5/87