
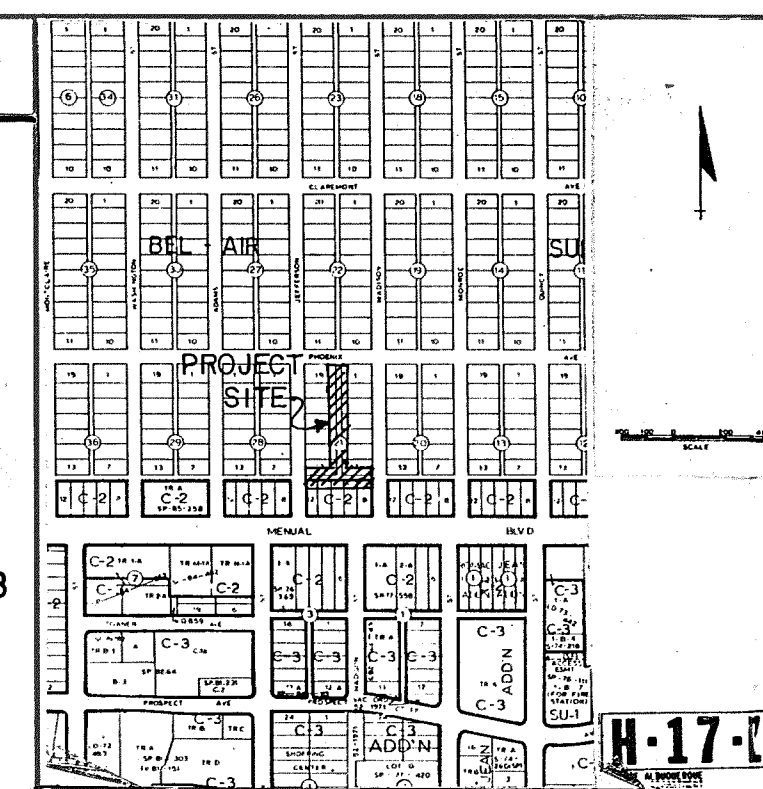
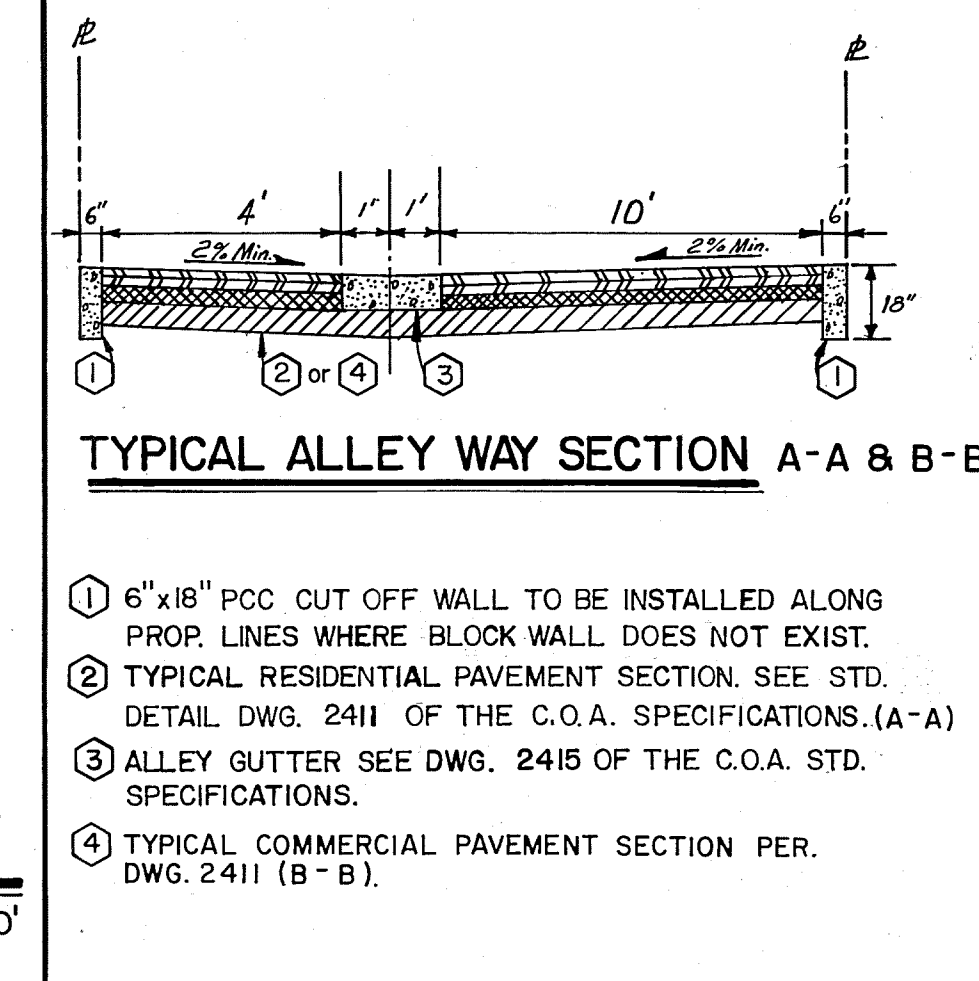
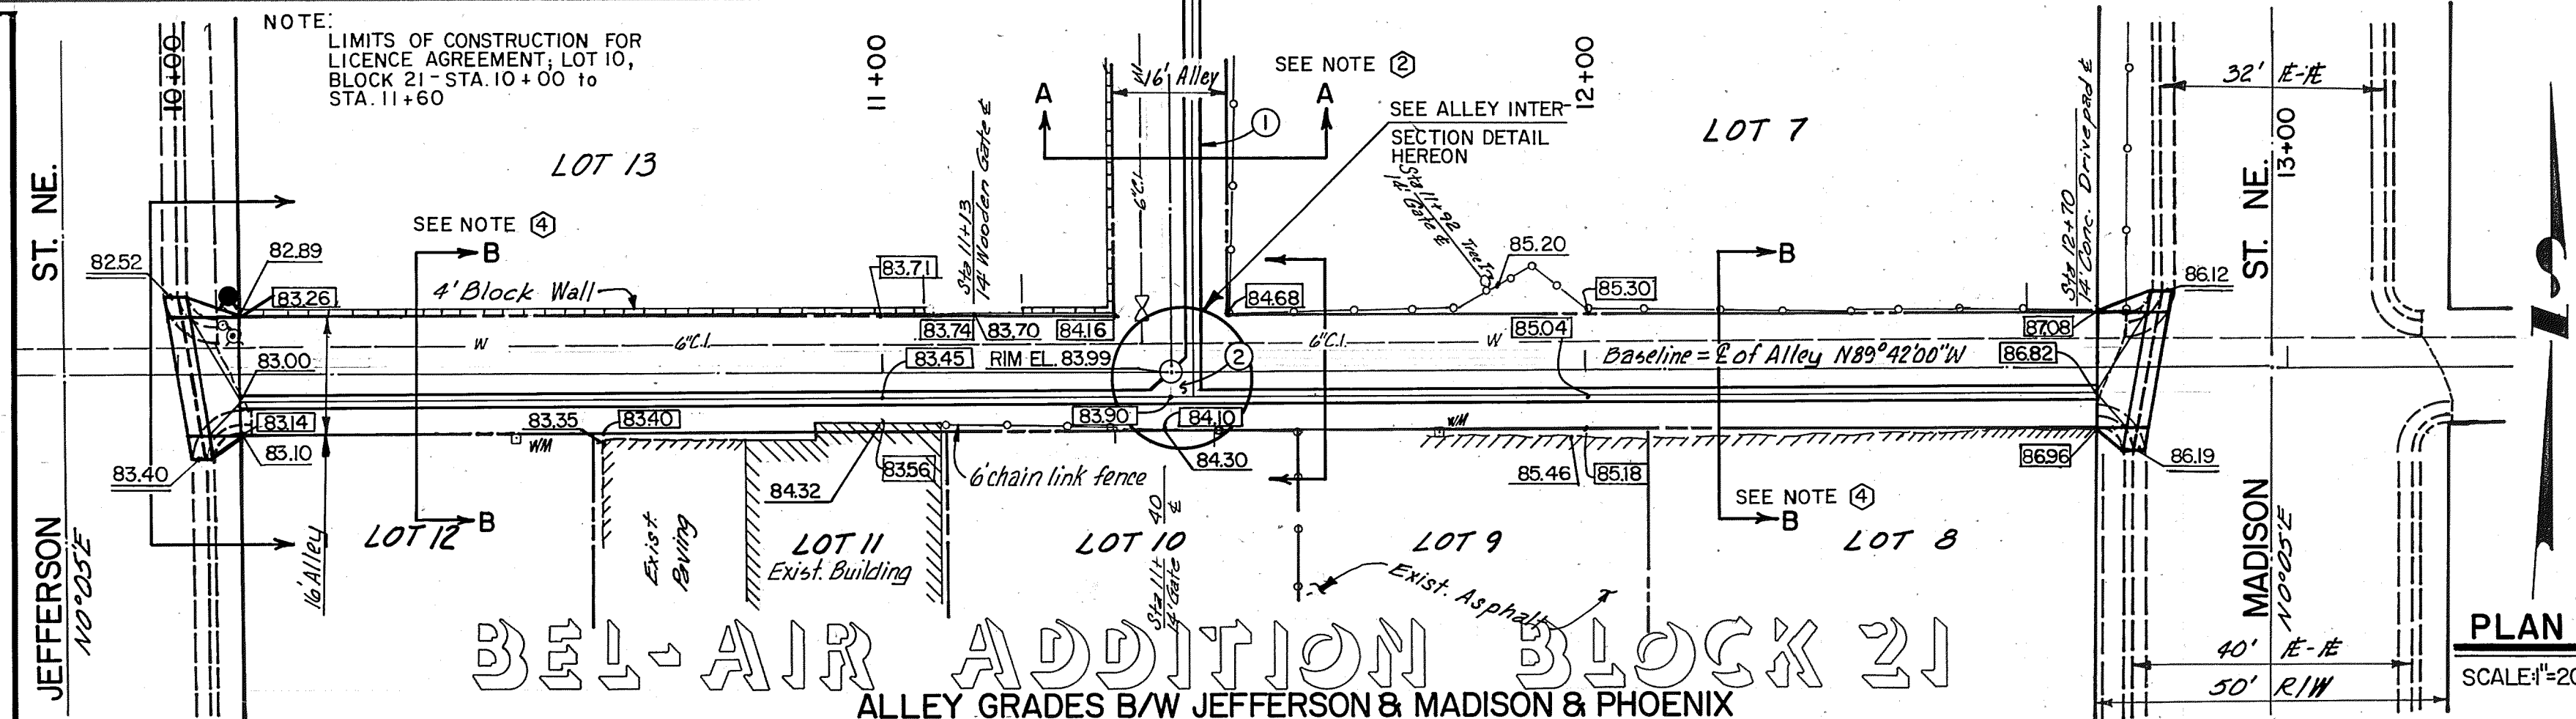


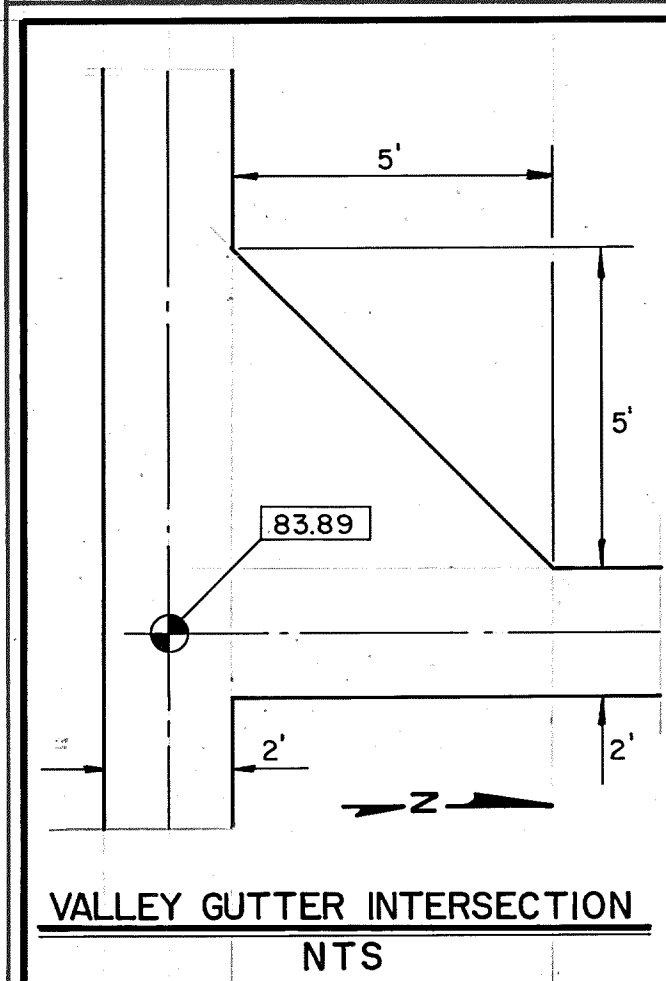

1. ALL WORK DETAILED ON THESE PLANS TO BE PERFORMED UNDER CONTRACT SHALL, EXCEPT AS OTHERWISE STATED OR PROVIDED FOR HEREON, BE CONSTRUCTED IN ACCORDANCE WITH THE CITY OF ALBUQUERQUE STANDARD SPECIFICATIONS FOR PUBLIC WORKS CONSTRUCTION 1986.

2. TWO (2) WORKING DAYS PRIOR TO ANY EXCAVATION, THE CONTRACTOR MUST CONTACT LINE LOCATING SERVICE 765-1234, FOR LOCATION OF EXISTING UTILITIES.

3. PRIOR TO CONSTRUCTION, THE CONTRACTOR SHALL EXCAVATE AND VERIFY THE HORIZONTAL AND VERTICAL LOCATIONS OF ALL OBSTRUCTIONS. SHOULD A CONFLICT EXIST, THE CONTRACTOR SHALL NOTIFY THE ENGINEER OR SURVEYOR SO THAT THE CONFLICT CAN BE RESOLVED WITH MINIMUM AMOUNT OF DELAY.

THE FOLLOWING NOTES ALSO APPLY WHEN CHECKED

☒ ALL UTILITIES AND UTILITY SERVICE LINES SHALL BE INSTALLED PRIOR TO PAVING.




☒ BACKFILL COMPACTION SHALL BE ACCORDING TO SPECIFIED STREET USE.

☐ TACK COAT REQUIREMENTS SHALL BE DETERMINED BY THE CITY ENGINEER.

☐ SIDEWALKS AND WHEELCHAIR RAMPS WITHIN THE CURB RETURNS SHALL BE CONSTRUCTED WHEREVER A NEW CURB RETURN IS CONSTRUCTED.

☐ IF CURB IS DERESSED FOR A DRIVEPAD OR A HANDICAP RAMP, THE DRIVEPAD OR RAMP SHALL BE CONSTRUCTED PRIOR TO ACCEPTANCE OF THE CURB AND GUTTER.

☐ ALL STORM DRAINAGE FACILITIES SHALL BE COMPLETED PRIOR TO FINAL ACCEPTANCE.

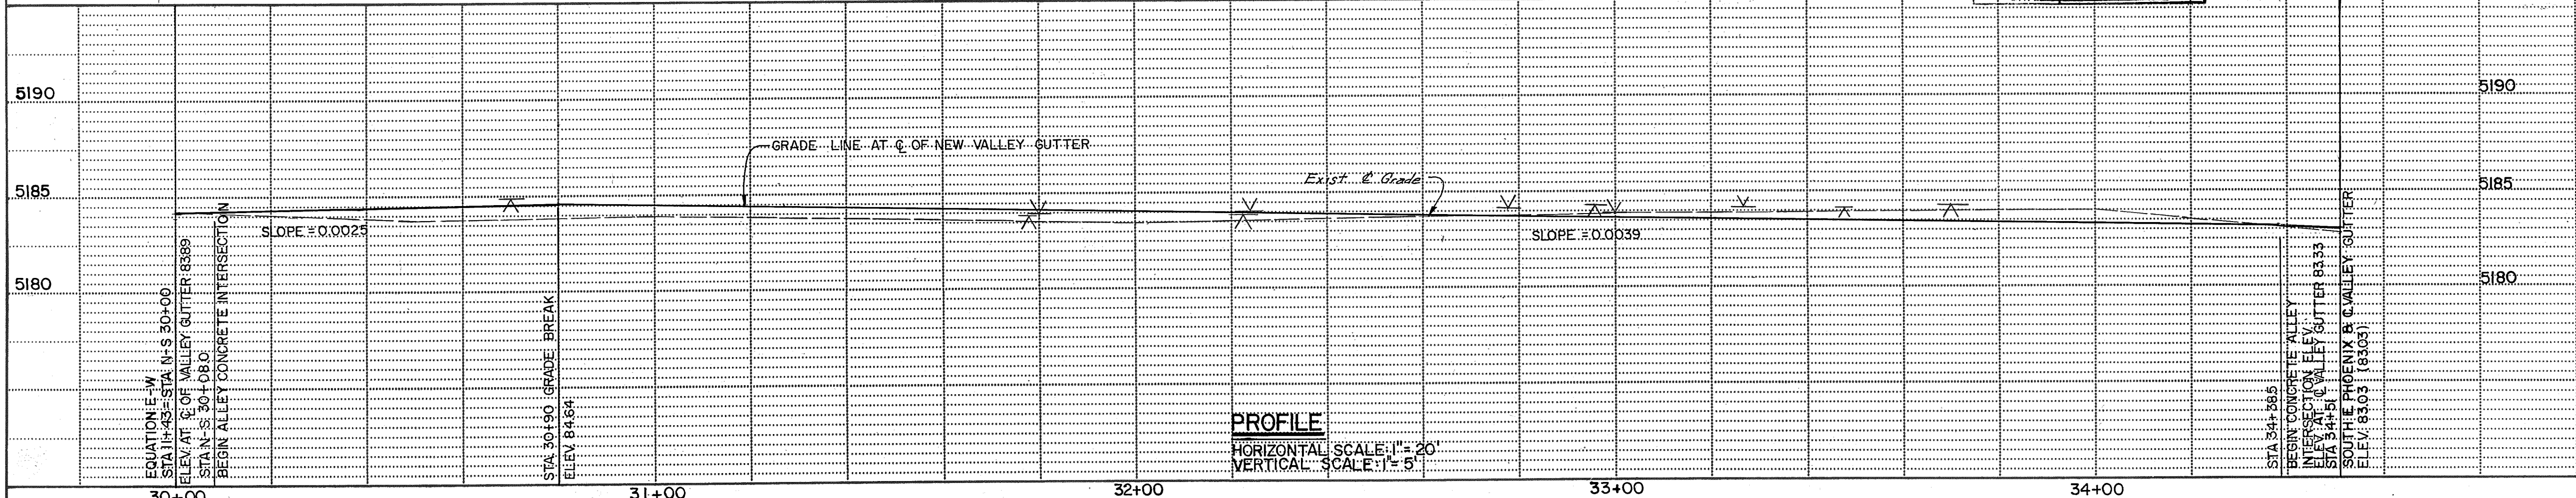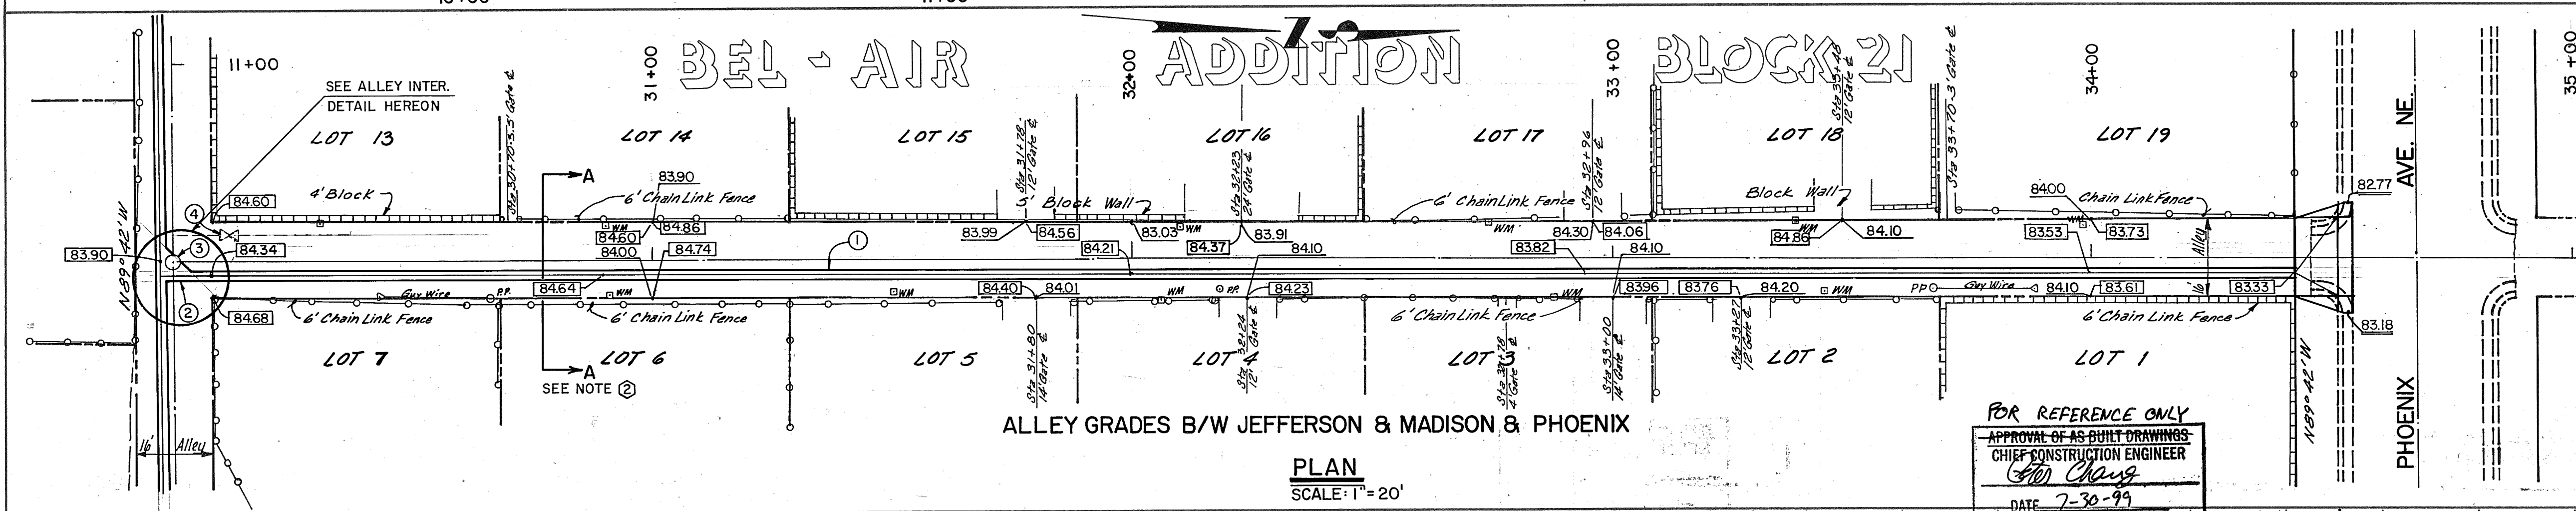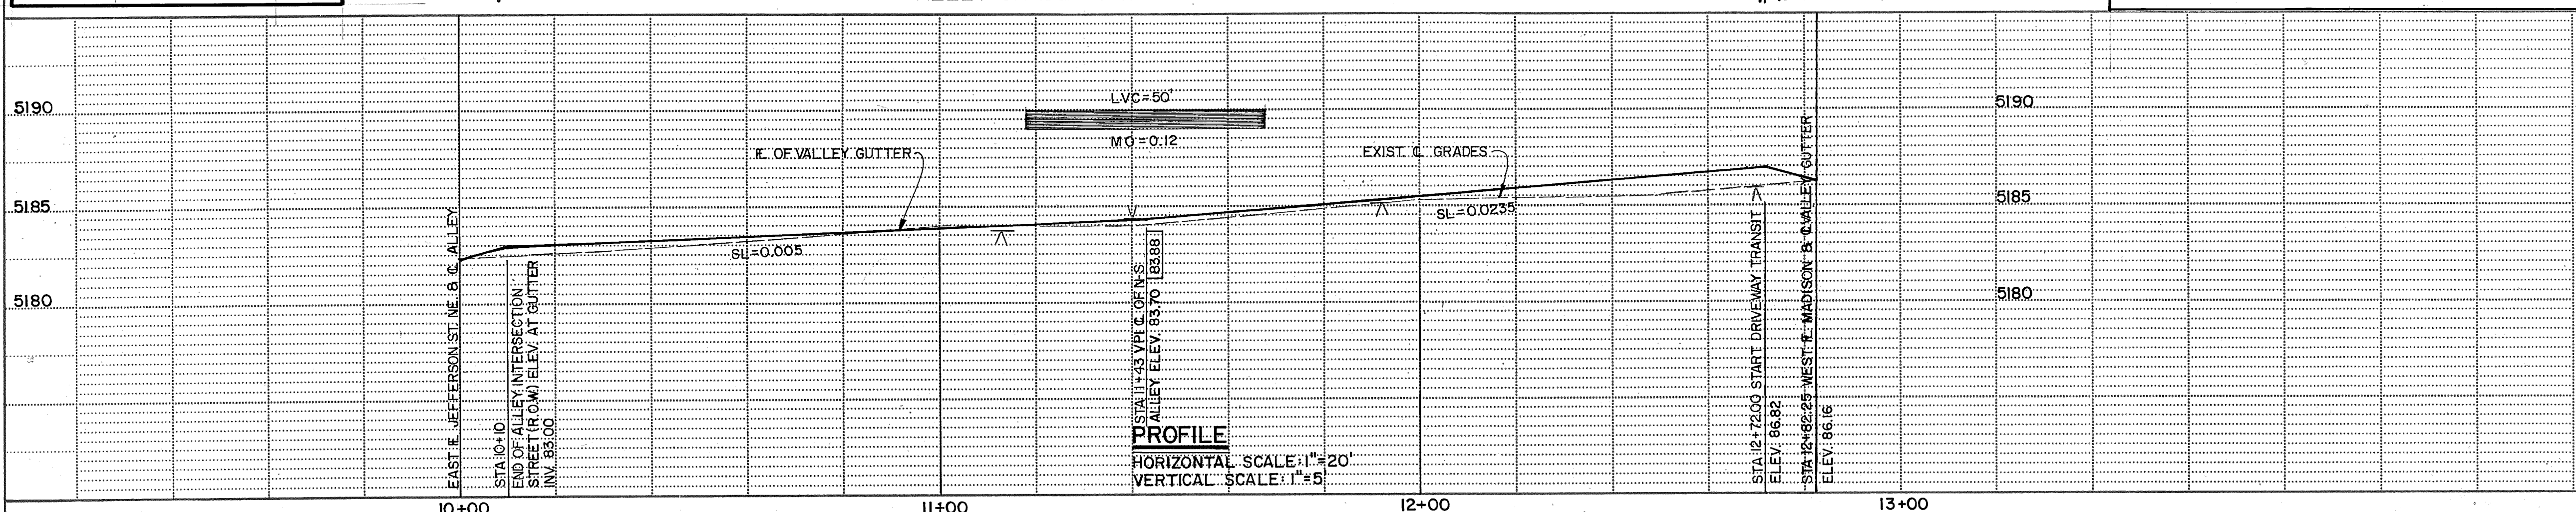

LEGEND

▽ C. OF GATE ALONG EAST & SOUTH ROW

△ C. OF GATE ALONG WEST & NORTH ROW

— EXISTING GRADE

— DESIGN GRADE

— MATCH EXISTING GRADE

KEYED NOTES THIS SHEET

① ASPHALTIC PAVEMENT ALLEY WITH PCC VALLEY GUTTER. SEE DETAIL THIS SHEET.

② VALLEY GUTTER INTERSECTION. SEE DETAIL THIS SHEET.

③ EXISTING SAS MANHOLE, RIM ELEVATION TO BE ADJUSTED TO NEW GRADE.

④ EXISTING 6" GATE VALVE. TO BE ADJUSTED TO NEW GRADE.

NOTE:

THIS PLAN IS PROPOSED FOR LOT 10, BLOCK 21 BEL-AIR ADD'N & LICENSE AGREEMENT FOR CONSTRUCTION LIMITS FROM STA. 10+00 TO STA. 11+60

CITY OF ALBUQUERQUE
MUNICIPAL DEVELOPMENT DEPARTMENT
ENGINEERING DIVISION

TITLE: DESIGN GRADES FOR ALLEY NORTH OF MENAUL BETWEEN JEFFERSON ST. NE. AND MADISON ST. NE. AND SOUTH OF PHOENIX AVE. NE.

APPROVALS	ENGINEER	DATE	APPROVALS	ENGINEER	DATE
City Engineer	[Signature]	9/10/87	Liquid Waste	[Signature]	9/10/87
A.C.E.-Design	[Signature]	9/10/87	Traffic	[Signature]	9/10/87
A.C.E.-Hydrology	[Signature]	9-10-87	Water	[Signature]	9/10/87

DRAWING NO. 3220 MAP NO. H-17 SHEET 1 OF 1

AS BUILT INFORMATION				BENCH MARKS				SURVEY INFORMATION				ENGINEER'S SEAL			
CONTRACTOR	DATE	INSPECTOR	DATE	NO.	DATE	BY	NO.	NO.	DATE	BY	NO.	NO.	DATE	BY	NO.
BM 5-117 A Square, El. Chiseled On Top															
Or Concrete Curb At The Edge Of Menaul															
Return: At The Intersection Of Menaul															
54-87 Blvd. & Grandview Dr. NE.															
Elevation															
5174250															
RECORDED BY															
NO.															