



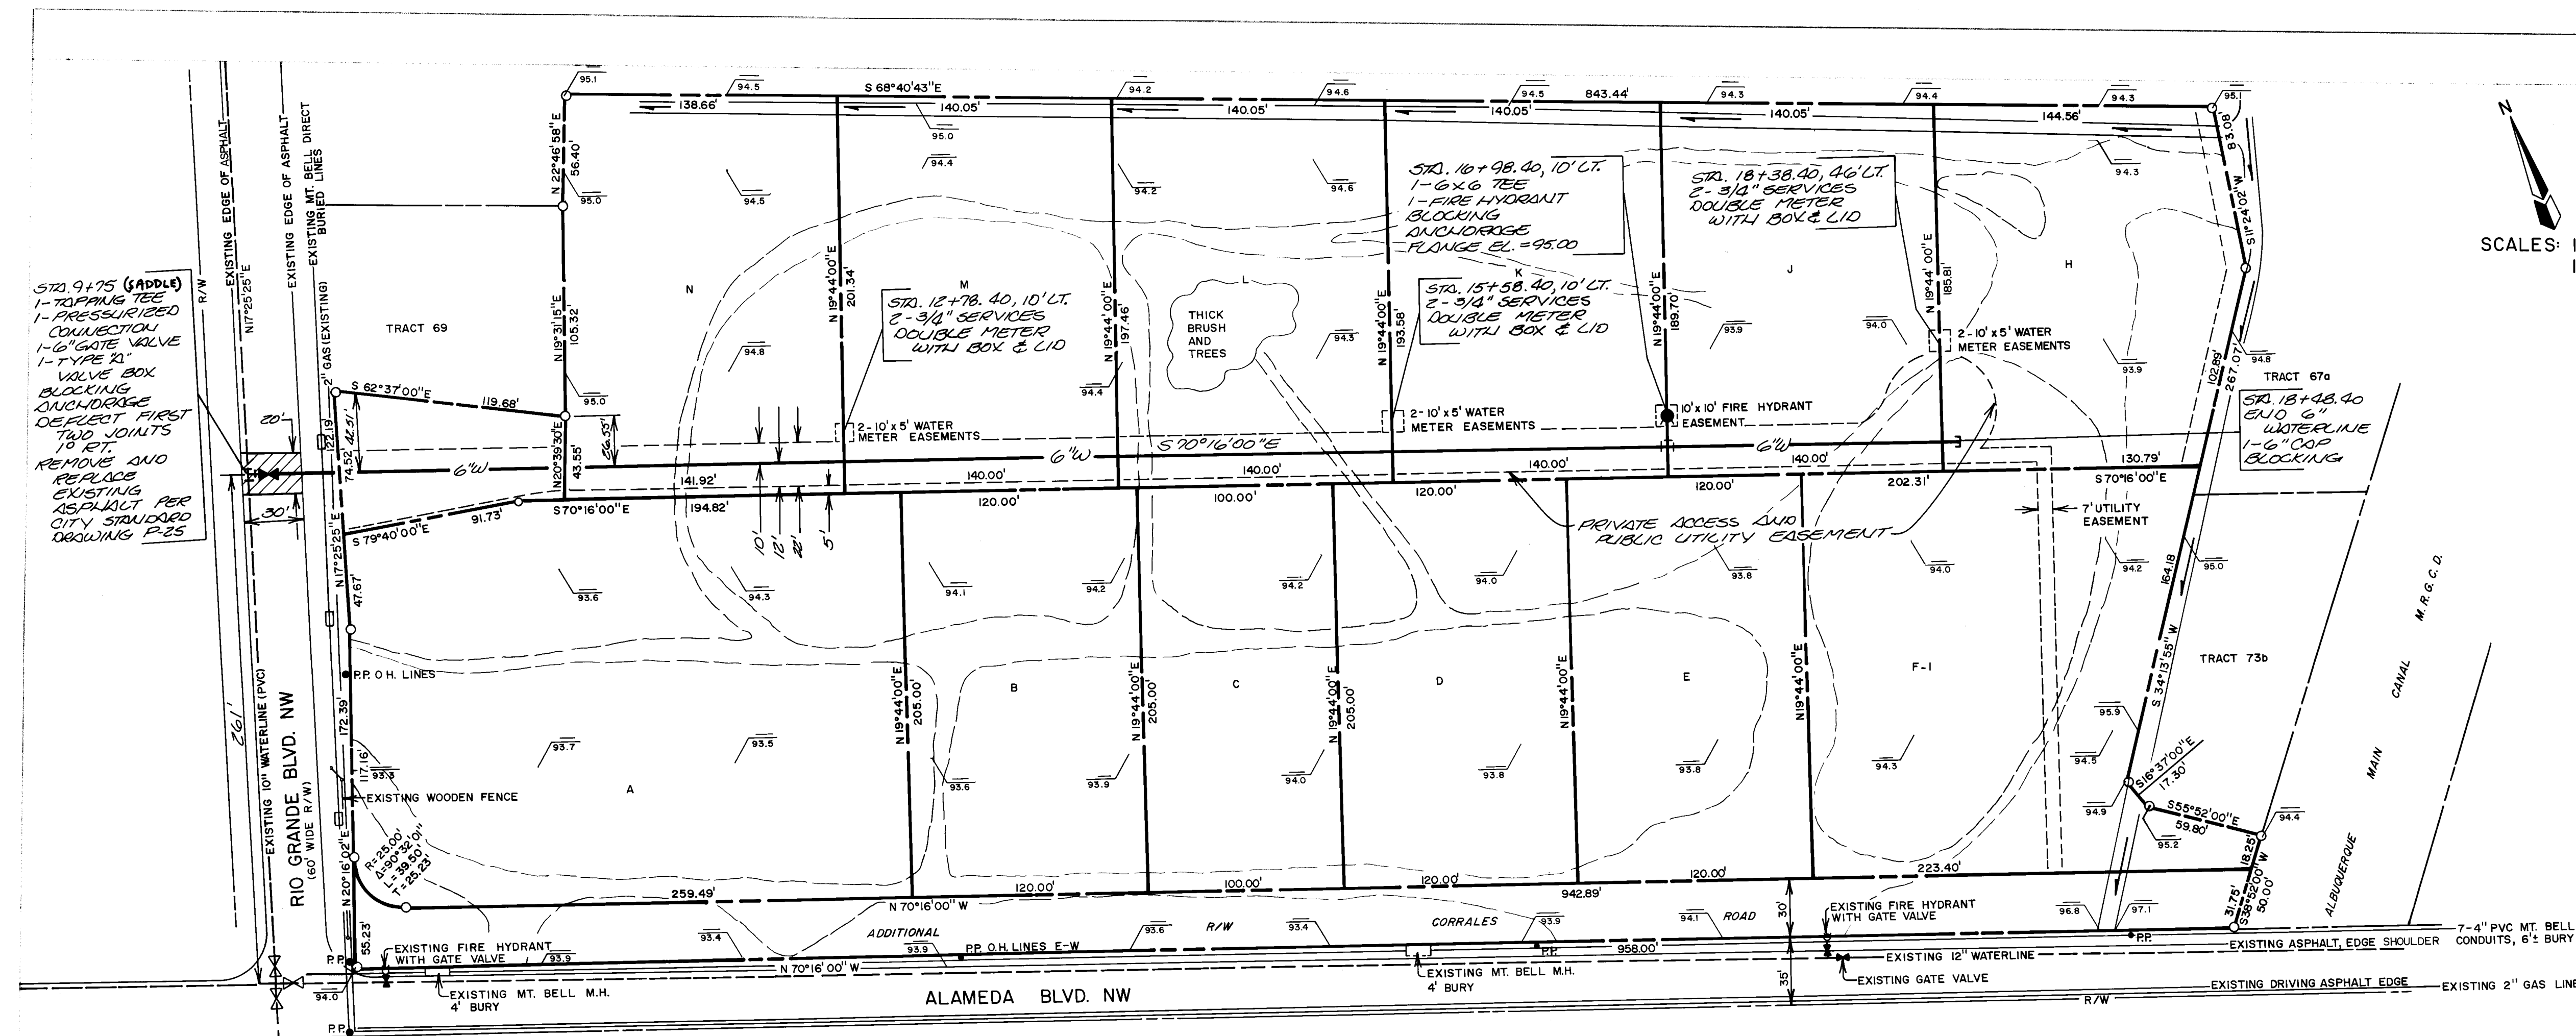

SCALES: 1" = 50' HOR.
1" = 5' VER.

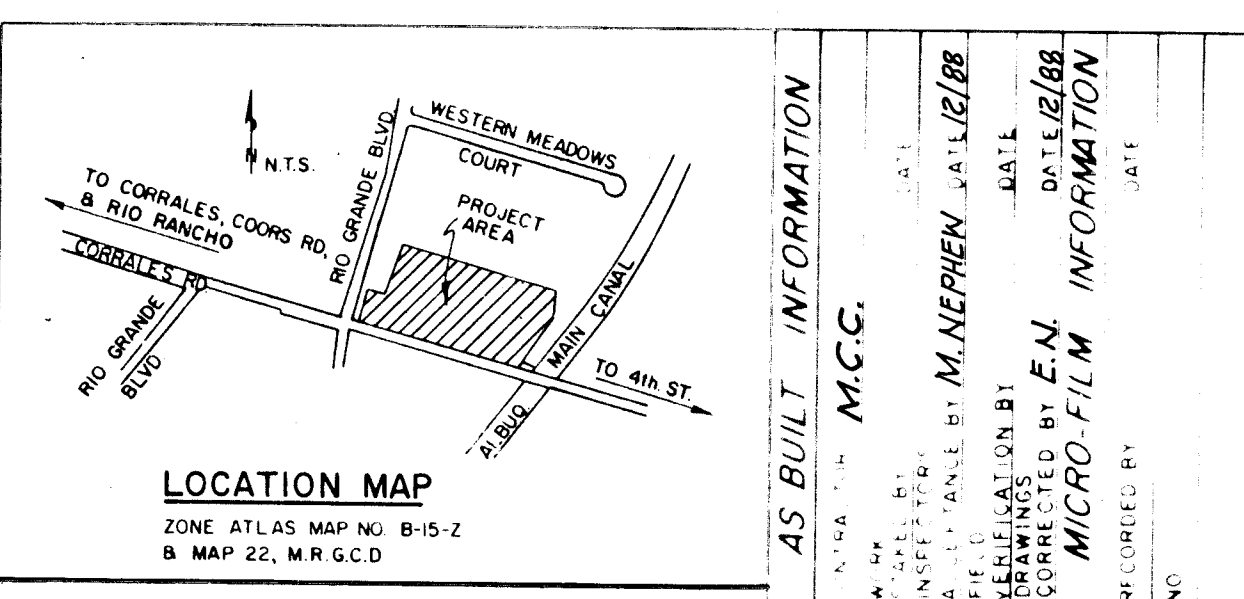


LEGEND	
	EXISTING GROUND SPOT ELEVATION
	EXISTING GATE VALVE
	PROPOSED GATE VALVE
	EXISTING FIRE HYDRANT
	PROPOSED FIRE HYDRANT
	FLOW ARROW
	WATERLINE TEE
	PROPERTY OR R/W BOUNDARY LINE
	EASEMENT BOUNDARY LINE
	EXISTING CONTOUR
	EXISTING WATERLINE
	EXISTING POWER POLE
	6" WATERLINE (PROPOSED)

GENERAL NOTES

- All construction is to be in accordance with the City of Albuquerque's Interim Standard Specifications for Public Works Construction, 1985 Edition.
- The following City Standard Drawings are to be used:
 - W-1 WATERLINE CONNECTION
 - W-2 TYPE A VALVE BOX
 - W-4 VALVE BOX RING & COVER
 - W-5 VALVE ANCHORAGE
 - W-10 METERED SERVICE LINE
 - W-15 METER BOX INSTALLATION
 - W-16 DOUBLE METER BOX
 - W-18 METER BOX AND LID
 - W-20 FIRE HYDRANT INSTALLATION
 - W-22 CONCRETE BLOCKING
 - P-2 RESIDENTIAL STREET SECTION, ASPHALT SECTION
- All pipe is to be ductile iron pipe or PVC.
- Traffic control is to be provided by Contractor per MUTCD Standards.
- Two (2) working days prior to any excavation, Contractor must contact line locating service 765-1234, for location of existing utilities.
- Prior to construction, the Contractor shall excavate and verify the horizontal and vertical locations of all obstructions. Should a conflict exist, the Contractor shall notify the Engineer or Surveyor so that the conflict can be resolved with a minimum amount of delay.
- Backfill compaction shall be according to specified street use.
- Tack coat requirements shall be determined by the City Engineer.

LEGAL DESCRIPTION

REPLAT OF COMMONS NORTH AND TRACT 70, MAP 22, M.R.G.C.D. TO COMMONS NORTH AT ALAMEDA BLVD. NW AND RIO GRANDE BLVD. NW, BERNALILLO COUNTY, NEW MEXICO (B-15-26).

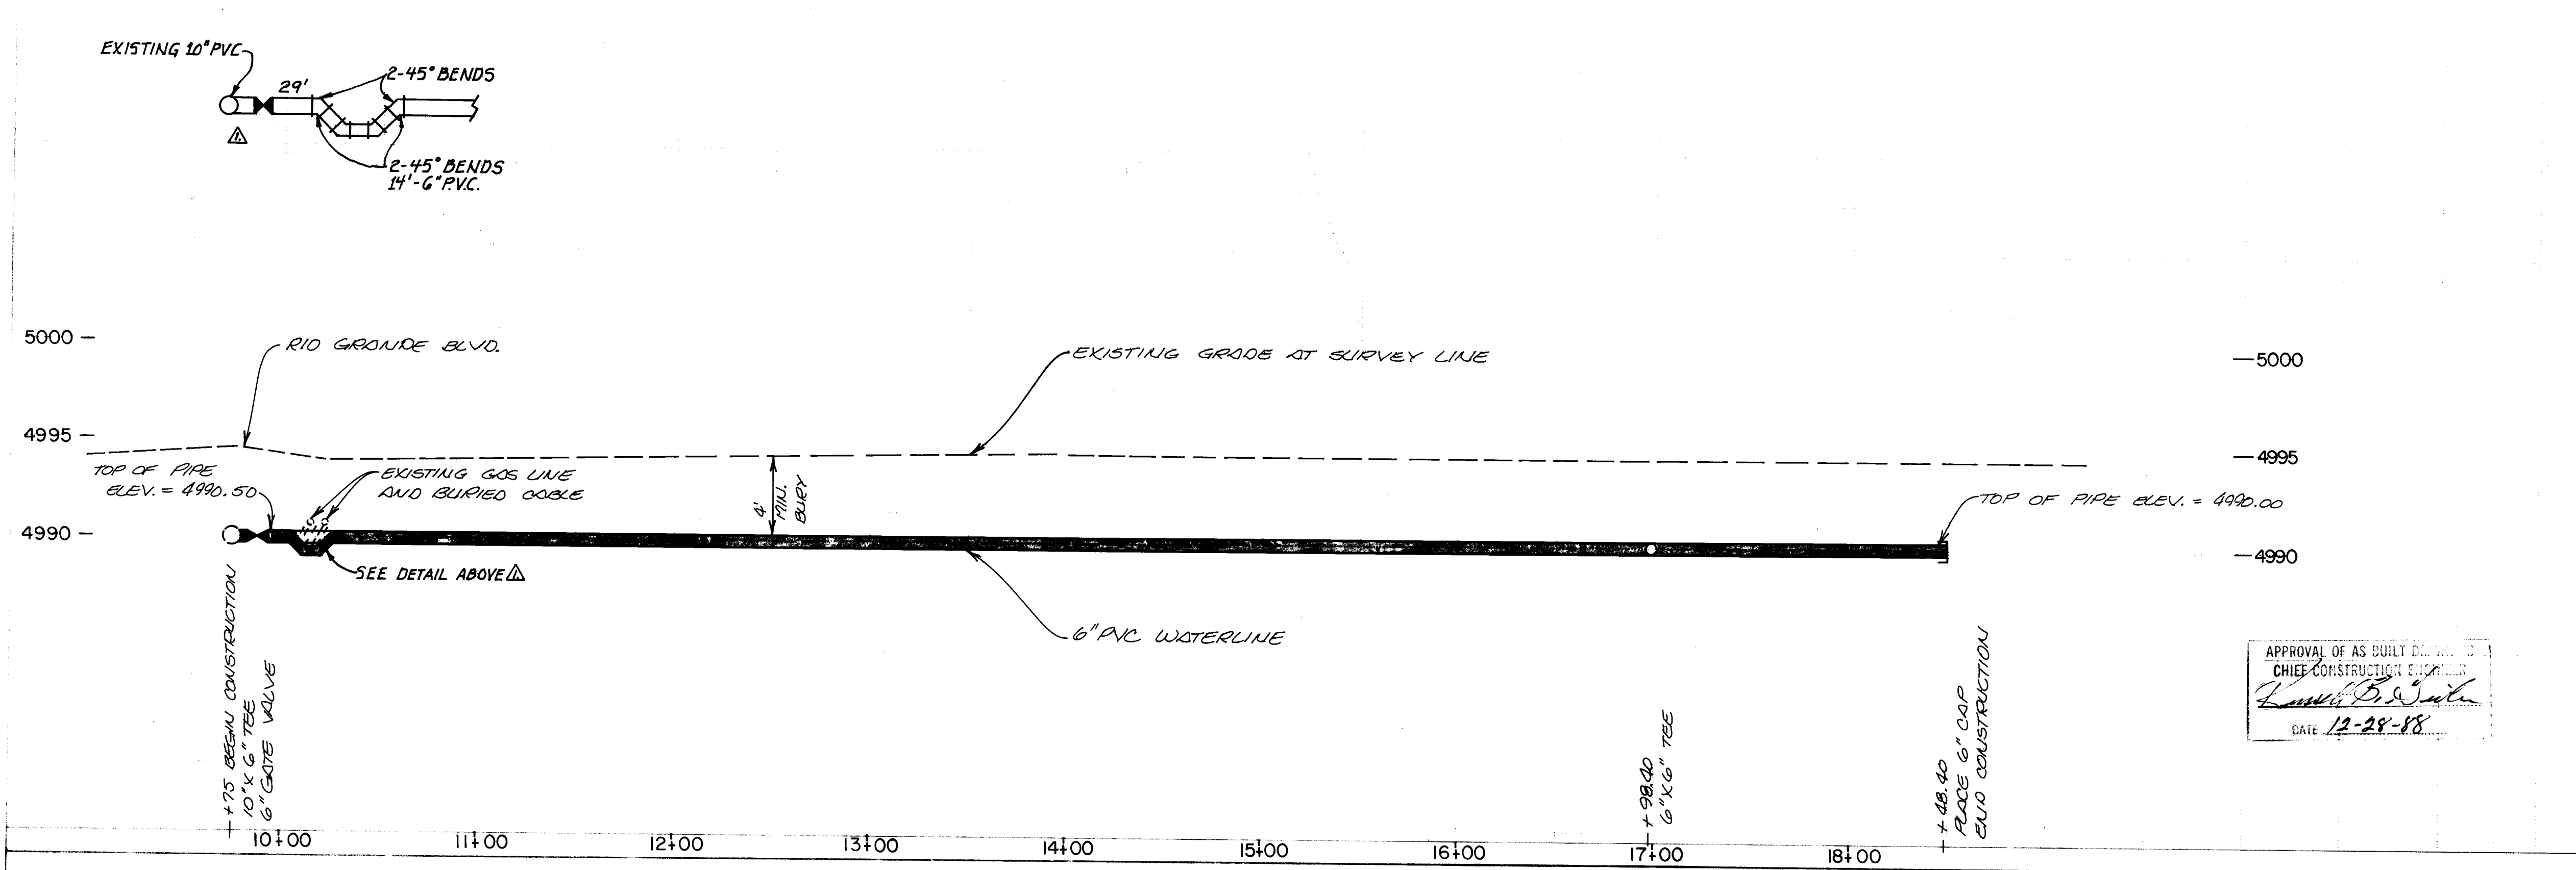

ENGINEER'S SEAL	
EN	BY
NO	DATE
REVISIONS	REVISIONS
DESIGNED BY	DATE
DRAWN BY	DATE
CHECKED BY	DATE

CITY OF ALBUQUERQUE PUBLIC WORKS DEPARTMENT ENGINEERING GROUP	
TITLE	
COMMONS NORTH WATERLINE EXTENSION	
APPROVALS	DATE
City Engineer	4/2/87
A.C.E. - Design	4/14/87
A.C.E. - Hydrology	4/14/87
APPROVALS	DATE
Liquid Waste	4/13/87
Traffic	4/10/87
Water	4/13/87