


CONSTRUCTION PLANS
FOR
AIRPORT TECHNICAL CENTER
60" RCP STORM DRAIN EXTENSION
ALBUQUERQUE, NEW MEXICO

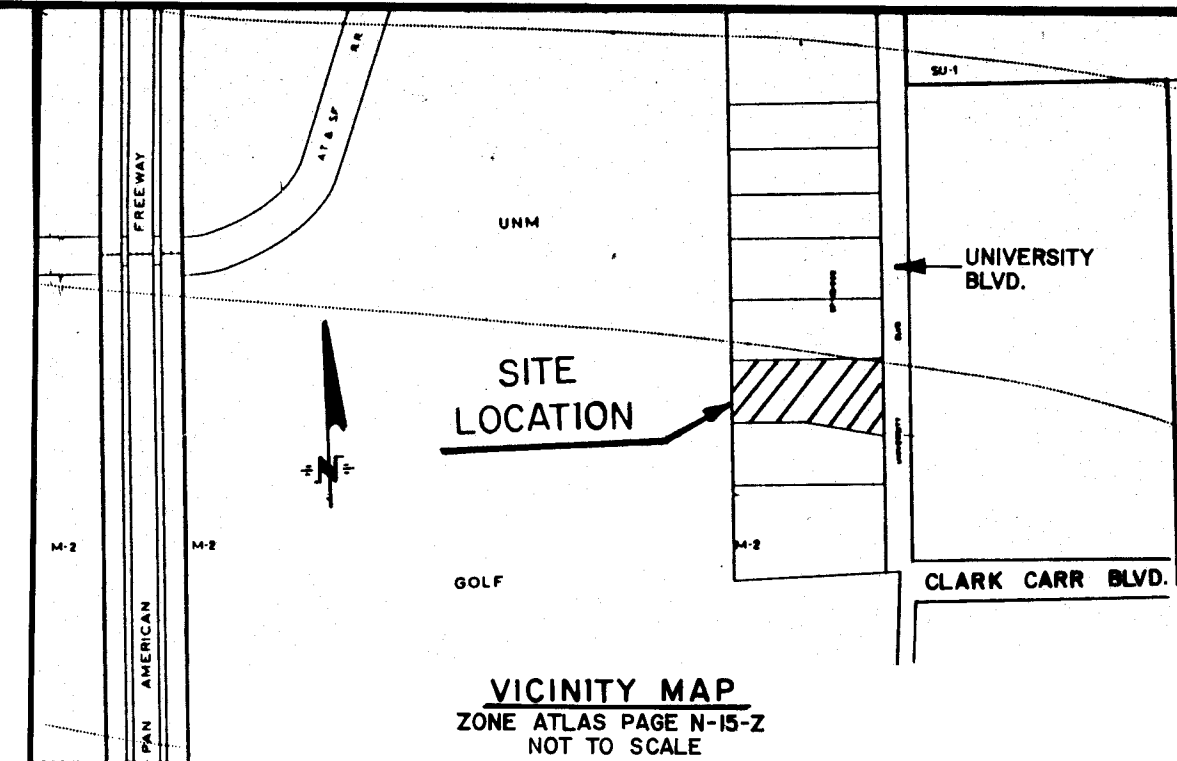


GENERAL NOTES

NOTICE TO CONTRACTORS


- ALL WORK DETAILED ON THESE PLANS TO BE PERFORMED UNDER CONTRACT SHALL, EXCEPT AS OTHERWISE STATED OR PROVIDED FOR HEREON, BE CONSTRUCTED IN ACCORDANCE WITH CITY OF ALBUQUERQUE INTERIM STANDARD SPECIFICATIONS PUBLIC WORKS CONSTRUCTION, 1985 EDITION.
- TWO WORKING DAYS PRIOR TO ANY EXCAVATION, CONTRACTOR MUST CONTACT LINE LOCATING SERVICE, 765-1234, FOR LOCATION OF EXISTING UTILITIES.
- PRIOR TO CONSTRUCTION, THE CONTRACTOR SHALL EXCAVATE AND VERIFY THE HORIZONTAL AND VERTICAL LOCATIONS OF ALL OBSTRUCTIONS. SHOULD A CONFLICT EXIST, THE CONTRACTOR SHALL NOTIFY THE ENGINEER OR SURVEYOR SO THAT THE CONFLICT CAN BE RESOLVED WITH A MINIMUM AMOUNT OF DELAY.

THE FOLLOWING NOTES ALSO APPLY WHEN CHECKED

- ☐ ALL UTILITIES AND UTILITY SERVICE LINES SHALL BE INSTALLED PRIOR TO PAVING.
- ☐ BACKFILL COMPACTION SHALL BE ACCORDING TO SPECIFIED STREET USE.
- ☐ TACK COAT REQUIREMENTS SHALL BE DETERMINED BY THE CITY ENGINEER.
- ☐ SIDEWALKS AND WHEELCHAIR RAMPS WITHIN THE CURB RETURNS SHALL BE CONSTRUCTED WHEREVER A NEW CURB RETURN IS CONSTRUCTED.
- ☐ IF CURB IS DEPRESSED FOR A DRIVEPAD, THE DRIVEPAD SHALL BE CONSTRUCTED PRIOR TO ACCEPTANCE OF CURB AND GUTTER.
- ☒ ALL STORM DRAINAGE FACILITIES SHALL BE COMPLETED PRIOR TO FINAL ACCEPTANCE.
- ☐ THE REQUESTOR OR DEVELOPER SHALL BE RESPONSIBLE FOR REPAIR OR REPLACEMENT OF ALL CURB AND GUTTER OR SIDEWALK DAMAGED AFTER APPROVAL BY THE CITY ENGINEER OF WORK COMPLETED BY THE CONTRACTOR.

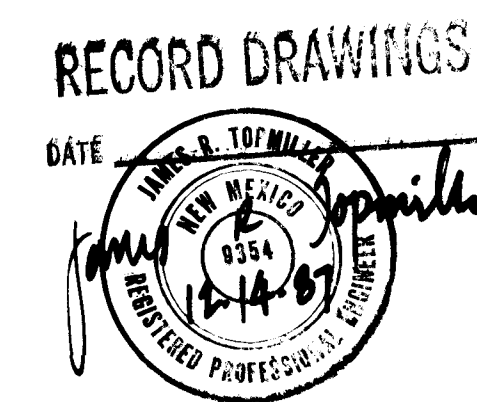



SHEET NO.	DESCRIPTION
1	TITLE SHEET
2	60" RCP PLAN & PROFILE
3	CONSTRUCTION DETAILS






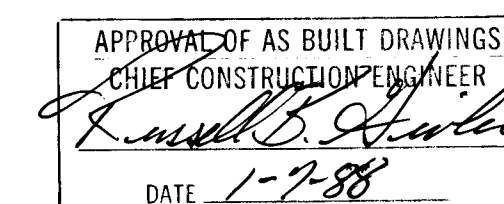


1	2	3	4	5	6	7	8	9	10	11	12
2	6	3	2	2	0	1	8	8			

REV	SHEETS	CITY ENGINEER	DATE	USER	DEPT.	DATE	USER	DEPT.	DATE
APPROVAL OF REVISIONS									

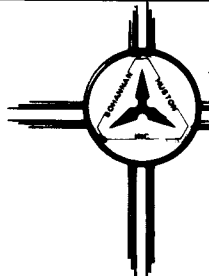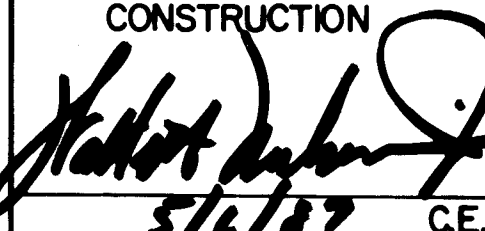

 BOHANNAN - HUSTON INC. ALBUQUERQUE - SANTA FE - EL PASO ENGINEERS PLANNERS PHOTOGRAMMETRISTS	APPROVED FOR CONSTRUCTION  5/6/87 C.E.
PROJECT NUMBER 3222	SHEET 1 OF 3

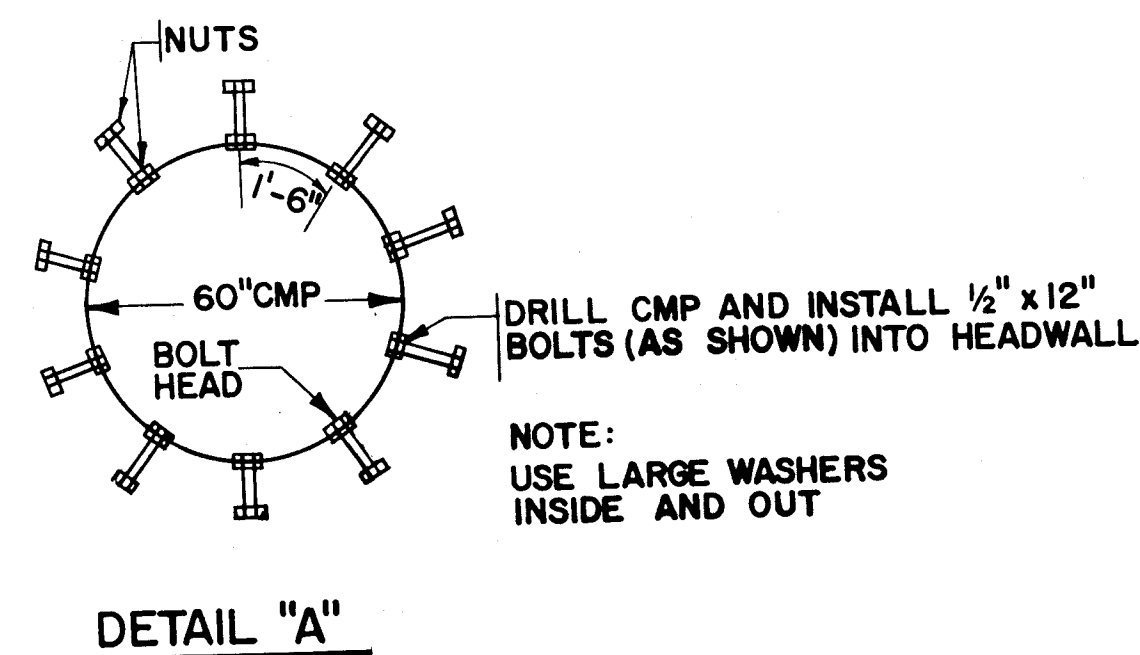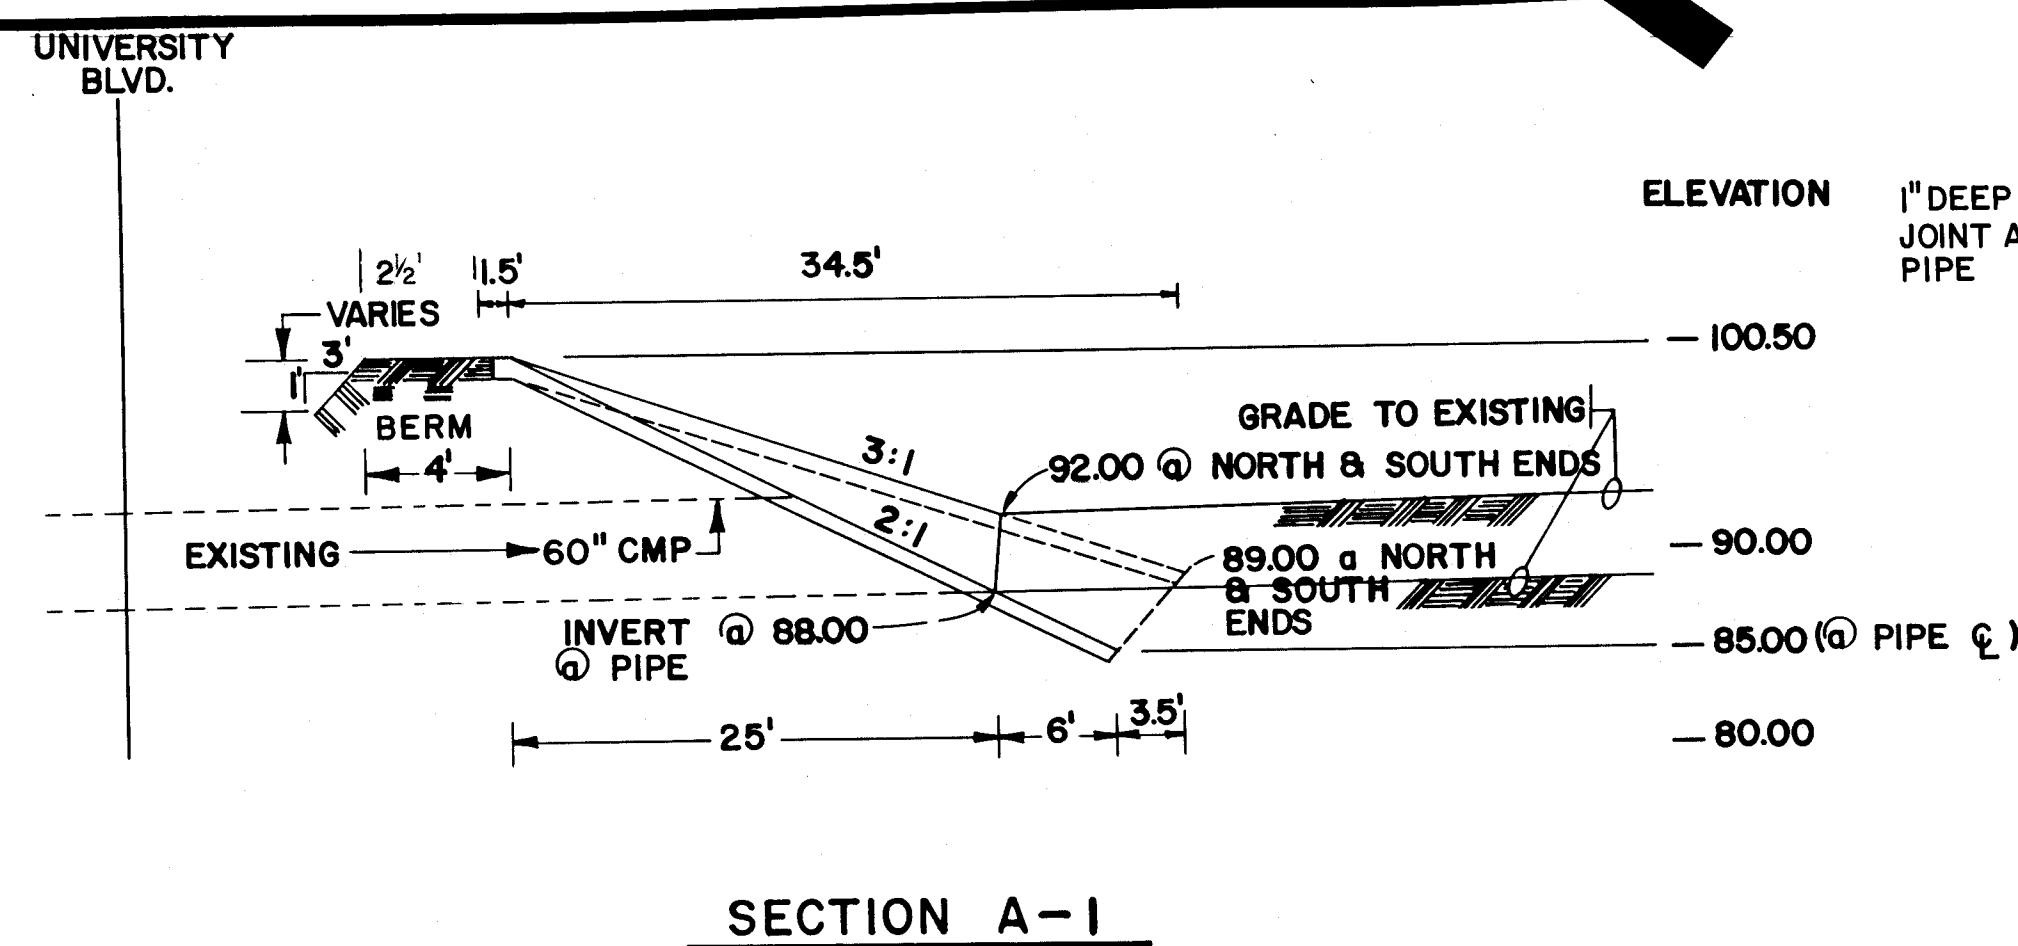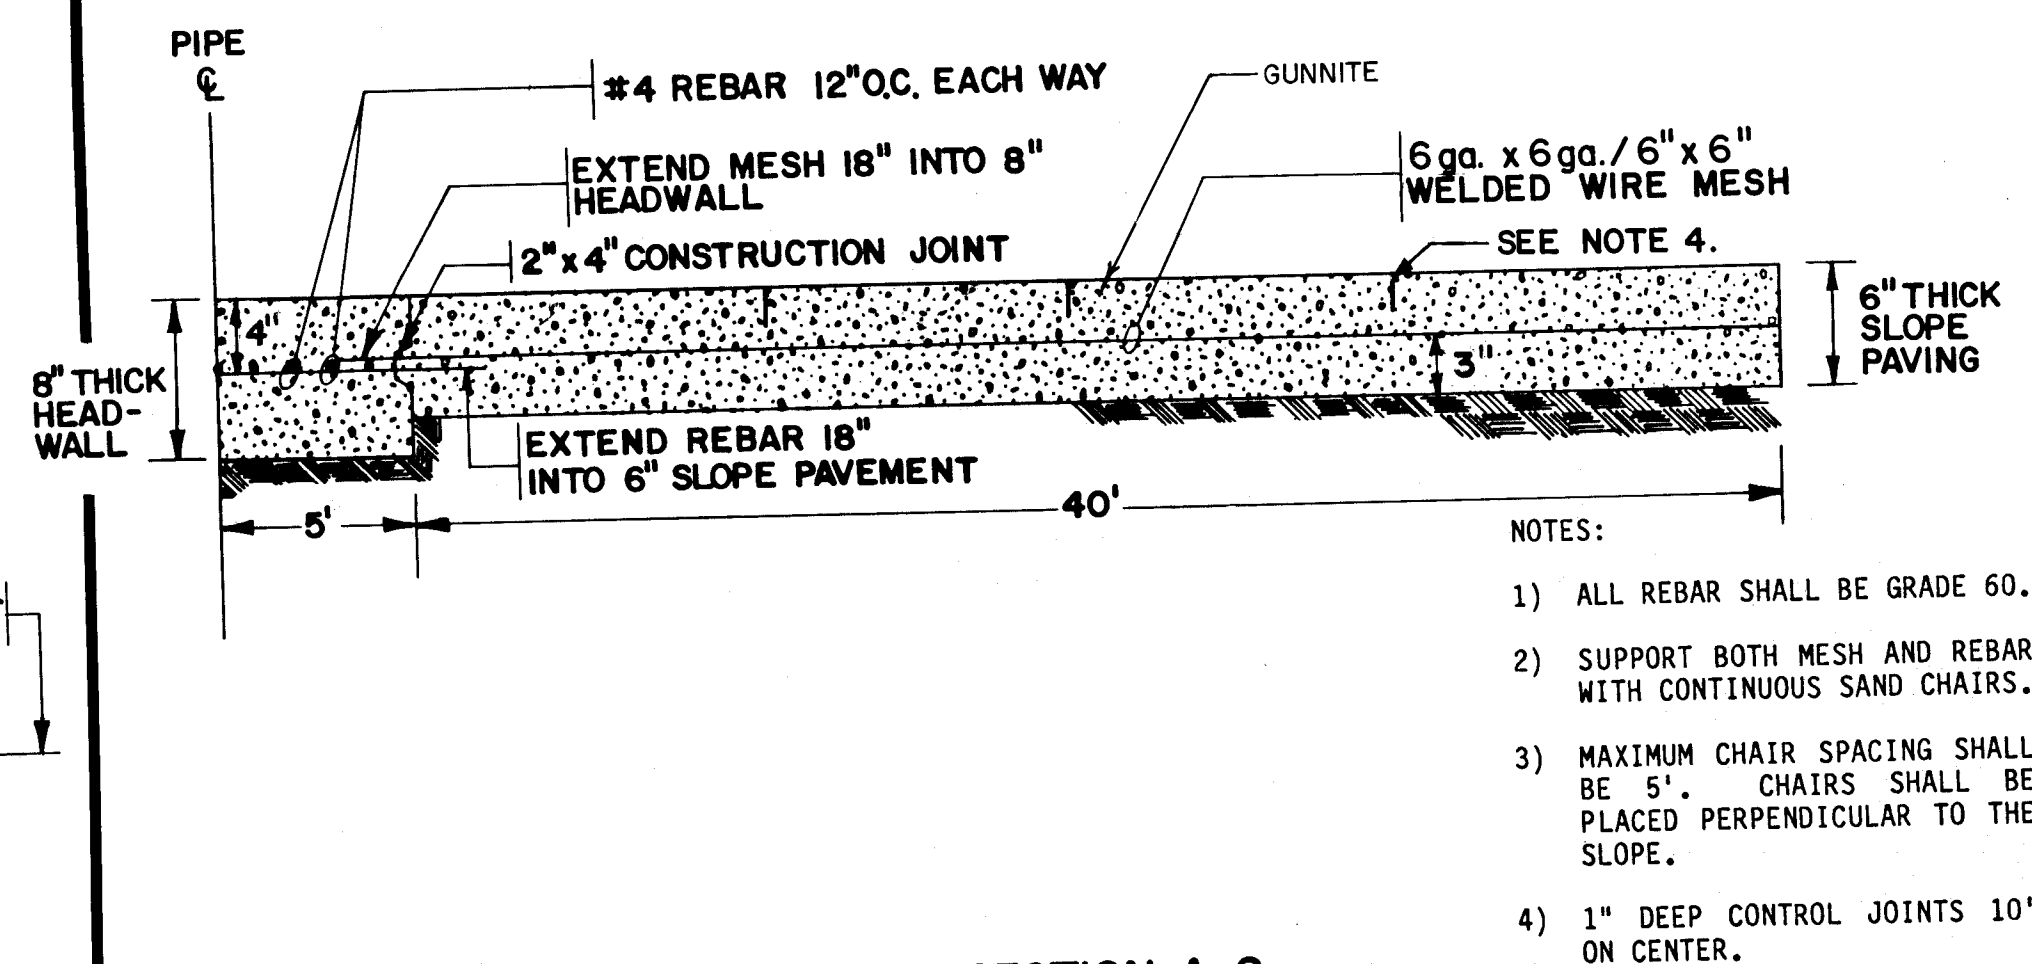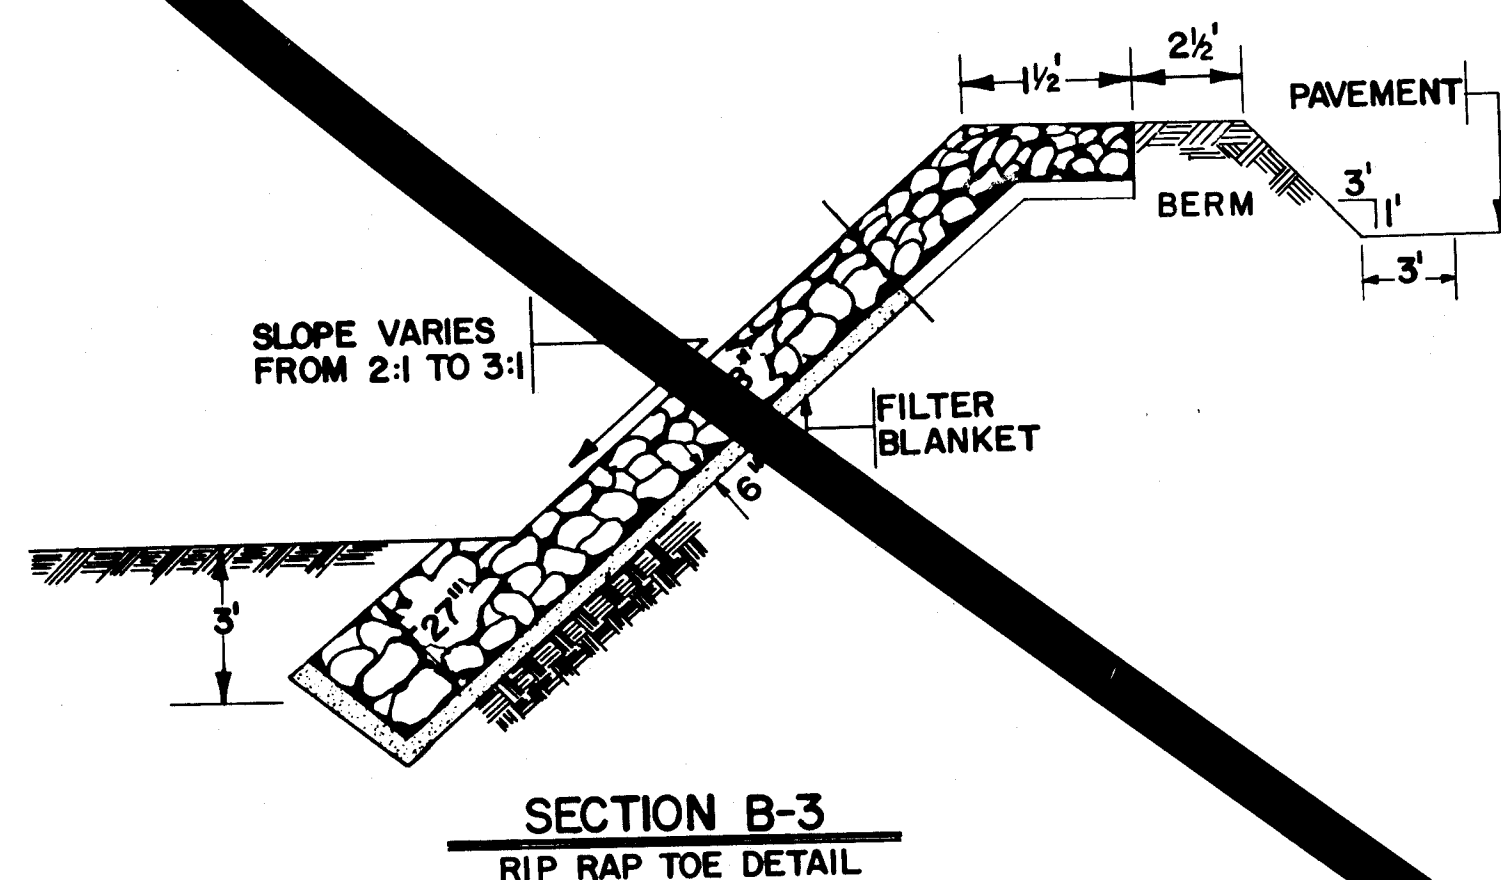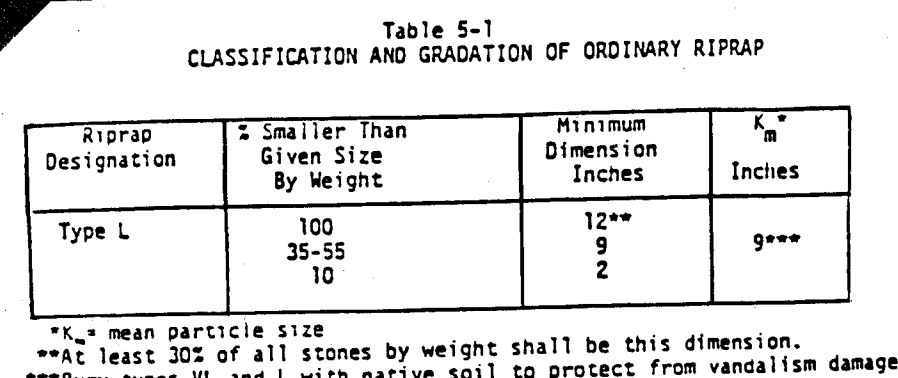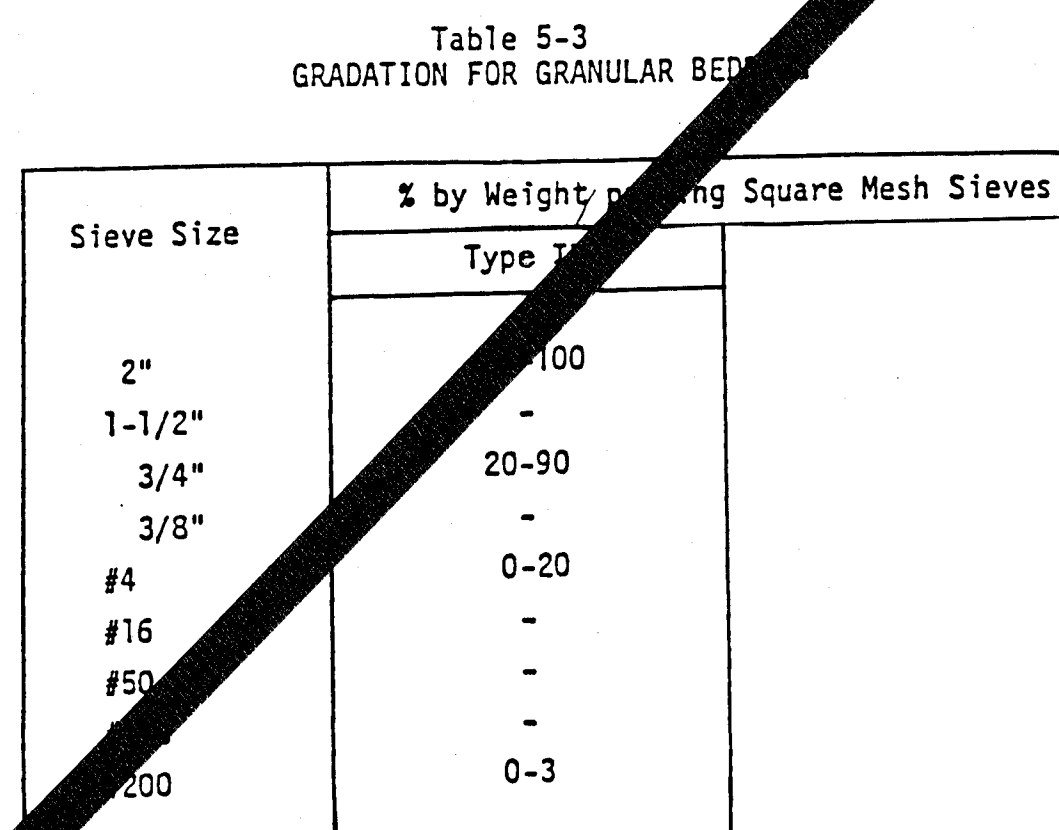

RECORD DRAWMING

DATE _____

James R. Topmiller



		UNIVERSITY CENTER ON EXTENSION DETAILS		QUERQUE	
APPROVALS Solid Waste Lic or		ENGINEER W/W NADW# W/W		DATE 4-3-87 4-3-87	
DESIGN DESIGNED BY JT DRAWN BY TL CHECKED BY JT		REVISIONS		REMARKS	
NO. DATE		BY		REMARKS	
ENGINEER'S SEAL 		SURVEY INFORMATION FIELD NOTES NO. BY DATE		BENCH MARKS CITY BENCH MARK 2-NIG, STD ACS BRASS, TABLET LOCATED SOUTHWEST CORNER OF THE ALBUQUERQUE INTERNATIONAL AIRPORT IN AN OPEN PRAIRIE.	
AS-BUILT INFORMATION CONTRACTOR UNIVERSAL CONSTRUCTORS STARTED BY B.H.I. DATE JUNE 1987 INSPECTOR'S FIELD ACCEPTANCE BY B.H.I. DATE JUNE 24, 1987 VERIFICATION BY B.H.I. DATE JUNE 1987 CORRECTED BY B.H.I. DATE JUNE 1987		MICRO-FILM INFORMATION RECORDED BY DATE NO.			

NOTES:

1. ALL SUBGRADE RECEIVING CONCRETE
SLOPE PAVING SHALL BE COMPACTED
TO 95% ASTM D 1557 TO DEPTH
OF 8".

2. ALL SUBGRADE RECEIVING RIP RAP
SHALL BE COMPACTED TO 95% ASTM
D 1557 TO DEPTH OF 8"

		CITY OF ALBUQUERQUE			
TITLE: AIRPORT TECHNICAL CENTER 60" RCP STORM DRAIN EXTENSION CONSTRUCTION DETAILS					
APPROVALS	ENGINEER	DATE	APPROVALS	ENGINEER	DATE
City Engineer	<i>[Signature]</i>	4/2/87	Liquid Waste	WJW	4-3-87
A C E - Design	TR	"	Traffic	NADWH	4/3/87
A C E - Hydrology	<i>[Signature]</i>	4-3-87	Water	WJW	4-3-87
DRAWING NO. 3222		MAP NO. N15		SHEET 3 OF 3	