
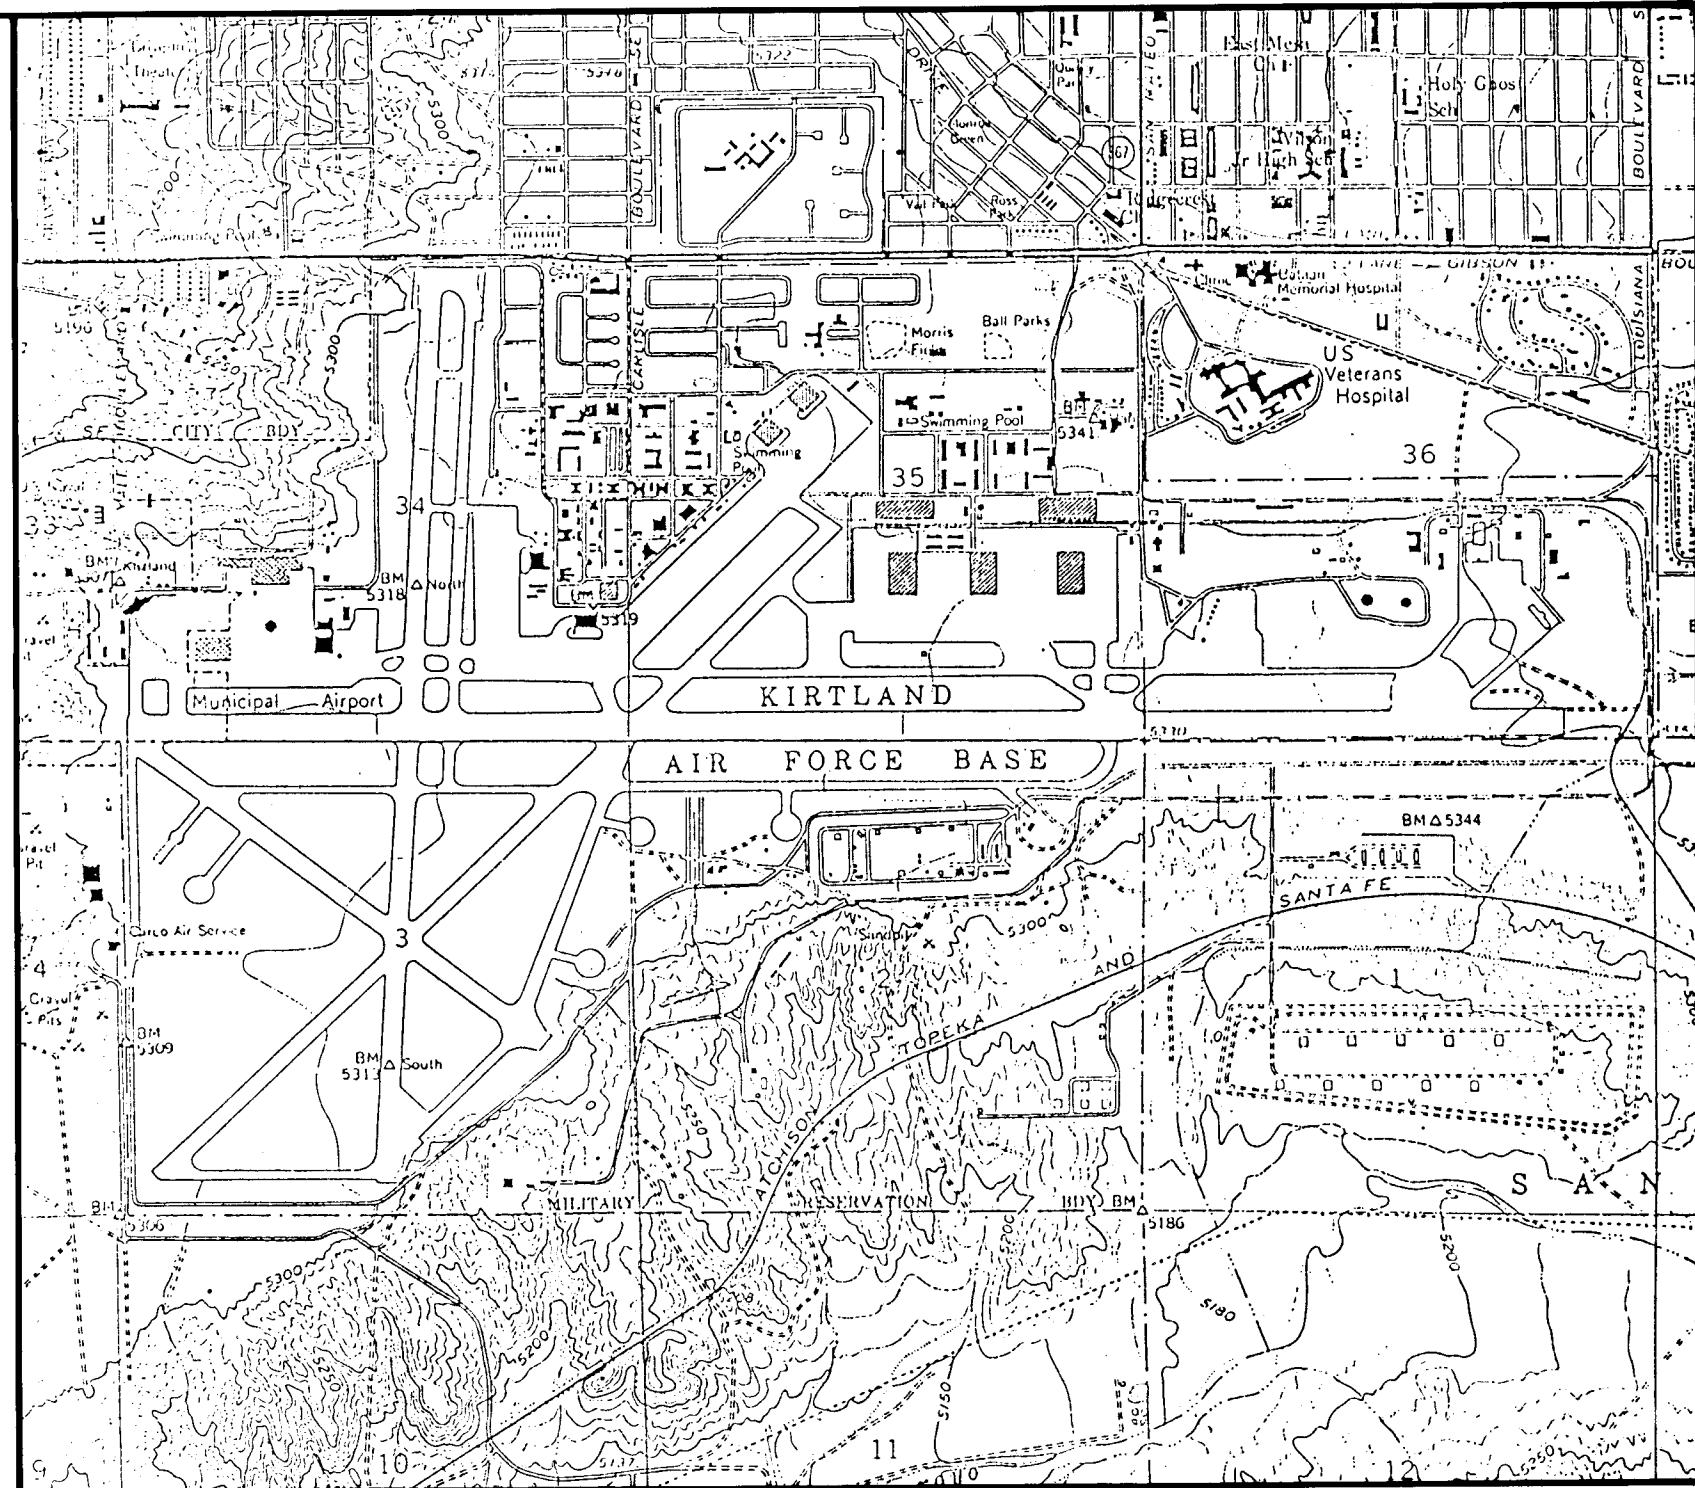


CITY OF ALBUQUERQUE
NEW MEXICO

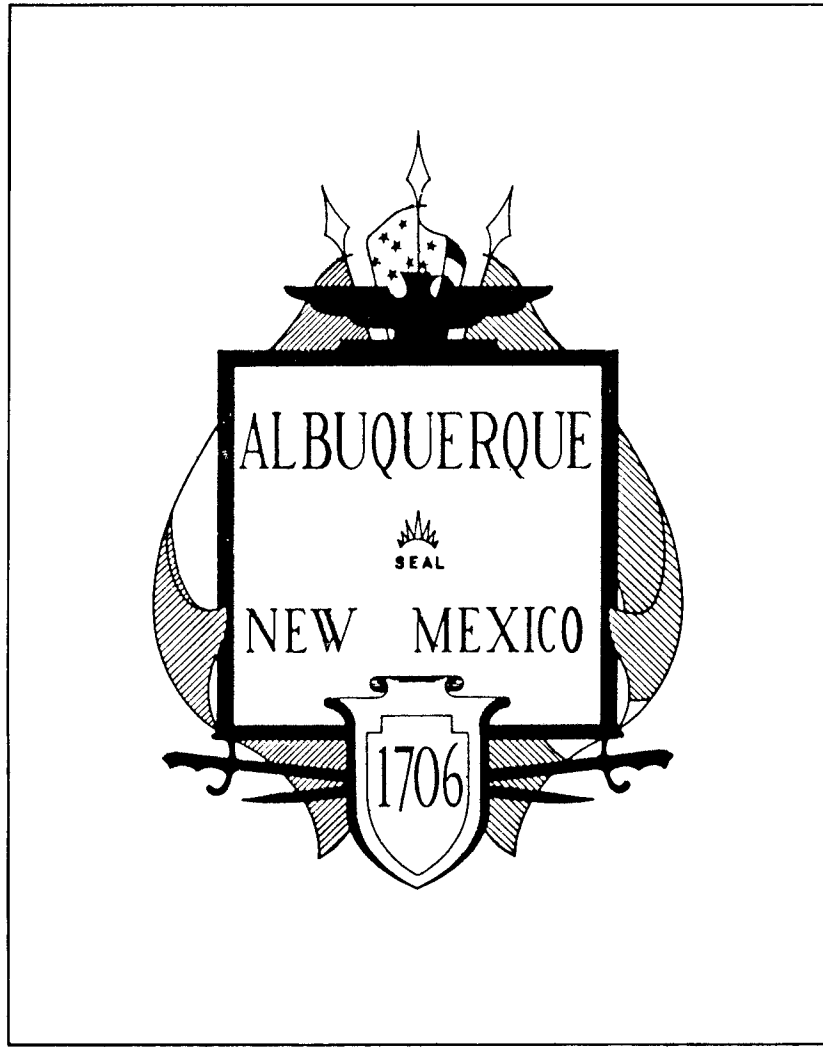

VICINITY MAP
SCALE: 1"=APPROX. 2000'


RUNWAY & TAXIWAY GUIDANCE SIGNS
ELECTRICAL VAULT EQUIPMENT RELOCATION
ALBUQUERQUE INT'L AIRPORT

A.I.P. 3-35-0003-05/06

MARCH 1987

INDEX OF DRAWINGS

1. COVER SHEET
2. RUNWAY AND TAXIWAY IDENTIFICATION
3. ESTIMATE OF QUANTITIES
- 4-12. GUIDANCE SIGN LAYOUT
13. CONTROL CABLE ROUTING AND LIGHTING DETAILS
14. LIGHTING CONTROL MODIFICATIONS AND EQUIPMENT LAYOUT - SOUTH ELECTRICAL VAULT
15. LIGHTING CONTROL MODIFICATIONS - SOUTH ELECTRICAL VAULT
16. ELECTRICAL EQUIPMENT LAYOUT - NEW ELECTRICAL VAULT
- 17-18. LIGHTING CONTROLS - NEW ELECTRICAL VAULT
19. REMOTE CONTROL PANEL - AIR TRAFFIC CONTROL TOWER

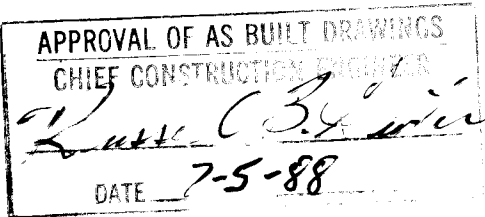

1 2 3 4 5 6 7 8 9 10 11 12											
26 32260188											
RECORD DRAWING											
DATE: 4/14/88 BY: [Signature] FROM:											
REV. SHEETS CITY ENGR. DATE USER DEPT. DATE USER DEPT. DATE											
APPROVAL OF REVISIONS											
APPROVED FOR CONSTRUCTION											
CITY ENGINEER [Signature]											
PROJECT NUMBER 3226											
SHEET 1 OF 19											

