


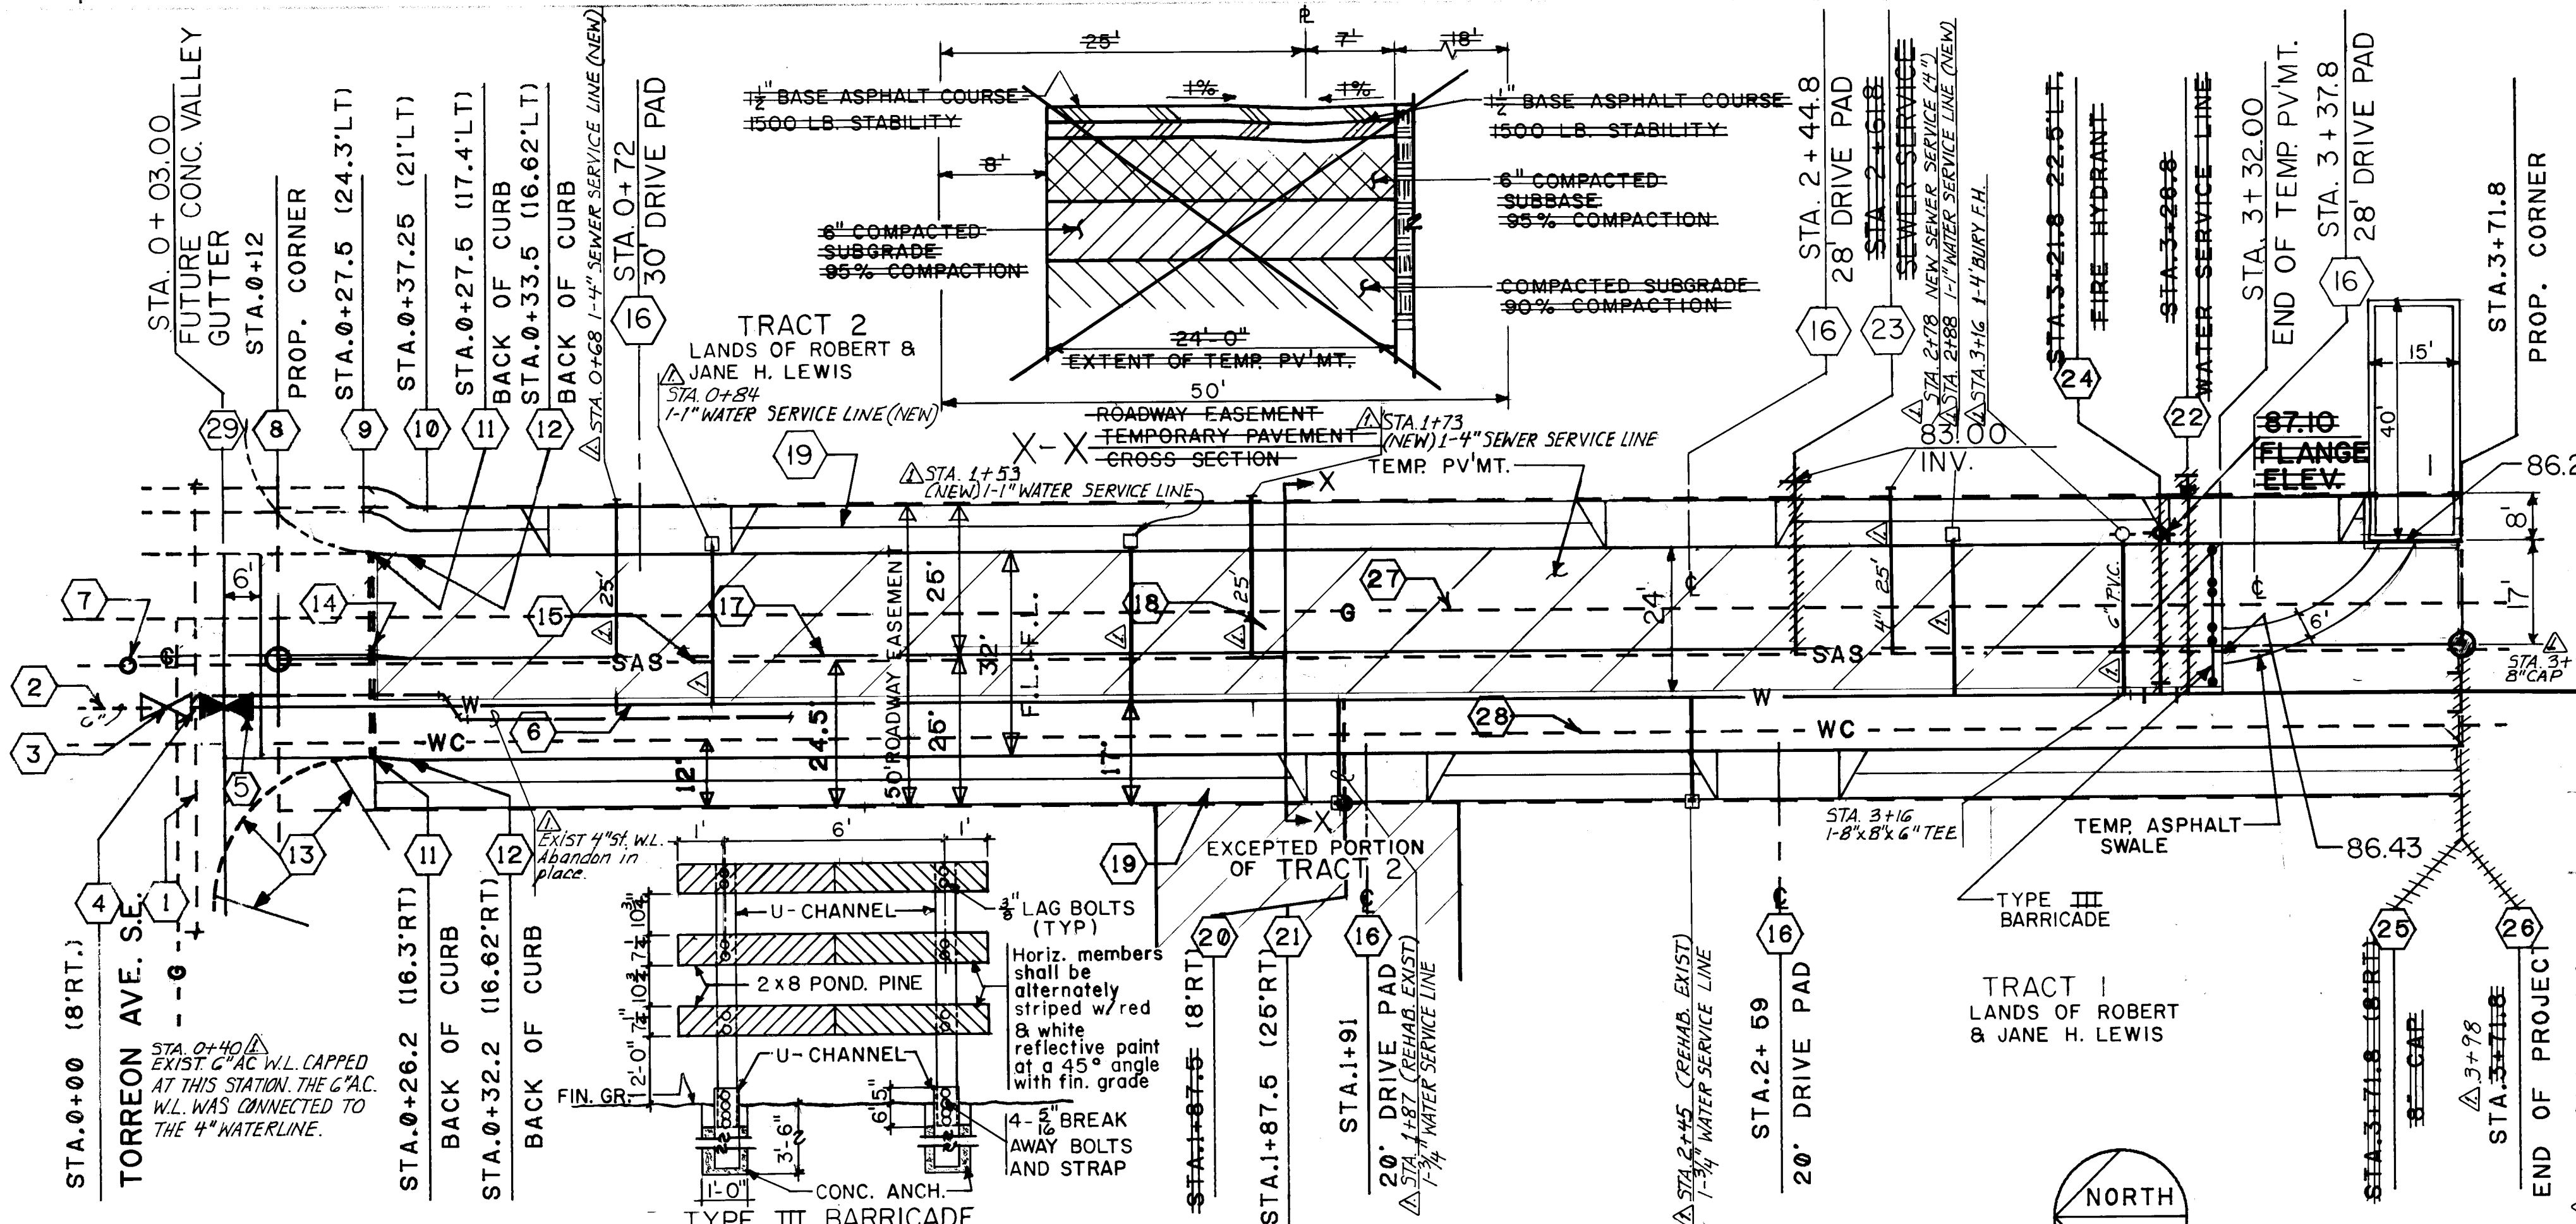

KEYED NOTES

1. Exist. 20" Steel Main Water Supply Line.
2. Exist. 8" Water Line.
3. Exist. 6" Gate Valve to Remain.
4. Exist. 4" Tee Leg to be Plugged and Tap the 20" Line with an 8" Pressure Connection per City Std. Dwg. W-1. This Connection shall be made at least 2 feet from existing Tee with a Welded Neck Flange and 8" Tapping Valve.
5. Install 8" Gate Valve per City Std. Dwg. W-6.
6. Exist. 4" Water Line to be Removed and Replaced by an 8" PVC C-900 Water Line.
7. Existing SWS Manhole.
8. Existing Shiner at Property Corner.
9. End of Exist. Sidewalk, Beginning of Transition to New Sidewalk per City Std. Dwg. P-15.
10. End of Transition From Exist. Sidewalk to New 4' Sidewalk per City Std. Dwg's P-13 & P-15.
11. End of Exist. Curb, Beginning of Transition to New Curb & Gutter.
12. End of Transition From Exist. Curb to New Curb & Gutter.
13. Exist. Laydown Curb and Drive Pad.
14. Exist. Curb at End of Exist. Paving to be Removed. New Temporary Paving to Match Existing.
15. Exist. 8" SWS Line.
16. Center Line of New Drive Pad, per City Std. Dwg. P-11.
17. Station Base Line, Property Line, and Center Line of New Street.
18. New Paving per City Std. Dwg. P-4.
19. New 4' Concrete Sidewalk per City Std. Dwg. P-13.
20. Exist. Water Service Connection to be Reconnected to New Water Line per City Std. Dwg. W-10.
21. Exist. Water Meter to Remain.
22. 1" Water Service Line with 1" Meter per City Std. Dwg. W-11.
23. 2" Water Service Line per City Std. Dwg. W-9.
24. 2" Water Service Line per City Std. Dwg. W-9.
25. Concrete Cutoff Wall at End of Project, Top of Wall Flush with Top of Asphalt.
26. Exist. 2" Gas Line.
27. Exist. 12" Well Collector.
28. New Concrete Valley Gutter to be constructed per City Standard Drawing P-9. Remove laydown curb at return and construct Standard curb return and wheel chair ramp per City Std. Dwg. P-16 and P-17.

VICINITY MAP

LEGAL DESCRIPTION
Tract 2 of the plat of the lands of Robert and Jane H. Lewis in the city of Albuquerque, N.M.

NOTICE TO CONTRACTOR


1. ALL WORK DETAILED ON THESE PLANS TO BE PERFORMED UNDER CONTRACT SHALL, EXCEPT AS OTHERWISE STATED OR PROVIDED HEREON, BE CONSTRUCTED IN ACCORDANCE WITH THE CITY OF ALBUQUERQUE INTERIM STANDARD SPECIFICATIONS PUBLIC WORKS CONSTRUCTION, 1985.
2. TWO WORKING DAYS PRIOR TO ANY EXCAVATION, CONTRACTOR MUST CONDUCT LINE LOCATING SERVICE 765-1234 FOR LOCATION OF EXISTING UTILITIES.
3. PRIOR TO CONSTRUCTION, THE CONTRACTOR SHALL EXCAVATE AND VERIFY THE HORIZONTAL AND VERTICAL LOCATIONS OF ALL OBSTRUCTIONS. SHOULD A CONFLICT EXIST, THE CONTRACTOR SHALL NOTIFY THE ENGINEER SO THAT THE CONFLICT CAN BE RESOLVED WITH A MINIMUM OF DELAY.
4. CONTRACTOR SHALL ASSIST THE ENGINEER/INSPECTOR IN THE RECORDING OF DATA ON ALL UTILITY LINES AND ACCESSORIES AS REQUIRED BY THE CITY OF ALBUQUERQUE FOR THE PREPARATION OF "AS CONSTRUCTED" DRAWINGS. CONTRACTOR SHALL NOT COVER UTILITY LINES AND ACCESSORIES UNTIL ALL DATA HAS BEEN RECORDED.
5. REFERENCE MADE TO STANDARD DRAWINGS REFER TO ALBUQUERQUE STANDARD DRAWINGS.
6. CURB AND GUTTER SHOWN AS EXISTING AND NOT TO BE REMOVED UNDER THE CONTRACT WHICH IS DAMAGED OR DISPLACED BY THE CONTRACTOR SHALL BE REMOVED AND REPLACED BY THE CONTRACTOR AT HIS EXPENSE.
7. WHEN CONSTRUCTION UNDER THIS PROJECT CONNECTS TO EXISTING IMPROVEMENTS, THE CONTRACTOR SHALL PROVIDE AN EASY RIDING CONNECTION.

TRAFFIC HANDLING NOTES:

1. CONTRACTOR MUST SUBMIT A CONSTRUCTION SIGNING AND BARRICADING PLAN TO TRAFFIC ENGINEERING DIVISION AND RECEIVE A BARRICADING PERMIT PRIOR TO CONSTRUCTION.
2. ALL CONSTRUCTION SIGNING AND BARRICADING TO COMPLY WITH MANUAL ON UNIFORM TRAFFIC CONTROL DEVICES, 1978 EDITION.

FUTURE PAVING / WATER LINE IMPROVEMENTS AT EDITH BLVD. S.E.

4/1/87
7/21/87 Hydrology
7/20/87
7/3/87
M.J.W.
D.J.H.
A.F.M.

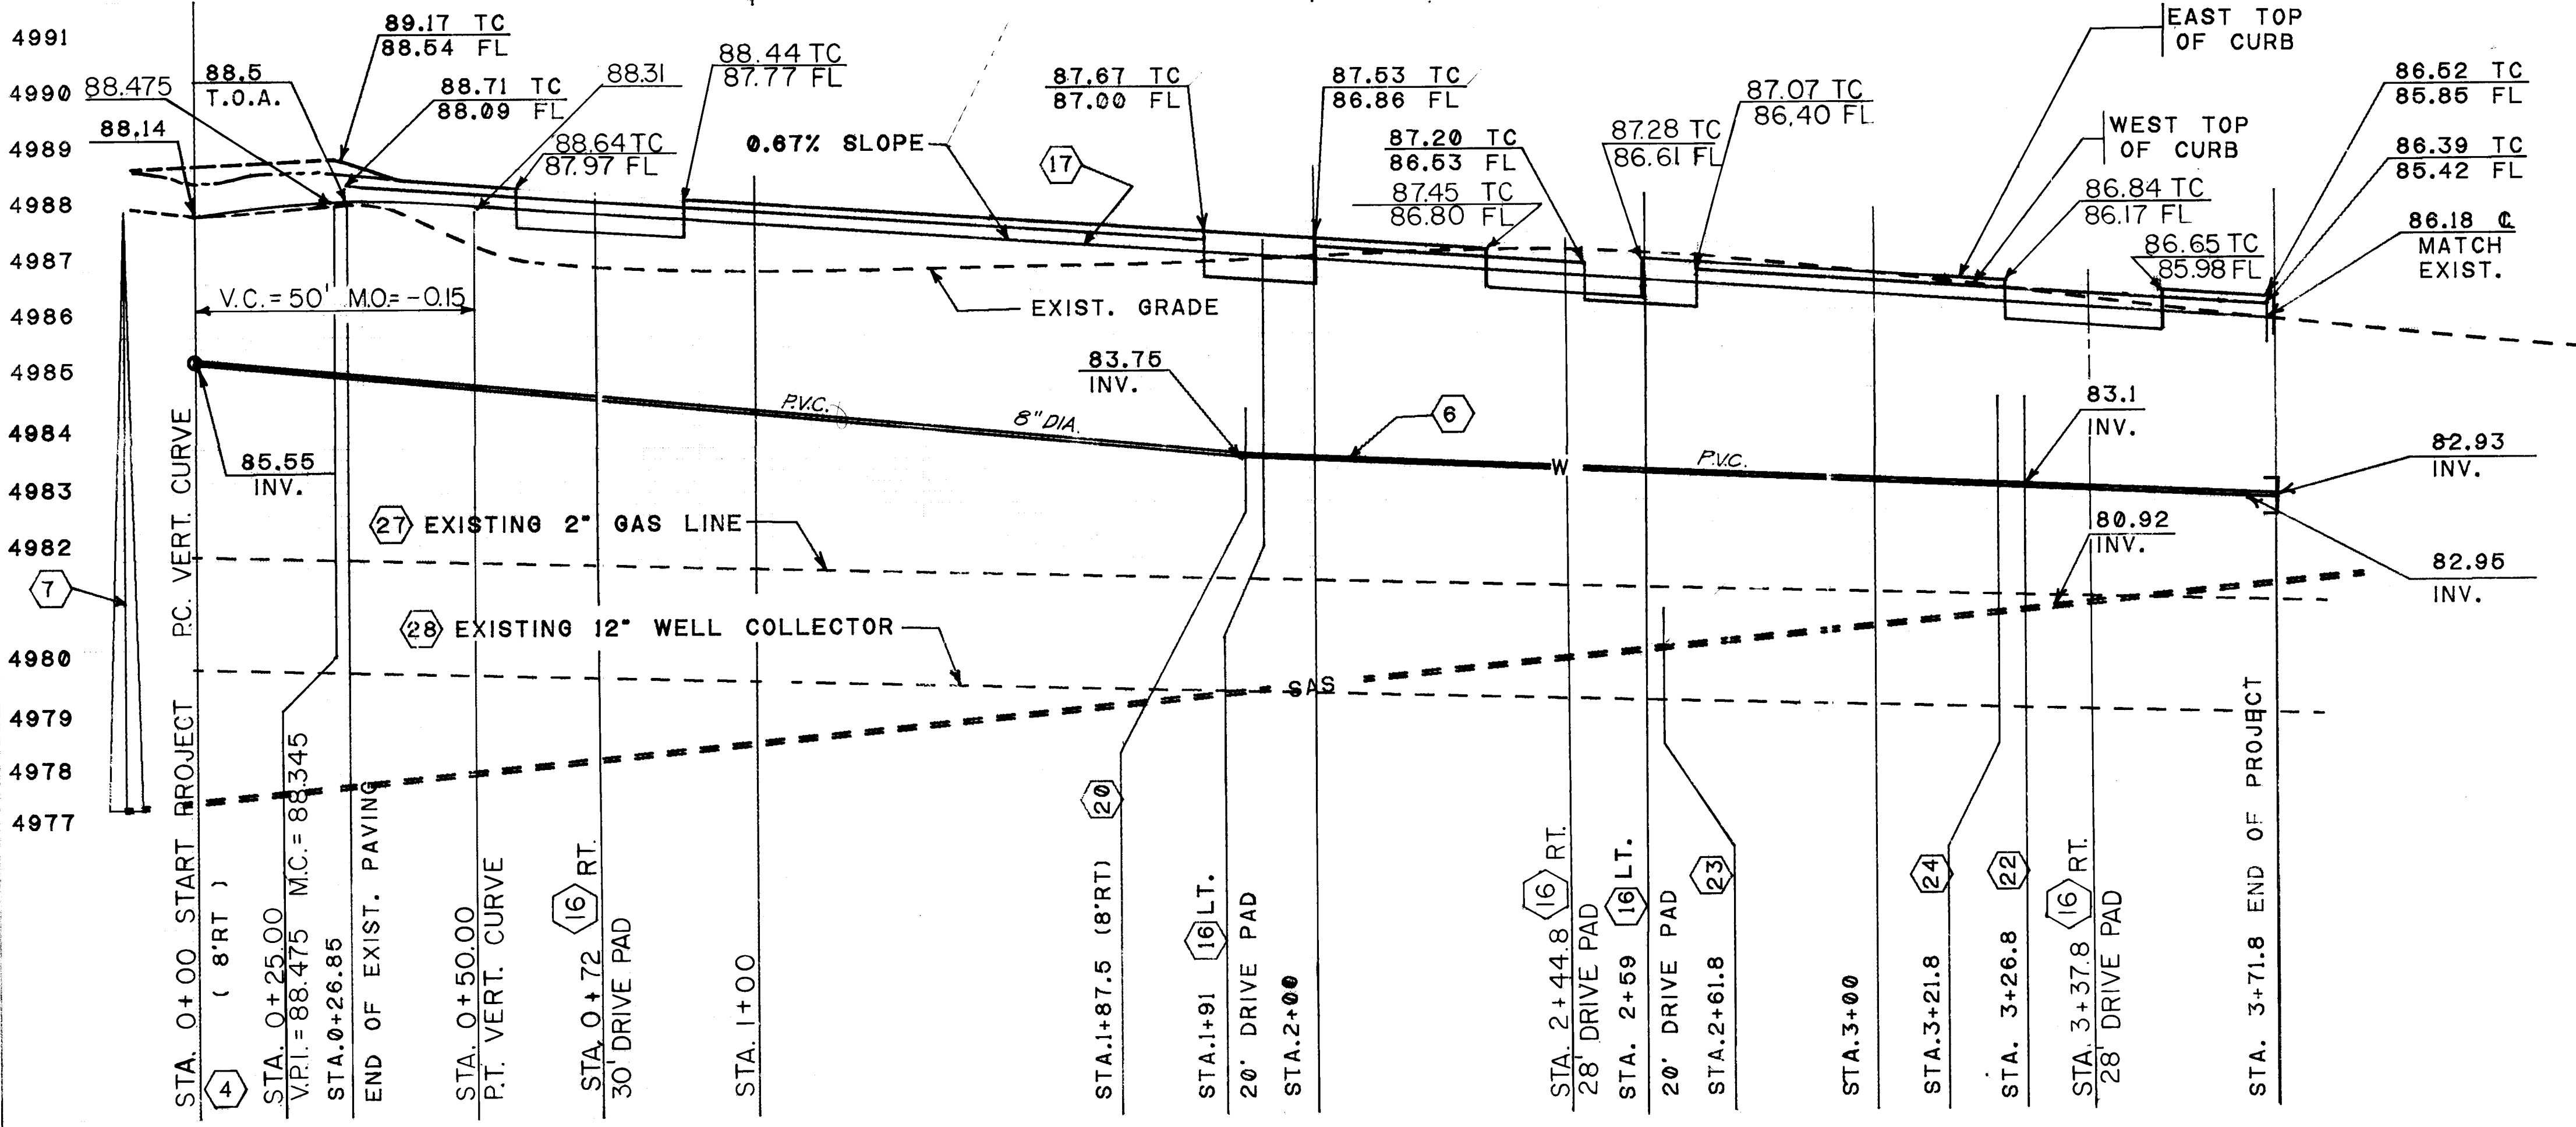

Shelton & Sons
222-1111