


PEPPERTREE SUBDIVISION

UNIT 2 PHASE II

ALBUQUERQUE, NEW MEXICO

INDEX TO DRAWINGS


SHEET NO.	DESCRIPTION
I	TITLE, INDEX TO DRAWINGS AND GENERAL NOTES
2-3	PLAT OF GEOMETRY
4	GRADING PLAN
5	EROSION CONTROL
6	PAVING COMPOSITE
7-10	PAVING PLAN AND PROFILE
11	UTILITY COMPOSITE
12-15	UTILITY PLAN AND PROFILE

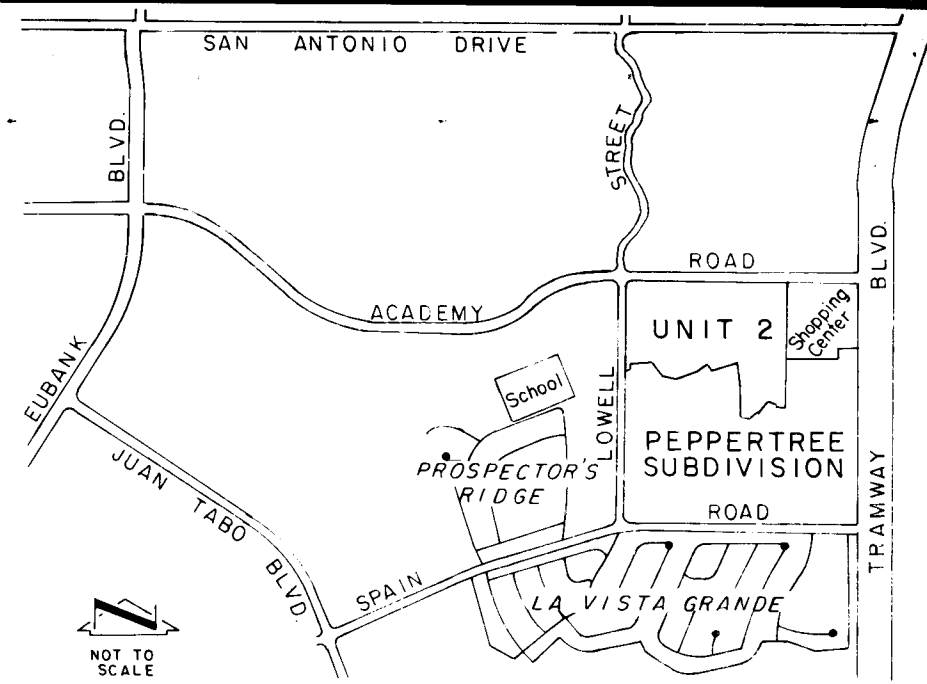

VICINITY MAP


GENERAL NOTES


1. ALL WORK DETAILED ON THESE PLANS TO BE PERFORMED UNDER CONTRACT SHALL, EXCEPT AS OTHERWISE STATED OR PROVIDED FOR HEREON, BE CONSTRUCTED IN ACCORDANCE WITH THE CITY OF ALBUQUERQUE STANDARD SPECIFICATIONS FOR PUBLIC WORKS CONSTRUCTION 1986.
2. TWO (2) WORKING DAYS PRIOR TO ANY EXCAVATION, CONTRACTOR MUST CONTACT LINE LOCATING SERVICE, 765-1234, FOR LOCATION OF EXISTING UTILITIES.
3. PRIOR TO CONSTRUCTION, THE CONTRACTOR SHALL EXCAVATE AND VERIFY THE HORIZONTAL AND VERTICAL LOCATIONS OF ALL OBSTRUCTIONS. SHOULD A CONFLICT EXIST, THE CONTRACTOR SHALL NOTIFY THE ENGINEER OR SURVEYOR SO THAT THE CONFLICT CAN BE RESOLVED WITH MINIMUM AMOUNT OF DELAY.
4. ALL UTILITIES AND UTILITY SERVICE LINES SHALL BE INSTALLED PRIOR TO PAVING.
5. BACKFILL COMPACTION SHALL BE ACCORDING TO SPECIFIED STREET USE.
6. JACK COAT REQUIREMENTS SHALL BE DETERMINED BY THE CITY ENGINEER.
7. SIDEWALKS AND WHEELCHAIR RAMPS WITHIN THE CURB RETURNS SHALL BE CONSTRUCTED WHEREVER A NEW CURB RETURN IS CONSTRUCTED.
8. IF CURB IS DEPRESSED FOR A DRIVEPAD OR A HANDICAP RAMP, THE DRIVEPAD OR RAMP SHALL BE CONSTRUCTED PRIOR TO ACCEPTANCE OF THE CURB AND GUTTER.
9. ALL STORM DRAINAGE FACILITIES SHALL BE COMPLETED PRIOR TO FINAL ACCEPTANCE.

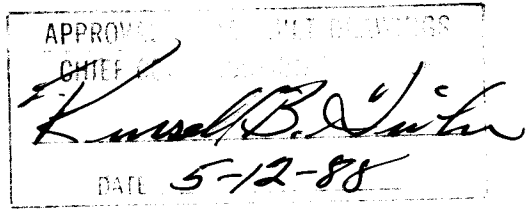

26 32640188

REV.	SHEETS	CITY	ENGR.	DATE	USER	DEPT.	DATE	USER	DEPT.	DATE
APPROVAL OF REVISIONS										
						0 SCANLON ASSOCIATES		APPROVED FOR CONSTRUCTION CITY ENGINEER 9/11/87		
						3264		SHEET 1 OF 15		

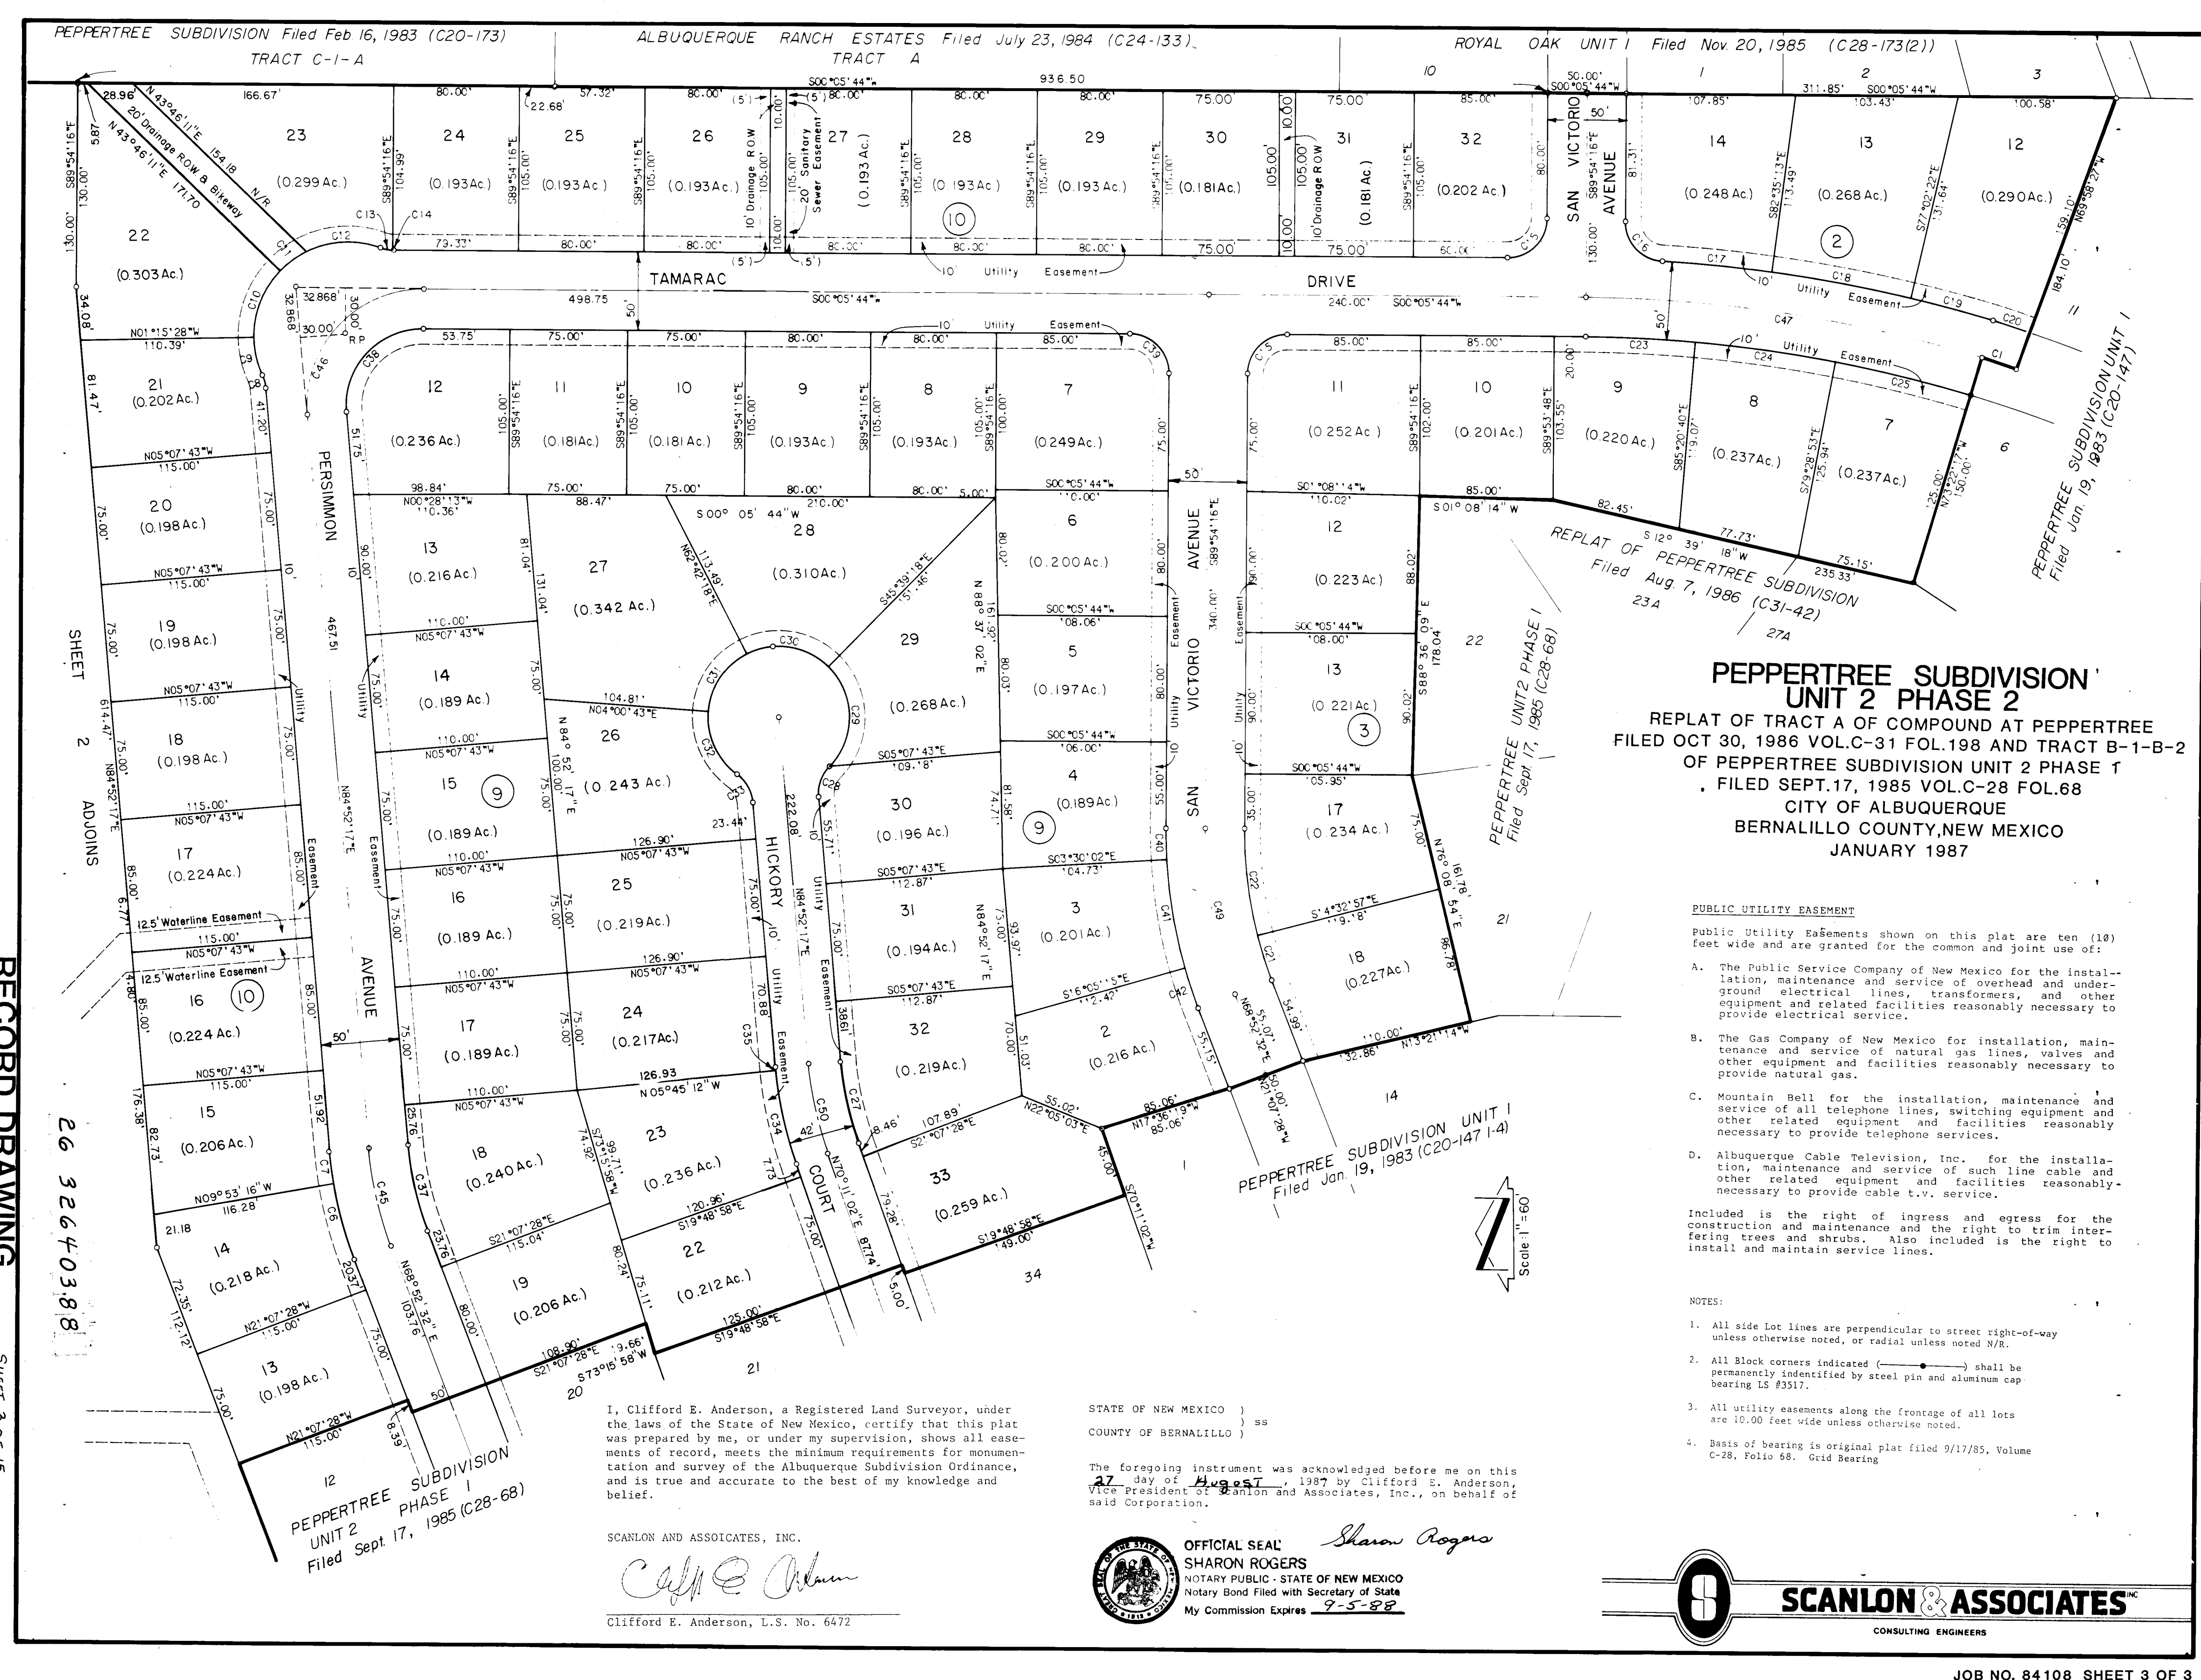

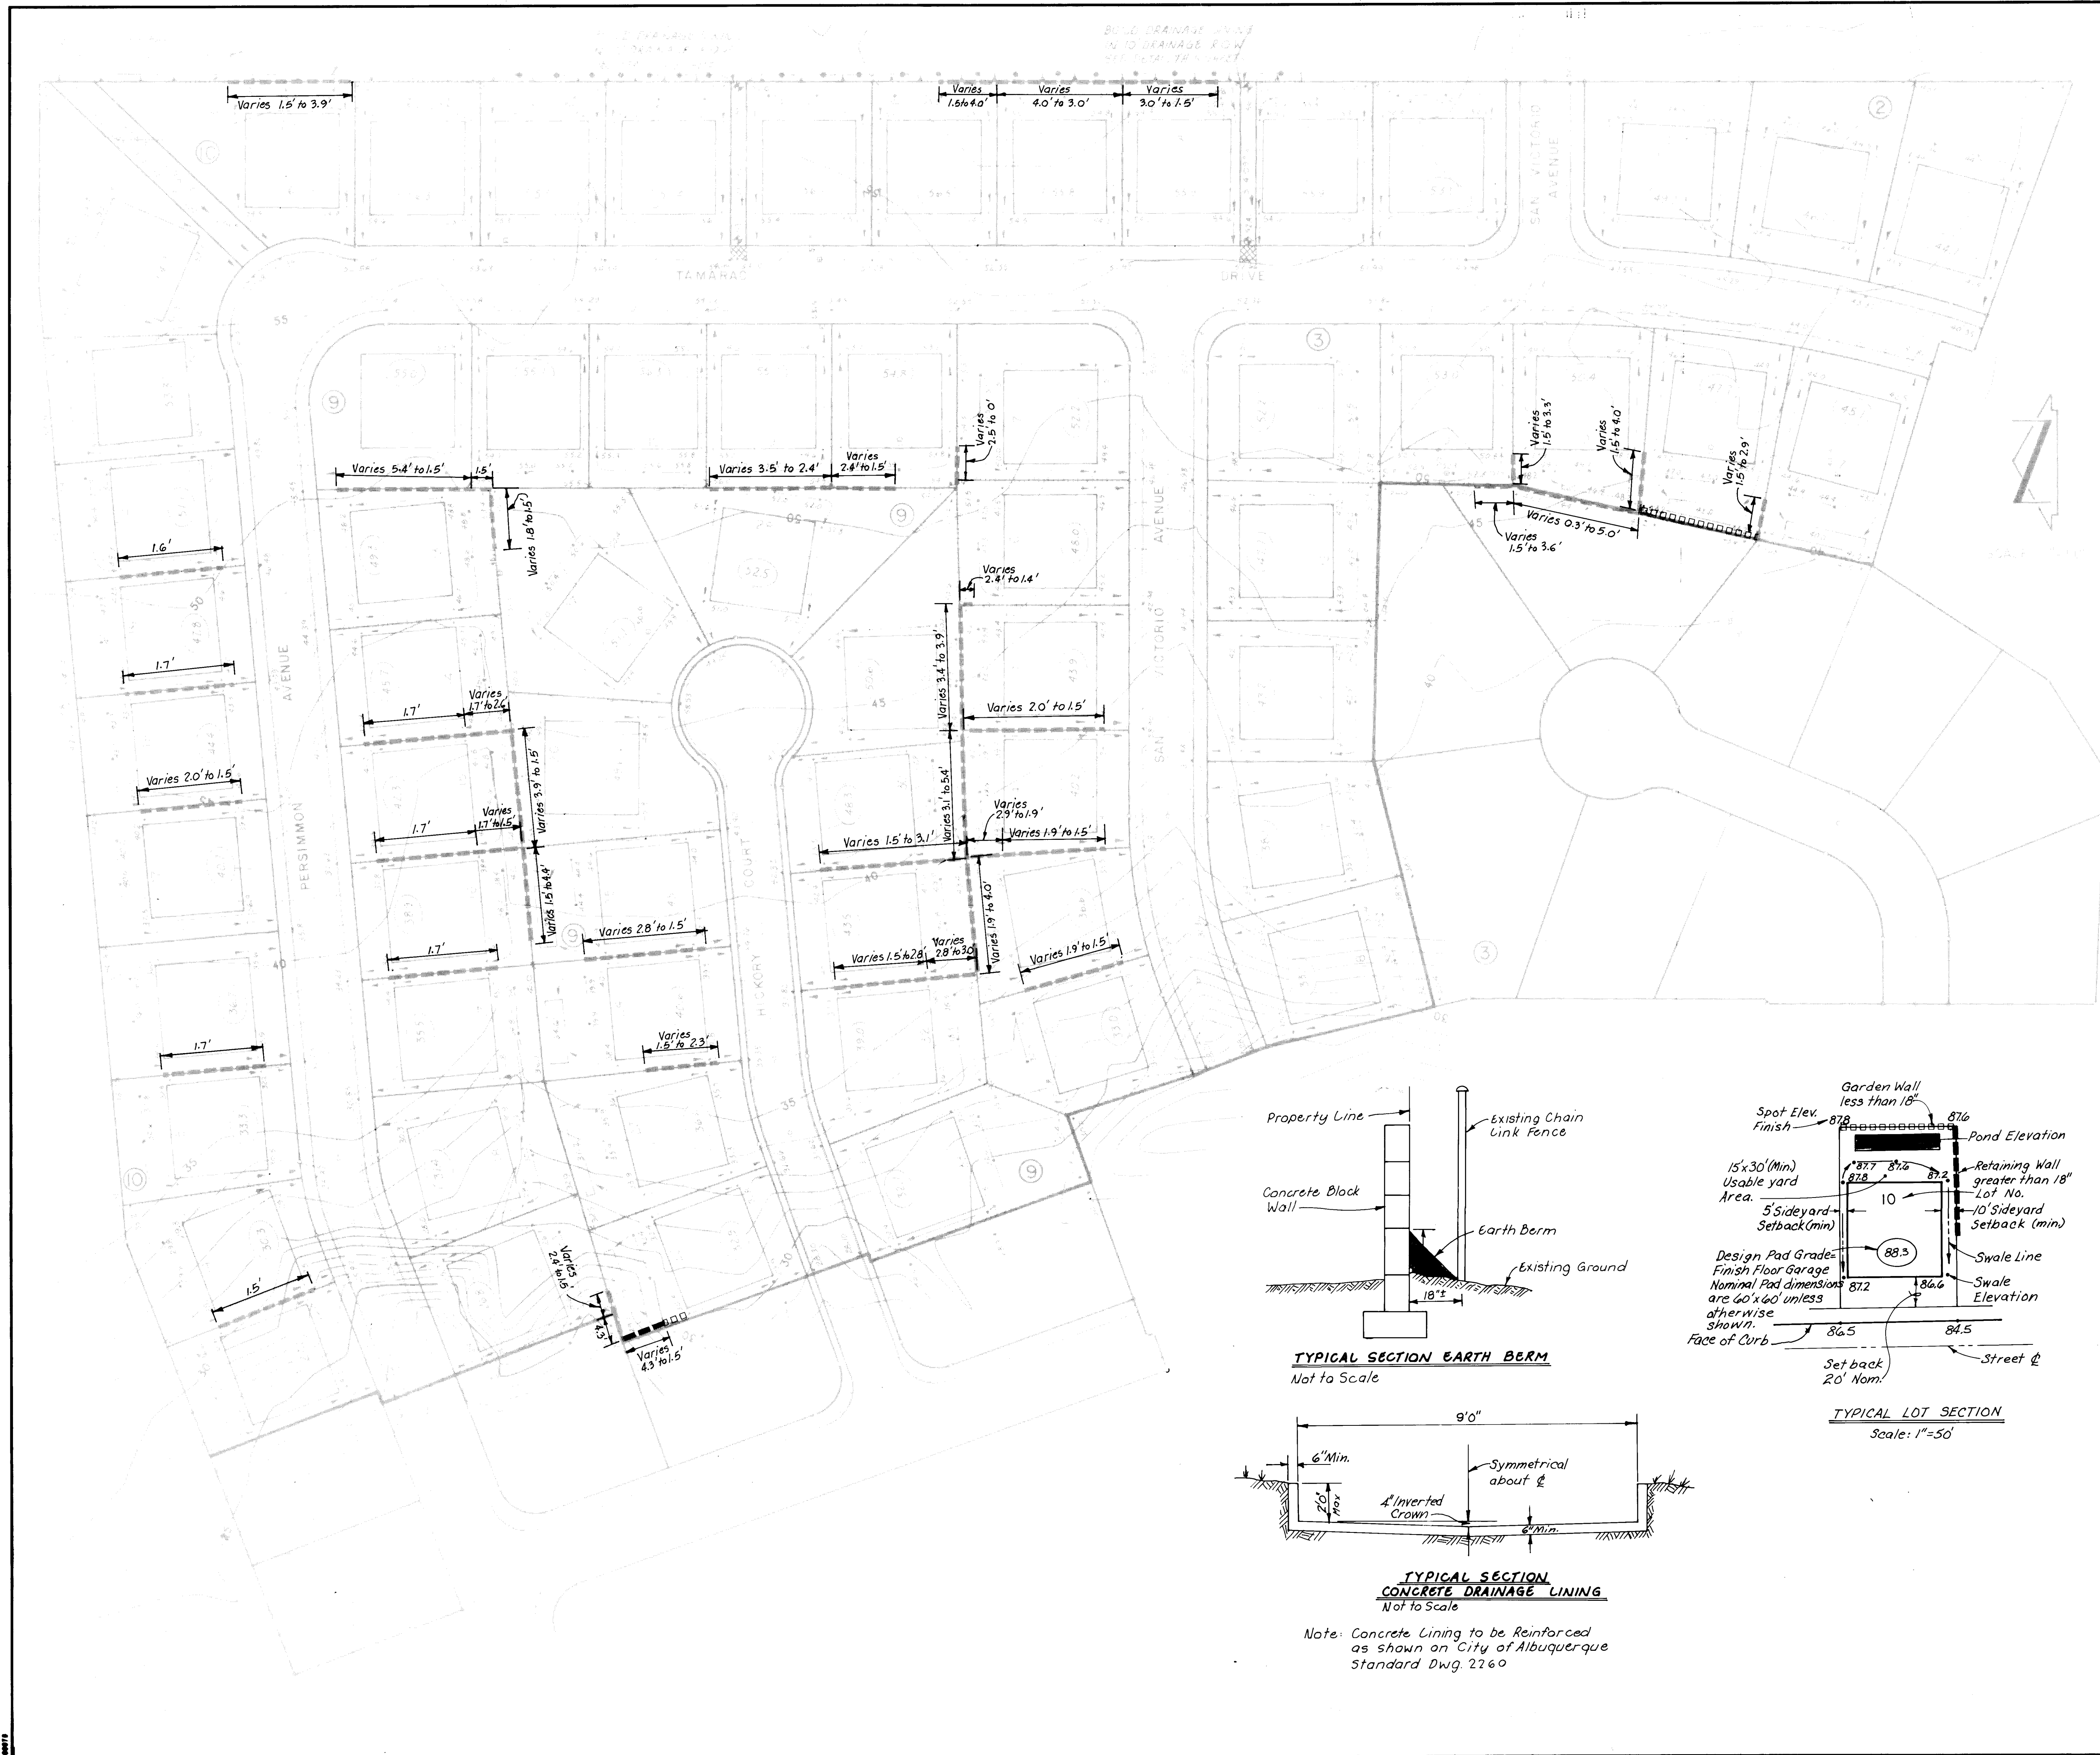

AS BUILT INFORMATION			
CONTRACTOR	INTERMOUNT	DATE	6/6/97
DESIGNED BY	WILLIAM E. D. TAYLOR	DATE	6/6/97
ENGINEER	WILLIAM E. D. TAYLOR	DATE	6/6/97
REVISIONS	DATE		
NO.	DATE	BY	REMARKS
1	6/6/97	WET	DESIGN
2	7/16/97	WET	DESIGN
3	7/16/97	WET	DESIGN
26 32640488A

PEPPERTREE UNIT 2 PHASE 2

CITY OF ALBUQUERQUE
MUNICIPAL DEVELOPMENT DEPARTMENT
ENGINEERING DIVISION


TITLE:
RETAINING WALL HEIGHTS

APPROVALS	ENGINEER	DATE	APPROVALS	ENGINEER	DATE
City Engineer	WET	7/16/97	Liquid Waste	WET	7/16/97
A.C.E. Design	WET	7/16/97	Traffic	WET	7/16/97
A.C.E. Hydrology	WET	7/16/97	Water	WET	7/16/97

DRAWING NO. MAP NO. E-22 SHEET 4A OF 15

SCANLON & ASSOCIATES JOB NO. 87101

RECORD DRAWING

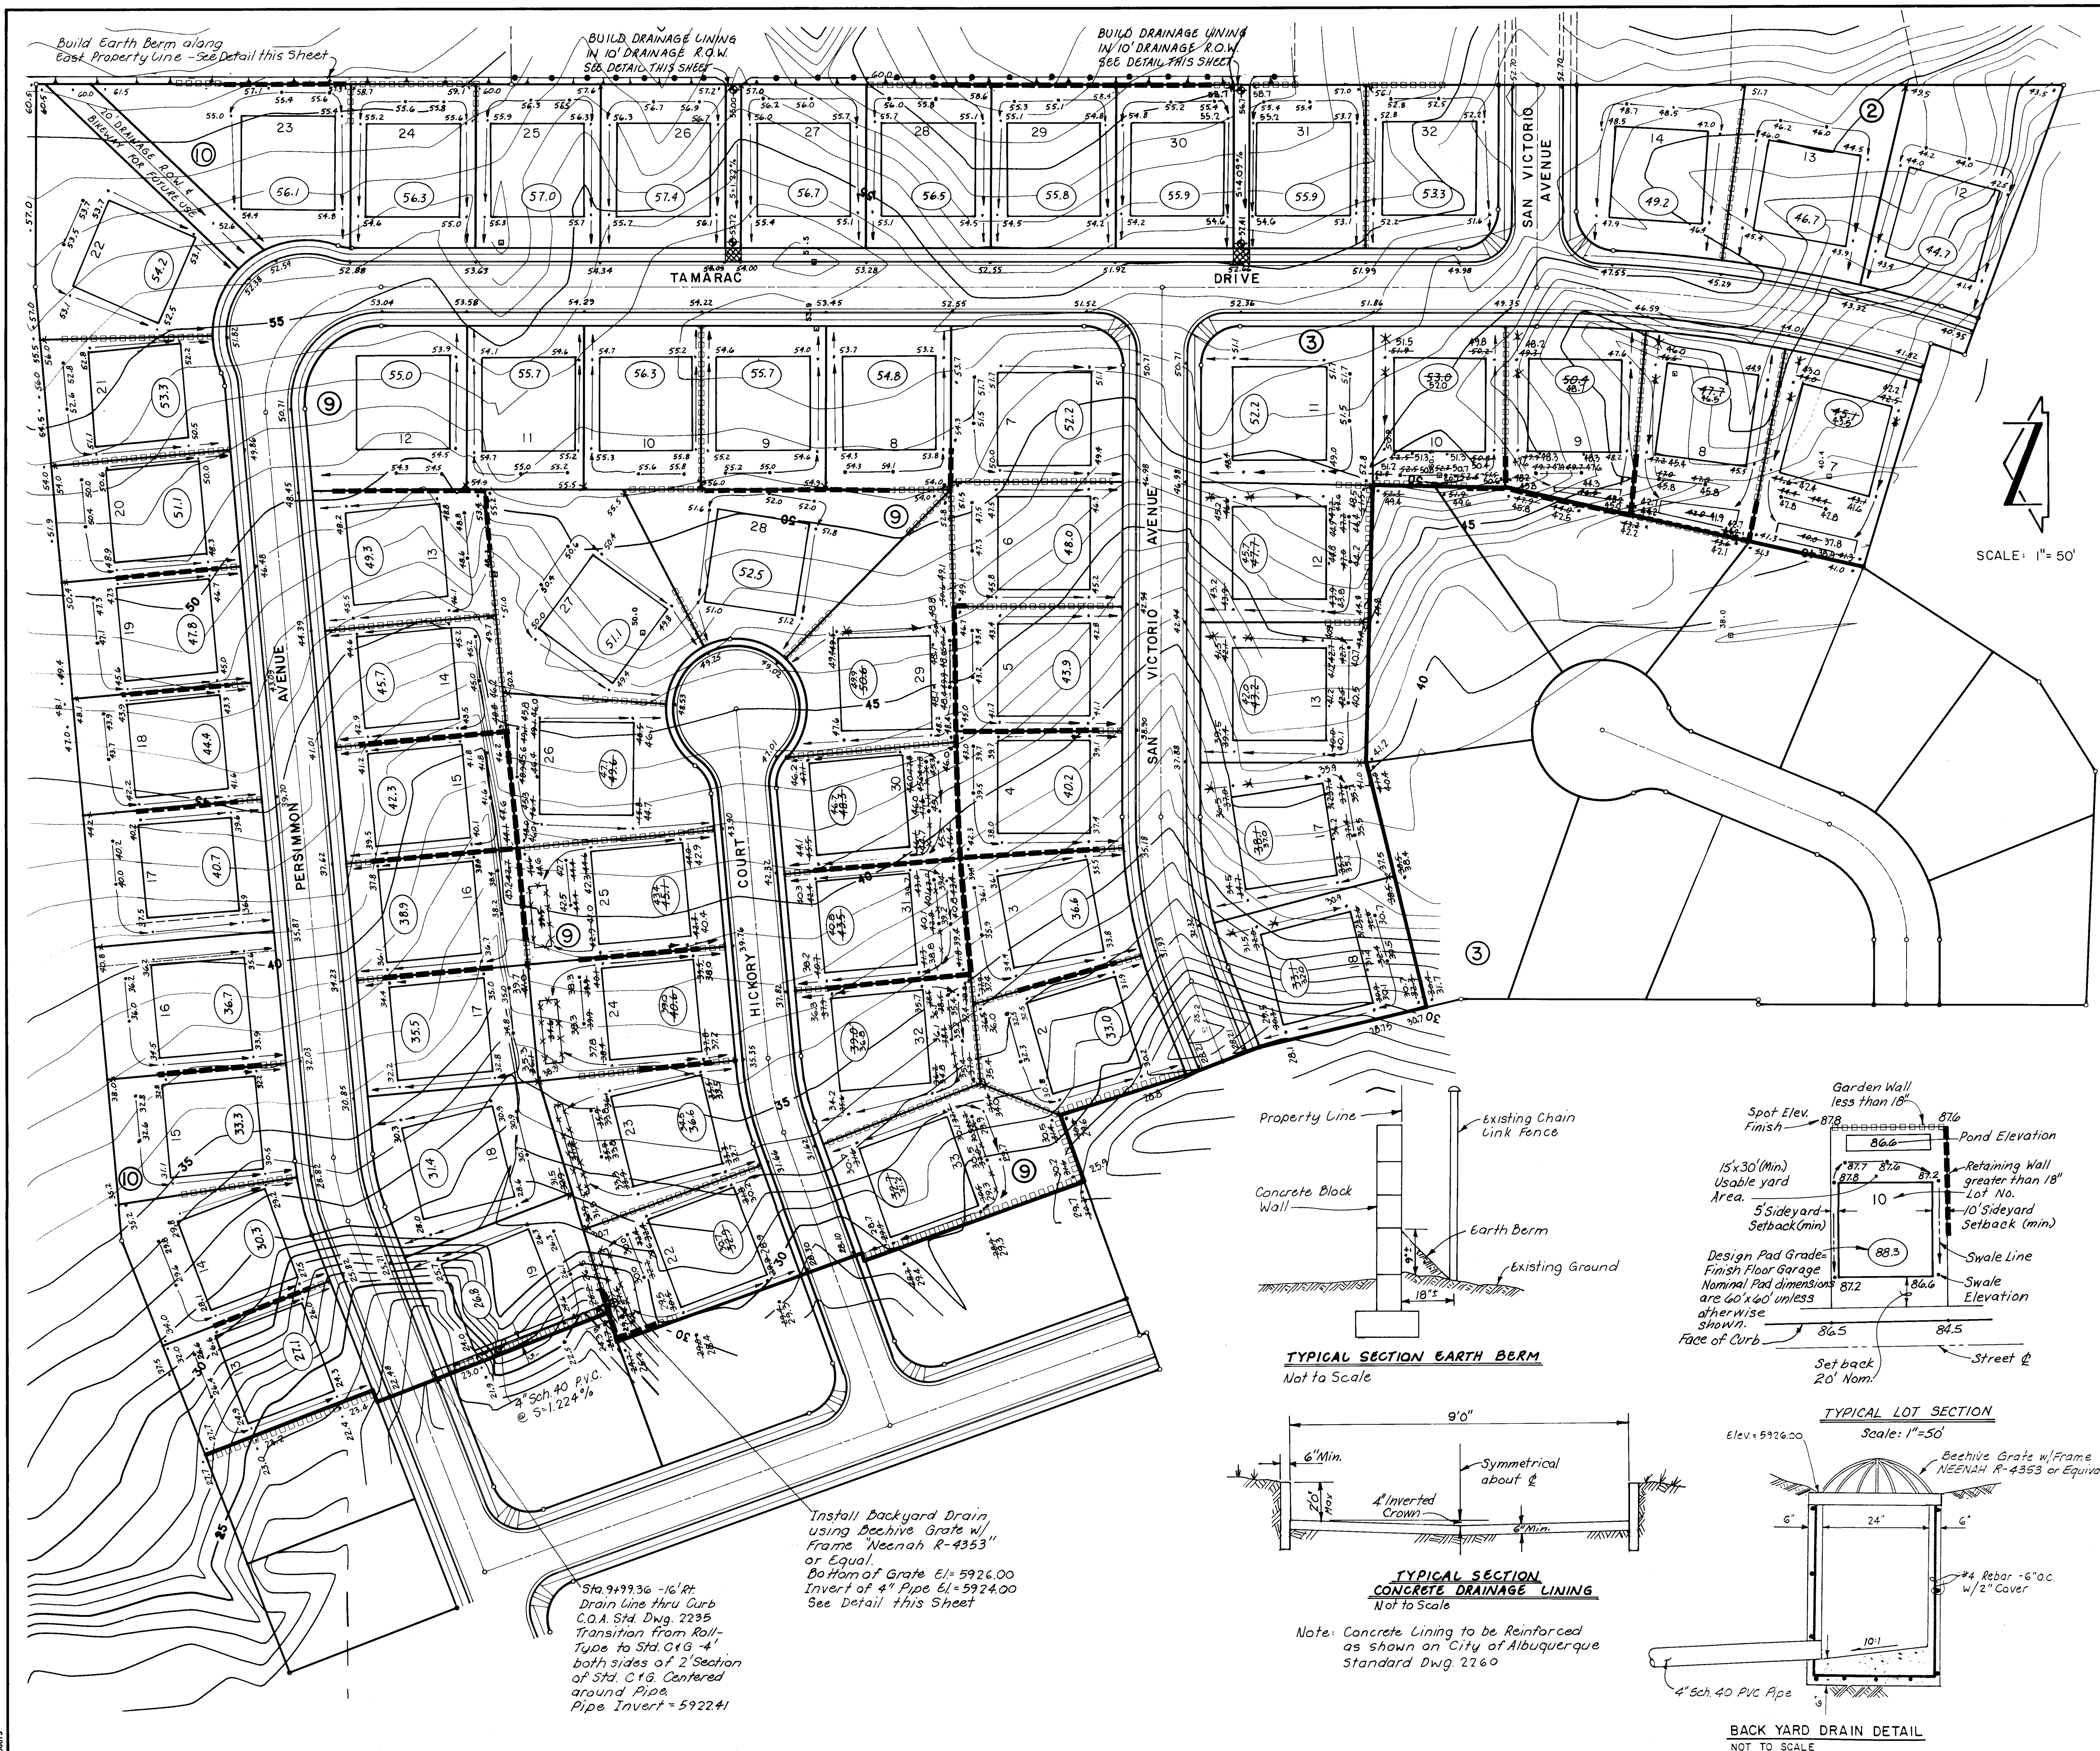


T.B.M. - ■ in top of curb
located on west side of
Teakwood Trail at the south
P.C., next to Lot 29 Block 1
of Peppertree Subdivision
Unit One. Elev = 5937.170

Min Backyard Pond Volumes:


Block	Lot	Vol. (cu. ft.)	Depth (ft.)
3	7	622	0.89
3	8	613	0.91
3	9	566	1.31
9	22	594	1.08
9	23	638	1.17
9	24	623	1.08
9	25	627	1.09

Site grading shall conform to section 210 of "City of Albuquerque Standard Specifications for Public Works Construction" 1986.

SCALE: 1" = 50'

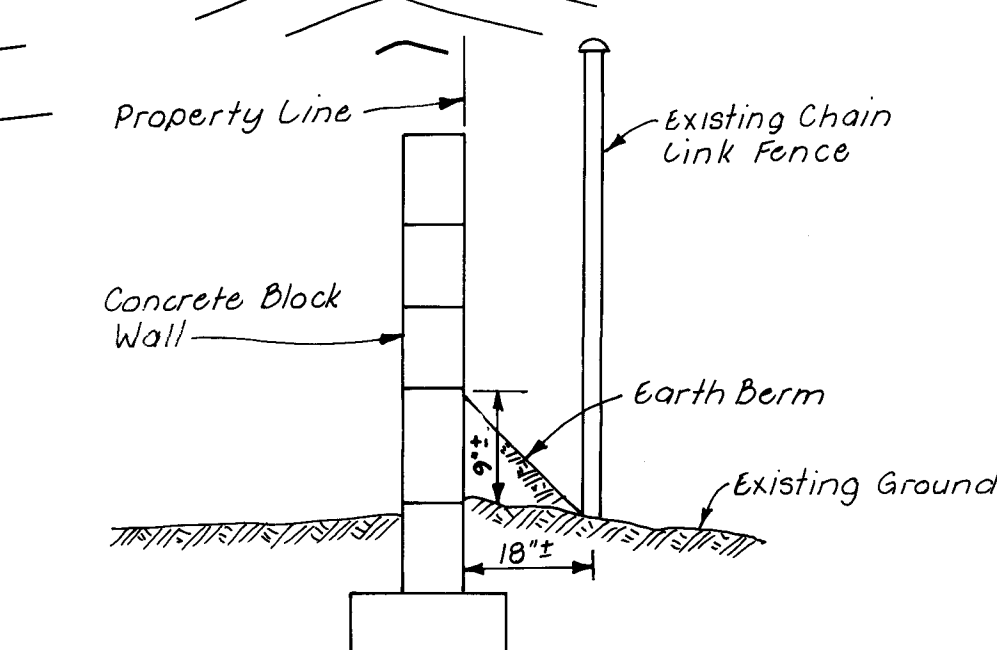


TYPICAL SECTION EARTH BERM
Not to Scale

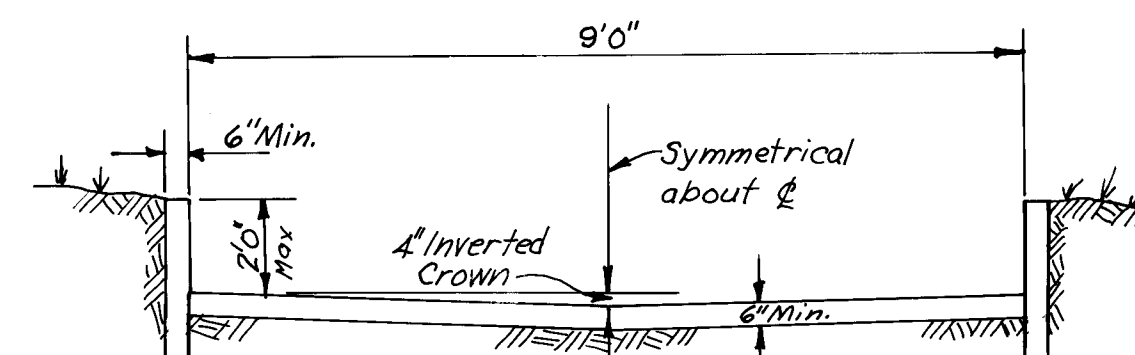


TYPICAL SECTION
CONCRETE DRAINAGE LINING
Not to Scale

Note: Concrete Lining to be Reinforced
as shown on City of Albuquerque
Standard Dwg. 2260

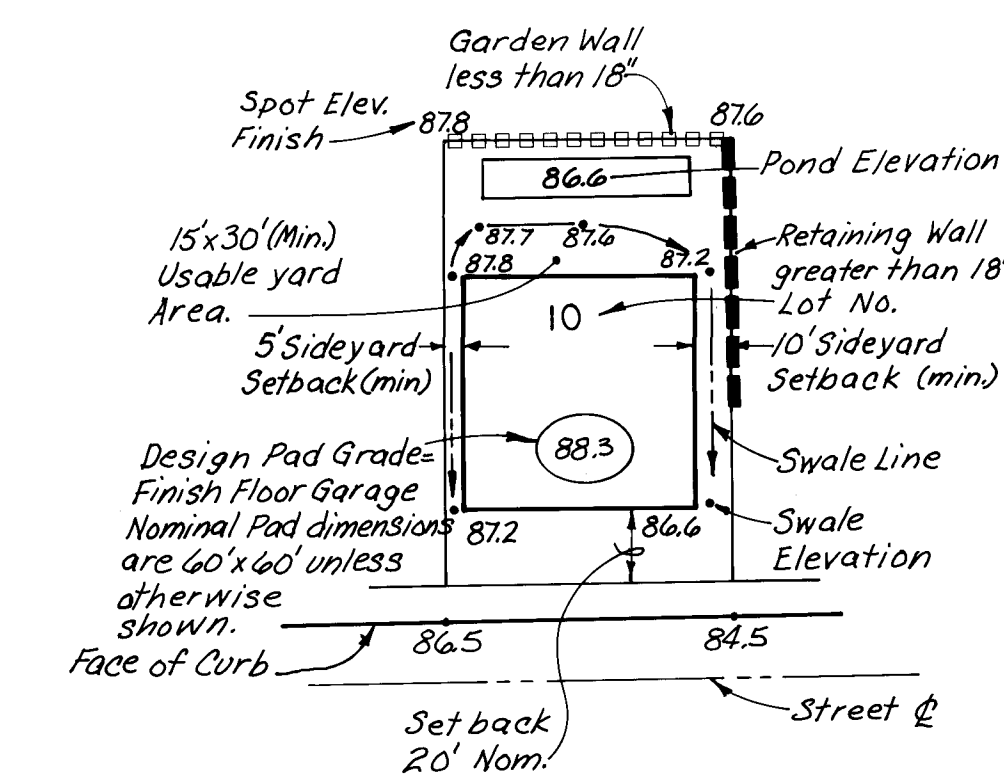

TYPICAL LOT SECTION

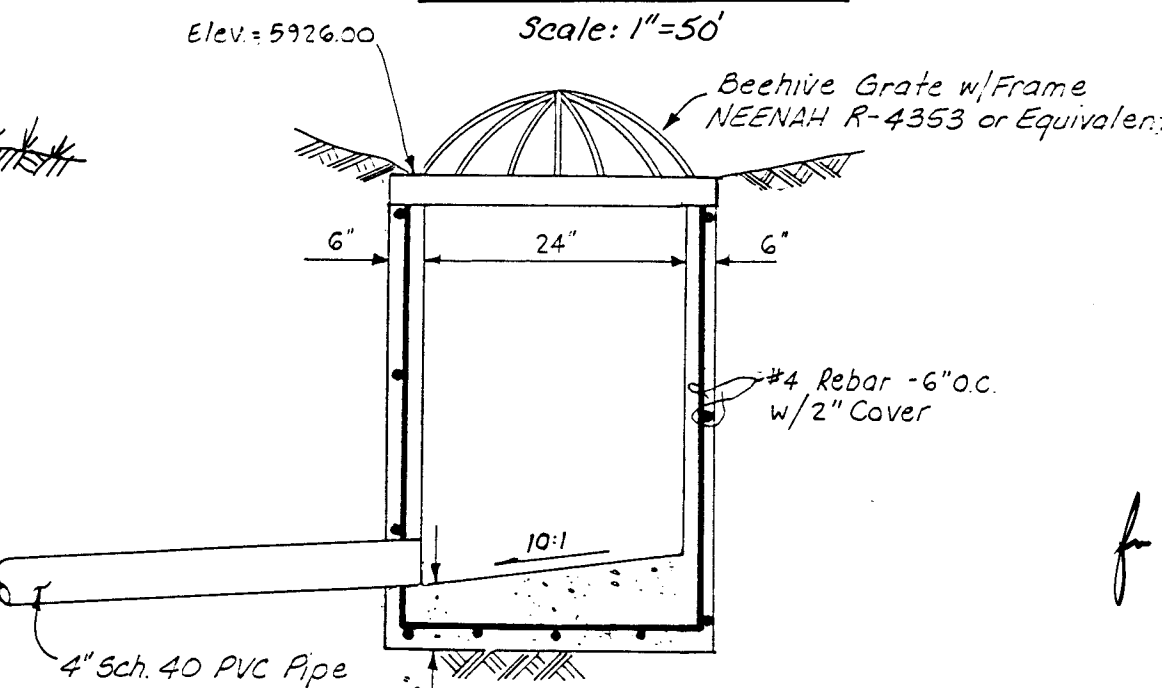

BACK YARD DRAIN DETAIL
NOT TO SCALE

[illegible]

26 32640488

PEPPERTREE UNIT 2 PHASE 2

CITY OF ALBUQUERQUE
MUNICIPAL DEVELOPMENT DEPARTMENT
ENGINEERING DIVISION

TITLE: GRADING PLAN


APPROVALS	ENGINEER	DATE	APPROVALS	ENGINEER	DATE
City Engineer	<i>[Signature]</i>	9/7/87	Liquid Waste	<i>[Signature]</i>	9/4/87
A.C.E. Design	" "	"	Traffic	<i>[Signature]</i>	9/4/87
A.C. E.-Hydrology	CAM	9-4-87	Water	<i>[Signature]</i>	9/4/87

DRAWING NO.	MAP NO. E-22	SHEET 4	OF 15
----------------	-----------------	------------	----------

SCANLON & ASSOCIATES

JOB NO. 87101




RECORD DRAWING

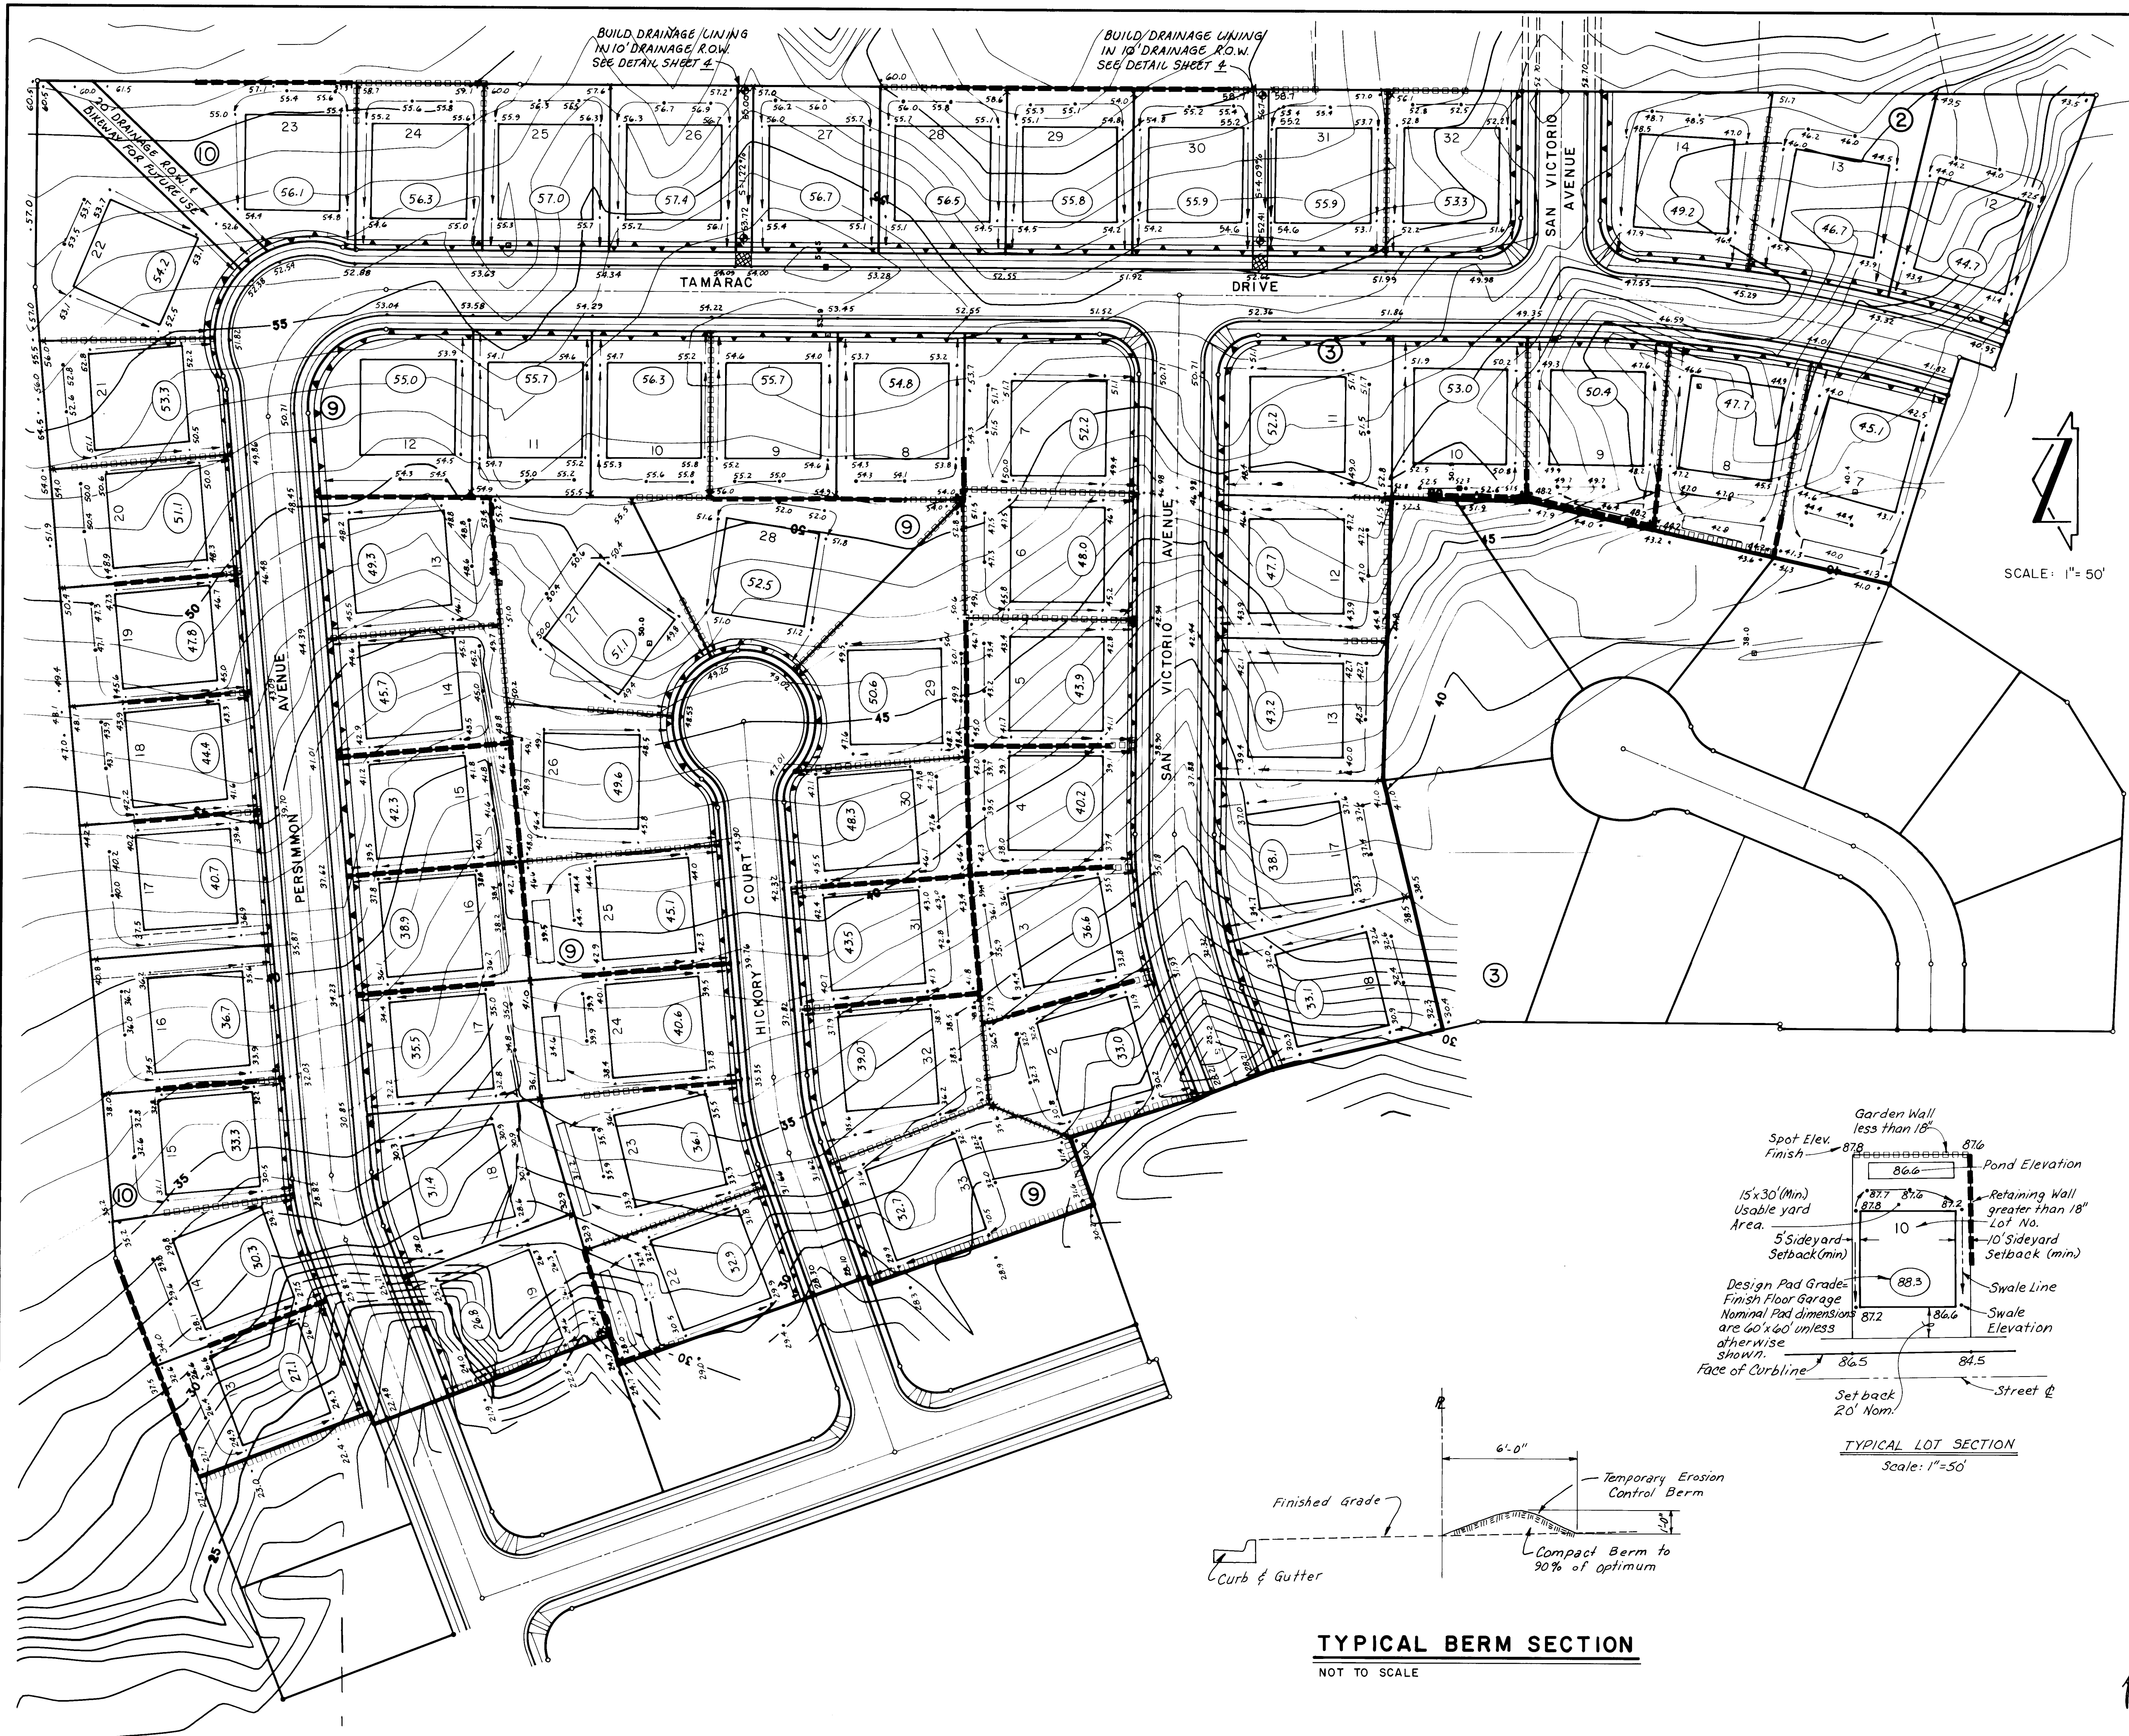

NOTE:
THE CONTRACTOR SHALL OBTAIN
A TOPSOIL DISTURBANCE PERMIT
PRIOR TO GRADING OPERATIONS.

APPROVALS		ENGINEER		DATE	
Waste					7/14/87
Office					7/16/87
Water					7/16/87
SHEET		5		OF	
2		5		15	

PROJECT		DEPARTMENT		DIVISION	
NO.	DATE	REMARKS	BY	DESIGNED BY	DATE
				JKZ	MARCH 1987
		REVISIONS		SLL	APRIL 1987
		DESIGN			DATE
					DATE
ENGINEER'S SEAL					
SURVEY INFORMATION		FIELD NOTES NO. BY DATE 12 MILES EAST ON ACADEMY, 375' SOUTH OF ACADEMY ON THE SOUTH RIM OF A SHALLOW ARROYO A STANDARD A.C.S. BRASS TABLET STAMPED "8-4972" SET IN THE TOP OF A CONCRETE POST. ELEVATION 5934.53			
BENCH MARKS		A.C.S. BENCH MARK 6-E22 LOCATED FROM THE INTERSECTION OF EUBANK N.E. AND ACADEMY N.E.			
AS BUILT INFORMATION		CONTRACTOR INTERWEST LTD. WORK ORDER NO. 1087 INSPECTED BY E.B. JENSEN DATE 10/87 ACCEPTANCE BY DRAWINGS BY S.C. MCGOWAN DATE 7/88 RECORDED BY NO.			

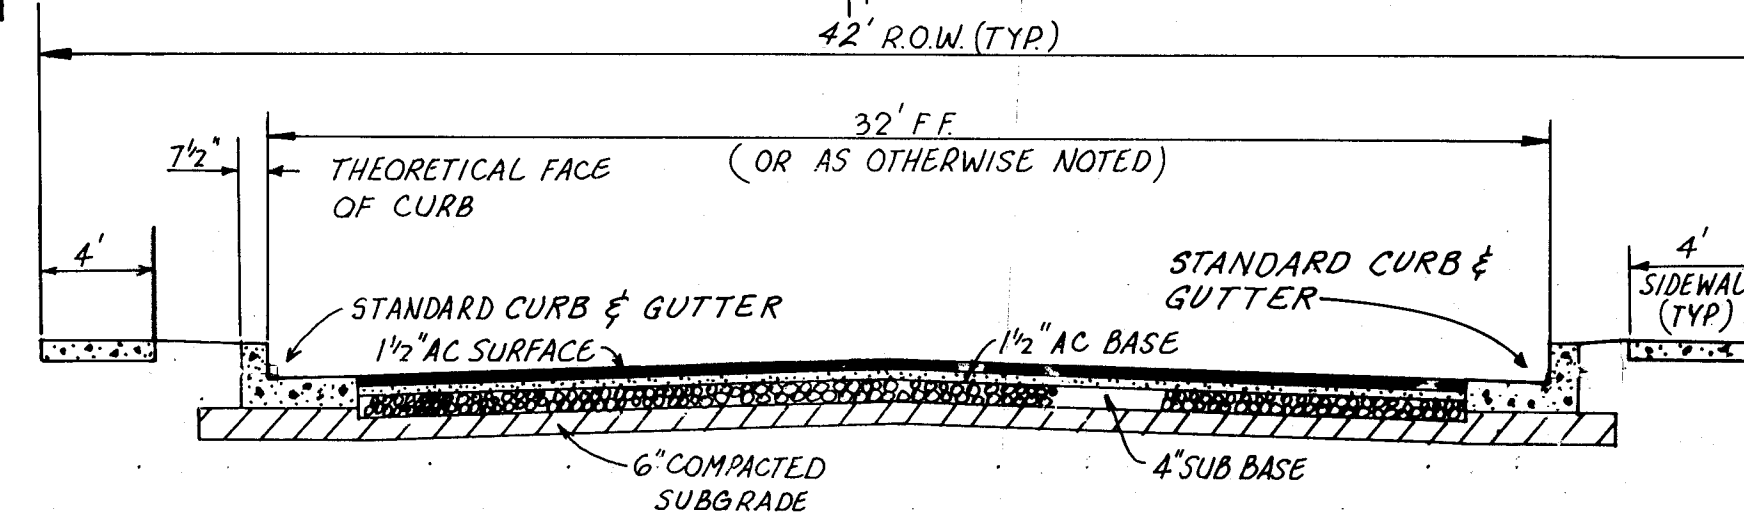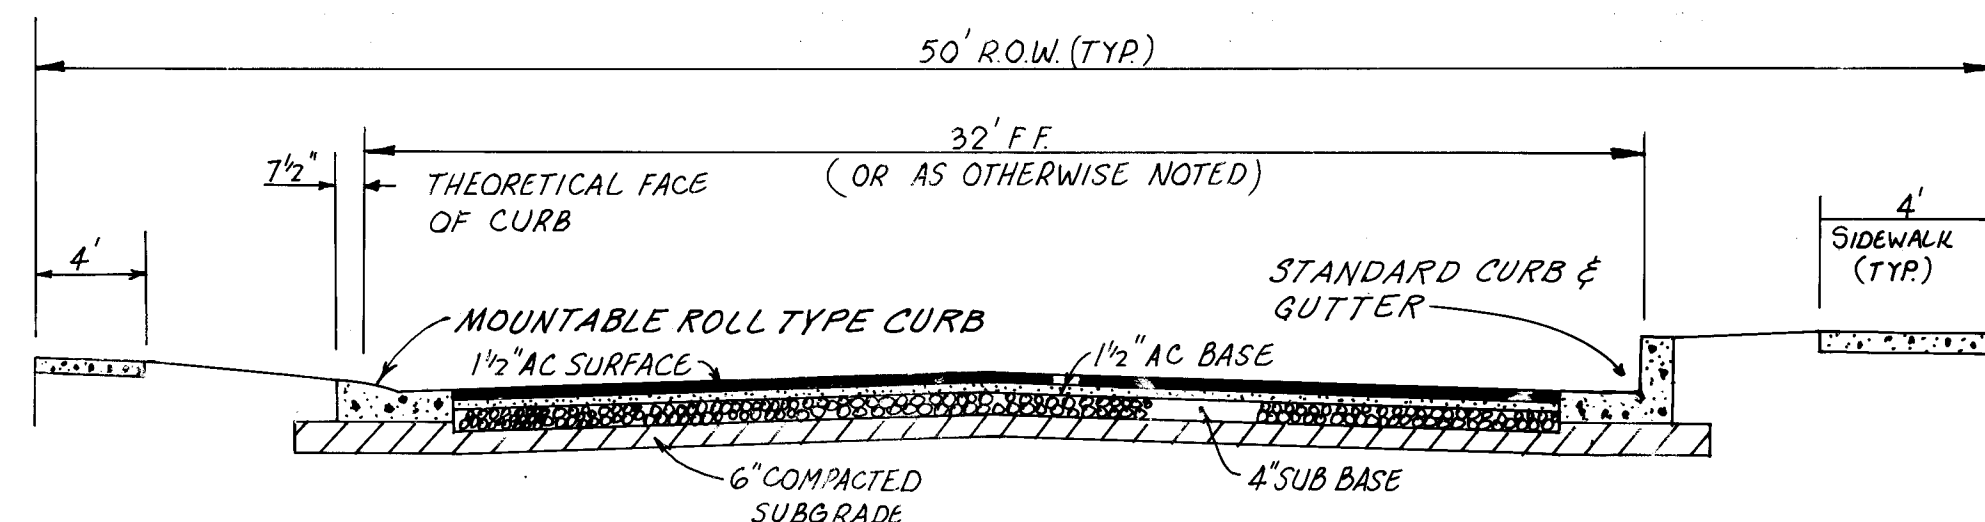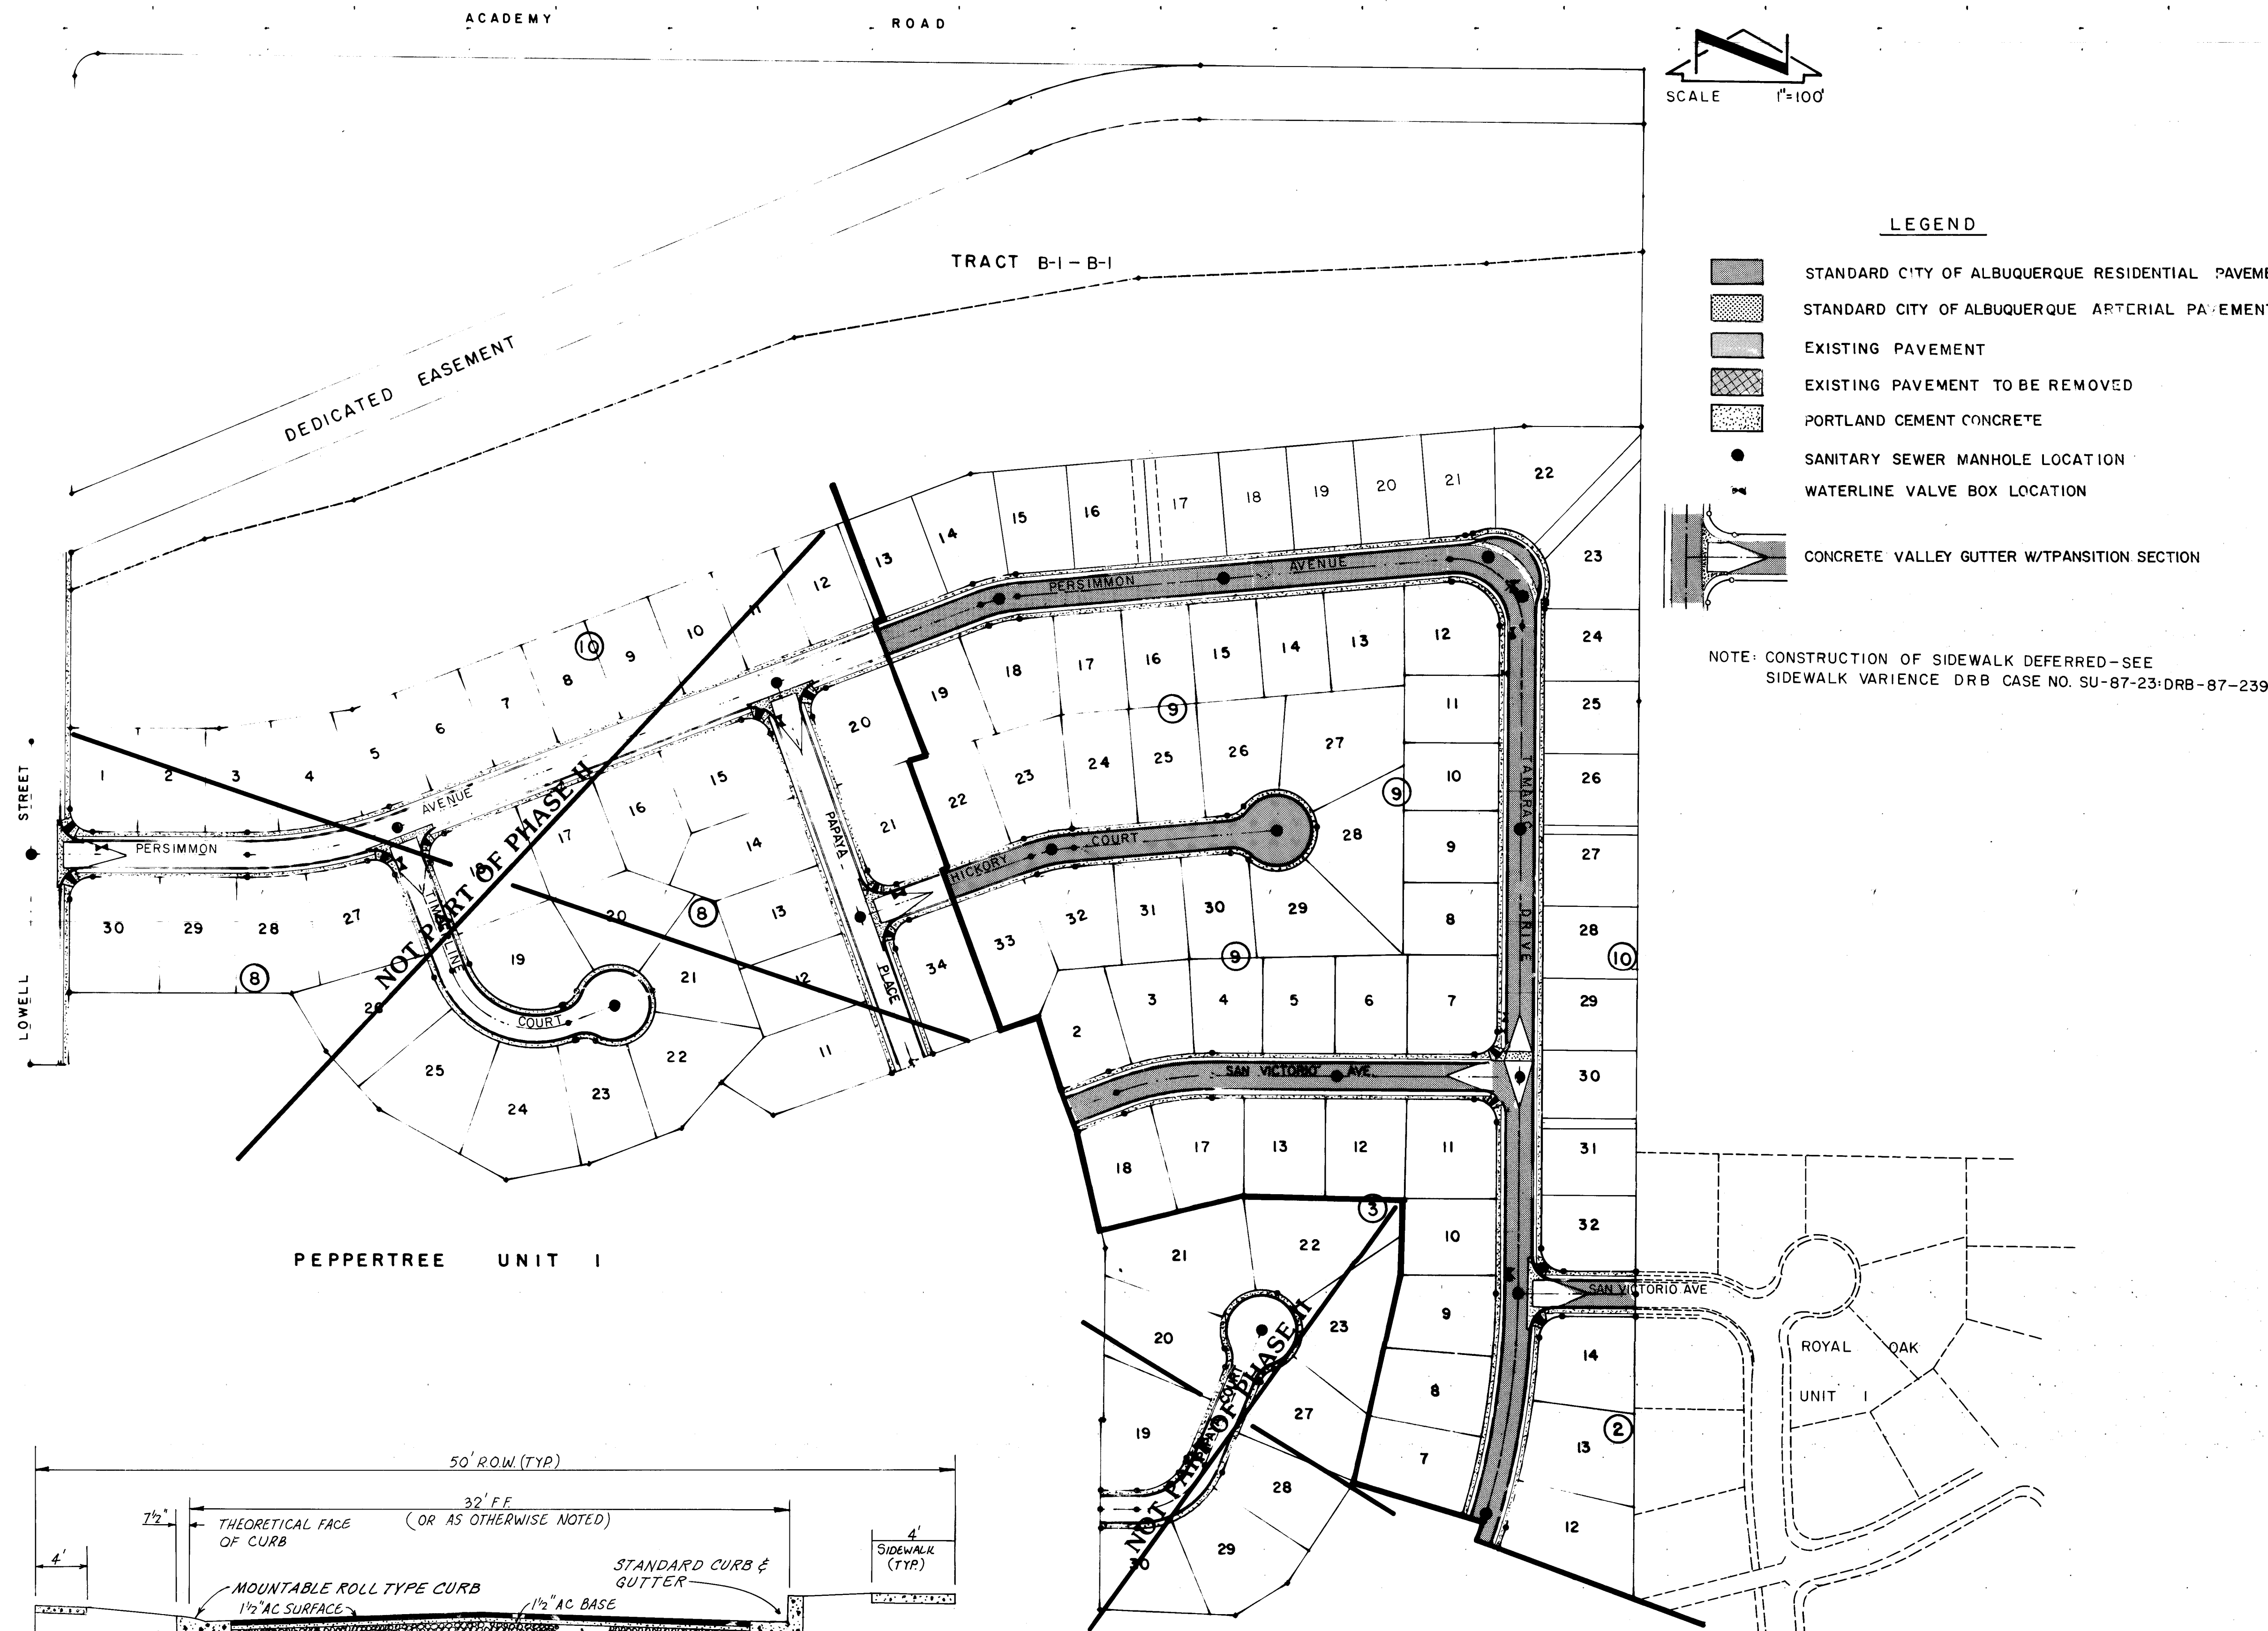


ENGINEER'S SEAL			SURVEY INFORMATION		BENCH MARKS		AS BUILT INFORMATION	
			FIELD NOTES		DATE		CONTRACTOR INTERVIEW	
			NO.	BY	DATE	BY	DATE	BY
			REVISIONS		DATE		DATE	
			NO.	DATE	REMARKS	NO.	DATE	REMARKS
			DESIGNED BY		DATE		DATE	
			DRAWN BY		DATE		DATE	
			CHECKED BY		DATE		DATE	

26 32640688

PEPPERTREE UNIT 2 PHASE 2


CITY OF ALBUQUERQUE MUNICIPAL DEVELOPMENT DEPARTMENT ENGINEERING DIVISION					
TITLE: PAVING COMPOSITE					
APPROVALS	ENGINEER	DATE	APPROVALS	ENGINEER	DATE
City Engineer	<i>[Signature]</i>	2/17/87	Liquid Waste	<i>[Signature]</i>	9/18/87
ACE - Design	<i>[Signature]</i>		Traffic	<i>[Signature]</i>	9/18/87
ACE - Hydrology	CAM	NA E-4-T	Water	<i>[Signature]</i>	9/18/87
DRAWING NO.	3264	MAP NO.	E-22	SHEET	6 OF 15

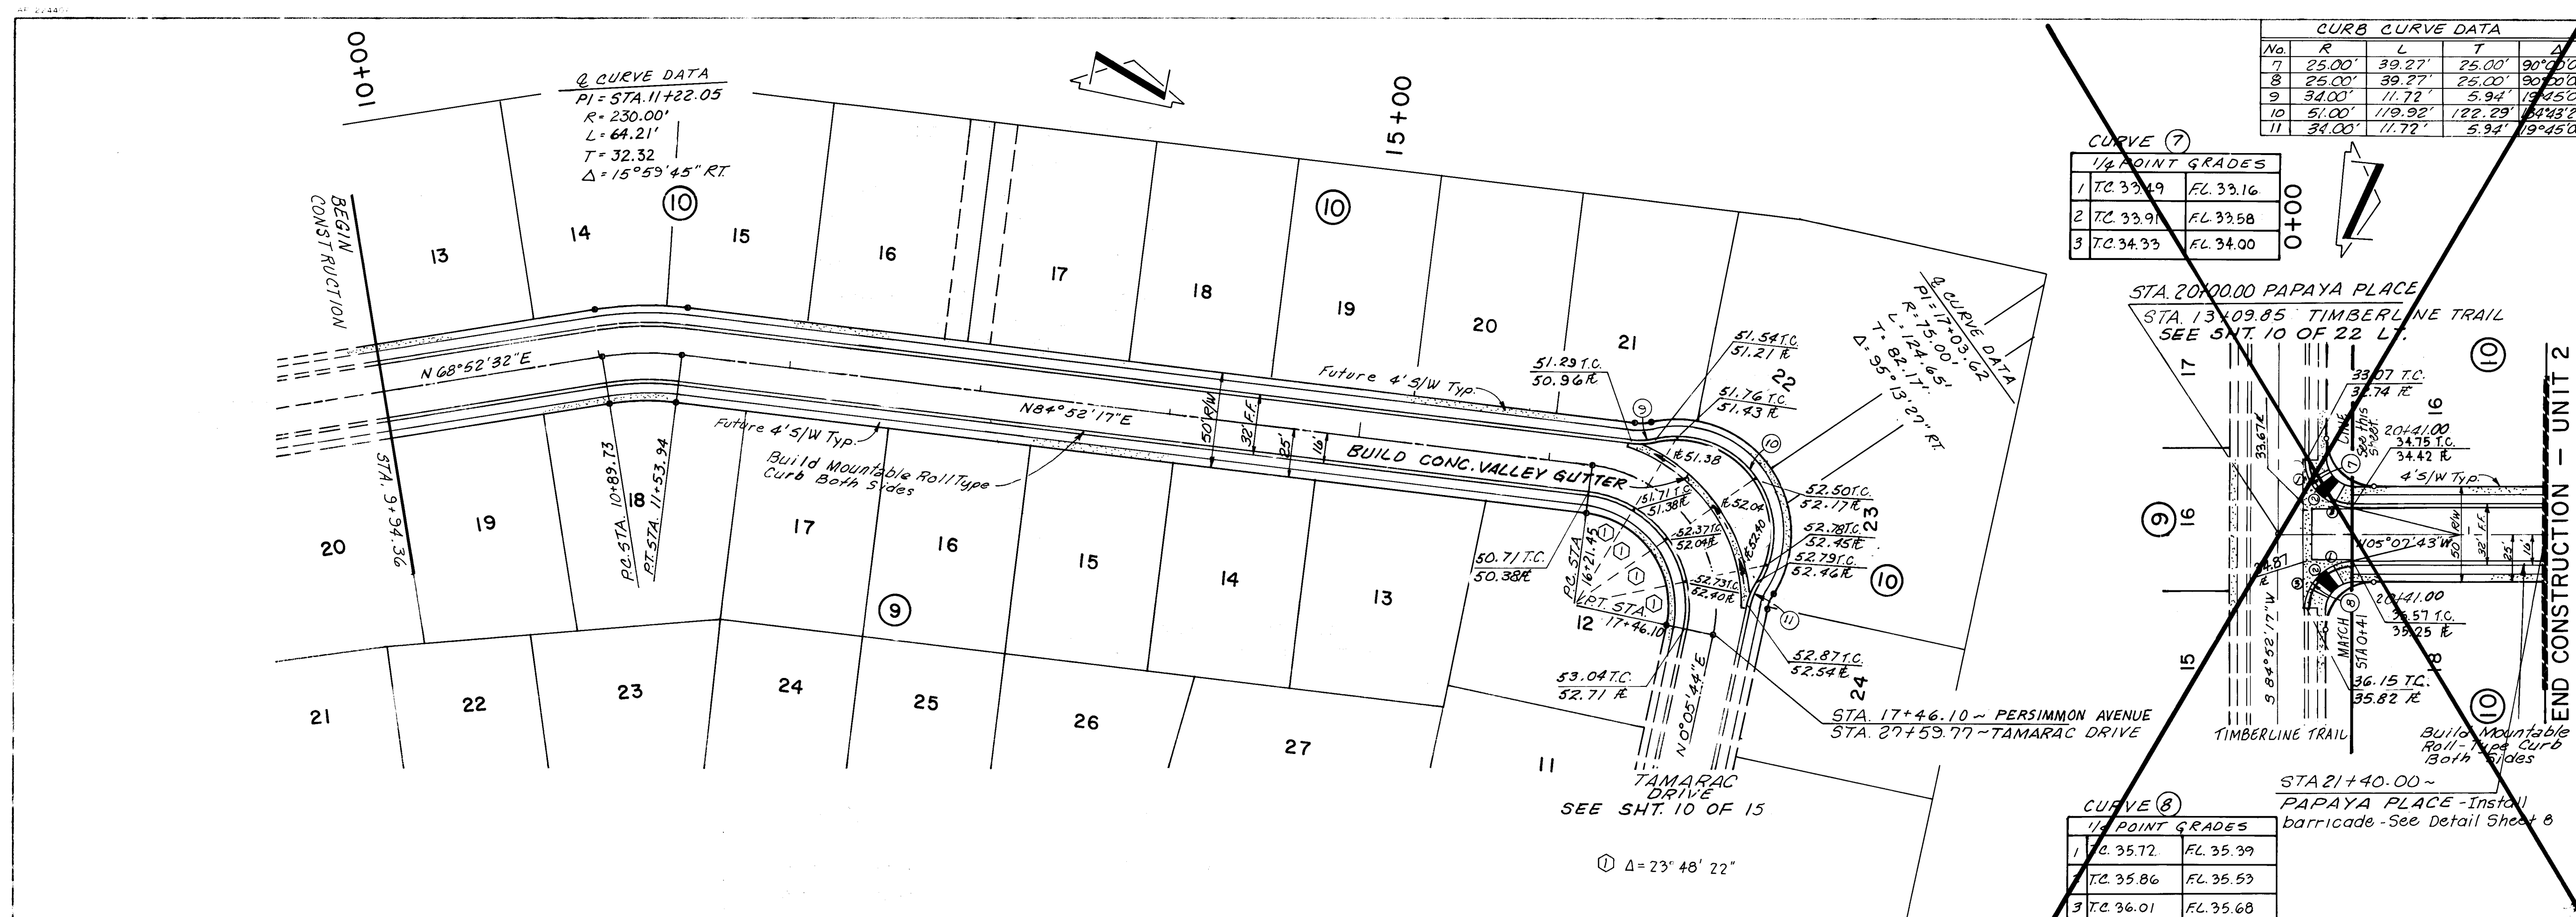

PERSIMMON AVENUE

PAPAYA PLACE

SCALE: 1" = 50' HORIZ.
1" = 5' VERT.

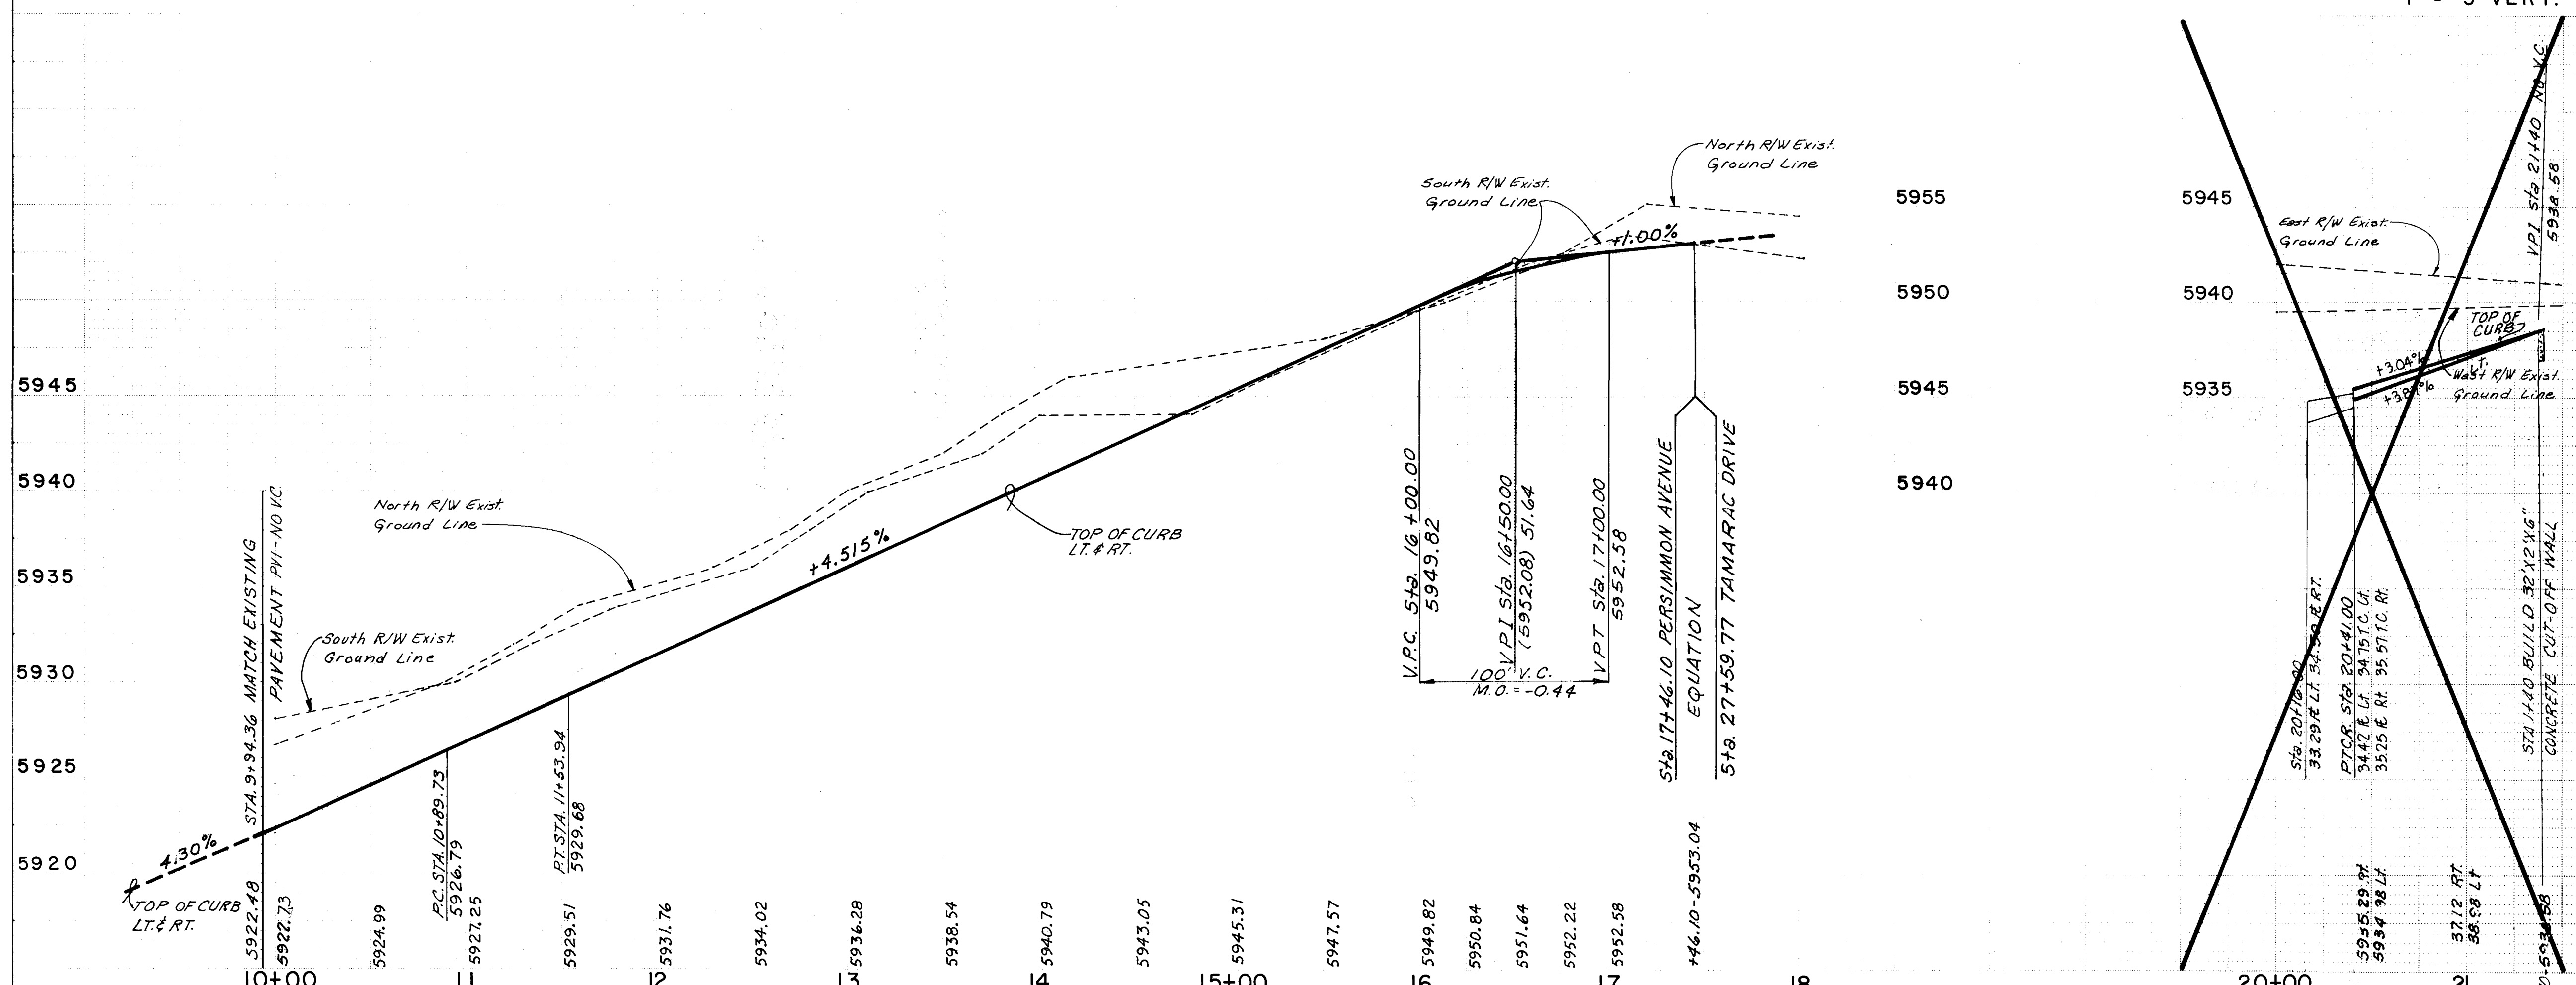

AS BUILT INFORMATION		BENCH MARKS		SURVEY INFORMATION		ENGINEER'S SEAL	
DATE	BY	DATE	BY	NO.	DATE	NO.	DATE
10/10/87	J. E. JENSEN						
A.C.S. BENCH MARK 6-E22 LOCATED FROM THE INTERSECTION OF EUBANK N.E. AND ACADEMY N.E. 1.2 MILES EAST ON ACADEMY, 375 SOUTH OF ACADEMY ON THE SOUTH RM OF A SHALLOW ARROYO. A STANDARD A.C.S. BRASS TABLET STAMPED "S-E22 LS-4972 SET IN THE TOP OF A CONCRETE POST, ELEVATION 5294.53"							
DESIGNED BY		REVISIONS		DATE		DATE	
J. E. JENSEN		DESIGN		APRIL 1987		APRIL 1987	
DRAWN BY		CHECKED BY		DATE		DATE	
SLL		SLL		APRIL 1987		APRIL 1987	
CHECKED BY				DATE		DATE	

26 32640788

PEPPERTREE UNIT 2 PHASE 2


CITY OF ALBUQUERQUE
MUNICIPAL DEVELOPMENT DEPARTMENT
ENGINEERING DIVISION

TITLE: PAVING PLAN & PROFILE
PERSIMMON AVENUE ~ STA. 9+94.36 TO STA. 17+46.10

APPROVALS	ENGINEER	DATE	APPROVALS	ENGINEER	DATE
CITY Engineer	J. E. JENSEN	10/10/87	Liquid Waste	J. E. JENSEN	10/10/87
A.C.E. - Design	J. E. JENSEN	10/10/87	Traffic	J. E. JENSEN	10/10/87
A.C.E. - Hydrology	C.A.M.	9-4-87	Water	J. E. JENSEN	10/10/87

DRAWING NO. 3264 MAP NO. E-22 SHEET 7 OF 15

SCANLON & ASSOCIATES JOB NO. 87101

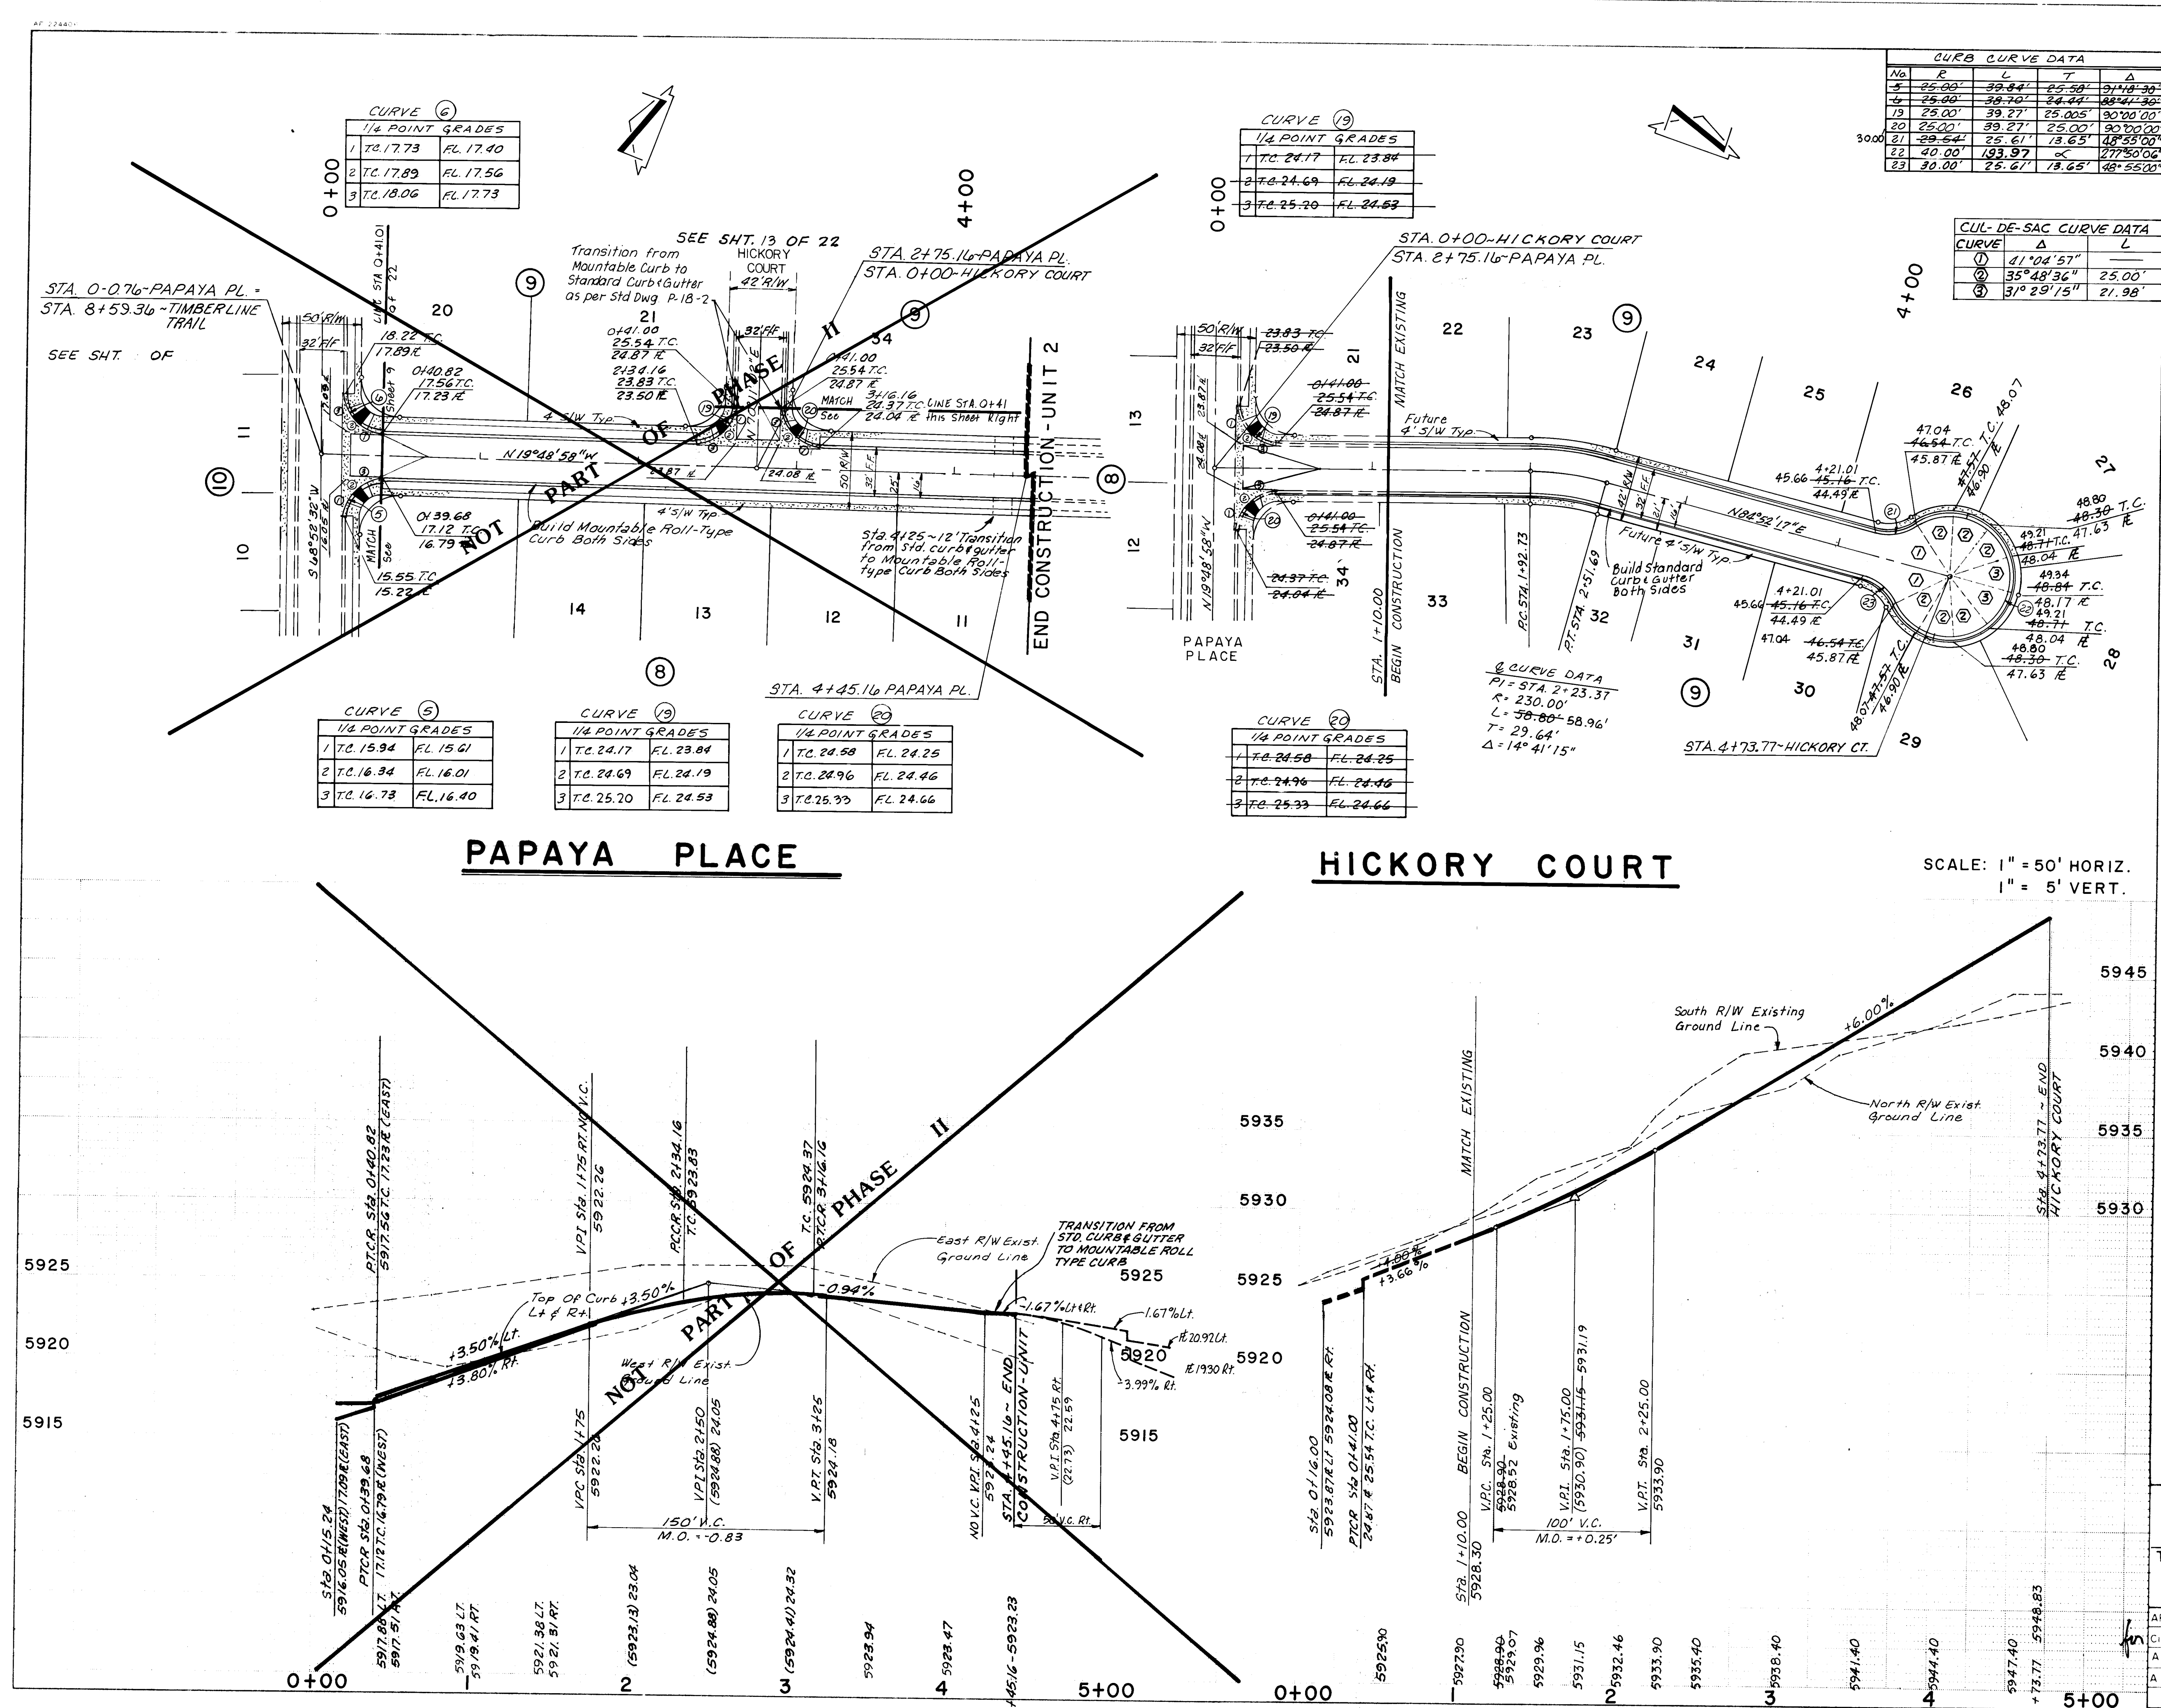

No	R	L	T	Δ
5	25.00'	39.84'	25.50'	91°48'30"
6	25.00'	39.70'	24.44'	88°41'30"
19	25.00'	39.27'	25.005'	90°00'00"
20	25.00'	39.27'	25.00'	90°00'00"
21	29.54'	25.61'	13.65'	48°55'00"
22	40.00'	193.97'	∞	277°50'06"
23	30.00'	25.61'	13.65'	48°55'00"

CURVE	Δ	L
①	$41^{\circ}04'57''$	—
②	$35^{\circ}48'36''$	25.00'
③	$31^{\circ}29'15''$	21.98'

CURVE (6)

1/4 POINT GRADES		
1	T.C. 17.73	FL. 17.40
2	T.C. 17.89	FL. 17.56
3	T.C. 18.06	FL. 17.73

1/4 POINT GRADES	
1 T.C. 24.17	FL. 23.84
2 T.C. 24.69	FL. 24.19
3 T.C. 25.20	FL. 24.53

CURVE (5)

1/4 POINT GRADES	
1 T.C. 15.94	FL. 15.61
2 T.C. 16.34	FL. 16.01
3 T.C. 16.73	FL. 16.40

1/4 POINT GRADES		
1	T.C. 24.17	FL. 23.84
2	T.C. 24.69	FL. 24.19
3	T.C. 25.20	FL. 24.53

CURVE 20

1/4 POINT GRADES		
1	T.C. 24.58	FL. 24.25
2	T.C. 24.96	FL. 24.46
3	T.C. 25.33	FL. 24.66


CURVE (20)

1/4 POINT GRADES	
1 T.C. 24.58	F.L. 24.25
2 T.C. 24.96	F.L. 24.46
3 T.C. 25.33	F.L. 24.66

PAPAYA PLACE

HICKORY COURT

SCALE: 1" = 50' HORIZ.
1" = 5' VERT.

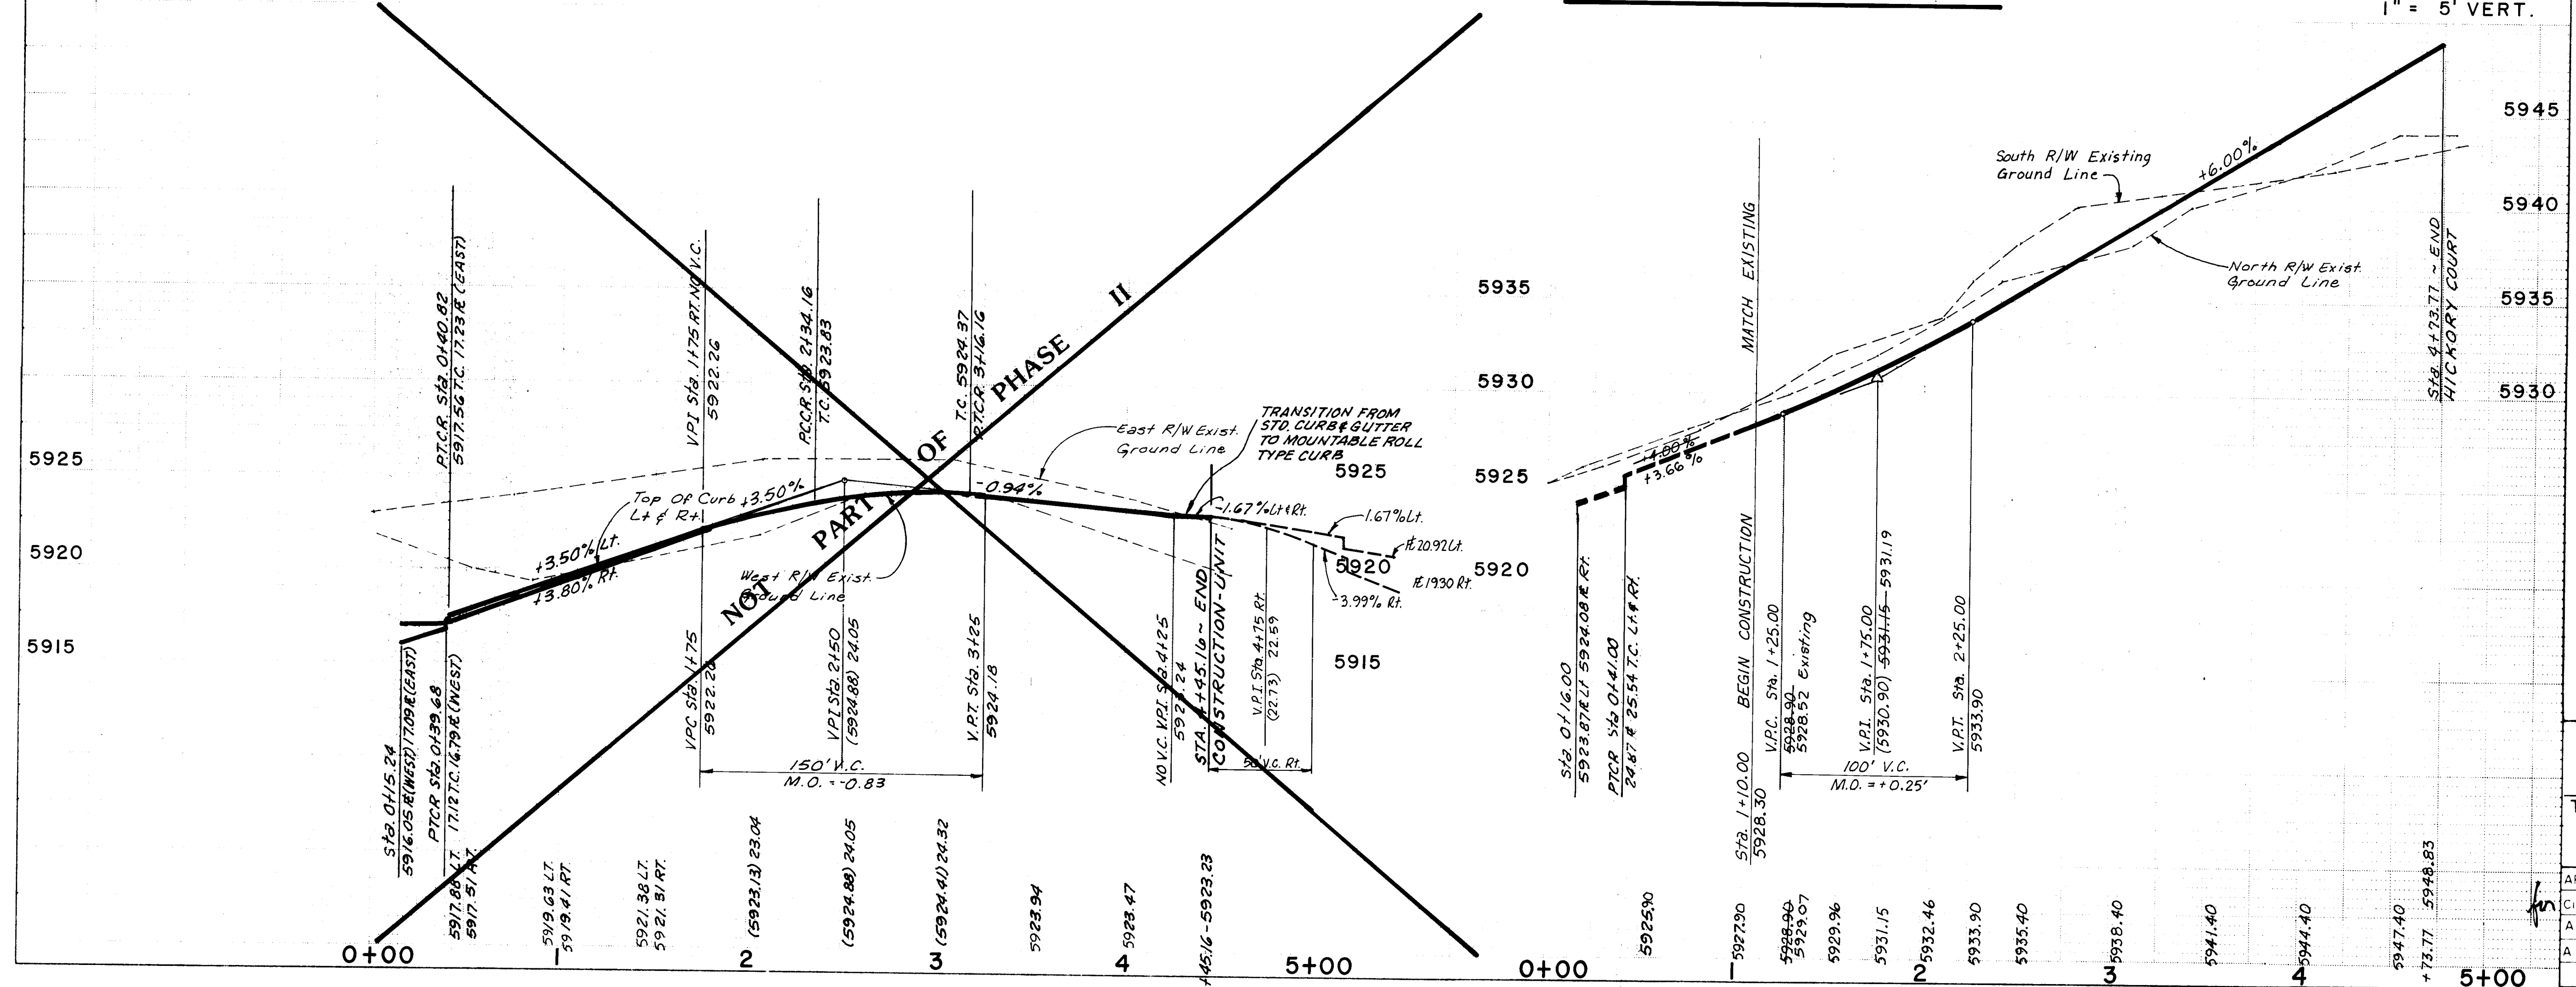

26 32640888

PEPPERTREE UNIT 2 PHASE 2

CITY OF ALBUQUERQUE
MUNICIPAL DEVELOPMENT DEPARTMENT
ENGINEERING DIVISION

TITLE: PAVING PLAN & PROFILE

HICKORY COURT

APPROVALS	ENGINEER	DATE	APPROVALS	ENGINEER	DATE
City Engineer	<i>[Signature]</i>	2/17/87	Liquid Waste	<i>[Signature]</i>	2/18/87
A C E - Design	" "	" "	Traffic	<i>[Signature]</i>	2/18/87
A C E - Hydrology	CAM	2-4-87	Water	<i>[Signature]</i>	2/18/87

DRAWING NO.	3264
-------------	------

MAP NO.
E-22



SHEET 8 OF 15

SCANLON & ASSOCIATES

JOB NO 8710



RECORD DRAWING

SHEETS		ENGINEER		DATE	
1		[Signature]		9/1/87	
2		[Signature]		9/1/87	
3		[Signature]		9/1/87	
93</					

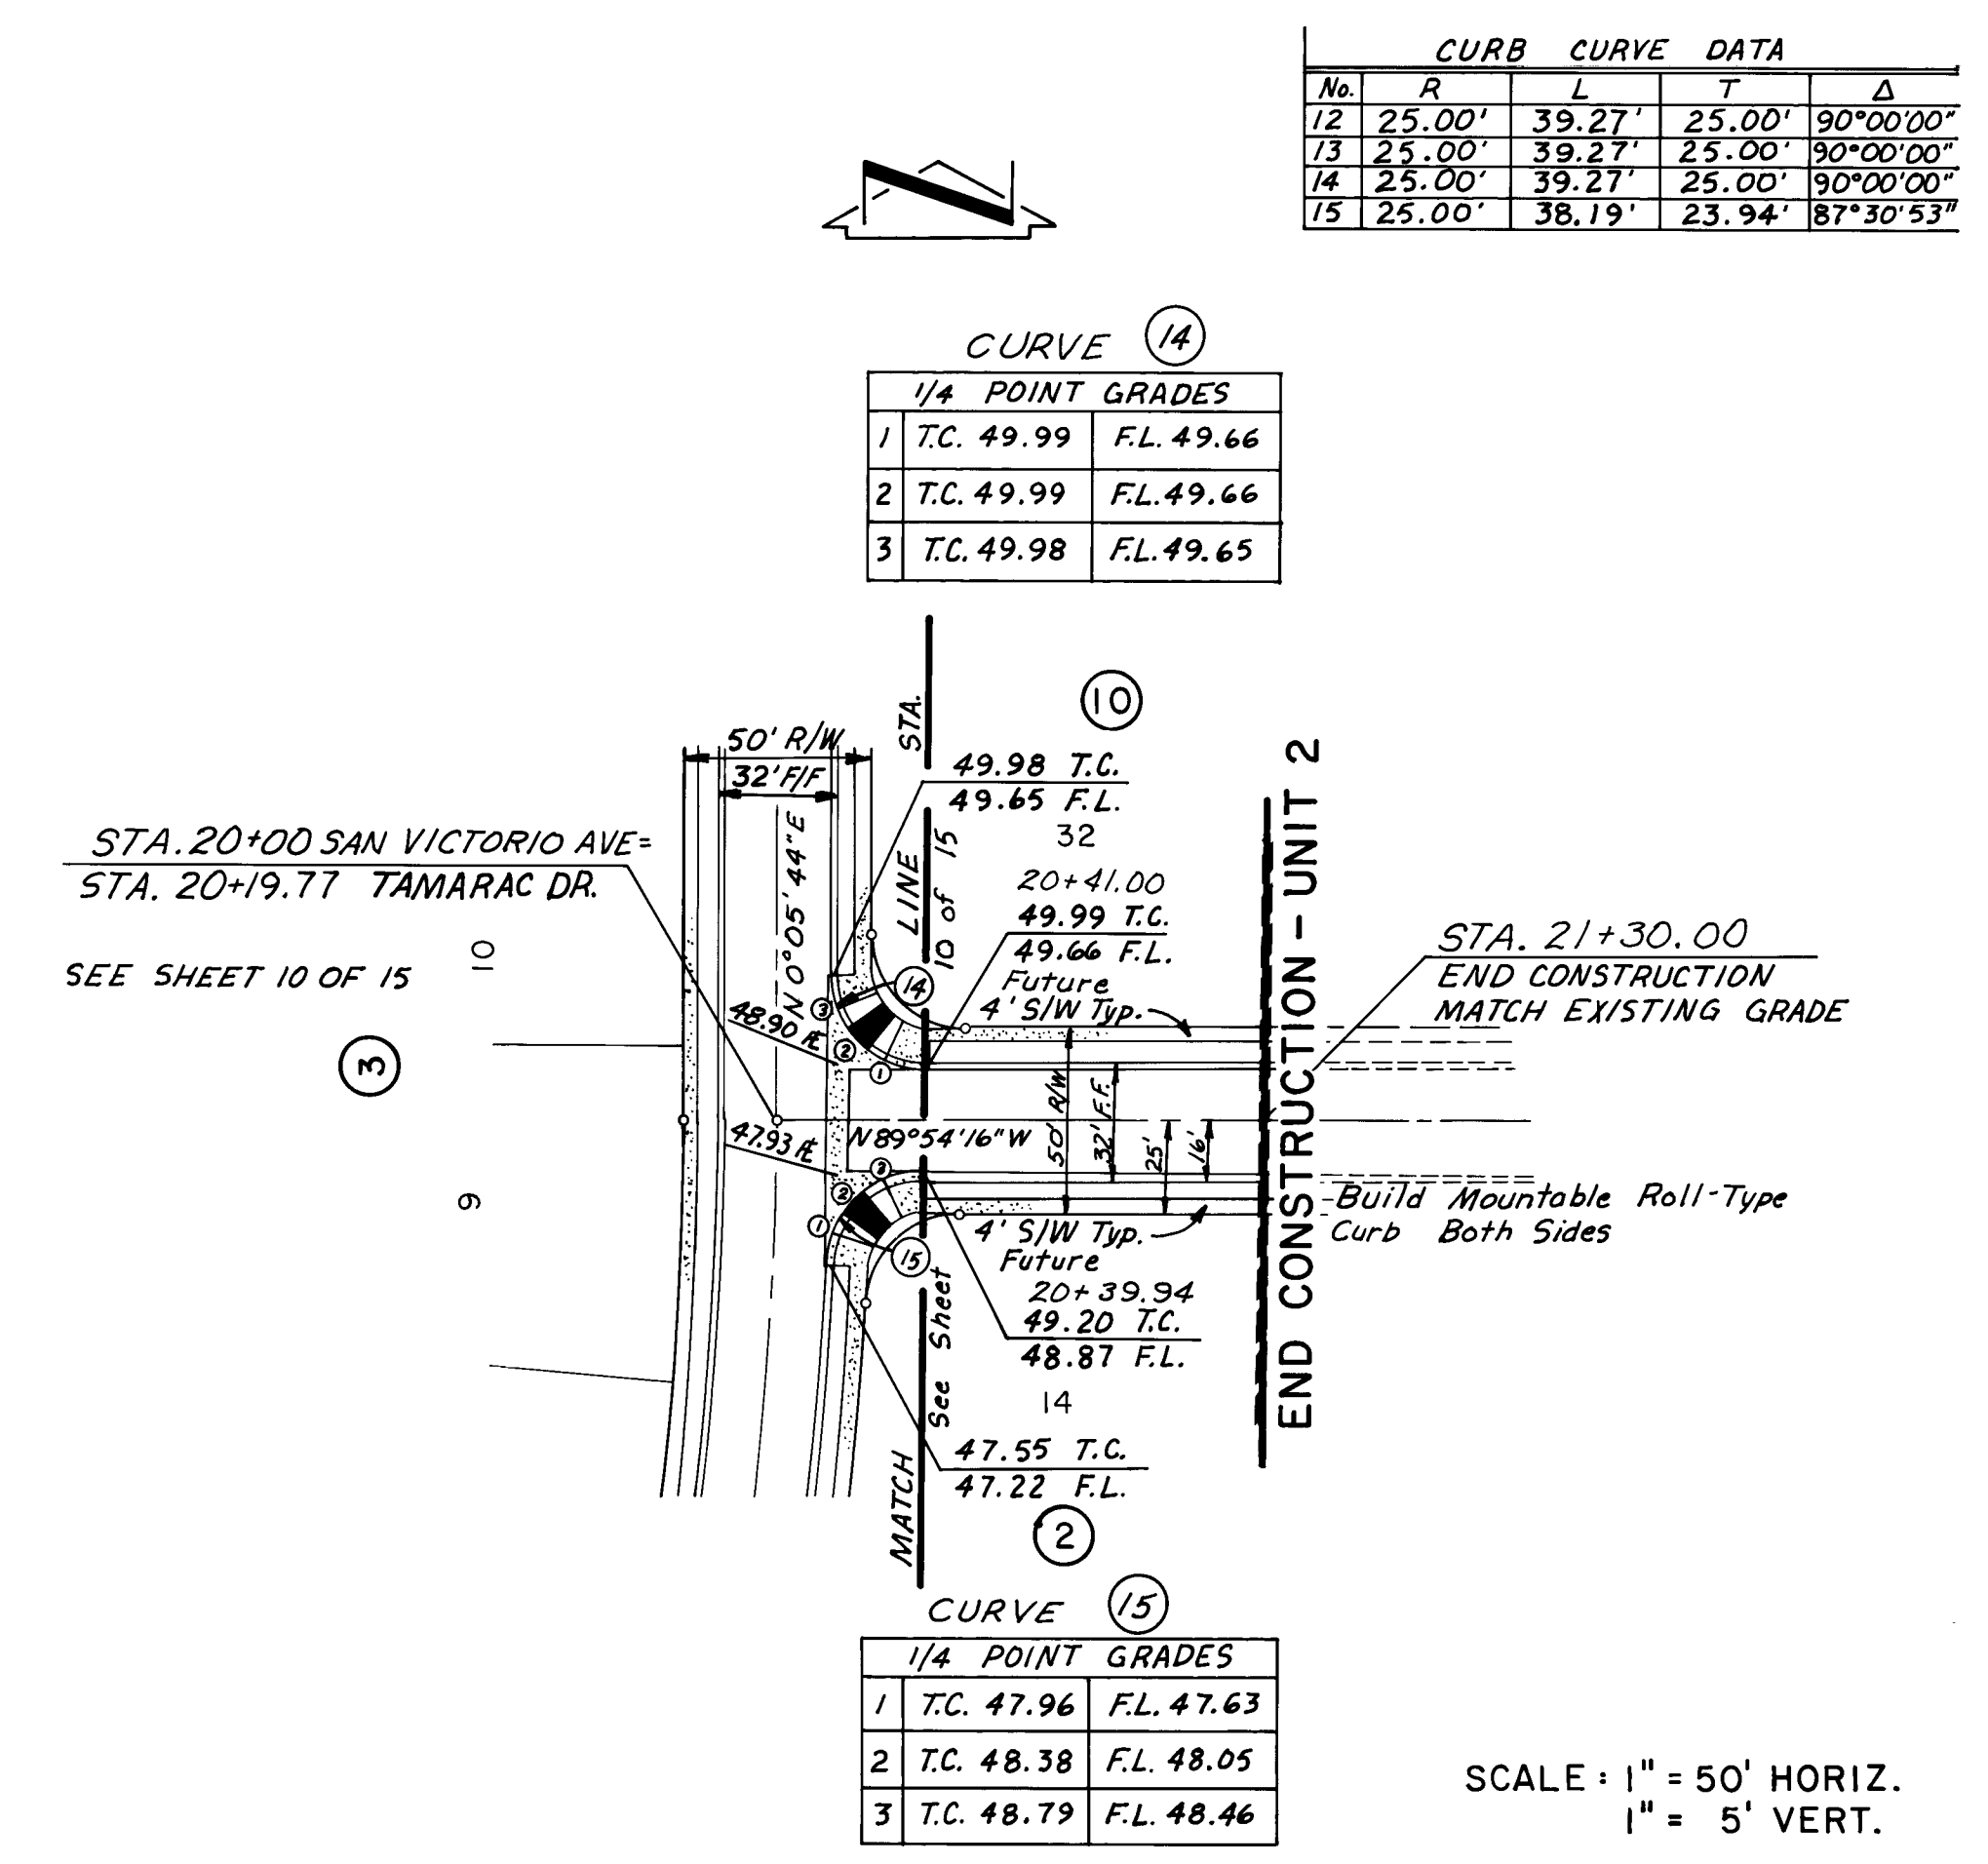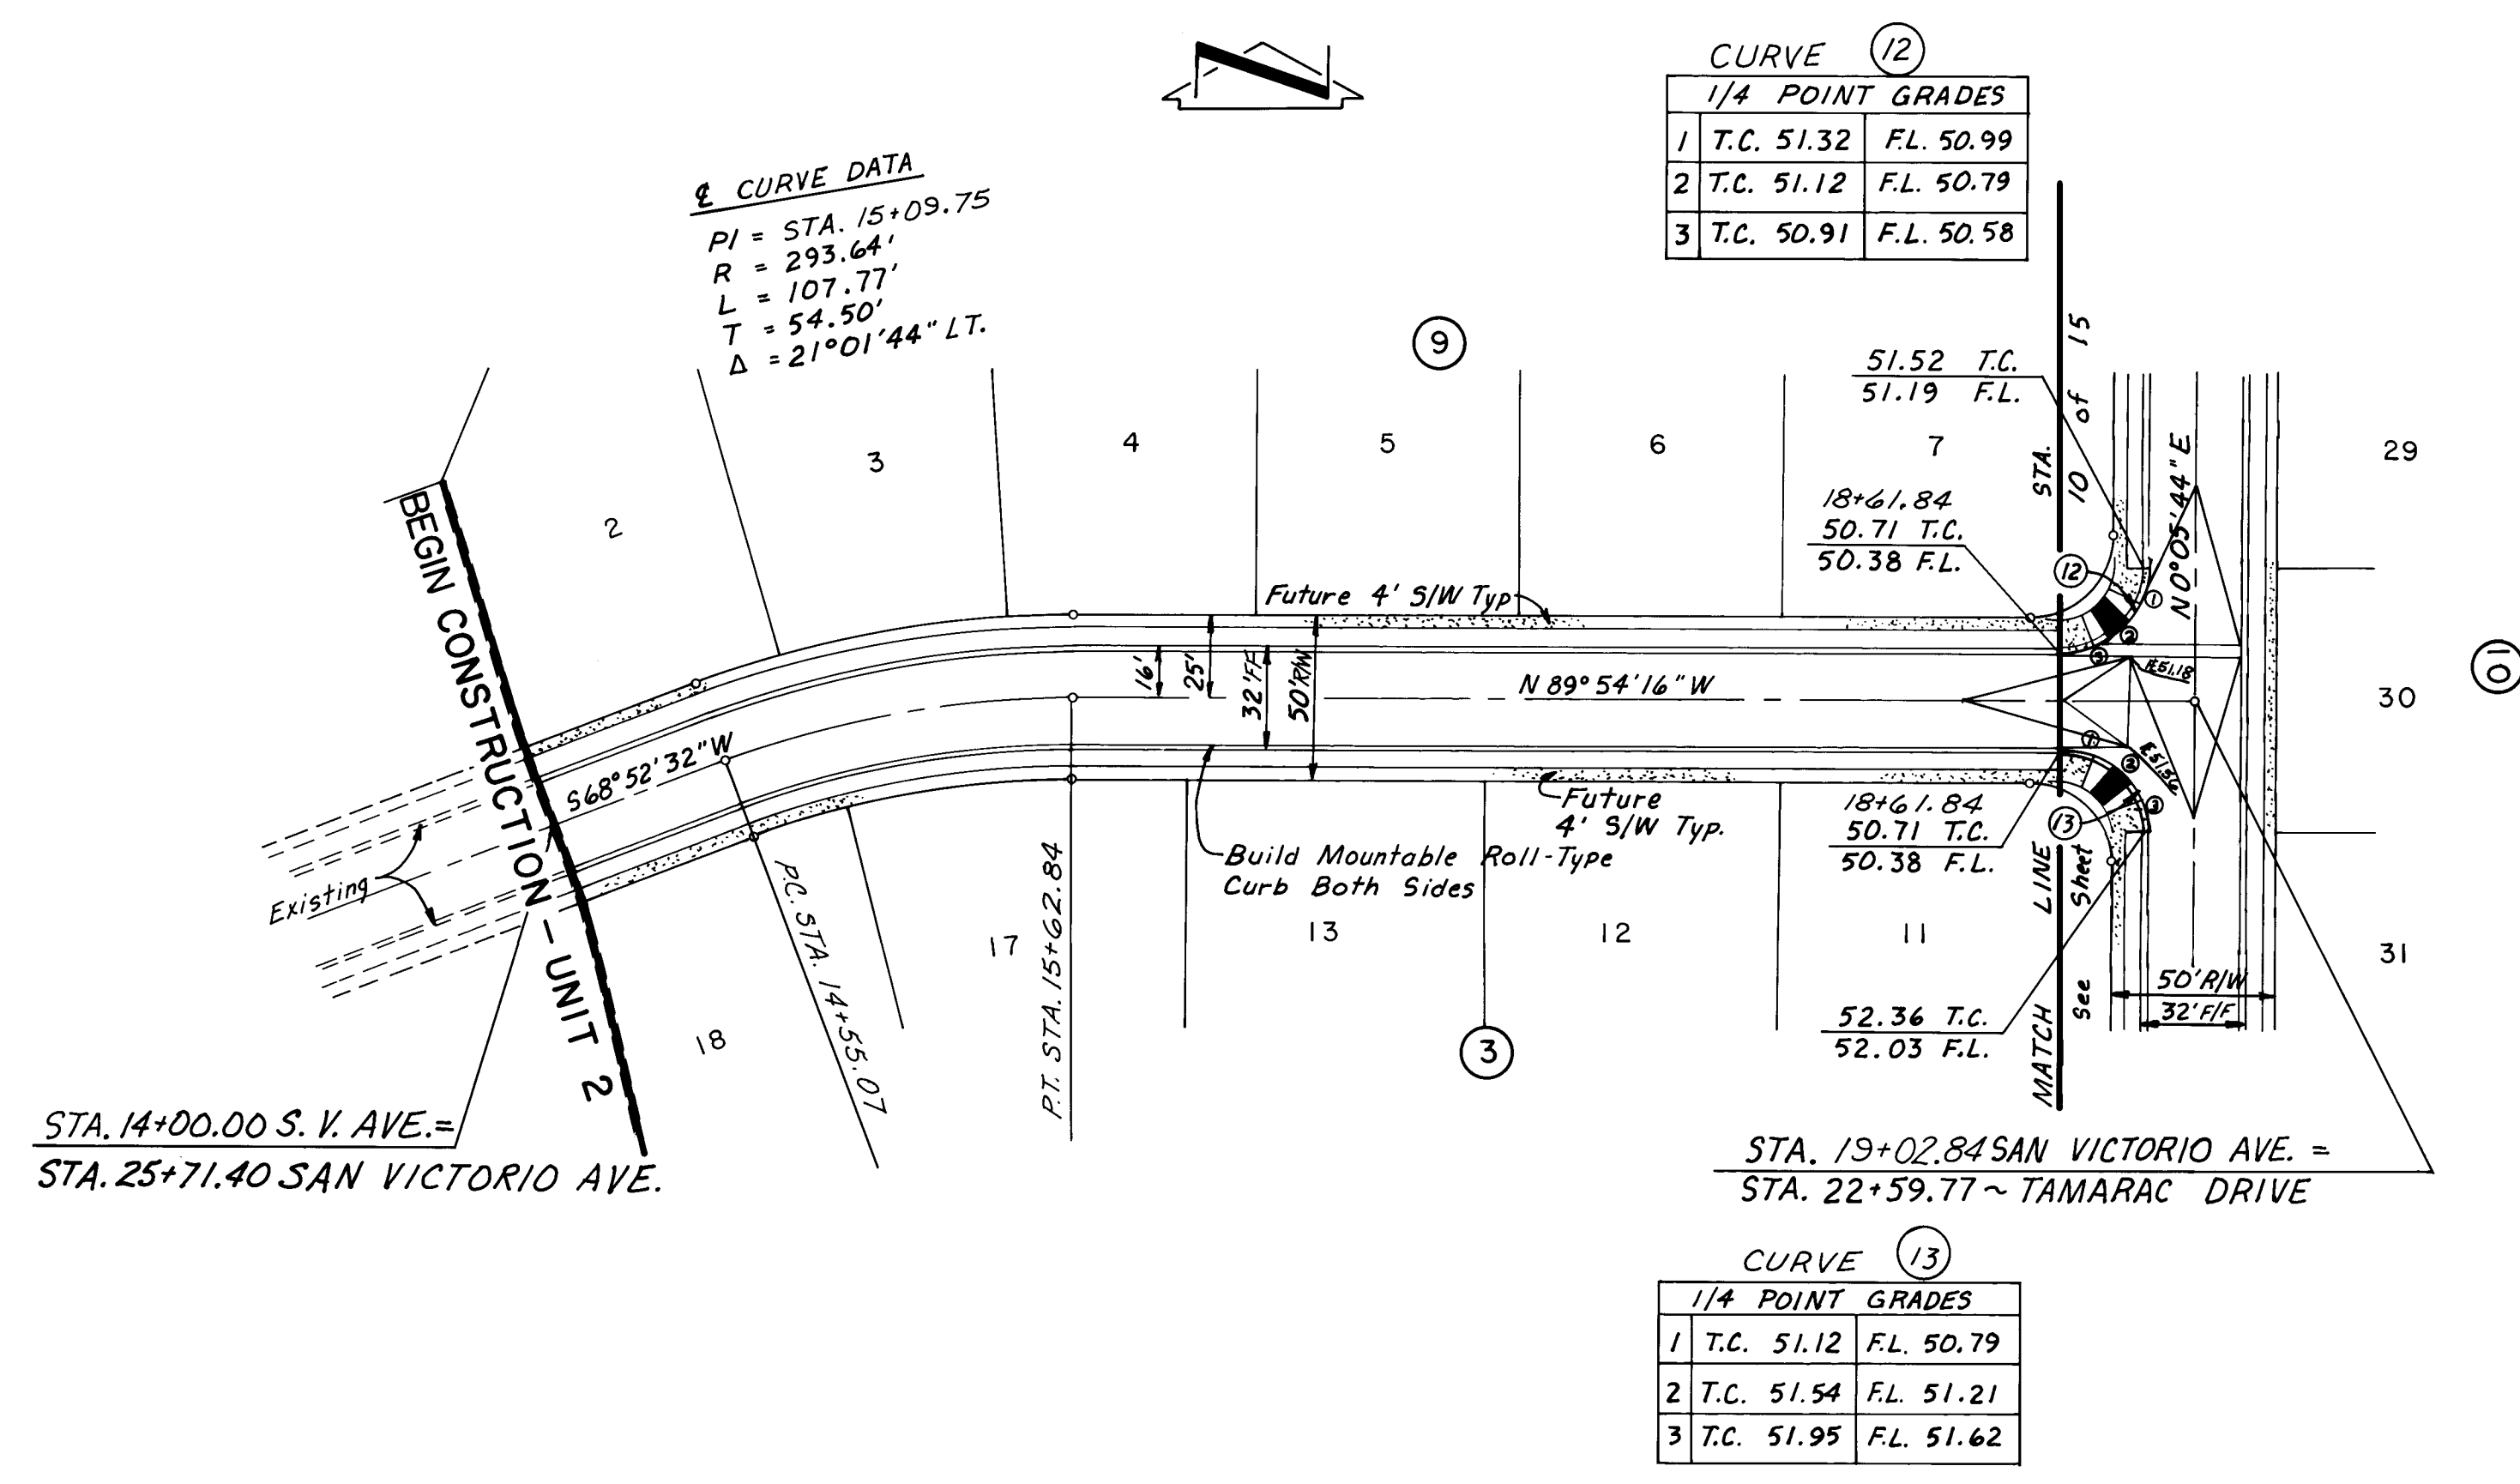

SAN VICTORIO AVENUE

SAN VICTORIO AVENUE

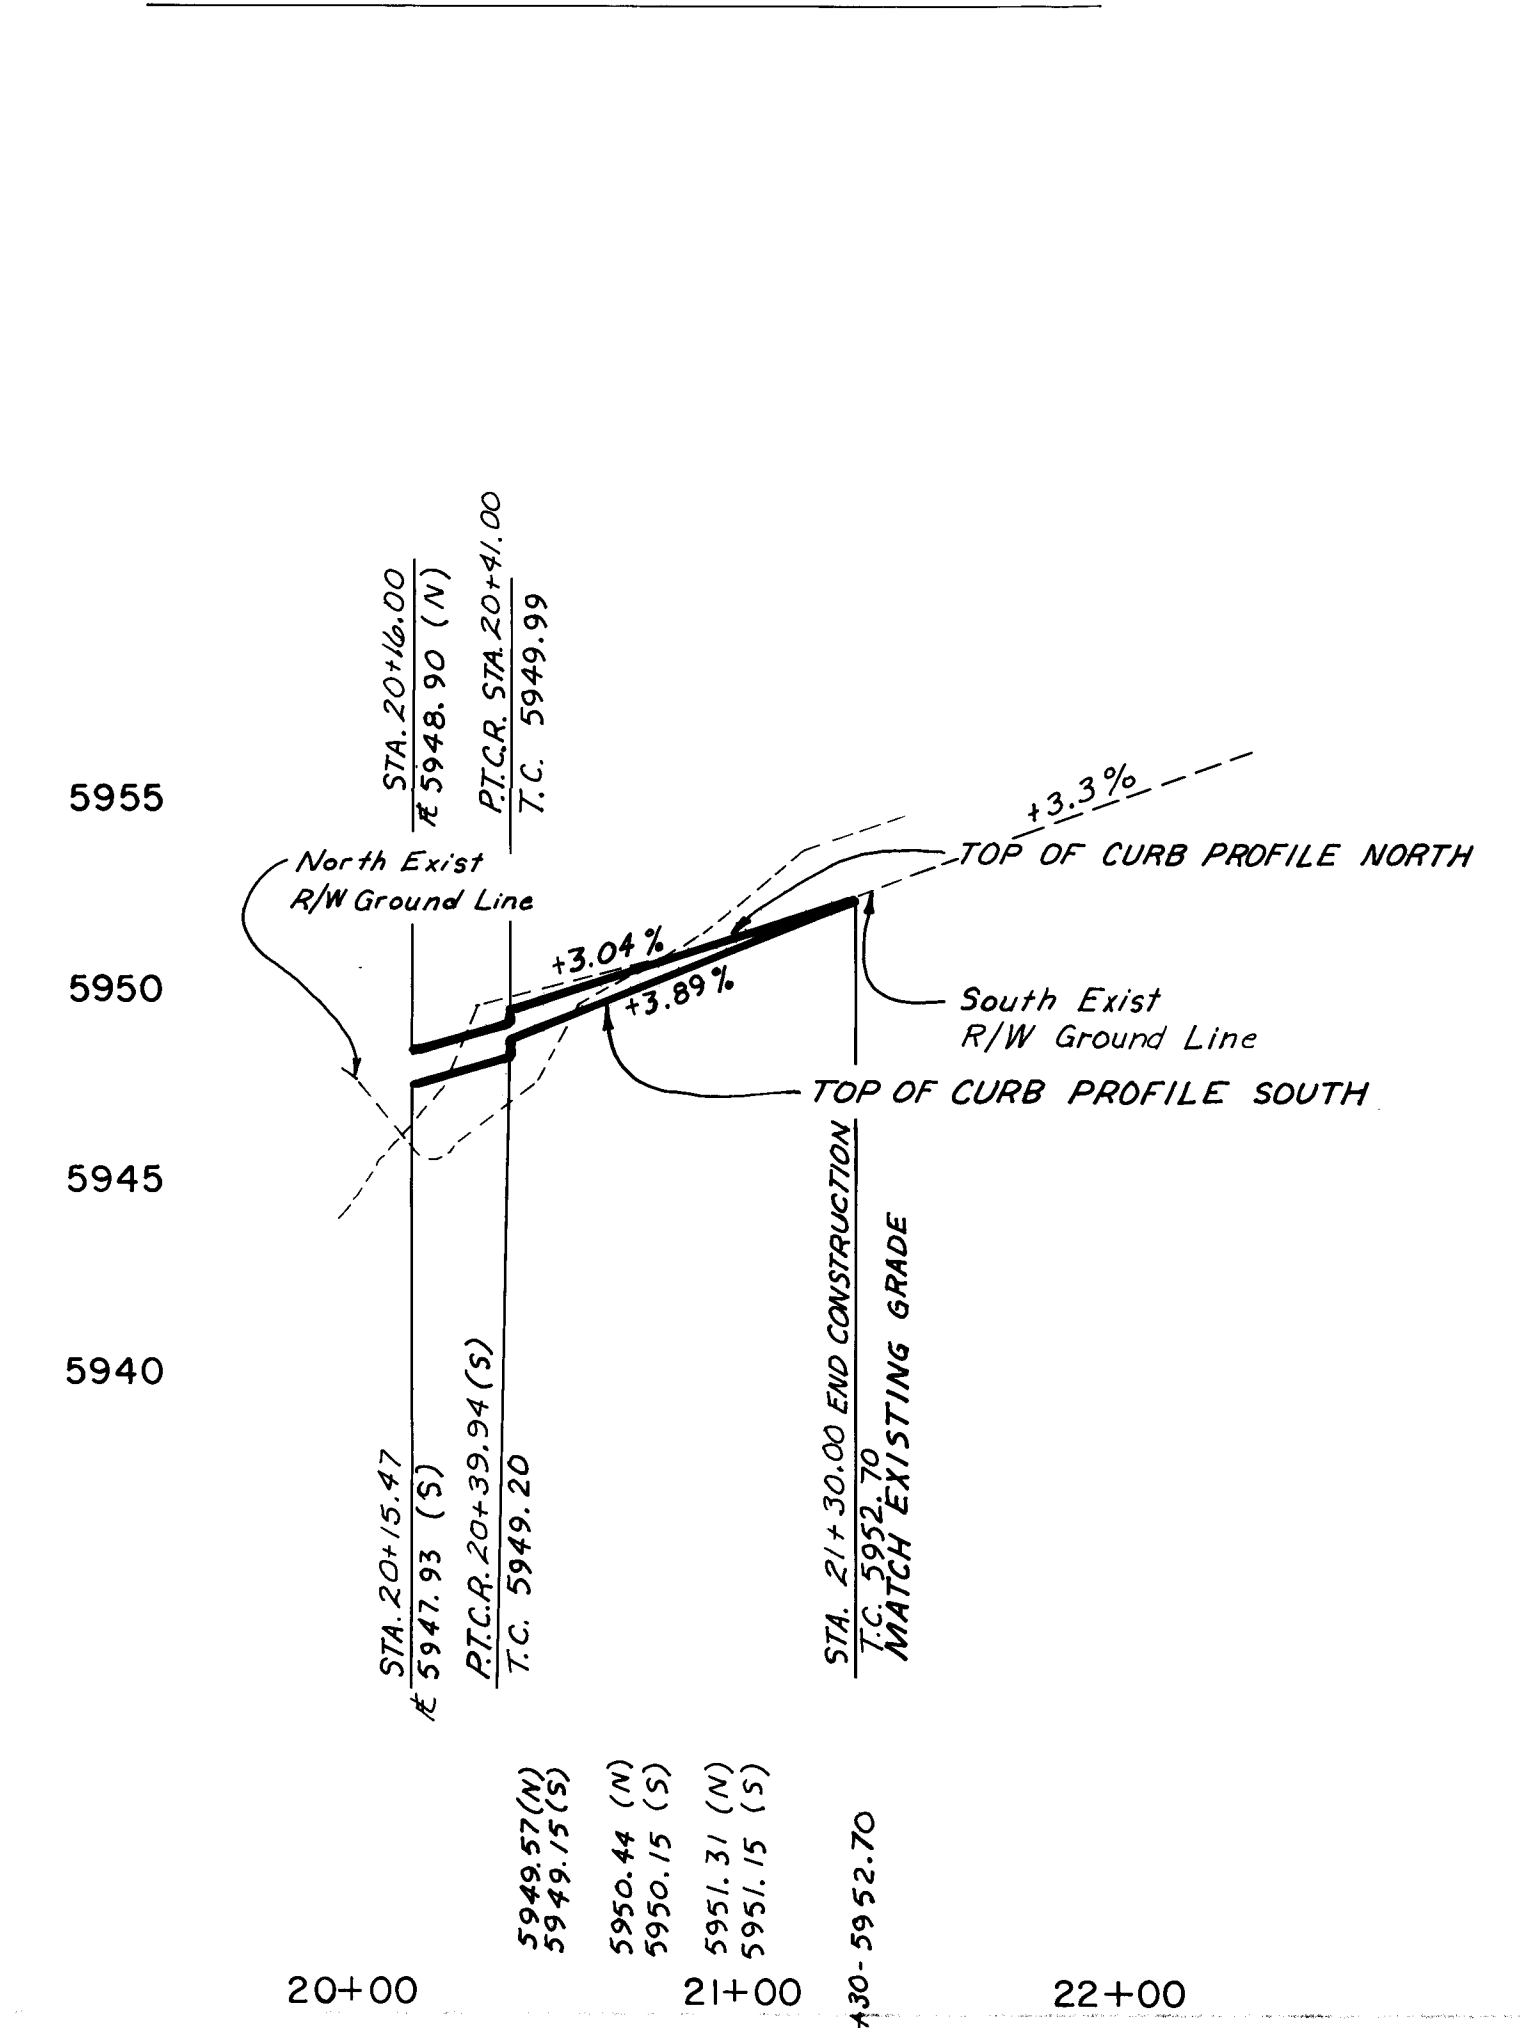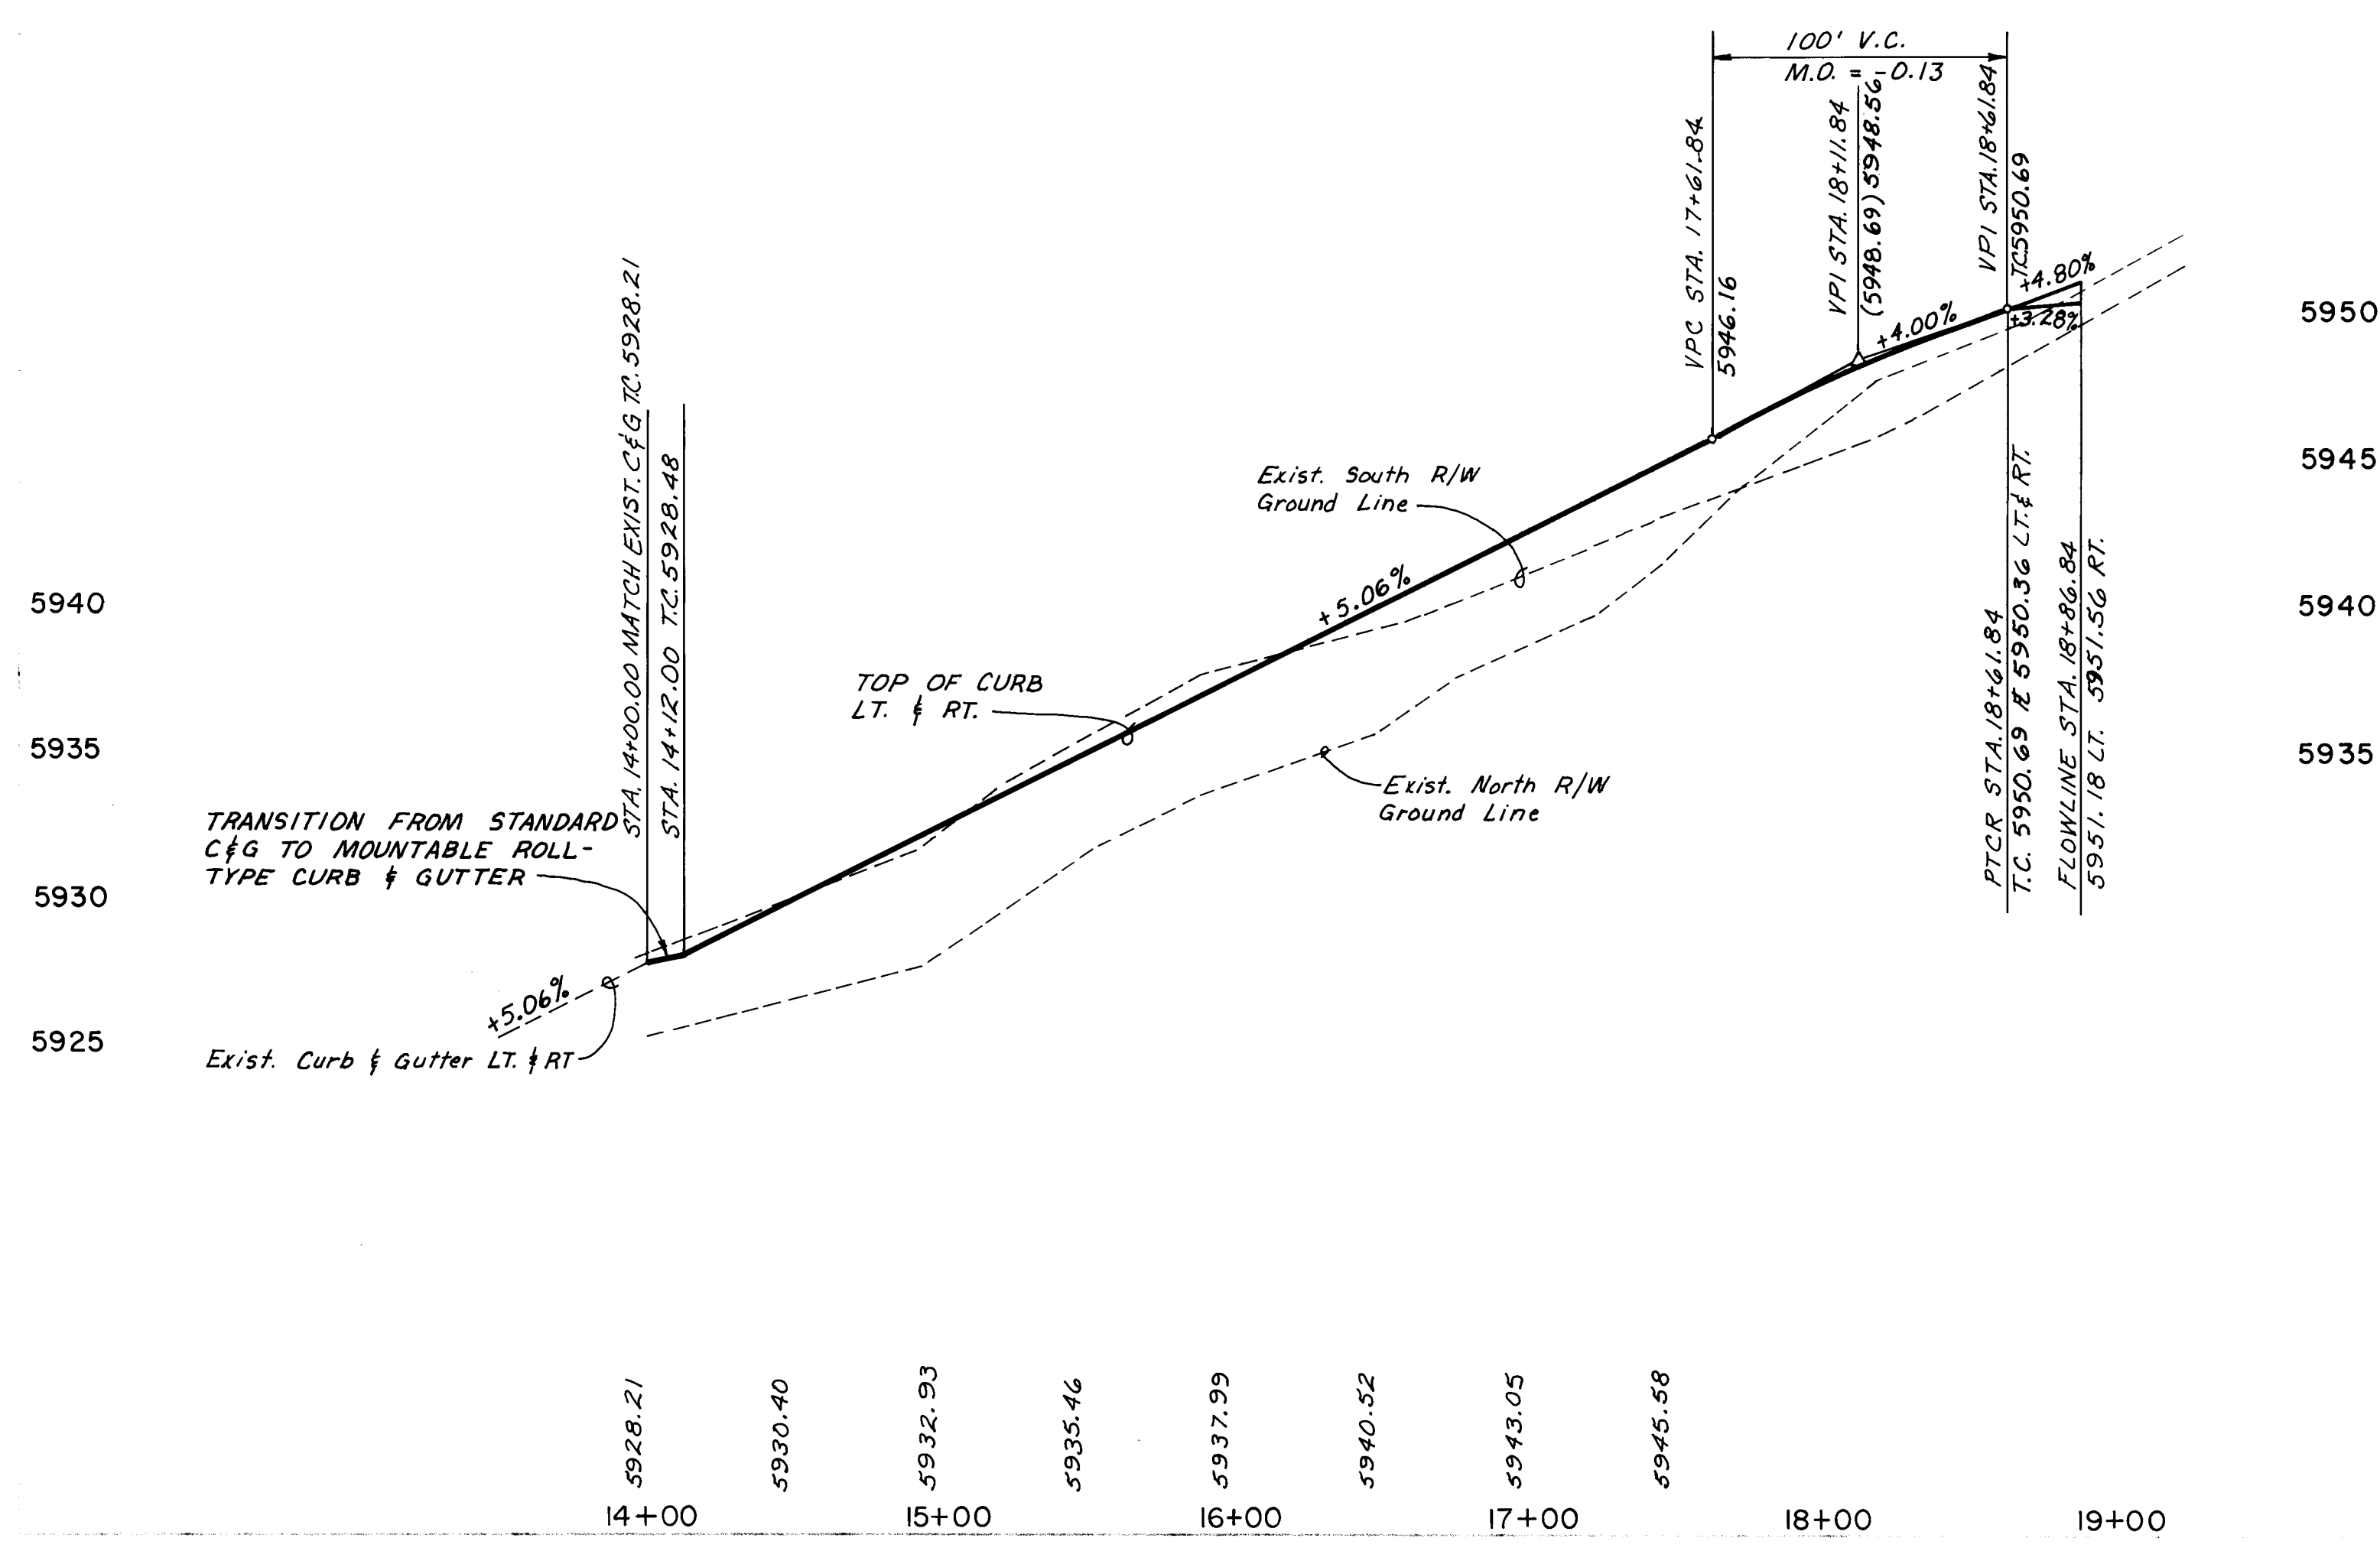



26 32640988
PEPPERTREE UNIT 2 PHASE 2

PAVING PLAN & PROFILE
SAN VICTORIO AVENUE

Hydrology
3264
9/1/87
9-4-87

INTEREST LTD.
E.B. JENSEN
10/67
SCANLON 1/85
5/88
A.C.S. BENCH MARK 6-E22 LOCATED FROM THE INTERSECTION OF EUBANK N.E. AND ACADEMY N.E. 1.2 MILES EAST ON ACADEMY, 375' SOUTH OF ACADEMY ON THE SOUTH RIM OF A SHALLOW ARROYO. A STANDARD A.C.S. BRASS TABLET STAMPED "6-E22 LS-4872" SET IN THE TOP OF A CONCRETE POST, ELEVATION 9934.53

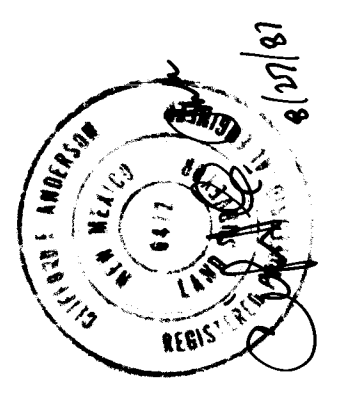

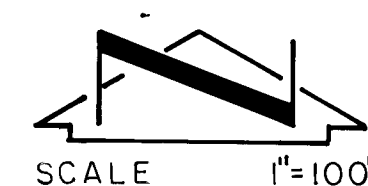

- 1) The Contractor shall furnish EMD's on all water and sewer service stubs, caps and plugs.
- 2) Stationing on watermain refers to street centerlines. Stationing on sewer services refers to street centerlines Stations.
- 3) Contractor shall field verify locations and elevations of all existing pipe and utilities prior to construction.
- 4) Water - Services shall be 3/4" cts, SDR - 9 Polyethylene tubing, ~~or 1" IPS, SDR 7 Polyethylene tubing in accordance with ASTM D-2737~~
- 5) All tees, bends and caps shall be blocked according to City of Albuquerque Standards.
- 6) All water meter boxes shall be furnished with heavy duty vehicle-proof cover.
- 7) Sewer Service stub locations and elevations shown on the following plan sheets shall be interpreted as occurring 2' beyond front property lines.
- 8) All pipe shall be furnished with Class "C" bedding unless otherwise noted.
- 9) In all locations where sewer mains exceed 13 feet in depth, sewer services shall be furnished with standard City of Albuquerque risers per City of Albuquerque standards.
- 10) All water valves shall be equipped w/Type A Boxes or as otherwise noted.
- 11) All sewer services shall be 4".
- 12) All valves will be resilient seat gate valves.
- 13) Fire Hydrants shall be 4'- 6" Bury.
- 14) Maximum Joint Deflection on curvilinear water and sewer lines shall not exceed 2/3 of the pipe manufacturers maximum recommended deflection, there will be no joint deflection in P.V.C. pipes, the deflection shall occur in the pipe, not at the joint.
- 15) Sanitary sewer line lengths are measured from ~~edge of~~ manhole to ~~edge of~~ manhole.

	PROPOSED SEWER LINE W/SIZE & FLOW
	EXISTING SEWER LINE W/SIZE & FLOW
	PROPOSED MANHOLE
	EXISTING MANHOLE
	PROPOSED WATER LINE W/SIZE
	EXISTING WATER LINE W/SIZE
	PROPOSED GATE VALVE
	EXISTING WATER VALVE
	PROPOSED BUTTERFLY VALVE
	EXISTING BUTTERFLY VALVE
	PROPOSED FIRE HYDRANT
	EXISTING FIRE HYDRANT

ENGINEER'S SEAL		SURVEY INFORMATION		BENCH MARKS		AS BUILT INFORMATION	
		FIELD NOTES		A.C.S. BENCH MARK 6-222 LOCATED FROM THE INTERSECTION OF EUBANK N.E. AND ACADEMY N.E., 1.2 MILES EAST ON ACADEMY, 375' SOUTH OF ACADEMY ON THE SOUTH RM. OF A SHALLOW ARROYO. A STANDARD A.C.S. BRASS TABLET 6-222 LS-4972 " SET IN THE TOP OF A CONCRETE POST, ELEVATION 5934.53		CONTRACT INFORMATION	
		NO.	BY			DATE	CONTRACT NO.
NO.	DATE	REMARKS	BY				
DESIGNED BY JKZ				DATE APRIL 1987			
DRAWN BY SLL				DATE APRIL 1987			
CHECKED BY				DATE			

26 32641188

PEPPERTREE UNIT 2 PHASE 2

CITY OF ALBUQUERQUE
MUNICIPAL DEVELOPMENT DEPARTMENT
ENGINEERING DIVISION


TITLE: UTILITY COMPOSITE

APPROVALS	ENGINEER	DATE	APPROVALS	ENGINEER	DATE
City Engineer	<i>[Signature]</i>	9/17/87	Liquid Waste	<i>[Signature]</i>	9/18/87
A C E - Design	" "	"	Traffic	<i>[Signature]</i>	9/18/87
A C E - Hydrology	CAM	9-4-87	Water	<i>[Signature]</i>	9/18/87

DRAWING NO.	3264	MAP NO.	E-22	SHEET	11	OF	15
-------------	------	---------	------	-------	----	----	----

SCANLON & ASSOCIATES JOB NO. 87101


RECORD DRAWING

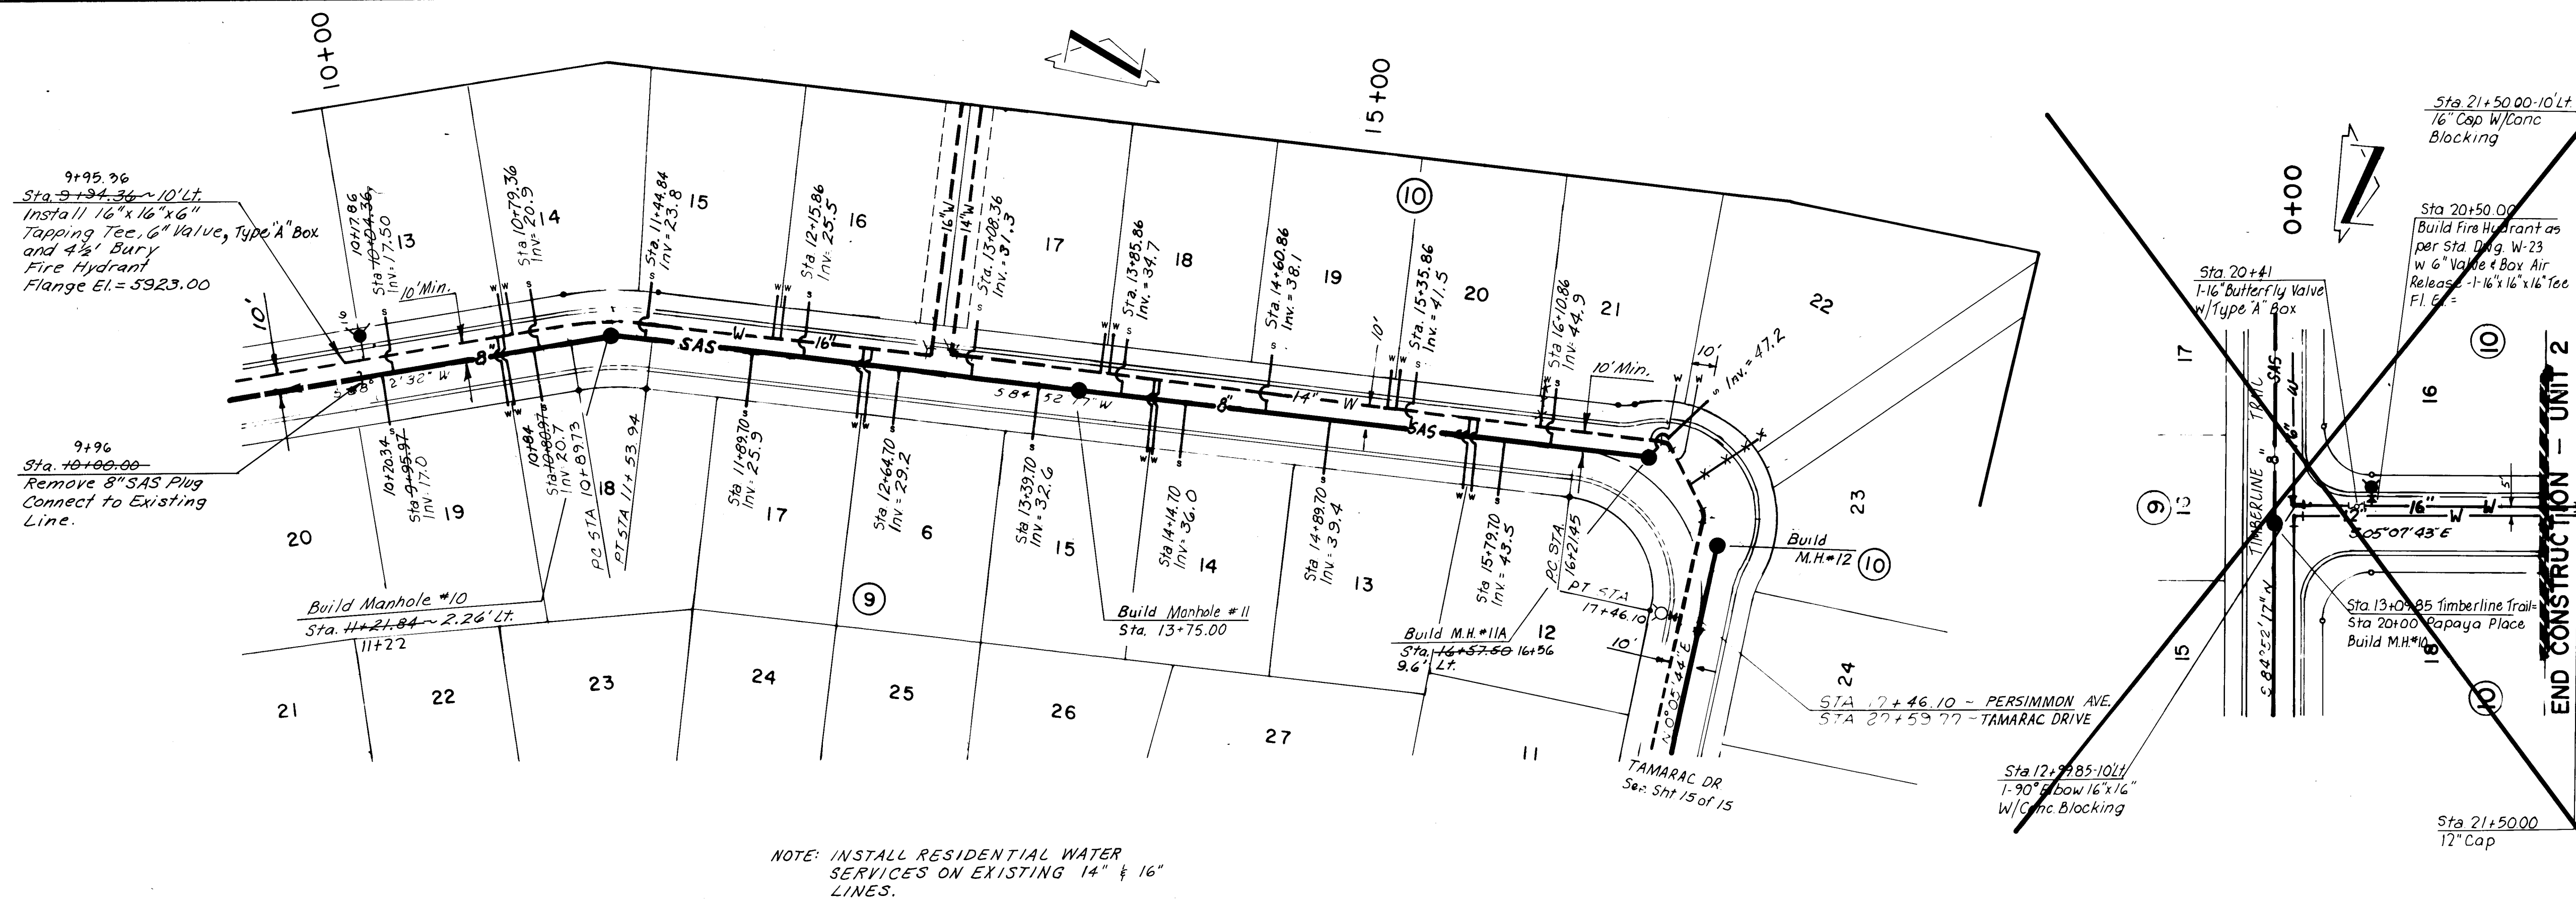

PERSIMMON AVENUE

PAPAYA PLACE

SCALE: 1" = 50' HORIZ.
1" = 5' VERT.

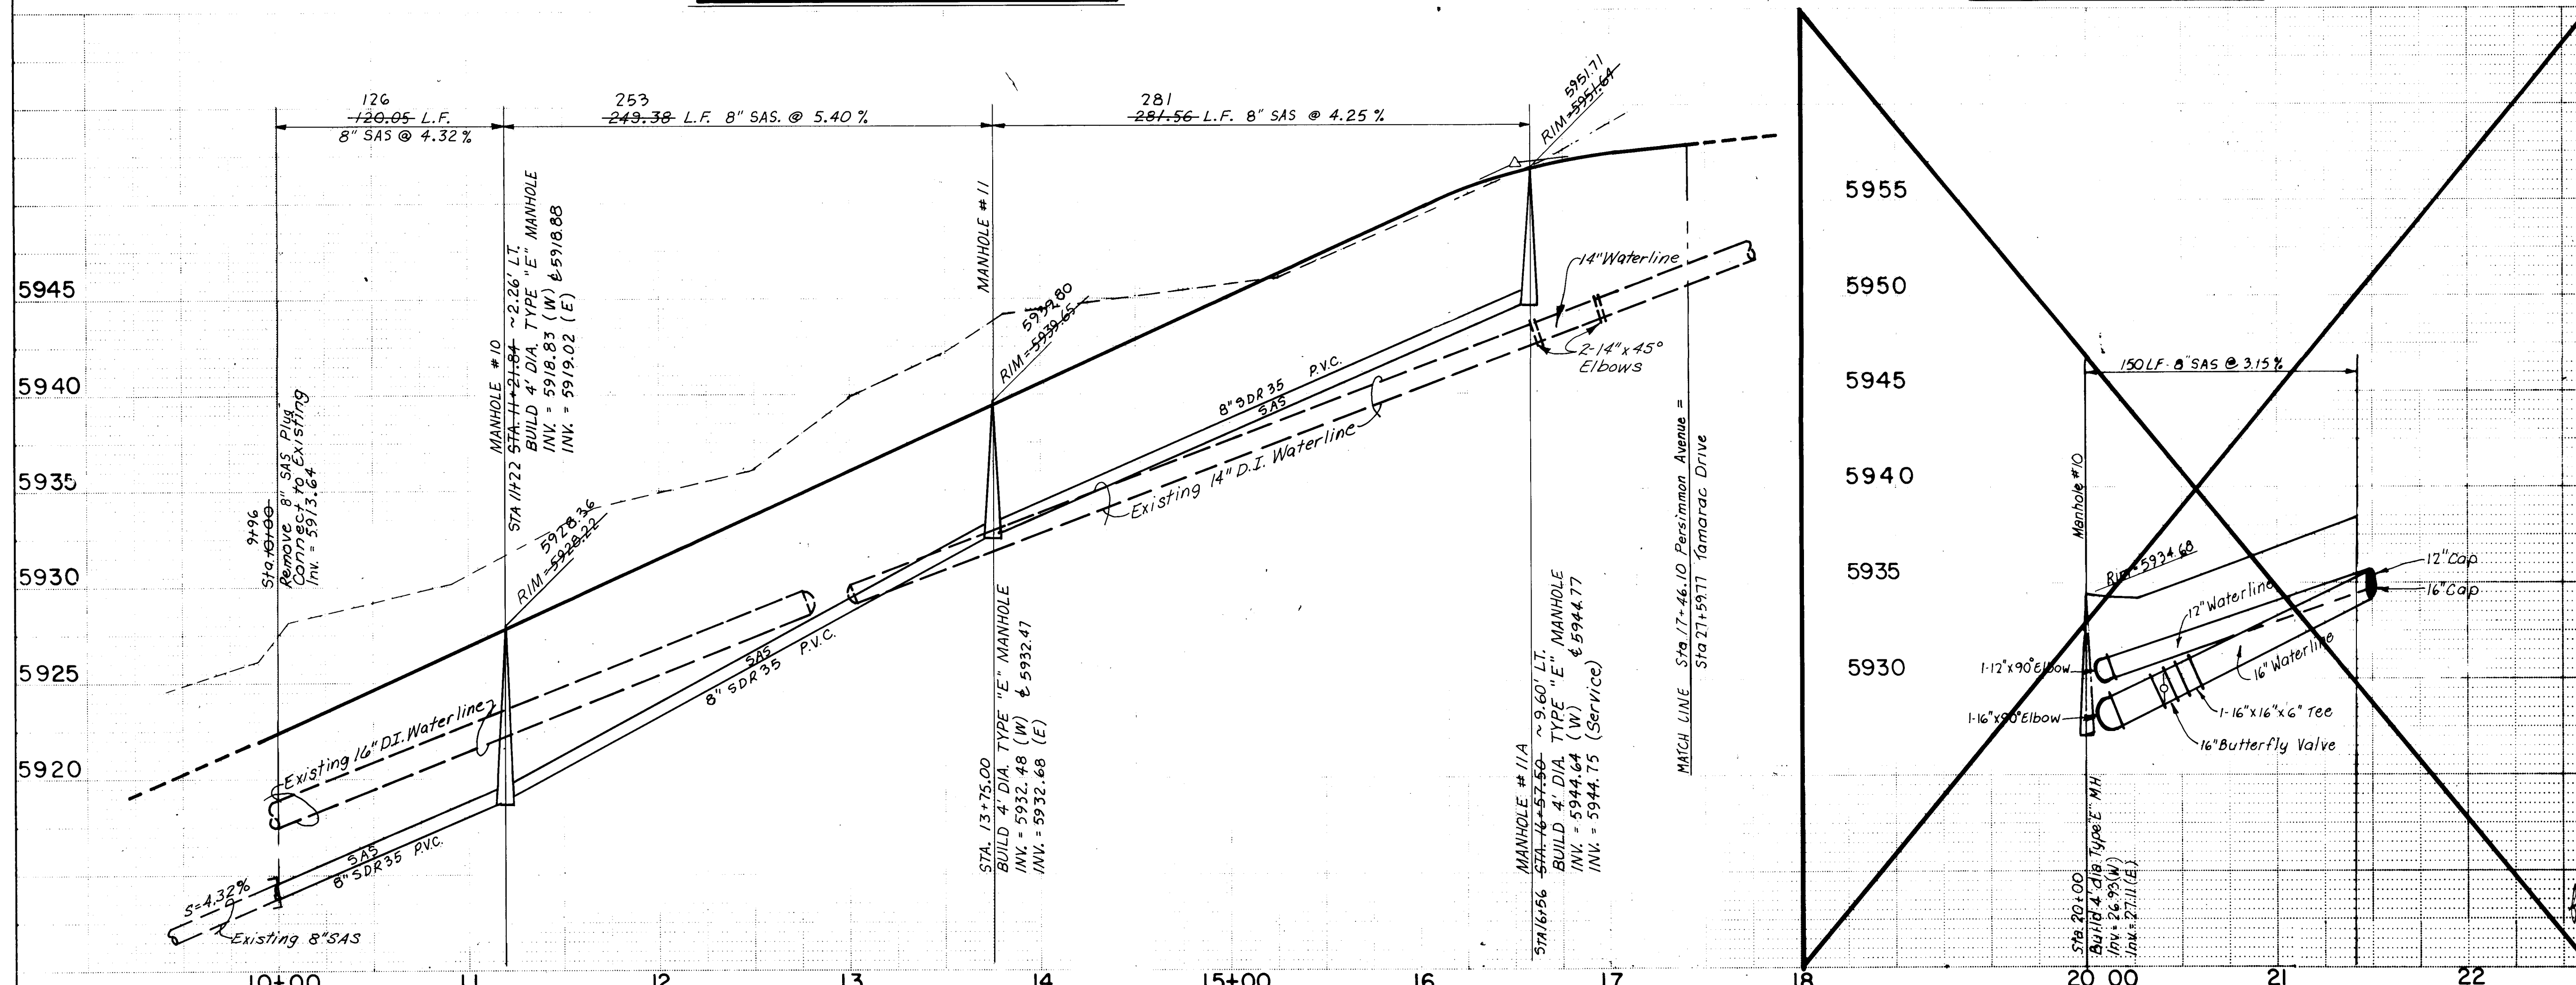

- NOTE:
- Sewer Service at Sta. 12+15.86 Distance P on Std. Dwg. 2125 Shall be Between 0.0' and 0.35'.
 - Sewer Service at Sta. 13+08.36 Distance P on Std. Dwg. 2125 Shall be 1.1'.

26 32641288

PEPPERTREE UNIT 2 PHASE 2


CITY OF ALBUQUERQUE
MUNICIPAL DEVELOPMENT DEPARTMENT
ENGINEERING DIVISION


TITLE: UTILITY PLAN & PROFILE
PERSIMMON AVENUE STA. 10+00 TO STA. 17+4561

APPROVALS	ENGINEER	DATE	APPROVALS	ENGINEER	DATE
City Engineer	<i>[Signature]</i>	9/17/87	Liquid Waste	<i>[Signature]</i>	9/16/87
A.C.E. - Design	<i>[Signature]</i>	"	Traffic	<i>[Signature]</i>	9/16/87
A.C.E. - Hydrology	<i>[Signature]</i>	9-17-87	Water	<i>[Signature]</i>	9/16/87

DRAWING NO.	3264	MAP NO.	E-22	SHEET	12	OF	15
-------------	------	---------	------	-------	----	----	----

AS BUILT INFORMATION		BENCH MARKS		SURVEY INFORMATION		ENGINEER'S SEAL		REVISIONS		DESIGNED BY		DRAWN BY		CHECKED BY		DATE	
CONTRACTOR	INTERVIEW LTD.	ACCA BENCH MARK 8-422 LOCATED FROM THE INTERSECTION OF EUBANK N.E. AND ACADEMY N.E. 1.2 MILES EAST ON ACADEMY, 575' SOUTH OF ACADEMY ON THE SOUTH END OF A SHALLOW ARROYO. A STANDARD ACCA BRASS TABLE STAMPED "8-422" IS SET IN THE TOP OF A CONCRETE POST, ELEVATION 5924.58	DATE	10/87	NO.	BY	DATE	NO.	DATE	NO.	DATE	NO.	DATE	NO.	DATE	NO.	DATE
INSPECTOR	E.B. JENSEN	DATE	10/87	NO.	BY	DATE	10/87	NO.	DATE	NO.	DATE	NO.	DATE	NO.	DATE	NO.	DATE
FIELD	DATE	DATE	DATE	DATE	DATE	DATE	DATE	DATE	DATE	DATE	DATE	DATE	DATE	DATE	DATE	DATE	DATE
RECORD BY	DATE	RECORD BY	DATE	RECORD BY	DATE	RECORD BY	DATE	RECORD BY	DATE	RECORD BY	DATE	RECORD BY	DATE	RECORD BY	DATE	RECORD BY	DATE

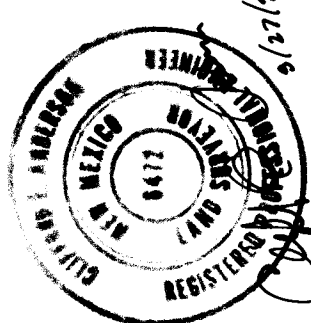


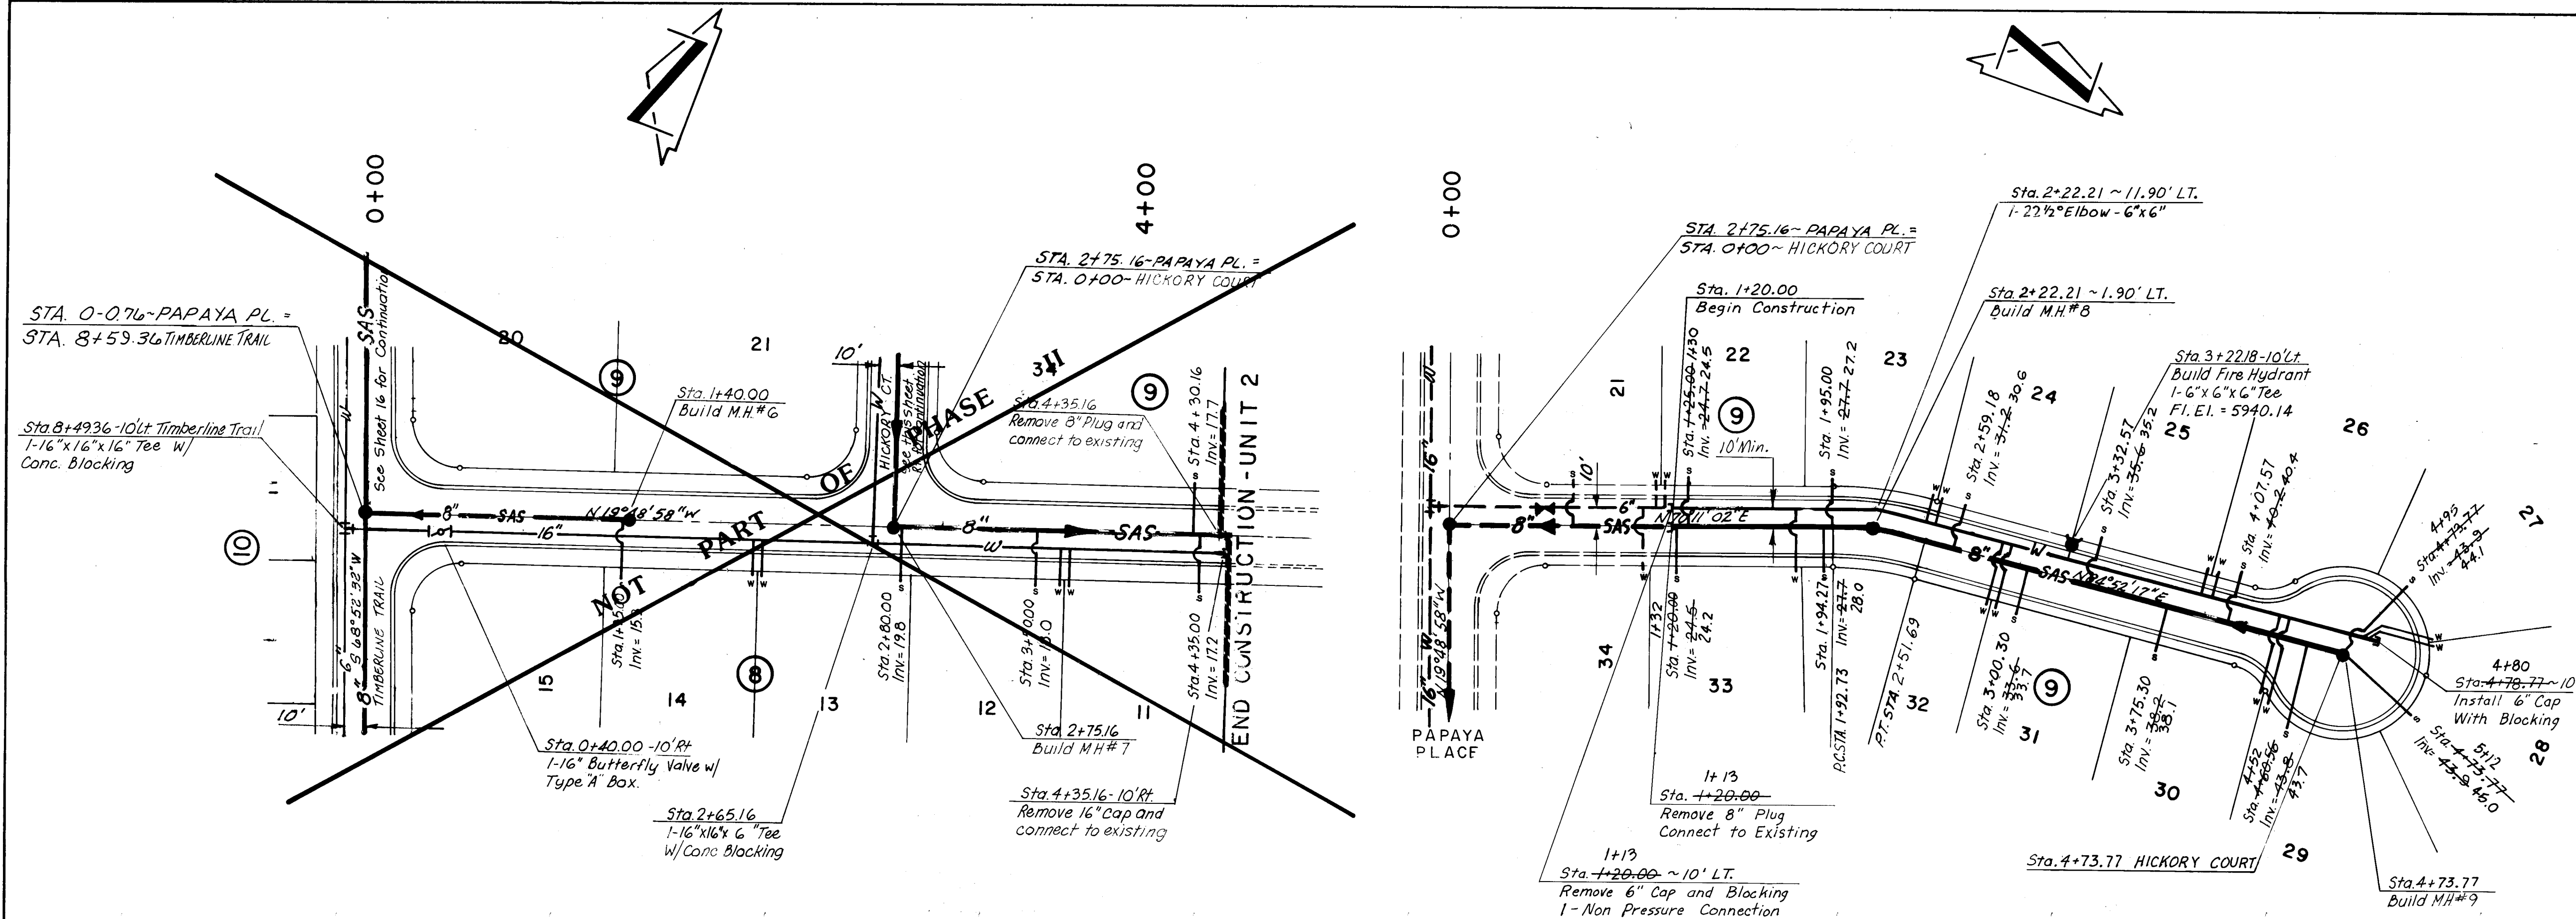

PAPAYA PLACE

HICKORY COURT

SCALE: 1" = 50' HORIZ.
1" = 5' VERT.

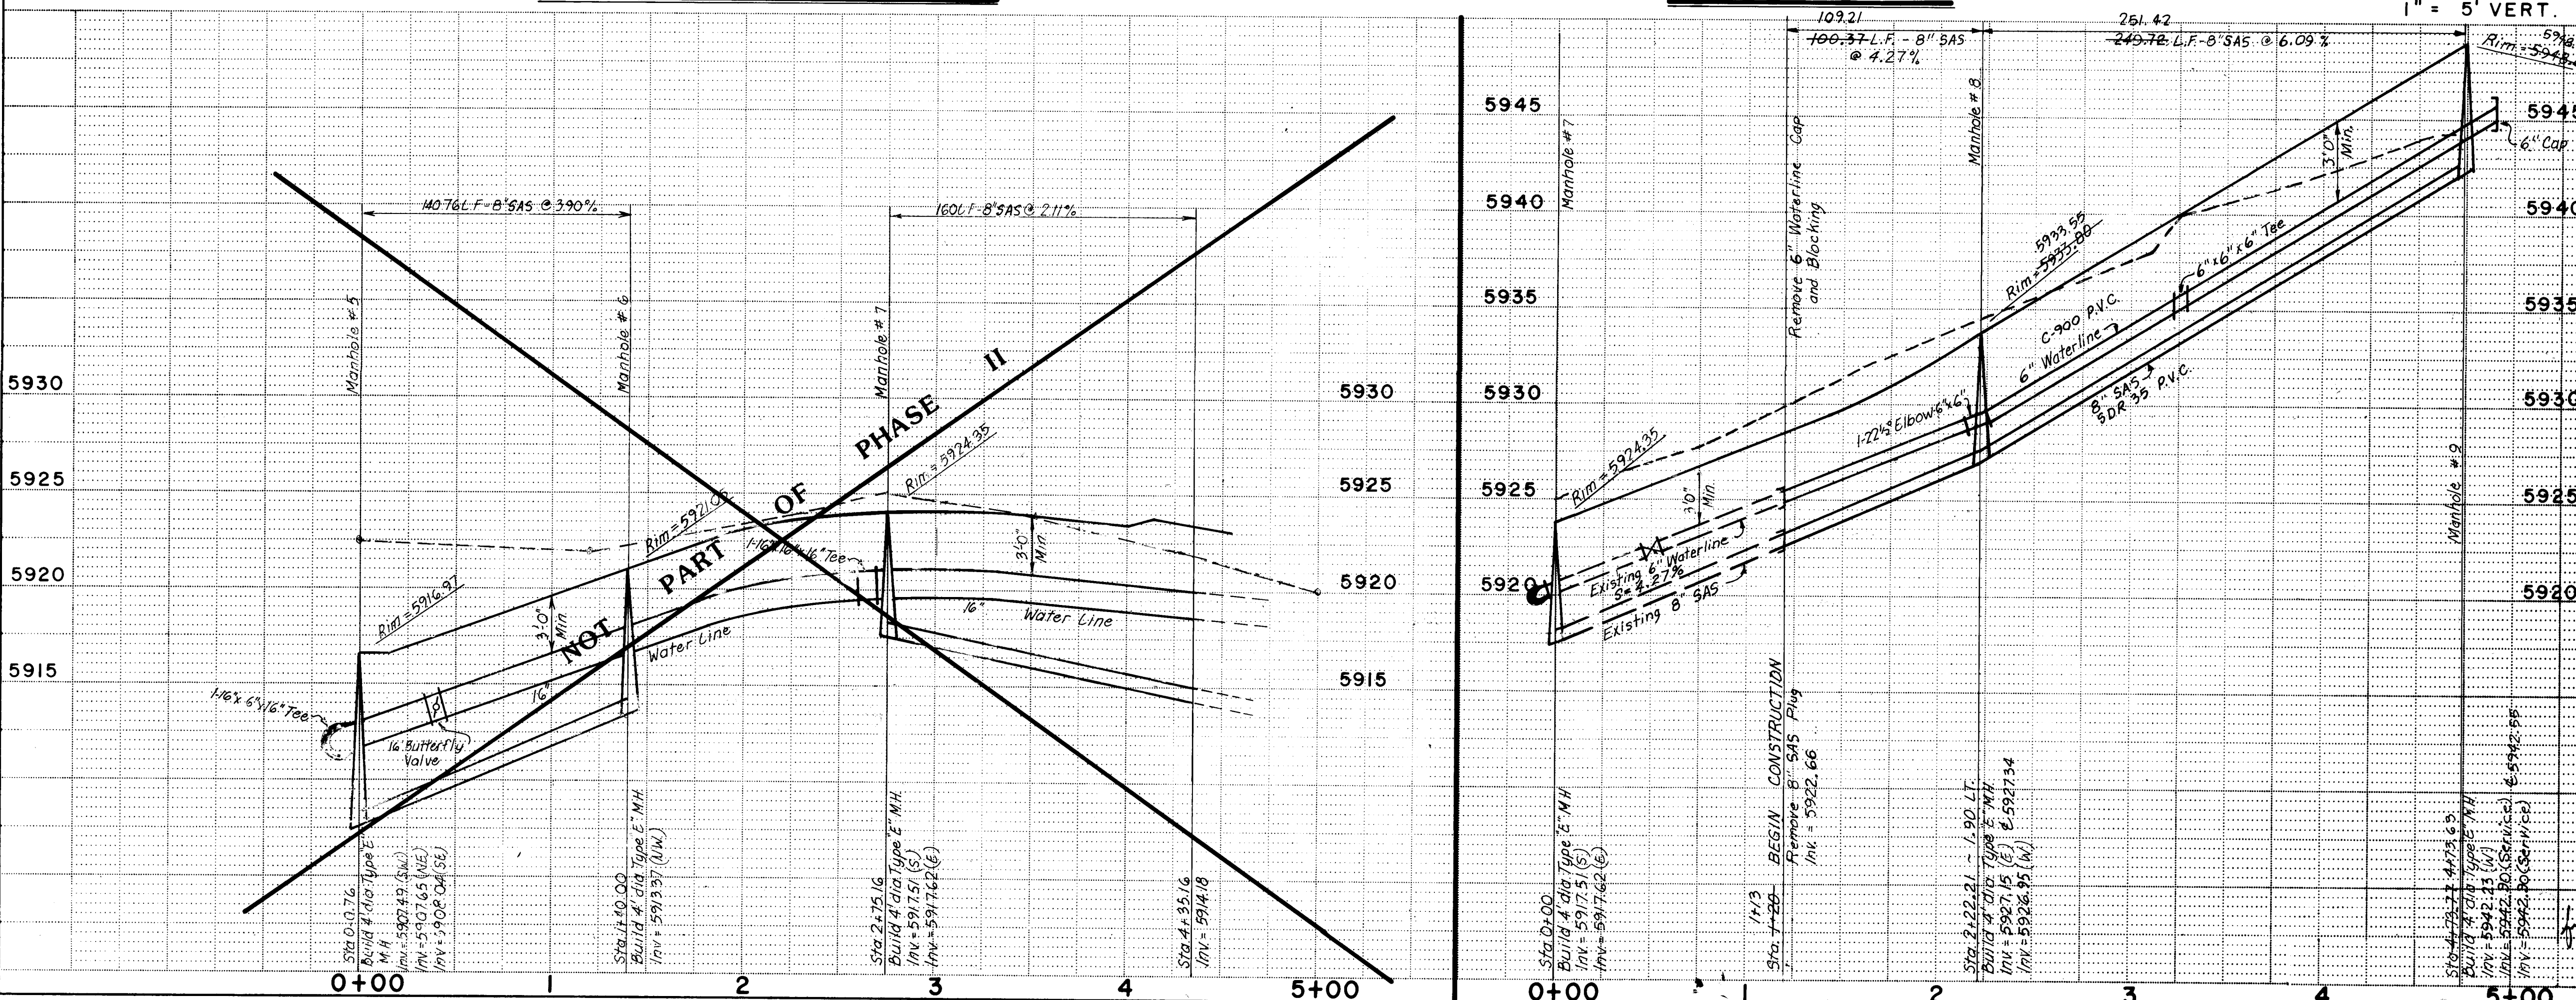

ENGINEER'S SEAL		SURVEY INFORMATION		BENCH MARKS		AS BUILT INFORMATION	
		NO.	DATE	NO.	DATE	NO.	DATE
REVISIONS		FIELD NOTES		CONTRACTOR INTERVIEW		CONTRACTOR INTERVIEW	
NO.	DATE	BY		A.C.S. BENCH MARK 6-E22 LOCATED FROM THE		CONTRACTOR INTERVIEW	
DESIGNED BY JKZ		DATE APRIL 1987		INTERSECTION OF EUBANK N.E. AND ACADEMY N.E.		CONTRACTOR INTERVIEW	
DRAWN BY SLL		DATE APRIL 1987		1.2 MILES EAST ON ACADEMY, 375' SOUTH OF		CONTRACTOR INTERVIEW	
CHECKED BY		DATE		ACADEMY ON THE SOUTH RIM OF A SHALLOW ARROYO.		CONTRACTOR INTERVIEW	
				A STANDARD A.C.S. BRASS TABLET STAMPED "E-22"		CONTRACTOR INTERVIEW	
				LS-4972 "SET IN THE TOP OF A CONCRETE POST,"		CONTRACTOR INTERVIEW	
				ELEVATION 5934.53		CONTRACTOR INTERVIEW	

26 32641388

PEPPERTREE UNIT 2 PHASE 2

CITY OF ALBUQUERQUE
MUNICIPAL DEVELOPMENT DEPARTMENT
ENGINEERING DIVISION

TITLE: UTILITY PLAN & PROFILE

HICKORY COURT

APPROVALS	ENGINEER	DATE	APPROVALS	ENGINEER	DATE
City Engineer	Adrian L.	9/12/87	Liquid Waste	W. J. J.	9/14/87
A.C.E. Design	" "	" "	Traffic	" "	9/14/87
A.C.E. Hydrology	CAM	9-4-87	Water	W. J. J.	9/14/87

DRAWING NO. 3264

MAP NO. E-22

SHEET 13 OF 15


SCANLON & ASSOCIATES

JOB NO. 87101

RECORD DRAWING

NOTE: INSTALL RESIDENTIAL WATER SERVICES
ON EXISTING 14" D.I. WATERLINE

SCALE: 1" = 50' HORIZ.
1" = 5' VERT.

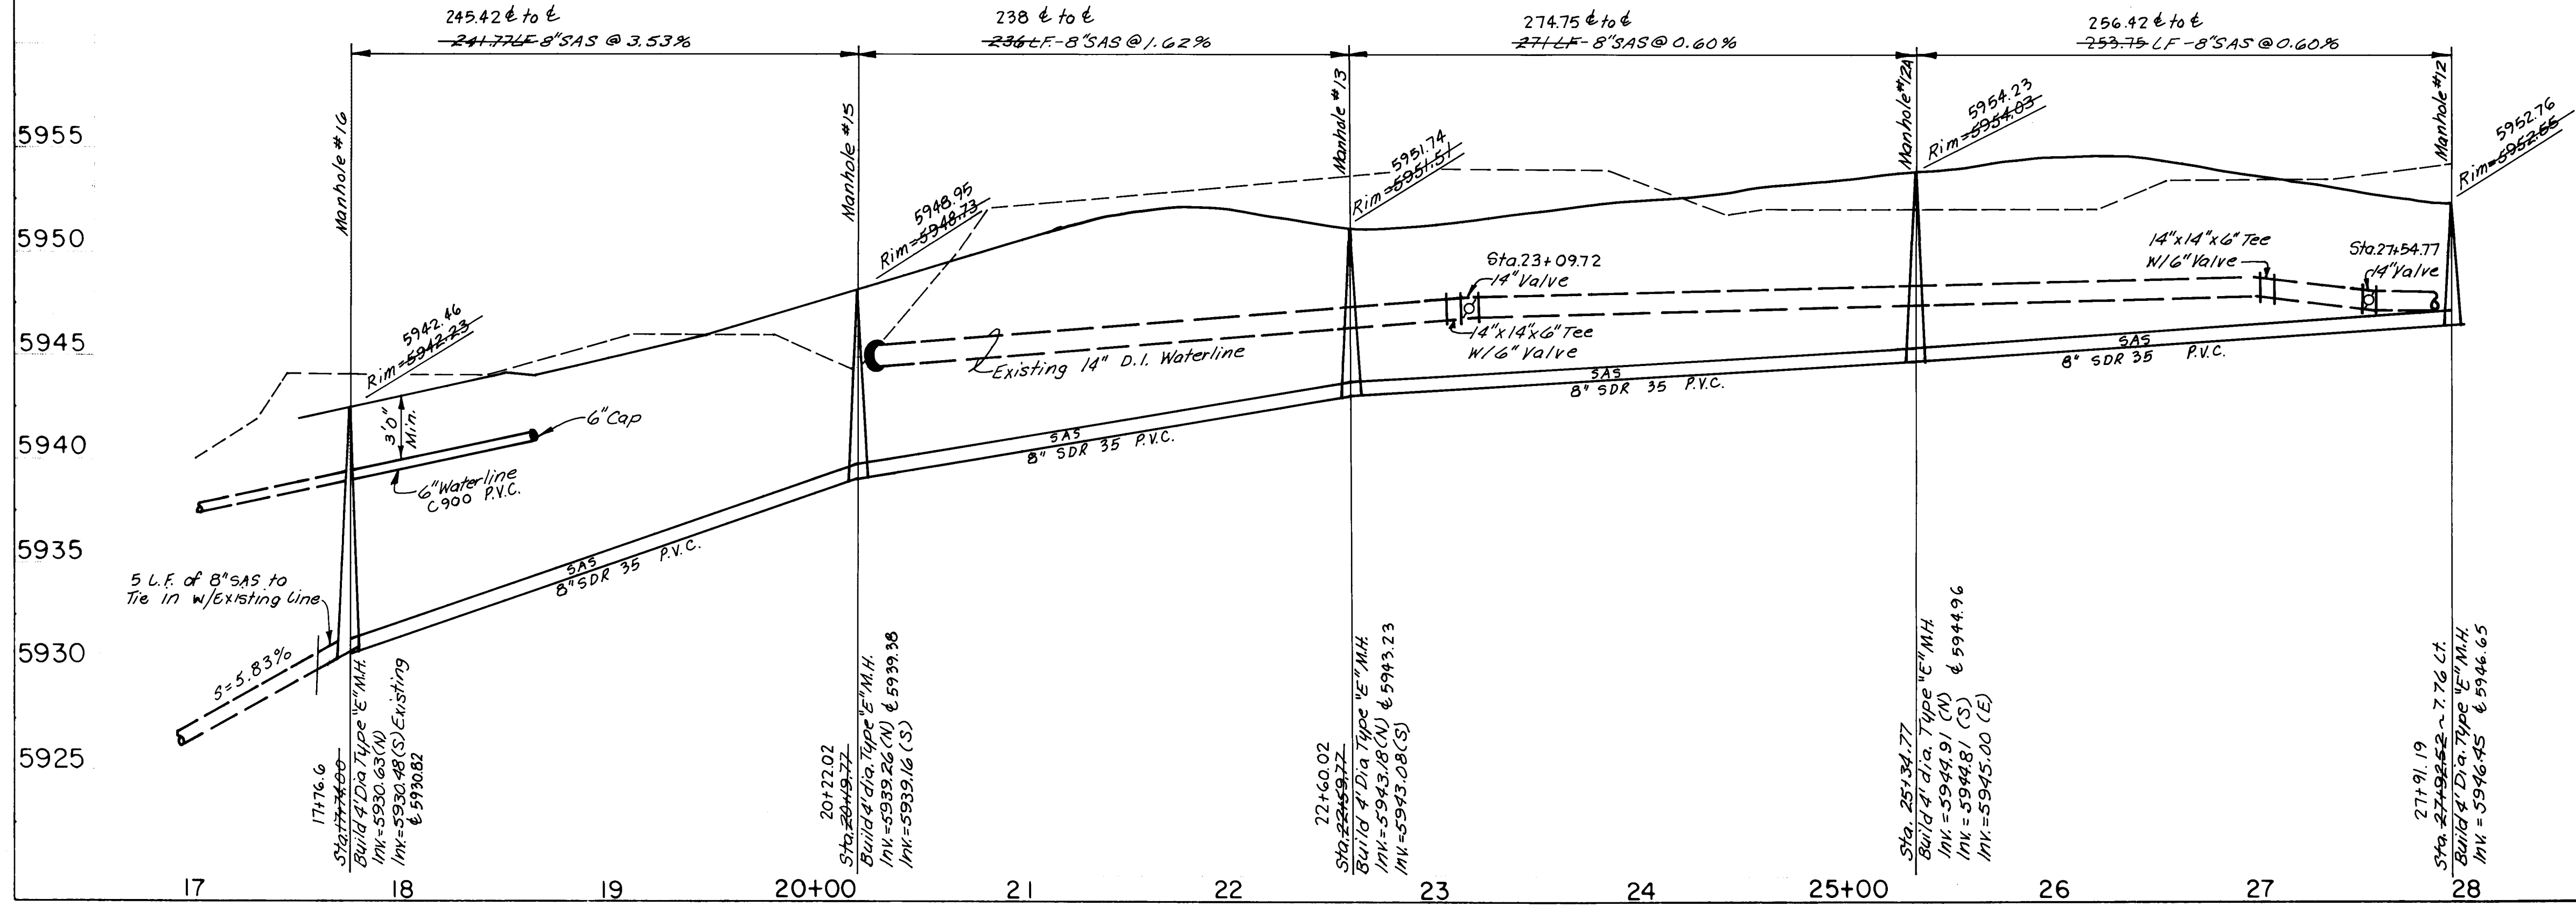

ENGINEER'S SEAL		SURVEY INFORMATION		BENCH MARKS		AS BUILT INFORMATION	
		FIELD NOTES					
		NO.	BY	DATE	A.C.S. BENCH MARK 6-E22 LOCATED FROM THE INTERSECTION OF EUBANK N.E. AND ACADEMY N.E.		
					12 MILES EAST ON ACADEMY, 375' SOUTH OF ACADEMY ON THE SOUTH RMN OF A SHALLOW ARROYO.		
					A STANDARD A.C.S. BRASS TABLET STAMPED "6-E22 LS-4972" SET IN THE TOP OF A CONCRETE POST, ELEVATION 5934.53		
REMARKS		BY					
DESIGN							
DESIGNED BY	JKZ	DATE		APRIL 1987			
DRAWN BY	SLL	DATE		APRIL 1987			
CHECKED BY		DATE					
PROFILE DEPARTMENT DIVISION							
APPROVALS		ENGINEER		DATE			
Waste							
		SHEET		OF			
		15		15			

