


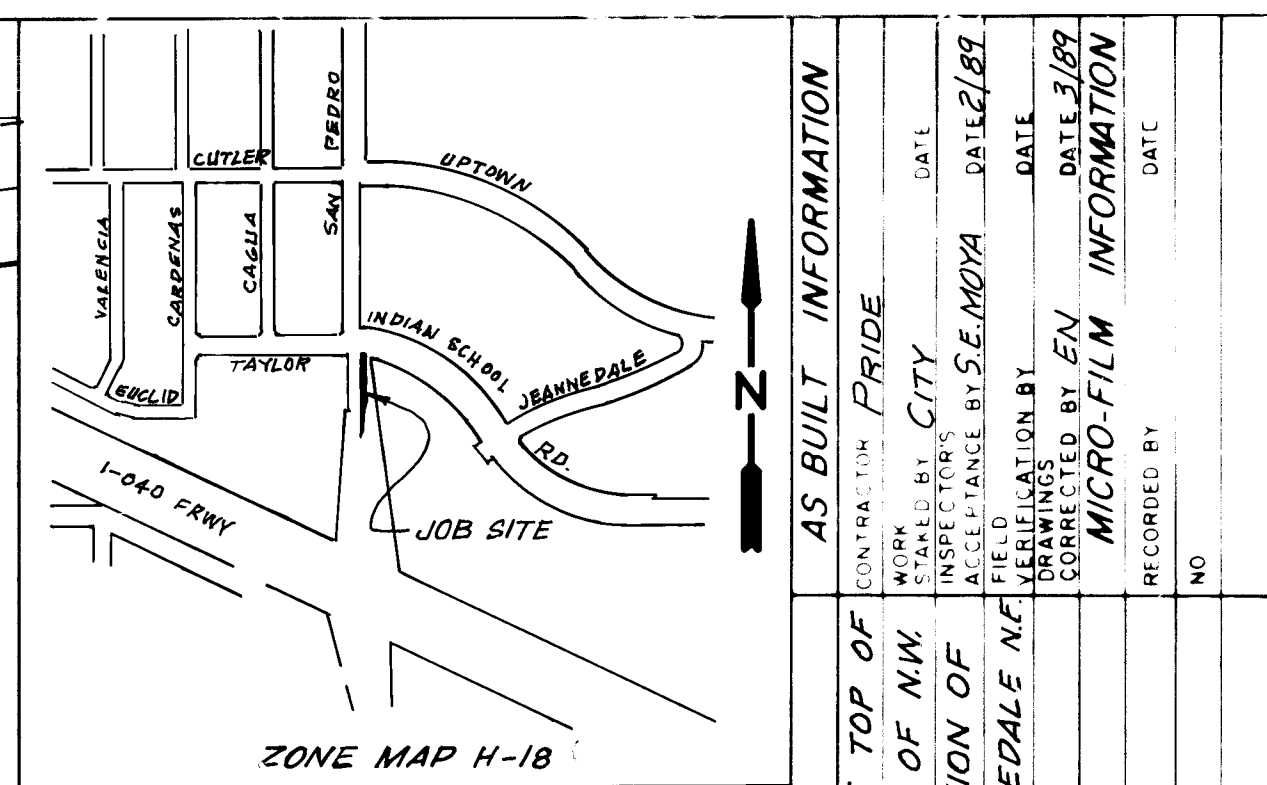

1. All work detailed on these plans to be performed under contract shall, except as otherwise stated or provided for hereon, be constructed in accordance with the City of Albuquerque Standard Specifications for Construction 1986.

2. Two (2) working days prior to any excavation, the contractor must contact Line Locating Service, 765-1234, for location of existing utilities.
3. Prior to construction, the contractor shall excavate and verify the horizontal and vertical locations of all obstructions. Should a conflict exist, the contractor shall notify the engineer or surveyor so that the conflict can be resolved with minimum amount of delay.

- ☒ All utilities and utility service lines shall be installed prior to paving.
- ☒ Backfill compaction shall be according to specified street use.
- ☒ Tack coat requirements shall be determined by the City Engineer.
- ☒ Sidewalks and wheelchair ramps within the curb returns shall be constructed wherever a new curb return is constructed.
- ☒ If curb is depressed for a driveway or a handicap ramp, the driveway or ramp shall be constructed prior to acceptance of the curb and gutter.
- ☒ All storm drainage facilities shall be completed prior to final acceptance.

1. CONTRACTOR MUST SUBMIT A CONSTRUCTION SIGNING AND BARRICADING PLAN TO TRAFFIC ENGINEERING DIVISION AND RECEIVE A BARRICADING PERMIT PRIOR TO CONSTRUCTION.
2. ALL CONSTRUCTION SIGNING AND BARRICADING TO COMPLY WITH MANUAL ON UNIFORM TRAFFIC CONTROL DEVICES, 1978 EDITION AND SUBSEQUENT REVISIONS.
3. CONTRACTOR'S OPERATION, BARRICADING AND SIGNING SHALL NOT AFFECT THRU LANES OF SAN PEDRO BETWEEN 7 AM AND 9 AM OR 4 PM AND 6 PM.

NEW ARTERIAL PAVING

EXISTING CURB & GUTTER

NEW STD. CURB & GUTTER

CITY STD. DWG. 2441
NEW HANDICAPPED RAMP
CASE 1

NEW CURB ELEVATIONS

T.C. 39.56
F.E. 38.89

T.S.

TRAFFIC SIGNAL INTERCONNECT CONDUIT

3/25/89

TITLE: INTERSECTION WIDENING SOUTH FROM INDIAN SCHOOL			
APPROVALS	ENGINEER	DATE	APPROVALS
City Engineer	<i>Amelia H. H. H.</i>	6/2/81	Liquid W
A C E - Design	" "	" "	Traffic
A C E - Hydrology	" "	" "	Water

DRAWING NO.	3268	MAP NO.	H-18
-------------	------	---------	------

