

LEGEND

MATERIALS

CONCRETE
RIP-RAP

LINES

RIGHT-OF-WAY
PROPERTY LINE (PLAN)
RIGHT-OF-WAY (SECTION)
CENTERLINE
EASEMENT LINE
MATCHLINE
SECTION CUT LINE

EARTHWORK

CONTOUR LINE
SPOT ELEVATION
PROJECT/PHASE
BOUNDARY
SWALE/DIRECT. OF FLOW

MISCELLANEOUS UTILITIES

GAS LINE
UNDERGROUND TELEPHONE
UNDERGROUND ELECTRICAL
STORM DRAIN
STORM DRAIN MANHOLE
STORM DRAIN INLET

SANITARY SEWER (SAS)

SANITARY LINE
SANITARY MANHOLE
SERVICE CONNECTIONS
CAP OR PLUG
ENCASEMENT

WATER

CAPS AND PLUGS
SERVICE CONNECTIONS
GATE VALVE
FIRE HYDRANT
BUTTERFLY VALVE
REDUCER
PRESSURE ZONE BOUNDARY
ELBOW
CROSS
TEE

MISCELLANEOUS

EDGE OF ASPHALT
FIELD FENCE
CHAINLINK FENCE
YARD/BLOCK WALL
RETAINING WALL
POWER OR TELE. POLE
TREE
TRAFFIC SIGN

MORRIS STREET
RECONSTRUCTION
NORTH OF
CANDELARIA RD., NE.

INDEX OF DRAWINGS

SHEET NO.

1

2


3

SHEET DESCRIPTION

TITLE SHEET

PLAN & PROFILE
430' NORTH OF
CANDELARIA ROAD NE.

DETAILS AND SECTIONS

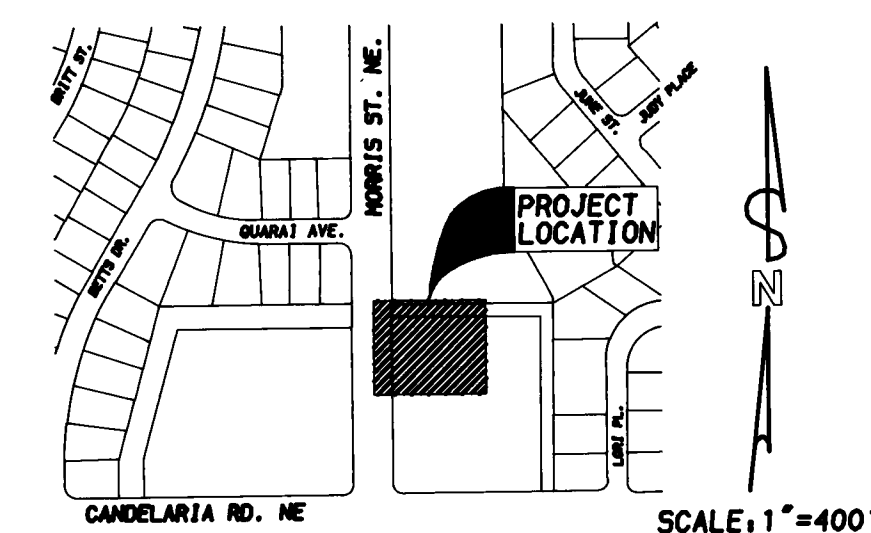


VICINITY MAP

ZONE ATLAS G-21


GENERAL NOTES:

- ALL WORK DETAILED ON THESE PLANS TO BE PERFORMED UNDER CONTRACT SHALL EXCEPT AS OTHERWISE STATED OR PROVIDED FOR HEREON, BE CONSTRUCTED IN ACCORDANCE WITH THE CITY OF ALBUQUERQUE STANDARD SPECIFICATIONS - PUBLIC WORKS CONSTRUCTION - 1986.
- TWO (2) WORKING DAYS PRIOR TO ANY EXCAVATION, CONTRACTOR MUST CONTACT LINE LOCATING SERVICE, 765-1234, FOR LOCATION OF EXISTING UTILITIES.
- CONTRACTOR SHALL NOTIFY THE ENGINEER NOT LESS THAN SEVEN (7) DAYS PRIOR TO STARTING WORK IN ORDER THAT THE ENGINEER MAY TAKE NECESSARY MEASURES TO INSURE THE PRESERVATION OF SURVEY MONUMENTS. CONTRACTOR SHALL NOT DISTURB PERMANENT SURVEY MONUMENTS WITHOUT THE CONSENT OF THE ENGINEER AND SHALL NOTIFY THE ENGINEER AND BEAR THE EXPENSE OF REPLACING ANY THAT MAY BE DISTURBED WITHOUT PERMISSION. REPLACEMENT SHALL BE DONE ONLY BY THE ENGINEER. WHEN A CHANGE IS MADE IN THE FINISHED ELEVATION OF THE PAVEMENT OF ANY ROADWAY IN WHICH A PERMANENT SURVEY MONUMENT IS LOCATED, CONTRACTOR SHALL, AT HIS OWN EXPENSE, ADJUST THE MONUMENT COVER TO THE NEW GRADE UNLESS OTHERWISE SPECIFIED.
- SHOULD A CONFLICT EXIST BETWEEN THESE PLANS AND ACTUAL FIELD CONDITIONS, THE CONTRACTOR SHALL PROMPTLY NOTIFY THE ENGINEER IN WRITING SO THAT THE CONFLICT CAN BE RESOLVED WITH A MINIMUM AMOUNT OF DELAY FOR ALL PARTIES.
- THE CONTRACTOR SHALL MAINTAIN ACCESS TO ADJACENT PROPERTIES DURING CONSTRUCTION.
- ALL WORK ON THIS PROJECT SHALL BE PERFORMED IN ACCORDANCE WITH APPLICABLE FEDERAL, STATE AND LOCAL LAWS, RULES AND REGULATIONS CONCERNING CONSTRUCTION SAFETY AND HEALTH.
- THE CONTRACTOR MUST SUBMIT A CONSTRUCTION SIGNING AND BARRICADING PLAN TO TRAFFIC ENGINEERING TO RECEIVE A BARRICADING PERMIT 48 HOURS PRIOR TO CONSTRUCTION.
- ALL UTILITIES AND UTILITY SERVICE LINES SHALL BE INSTALLED PRIOR TO PAVING.
- BACKFILL COMPACTION SHALL BE ACCORDING TO SPECIFIED STREET USE.
- TACK COAT REQUIREMENTS SHALL BE DETERMINED BY THE CITY ENGINEER.
- SIDEWALKS AND WHEELCHAIR RAMP WITHIN THE CURB RETURNS SHALL BE CONSTRUCTED WHEREVER A NEW CURB RETURN IS CONSTRUCTED.
- IF CURB IS DEPRESSED FOR A DRIVEPAD OR A HANDICAP RAMP, THE DRIVEPAD OR RAMP SHALL BE CONSTRUCTED PRIOR TO ACCEPTANCE OF THE CURB AND GUTTER.
- ALL STORM DRAINAGE FACILITIES SHALL BE COMPLETED PRIOR TO FINAL ACCEPTANCE.
- ALL STATIONING SHALL BE BASED ON CONSTRUCTION CENTERLINE.

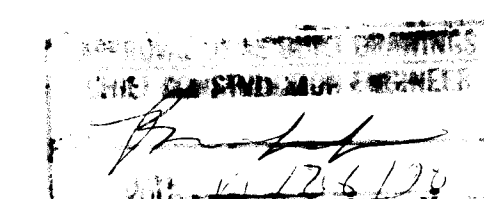

26 3282.0190

DRAWING NO. 3282		MAP NO. G-21	APPROVED FOR CONSTRUCTION CITY ENGINEER 3-6-90	
			SHEET NO.	OF 1 3

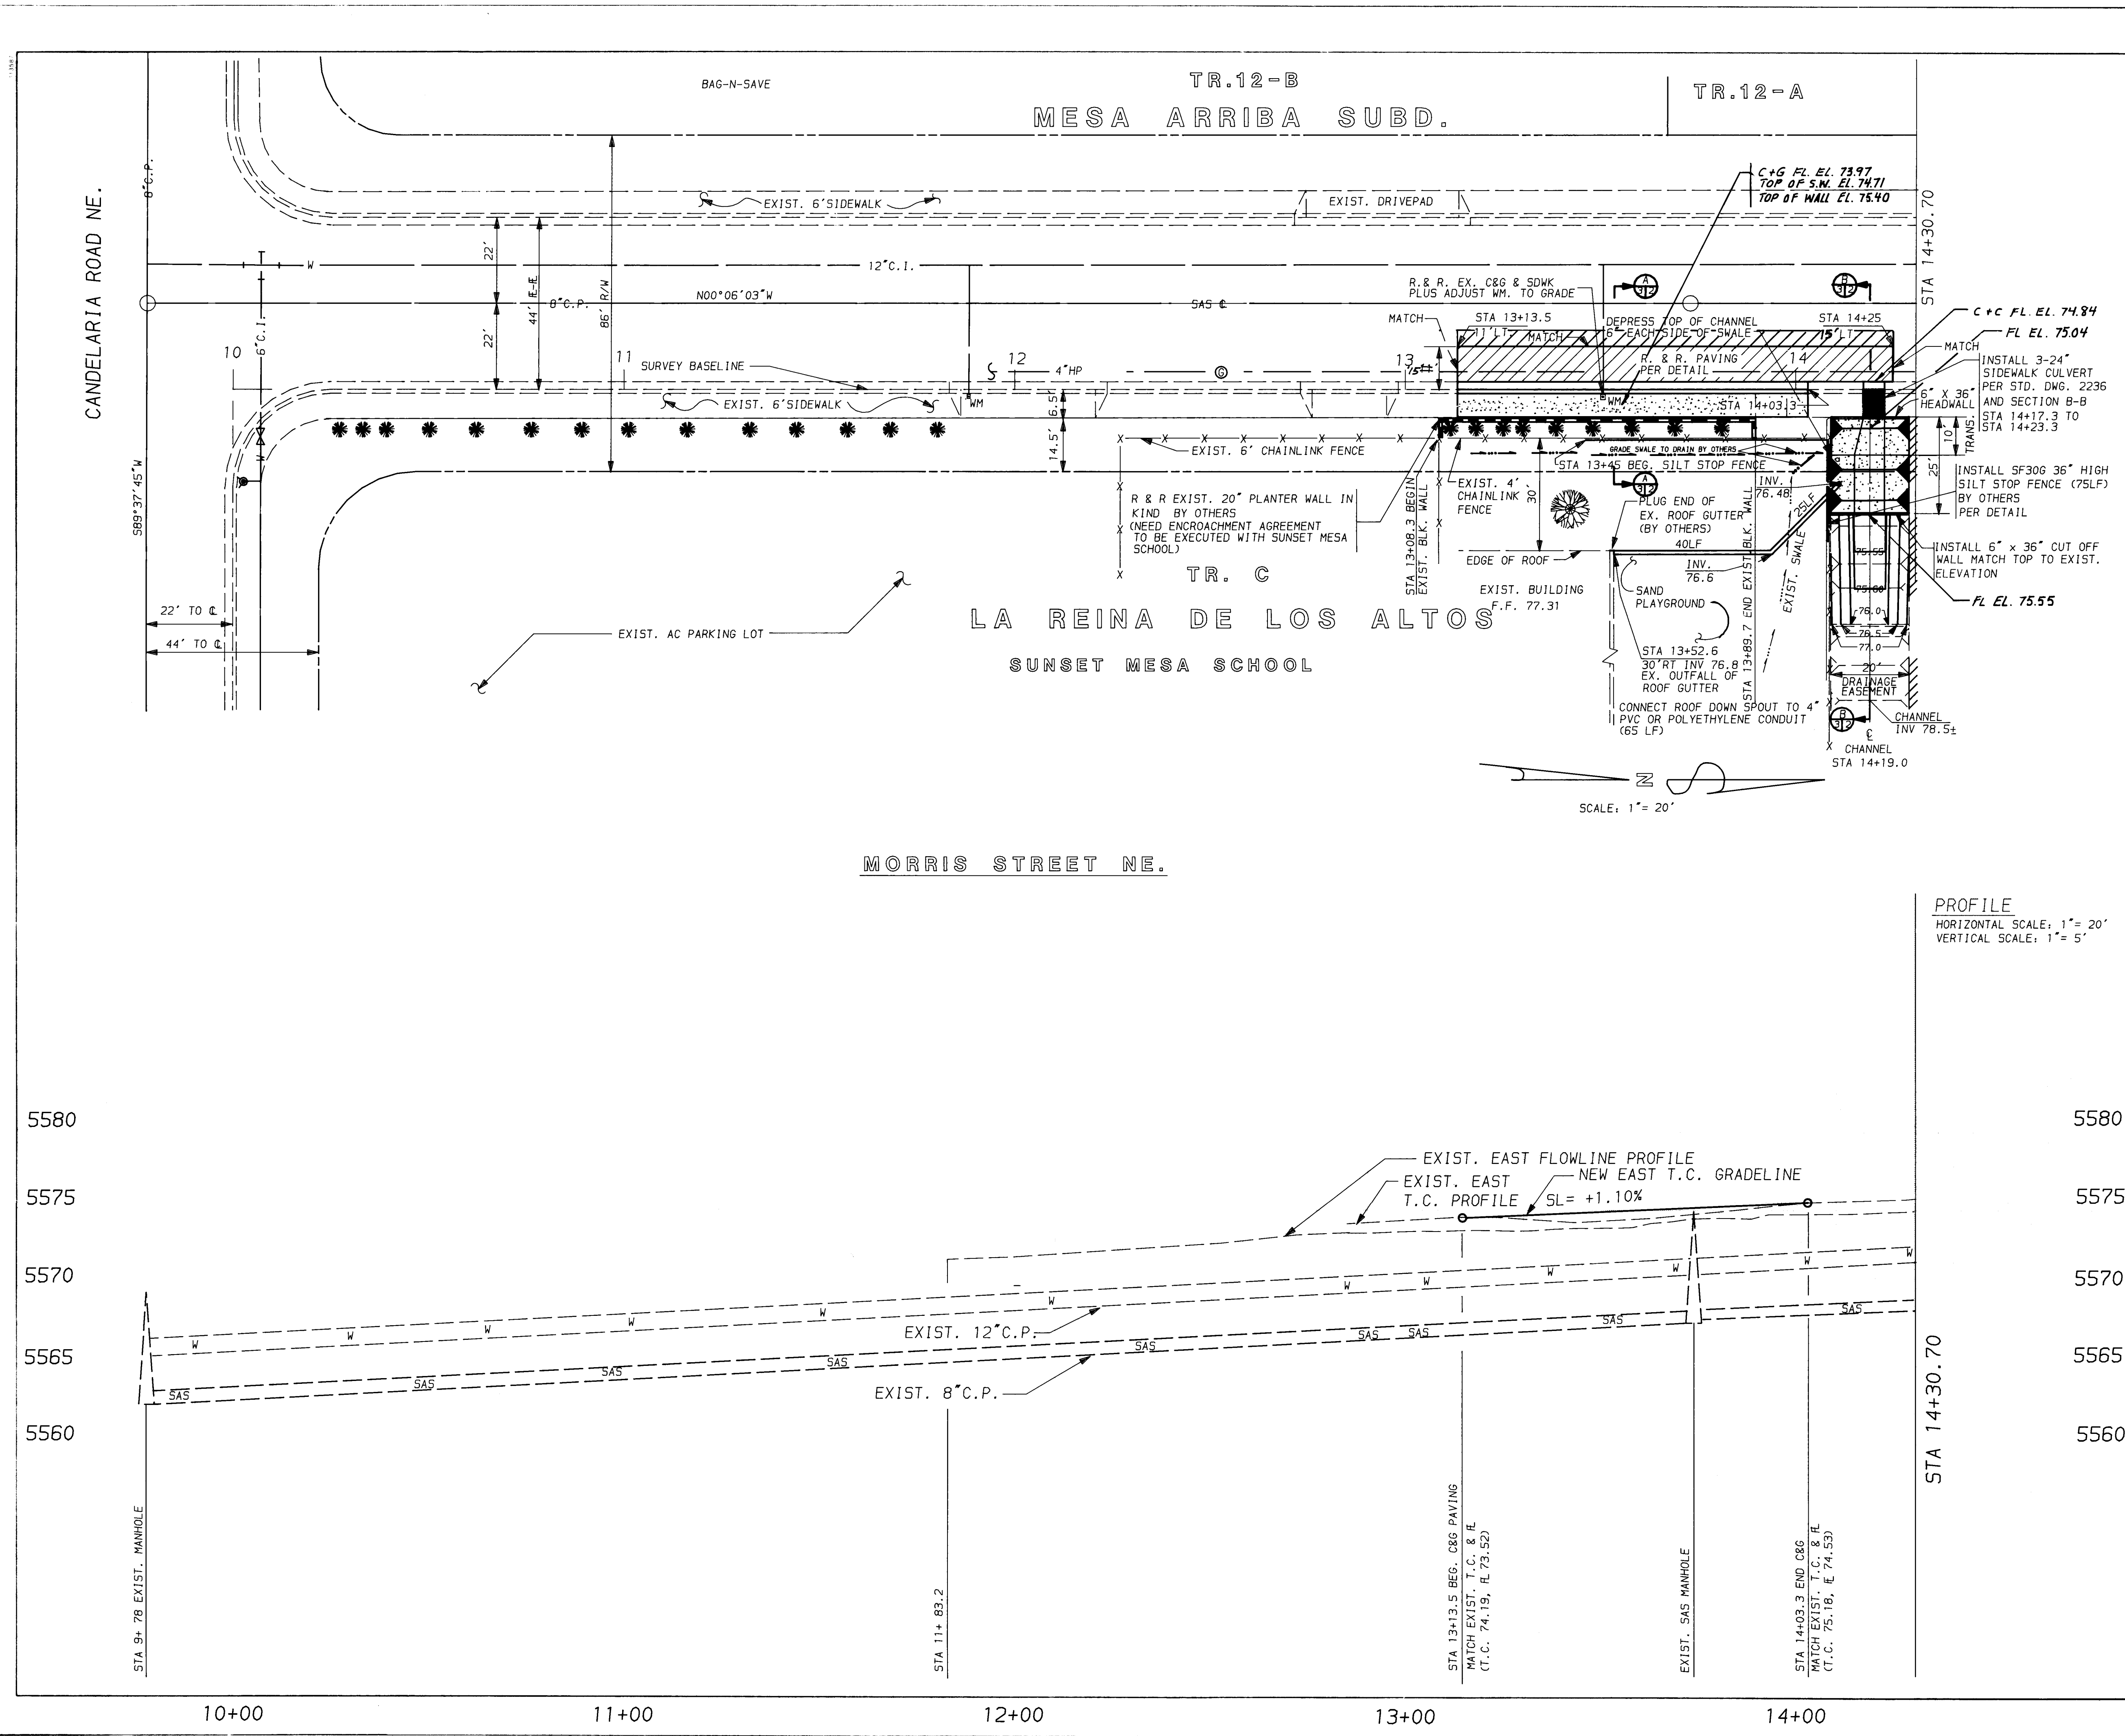

LEGEND

- TRAFFIC SIGN
- P.P.
- TELEPHONE BOX
- WATER METER
- CHAINLINK FENCE
- WOOD FENCE
- P.P./GUYWIRE
- FIRE HYDRANT
- EXIST. EDGE OF PAVEMENT
- EXIST. 2"MP GAS LINE
- EXIST. WATER VALVE
- EXIST. MANHOLE
- DIRECTION OF FLOW

PROFILE

HORIZONTAL SCALE: 1"= 20'

VERTICAL SCALE: 1"= 5'








NO.	DATE	REVISIONS	BY
1	6/2/87	DESIGN	R. PANG
		DESIGN	A. J. OLIVAS SR.
		CHECKED BY	

CITY OF ALBUQUERQUE
PUBLIC WORKS DEPARTMENT
ENGINEERING GROUP

TITLE MORRIS ST. RECONSTRUCTION NORTH OF
CANDELARIA ROAD, NE.-PLAN & PROFILE

APPROVALS	ENGINEER	DATE	APPROVALS	ENGINEER	DATE
D.R.C. Chair	R. PANG	10-3-89			
Trans. Dev.	R. PANG	9-25-89			
Utility Dev.	R. W. KANE	9-25-89			

DRAWING NO. 3282 MAP NO. 6-21 SHEET 2 OF 3

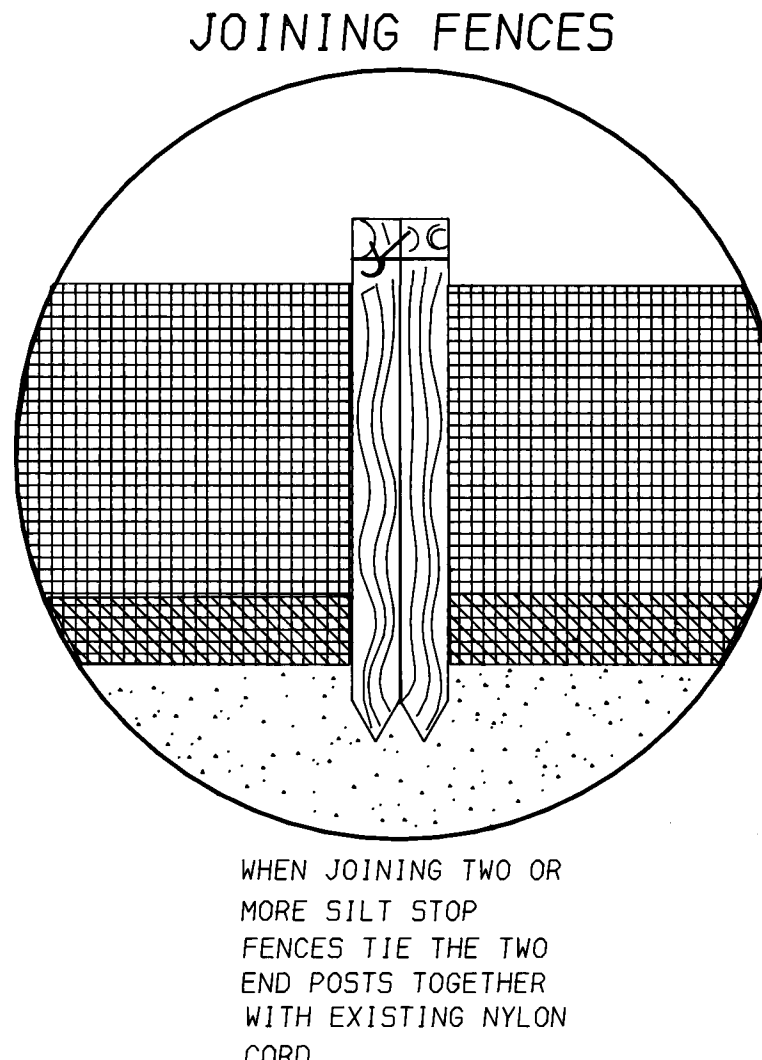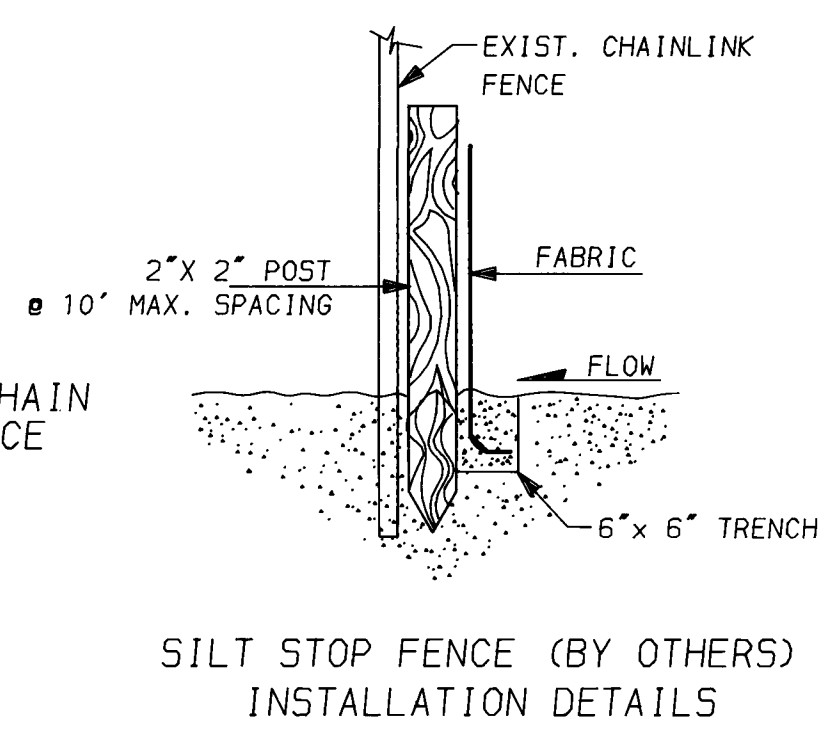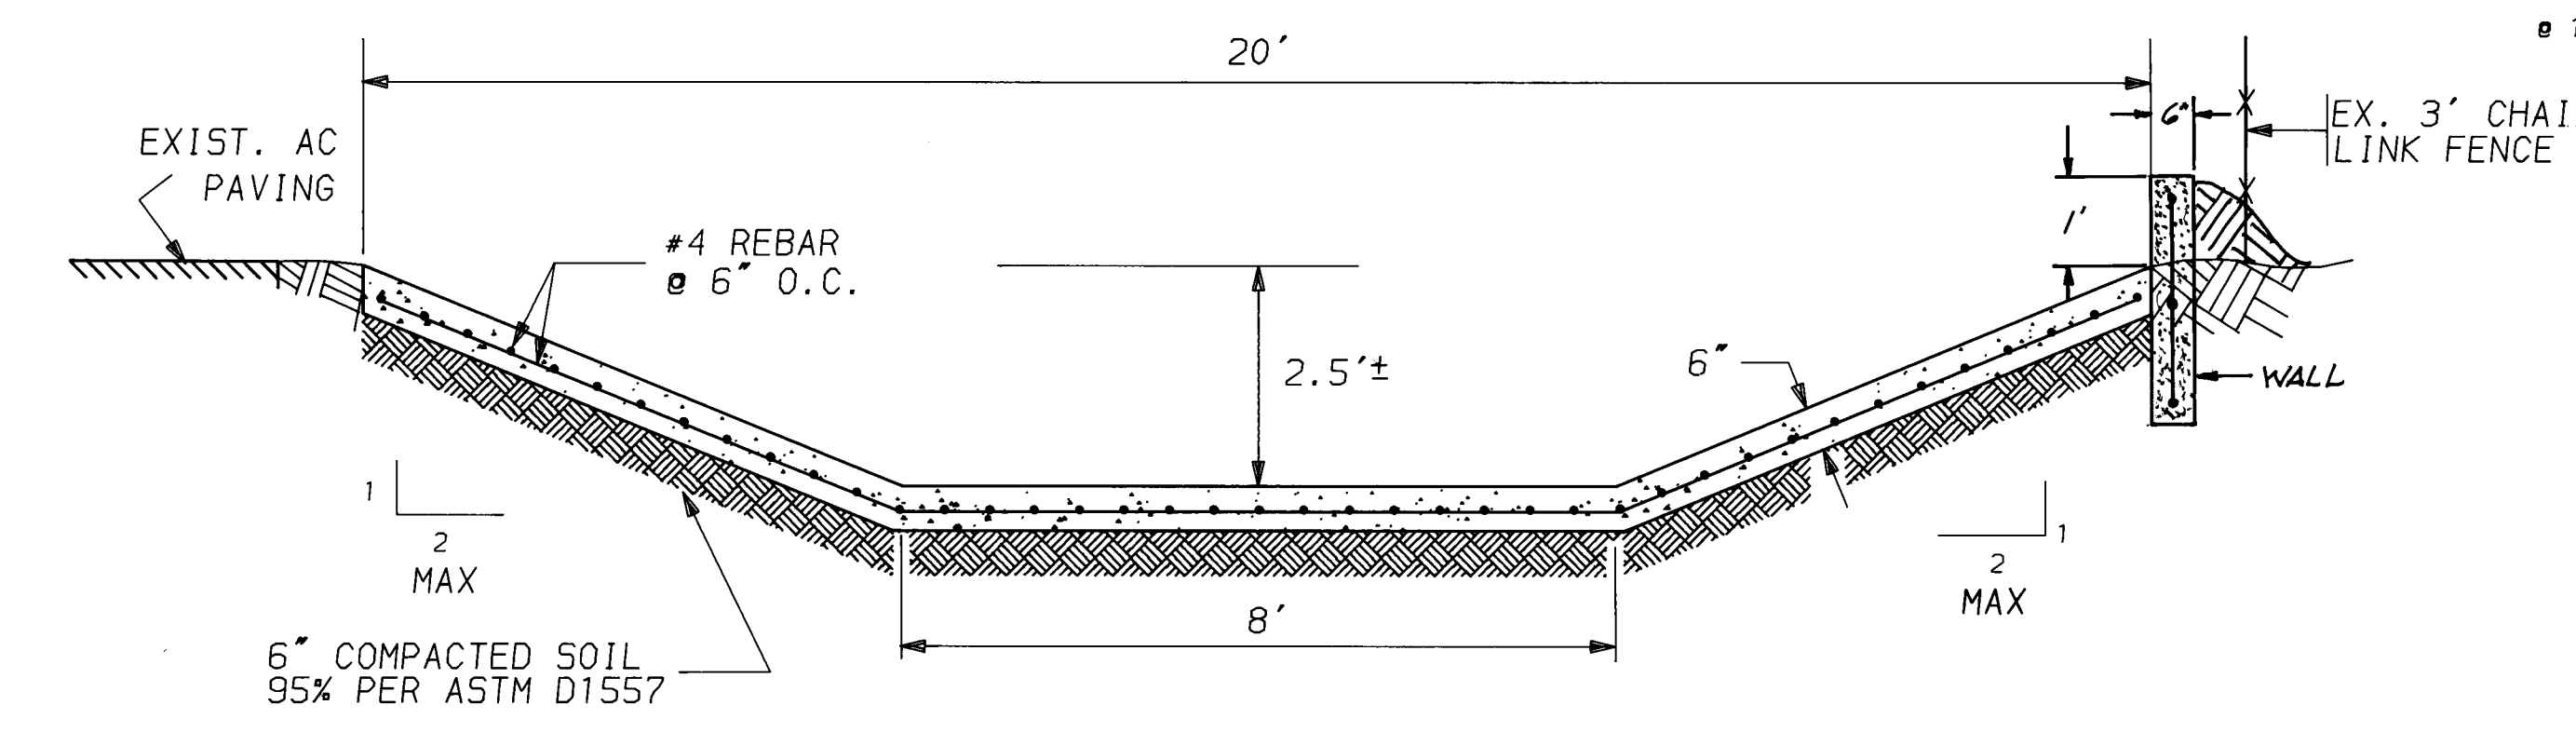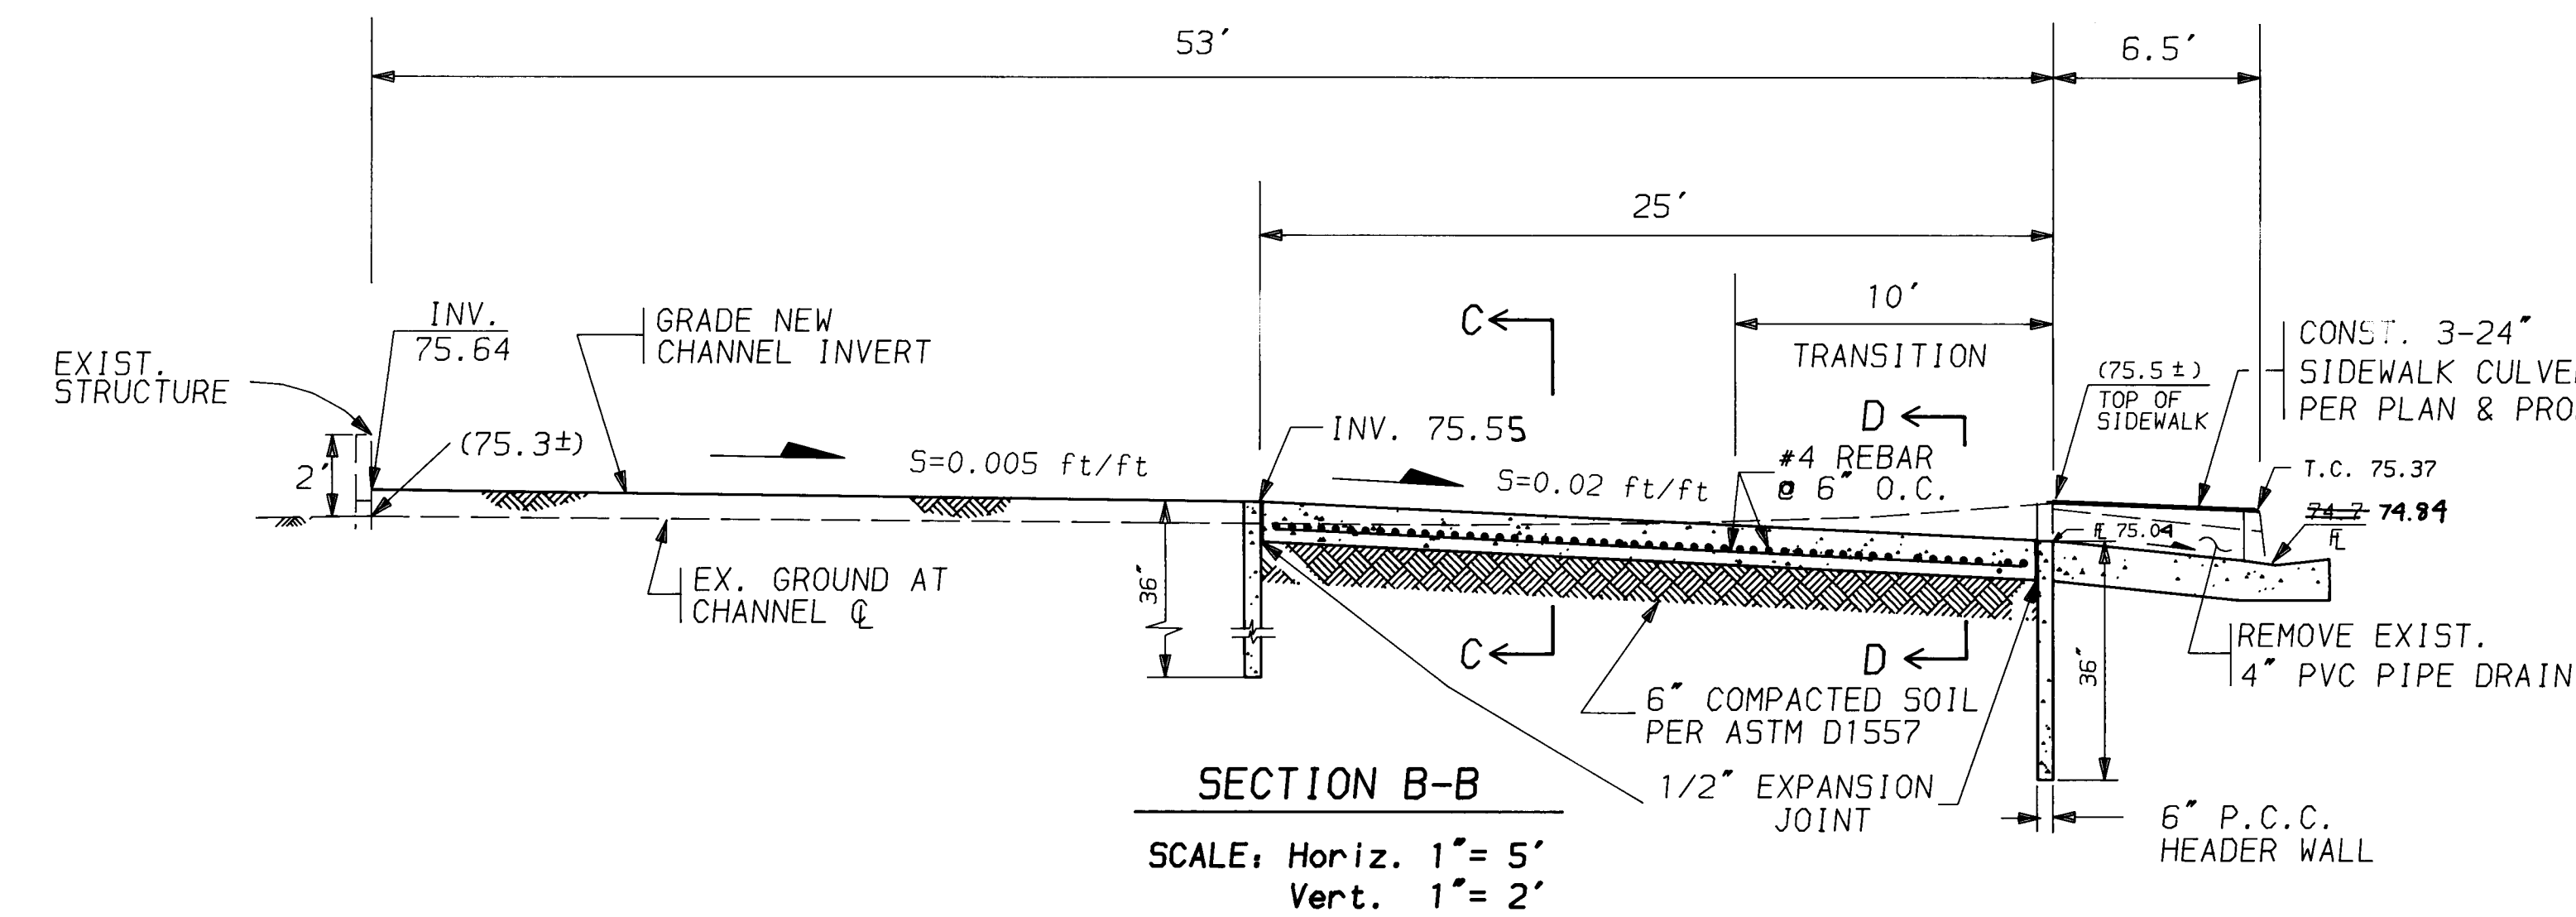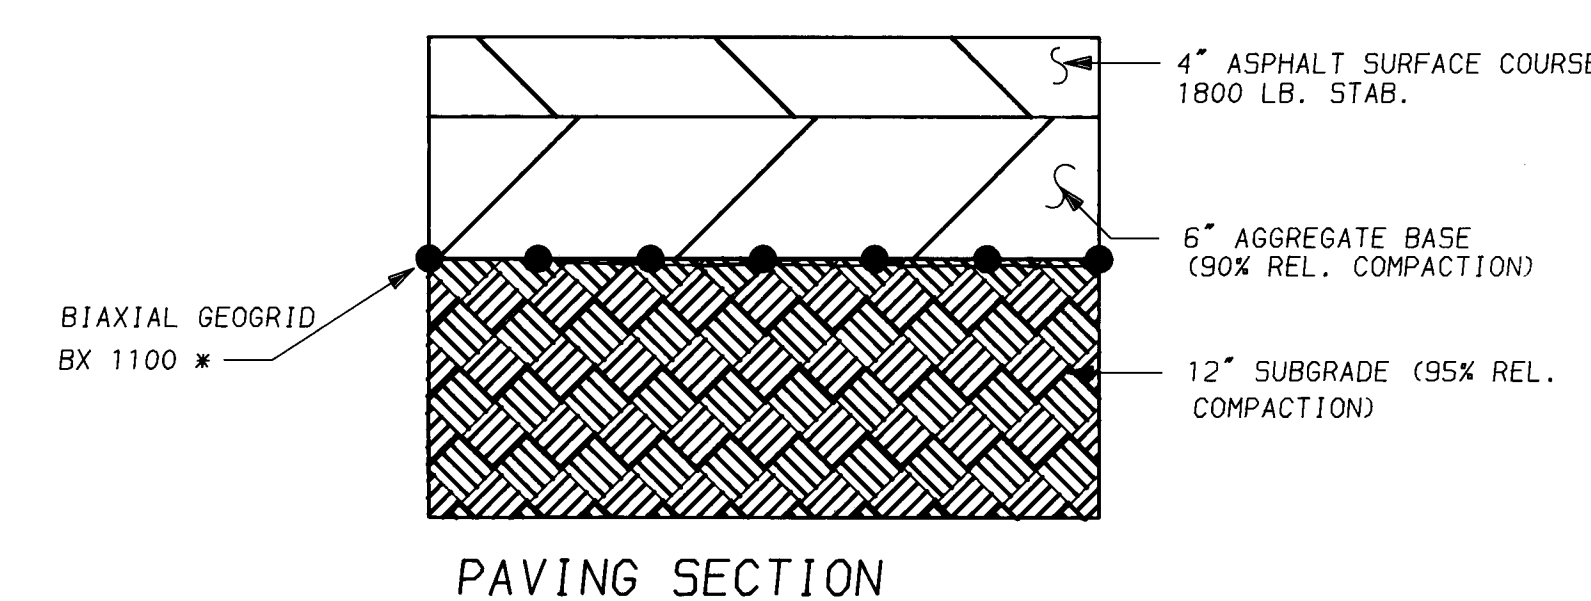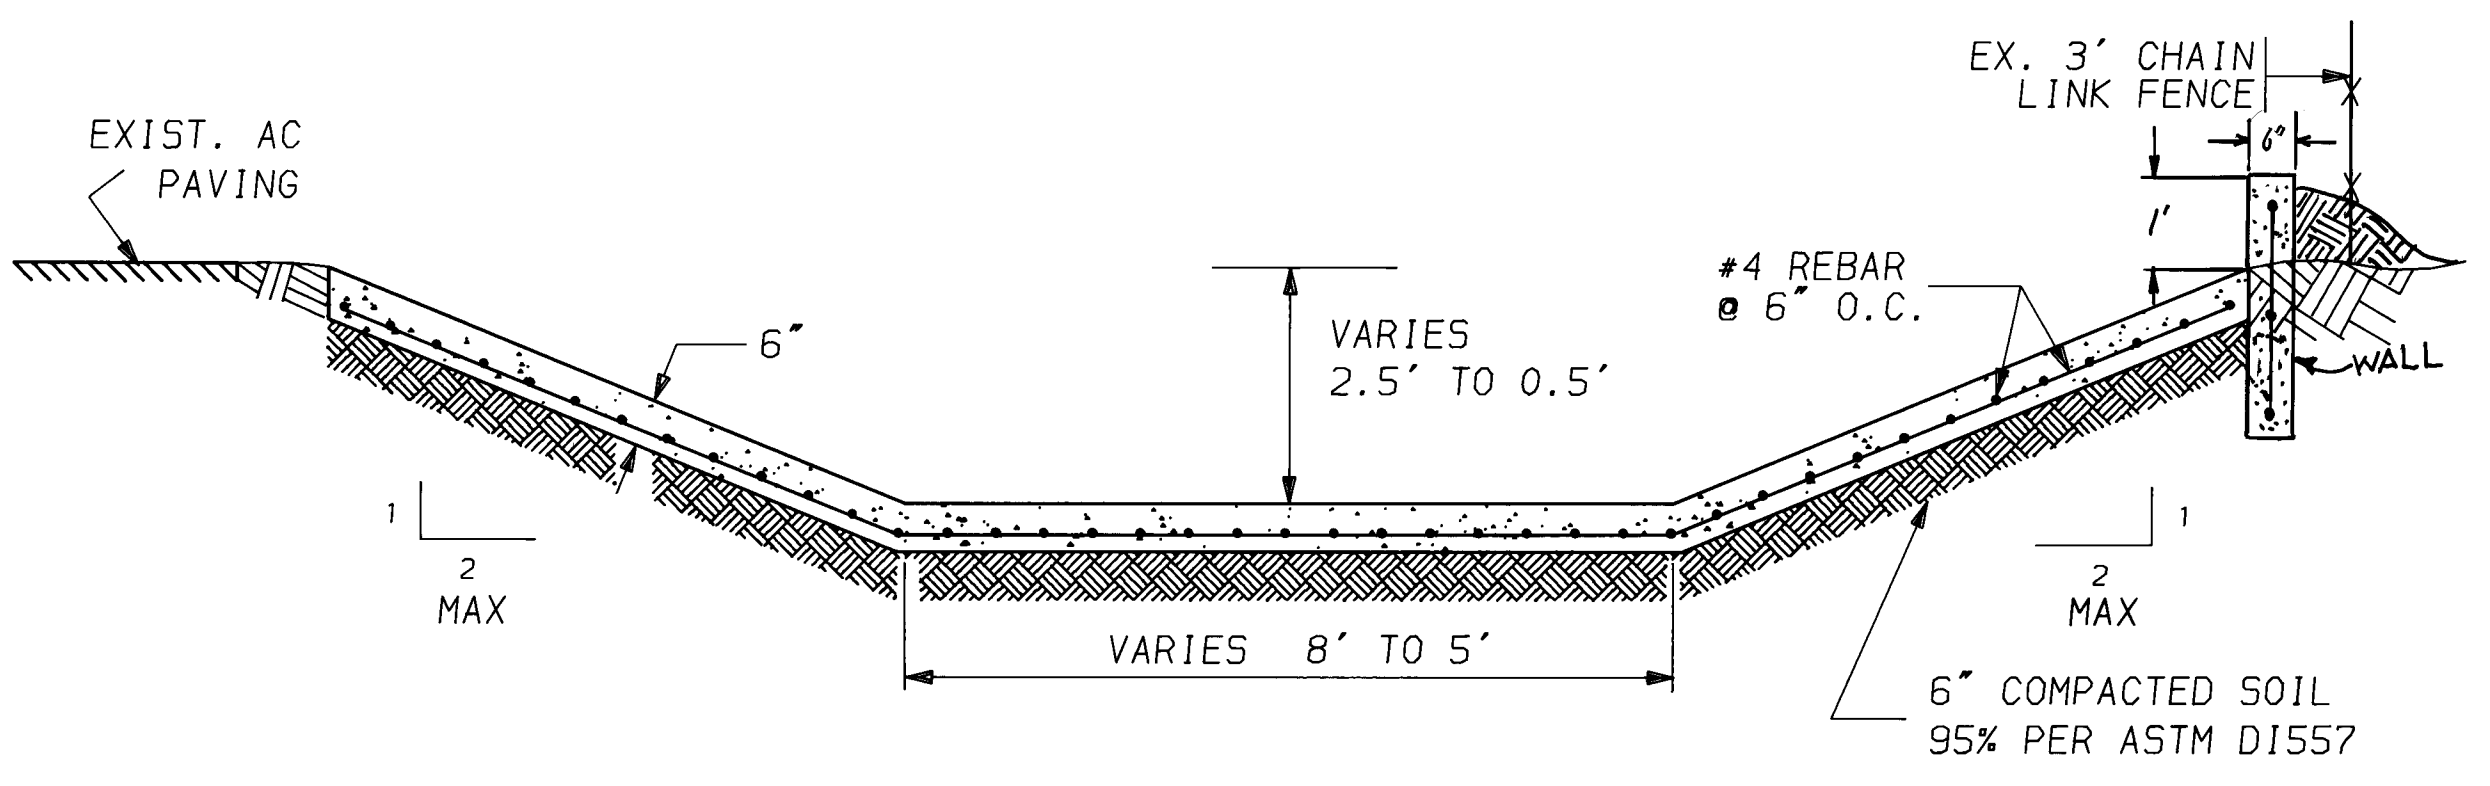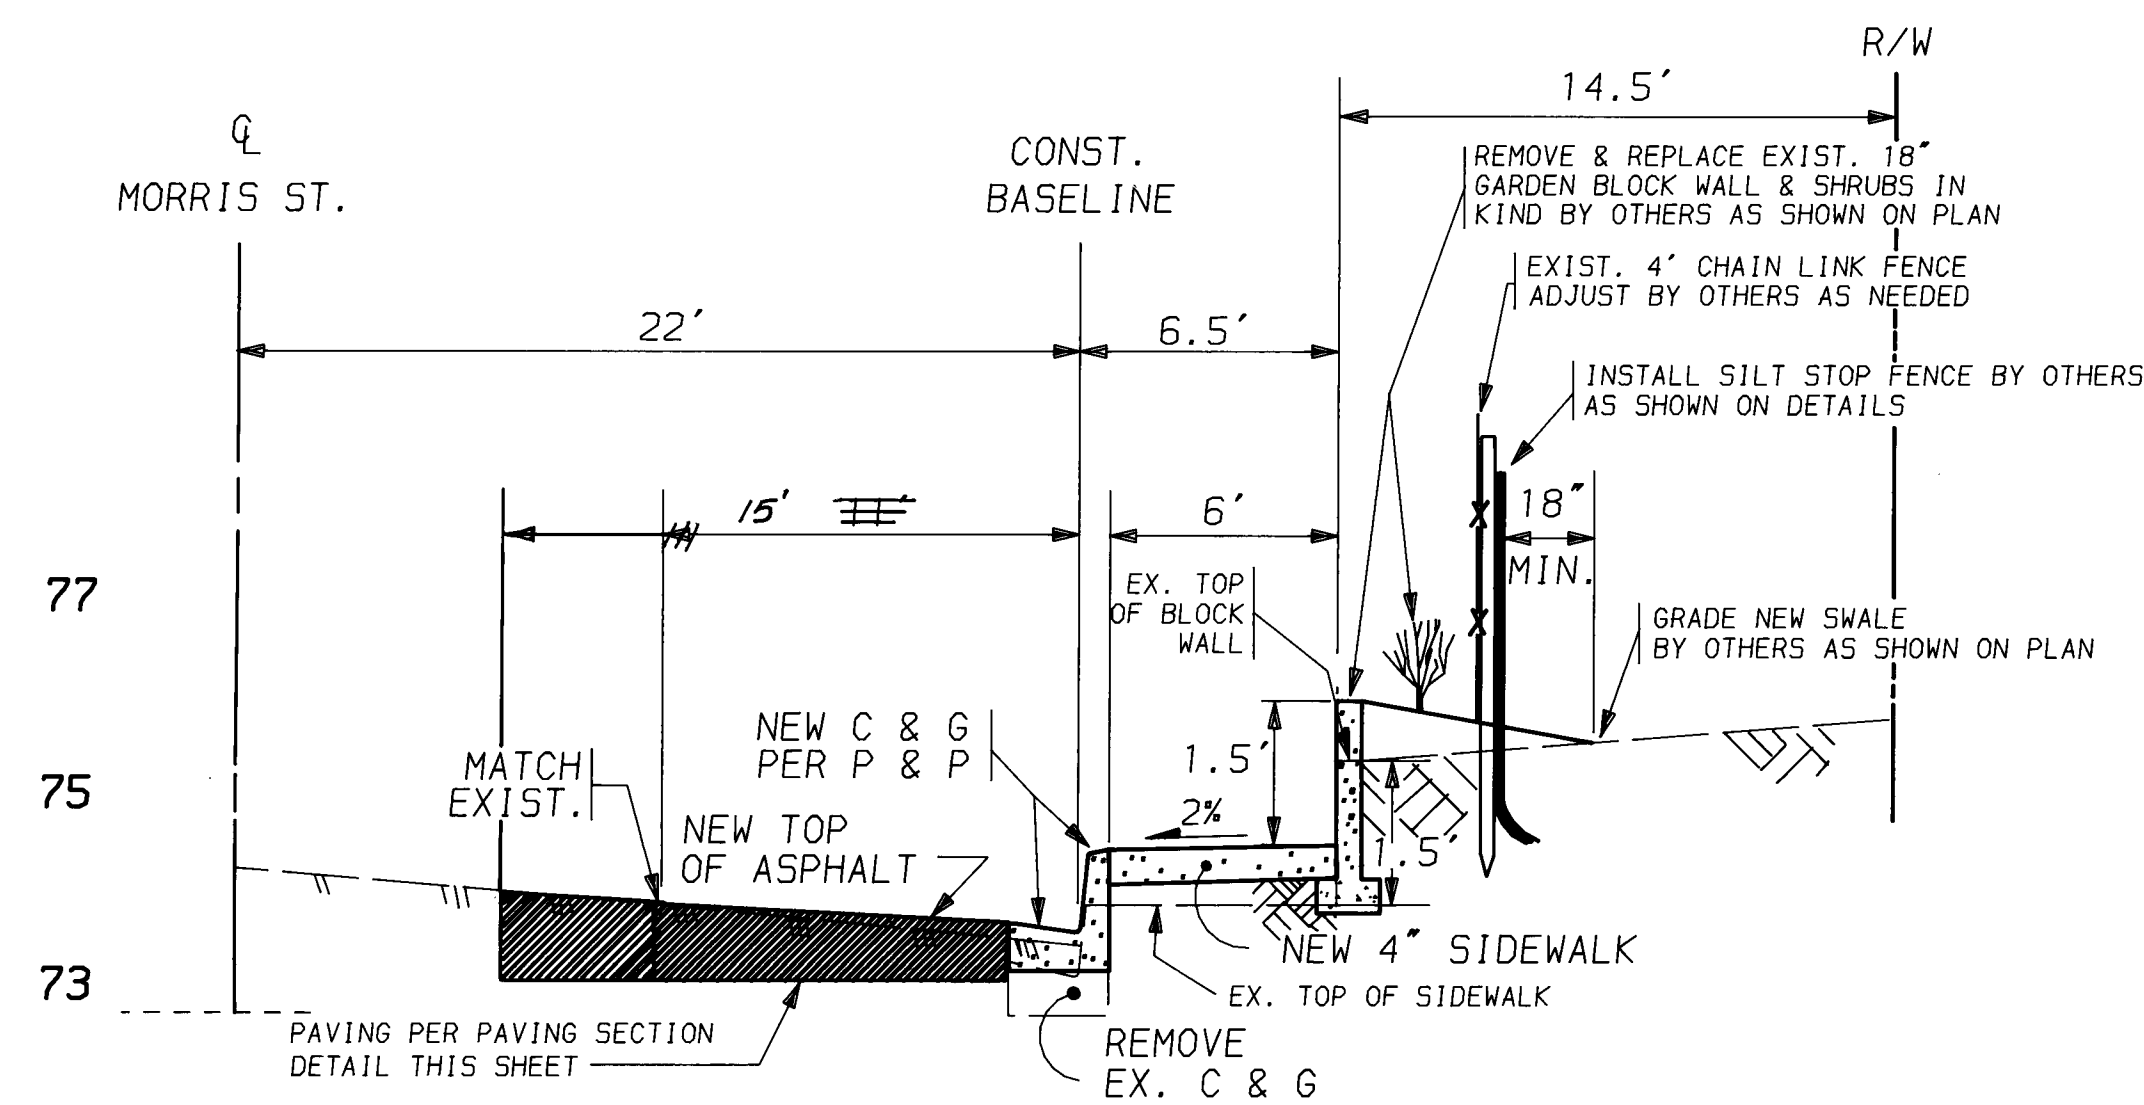

AS BUILT INFORMATION			BENCH MARKS			SURVEY INFORMATION			ENGINEER'S SEAL		
CONTRACTOR	C.C.M.		NO.	BY	DATE	NO.	BY	DATE	NO.	BY	DATE
WORK STORED BY											
DATE											
ACCEPTANCE BY	M.S.										
DATE	10/21/89										
FIELD VERIFICATION BY											
DATE											
DRAWINGS											
CORRECTED BY											
DATE											
MICRO-FILM INFORMATION											
RECORDED BY											
NO.											

CITY OF ALBUQUERQUE PUBLIC WORKS DEPARTMENT ENGINEERING GROUP					
TITLE: MORRIS ST. RECONSTRUCTION NORTH OF CANDELARIA RD, NE. - DETAILS & CROSS SECTIONS					
APPROVALS	ENGINEER	DATE	APPROVALS	ENGINEER	DATE
D.R.C. Chair	R. P. Pang	10-3-89			
Trans. Dev	R. P. Pang	9-25-89			
Utility Dev	R. P. Pang	9-25-89			
DRAWING NO.	3282	MAP NO.	6-21	SHEET	3 OF 3