


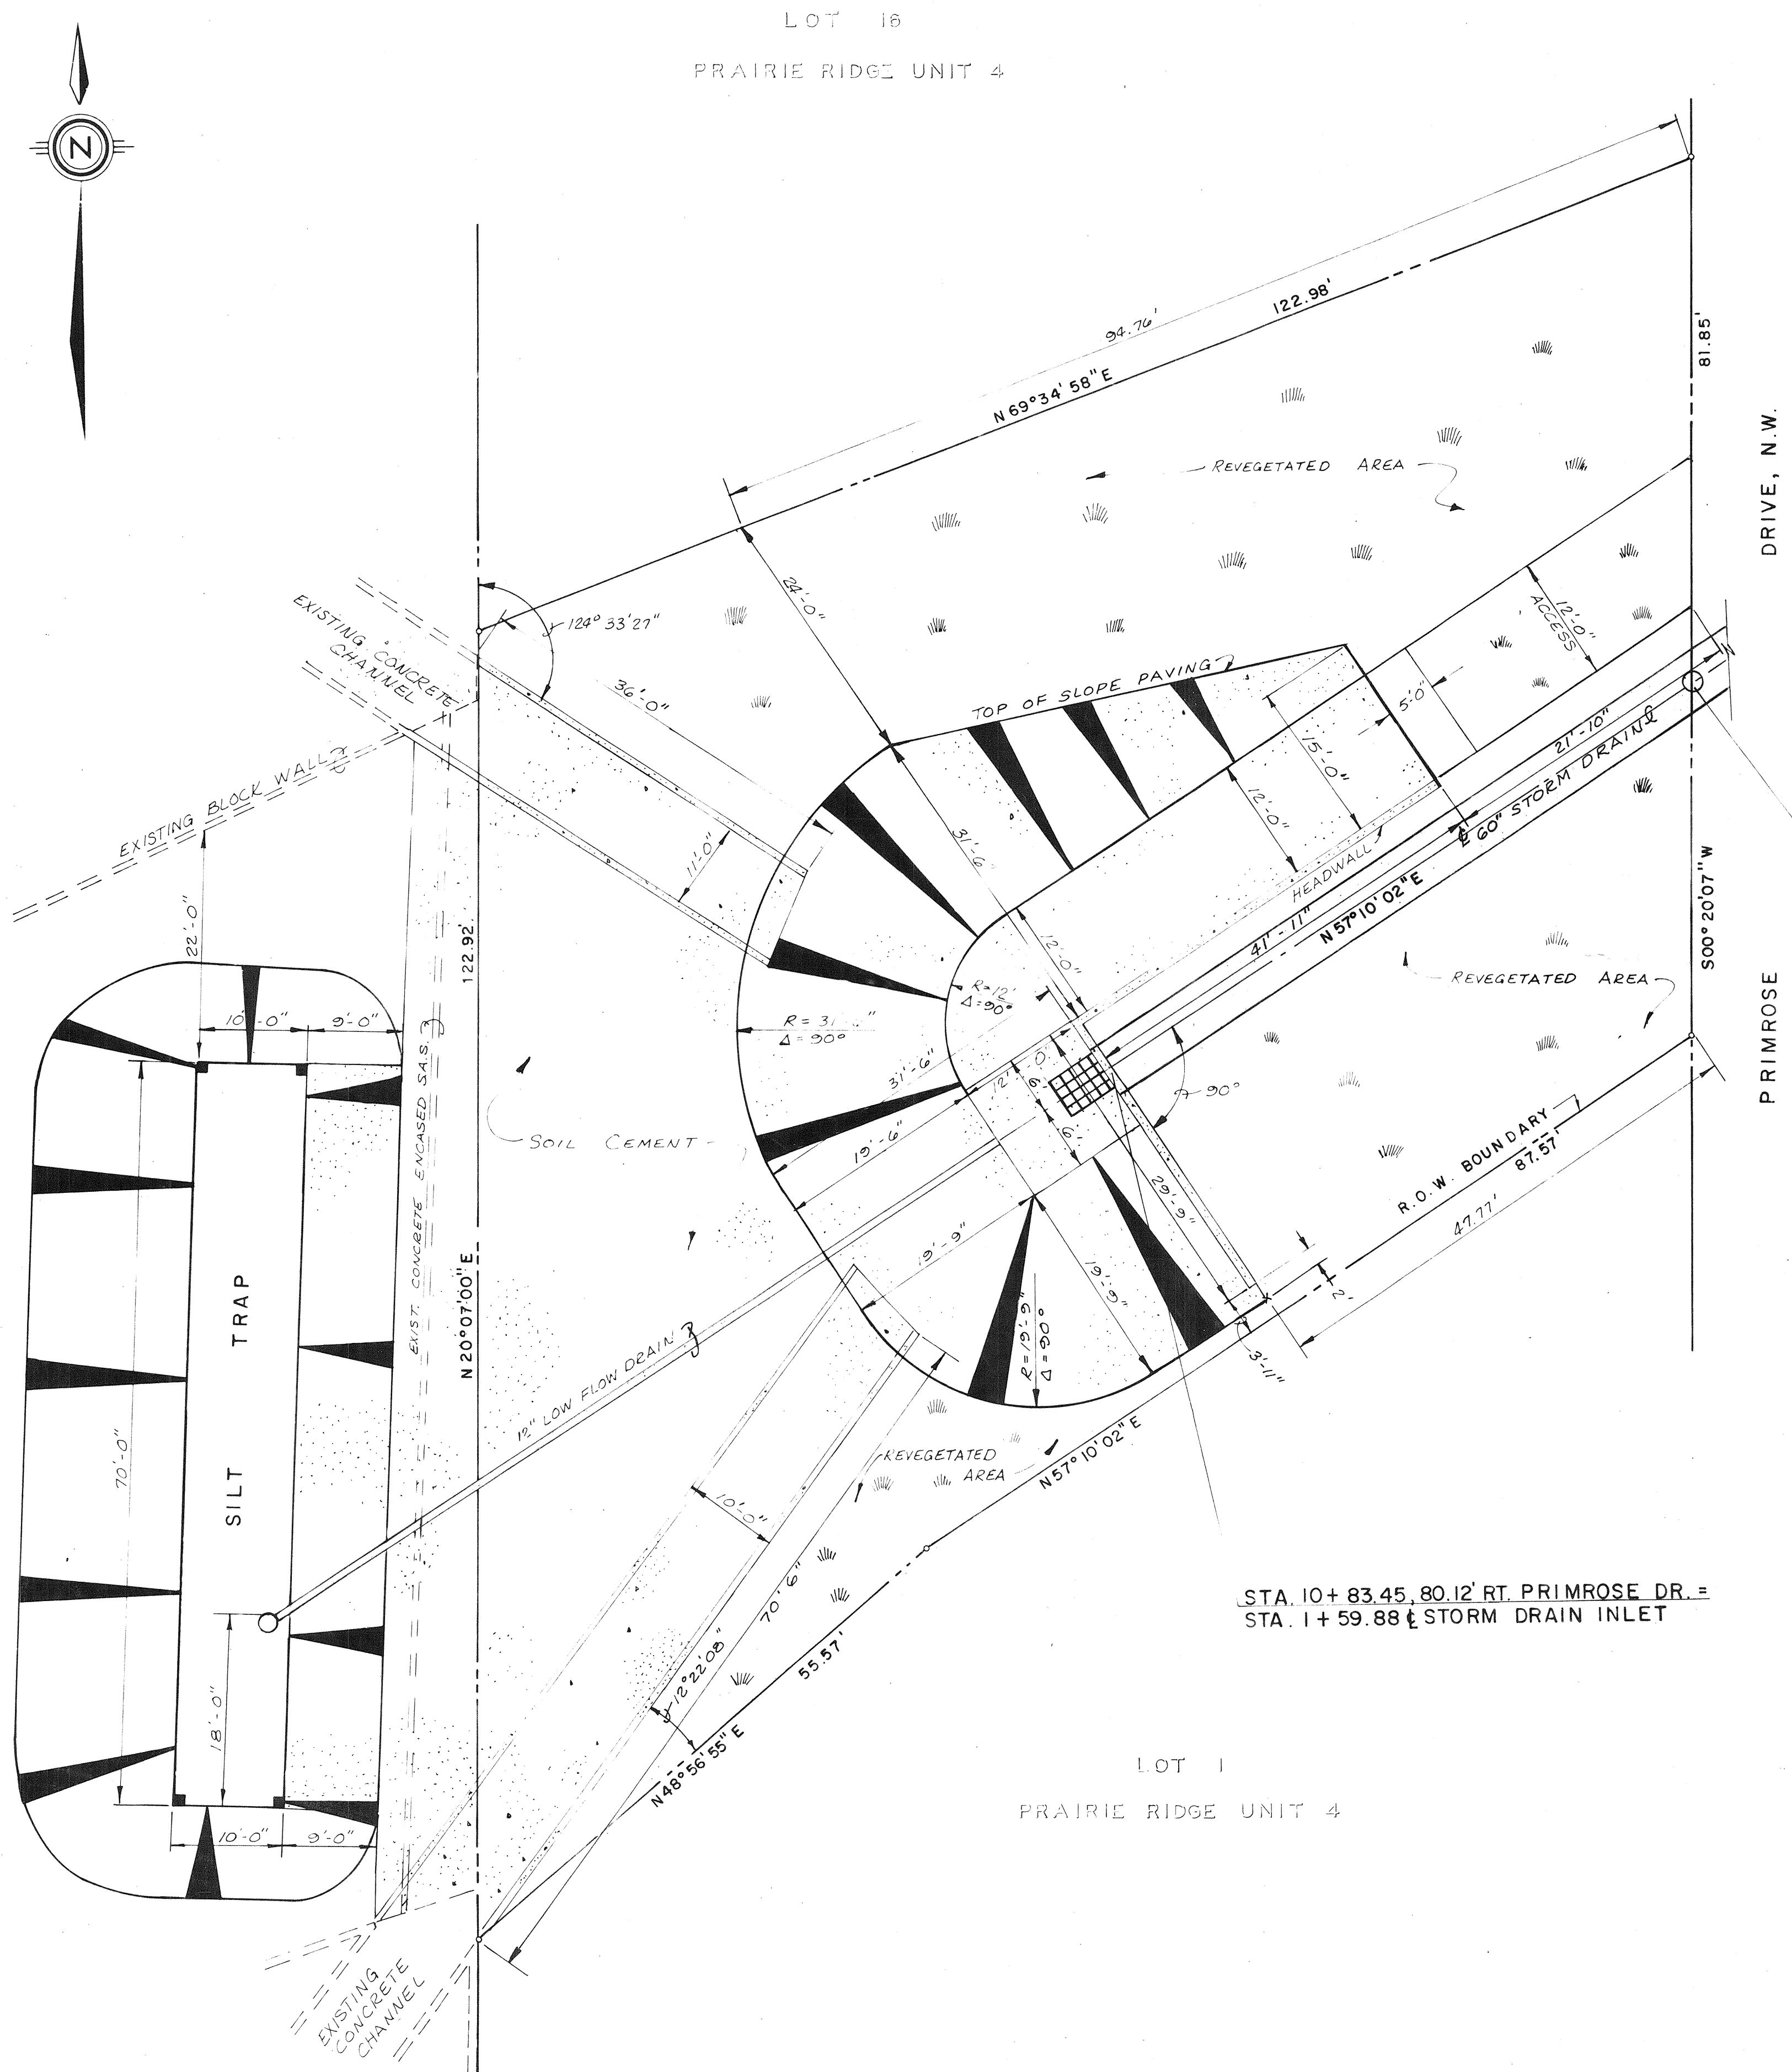

MANHOLE
STA 10+47.43, 25' RT. PRIMROSE DR. =
STA. 2+25.73 & STORM DRAIN

STA. 10+ 83.45, 80.12' RT. PRIMROSE DR. =
STA. 1+ 59.88 & STORM DRAIN INLET

RECORD DRAWING AS BUILT

NOTE: AS BUILT CERTIFICATION IS BASED UPON PERIODIC CONSTRUCTION MONITORING, NOT FULLTIME, PROFESSIONAL, CONSTRUCTION INSPECTION. AS SUCH THIS CERTIFICATION REFERS TO READILY AVAILABLE LOCATIONAL AND ELEVATION DATA, AND MATERIAL CHARACTERISTIC ASPECTS OF THE WORK AND IS NOT INTENDED TO VERIFY EITHER SPECIFIC DETAILS OR QUALITY OF CONSTRUCTION. IN ADDITION THE DRAWING MAY CONTAIN INFORMATION GATHERED BY CITY INSPECTORS WHICH I CANNOT VERIFY.

CERTIFIED BY *[Signature]* DATE *9/28/87*

SCALE: 1" = 10'

community sciences corporation
LAND PLANNING P.O. Box 1326 ENGINEERING SURVEYING Corralles, N.M. 87048

CITY OF ALBUQUERQUE
PUBLIC WORKS DEPARTMENT
ENGINEERING GROUP

TITLE: PRAIRIE RIDGE UNIT FOUR
SOUTH BRANCH INLET-SURVEY CONTROL

APPROVALS	ENGINEER	DATE	APPROVALS	ENGINEER	DATE
D.R.C. Chair	<i>[Signature]</i>	<i>9/19/87</i>			
Trans. Dev.	<i>[Signature]</i>	<i>9/18/87</i>			
Utility Dev.	<i>[Signature]</i>	<i>9/18/87</i>			
Hydrology	<i>[Signature]</i>	<i>9/14/87</i>			
DRAWING NO.	3314	MAP NO.	D-12	SHEET	39 OF 41

ENGINEER'S SEAL			SURVEY INFORMATION		BENCH MARKS		AS BUILT INFORMATION	
			FIELD NOTES				CONTRACTOR	
			NO.	BY	DATE		CONSTRUCTION MANAGEMENT CORPORATION	DATE 10-87
							INSPECTOR'S	DATE
							FIELD COMMUNITY SCIENCES CORPORATION	DATE
							VERIFICATION BY	DATE
							CORRECTED BY	DATE
							MICRO-FILM INFORMATION	
							RECORDED BY	DATE
							NO.	