


1	2	3	4	5	6	7	8	9	10	11
2	6		3	3	1	6	0	1	8	8

- APPROVAL OF AS BUILT DRAWINGS
CHIEF CONSTRUCTION ENGINEER
[Signature]
DATE 9/5/88

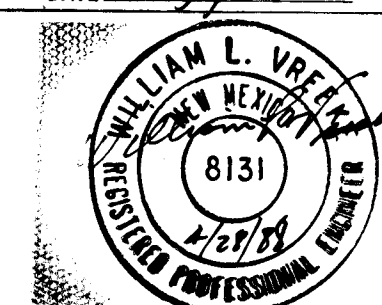

RECORD DRAWINGS

DATE 4/28/88

- | | | | | | | | | | |
|-----|--------|---------------|------|------|------|------|------|-------|------|
| | | | | | | | | | |
| | | | | | | | | | |
| | | | | | | | | | |
| REV | SHEETS | CITY ENGINEER | DATE | USER | DEPT | DATE | USER | DEPT. | DATE |

 **BOHANNAN - HUSTON INC.**
ALBUQUERQUE SANTA FE EL PASO

ENGINEERS PLANNERS PHOTOGRAMMETERS


PROJECT NUMBER	
----------------	--

3316

APPROVED FOR
CONSTRUCTION

8-26-87 C.E.

SHEET 1 OF **38**

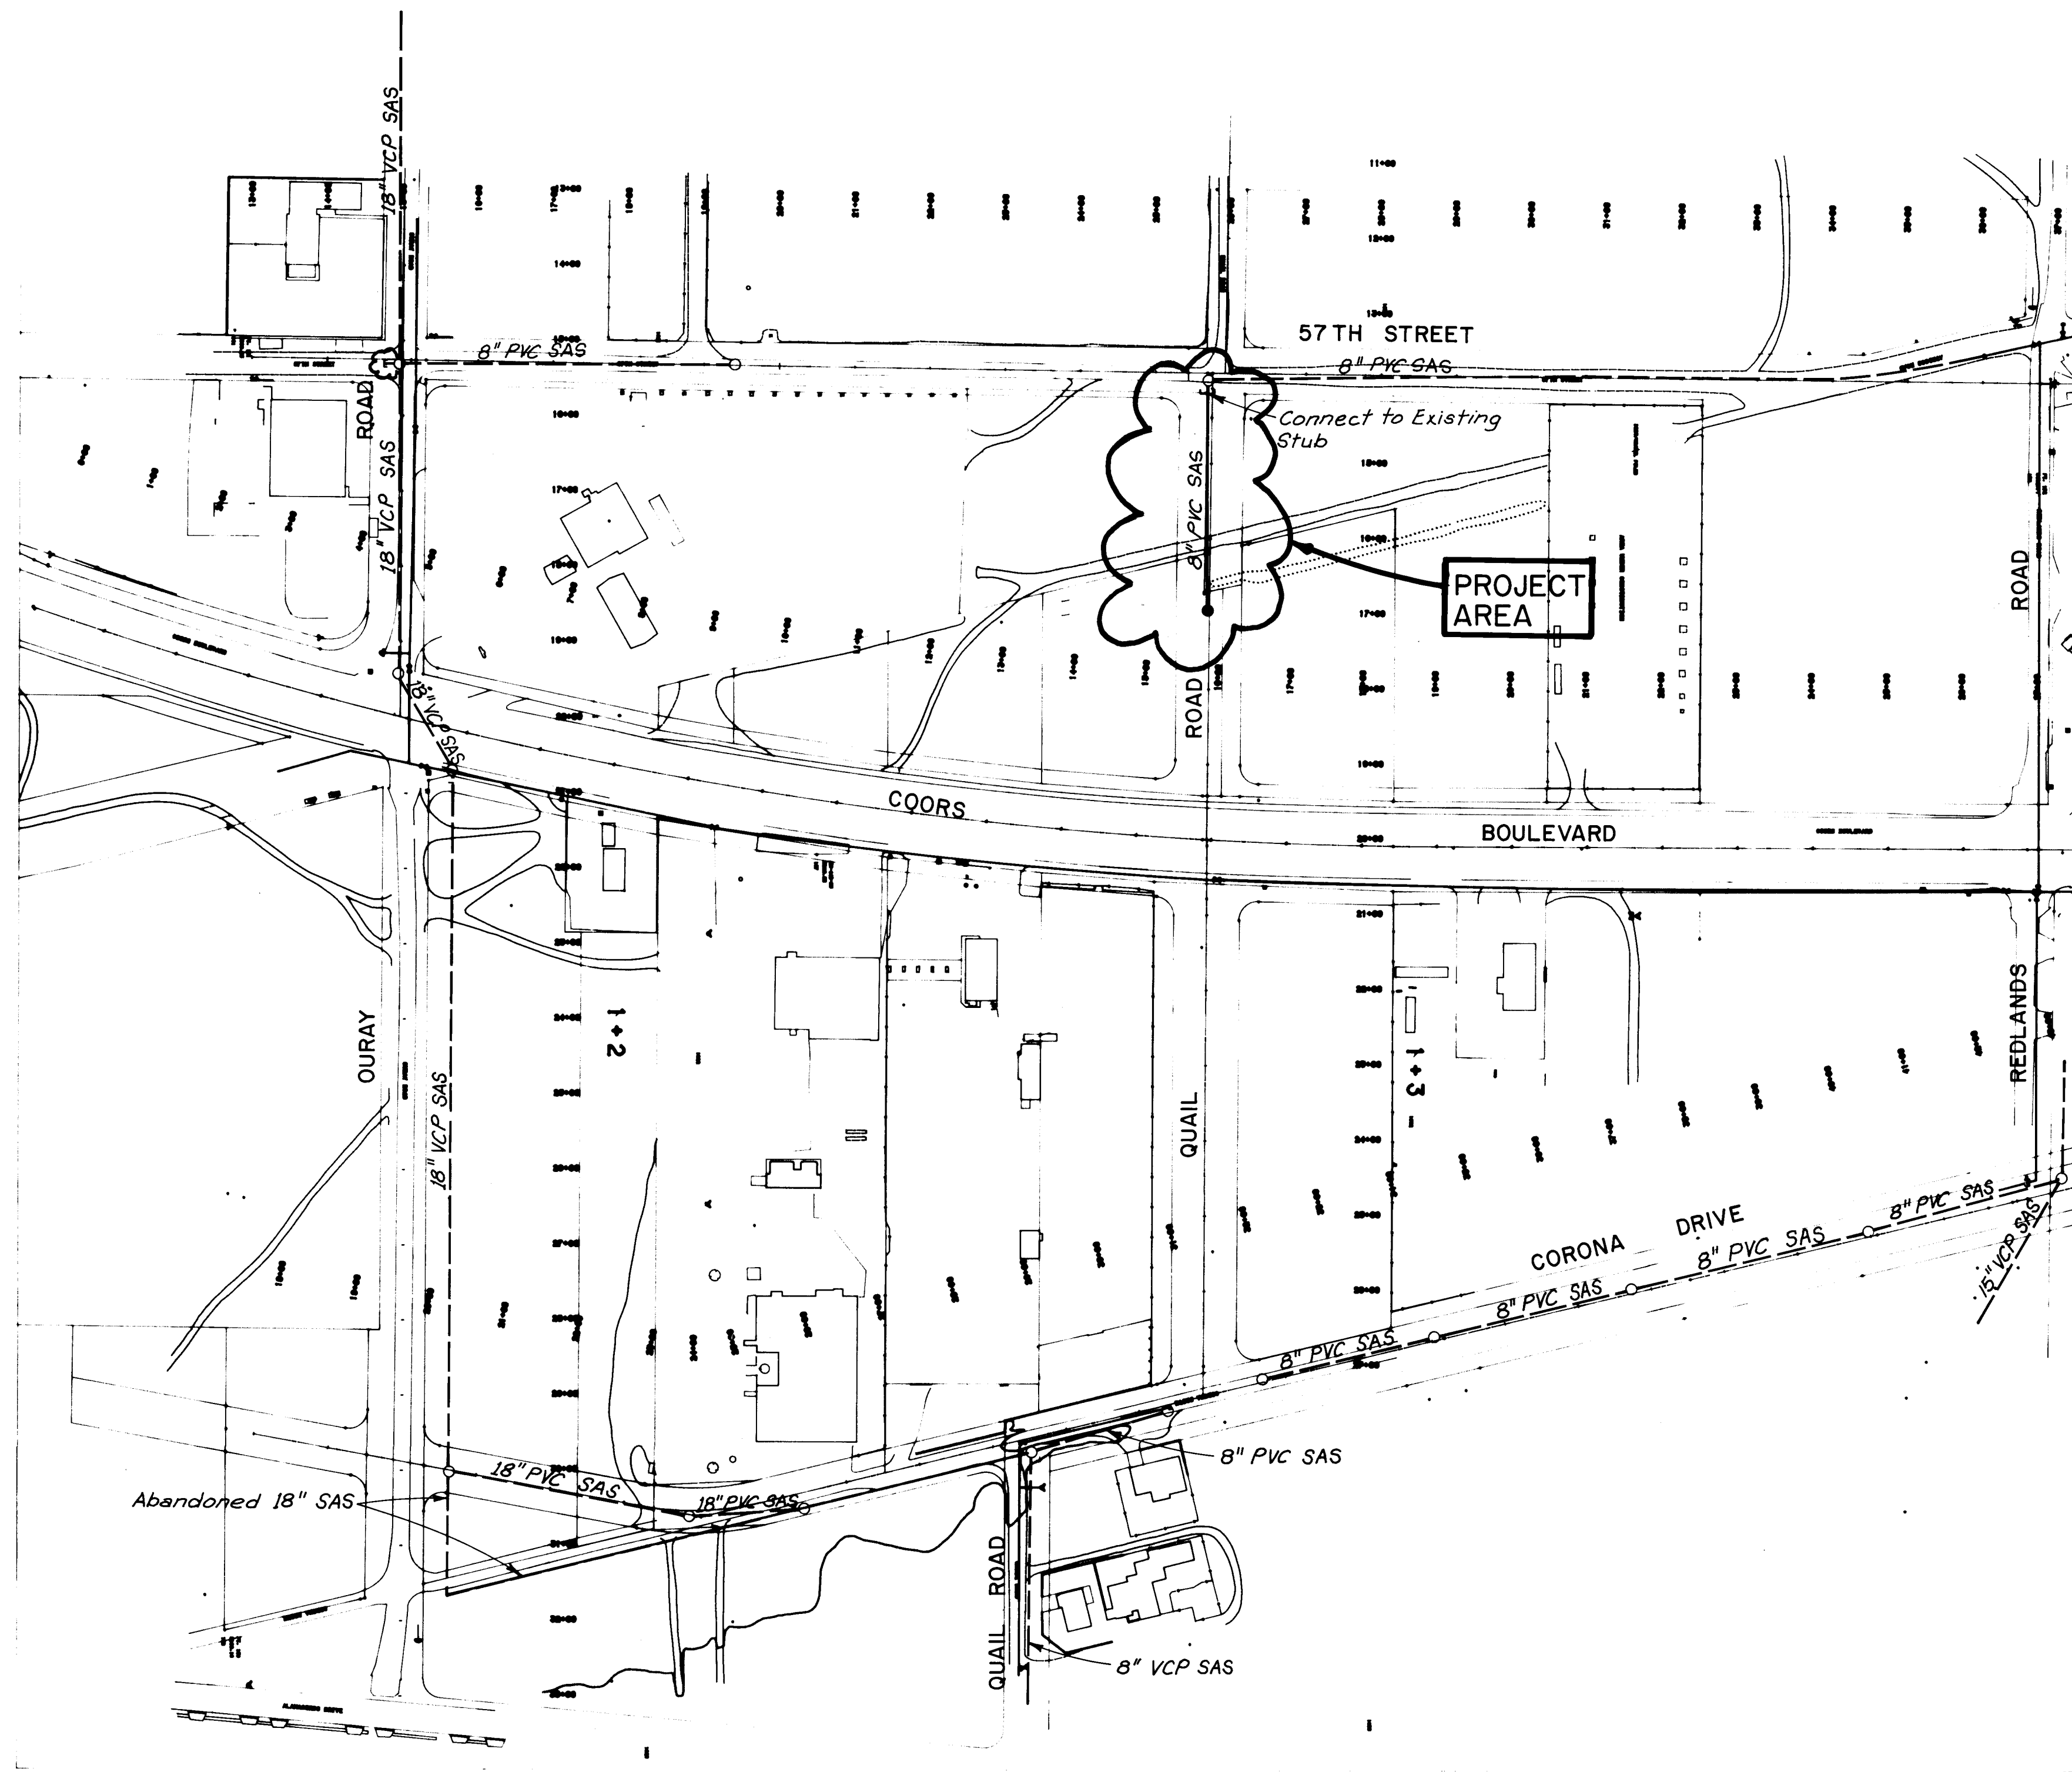

LEGEND
 Proposed Existing
 --- Sanitary Sewer Line
 ---○--- Sanitary Sewer Manhole
 --- Cap

1 2 3 4 5 6 7 8 9 10 11 12
 26 33160388

Job No.

FHWA Region No.	NEW MEXICO	SHEET NO.	TOTAL SHEETS
6			

SURVEY INFORMATION		BENCH MARKS		AS-BUILT INFORMATION	
NO.	DATE	NO.	DATE	NO.	DATE
		STA. N.M. 448-13 ELEV. 5099.527		CONTRACTOR	DATE
		STANDARD N.M.S.H.C. BRASS TABLET		INSPECTOR'S	DATE
		SET FLUSH IN TOP OF CONCRETE		VERIFICATION BY	DATE
		POST LOCATED IN THE SOUTH WEST		COMPILED BY	DATE
		EDGE OF "WEST MESA BOWL"		RECORDED BY	DATE
		BOWLING ALLEY PARKING LOT			



RECORD DRAWINGS
 DATE 4-28-88

SCALE: 1" = 150'




CITY OF ALBUQUERQUE
 PUBLIC WORKS
 ENGINEERING

TITLE: COORS WIDENING - LOTS 2 & 3
 SANITARY SEWER LAYOUT

APPROVALS	ENGINEER	DATE	APPROVALS	ENGINEER	DATE
D.R.C. Chairman	NA	8/1/87	Liquid Waste	JE Eutsgaard	8/1/87
A.C.E. - Design	NA	8/1/87	Traffic	NA	8/1/87
A.C.E. - Hydrology	NA	8/1/87	Water	JE Eutsgaard	8/1/87

DRAWING NO.	3316	MAP NO.	H-11	SHEET	3	OF	38
----------------	------	---------	------	-------	---	----	----

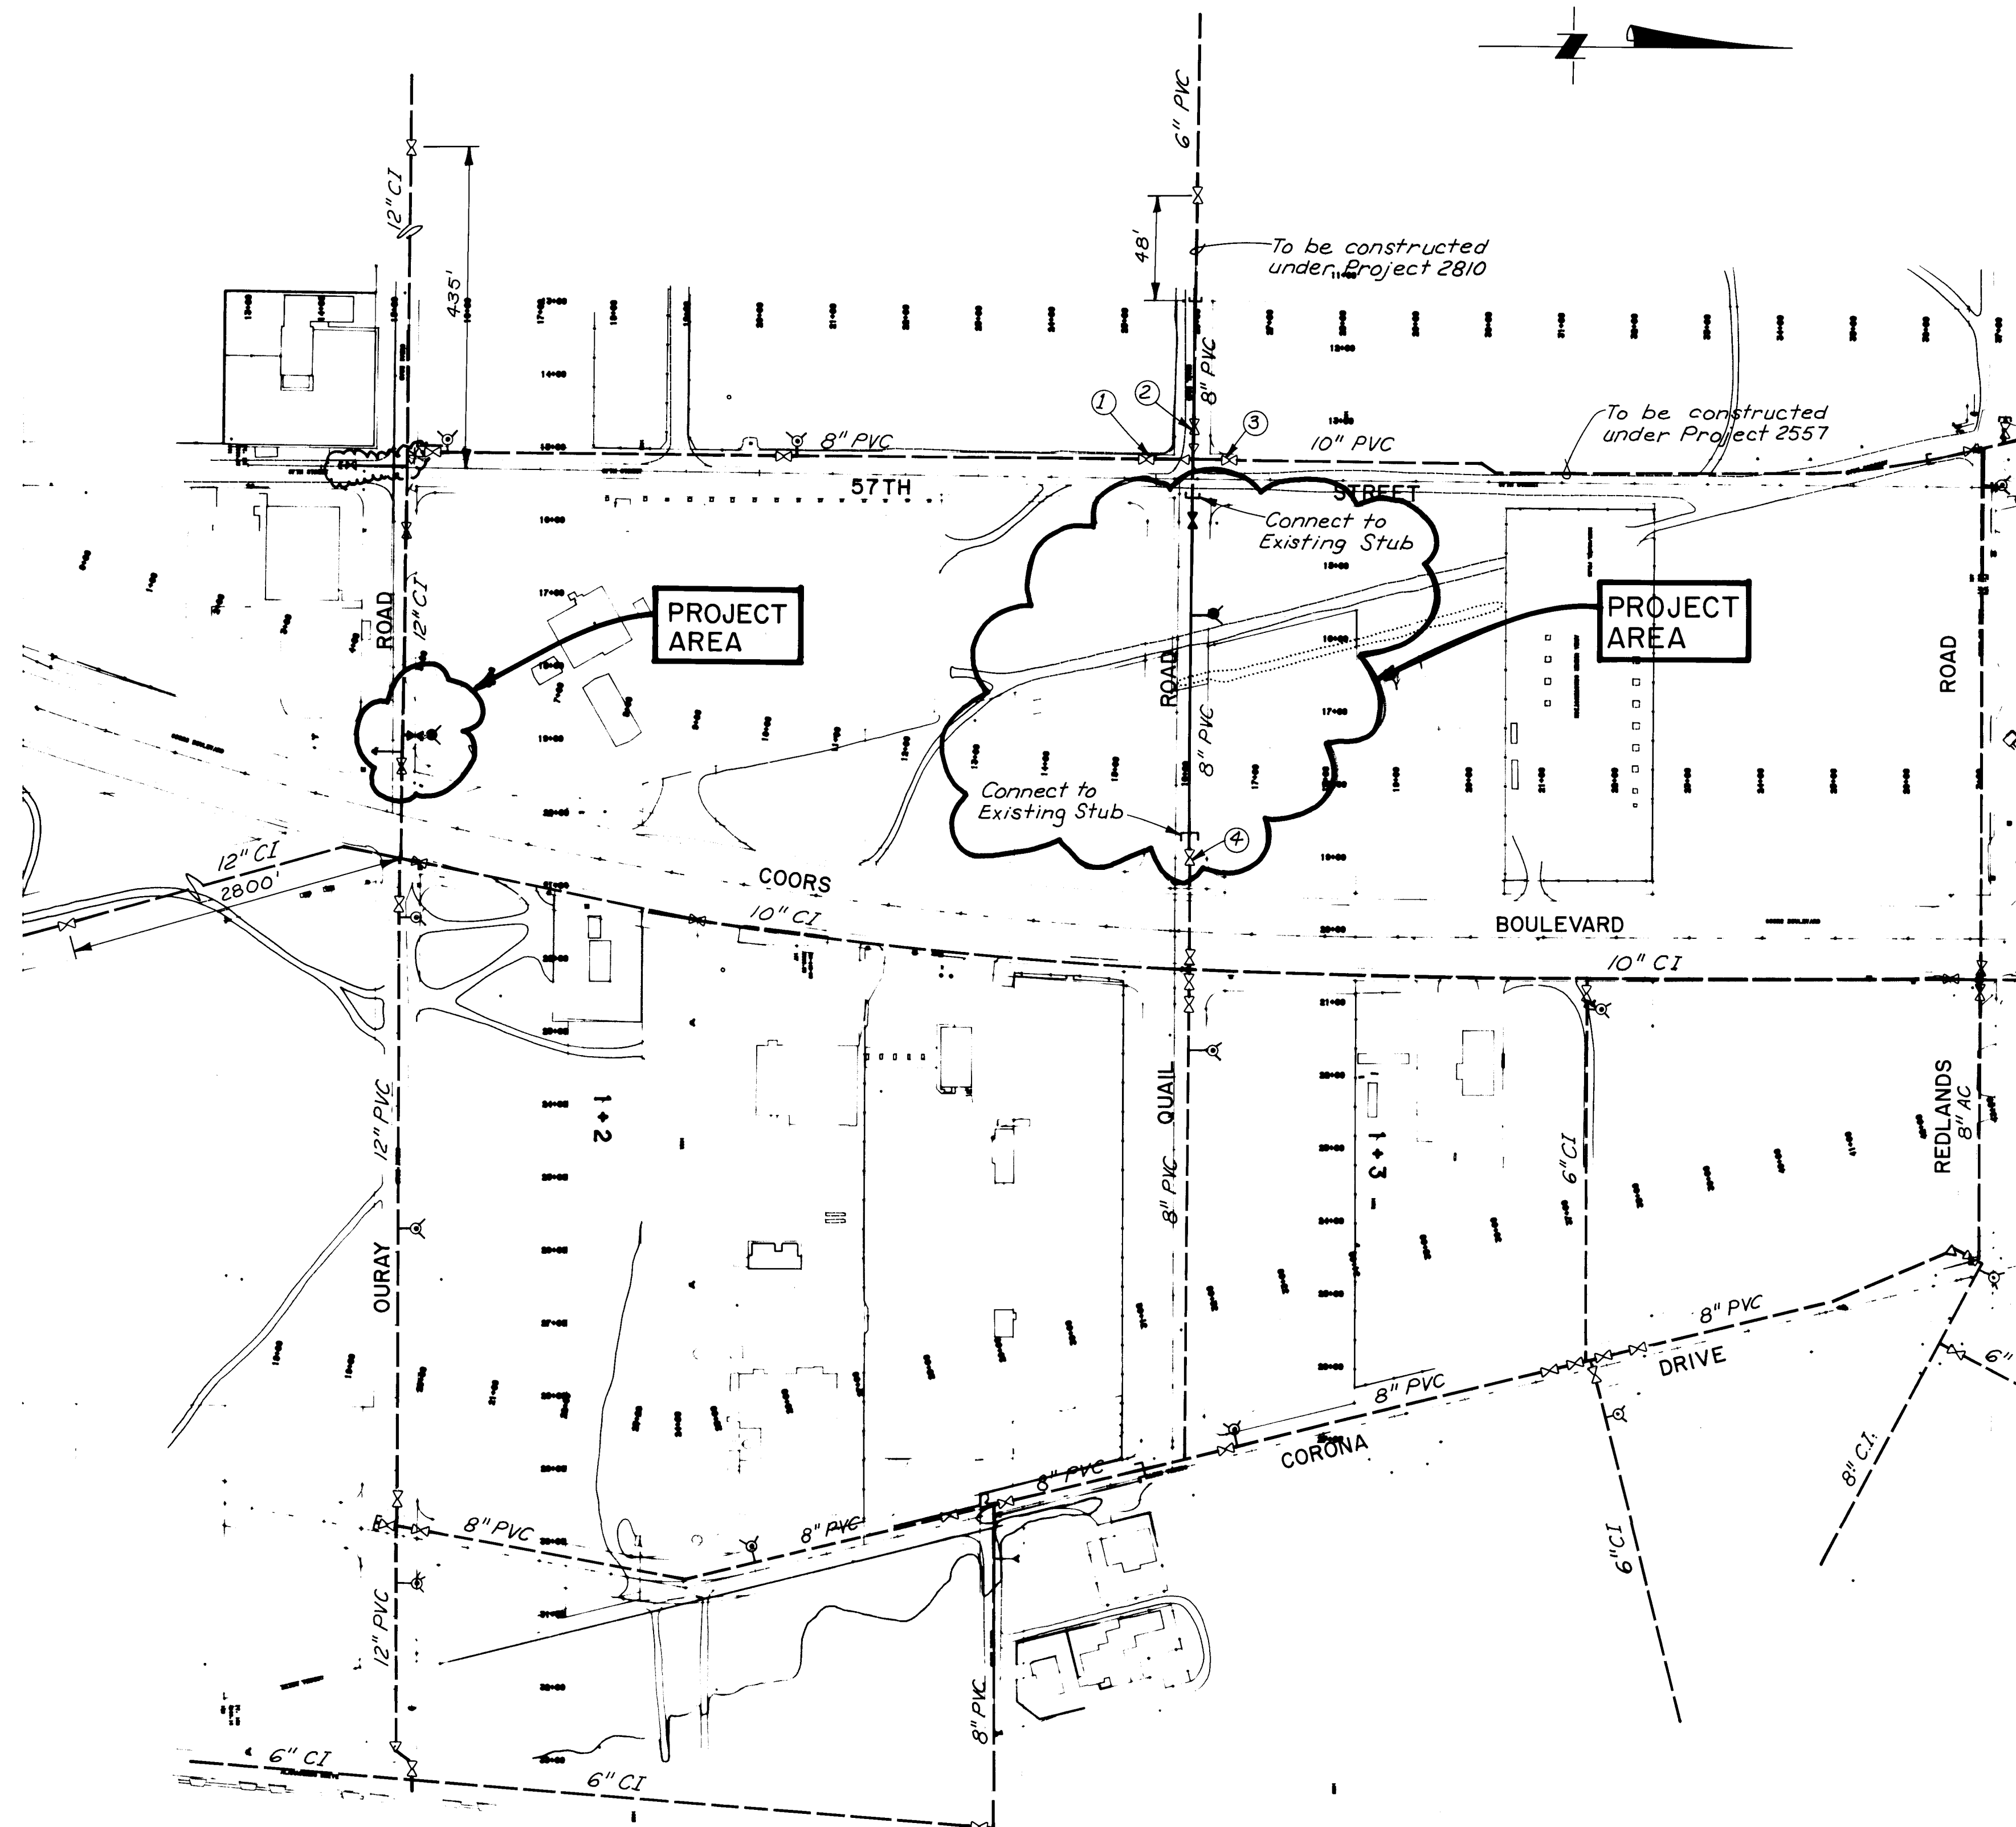

LEGEND

Proposed	Existing	Waterline
		Gate Valve
		Air Release Valve
		Reducer
		Fire Hydrant Cap

WATER SHUT-OFF TABLE Tie-Ins to Existing System

Location	Exist. Line Size	Valves to Shut-Off
1. Sta. 14+02 ± Quail	8"	①②③④
2. Sta. 18+75 ± Quail	8"	①②③④

1 2 3 4 5 6 7 8 9 10 11 12
26 33160408

Job No.

F.H.W.A. Region No.	NEW MEXICO	SHEET NO.	TOTAL SHEETS
6			

CONSTRUCTION NOTES

1. Contractor shall make arrangements for a water shut-off permit with the Water Division at 5501 Pino Rd. N.E. 823-4200. The Water shut-off shall be approved and the pre-trial water shut-off completed before tie-ins into existing waterlines.

AS-BUILT INFORMATION		BENCH MARKS		SURVEY INFORMATION		ENGINEER'S SEAL		REVISIONS		DESIGNED BY		DRAWN BY		CHECKED BY	
CONTRACTOR	DATE	STA.	N.M.	NO.	BY	DATE	NO.	DATE	REVISIONS	DATE	DATE	DATE	DATE	DATE	DATE
STANDARD N.M.S.H.C. BRASS TABLET	DATE	448-N3	448-N3	5095.527	DATE	DATE	1	DATE	REVISIONS	DATE	DATE	DATE	DATE	DATE	DATE
INSPECTOR'S FIELD CHECK BY	DATE	SET FLUSH IN TOP OF CONCRETE POST	LOCATED IN THE SOUTH WEST EDGE OF "WEST MESA BOWL" BOWLING ALLEY PARKING LOT.	DATE	DATE	DATE	DATE	DATE	DATE	DATE	DATE	DATE	DATE	DATE	DATE
DATE 5/08	DATE 4/08	DATE 4/08	DATE 4/08	DATE 4/08	DATE 4/08	DATE 4/08	DATE 4/08	DATE 4/08	DATE 4/08	DATE 4/08	DATE 4/08	DATE 4/08	DATE 4/08	DATE 4/08	DATE 4/08






RECORD DRAWINGS

DATE 4-28-88

SCALE: 1" = 150'

CITY OF ALBUQUERQUE PUBLIC WORKS ENGINEERING					
TITLE: COORS WIDENING - LOTS 2 & 3 WATER SHUT-OFF PLAN					
APPROVALS	ENGINEER	DATE	APPROVALS	ENGINEER	DATE
D.R.C. Chairman	ALB	8/14/87	Liquid Waste	DE Eutgaard	8/14/87
A.C.E. Design	"	"	Traffic	NA DWH	8/15/87
A.E.E. Hydrology	NA SAB	8/24/87	Water	DE Eutgaard	8/14/87
DRAWING NO.	3316	MAP NO.	H-11	SHEET	4 OF 38

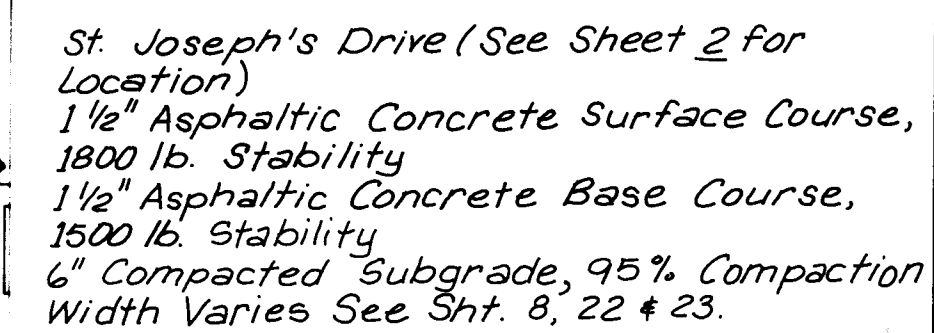

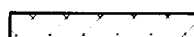 	<i>Permanent Pavement</i>
	<i>Temporary Pavement</i>
<u>Existing</u>	<u>Proposed</u>
	
	<i>Manhole or Junction Box</i>
	
	<i>Inlet</i>
	
	<i>Cap</i>

1	2	3	4	5	6	7	8	9	10	11	12
26			33	16	05	88					

DRAWING NO.	3316	MAP NO.	H-11	SHEET	5	OF	38
----------------	------	---------	------	-------	---	----	----

COORS BOULEVARD

Sheet 10			Position on
Sta.	Road	Description	
4+38	LT	Mastarm, signal & foundation, see Sheet 10 & 32 (remove and transport)	
4+46 to 4+54	LT	12 RR ties, see Sheet 21 (remove and salvage)	
4+63	LT	Fire hydrant, see Sheet 21 (remove and salvage)	
5+26	LT	Mastarm, signal & foundation, see Sheet 10 & 32 (remove and transport)	
5+20 to 6+15	LT	Concrete header curb (remove and dispose)	
4+43	CL	Median signal & foundation, see Sheet 10 & 32 (remove and transport)	
5+71	CL	Median signal & foundation, see Sheet 10 & 32 (remove and transport)	
4+63	RT	Signal controller box, see Sheet 10 & 32 (remove and City will transport)	
5+01	RT	Mastarm, signal & foundation, see Sheet 10 & 32 (remove and transport)	
5+79	RT	Mastarm, signal & foundation, see Sheet 10 & 32 (remove and transport)	

57th Street

Sheet 13			Position on
Sta.	Road	Description	
16+30 to 22+50	RT	Asphalt curb	

Quail Road

Sheet 15			Position on
Sta.	Road	Description	
16+56	LT	Abandoned Mountain Bell Riser (remove and dispose)	
18+64 to 18+86	LT	Billboard to be relocated as directed by Engineer	
16+63	CL	Abandoned Mountain Bell Riser (remove and dispose)	

Ouray Road


Sheet 17			Position on
Sta.	Road	Description	
6+90	RT	PNM direct buried cable, see Note 3, Sheet 21	
11+15	RT	PNM direct buried cable, see Note 3, Sheet 21	

Ouray Road

Sheet 18			Position on
Sta.	Road	Description	
16+23 to 16+33	LT	Concrete header curb (remove and dispose)	

St. Joseph's



Sheet 23			Position on
Sta.	Road	Description	
17+30	LT	Traffic signals w/mastarm, see Sheet 23 (remove and relocate)	
17+50	LT	Traffic signal pull box, see Sheet 23 (remove and relocate)	
18+08	LT	Traffic signal w/pole, see Sheet 23 (remove and relocate)	

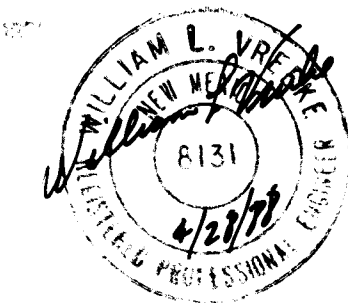

RECORD DRAWINGS
DATE 4/28/88


AS-BUILT INFORMATION		BENCH MARKS		SURVEY INFORMATION		ENGINEER'S SEAL	
CONTRACTOR	DATE	NO.	BY	NO.	BY	NO.	BY
WORK STAKED BY	DATE						
FIELD ACCEPTANCE BY	DATE						
FIELD LOCATION BY	DATE						
DRAWINGS CORRECTED BY	DATE						
MICRO-FILM INFORMATION		REVISIONS		DESIGNED BY		DRAWN BY	

BRUNING 44-232

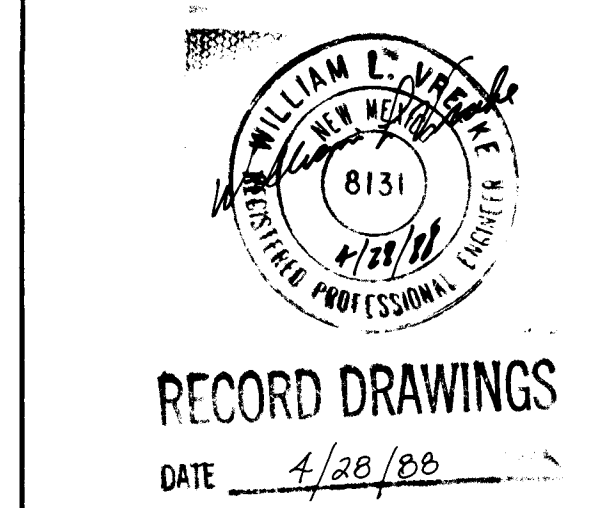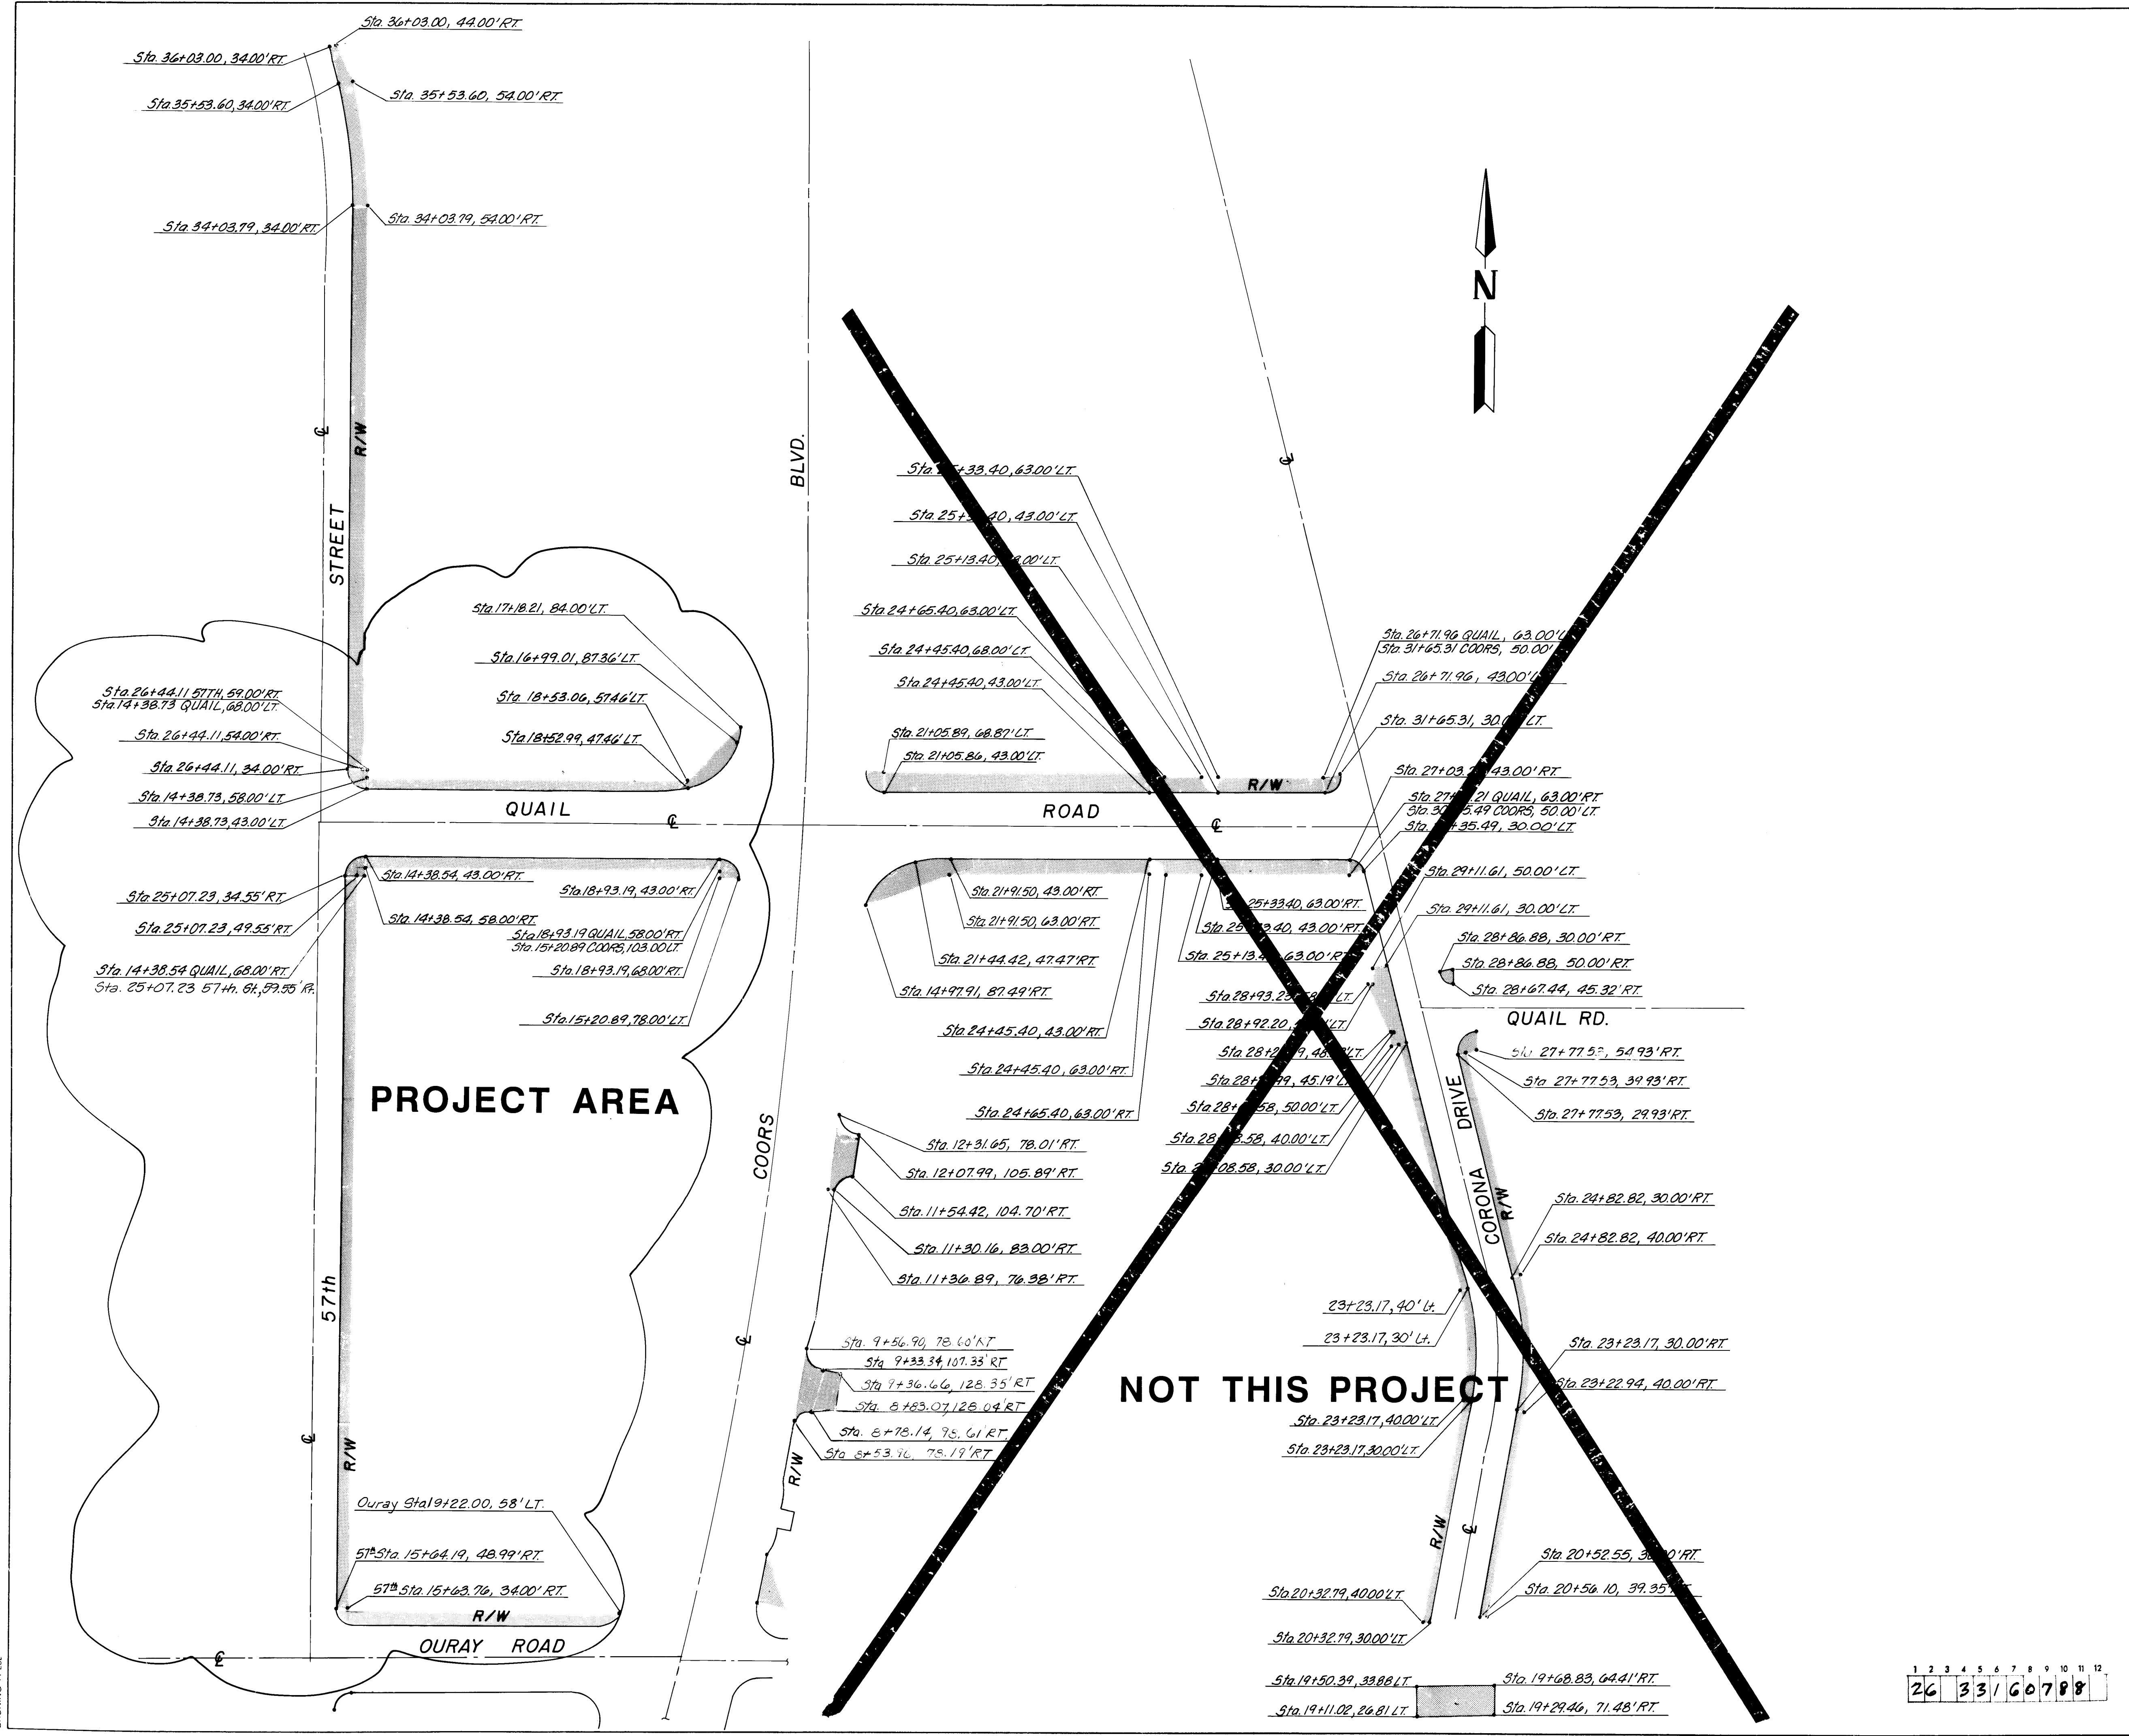

NOT TO SCALE								NO		DES	CH
			CITY OF ALBUQUERQUE PUBLIC WORKS ENGINEERING								
TITLE: COORS WIDENING — LOTS 2 & 3 TEMPORARY CONSTRUCTION PERMIT AREAS											
APPROVALS		ENGINEER		DATE		APPROVALS		ENGINEER		DATE	
D.R.C. Chairman		<i>NA JEE</i>		<i>8/14/87</i>		Liquid Waste		<i>NA JEE</i>		<i>8/14/87</i>	
A.C.E. - Design		<i>NA JEE</i>		<i>8/15/87</i>		Traffic		<i>NA DUH</i>		<i>8/15/87</i>	
A.C.E. - Hydrology		<i>Ston. Boley</i>		<i>8/14/87</i>		Water		<i>NA JEE</i>		<i>8/14/87</i>	
DRAWING NO. 3316				MAP NO. H-11				SHEET 7 OF 38			

SURVEY INFORMATION		BENCH MARKS		AS-BUILT INFORMATION	
NO.	BY	DATE	STA. N.M. 448-N3 ELEV. 5099.527	CONTRACTOR	STANDARD MECHANICAL
			STANDARD N.M.S.H.C. BRASS TABLET	STAKED BY	BHI
			SET FLUSH IN TOP OF CONCRETE POST	INSPECTOR'S	DATE
			LOCATED IN THE SOUTH WEST EDGE	FIELD	DATE
			OF "WEST MESA BOWL" BOWLING	VERIFICATION BY	5/88
			ALLEY PARKING LOT.	CORRECTED BY	4/88
ENGINEER'S SEAL		MICRO-FILM INFORMATION		RECORDED BY	DATE
<i>William A. Doherty</i>		7/17/87			
NO.	DATE	DESIGNED BY	DRAWN BY	CHECKED BY	DATE

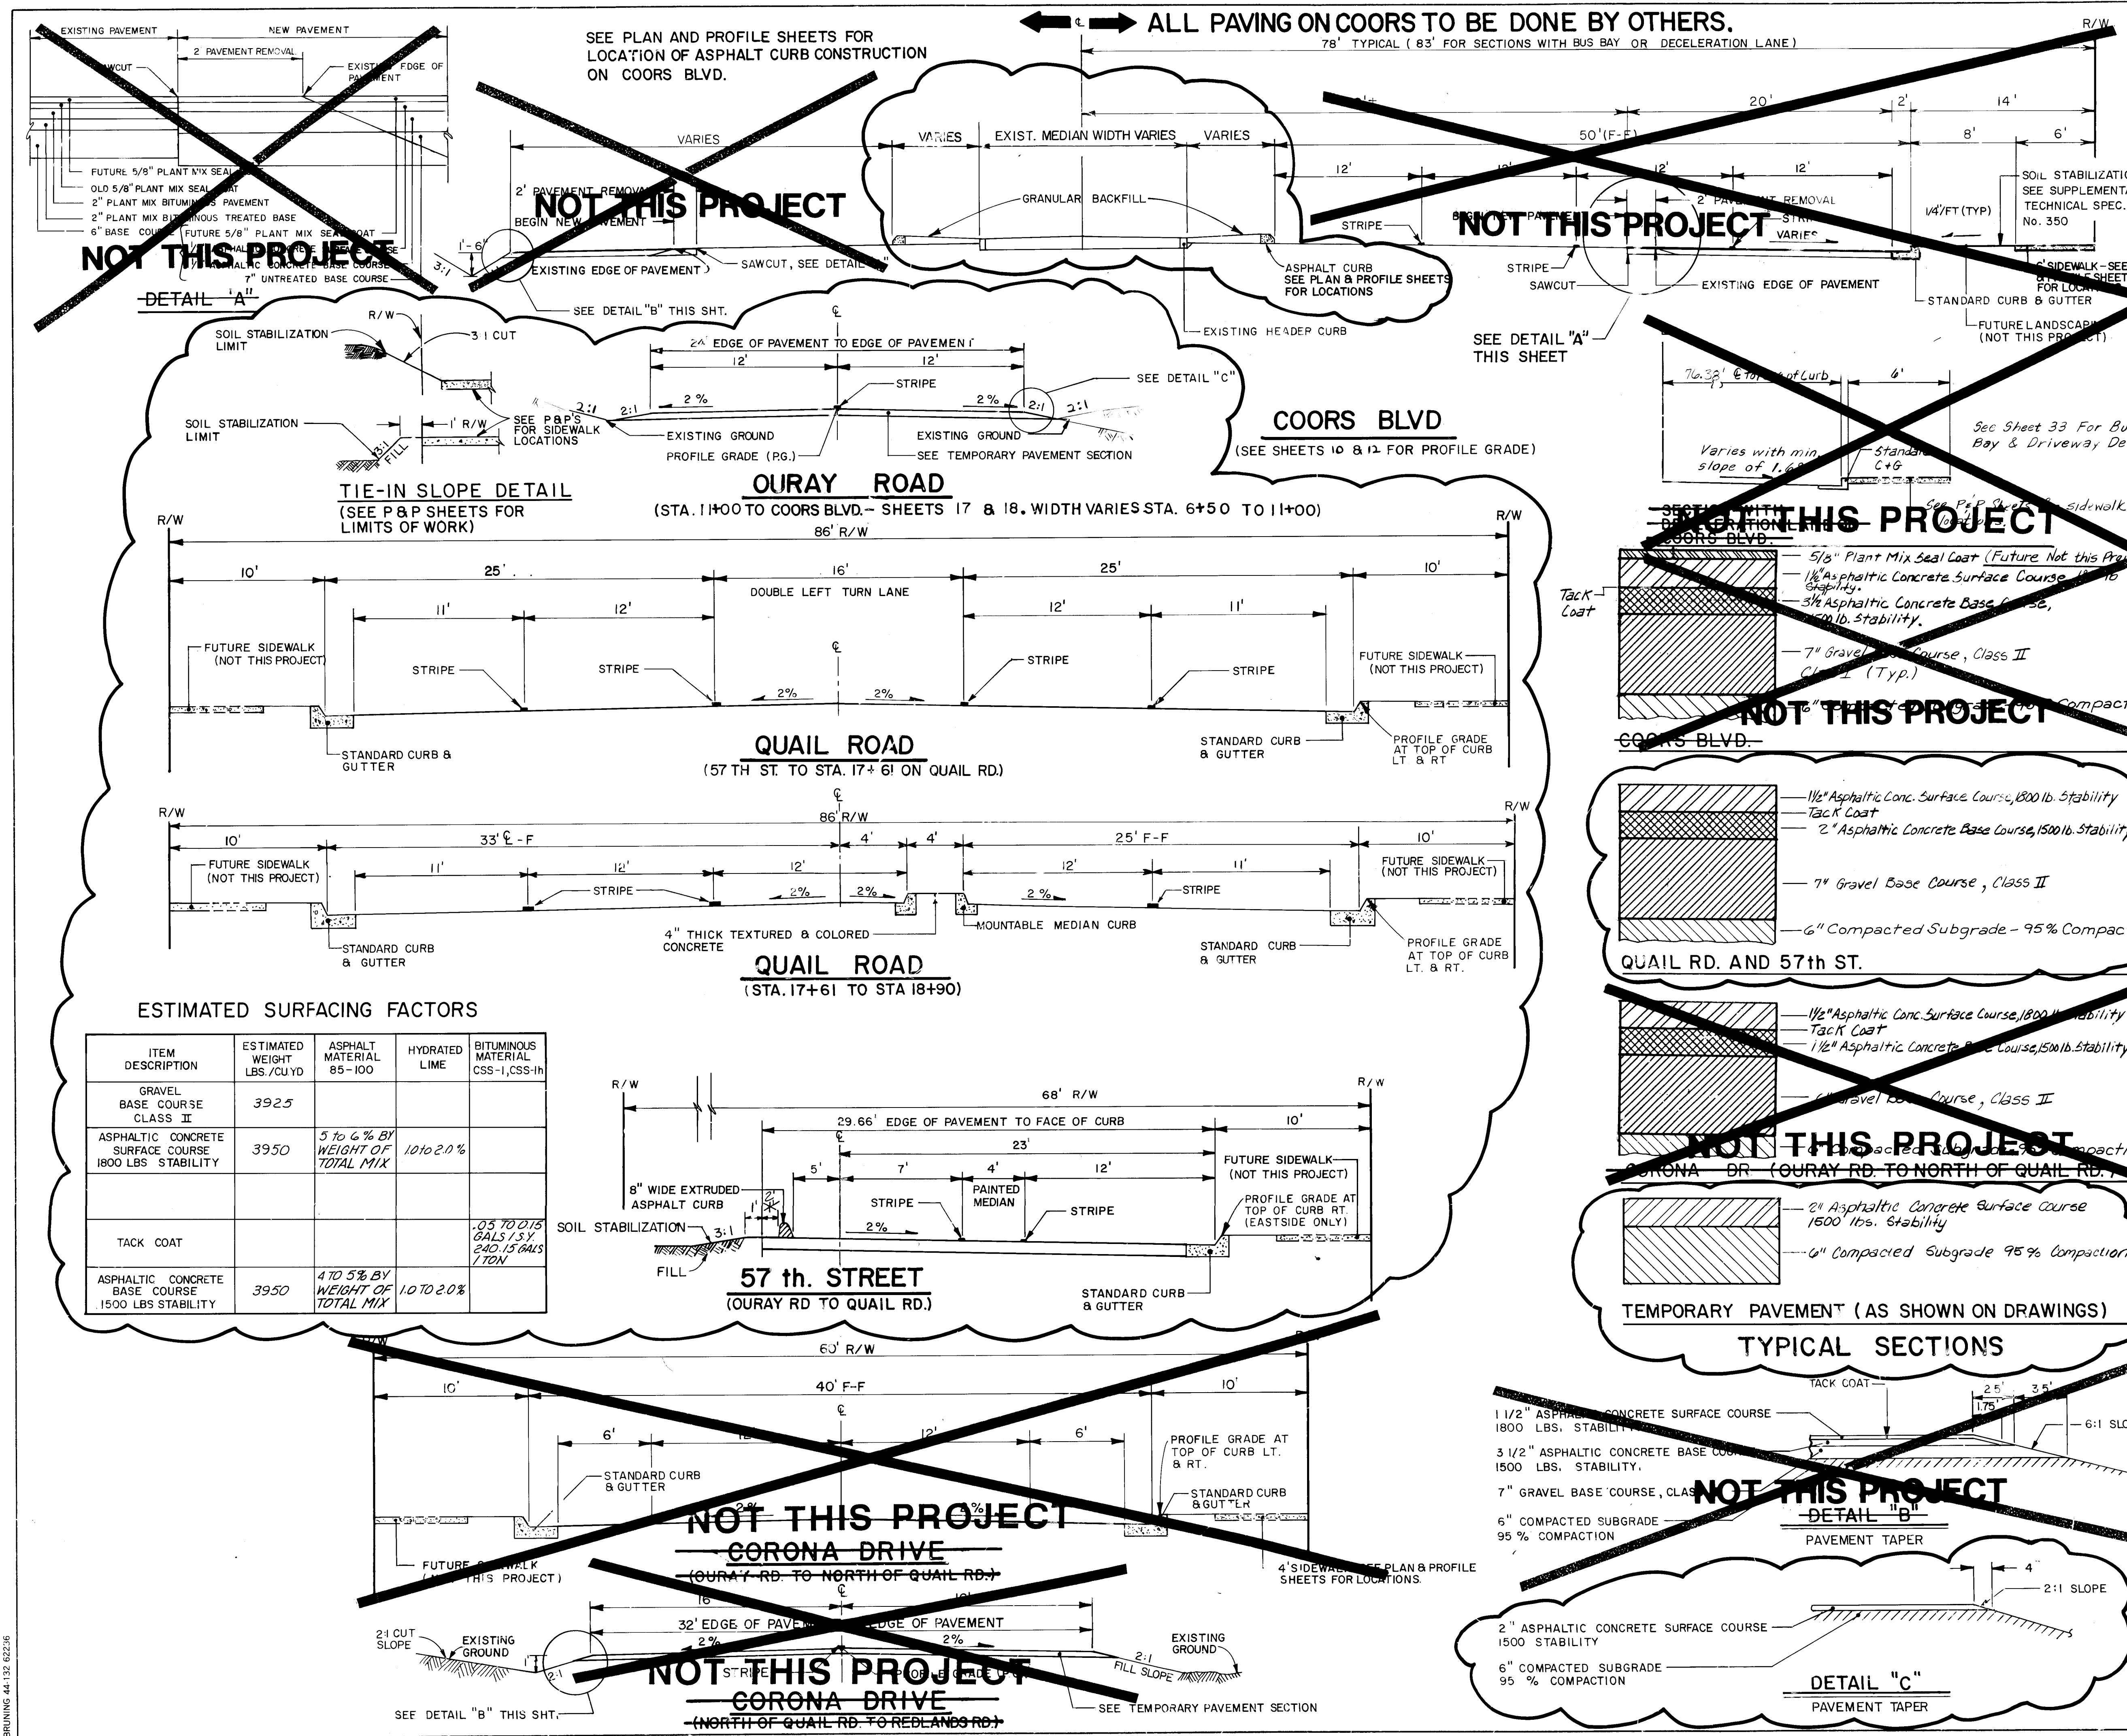

- NOTES:**
- 1.) ALL STRIPING AND PAINTING ON ROAD TO BE DONE BY OTHERS.
 - 2.) CONC. MEDIANS LESS THAN 5' F-F WILL REQUIRE 4" THICK TEXTURED CONC. 4" X 6" RUNNING BOND BRICK. COLOR OF CONCRETE TO BE BAJA RED DAVIS 160 OR ENGINEER APPROVED EQUAL. (SEE CITY STANDARD SPEC 346)
 - 3.) SEE STANDARD DRAWING P-8 FOR ASPHALT CURB DETAIL.
 - 4.) PROFILE GRADE IS TOP OF CURB GRADE UNLESS SHOWN OTHERWISE.
 - 5.) ELEV. OF RIGHT AND LEFT CURBS MAY DIFFER. SEE PROFILE GRADES ON P & P SHEETS.
 - 6.) SOIL STABILIZATION, SEE SUPPLEMENTAL TECHNICAL SPECIFICATIONS 350.
 - 7.) GRANULAR BACKFILL SHALL BE INCIDENTAL TO THE CONTRACT
 - 8.) WHEELCHAIR RAMPS WILL BE CONSTRUCTED AS PART OF THIS PROJECT AND ARE INCLUDED IN THE SIDEWALK BID ITEM.

ESTIMATED SURFACING FACTORS

ITEM DESCRIPTION	ESTIMATED WEIGHT LBS./CU.YD	ASPHALT MATERIAL 85-100	HYDRATED LIME	BITUMINOUS MATERIAL CSS-1, CSS-1h
GRAVEL BASE COURSE CLASS II	3925			
ASPHALTIC CONCRETE SURFACE COURSE 1800 LBS STABILITY	3950	5 TO 6% BY WEIGHT OF TOTAL MIX	10 TO 2.0%	
TACK COAT				.05 TO .015 GALS / SY 240.15 GALS / TON
ASPHALTIC CONCRETE BASE COURSE 1500 LBS STABILITY	3950	4 TO 5% BY WEIGHT OF TOTAL MIX	10 TO 2.0%	

AS BUILT INFORMATION

CONTRACTOR: **SWANSON MECHANICAL**

DATE: **8/14/87**

INSPECTOR: **BHI**

DATE: **8/14/87**

DESIGNED BY: **CEP**

DATE: **8/14/87**

REVIEWED BY: **BHI**

DATE: **8/14/87**

RECORDED BY: **BHI**

DATE: **8/14/87**

ENGINEER'S SEAL

DATE: **8/14/87**

RECORD DRAWINGS

DATE: **4/28/88**

NOT TO SCALE


26 33 160988

CITY OF ALBUQUERQUE

TITLE: COORS WIDENING- LOTS 2 & 3 TYPICAL SECTIONS

APPROVALS	ENGINEER	DATE	APPROVALS	ENGINEER	DATE
D.R.C. - Chairman	ACE	8/24/87	Liquid Waste	ACE	8/14/87
ACE - Design	ACE	8/24/87	Traffic	ACE	8/14/87
ACE - Hydrology	ACE	8/24/87	Water	ACE	8/14/87

DRAWING NO. **3316** MAP NO. **H-11** SHEET **9** OF **38**

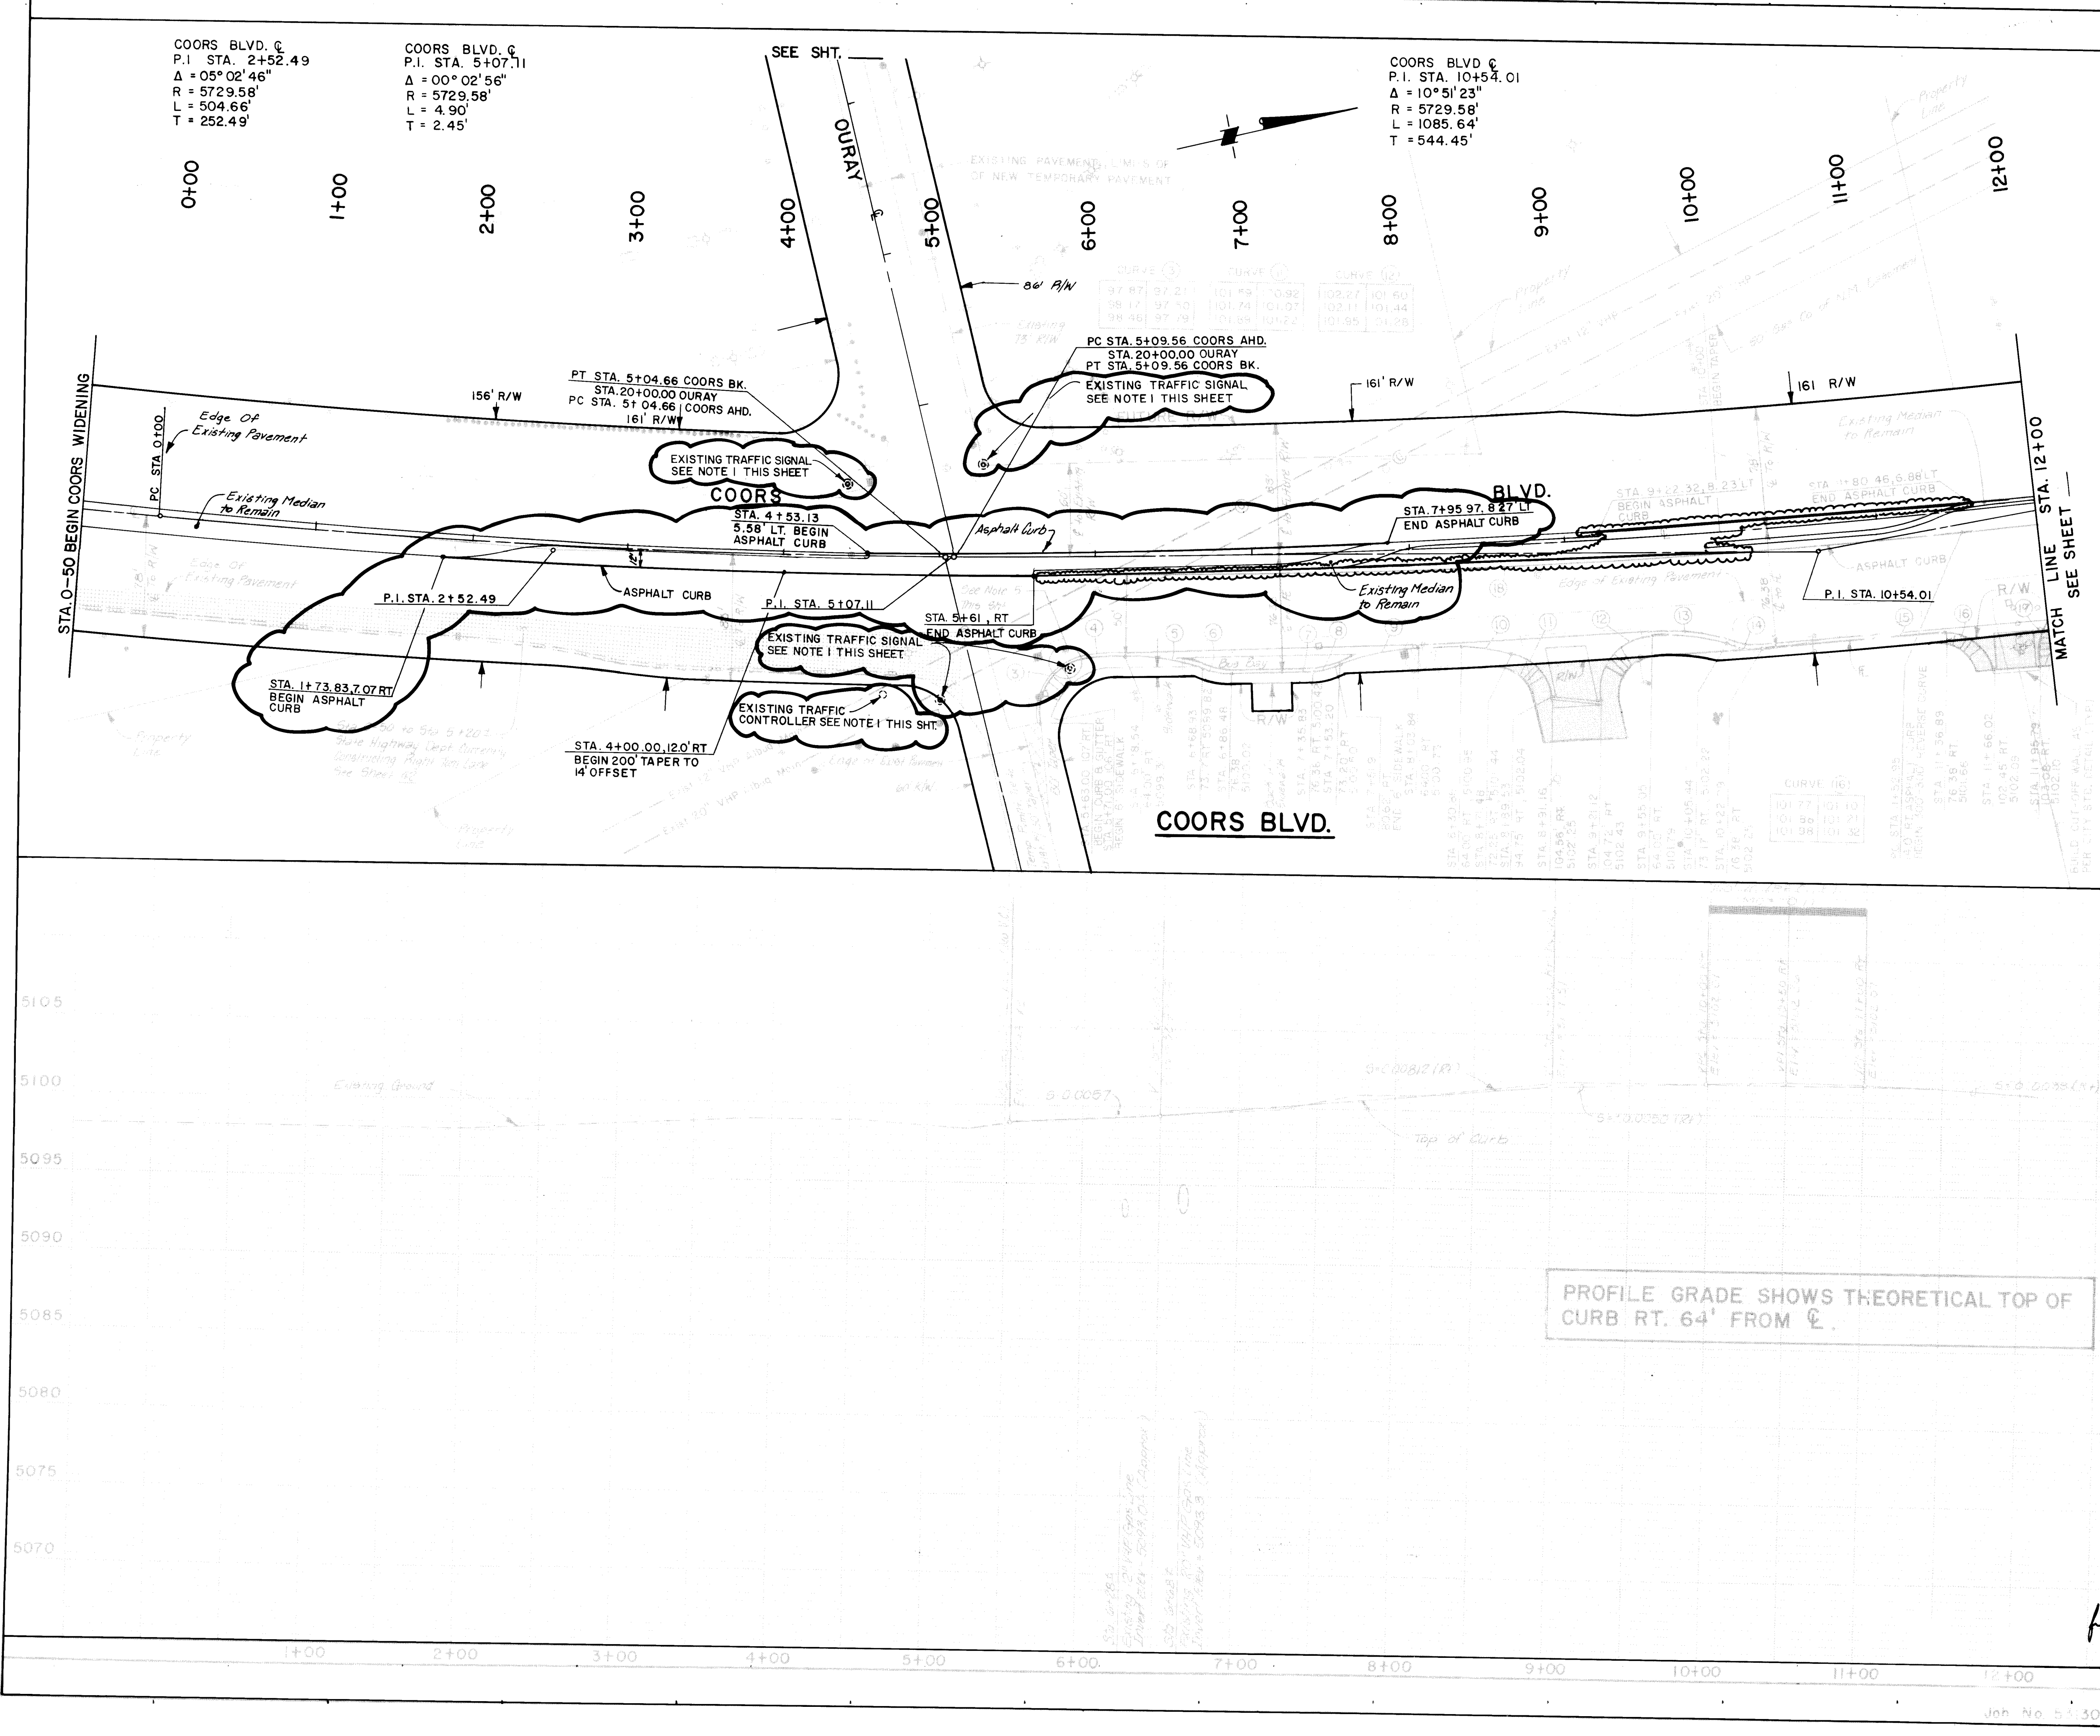

COORS BLVD. C
P.I. STA. 2+52.49
 $\Delta = 05^{\circ}02'46''$
 $R = 5729.58'$
 $L = 504.66'$
 $T = 252.49'$

COORS BLVD. C
P.I. STA. 5+07.11
 $\Delta = 00^{\circ}02'56''$
 $R = 5729.58'$
 $L = 4.90'$
 $T = 2.45'$

COORS BLVD. C
P.I. STA. 10+54.01
 $\Delta = 10^{\circ}51'23''$
 $R = 5729.58'$
 $L = 1085.64'$
 $T = 544.45'$

NOTES

- The traffic signals at the Coors/Coors intersection shall remain in operation until the median openings are closed. All of the traffic signal equipment, including traffic controller, signals, pull boxes and foundations shall be removed. All salvageable equipment shall be transported by the Contractor to the City Yards, 5501 Pino Street N.E., with the exception of the controller which will be transported by City personnel. The Contractor shall give three (3) days notice to Tom Kennerly at 505/764-1599 before transporting this equipment. The Contractor shall also give the City three (3) days notice prior to excavating the traffic controller. The removal and transportation of these traffic signal facilities shall be included in Bid Item No. 1 in the Bid Proposal.
- See sheets 11 and 18 for Coors/Coors storm sewer work.

AS BUILT INFORMATION		BENCH MARKS		SURVEY INFORMATION		ENGINEER'S SEAL	
CONTRACTOR	DATE	STA. N.M. 448-N3 ELEV. 5099.927	DATE	NO.	BY	NO.	DATE
WORK BY: BHI	DATE: 8/18	STANDARD N.M.S.C. BRASS TABLET SET FLUSH IN TOP OF CONCRETE POST, LOCATED IN THE SOUTHWEST CORNER OF "WEST MESA BOWL" BOWLING ALLEY PARKING LOT.	DATE: 8/18				
FILED BY: BHI	DATE: 8/18						
REVISIONS BY: BHI	DATE: 8/18						
CHECKED BY: BHI	DATE: 8/18						
RECORDED BY: BHI	DATE: 8/18						

RECORD DRAWINGS
DATE: 4/28/88

PLAN
SCALE: HORIZ. 1" = 50'

PROFILE
SCALE: HORIZ. 1" = 50'
VERT. 1" = 5'


CITY OF ALBUQUERQUE
PUBLIC WORKS
ENGINEERING

TITLE: COORS WIDENING
COORS BLVD STA 0-50 TO STA 12+00
ROADWAY

APPROVALS	ENGINEER	DATE	APPROVALS	ENGINEER	DATE
City Engineer	ALB	8/14/87	Liquid Waste	NA	8/14/87
A-C-E-Design	"	"	Traffic	David L. Hummer	8/14/87
A-C-E-Hydrology	Stenley	8/14/87	Water	NA	8/14/87

DRAWING NO. 3316 MAP NO. H-11 SHEET 10 OF 38

Job No. 5430

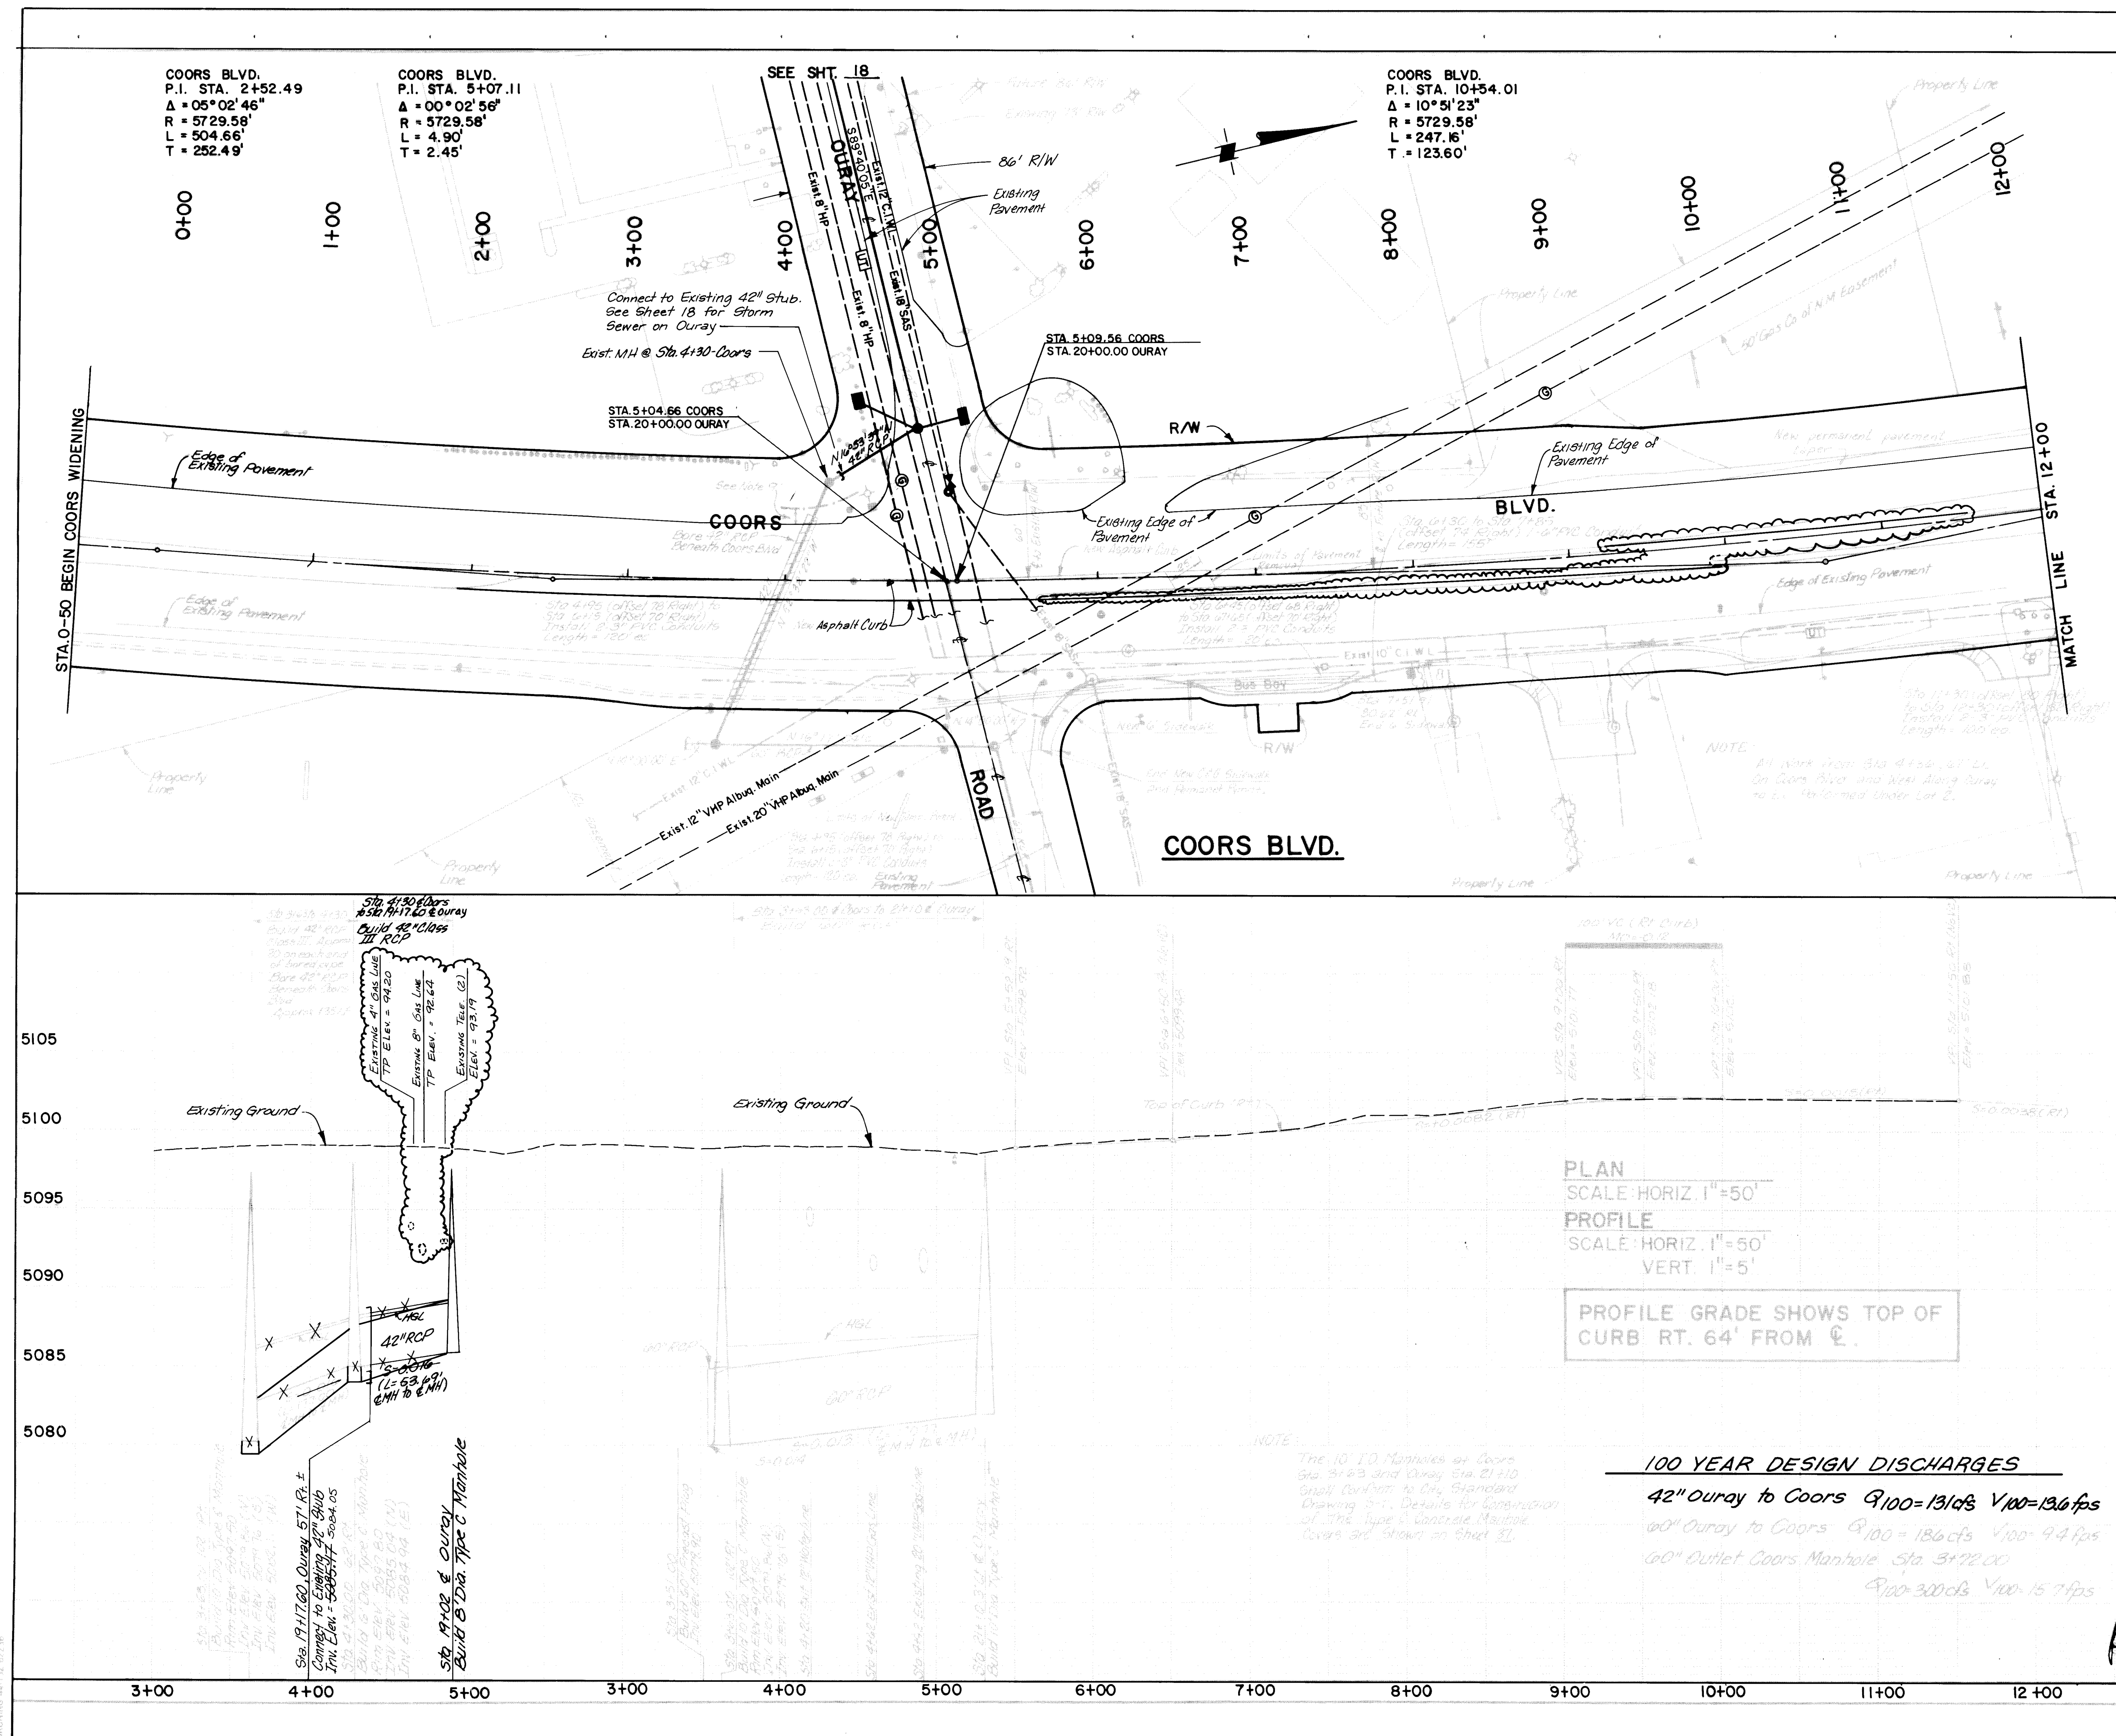

NOTE:
ANY EXCAVATION WORK IN THE AREA OF THE
12-INCH AND 20-INCH HIGH PRESSURE GAS
LINES SHALL REQUIRE THE PRESENCE OF
A GAS COMPANY OF NEW MEXICO
REPRESENTATIVE. IT IS THE CONTRACTORS
RESPONSIBILITY TO CONTACT GAS COMPANY
OF NEW MEXICO REPRESENTATIVE AL MEYERS
AT 889-8421. EMERGENCY NUMBER 345-6058.

PLAN

SCALE : HORIZ. 1" = 50'

PROFILE

SCALE: HORIZ. 1" = 50'
VERT. 1" = 5'

1	2	3	4	5	6	7	8	9	10	11	12
26			33	16	11	88					



TITLE:	COORS WIDENING - LOTS 2 & 3 COORS BLVD. STA. 0+50 TO STA. 12+00
--------	--


APPROVALS	ENGINEER	DATE	APPROVALS	ENGINEER	DATE
City Engineer	<i>[Signature]</i>	8/26/87	Liquid Waste	NA	JEE 8/14/87
A.C.E.-Design	" "	"	Traffic		Daniel W. Hume 8/15/87
A.C.E.-Hydrology	Steve Bolong	8/26/87	Water	NA	JEE 8/14/87

		ENGINEER'S SEAL		SURVEY INFORMATION		BENCH MARKS		AS BUILT INFORMATION	
				FIELD NOTES		STA N.M. 448-N3 ELEV. 5099.527		CONTRACTOR SUNDANCE MECHANICAL	
				NO.		BY		DATE	
						STANDARD N.M.S.H.C BRASS TABLET SET FLUSH IN TOP OF CONCRETE POST, LOCATED IN THE SOUTHWEST EDGE OF "WEST MESA BOWL" BOWLING ALLEY PARKING LOT.		WORK STARTED BY B.H.T.	
								DATE	
								FIELD	
								ASSEMBLY BY GAP	
								DATE 5/88	
								FIELD	
								CORRECTION BY BHT	
								DATE 4/88	
								CORRECTED BY BHT	
								DATE 4/88	
								MICRO-FILM INFORMATION	
								RECORDED BY	
								DATE	
								NO	

[illegible]

BENCH MARKS
STA. N.M. 448 - N3 ELEV. 5099.927
STANDARD N.M.S.H.C. BRASS TABLET SET FLUSH
IN TOP OF CONCRETE POST, LOCATED IN THE
SOUTHWEST EDGE OF "WEST MESA BOWL"
BOWLING ALLEY PARKING LOT.

AS BUILT INFORMATION	
INSTRATOR SUNDANCE MECHANICAL	
APPROVED BY BHI.	
SPECTOR'S	DATE
EXPERIENCE BY CGP	DATE 5/08
FIELD	
IFICATION BY BHI	DATE 4/08
RECTED BY BHI	DATE 4/08
MICRO-FILM INFORMATION	
RECORDED BY	DATE

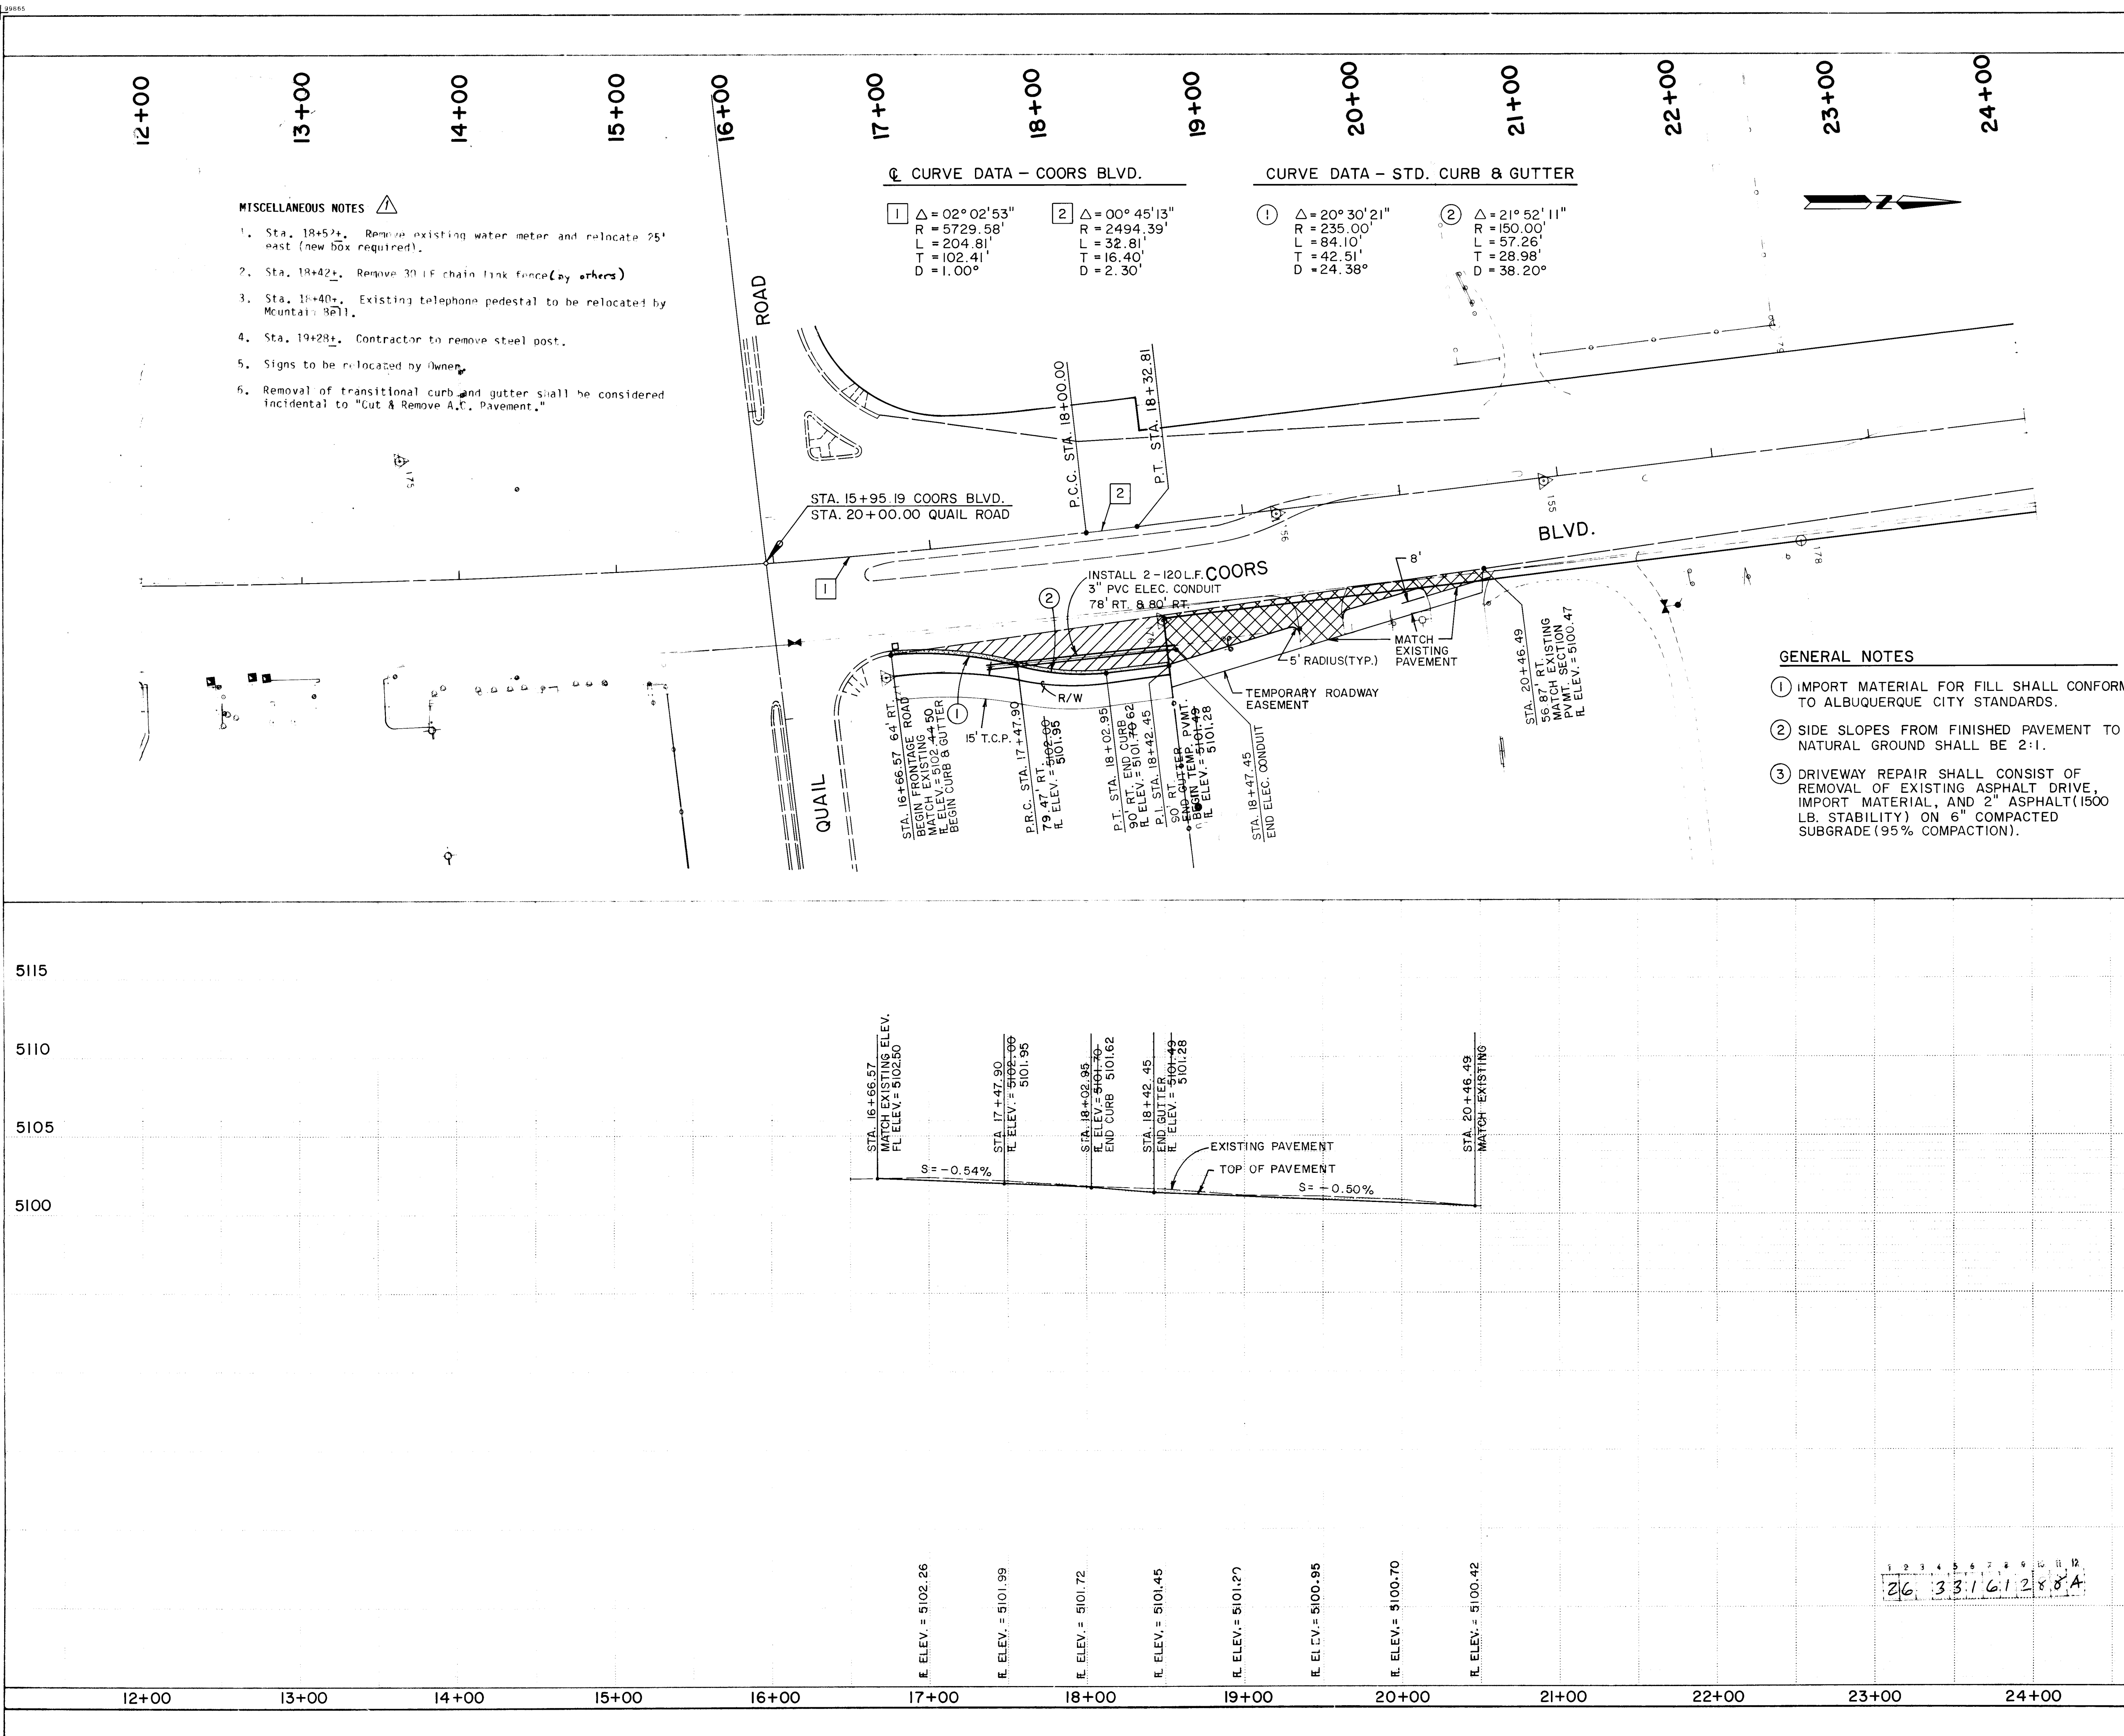

- MISCELLANEOUS NOTES
- Sta. 18+57+. Remove existing water meter and relocate 25' east (new box required).
 - Sta. 18+42+. Remove 30' IF chain link fence (by others).
 - Sta. 18+40+. Existing telephone pedestal to be relocated by Mountain Bell.
 - Sta. 19+28+. Contractor to remove steel post.
 - Signs to be relocated by Owner.
 - Removal of transitional curb and gutter shall be considered incidental to "Cut & Remove A.C. Pavement."

CURVE DATA - COORS BLVD.


1	$\Delta = 02^{\circ}02'53''$ R = 5729.58' L = 204.81' T = 102.41' D = 1.00°	2	$\Delta = 00^{\circ}45'13''$ R = 2494.39' L = 32.81' T = 16.40' D = 2.30°
---	---	---	---

CURVE DATA - STD. CURB & GUTTER

1	$\Delta = 20^{\circ}30'21''$ R = 235.00' L = 84.10' T = 42.51' D = 24.38°	2	$\Delta = 21^{\circ}52'11''$ R = 150.00' L = 57.26' T = 28.98' D = 38.20°
---	---	---	---


GENERAL NOTES

- IMPORT MATERIAL FOR FILL SHALL CONFORM TO ALBUQUERQUE CITY STANDARDS.
- SIDE SLOPES FROM FINISHED PAVEMENT TO NATURAL GROUND SHALL BE 2:1.
- DRIVEWAY REPAIR SHALL CONSIST OF REMOVAL OF EXISTING ASPHALT DRIVE, IMPORT MATERIAL, AND 2" ASPHALT (1500 LB. STABILITY) ON 6" COMPACTED SUBGRADE (95% COMPACTION).

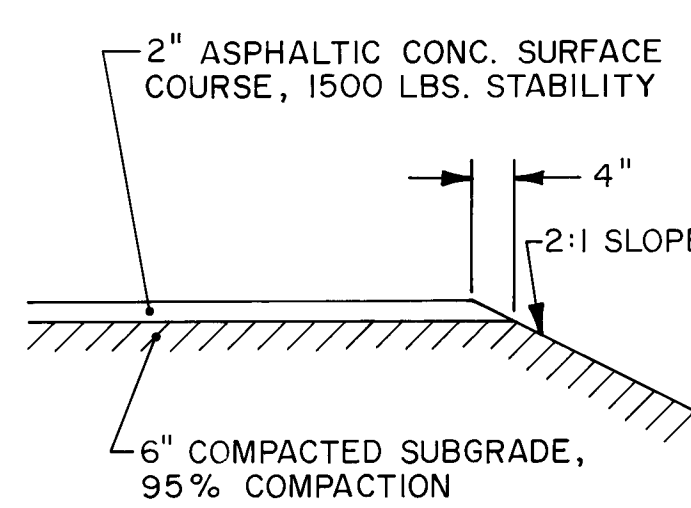

TEMPORARY PAVEMENT TAPER


N.T.S.

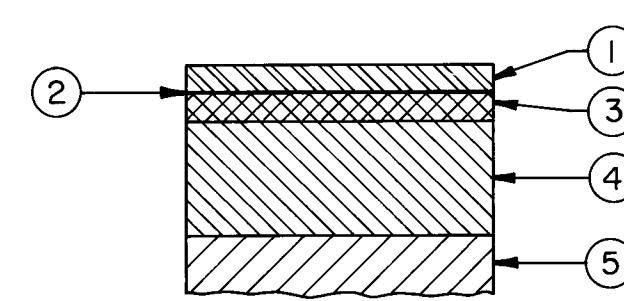

- 1 1/2" ASPHALTIC CONCRETE SURFACE COURSE, 1800 LBS. STABILITY
- TACK COAT
- 3 1/2" ASPHALTIC CONCRETE BASE COURSE, 1500 LBS. STABILITY
- 7" GRAVEL BASE COURSE, CLASS II
- 6" COMPACTED SUBGRADE, 95% COMPACTION

FRONTAGE ROAD SECTION

N.T.S.

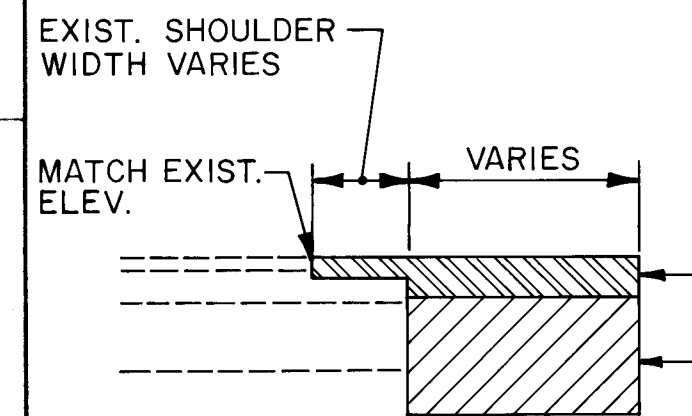

- 2" ASPHALTIC CONCRETE SURFACE COURSE, 1500 LBS. STABILITY
- 6" COMPACTED SUBGRADE, 95% COMPACTION

TEMPORARY PAVEMENT SECTION

N.T.S.

RECORD DRAWINGS

DATE 5/3/81



SCALE
HORIZ. 1" = 50'
VERT. 1" = 5'



CITY OF ALBUQUERQUE
PUBLIC WORKS DEPARTMENT
ENGINEERING GROUP

TITLE: COORS WIDENING
FRONTAGE ROAD

APPROVALS	ENGINEER	DATE	APPROVALS	ENGINEER	DATE
City Engineer			Liquid Waste		
A C E - Design			Traffic		
A C E - Hydrology			Water		

DRAWING NO. MAP NO. SHEET 12A OF

ENGINEER'S SEAL		SURVEY INFORMATION		BENCH MARKS		AS BUILT INFORMATION	
		FIELD NOTES				SURROUNDING MECHANICAL	
		BY		DATE		DATE 5/1/88	
		NO.				DATE 5/1/88	
						DATE 5/1/88	
						DATE 5/1/88	
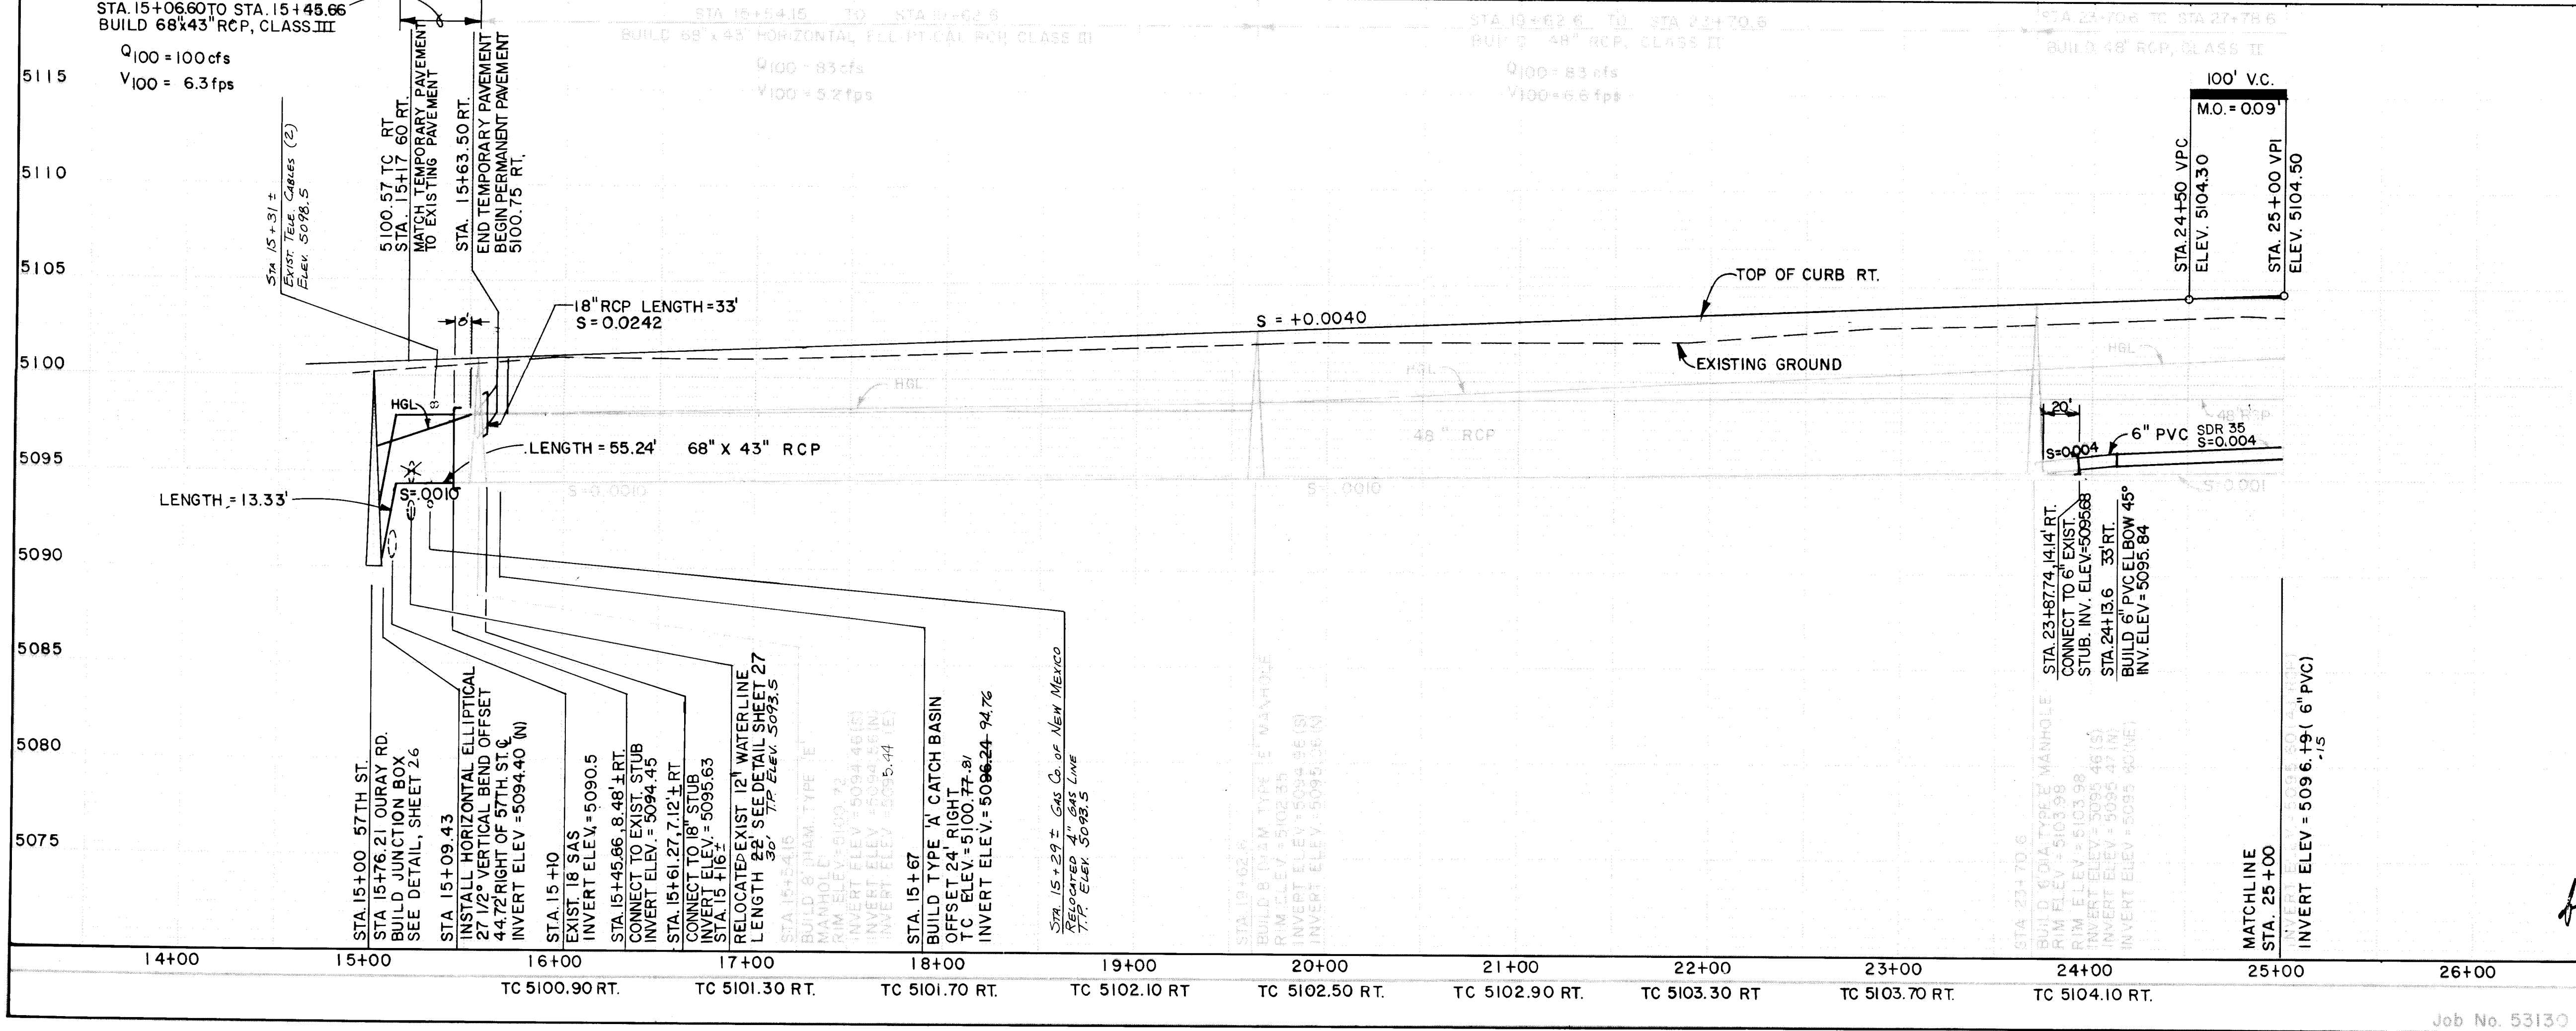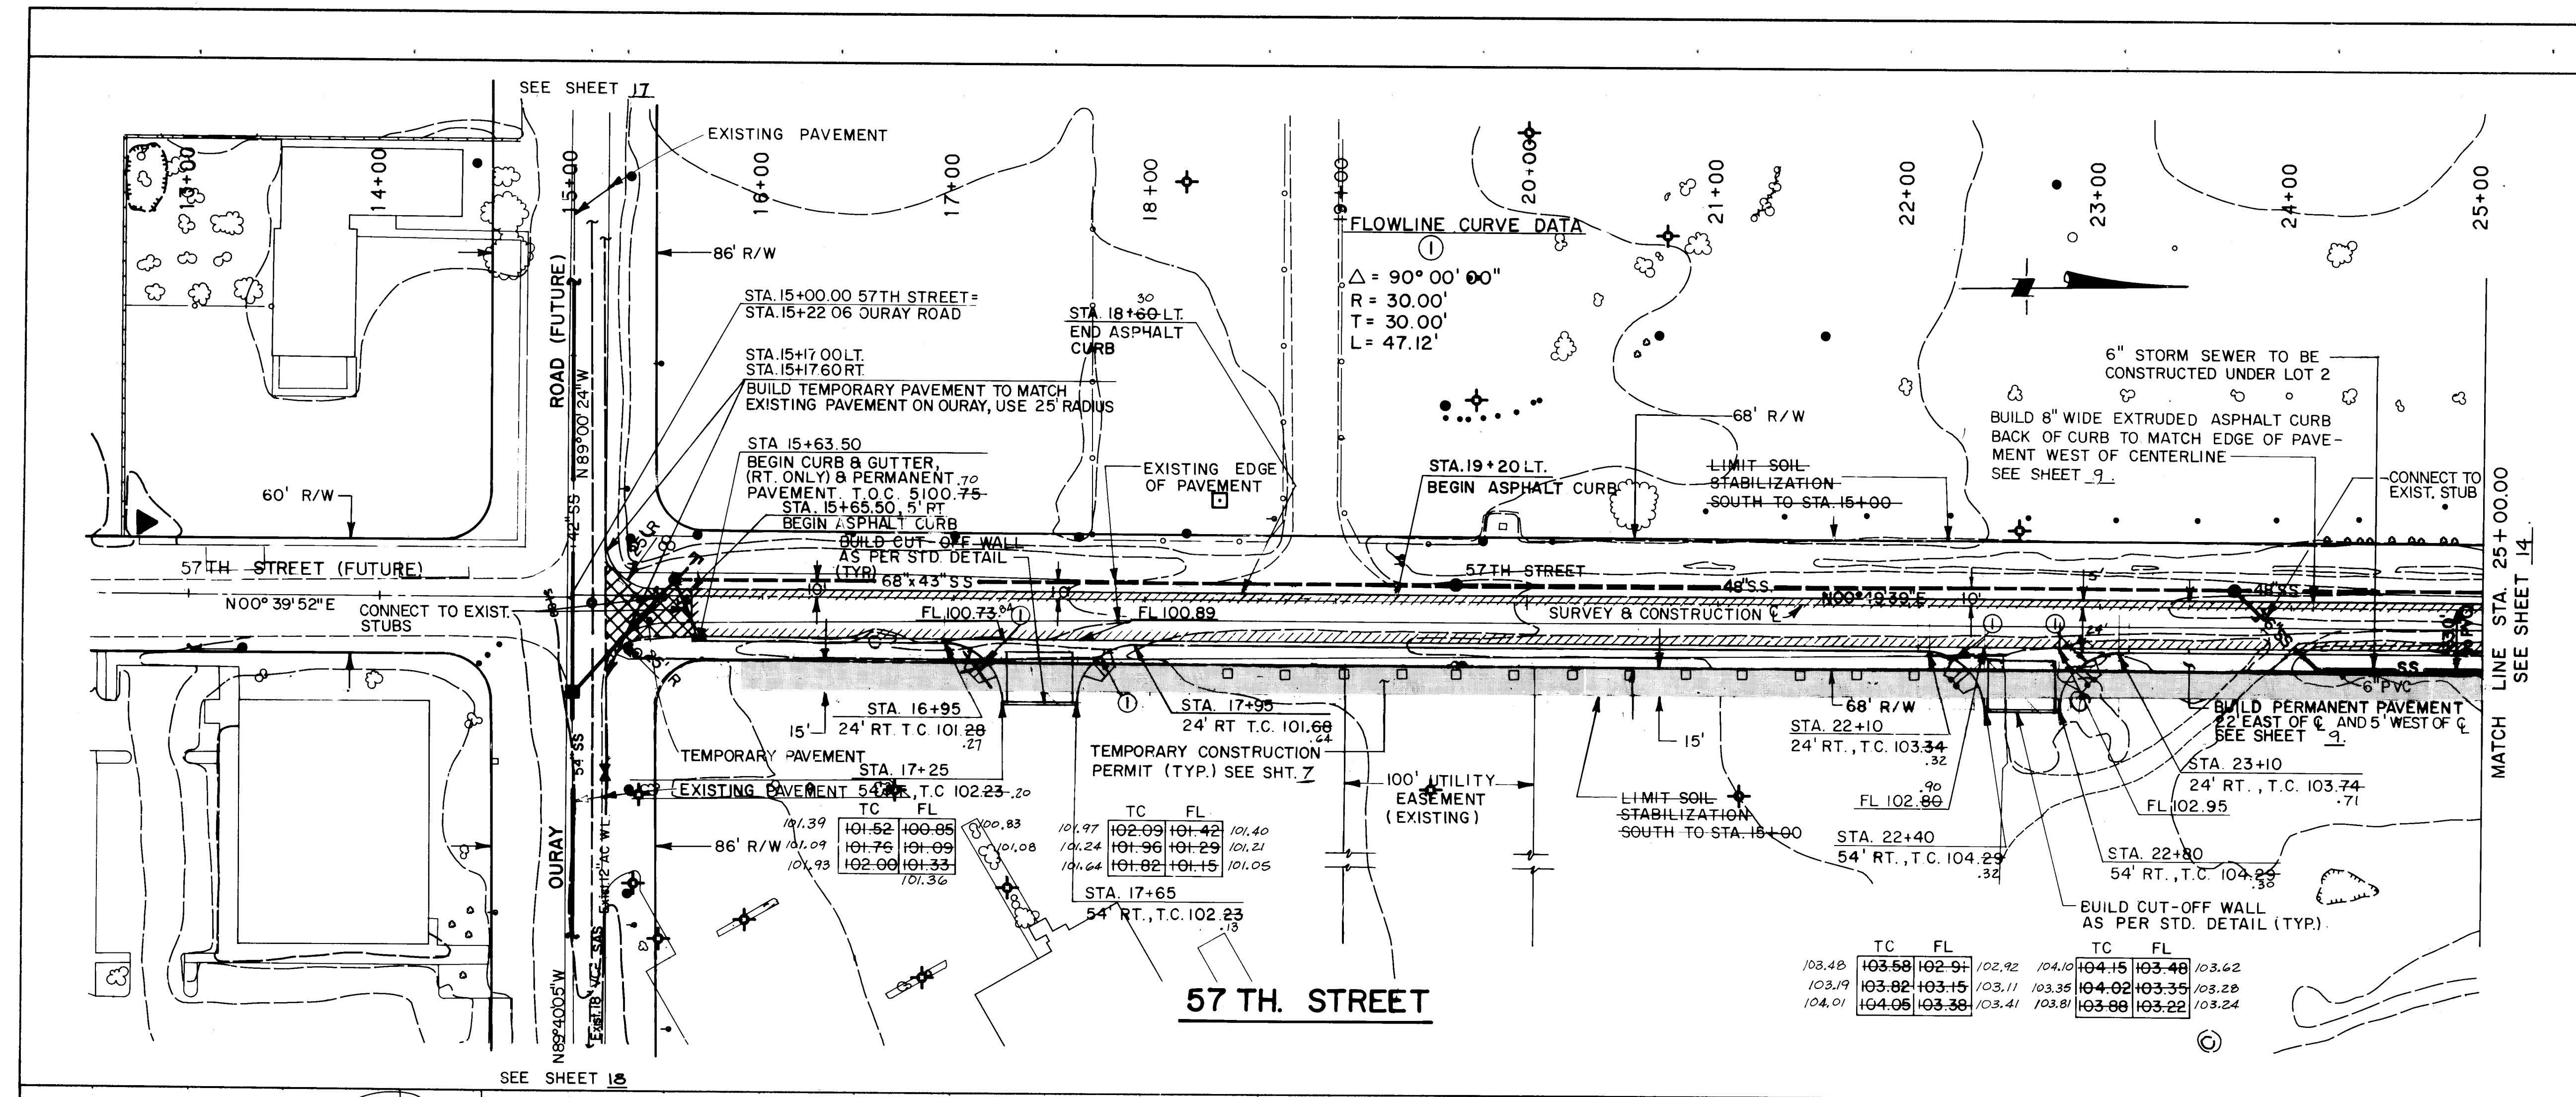

NOTES

- Diaper and Grout all Joints of 68" X 43" Horizontal Elliptical RCP.
- Wheel Chair Ramps to be Centered Within Curve.
- See Sheet 19 For Existing Utilities and Proposed Water and SAS Work.

AS BUILT INFORMATION

CONTRACTOR: SWANSON MECHANICAL
 STATIONED BY: BHI
 FIELD CHECKED BY: CGP
 DATE: 4/28/88
 CALIBRATION BY: BHI
 DATE: 4/88
 MICRO-FILM INFORMATION
 RECORDED BY: []
 NO: []

BENCH MARKS

STA. N.M. 448-N3 ELEV. 5099.827
 STANDARD N.M.S.H.C. BRASS TABLET SET FLUSH IN TOP OF CONCRETE POST, LOCATED IN THE SOUTHWEST CORNER OF "WEST MESA BOWL" BOWLING ALLEY PARKING LOT.

SURVEY INFORMATION

FIELD NOTES
 NO. [] BY [] DATE []

ENGINEER'S SEAL

WILLIAM T. VREDE
 8131
 4/28/88
 REGISTERED PROFESSIONAL ENGINEER

RECORD DRAWINGS

DATE: 4/28/88

PLAN

SCALE: HORIZ. 1" = 50'

PROFILE

SCALE: HORIZ. 1" = 50'

VERT. 1" = 5'

REVISIONS

NO.	DATE	REMARKS
1	3/16/87	DESIGN
2	3/16/87	DESIGN
3	3/16/87	DESIGN
4	3/16/87	DESIGN
5	3/16/87	DESIGN
6	3/16/87	DESIGN
7	3/16/87	DESIGN
8	3/16/87	DESIGN
9	3/16/87	DESIGN
10	3/16/87	DESIGN
11	3/16/87	DESIGN
12	3/16/87	DESIGN

CITY OF ALBUQUERQUE
PUBLIC WORKS
ENGINEERING



TITLE: COORS WIDENING - LOT 2 & 3
 57 TH. STREET STA. 15+00 TO STA. 25+00

APPROVALS

ENGINEER	DATE	ENGINEER	DATE
City Engineer	8/14/87	City Engineer	8/14/87
A.C.E. - Design	8/14/87	A.C.E. - Design	8/14/87
A.C.E. - Hydrology	8/14/87	A.C.E. - Hydrology	8/14/87

DRAWING NO. 3316 **MAP NO.** H-11 **SHEET** 13 **OF** 38

Job No. 53130

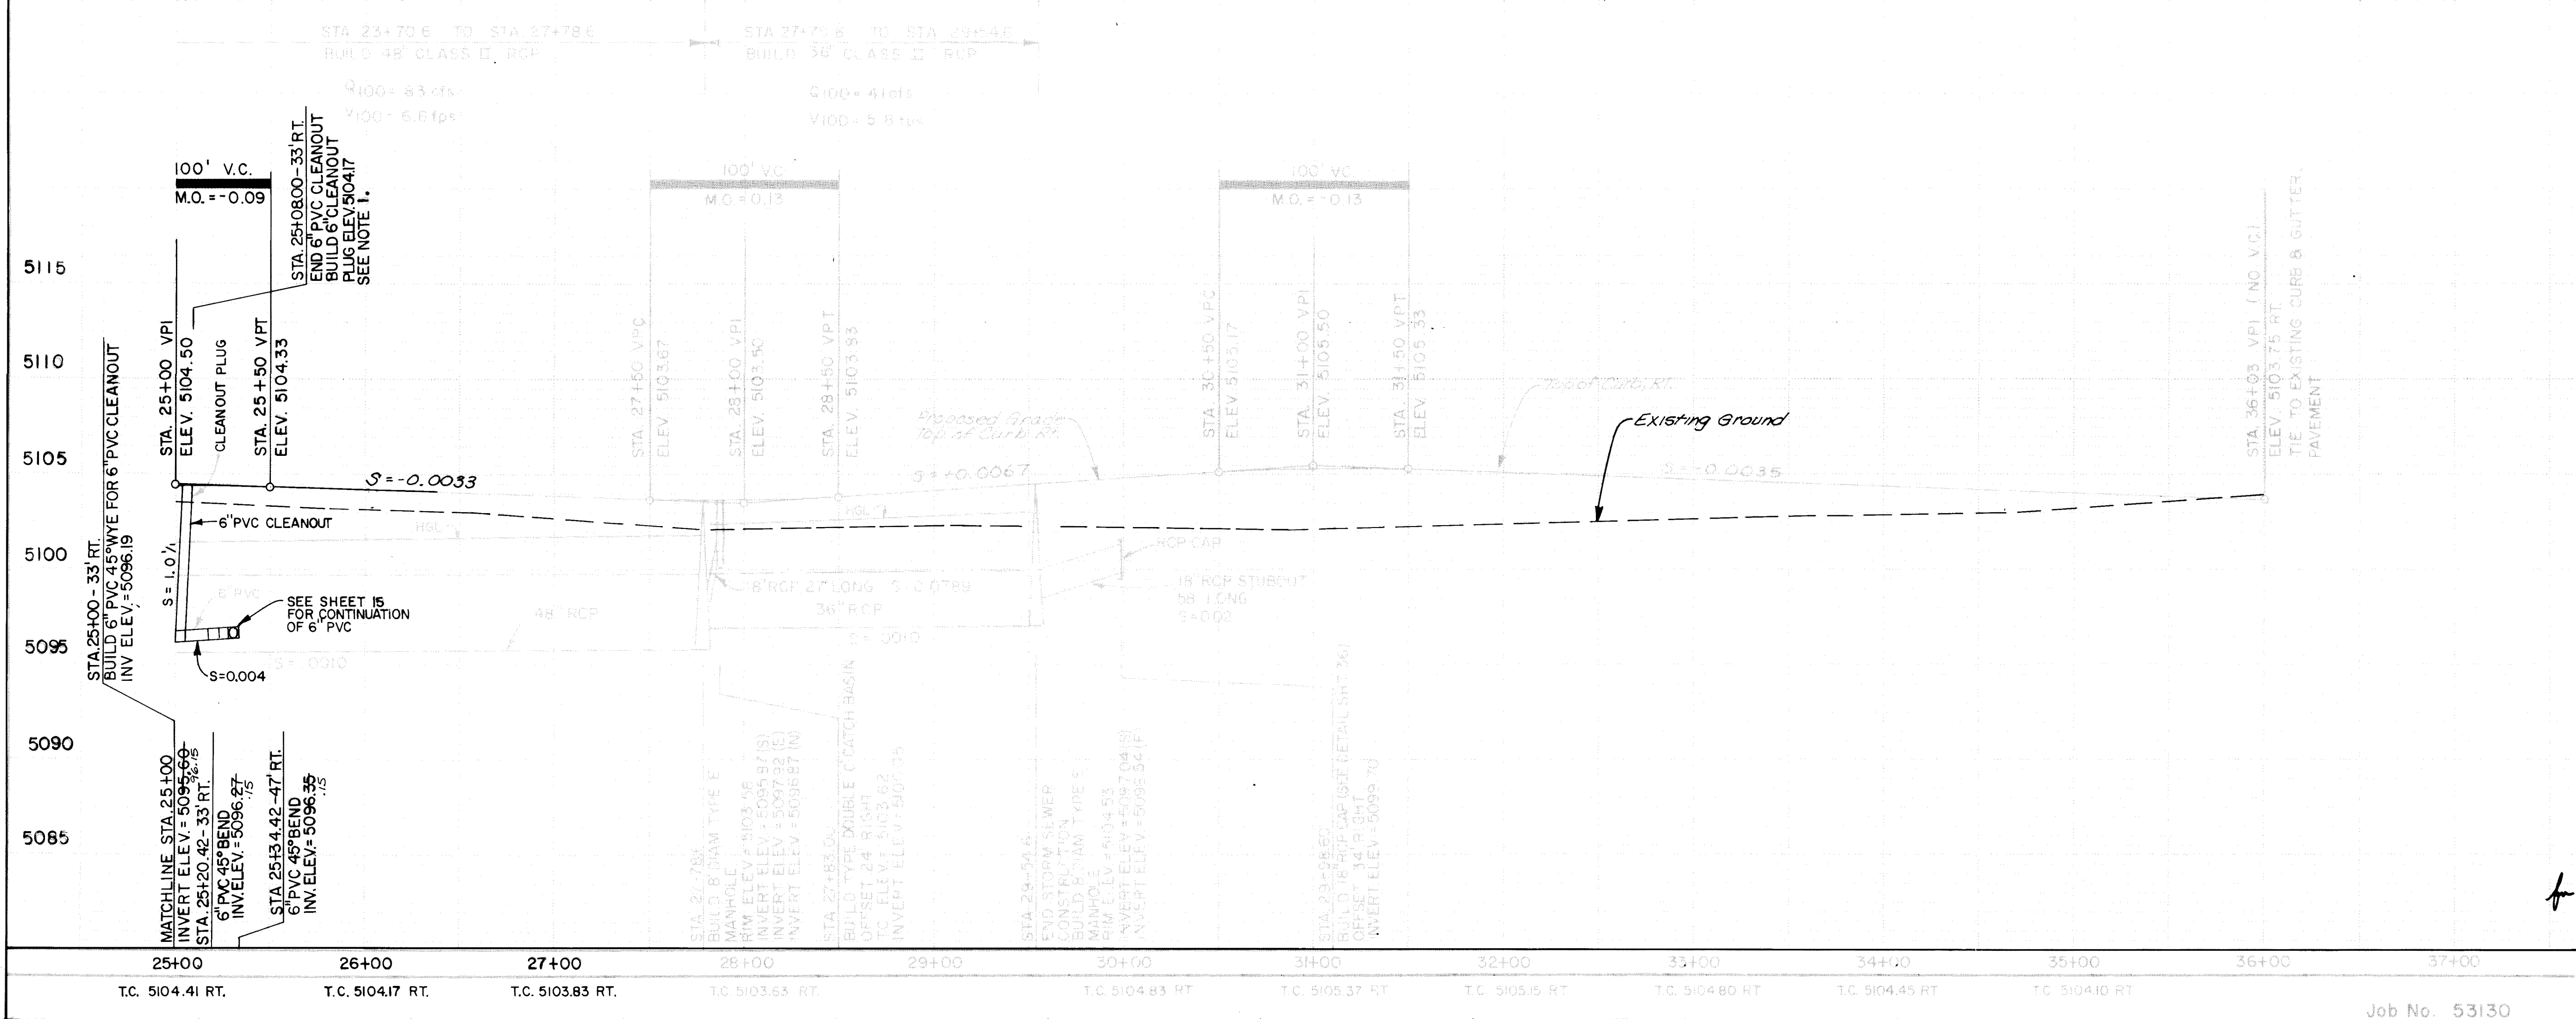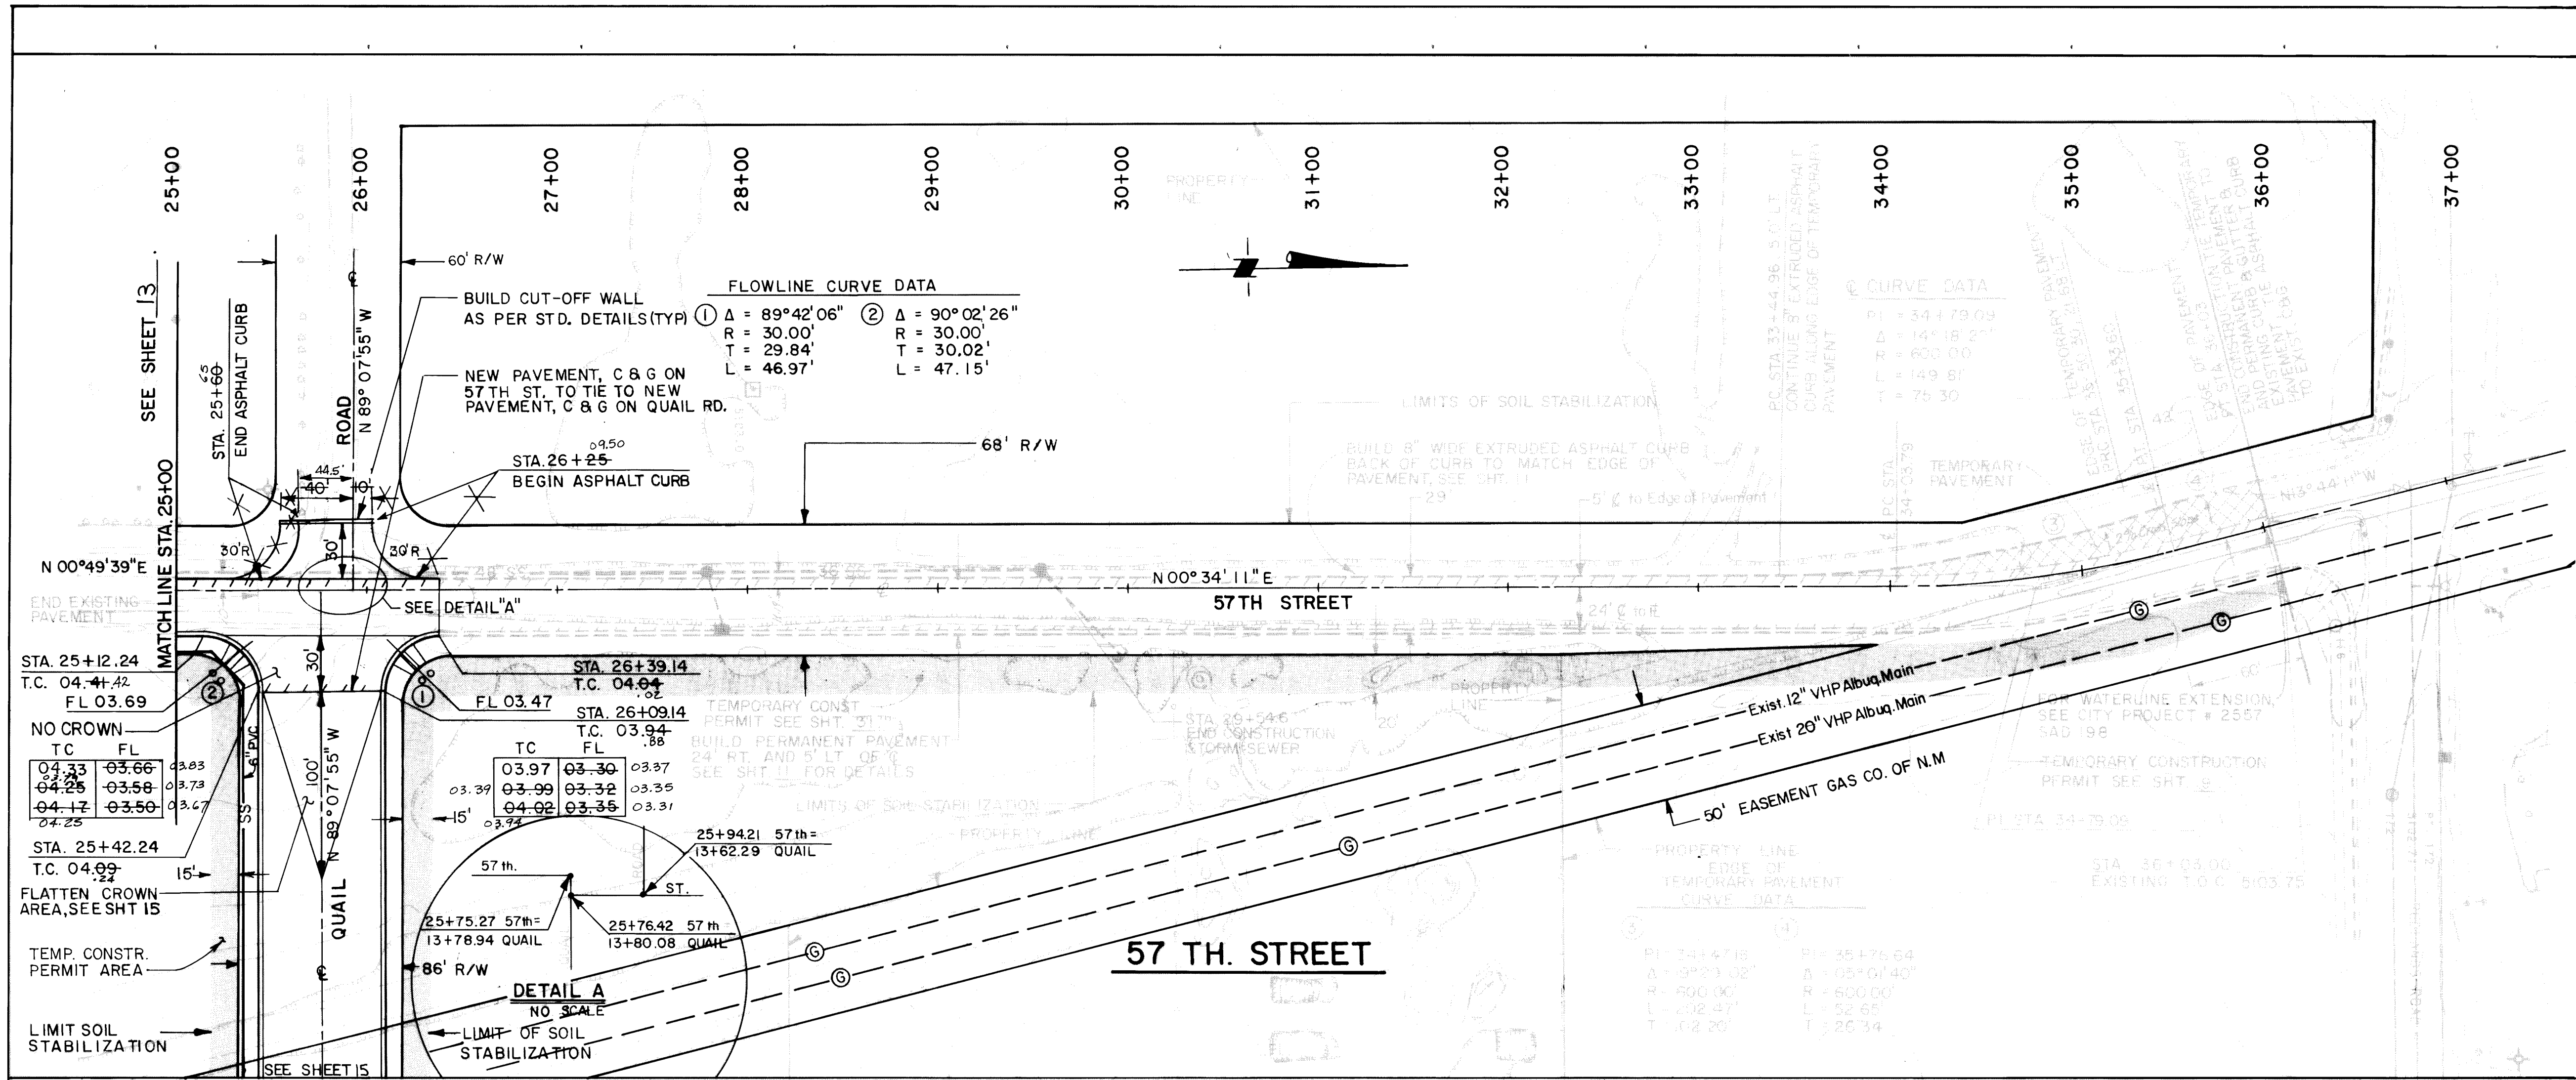

NOTES:
1) Cleanup Plug Shall Conform to ASTM D 3034, Table B, Cleanup Adapter, Cap and Plug or an Engineer Approved Equal May be Substituted.






RECORD DRAWINGS
DATE 4/28/88

NOTE:
ANY EXCAVATION WORK IN THE AREA OF THE 12-INCH AND 20-INCH HIGH PRESSURE GAS LINES SHALL REQUIRE THE PRESENCE OF A GAS COMPANY OF NEW MEXICO REPRESENTATIVE. IT IS THE CONTRACTORS RESPONSIBILITY TO CONTACT GAS COMPANY OF NEW MEXICO REPRESENTATIVE AL MEYERS AT 889-8421. EMERGENCY NUMBER 345-6058.

PLAN
SCALE: HORIZ. 1" = 50'
PROFILE
SCALE: HORIZ. 1" = 50'
VERT. 1" = 5'

26 33 16 14 8 8

CITY OF ALBUQUERQUE PUBLIC WORKS ENGINEERING			
TITLE: COORS WIDENING- LOTS 2 & 3 57 TH. STREET STA. 25+00.00 TO STA. 26+39.14			
APPROVALS	ENGINEER	DATE	APPROVALS
City Engineer	8/26/87	8/26/87	Engineer
ACE-Design	8/26/87	8/26/87	ACE-Design
ACE-Hydrology	8/26/87	8/26/87	ACE-Hydrology
DRAWING NO.	3316	MAP NO. H-11	SHEET 14 OF 38

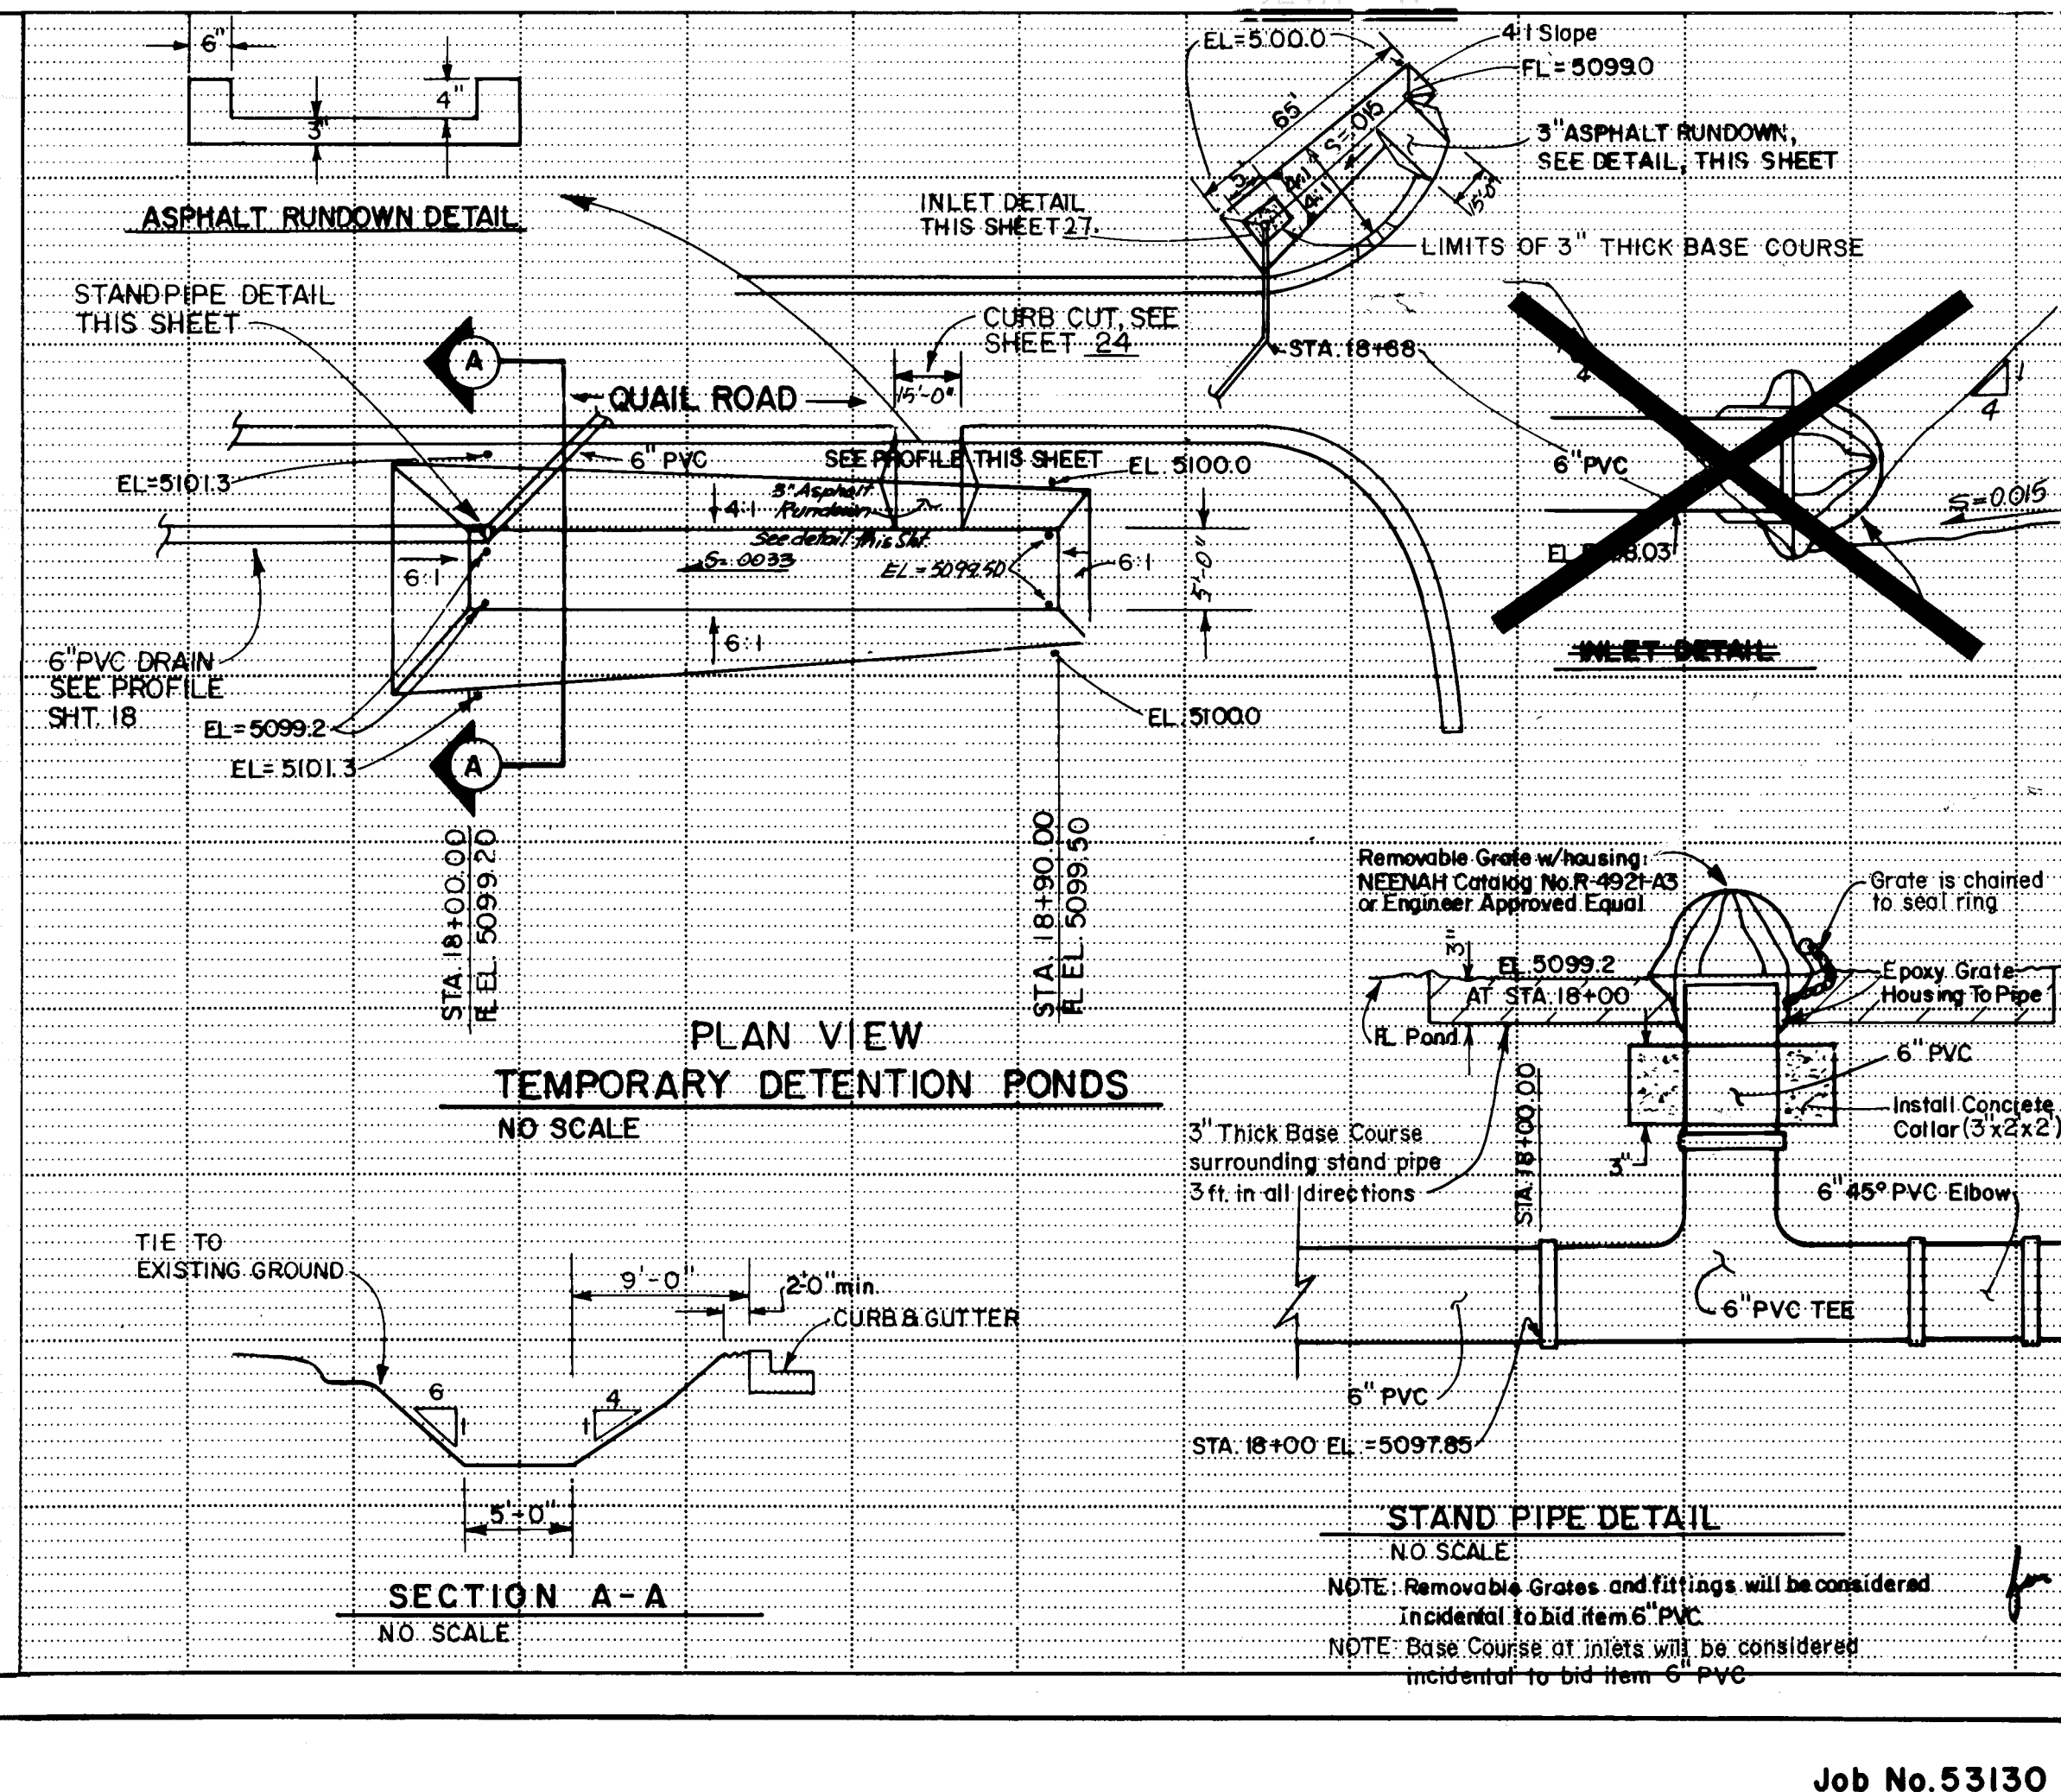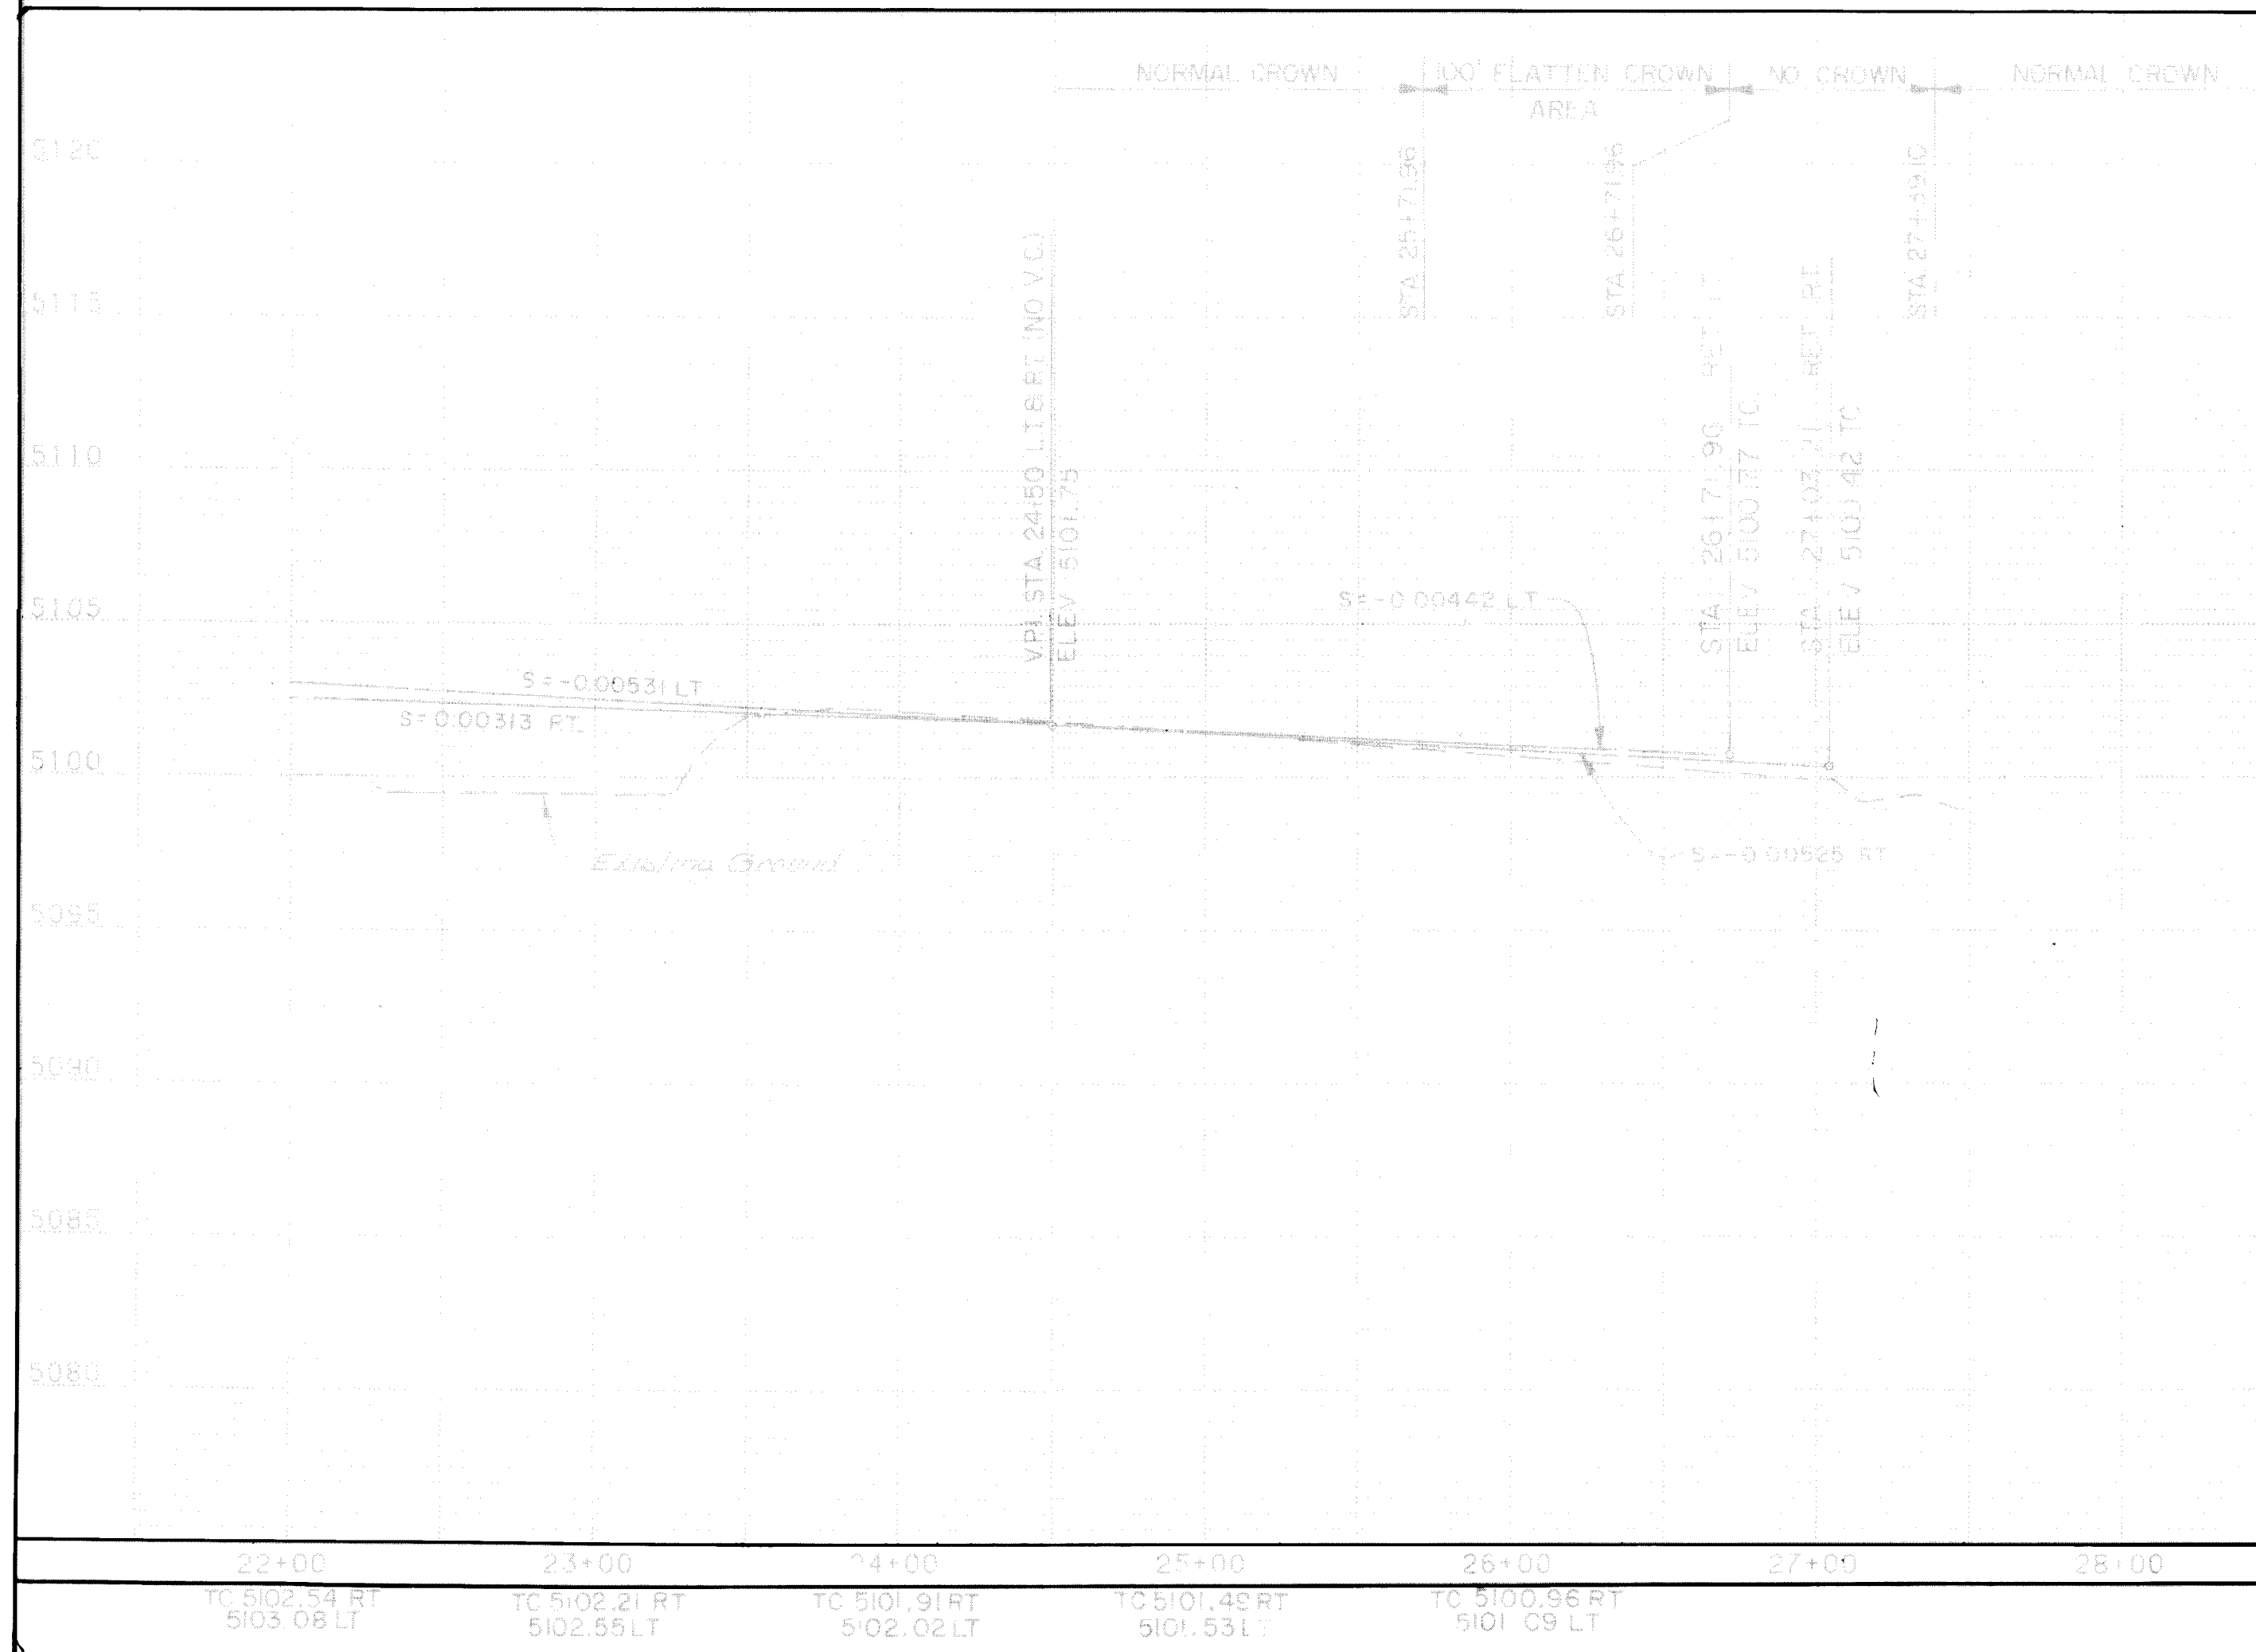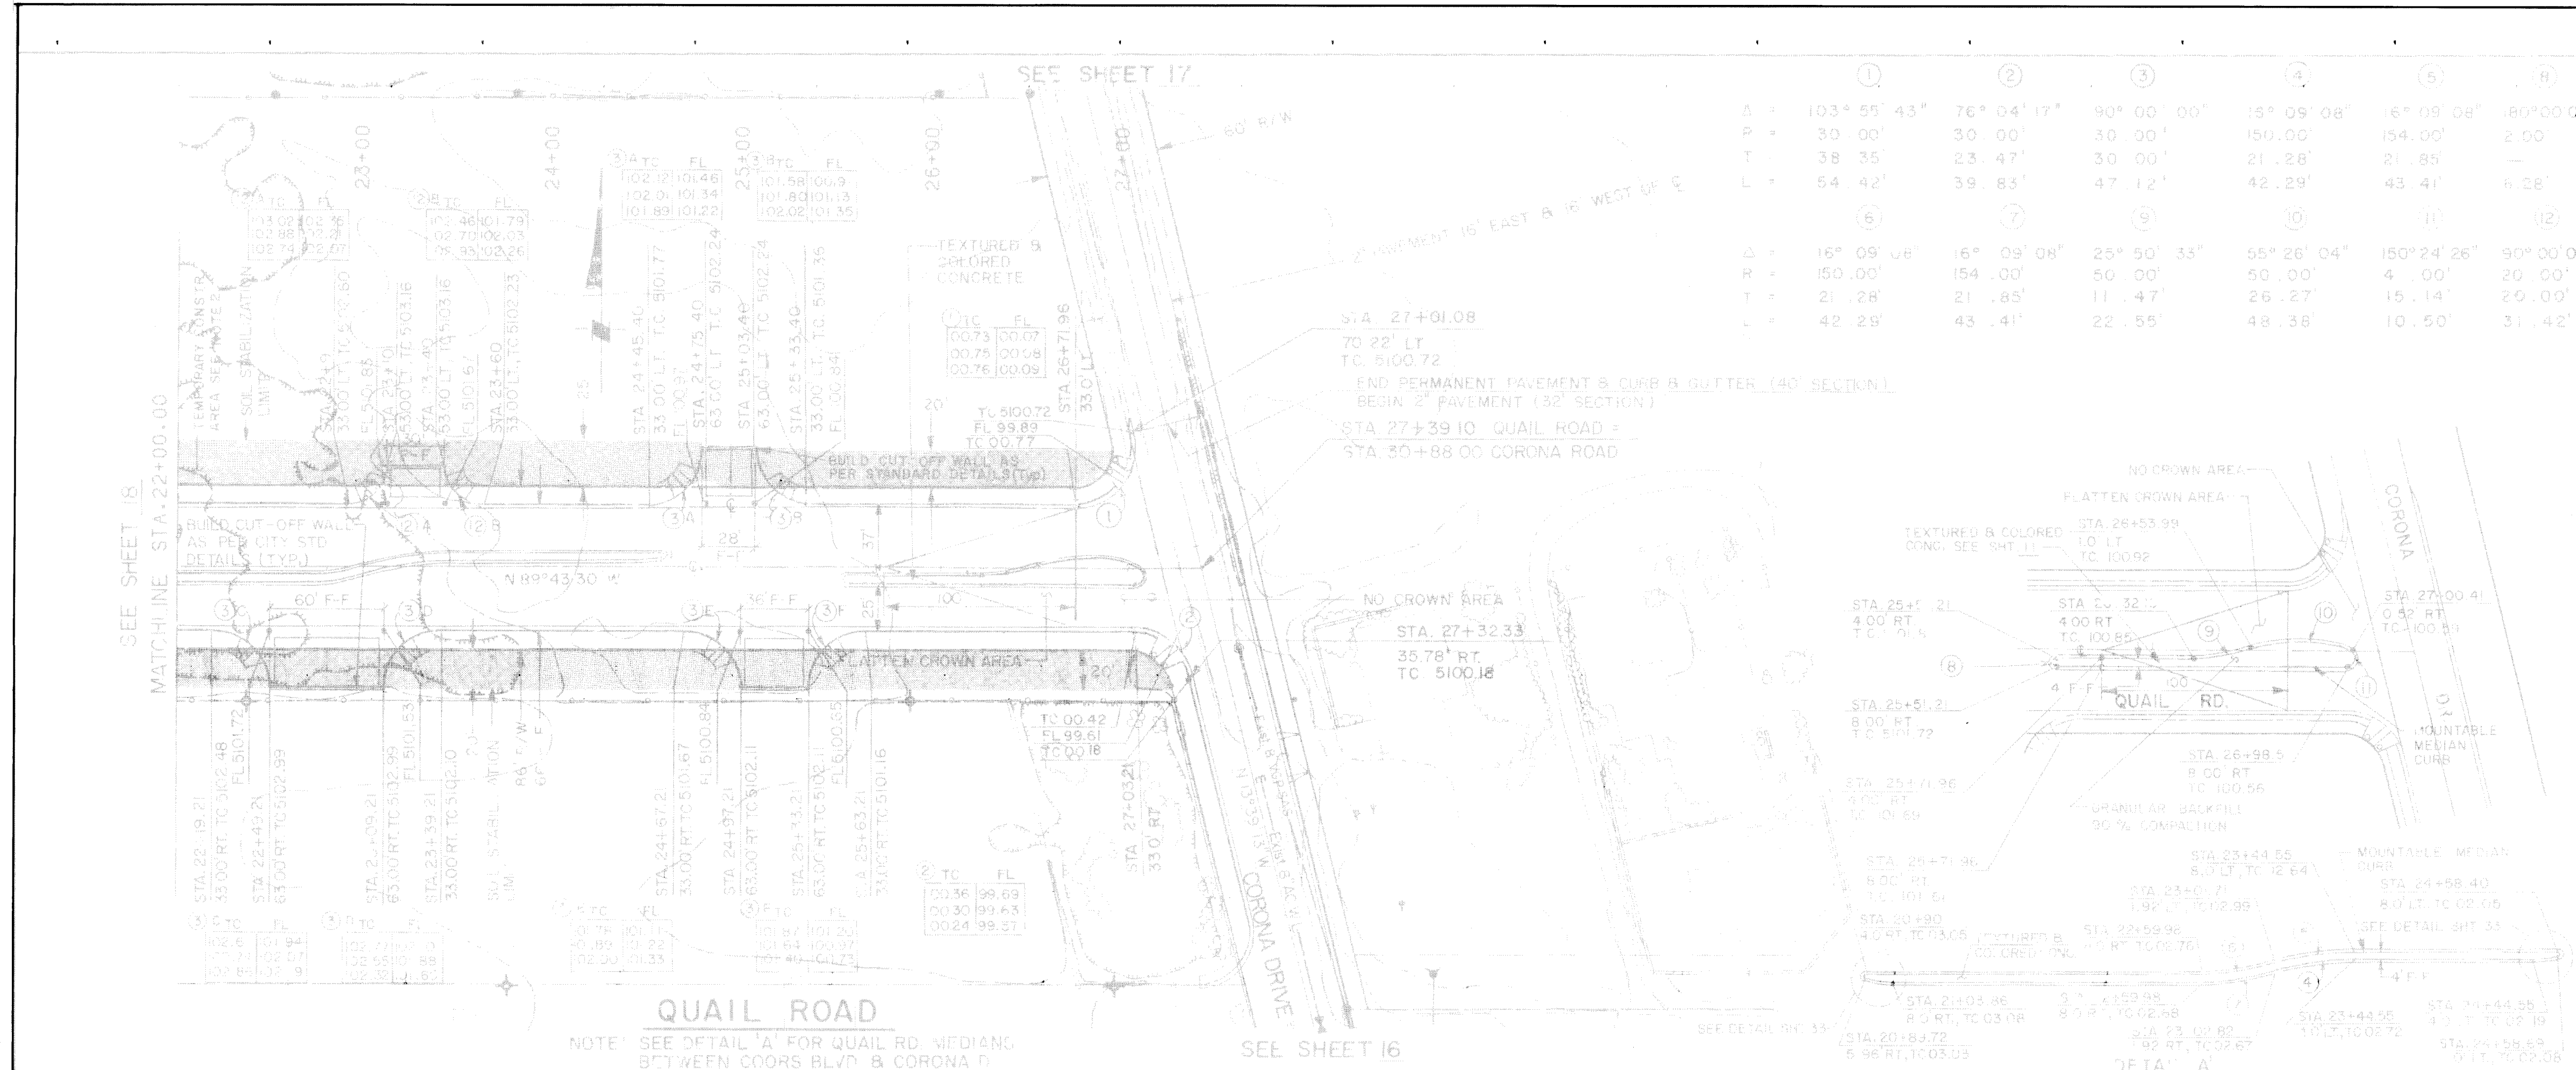

NOTES:

- See Sheet 15 For Detention Pond Locations.
- Payment For Detention Ponds Shall be for Square Yard of Grading for Less Than 2' of Excavation.
- Trenching For 6" PVC Storm Sewer Pipe Shall be Incidental to 6" PVC Bid Item.
- 3" Asphalt Rundowns Shall be Subsidiary to 6" PVC Bid Item.

AS BUILT INFORMATION		BENCH MARKS		SURVEY INFORMATION		ENGINEER'S SEAL	
CONTRACTOR	DATE	STA. NO.	MARK	NO.	DATE	SEAL	DATE
CONTRACTOR	DATE	STA. NO.	MARK	NO.	DATE	SEAL	DATE

RECORD DRAWINGS

DATE: 4/28/88

PLAN

SCALE: HORIZ. 1" = 50'

PROFILE

SCALE: HORIZ. 1" = 50'

VERT. 1" = 5'

CITY OF ALBUQUERQUE

PUBLIC WORKS

ENGINEERING

TITLE:


COORS WIDENING - LOTS 2 & 3

QUAIL RD. DETENTION POND DETAILS


APPROVALS	ENGINEER	DATE	APPROVALS	ENGINEER	DATE
City Engineer	John H. ...	8/14/87	Liquid Waste	NA	8/14/87
A.C.E. - Design	...	...	Traffic	...	8/15/87
A.C.E. - Hydrology	...	8/16/87	Water	NA	8/14/87

DRAWING NO. 3316 **MAP NO.** H-11 **SHEET** 16 **OF** 38

Job No. 53130

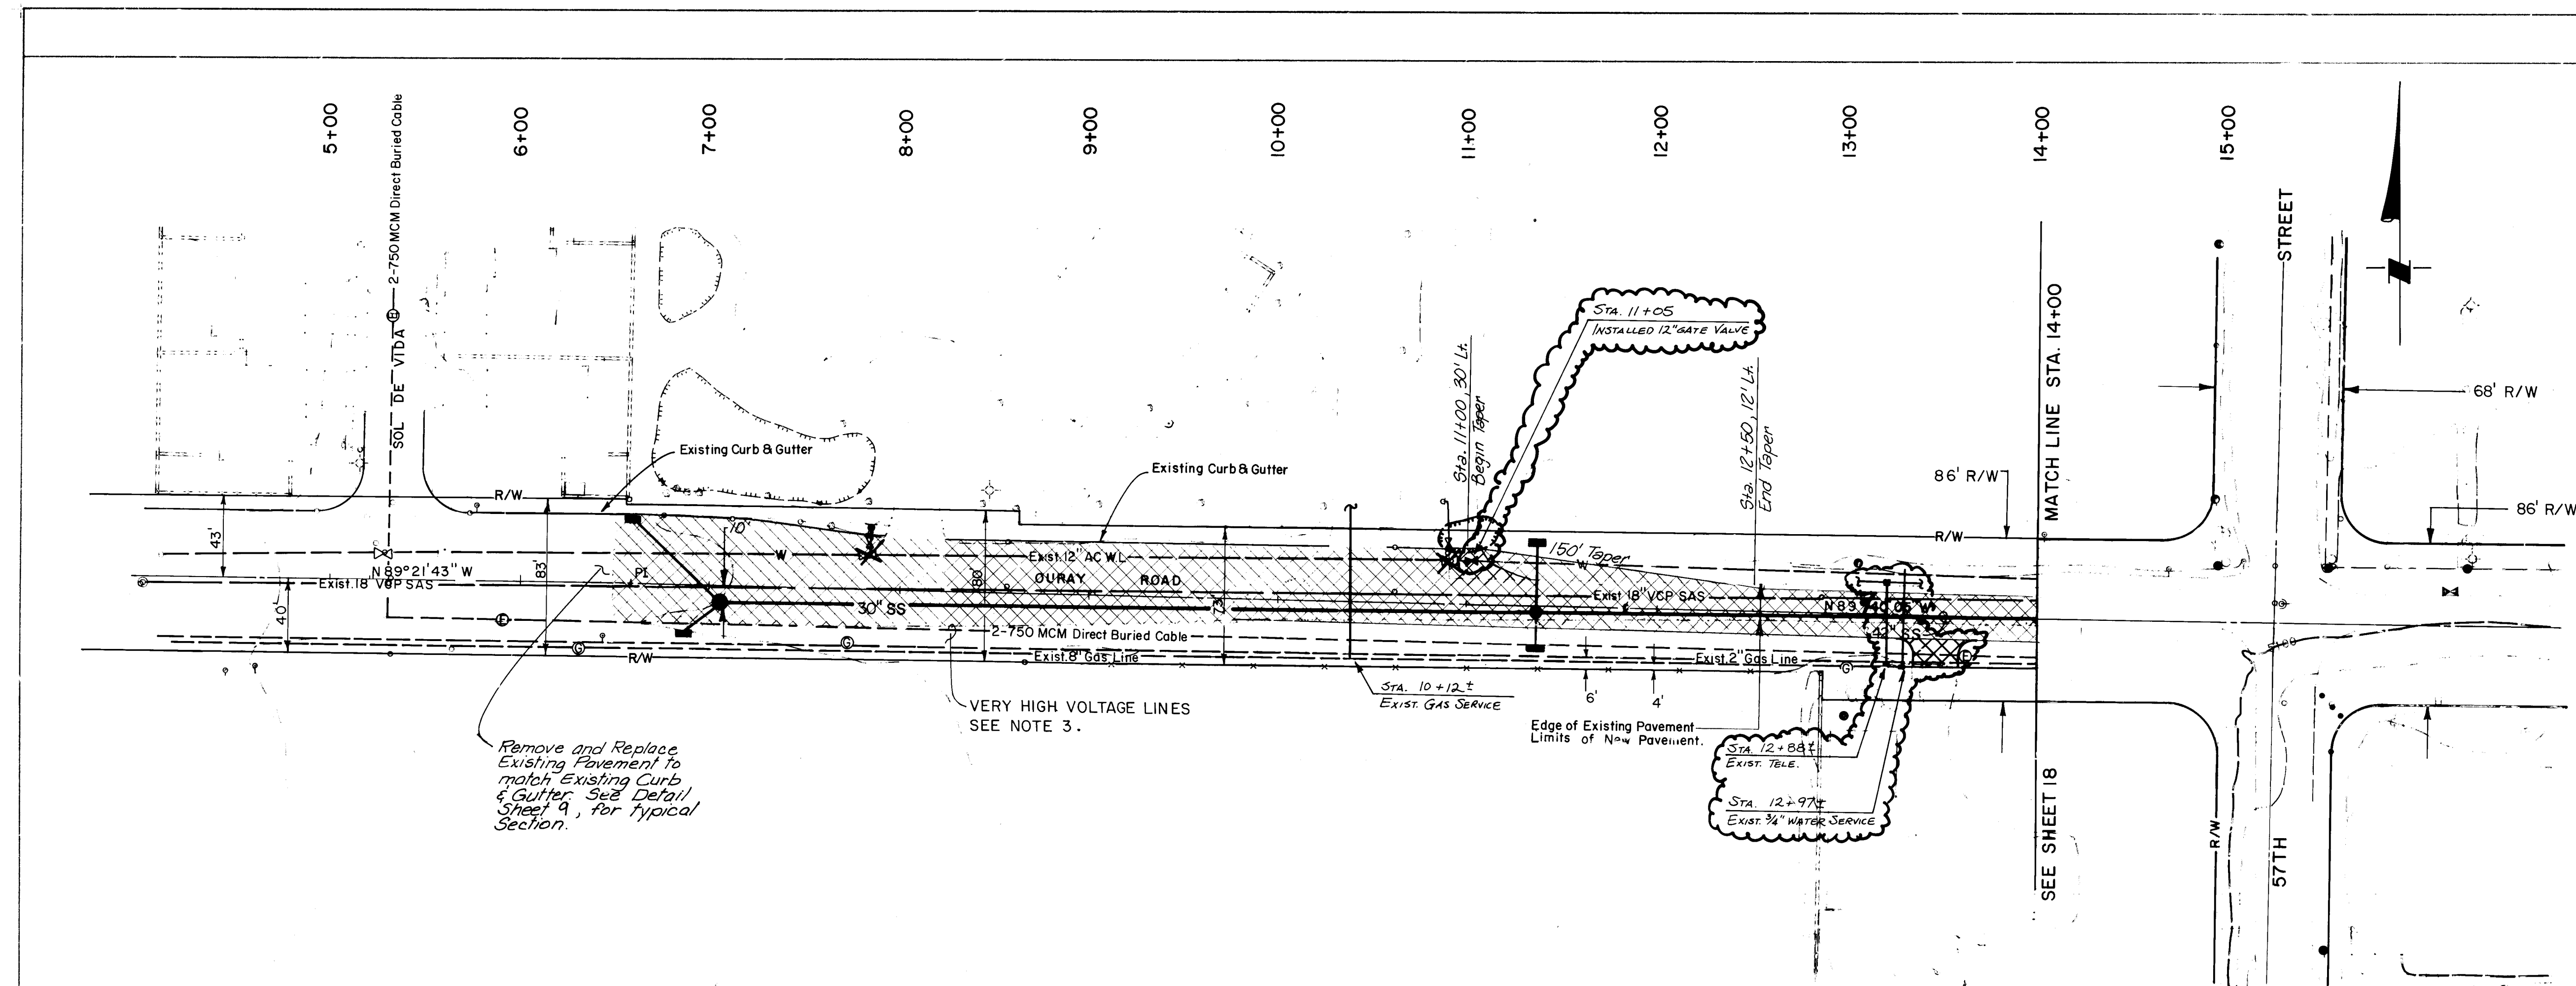

OURAY ROAD

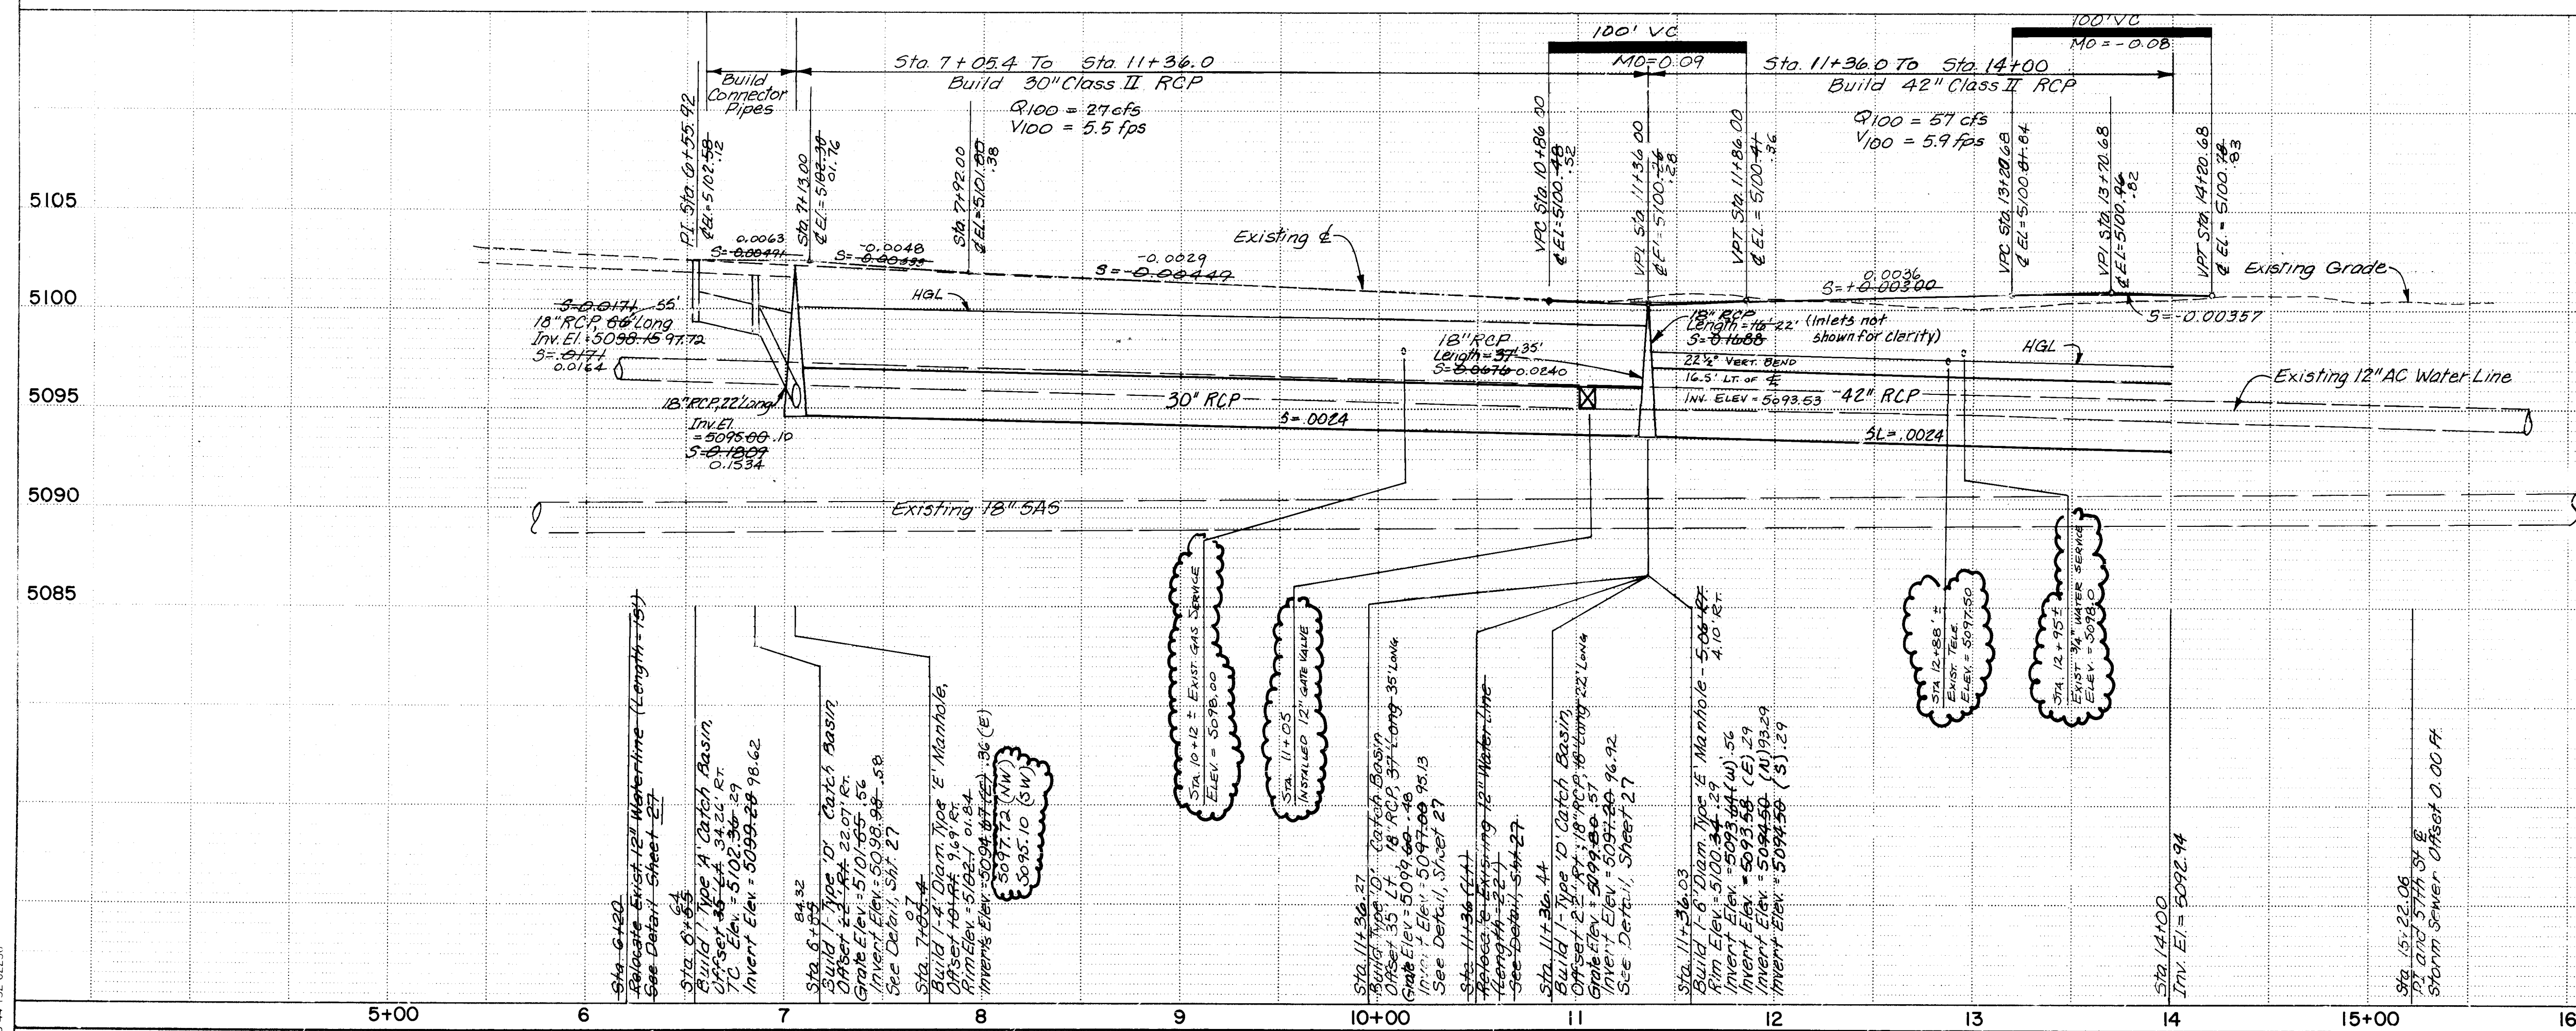


1. See Note 3, Sheet 18

2. See Sheet 27 for Type D Inlet detail.

3. One week before any excavation on Ouray Road between Sta. 5+00 and Sta. 17+00, the Contractor will notify PNM representative Dan White at 761-3306 and request de-energization of the 2-750 KCM high voltage cables.

Two days prior to any excavation on Ouray between Sta. 5+00 and Sta. 17+00, the Contractor shall have all electrical utilities located by calling the blue stake program at 765-1234. The Contractor shall not excavate within 2' of the electrical utilities without a PNM representative on site (761-3306).

The Contractor shall complete all underground construction between Sta. 6+00 and 17+00 on Ouray Road. Within fifteen (15) calendar days notify PNM (761-3306) immediately after work is complete. Upon notification, PNM will re-energize the 750 KCM cables.

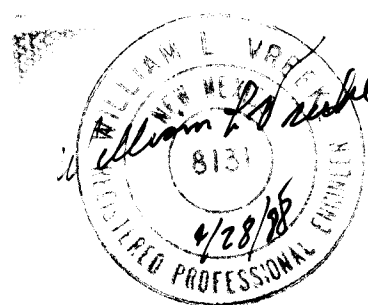

RECORD DRAWINGS

DATE 4/28/88

PLAN

SCALE: HORIZ. 1" = 50'

PROFILE

SCALE: HORIZ. 1" = 50'
VERT. 1" = 5'

26 33161788

CITY OF ALBUQUERQUE
PUBLIC WORKS
ENGINEERINGTITLE: COORS WIDENING—LOTS 2 & 3
OURAY ROAD STA. 6+50 TO STA. 14+00

APPROVALS	ENGINEER	DATE	APPROVALS	ENGINEER	DATE
D.R.C. Chairman	<i>[Signature]</i>	8/26/87	Liquid Waste	<i>[Signature]</i>	8/14/87
A.C.E. Design	"	"	Traffic	<i>[Signature]</i>	8/15/87
A.C.E. Hydrology	<i>[Signature]</i>	8/26/87	Water	<i>[Signature]</i>	8/14/87

DRAWING NO.	MAP NO.	SHEET	OF
3316	H-11	17	38

ENGINEER'S SEAL		SURVEY INFORMATION		BENCH MARKS		AS BUILT INFORMATION	
 1/21/87		FIELD NOTES		STA. N.M. 448-N3	ELEV. 5099.527	SURFACE MECHANICAL	
		NO.	DATE	STANDARD N.M.S.H.C. BRASS TABLET SET FLUSH		DATE	
				IN TOP OF CONCRETE POST, LOCATED IN THE		DATE	
				SOUTHWEST EDGE OF "WEST MESA BOWL"		DATE	
				BOWLING ALLEY PARKING LOT.		DATE	
						DATE	
						DATE	
SEE SHEET 13 FOR
57 TH. STREET PLAN & PROFILE

SEE SHEET 12

NOTES

- See Sheet 21 for existing utilities and water and sanitary sewer lines to be constructed in this project.
- Remove existing pavement as required for storm sewer construction and replace to 24" width minimum horizontally and to vertical grade shown on profile. Where profile grade is omitted, existing grades shall be recorded by the Engineer prior to excavation for later use in replacing pavement. Contractor shall notify Engineer at least one week before excavation.
- One week before any excavation on Ouray Road between Sta. 5+00 and Sta. 17+00 the Contractor will notify PNM representative Dan White at 761-3306 and request deenergization of the 2-750 KCM high voltage cables.

Two days prior to any excavation on Ouray between Sta. 5+00 and Sta. 17+00 the Contractor shall have all electrical utilities located by calling the blue stake program at 765-1234. The Contractor shall not excavate within 2' of the electrical utilities without a PNM representative on site (761-3306).

The Contractor shall complete all underground construction between Sta. 6+00 and 17+100 on Ouray Road. Within fifteen (15) calendar days notify PNM (761-3306) immediately after work is complete. Upon notification, PNM will re-energize the 750 KCM cables.



RECORD DRAWINGS

DATE 4/28/88

NOTE:
ANY EXCAVATION WORK IN THE AREA OF THE 12-INCH AND 20-INCH HIGH PRESSURE GAS LINES SHALL REQUIRE THE PRESENCE OF A GAS COMPANY OF NEW MEXICO REPRESENTATIVE. IT IS THE CONTRACTORS RESPONSIBILITY TO CONTACT GAS COMPANY OF NEW MEXICO REPRESENTATIVE AL MEYERS AT 889-8421. EMERGENCY NUMBER 345-6058.

PLAN

SCALE: HORIZ. 1" = 50'

PROFILE

SCALE: HORIZ. 1" = 50'
VERT. 1" = 5'

1 2 3 4 5 6 7 8 9 10 11 12
26 33 16 18 8 8




CITY OF ALBUQUERQUE
PUBLIC WORKS
ENGINEERING

TITLE: COORS WIDENING - LOTS 2 & 3
OURAY ROAD STA. 14+00 TO STA. 25+00



APPROVALS	ENGINEER	DATE	APPROVALS	ENGINEER	DATE
City Engineer	<i>[Signature]</i>	8/14/87	Liquid Waste	<i>[Signature]</i>	8/14/87
A.C.E. - Design	<i>[Signature]</i>		Traffic	<i>[Signature]</i>	8/15/87
A.C.E. - Hydrology	<i>[Signature]</i>	8/14/87	Water	<i>[Signature]</i>	8/14/87



DRAWING NO. 3316 MAP NO. H-11 SHEET 18 OF 38

Job No 53139

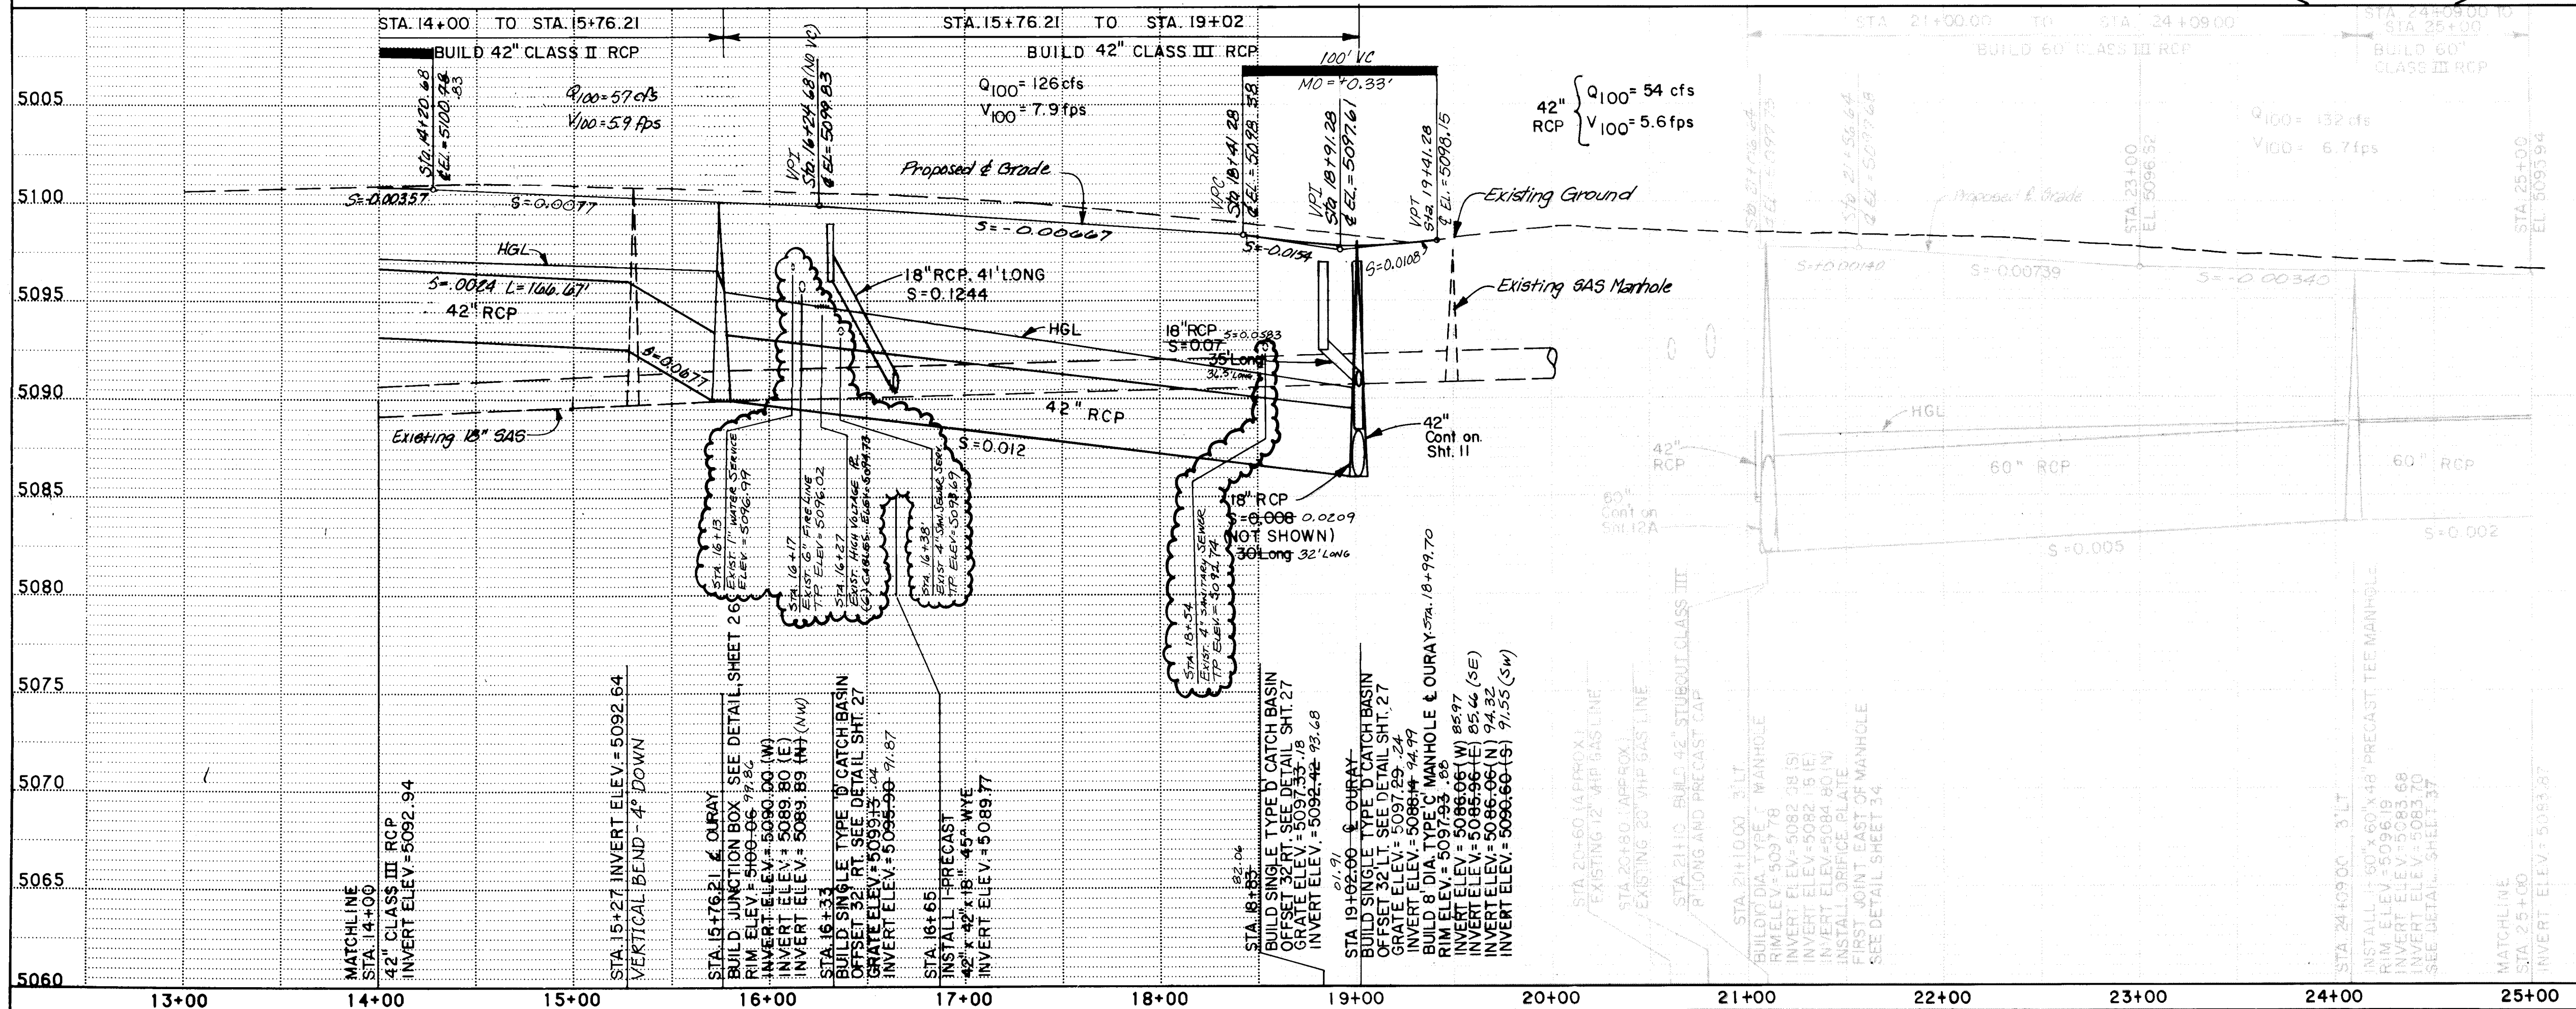

SEE SHEET 10 FOR COORS BLVD. PLAN & PROFILE, SHT. II FOR STORM SEWER

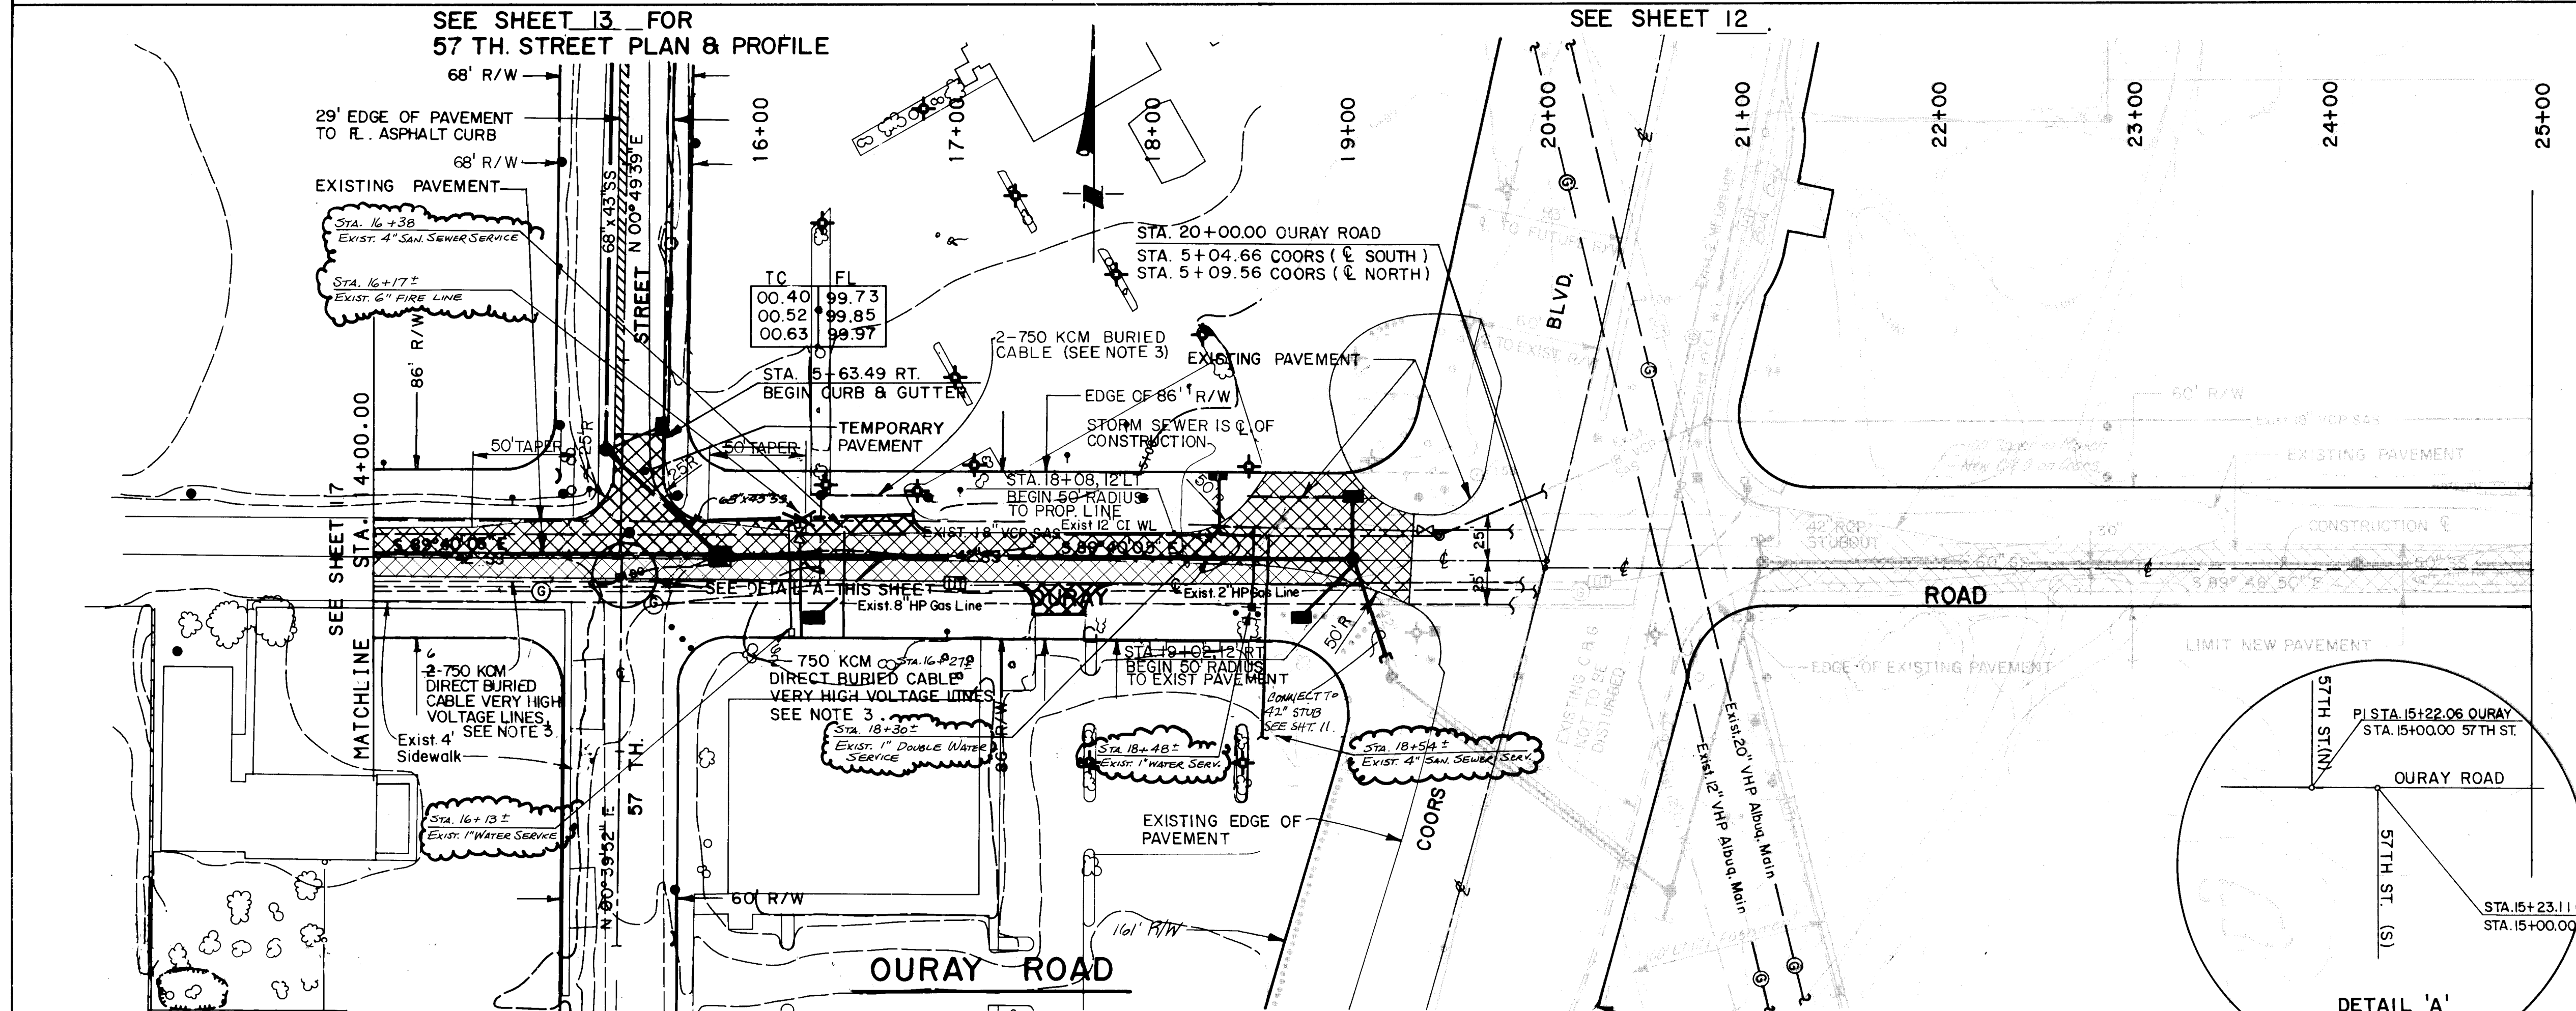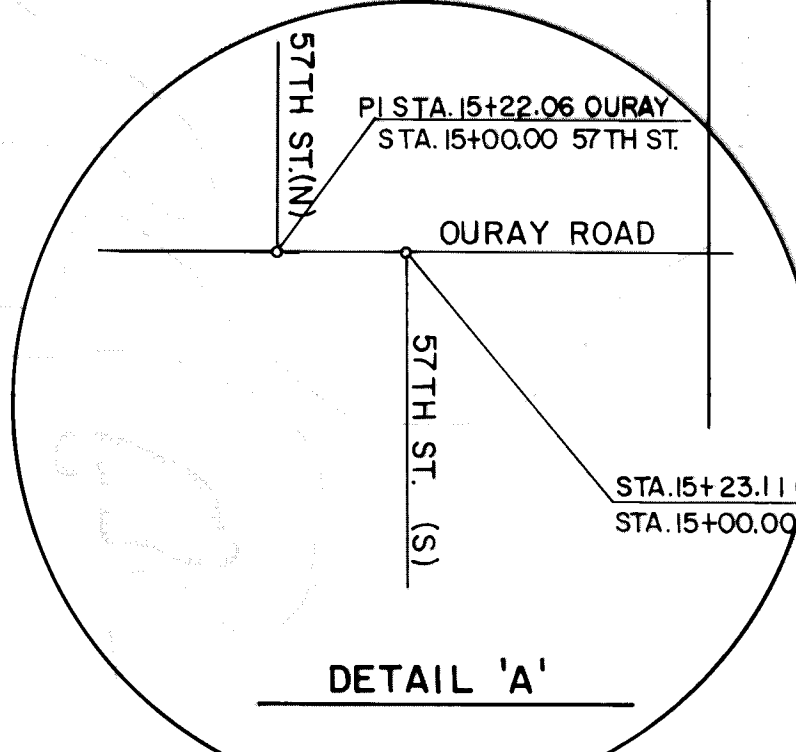

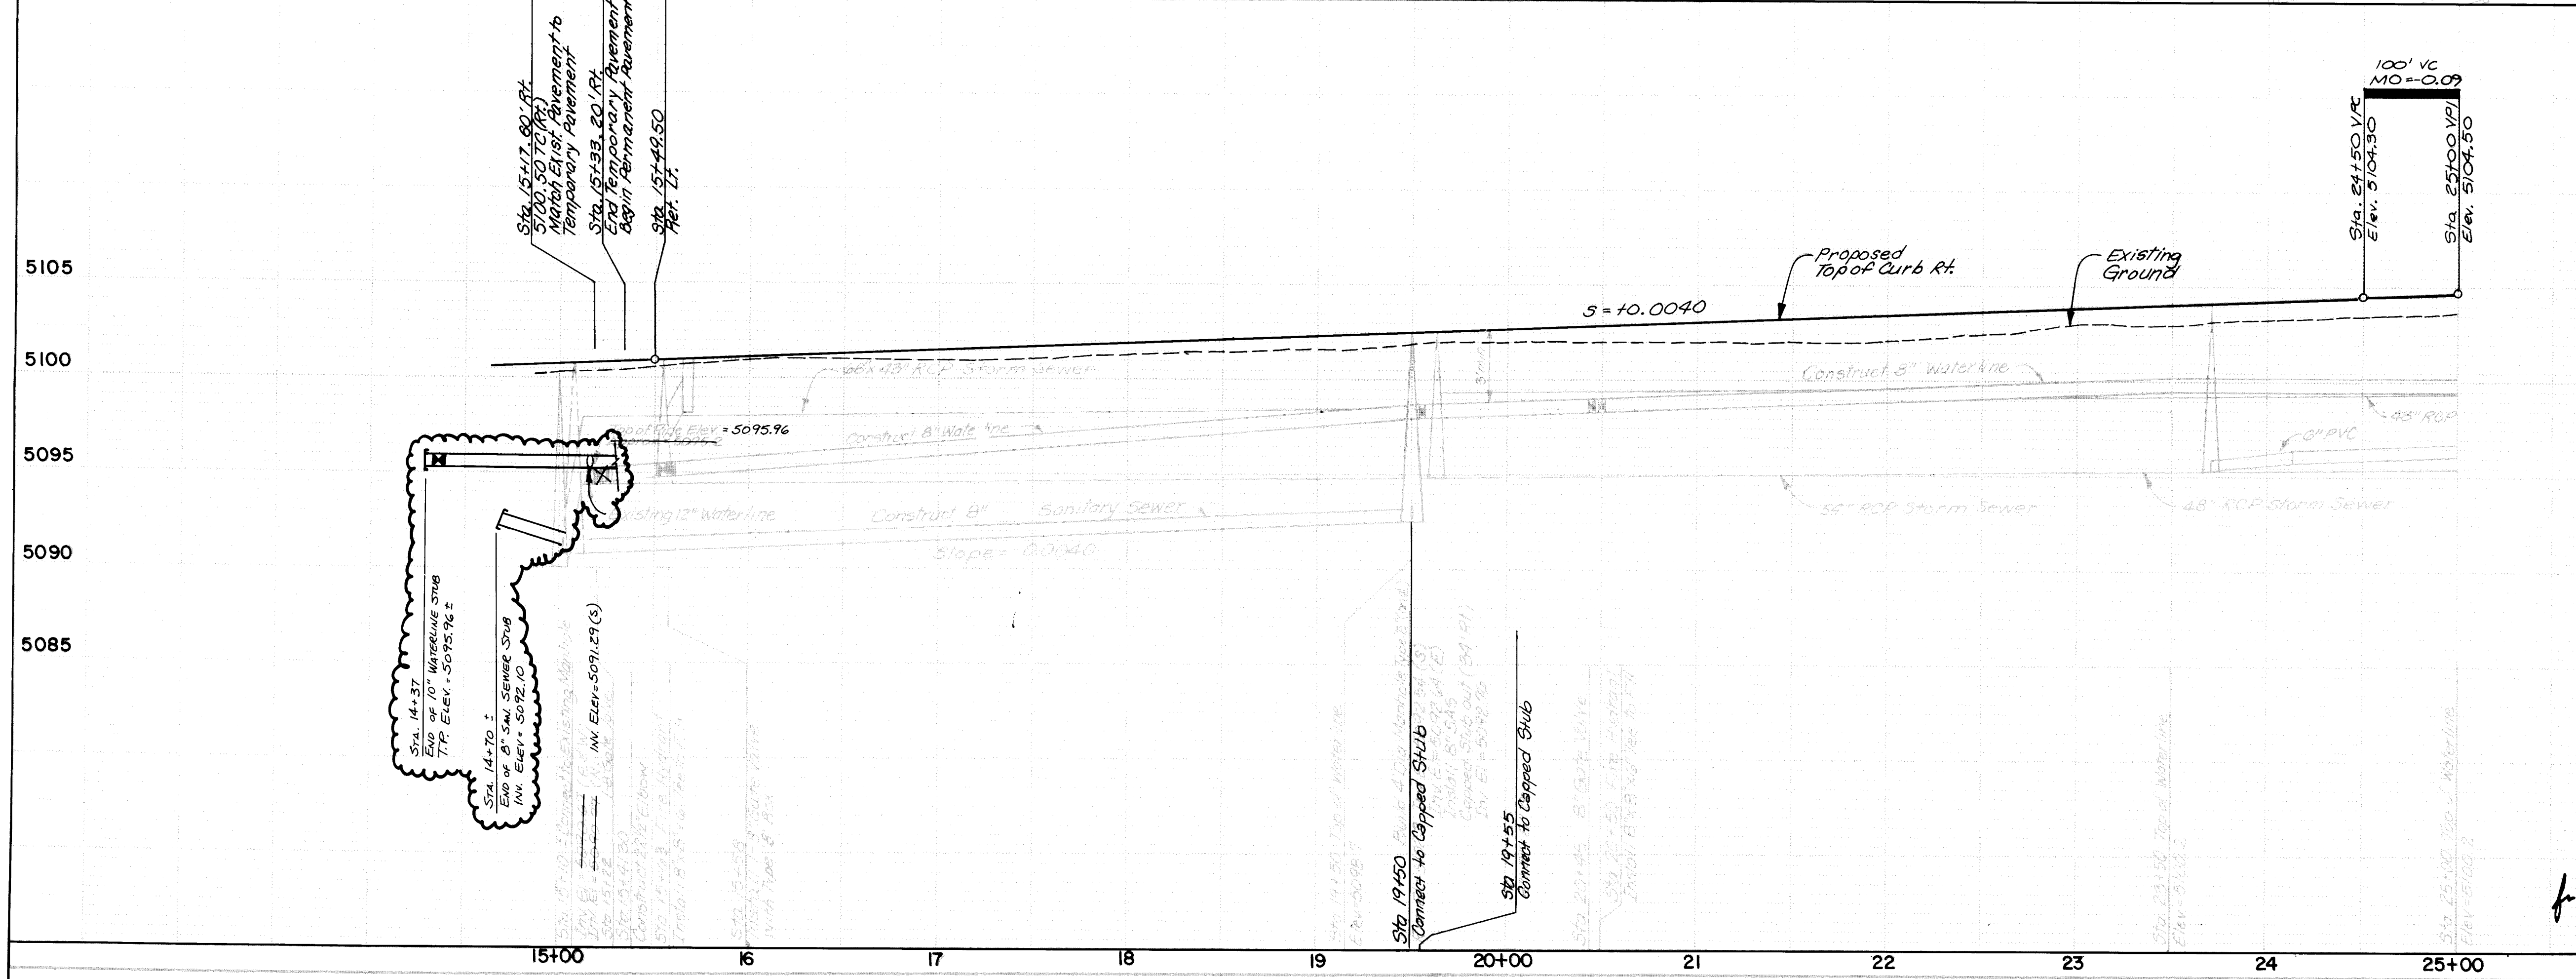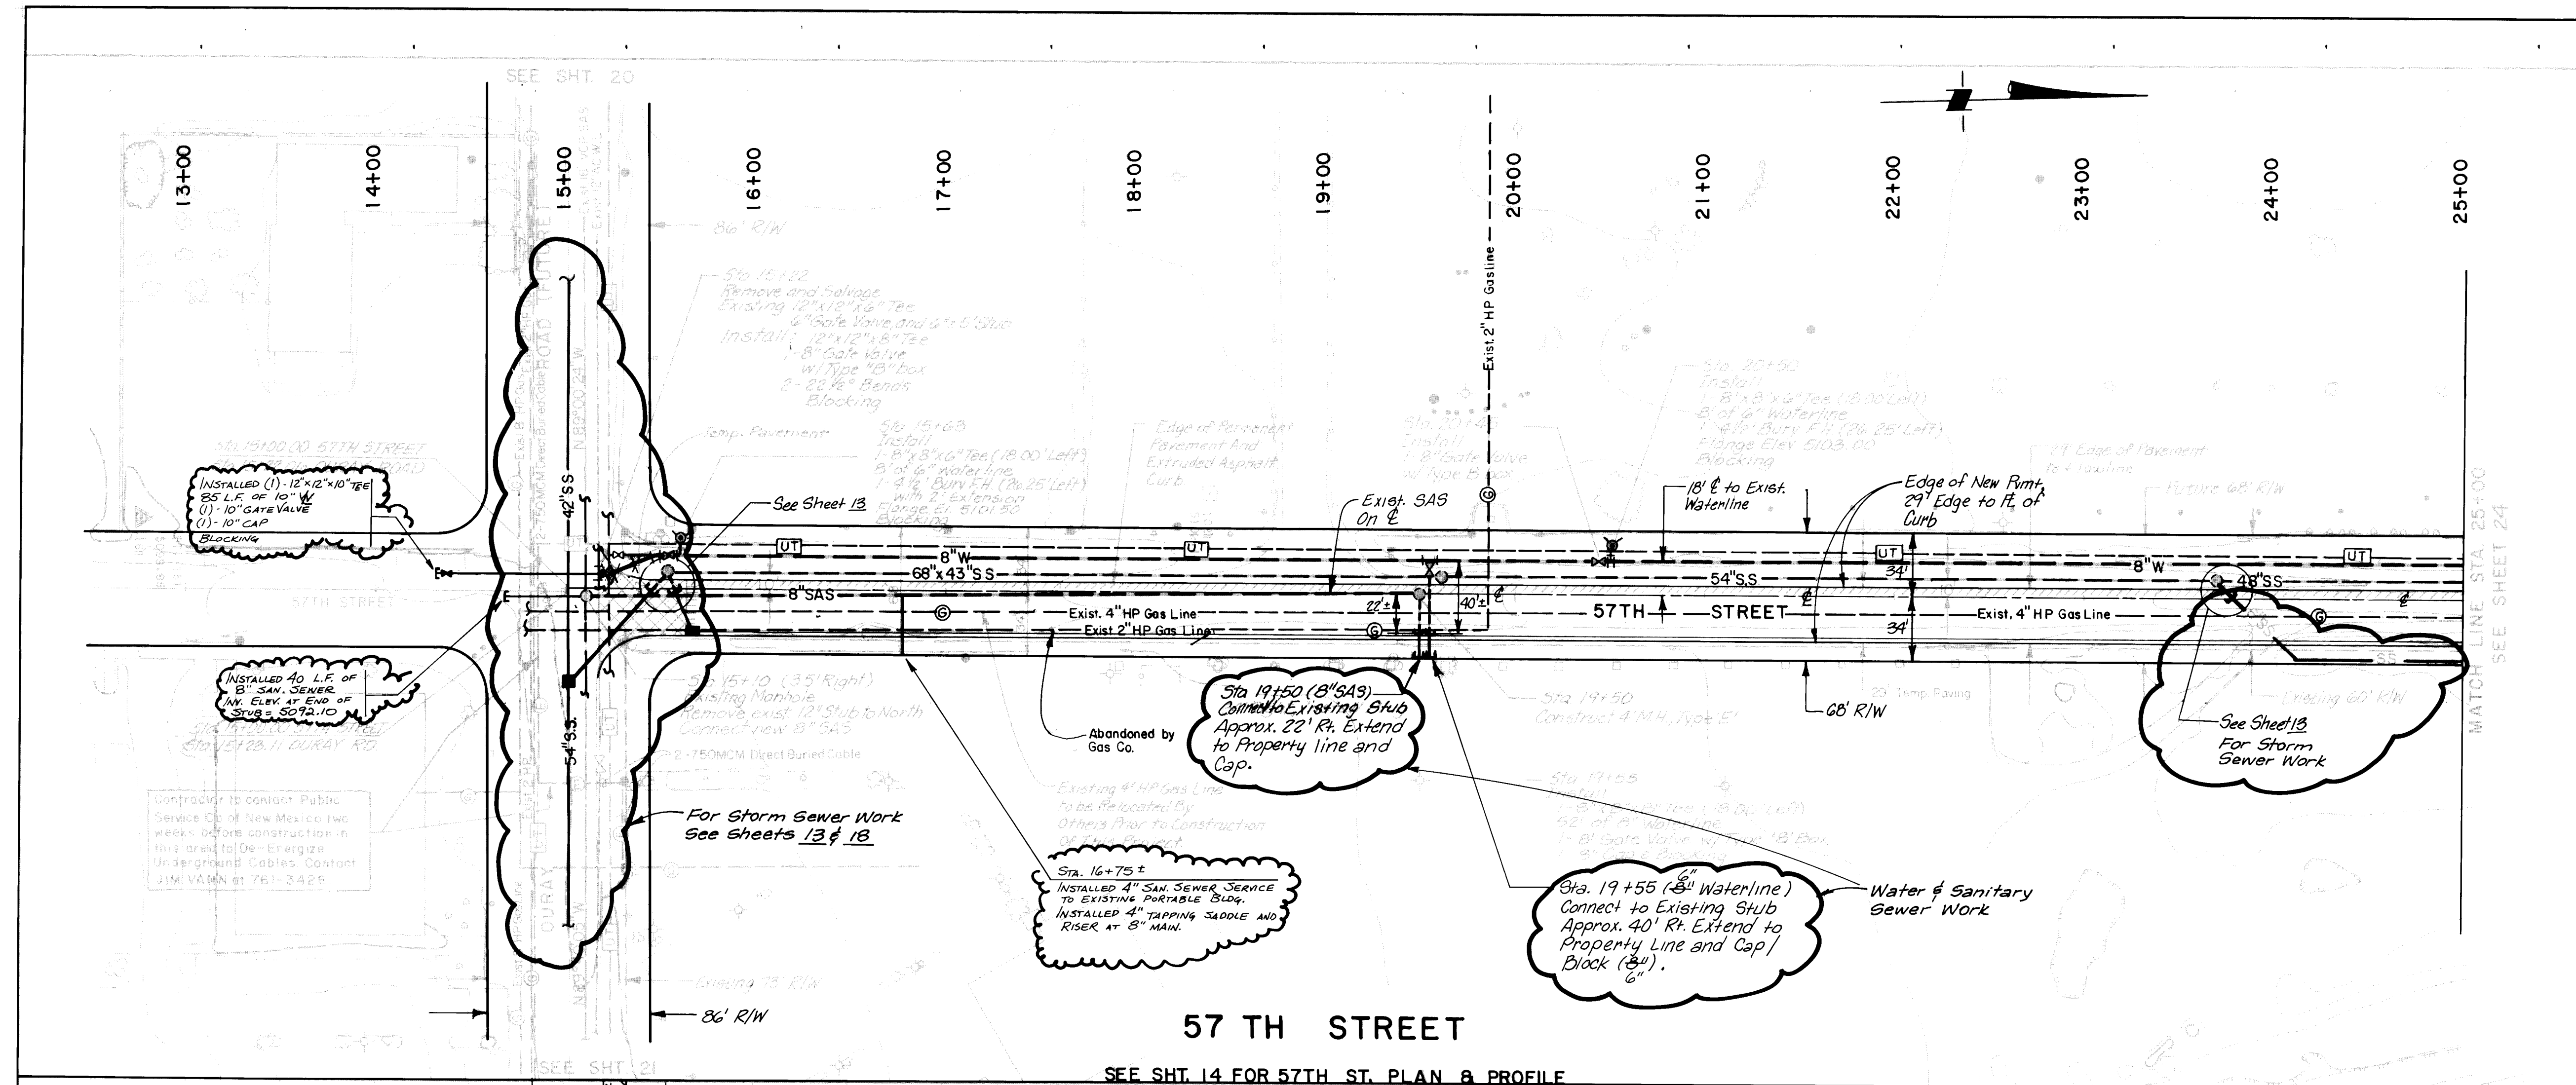

CONSTRUCTION NOTES

1. Contractor shall verify location and elevation of all existing utilities prior to construction.

2. For AWWA Class C900 PVC pipe, the maximum deflection per 20 foot joint shall be:

Pipe Diam.	Deflection
4"	1 1/4"
6"	1 1/2"
8"	2"
10"	2 1/2"
12"	3"

AS BUILT INFORMATION

CONTRACTOR	DATE	BY
STANDARD N.M.S.H.C. BRASS TABLET SET FLUSH IN TOP OF CONCRETE POST, LOCATED IN THE SOUTH WEST CORNER OF "WEST MESA BOWL" BOWLING LOT. <td>4/1/88<td>DATE 4/1/88</td></td>	4/1/88 <td>DATE 4/1/88</td>	DATE 4/1/88

ENGINEER'S SEAL

RECORD DRAWINGS

DATE 4/28/88

PLAN

SCALE: HORIZ. 1" = 50'

PROFILE

SCALE: HORIZ. 1" = 50'

VERT. 1" = 5'

THIS SHEET PERTAINS TO WATERLINE AND SANITARY SEWER DESIGN ONLY.

CITY OF ALBUQUERQUE

PUBLIC WORKS

ENGINEERING

TITLE:

COORS WIDENING - LOTS 2&3

57TH STREET STA. 15+00 TO STA. 25+00


APPROVALS	ENGINEER	DATE	APPROVALS	ENGINEER	DATE
D.R.C. Chairman		6/2/87	Liquid Waste		4/14/87
Design			Traffic		3/15/87
Hydrology		3/2/87	Water		4/14/87

DRAWING NO. 3316


MAP NO. H-11

SHEET 19 **OF** 38

BRUNING 44 115 87796

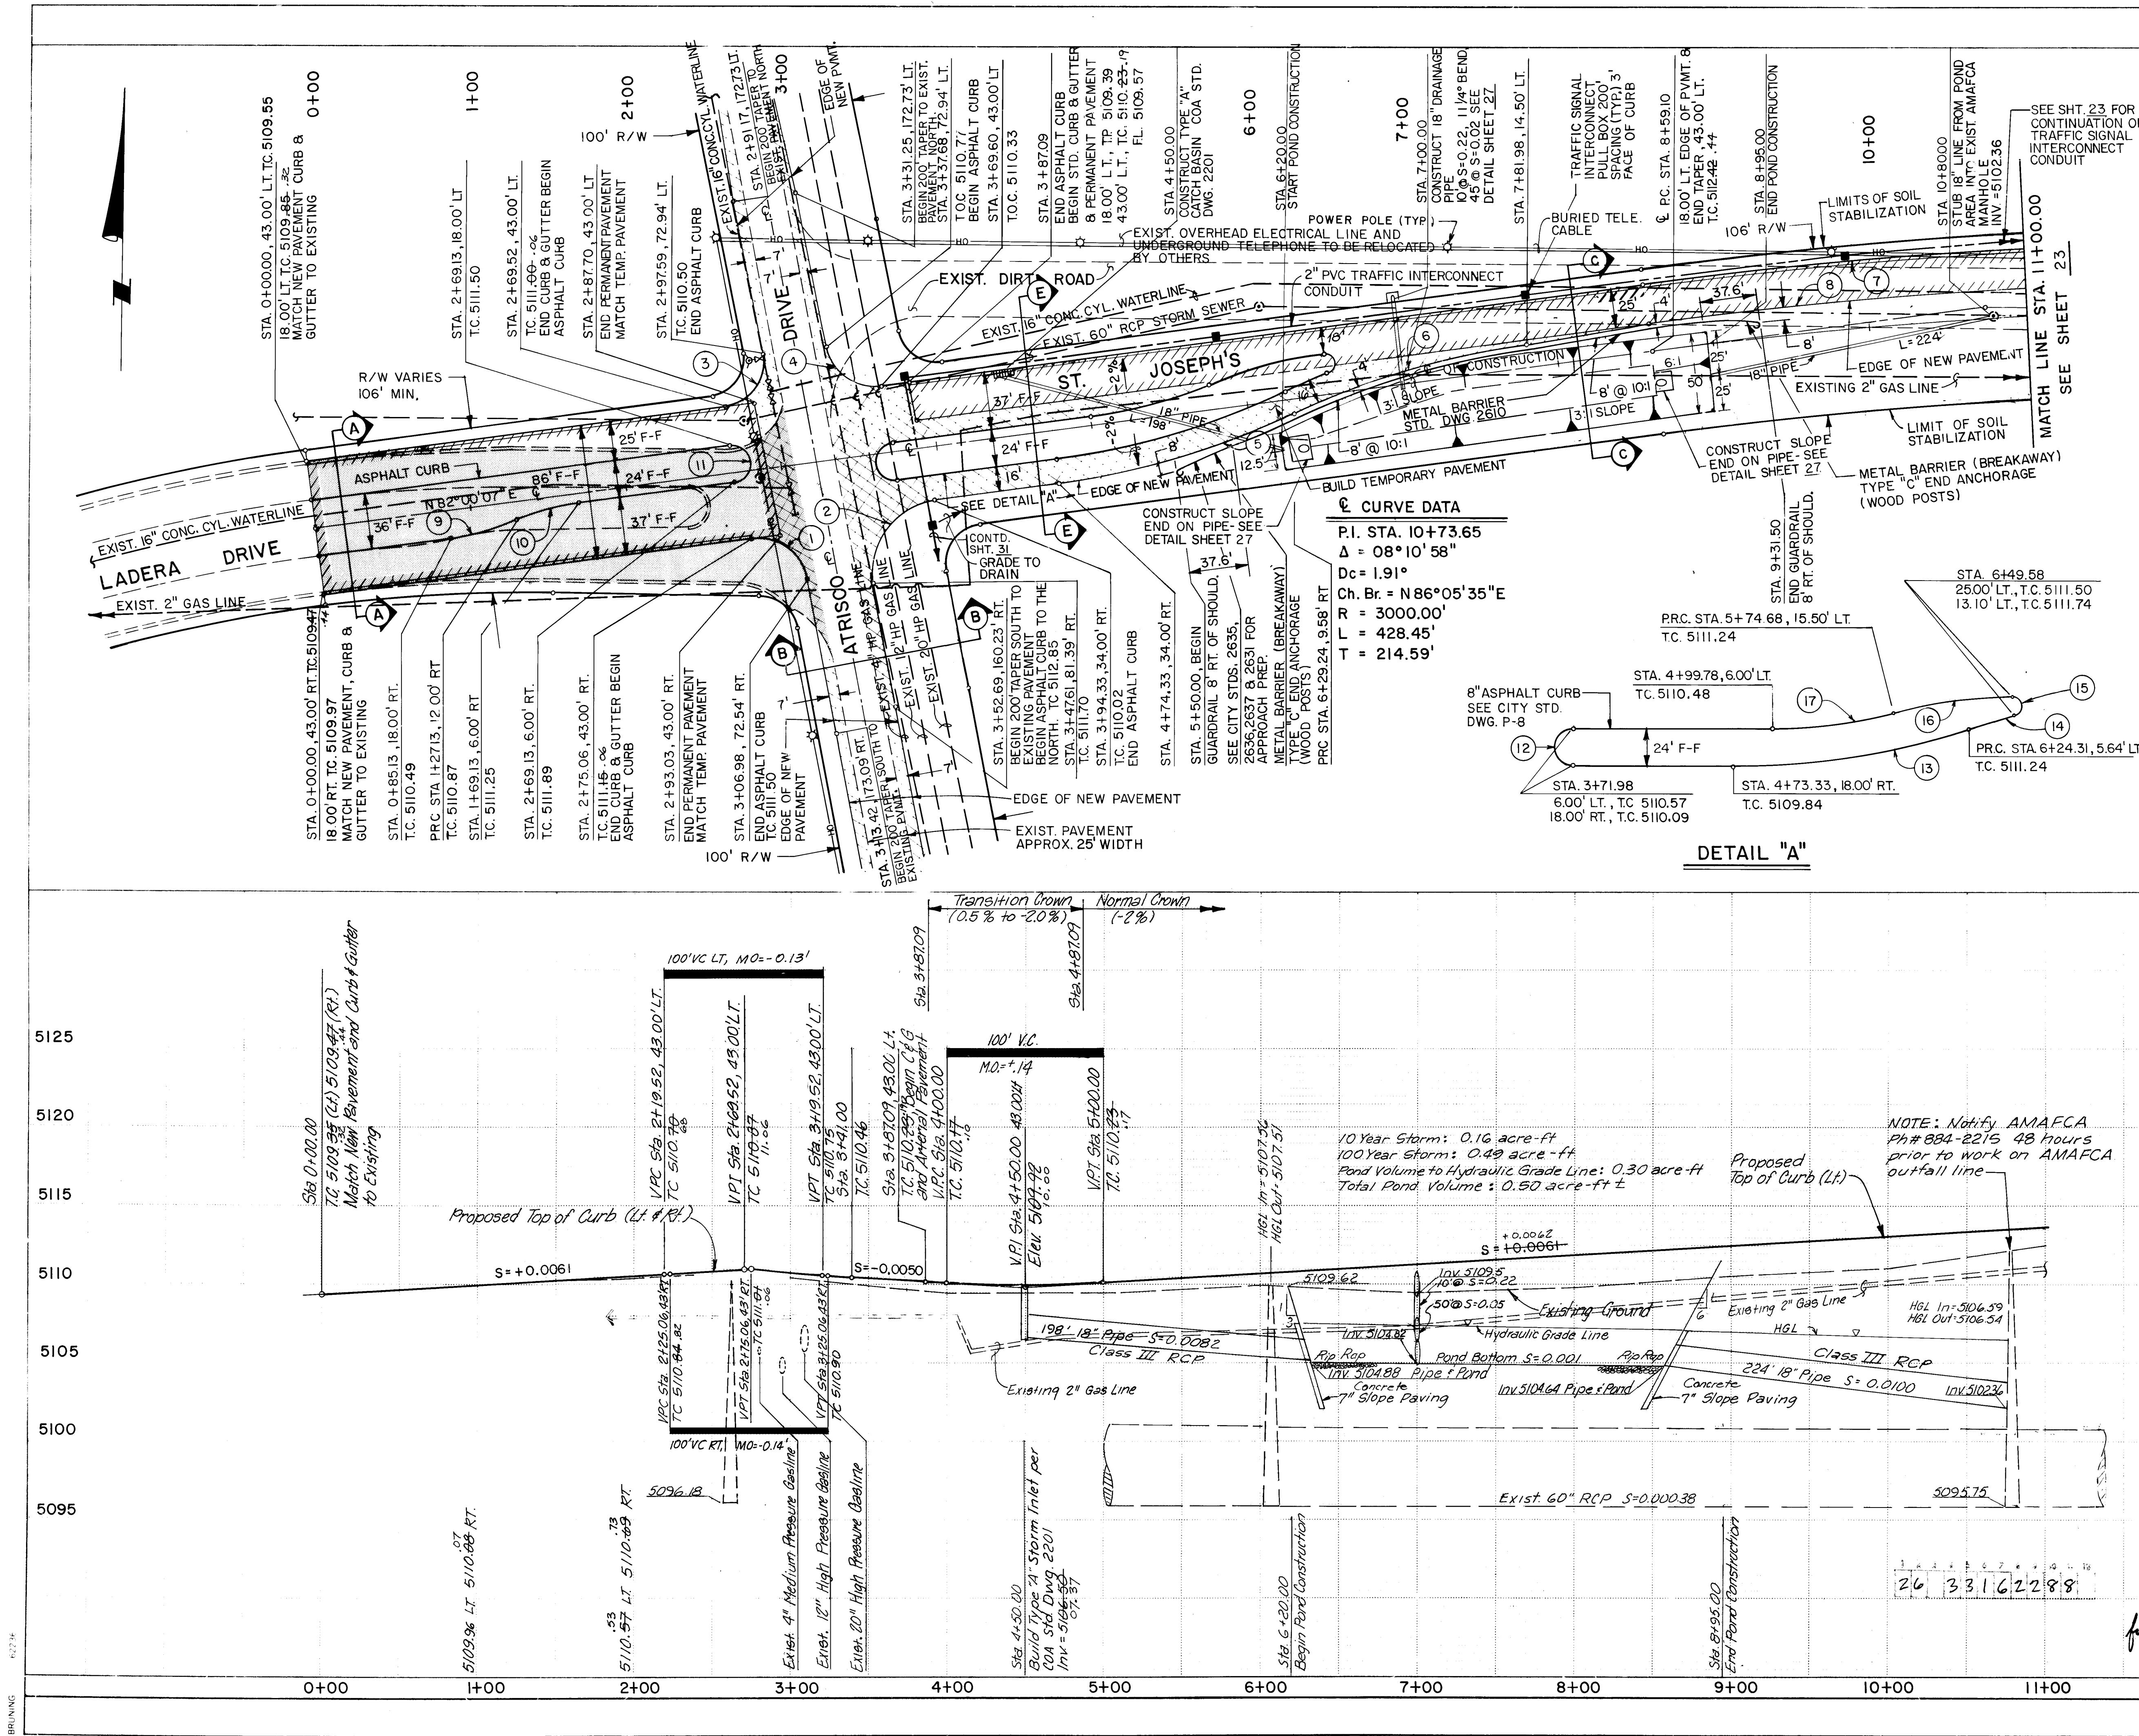

NOTES :		AS BUILT INFORMATION		BENCH MARKS		SURVEY INFORMATION		ENGINEER'S SEAL		REVISIONS		DESIGNED BY		CHECKED BY	
1.) [] EXIST. PAVEMENT, CURB & GUTTER TO BE REMOVED ON LADERA DRIVE.		DATE		STA. N.M. 448-N3 ELEV. 5099.527		NO		[Signature]		DATE		DATE		DATE	
2.) [] NEW PERMANENT PAVEMENT SEE SHEET 8 FOR TYPICAL SECTION.		DATE		STANDARD N.M.S.H.C. BRASS TABLET		BY				RECORD		DATE		DATE	
3.) CURVES ① ② ③ ⑦, & ⑨ THRU ⑪ DEFINE R. AT CURB, CURVES ④ ⑤ ⑥ & ⑧ DEFINE EDGE OF PAVEMENT.		DATE		SET FLUSH IN TOP OF CONCRETE POST LOCATED IN THE SOUTH WEST EDGE OF "WEST MESA BOWL" BOWLING ALLEY PARKING LOT.		NO				RECORD		DATE		DATE	
4.) SEE SHEET 31 FOR ST. JOSEPH'S / ATRISCO TRAFFIC SIGNALIZATION.		DATE				NO				RECORD		DATE		DATE	
5.) ALL MEDIANS TO HAVE 6" OF BACKFILL 90% COMPACTION, INCIDENTAL TO CONTRACT.		DATE				NO				RECORD		DATE		DATE	
6.) MATL. EXCAVATED FROM POND ON ST. JOSEPH'S TO BE HAULED AND REUSED AS FILL THROUGHOUT PROJECT - LOTS 2 & 3.		DATE				NO				RECORD		DATE		DATE	
NOTE: ANY EXCAVATION WORK IN THE AREA OF THE 12-INCH AND 20-INCH HIGH PRESSURE GAS LINES SHALL REQUIRE THE PRESENCE OF A GAS COMPANY OF NEW MEXICO REPRESENTATIVE. IT IS THE CONTRACTOR'S RESPONSIBILITY TO CONTACT GAS COMPANY OF NEW MEXICO REPRESENTATIVE AL MEYERS AT 889-8421. EMERGENCY NUMBER 345-6058.		DATE				NO				RECORD		DATE		DATE	
①		②		③		④		⑤		⑥		⑦		⑧	
Δ = 93°41'00" DC = 190.98' R = 30.00' L = 49.05' T = 31.99'		Δ = 83°26'54" DC = 114.59' R = 50.00' L = 72.82' T = 44.58'		Δ = 86°18'60" DC = 190.98' R = 30.00' L = 45.19' T = 28.13'		Δ = 93°41'00" DC = 190.98' R = 30.00' L = 49.05' T = 31.99'		Δ = 17°55'03" DC = 11.38' R = 503.50' L = 157.46' T = 79.37'		Δ = 17°55'03" DC = 11.54' R = 496.50' L = 155.26' T = 78.27'		Δ = 8°10'58" DC = 1.88' R = 3043.00' L = 434.59' T = 217.67'		Δ = 8°10'58" DC = 1.90' R = 3018.00' L = 431.02' T = 215.88'	
④		⑤		⑥		⑦		⑧		⑨		⑩		⑪	
Δ = 93°41'00" DC = 190.98' R = 30.00' L = 49.05' T = 31.99'		Δ = 17°55'03" DC = 11.38' R = 503.50' L = 157.46' T = 79.37'		Δ = 17°55'03" DC = 11.54' R = 496.50' L = 155.26' T = 78.27'		Δ = 8°10'58" DC = 1.88' R = 3043.00' L = 434.59' T = 217.67'		Δ = 8°10'58" DC = 1.90' R = 3018.00' L = 431.02' T = 215.88'		Δ = 16°15'37" DC = 38.20' R = 150.00' L = 42.57' T = 21.43'		Δ = 180°00'00" DC = -- R = 12.00' L = 37.70' T = --		Δ = 180°00'00" DC = -- R = 12.00' L = 37.70' T = --	
⑦		⑧		⑨		⑩		⑪		⑫		⑬		⑭	
Δ = 8°10'58" DC = 1.88' R = 3043.00' L = 434.59' T = 217.67'		Δ = 8°10'58" DC = 1.90' R = 3018.00' L = 431.02' T = 215.88'		Δ = 16°15'37" DC = 38.20' R = 150.00' L = 42.57' T = 21.43'		Δ = 180°00'00" DC = -- R = 12.00' L = 37.70' T = --		Δ = 180°00'00" DC = -- R = 12.00' L = 37.70' T = --		Δ = 17°55'03" DC = 11.75' R = 487.50' L = 152.45' T = 76.85'		Δ = 02°56'43" DC = 11.88' R = 512.50' L = 26.34' T = 13.17'		Δ = 17°55'03" DC = 11.88' R = 512.50' L = 26.34' T = 13.17'	
⑩		⑪		⑫		⑬		⑭		⑮		⑯		⑰	
Δ = 16°15'37" DC = 38.20' R = 150.00' L = 42.57' T = 21.43'		Δ = 180°00'00" DC = -- R = 12.00' L = 37.70' T = --		Δ = 180°00'00" DC = -- R = 12.00' L = 37.70' T = --		Δ = 17°55'03" DC = 11.75' R = 487.50' L = 152.45' T = 76.85'		Δ = 02°56'43" DC = 11.88' R = 512.50' L = 26.34' T = 13.17'		Δ = 17°55'03" DC = 11.88' R = 512.50' L = 26.34' T = 13.17'		Δ = 14°27'27" DC = 19.10' R = 300.00' L = 75.50' T = 38.05'		Δ = 14°27'27" DC = 19.10' R = 300.00' L = 75.50' T = 38.05'	
⑬		⑭		⑮		⑯		⑰		⑱		⑲		⑳	
Δ = 17°55'03" DC = 11.75' R = 487.50' L = 152.45' T = 76.85'		Δ = 02°56'43" DC = 11.88' R = 512.50' L = 26.34' T = 13.17'		Δ = 17°55'03" DC = 11.88' R = 512.50' L = 26.34' T = 13.17'		Δ = 14°27'27" DC = 19.10' R = 300.00' L = 75.50' T = 38.05'		Δ = 14°27'27" DC = 19.10' R = 300.00' L = 75.50' T = 38.05'		Δ = 14°27'27" DC = 19.10' R = 300.00' L = 75.50' T = 38.05'		Δ = 14°27'27" DC = 19.10' R = 300.00' L = 75.50' T = 38.05'		Δ = 14°27'27" DC = 19.10' R = 300.00' L = 75.50' T = 38.05'	
⑰		⑱		⑲		⑳		㉑		㉒		㉓		㉔	
Δ = 14°27'27" DC = 19.10' R = 300.00' L = 75.50' T = 38.05'		Δ = 14°27'27" DC = 19.10' R = 300.00' L = 75.50' T = 38.05'		Δ = 14°27'27" DC = 19.10' R = 300.00' L = 75.50' T = 38.05'		Δ = 14°27'27" DC = 19.10' R = 300.00' L = 75.50' T = 38.05'		Δ = 14°27'27" DC = 19.10' R = 300.00' L = 75.50' T = 38.05'		Δ = 14°27'27" DC = 19.10' R = 300.00' L = 75.50' T = 38.05'		Δ = 14°27'27" DC = 19.10' R = 300.00' L = 75.50' T = 38.05'		Δ = 14°27'27" DC = 19.10' R = 300.00' L = 75.50' T = 38.05'	
PLAN		SCALE: HORIZ. 1" = 50'		PROFILE		SCALE: HORIZ. 1" = 50'		VERT. 1" = 5'		CITY OF ALBUQUERQUE PUBLIC WORKS ENGINEERING		CITY OF ALBUQUERQUE PUBLIC WORKS ENGINEERING		CITY OF ALBUQUERQUE PUBLIC WORKS ENGINEERING	
APPROVALS		ENGINEER		DATE		APPROVALS		ENGINEER		DATE		APPROVALS		ENGINEER	
City Engineer		[Signature]		8/26/87		Liquid Waste		NA		JEE		8/14/87		8/15/87	
A-C-E-Design		[Signature]		8/26/87		Traffic		NA		David Hanna		8/15/87		8/14/87	
A-C-E-Hydrology		[Signature]		8/26/87		Water		NA		JEE		8/14/87		8/14/87	
DRAWING NO. 3316		MAP NO. G-11		SHEET 22		OF 38		CITY OF ALBUQUERQUE PUBLIC WORKS ENGINEERING		CITY OF ALBUQUERQUE PUBLIC WORKS ENGINEERING		CITY OF ALBUQUERQUE PUBLIC WORKS ENGINEERING		CITY OF ALBUQUERQUE PUBLIC WORKS ENGINEERING	

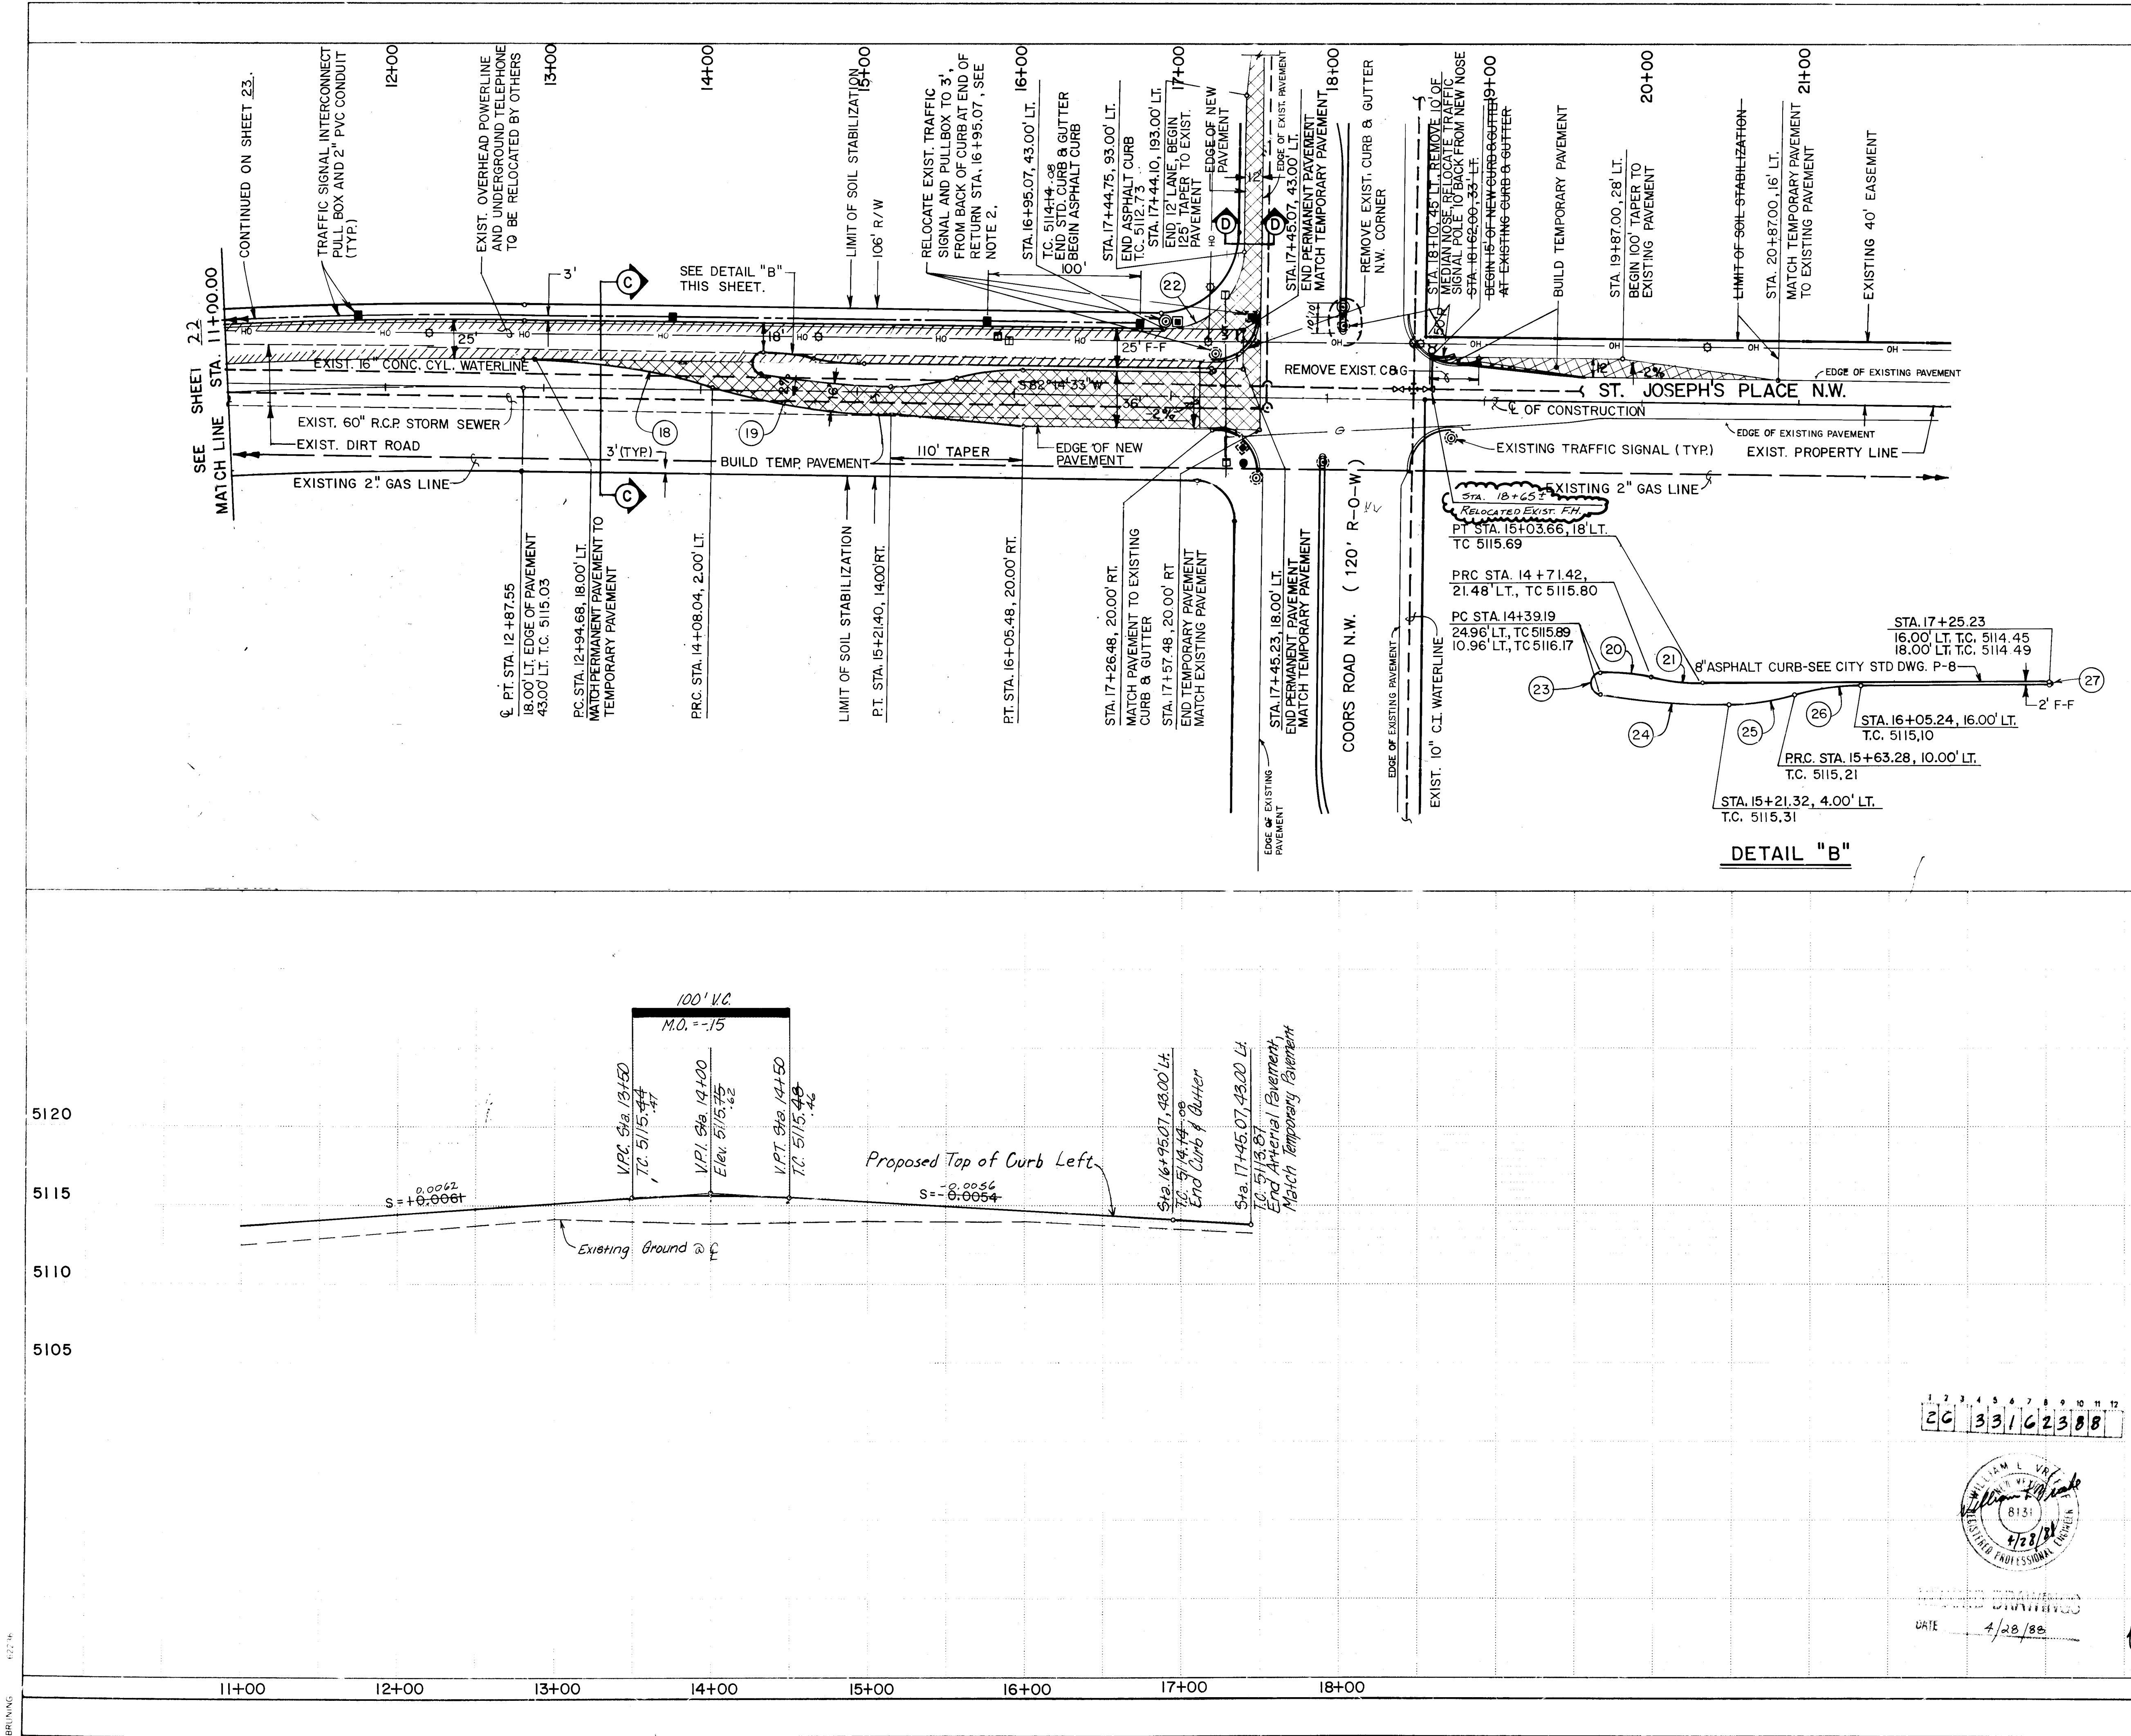

- NOTES :
- 1) NEW ARTERIAL PAVEMENT SEE SHEET 8 FOR TYPICAL SECTION.
 - 2) THE CONTRACTOR WILL BE REQUIRED TO BUILD TWO NEW TRAFFIC SIGNAL FOUNDATIONS (TYPE I & TYPE II) AND STANDARD PULLBOXES. THESE ITEMS WILL BE PAID FOR USING THE UNIT PRICE IN THE BID PROPOSAL. ALL OTHER WORK REQUIRED TO RELOCATE THESE SIGNALS SUCH THAT THEY ARE OPERATIONAL AS BEFORE, SHALL BE PAID FOR IN BID ITEM NO. 1 IN THE BID PROPOSAL. 2" PVC CONDUIT BETWEEN NEW SIGNALS AND PULLBOXES.
 - 3) CURVES (18) AND (19) DEFINE EDGE OF PAVEMENT, CURVES (20) THRU (27) DEFINE FLOWLINE AT CURB.
 - 4) ALL MEDIANS AND ISLANDS TO HAVE 8" OF BACKFILL, 90% COMPACTION, INCIDENTAL TO CONTRACT.

NO.	BY	DATE
18		
19		
20		
21		
22		
23		
24		
25		
26		
27		

PLAN

SCALE: HORIZ. 1" = 50'


PROFILE

SCALE: HORIZ. 1" = 50'
VERT. 1" = 5'

CITY OF ALBUQUERQUE PUBLIC WORKS ENGINEERING			
TITLE: COORS WIDENING LOTS 283 ST. JOSEPH'S STA. 11+00 TO STA. 18+00			
APPROVALS	ENGINEER	DATE	APPROVALS
City Engineer	4/28/88	4/28/88	Liquid Waste
A.C.E. Design			Traffic
A.C.E. Hydrology	Steve Poling	8/28/87	Water
DESIGNED BY		DATE	
DRAWN BY		DATE	
CHECKED BY		DATE	
NO.		SHEET 23 OF 38	

① $\Delta = 18^\circ 39' 46''$
 $R = 250.00'$
 $T = 41.08'$
 $L = 81.43'$

10

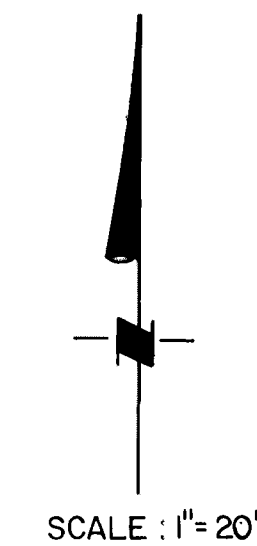

A circular professional engineer seal for William Q. Vree, State of New Mexico. The seal contains the text "WILLIAM Q. VREE", "NEW MEXICO", "8131", "4/28/88", and "REGISTERED PROFESSIONAL ENGINEER". The seal is stamped over a handwritten signature.

RECORD DRAWINGS
DATE 4/28/88

26 33162488




CITY OF ALBUQUERQUE
PUBLIC WORKS
ENGINEERING


TITLE: COORS WIDENING-LOTS 2 & 3
QUAIL/COORS INTERSECTION

APPROVALS	ENGINEER	DATE	APPROVALS	ENGINEER	DATE
City Engineer	<i>[Signature]</i>	8/14/87	Liquid Waste <i>NA</i>	<i>JEE</i>	8/14/87
A-C-E-Design	" "	" "	Traffic	<i>Dandy, Hanner</i>	8/15/87
A-C-E-Hydrology	<i>Steve Bolger</i>	8/14/87	Water <i>NA</i>	<i>JEE</i>	8/14/87


DRAWING NO.	3316	MAP NO.	H-11	SHEET	24	OF	38
----------------	------	---------	------	-------	----	----	----

[illegible]

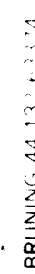

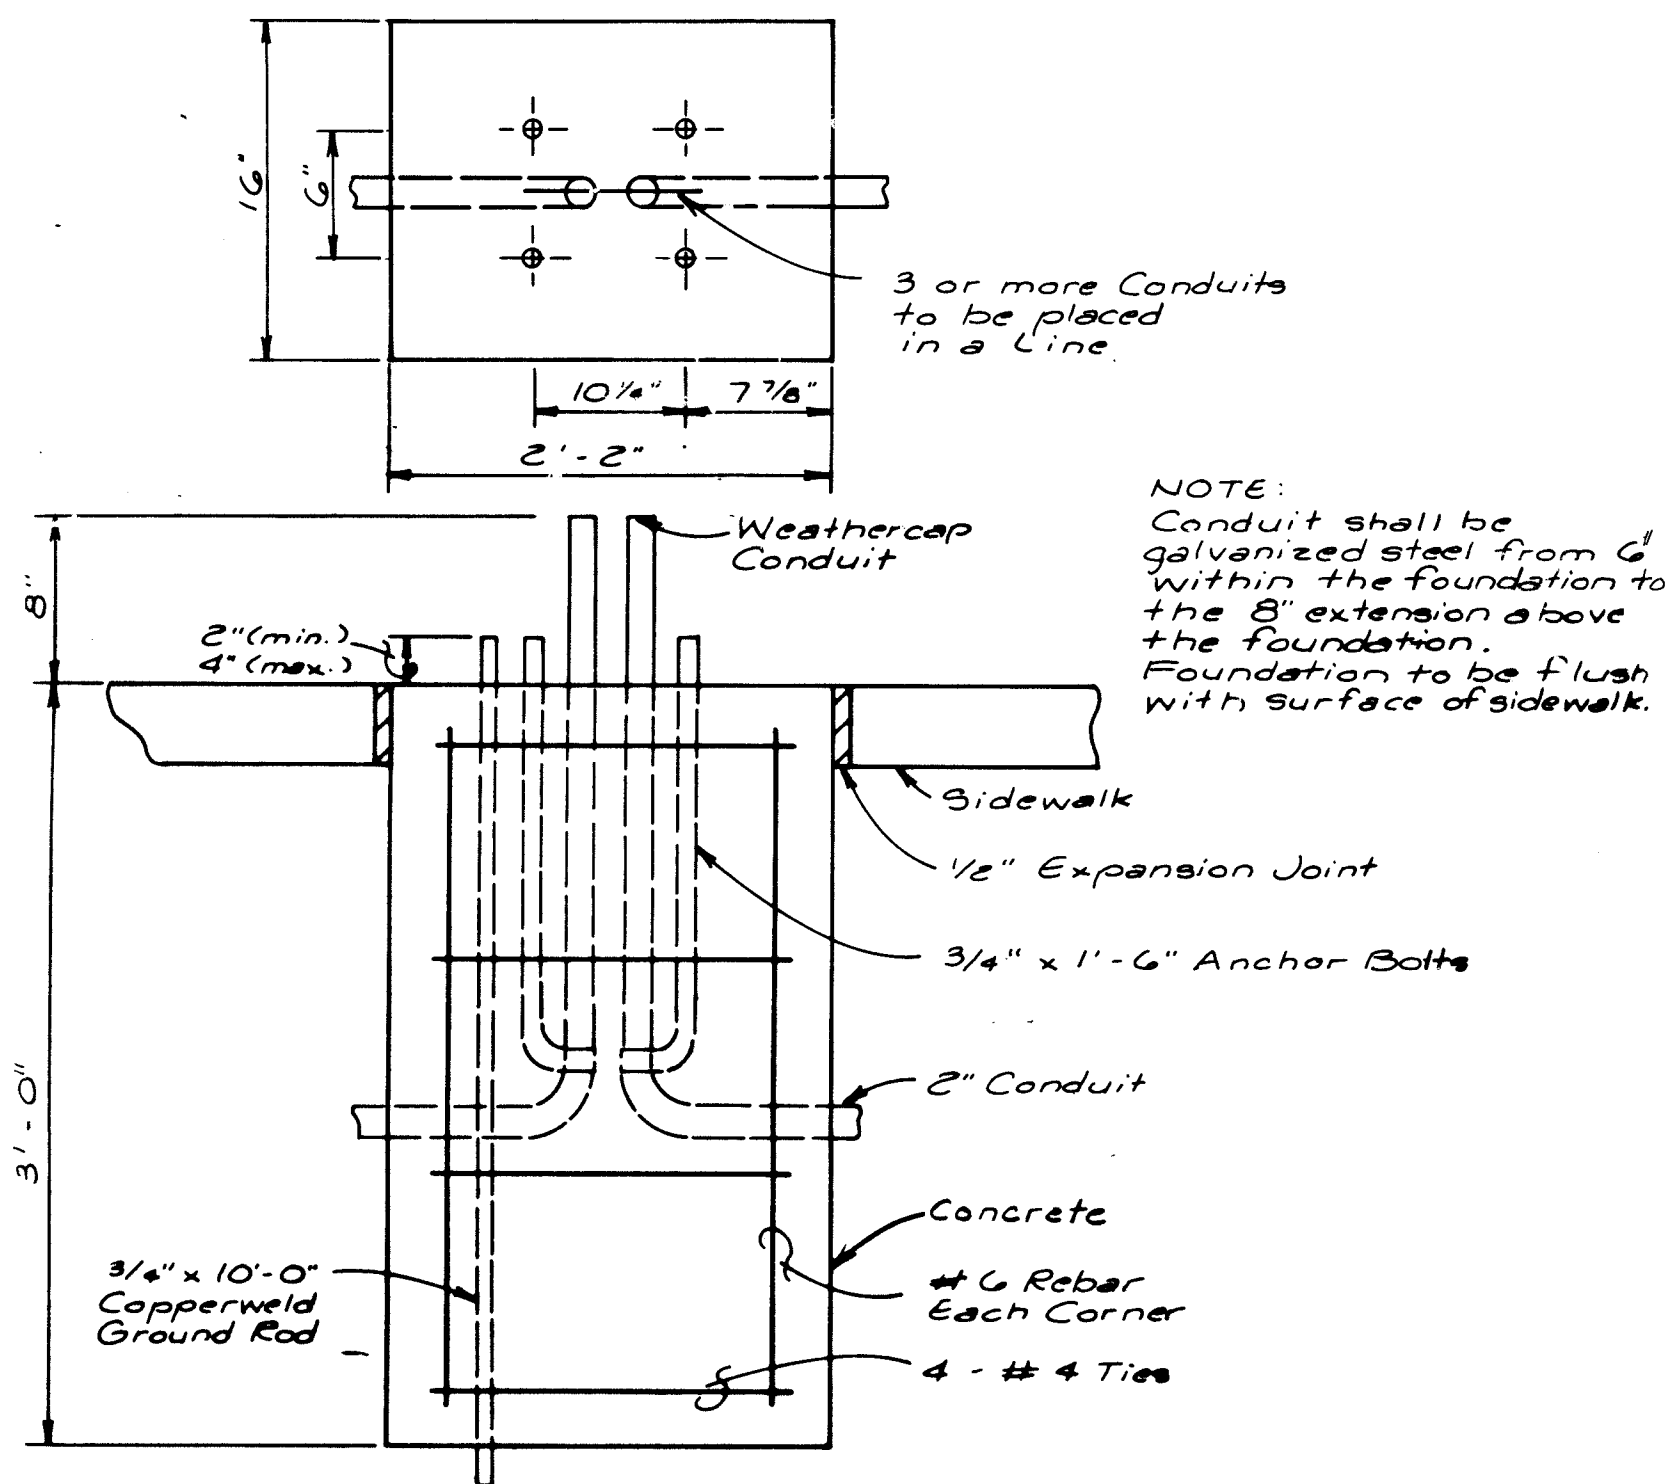

SPLICE CABINET FOUNDATION (GAYLORD)
NO SCALE

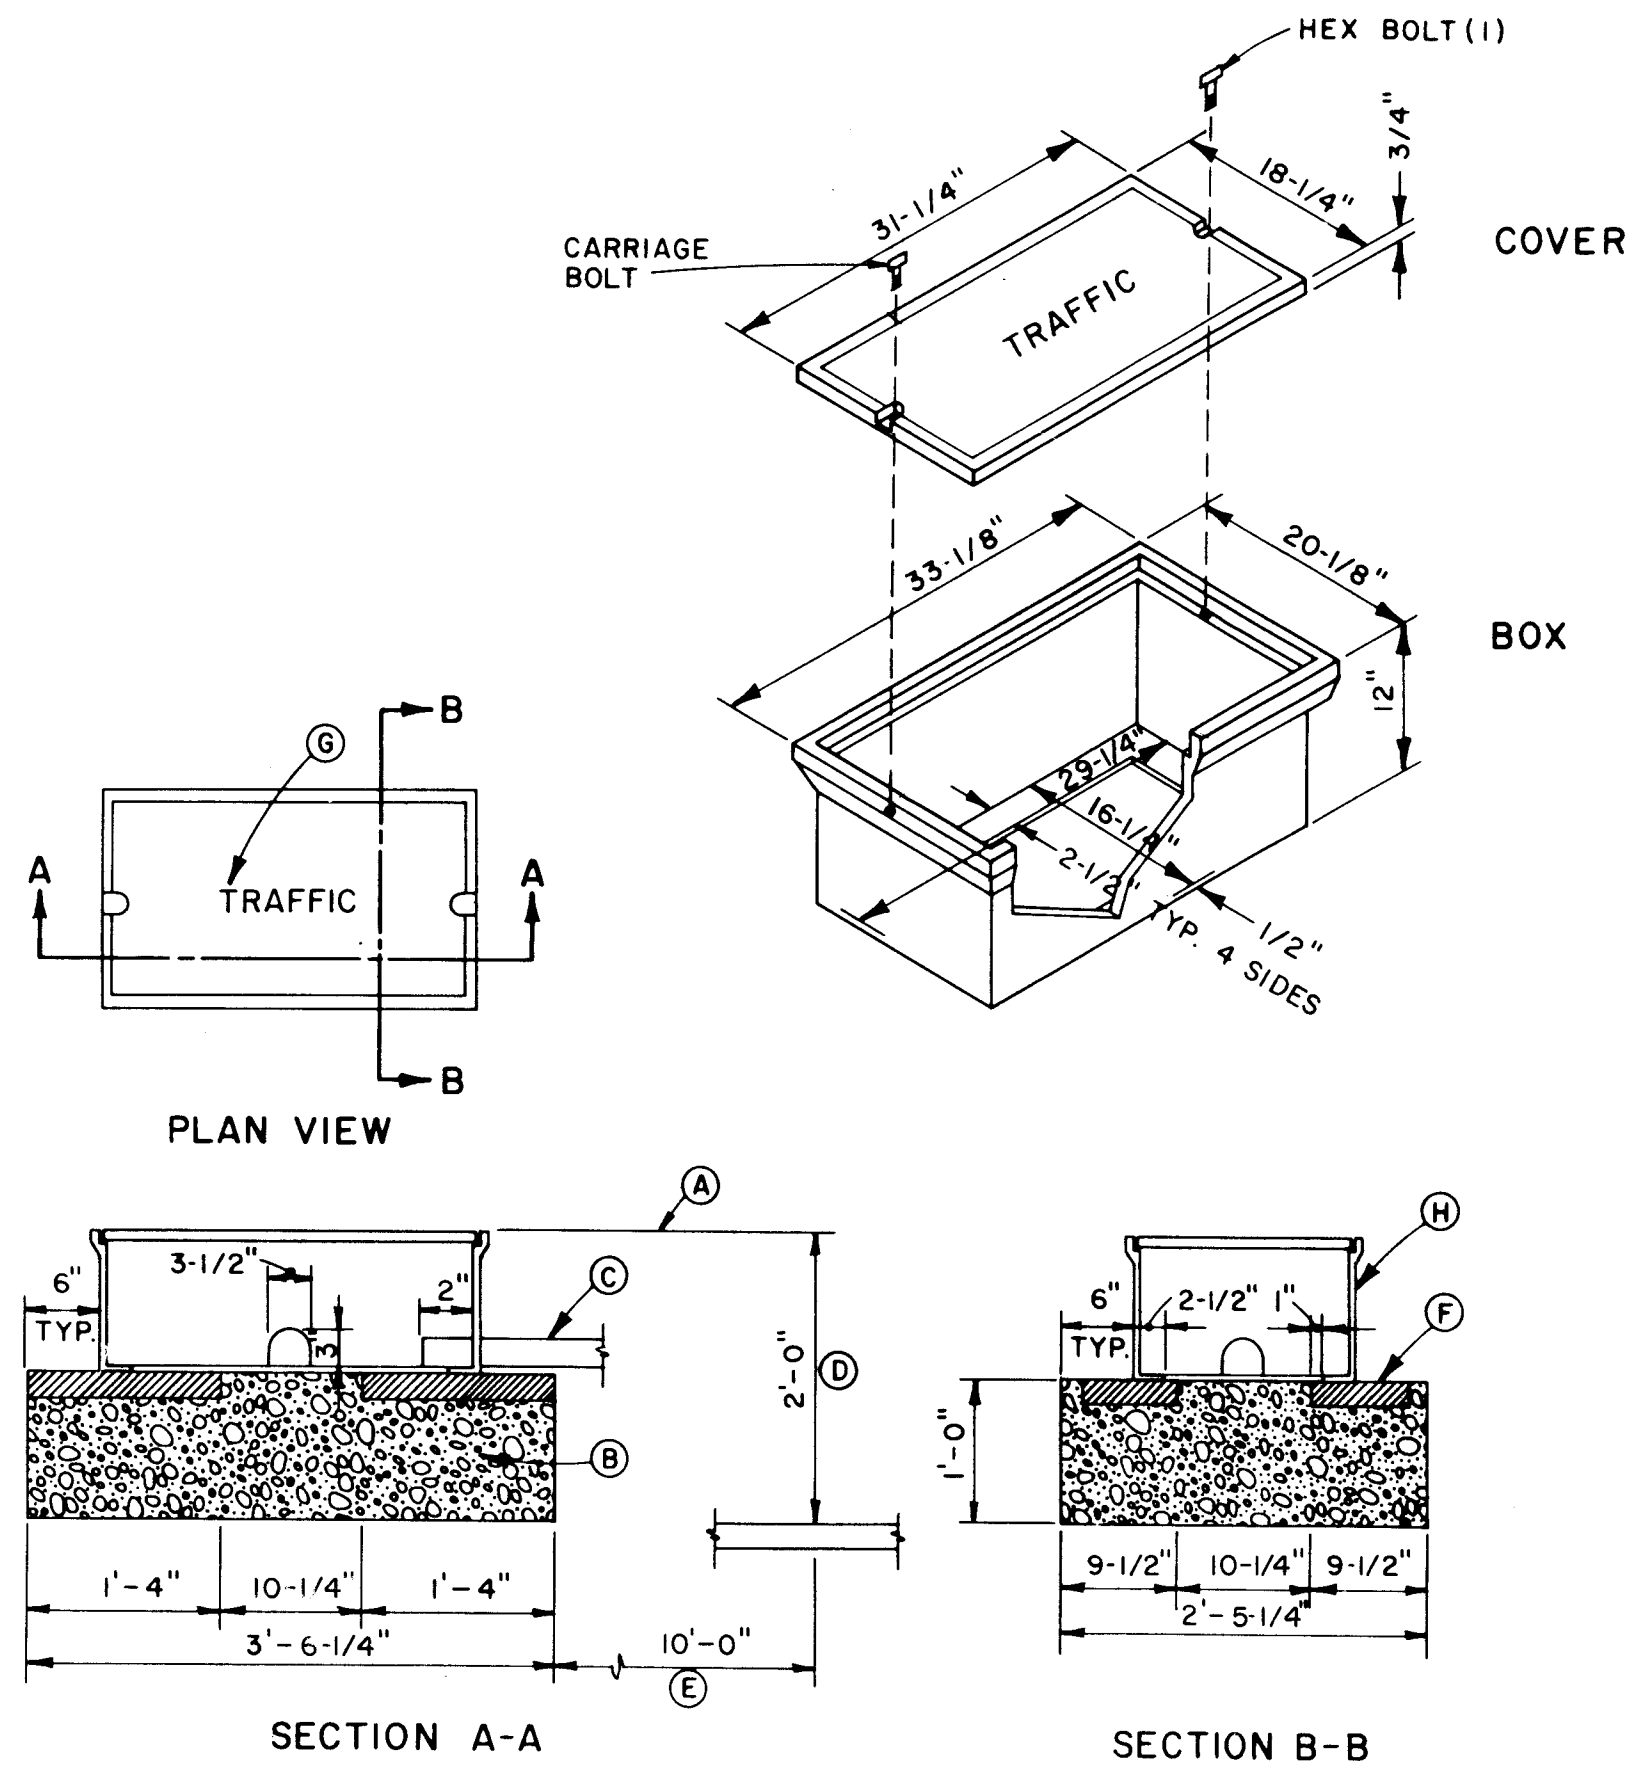


GENERAL NOTES

1. UNDERGROUND ENCLOSURES SHALL BE QUAZITE COMPOSOLITE NONCONCRETE OR APPROVED EQUAL.
2. ENCLOSURES SHALL BE COMPOSED OF REINFORCED POLYMER CONCRETE AND BE DESIGNED AND TESTED TO TEMPERATURES OF -50°F, AND MEET THE REQUIREMENTS OF THE FOLLOWING TESTS: ASTM D-756, ASTM D-543, ASTM D-1501, ASTM D-570, ASTM D-790, AND ASTM D-635.


CONSTRUCTION NOTES

- A. GROUND OR SIDEWALK LEVEL.
- B. CLEAN GRAVEL DRAIN.
- C. TRAFFIC SIGNAL CONDUIT.
- D. NATIONAL ELECTRICAL CODE DEPTH REQUIREMENT.
- E. BEND ELECTRICAL CONDUIT INTO PULL BOX OVER A DISTANCE OF 10 FT.
- F. PROVIDE 4-8" X 2" X 16" CONCRETE BLOCKS FOR SUPPORT OF BOX.
- G. PROVIDE "TRAFFIC" LOGO EMBOSSED ON BOX COVER.
- H. TRAFFIC PULL BOX SHALL BE FOOTED BOX TYPE.


LARGE PULLBOX DETAIL
(30-1/4" X 17-1/4" X 12")
NO SCALE

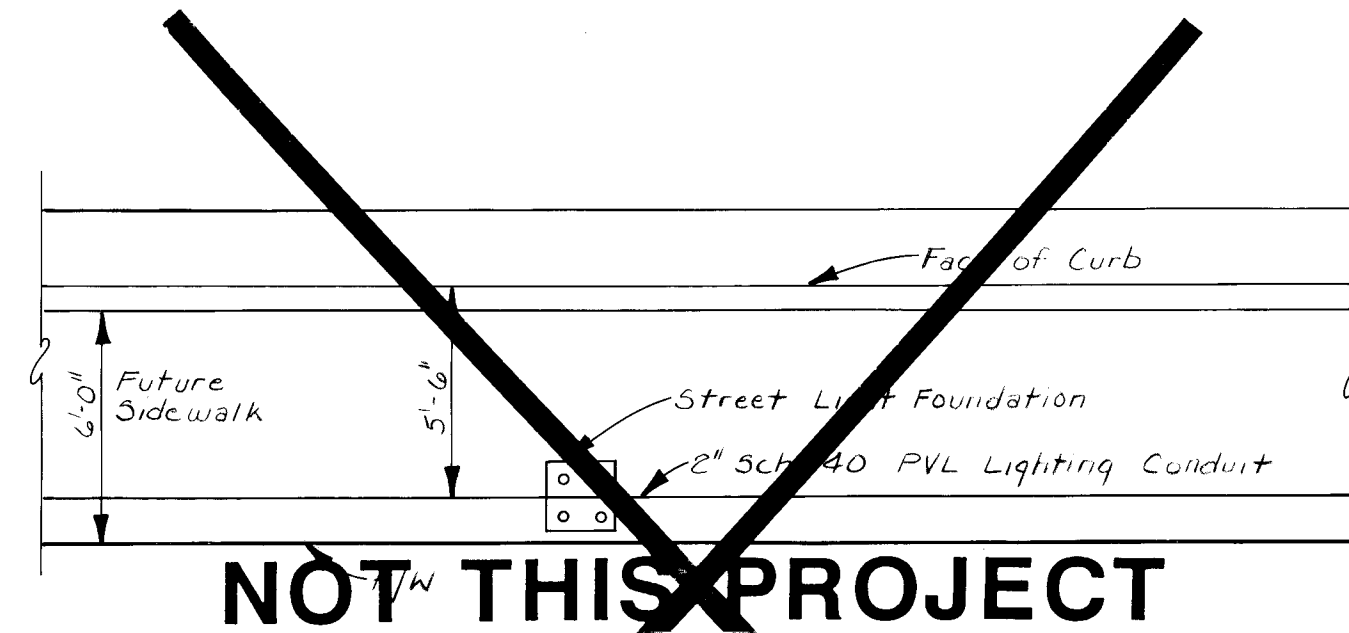


STREET LIGHT FOUNDATION & COMPUTER INTERCONNECT STD. PULLBOX LOCATION - DETAIL A
NO SCALE
West Side Street Light Foundations Station 6+30 to +35

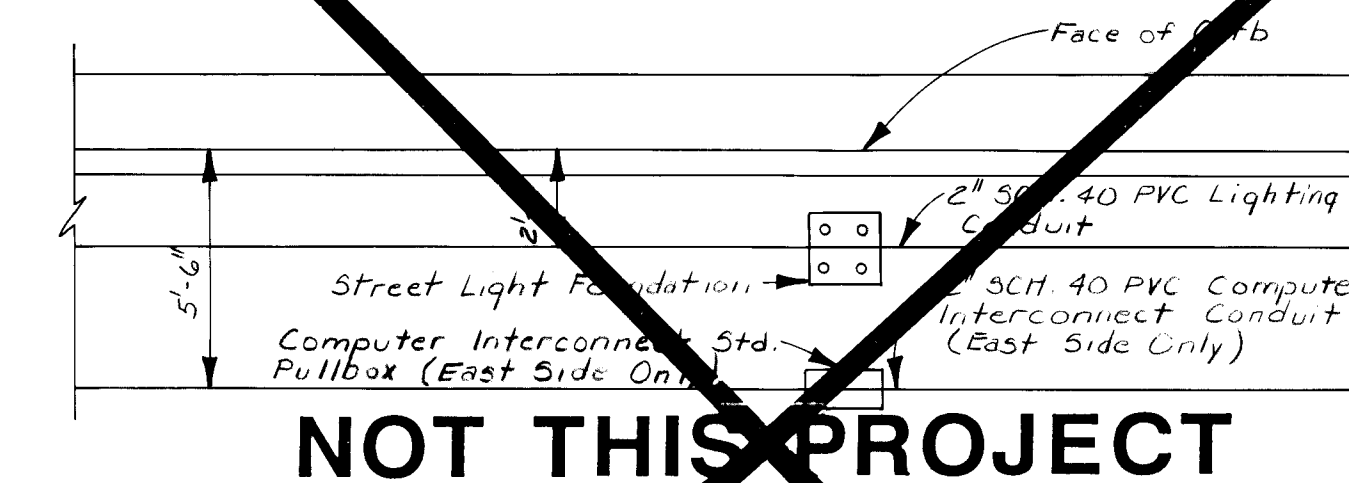

STREET LIGHT FOUNDATION & COMPUTER INTERCONNECT STD. PULLBOX LOCATION - DETAIL B
NO SCALE
West Side Street Light Foundations Stations 14+82, 18+00, 19+30
East Side Street Light Foundations & Computer Interconnect Std. Pullboxes Stations 4+20, 10+65, 14+00, 18+60

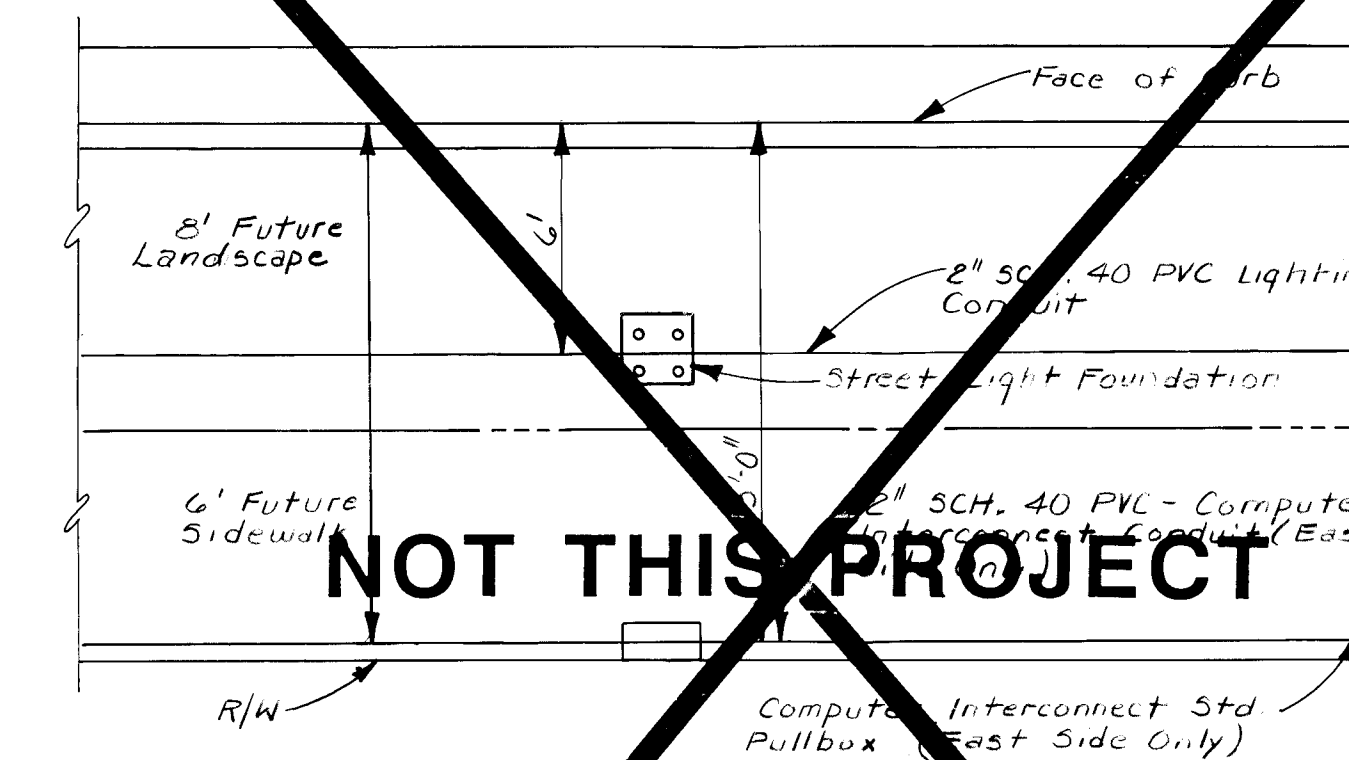

STREET LIGHT FOUNDATION & COMPUTER INTERCONNECT STD. PULLBOX LOCATION - DETAIL C
NO SCALE
West Side Street Light Foundations Station 0+25, 1+95, 4+20, 10+65, 12+85
East Side Street Light Foundations & Computer Interconnect Std. Pullboxes Stations 0+25, 1+95, 6+30, 8+00, 12+42, 17+00, 18+60

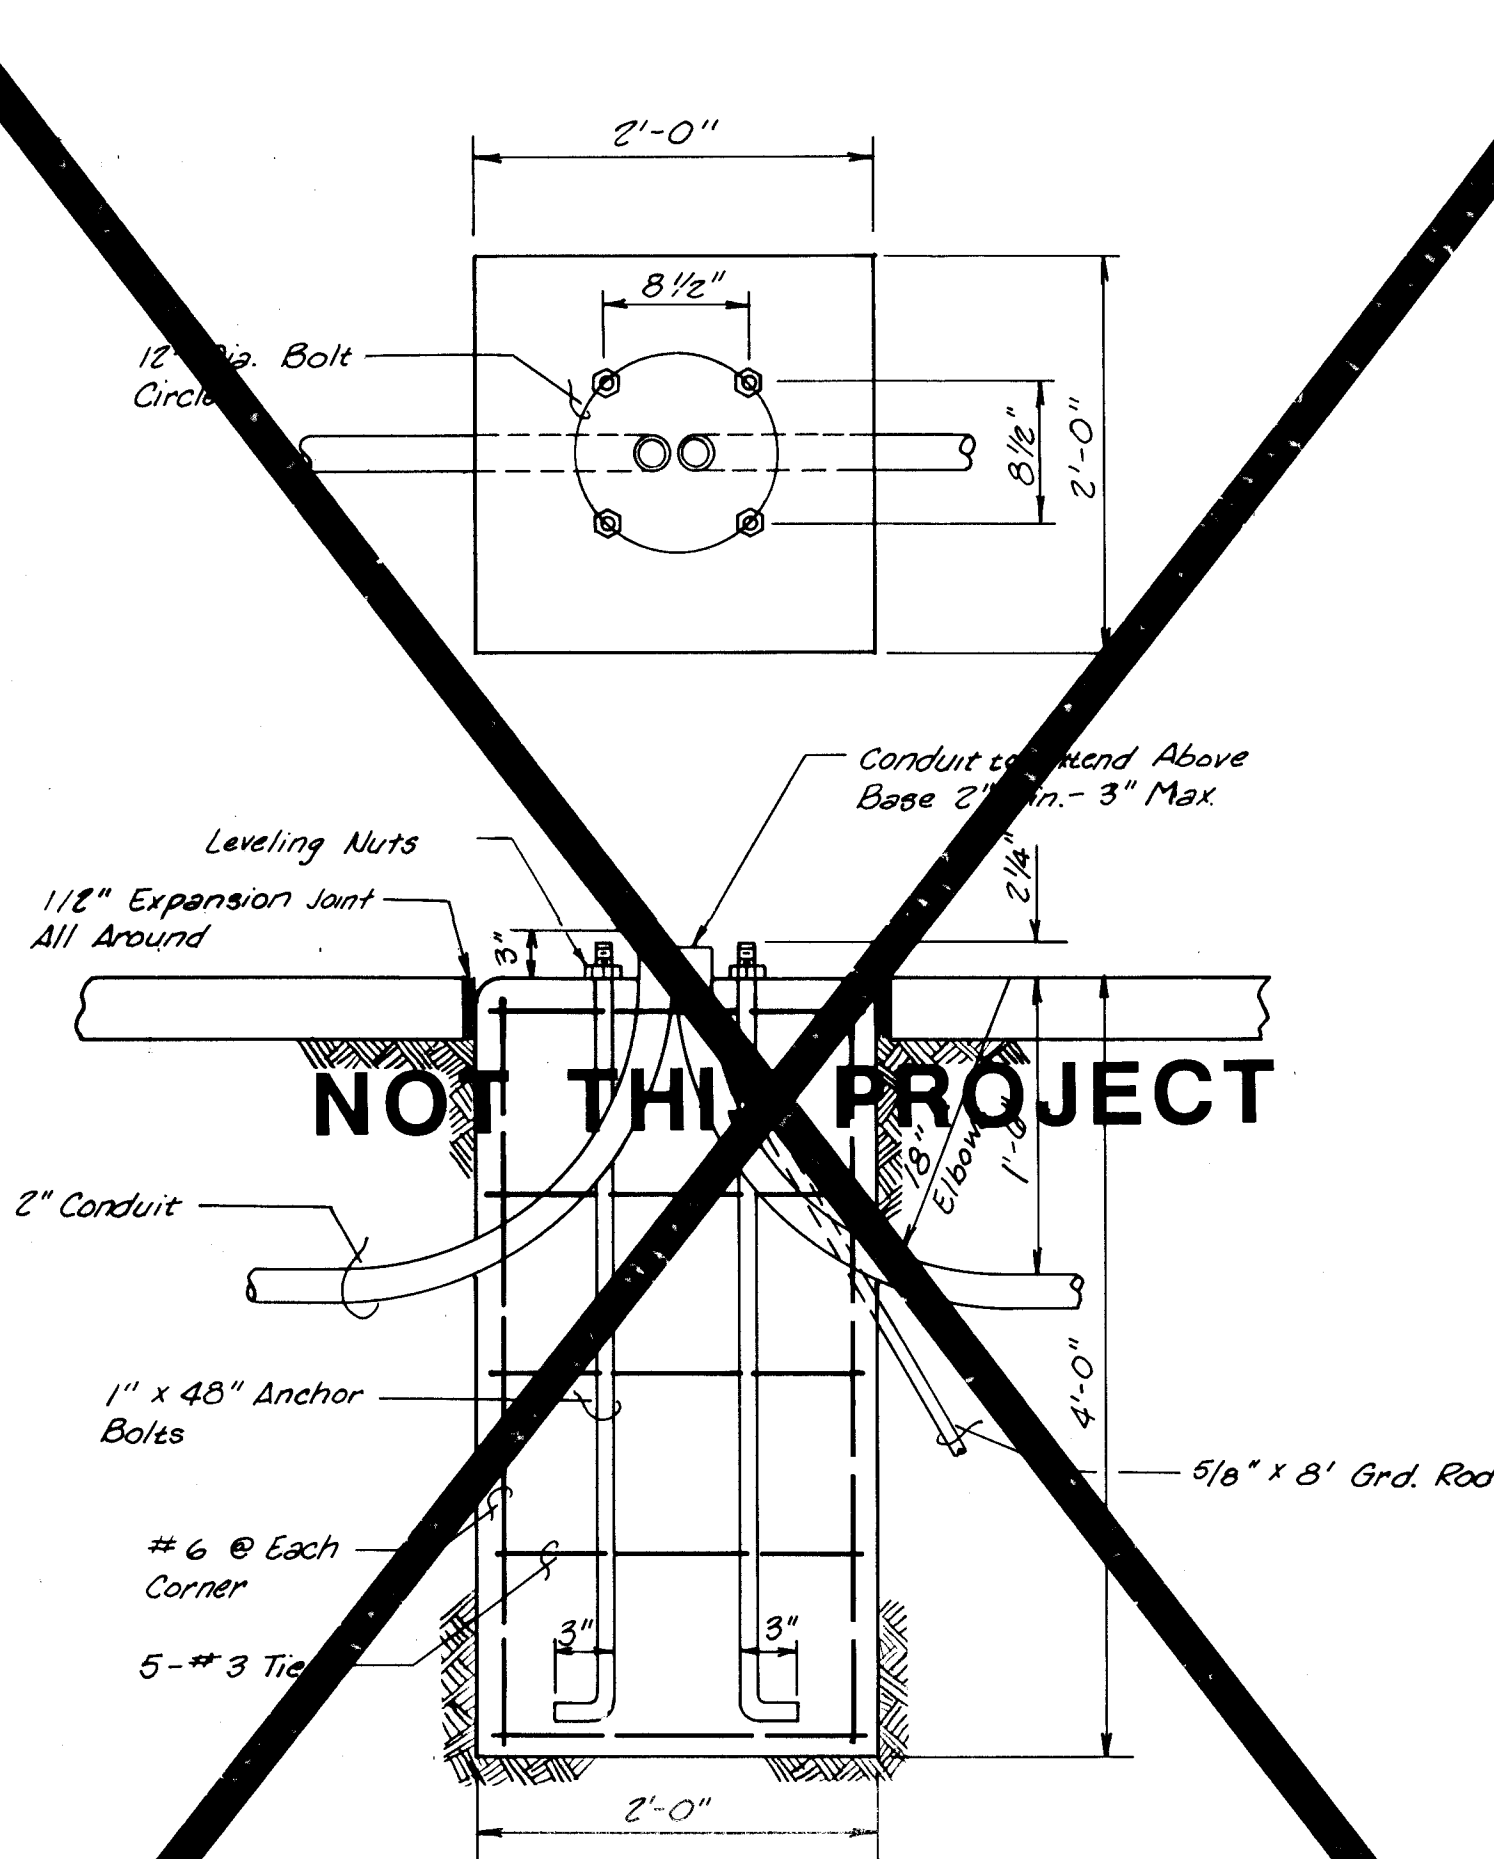

ARTERIAL STREET LIGHT FOUNDATION DETAIL
NO SCALE



RECORD DRAWINGS
DATE 4/28/88


1 2 3 4 5 6 7 8 9 10 11 12
26 33 142888

CITY OF ALBUQUERQUE
PUBLIC WORKS
ENGINEERING


TITLE: COORS WIDENING-LOTS 2 & 3
MISCELLANEOUS DETAILS / TRAFFIC

APPROVALS	ENGINEER	DATE	APPROVALS	ENGINEER	DATE
City Engineer	W. L. Vreese	8/14/87	Liquid Waste	NA	8/14/87
A-C-E-Design	W. L. Vreese	8/15/87	Traffic	W. L. Vreese	8/15/87
A-C-E-Hydrology	W. L. Vreese	8/15/87	Water	NA	8/14/87


DRAWING NO. 3316
MAP NO. H-II
SHEET 28 OF 38

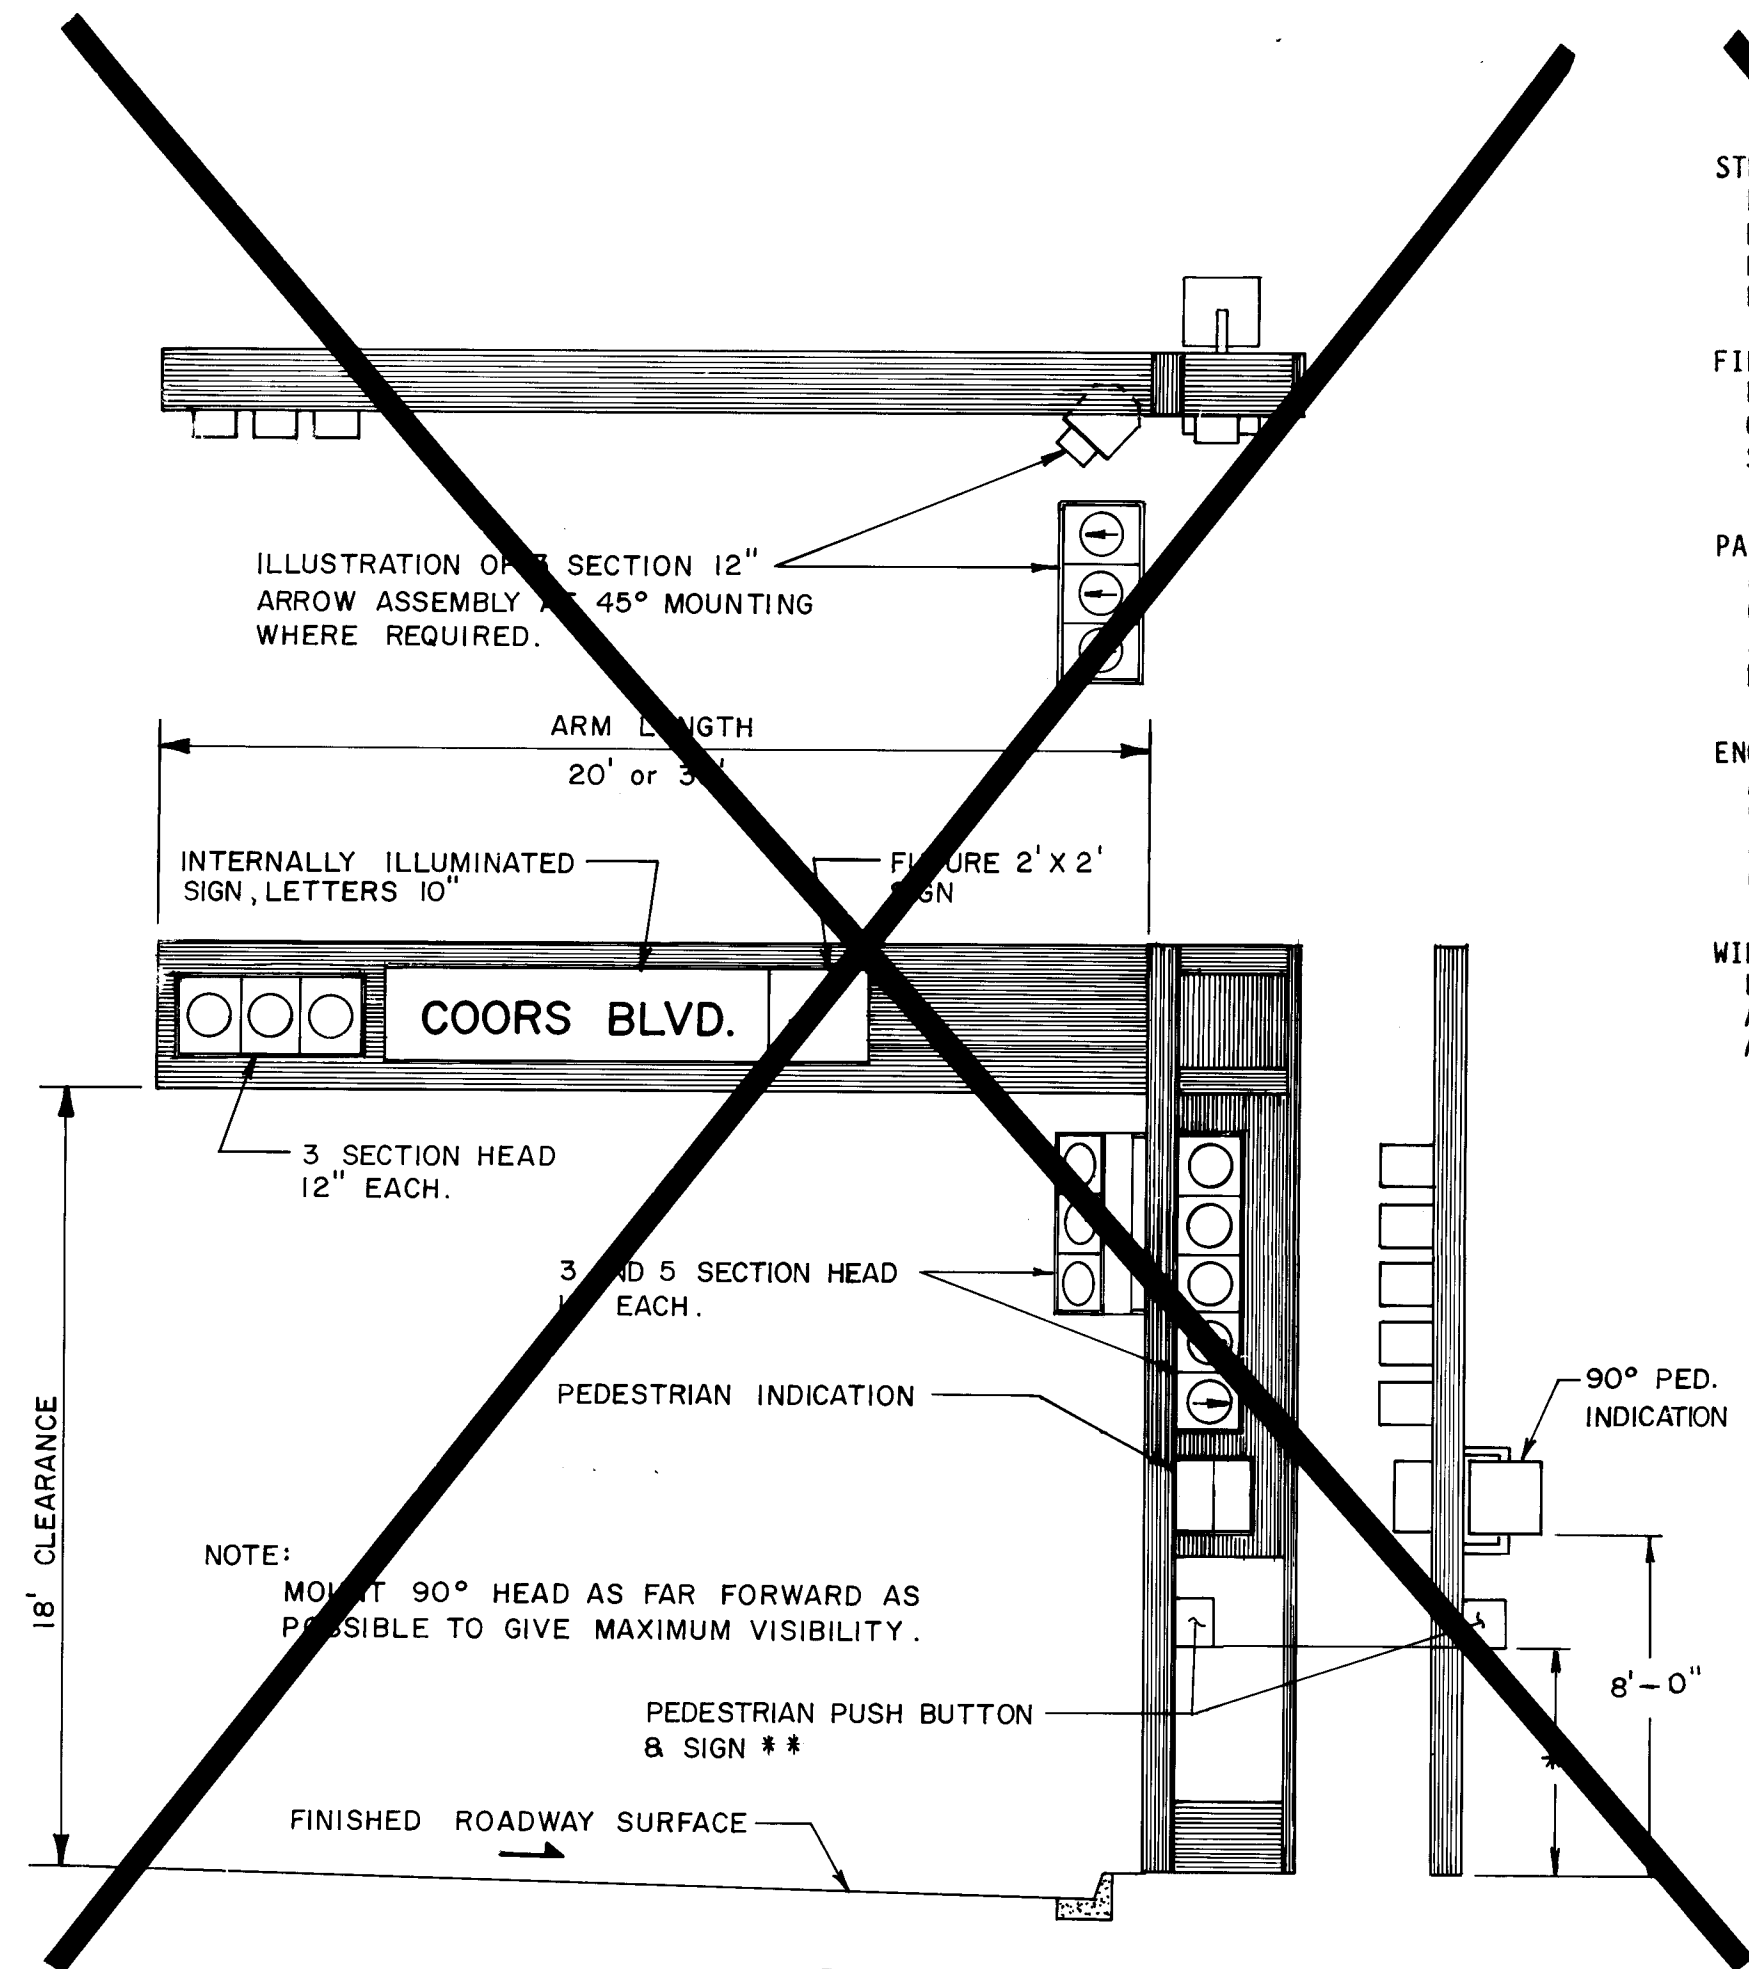


NOT THIS PROJECT
SPECIAL SIGNAL TYPE "A"
NO SCALE

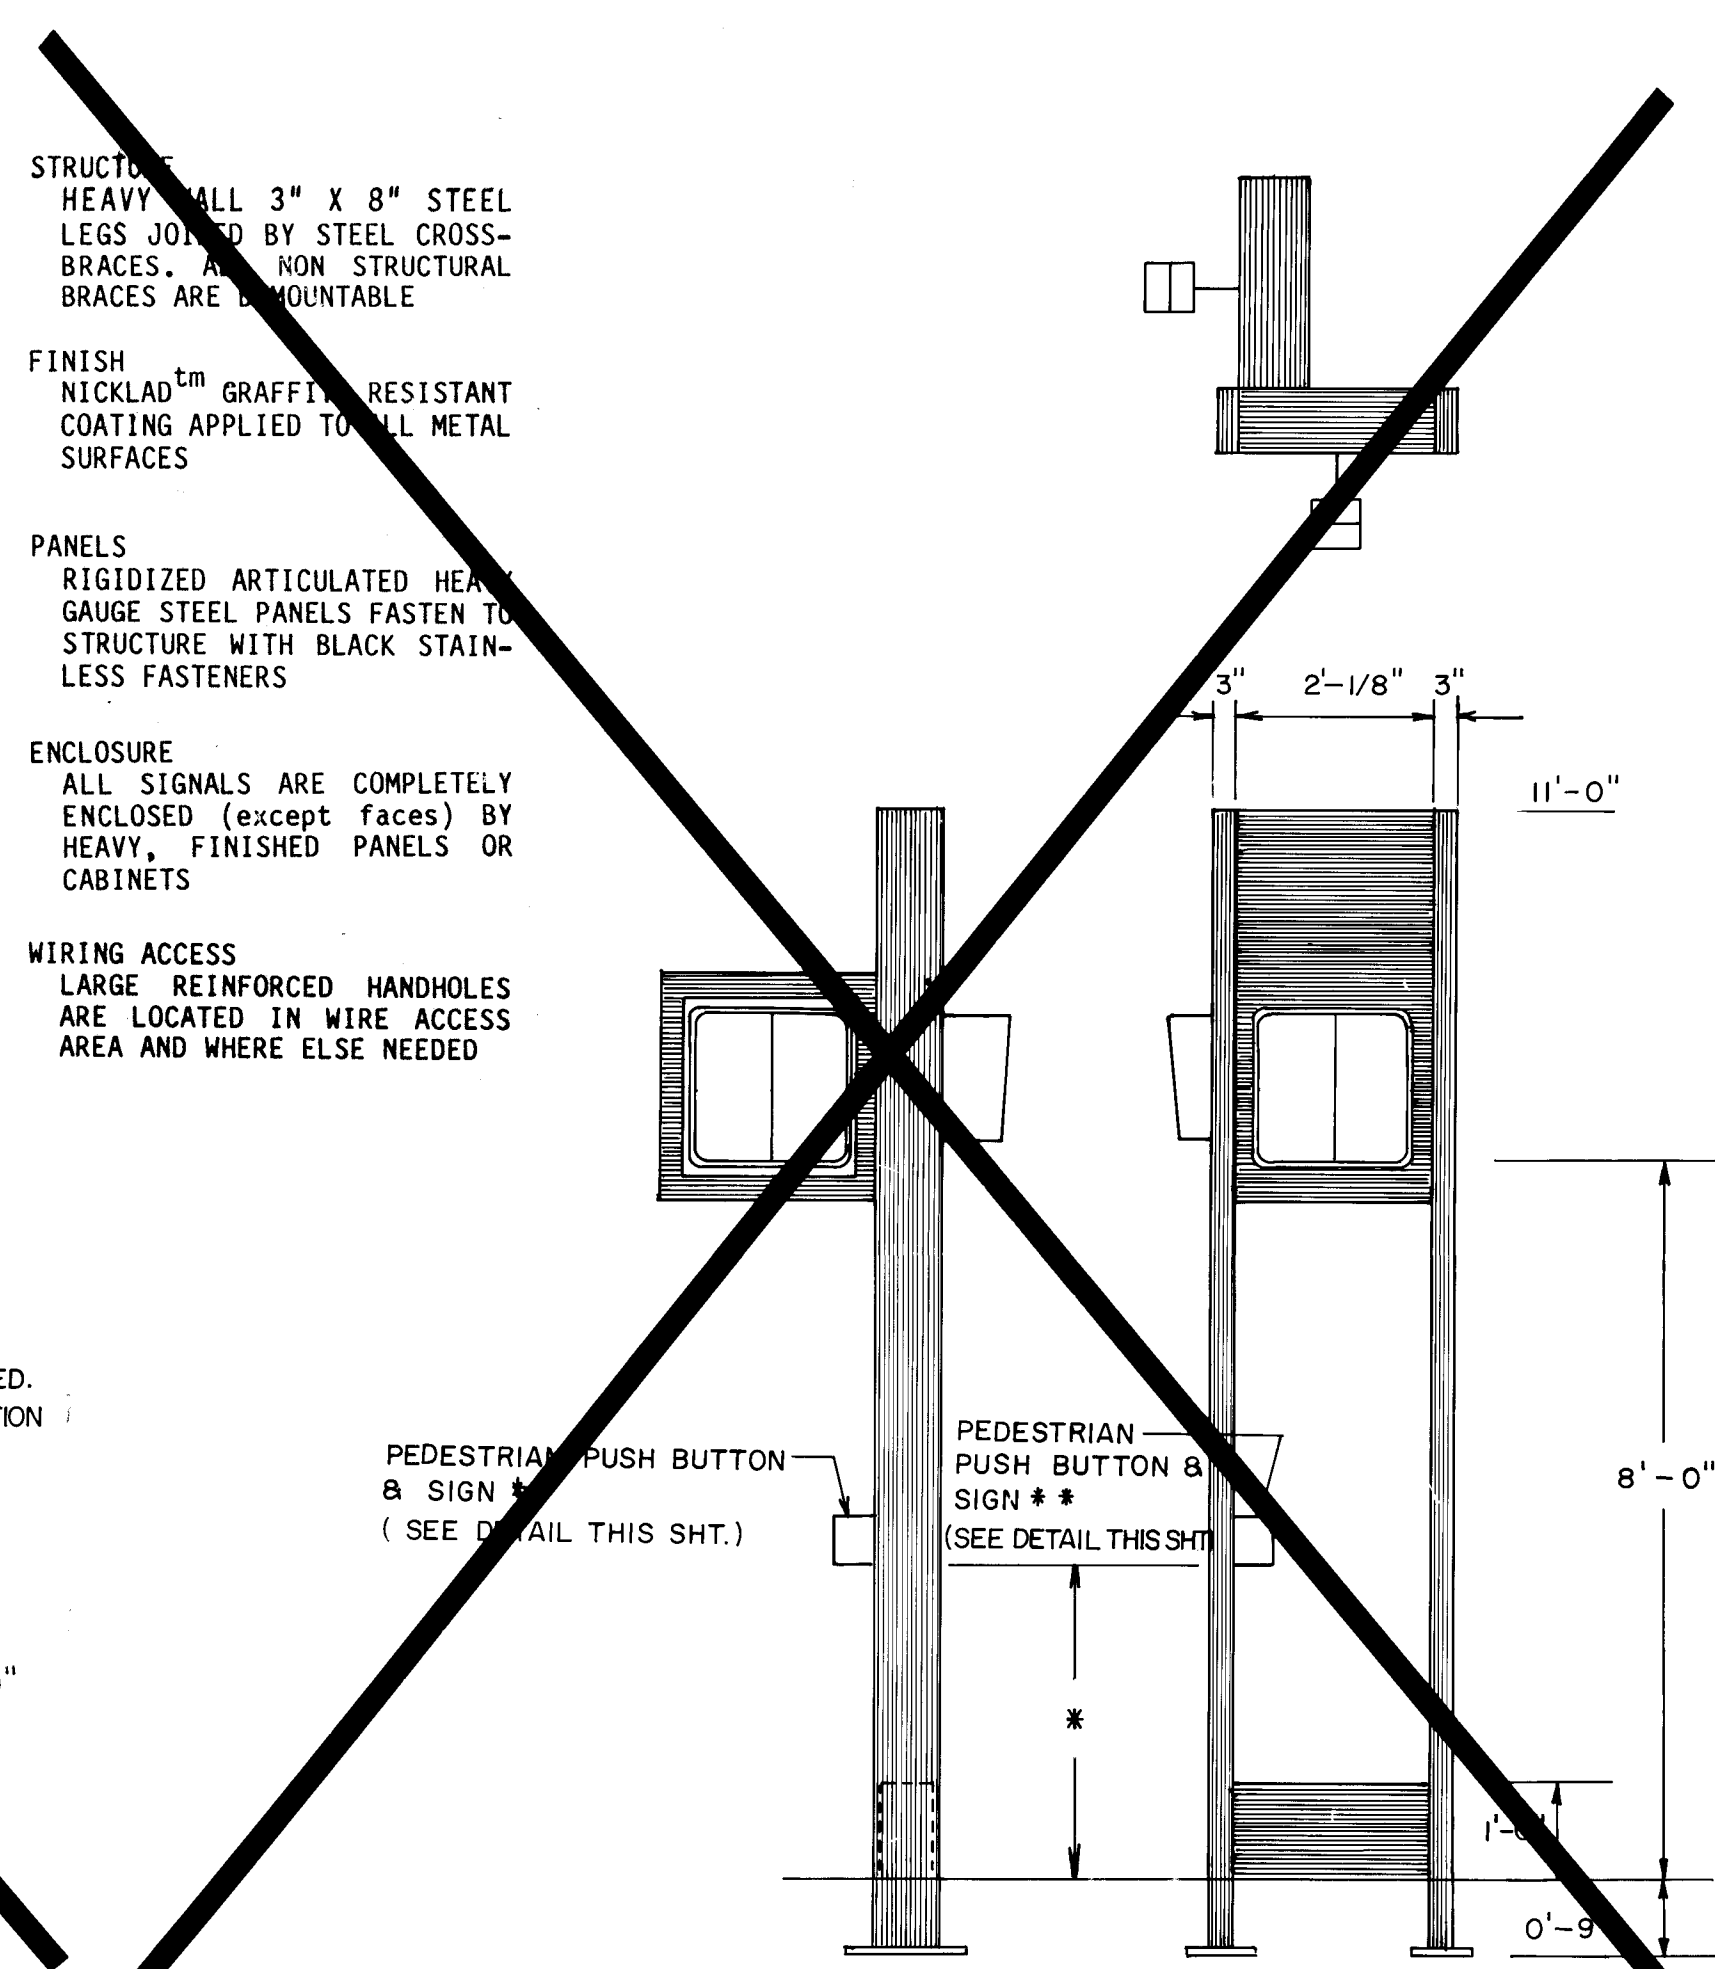


NOT THIS PROJECT
SIGNAL TYPE "B"
NO SCALE

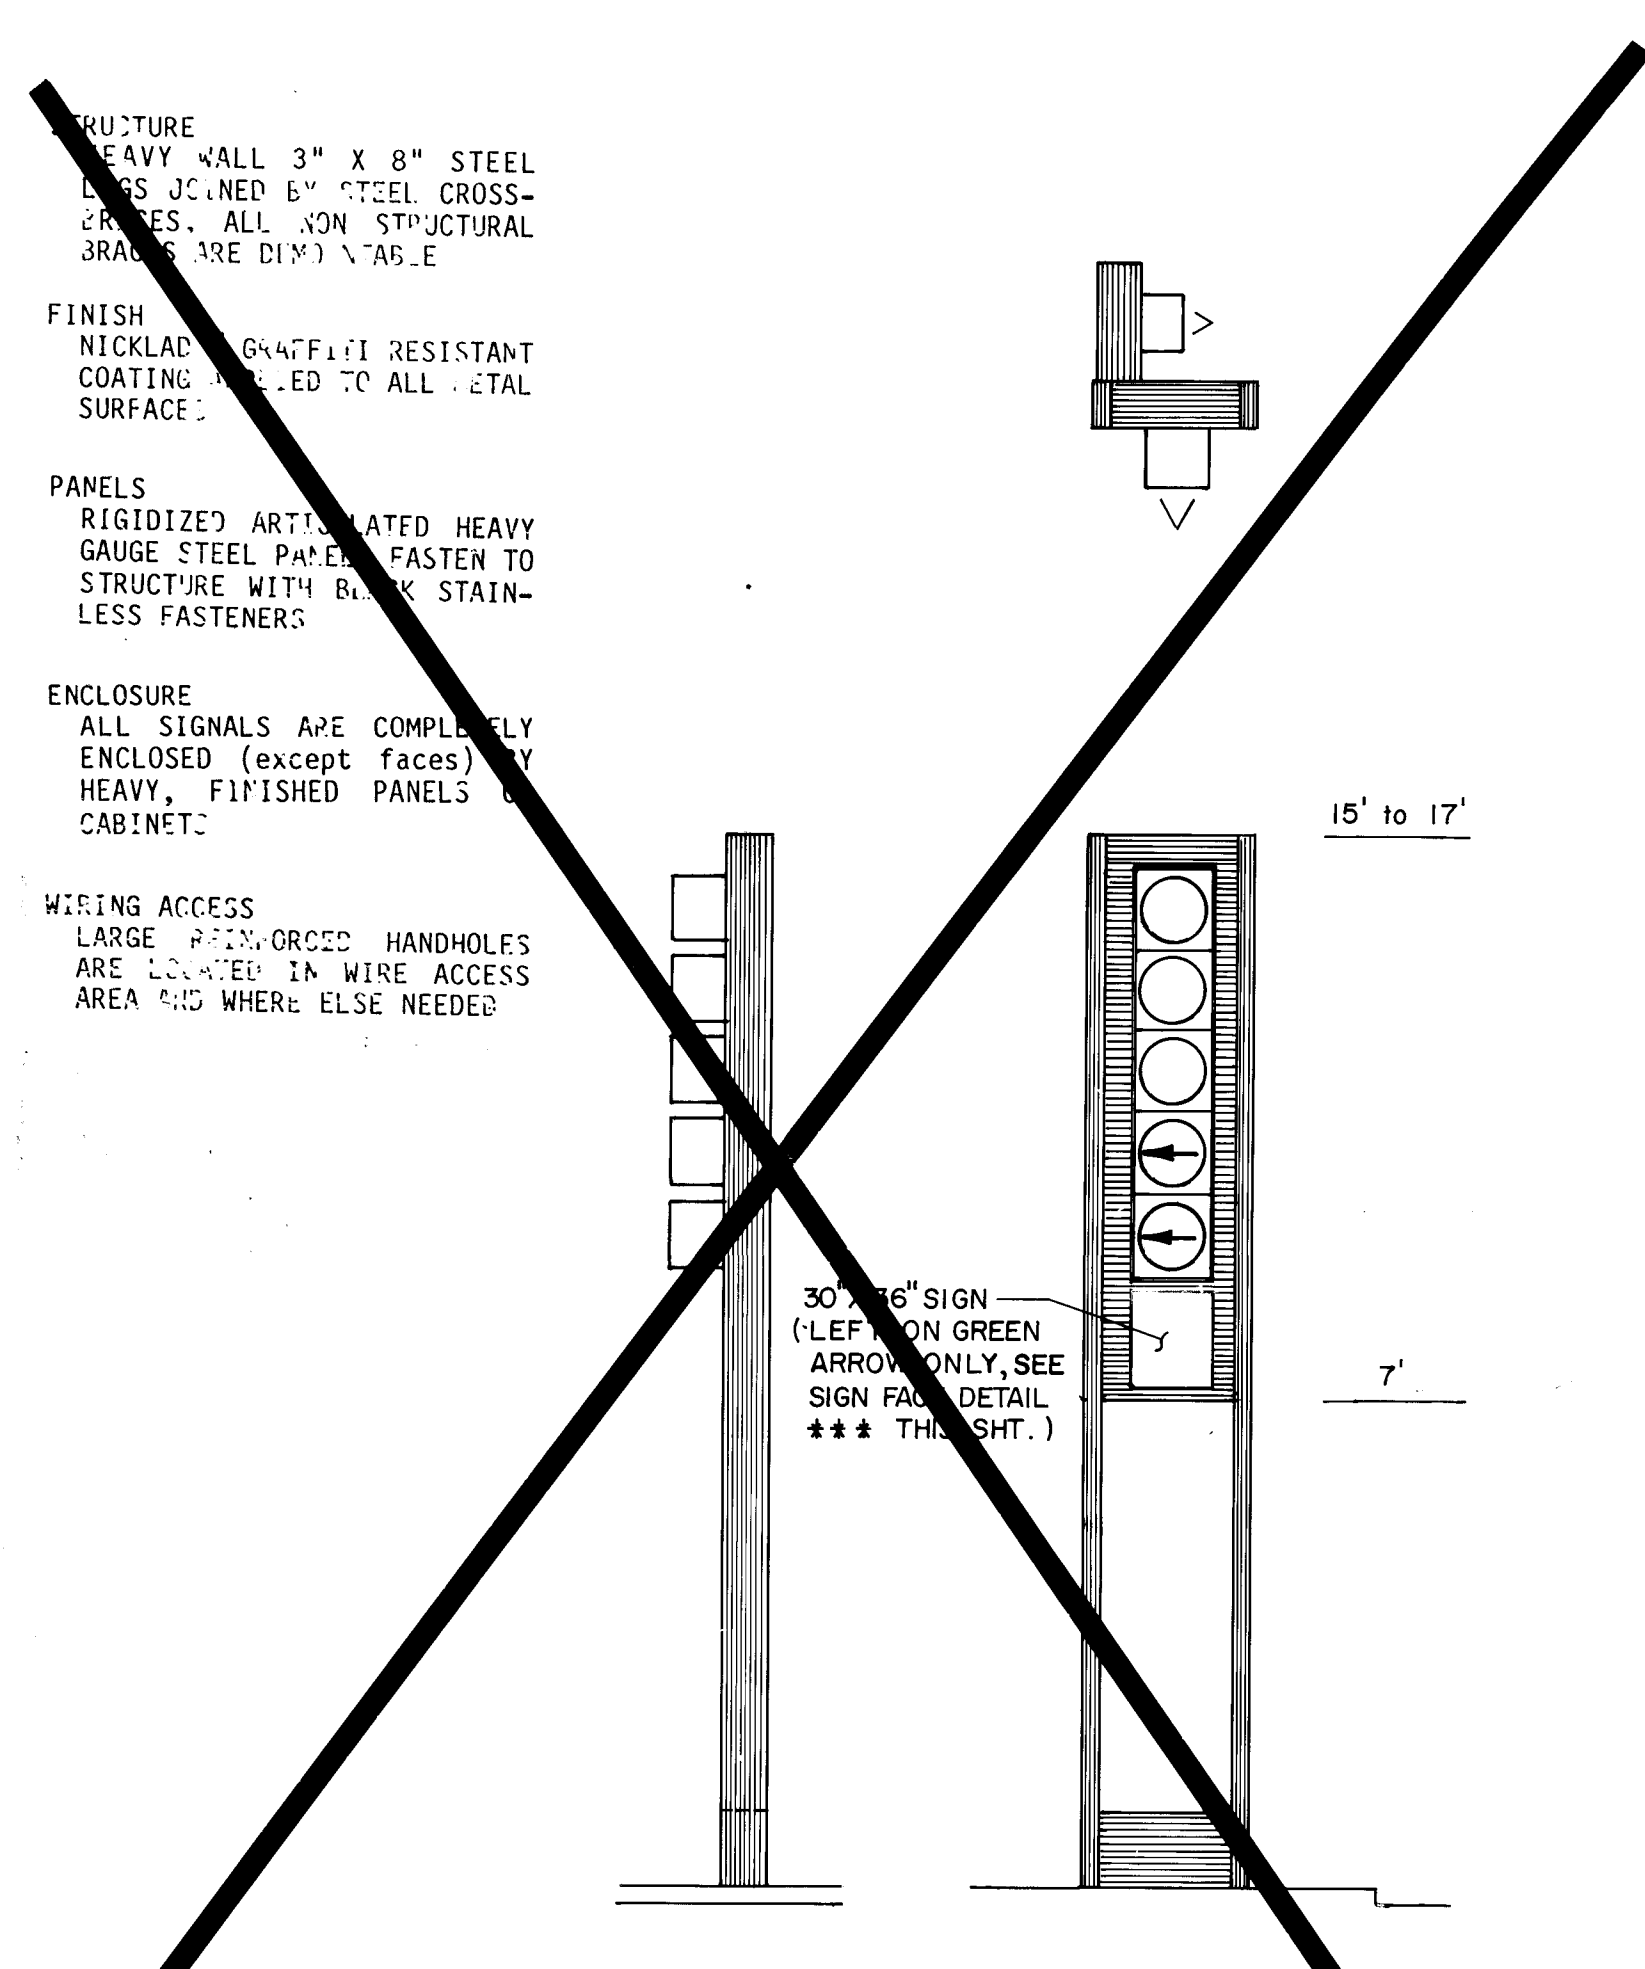


NOT THIS PROJECT
SIGNAL TYPE "C"
NO SCALE

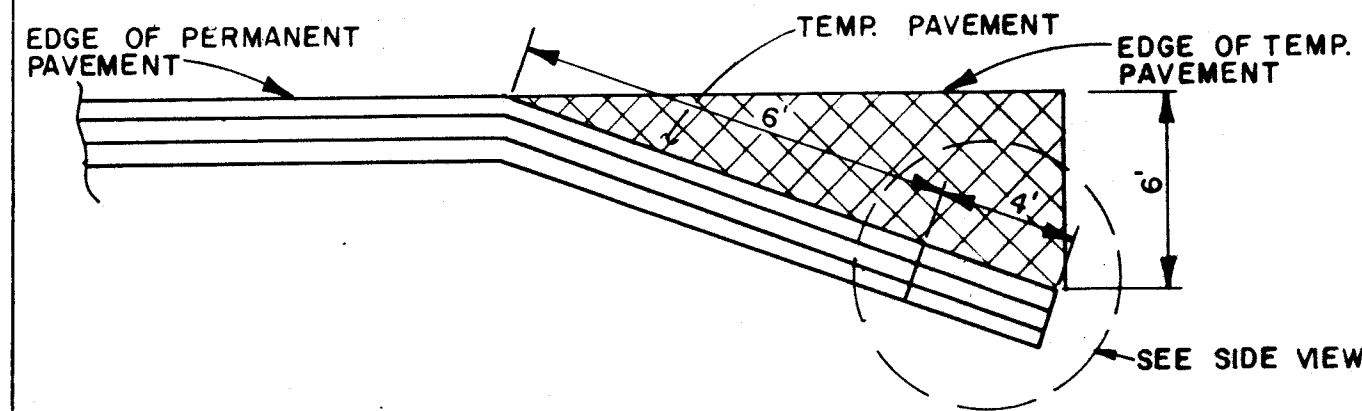


ASPHALT CURB FLARE - PLAN
NO SCALE

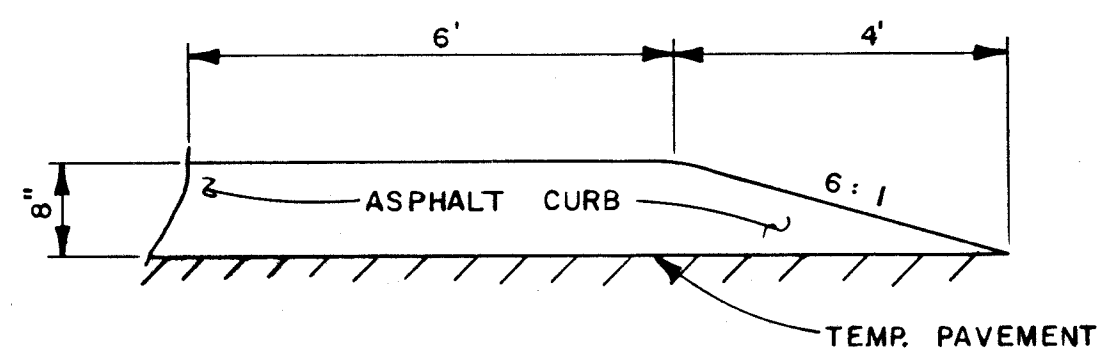


ASPHALT CURB FLARE - SIDE VIEW
NO SCALE

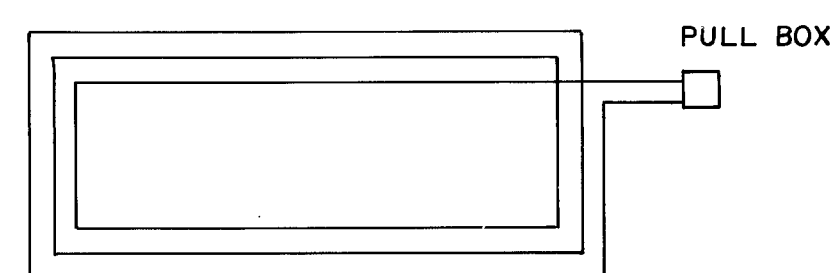


3 TURN STANDARD LOOP DETAIL
NO SCALE

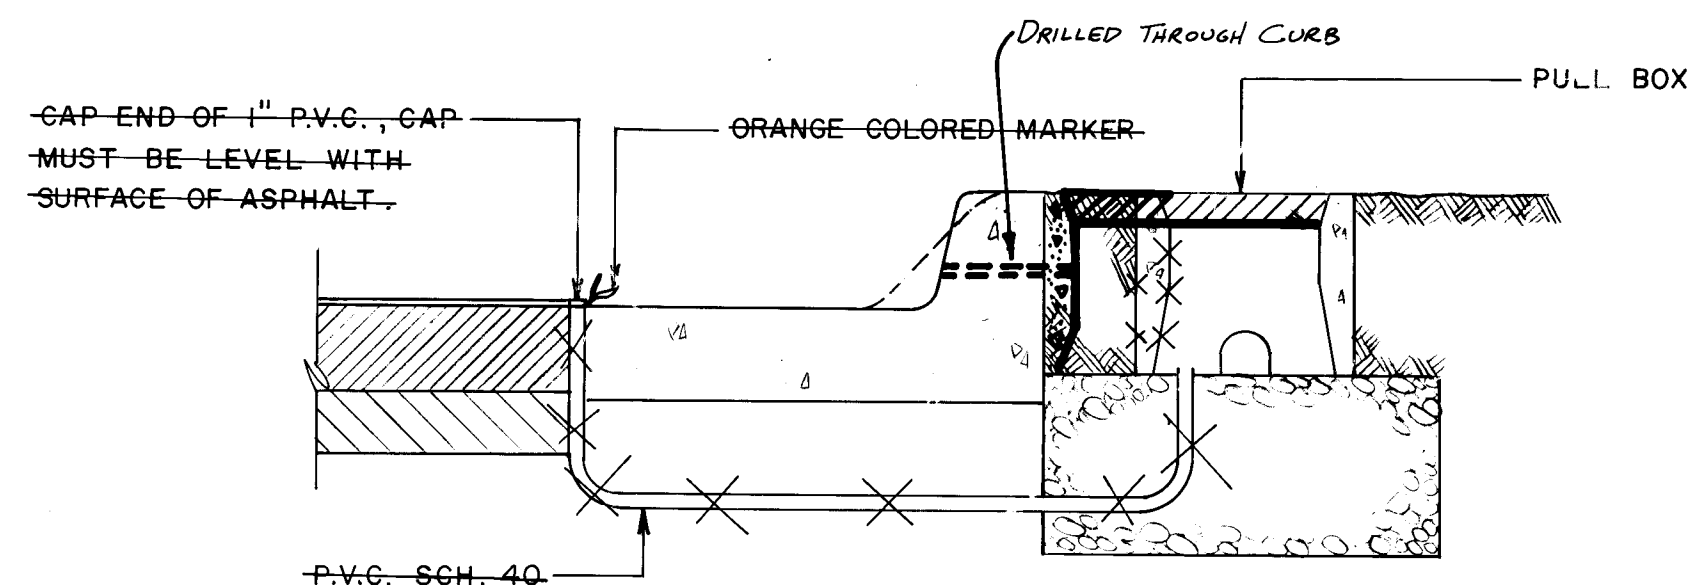


LOOP DETECTOR CONDUIT DETAIL
NO SCALE

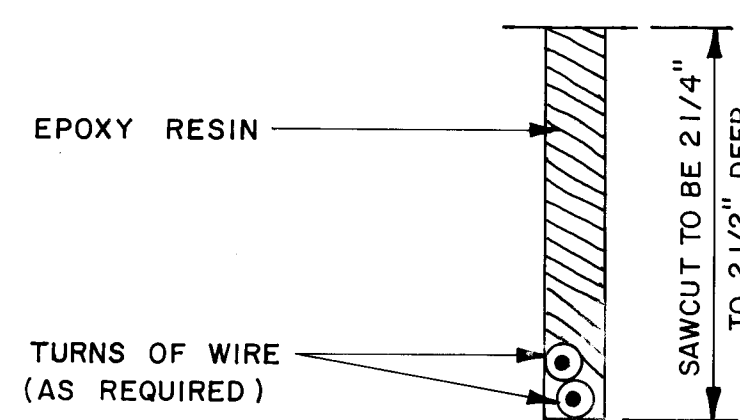

TYPICAL ROADWAY LOOP SAWCUT DETAIL
NO SCALE

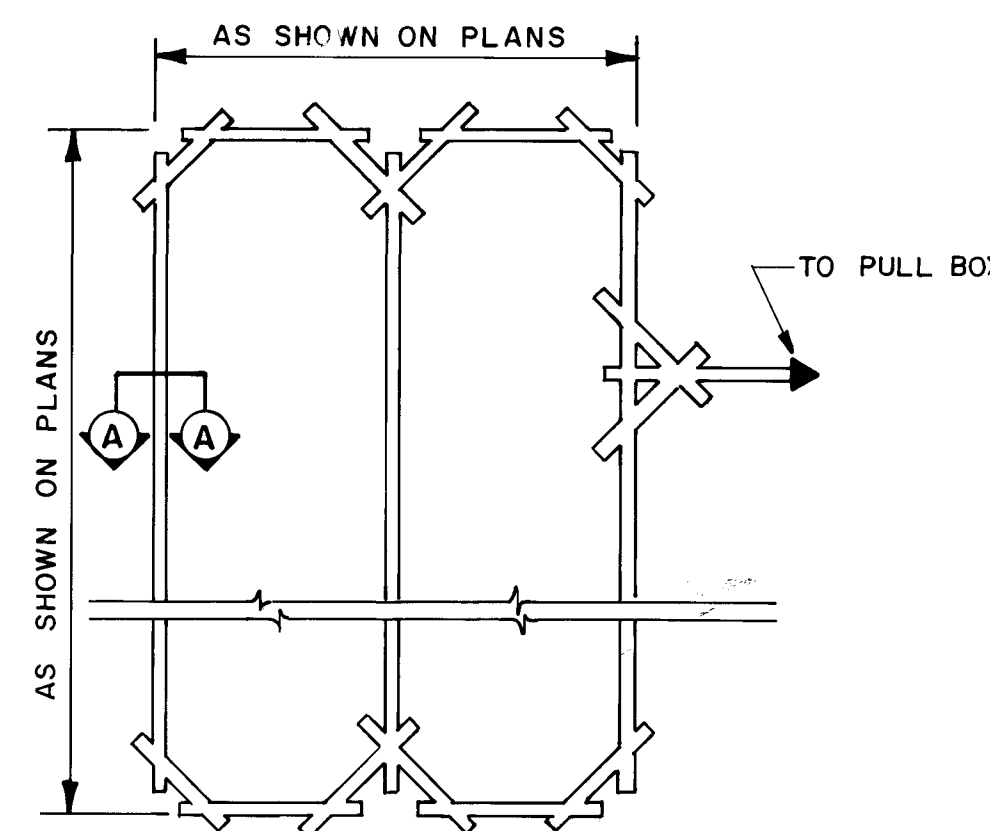

NOTE: ALL LOOP DETECTORS TO BE INDIVIDUALLY WIRED TO THE CONTROLLER. WIRING TO BE SLIDING SLEEVE # 14AWG X HHW STD. WIRING.

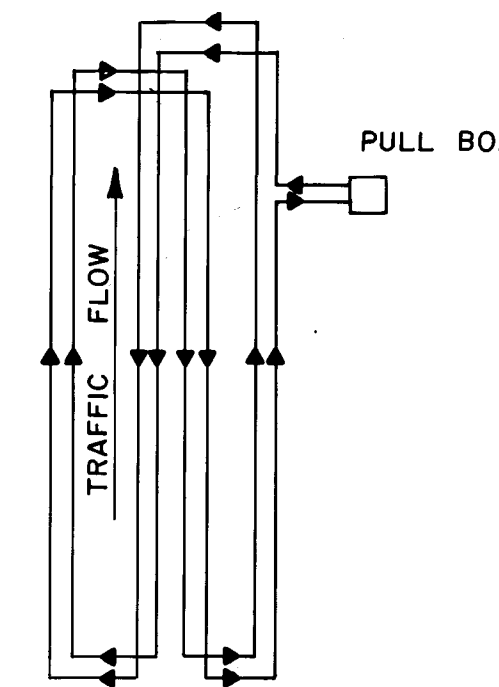


QUADRAPOLE LOOP DETAIL
NO SCALE




RECORD DRAWINGS
DATE 4/28/88

CITY OF ALBUQUERQUE PUBLIC WORKS ENGINEERING					
TITLE: COORS WIDENING - LOTS 2 & 3 MISCELLANEOUS DETAILS / TRAFFIC					
APPROVALS	ENGINEER	DATE	APPROVALS	ENGINEER	DATE
CITY Engineer	John J. 12	8/26/87	Liquid Waste	NA	8/14/87
A.C.E. - Design	David L. 12	8/15/87	Traffic	NA	8/14/87
A.C.E. - Hydrology	Steve 12	8/20/87	Water	NA	8/14/87
DRAWING NO.	3316	MAP NO.	H-11	SHEET	29 OF 38

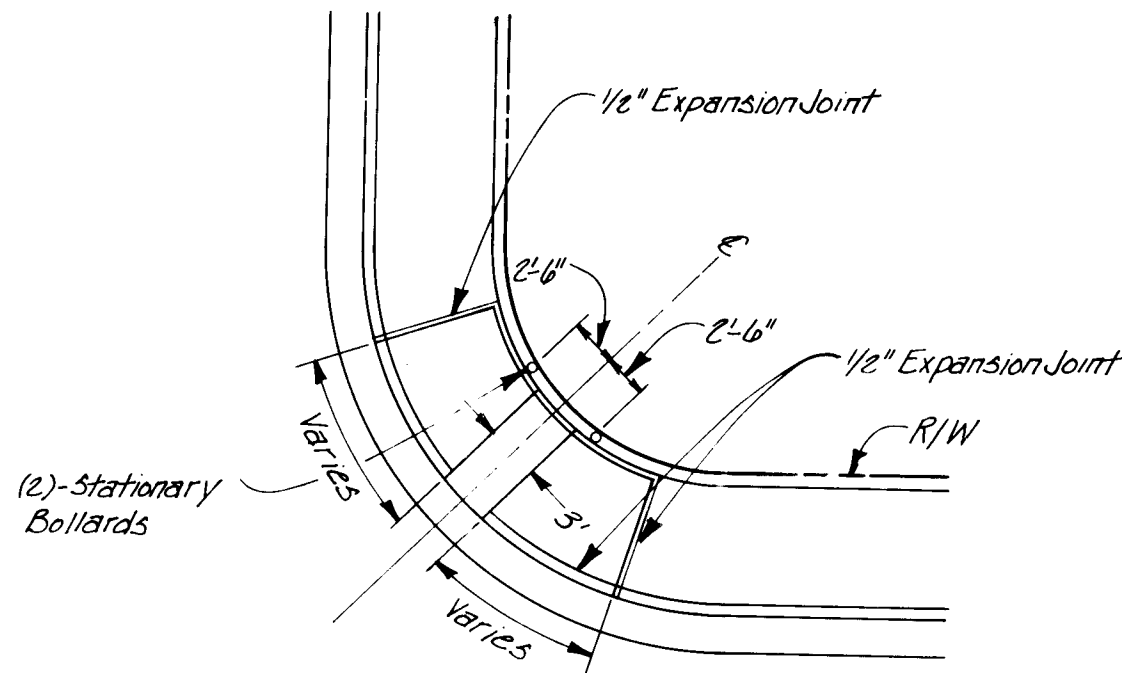

BOLLARD LOCATION PLAN
NO SCALE

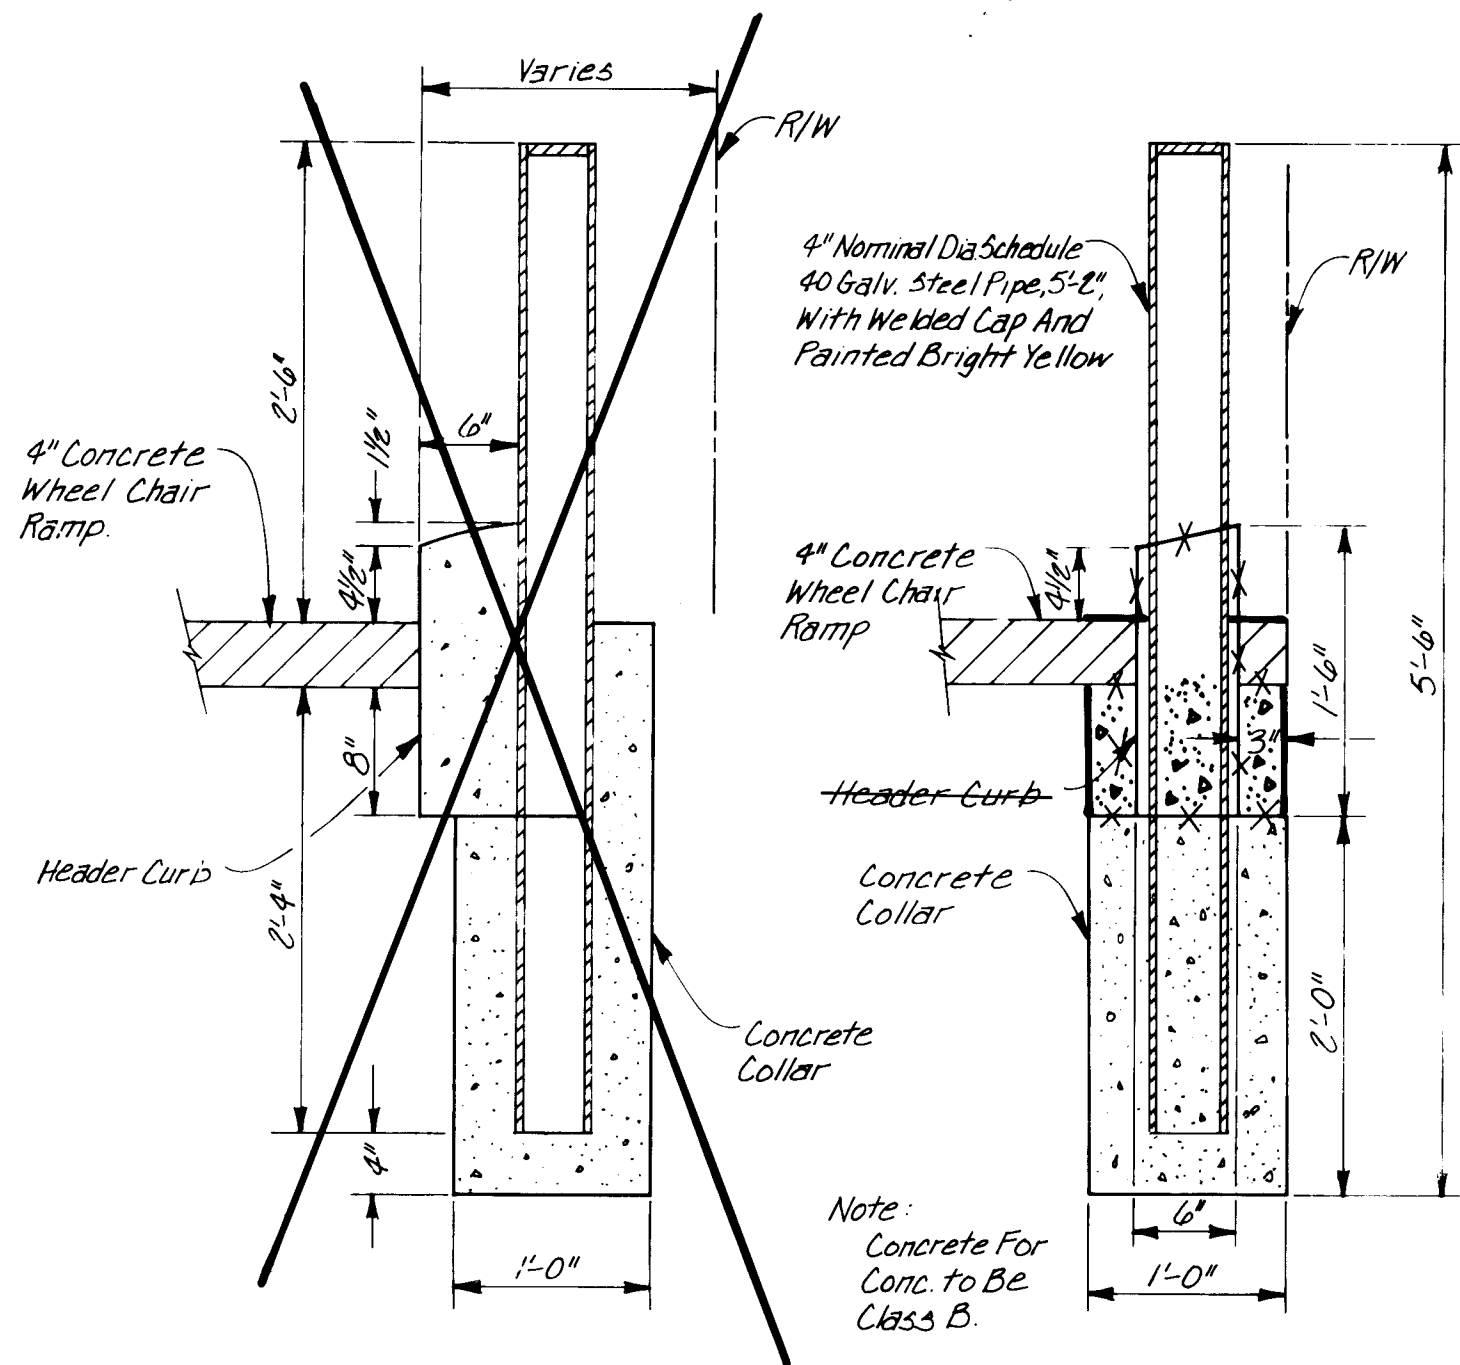

BOLLARD CONSTRUCTION DETAIL
NO SCALE



RECORD DRAWINGS
DATE 4/28/88


NOT TO SCALE
1 2 3 4 5 6 7 8 9 10 11 12
26 33 16 30 8 8


CITY OF ALBUQUERQUE
PUBLIC WORKS
ENGINEERING

TITLE: **COORS WIDENING - LOTS 2 & 3**
MISCELLANEOUS DETAILS / TRAFFIC


APPROVALS	ENGINEER	DATE	APPROVALS	ENGINEER	DATE
City Engineer	<i>John J. ...</i>	<i>8/26/87</i>	Liquid Waste	<i>NA</i>	<i>8/14/87</i>
A.C.E. - Design	<i>"</i>	<i>"</i>	Traffic	<i>John J. ...</i>	<i>8/15/87</i>
Hydrology	<i>Stan ...</i>	<i>8/24/87</i>	Water	<i>NA</i>	<i>8/14/87</i>

DRAWING NO. **3316** MAP NO. **H-11** SHEET **30** OF **38**

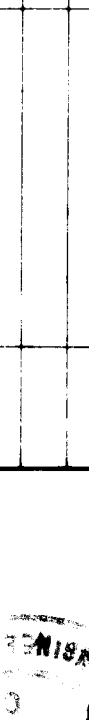ENGINEER'S SEAL		SURVEY INFORMATION		BENCH MARKS		AS-BUILT INFORMATION	
				FIELD NOTES		CONTRACTOR <i>SUNDANCE MECHANICAL</i>	
				NO.	BY	DATE	WORK STAKED BY <i>BMT</i> DATE <i>5/08</i>
							ACCEPTANCE BY <i>CGP</i> DATE <i>4/08</i>
							VERIFICATION BY <i>BMT</i> DATE <i>4/08</i>
							DRAWINGS CORRECTED BY <i>BMT</i> DATE <i>4/08</i>
						MICRO-FILM INFORMATION	
						RECORDED BY	DATE
						NO.	

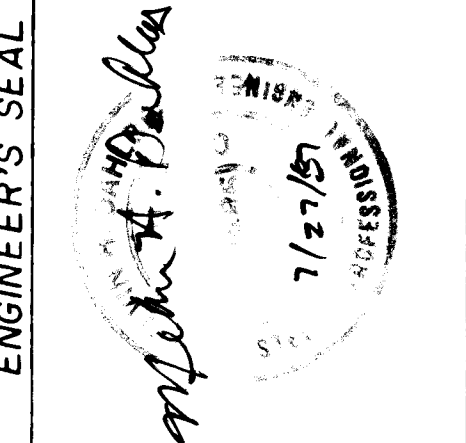

REVISIONS	DATE	DATE
DESIGN		
CHECKED BY		
DRAWN BY		
DESIGNED BY		

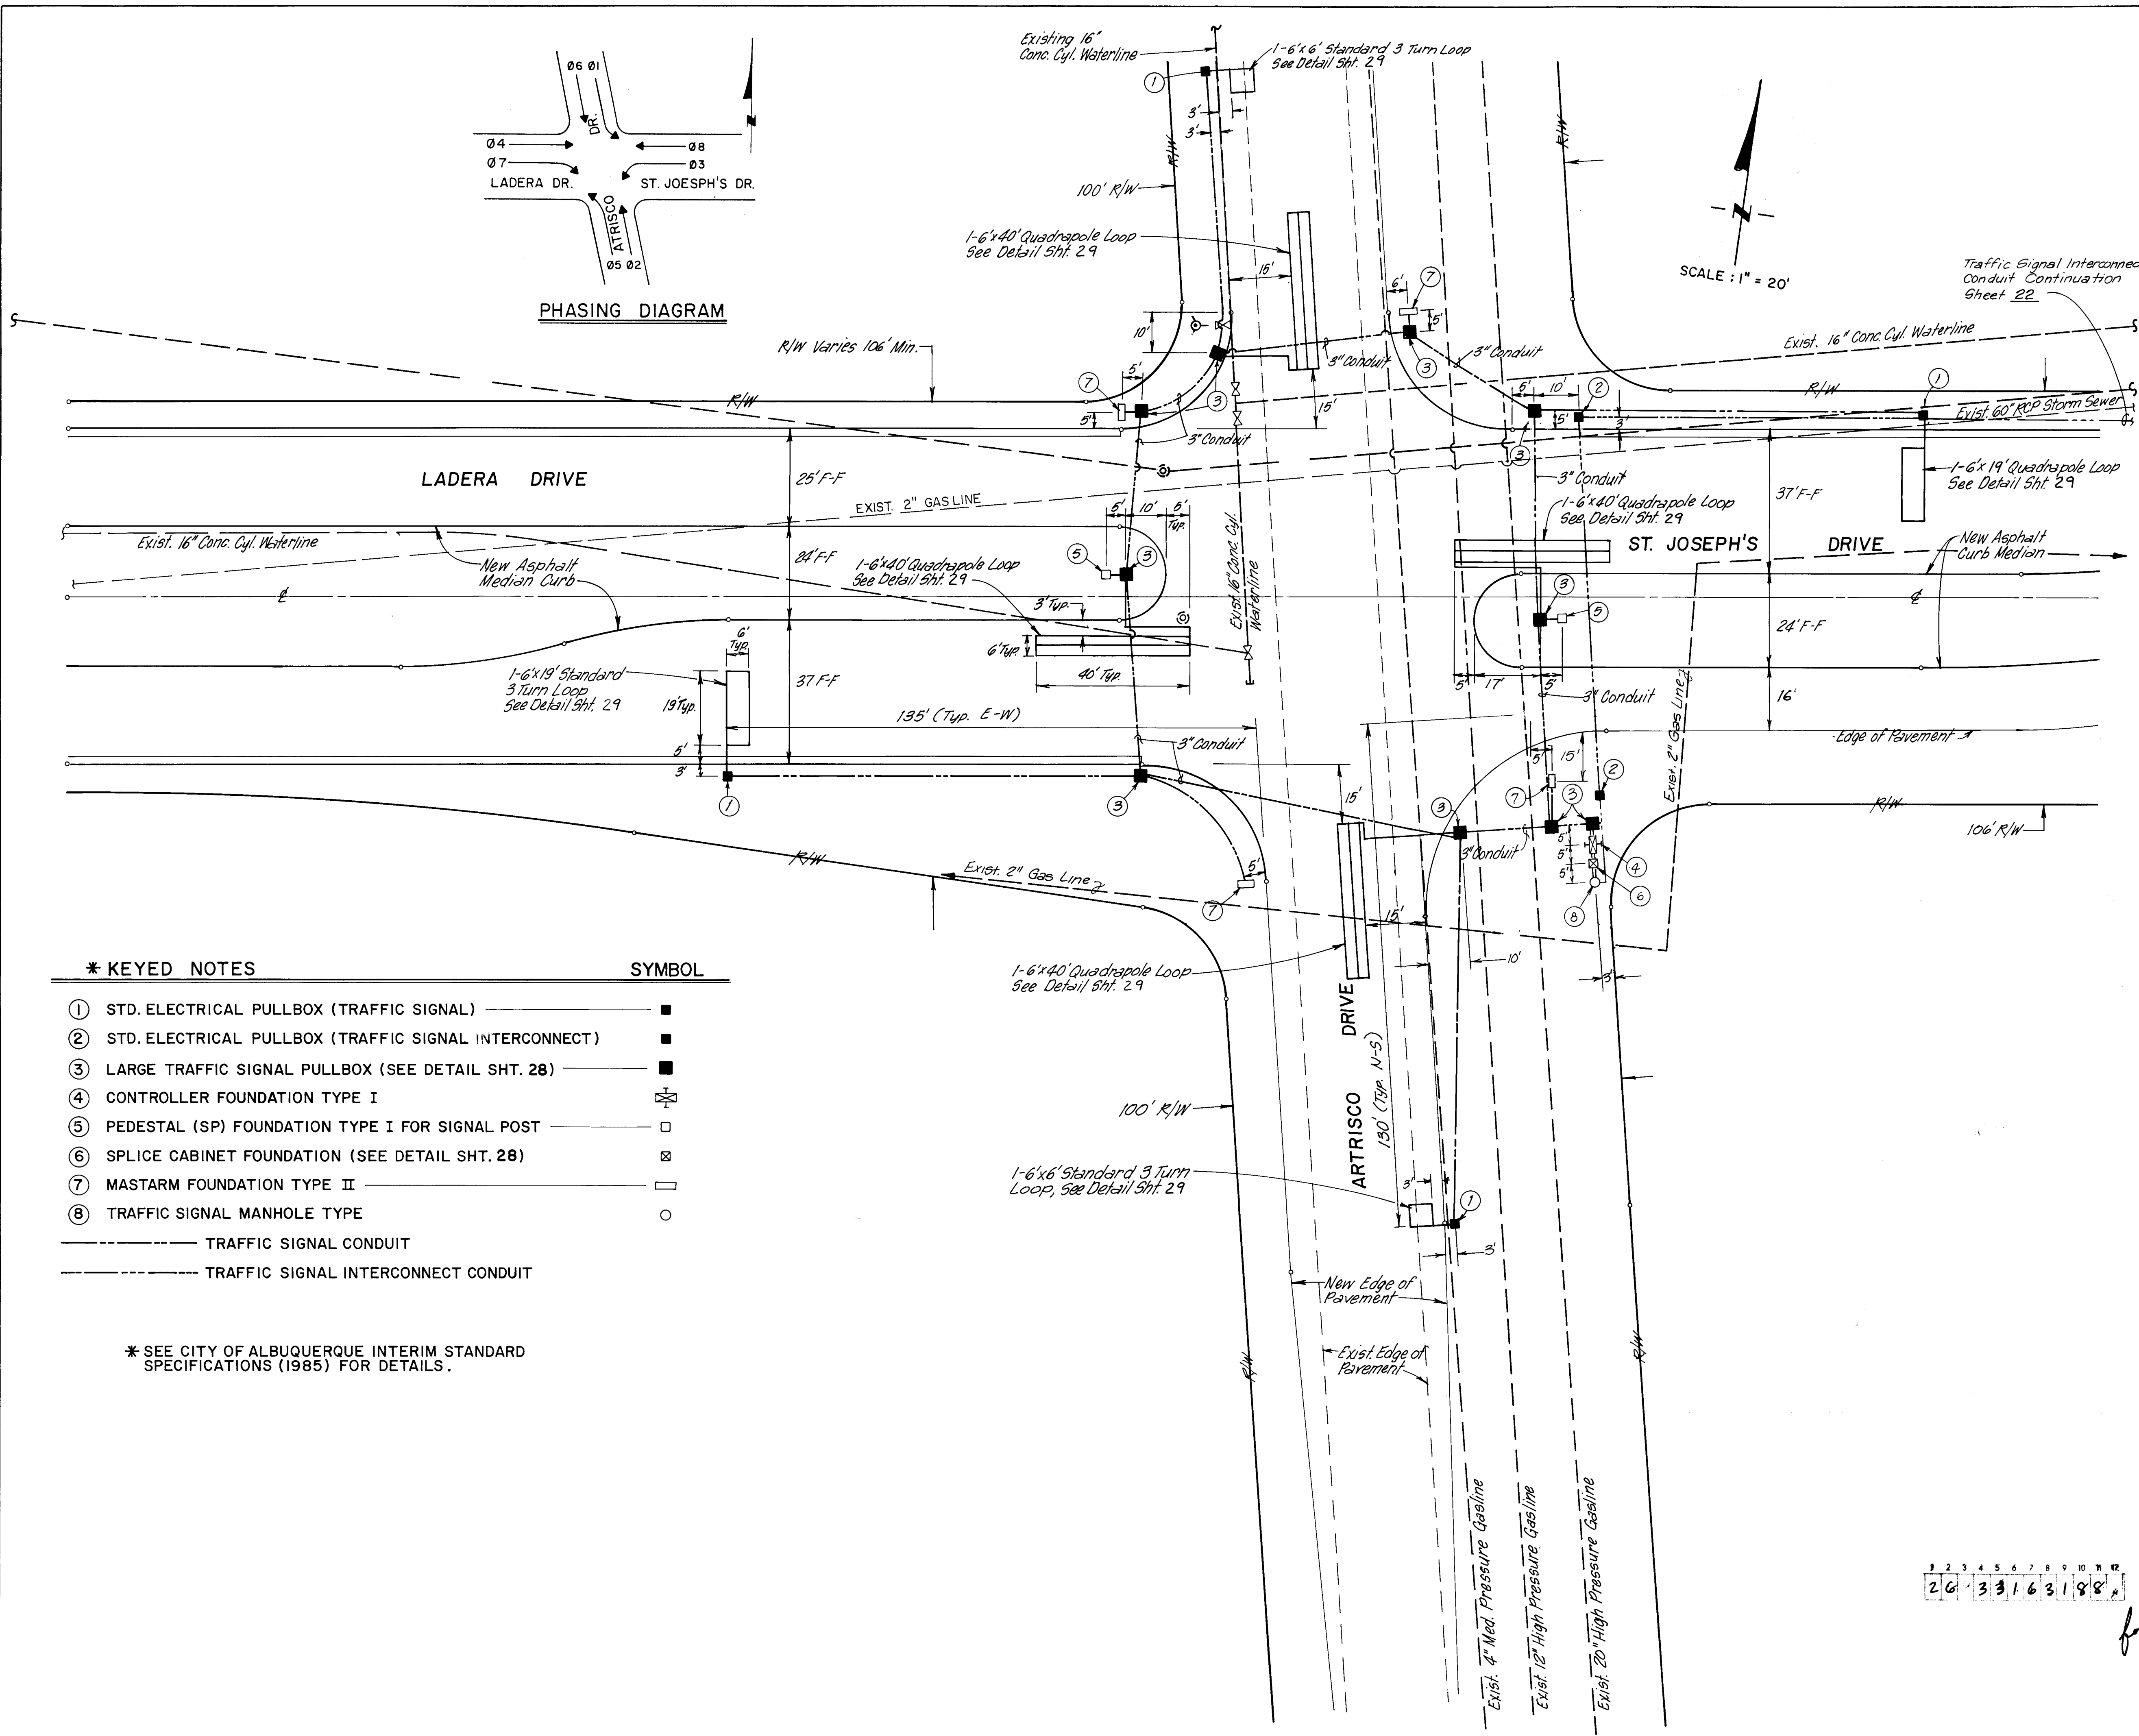

PHASING DIAGRAM

* KEYED NOTES

- | | | |
|---|---|---|
| ① | STD. ELECTRICAL PULLBOX (TRAFFIC SIGNAL) | ■ |
| ② | STD. ELECTRICAL PULLBOX (TRAFFIC SIGNAL INTERCONNECT) | ■ |
| ③ | LARGE TRAFFIC SIGNAL PULLBOX (SEE DETAIL SHT. 28) | ■ |
| ④ | CONTROLLER FOUNDATION TYPE I | ⊠ |
| ⑤ | PEDESTAL (SP) FOUNDATION TYPE I FOR SIGNAL POST | □ |
| ⑥ | SPLICE CABINET FOUNDATION (SEE DETAIL SHT. 28) | ⊠ |
| ⑦ | MASTARM FOUNDATION TYPE II | □ |
| ⑧ | TRAFFIC SIGNAL MANHOLE TYPE | ○ |

SYMBOL

- TRAFFIC SIGNAL CONDUIT
- TRAFFIC SIGNAL INTERCONNECT CONDUIT

* SEE CITY OF ALBUQUERQUE INTERIM STANDARD SPECIFICATIONS (1985) FOR DETAILS.

GENERAL NOTES

- ALL CONDUIT* TO BE PVC, HEAVY-DUTY, SCHEDULE 40.
- ALL CONDUIT CONNECTIONS TO BE MADE OF THE SOLVENT WELD TYPE ACCORDING TO THE RECOMMENDATIONS OF THE PVC CONDUIT MANUFACTURER.
- ALL CONDUIT TO BE RUN IN STRAIGHT-LINE FASHION FROM TERMINAL TO TERMINAL AS MUCH AS POSSIBLE. SOME MAY HAVE TO FOLLOW CURVATURE TO STAY WITHIN RIGHT-OF-WAY.
- ALL CONDUIT 2" IN DIAMETER, EXCEPT THAT MARKED 3".
- ALL CONDUIT RUNS TO BE CLEARLY LABELED AT END POINTS INSIDE PULL BOXES, MANHOLES, SIGNAL FOUNDATIONS, ETC. LABEL BOTH ENDS OF SAME CONDUIT RUN AS "AA," "BB," "CC," ETC.
- SEE SHEET 29 FOR LOOP DETECTOR CONDUIT DETAIL.
- LOOP DETECTOR WIRING NEEDS TO BE 14 STRANDED WIRE WITH SLIDING SLEEVE.
- USE 1-INCH GALVANIZED STEEL RISER FOR UTILITY POWER POLE WHICH PROVIDES ELECTRICAL SERVICE TO SIGNALS. TERMINATE IN STANDARD SIZE PULL BOX AT BASE OF POLE WITH UNDERGROUND CONDUIT.
- PROVIDE 2-INCH CONDUIT FOR ELECTRICAL SERVICE FROM PULL BOX AT BASE OF POWER POLE TO LARGE PULL BOX ON CLOSEST CORNER.
- CONTRACTOR TO CONTACT PUBLIC SERVICE COMPANY OF NEW MEXICO REPRESENTATIVE, DAVE WHITE, AT 505/761-3306 TO VERIFY SERVICE POLE CONNECTION.
- CONTRACTOR TO INSTALL UNDERGROUND TRAFFIC FACILITIES ONLY.
- CONTRACTOR TO INSTALL PULLWIRES IN ALL CONDUIT. PULLWIRES WILL BE INCIDENTAL TO THE CONTRACT.

* CONTRACTOR TO PROVIDE ALL NECESSARY HARDWARE




RECORD DRAWINGS
DATE 4/28/88


SIGNAL ABBREVIATIONS

- G = GREEN INDICATION
Y = YELLOW
R = RED
W = WALK
DW = DON'T WALK
PB = PUSH BUTTON

NOTE:
ANY EXCAVATION WORK IN THE AREA OF THE 12-INCH AND 20-INCH HIGH PRESSURE GAS LINES SHALL REQUIRE THE PRESENCE OF A GAS COMPANY OF NEW MEXICO REPRESENTATIVE. IT IS THE CONTRACTORS RESPONSIBILITY TO CONTACT GAS COMPANY OF NEW MEXICO REPRESENTATIVE AL MEYERS AT 889-8421, EMERGENCY NUMBER 345-6058.

CITY OF ALBUQUERQUE PUBLIC WORKS ENGINEERING			
TITLE: COORS WIDENING-LOTS 2 & 3 ST. JOSEPH'S/ATRISCO SIGNAL PLAN			
APPROVALS	ENGINEER	DATE	APPROVALS
City Engineer	8/26/87	8/26/87	Liquid Waste
A-C-E-Design	"	"	Traffic
A-C-E-Hydrology	N/A	8/26/87	Water
DRAWING NO. 33i6		MAP NO. G-11	SHEET 31 OF 38

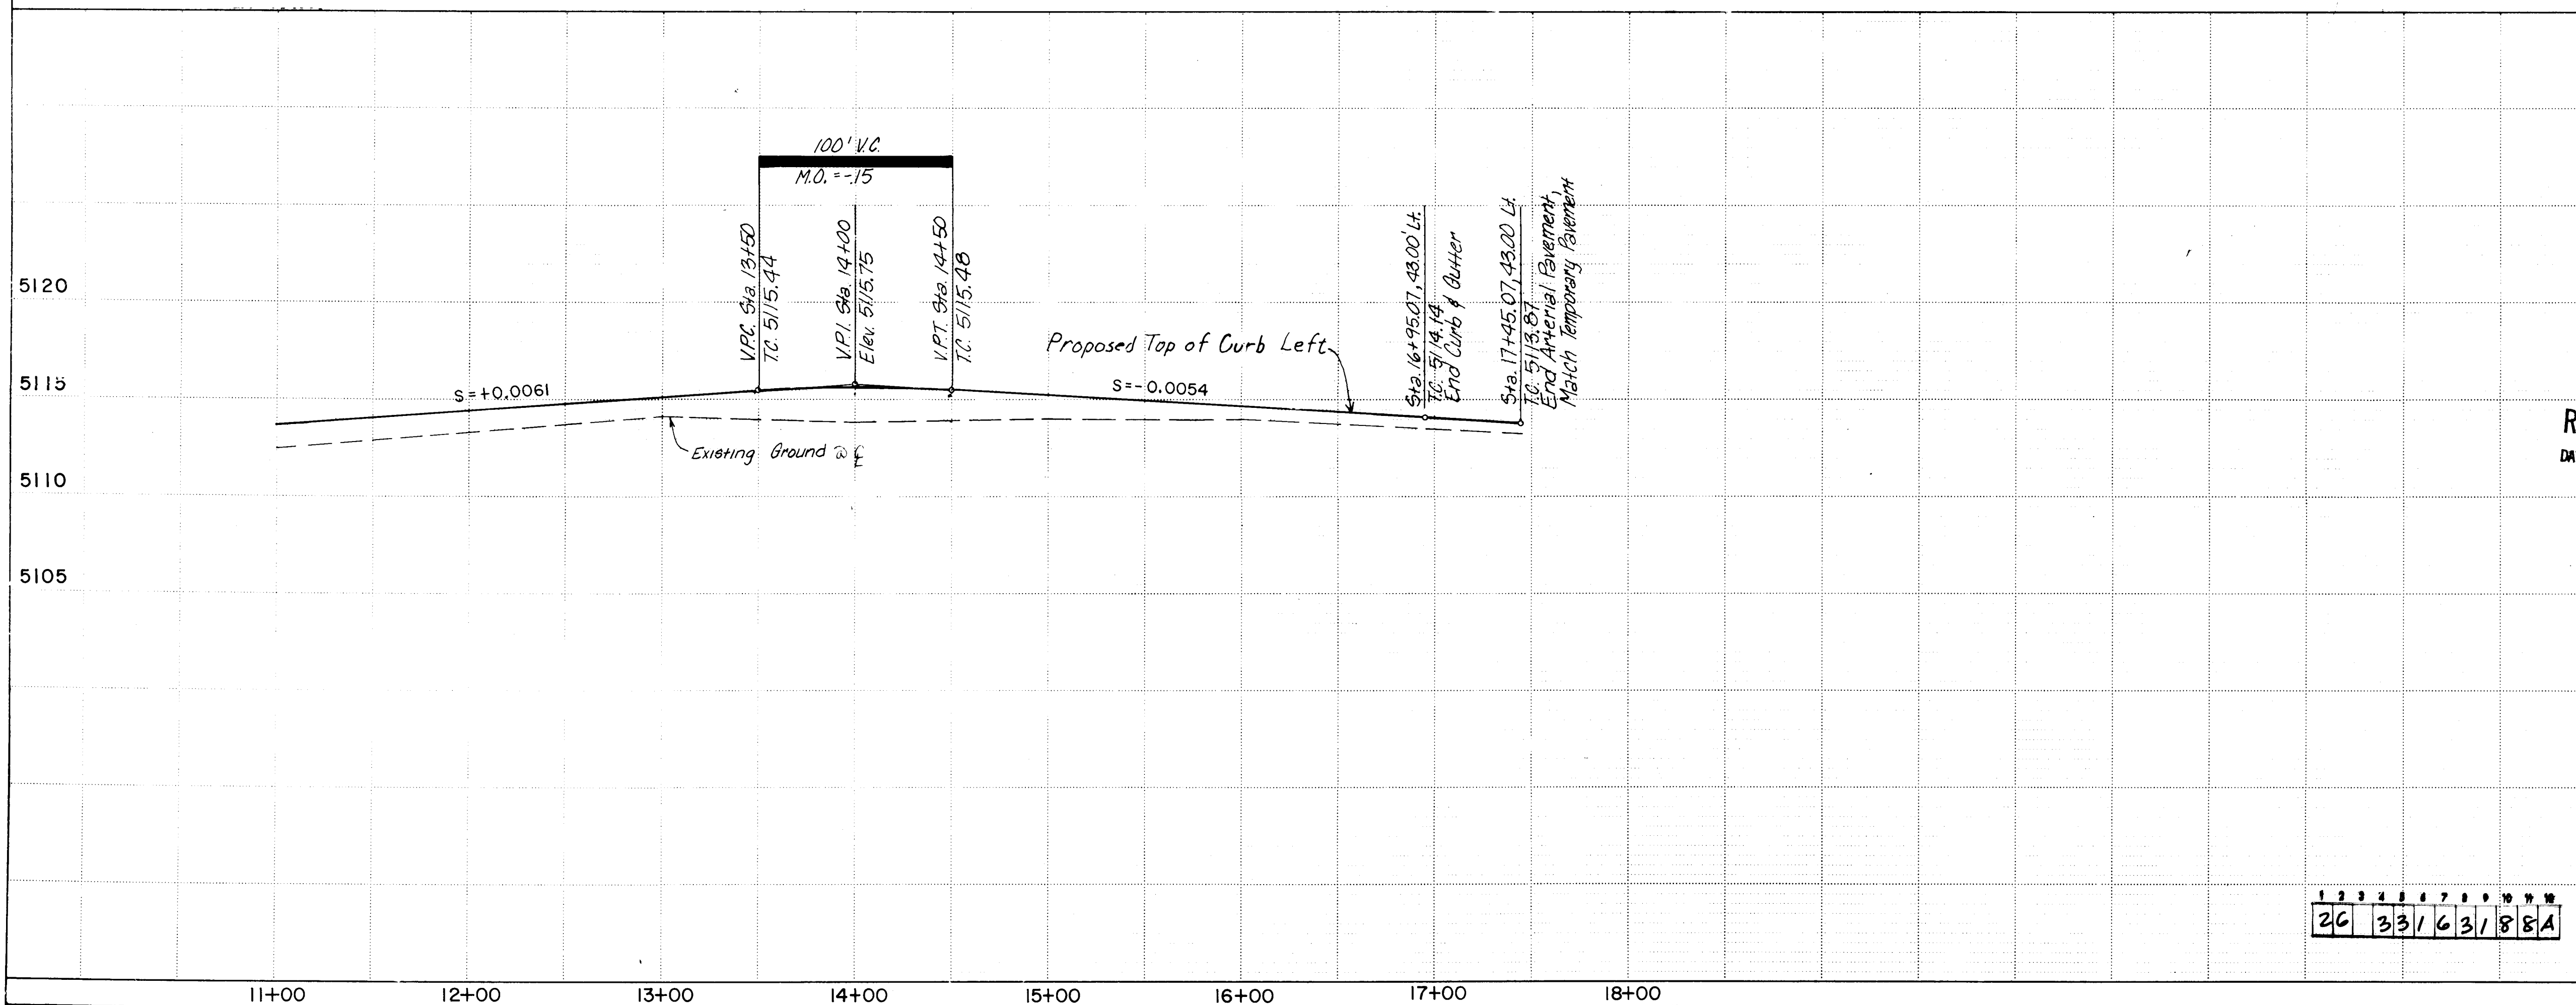

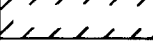- 1.)  NEW ARTERIAL PAVEMENT
SEE SHEET **B** FOR TYPICAL SECTION.
- 2.) THE CONTRACTOR WILL BE REQUIRED TO BUILD TWO NEW TRAFFIC SIGNAL FOUNDATIONS (TYPE I & TYPE II) AND STANDARD PULLBOXES. THESE ITEMS WILL BE PAID FOR USING THE UNIT PRICE IN THE BID PROPOSAL. ALL OTHER WORK REQUIRED TO RELOCATE THESE SIGNALS SUCH THAT THEY ARE OPERATIONAL AS BEFORE, SHALL BE PAID FOR IN BID ITEM No.1 IN THE BID PROPOSAL. 2" PVC CONDUIT BETWEEN NEW SIGNALS AND PULLBOXES.
- 3.) CURVES (18) AND (19) DEFINE EDGE OF PAVEMENT, CURVES (20) THRU (27) DEFINE FLOWLINE AT CURB.
- 4.) ALL MEDIANS AND ISLANDS TO HAVE 8" OF BACKFILL, 90% COMPACTION, INCIDENTAL TO CONTRACT

RECORD DRAWINGS
DATE 2/26/88




SCALE: HORIZ. 1" = 50'
VERT. 1" = 5'



APPROVALS	ENGINEER	DATE	APPROVALS	ENGINEER	DATE
City Engineer	<i>[Signature]</i>	8/26/87	Liquid Waste <i>NA</i>	<i>DEE</i>	8/14/87
ACE - Design	"	"	Traffic	<i>Daniel Williams</i>	8/15/87
ACE - Hydrology	<i>Steve Bolan</i>	8/26/87	Water <i>NA</i>	<i>DEE</i>	8/14/87


DRAWING NO.	3316	MAP NO.	G-11	SHEET	31A	OF	55
----------------	------	---------	------	-------	-----	----	----

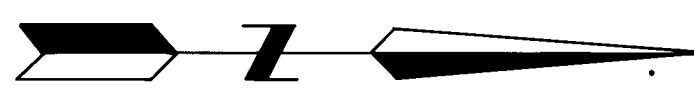


DATE 4/28/88

1	2	3	4	5	6	7	8	9	10	11	12
2	6		3	1	6	3	2	8	8		

APPROVALS	ENGINEER	DATE	APPROVALS	ENGINEER	DATE
City Engineer	<i>[Signature]</i>	8/24/87	Liquid Waste	JEE	8/14/87
A.C.E - Design	" "	"	Traffic	NAD, H	8/15/87
A.C.E - Hydrology	W.A. SAB	8/26/87	Water	JEE	8/14/87

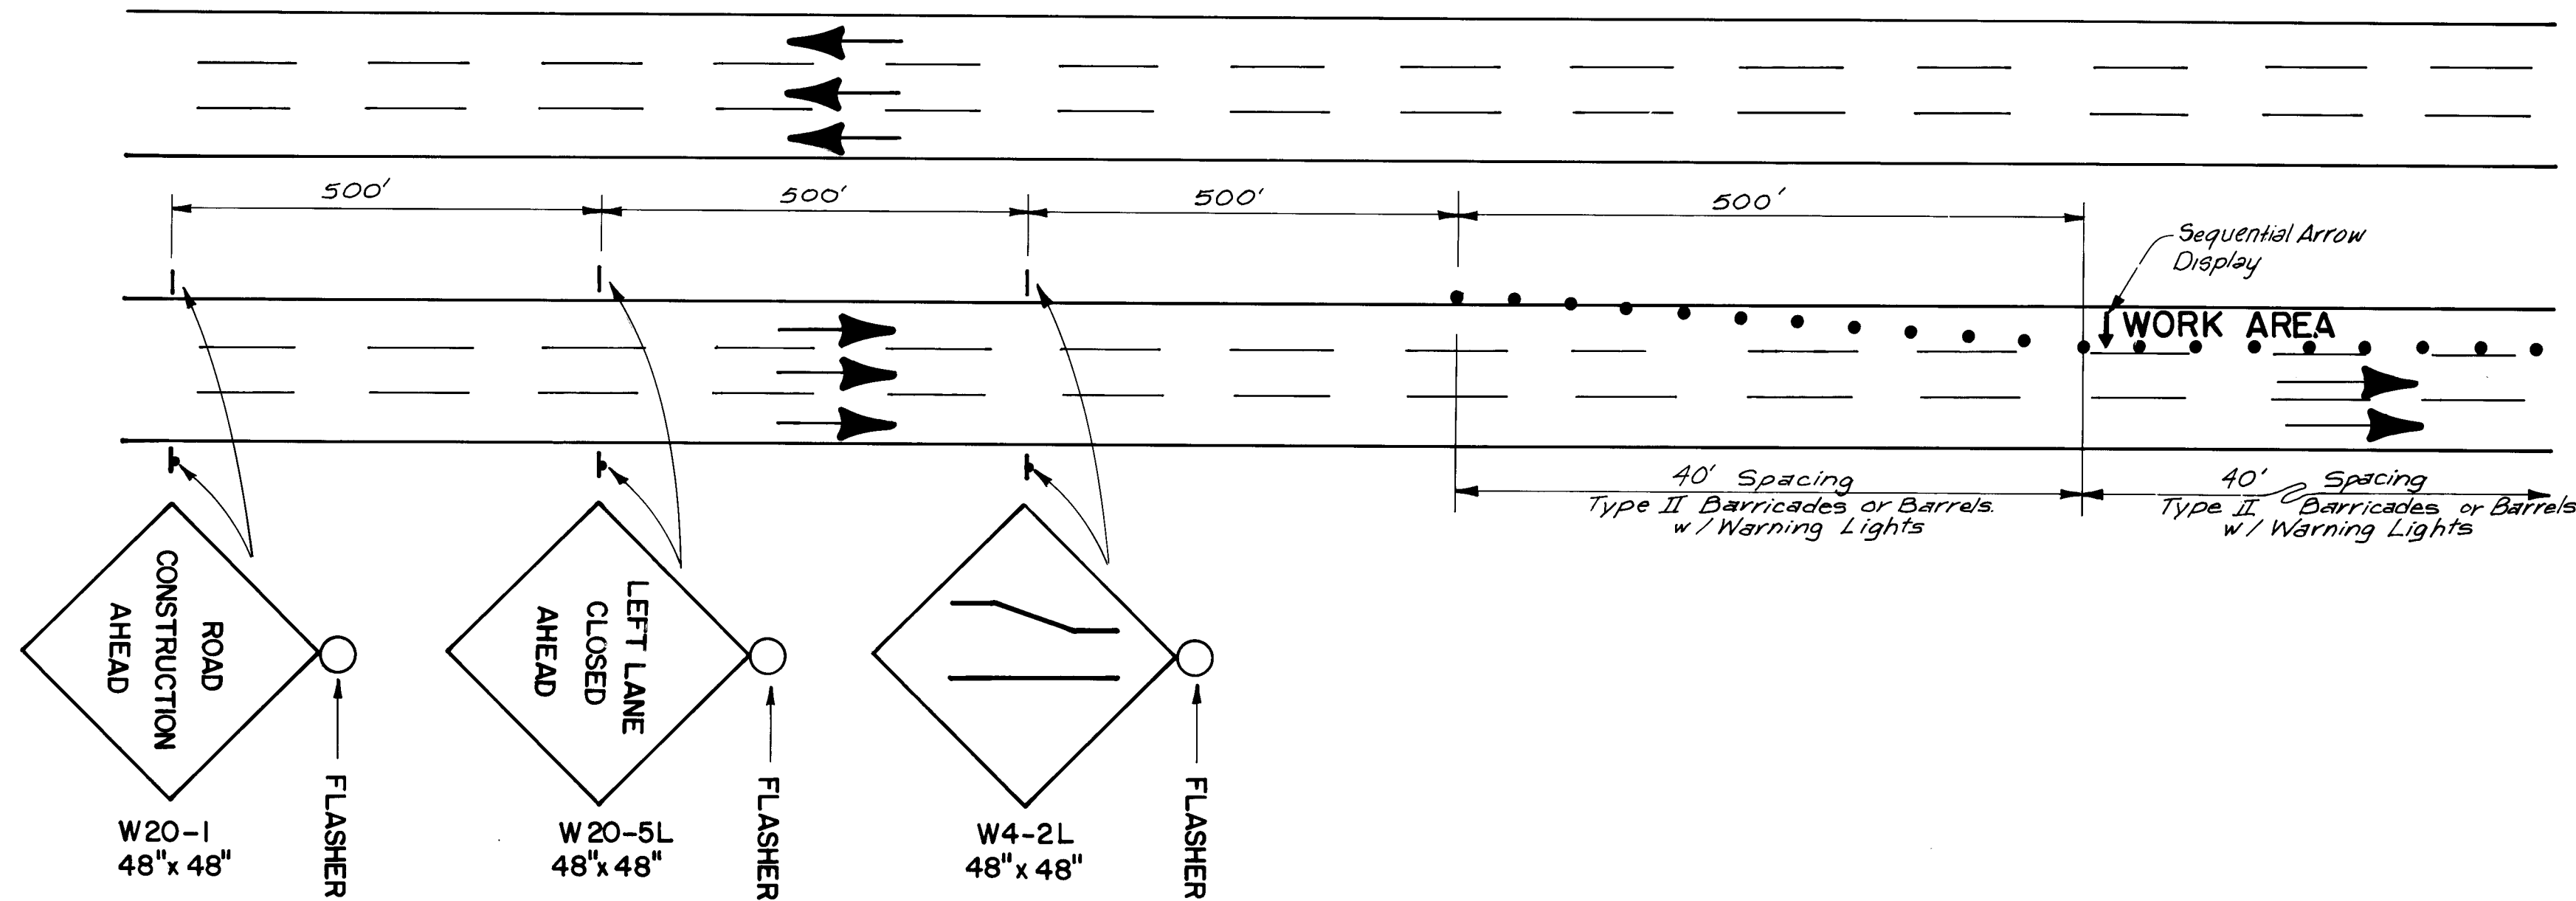

TYPICAL LEFT LANE CLOSURE
NO SCALE

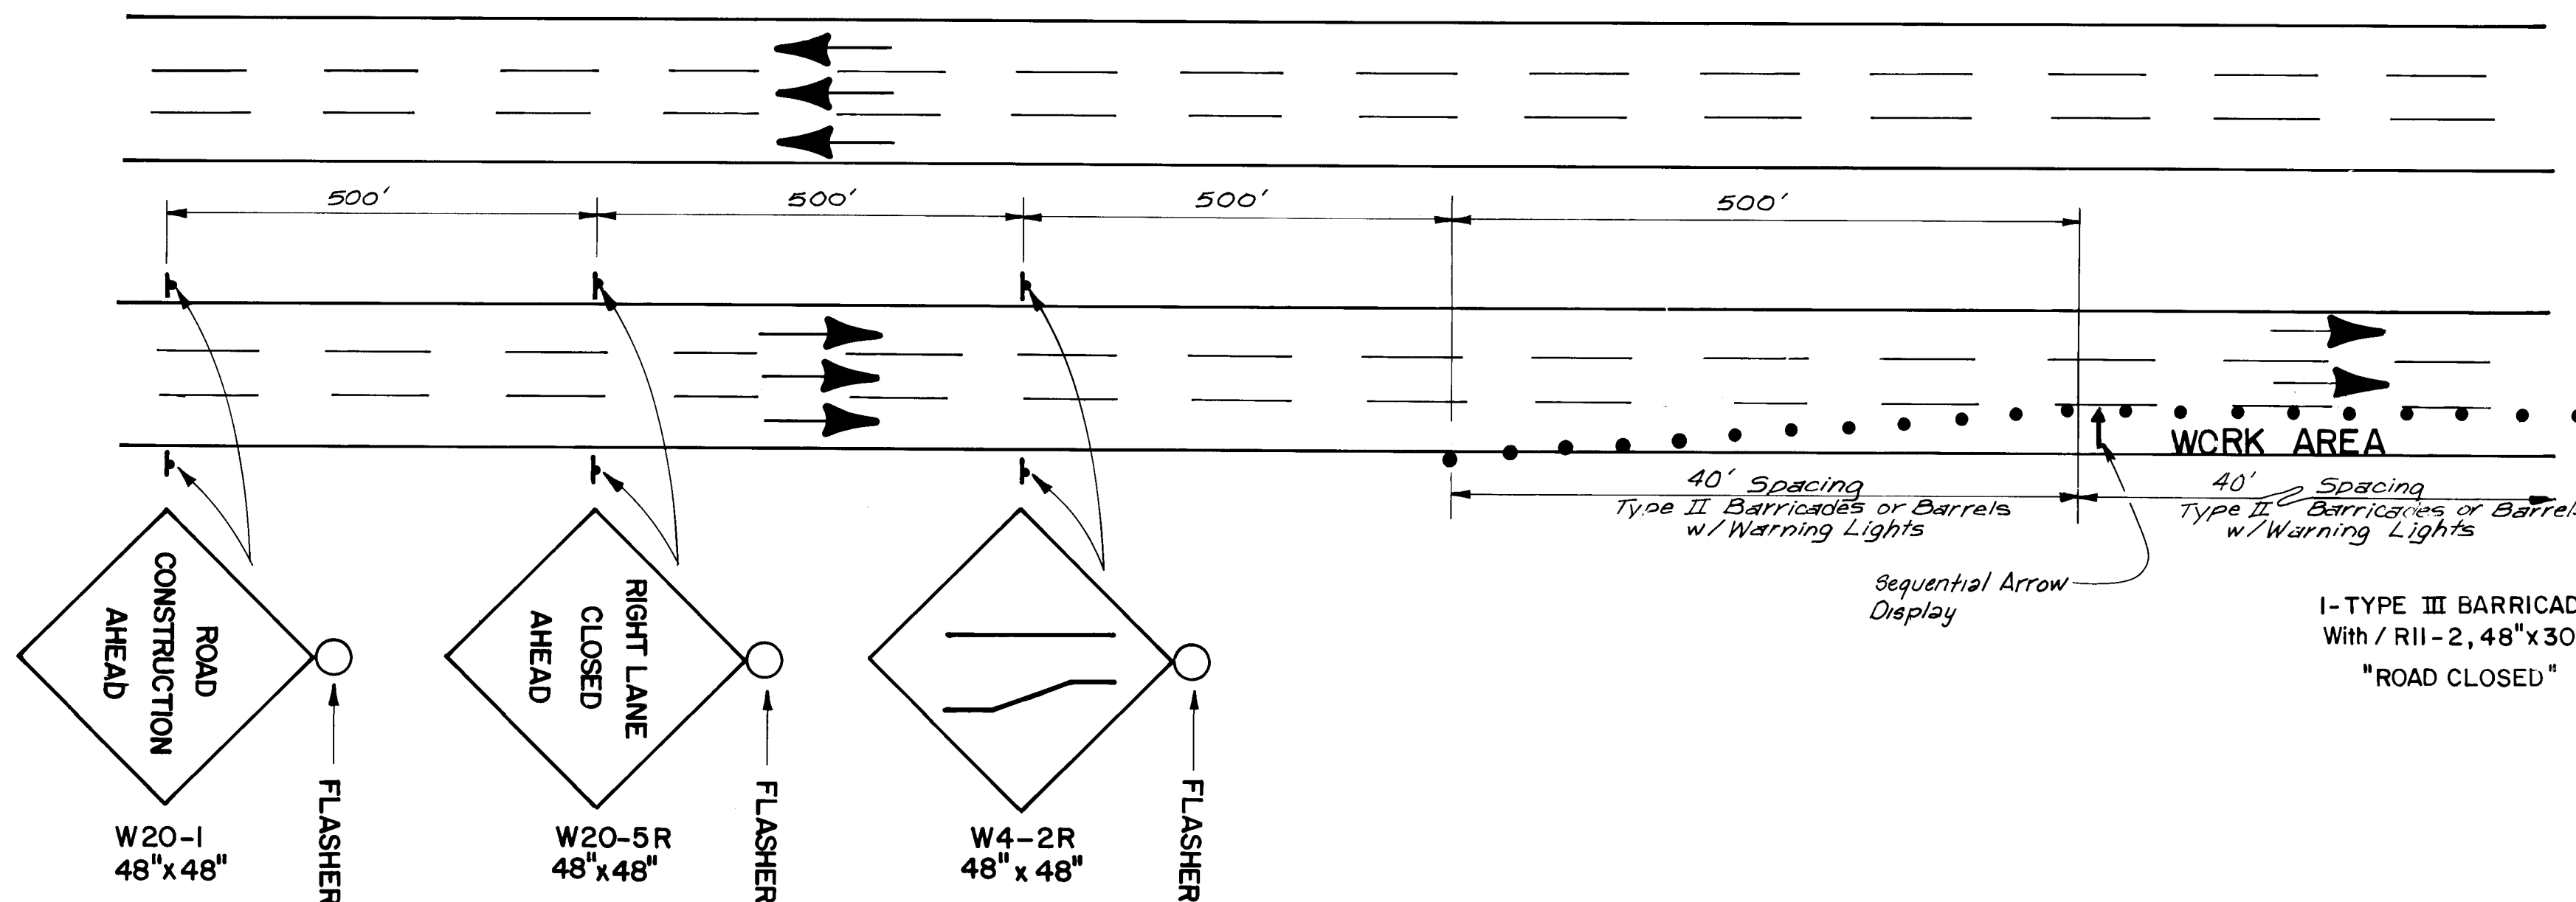

TYPICAL RIGHT LANE CLOSURE
NO SCALE

GENERAL NOTES

1. All traffic control devices shall comply with Chapter VI of the 1978 edition "New Mexico Manual for Uniform Traffic Control Devices."
2. The Contractor shall prepare and submit to the Project Engineer a detailed traffic control plan, which must be approved by the City Traffic Engineer three working days in advance of any required lane closures other than those shown in these plans.
3. All signs must be installed before construction begins as directed by the Engineer. Sign heights shall be 7 feet above the sidewalk level to the bottom of the sign.
4. All signs, barricades and/or drums will be reflectorized. All drums may have sand or water ballast limited to 100 lbs.
5. All sign locations will be selected in the field and approved by the Project Engineer. Distances may be adjusted for local conditions.
6. All applicable signs will be moved forward as the construction progresses.
7. The Contractor shall maintain access to adjacent properties during construction.
8. When barriers are required after dark, all advance warning signs and all barricades shall be equipped with flashing warning lights (Type A), except that all channelizing barricades shall have steady burning warning lights (Type C). Lights will be considered incidental to the barricades and warning signs.
9. All existing permanent signs that need to be removed, relocated or reinstalled shall be done by the City of Albuquerque Traffic Engineering Division. The Contractor shall notify the Traffic Engineering Division three working days in advance of any required work.
10. The Contractor shall provide and maintain a safe and adequate means of channeling pedestrian traffic around all work areas throughout the period of construction. All such channelization shall be arranged to prevent pedestrians from having to enter the roadway in order to pass around the work areas.
11. All construction signing shall be black on a reflectorized orange field unless otherwise specified. All construction barricades and channelization devices shall be orange on white, reflectorized, unless otherwise specified.
12. All advance warning signs not directly applicable shall be removed, covered, or turned away from oncoming traffic.
13. Barricades and barrels shall not be intermixed in the same series of channelization.
14. Portable sign supports must satisfy mounting height requirements (see Note 3). Portable sign supports will be allowed only for installations lasting seven days or less.
15. No measurement or payment will be made for moving traffic control devices for detours from one location to another, for maintenance, or for repair or replacement if any item is damaged or destroyed for any reason. Temporary striping shall be removable adhesive marking tape 4" wide 10' stripe - 30' gap. A plan for temporary striping, including colors, must be approved by the Traffic Engineer. Permanent striping will be the responsibility of the City and must be completed before any segment of the project is opened to traffic. The Contractor shall coordinate with the City Traffic Engineer as to when each segment will be completed.
16. Three lanes must be open to traffic in each direction on Coors from 5:30 a.m. to 9:00 a.m. and from 3:00 p.m. to 7:00 p.m. on weekdays.
17. Two lanes must be open to traffic in each direction on Coors at all other times.

CONSTRUCTION PHASING


For construction phasing see sheet 32.

NOTE:

TRAFFIC CONTROL EQUIPMENT QUANTITIES ON SHEETS 34-37 ARE ESTIMATED.

LEGEND FOR CONSTRUCTION SIGNING SHEETS:

———— New Construction
----- Existing

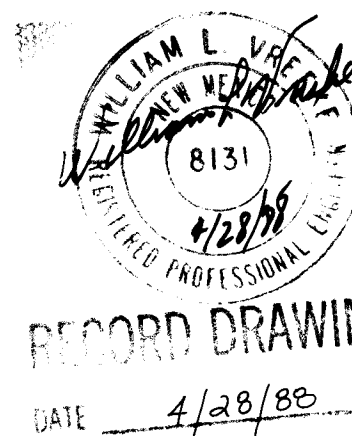


RECORD DRAWINGS
DATE 4/28/88

26 33163388

CITY OF ALBUQUERQUE		PUBLIC WORKS ENGINEERING	
TITLE: COORS WIDENING—LOT 2 & 3 CONSTRUCTION SIGNING GENERAL NOTES			
APPROVALS	ENGINEER	DATE	APPROVALS
City Engineer	ACE	8/26/87	Liquid Waste
ACE - Design	"	"	Traffic
ACE - Hydrology	NA SAB	8/26/87	Water
DRAWING NO. 3316		MAP NO. H-11	SHEET OF 33 38


AS-BUILT INFORMATION		BENCH MARKS		SURVEY INFORMATION		ENGINEER'S SEAL	
CONTRACTOR SURVEY MECHANICAL	WORK STAKED BY BHI	DATE 5/88	INSPECTOR'S POST VERIFICATION BY BHI	DATE 4/88	DATE 4/88	DATE 4/88	DATE 4/88
STANDARD N.M.S.H.C. BRASS TABLET SET FLUSH IN TOP OF CONCRETE POST LOCATED IN THE SOUTH WEST EDGE OF "WEST MESA BOWL" BOWLING ALLEY PARKING LOT.		DATE		DATE		DATE	
RECORDED BY		NO		RECORDED BY		NO	

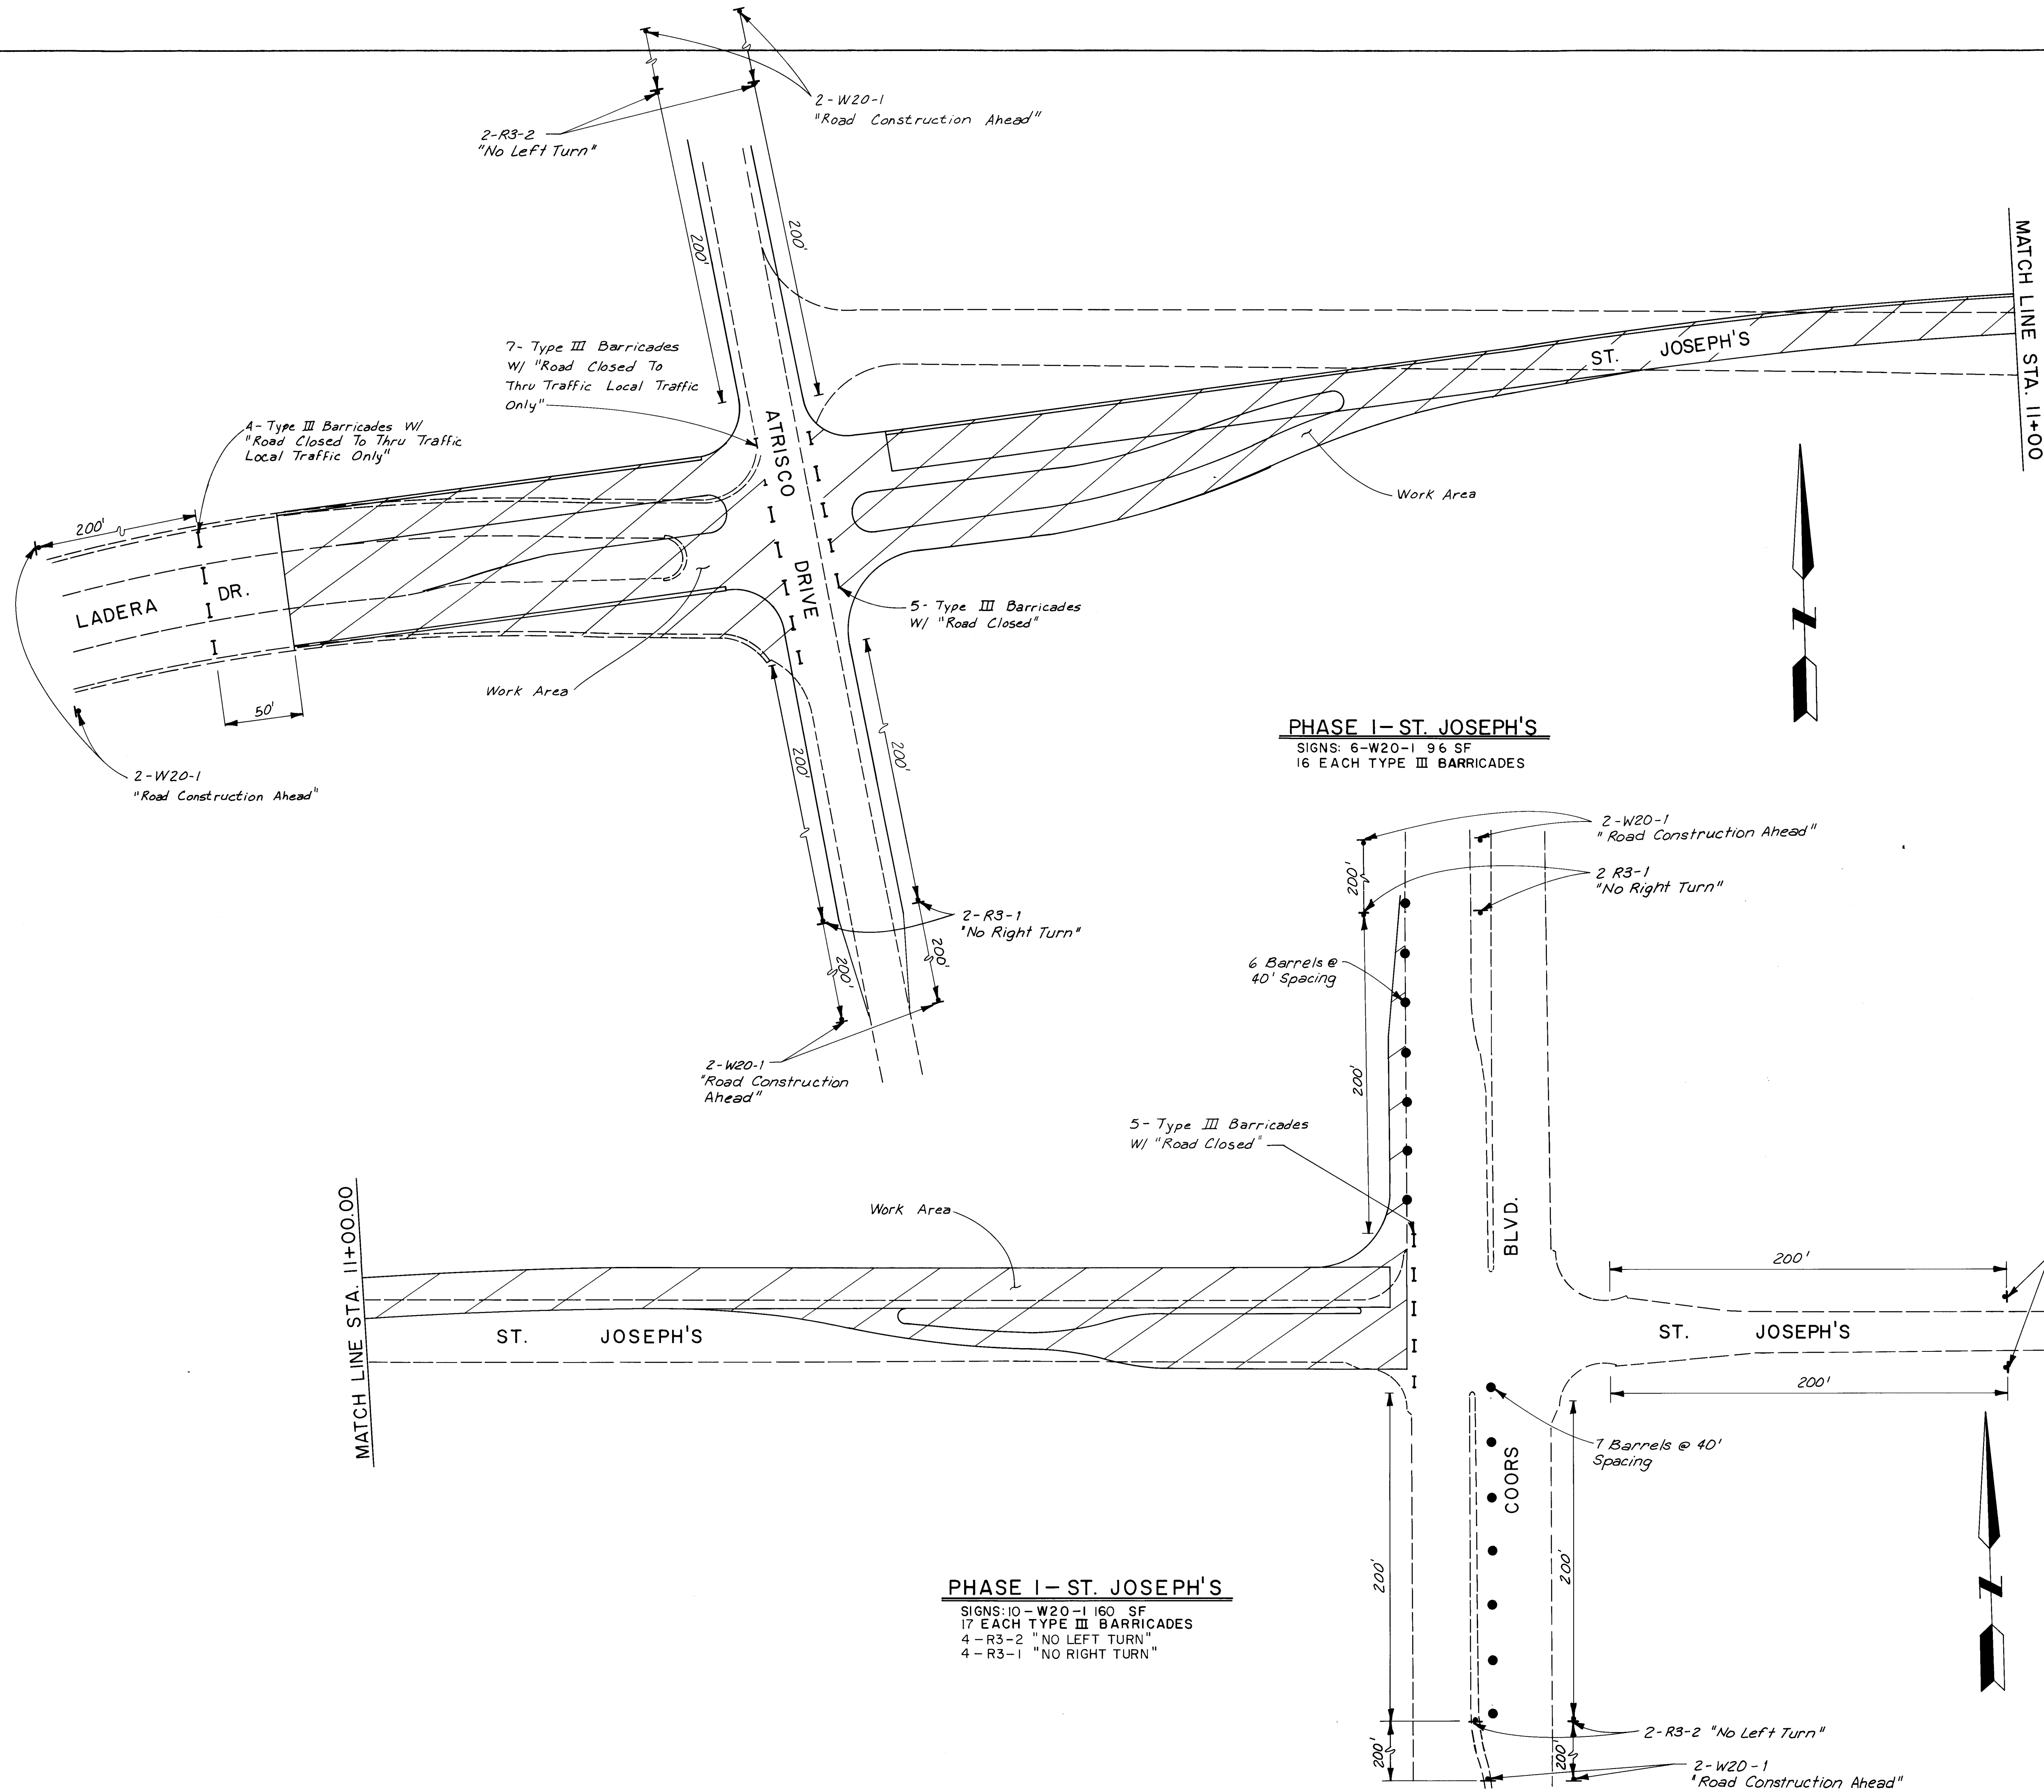

Notes:

1. Contractor must maintain two 12' Lanes on Ladera at all times during construction.
2. Contractor will use typical right lane closures shown on sheet when sawcutting on Atrisco and on Coors.
3. Lane closures on Coors Blvd. allowed from 9:00 am to 3:00 p.m. Only.
4. See Sheet 32 for St. Joseph's detour signing at Western Trail and Coors Blvd.

AS-BUILT INFORMATION				BENCH MARKS				SURVEY INFORMATION				ENGINEER'S SEAL				REVISIONS			
CONTRACTOR	DATE	NO.	BY	CONTRACTOR	DATE	NO.	BY	FIELD	DATE	NO.	BY	DESIGNED	DATE	DRAWN	DATE	DESIGNED	DATE	DRAWN	DATE
SWANSON MECHANICAL																			
WORK STAKED BY	BHI																		
INSPECTION ACCEPTANCE BY	C&P																		
FIELD VERIFICATION BY	BHI																		
DRAWINGS CORRECTED BY	BHI																		
MICRO-FILM INFORMATION																			
RECORDED BY																			
NO.																			

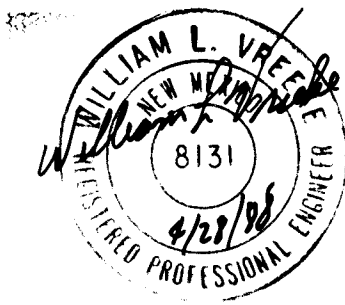


RECORD DRAWINGS

DATE 4/28/88

1	2	3	4	5	6	7	8	9	10	11	12
2	6	3	1	6	3	4	8	8			

CITY OF ALBUQUERQUE PUBLIC WORKS ENGINEERING			
TITLE: COORS WIDENING—LOTS 2 & 3 CONSTRUCTION SIGNING			
APPROVALS	ENGINEER	DATE	APPROVALS
City Engineer	<i>[Signature]</i>	8/24/87	Liquid Waste
A.C.E. - Design	" "	" "	Traffic
A.C.E. - Hydrology	N/A SAB	8/24/87	Water
DRAWING NO. 3316		MAP NO. H-11	SHEET 34 OF 38

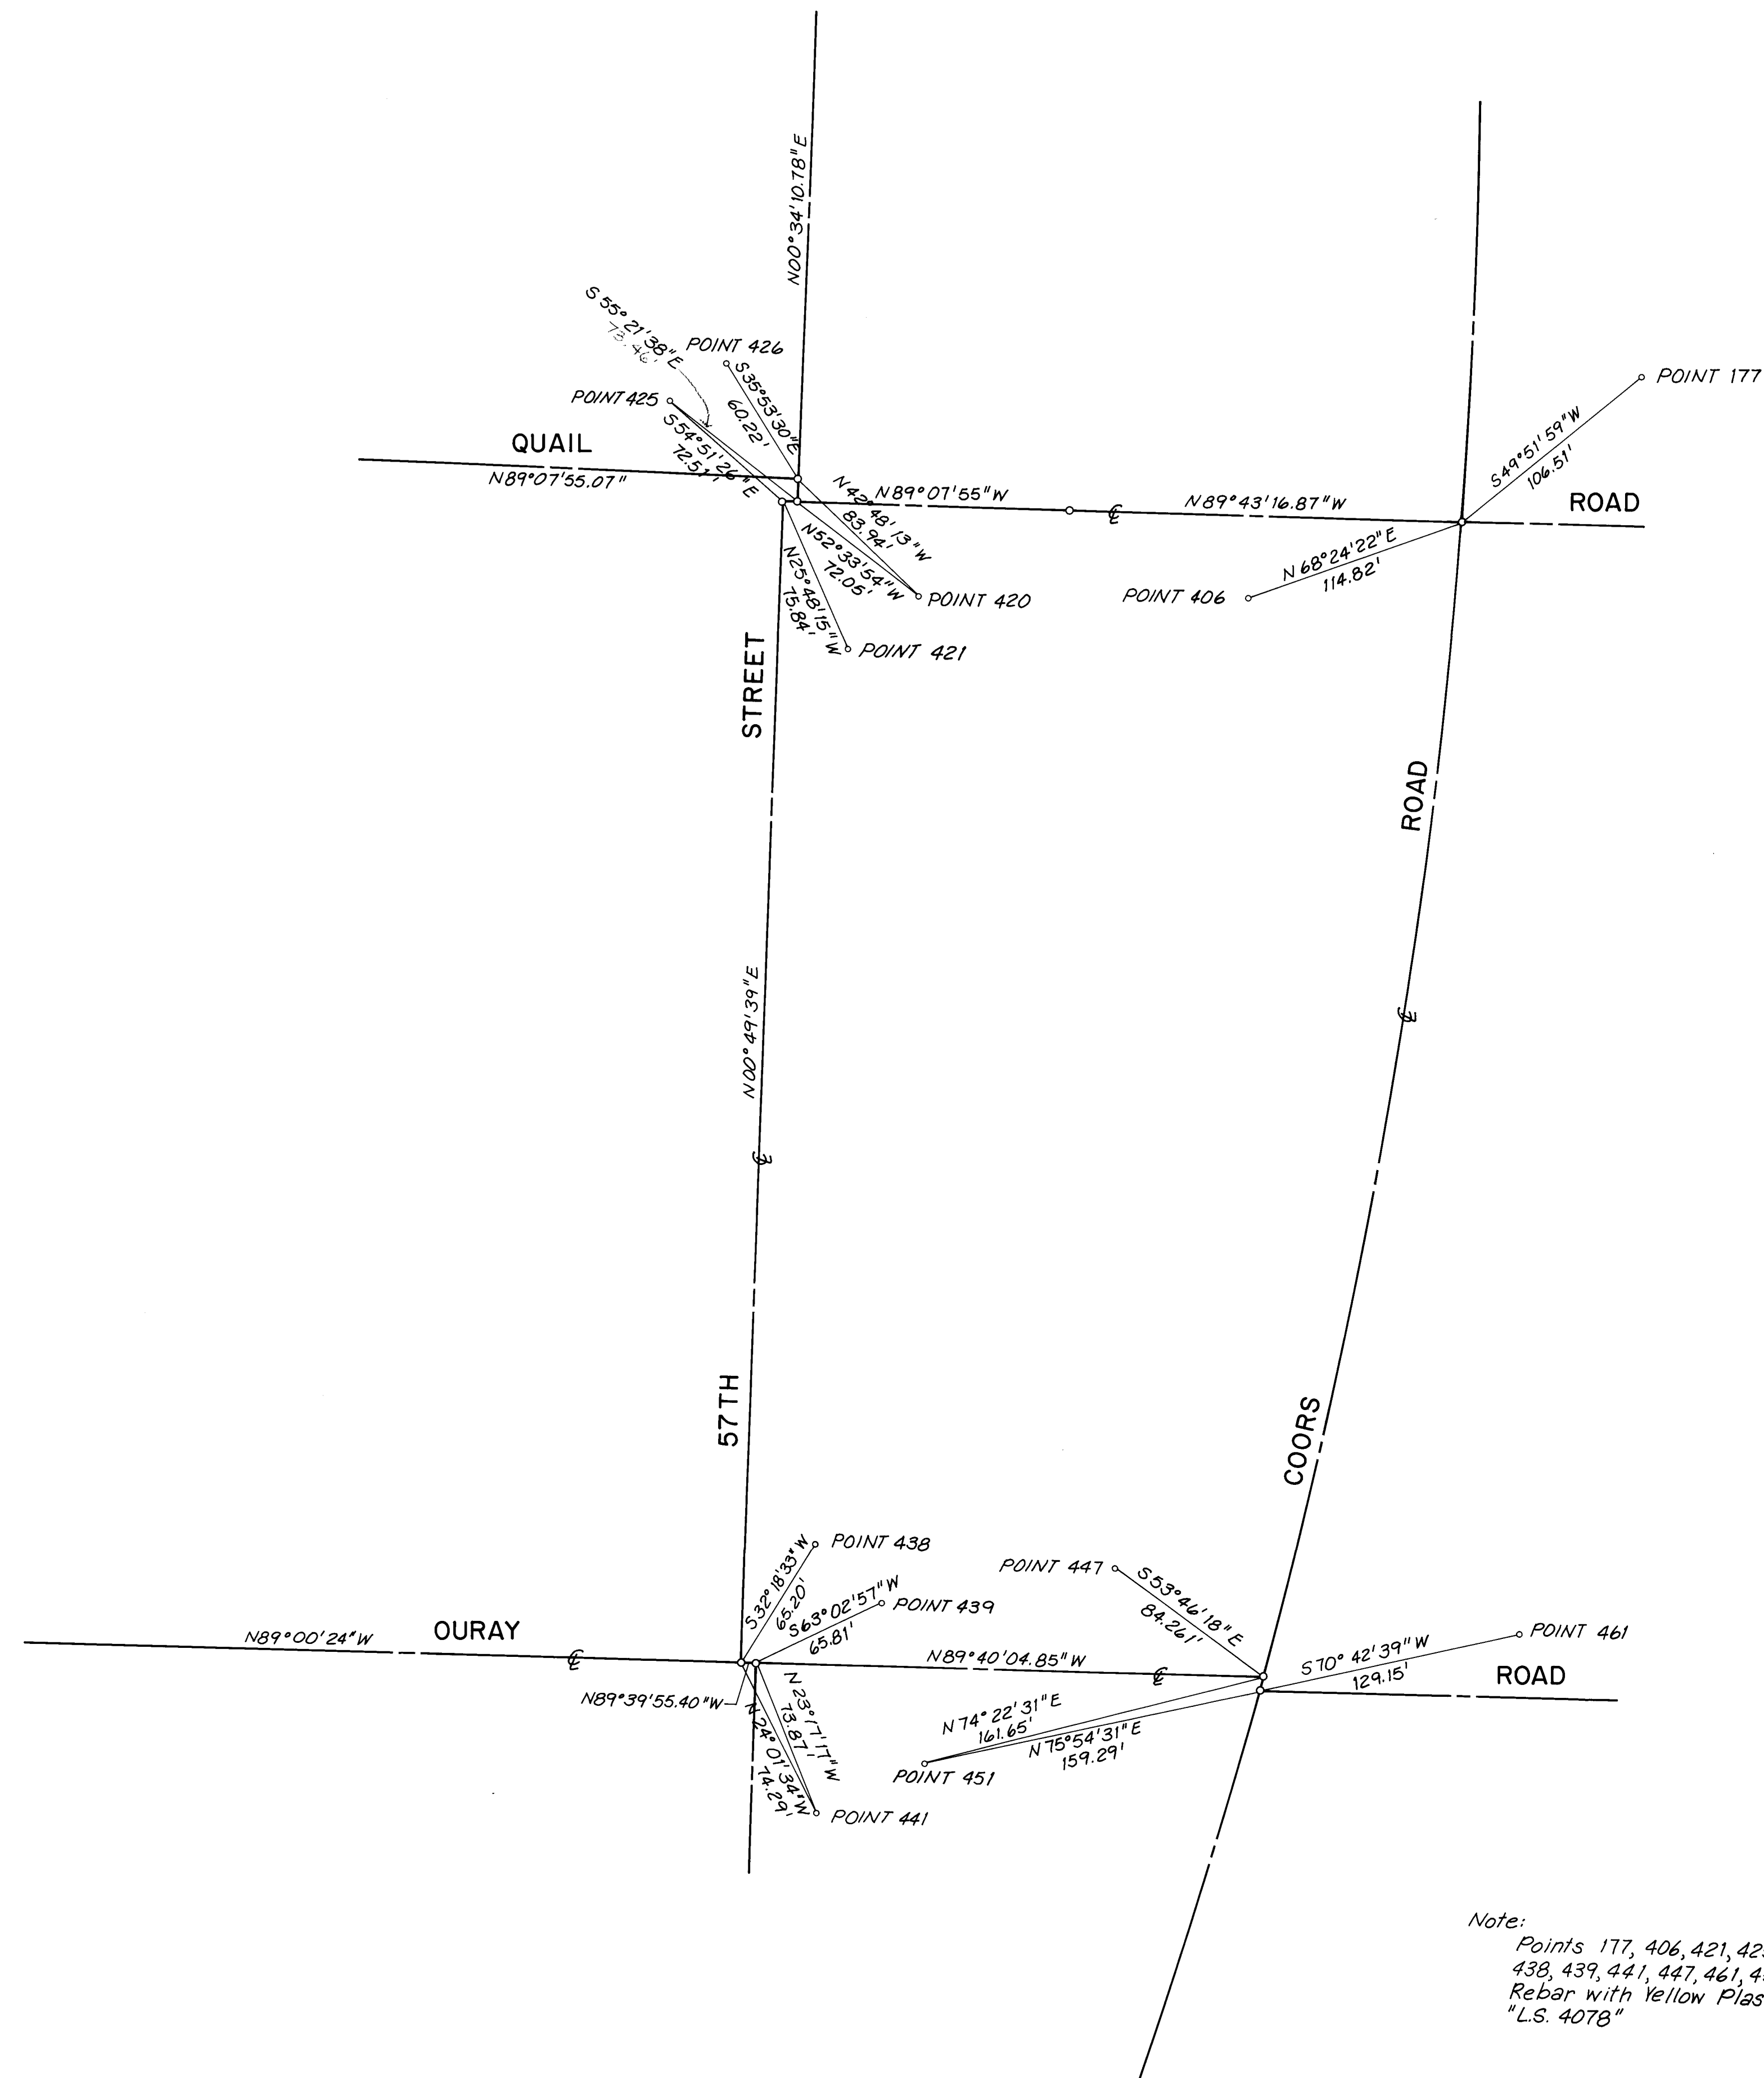

No Scale

[illegible]

		CITY OF ALBUQUERQUE PUBLIC WORKS ENGINEERING					
TITLE: COORS WIDENING - LOTS 2 & 3 HORIZONTAL TIES							
APPROVALS	ENGINEER	DATE	APPROVALS	ENGINEER	DATE		
City Engineer	<i>[Signature]</i>	8/14/87	Liquid Waste	<i>NA</i>	<i>LEE</i>	8/14/87	
A C E - Design	" "	" "	Traffic		<i>NA</i> DWH	8/15/87	
A C E - Hydrology	<i>NA</i> SAB	8/24/87	Water	<i>NA</i>	<i>LEE</i>	8/14/87	
DRAWING NO.		MAP NO.		SHEET		OF	
3316		H-11		38		38	