


CITY OF ALBUQUERQUE

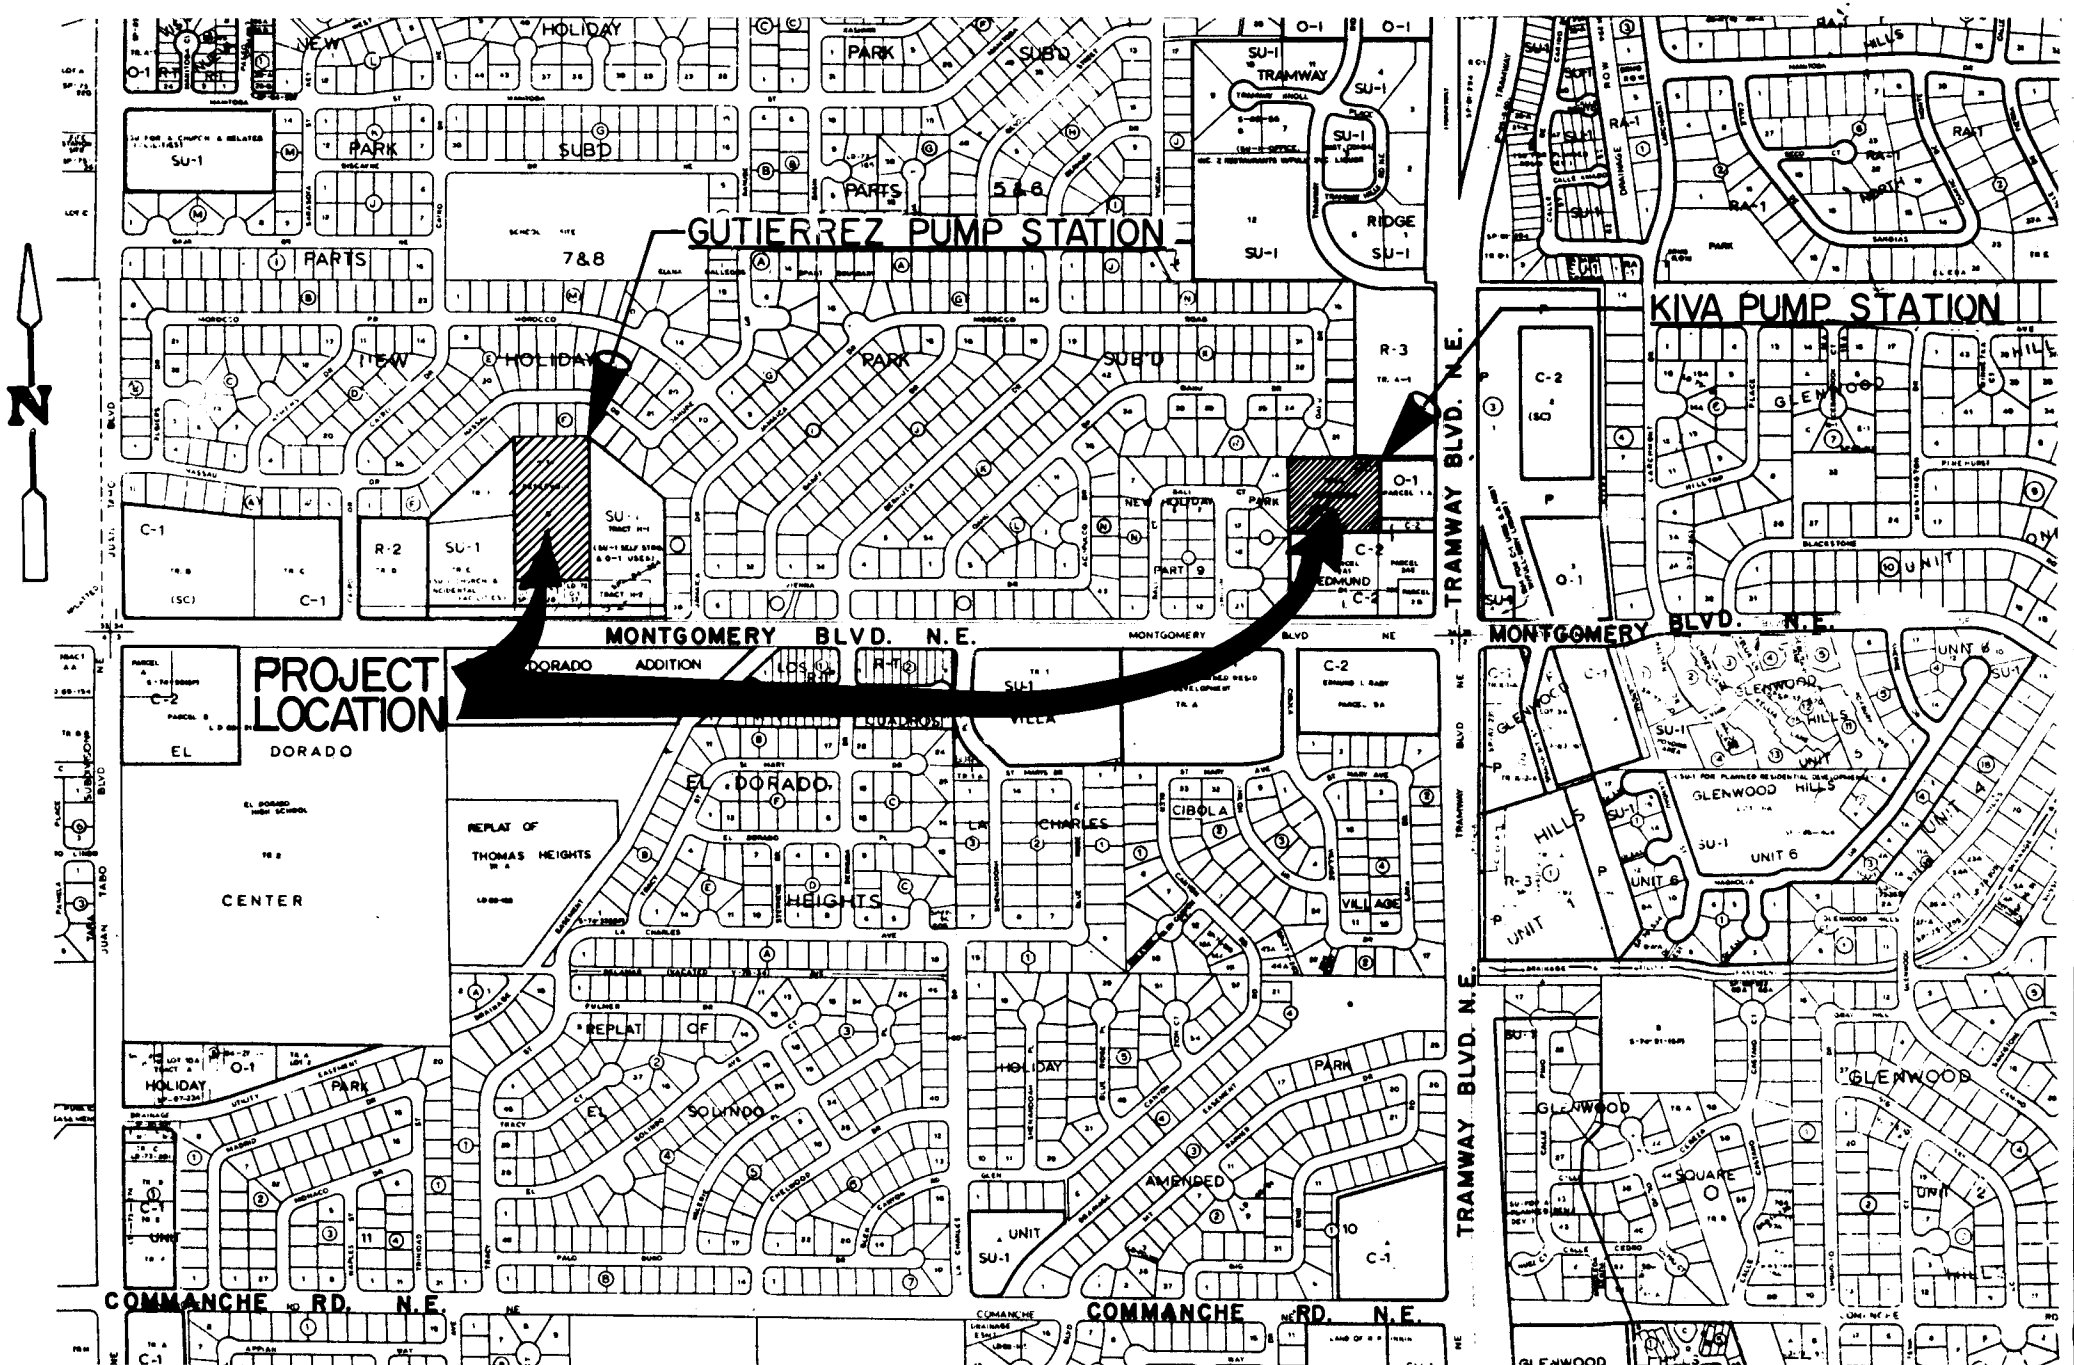

PROJECT LOCATION MAP
SCALE: 1" = 800' ±
ZONE ATLAS: F-22

GUTIERREZ PUMP STATION RECONSTRUCTION AND KIVA LANDSCAPE IMPROVEMENTS

INDEX OF SHEETS

TITLE

SHEET NO.

1 OF 15	COVER
2 OF 15	LEGEND
3 OF 15	INITIAL AND FINAL DEMOLITION PLAN
4 OF 15	SITE LAYOUT AND GRADING
5 OF 15	YARD PIPING
6 OF 15	BUILDING ELEVATIONS
7 OF 15	FOUNDATION PLAN
8 OF 15	FOUNDATION AND PIT DETAILS
9 OF 15	FLOOR AND PIPING PLAN
10 OF 15	PIPING SECTIONS
11 OF 15	WALL SECTIONS
12 OF 15	ROOF FRAMING AND DRAINAGE PLAN
13 OF 15	MISCELLANEOUS STRUCTURAL DETAILS
14 OF 15	MISCELLANEOUS PIPING DETAILS
15 OF 15	PIPE CRADLE, RESTRAINT AND STRAP DETAILS

UTILITIES

U-1 OF U-2	4" SANITARY SEWER PLAN AND PROFILE
U-2 OF U-2	WATER SHUT-OFF PLAN

MECHANICAL

M1 OF 3	MECHANICAL FLOOR PLAN
M2 OF 3	MECHANICAL DETAILS
M3 OF 3	MECHANICAL SCHEDULE AND DETAILS

ELECTRICAL

E-1	ELECTRICAL LEGEND
E-2	ELECTRICAL SITE PLAN
E-3	ELECTRICAL ONE-LINE DIAGRAM
E-4	LIGHTING/RECEPTACLE PLAN
E-5	MECHANICAL SYSTEMS ELECTRICAL PLAN
E-6	WATER SYSTEMS ELECTRICAL PLAN
E-7	GROUNDING/LIGHTNING PROTECTION SYSTEM PLAN
E-8	SCHEDULES
E-9	CONTROL SCHEMATICS
E-10	CONTROL SCHEMATICS
E-11	CONTROL SCHEMATICS
E-12	INTERCONNECTION DIAGRAMS - PUMP NO. 1
E-13	INTERCONNECTION DIAGRAMS - PUMP NO. 2
E-14	INTERCONNECTION DIAGRAMS - PUMP NO. 3
E-15	INTERCONNECTION DIAGRAMS - PUMP NO. 4
E-16	INTERCONNECTION DIAGRAMS - MISC.
E-17	INTERCONNECTION DIAGRAMS - MISC.
E-18	DETAILS
E-19	DETAILS

LANDSCAPING


GL-1	IRRIGATION PLAN
GL-2	PLANTING PLAN
KL-1	IRRIGATION PLAN
KL-2	PLANTING PLAN
KL-3	IRRIGATION DETAILS AND NOTES
KL-4	PLANTING DETAILS AND PLANT LIST

CONTROLS AND INSTRUMENTATION

I-1	PIPING AND INSTRUMENT DIAGRAM
I-2	PIPING AND INSTRUMENT DIAGRAM
I-3	PIPING AND INSTRUMENT DIAGRAM


GENERAL NOTES

- ALL WORK DETAILED ON THESE PLANS TO BE PERFORMED UNDER CONTRACT SHALL, EXCEPT AS OTHERWISE STATED OR PROVIDED FOR HEREON, BE CONSTRUCTED IN ACCORDANCE WITH THE CITY OF ALBUQUERQUE STANDARD SPECIFICATIONS FOR PUBLIC WORKS CONSTRUCTION - 1986 EDITION (REFERRED TO HEREIN AS THE STANDARD SPECIFICATIONS).
- FIVE (5) WORKING DAYS PRIOR TO ANY EXCAVATION, CONTRACTOR MUST CONTACT NEW MEXICO ONE CALL, 260-1990, FOR LOCATION OF EXISTING UTILITIES. THE CONTRACTOR SHALL EXERCISE DUE CARE TO AVOID DISTURBING EXISTING UNDERGROUND UTILITIES. IT SHALL BE HIS RESPONSIBILITY TO COORDINATE WITH THE UTILITY COMPANIES IN ORDER TO PREVENT ANY SERVICE DISRUPTION.
- PRIOR TO CONSTRUCTION, THE CONTRACTOR SHALL EXCAVATE AND VERIFY THE HORIZONTAL AND VERTICAL LOCATIONS OF ALL OBSTRUCTIONS. SHOULD A CONFLICT EXIST, THE CONTRACTOR SHALL NOTIFY THE ENGINEER OR SURVEYOR SO THAT THE CONFLICT CAN BE RESOLVED WITH MINIMUM AMOUNT OF DELAY.
- ALL UTILITIES AND UTILITY SERVICE LINES SHALL BE INSTALLED PRIOR TO PAVING.
- BACKFILL COMPACTION SHALL BE ACCORDING TO SPECIFIED STREET USE.
- TACK COAT REQUIREMENTS SHALL BE DETERMINED BY THE CITY ENGINEER.
- IF CURB IS DEPRESSED FOR A DRIVEPAD OR A HANDICAP RAMP, THE DRIVEPAD OR RAMPS SHALL BE CONSTRUCTED PRIOR TO ACCEPTANCE OF THE CURB AND GUTTER.
- ALL STORM DRAINAGE FACILITIES SHALL BE COMPLETED PRIOR TO FINAL ACCEPTANCE.
- CONTRACTOR SHALL BE FULLY RESPONSIBLE FOR COORDINATION WITH THE WATER SYSTEMS PROJECT MANAGER (857-8200) FIVE (5) WORKING DAYS PRIOR TO ANY WORK NEEDING THE EXECUTION OF THE WATER VALVE SHUT-OFF PLAN.
- CONTRACTOR SHALL MAINTAIN SAFE ACCESS FOR CITY CREWS TO OPERATE AND MAINTAIN FACILITIES AT ALL TIMES DURING THE CONSTRUCTION PERIOD.

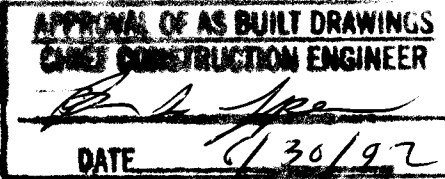

CODE REFERENCE
Occupancy Group B4
Type of Construction UN
Area of Each Floor 2737
Occupant Load 8
Seismic Zone 2B
Soil Bearing Capacity 2,000 psf
Concrete Strength 3000 psi
Stress Values:
Lumber NA Steel 36 ksi
Wind Design Load 7.5 mph
Roof Design Load DL-15 psf LL-20 psf
Floor Design Load LL-100 psf / 90' conc
Corridor Design Load NA
Ref. Bldg. Code 331(4)

RECORD DRAWING
FEB 1992
These drawings have been reviewed and approved for record and every reasonable attempt has been made to depict construction as actually performed.

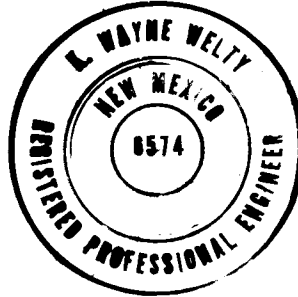


APPROVAL OF REVISIONS		APPROVED FOR CONSTRUCTION	
LEEDSHILL-HERKENHOFF, INC. Copper Square, 500 Copper Ave. N.W. P.O. Box 1217 Albuquerque, New Mexico 87103 (505) 247-0284		11-16-90 CE	
PROJECT NO.	333790	SHEET OF	1 15

PROPOSED	EXISTING	DESCRIPTION
NA	○	SANITARY SEWER MANHOLE
NA	⊗	STORM DRAIN MANHOLE
NA	○ TELE MH	TELEPHONE MANHOLE
SAS 8" CP	--- SAS 8" CP	SANITARY SEWER LINE W/SIZE & TYPE
NA	--- SD 48" RCP	STORM DRAIN LINE W/SIZE & TYPE
W 6" CI	--- W 6" CI	WATER LINE W/SIZE & TYPE
NA	--- [E]	OVERHEAD ELECTRICAL LINES
UE	--- [UE]	UNDERGROUND ELECTRICAL / TRAFFIC CONTROL
UT	--- [UT]	UNDERGROUND TELEPHONE
⊙	--- ⊙ 2" H.P.	GAS LINES W/SIZE & TYPE
NA	--- [CT]	CABLE TELEVISION LINES
NA	--- []	ENCASEMENT
NA	⊕	STORM DRAIN INLETS (GRADE ELEVATION GIVEN IN PLANS IS EXTENDED FLOW LINE)
---	---	GATE VALVE
---	---	BUTTERFLY VALVE
▼	▼	FIRE HYDRANTS
---	---	REDUCERS
NA	--- T --- T	SANITARY SEWER SERVICE CONNECTION
NA	--- T --- T	WATER SERVICE CONNECTION
+	+	TEES
NA	--- + ---	CROSSES
~	~	BENDS
---	---	CAPS & PLUGS
NA	WM	WATER METER
VB, □ VB	VB, □	VALVE BOX, VALVE BOX W/CONCRETE RING
NA	PP	POWER POLE
NA	LP	LIGHT POLE
NA	TL	TRAFFIC LIGHT
NA	TC	TRAFFIC CONTROL BOX
NA	PB	PULL BOX
NA	TB	TELEPHONE BOOTH
---	---	CURB & GUTTER
NA	4 S.W.	SIDEWALK
NA	□ □ □ □	BLOCK WALL
NA	○ ○ ○ ○	CHAIN LINK FENCE
NA	× × × × ×	FIELD FENCE
NA	NA	SPOT ELEVATIONS
NA	---	PROJECT/PHASE BOUNDARY
NA	---	RIGHT OF WAY LINES
NA	---	PROPERTY LINES (SIDE)
NA	---	PUBLIC EASEMENTS
---	NA	CONSTRUCTION THIS PROJECT SPECIFIED ON DIFFERENT SHEET
NA	NA	LIGHT POLE BASE

LEGEND


PROPOSED	EXISTING	DESCRIPTION
NA	EXISTING	RESIDENTIAL PAVING
---	---	ARTERIAL PAVING
---	EXISTING	CONCRETE PAVING
NA	---	TEMPORARY PAVING
NA	---	WHEELCHAIR RAMP
NA	---	TREES
5700	5700	CONTOUR

CROSS REFERENCES:

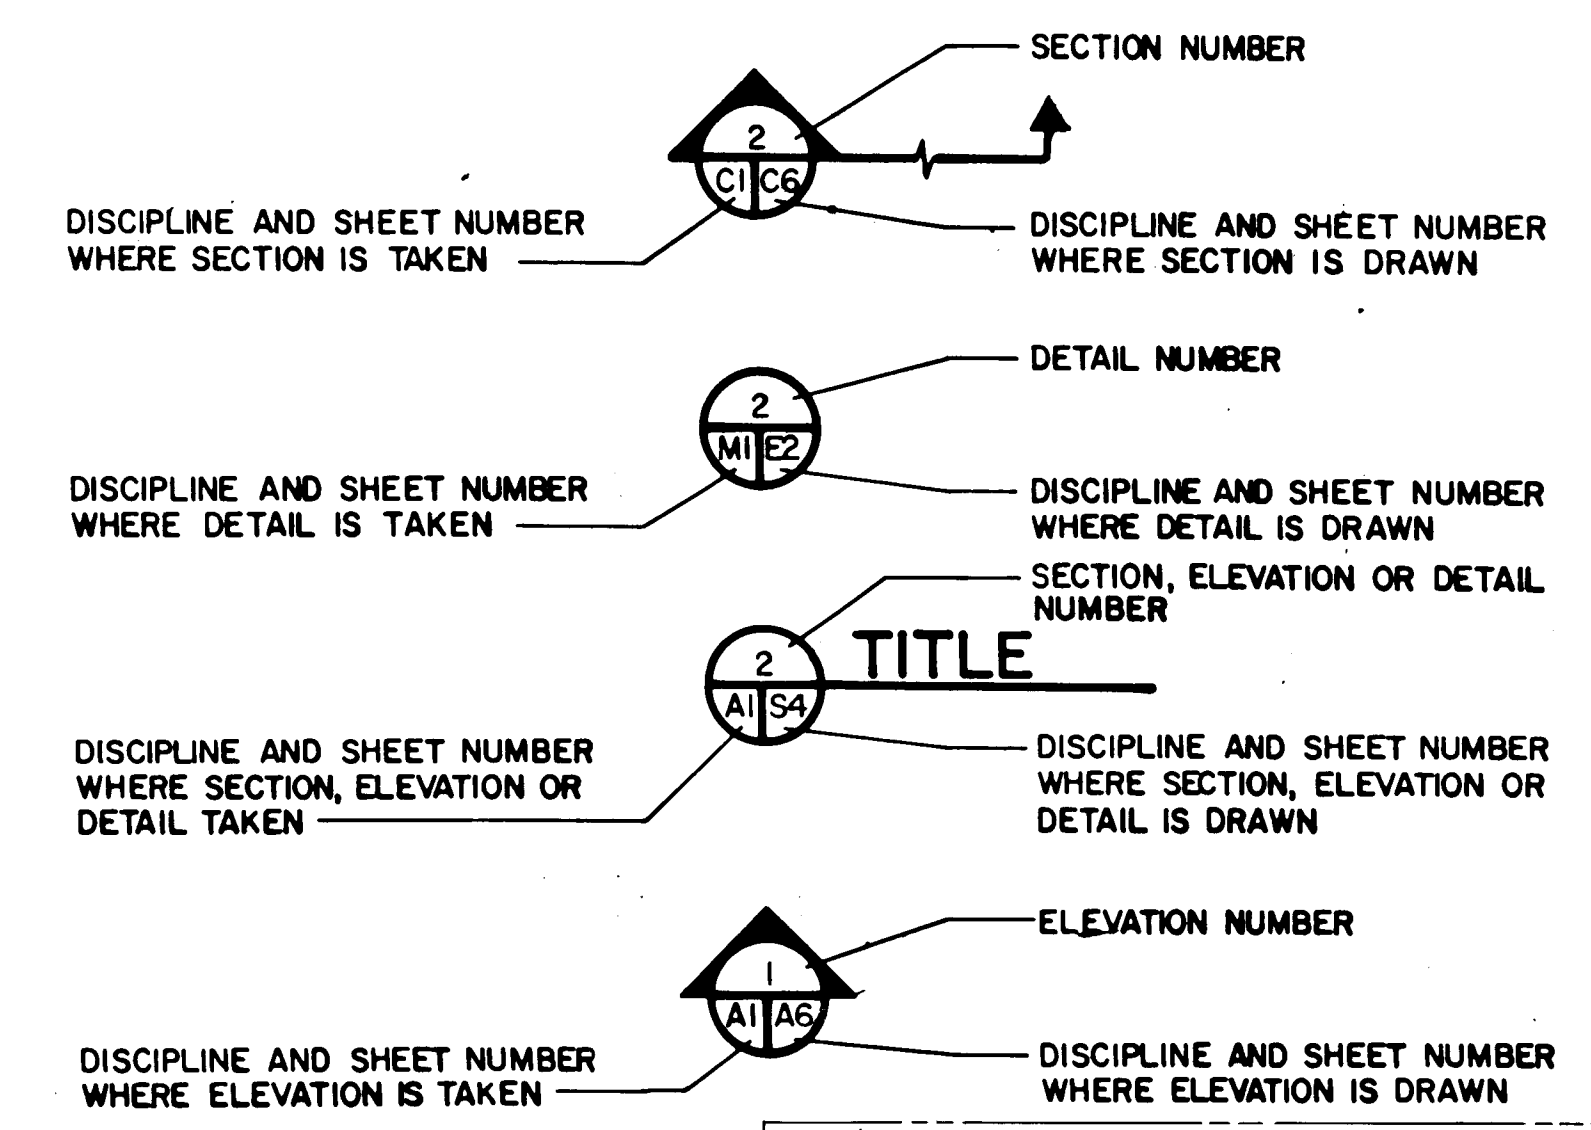

ABBREVIATIONS

A.B.	ANCHOR BOLT	PRC	POINT OF REVERSE CURVE
A.F.F.	ABOVE FINISHED FLOOR	PT	POINT OF TANGENT
BOC	BACK OF CURB	REQ'D.	REQUIRED
BRG.	BRIDGING	RT.	RIGHT
CI.	CAST IRON	RTB	REMOTE TERMINAL UNIT
CCYL	CONCRETE CYLINDER	RTU	REMOTE TERMINAL UNIT
CLR.	CLEAR	SHT.	SHEET
C.O.A.	CITY OF ALBUQUERQUE	SIM.	SIMILAR
COMP.	COMPRESSOR	SQ.	SQUARE
CONT.	CONTINUOUS	STA.	STATION
DN	DOWN	STD.	STANDARD
DWG	DRAWINGS	SVY	SURVEY
EA.	EACH	TC	TOP OF CURB
E.F.	EACH FACE	TR	TELEPHONE RISER
EL.	ELEVATION	TRANS	TRANSFORMER
E.W.	EACH WAY	TYP.	TYPICAL
FIN. FLR.	FINISHED FLOOR	T.O.C.	TOP OF CONCRETE
FL	FLANGE	T.O.S.	TOP OF SLAB
GA.	GAGE	T&B	TOP AND BOTTOM
GALV.	GALVANIZED	VAR.	VARIES
GYP.	GYPSON	WR	WATER RESISTANT
INST.	INSTRUMENT	W/	WITH
INV.	INVERT		
LBS.	POUNDS		
LT.	LEFT	L	ANGLE
MCC	MOTOR CONTROL CENTER	CL	CENTERLINE
MFG.	MANUFACTURER	PL	PLATE
MIN.	MINIMUM	AT	AT
NO.	NUMBER	Ø	DIAMETER
NOM.	NOMINAL	AND	AND
NPT	NATIONAL PIPE THREAD	POUNDS	POUNDS
NTS	NOT TO SCALE		
O.C.	ON CENTER		
OPNG.	OPENING		
OPP.	OPPOSITE		
P1	POINT OF INTERSECTION		
PC	POINT OF CURVE		
PE	PLAIN END		

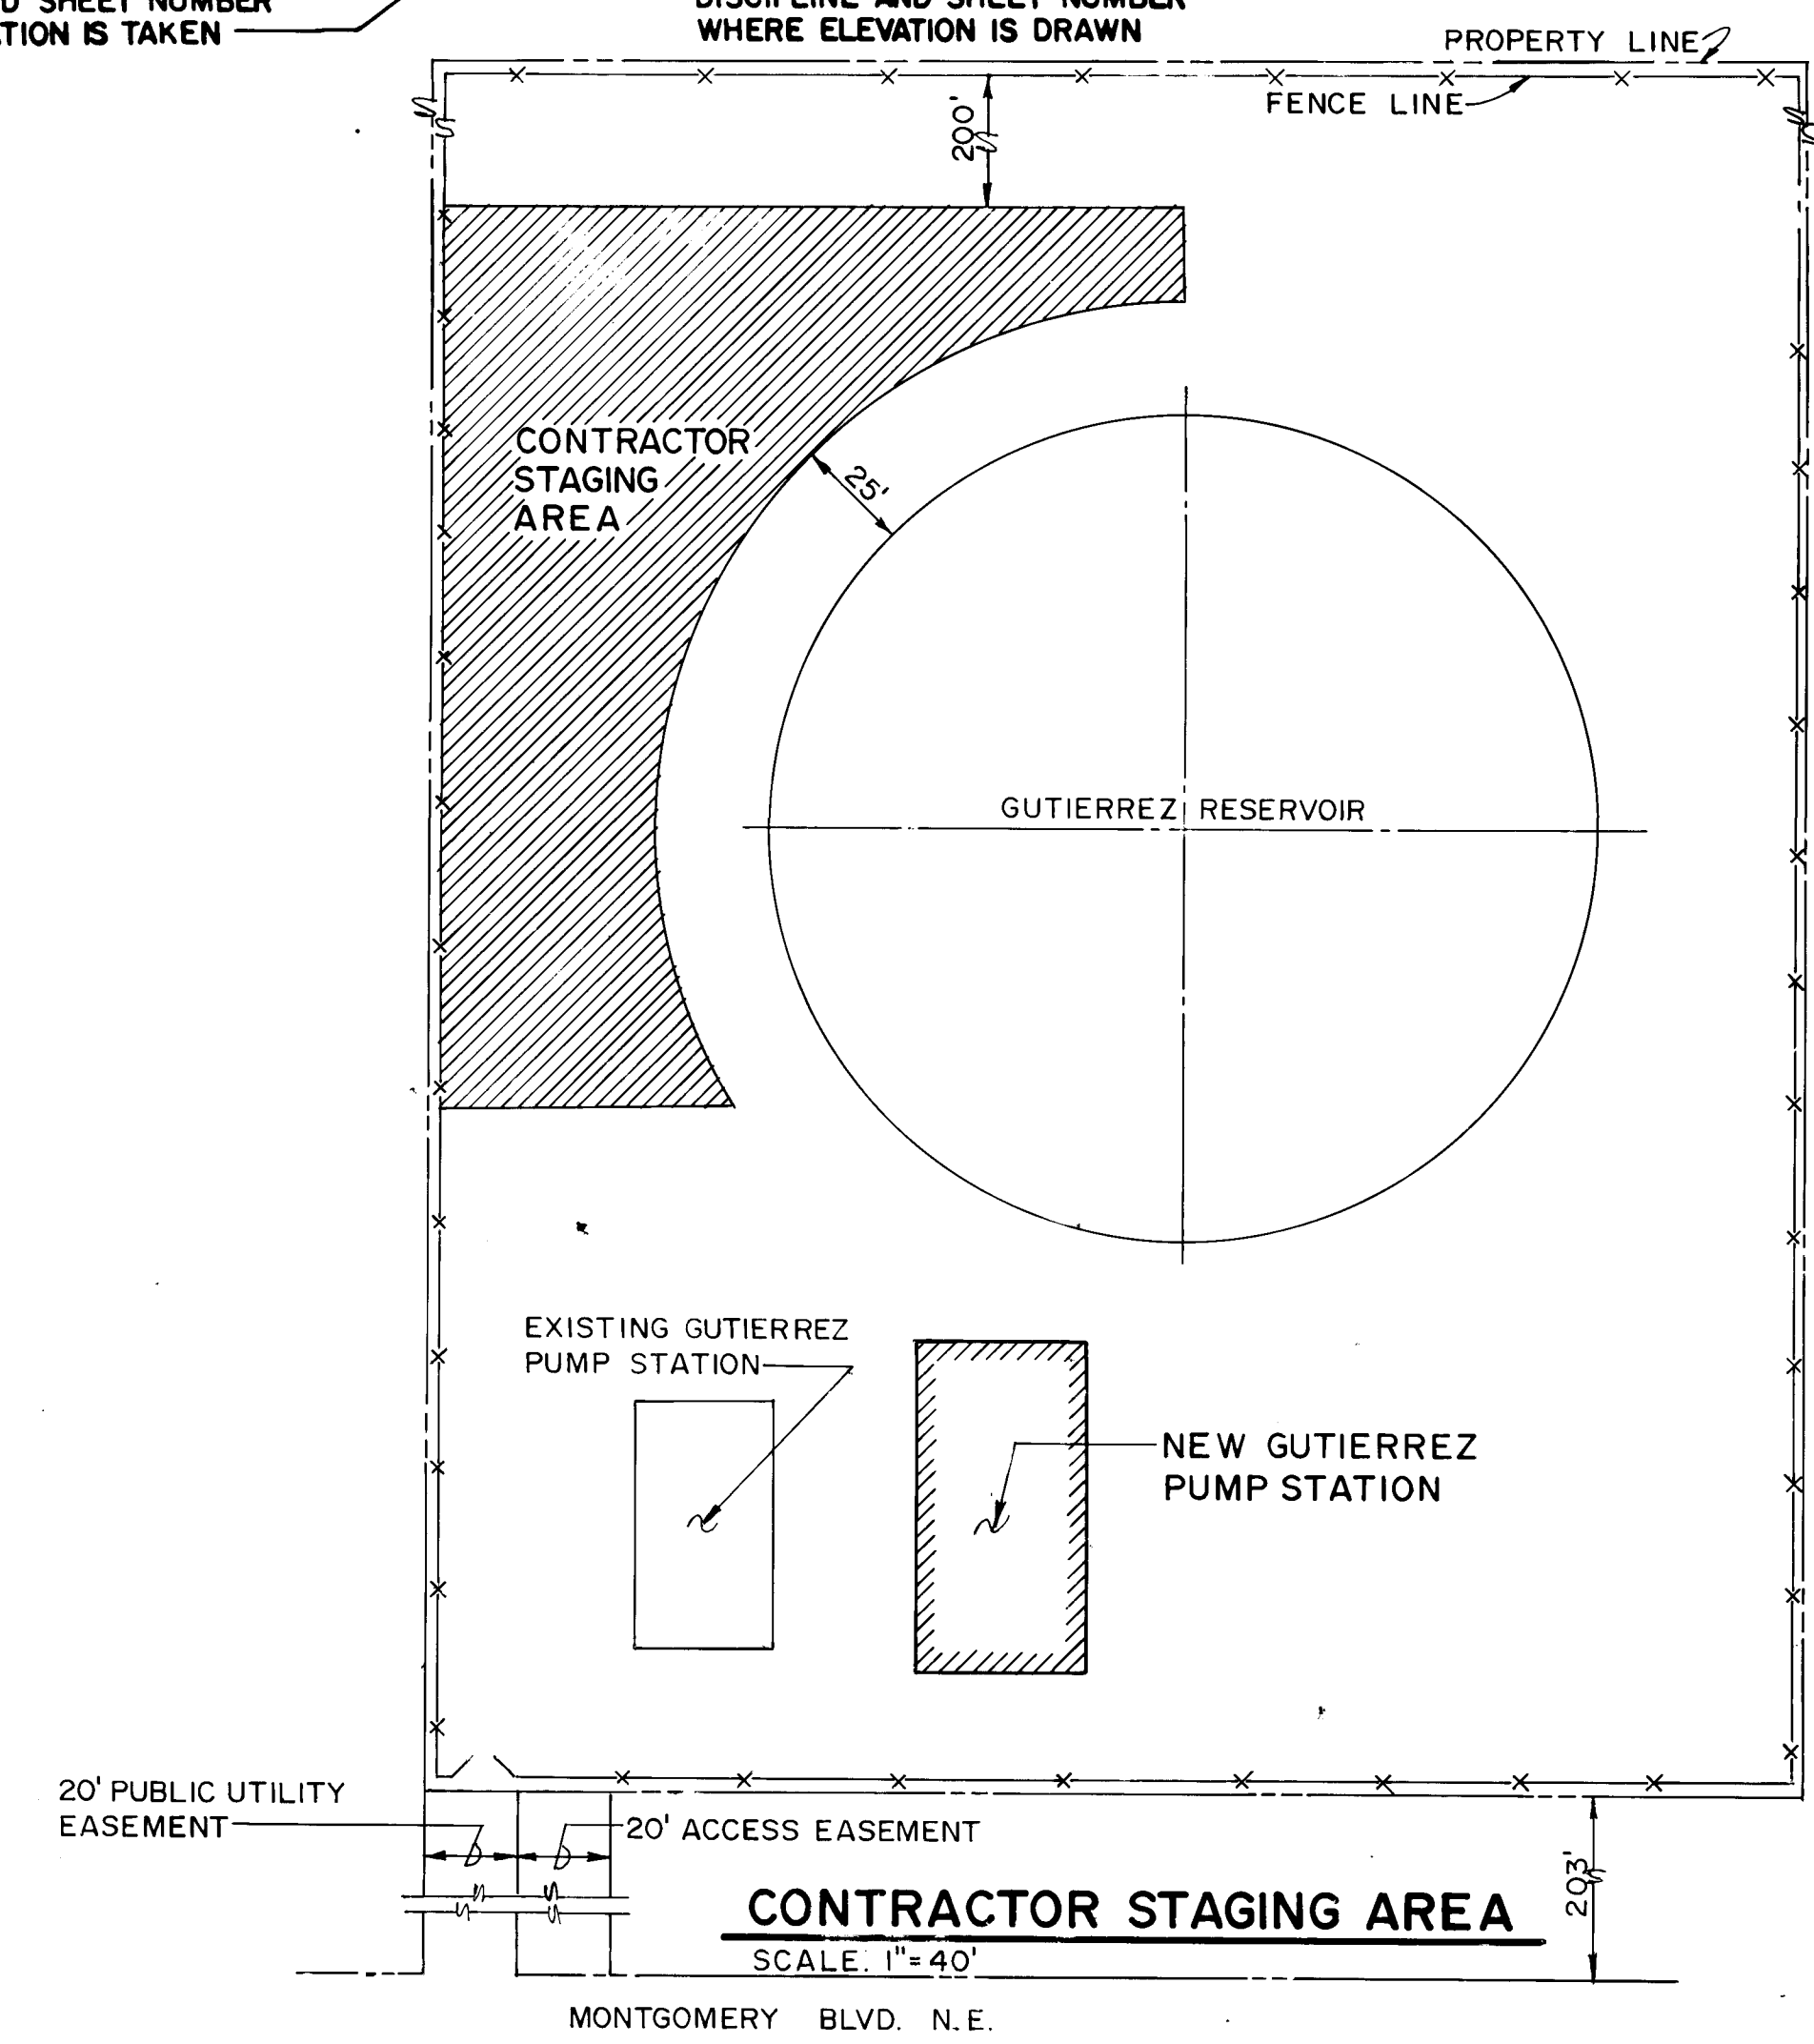


AS BUILT INFORMATION	BENCH MARKS	SURVEY INFORMATION	ENGINEER'S SEAL
CONTRACT NO. MCC Construction Co.		FIELD NOTES	
WORK ORDER NO. 1/91		DATE	
INSPECTOR'S SIGNATURE		BY	
ACCEPTANCE BY ENGINEER DATE 12/91		NO	
VERIFICATION BY ENGINEER DATE 12/91			
DRAWING BY DATE 12/91			
REVISIONS			
NO.			
DATE			
REMARKS			
DESIGNED BY K.W. WELTY			
DRAWN BY L.H. INC.			
CHECKED BY K.W. WELTY			
DATE JUNE 1990			
DATE JUNE 1990			
DATE JUNE 1990			


RECORD DRAWING
FEB 1992

These drawings have been revised based on field data and every reasonable effort has been made to depict construction as actually performed.

CITY OF ALBUQUERQUE PUBLIC WORKS DEPARTMENT ENGINEERING GROUP					
TITLE GUTIERREZ PUMP STATION RECONSTRUCTION, LEGEND, GENERAL NOTES AND ABBREVIATIONS					
APPROVALS	ENGINEER	DATE	APPROVALS	ENGINEER	DATE
DR. Char	R.W. Kane	11-14-90			
Trans. Dir.					
Utility Dir.					
Hyd.					
PROJECT NO. 333790	MAP NO. F-22	SHEET 2	OF 15		

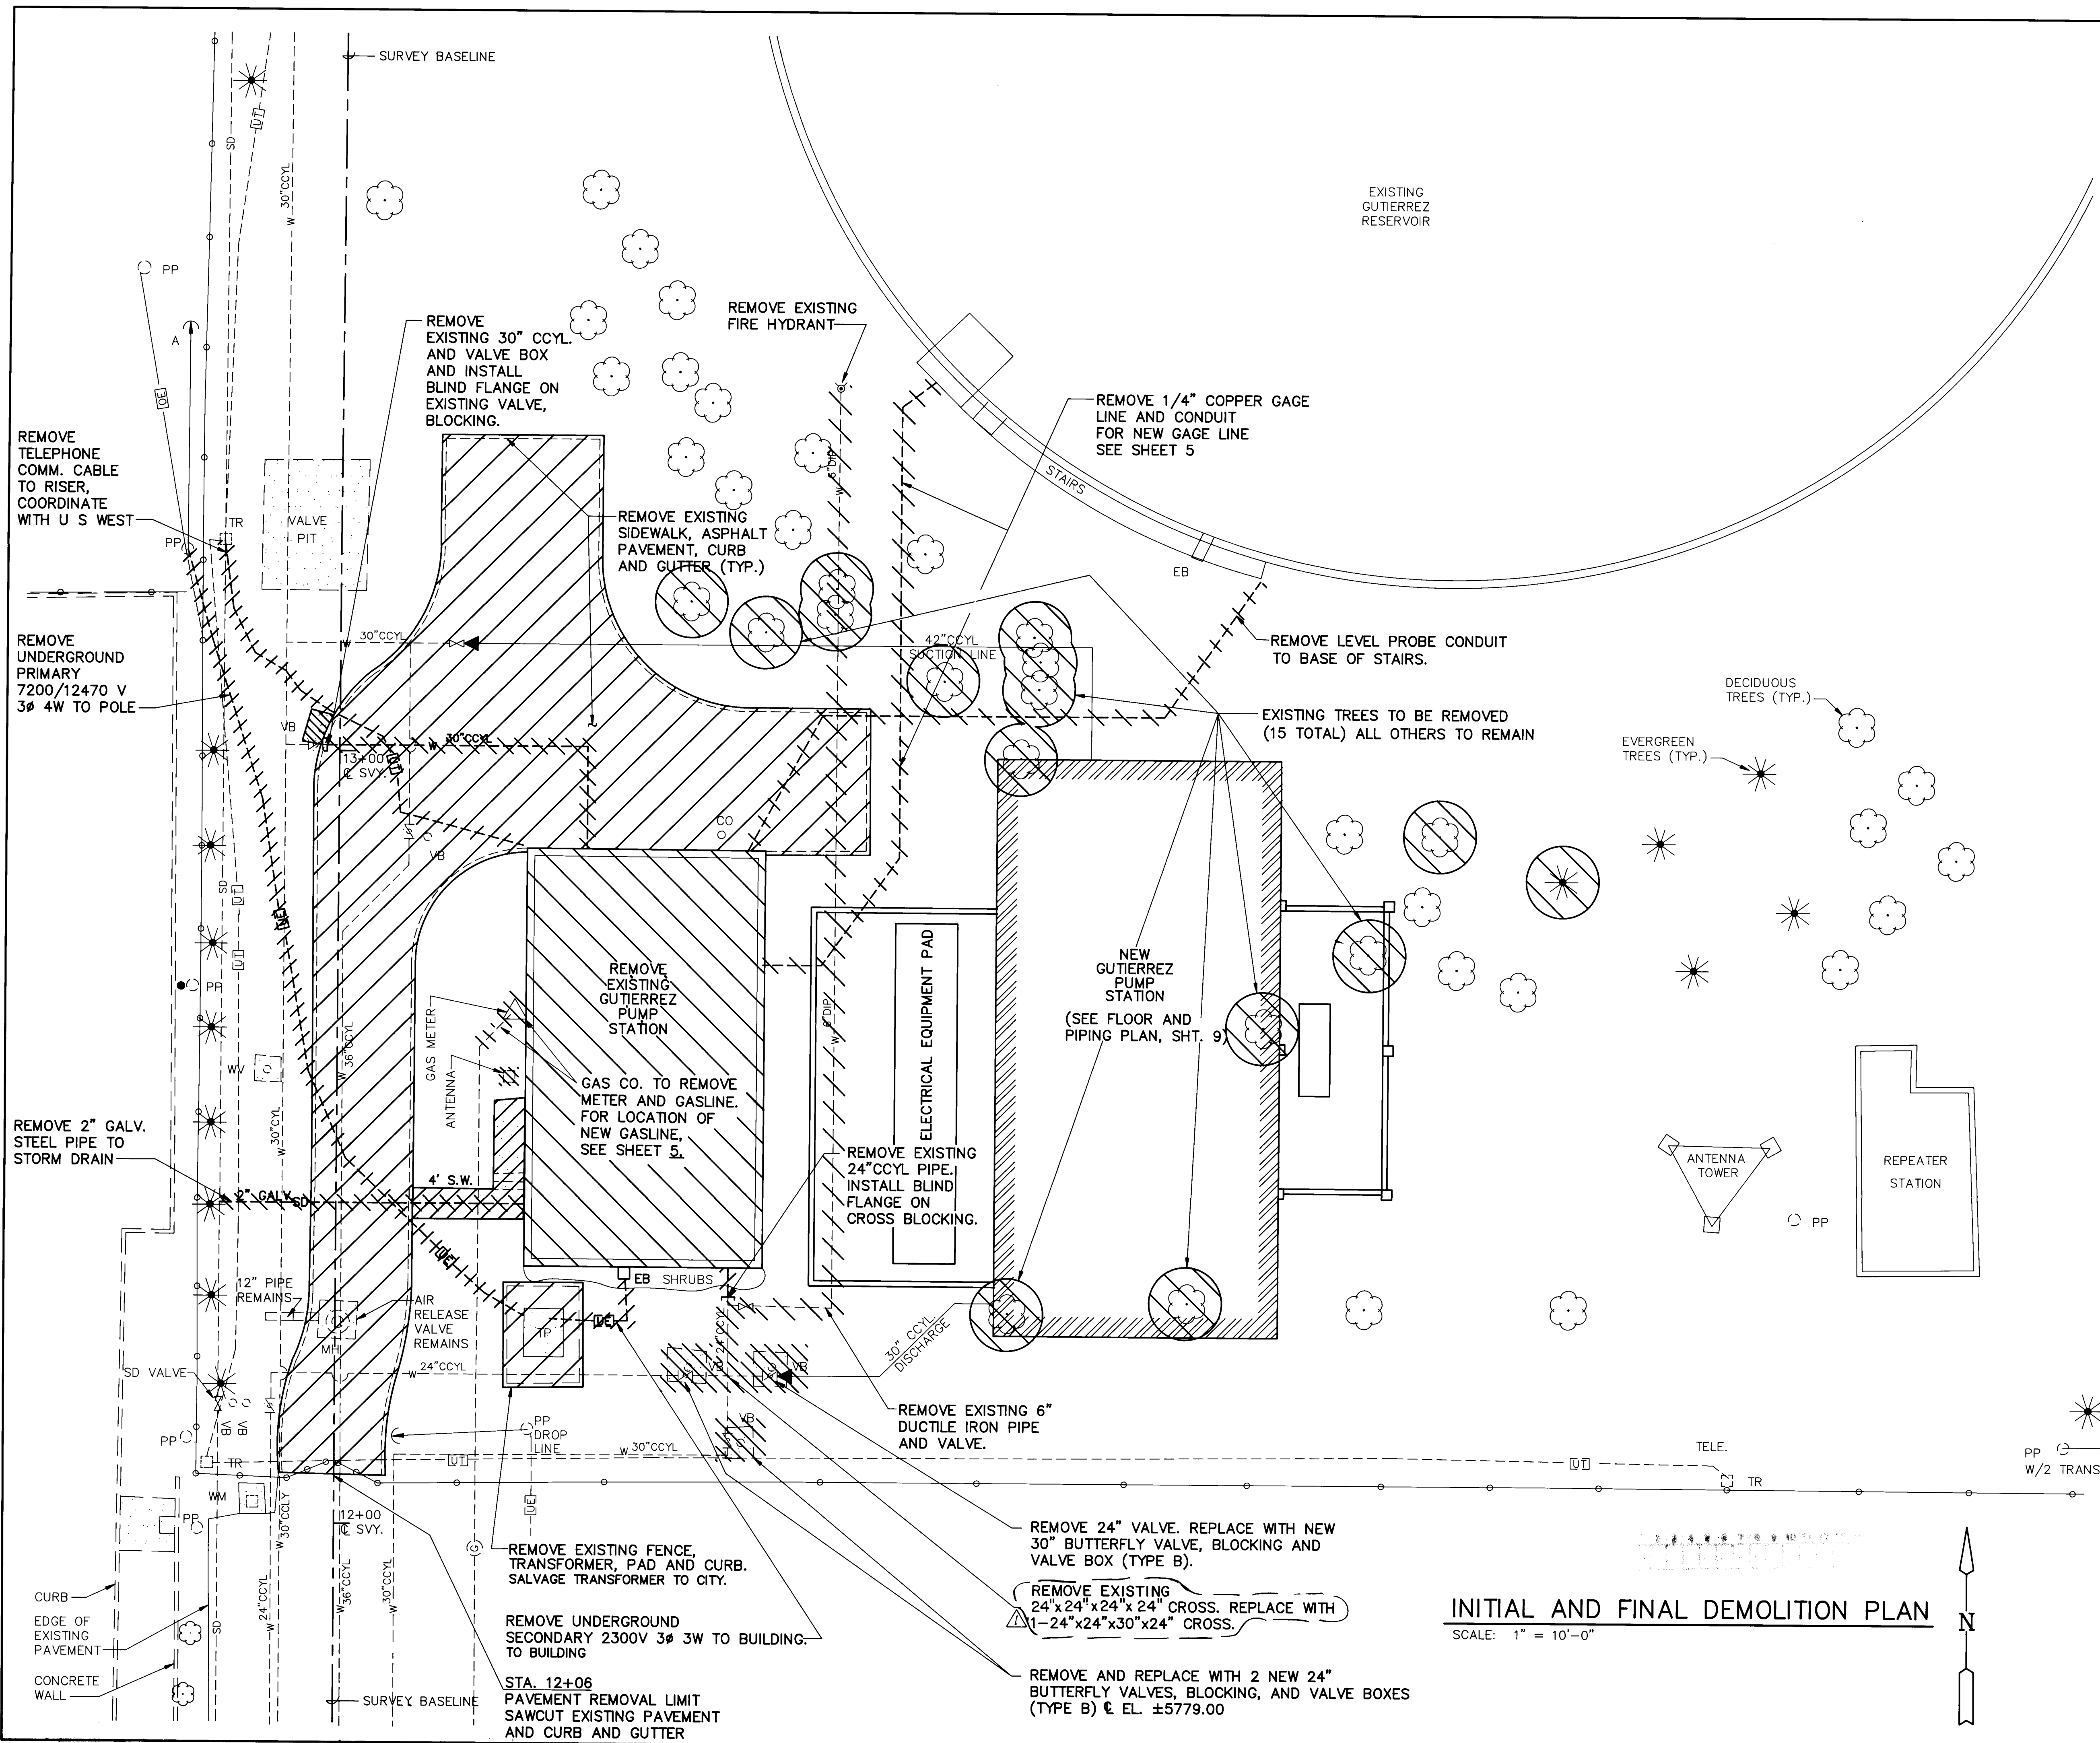

- NOTES:**
1. TREE REMOVALS AND IRRIGATION SYSTEM RELOCATIONS SHOWN ON LANDSCAPING SHEET. IRRIGATION SYSTEM NOT SHOWN ON THIS SHEET FOR CLARITY.
 2. ALL EXISTING ITEMS SHOWN IN THE LEGEND ON THIS SHEET SHALL BE REMOVED IN ACCORDANCE WITH THESE DRAWINGS AND SPECIFICATIONS. ALL OTHERS TO REMAIN UNDISTURBED.
 3. PHASING OF DEMOLITION ITEMS AND ITEMS TO BE SALVAGED ARE AS OUTLINED IN SPECIFICATIONS.
 4. NEW GUTIERREZ PUMP STATION MUST BE OPERATIONAL PRIOR TO DEMOLITION OF EXISTING PUMP STATION. EXISTING STATION TO REMAIN COMPLETELY OPERABLE DURING CONSTRUCTION.
 5. SEE GENERAL NOTES SHEET 1 FOR WATER VALVE - SHUT-OFF PLAN REQUIREMENTS.

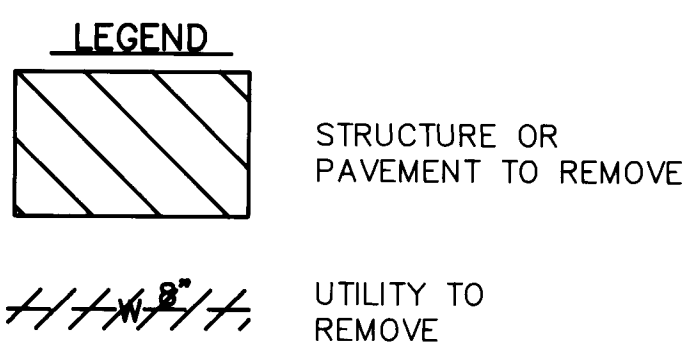

AS BUILT INFORMATION			BENCH MARKS			SURVEY INFORMATION			ENGINEER'S SEAL		
CONTRACTOR	MCC Construction Co.	DATE	2/91	STATION	10-F22A	DATE	5/90		BY	DATE	REMARKS
WORK	ALBUQUERQUE	DATE	2/91	STATION	10-F22A	DATE	5/90				
STARTED BY	ALBUQUERQUE	DATE	2/91	STATION	10-F22A	DATE	5/90				
DESIGNED BY	E. LIVINGSTON	DATE	JUNE 1990	DRAWN BY	LH	DATE	JUNE 1990	DESIGN			
CHECKED BY	K.W. WELTY	DATE	JUNE 1990								

RECORD DRAWING
DATE: FEB 1992
When drawings have been revised, the field date and every revision shall be made to the drawing as actually performed.

8026.21CD5 - 8026DEMO


**CITY OF ALBUQUERQUE
PUBLIC WORKS DEPARTMENT
ENGINEERING GROUP**

TITLE: GUTIERREZ PUMP STATION RECONSTRUCTION
INITIAL AND FINAL DEMOLITION PLAN

APPROVALS	ENGINEER	DATE	APPROVALS	ENGINEER	DATE
DRC CHAIRMAN	R.W. Kane	11-13-90	WATER	R.W. Kane	11-13-90
TRANSPORTATION	R.W. Kane	11-16-90	WASTE WATER	R.W. Kane	11-13-90
HYDROLOGY	L.D. M.	11-15-90			

PROJECT NO. 3337.90 MAP NO. F-22 SHEET 3 OF 15

INITIAL AND FINAL DEMOLITION PLAN
SCALE: 1" = 10'-0"

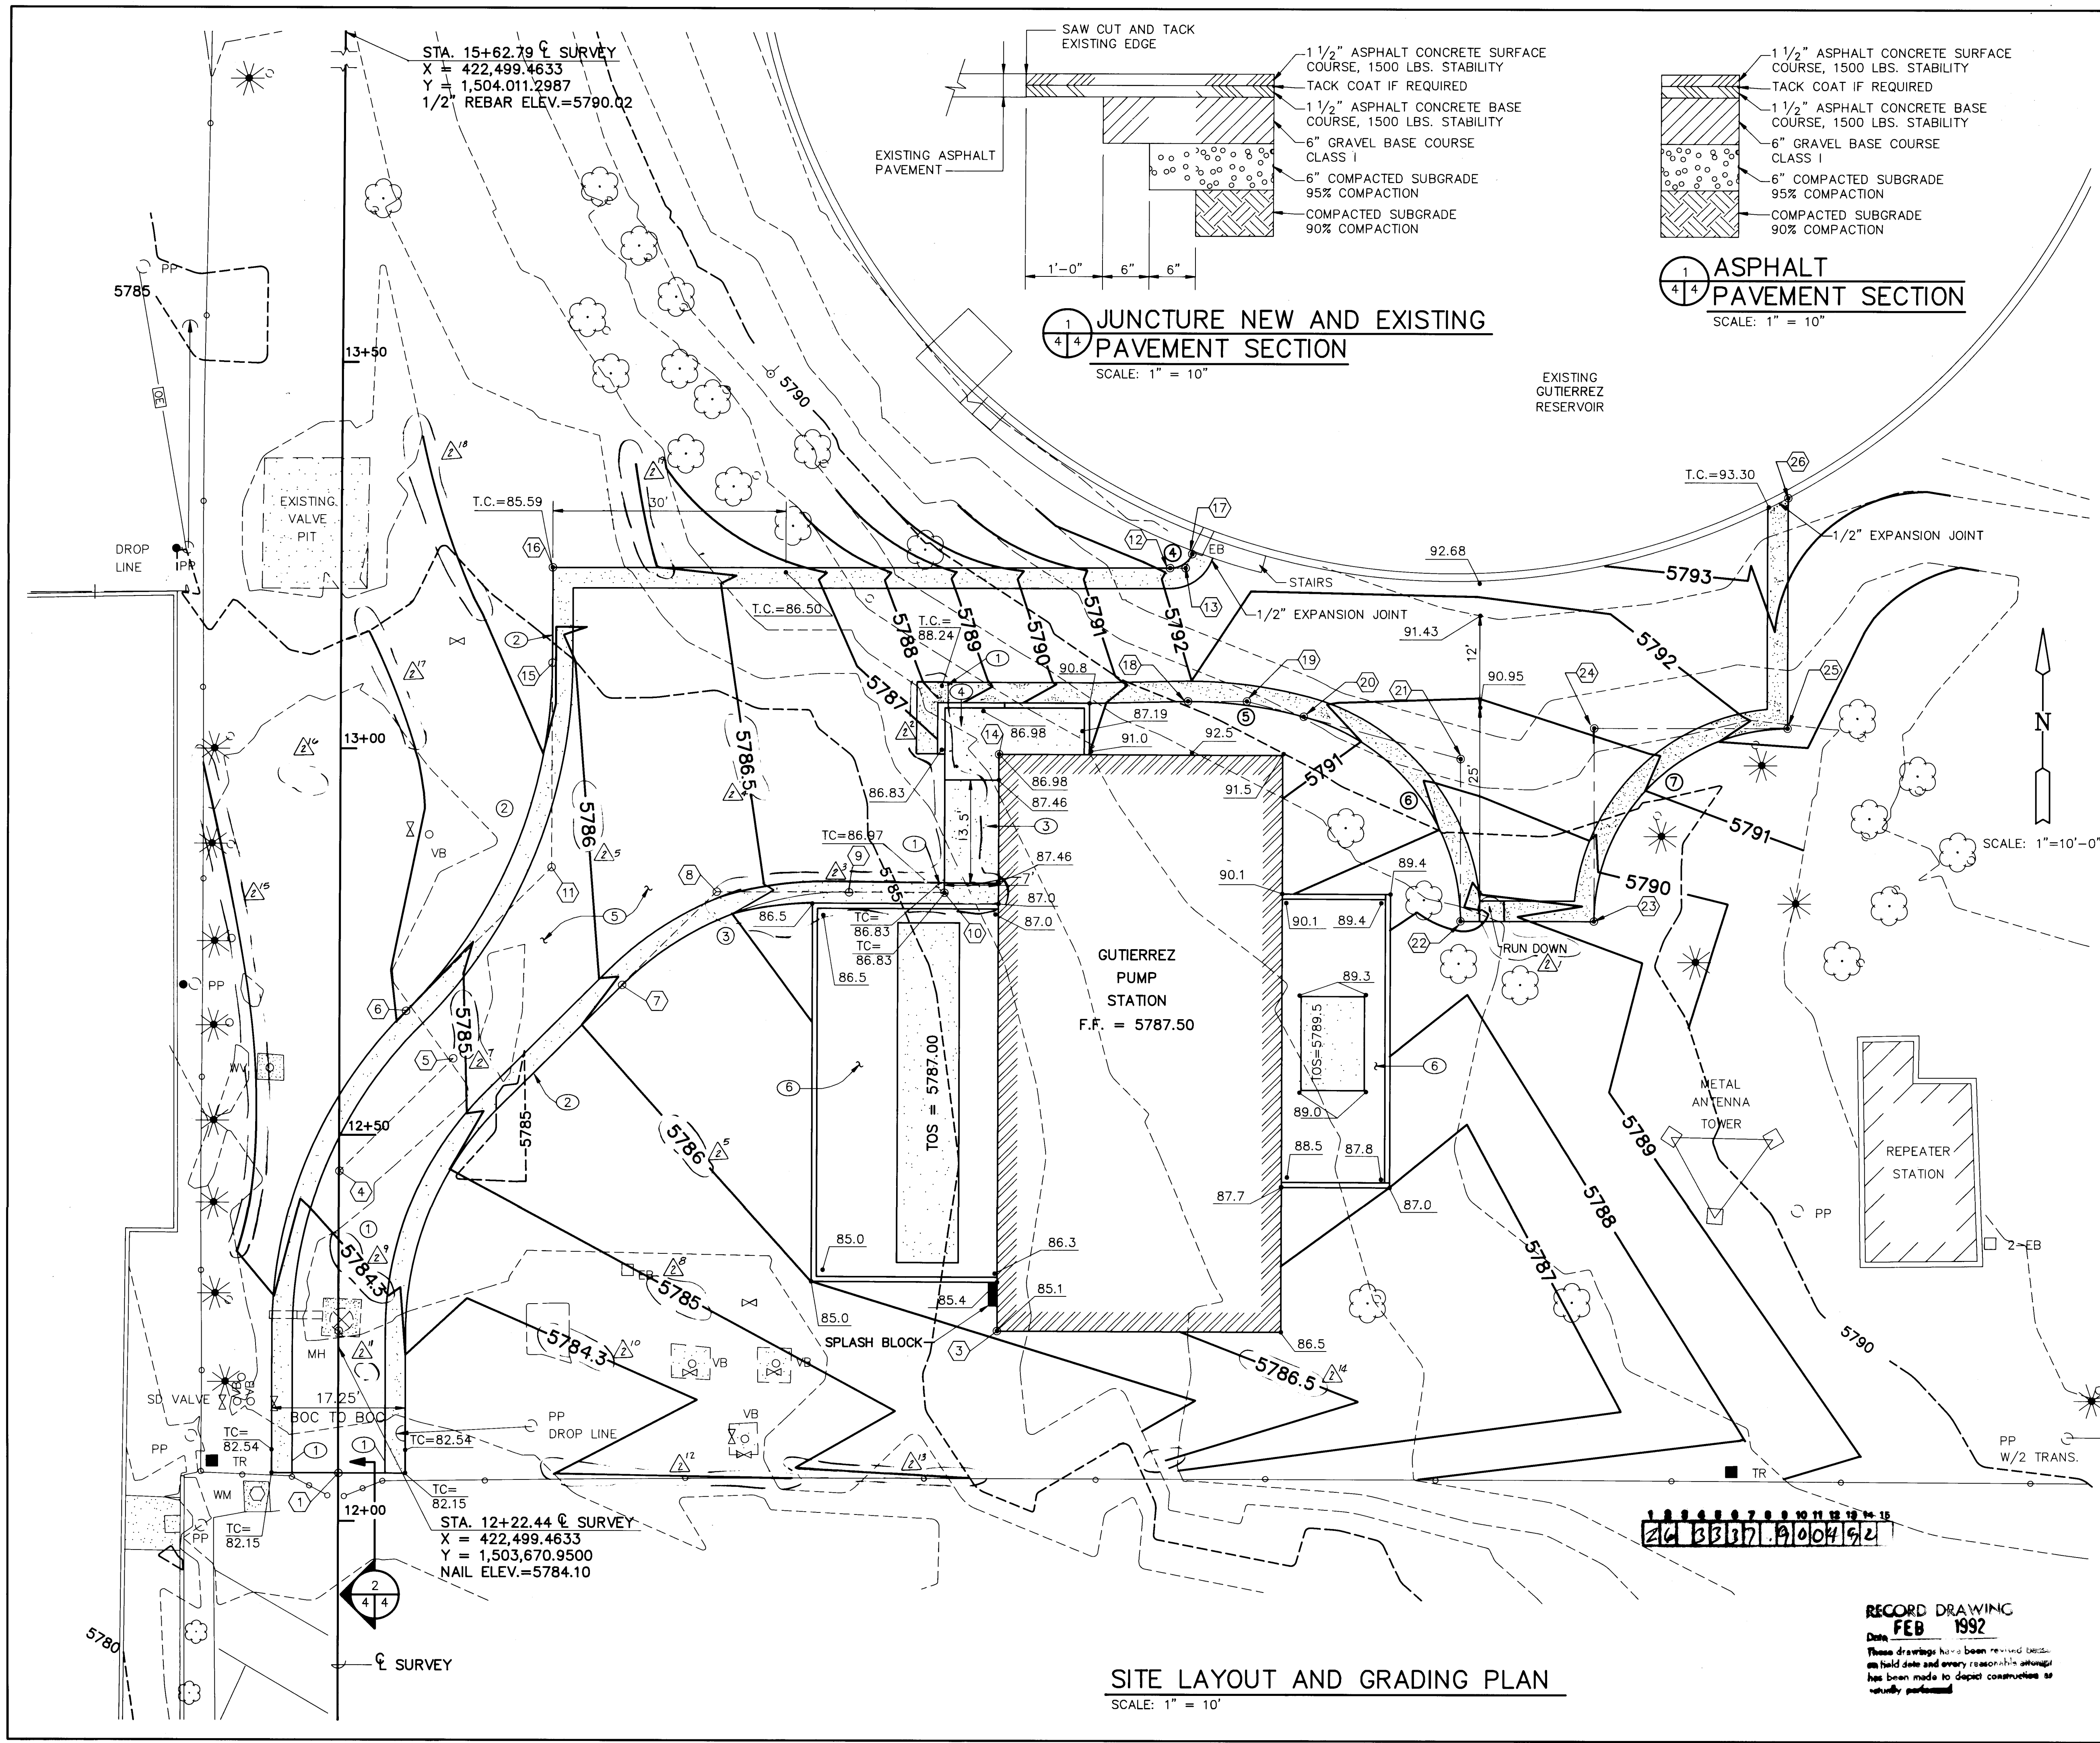

NOTES:

1. IRRIGATION AND LANDSCAPING REPLACEMENTS NOT SHOWN FOR CLARITY. SEE IRRIGATION AND LANDSCAPING SHEETS FOR DETAILS.

KEYED NOTES:

1. STA. 12+06.26, @ SVY.
2. PC STA. 12+24.62, @ SVY.
3. STA. 12+25.00, 85' RT. @ SVY.
4. PI STA. 12+45.38, @ SVY.
5. PT STA. 12+59.98, 14.64' RT. @ SVY.
6. PRC STA. 12+66.08, 8.54' RT. @ SVY.
7. PC STA. 12+69.59, 36.45' RT. @ SVY.
8. PI STA. 12+81.71, 48.57' RT. @ SVY.
9. PT STA. 12+81.71, 65.70' RT. @ SVY.
10. STA. 12+81.71, 78.00' RT. @ SVY.
11. PI STA. 12+84.78, 27.25' RT. @ SVY.
12. PT STA. 13+23.58, 107.00' RT. @ SVY.
13. PI STA. 13+23.58, 109.00' RT. @ SVY.
14. STA. 12+99.67, 85.00' RT. @ SVY.
15. PC STA. 13+11.22, 27.25' RT. @ SVY.
16. STA. 13+23.58, 27.25' RT. @ SVY.
17. PC STA. 13+25.39, 109.85' RT. @ SVY.
18. PC STA. 13+06.33, 109.39' RT. @ SVY.
19. PI STA. 13+06.33, 117.00' RT. @ SVY.
20. PCC STA. 13+04.36, 124.35' RT. @ SVY.
21. PI STA. 12+98.93, 144.64' RT. @ SVY.
22. PT STA. 12+77.93, 144.64' RT. @ SVY.
23. PC STA. 12+77.93, 161.89' RT. @ SVY.
24. PI STA. 13+02.93, 161.89' RT. @ SVY.
25. PT STA. 13+02.93, 186.89' RT. @ SVY.
26. STA. 13+31.1, 186.89' RT. @ SVY.

KEYED NOTES:

1. TRANSITION CURB HEIGHT FROM 3/4" TO 4" IN 3' OF LENGTH AT ENDS OF CURB
2. MOUNTABLE CURB ROLL TYPE PER STD. DWG. 2415
3. DRIVEPAD PER STD. DWG. 2425
4. SIDEWALK PER STD. DWG. 2430
5. PAVEMENT PER 1/4
6. FINISH GRADE IN GRAVEL AREAS IS TOP OF GRAVEL.

CURVE DATA - (ALL DATA AT BACK OF CURB UNLESS OTHERWISE NOTED)

	R	L	T
1 45'00"00"	50.00'	39.27'	20.71'
2 45'00"00"	63.84'	50.14'	26.44'
3 45'00"00"	41.38'	32.50'	17.14'
4 65'00"00"	3.14'	3.56'	2.00'
5 15'00"00"	57.81'	15.13'	7.61'
6 75'00"00"	27.37'	35.82'	21.00'
7 90'00"00"	25.00'	39.27'	25.00'

1/4 PT. ELEVATION - TOP OF CURB

	1	2	3	4	5
1 WEST	5782.88	5783.17	5783.46	5783.74	5784.03
2 EAST	5783.16	5783.49	5783.81	5783.14	5784.46
3	5785.28	5784.97	5784.66	5784.34	5784.03
4	5785.35	5785.68	5786.00	5786.33	5786.65
5	5792.90	5792.79	5792.69	5792.58	5792.47
6	5792.28	5792.05	5791.83	5791.60	5791.37
7	5791.37	5790.83	5790.30	5789.76	5789.22
8	5789.70	5790.39	5791.08	5791.76	5792.45


8026.21CD5 / GUTSORD

**CITY OF ALBUQUERQUE
PUBLIC WORKS DEPARTMENT
ENGINEERING GROUP**

TITLE:
GUTIERREZ PUMP STATION
SITE LAYOUT AND GRADING PLAN

APPROVALS	ENGINEER	DATE	APPROVALS	ENGINEER	DATE
DRC CHAIRMAN	1/1/92	1/1/92	WATER	R.W. Kane	11-13-90
TRANSPORTATION	1/1/92	1/1/92	WASTE WATER	R.W. Kane	11-13-90
HYDROLOGY	1/1/92	1/1/92			


PROJECT NO. 3337.90 MAP NO. F-22 SHEET 4 OF 15

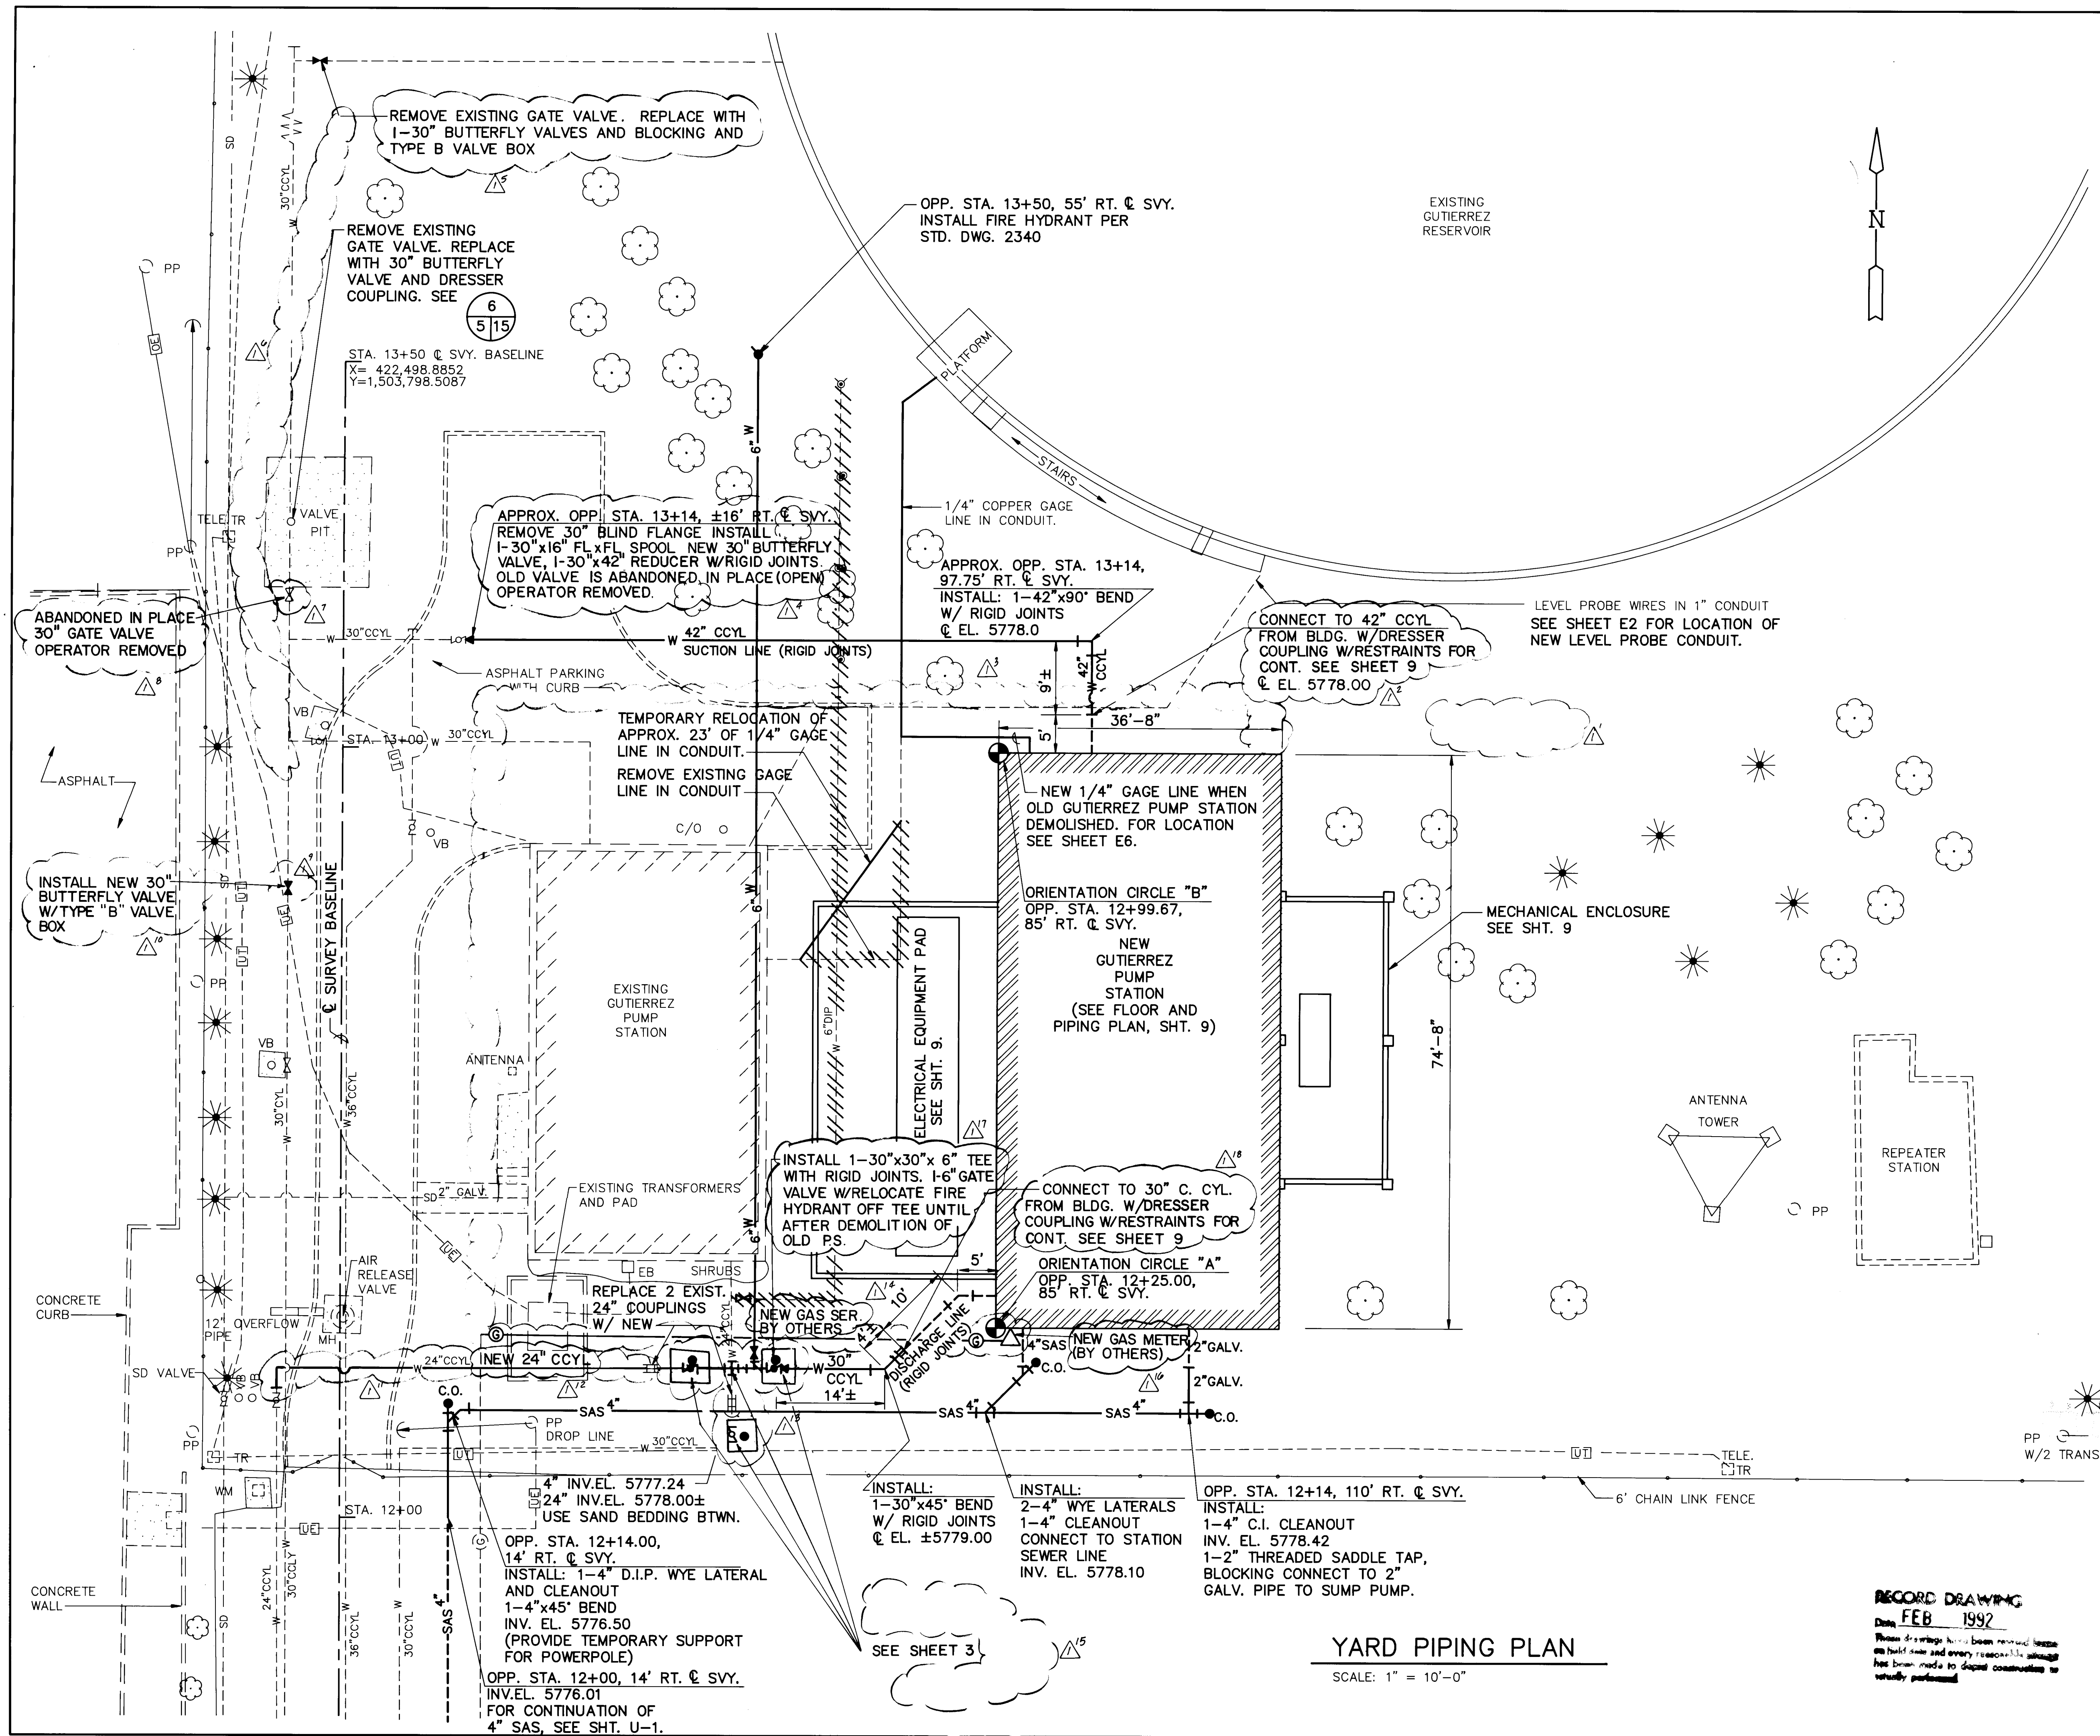

- NOTES:**
1. FOR LOCATIONS OF ELECTRICAL SERVICE AND TELEPHONE LINE RELOCATIONS, SEE SHEET E-1.
 2. EXISTING UTILITY LOCATIONS AND ELEVATIONS SHOWN ARE APPROXIMATE. CONTRACTOR TO FIELD VERIFY PRIOR TO FABRICATION OF PIPING.
 3. ALL NEW CONCRETE CYLINDER PIPING SHOWN SHALL HAVE FULL RIGID JOINTS PER C.O.A. STD. DWG. 2305.
 4. LANDSCAPING IRRIGATION SYSTEM NOT SHOWN FOR CLARITY. SEE IRRIGATION AND LANDSCAPING SHEETS FOR DETAILS.
 5. BUTTERFLY VALVE INSTALLATION PER CITY STD. DWG. 2351.
 6. BLOCKING FOR NEW VALVES SHALL BE INSTALLED PER C.O.A. DWG. 2333.
 7. VALVE BOXES SHALL BE INSTALLED PER C.O.A. STD. DWG. 2326.
 8. EXISTING GUTIERREZ PUMP STATION TO REMAIN IN FULL OPERATION DURING CONSTRUCTION OF NEW PUMP STATION. TEMPORARY SHUT-DOWN OF EXISTING STATION ALLOWED FOR INSTALLATION OF NEW 24\"/>


BENCH MARKS			SURVEY INFORMATION			ENGINEER'S SEAL		
THE STATION IS AN ACS BRASS TABLET STAMPED "10-F22A" LOCATED ON THE NORTH CURB OF MONTGOMERY BLVD. NE AT THE INTERSECTION OF MONTGOMERY BLVD. AND SHENANDOAH PL. NE. ELEVATION = 5831.93 (1ST. ORDER)			DATE	BY	REMARKS	DESIGNED BY	DRAWN BY	CHECKED BY
1	5/90	ALBQ. SURVEY				E. LIVINGSTON	K. H. KROHN	K. W. WELTY
CONTRACTOR: NCC Construction Co. INSPECTOR: [Signature] DATE: 2/91 VERIFICATION BY: [Signature] DATE: 2/91 RECORD BY: [Signature] DATE: 2/92 RECORD BY: [Signature] DATE: 2/92			DATE: JUNE 1990 DATE: JUNE 1990 DATE: JUNE 1990			PROJECT NO. 3337.90 MAP NO. F-22 SHEET 5 OF 15		

CITY OF ALBUQUERQUE PUBLIC WORKS DEPARTMENT ENGINEERING GROUP					
TITLE: GUTIERREZ PUMP STATION RECONSTRUCTION YARD PIPING PLAN					
APPROVALS	ENGINEER	DATE	APPROVALS	ENGINEER	DATE
DR. CHAIRMAN	[Signature]	11-13-90	WATER	R.W. Kane	11-13-90
TRANSPORTATION	[Signature]	11-16-90	WASTE WATER	R.W. Kane	11-13-90
HYDROLOGY	[Signature]	11-15-90			

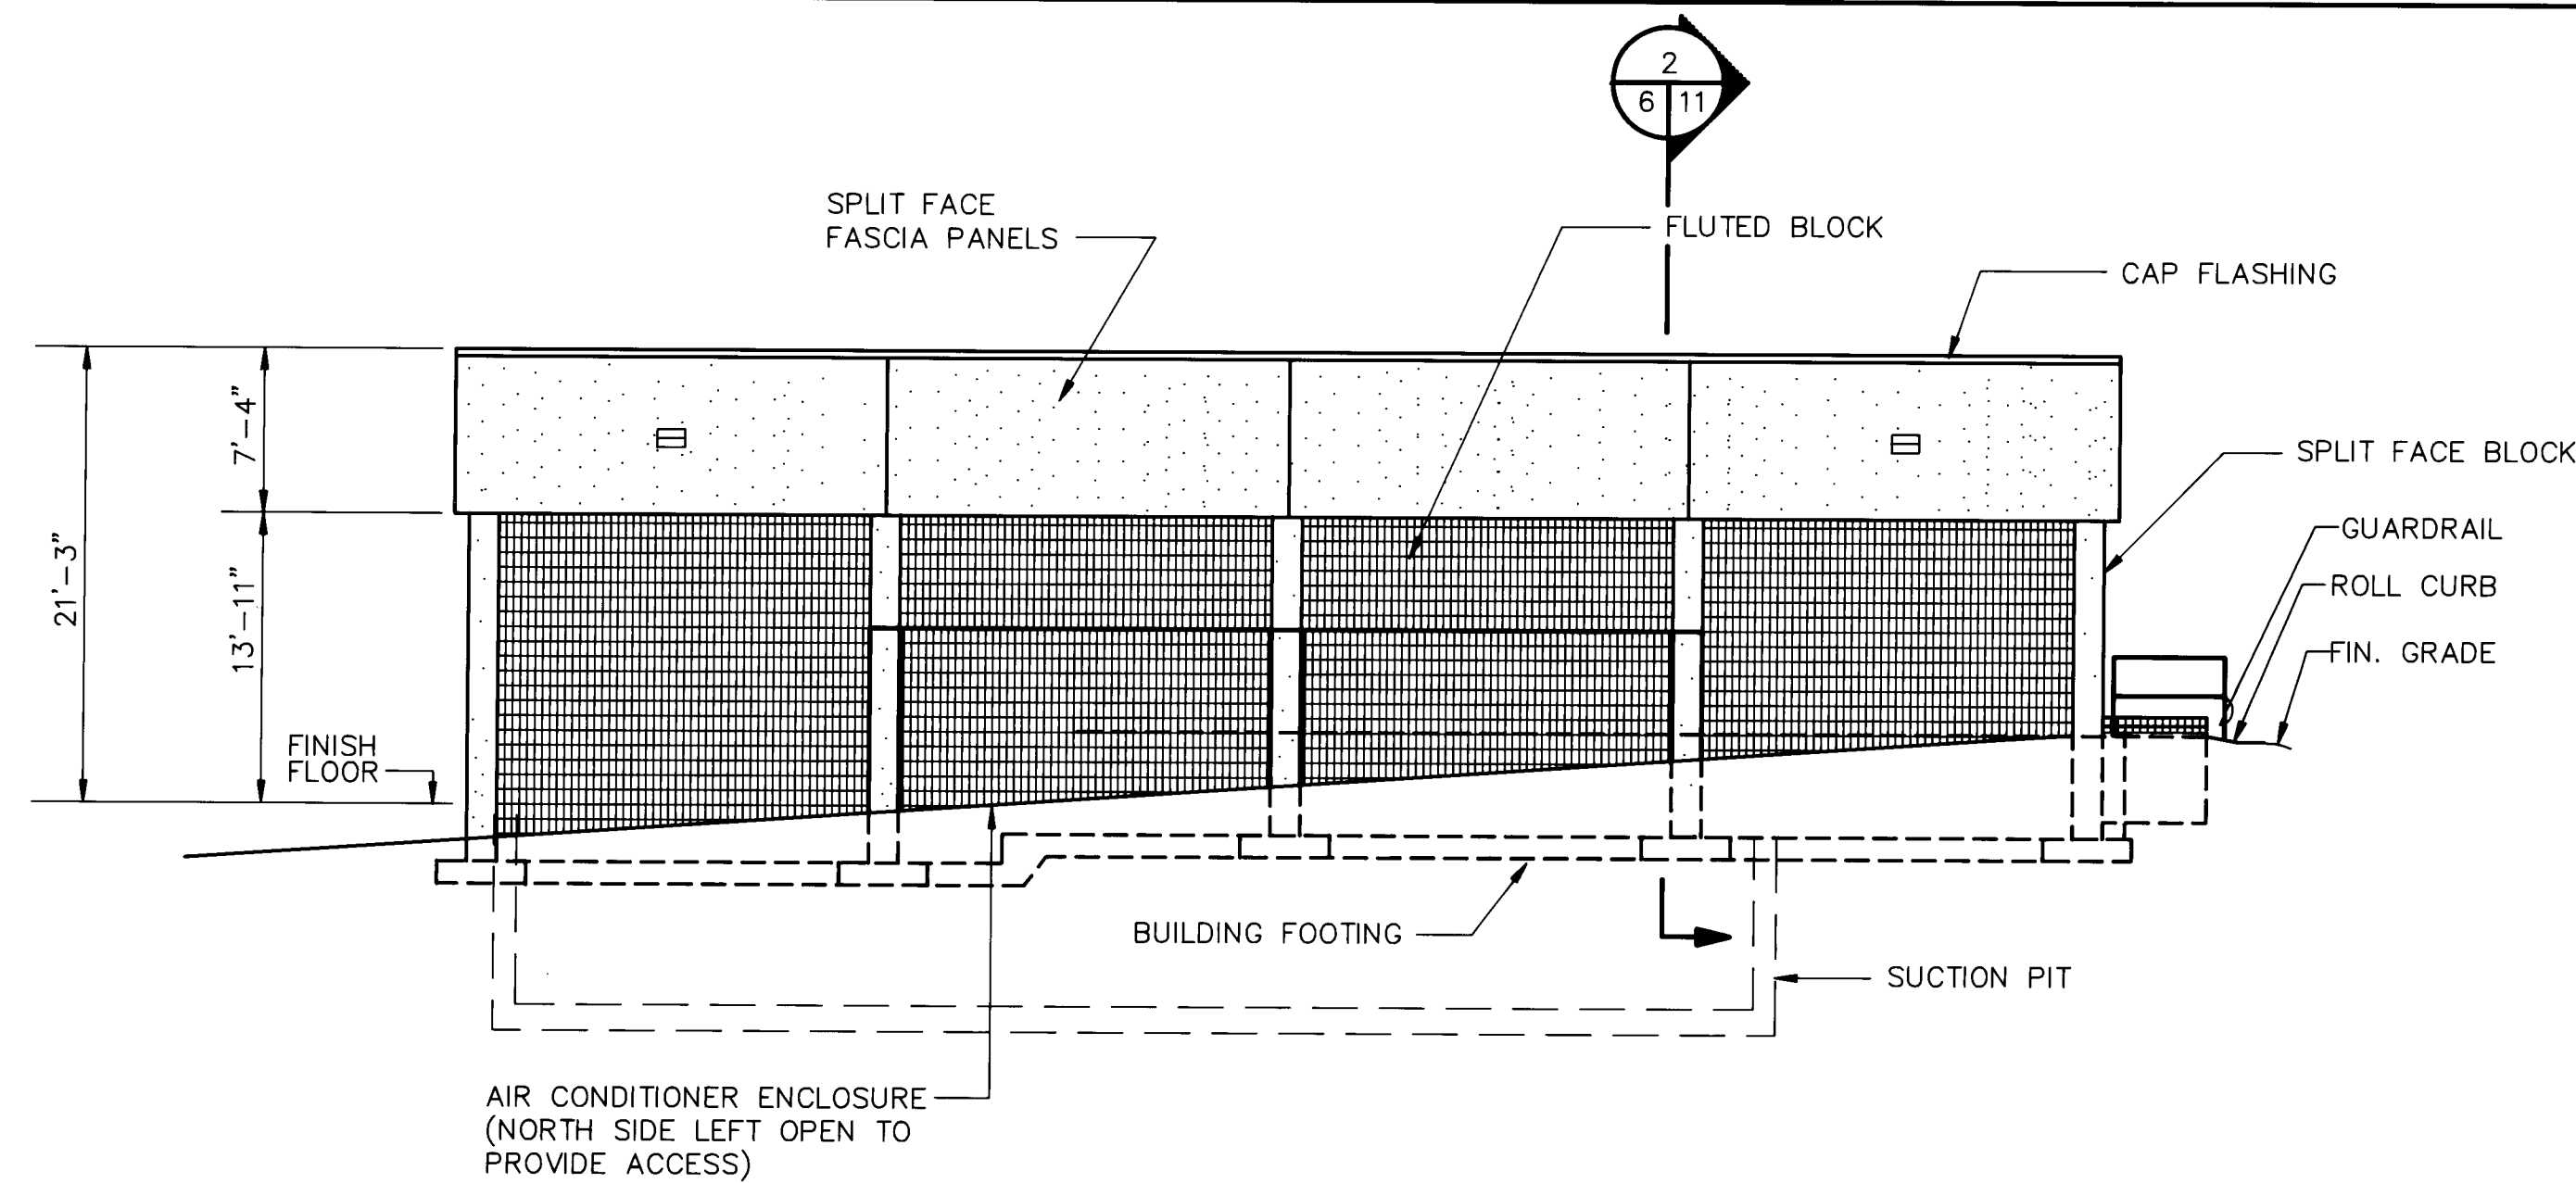


EAST ELEVATION

SCALE: 1/8" = 1'-0"

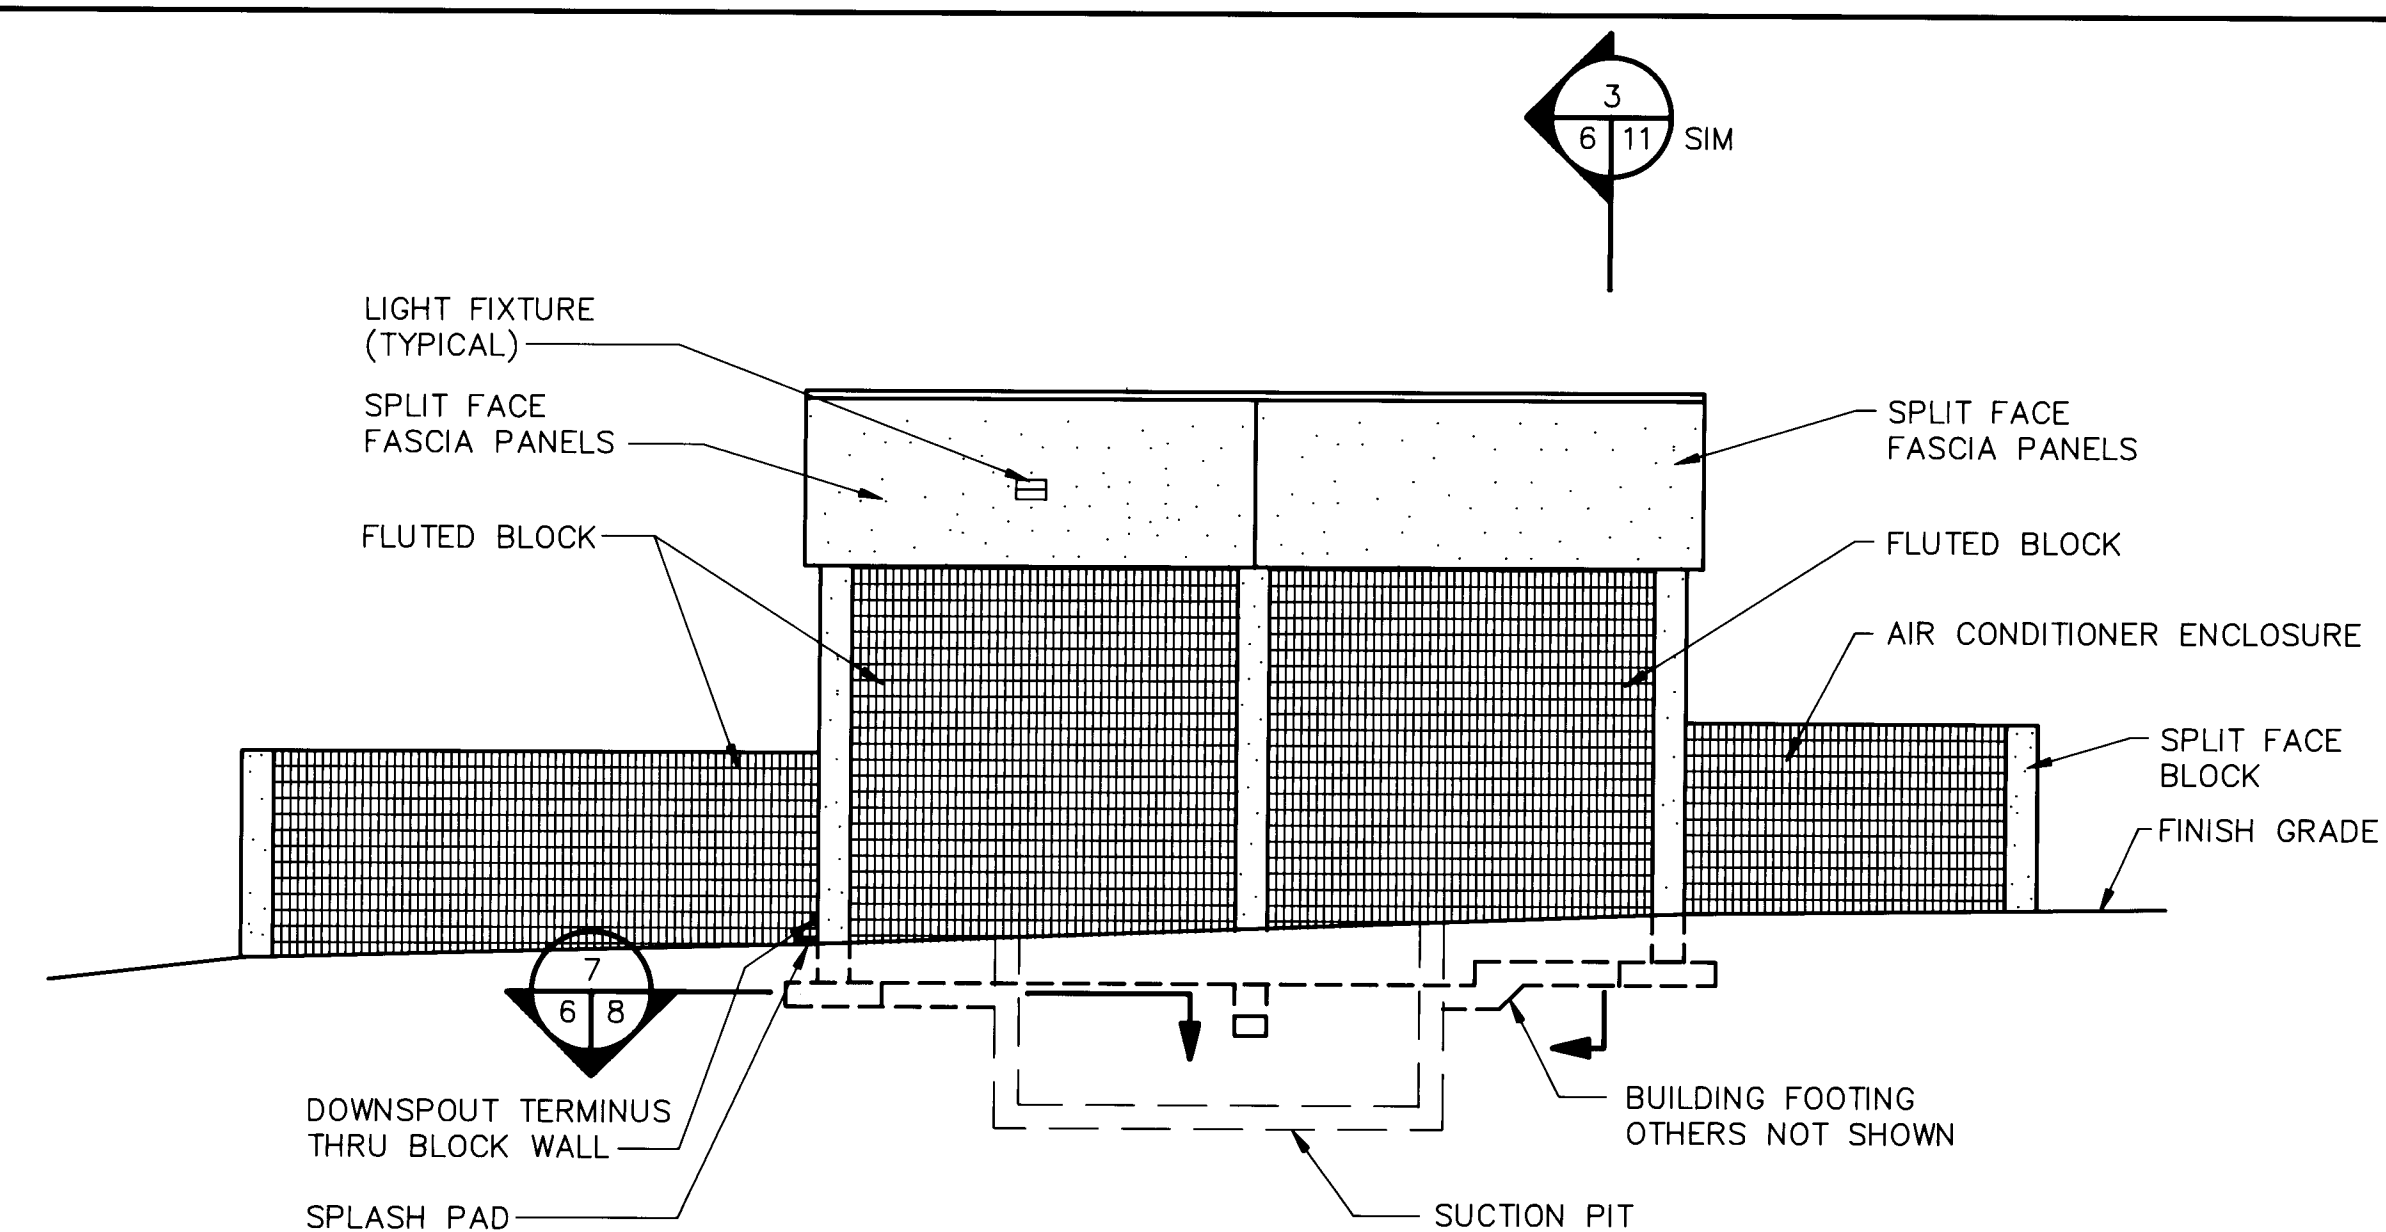


SOUTH ELEVATION

SCALE: 1/8" = 1'-0"

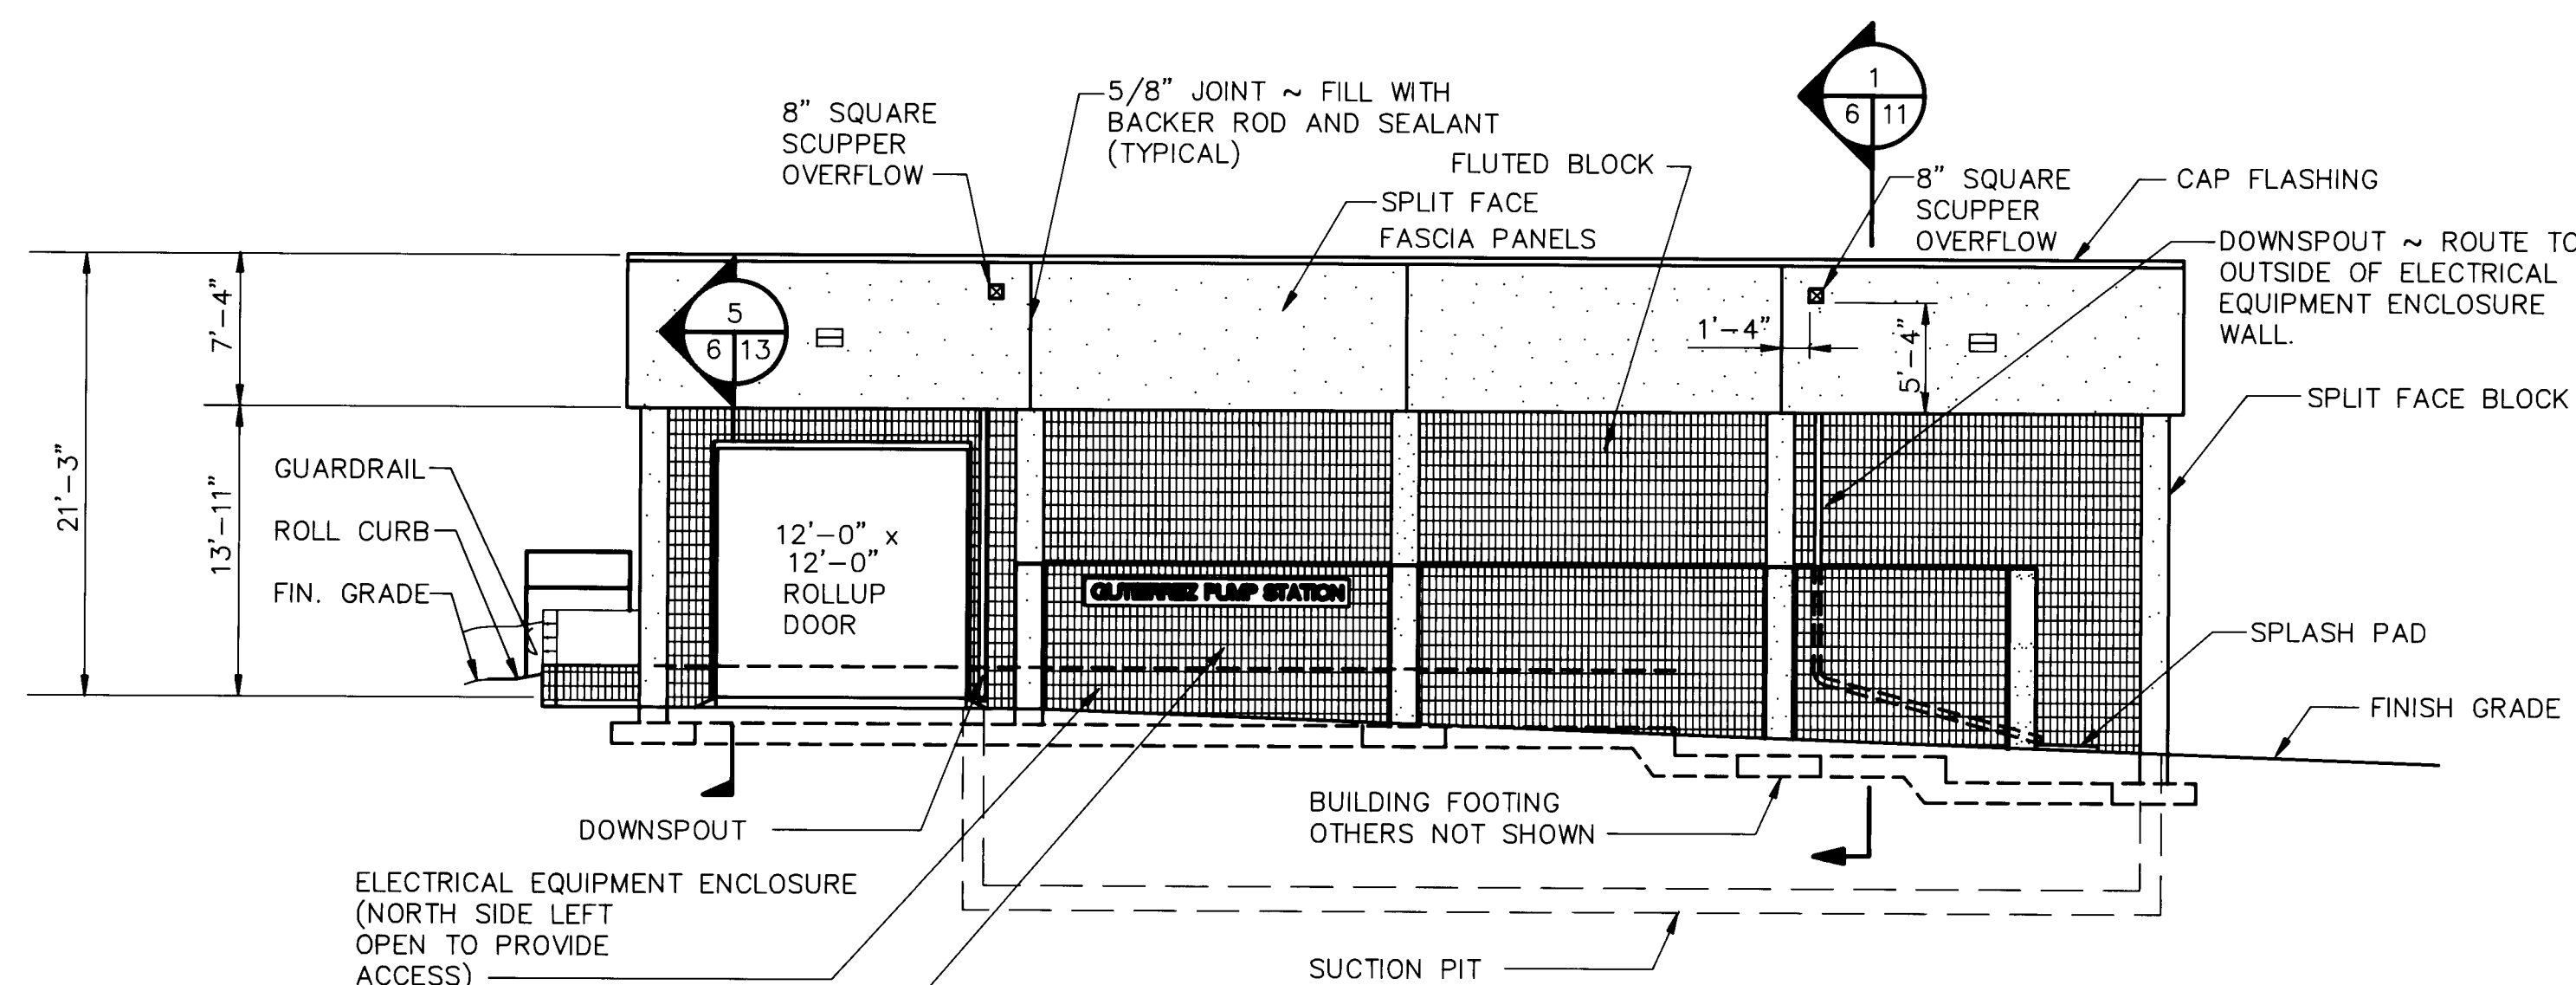


WEST ELEVATION

SCALE: 1/8" = 1'-0"

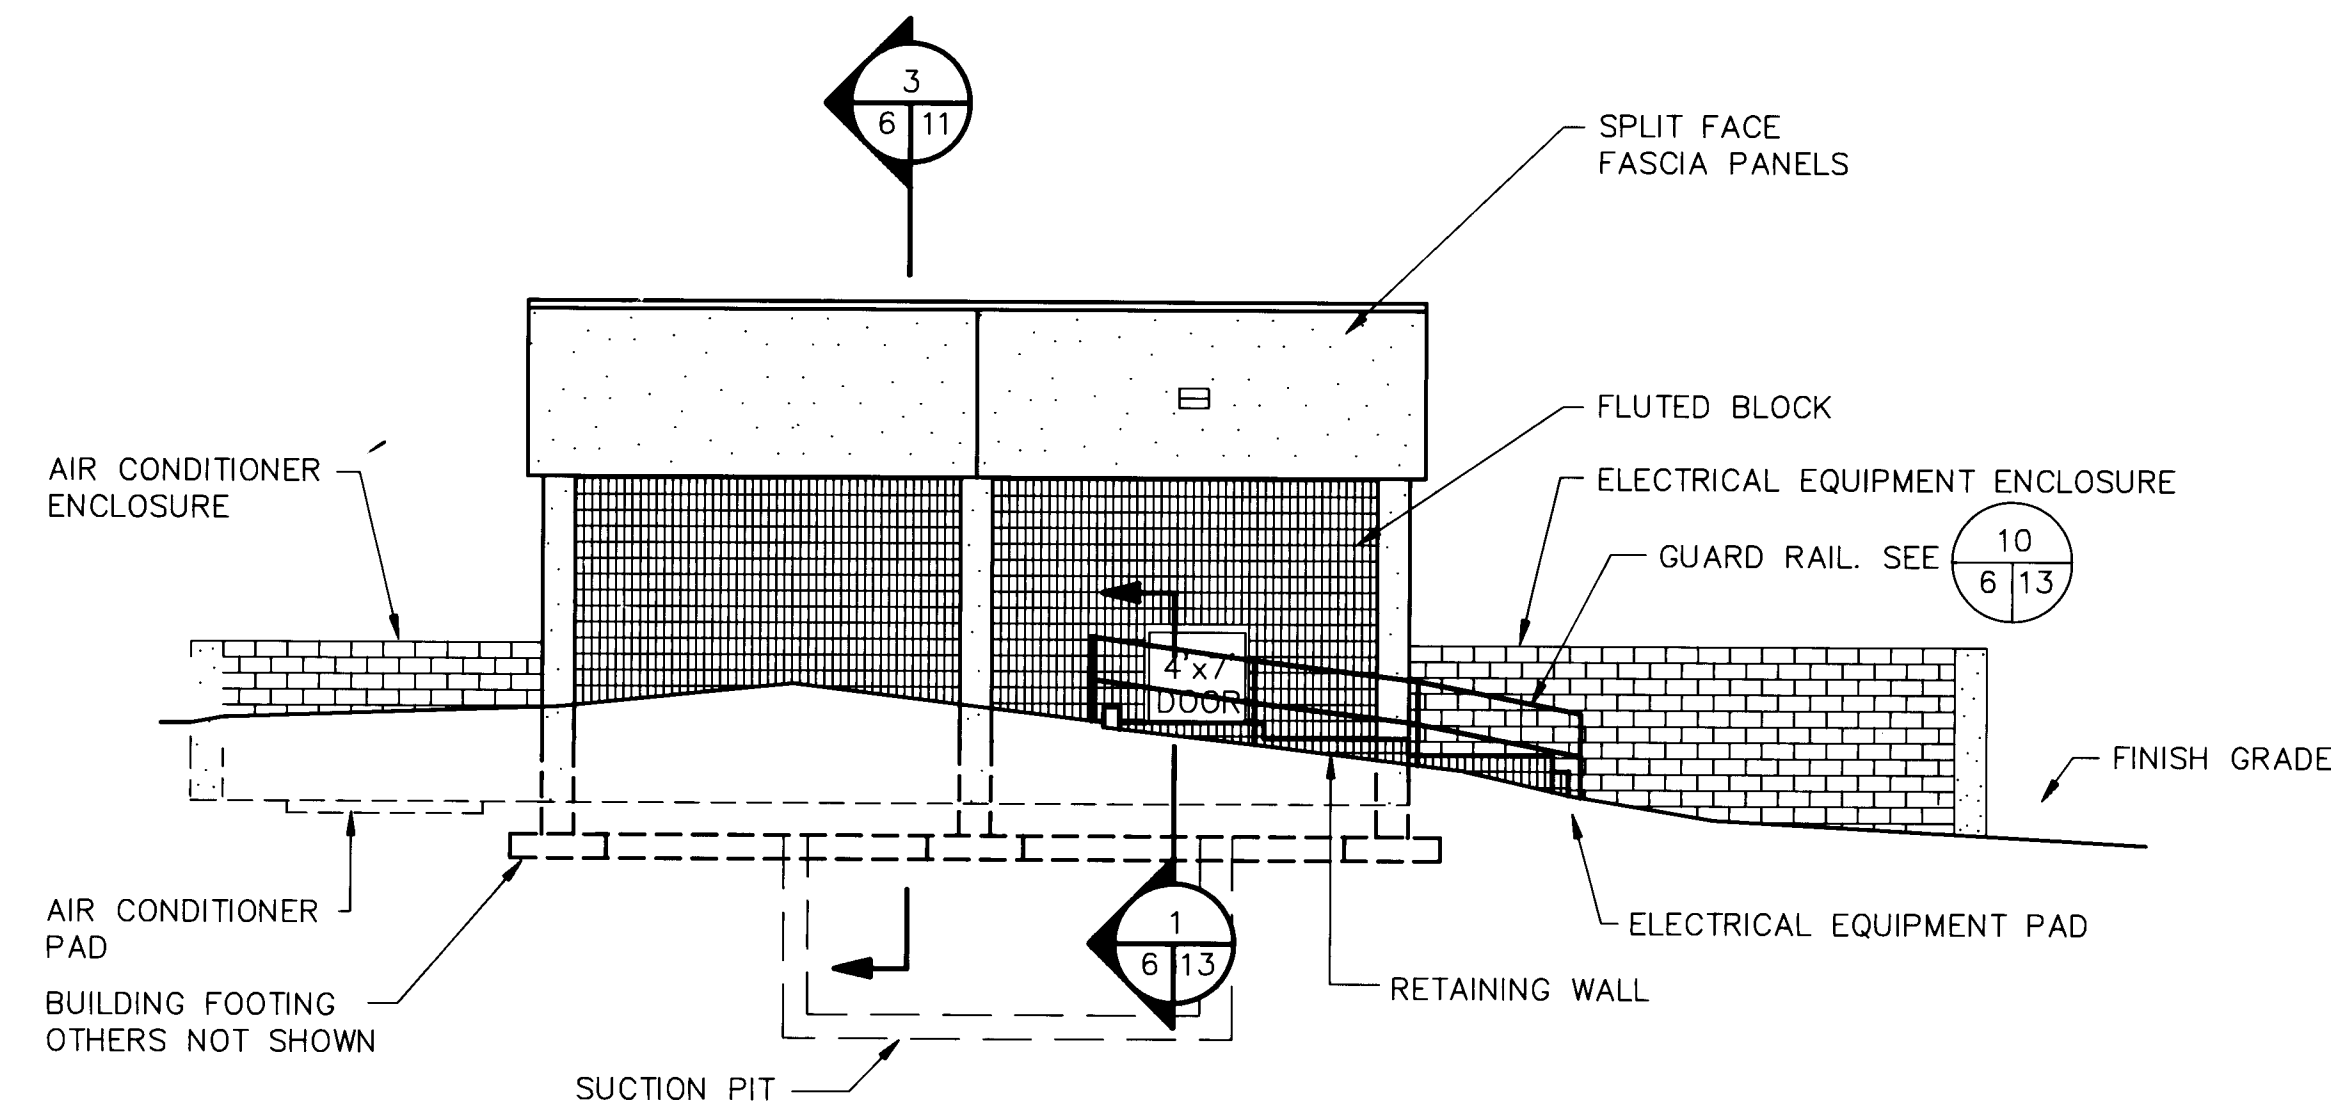


NORTH ELEVATION

SCALE: 1/8" = 1'-0"

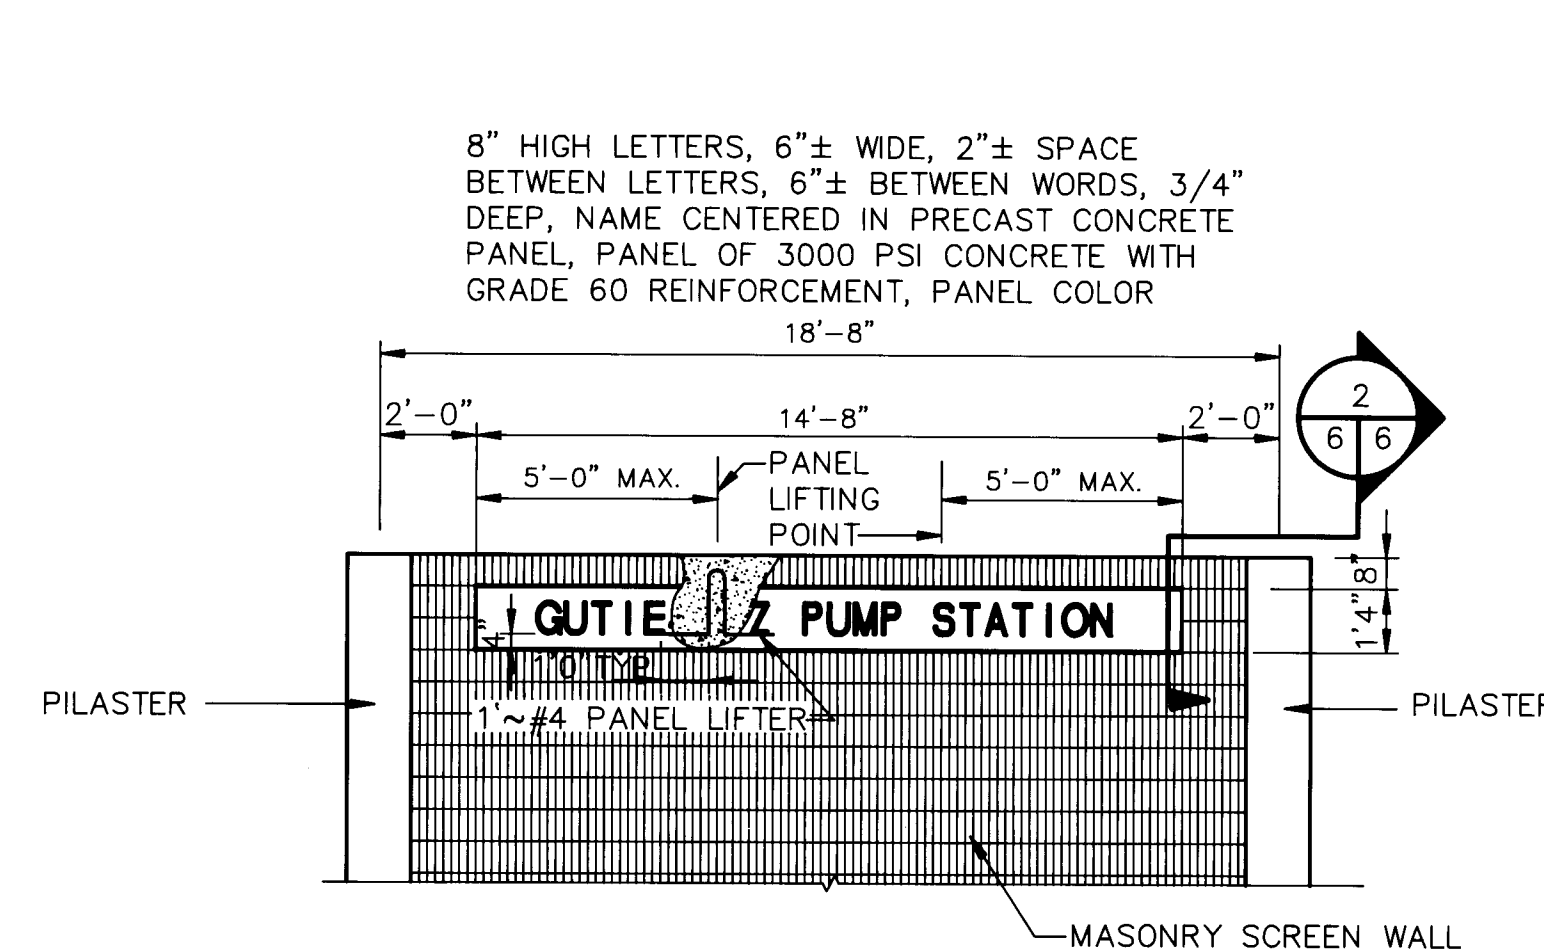

ELEVATION PRECAST PANEL

SCALE: 1/4" = 1'-0"

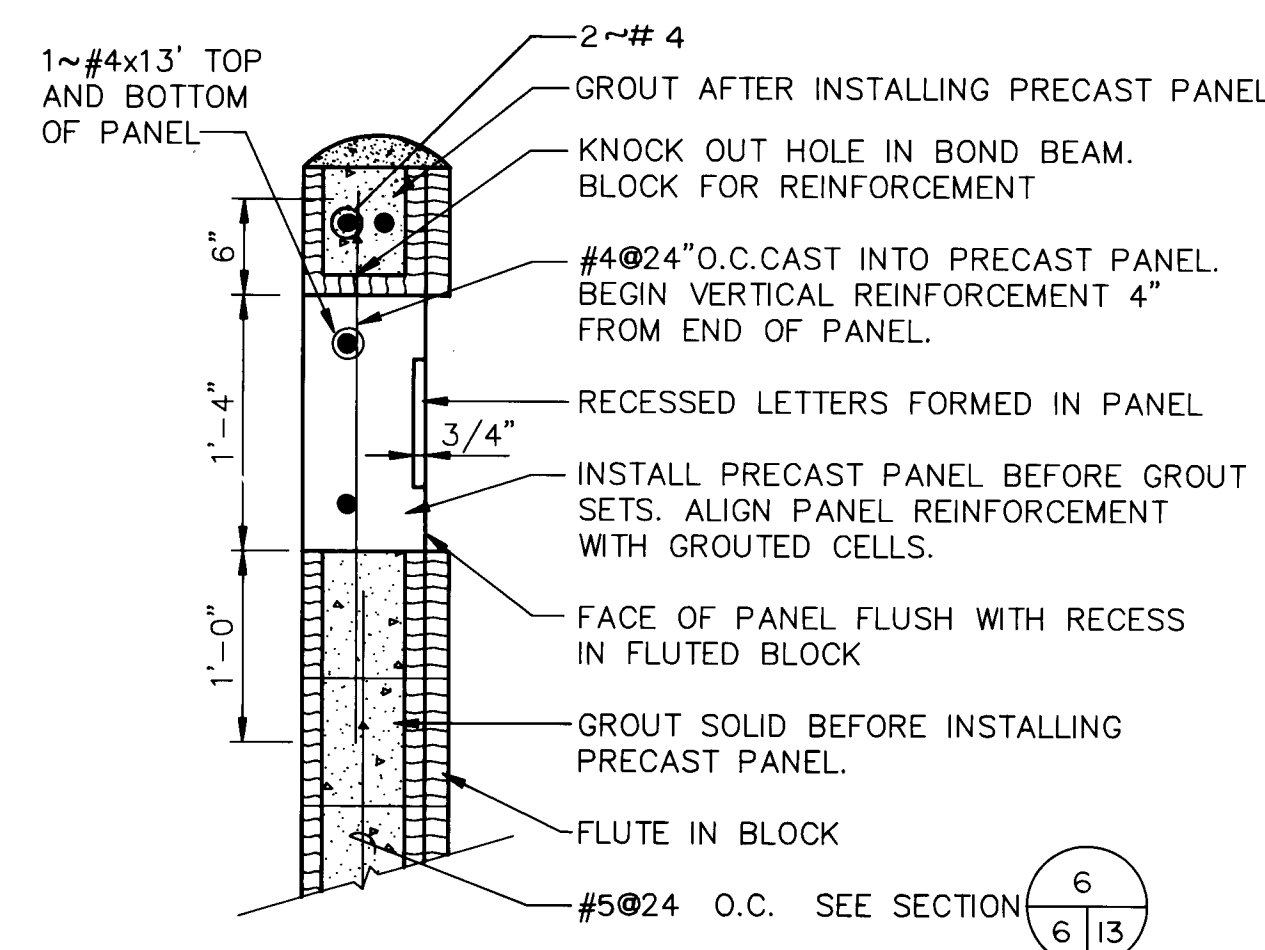

SECTION

SCALE: 1" = 1'-0"

NOTE: BLOCK COLOR SHALL BE COPPER
COLOR AS MANUFACTURED BY
CREGO BLOCK COMPANY, OR EQUAL.


26 333790 11-13-90

REVISIONS
FEB 1992

These drawings have been revised based
on field data and every reasonable attempt
has been made to depict conditions as
actually performed.

CITY OF ALBUQUERQUE PUBLIC WORKS DEPARTMENT ENGINEERING GROUP					
TITLE: GUTIERREZ PUMP STATION RECONSTRUCTION BUILDING ELEVATIONS					
APPROVALS	ENGINEER	DATE	APPROVALS	ENGINEER	DATE
DRC CHAIRMAN	<i>[Signature]</i>	4-15-90	WATER	<i>R.W. Kane</i>	11-13-90
TRANSPORTATION	<i>N/A RWD</i>	11-16-90	WASTE WATER	<i>R.W. Kane</i>	11-13-90
HYDROLOGY	<i>LDM</i>	11-15-90			
PROJECT NO. 333790		MAP NO. F-22	SHEET 6 OF 15		

AS BUILT INFORMATION		BENCH MARKS		SURVEY INFORMATION		ENGINEER'S SEAL	
CONTRACTOR	MCC Construction Co.	THE STATION IS AN ACS BRASS TABLET STAMPED	THE STATION IS AN ACS BRASS TABLET STAMPED	DATE	5/90	NO.	1
WORK STARTED BY	ALBUQUERQUE	"10-E22A" LOCATED ON THE NORTH CURB OF	"10-E22A" LOCATED ON THE NORTH CURB OF	BY	ALBUQ. SURVEY	REMARKS	
WORK STOPPED BY	ALBUQUERQUE	MONTGOMERY BLVD. N.E. AT THE INTERSECTION	MONTGOMERY BLVD. N.E. AT THE INTERSECTION	DATE	5/90	REVISIONS	
FIELD LOCATION BY	ALBUQUERQUE	OF MONTGOMERY BLVD. AND SHENANDOAH PL.	OF MONTGOMERY BLVD. AND SHENANDOAH PL.	DESIGNED BY	E. LIVINGSTON	DESIGN	
DRAWINGS CORRECTED BY	ALBUQUERQUE	N.E. ELEVATION=5831.93 (1ST ORDER)	N.E. ELEVATION=5831.93 (1ST ORDER)	DRAWN BY	LH	REVISIONS	
DATE	2/92			CHECKED BY	K.W. WELTY	REVISIONS	
MICRO-FILM INFORMATION							
RECORDED BY		NO.		DATE	JUNE 1990	DATE	JUNE 1990
				DATE	JUNE 1990	DATE	JUNE 1990

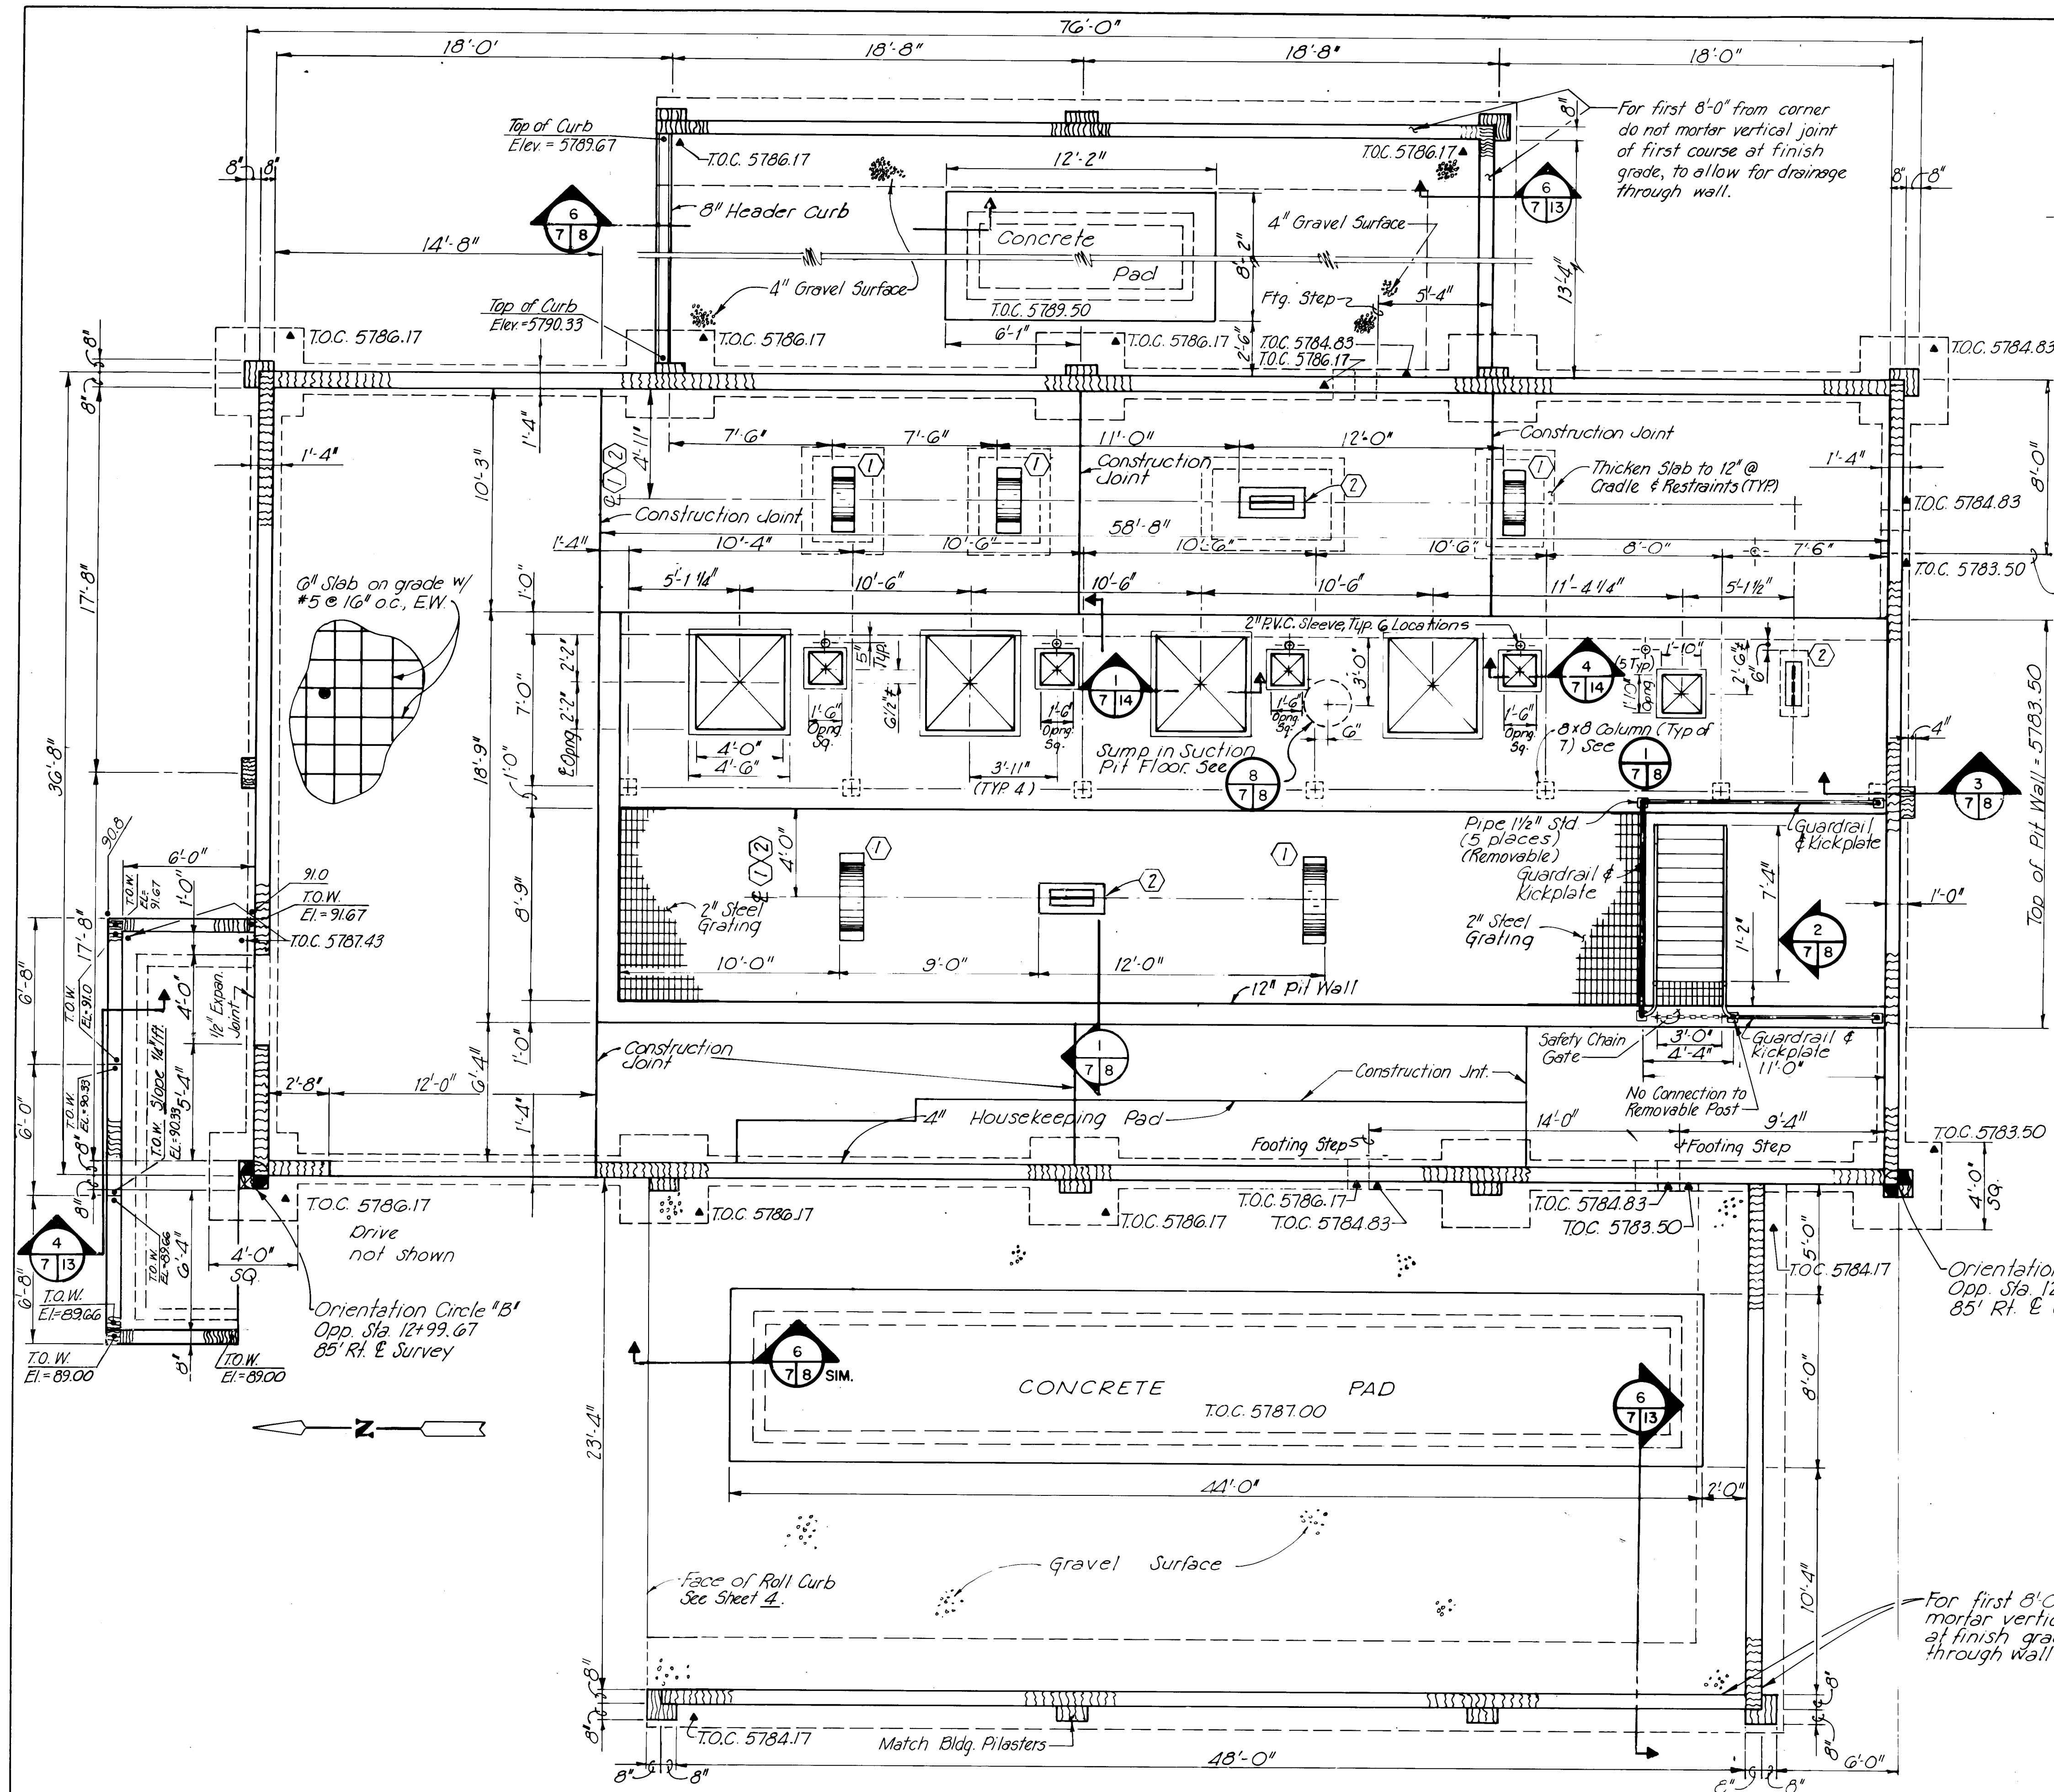

LEGEND

- T.O.C. Top of Concrete
 (1) Pipe Gracle See 7/15
 (2) Longitudinal Restraints See 7/15
 CMU
 Footing Outline See Sheets 11 & 13 for Details
 Floor Drain

NOTE

- ± dimensions to be coordinated with piping and equipment furnished
 4" housekeeping pad to be 3" larger than equipment furnished

Footing Step See 7/10 (TYP)

MASONRY SPECIAL INSPECTION NOTES:

- A. Special inspection is required during preparation of masonry, wall prisms, sampling and placing of all masonry units, placement of reinforcement, inspection of grout space, immediately prior to closing of cleanouts, and during all grouting operations.
 B. Some inspections may be made on a periodic basis and satisfy the requirements of continuous inspection, provided this periodic scheduled inspection is performed as approved by the building official.

GENERAL NOTES

- A. Design Loads:
 1. Gravity - Roof live = 20 psf
 Roof dead = 15 psf
 Conc. Floor live = 950 lbs
 Unit Floor live = 100 psf
 2. Seismic - 1988 UBC Zone 2B
 3. Wind - Basic Wind Speed 75mph
 -I = 1.0
 -qs = 15 psf

- B. Allowable Soil Bearing - 2000 psf

FOUNDATION NOTES

- A. Building footings and interior slab shall be founded on a minimum of 2 feet Engineered Fill. Suction Pit wall shall not require overexcavation.
 B. Exterior miscellaneous slabs shall not require Engineered Fill.

CONCRETE NOTES

- A. Min. 28 day compressive strength f'c = 3000 psi
 B. Reinforcing shall conform to ASTM A615, A616, A617 grade 60. Stirrups and ties grade 40.
 C. Reinforcing continuous around corners
 D. Exposed concrete chamfer 1/4"
 E. Keyway: Depth 1 1/2", Width 1/3 of member.
 F. Provide 1" x 5" x 4" at each corner all openings
 G. Floor slab shall be placed in a checkerboard fashion.

MASONRY NOTES

- A. CMU shall be grade N-1 moisture control with f'm = 1500 psi.
 B. Continue bond beam reinforcing around corners
 C. Provide 1" x 5" jamb and head of all doors unless detailed otherwise
 D. Mortar Type 'A' f'm = 2500 psi
 E. Reinforcing shall conform to ASTM A615, A616, A617, grade 40
 F. Special Inspection Required: See Masonry Special Inspection Notes, This Sheet
STEEL NOTES
 A. All beams, angles and misc. shapes shall be ASTM A36.
 B. All welds not shown AISC minimums.
 C. All connection bolts shall be 3/4" ASTM A325 except as noted.
 D. Anchor bolts shall be ASTM A307.

LANDSCAPE GRAVEL

- A. Sterilize soil prior to placing gravel.
 B. Gravel thickness 4" minimum.


FOUNDATION PLAN

SCALE: 1/4" = 1'-0"
 Station Finish Floor Elevation = 5787.50
 Suction Pit Finish Floor Elev = 5778.50


RECORD DRAWING
 FEB 1992

These drawings have been revised based on field data and every reasonable survey has been made to depict construction as actually performed.


CITY OF ALBUQUERQUE PUBLIC WORKS DEPARTMENT ENGINEERING GROUP					
TITLE: GUTIERREZ PUMP STATION RECONSTRUCTION					
FOUNDATION PLAN					
APPROVALS	ENGINEER	DATE	APPROVALS	ENGINEER	DATE
DRC CHAIRMAN			WATER	R.W. Kane	11-13-90
TRANSPORTATION	K.A. RHO	11-16-90	WASTE WATER	R.W. Kane	11-13-90
HYDROLOGY	LDH	11-15-90			
PROJECT NO.	3337 90	MAP NO.	F-22	SHEET	7 OF 15

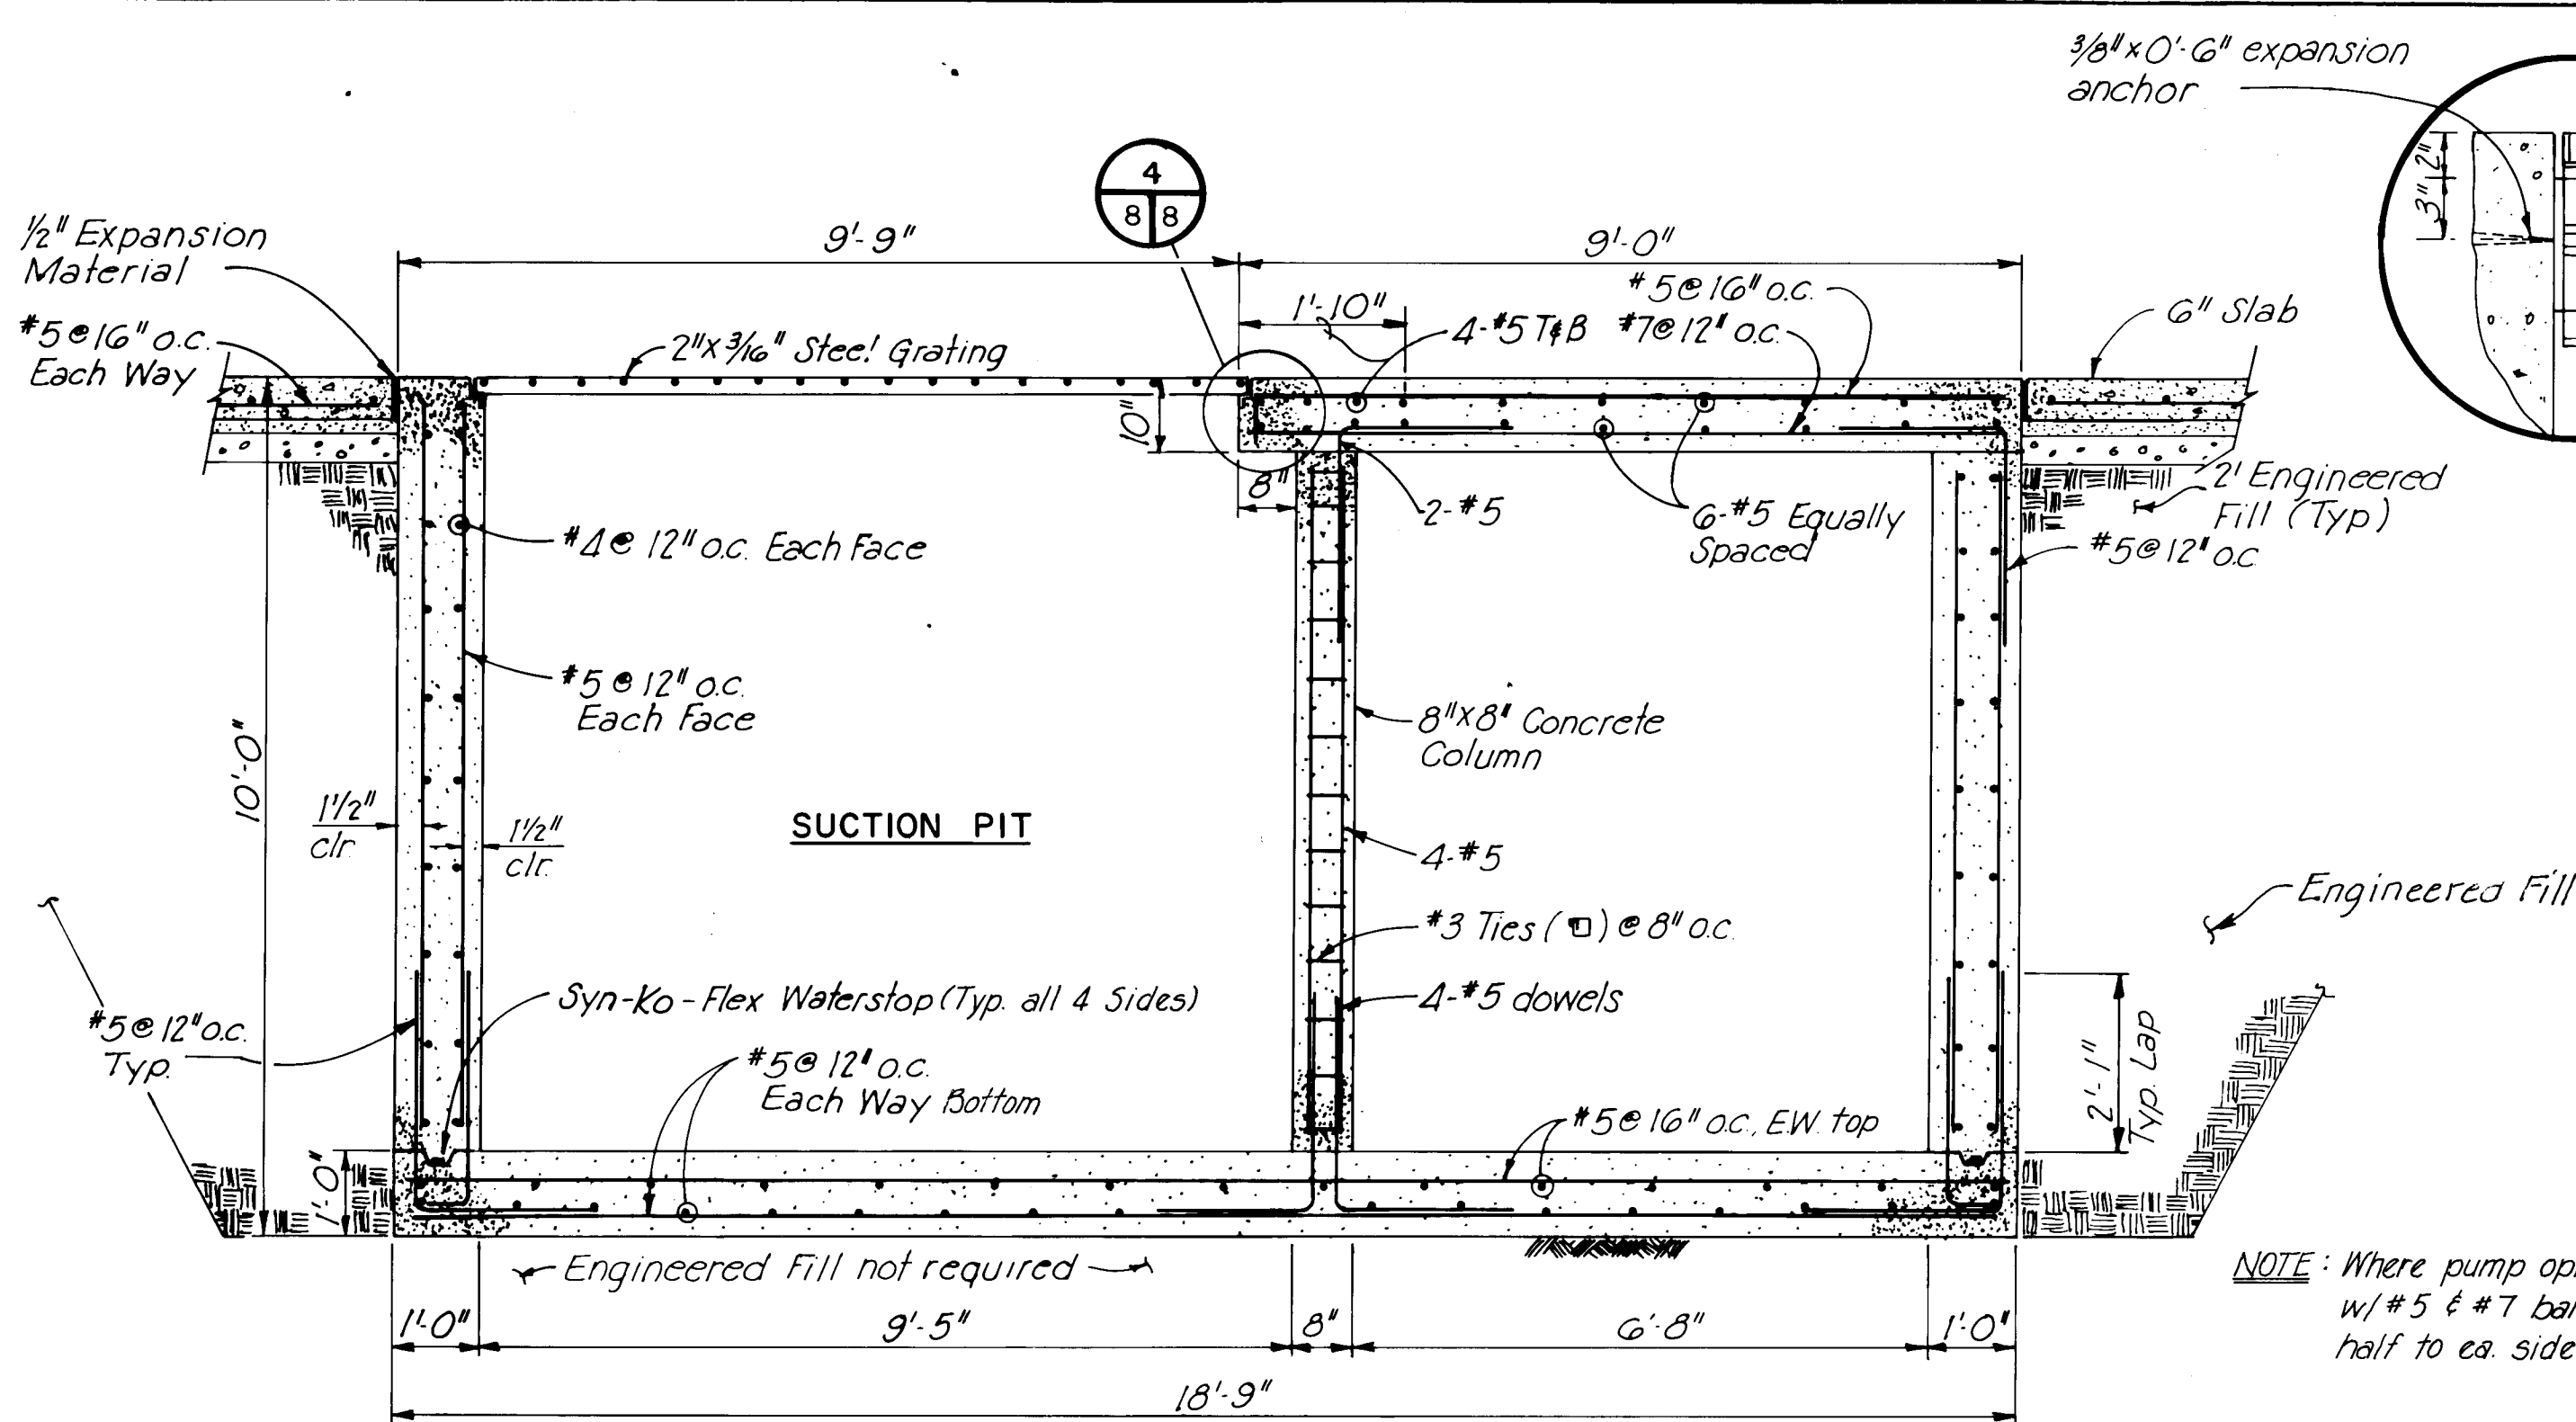


1 SUCTION PIT TRANSVERSE SECTION
SCALE: 1/2" = 1'-0"

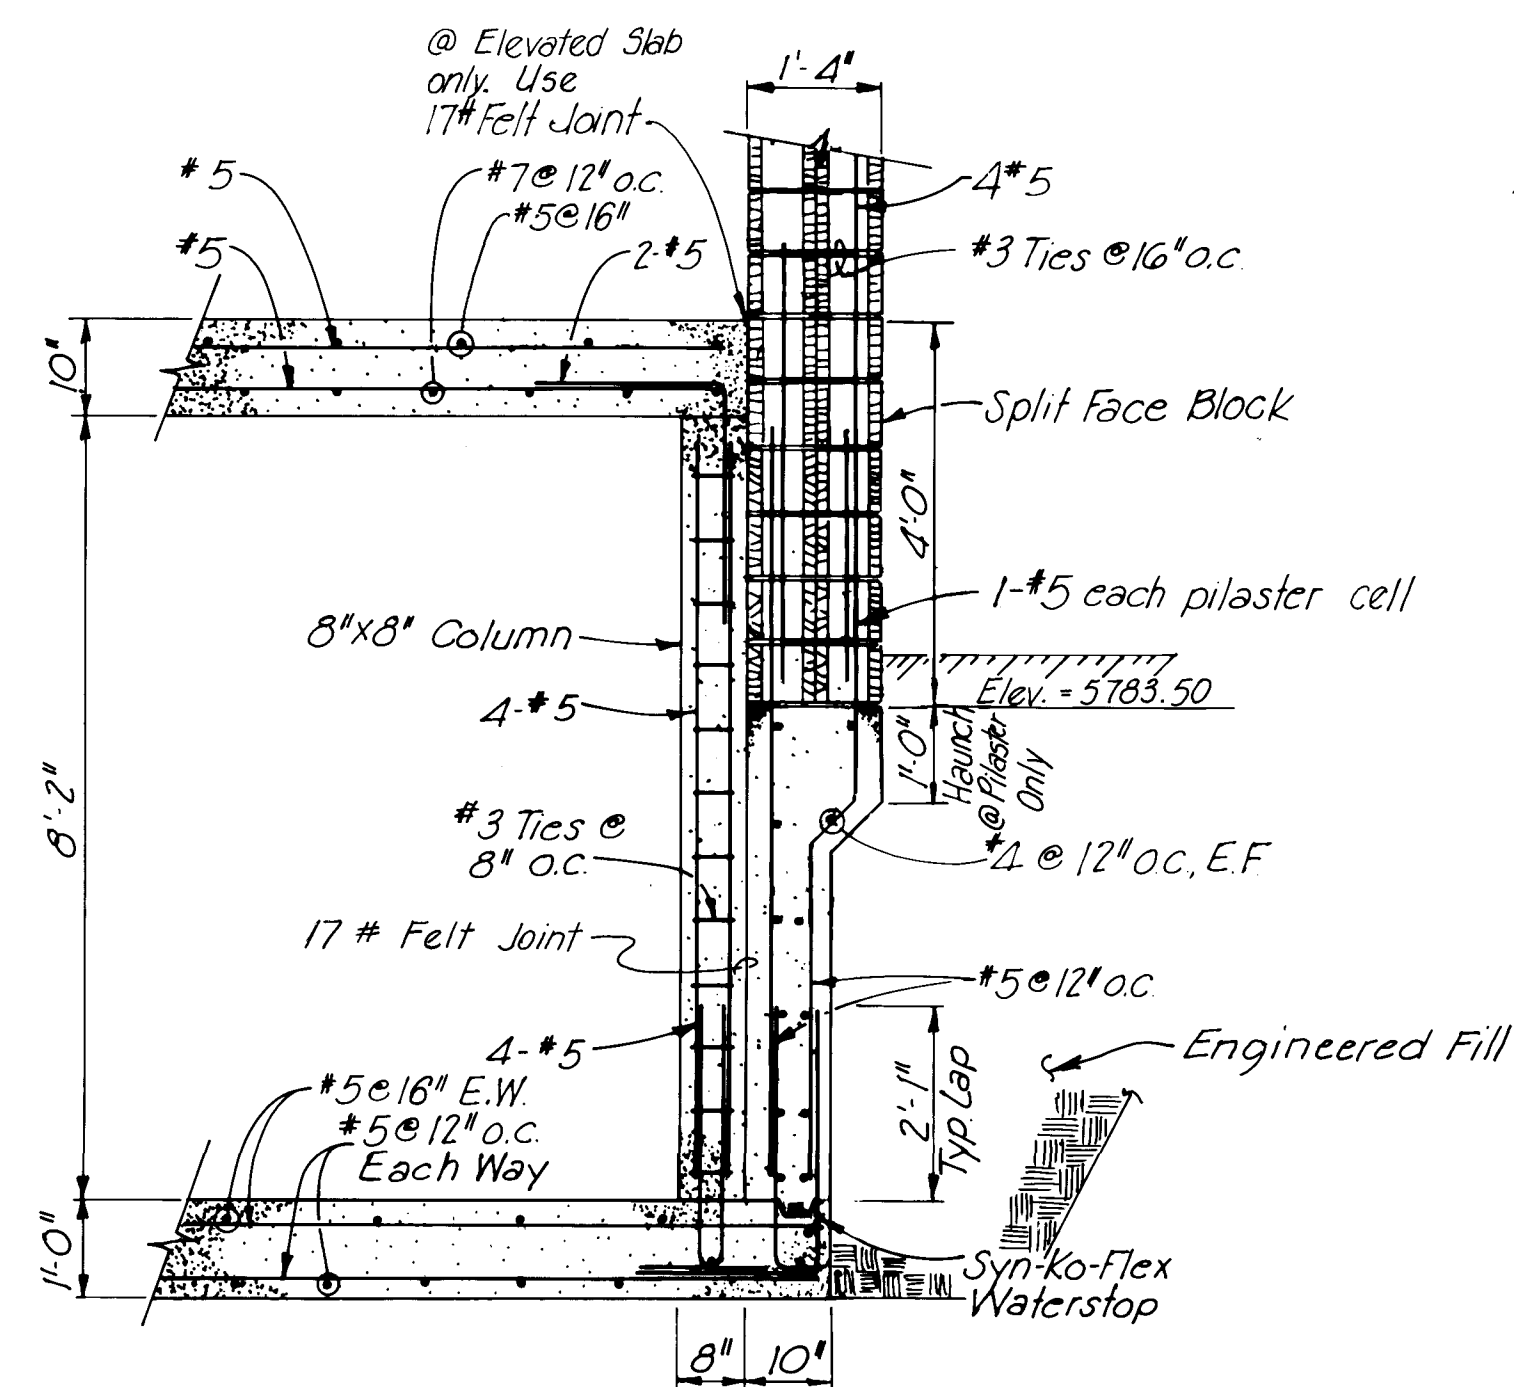


3 PIT WALL
SCALE: 1/2" = 1'-0"

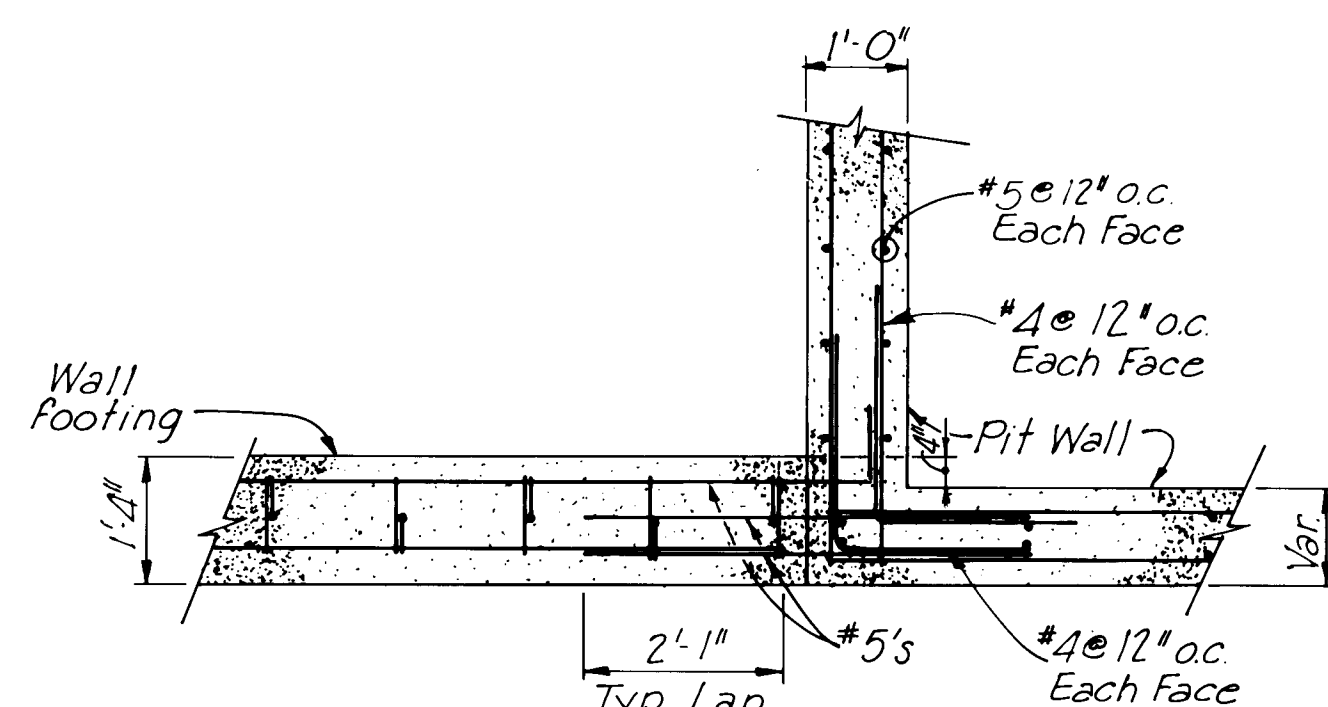

7 FOOTING/PIT TIE-PLAN SECTION
SCALE: 1/2" = 1'-0"

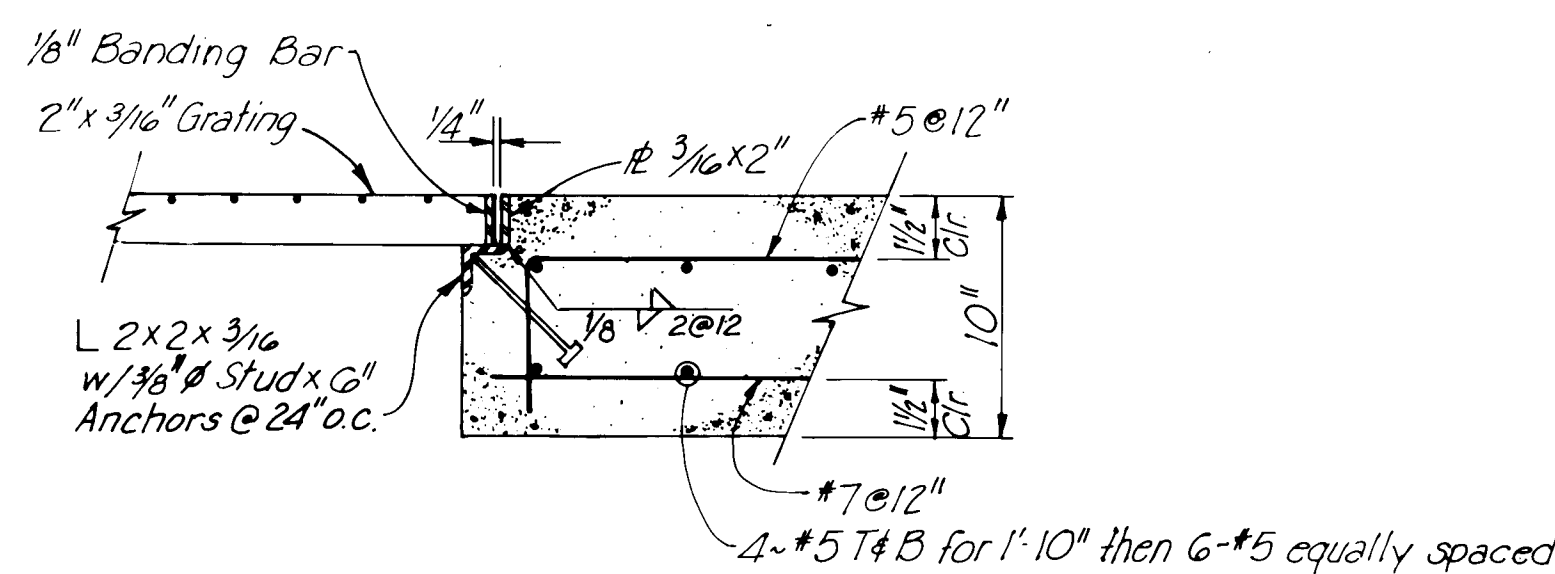


4 EDGE DETAIL
SCALE: 1 1/2" = 1'-0"

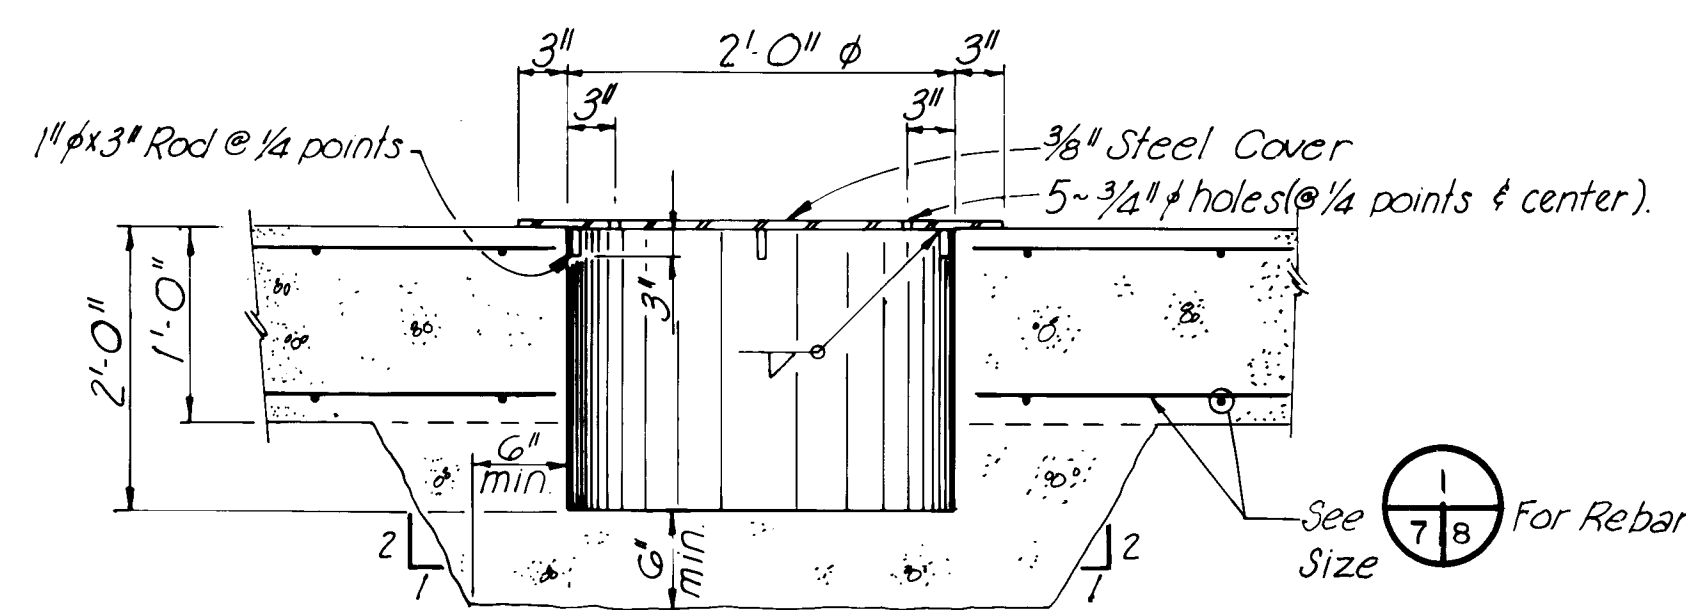


8 SUMP PIT DETAIL
NOT TO SCALE


NOTE: Where pump piping conflicts w/ #5 & #7 bar; place one-half to ea. side of opening.

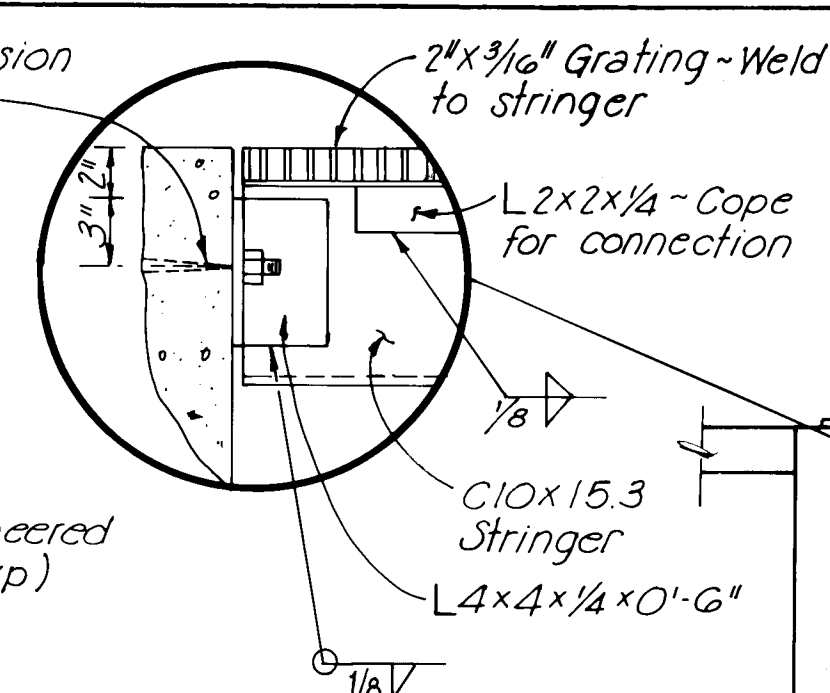


2 LADDER ELEVATION
SCALE: 1/2" = 1'-0"

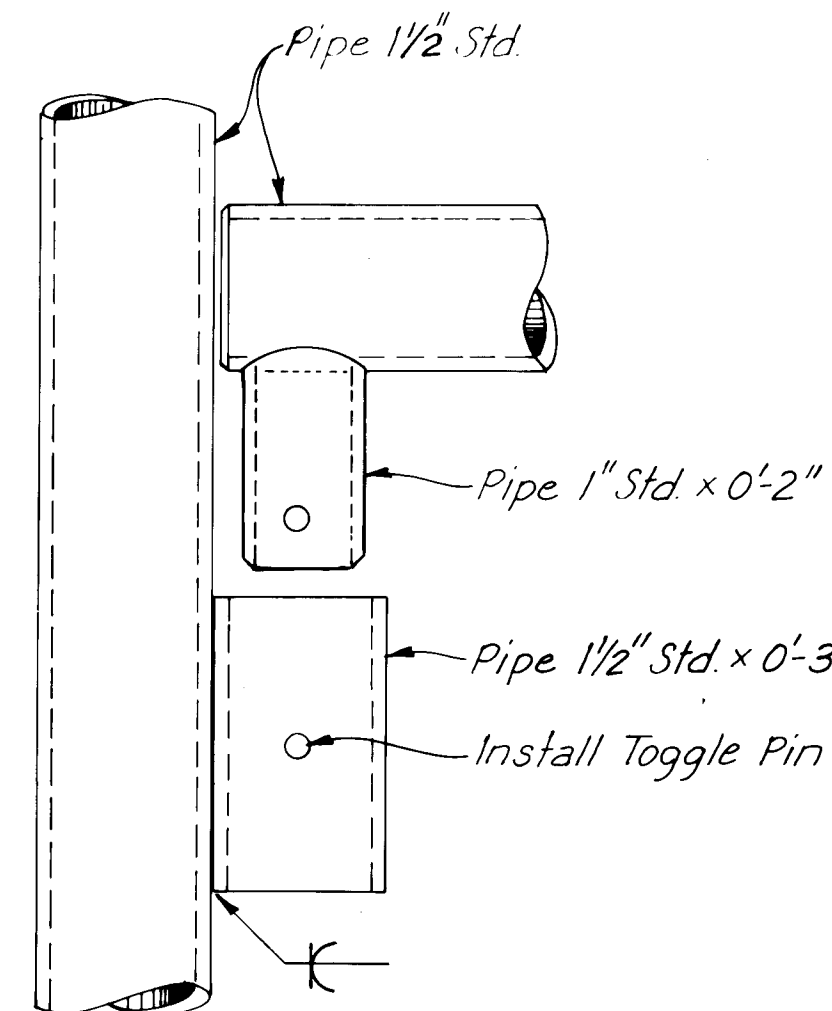


5 REMOVABLE GUARDRAIL CONNECTION
N.T.S.

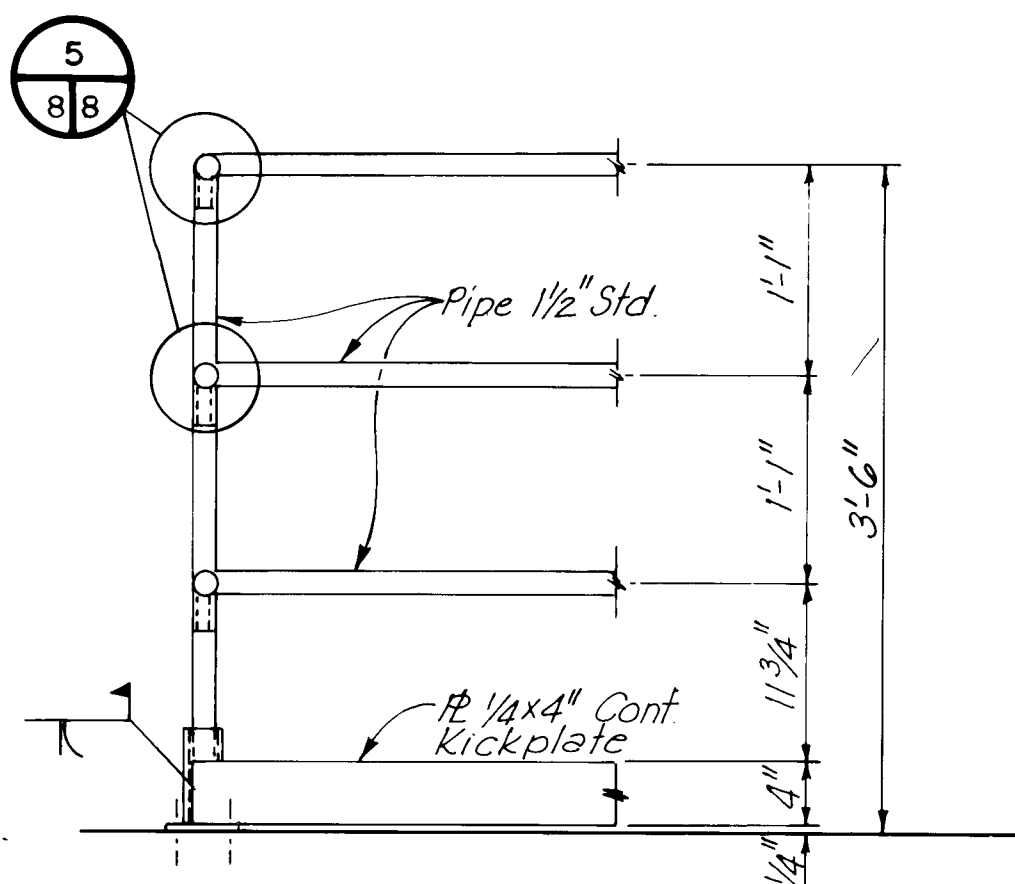


9 GUARDRAIL DETAILS
SCALE: AS SHOWN

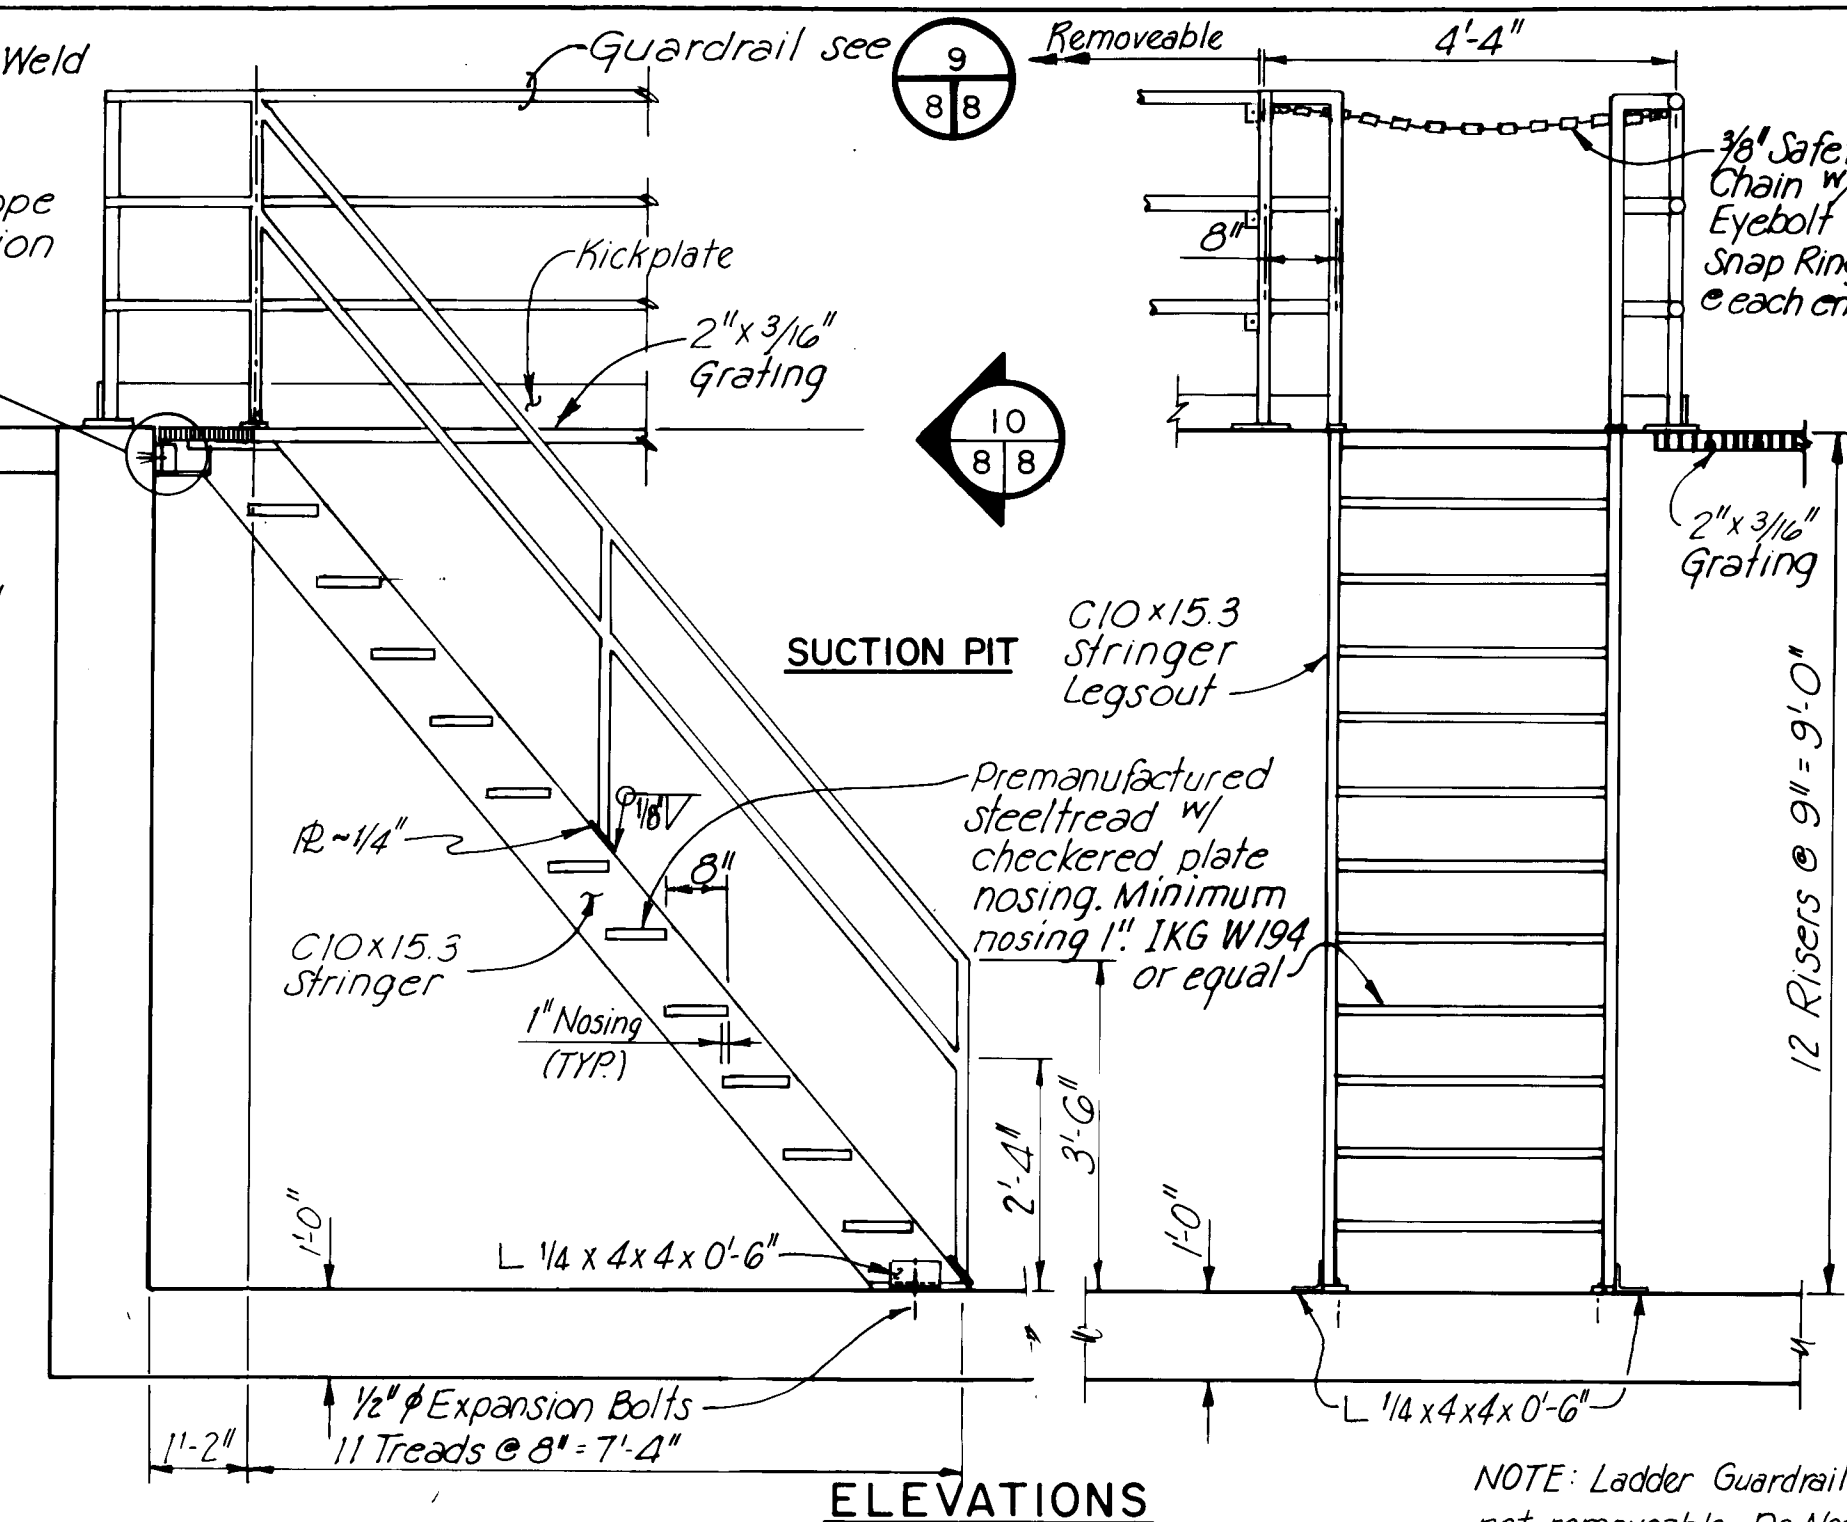

10 ELEVATION
SCALE: 1/2" = 1'-0"

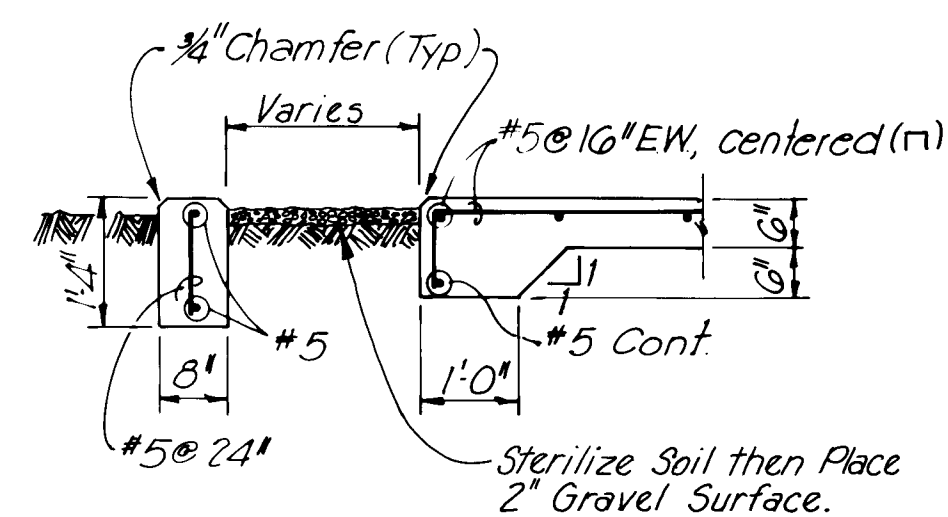


6 SECTION
SCALE: 1/2" = 1'-0"

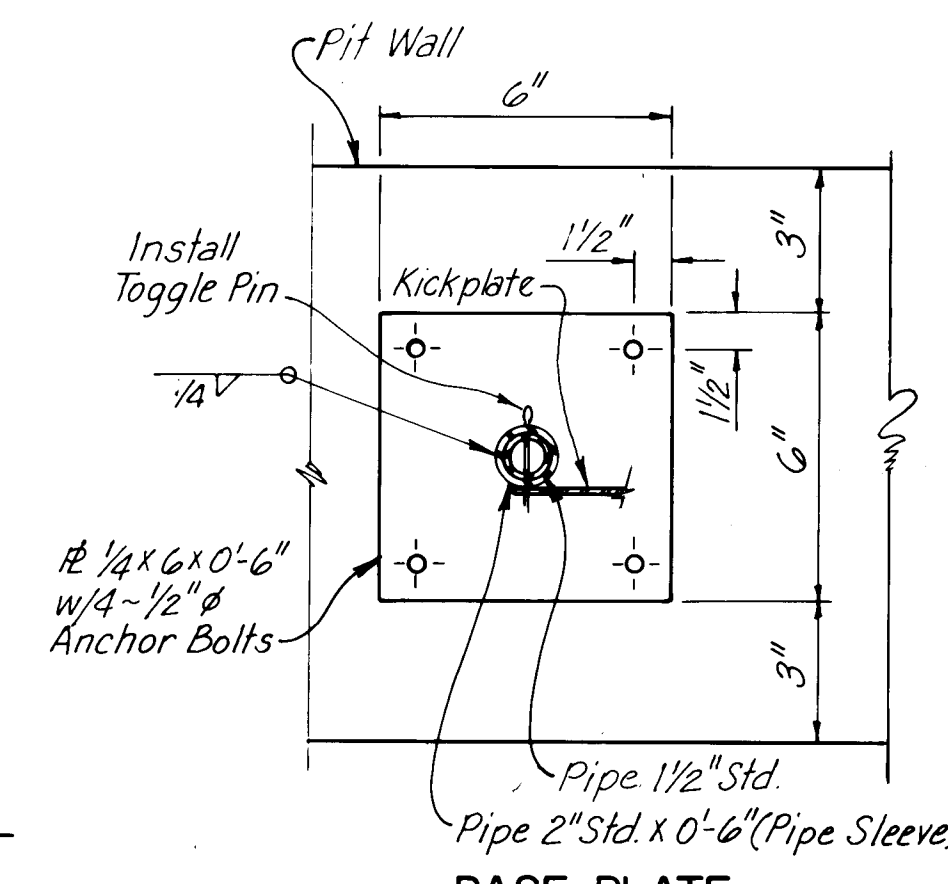

BASE PLATE
3" = 1'-0"


AS BUILT INFORMATION				BENCH MARKS				SURVEY INFORMATION				ENGINEER'S SEAL			
CONTRACTOR	DATE	BY	NO.	DATE	BY	NO.	DATE	DATE	BY	NO.	DATE	DATE	BY	NO.	
ALBUQUERQUE	11-13-90	R.W. Kane	11-13-90												
CITY OF ALBUQUERQUE PUBLIC WORKS DEPARTMENT ENGINEERING GROUP				TITLE: GUTIERREZ PUMP STATION RECONSTRUCTION FOUNDATION AND PIT DETAILS				APPROVALS				ENGINEER			
APPROVALS				ENGINEER				DATE				DATE			
DRG CHAIRMAN				11-13-90				WATER				R.W. Kane			
TRANSPORTATION				11-16-90				WASTE WATER				R.W. Kane			
HYDROLOGY				11-15-90											
PROJECT NO.				3337.90				MAP NO.				F-22			
SHEET				8				OF				15			

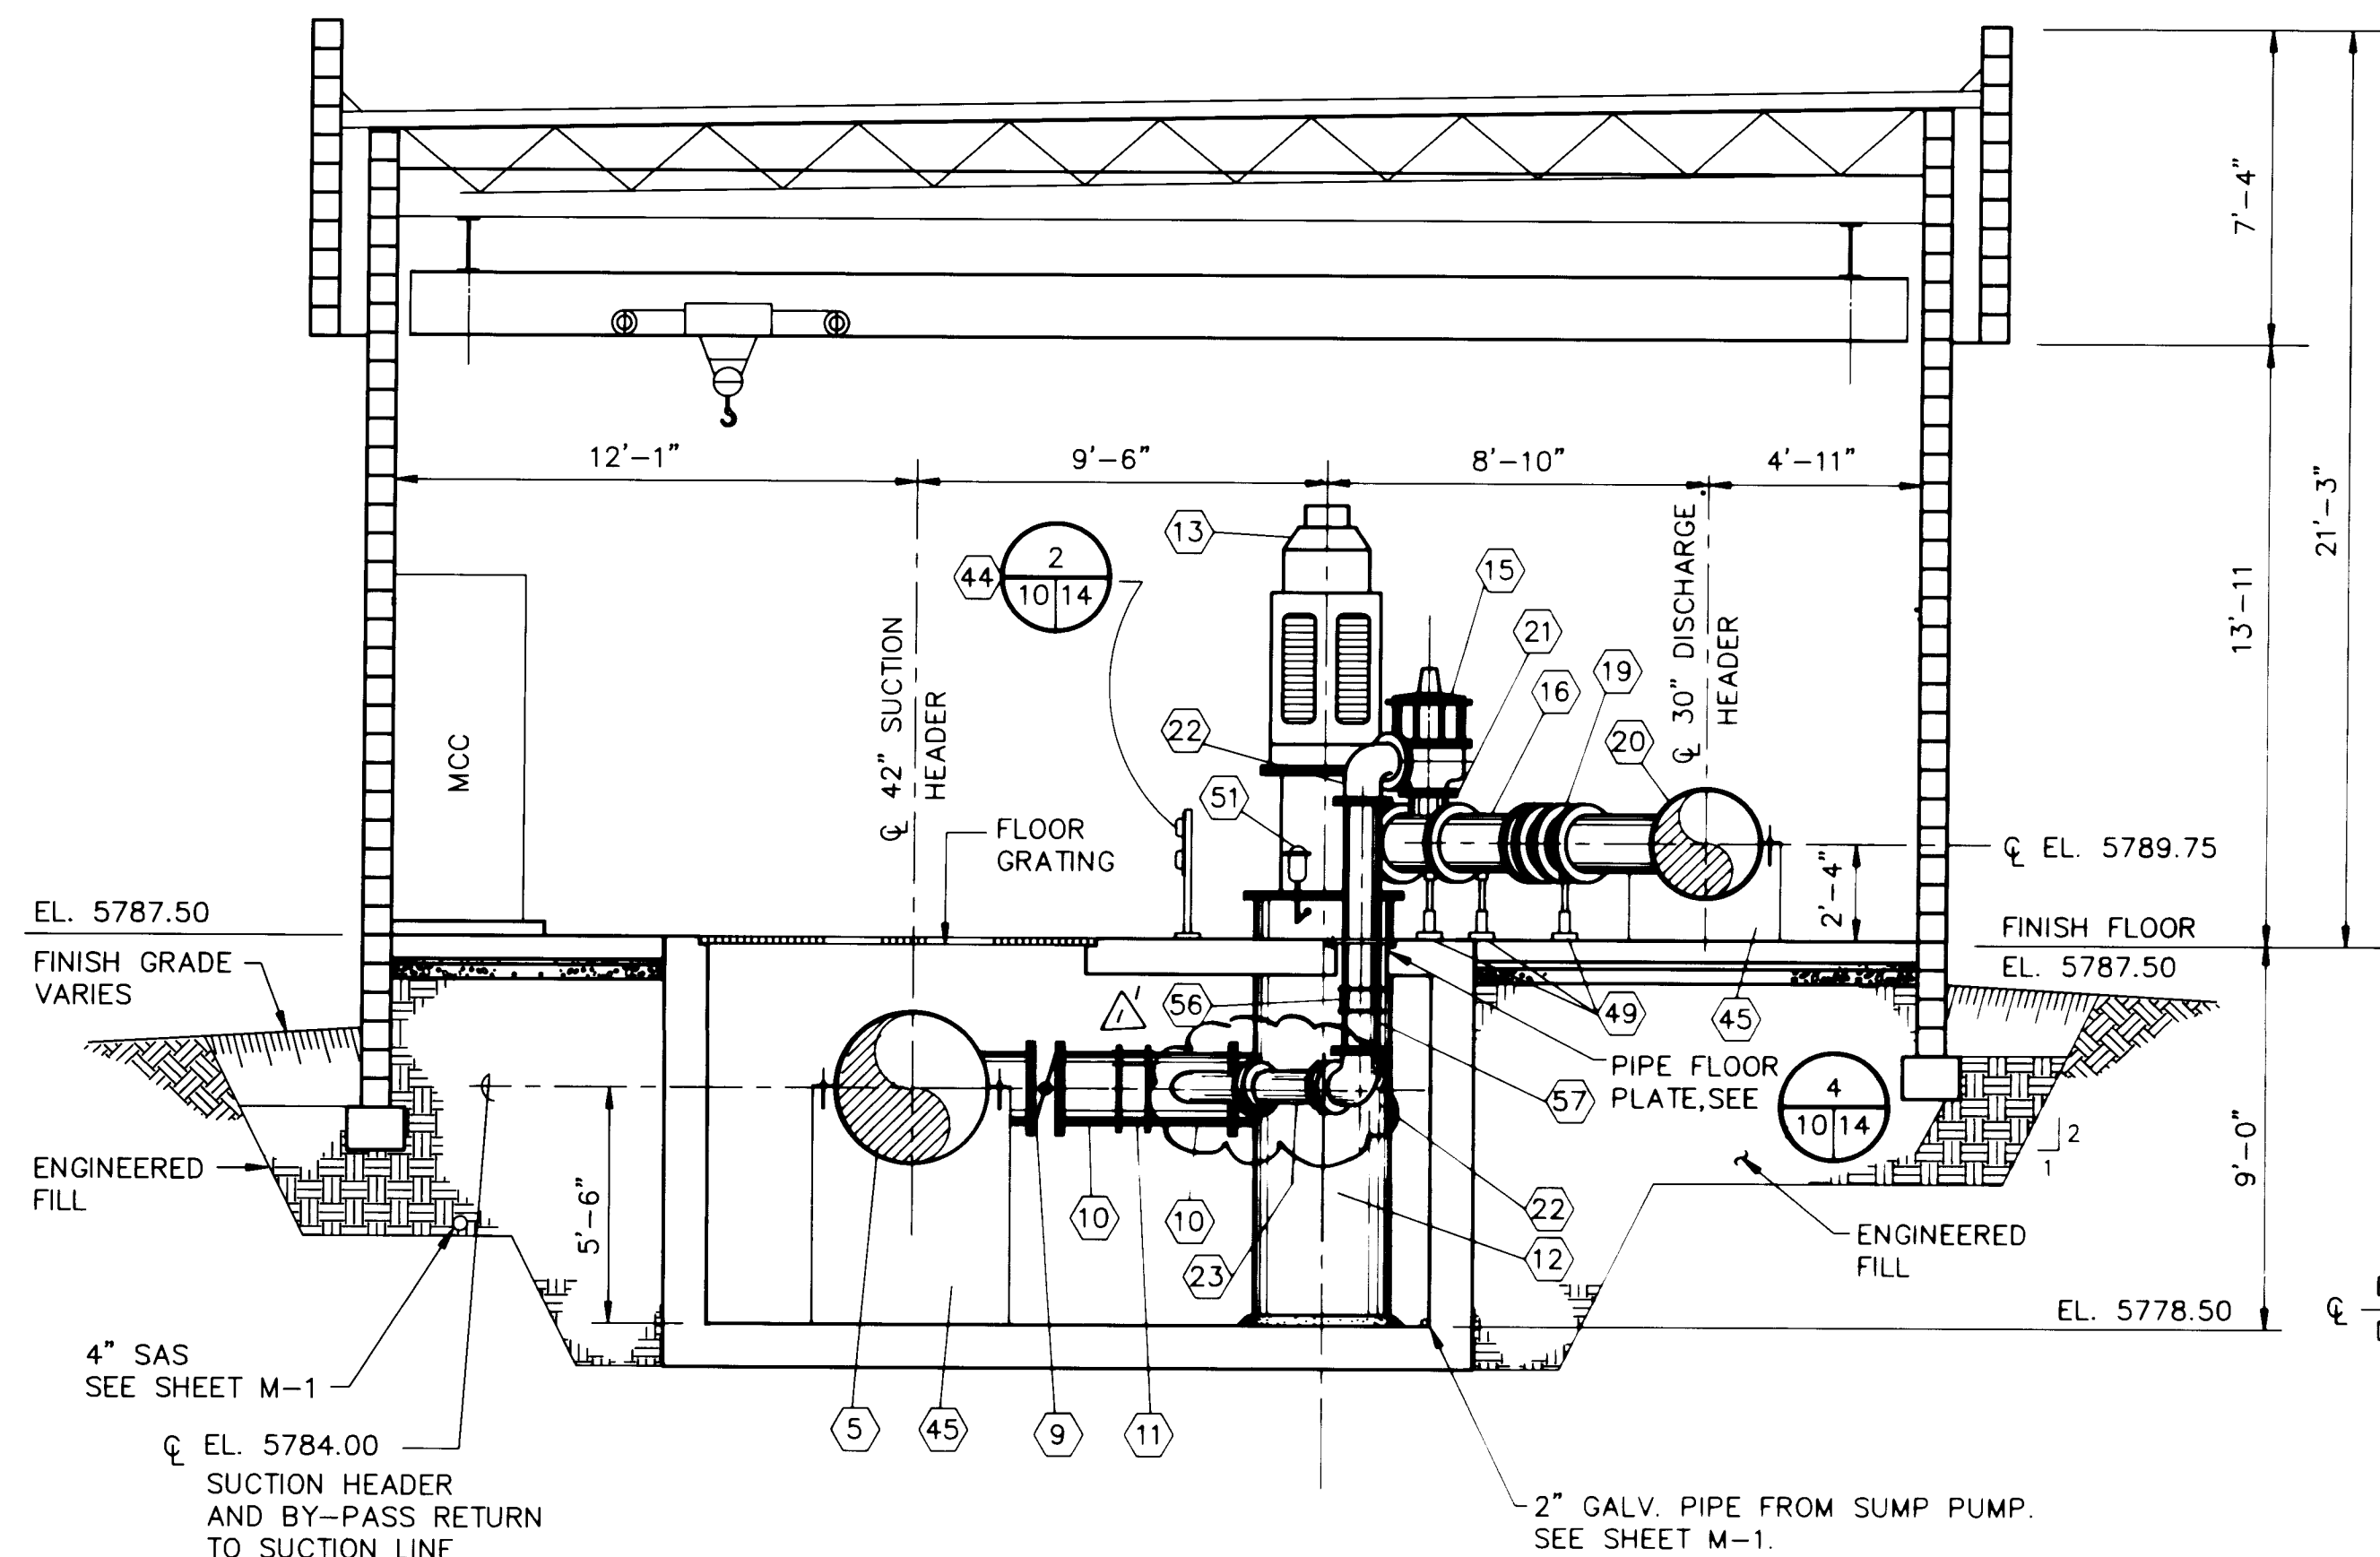

1
9/10

SECTION


SCALE: 1/4" = 1'-0"

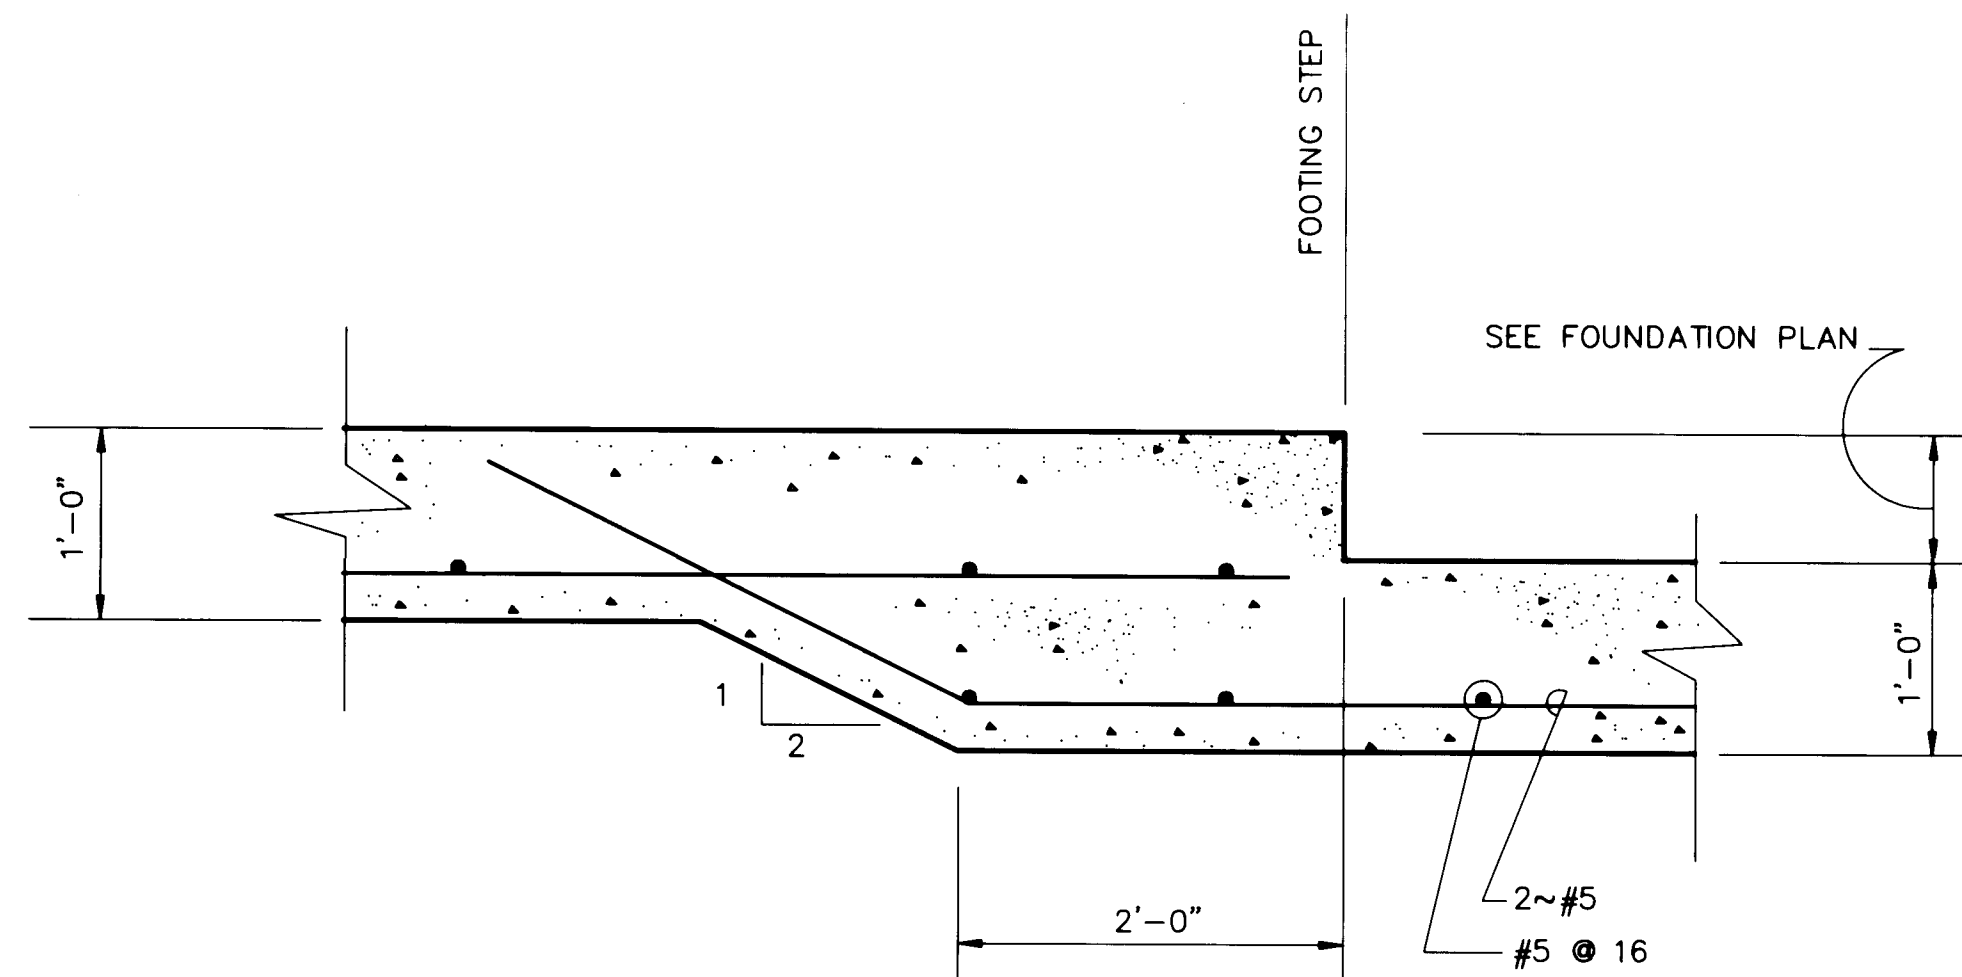

3
7/10

FOOTING STEP DETAIL

SCALE: 1" = 1'-0"

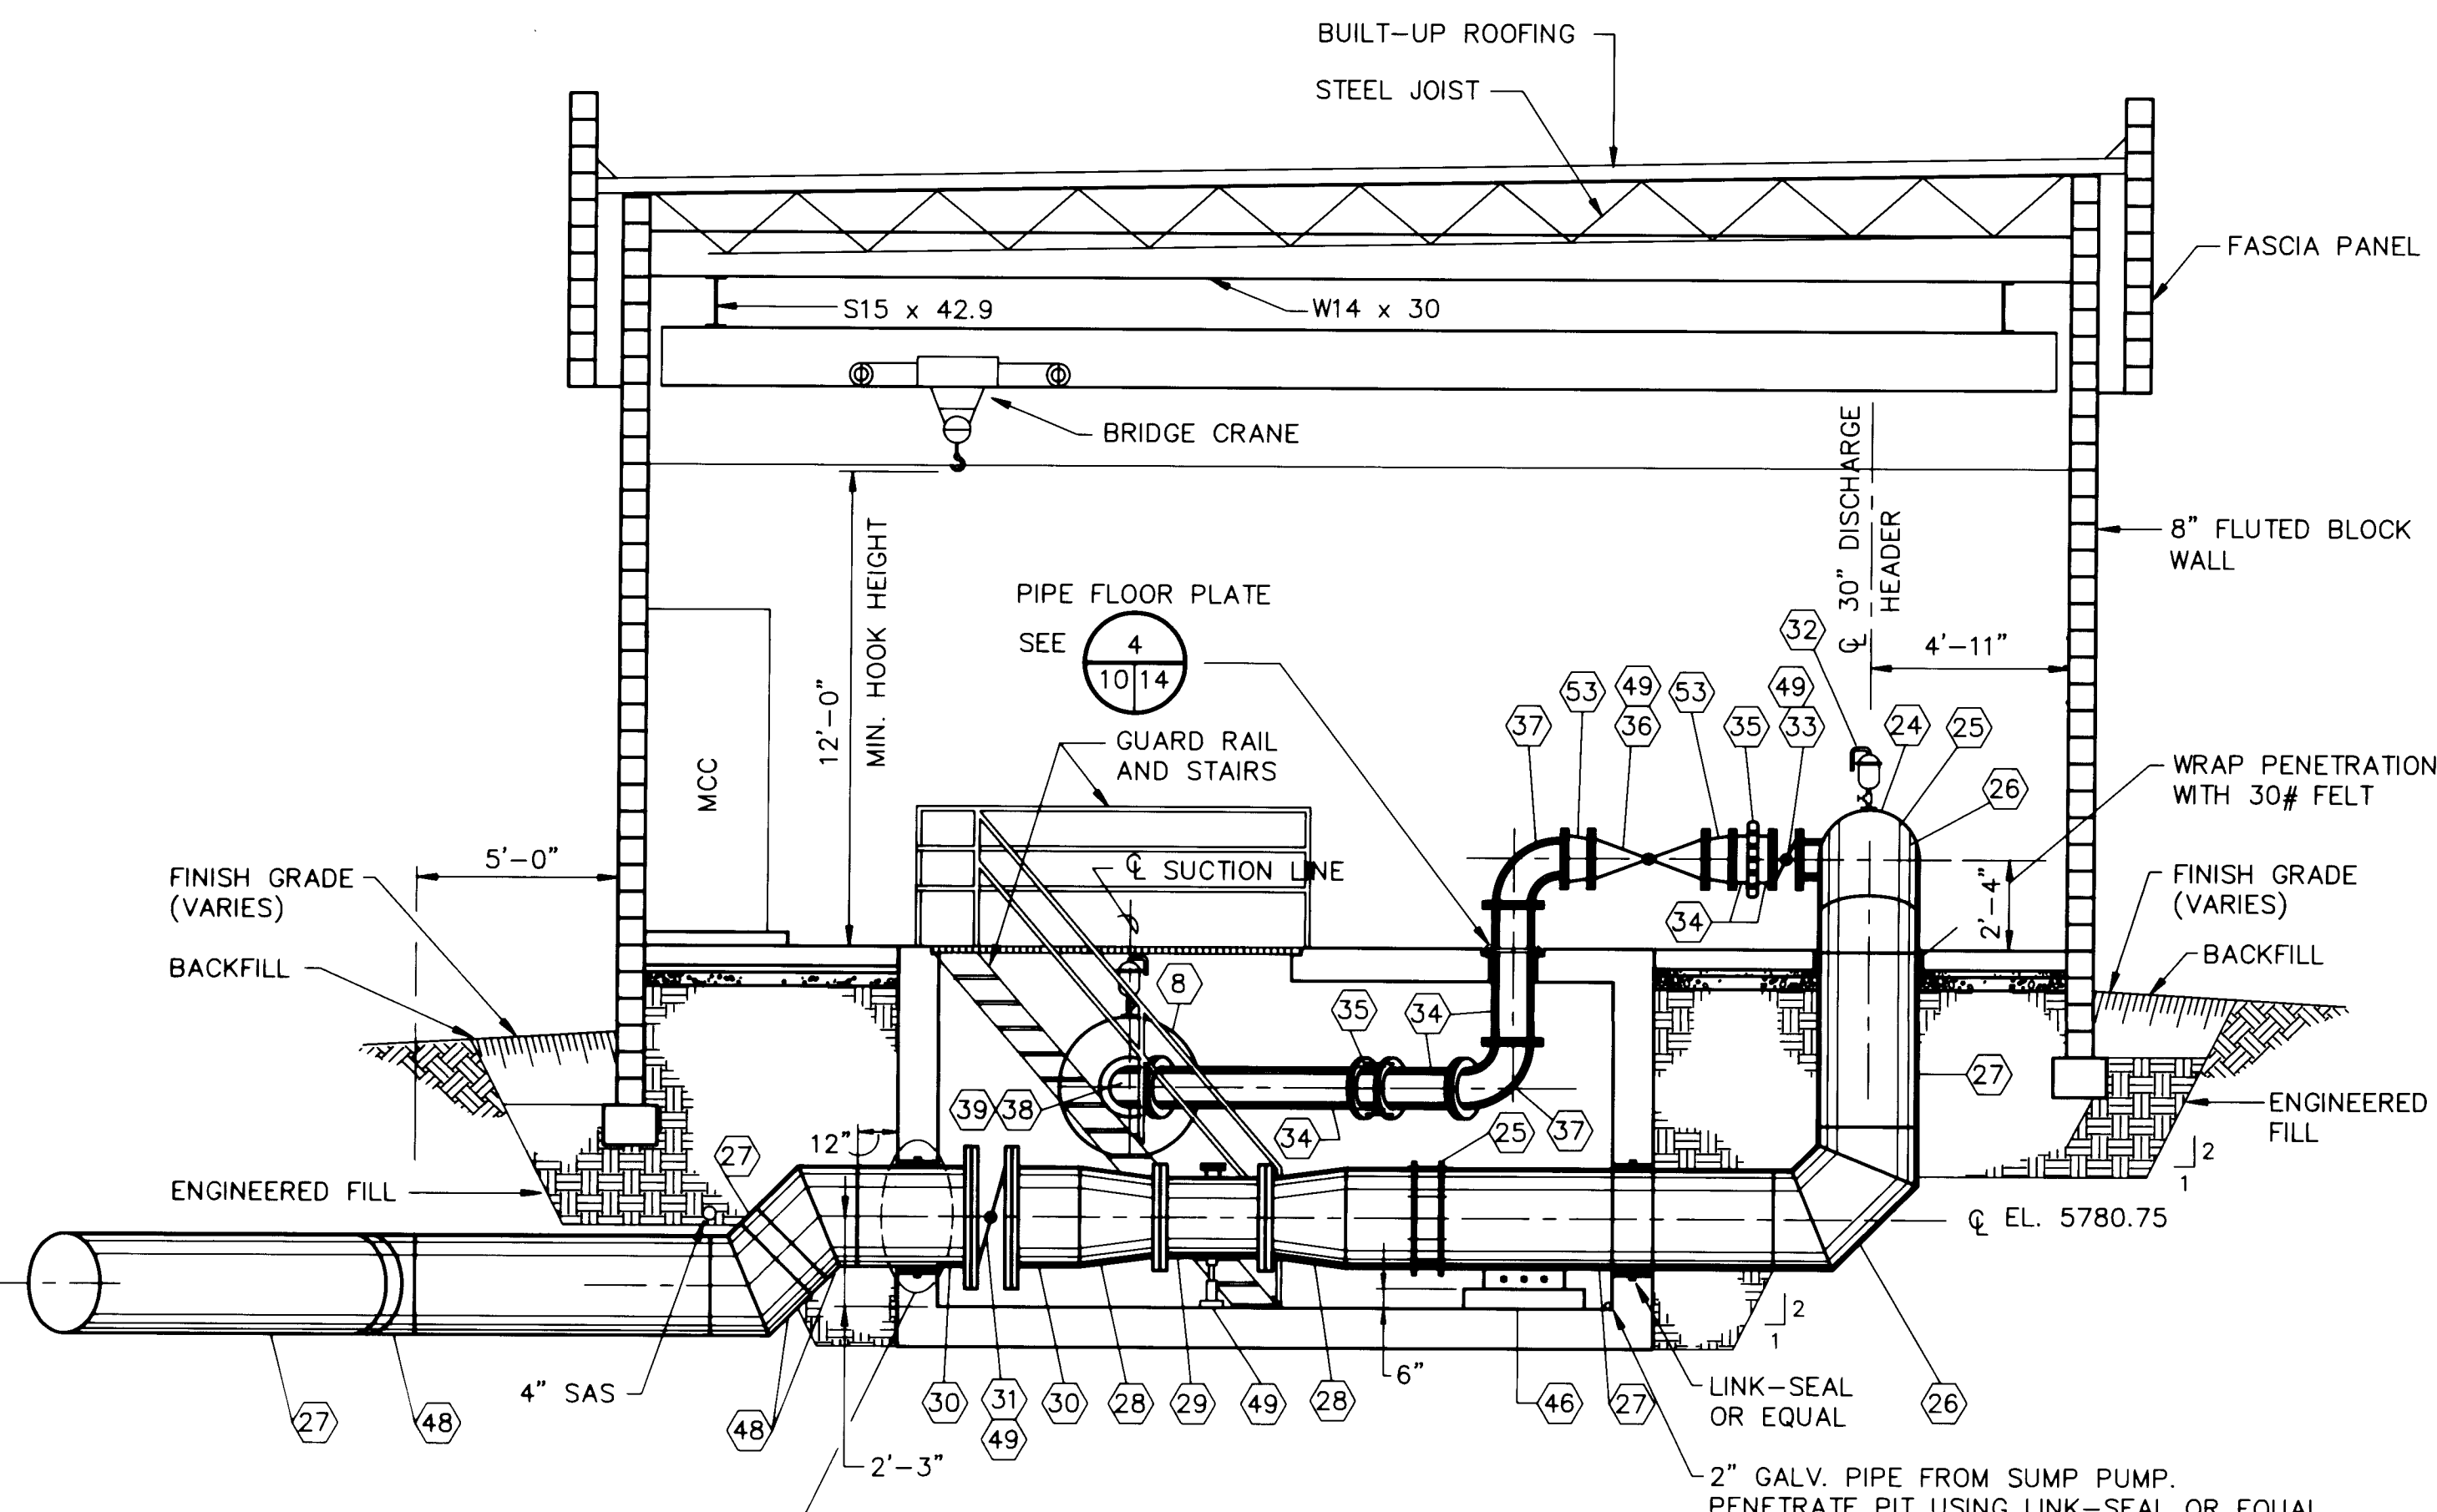

2
9/10

SECTION

SCALE: 1/4" = 1'-0"

LEGEND:

(26) = KEY NOTE, SEE FLOOR AND PIPING PLAN SHEET.

NOTES:

1. REFER TO FLOOR AND PIPING PLAN SHEET 9 FOR OTHER KEYED NOTES NOT SHOWN.




RECORD DRAWING

FEB 1990

These drawings have been revised based on field data and every reasonable attempt has been made to depict construction as actually performed.

AS BUILT INFORMATION			BENCH MARKS			SURVEY INFORMATION			ENGINEER'S SEAL		
CONTRACTOR	MCC Construction Co.	DATE	2/91	THE STATION IS AN ACS BRASS TABLET STAMPED	DATE	5/90	FIELD NOTES	NO.	1	REMARKS	REVISIONS
WORKED BY	ALBUQUERQUE	DATE	2/91	"10-F22A" LOCATED ON THE NORTH CURB OF	DATE	5/90	BY	DATE	DATE	DATE	DATE
INSPECTED BY	ALBUQUERQUE	DATE	12/91	MONTGOMERY BLVD. N.E. AT THE INTERSECTION	DATE	5/90	NO.	1	DATE	DATE	DATE
ACCEPTANCE BY	ALBUQUERQUE	DATE	12/91	OF MONTGOMERY BLVD. AND SHENANDOAH PL.	DATE	5/90	NO.	1	DATE	DATE	DATE
VERIFICATION BY	ALBUQUERQUE	DATE	12/91	N.E. ELEVATION=5831.93 (1ST ORDER)	DATE	5/90	NO.	1	DATE	DATE	DATE
DRAWN BY	ALBUQUERQUE	DATE	12/91		DATE	5/90	NO.	1	DATE	DATE	DATE
CHECKED BY	ALBUQUERQUE	DATE	12/91		DATE	5/90	NO.	1	DATE	DATE	DATE
RECORDED BY	ALBUQUERQUE	DATE	12/91		DATE	5/90	NO.	1	DATE	DATE	DATE
DATE	ALBUQUERQUE	DATE	12/91		DATE	5/90	NO.	1	DATE	DATE	DATE

CITY OF ALBUQUERQUE PUBLIC WORKS DEPARTMENT ENGINEERING GROUP					
TITLE: GUTIERREZ PUMP STATION RECONSTRUCTION PIPING SECTIONS					
APPROVALS	ENGINEER	DATE	APPROVALS	ENGINEER	DATE
DRG CHAIRMAN	R.W. Kane	11-13-90	WATER	R.W. Kane	11-13-90
TRANSPORTATION	R.W. Kane	11-13-90	WASTE WATER	R.W. Kane	11-13-90
HYDROLOGY	R.W. Kane	11-13-90			
PROJECT NO.	MAP NO.	SHEET	OF	NO.	DATE
3337.90	F-22	10	15		

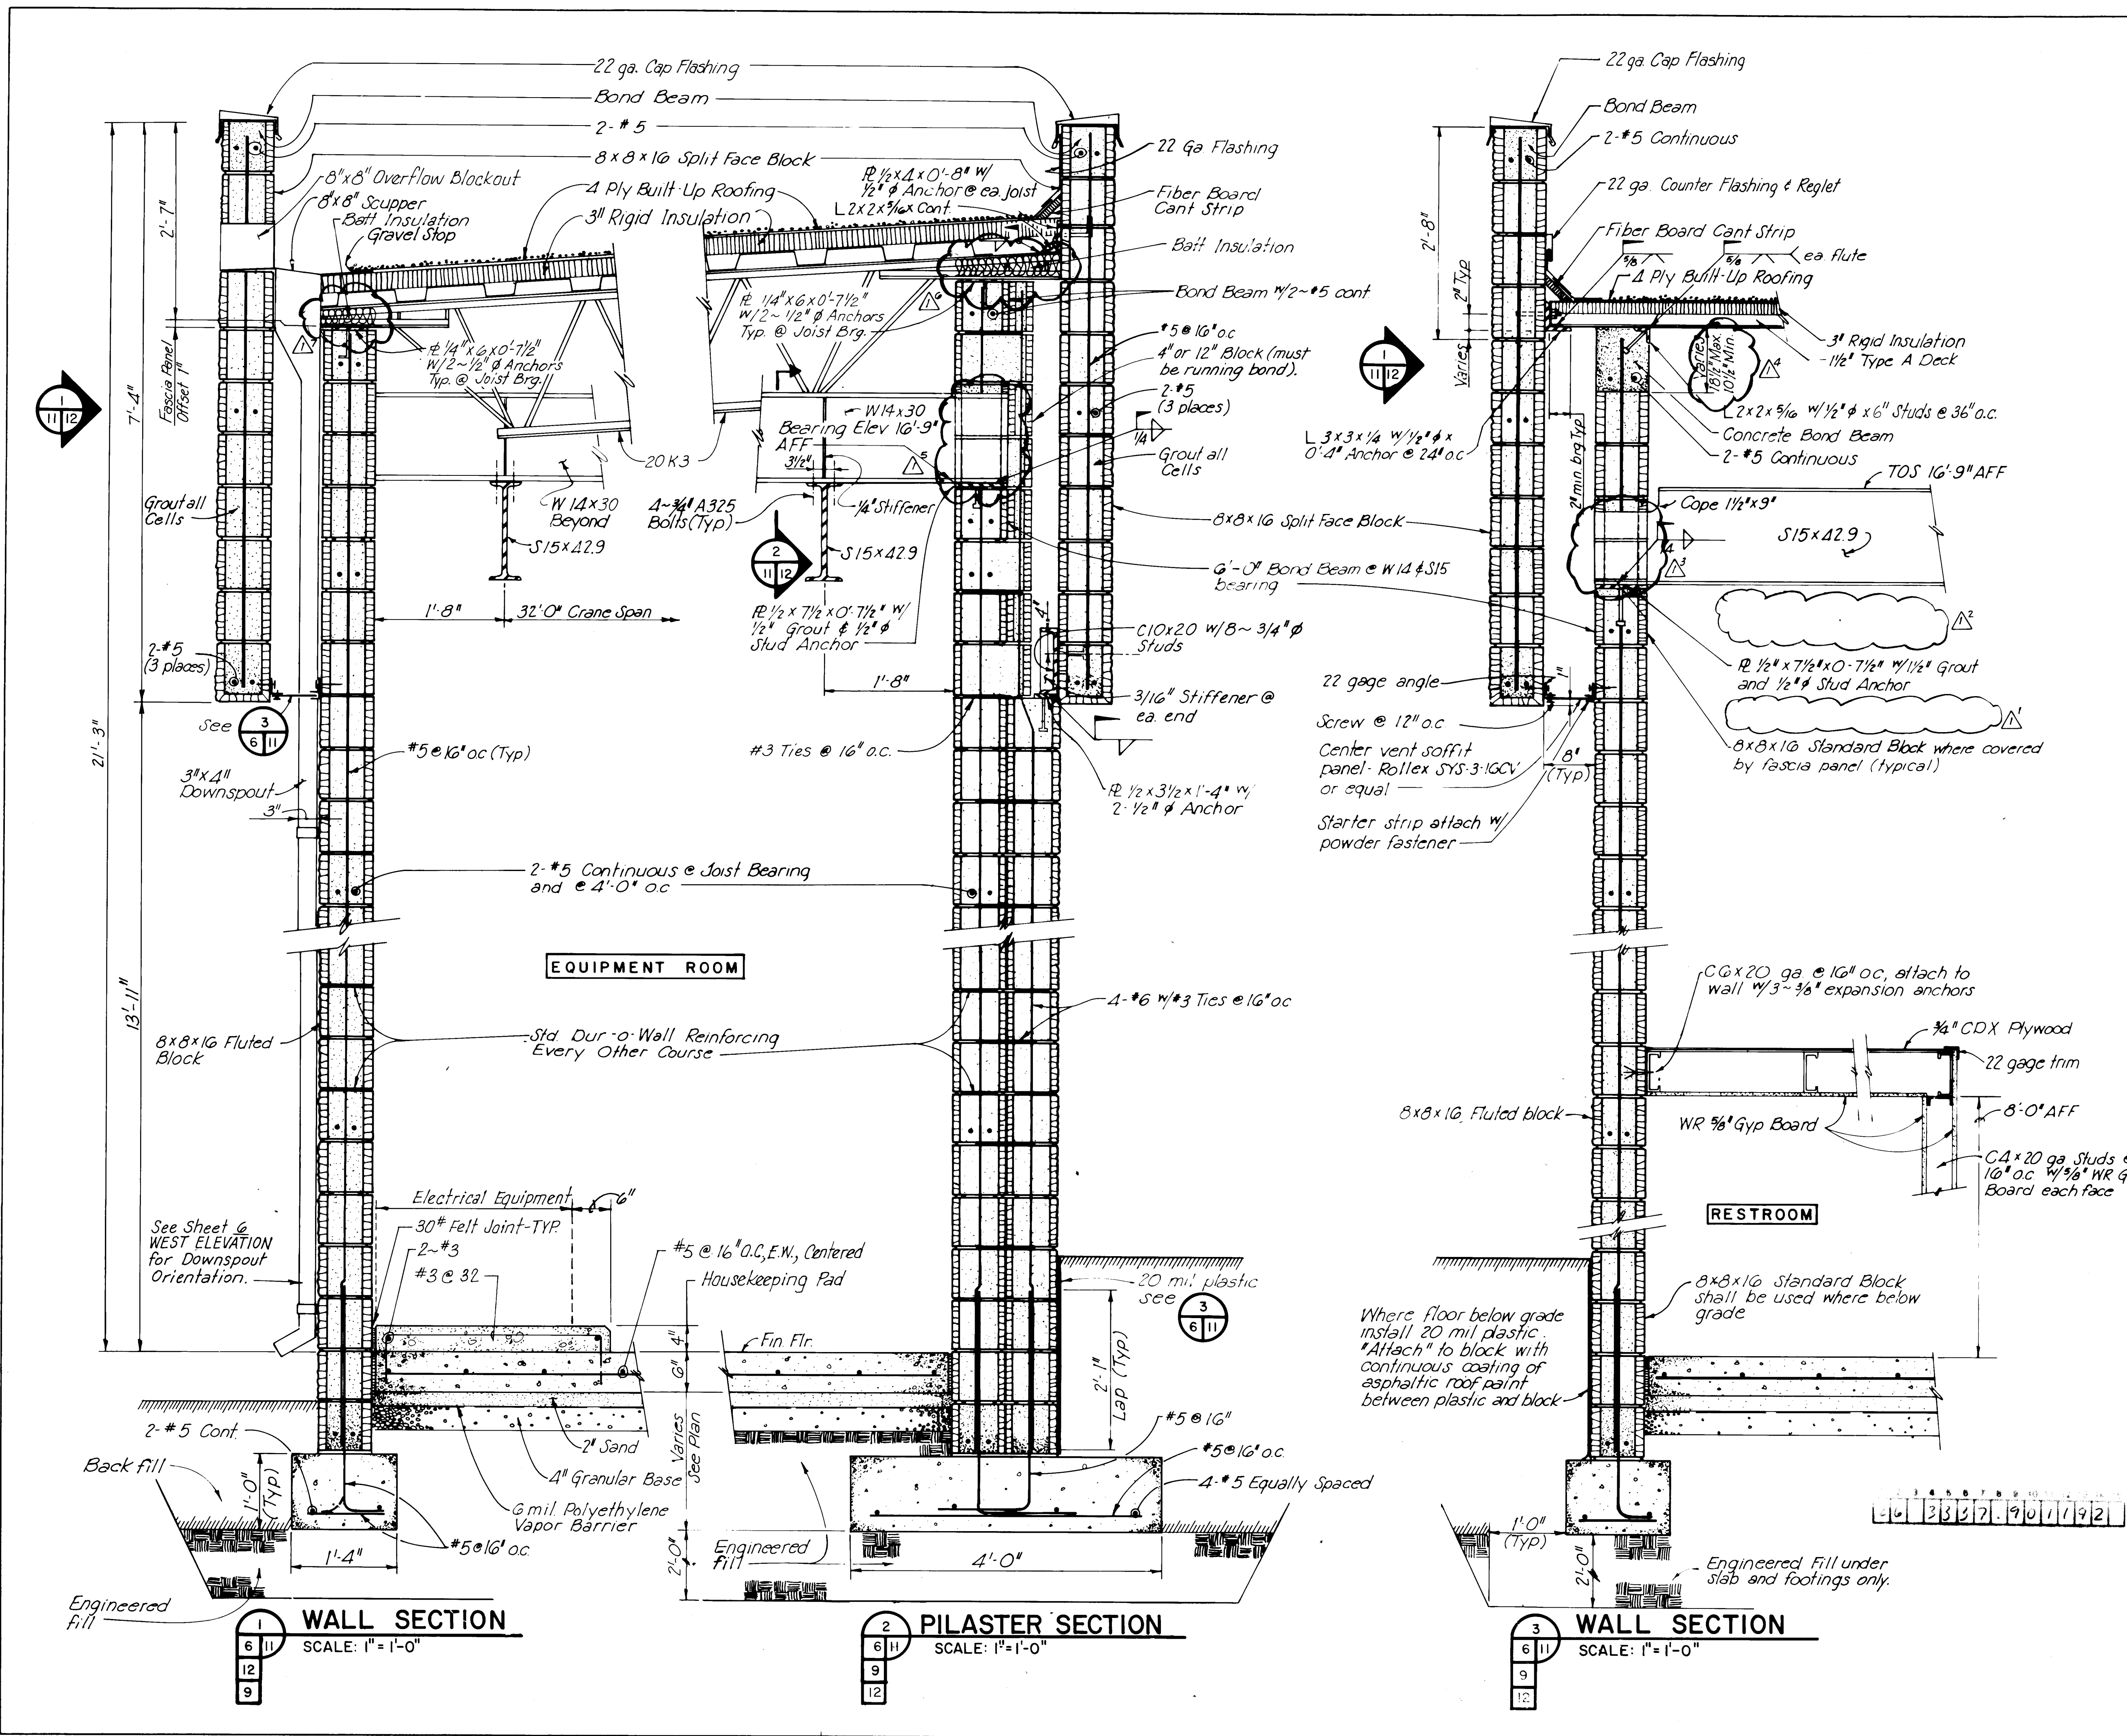

AS BUILT INFORMATION

CONTRACTOR: MCC Construction Co.

INSPECTOR: L. DINE

DATE: 11-13-90

REVISIONS:

NO. DATE DESCRIPTION

1 2/92 Proposed V.I. for 1st Floor Deck

2 11/16/90 Proposed V.I. for 1st Floor Deck

3 11/15/90 Proposed V.I. for 1st Floor Deck

4 11/15/90 Proposed V.I. for 1st Floor Deck

5 11/15/90 Proposed V.I. for 1st Floor Deck

6 11/15/90 Proposed V.I. for 1st Floor Deck

7 11/15/90 Proposed V.I. for 1st Floor Deck

8 11/15/90 Proposed V.I. for 1st Floor Deck

9 11/15/90 Proposed V.I. for 1st Floor Deck

10 11/15/90 Proposed V.I. for 1st Floor Deck

11 11/15/90 Proposed V.I. for 1st Floor Deck

12 11/15/90 Proposed V.I. for 1st Floor Deck

ENGINEER'S SEAL

DESIGNED BY: L. DINE

DRAWN BY: L.H. INC.

CHECKED BY: K.W. WELTY

DATE: JUNE 1990

DATE: JUNE 1990

DATE: JUNE 1990

CITY OF ALBUQUERQUE






PUBLIC WORKS DEPARTMENT

ENGINEERING GROUP

TITLE: GUTIERREZ PUMP STATION RECONSTRUCTION WALL SECTIONS

APPROVALS	ENGINEER	DATE	APPROVALS	ENGINEER	DATE
DRC CHAIRMAN	R.W. Kane	11-13-90	WATER	R.W. Kane	11-13-90
TRANSPORTATION	N/A R.W.	11-16-90	WASTE WATER	R.W. Kane	11-13-90
HYDROLOGY	L.D.M.	11-15-90			





PROJECT NO. 333790 MAP NO. F-22 SHEET 11 OF 15

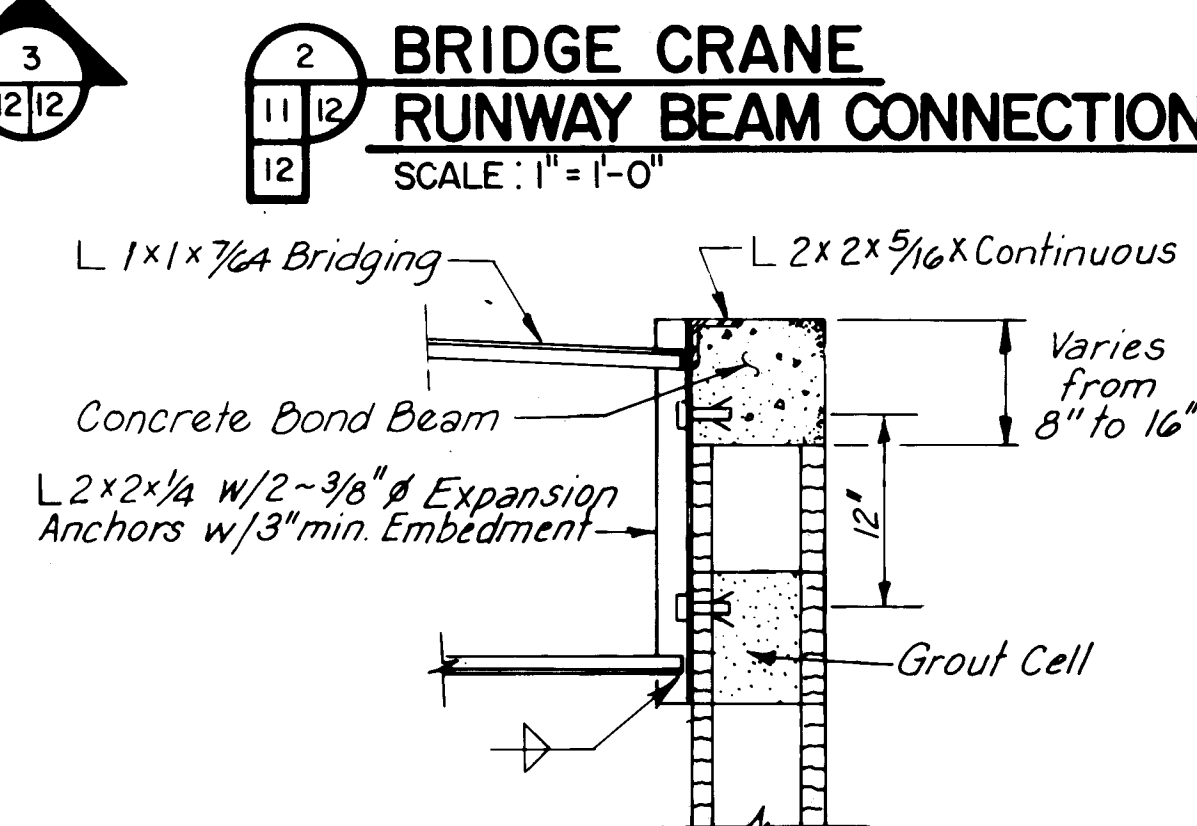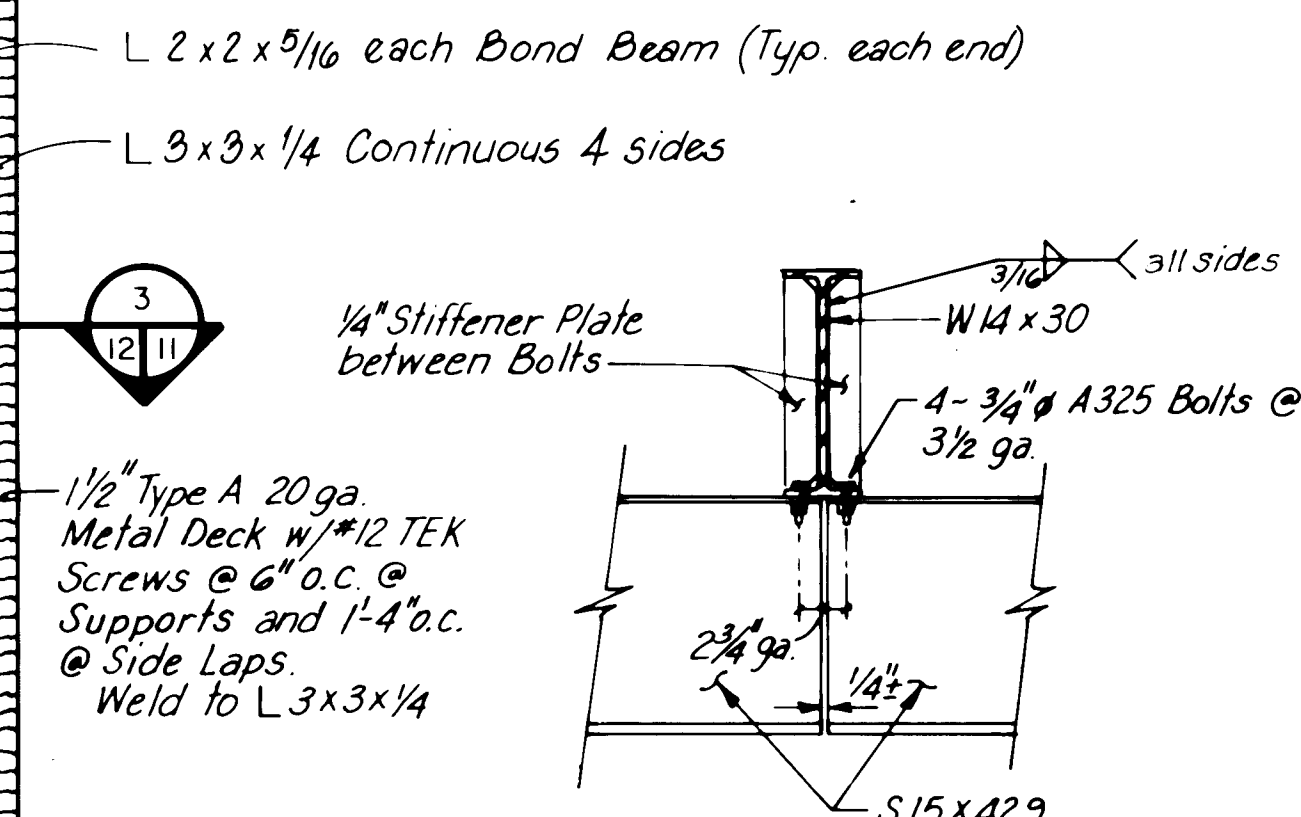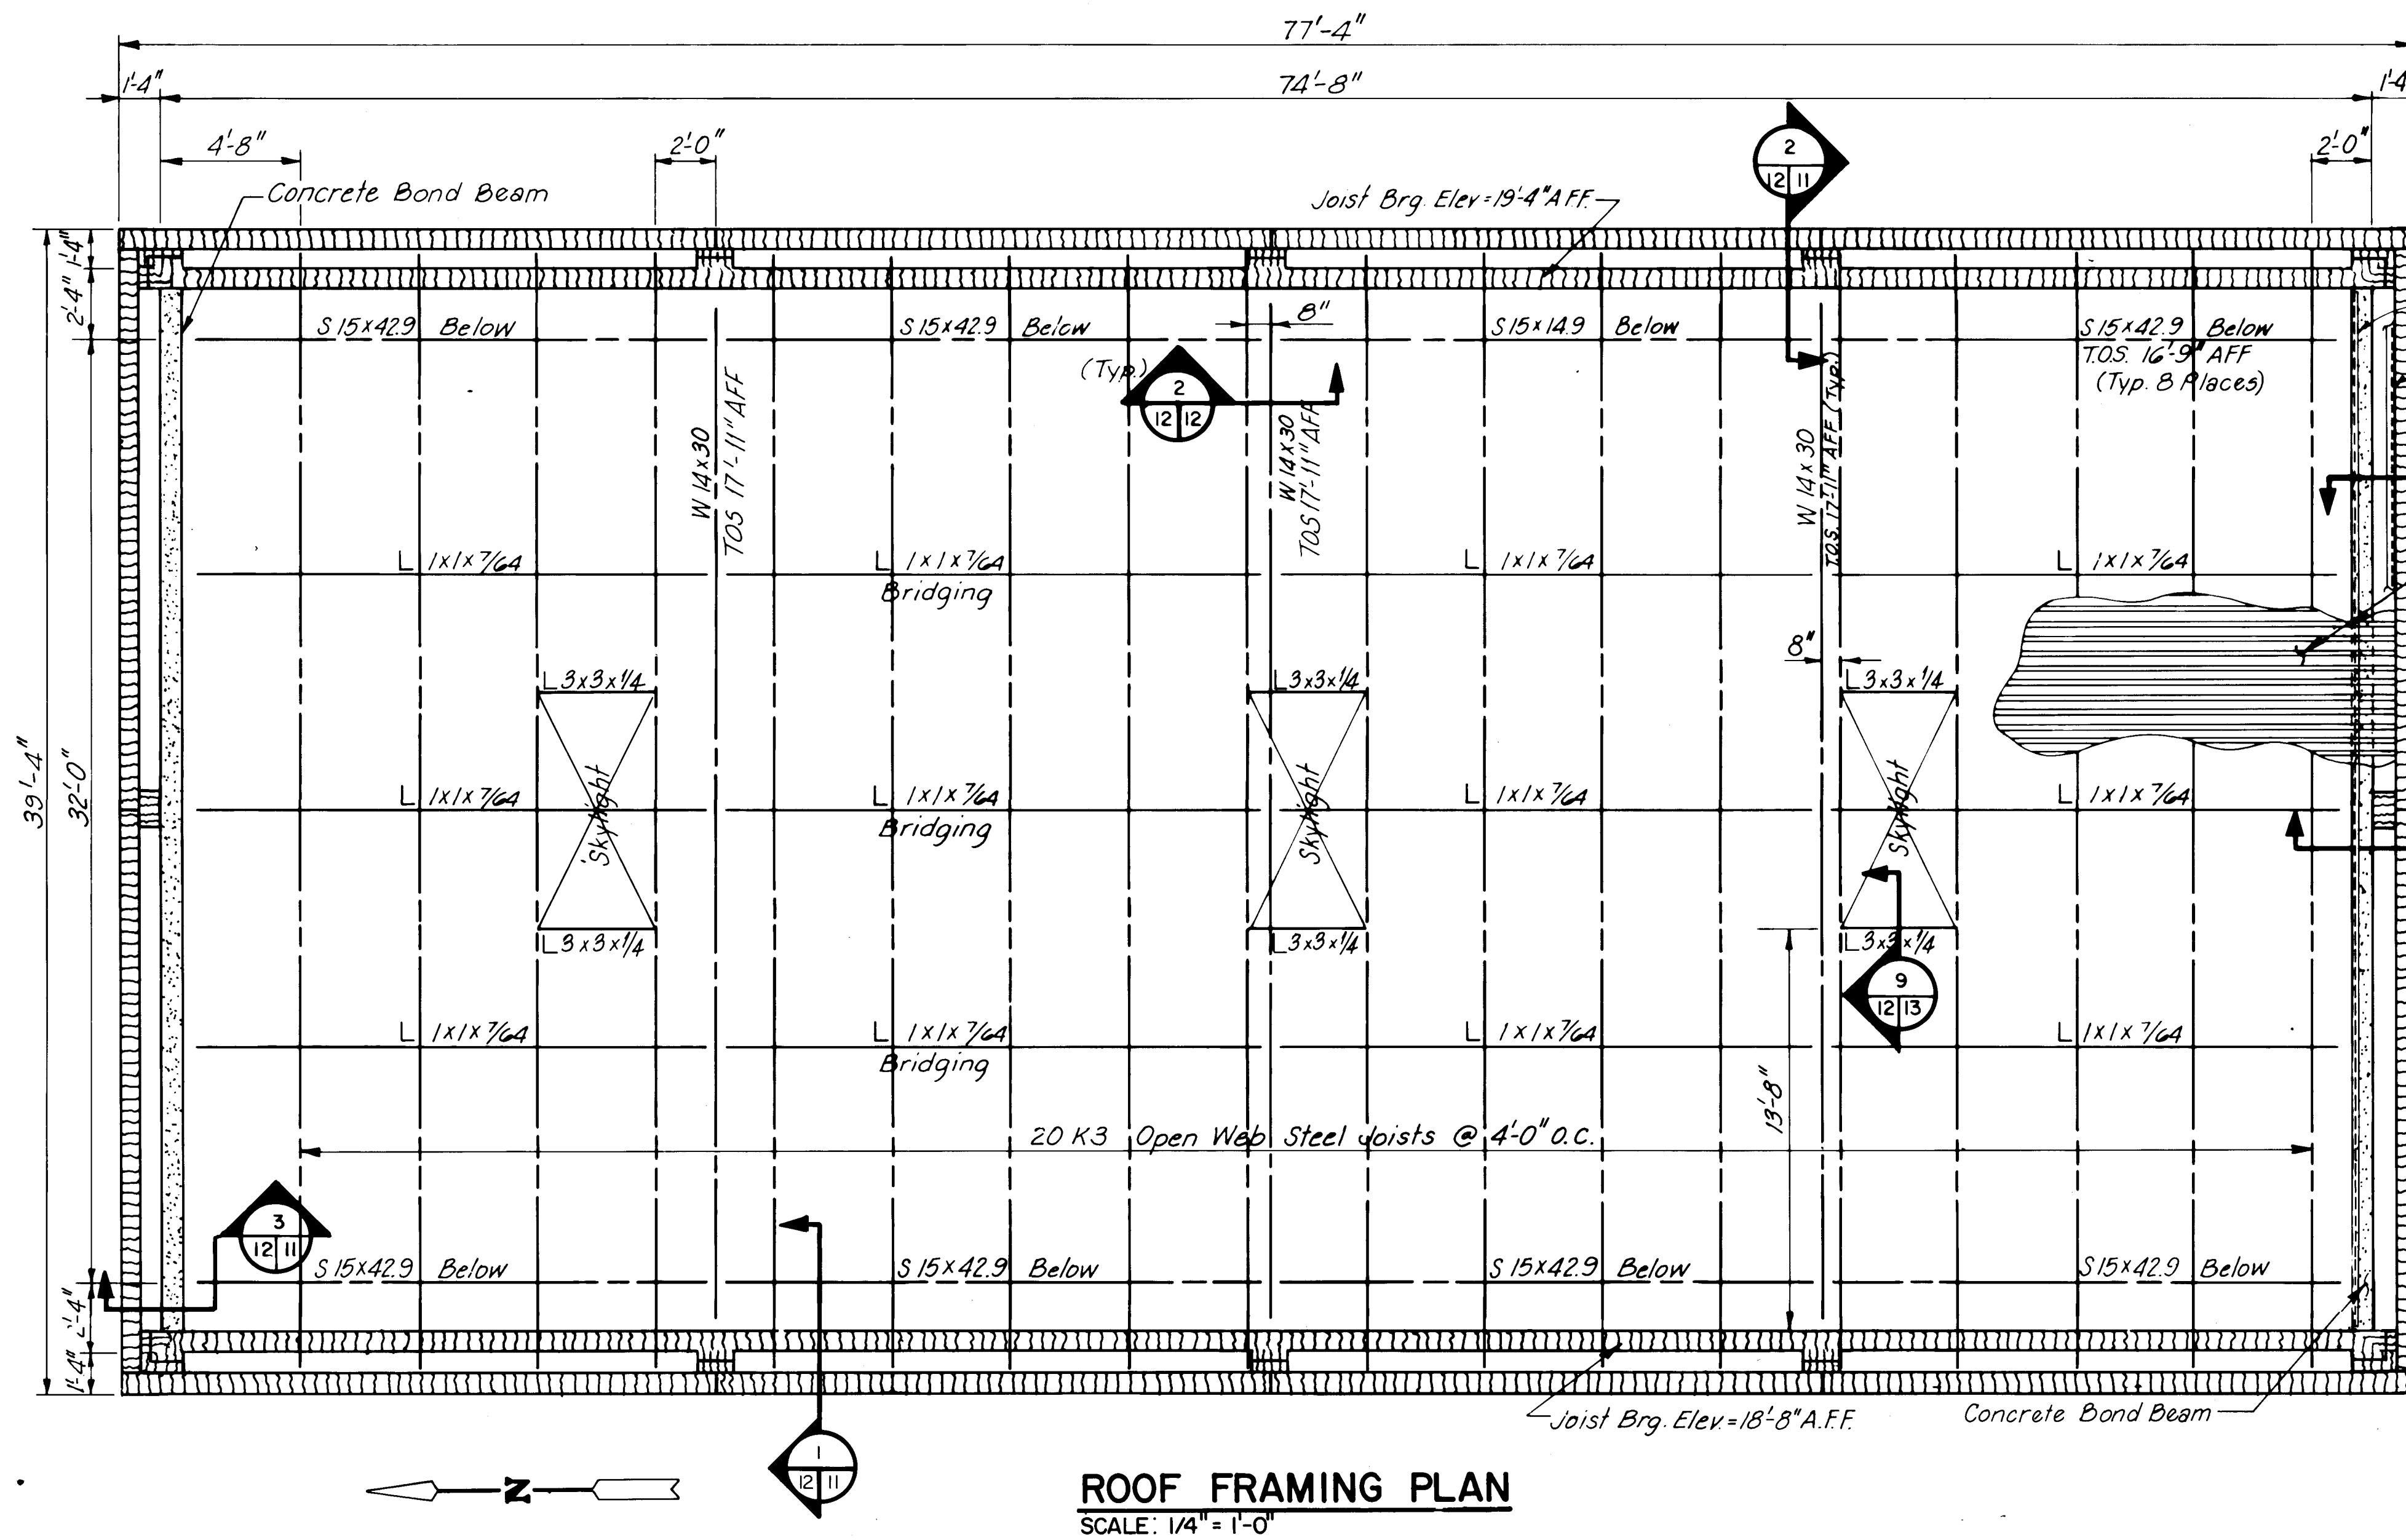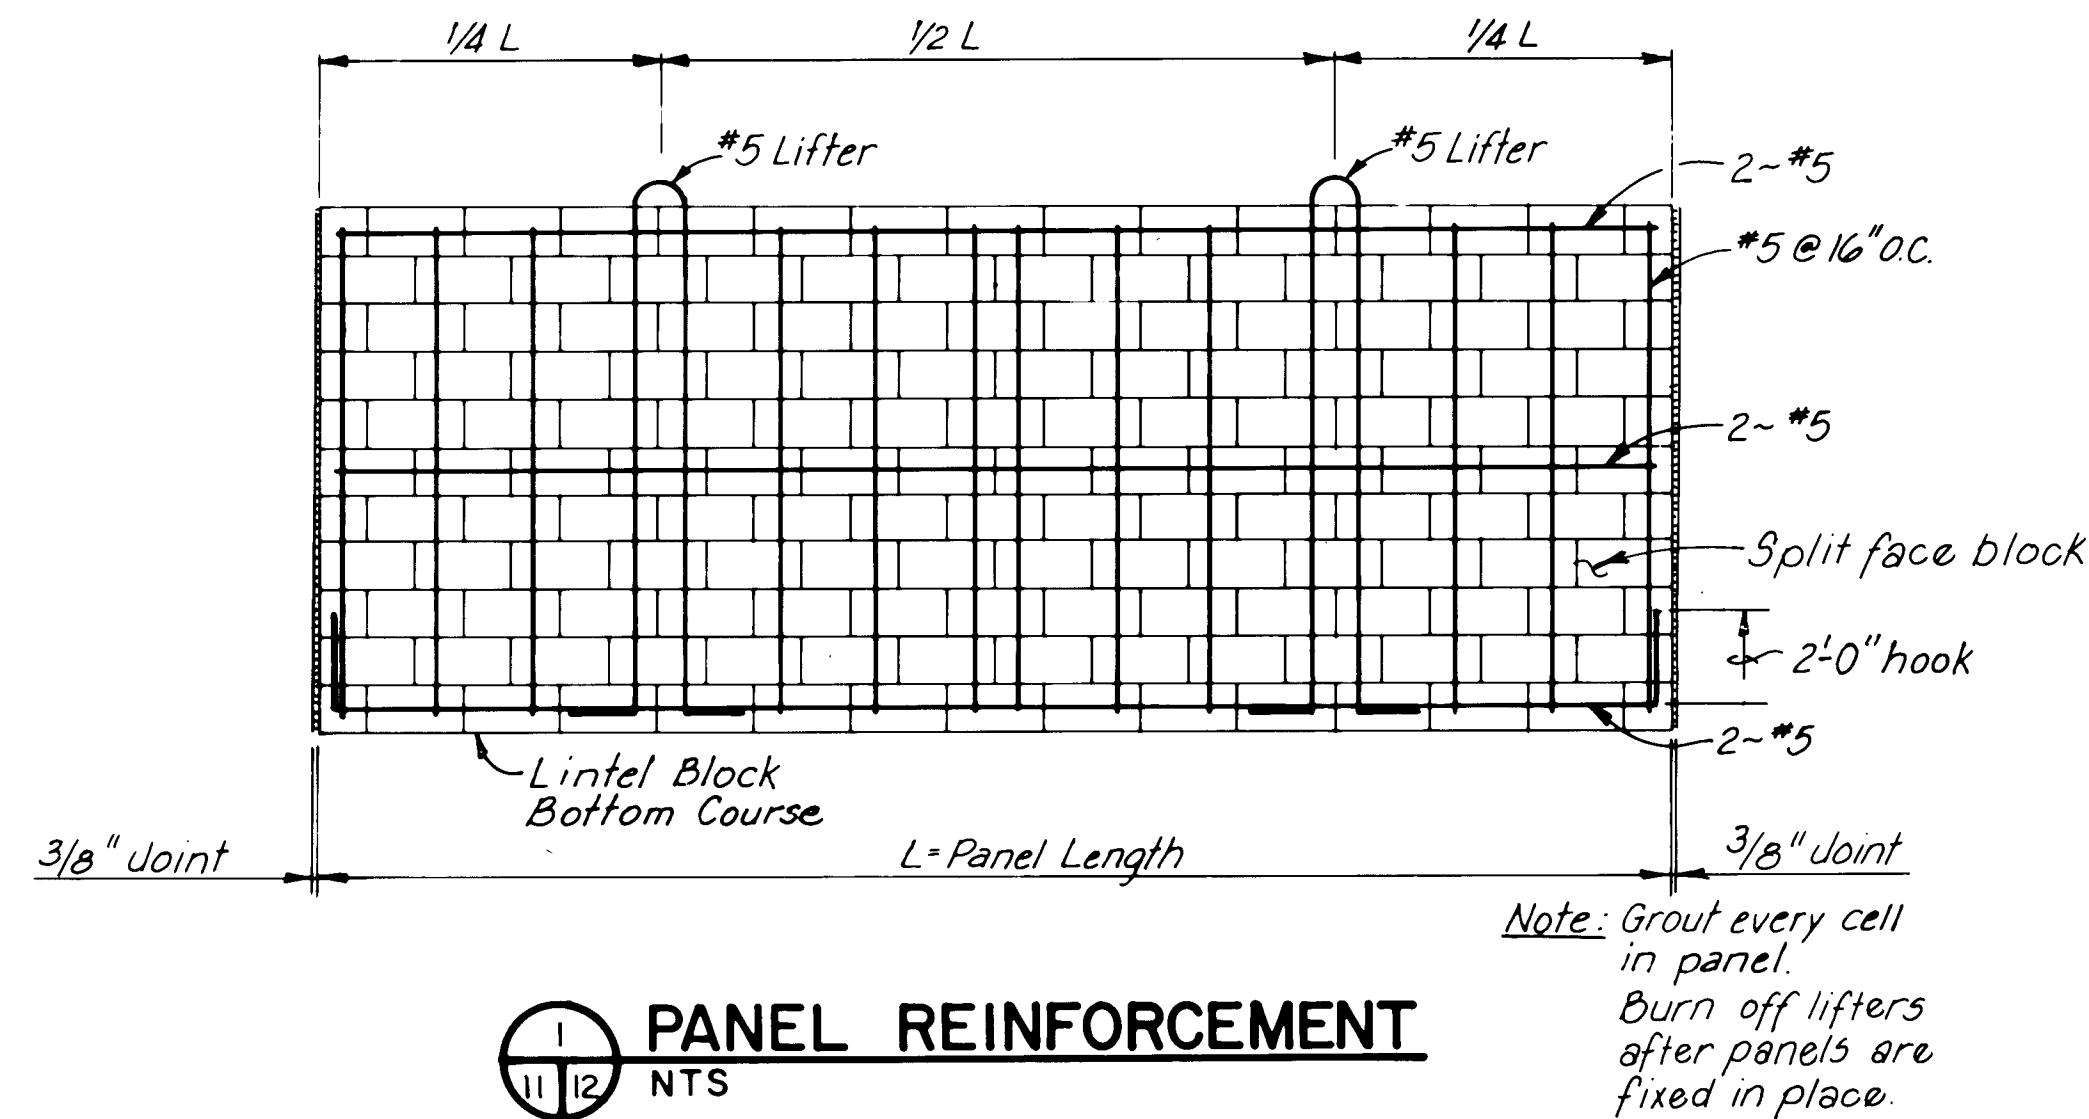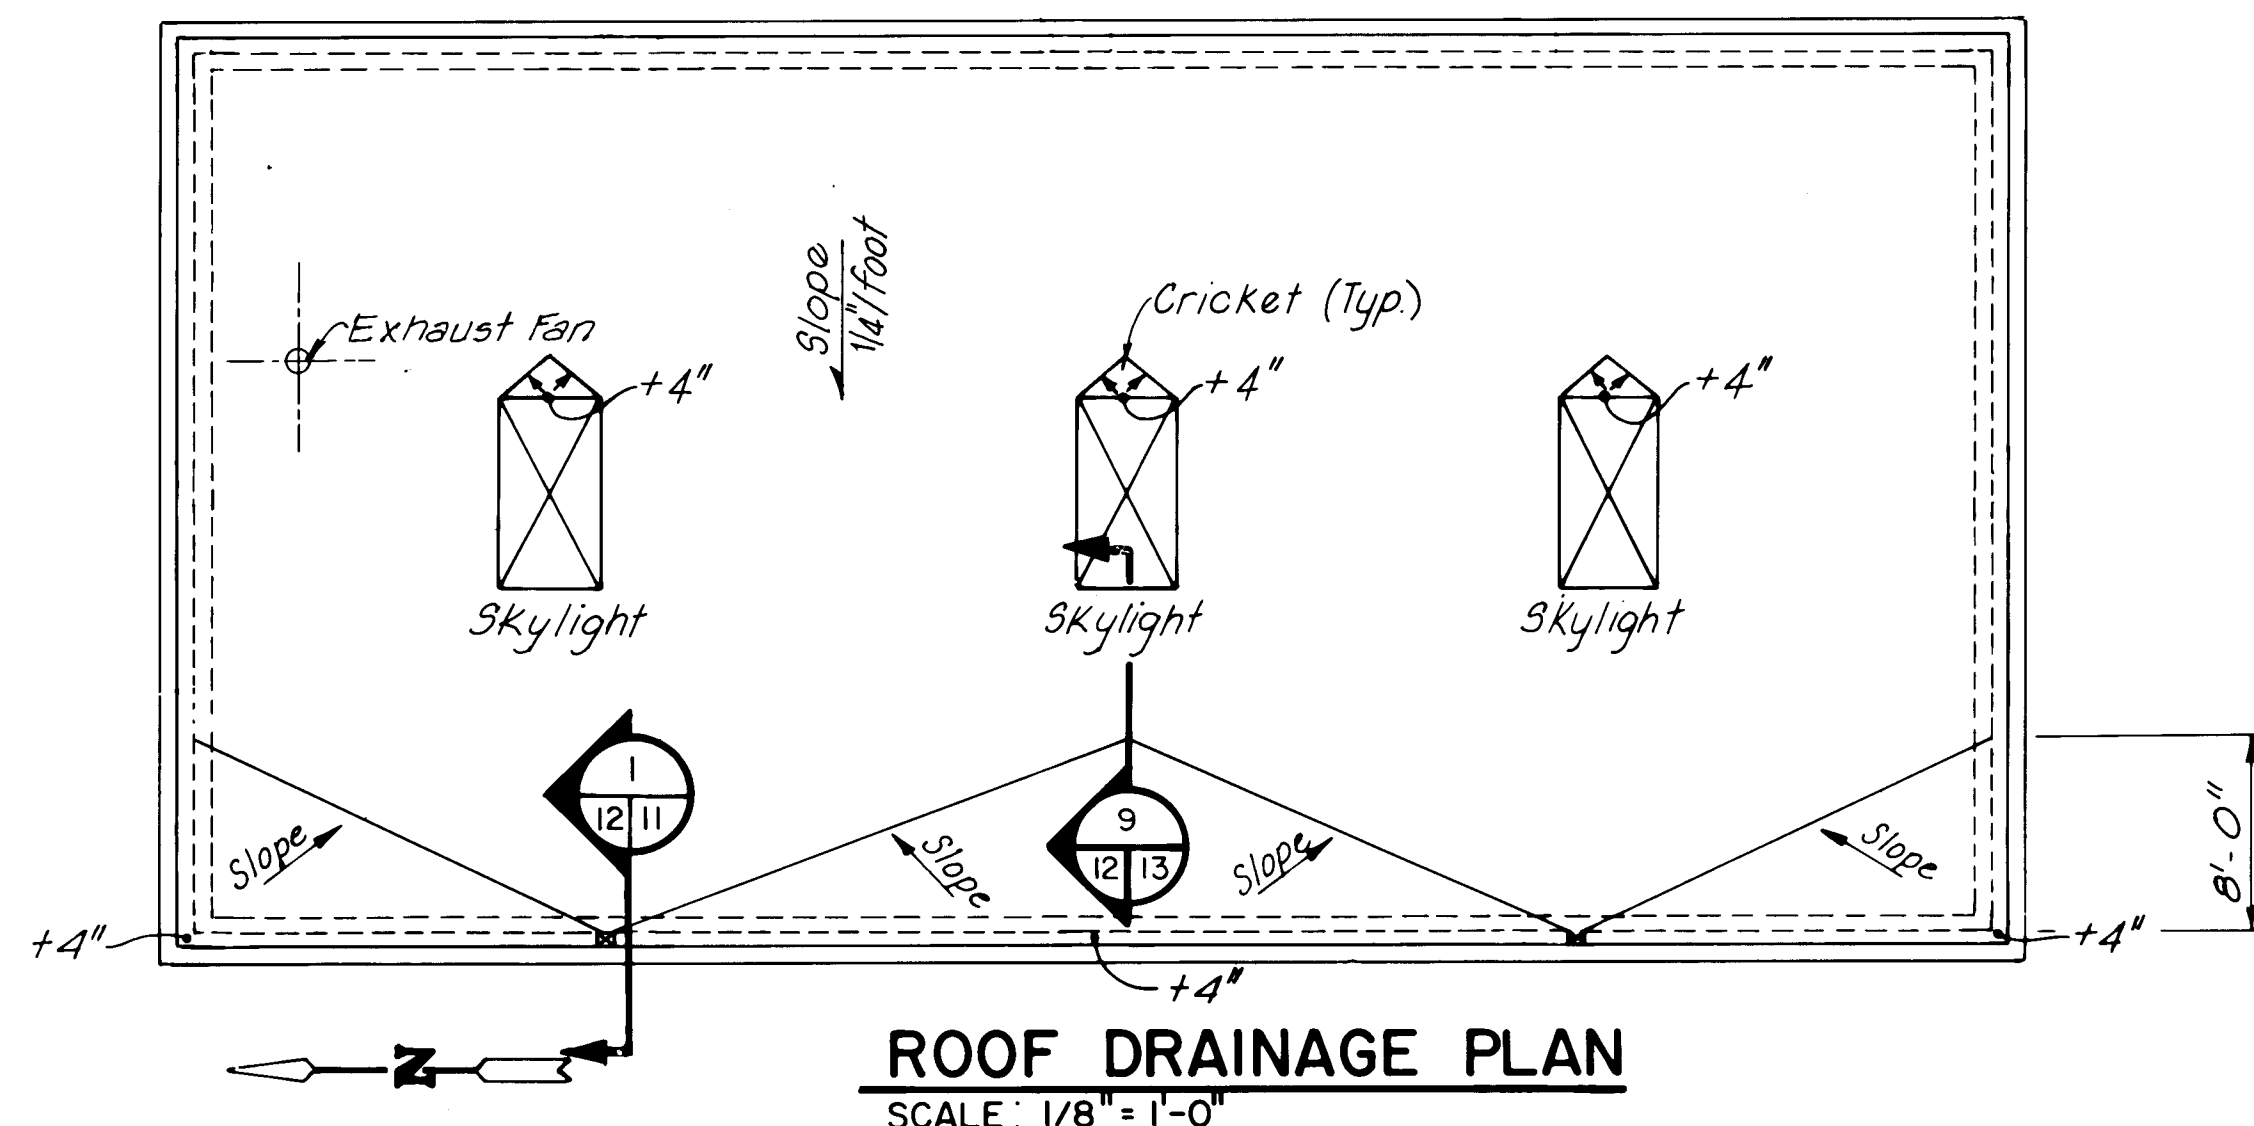

RECORD DRAWING
FEB 1992
These drawings have been reviewed, checked, and approved by the engineer of record and every reasonable effort has been made to depict construction as actually performed.

AS BUILT INFORMATION			BENCH MARKS			SURVEY INFORMATION			ENGINEER'S SEAL		
CONTRACTOR	ALBUQUERQUE CONSTRUCTION CO.	DATE	NO.	BY	DATE	NO.	BY	DATE			
WORK	RECONSTRUCTION OF PUMP STATION	DATE									
FIELD	ALBUQUERQUE, N.M.	DATE									
REVISIONS	DATE	BY	NO.	BY	DATE	NO.	BY	DATE			
DESIGNED BY	L. DINE	DATE									
DRAWN BY	L.H. INC.	DATE									
CHECKED BY	K.W. WELTY	DATE									

CITY OF ALBUQUERQUE PUBLIC WORKS DEPARTMENT ENGINEERING GROUP					
TITLE: GUTIERREZ PUMP STATION RECONSTRUCTION ROOF FRAMING AND DRAINAGE PLAN					
APPROVALS	ENGINEER	DATE	APPROVALS	ENGINEER	DATE
D.R.C. Chair	eng. [Signature]	11-14-90			
Trans. Dev	N/A RHO	11-16-90			
Utility Dev	R.W. Kane	11-13-90			
Hyd	LDM	11-15-90			
PROJECT NO.	3337.90	MAP NO.	F-22	SHEET	12 OF 15

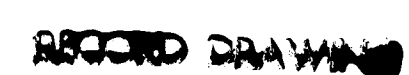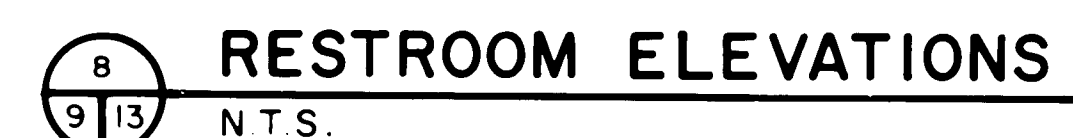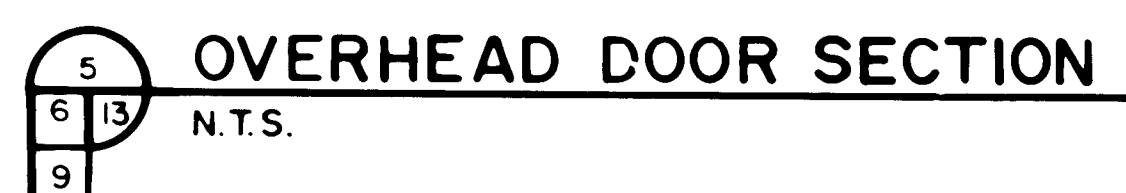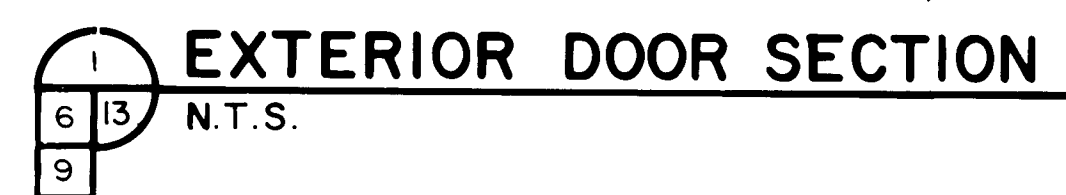


These drawings have been reviewed, tested on fold data and every reasonable attempt has been made to depict construction as actually performed.


CITY OF ALBUQUERQUE PUBLIC WORKS DEPARTMENT ENGINEERING GROUP					
TITLE: GUTIERREZ PUMP STATION RECONSTRUCTION MISCELLANEOUS STRUCTURAL DETAILS					
APPROVALS	ENGINEER	DATE	APPROVALS	ENGINEER	DATE
DRC CHAIRMAN	<i>[Signature]</i>	11-16-98	WATER	R.W. Kane	11-13-98
TRANSPORTATION	N/A RHD	11-16-98	WASTE WATER	R.W. Kane	11-13-98
HYDROLOGY	CRM	11-15-98			
PROJECT NO. 3337.90		MAP NO. F-22		SHEET 13 OF 15	

ENGINEER'S SEAL		SURVEY INFORMATION		BENCH MARKS		AS BUILT INFORMATION	
		FIELD NOTES					
		NO.	BY	DATE			
						CONTRACTOR <i>MCC Construction Co</i>	
						WORK ORDER BY <i>ALBUQUE RQUE</i>	
						INSPECTOR'S <i>LEGOS/ALL</i>	
						ACCEPTANCE BY <i>TERRENOFF</i> DATE <i>2/91</i>	
						VEGETATION BY <i>LEGOS/ALL</i> DATE <i>12/91</i>	
						DRAWINGS BY <i>LEGOS/ALL</i>	
						CORRECTED BY <i>LEGOS/ALL</i> DATE <i>2/91</i>	
						MICRO-FILM INFORMATION	
						RECORDED BY	
						DATE	
						NO	

DESIGN	
DESIGNED BY <i>K.W. WELTY</i>	DATE <i>JUNE 1990</i>
DRAWN BY <i>L-H. INC.</i>	DATE <i>JUNE 1990</i>
CHECKED BY <i>K.W. WELTY</i>	DATE <i>JUNE 1990</i>

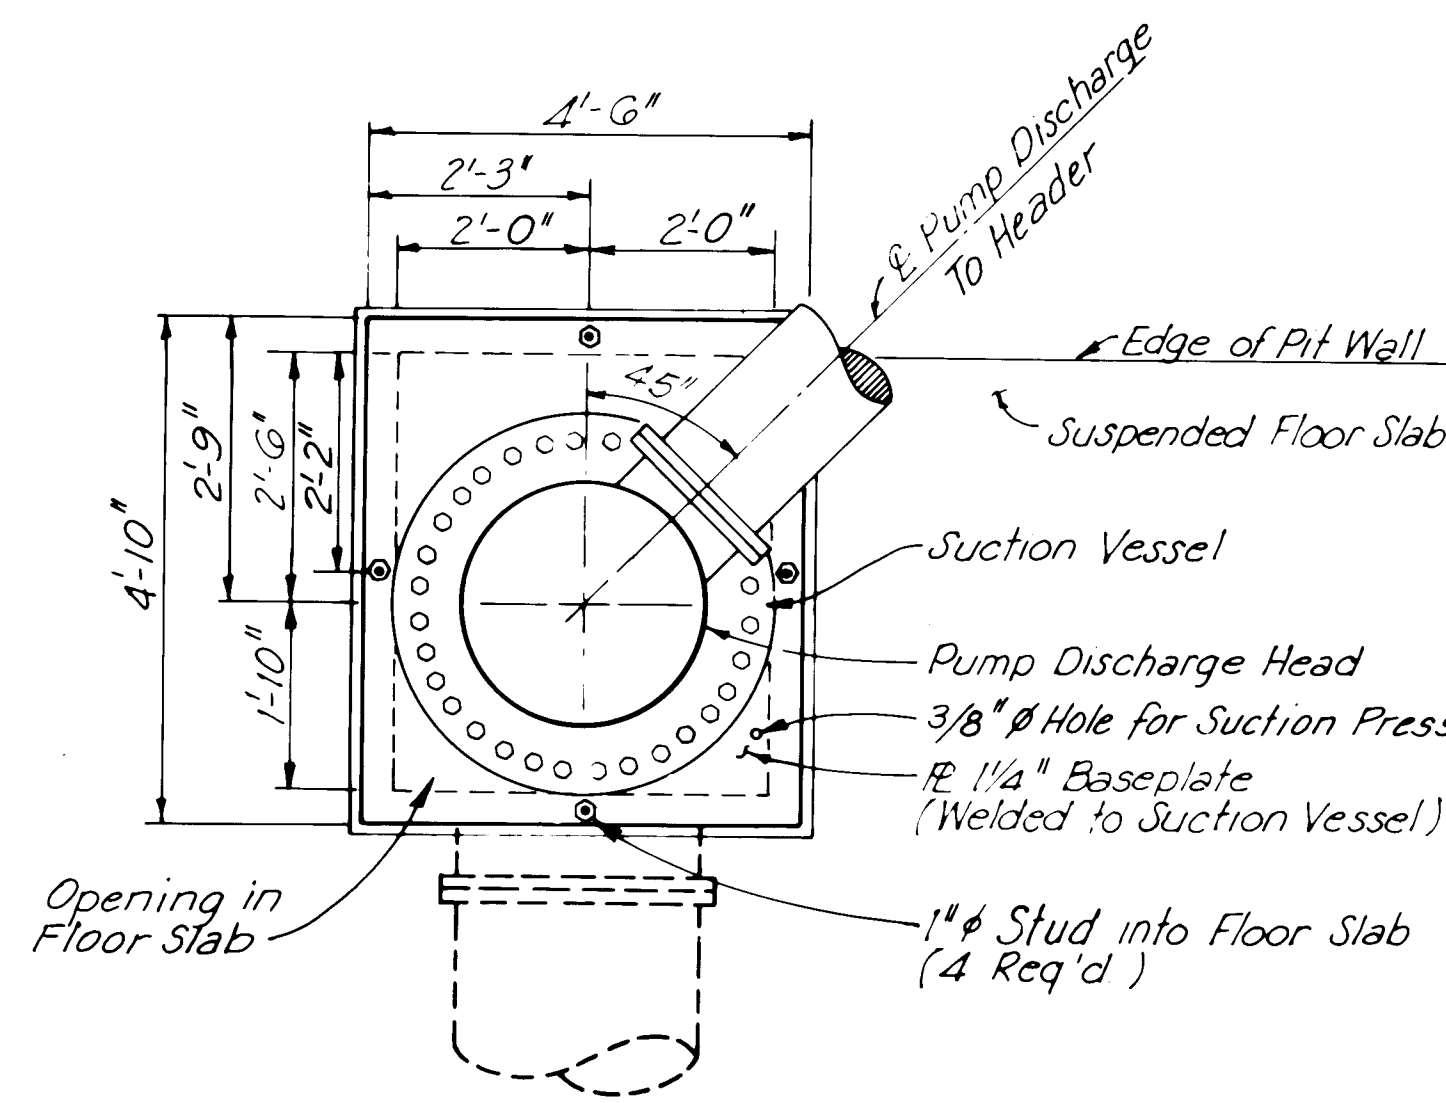


PLAN

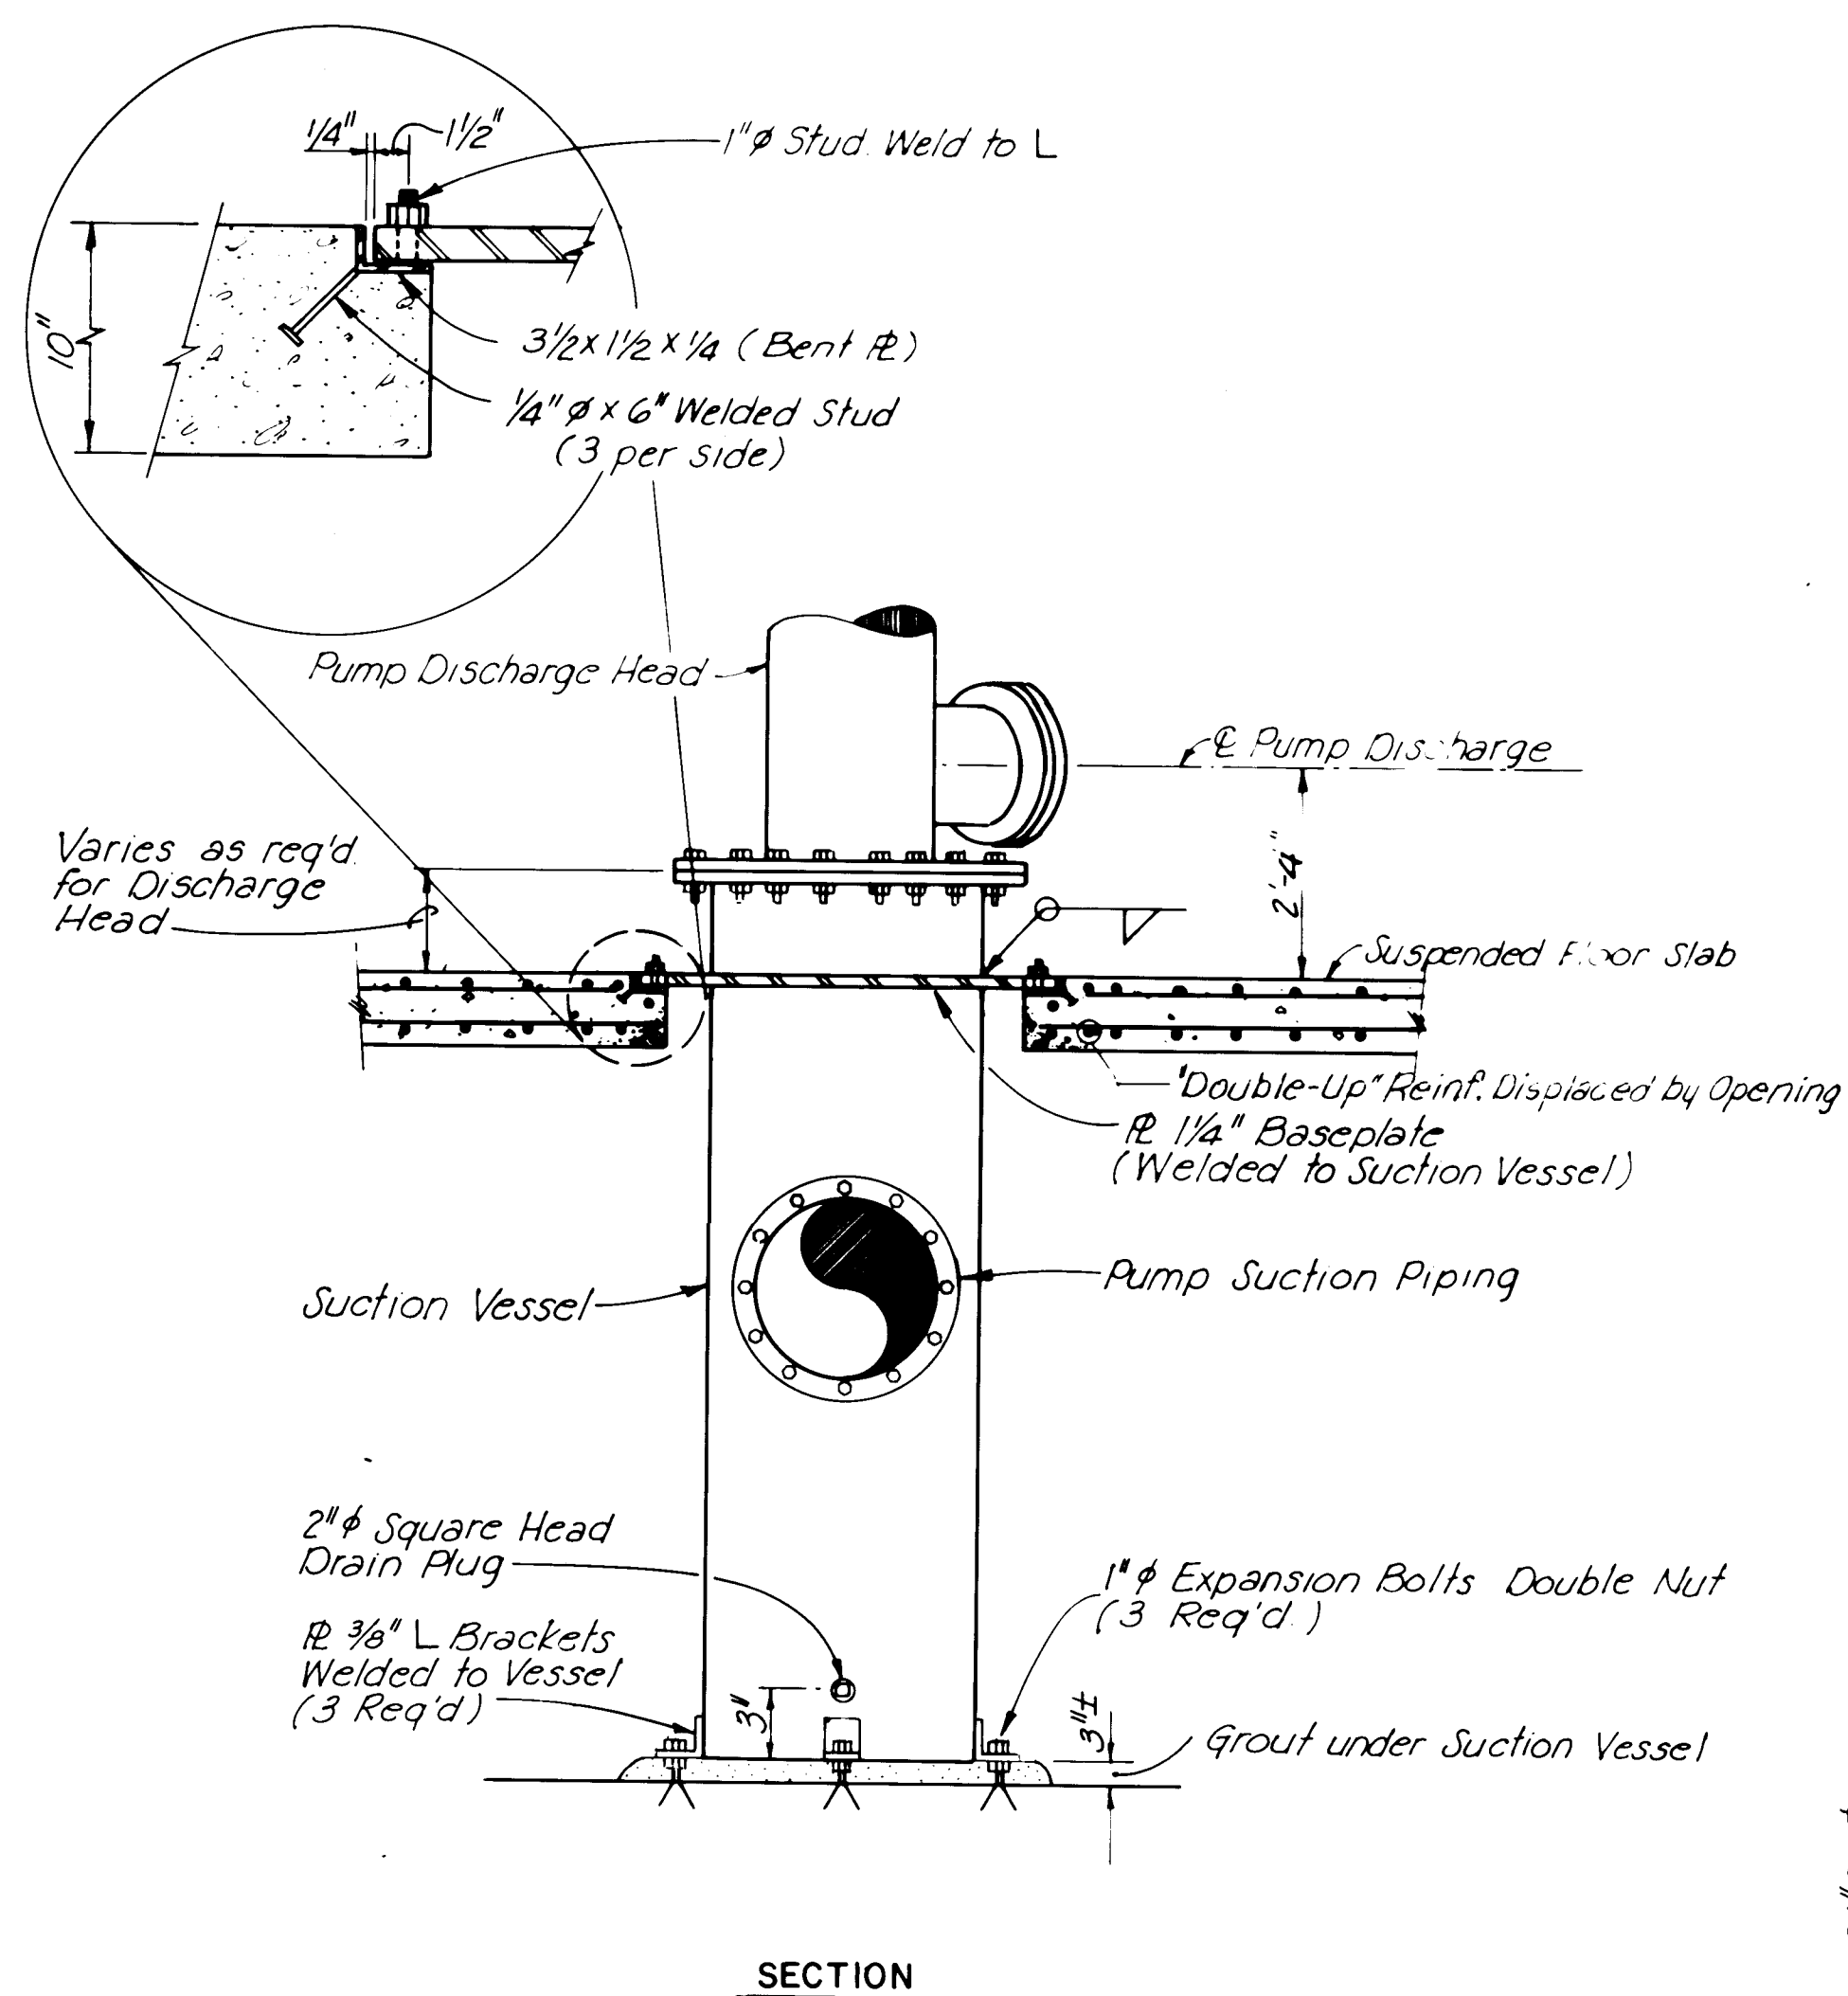


SECTION

1 SUCCTION VESSEL DETAIL
7/14 NTS

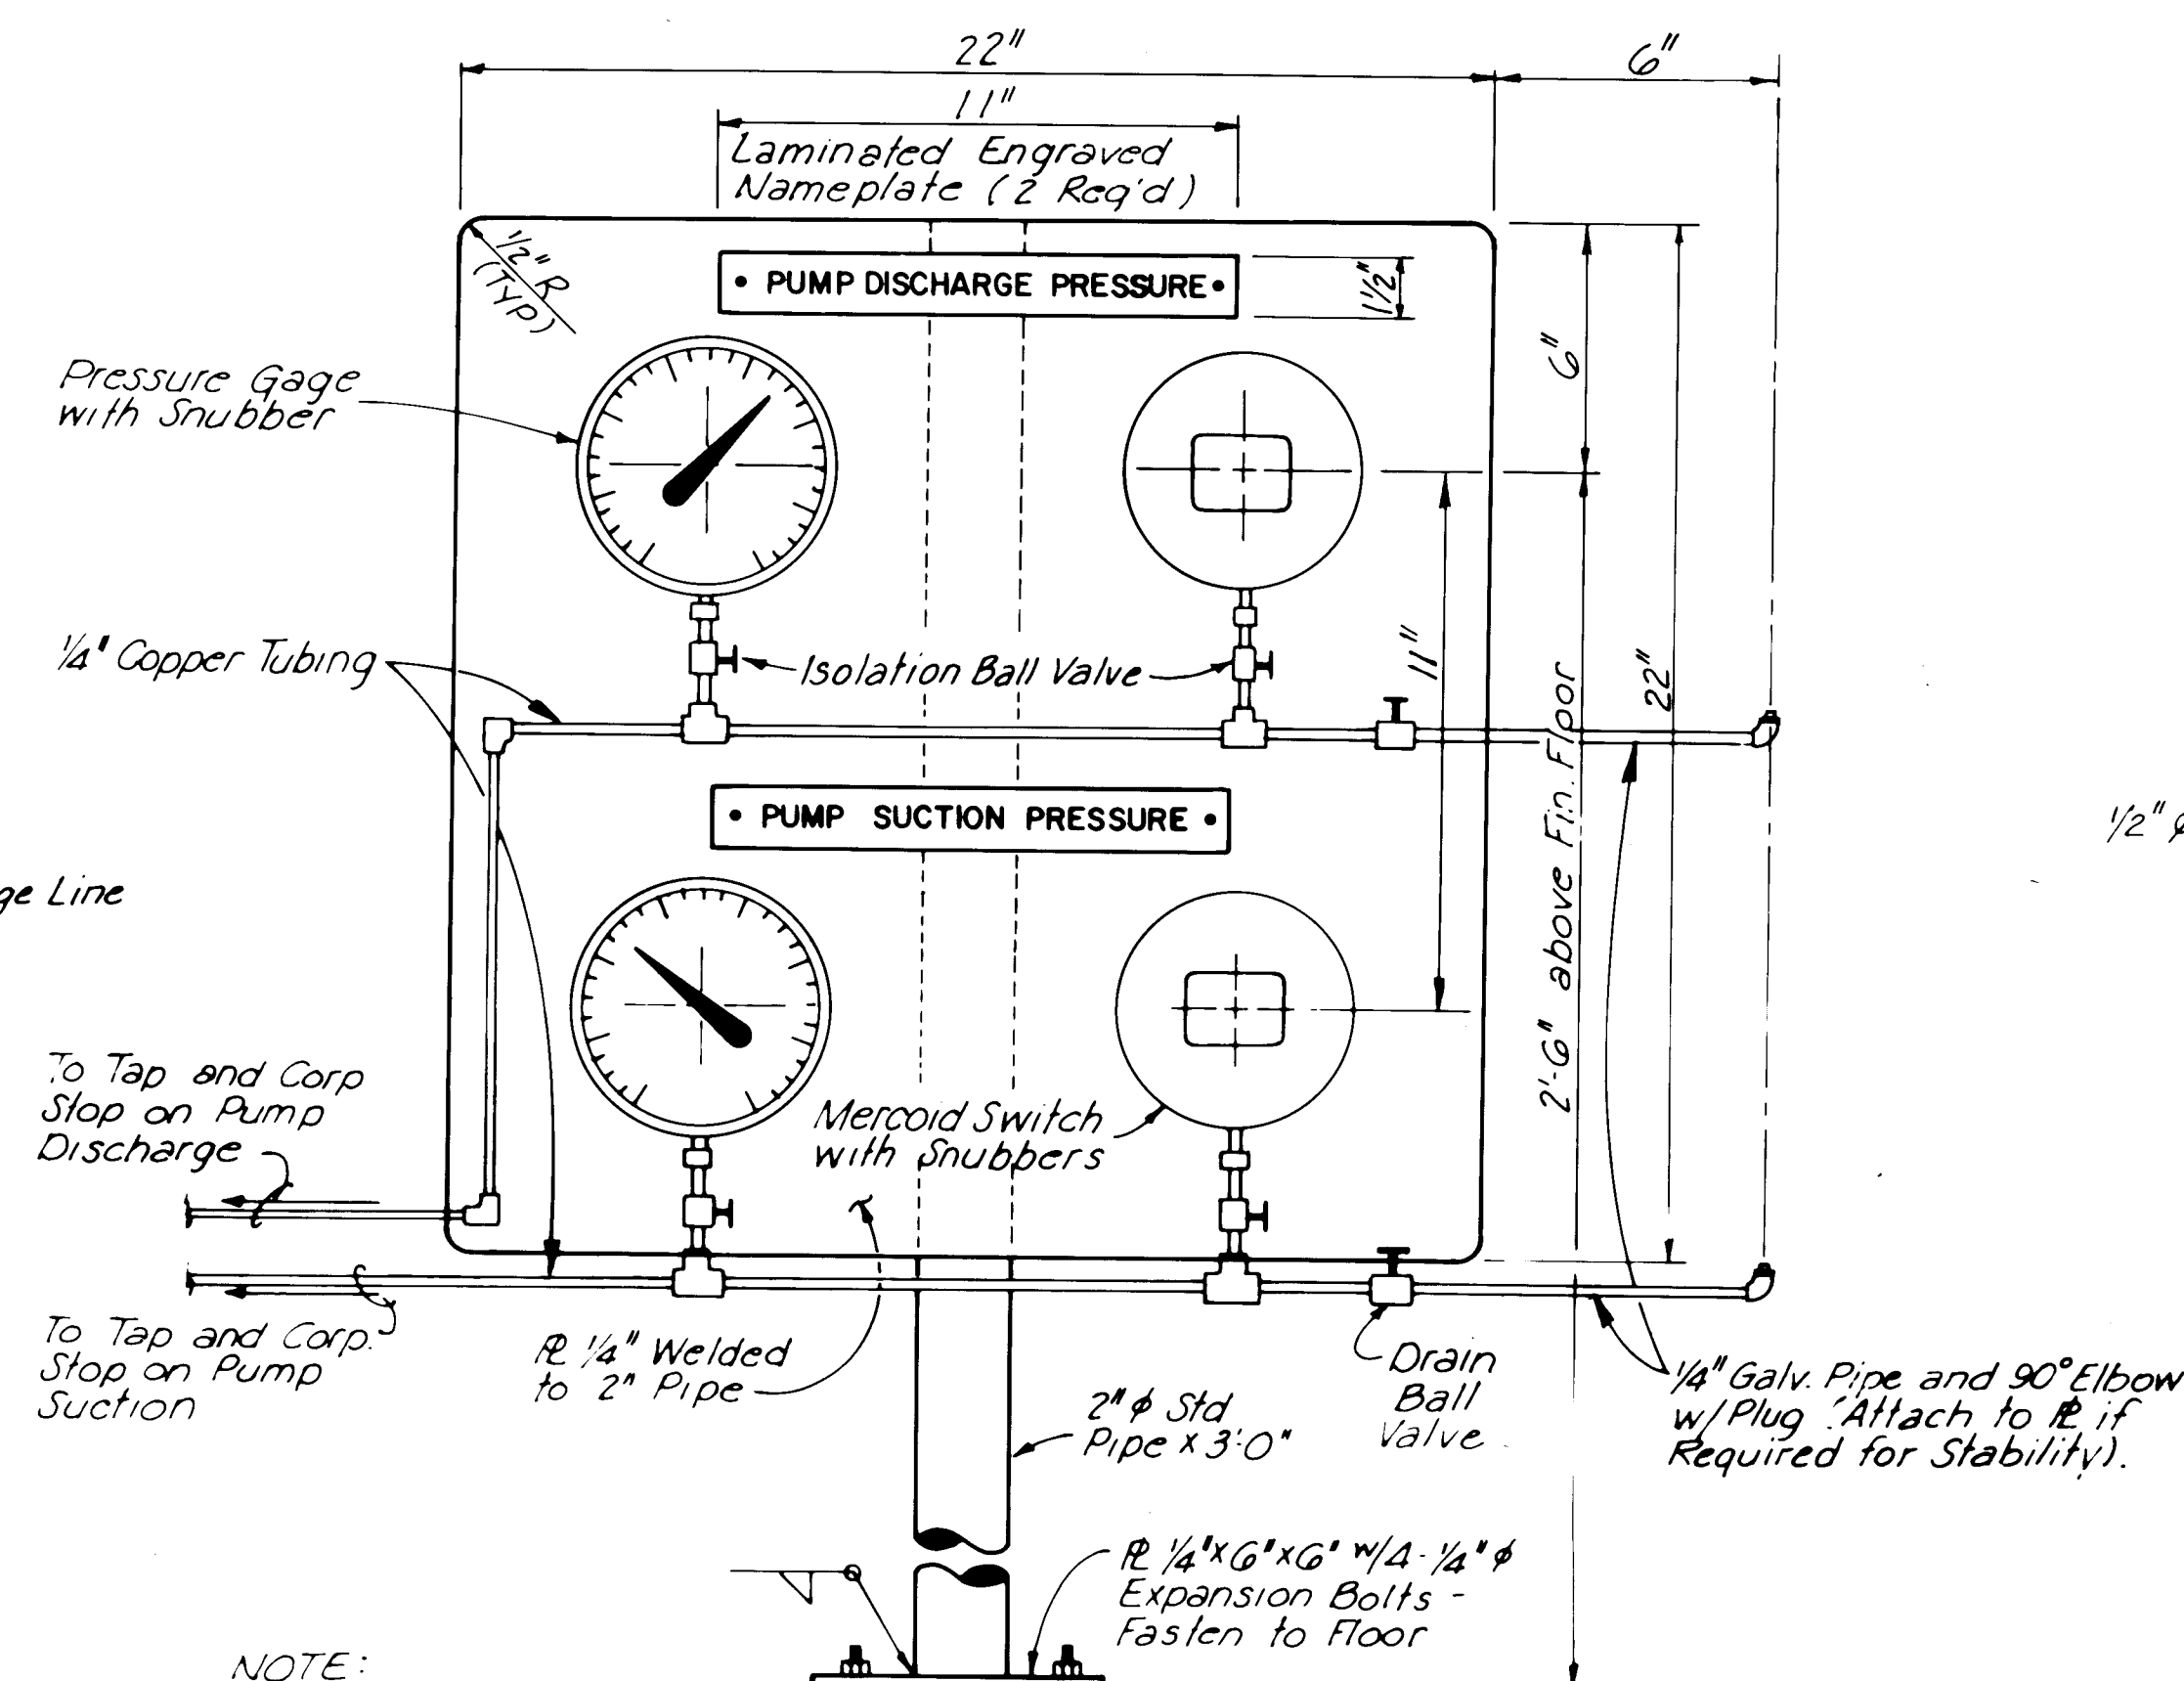

NOTE:
For locations, see
Floor and Piping Plan.
Electrical Conduit not
shown for clarity.


2 PRESSURE GAGE STAND DETAIL
10/14 NTS

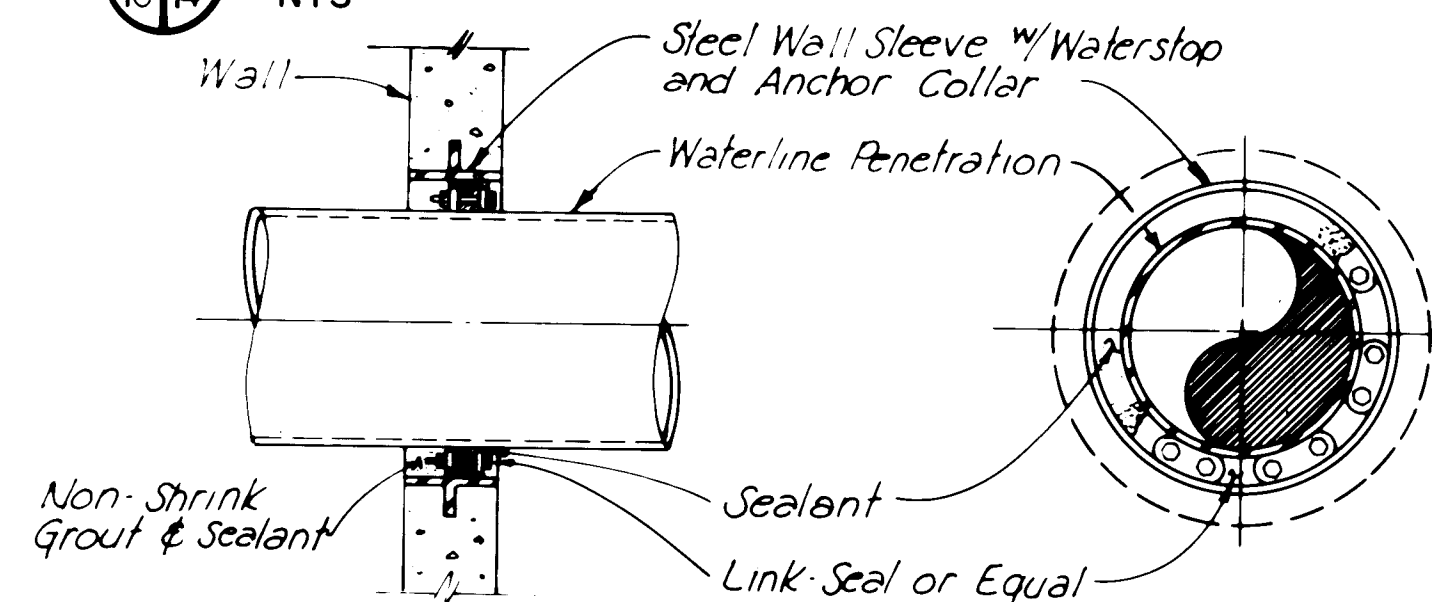


SECTION

ELEVATION

3 WALL PENETRATION DETAIL
10/14 NTS

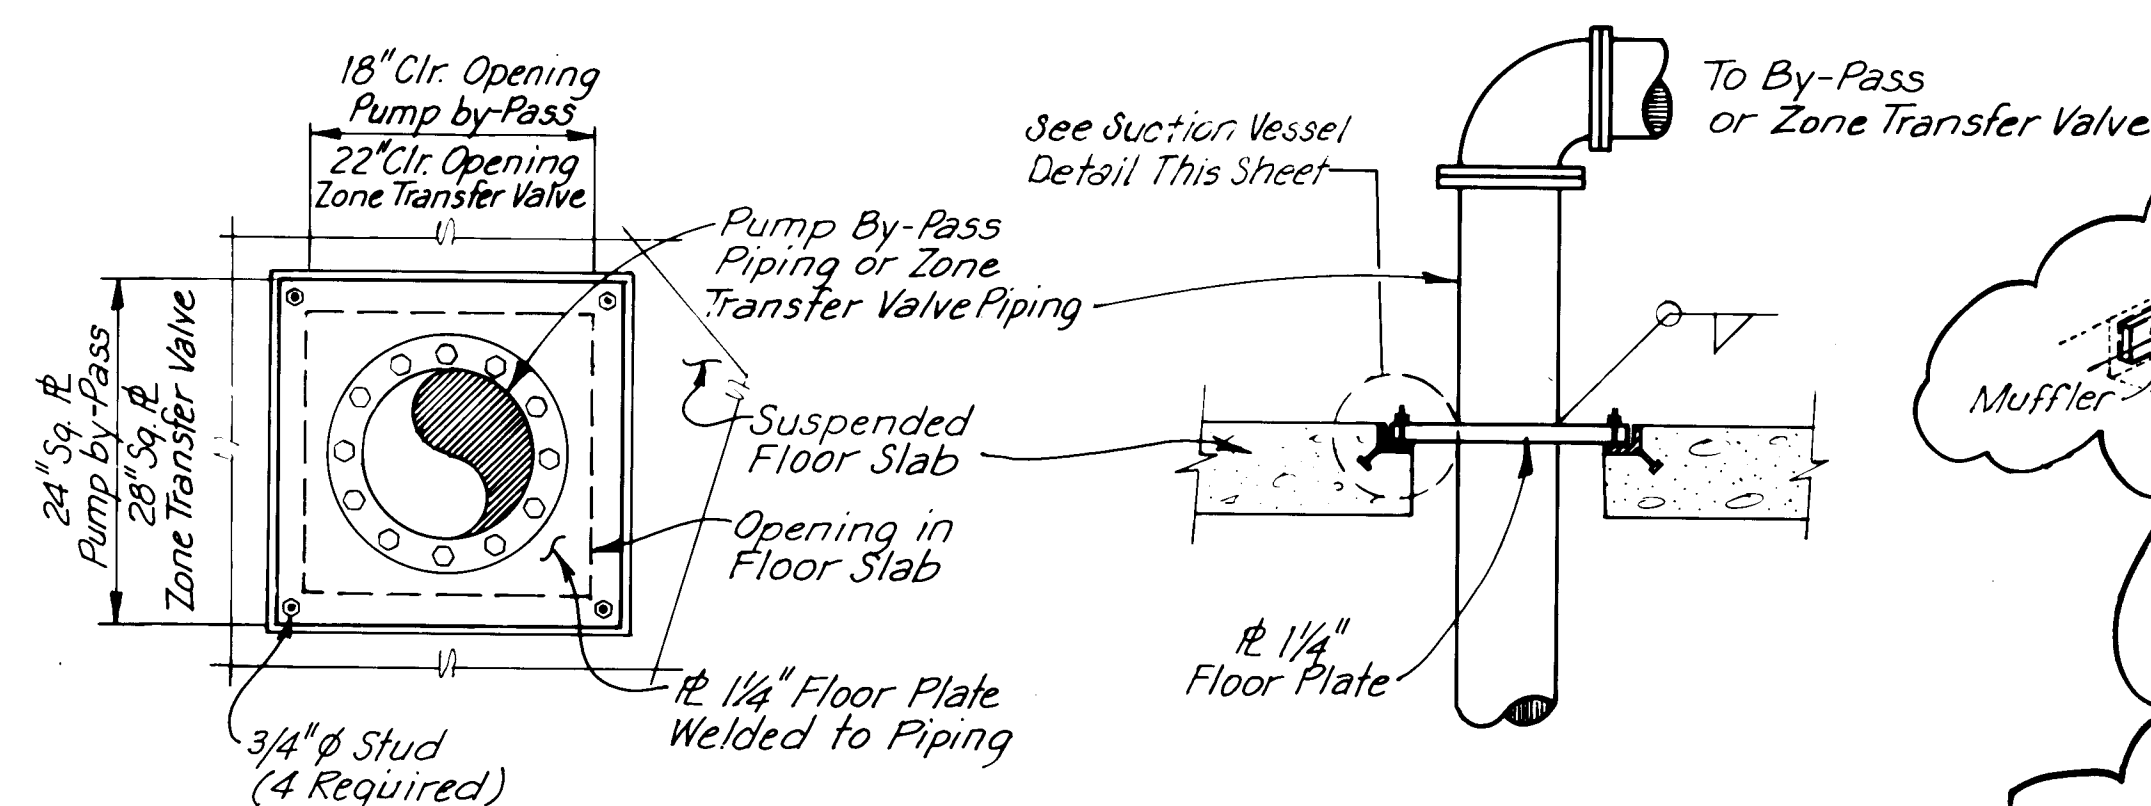


4 PIPE FLOOR PLATE DETAIL
7/14 NTS

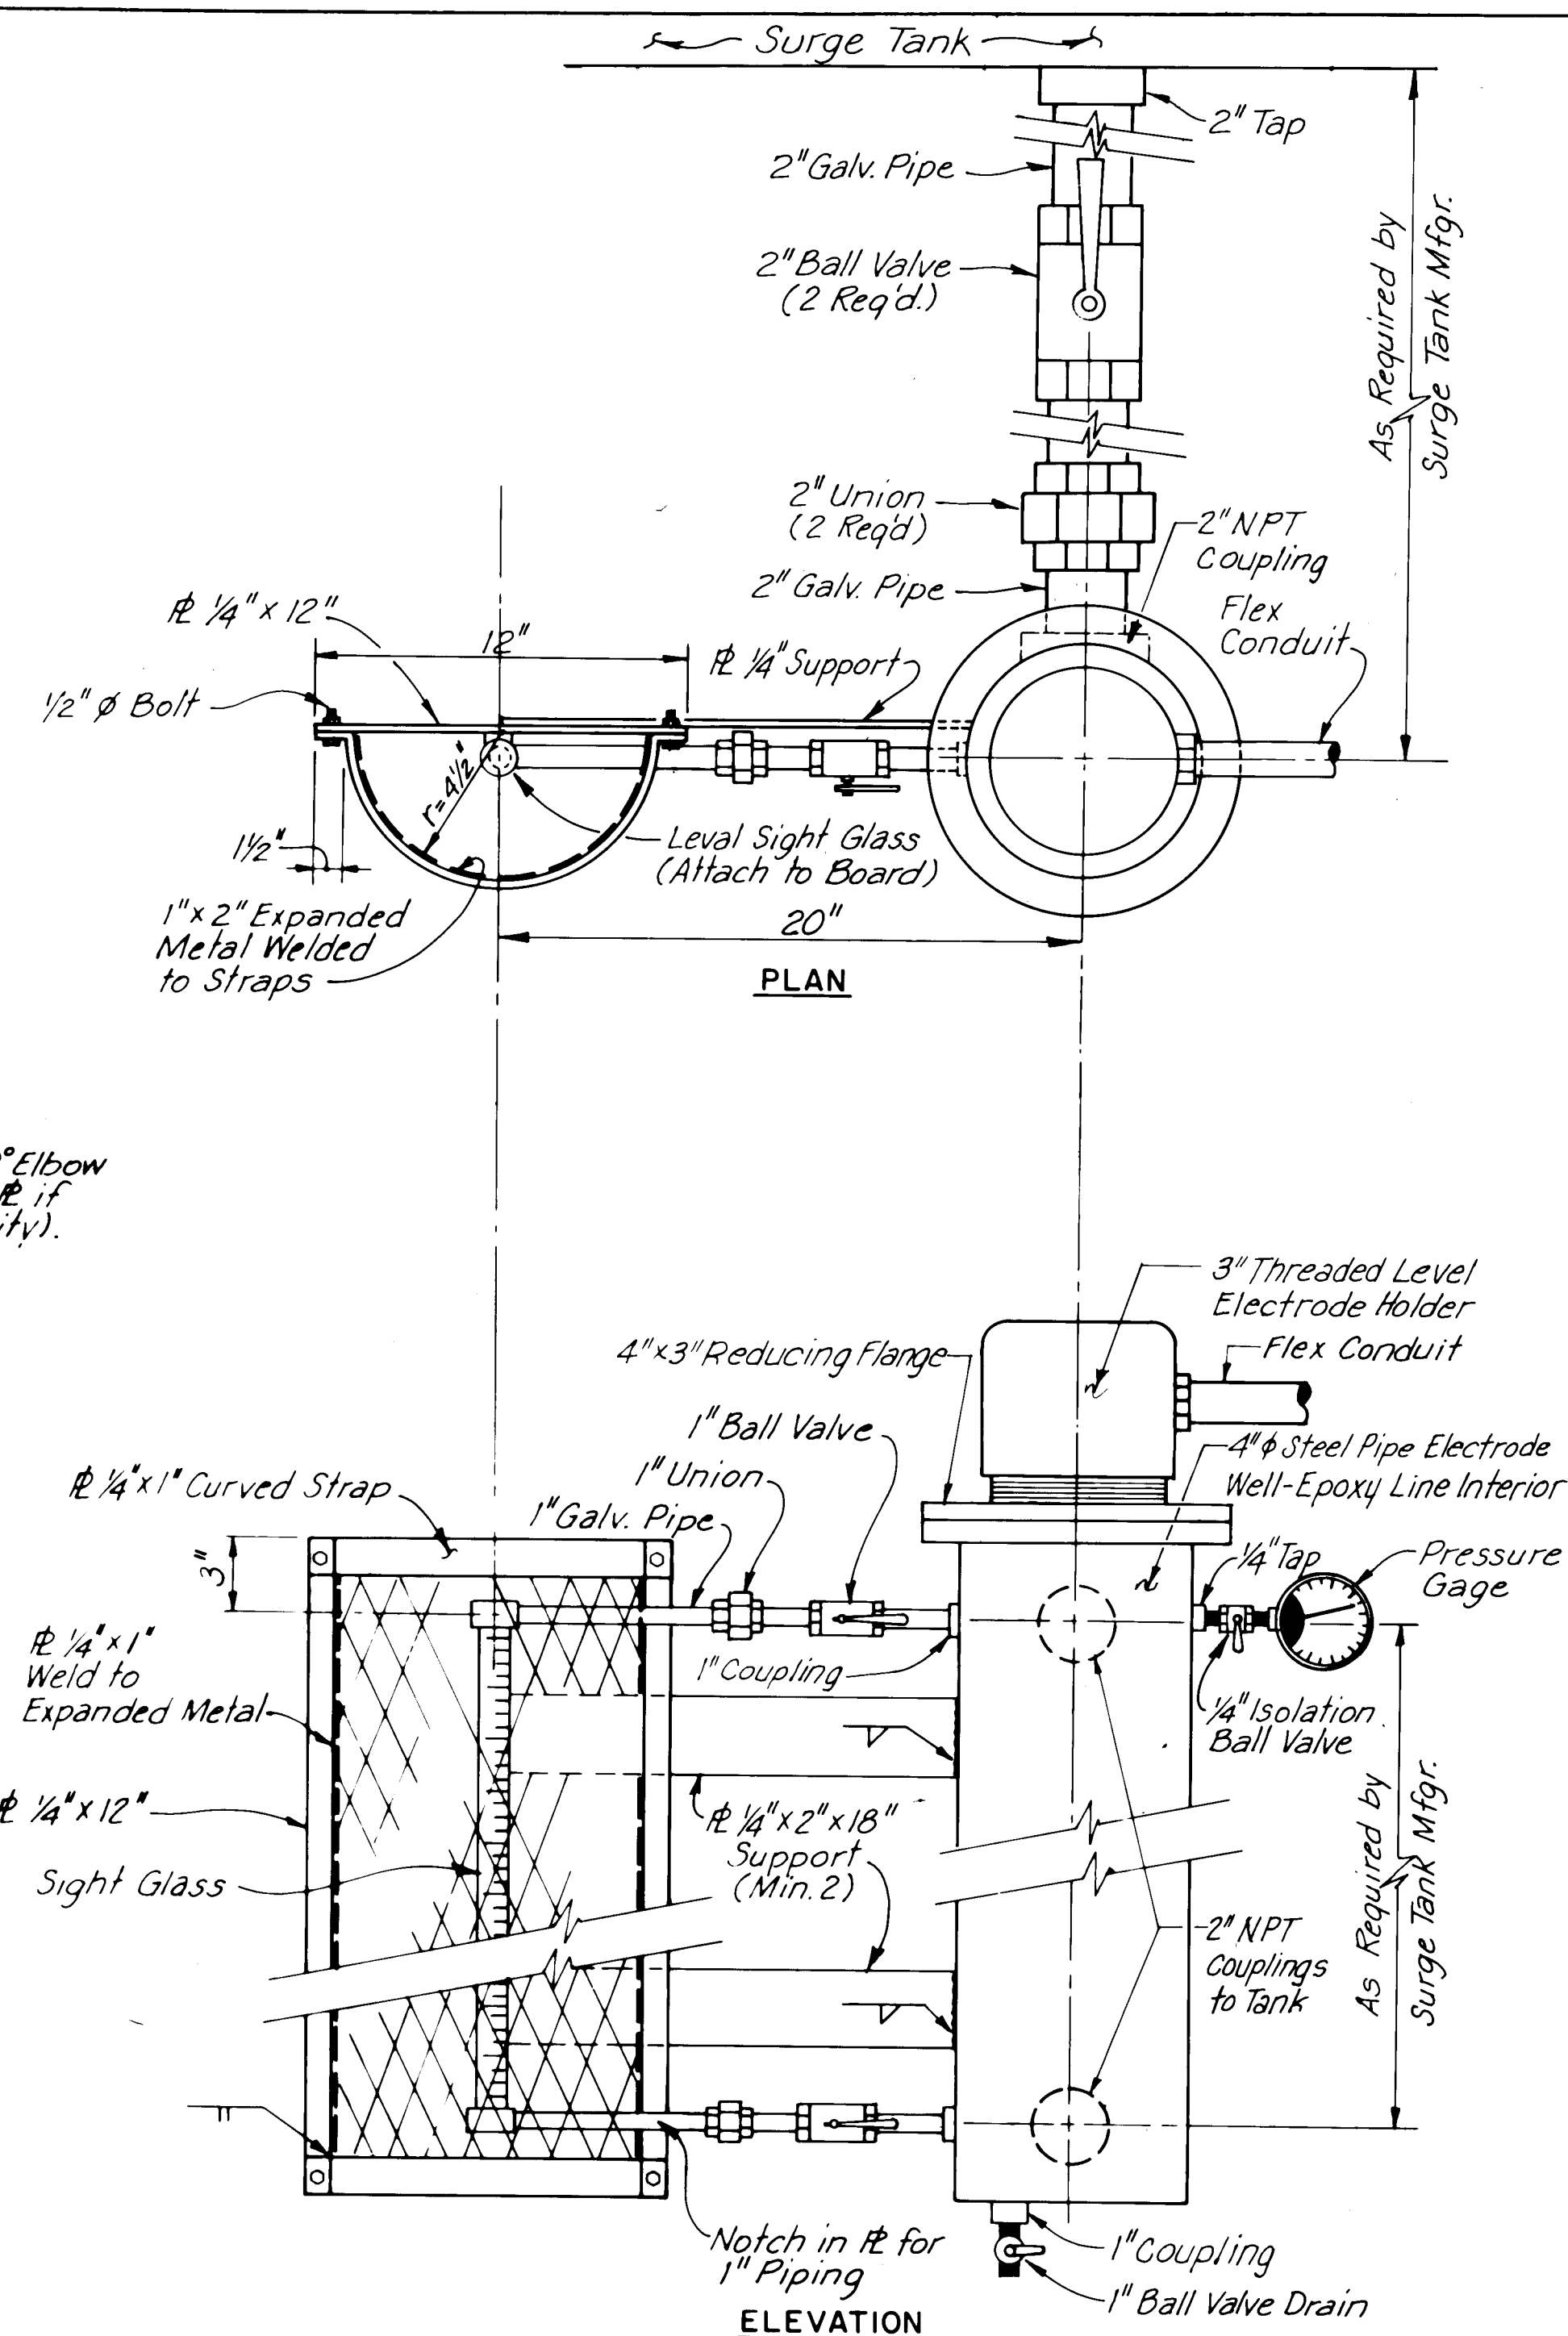

ELEVATION

5 SURGE TANK PROBE WELL DETAIL
9/14 NTS

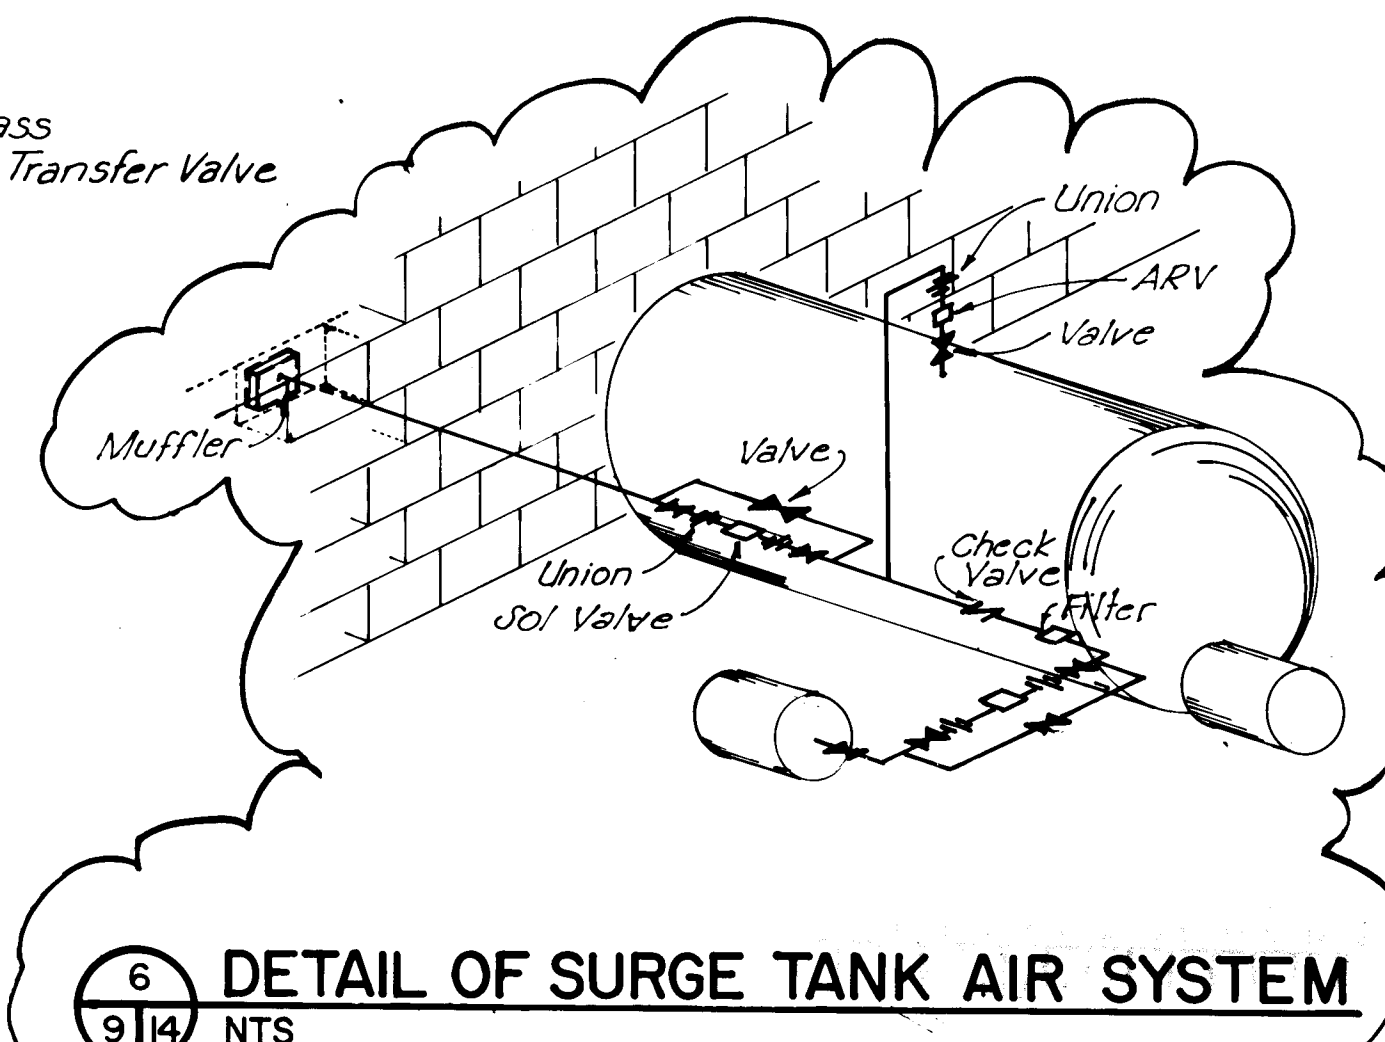

6 DETAIL OF SURGE TANK AIR SYSTEM
9/14 NTS

RECORD DRAWING
FEB 1992


These drawings have been reviewed for field data and every reasonable attempt has been made to depict construction as actually performed.

1 2 3 4 5 6 7 8 9 10 11 12 13 14 15


26 33 37 7 9 0 1 4 9 2

CITY OF ALBUQUERQUE PUBLIC WORKS DEPARTMENT ENGINEERING GROUP					
TITLE: GUTIERREZ PUMP STATION RECONSTRUCTION MISCELLANEOUS PIPING DETAILS					
APPROVALS	ENGINEER	DATE	APPROVALS	ENGINEER	DATE
DRC CHAIRMAN	<i>[Signature]</i>	11-13-90	WATER	R.W. Kane	11-13-90
TRANSPORTATION	N/A RHD	11-14-90	WASTE WATER	R.W. Kane	11-13-90
HYDROLOGY	LDM	11-15-90			
PROJECT NO.	3337.90	MAP NO.	F-22	SHEET	14 OF 15

AS BUILT INFORMATION		BENCH MARKS		SURVEY INFORMATION		ENGINEER'S SEAL	
CONTRACTOR	ALBUQUERQUE CONSTRUCTION Co.	NO.	DATE	NO.	DATE		
WORK	INSPECTION	NO.	DATE	NO.	DATE		
INSPECTOR	ALBUQUERQUE CONSTRUCTION Co.	NO.	DATE	NO.	DATE	REVISIONS	BY
ACCEPTANCE	ALBUQUERQUE CONSTRUCTION Co.	NO.	DATE	NO.	DATE	DESIGN	DATE
FIELD	ALBUQUERQUE CONSTRUCTION Co.	NO.	DATE	NO.	DATE	NO.	DATE
DRAWINGS	ALBUQUERQUE CONSTRUCTION Co.	NO.	DATE	NO.	DATE	NO.	DATE
CORRECTED	ALBUQUERQUE CONSTRUCTION Co.	NO.	DATE	NO.	DATE	NO.	DATE
MICRO-FILM	ALBUQUERQUE CONSTRUCTION Co.	NO.	DATE	NO.	DATE	NO.	DATE
RECORDED	ALBUQUERQUE CONSTRUCTION Co.	NO.	DATE	NO.	DATE	NO.	DATE

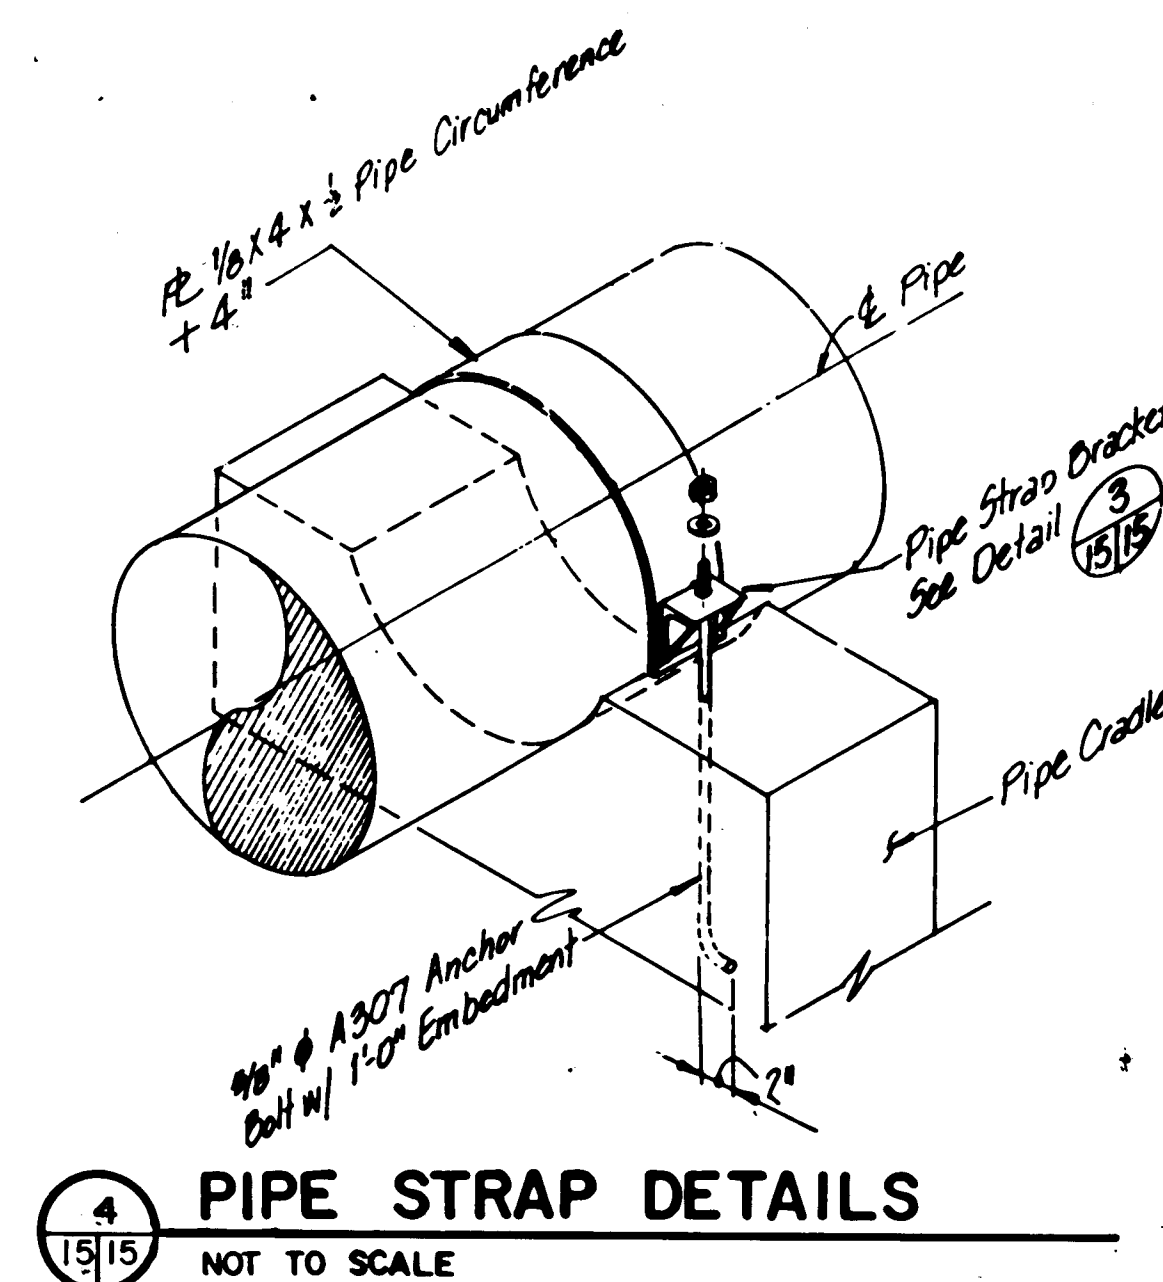

4 **PIPE STRAP DETAILS**
15/15 NOT TO SCALE

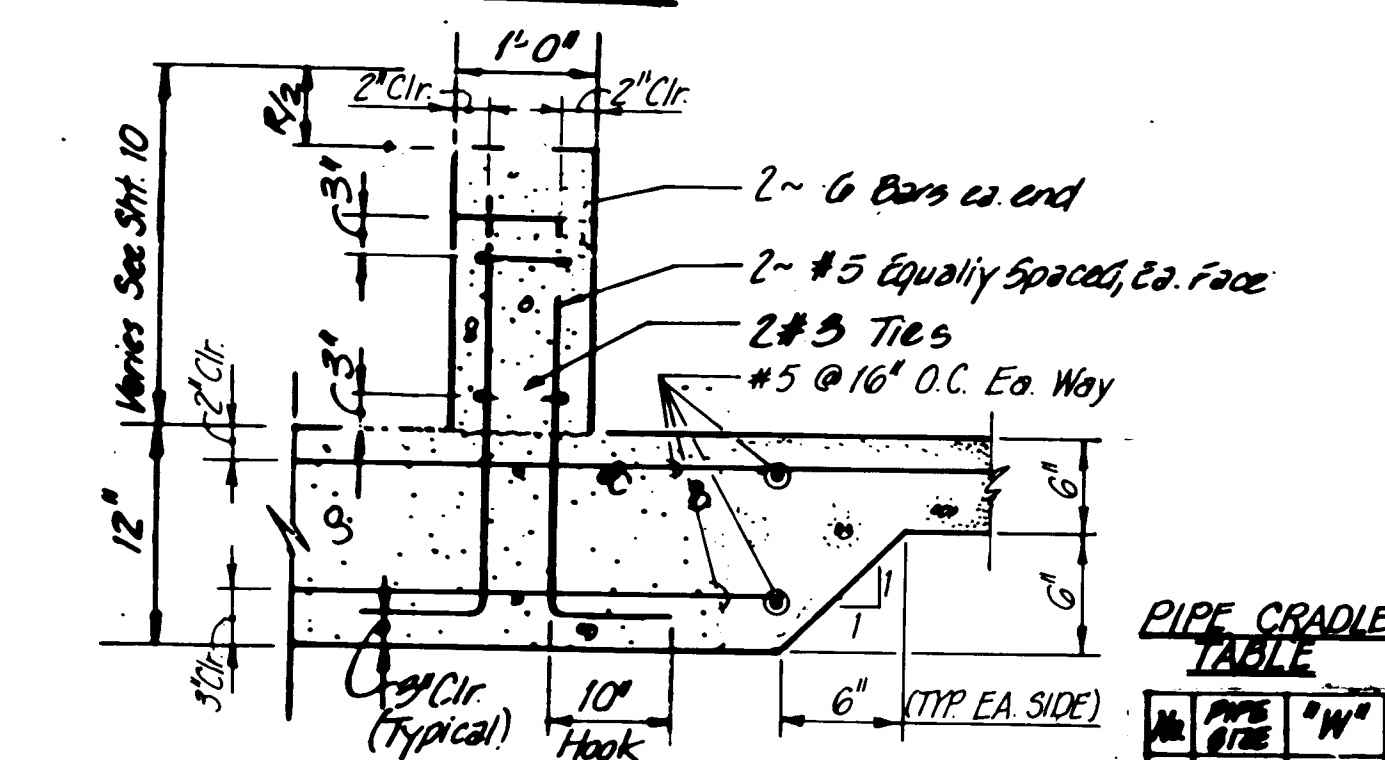

SECTION A-A


PIPE CRADLE DETAILS

NOT TO SCALE

<u>No.</u>	<u>PIPE</u> <u>SIZE</u>	<u>"W"</u>
1	42"	54"
2	30"	42"
3	24"	36"


3 PIPE STRAP BRACKET DETAILS

SCALE: 1/8" = 1'

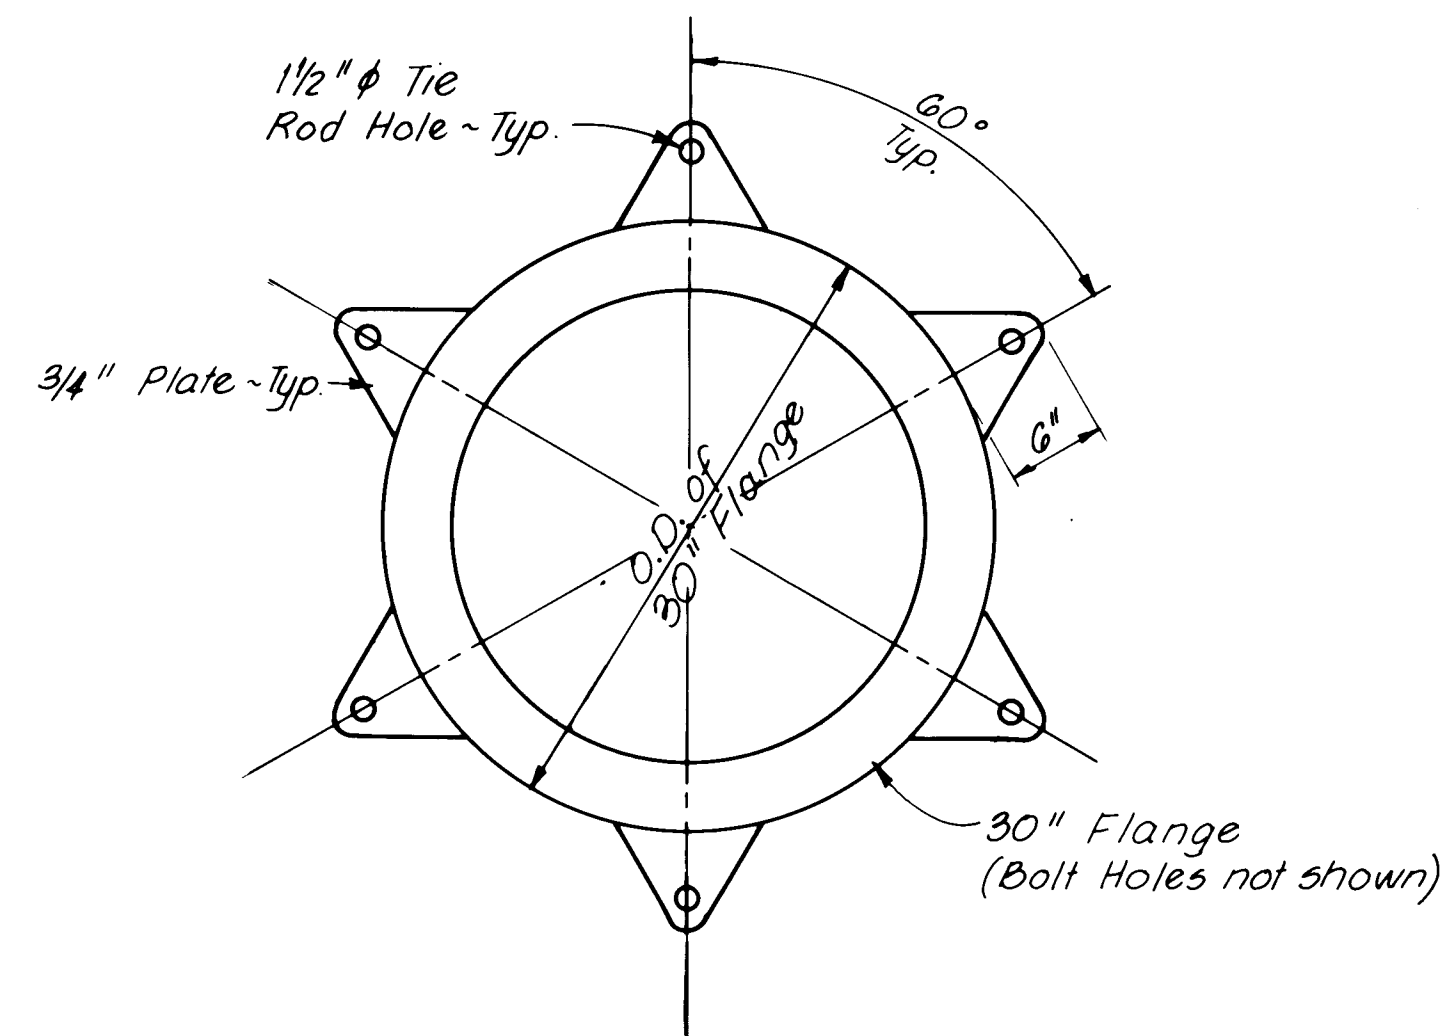

5 HARNESS LUG DETAIL


SCALE: 1" = 1' - 0"

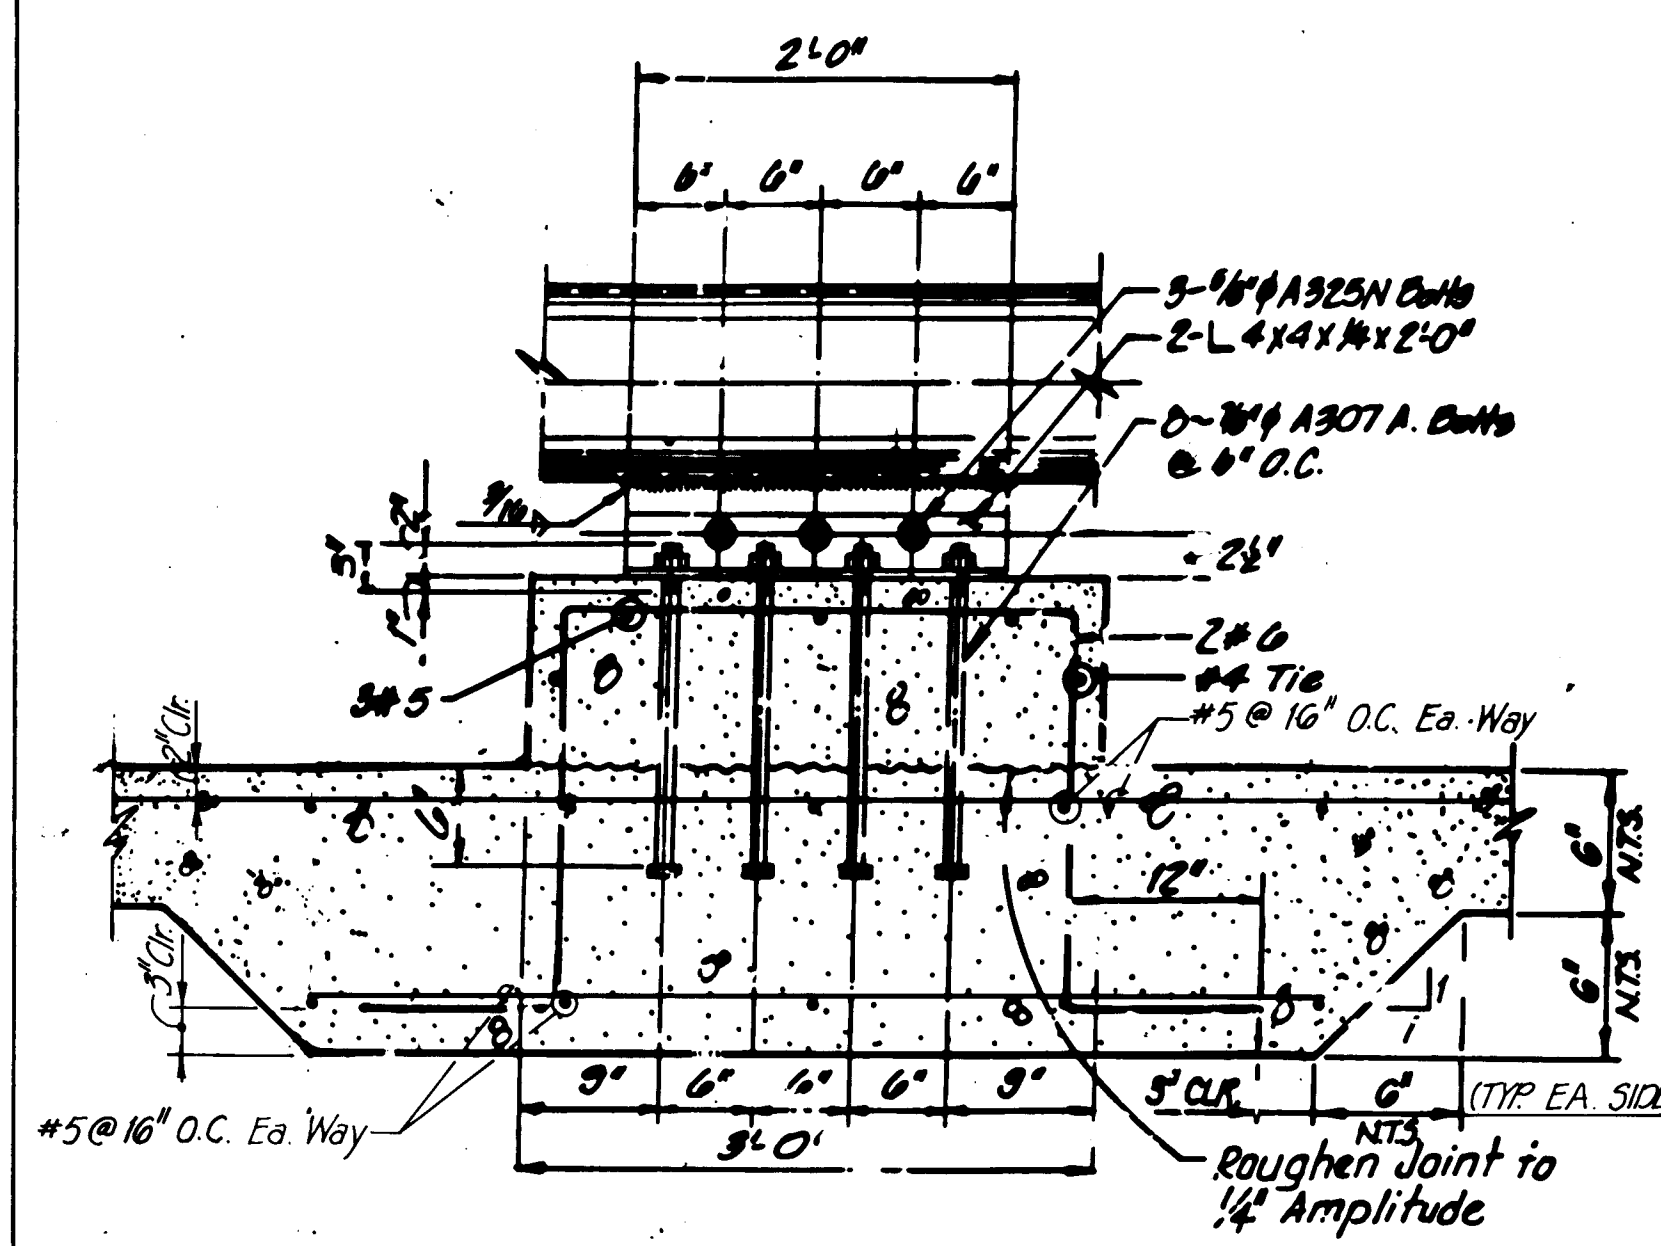


LONGITUDINAL SECTION

PIPE RESTRAINT BLOCK DETAILS

SCALE: 1" = 1' - 0"

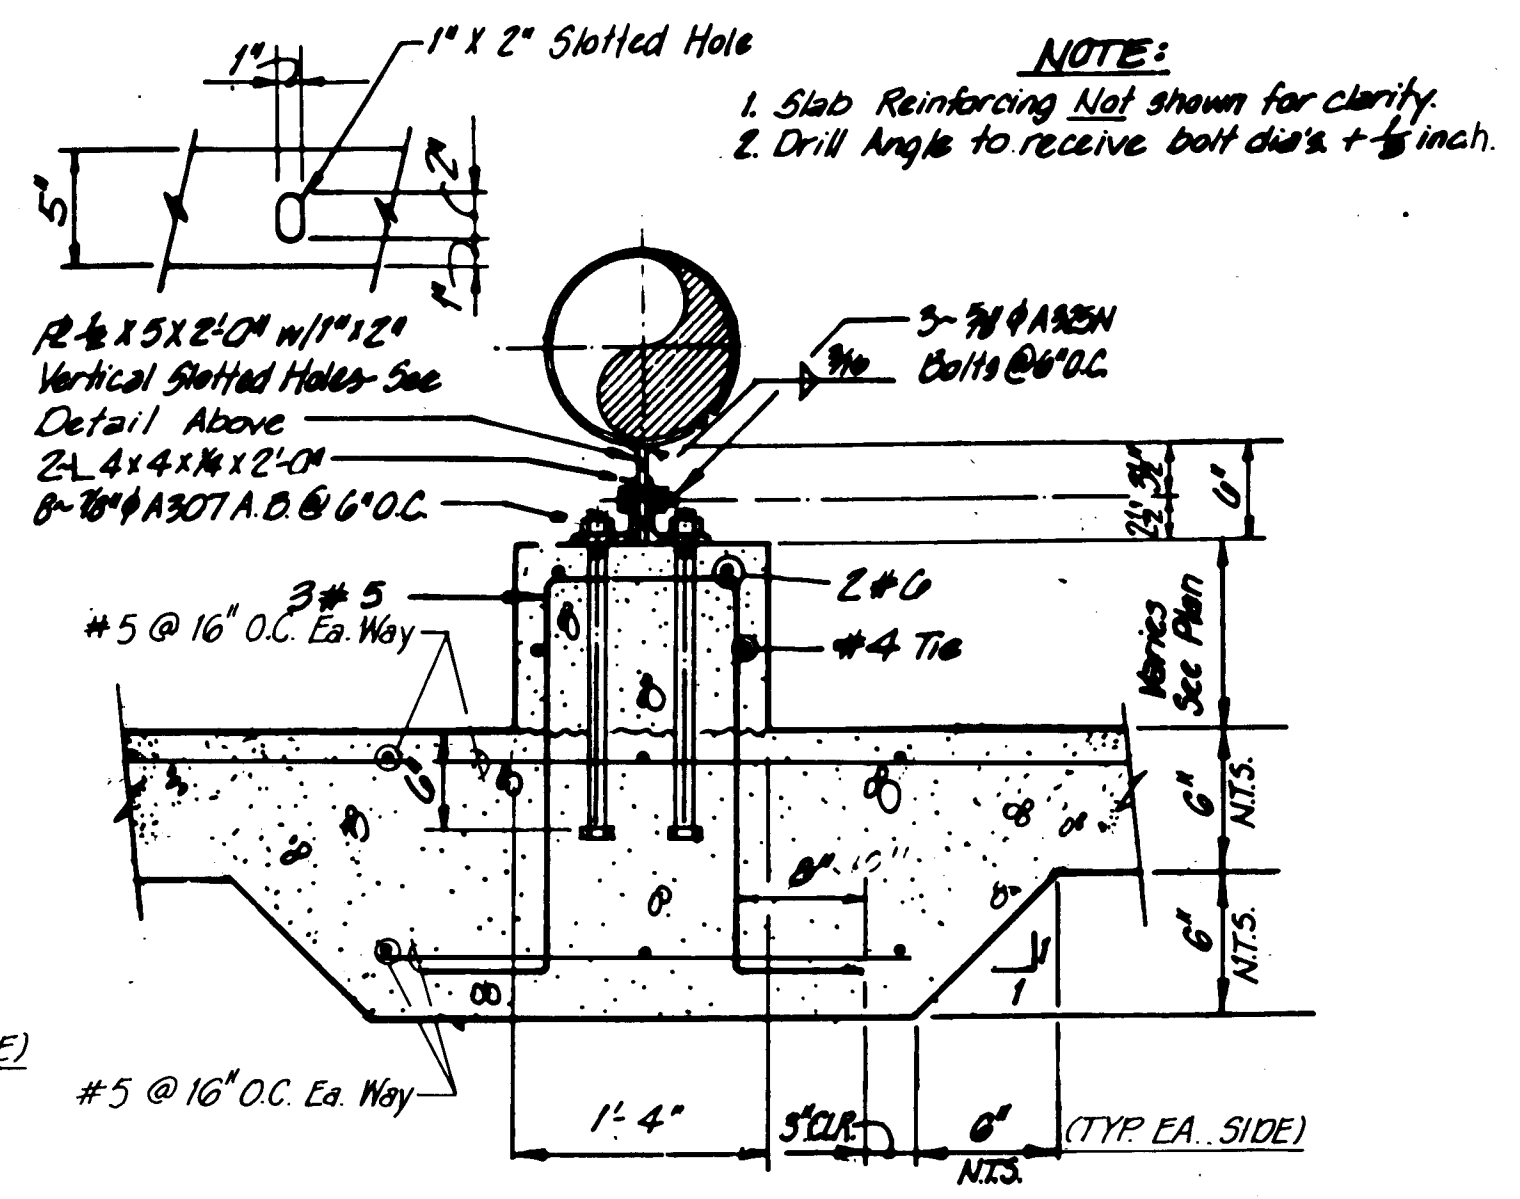

TRANSVERSE SECTION

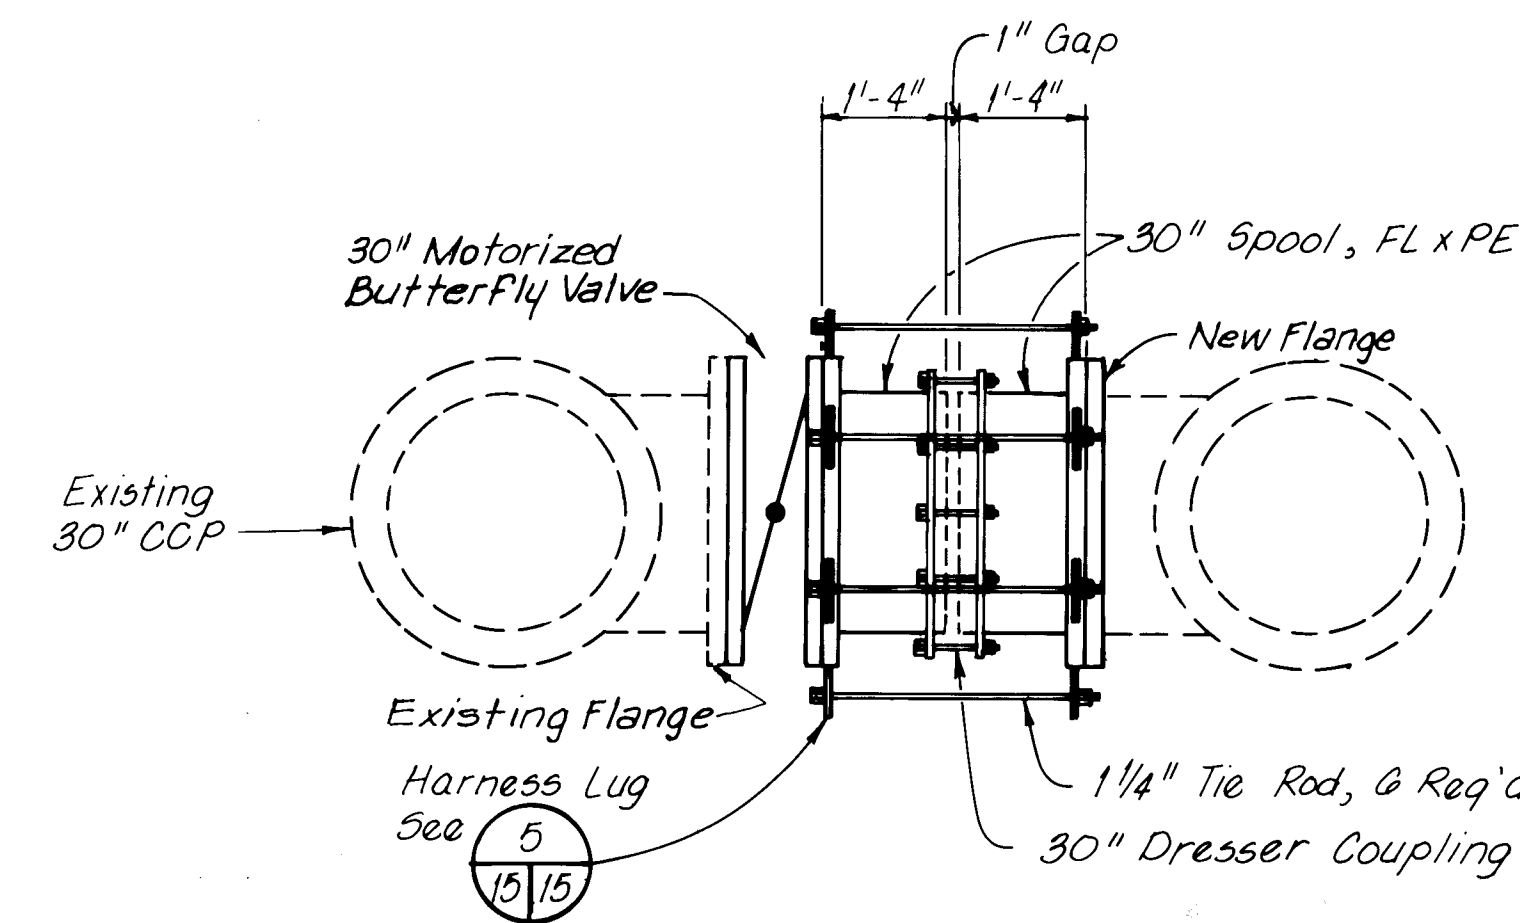

DETAIL - VALVE REPLACEMENT

AT BY PASS VALVE PIT

SCALE: 1/2" = 1'-0"

1	2	3	4	5	6	7	8	9	10	11	12	13	14	15
2	6		3	3	3	7		9	0	1	5	9	2	

RECORD DRAWING
FEB 1992

These drawings have been



on field data and every reasonable attempt
has been made to depict construction
actually performed.

CITY OF ALBUQUERQUE
PUBLIC WORKS DEPARTMENT
ENGINEERING GROUP

TITLE: GUTIERREZ PUMP STATION RECONSTRUCTION
PIPE CRADLE, RESTRAINT AND STRAP DETAILS

APPROVALS	ENGINEER	DATE	APPROVALS	ENGINEER	DATE
DRC CHAIRMAN	<i>R. W. Kane</i>	11-16-90	WATER	<i>R. W. Kane</i>	11-13-90
TRANSPORTATION	<i>R. W. Kane</i>	11-16-90	WASTE WATER	<i>R. W. Kane</i>	11-13-90
HYDROLOGY	<i>L. D. ...</i>	11-15-90			

PROJECT NO.	3337.90	MAP NO.	F-22	SHEET	15	OF	15
-------------	---------	---------	------	-------	----	----	----

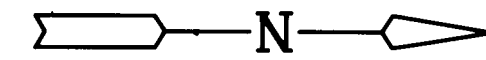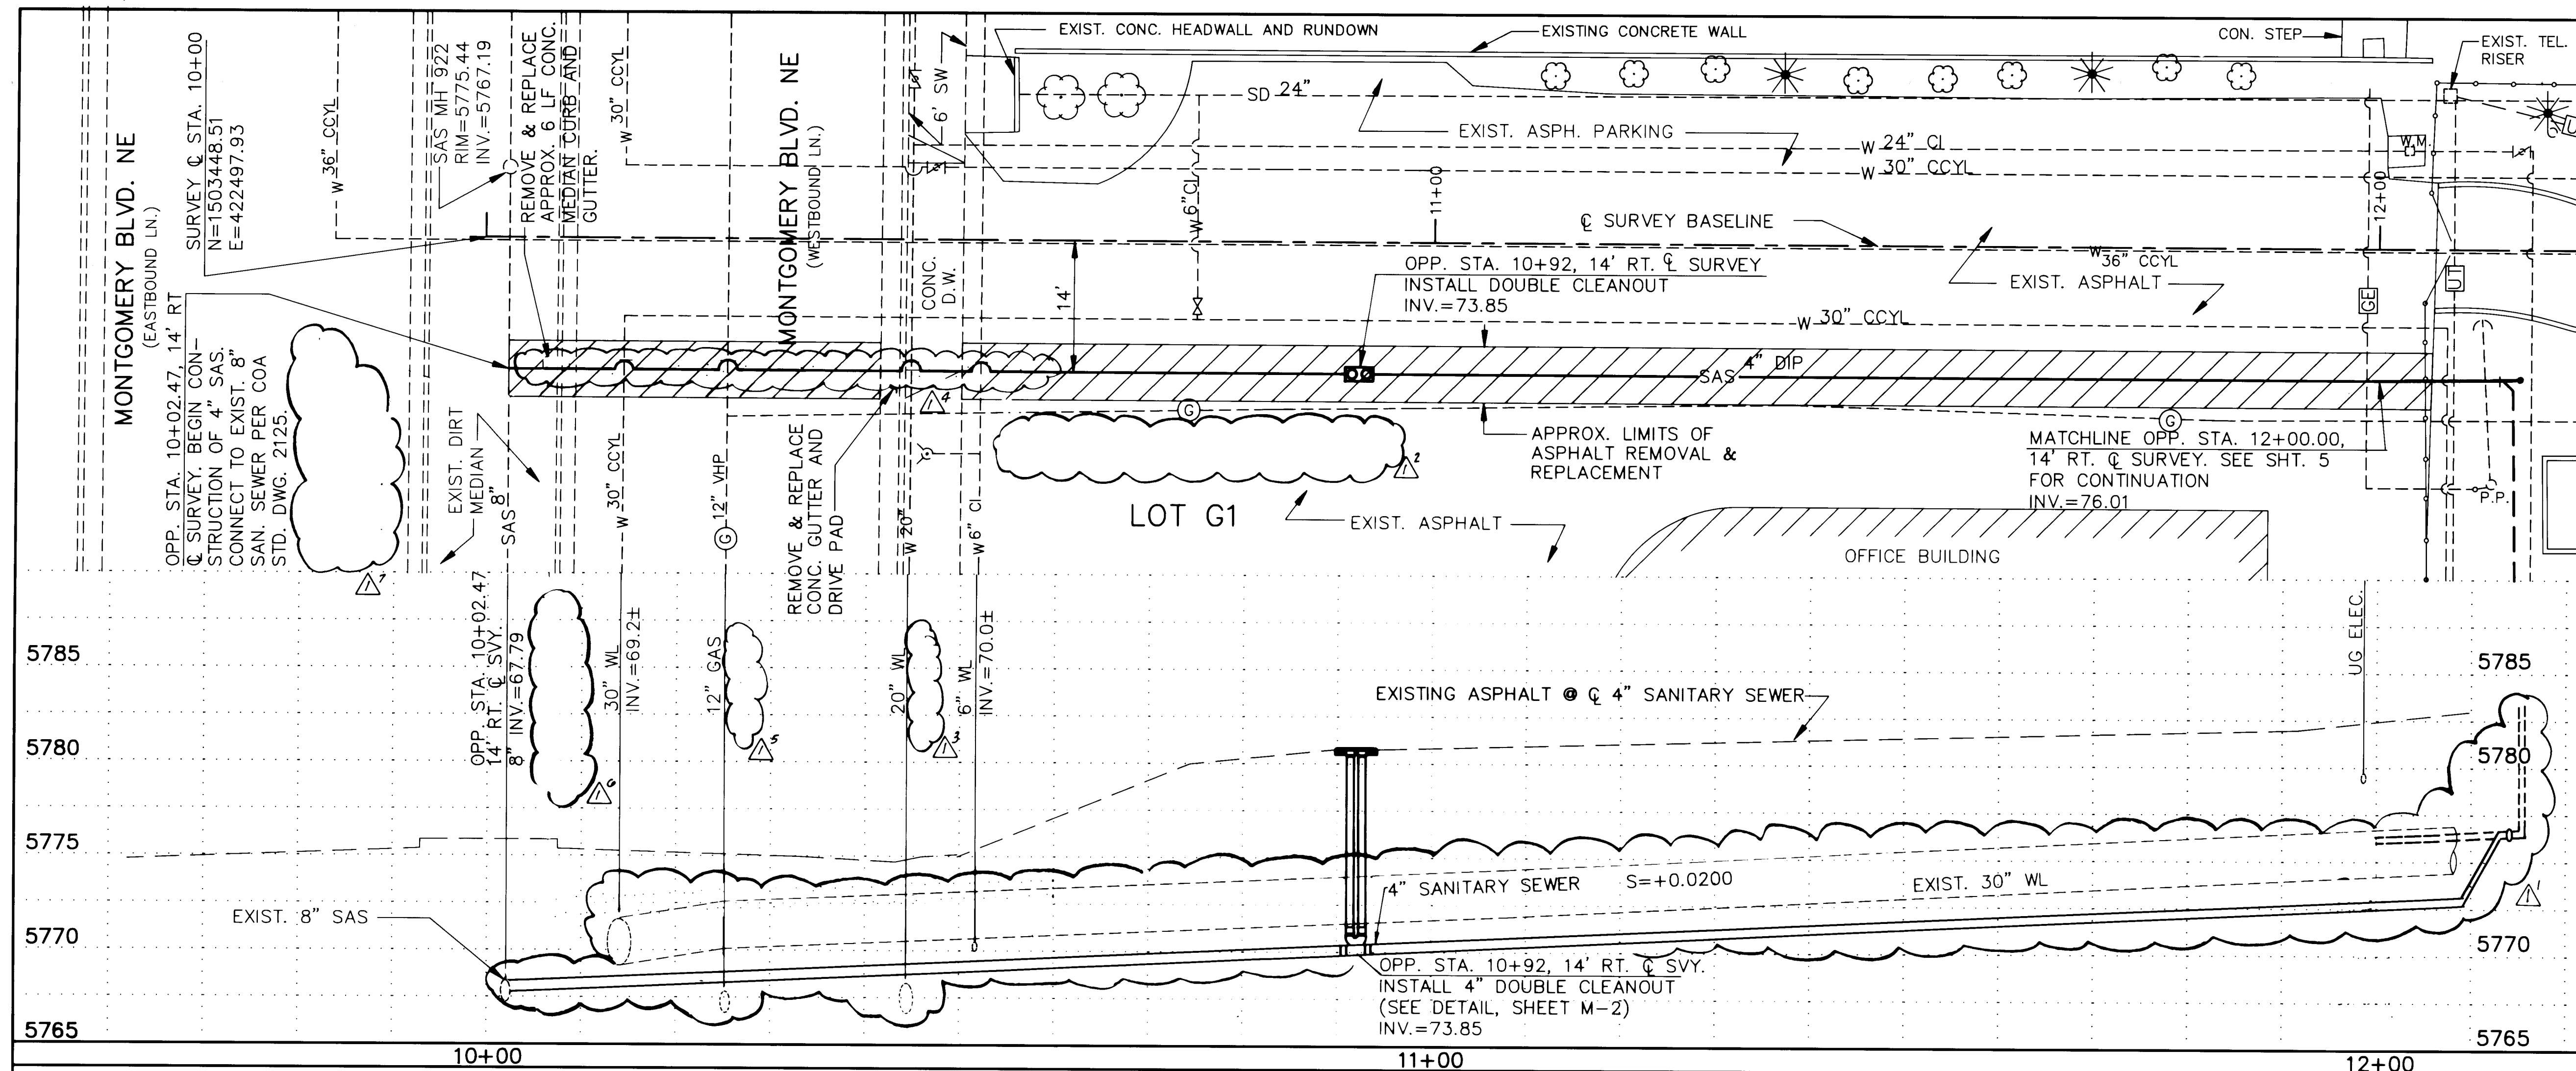

SCALE:
HORIZ. 1"=10'
VERT. 1"=5'

NOTES:

- EXISTING UTILITIES SHOWN ARE APPROXIMATE. CONTRACTOR TO FIELD VERIFY PRIOR TO TRENCHING.
- PAVEMENT REPLACEMENT SECTION IN MONTGOMERY BLVD. SHALL BE COA STD. DWG. 2465. (ARTERIAL)
- PAVEMENT REPLACEMENT SECTION IN PARKING LOT SHALL BE COA STD. DWG. 2465. (RESIDENTIAL)
- SUPPORT 30" CCYL WATERLINE AND/OR GAS LINE IF REQUIRED DURING CONSTRUCTION OF 4" SANITARY SEWER.

RECORD DRAWING

FSB 1052

These drawings have been reviewed based on field data and every reasonable attempt has been made to depict construction as actually performed.

8026.21CD1 / GUTIEPP.DWG


CITY OF ALBUQUERQUE
PUBLIC WORKS DEPARTMENT
ENGINEERING GROUP

TITLE:
GUTIERREZ PUMP STATION RECONSTRUCTION
4" SANITARY SEWER PLAN AND PROFILE


APPROVALS	ENGINEER	DATE	APPROVALS	ENGINEER	DATE
DRG CHAIRMAN	R. W. Kane	11-16-90	WATER	R. W. Kane	11-13-90
TRANSPORTATION	N/A	11-16-90	WASTE WATER	R. W. Kane	11-13-90
HYDROLOGY	Lon	11-15-90			

PROJECT NO. 3337 MAP NO. F-22 SHEET U-1 OF U-2


ENGINEER'S SEAL		SURVEY INFORMATION		BENCH MARKS		AS BUILT INFORMATION	
		FIELD NOTES		THE STATION IS AN AC BRASS TABLET STAMPED "10-F22A" LOCATED ON THE NORTH CURB OF MONTGOMERY BLVD. NE AT THE INTERSECTION OF MONTGOMERY BLVD. AND SHENANDOAH PL. NE. ELEVATION=5831.93 (1ST ORDER)		CONTRACTOR MCC Construction Co.	
		NO. 1.	DATE 5/90	BY ALBUQ. SURVEY		STAMPED BY SURVEYING CO. DATE 2/91	INSPECTOR'S SIGNATURE DATE 12/91
DESIGNED BY T. J. MARTINI		REVISIONS		MICRO-FILM INFORMATION		RECORDED BY	
DRAWN BY T. J. MARTINI		DATE JUNE 1990		NO.		DATE	
CHECKED BY E. C. LIVINGSTON		DATE JUNE 1990					

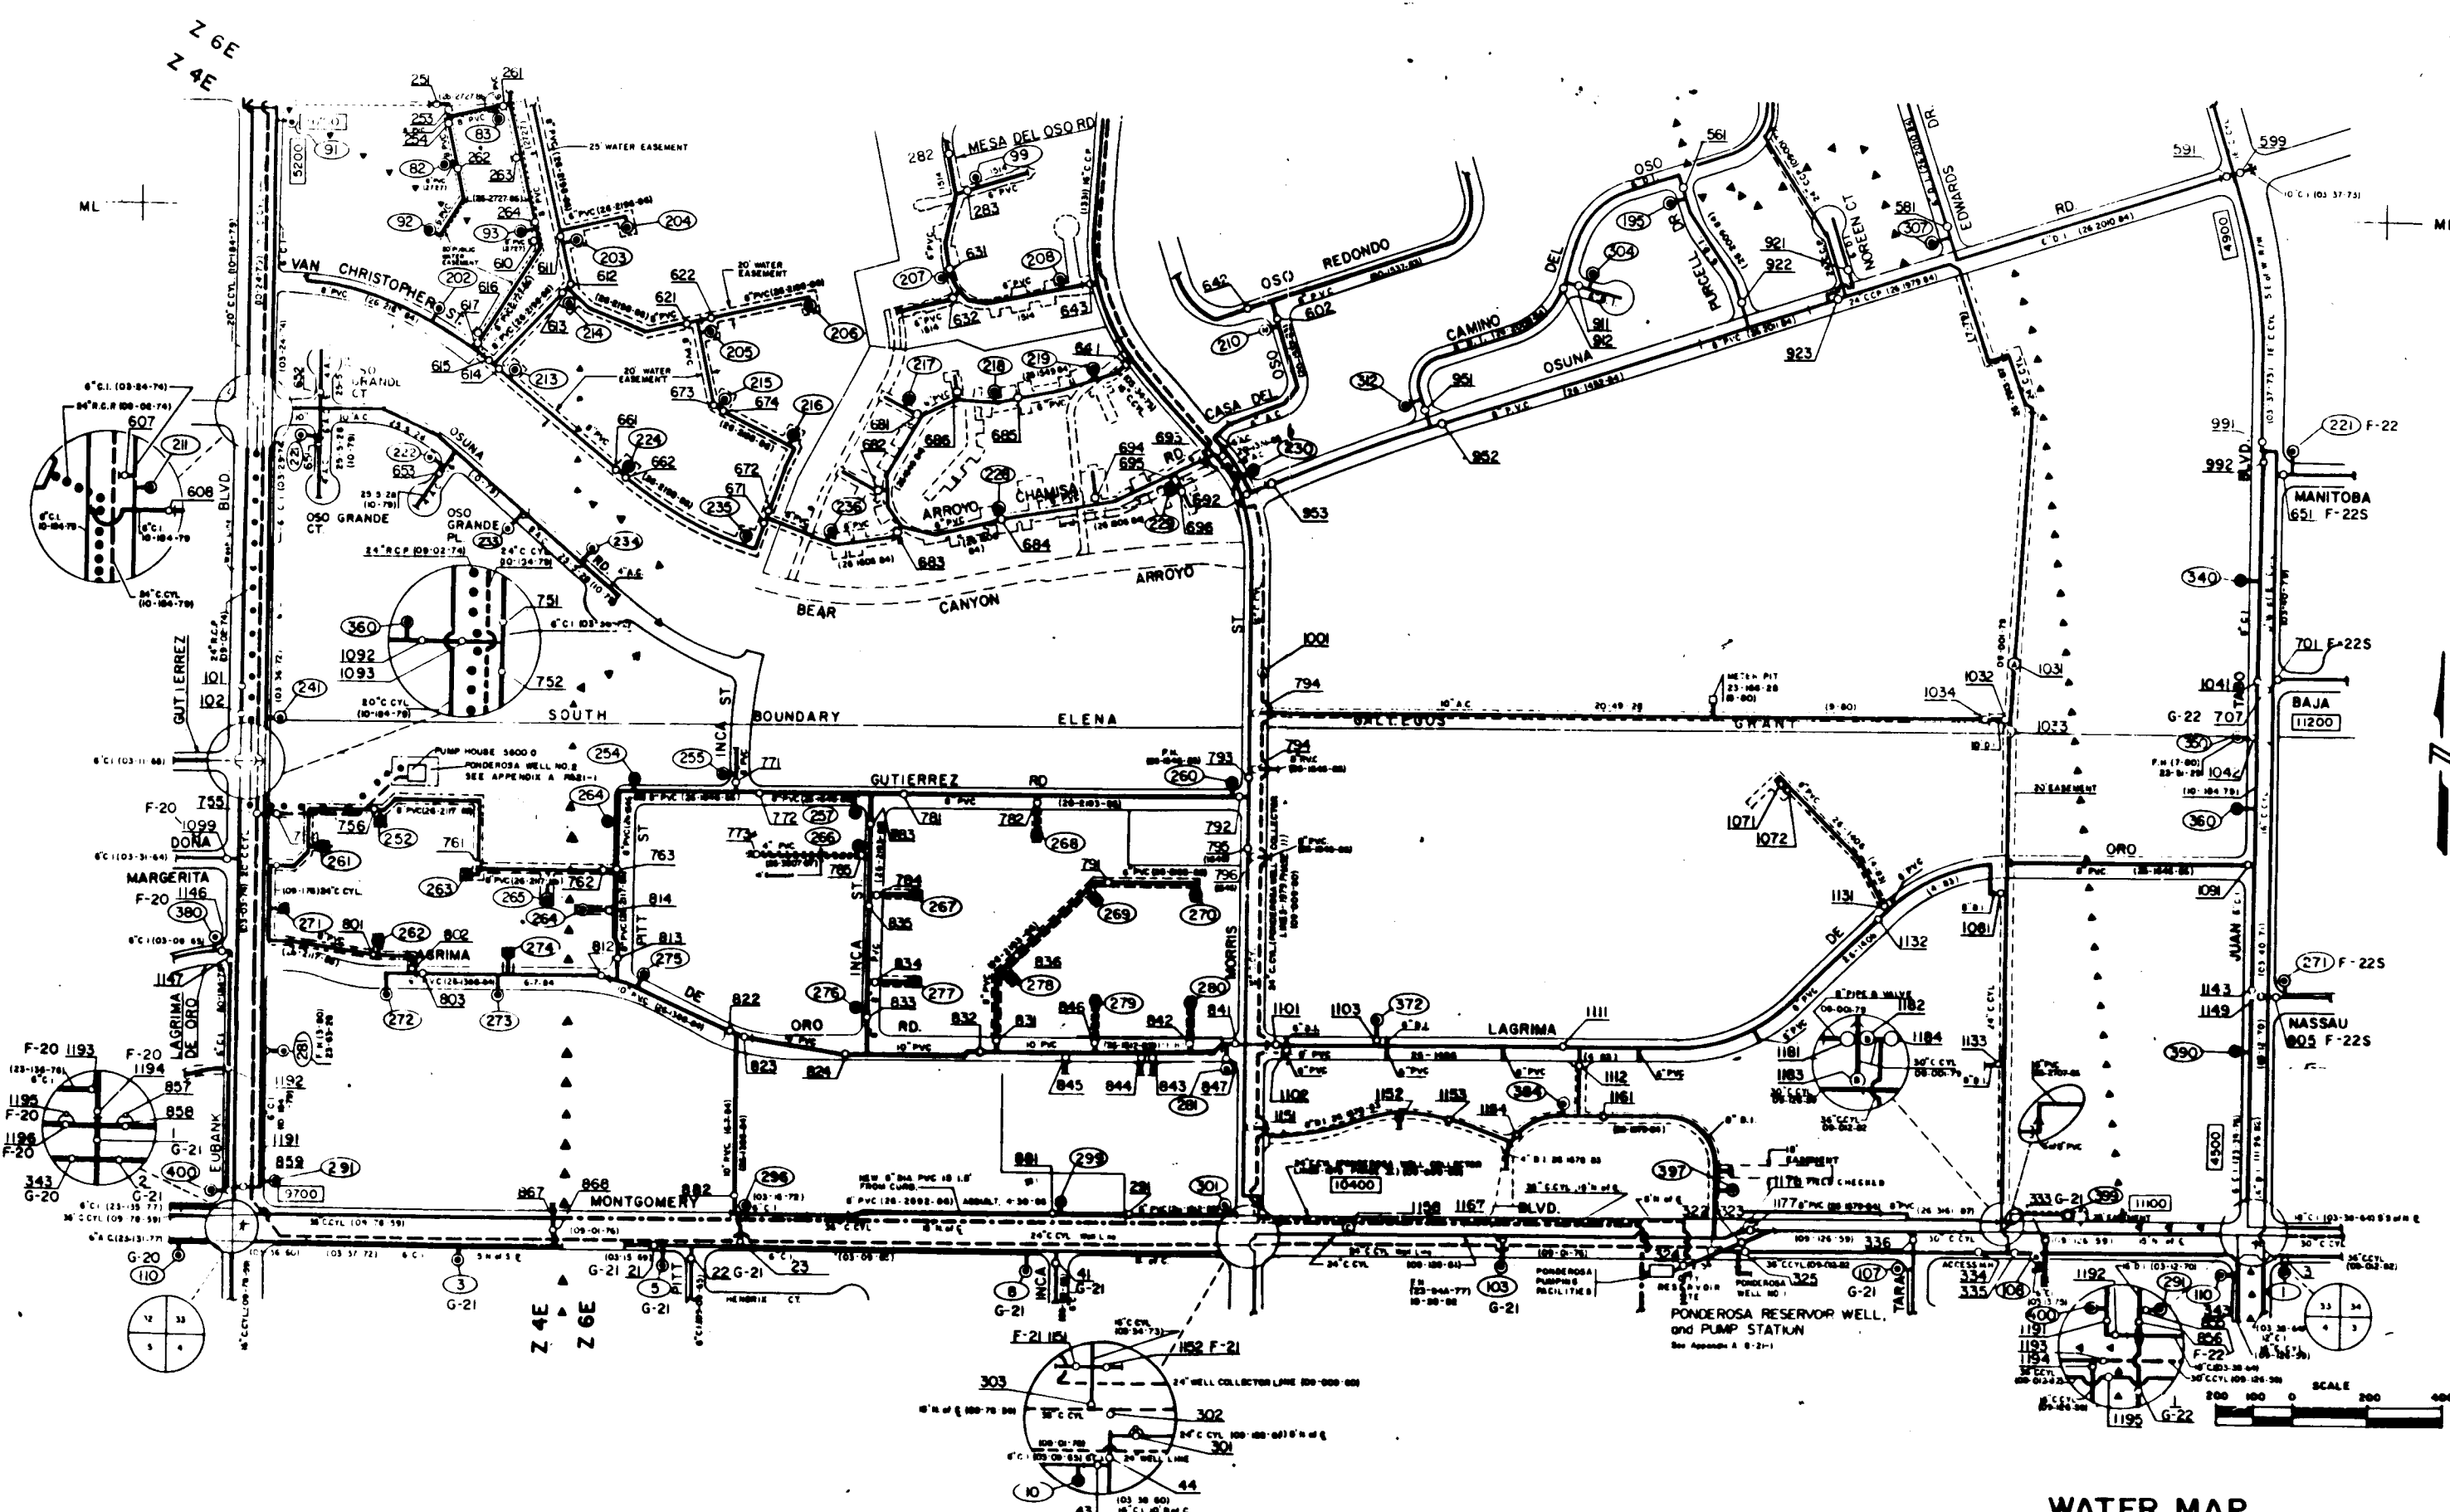

WATER MAP
F-21S

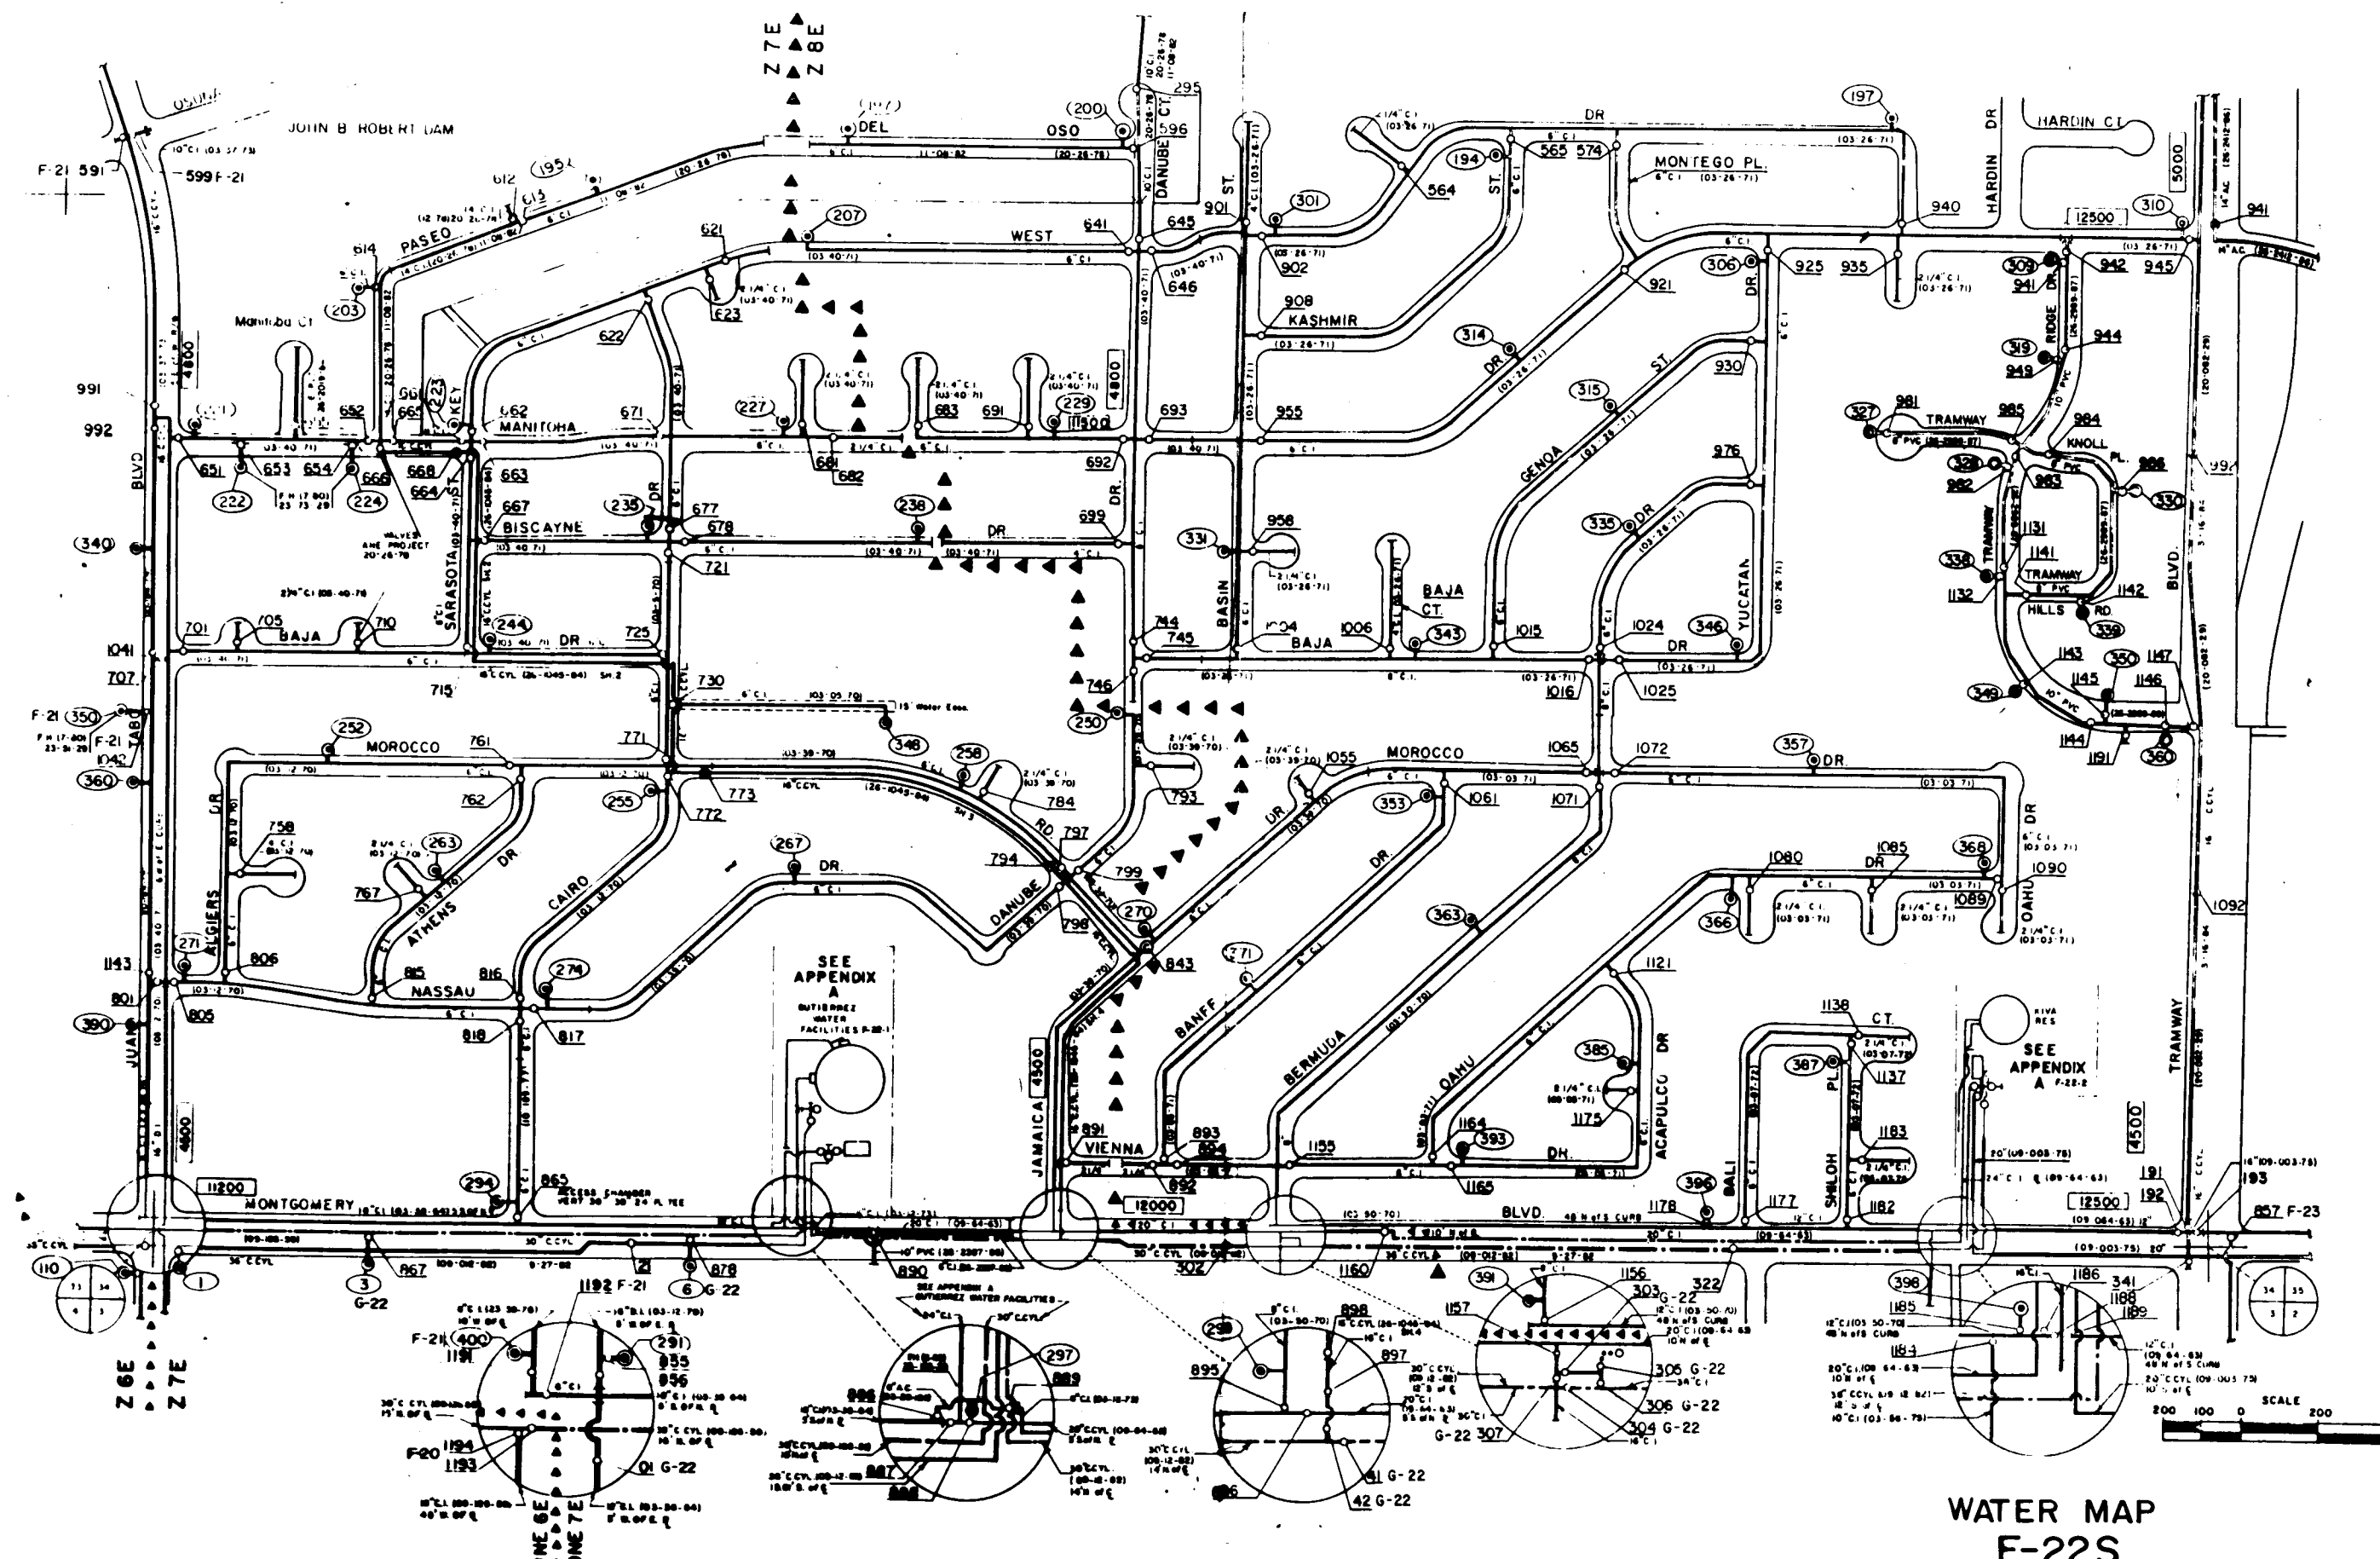

WATER MAP
F-22S

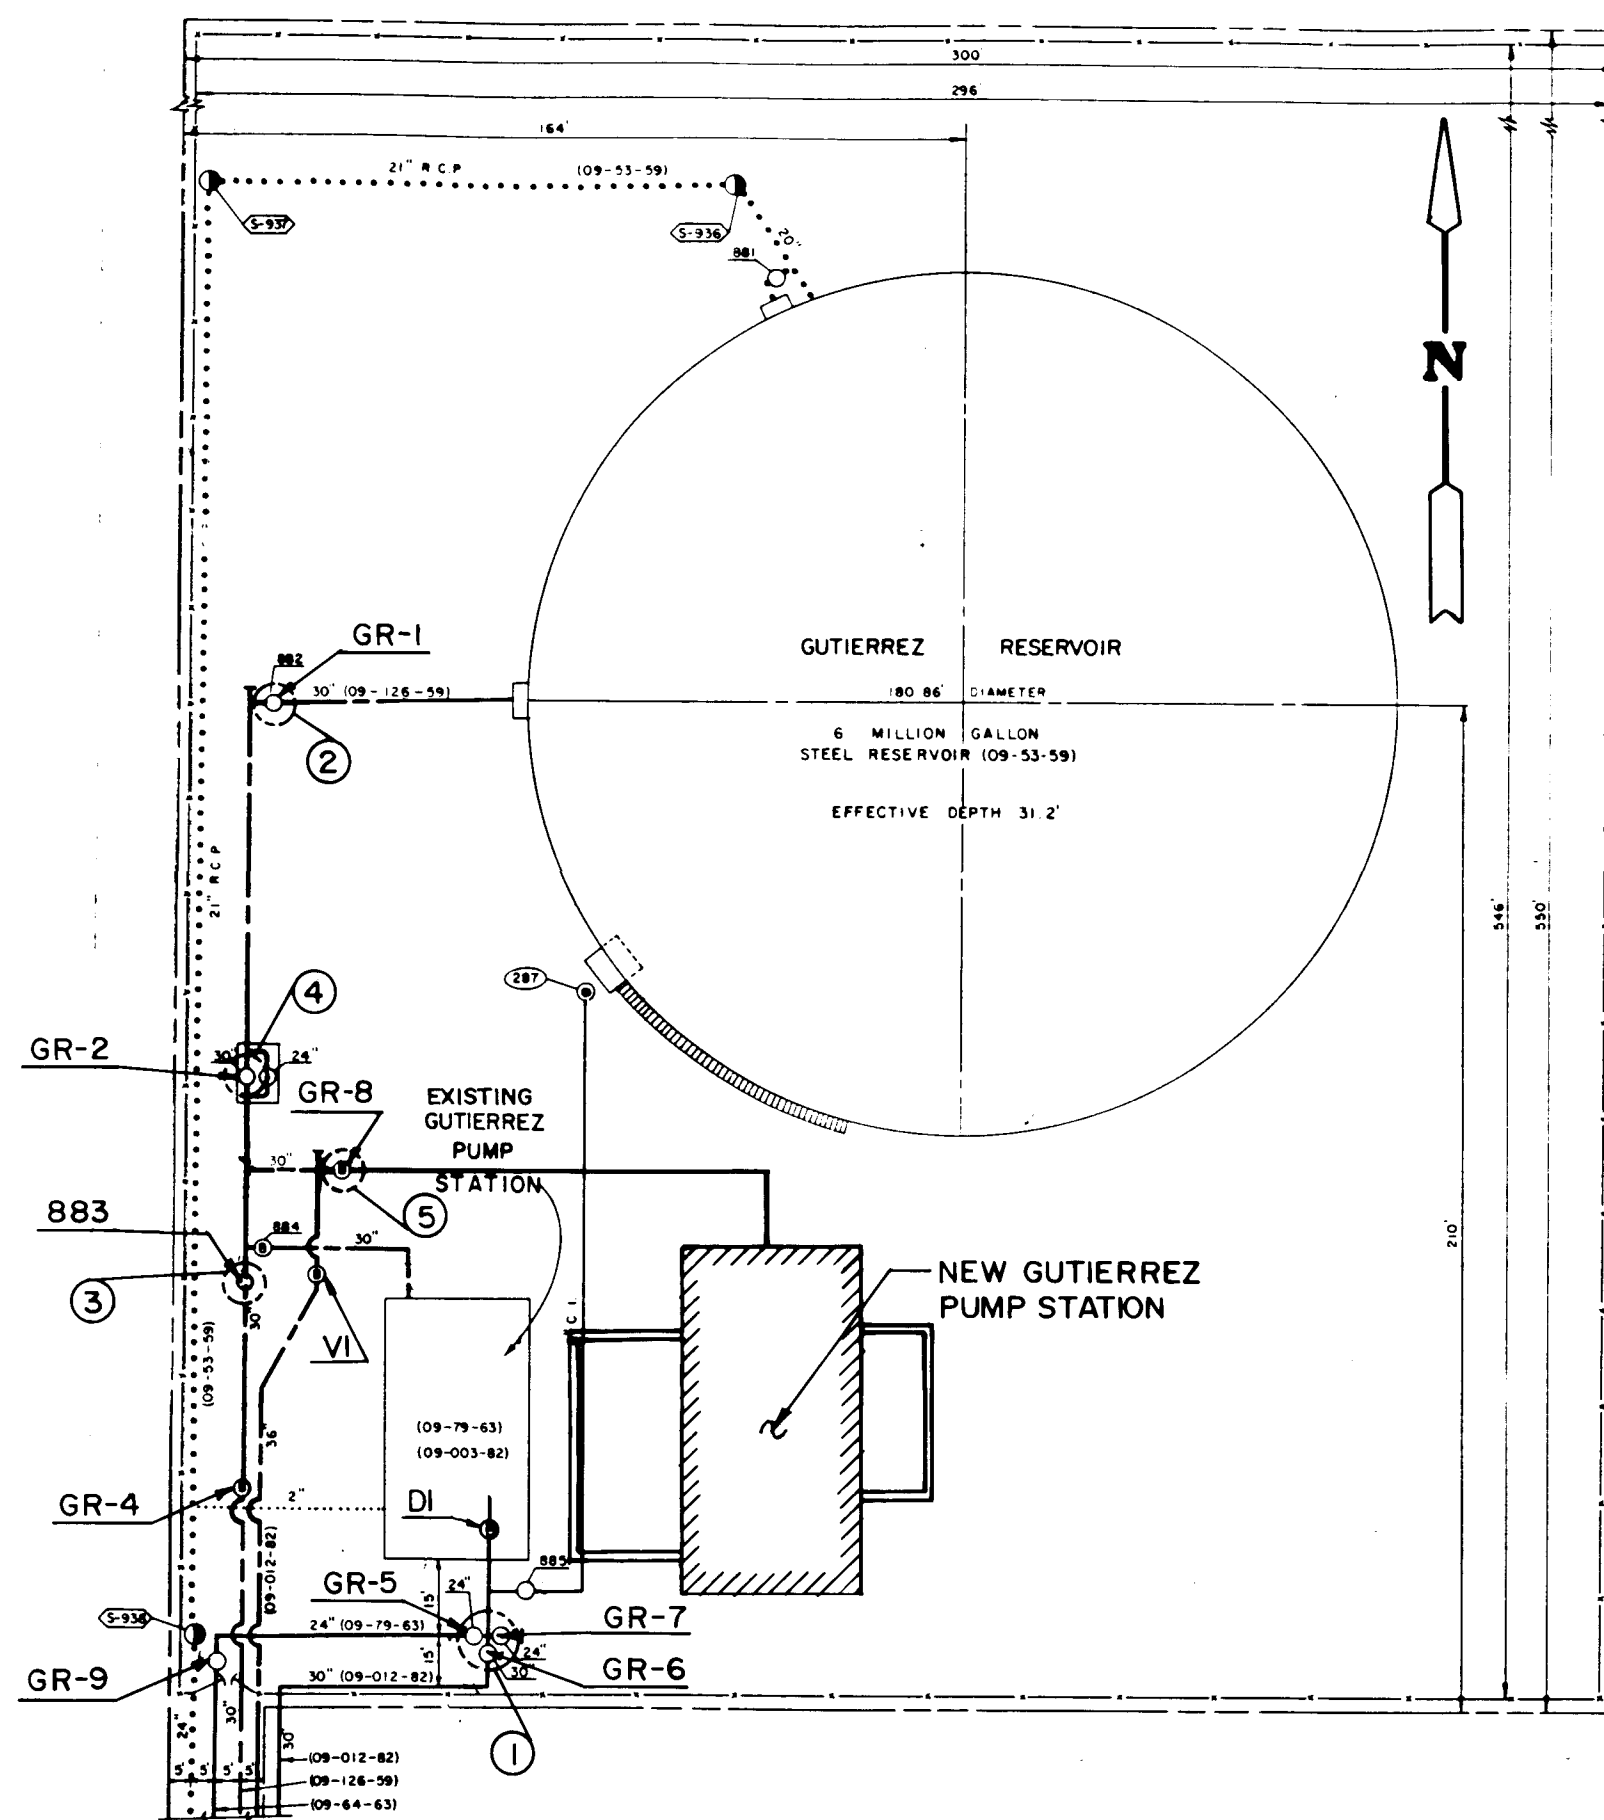

GUTIERREZ RESERVOIR AND PUMP STATION

COORDINATION OF KEY CONSTRUCTION ELEMENTS						
ELEMENT NO.	DESCRIPTION OF WORK ELEMENTS	WORK ELEMENT TIME REQUIREMENTS (HOURS)	MAX. FACILITIES DOWN TIME (HOURS)	FACILITIES OUT OF SERVICE	COMMENTS	VALVES TO BE OPERATED
①	a. REPLACE DISCHARGE LINE CROSS.	8	16	GUTIERREZ PUMP STATION	PONDEROSA PUMP STATION TO DEADHEAD AGAINST VALVES GR-9, 41G-22 AND 42G-22	D-1 GR-9 41G-22 42G-22
	b. REPLACE VALVE GR-5	8				
	c. REPLACE VALVE GR-6	8				
	d. REPLACE VALVE GR-7	8				
②	REPLACE VALVE GR-1	8	8	GUTIERREZ RESERVOIR	PONDEROSA PUMP STATION TO DEADHEAD AGAINST VALVE GR-2 FOR GUTIERREZ SUCTION. GUTIERREZ RESERVOIR SHALL NOT BE DRAINED.	GR-2 RESERVOIR SHALL NOT BE DRAINED CONTRACTOR TO "PLUG" OPENING TO SUIT HIS CONSTRUCTION PREFERENCE.
③	REPLACE VALVE 883	8	8	GUTIERREZ RESERVOIR GUTIERREZ PUMP STATION	PONDEROSA PUMP STATION TO DEADHEAD AGAINST VALVES GR-4 AND VI	884 GR-8 GR-1 GR-4 V-1
④	REPLACE VALVE GR-2	16	16	GUTIERREZ RESERVOIR GUTIERREZ PUMP STATION	PONDEROSA PUMP STATION TO DEADHEAD AGAINST VALVES 883 AND VI	VI GR-1 883 884 GR-8
⑤	REPLACE VALVE GR-8	8	8	GUTIERREZ RESERVOIR GUTIERREZ PUMP STATION	PONDEROSA PUMP STATION TO DEADHEAD AGAINST VALVES 883 AND VI	VI GR-1 883 884

NOTES

- THE CONTRACTOR MUST HAVE ALL FITTINGS, MATERIALS, AND EQUIPMENT ON SITE PRIOR TO VALVE SHUT OFF FOR REQUIRED ELEMENT. ALL EXCAVATIONS MUST BE COMPLETE EXCEPT AS NECESSARY FOR MAINTAINING THE SYSTEM SAFE OPERATION WHILE UNDER PRESSURE.
- ALL HOURS LISTED ARE CONTINUOUS HOURS, NOT BASED ON 8 HOUR WORKING DAY. PERFORMANCE PERIOD BEGINS WHEN CITY HAS MADE ALL APPLICABLE VALVE CLOSURES.
- THE CONTRACTOR MUST REQUEST A WATER SHUT-OFF IN WRITING WITHIN 5 (FIVE) DAYS NOTICE, PER STANDARD CITY OF ALBUQUERQUE PROCEDURE. A 24 HOUR RECOVERY PERIOD SHALL BE PROVIDED BETWEEN EACH ELEMENT.
- WITHIN 5 DAYS AFTER RECEIPT OF CONTRACTOR'S SHUT-OFF REQUEST, TRIAL SHUT-OFFS ASSOCIATED WITH ABOVE WORK WILL BE CONDUCTED. CITY TO FURNISH LABOR AND APPURTENANCES NECESSARY TO VERIFY COMPLETENESS OF SHUTOFFS.
- THE CONTRACTOR WILL BE ASSESSED \$100/HR. (ONE HUNDRED DOLLARS PER HOUR) FOR ANY TIME TAKEN OVER THE FACILITY DOWNTIME ALLOWED FOR EACH WORK ELEMENT.
- THE CONTRACTOR IS NOT TO OPERATE ANY VALVES THAT MAY AFFECT SYSTEM OPERATION.
- CONTRACTOR SHALL BE RESPONSIBLE FOR ANY WATER DRAIN LINES, PUMPING, OR WATERLINE VENTING ASSOCIATED WITH VALVE REMOVALS AS AN INCIDENTAL COST TO THE VALVE REMOVAL AND REPLACEMENT.
- ALL VALVES SHALL BE REPLACED PRIOR TO CONSTRUCTION OF NEW PUMP STATION.

VALVE LOCATION

VALVE NO.	SIZE	LOCATION
GR-1	30"	ON SITE, TRANSMISSION LINE INTO RESERVOIR
GR-2	30"	ON SITE, BY PASS VALVE PIT
GR-4	30"	ON SITE, TRANSMISSION LINE INTO RESERVOIR
GR-9	30"	ON SITE, PUMP STATION DISCHARGE LINE
41G-22	30"	MONTGOMERY BLVD. AND JAMAICA
42G-22	16"	MONTGOMERY BLVD. AND JAMAICA
883	30"	ON SITE, TRANSMISSION LINE INTO RESERVOIR
884	30"	ON SITE, PUMP STATION SUCTION
VI	36"	ON SITE, TRANSMISSION LINE INTO RESERVOIR
DI	24"	BUTTERFLY VALVE INSIDE PUMP STATION ON DISCHARGE HEADER.

RECORD DRAWING
FEB 1992

These drawings have been reviewed based on field data and every reasonable attempt has been made to depict construction as actually performed.

LEGEND

THRU TRANSMISSION LINE	GATE VALVE W/ BYPASS
WATER DISTRIBUTION LINES	FIRE HYDRANT
WELL LINE	END OF PROJECT
GATE VALVE	FIRE HYDRANT NUMBER
AIR RELIEF VALVE	VALVE NUMBER
	WATERLINE RELOCATION


CITY OF ALBUQUERQUE
PUBLIC WORKS DEPARTMENT
ENGINEERING GROUP

TITLE: GUTIERREZ PUMP STATION RECONSTRUCTION
WATER SHUT-OFF PLAN


APPROVALS	ENGINEER	DATE	APPROVALS	ENGINEER	DATE
D.R.C. Chair	R.W. Kane	11-13-90	WATER	R.W. Kane	11-13-90
Trans. Dev.	R.W. Kane	11-16-90	WASTE WATER	R.W. Kane	11-13-90
Utility Dev.					

DRAWING NO. 3337.90 MAP NO. F-22 SHEET U-2 OF U-2


AS BUILT INFORMATION		BENCH MARKS		SURVEY INFORMATION		FIELD NOTES		ENGINEER'S SEAL	
CONTRACTOR	ALBUQUERQUE	NO.	DATE	NO.	DATE	NO.	DATE	NO.	DATE
INSPECTOR	ALBUQUERQUE	NO.	DATE	NO.	DATE	NO.	DATE	NO.	DATE
FIELD	ALBUQUERQUE	NO.	DATE	NO.	DATE	NO.	DATE	NO.	DATE
CONTRACT	ALBUQUERQUE	NO.	DATE	NO.	DATE	NO.	DATE	NO.	DATE
RECORD	ALBUQUERQUE	NO.	DATE	NO.	DATE	NO.	DATE	NO.	DATE
REVISIONS	ALBUQUERQUE	NO.	DATE	NO.	DATE	NO.	DATE	NO.	DATE
DESIGNED BY	ALBUQUERQUE	NO.	DATE	NO.	DATE	NO.	DATE	NO.	DATE
DRAWN BY	ALBUQUERQUE	NO.	DATE	NO.	DATE	NO.	DATE	NO.	DATE
CHECKED BY	ALBUQUERQUE	NO.	DATE	NO.	DATE	NO.	DATE	NO.	DATE

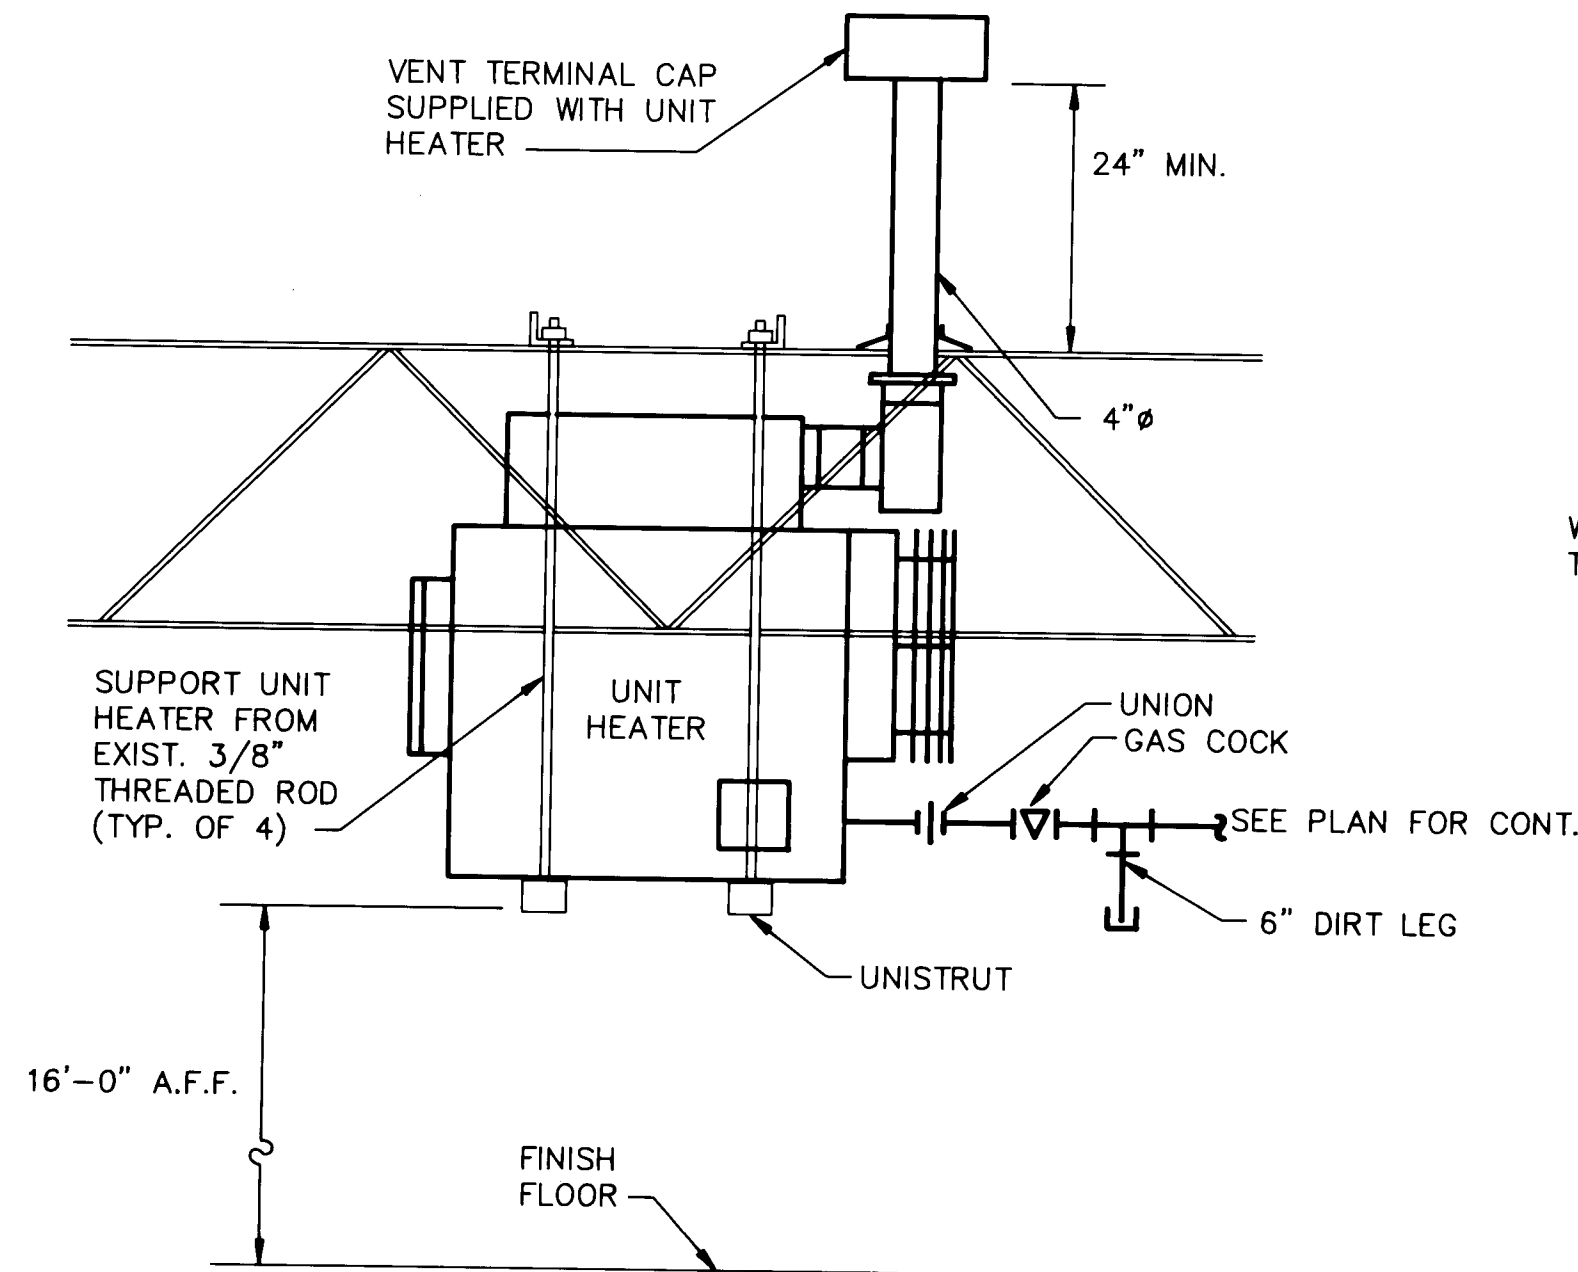


1 UNIT HEATER DETAIL
M1/M2 NOT TO SCALE

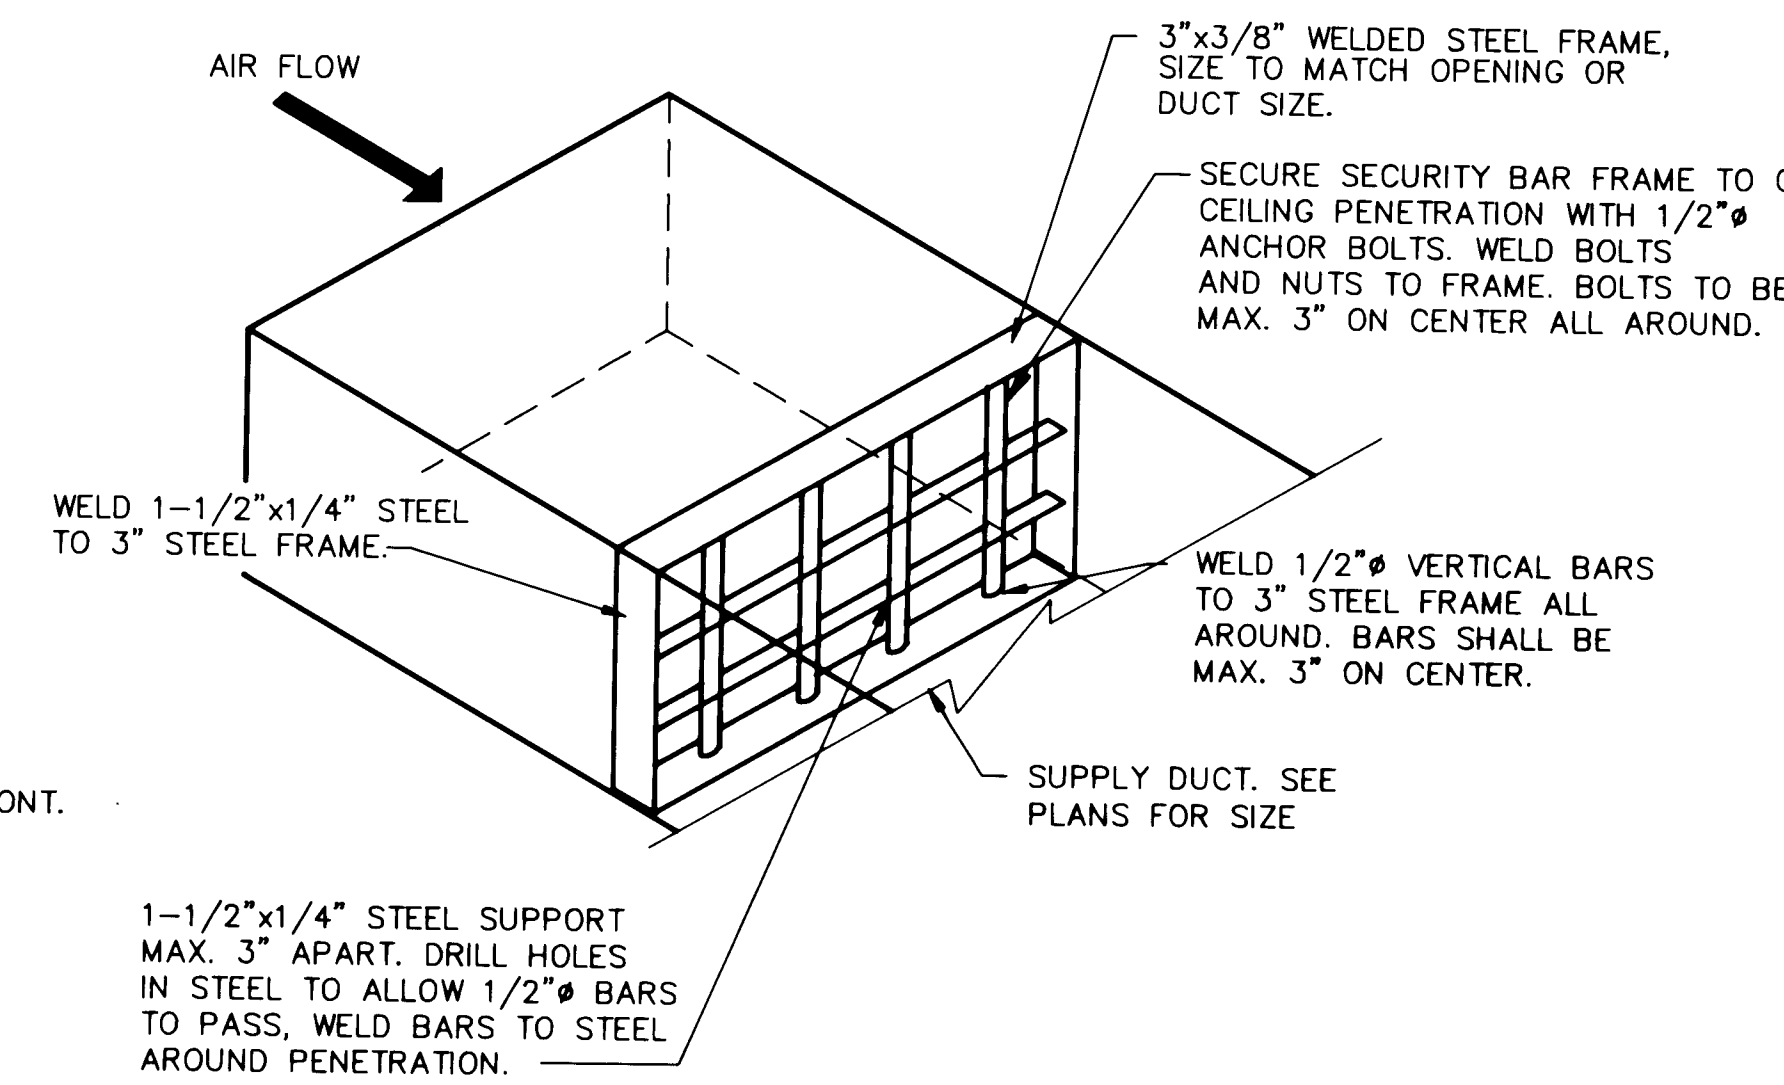


2 SECURITY BAR DETAIL
M1/M2 SCALE: NONE

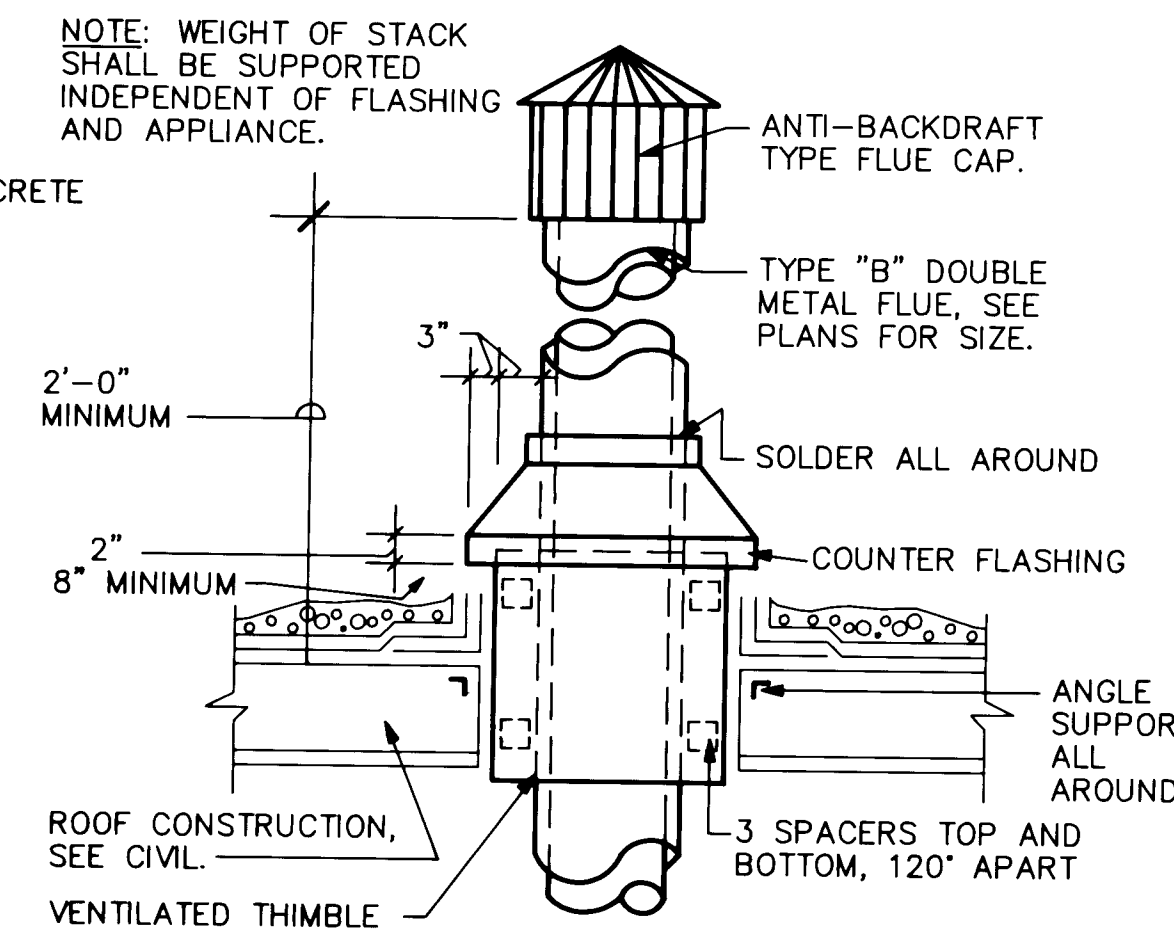


3 FLUE THRU ROOF DETAIL
M1/M2 SCALE: NONE

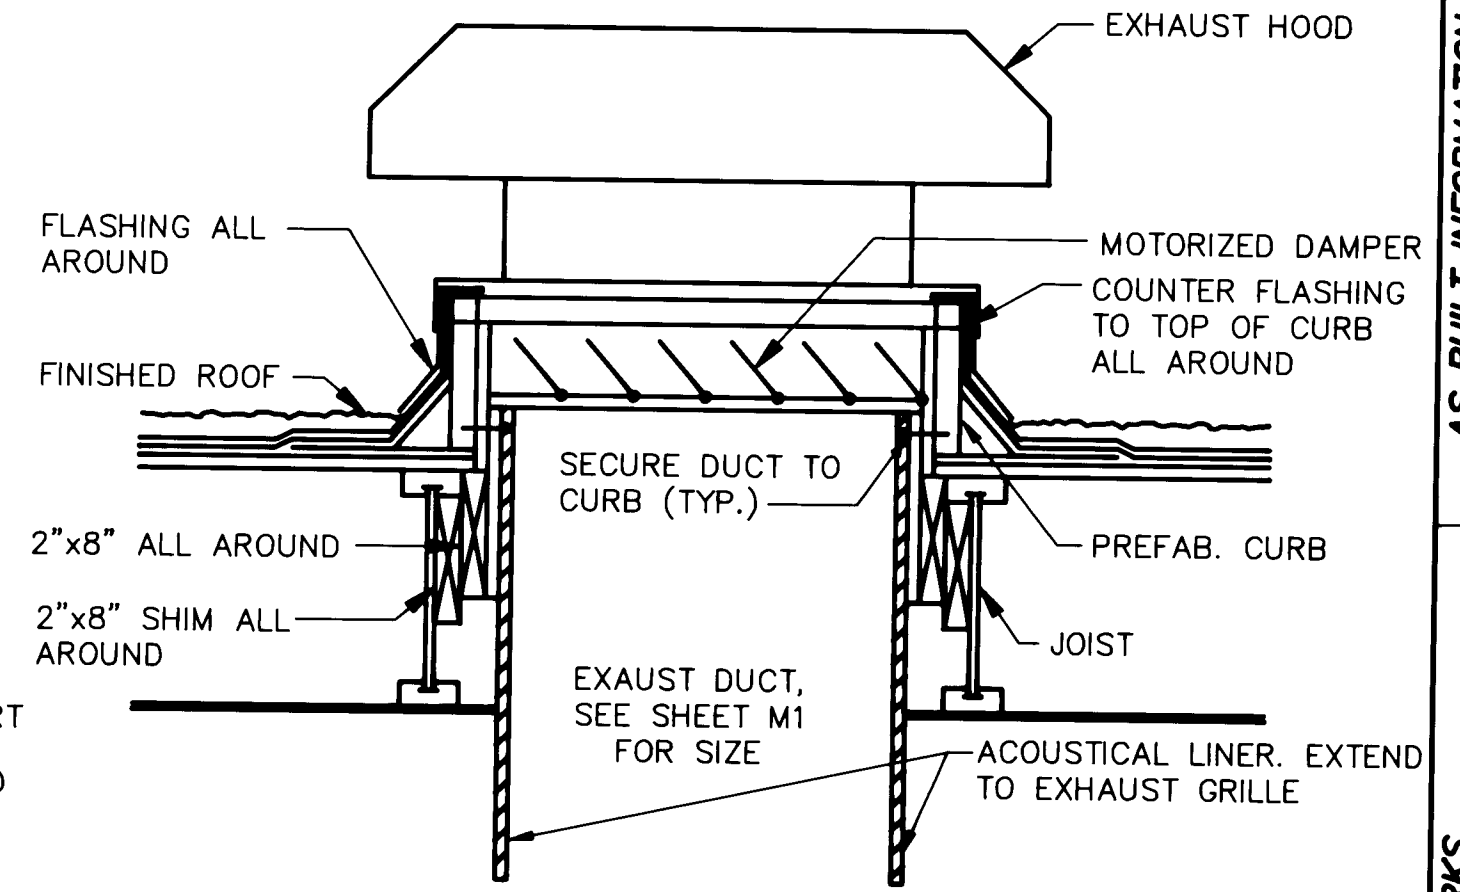


4 EXHAUST HOOD DETAIL
M1/M2 SCALE: NONE

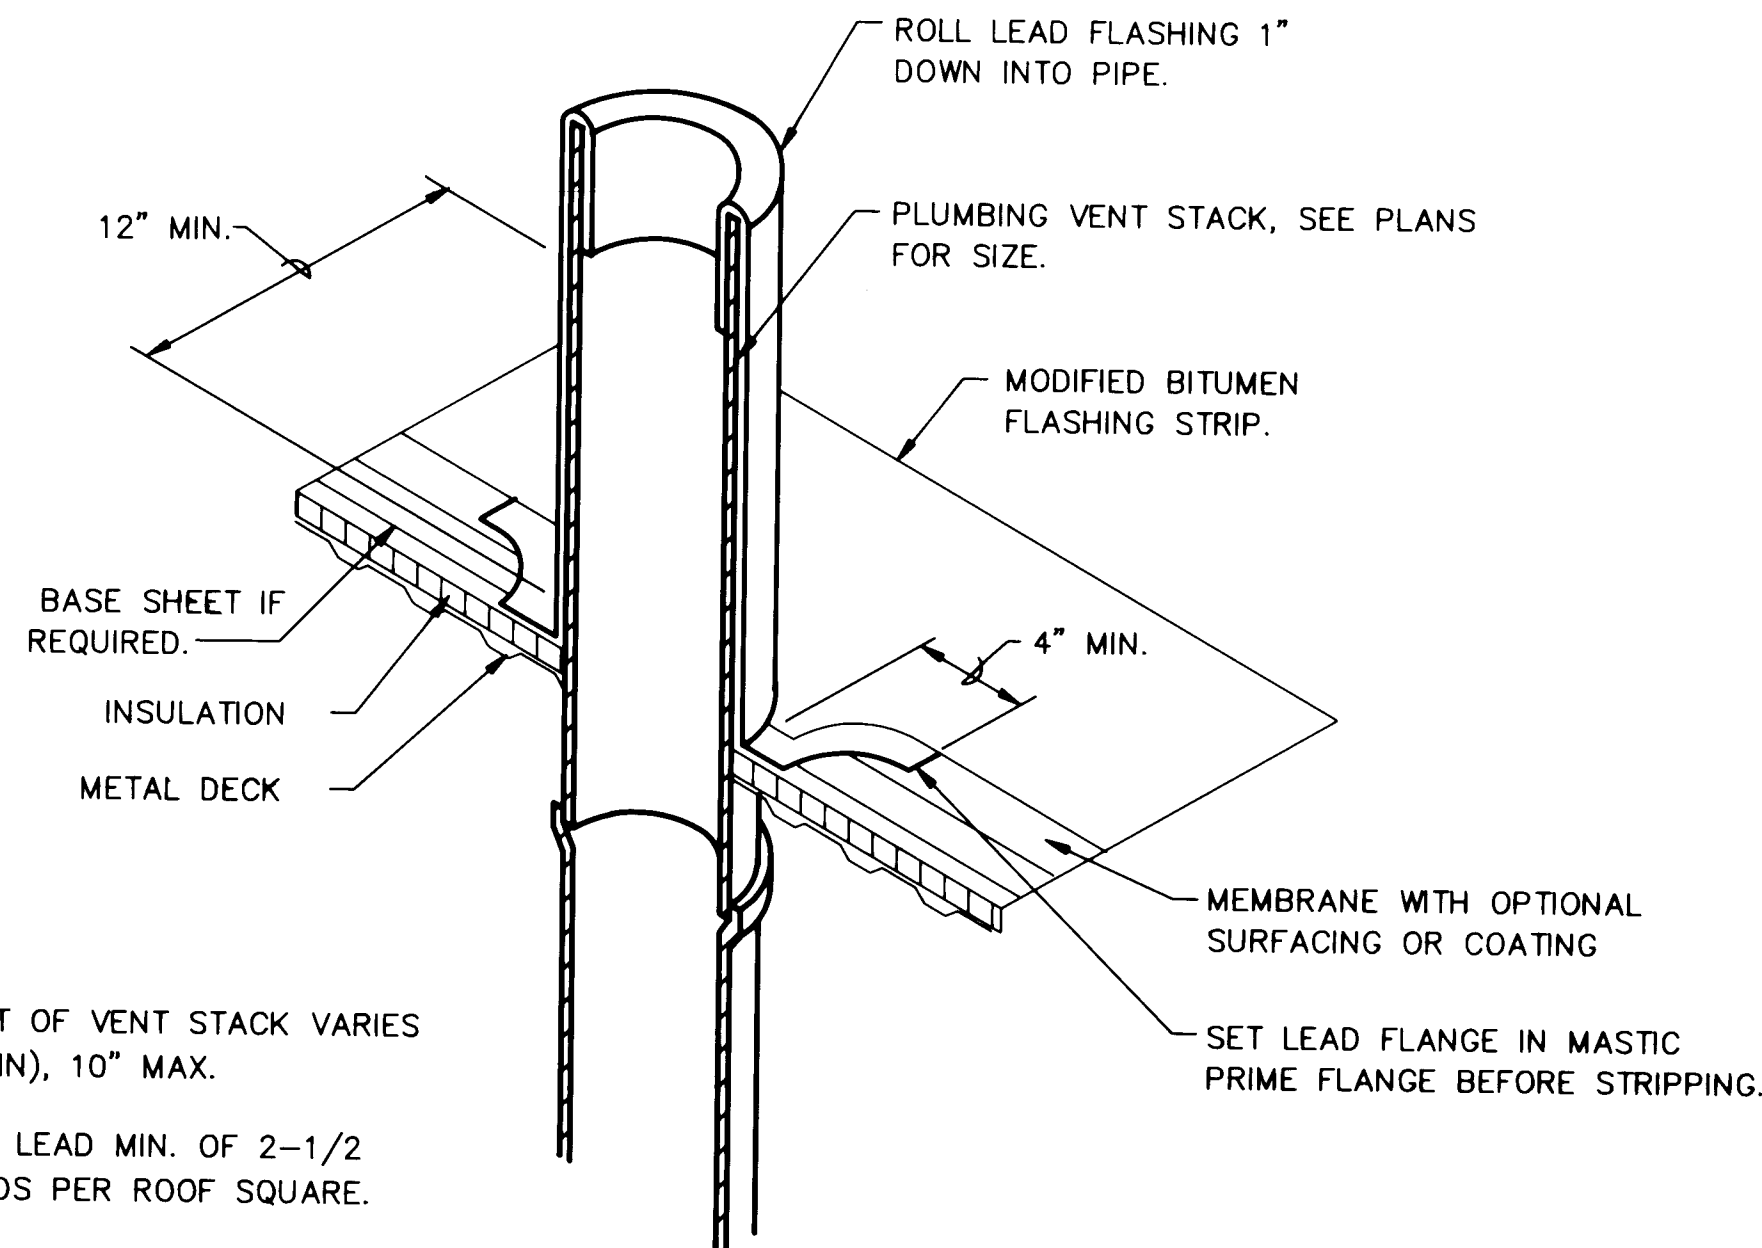


5 VENT THRU ROOF DETAIL
M1/M2 SCALE: NONE

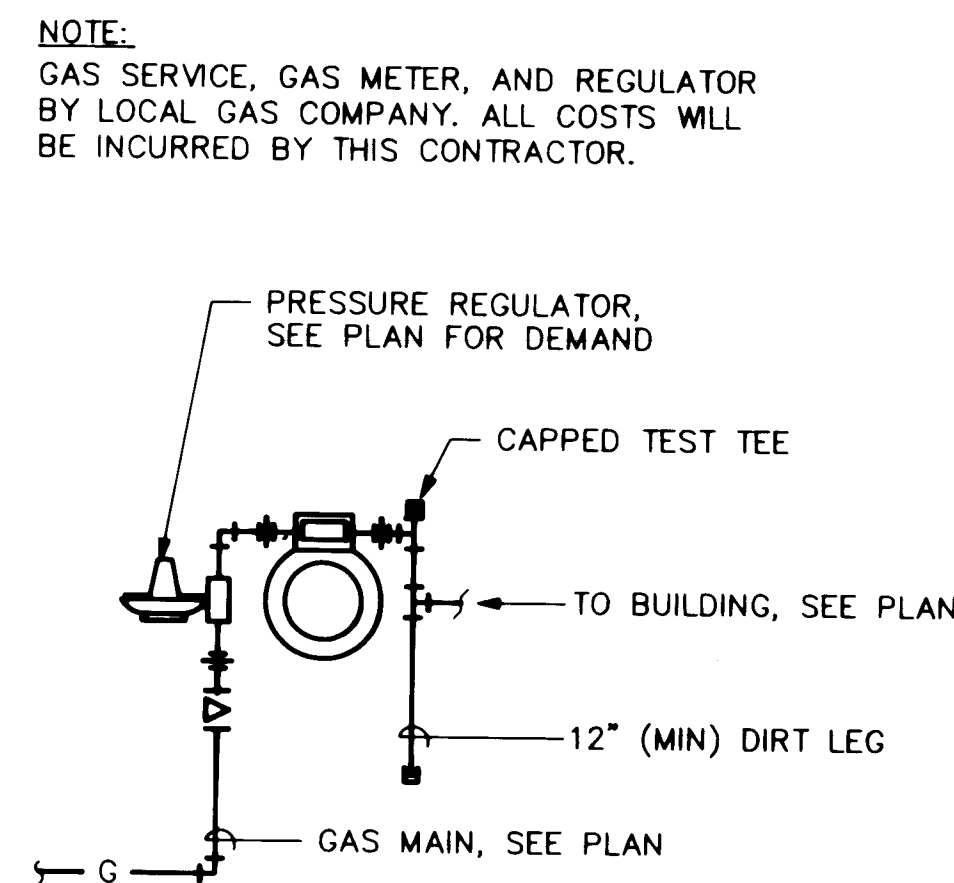


6 GAS METER DETAIL
M1/M2 SCALE: NONE

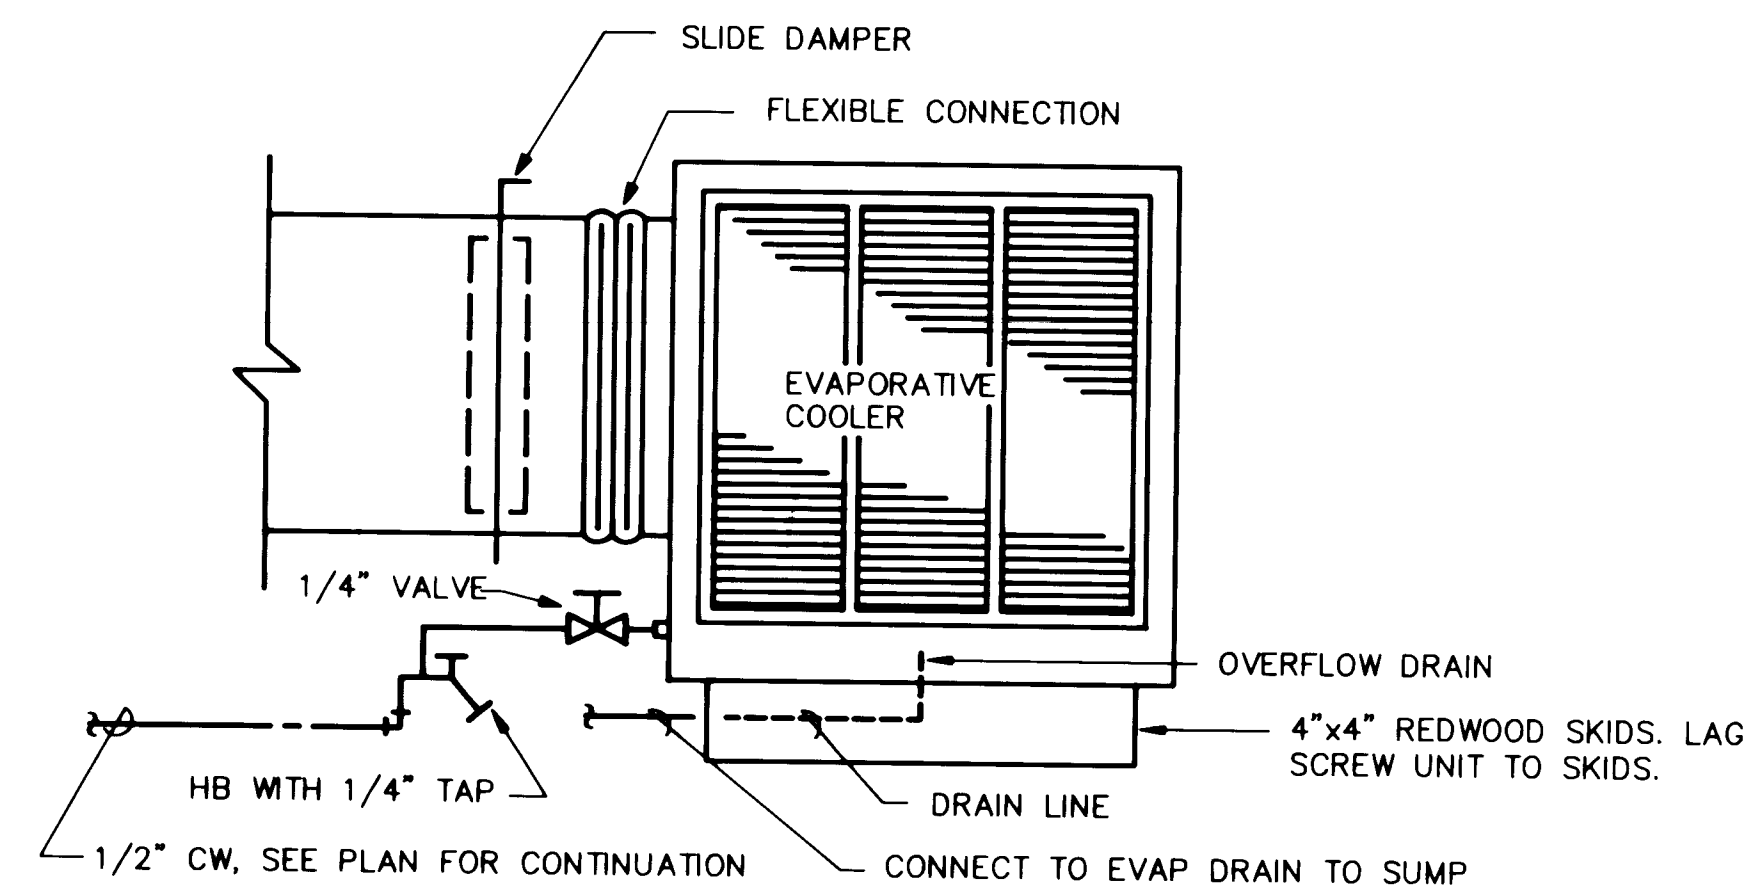


7 EVAPORATIVE COOLER DETAIL
M1/M2 SCALE: NONE

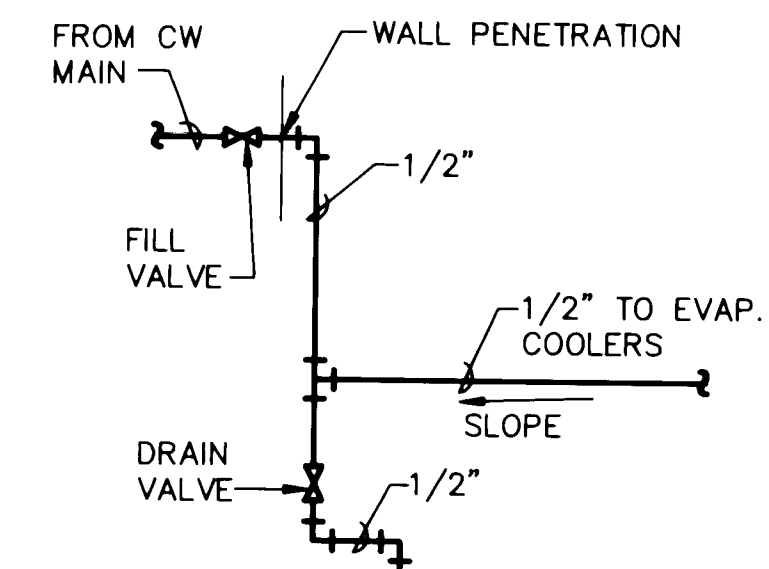


8 EVAP. COOLER WATER PIPING DETAIL
M1/M2 SCALE: NONE

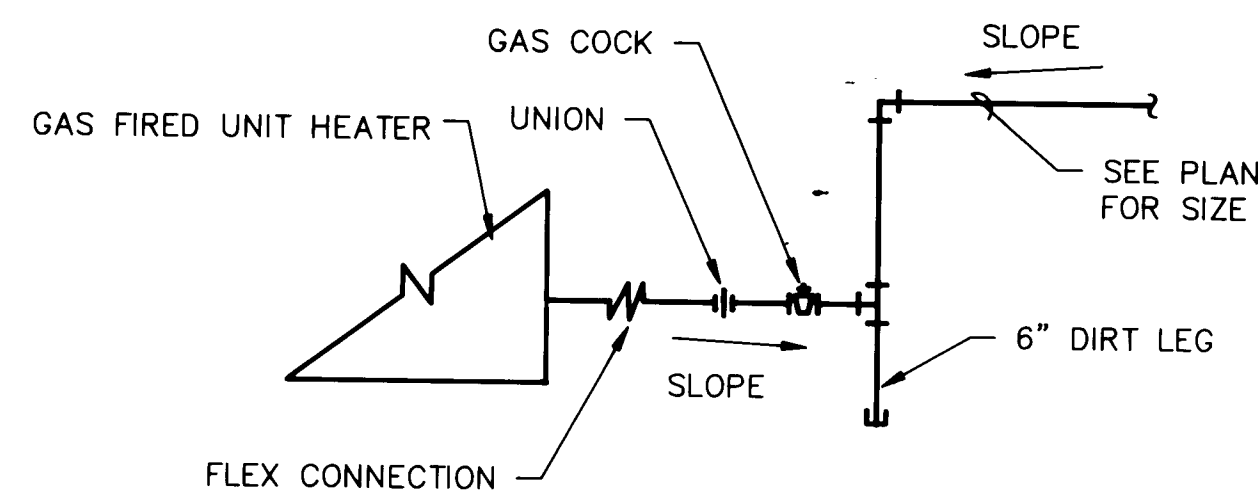


9 GAS CONNECTION DETAIL
M1/M2 SCALE: NONE

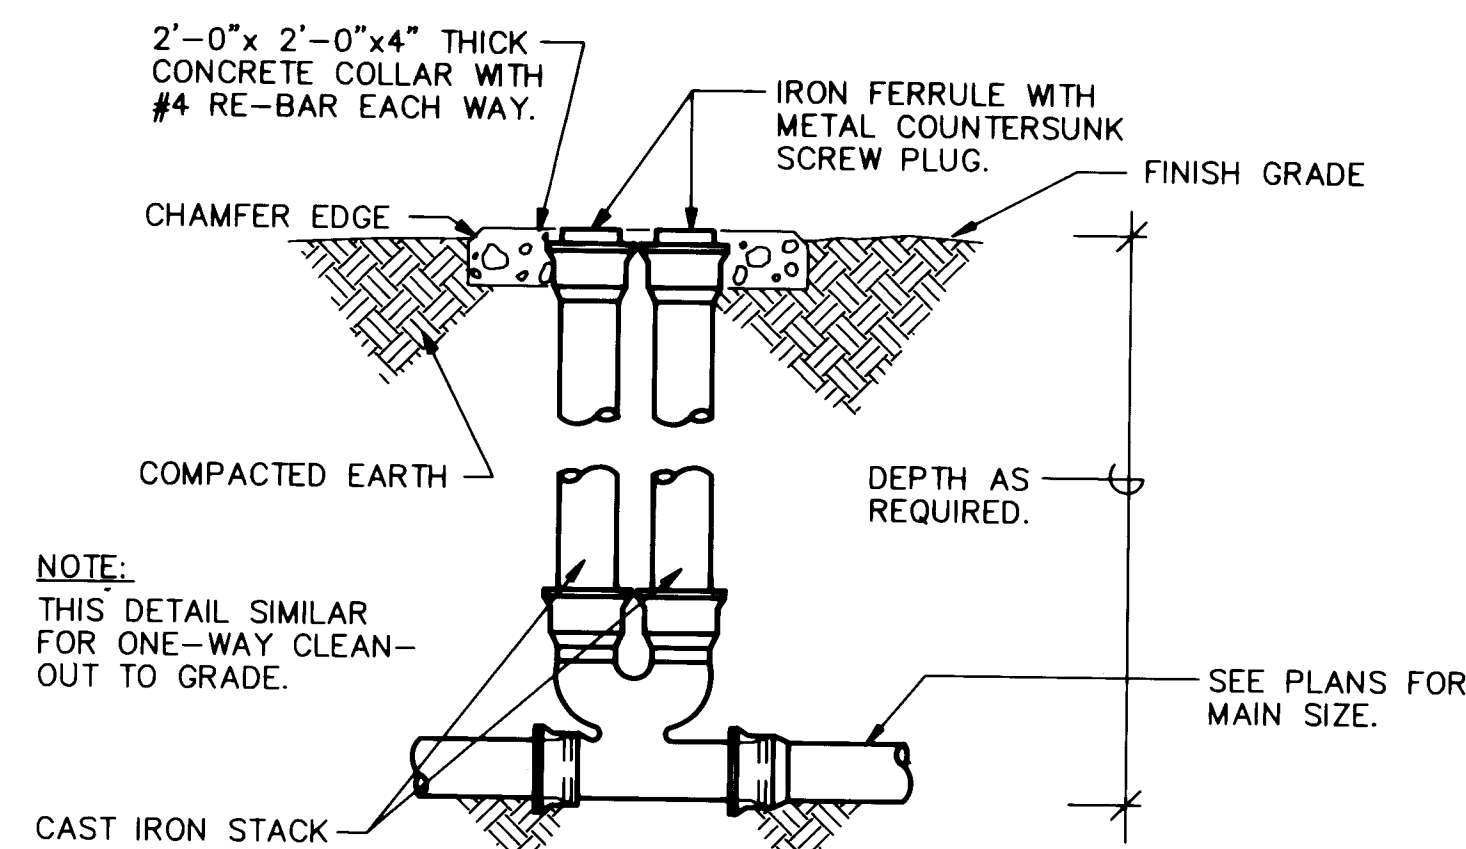

10 CLEANOUT TO GRADE
M1/M2 SCALE: NONE

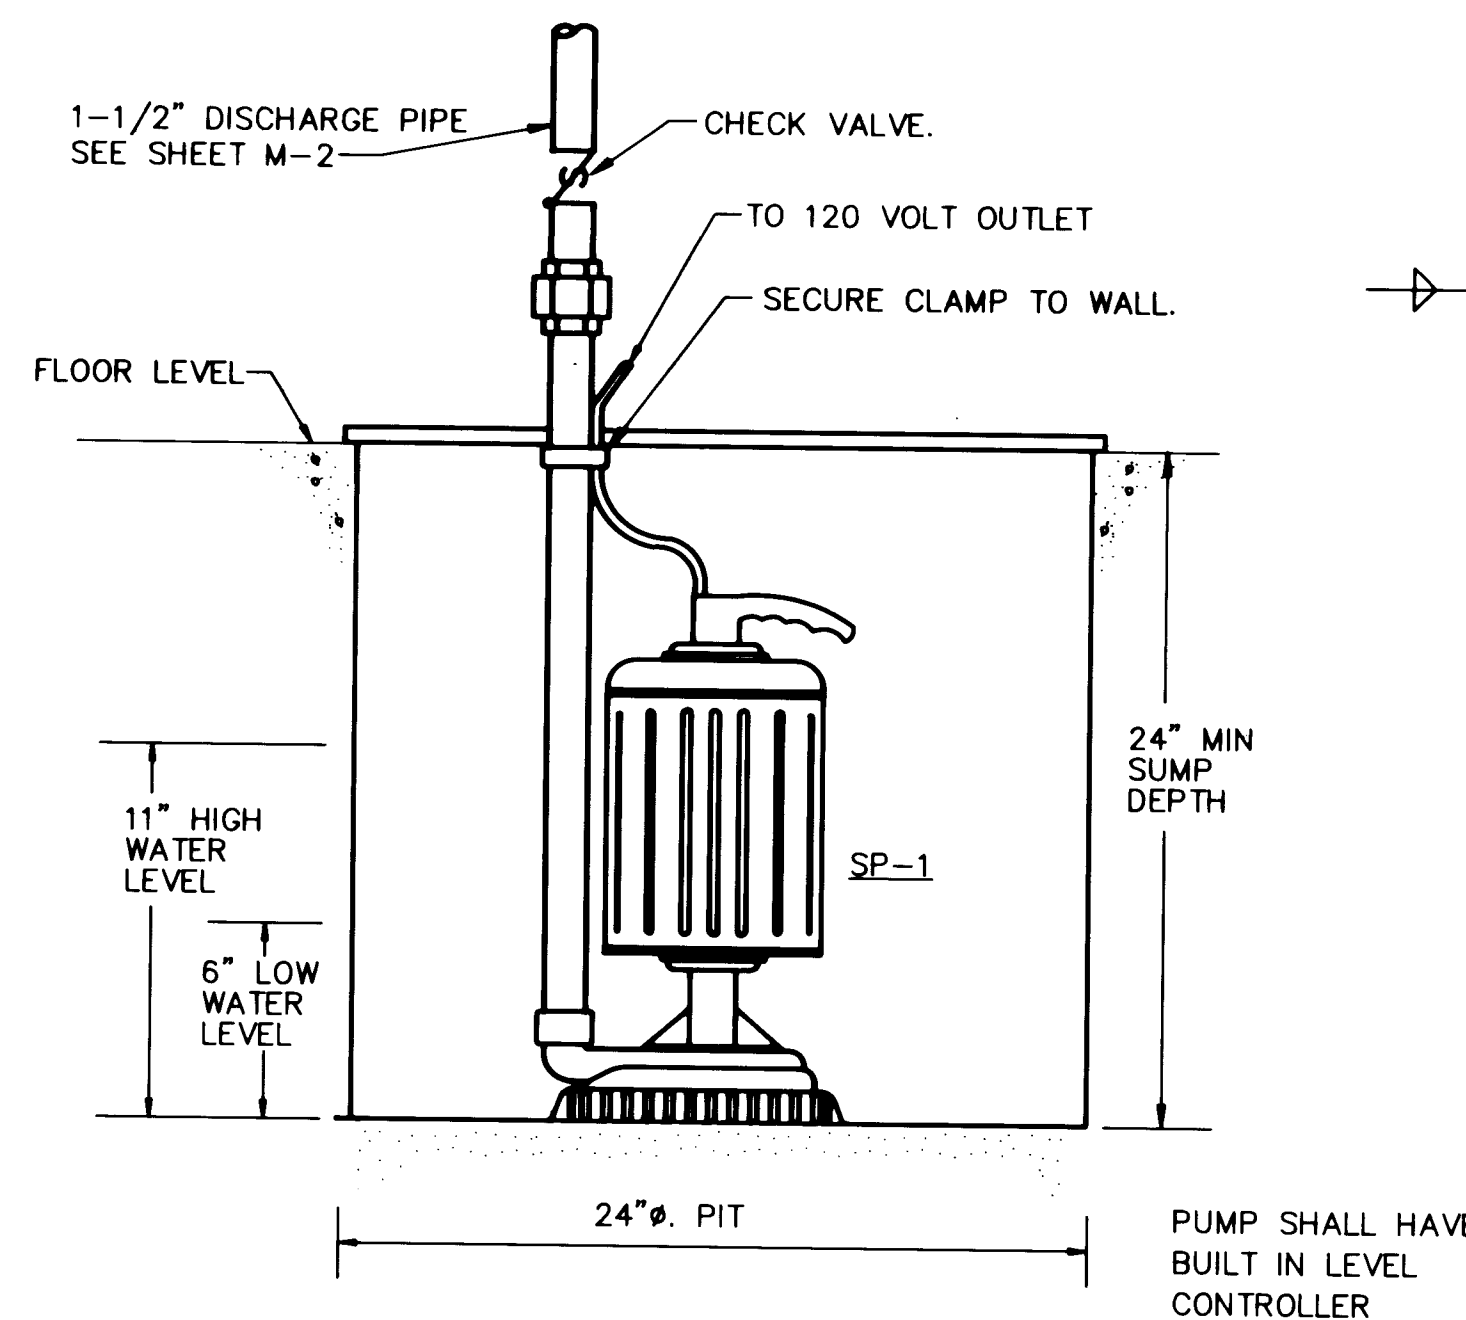

11 SUMP PUMP
M1/M2 SCALE: NONE

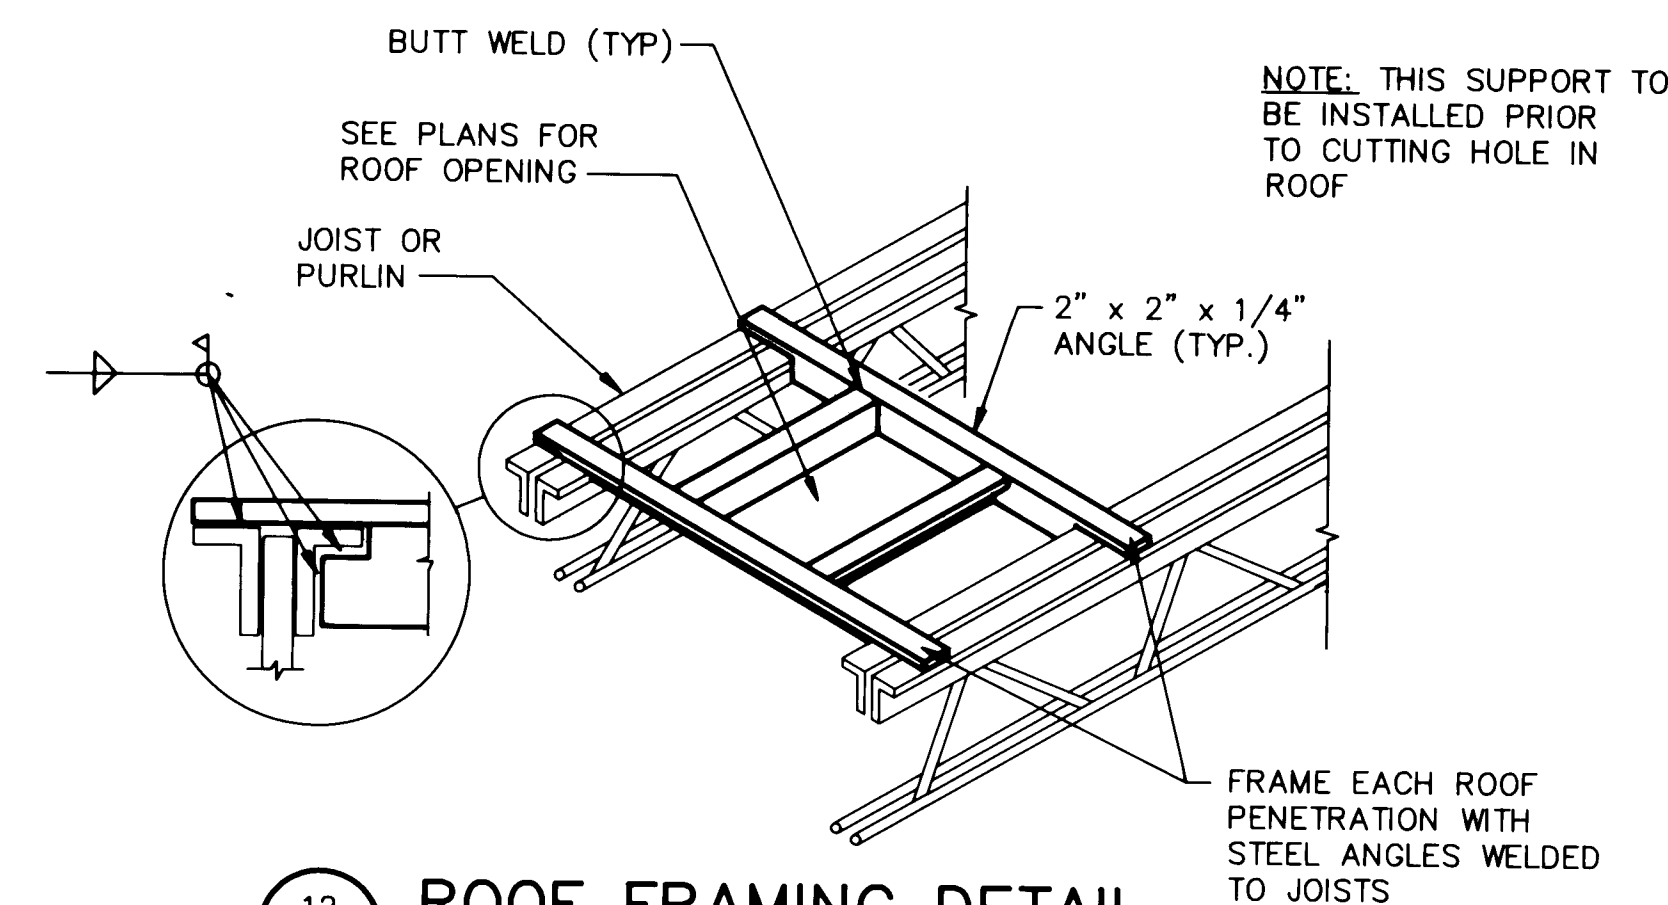


12 ROOF FRAMING DETAIL
M1/M2 SCALE: NONE

RECORD DRAWING


Date: FEB 1992

These drawings have been revised based on field data and every reasonable attempt has been made to depict construction actually performed.

CITY OF ALBUQUERQUE PUBLIC WORKS DEPARTMENT ENGINEERING GROUP					
TITLE: GUTIERREZ PUMP STATION RECONSTRUCTION MECHANICAL DETAILS					
APPROVALS	ENGINEER	DATE	APPROVALS	ENGINEER	DATE
TRANSPORTATION	WATER	11-16-90	WASTE WATER	R.W. Kane	11-13-90
HYDROLOGY	11-15-90				
PROJECT NO.	3337.90		MAP NO.	F-22	
SHEET	M2		OF 3		

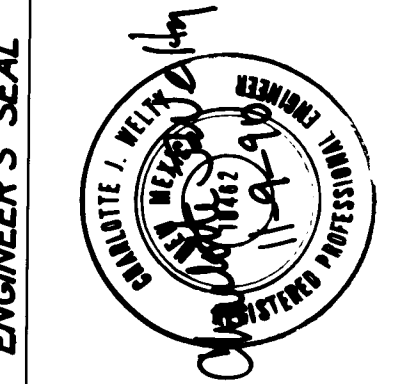

REMARKS		BY	DATE
DESIGN			
REVISIONS			
NO. DATE			
DESIGNED BY		CJW	DATE NOV. 9, 1990
DRAWN BY		RNF	DATE NOV. 9, 1990
CHECKED BY			DATE

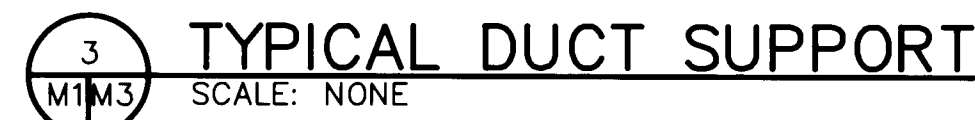


1	2	3	4	5	6	7	8	9	10	11	12	13	14	15
2	6		3	3	3	7	.	9	0	2	0	9	2	

These drawings have been revised based on field data and every reasonable attempt has been made to depict construction actually performed.

[illegible]

CITY OF ALBUQUERQUE PUBLIC WORKS DEPARTMENT ENGINEERING GROUP					
TITLE: GUTIERREZ PUMP STATION RECONSTRUCTION MECHANICAL SCHEDULE AND DETAILS					
APPROVALS	ENGINEER	DATE	APPROVALS	ENGINEER	DATE
DRC CHAIRMAN	<i>[Signature]</i>	11/14/90	WATER	<i>R.W. Kane</i>	11-13-90
TRANSPORTATION	<i>NH RWH</i>	11-16-90	WASTE WATER	<i>R.W. Kane</i>	11-13-90
HYDROLOGY	<i>CDL</i>	11-15-90			
PROJECT NO. 3337.90		MAP NO. F-22		SHEET M3 OF 3	

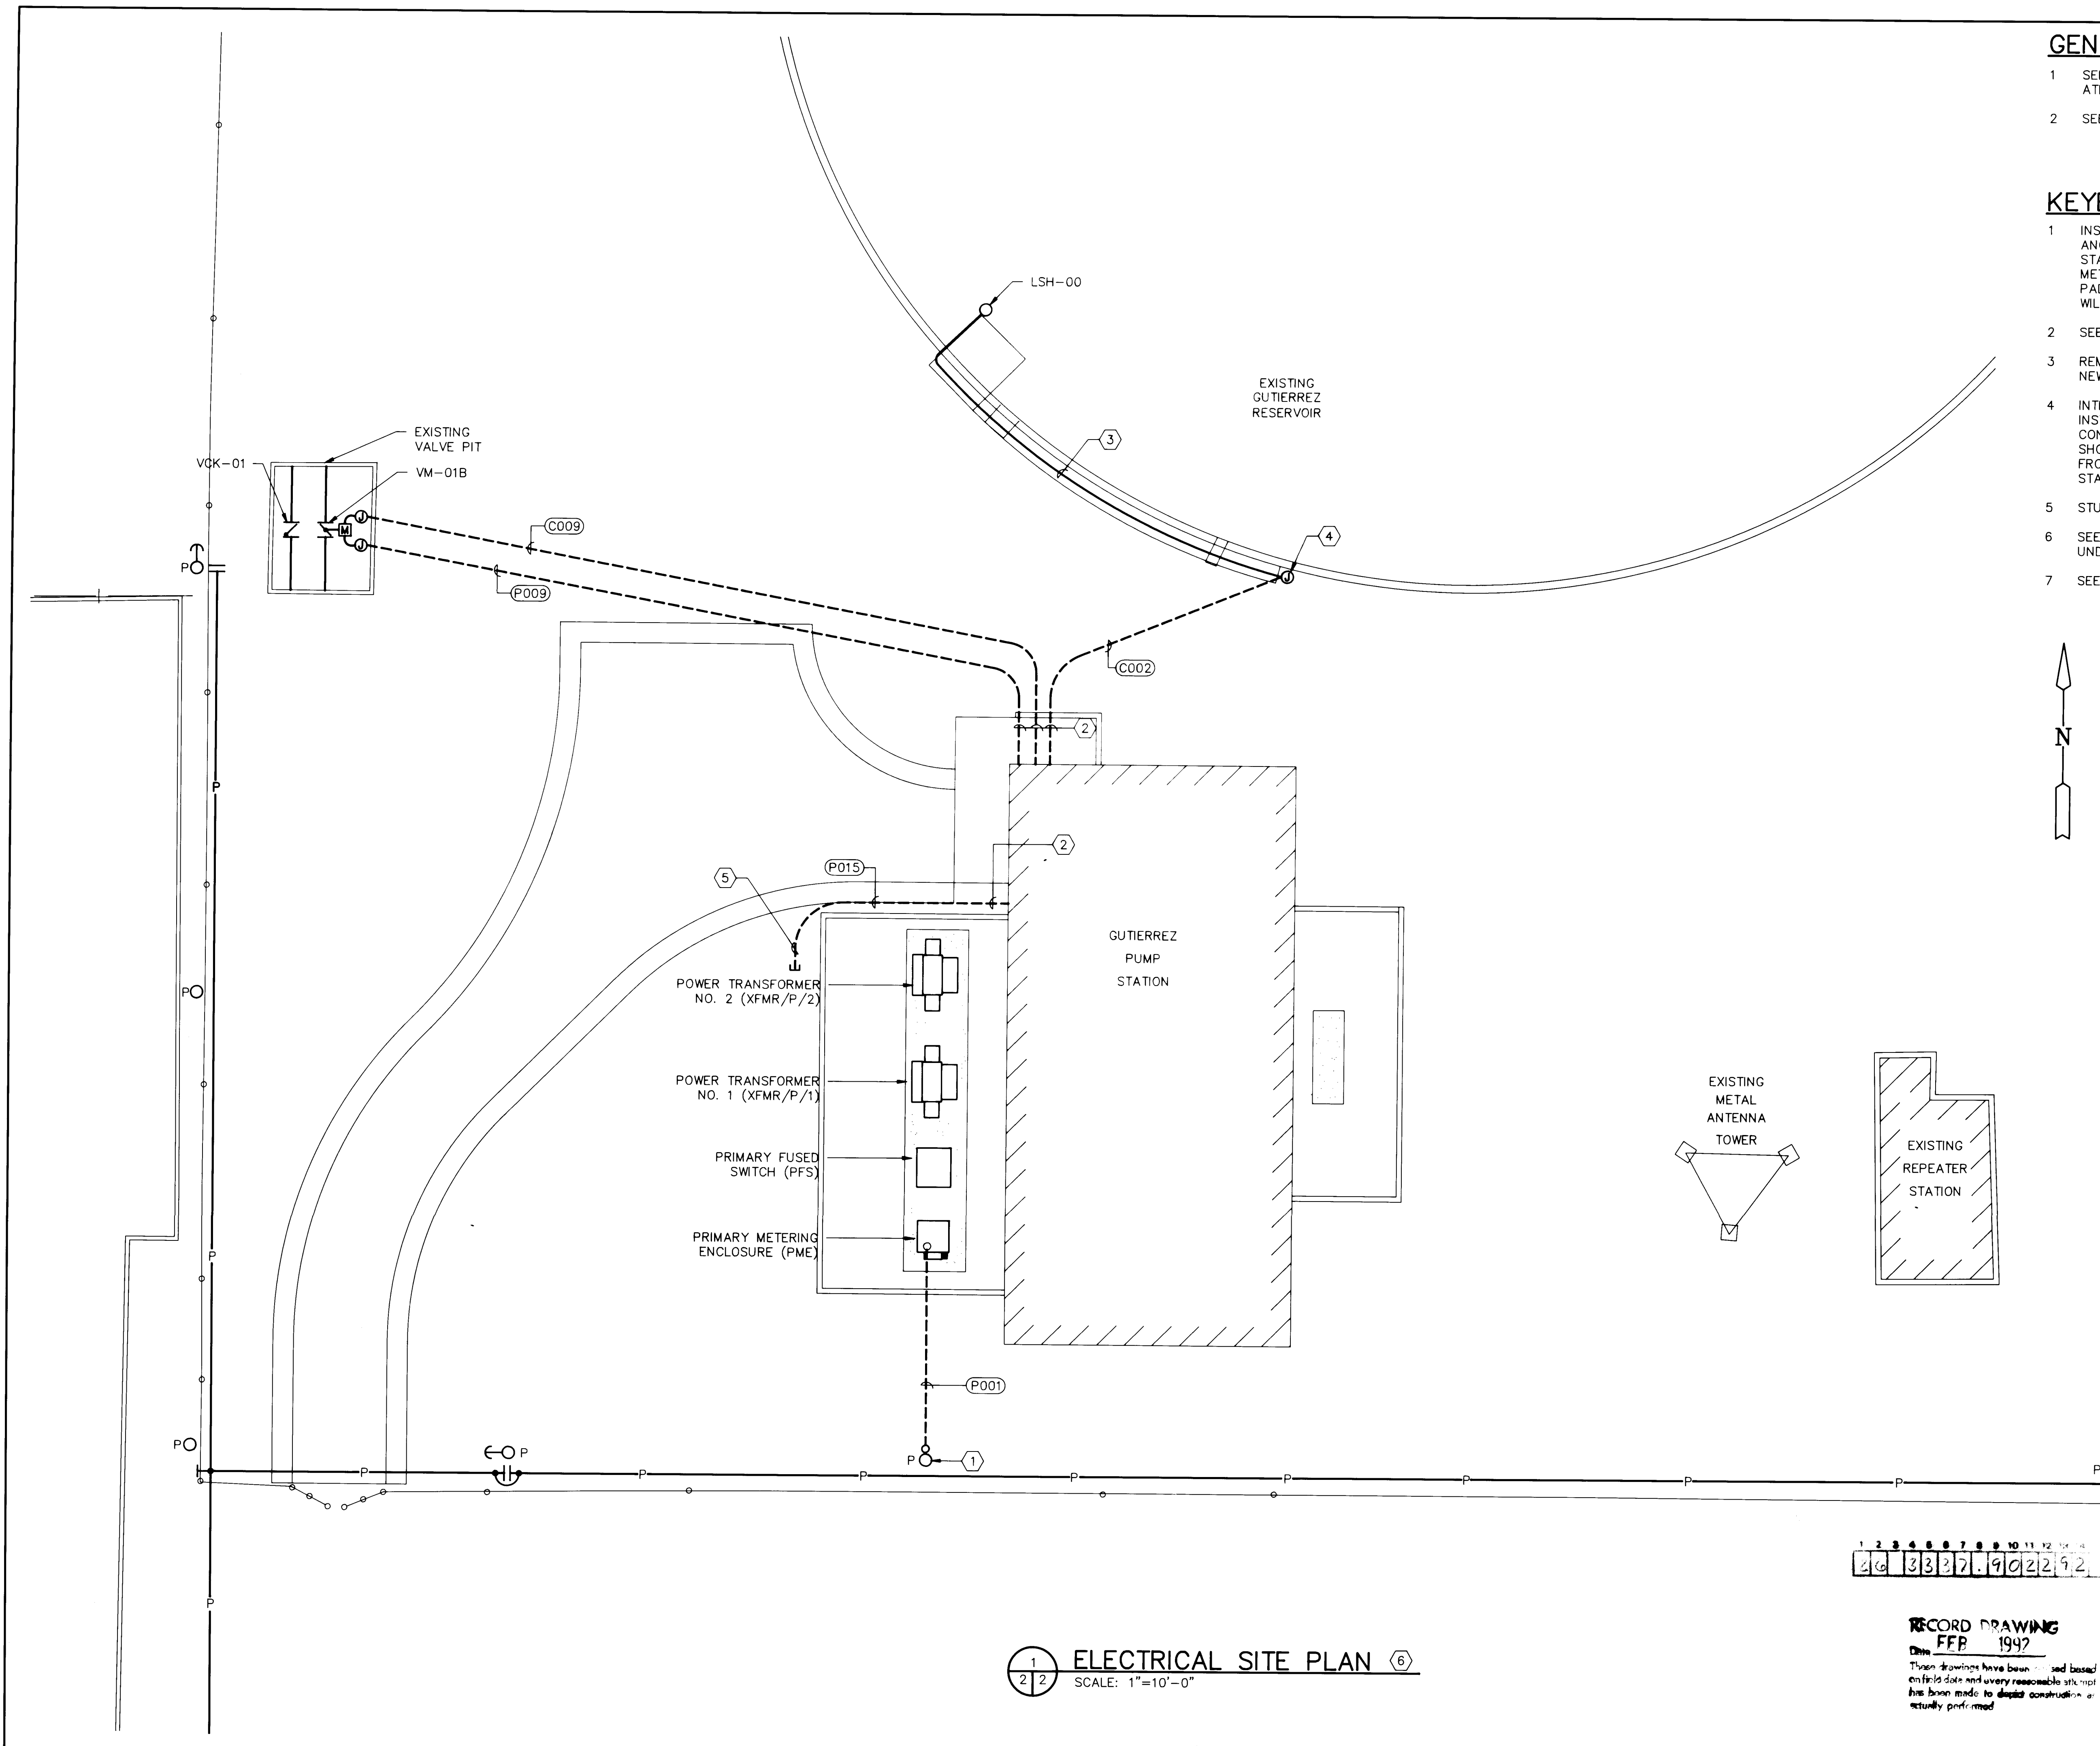

GENERAL NOTES


- 1 SEE SHEET E1 FOR SYMBOLS LEGEND AND ABBREVIATIONS LIST.
- 2 SEE SHEET E8 FOR SCHEDULES.

KEYED NOTES

- 1 INSTALL PRIMARY RISER ON NEW POLE IN ACCORDANCE WITH PUBLIC SERVICE CO. (PNM) DISTRIBUTION STANDARD DS-7-15.1. ROUTE CONDUIT TO PRIMARY METERING ENCLOSURE ON ELECTRICAL EQUIPMENT PAD. SEE ENLARGED PLAN ON SHEET E6. NEW POLE WILL BE INSTALLED BY PNM.
- 2 SEE SHEET E6 FOR CONTINUATION.
- 3 REMOVE CONDUCTOR FROM EXISTING CONDUIT. INSTALL NEW CONDUCTOR AS NOTED IN EXISTING CONDUIT.
- 4 INTERCEPT EXISTING CONDUIT AT THIS LOCATION AND INSTALL NEW J-BOX. ROUTE NEW CONDUIT AND CONDUCTOR FROM J-BOX TO NEW PUMP STATION AS SHOWN. REMOVE EXISTING CONDUIT AND CONDUCTOR FROM THIS LOCATION BACK TO EXISTING PUMP STATION.
- 5 STUB-OUT CONDUIT FOR IRRIGATION CONTROL WIRING.
- 6 SEE SHEET 5 FOR YARD PIPING AND OTHER UNDERGROUND UTILITIES, NEW AND EXISTING.
- 7 SEE SHEET 3 FOR ELECTRICAL DEMOLITION.



AS BUILT INFORMATION		BENCH MARKS		SURVEY INFORMATION		ENGINEER'S SEAL	
CONTRACTOR	NO.	NO.	DATE	NO.	DATE	NO.	DATE
WORKED BY	DATE	NO.	DATE	NO.	DATE	NO.	DATE
INSPECTED BY	DATE	NO.	DATE	NO.	DATE	NO.	DATE
ACCEPTANCE BY	DATE	NO.	DATE	NO.	DATE	NO.	DATE
VERIFICATION BY	DATE	NO.	DATE	NO.	DATE	NO.	DATE
DRAWING NO.	DATE	NO.	DATE	NO.	DATE	NO.	DATE
CONSTRUCTION BY	DATE	NO.	DATE	NO.	DATE	NO.	DATE
MICRO-FILM INFORMATION		REVISIONS		DESIGN		DATE NOV. 9, 1990	
RECORDED BY		NO.		BY		S. HAUGLAND	
NO.		NO.		NO.		B. GRIFFIS	

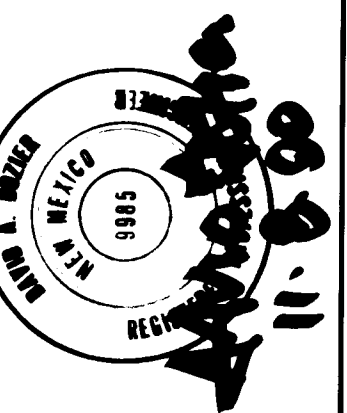


CITY OF ALBUQUERQUE PUBLIC WORKS DEPARTMENT ENGINEERING GROUP					
TITLE: GUTIERREZ PUMP STATION RECONSTRUCTION ELECTRICAL SITE PLAN					
APPROVALS	ENGINEER	DATE	APPROVALS	ENGINEER	DATE
DRC CHAIRMAN	R.W. Kane	11-13-90	WATER	R.W. Kane	11-13-90
TRANSPORTATION	N/A R.W.	11-16-90	WASTE WATER	R.W. Kane	11-13-90
HYDROLOGY	LDM	11-15-90			
PROJECT NO.	3337.90	MAP NO.	F-22	SHEET	E2 OF 19

RECORD DRAWING
Date FEB 1992
These drawings have been used based on field data and every reasonable attempt has been made to depict construction as actually performed.

GENERAL NOTES

- SEE SHEET E1 FOR SYMBOLS LEGEND AND ABBREVIATIONS LIST
- SEE SHEET E8 FOR SCHEDULES.

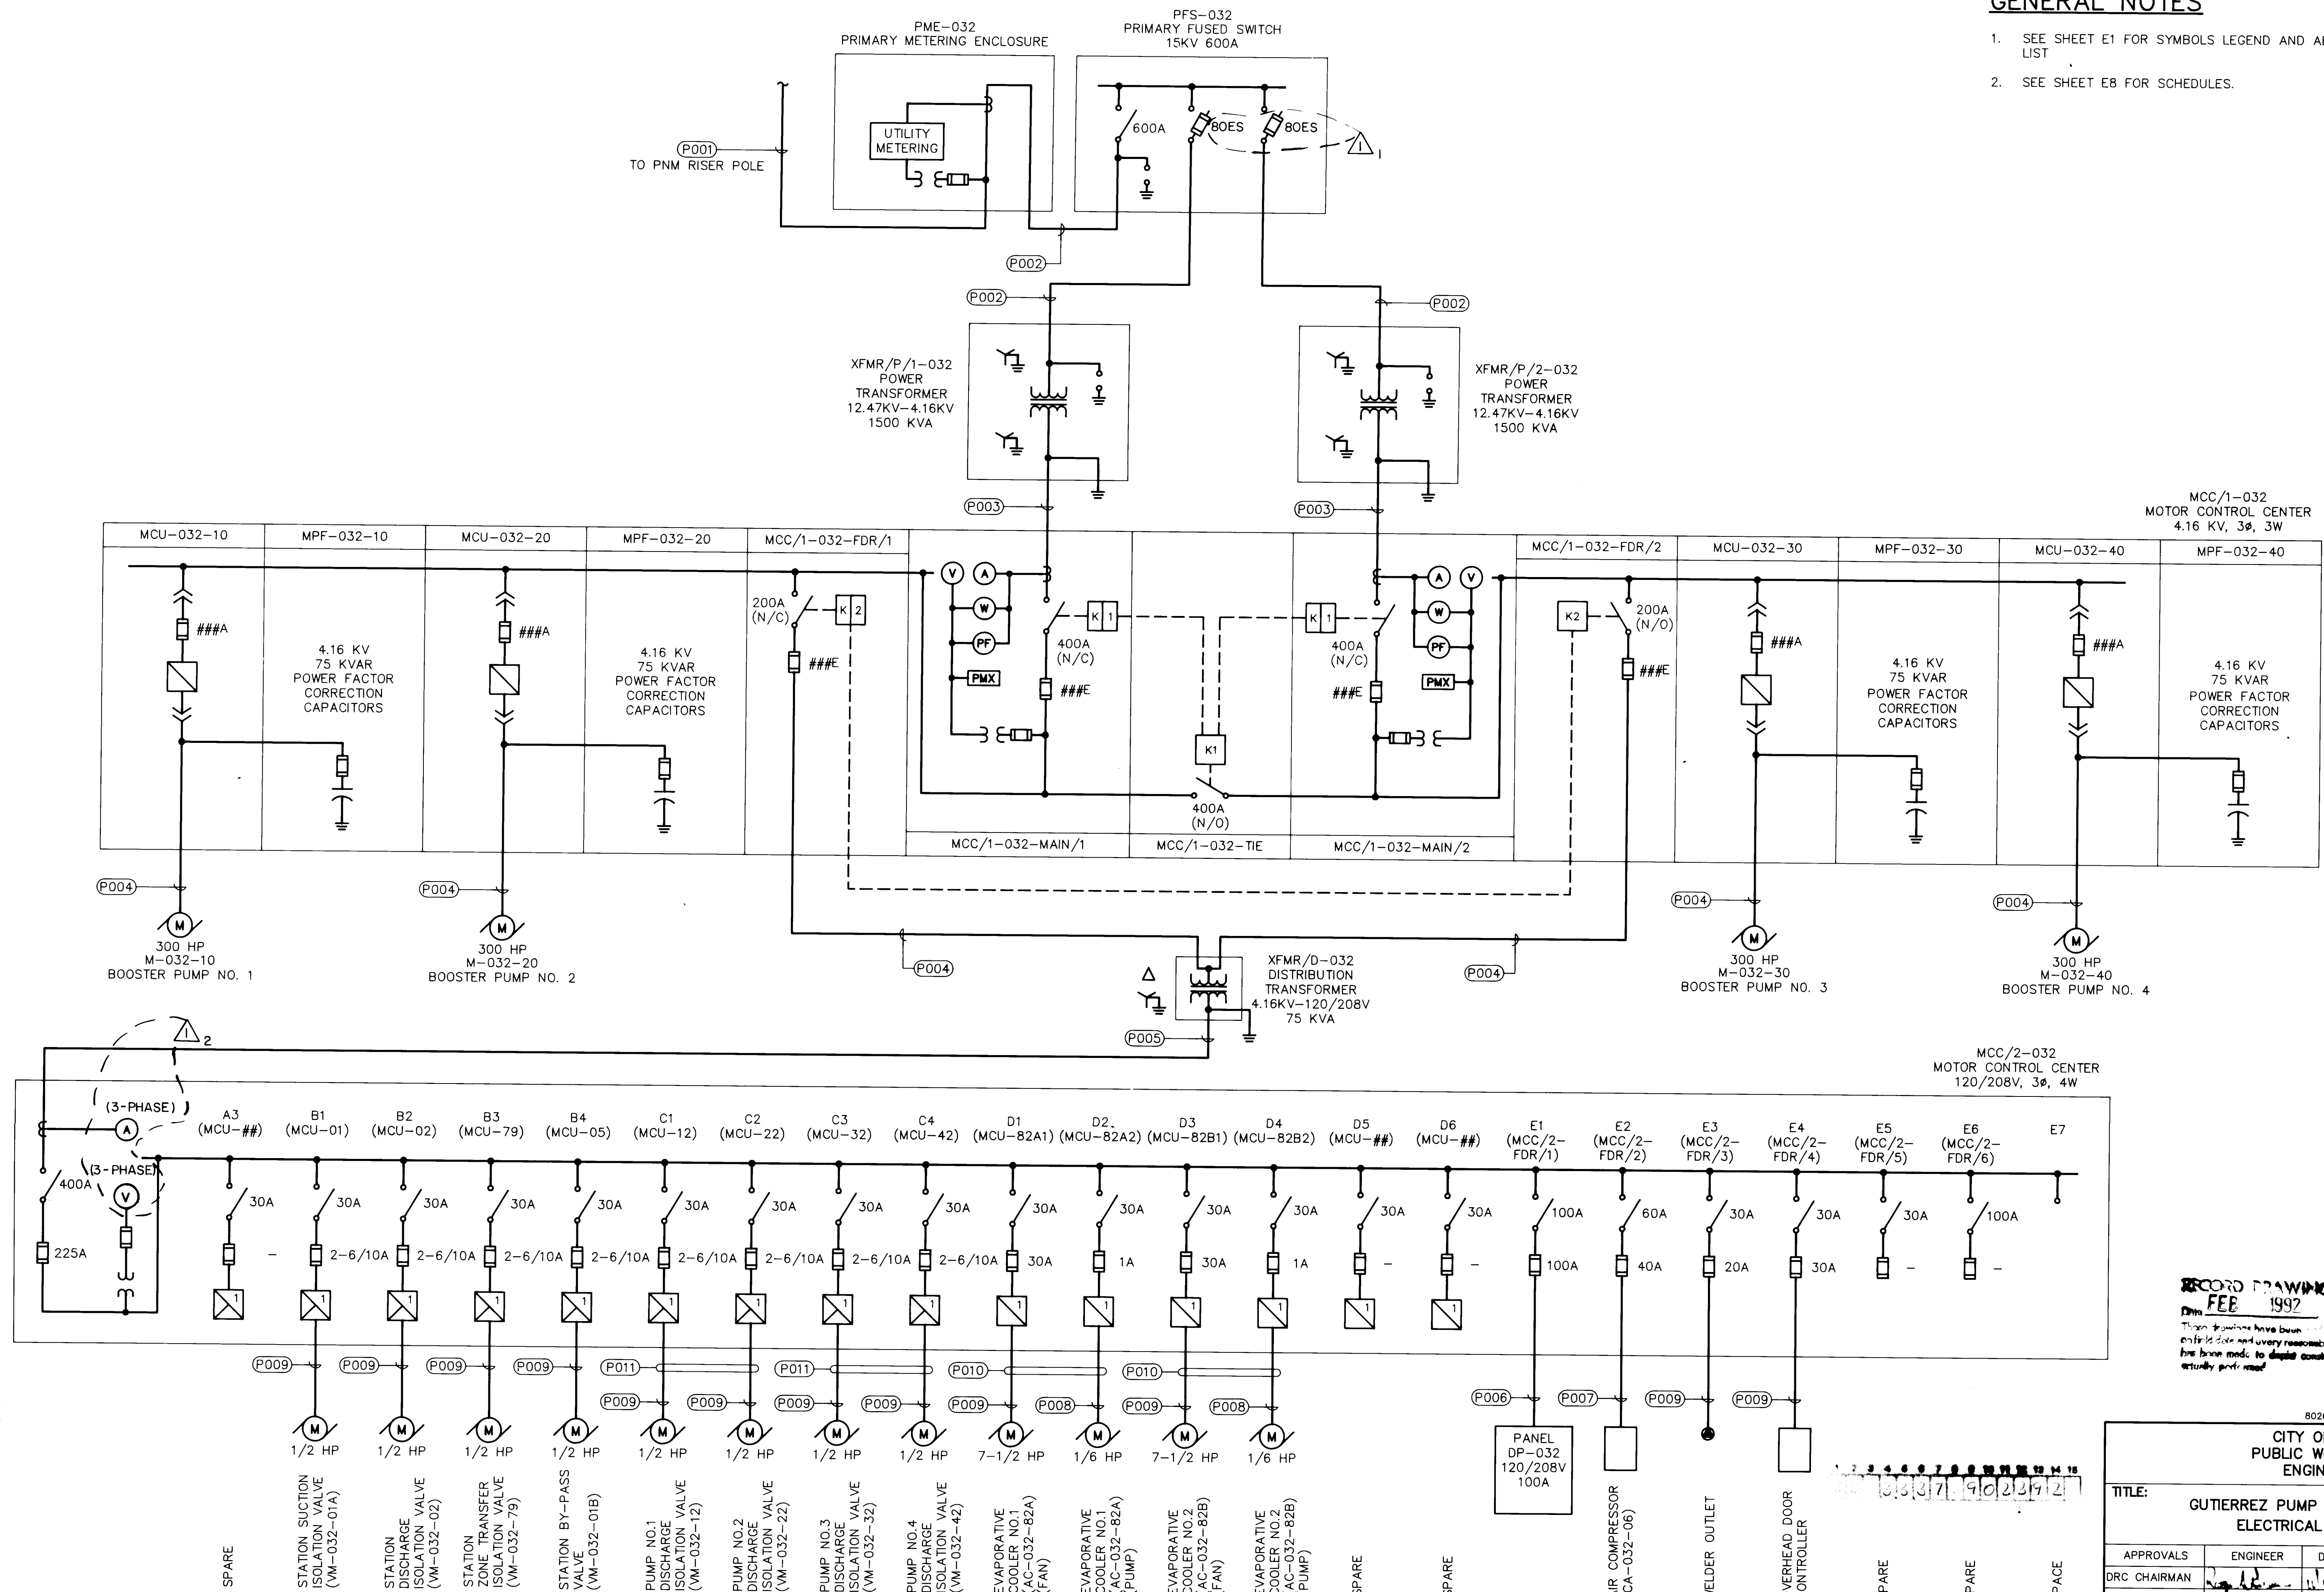

ONE-LINE DIAGRAM
NO SCALE

AS BUILT INFORMATION			
CONTRACTOR	DATE	BY	DATE
WORK	DATE	BY	DATE
INSPECTION	DATE	BY	DATE
FIELD	DATE	BY	DATE
REVISION	DATE	BY	DATE
CORRECTION	DATE	BY	DATE

BENCH MARKS

SURVEY INFORMATION

FIELD NOTES

NO.

BY

DATE

ENGINEER'S SEAL

NO.

BY

DATE

NOV. 9, 1990

DESIGNED BY

D. DOZIER

DRAWN BY

P. STRINEL

CHECKED BY

B. GRIFFIS

REVISIONS

NO.

DATE

2-92

REMARKS

DESIGN

NO.

DATE

NOV. 9, 1990

DESIGNED BY

D. DOZIER

DRAWN BY

P. STRINEL

CHECKED BY



B. GRIFFIS

8026.21G0D1/G8026ONE

CITY OF ALBUQUERQUE
PUBLIC WORKS DEPARTMENT
ENGINEERING GROUP

TITLE: GUTIERREZ PUMP STATION RECONSTRUCTIONS ELECTRICAL ONE-LINE DIAGRAMS			
APPROVALS	ENGINEER	DATE	APPROVALS
DRC CHAIRMAN	R.W. Kane	11-13-90	WATER
TRANSPORTATION	R.W. Kane	11-13-90	WASTE WATER
HYDROLOGY	CDM	11-15-90	
PROJECT NO.	3337.90	MAP NO.	F-22
		SHEET	E3 OF 19



1. SEE SHEET E-1 FOR SYMBOLS LEGEND AND ABBREVIATIONS LIST.
2. SEE SHEET E-8 FOR SCHEDULES.
3. REPLACE "##" AND "#-#" WITH ACTUAL TERMINAL ASSIGNMENTS BASED ON MANUFACTURERS SHOP DRAWINGS (TYPICAL).

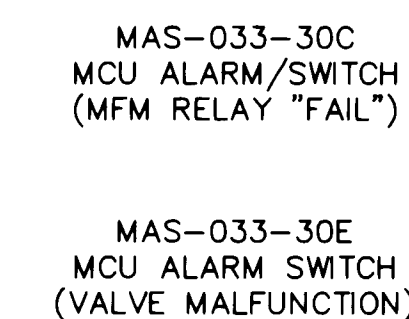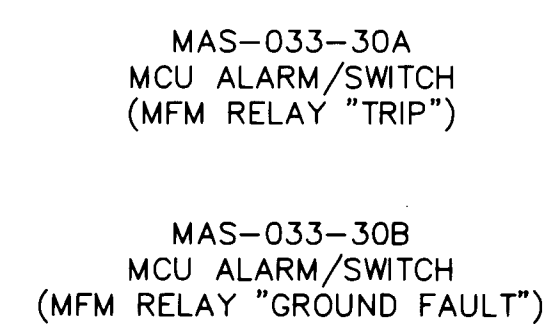

ENGINEER'S SEAL						SURVEY INFORMATION		BENCH MARKS		AS BUILT INFORMATION	
						FIELD NOTES					
						NO.	BY		DATE		
										CONTRACTOR	
										WORKED BY	DATE
										SUPERVISOR'S ACCEPTANCE BY	DATE
										CERTIFICATION BY	DATE
										DRAWINGS CORRECTED BY	DATE
						MICRO-FILM INFORMATION					
										RECORDED BY	DATE
										NO.	

CITY OF ALBUQUERQUE PUBLIC WORKS DEPARTMENT ENGINEERING GROUP					
TITLE: GUTIERREZ PUMP STATION RECONSTRUCTION INTERCONNECTION DIAGRAMS – PUMP NO. 3					
APPROVALS	ENGINEER	DATE	APPROVALS	ENGINEER	DATE
DRC CHAIRMAN	<i>Rogelio Perea</i>	<i>11/16/90</i>	WATER	<i>A.W. Kane</i>	<i>11-13-90</i>
TRANSPORTATION	<i>R/A RHP</i>	<i>11/16-90</i>	WASTE WATER	<i>R.W. Kane</i>	<i>11-13-90</i>
HYDROLOGY	<i>Com</i>	<i>11-15-90</i>			
PROJECT NO. 3337.90		MAP NO. F-22	SHEET E14		OF 19

1. SEE SHEET E-1 FOR SYMBOLS LEGEND AND ABBREVIATIONS LIST.
2. SEE SHEET E-8 FOR SCHEDULES.
3. REPLACE "##" AND "#-#" WITH ACTUAL TERMINAL ASSIGNMENTS BASED ON MANUFACTURERS SHOP DRAWINGS (TYPICAL).

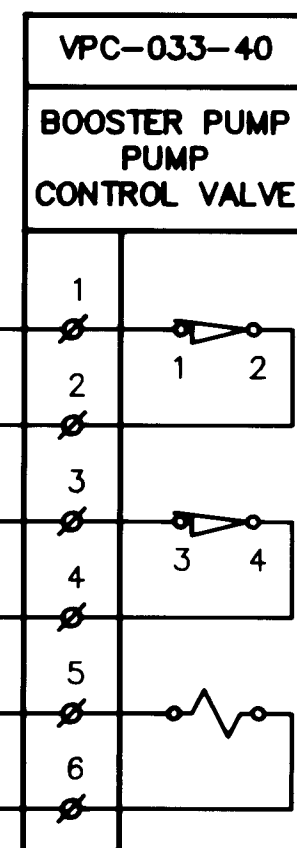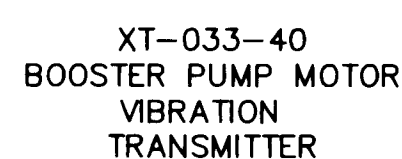

These drawings have been revised based on field data and every reasonable attempt has been made to depict construction as actually performed.

TE-033-40

INTER PUMP MOTOR ELECTRICAL BLOCK

TE-033-40A1 STATOR (RTD-1)

TE-033-40A2 STATOR (RTD-2)

TE-033-40B1 STATOR (RTD-3)

TE-033-40B2 STATOR (RTD-4)

TE-033-40C1 STATOR (RTD-5)

TE-033-40C2 STATOR (RTD-6)

TE-033-40G GUIDE BEARING (RTD-7)

TE-033-40T THRUST BEARING (RTD-8)

AS BUILT INFORMATION			
CONTRACTOR	MCC	DATE 2/92	DATE 12/19/91
WORK STARTED BY	ALB. S.V.		
ACCEPTANCE BY			
FIELD LOCATION BY	LH		
DRAWINGS BY	LH		
CORRECTED BY	LH		
MICRO-FILM INFORMATION		DATE 2/92	
RECORDED BY		DATE	
NO.			

BENCH MARKS			

SURVEY INFORMATION			
FIELD NOTES		DATE	
NO.	BY		

ENGINEER'S SEAL			

REVISIONS			
NO.	DATE	REMARKS	BY

DESIGN			
DESIGNED BY	D. DOZIER/H. LIVERMORE	DATE	NOV. 9, 1990
DRAWN BY	P. STRINEL		
CHECKED BY	B. GRIFFS		

DRAWN FOR RECORD PURPOSES

G8026E17/802621GED2

**CITY OF ALBUQUERQUE
PUBLIC WORKS DEPARTMENT
ENGINEERING GROUP**

TITLE: GUTIERREZ PUMP STATION RECONSTRUCTION
INTERCONNECTION DIAGRAMS - PUMP NO. 4

APPROVALS	ENGINEER	DATE	APPROVALS	ENGINEER	DATE
DRC CHAIRMAN			WATER		
TRANSPORTATION			WASTE WATER		
HYDROLOGY					

PROJECT NO. 3337.90	MAP NO. F-22	SHEET E15 OF 19
---------------------	--------------	-----------------

GENERAL NOTES

1. SEE SHEET E-1 FOR SYMBOLS LEGEND AND ABBREVIATIONS LIST.
2. SEE SHEET E-8 FOR SCHEDULES.
3. REPLACE "##" AND "#-" WITH ACTUAL TERMINAL ASSIGNMENTS BASED ON MANUFACTURERS SHOP DRAWINGS (TYPICAL).

VZIO-033-42
INDICATION
(NOT CLOSED)

VZIC-033-42
INDICATION
(NOT OPENED)

VWSO-033-42
OVERTORQUE SWITCH
(OPEN)

VWSC-033-42
OVERTORQUE SWITCH
(CLOSE)


VCO-033-42
OPEN COMMAND

VCC-033-42
CLOSE COMMAND

VCS-033-42
STOP COMMAND

CLOSE CONTACTOR

OPEN CONTACTOR

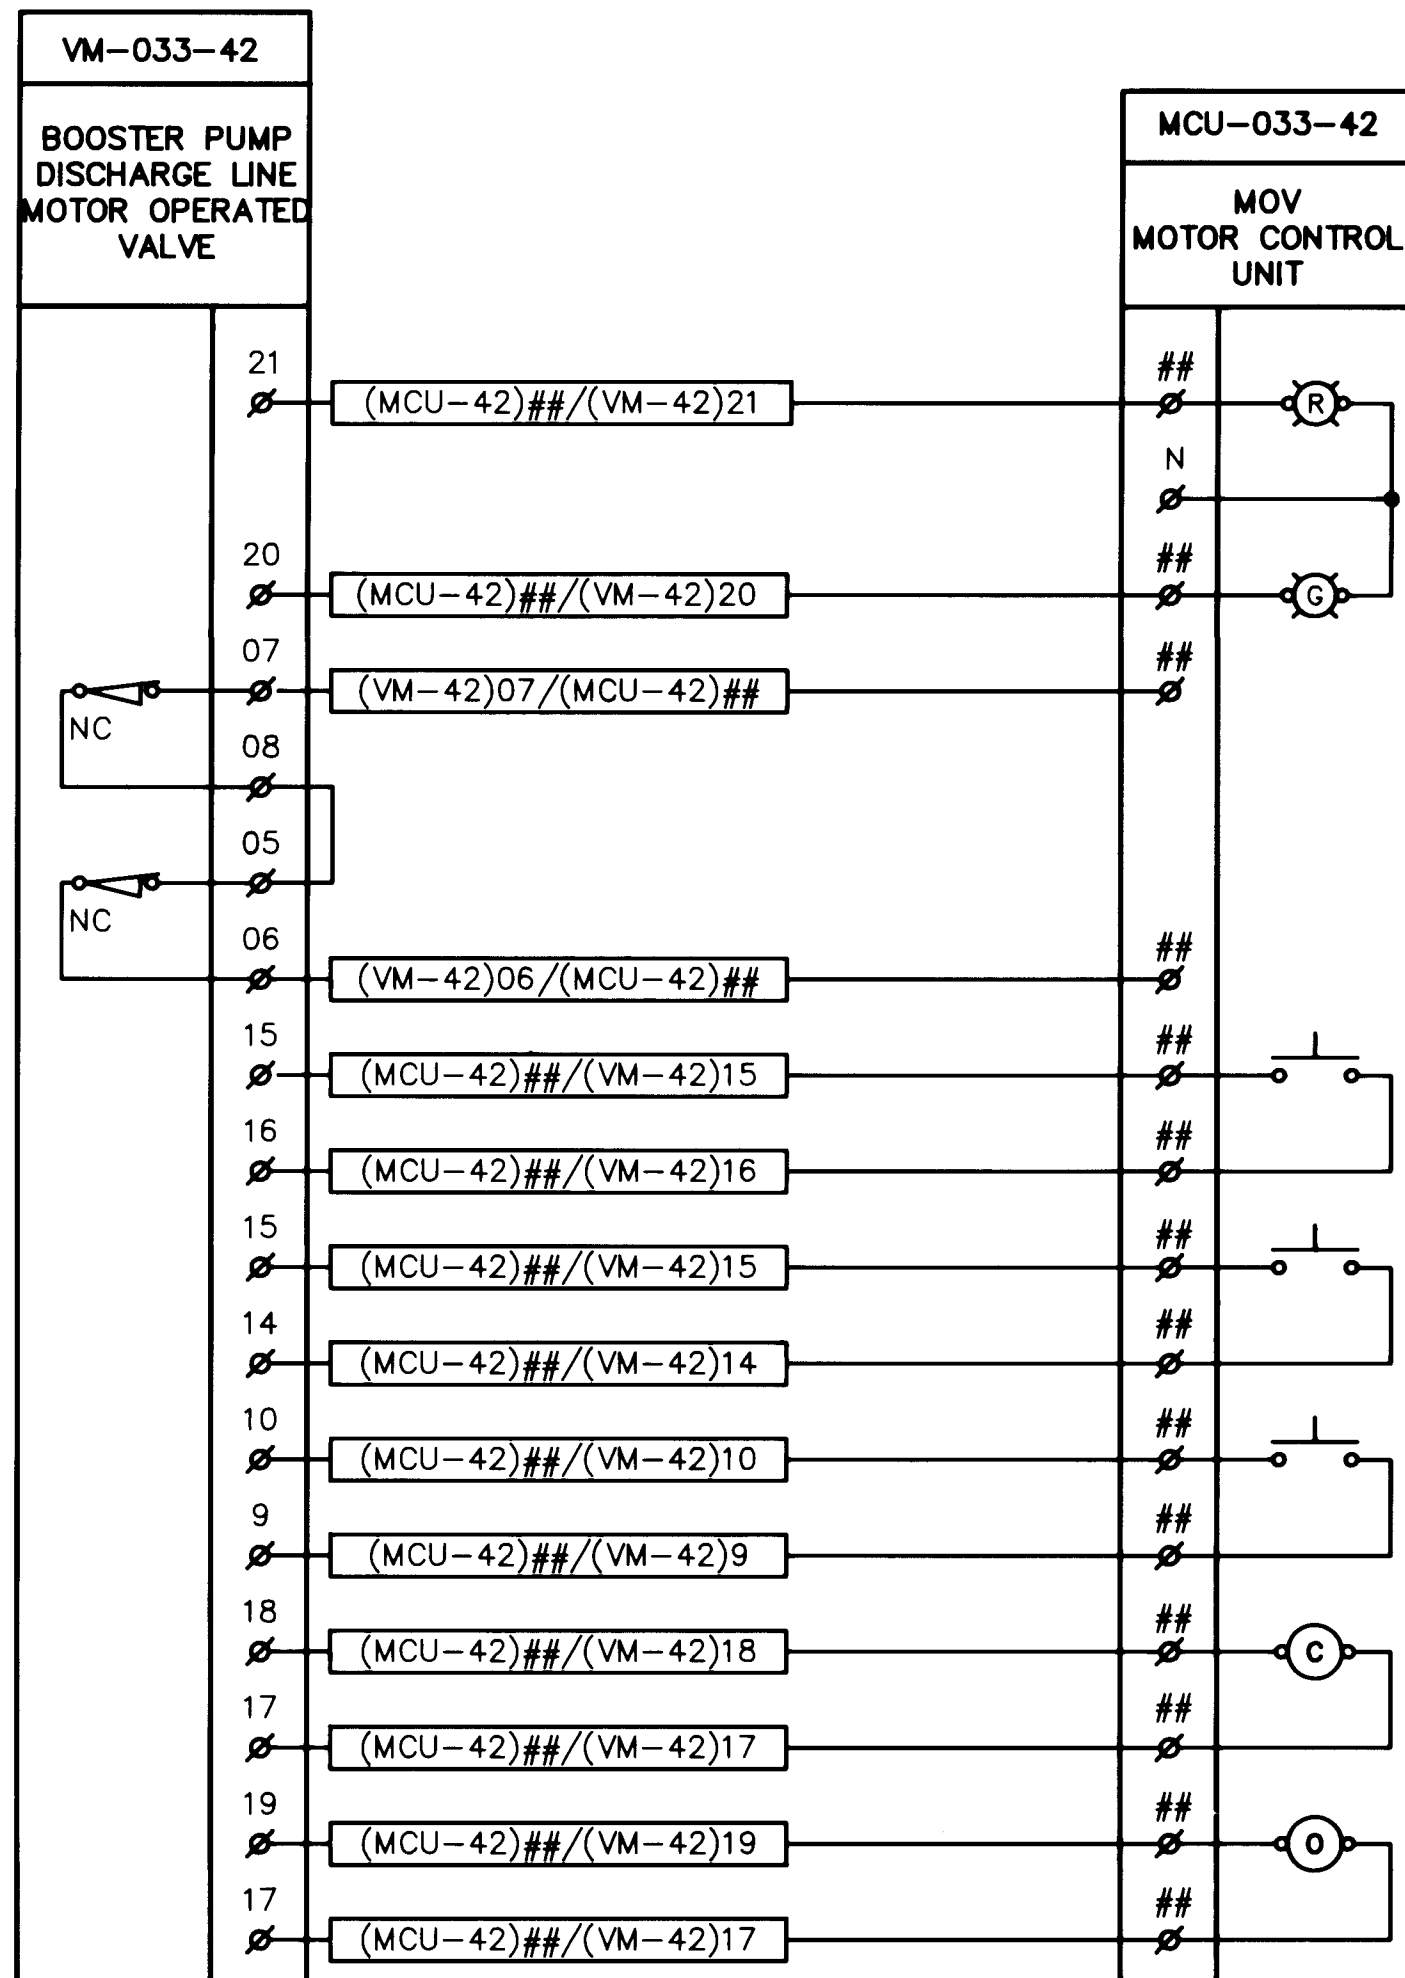

MAS-033-40A
MCU ALARM/SWITCH
(MFM RELAY "TRIP")

MAS-033-40B
MCU ALARM/SWITCH
(MFM RELAY "GROUND FAULT")

MAS-033-40C
MCU ALARM/SWITCH
(MFM RELAY "FAIL")

MAS-033-40E
MCU ALARM SWITCH
(VALVE MALFUNCTION)

MI-033-40
MCU RUN
INDICATION

MC-033-40
RUN/STOP
COMMAND

XT-033-40
BOOSTER PUMP MOTOR
VIBRATION LOOP

JS-033-40
BOOSTER PUMP
ELECTRICAL
CONSUMPTION
PULSE METER (KYZ)

VZSO-033-40
POSITION SWITCH
(FULL OPEN)

VZSC-033-40
POSITION SWITCH
(NOT CLOSED)



VS-033-40
PUMP CONTROL VALVE
SOLENOID

VZSC-033-42
POSITION SWITCH
(NOT CLOSED)

VZSO-033-42
POSITION SWITCH
(NOT OPENED)

VZSC-033-42
POSITION SWITCH
(FULL CLOSED)

XT-033-40
BOOSTER PUMP MOTOR
VIBRATION
TRANSMITTER

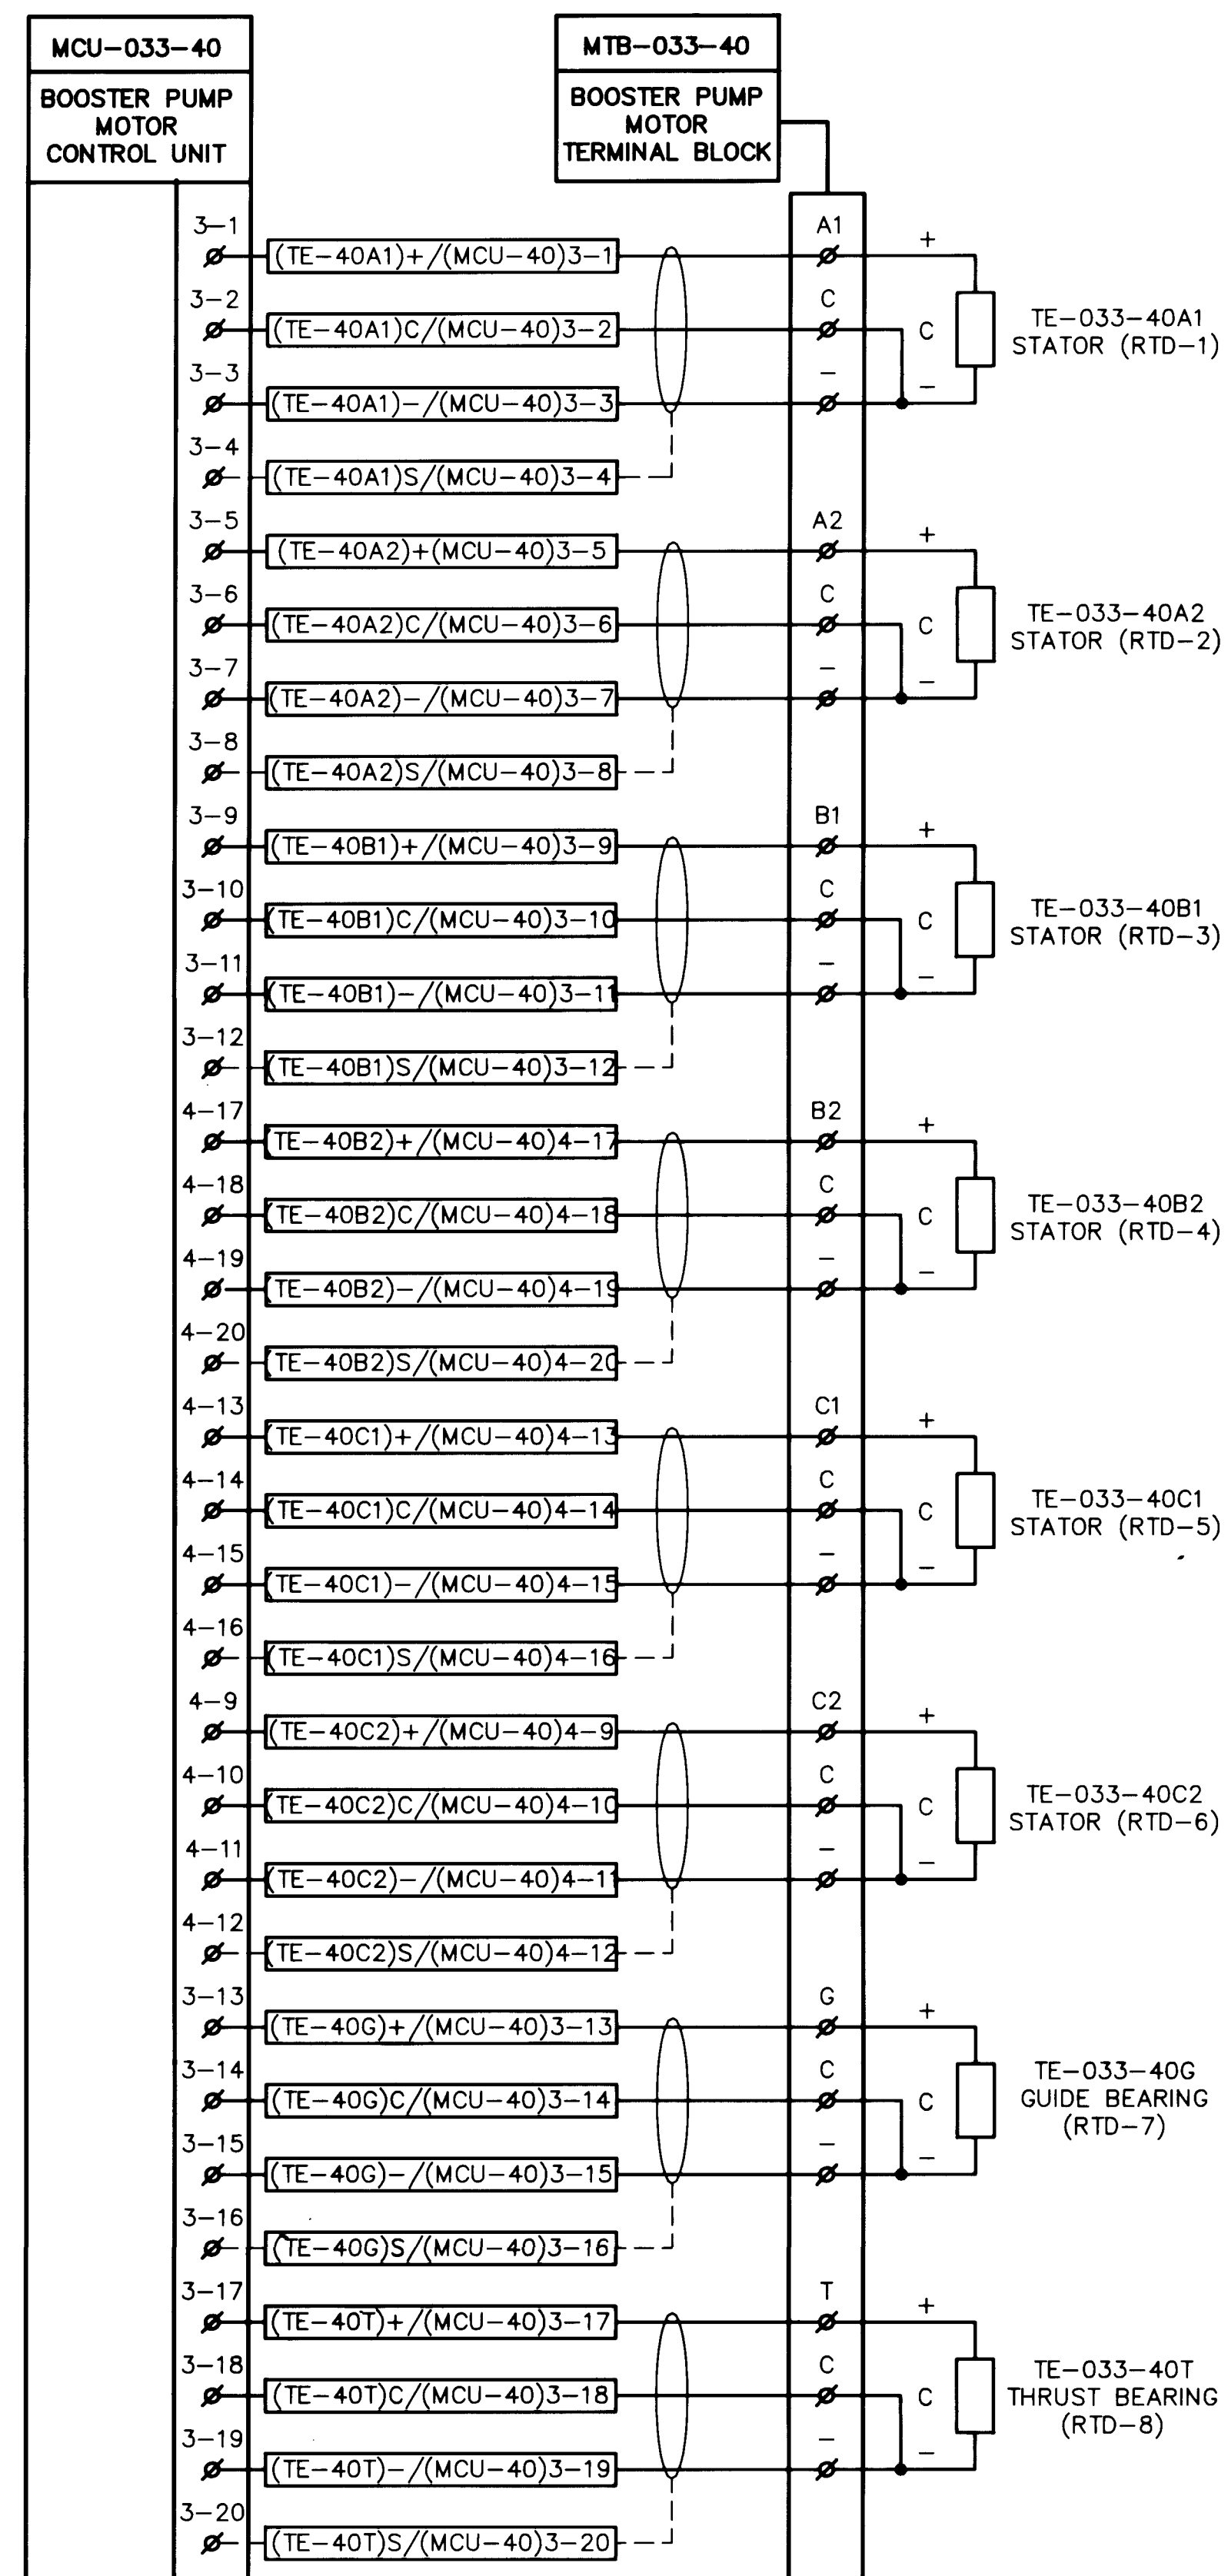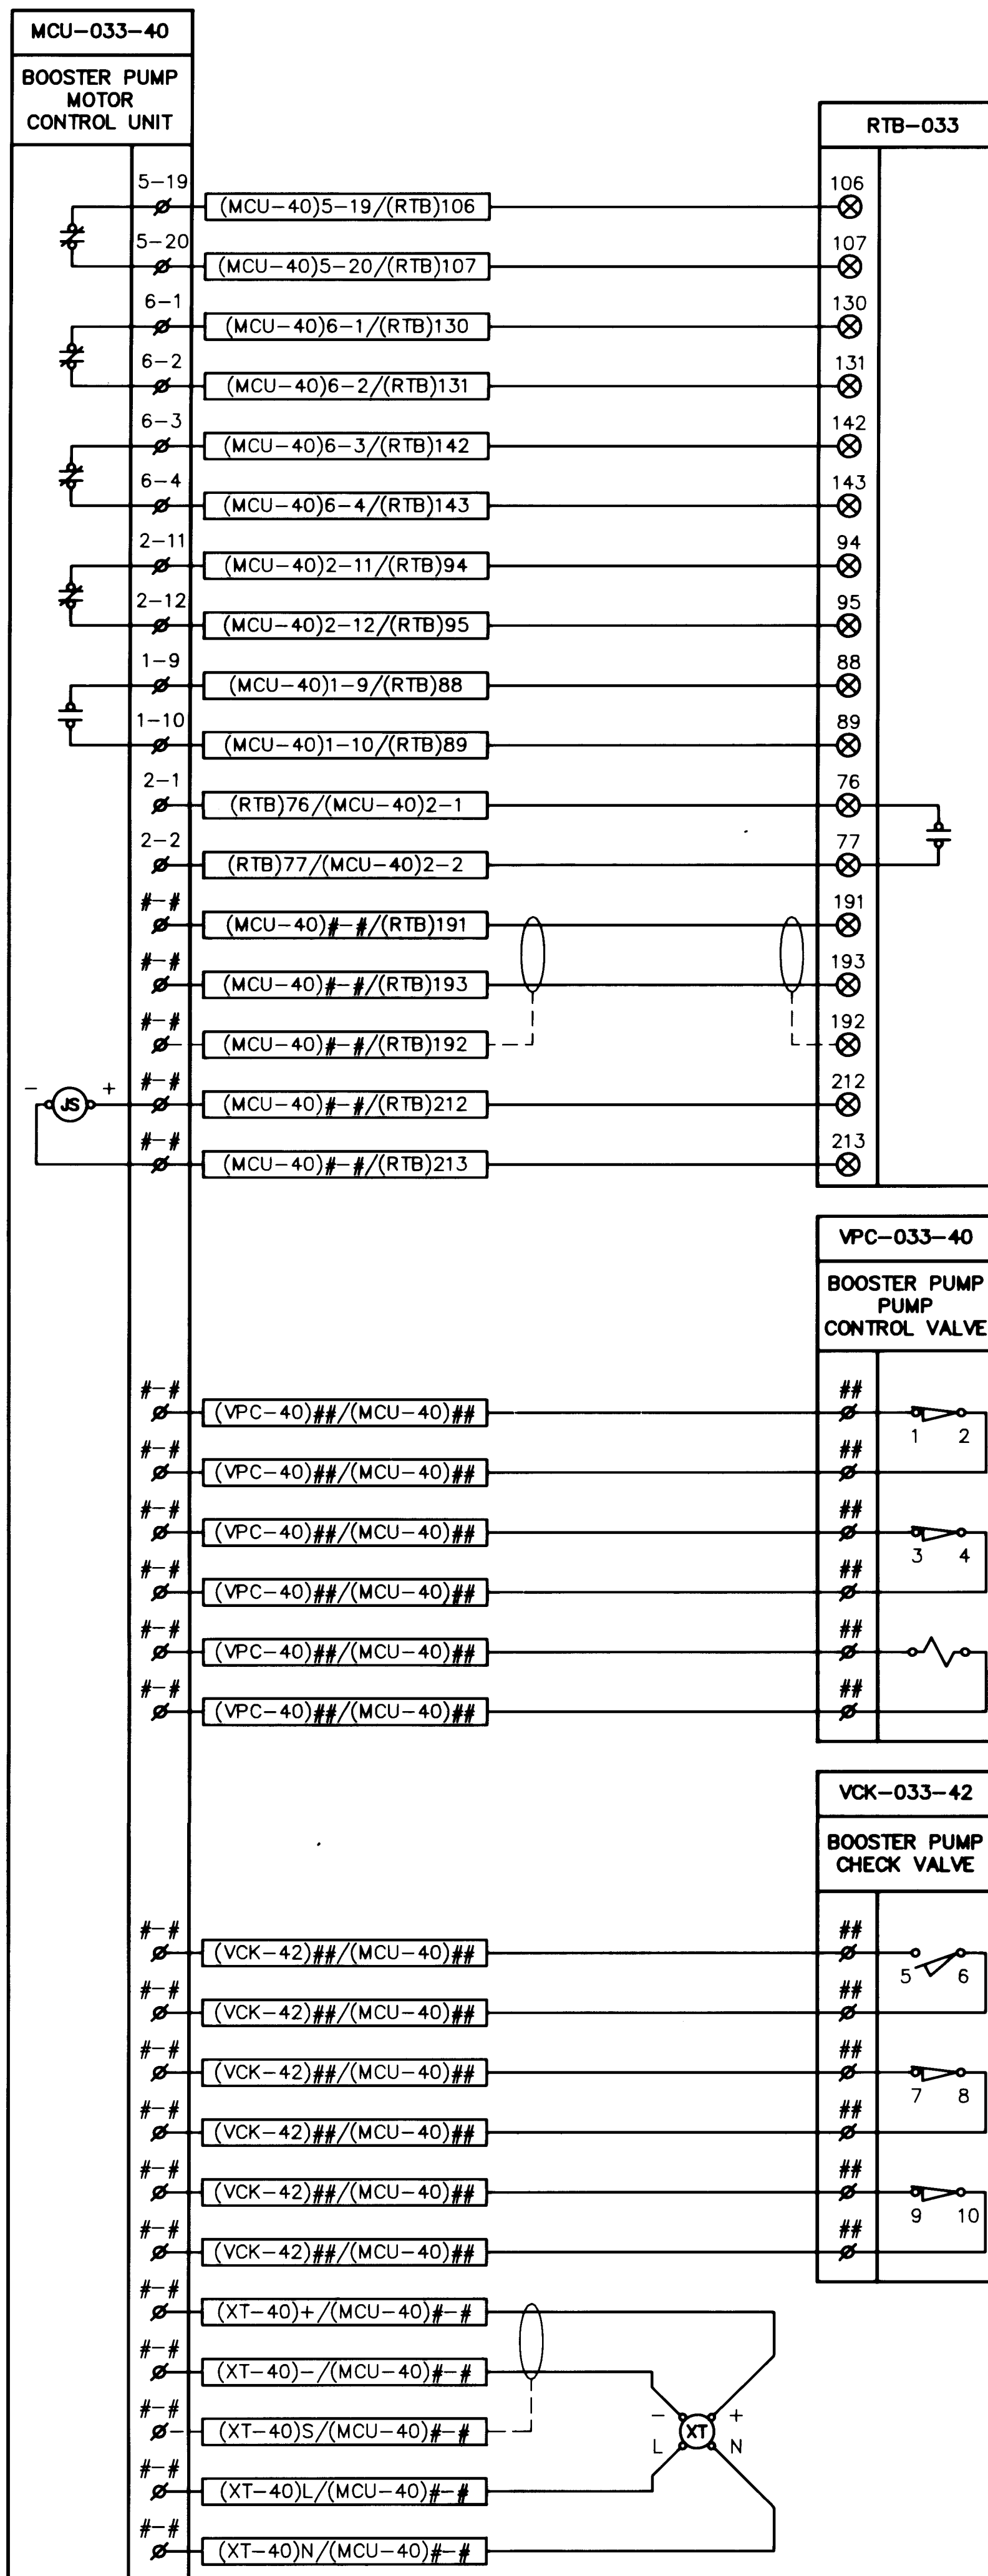

26 3337.90 92 92

THIS SHEET SUPERSEDED BY
SIMILAR SHEET MARKED "REDRAWN
FOR RECORD PURPOSES"

Form containing project information, approvals, and design details. Includes fields for TITLE, APPROVALS, ENGINEER, DATE, and DESIGN.

Table with 4 columns: CONTRACTOR, DATE, INSPECTOR, DATE. Rows for AS BUILT INFORMATION and MICRO-FILM INFORMATION.

Table with 4 columns: FIELD NOTES, DATE, BY, NO. Rows for BENCH MARKS and SURVEY INFORMATION.





Table with 4 columns: REMARKS, REVISIONS, DATE, BY. Rows for ENGINEER'S SEAL and DESIGN.

GENERAL NOTES

- SEE SHEET E1 FOR SYMBOLS LEGEND AND ABBREVIATIONS LIST.
- SEE SHEET E8 FOR SCHEDULES.
- REPLACE "##" AND "#-#" WITH ACTUAL TERMINAL ASSIGNMENTS BASED ON MANUFACTURERS DRAWINGS (TYPICAL).

KEYED NOTES

- B/W CONTROLS INC. RELAY. SEE SECTION 13311 OF THE SPECIFICATIONS.

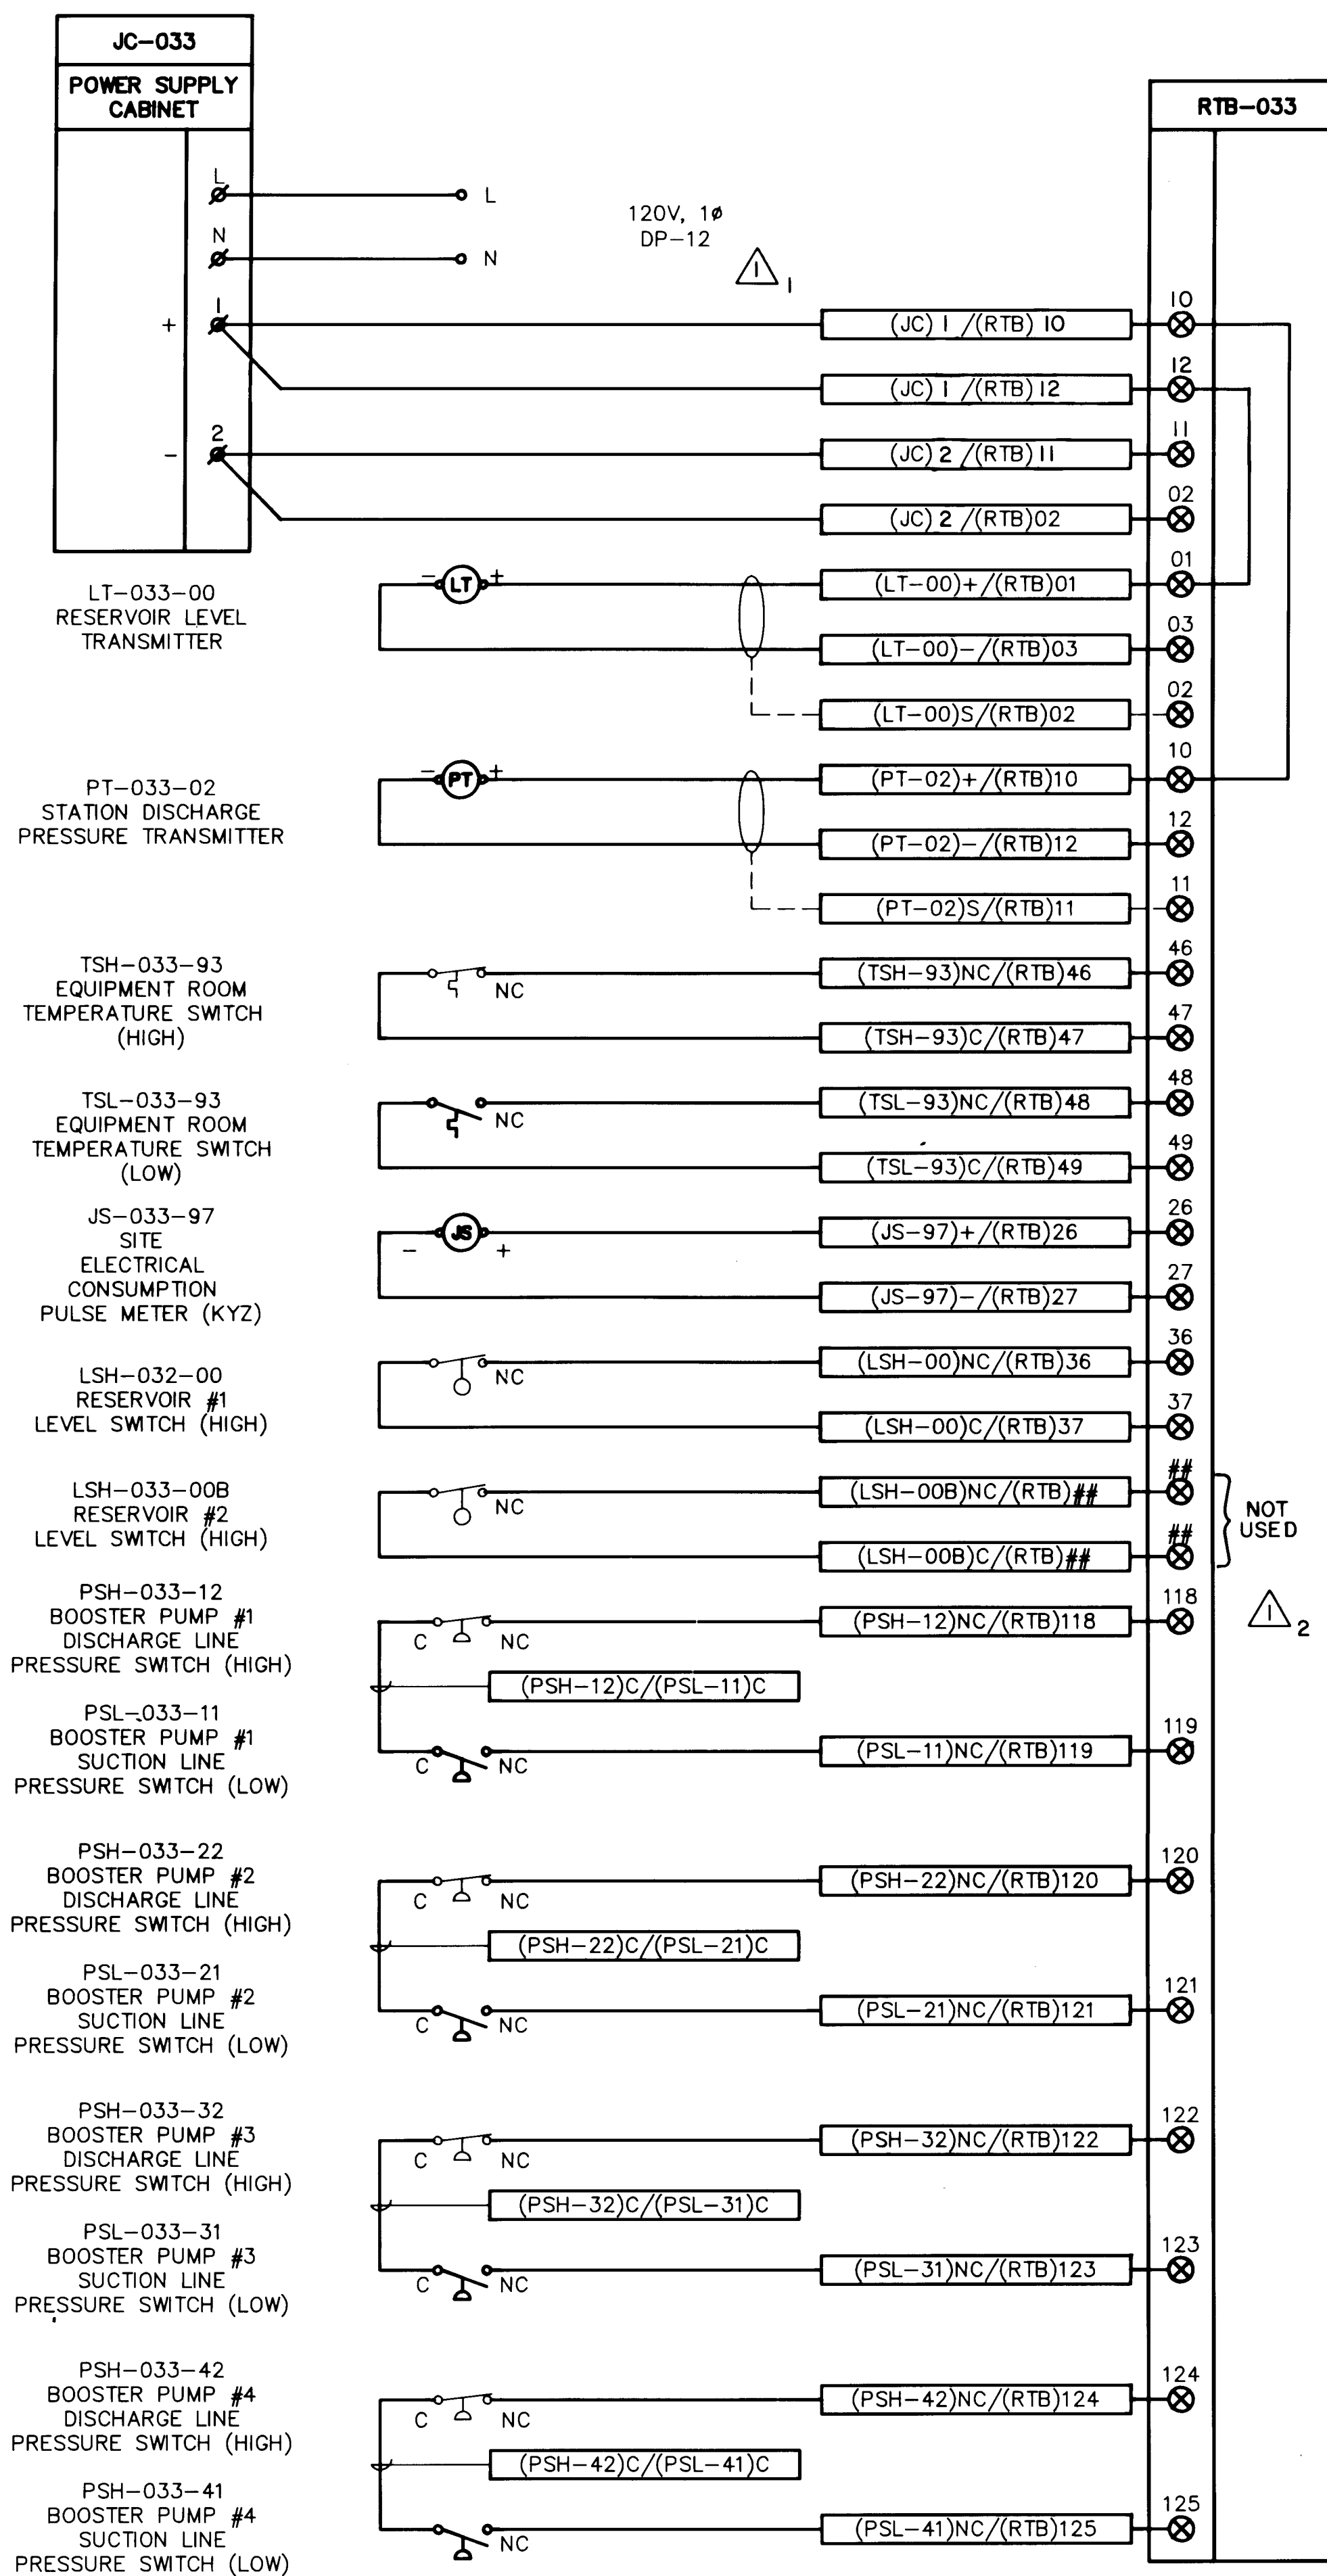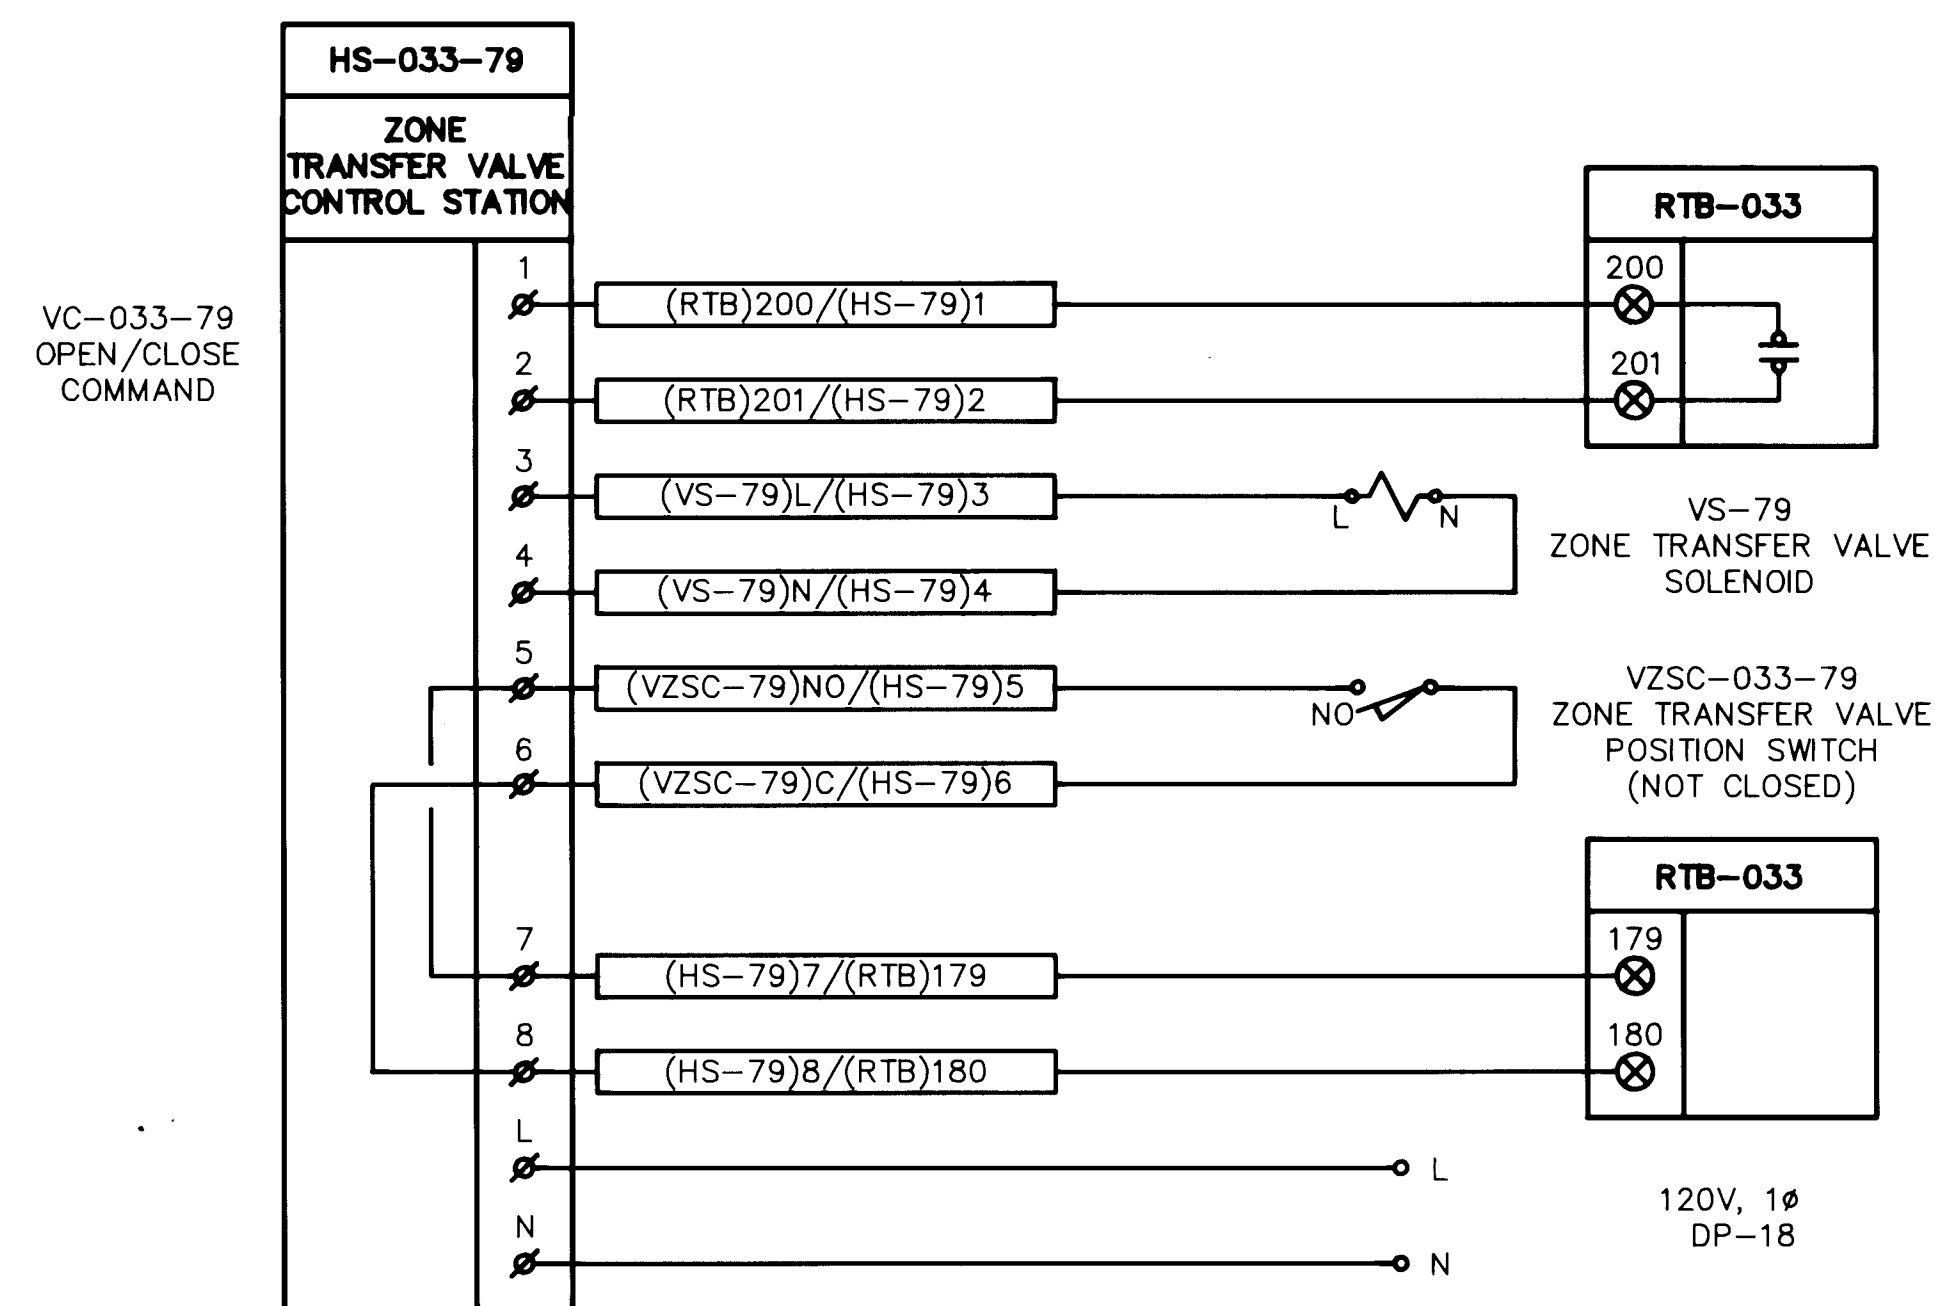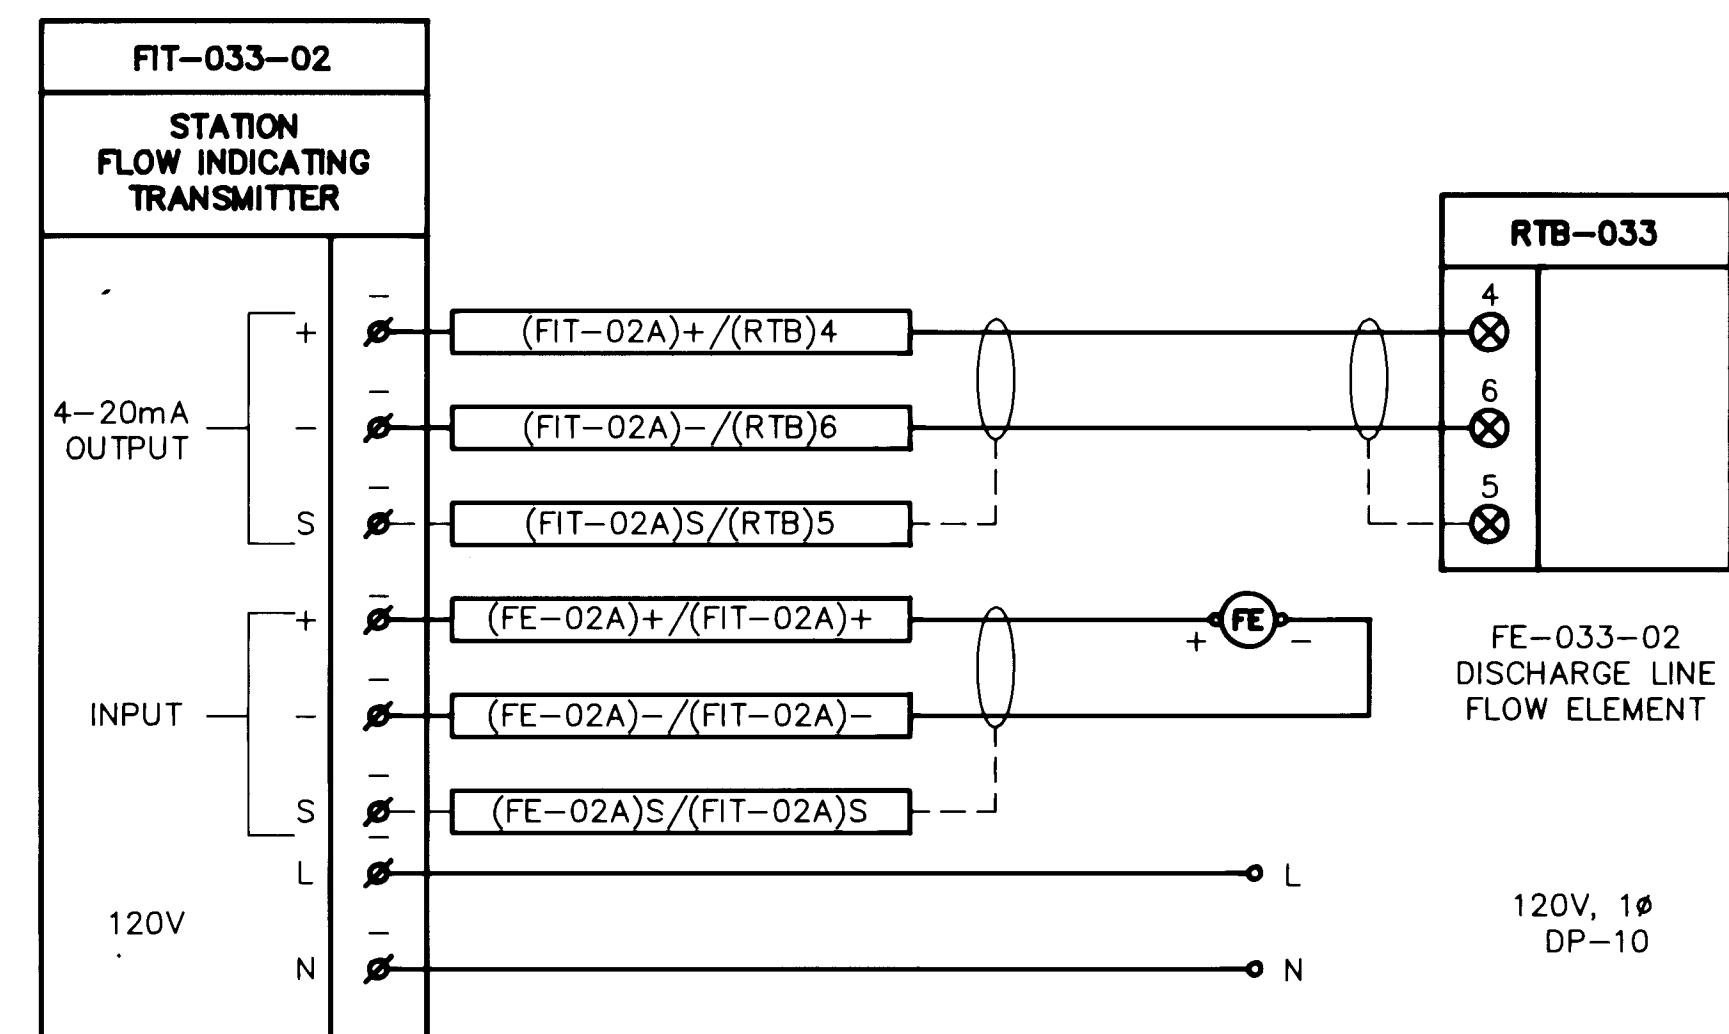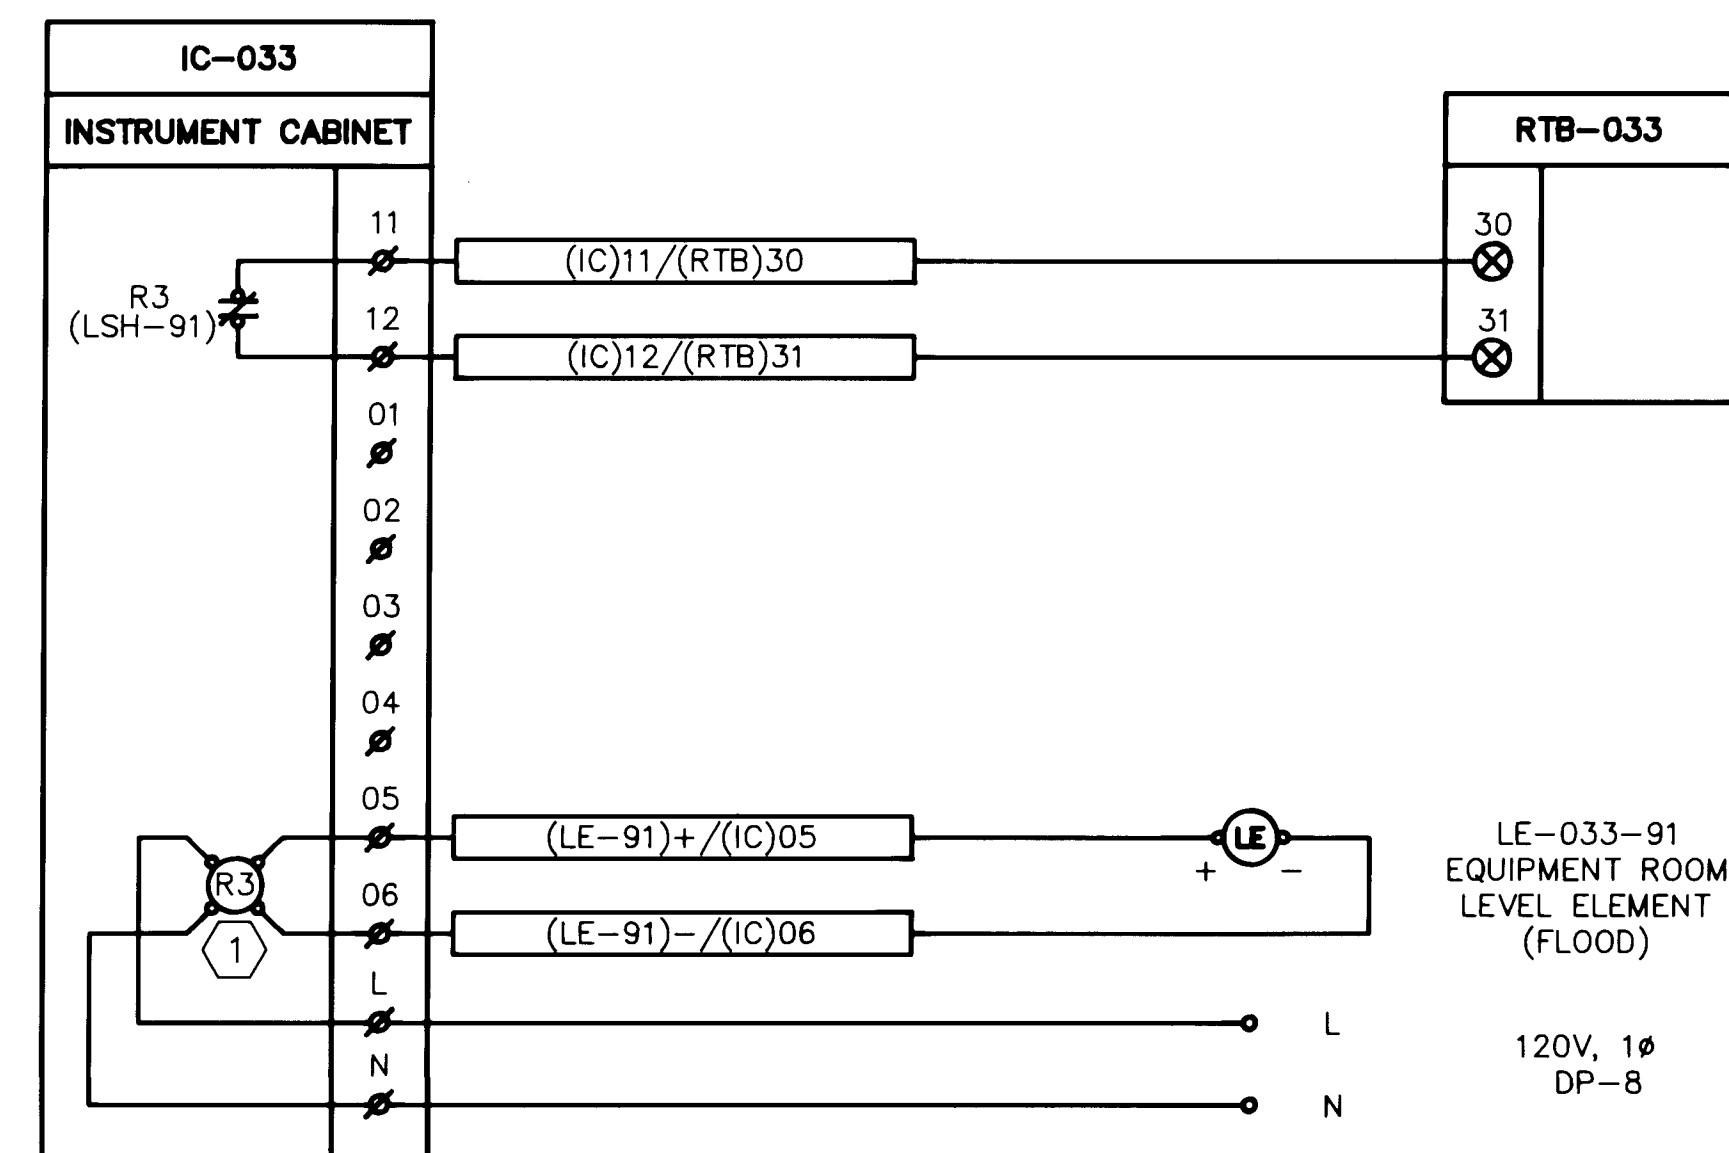

AS BUILT INFORMATION	
CONTRACTOR	DATE
WORKED BY	DATE
INSPECTOR'S	DATE
ACCEPTANCE BY	DATE
VERIFICATION BY	DATE
DRAWING	DATE
DESIGNED BY	DATE
RECORDED BY	DATE
NO.	

BENCH MARKS	

SURVEY INFORMATION	
FIELD NOTES	DATE
NO.	BY

ENGINEER'S SEAL	
NO.	DATE

REVISIONS	
NO.	DATE
2	2-92
BY	REMARKS
DESIGNED BY	D. DOZIER/H. LIVERMORE
DRAWN BY	T. LAKE
CHECKED BY	G. GRIFTS







CITY OF ALBUQUERQUE PUBLIC WORKS DEPARTMENT ENGINEERING GROUP					
TITLE: GUTIERREZ PUMP STATION RECONSTRUCTION INTERCONNECTION DIAGRAMS - MISC.					
APPROVALS	ENGINEER	DATE	APPROVALS	ENGINEER	DATE
DRC CHAIRMAN	2-92	11-16-90	WATER	R.W. Kane	11-13-90
TRANSPORTATION	N/A RHD	11-16-90	WASTE WATER	R.W. Kane	11-13-90
HYDROLOGY	LDH	11-15-90			
PROJECT NO.	3337.90	MAP NO.	F-22	SHEET	19

RECORD DRAWING
FEB 1992

These drawings have been revised based on field data and every reasonable attempt has been made to depict construction as actually performed.

GENERAL NOTES

- SEE SHEET E1 FOR SYMBOLS LEGEND AND ABBREVIATIONS LIST.
- SEE SHEET E8 FOR CONDUIT SCHEDULES.
- REPLACE "##" AND "##" WITH TERMINAL ASSIGNMENTS BASED ON MANUFACTURER'S SHOP DRAWINGS. (TYPICAL)

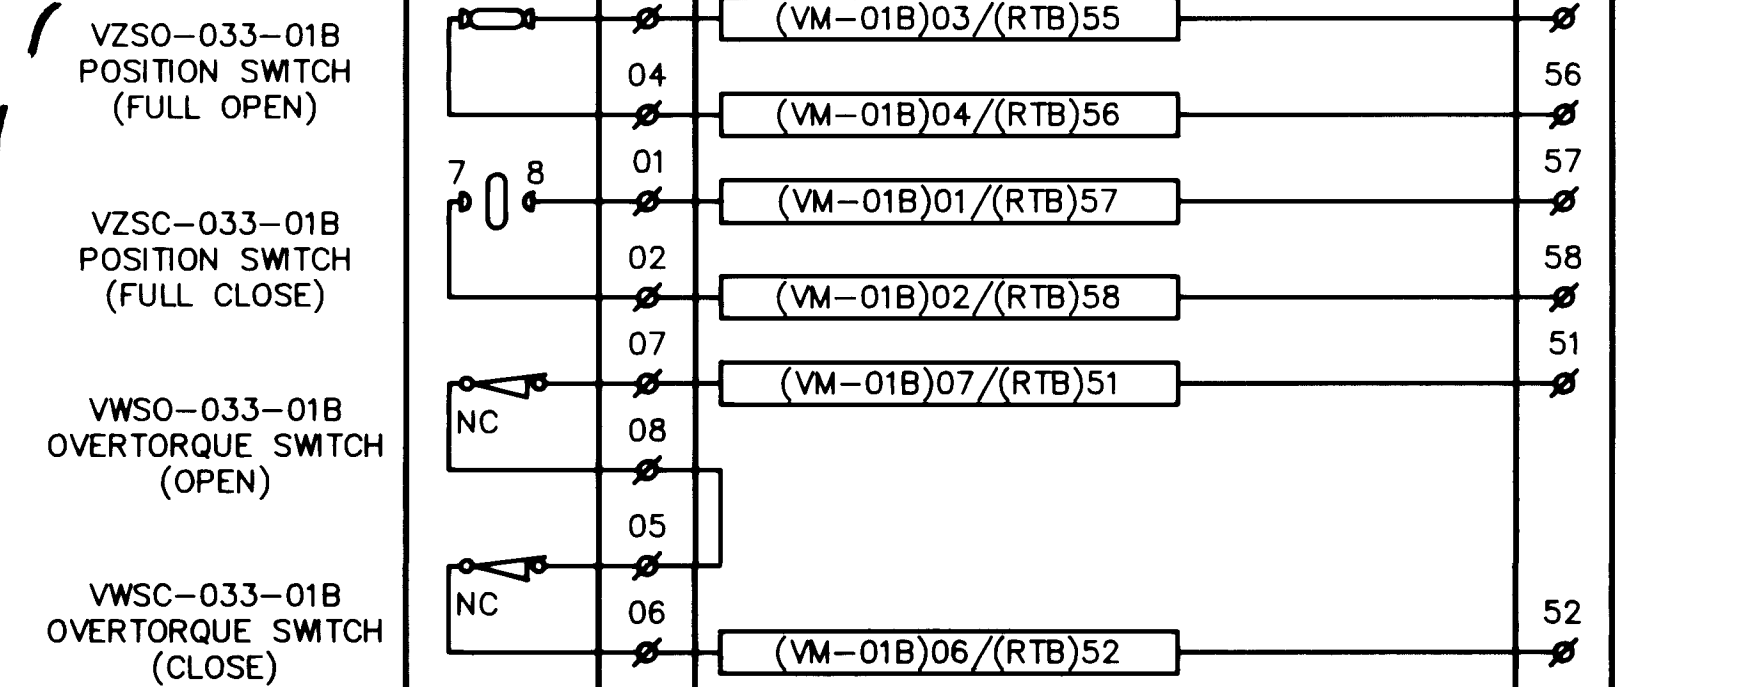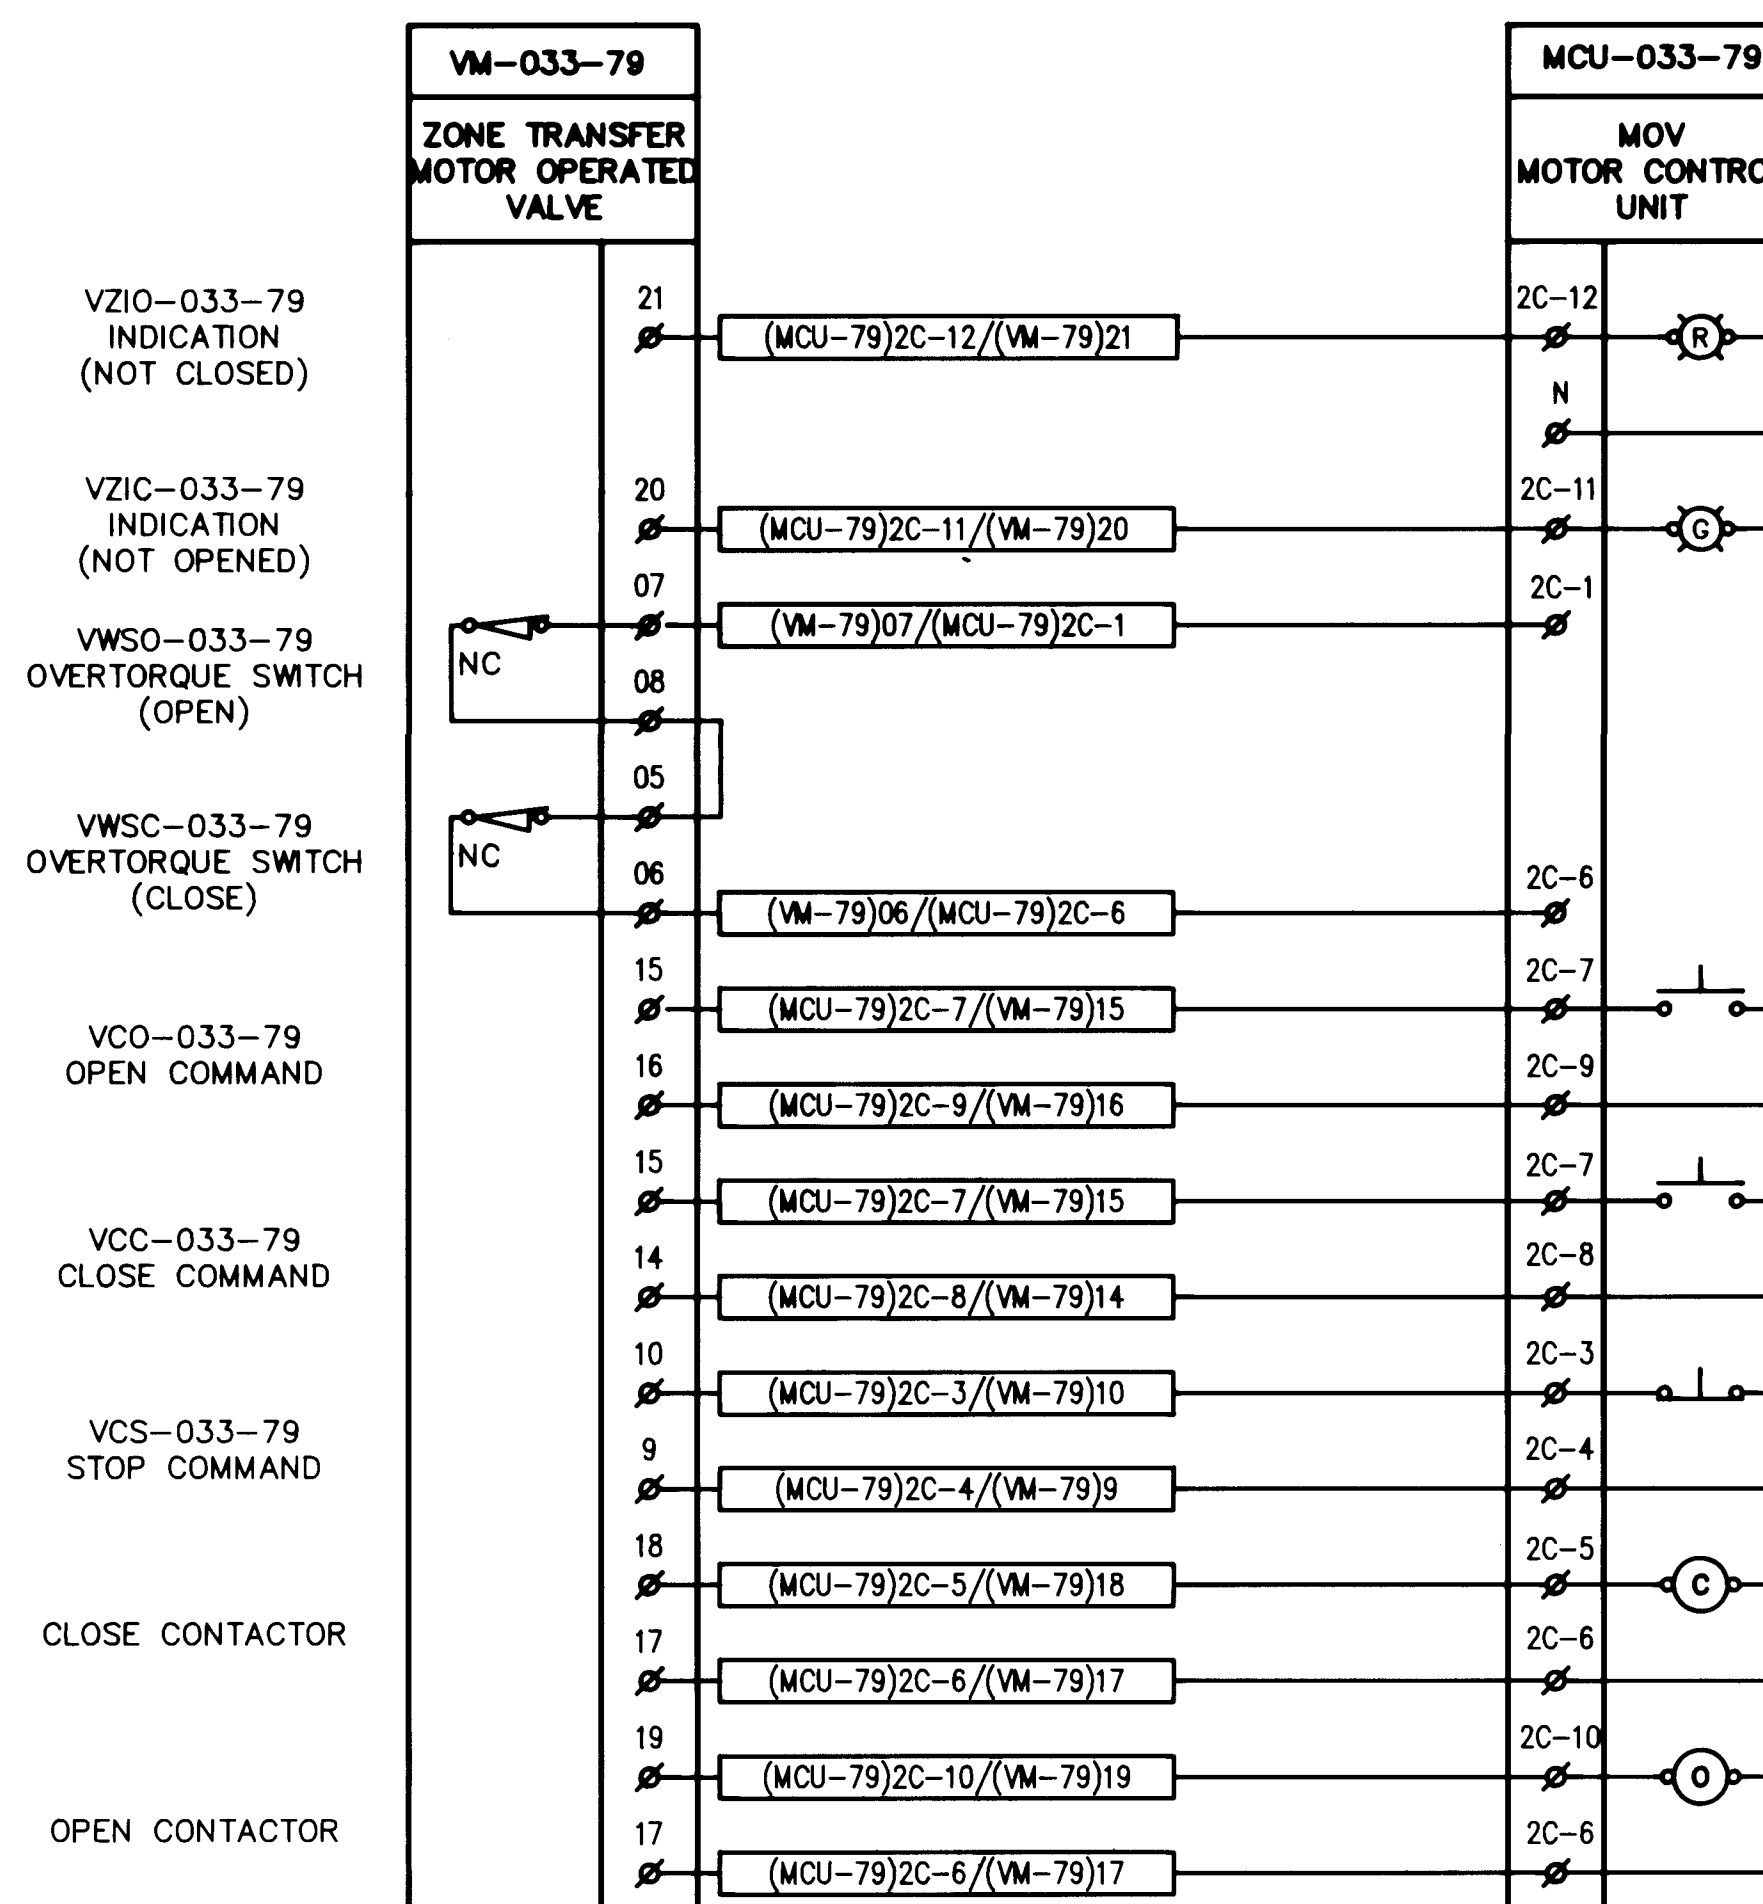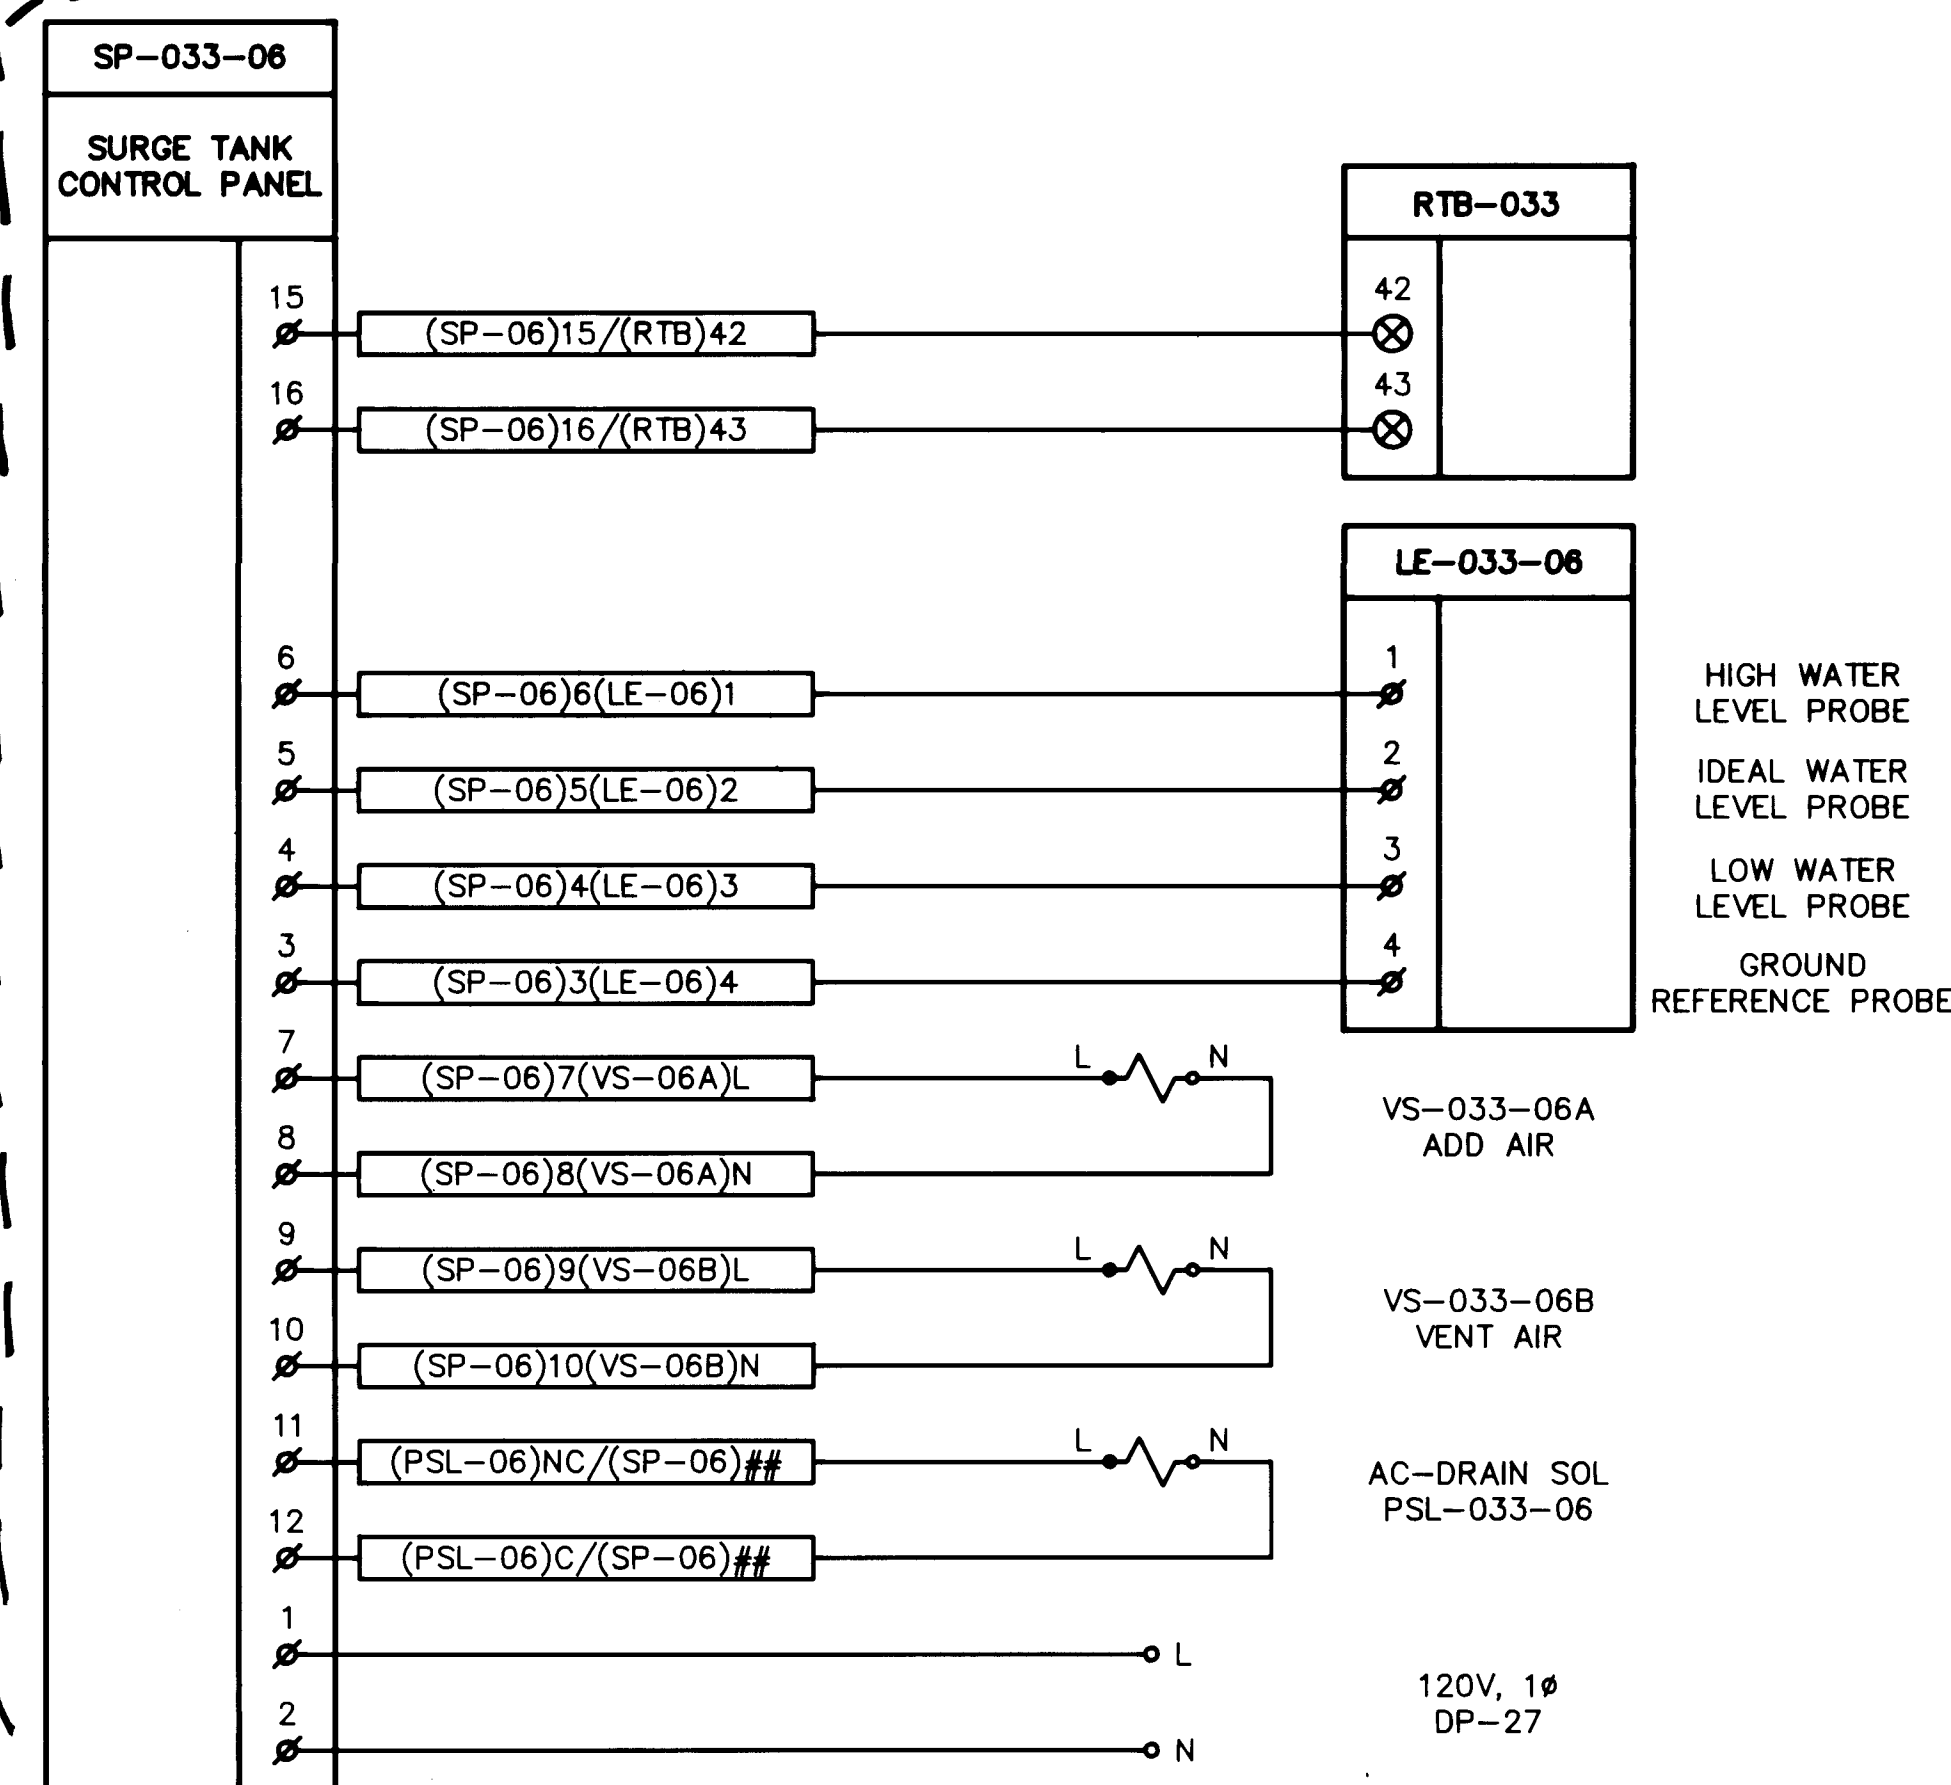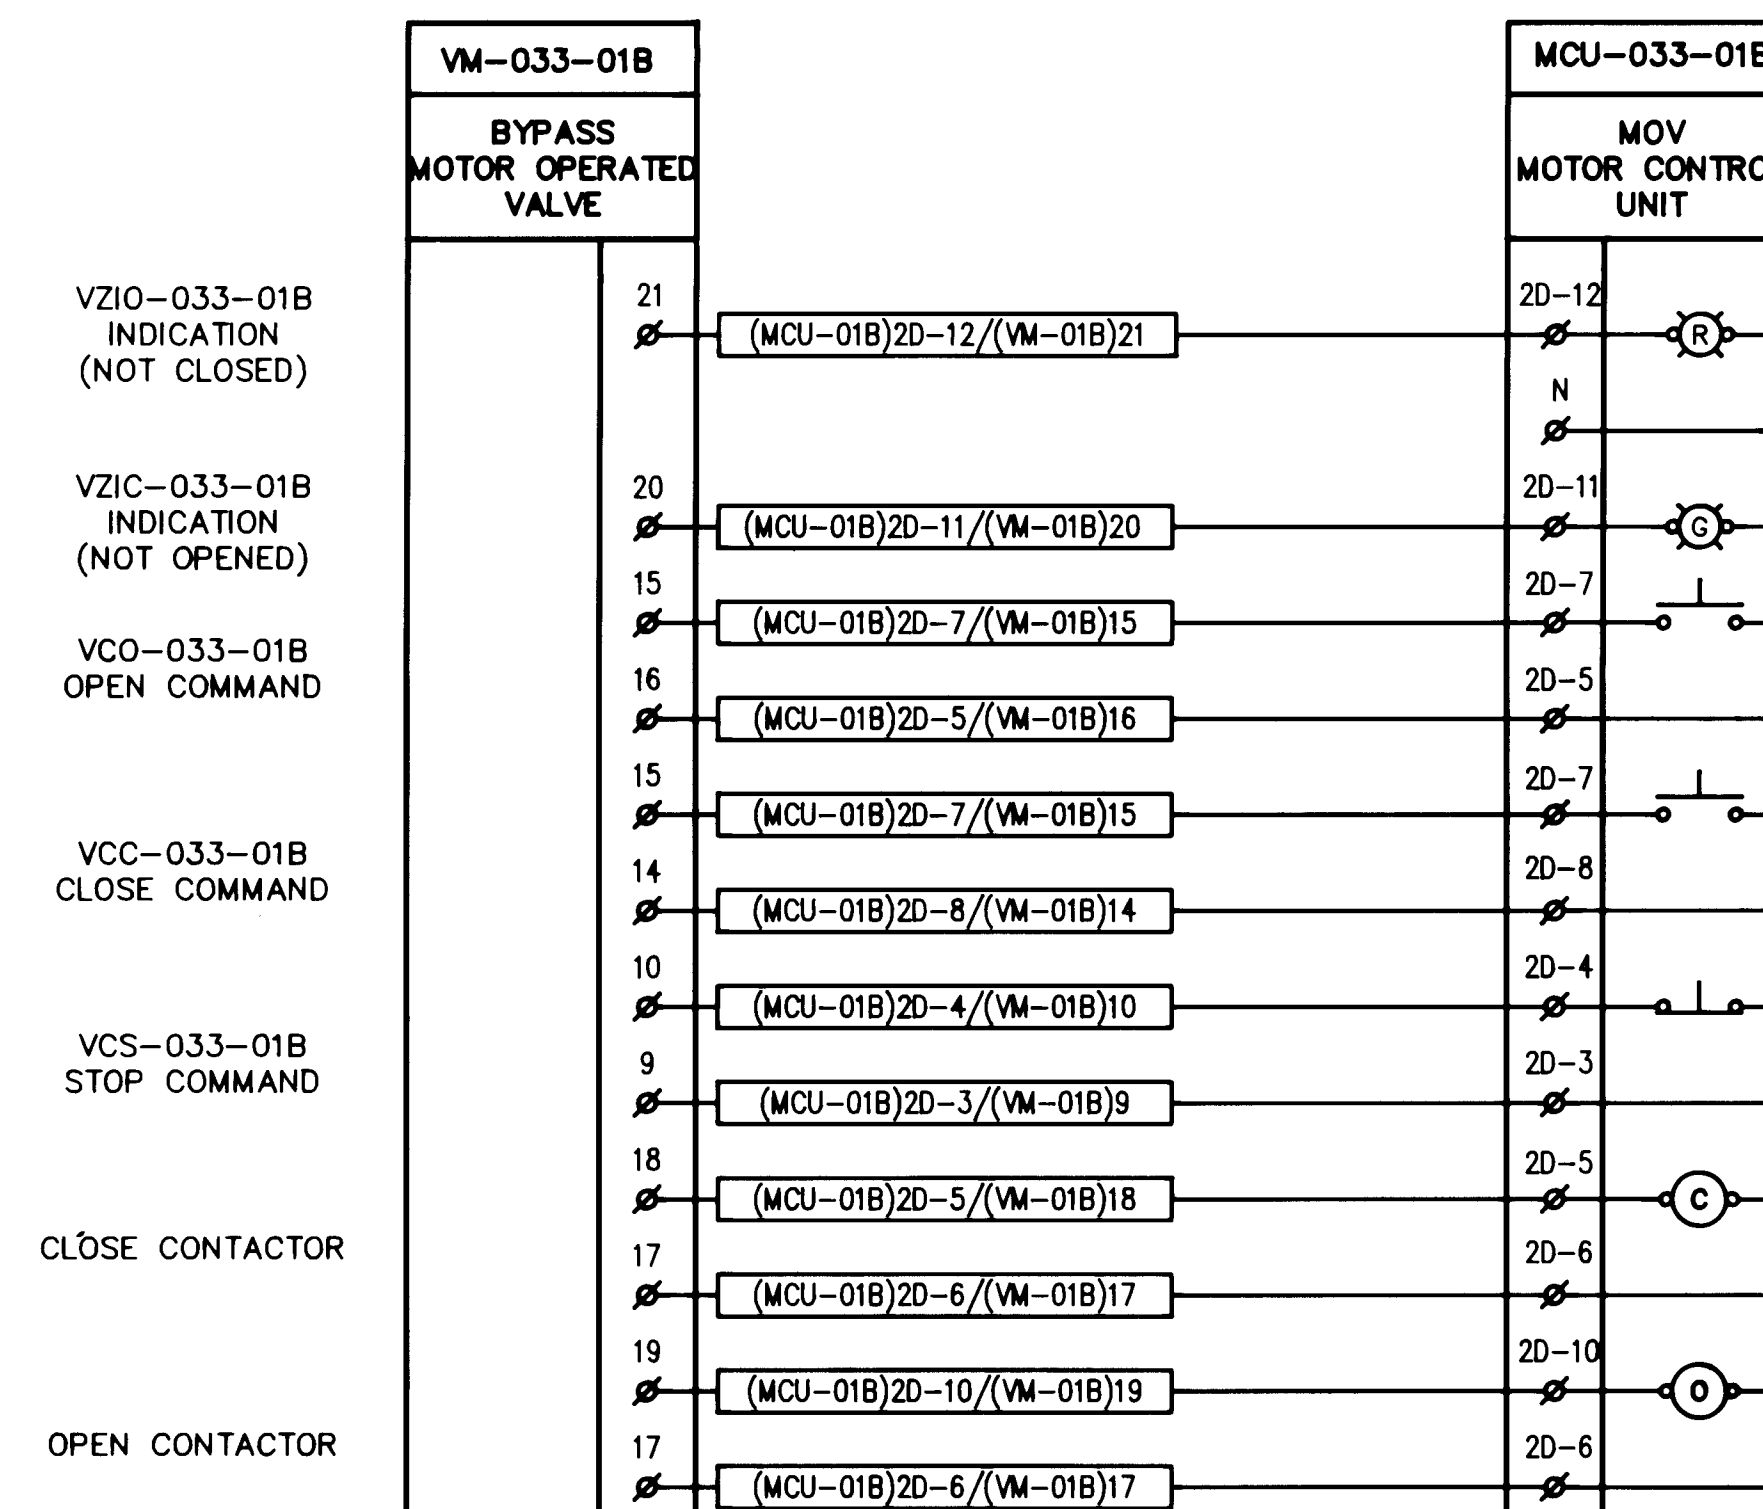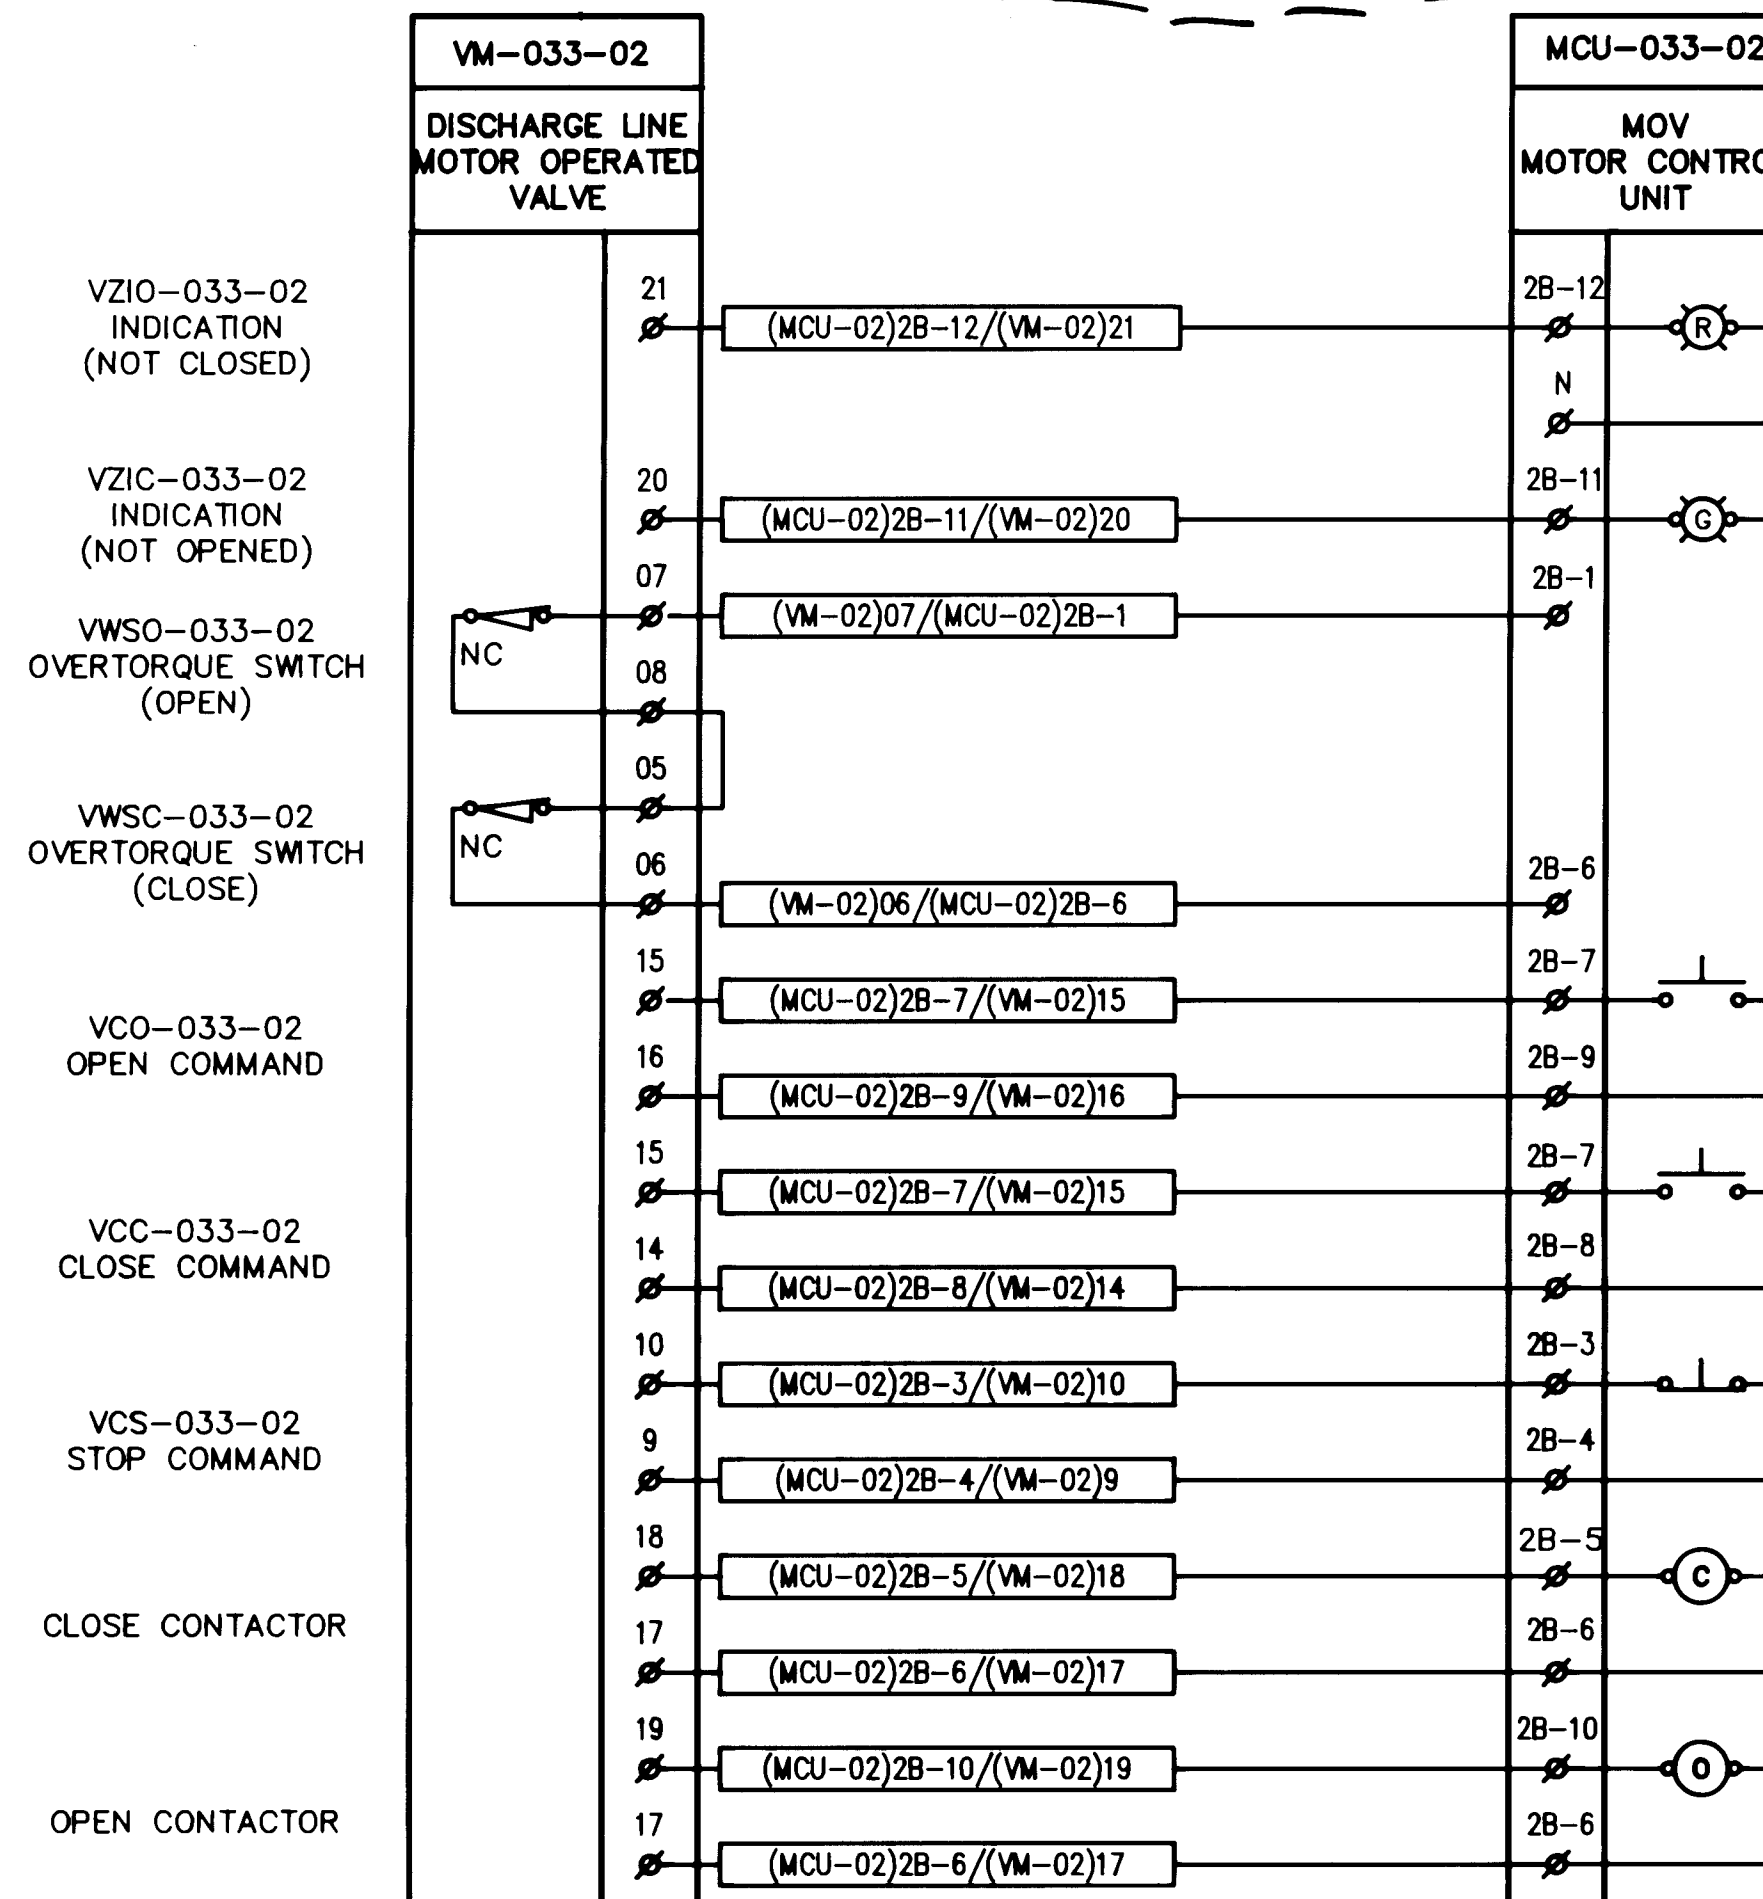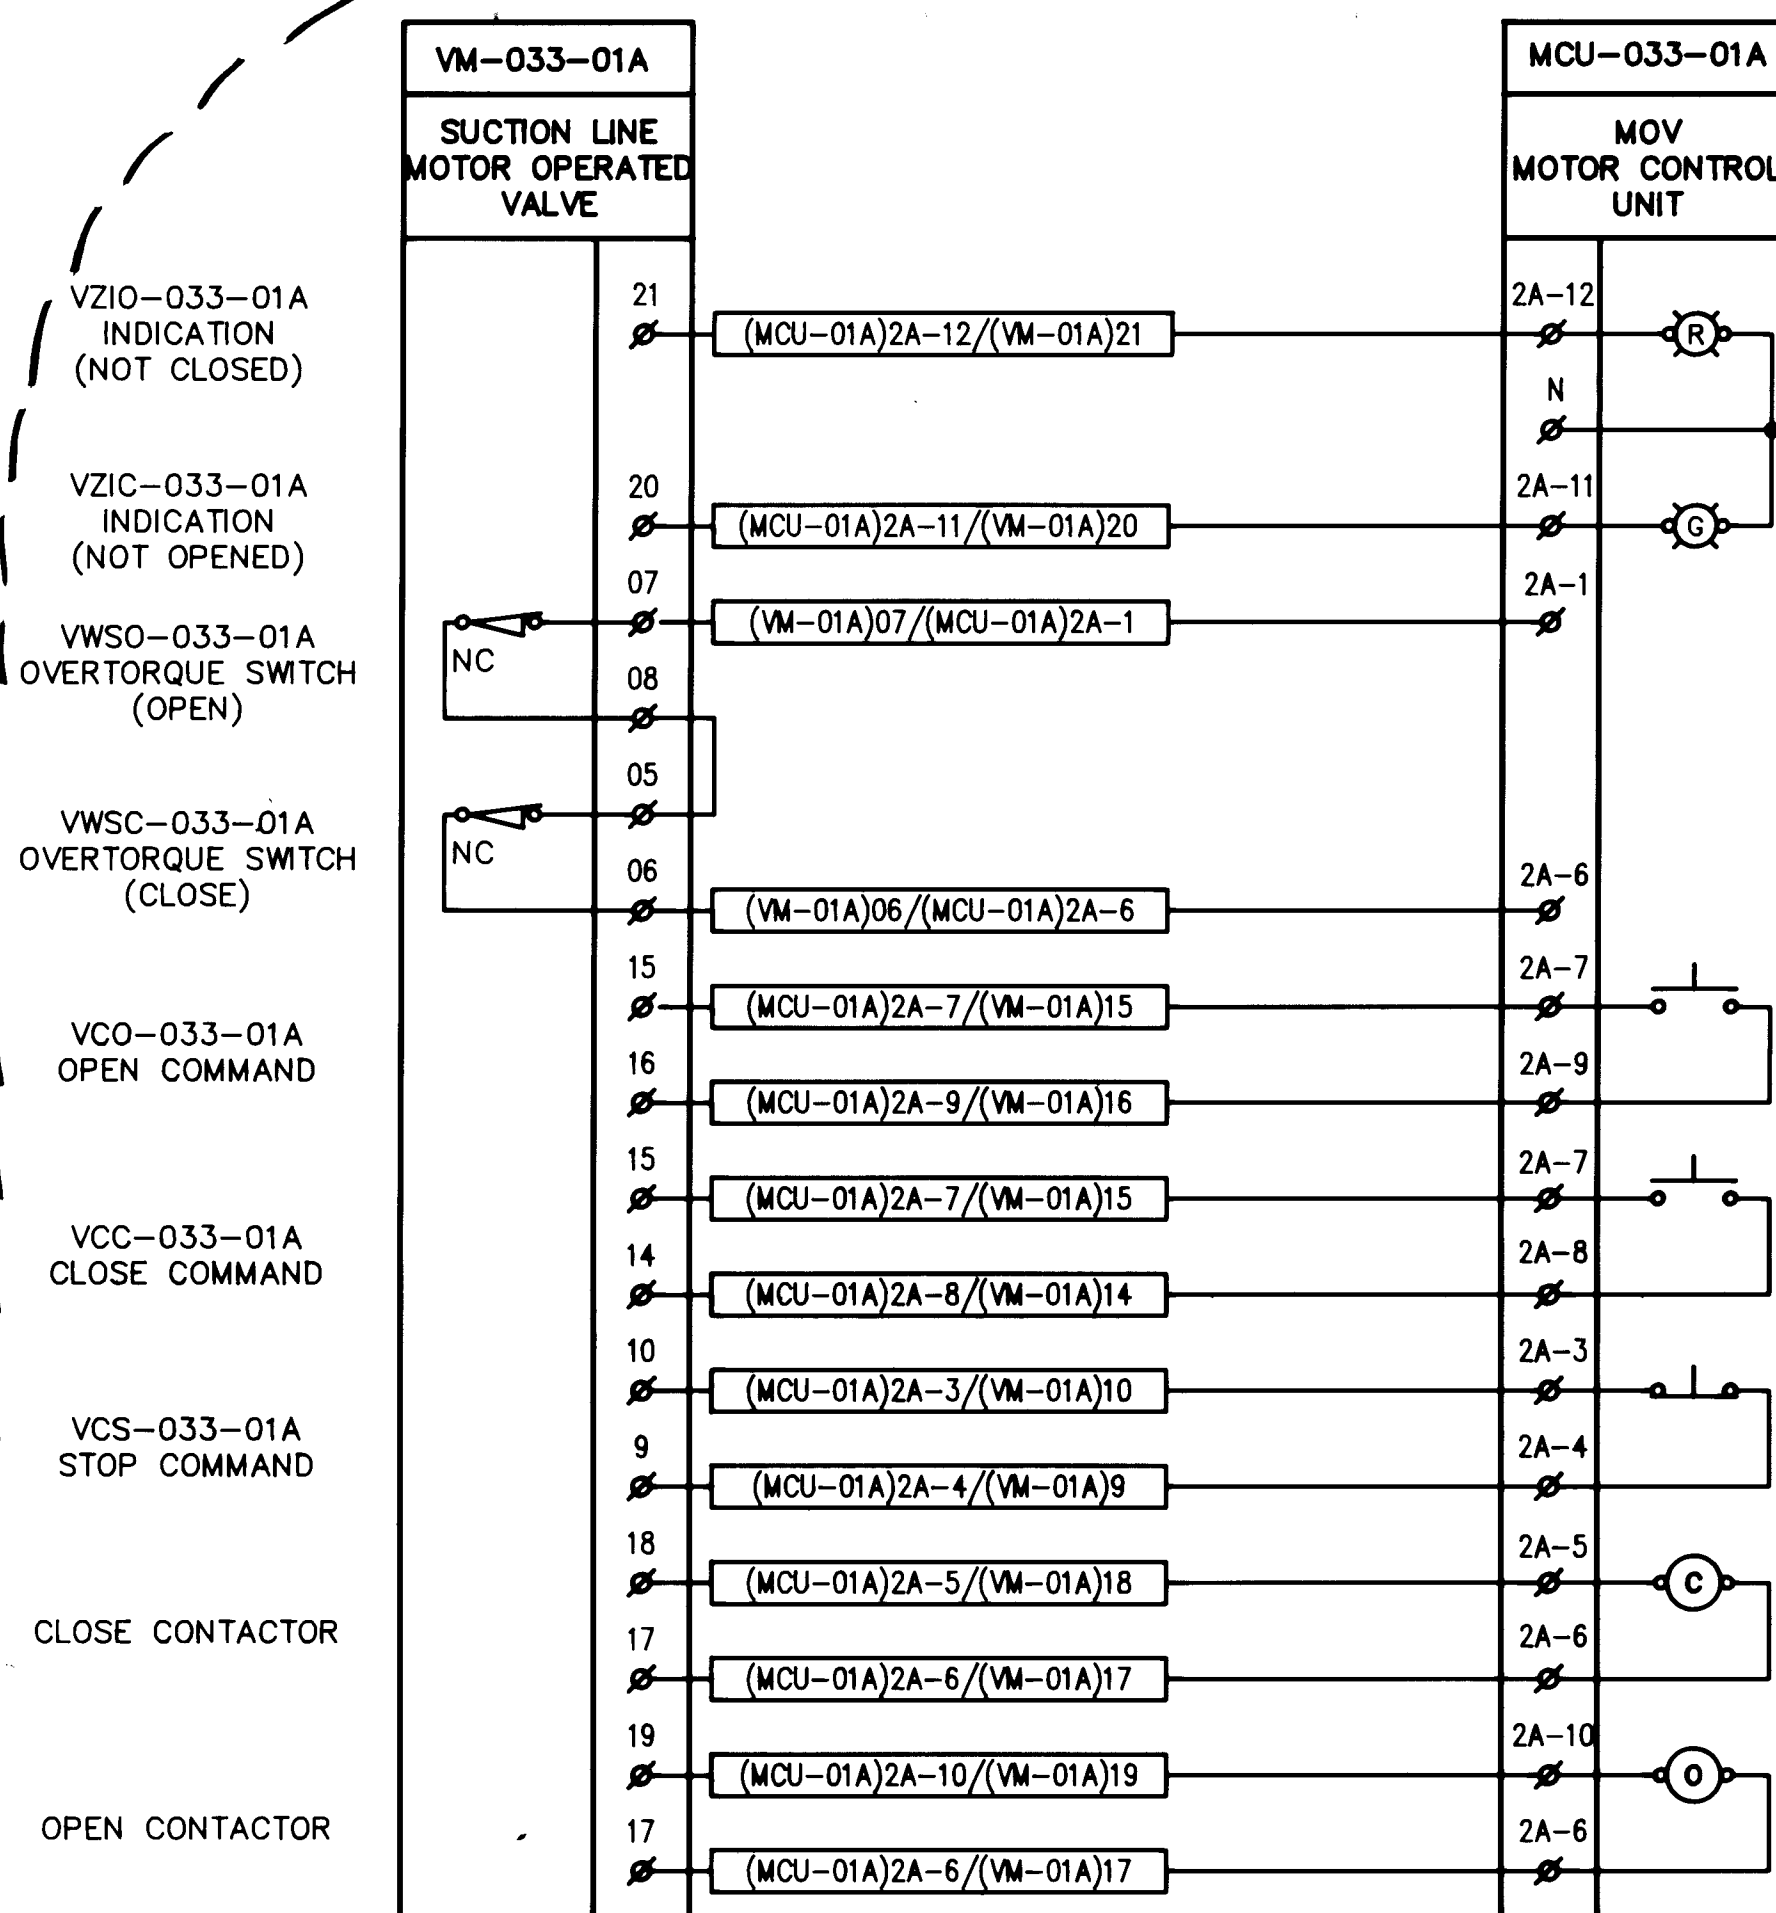

REDRAWN FOR RECORD PURPOSES



26 3337.904492

RECORD DRAWING
FEB 1992

These drawings have been revised based on field data and every reasonable attempt has been made to depict construction as actually performed.


CITY OF ALBUQUERQUE PUBLIC WORKS DEPARTMENT ENGINEERING GROUP					
TITLE: GUTIERREZ PUMP STATION RECONSTRUCTION INTERCONNECTION DIAGRAMS - MISC.					
APPROVALS	ENGINEER	DATE	APPROVALS	ENGINEER	DATE
DRG CHAIRMAN			WATER		
TRANSPORTATION			WASTE WATER		
HYDROLOGY					
PROJECT NO. 3337.90		MAP NO. F-22		SHEET E17 OF 19	

AS BUILT INFORMATION		BENCH MARKS		SURVEY INFORMATION		ENGINEER'S SEAL	
CONTRACTOR	MCC	DATE	DATE	DATE	DATE	DATE	DATE
WORK STARTED BY	ALB. SVY.	DATE 2/92	DATE 12/91	DATE 12/91	DATE 12/91	DATE 12/91	DATE 12/91
WORK STOPPED BY	DATE 12/91	DATE 12/91	DATE 12/91	DATE 12/91	DATE 12/91	DATE 12/91	DATE 12/91
WORK RESUMED BY	DATE 12/91	DATE 12/91	DATE 12/91	DATE 12/91	DATE 12/91	DATE 12/91	DATE 12/91
WORK CORRECTED BY	DATE 12/91	DATE 12/91	DATE 12/91	DATE 12/91	DATE 12/91	DATE 12/91	DATE 12/91
WORK RECORDED BY	DATE 12/91	DATE 12/91	DATE 12/91	DATE 12/91	DATE 12/91	DATE 12/91	DATE 12/91
MICRO-FILM INFORMATION		RECORDED BY		DATE		NO.	

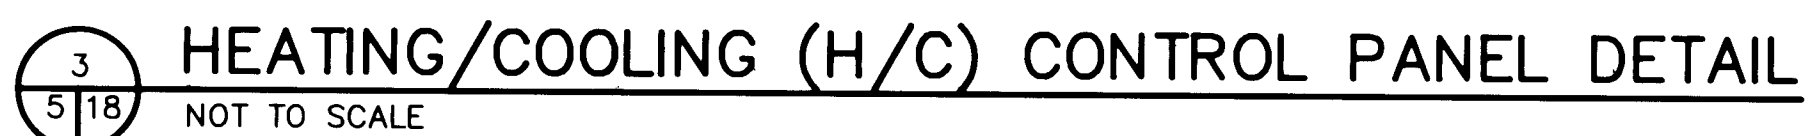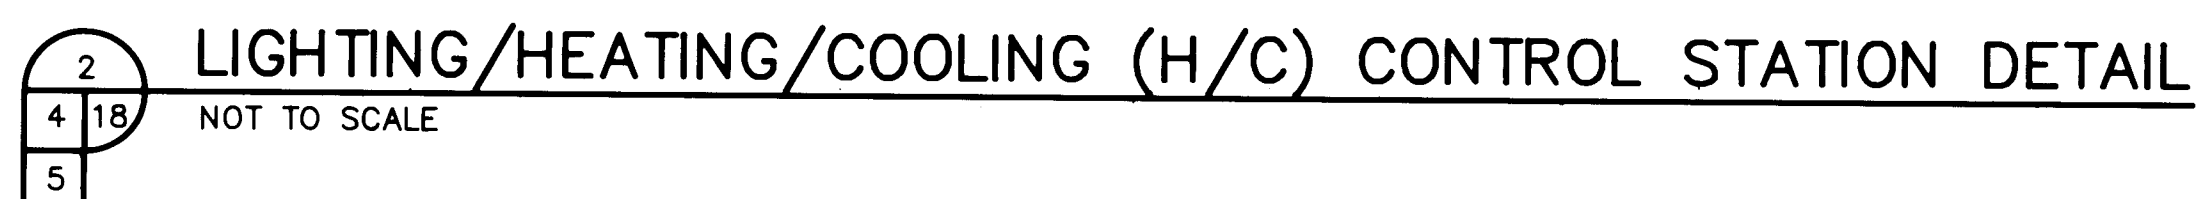


Date FEB 1997
These drawings have been revised based on field data and every reasonable attempt has been made to depict construction as actually performed.


CITY OF ALBUQUERQUE PUBLIC WORKS DEPARTMENT ENGINEERING GROUP					
TITLE: GUTIERREZ PUMP STATION RECONSTRUCTION DETAILS					
APPROVALS	ENGINEER	DATE	APPROVALS	ENGINEER	DATE
DRC CHAIRMAN	<i>Ramirez</i>	<i>11/16/90</i>	WATER	<i>R.W. Kane</i>	<i>11-17-90</i>
TRANSPORTATION	<i>N/A</i>	<i>11/16/90</i>	WASTE WATER	<i>R.W. Kane</i>	<i>11-17-90</i>
HYDROLOGY	<i>Don</i>	<i>11-15-90</i>			
PROJECT NO.	3337.90		MAP NO.	F-22	SHEET E18 OF 19

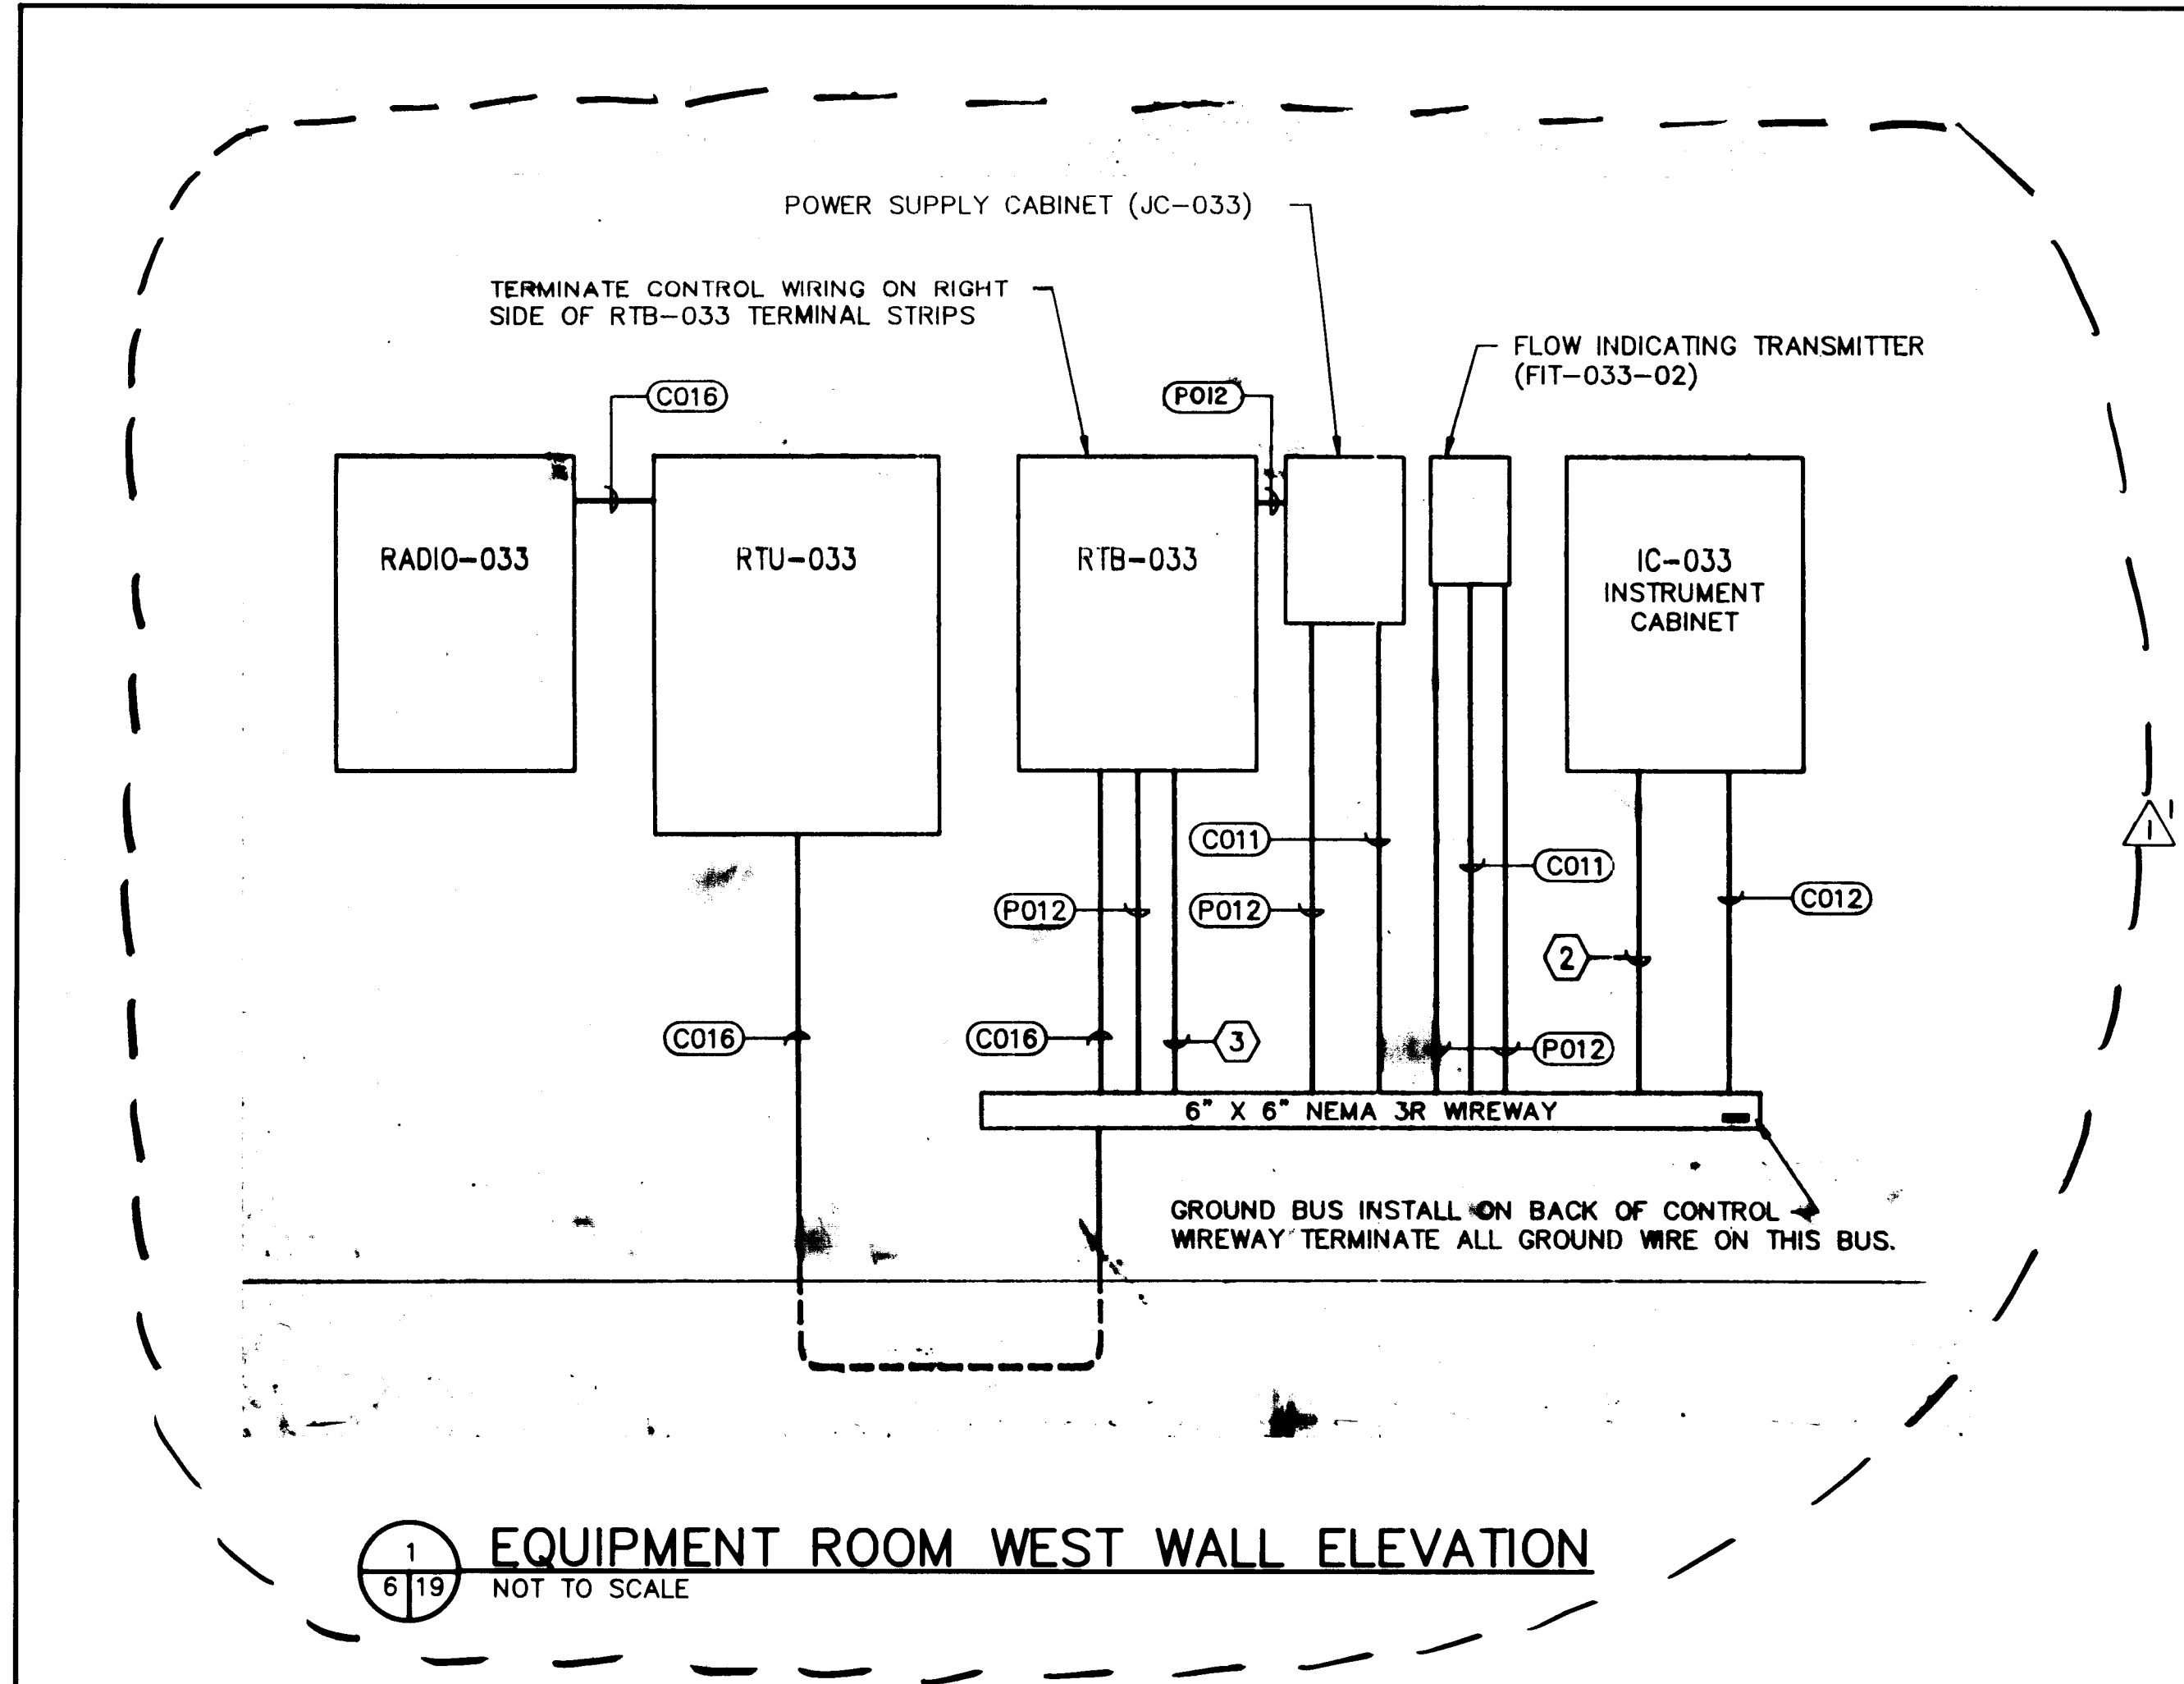


1 EQUIPMENT ROOM WEST WALL ELEVATION
6/19 NOT TO SCALE

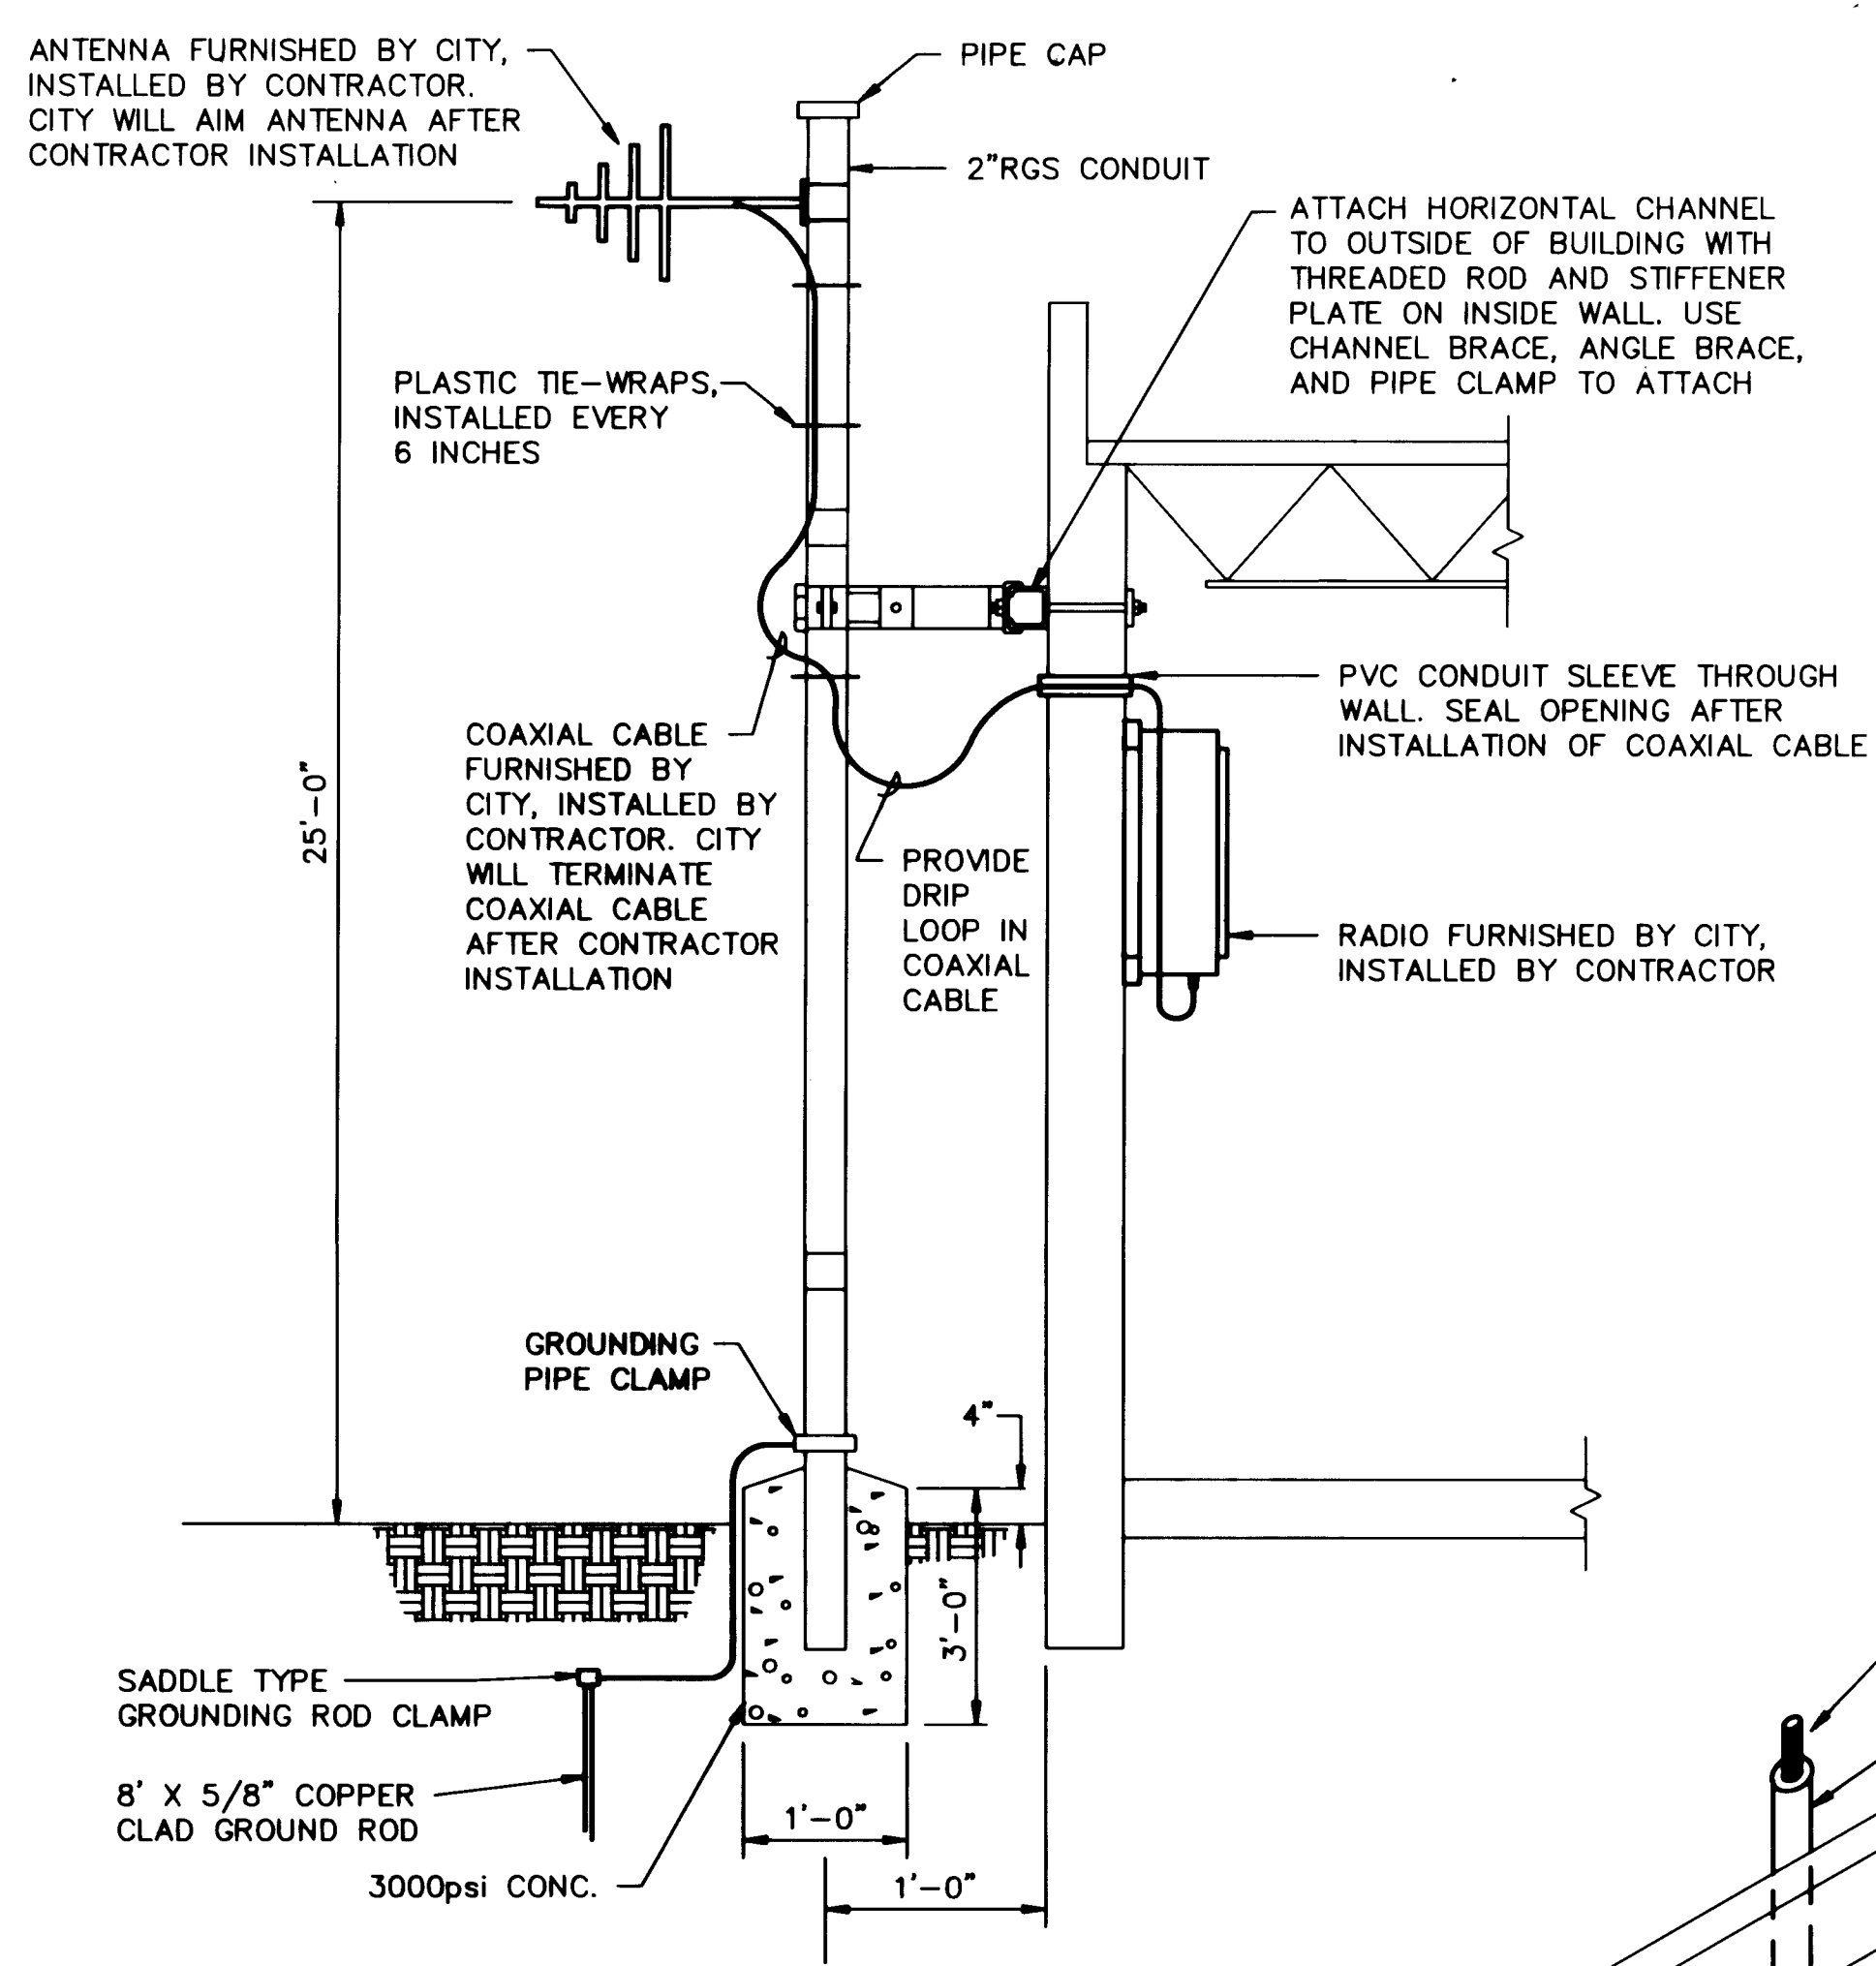

4 ANTENNA AND MAST DETAIL
6/19 NOT TO SCALE

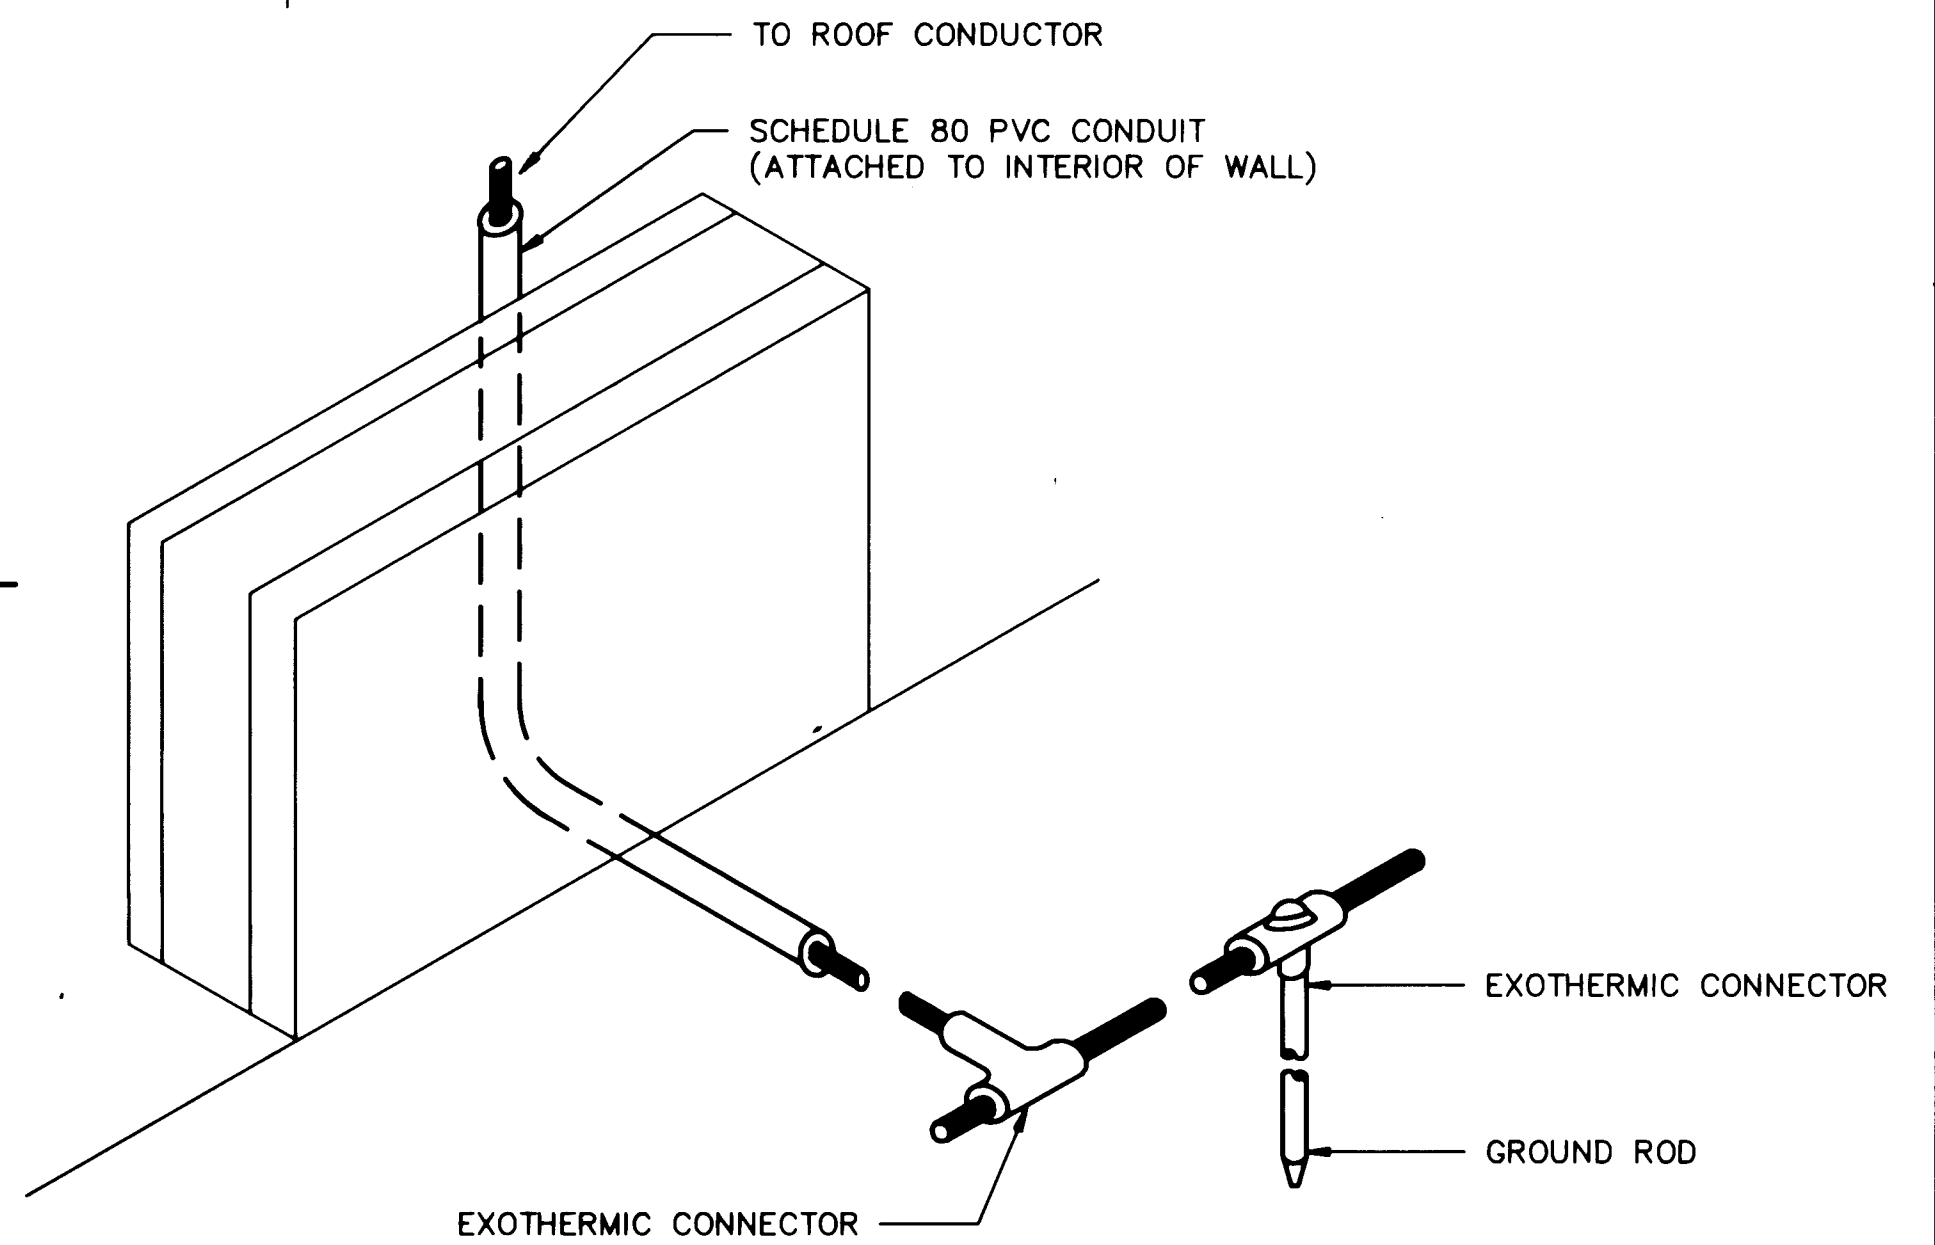

3 DOWN CONDUCTOR DETAIL
7/19 NOT TO SCALE

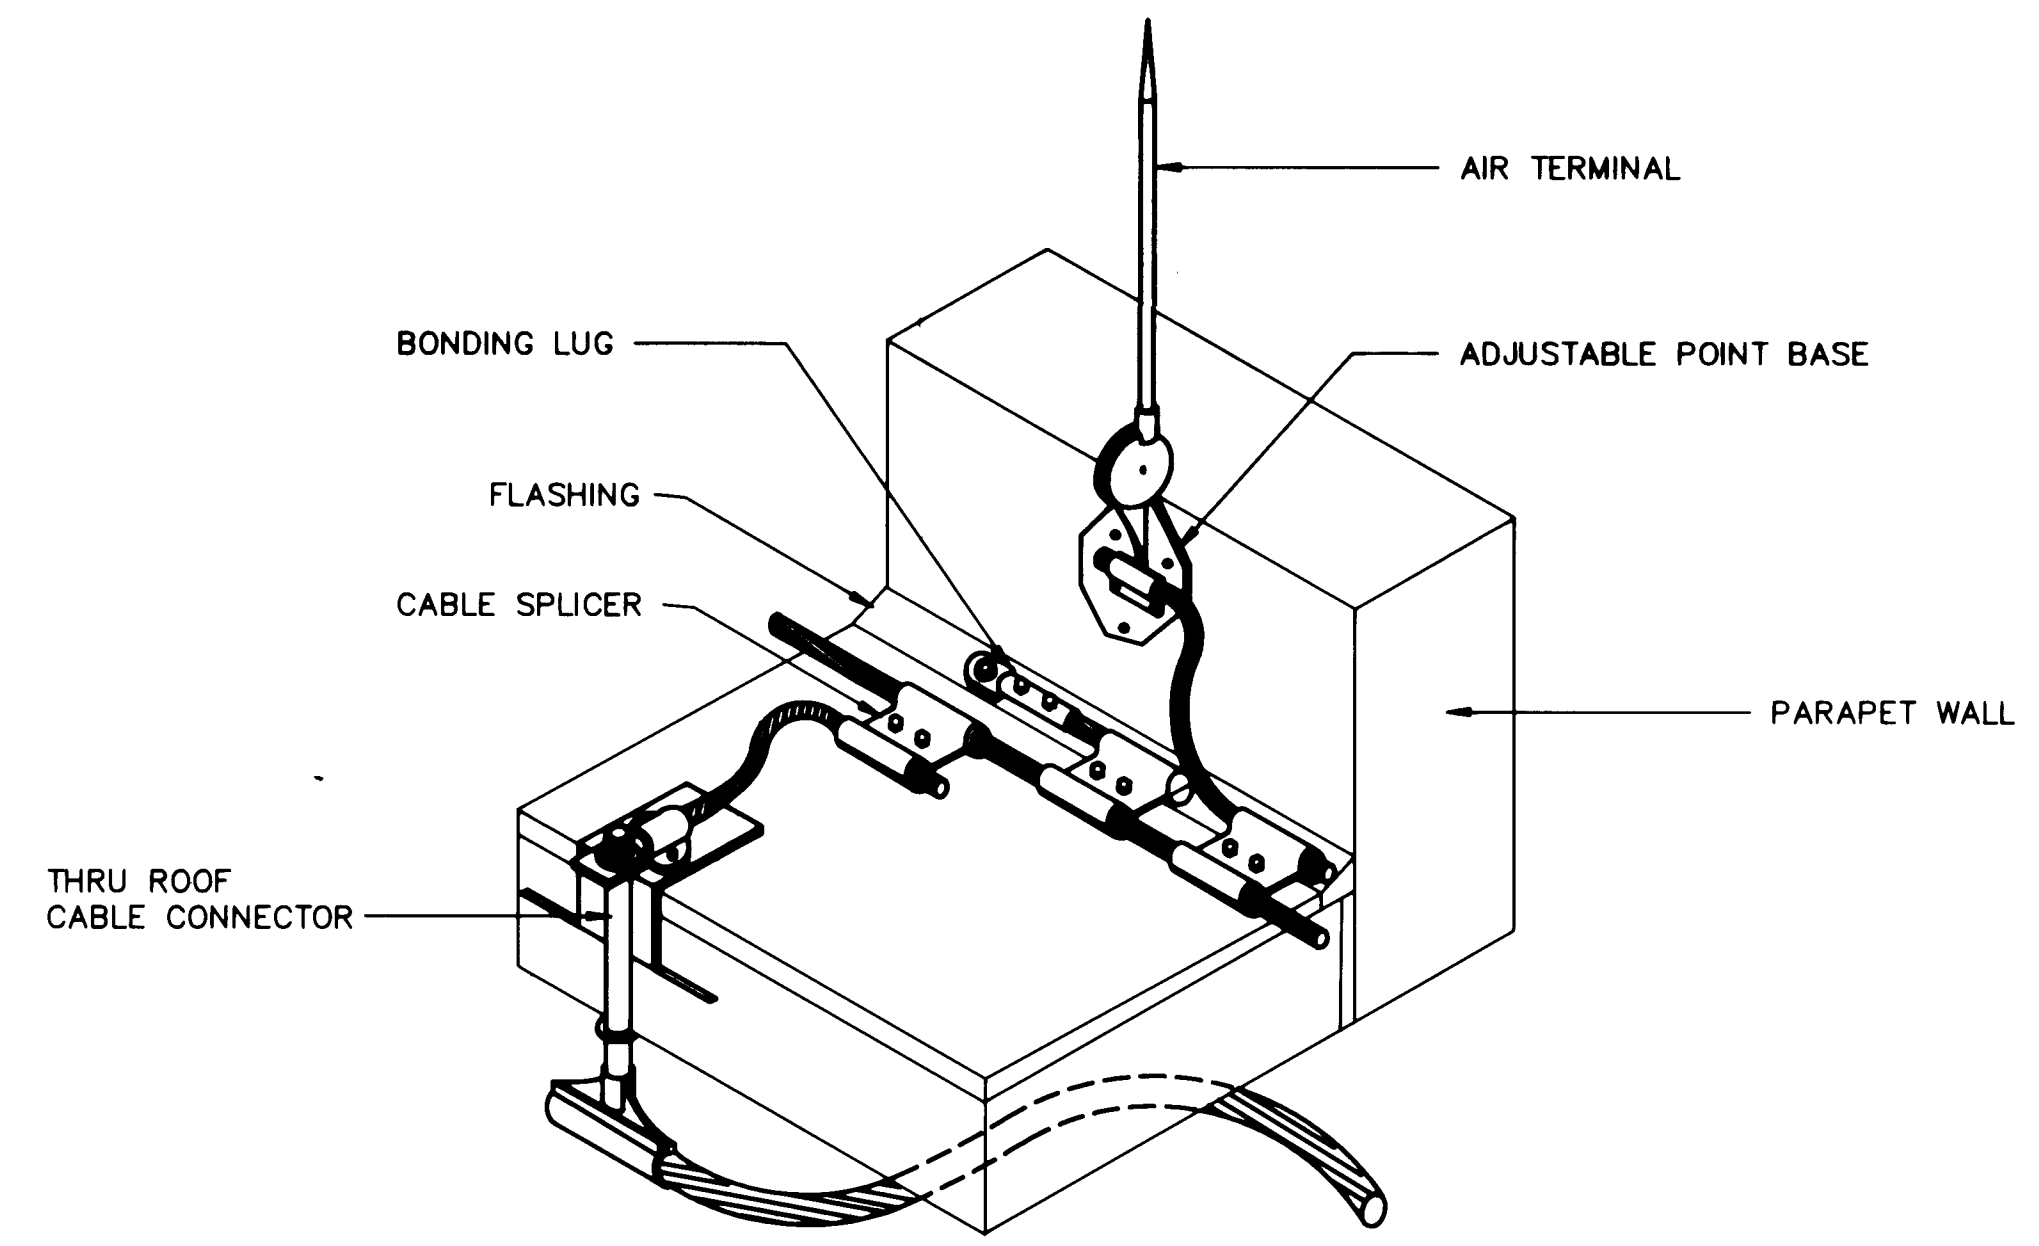

2 AIR TERMINAL/DOWN CONDUCTOR DETAIL
7/19 NOT TO SCALE

GENERAL NOTES

- SEE SHEET E1 FOR SYMBOLS LEGEND AND ABBREVIATIONS LIST.
- SEE SHEET E8 FOR SCHEDULES.


KEYED NOTES

- CONDUIT TO FIELD DEVICES AND PANELBOARD DP-033 NOT SHOWN FOR DRAWING CLARITY.
- 2\"/>

RECORD DRAWING
Date FEB 1992
These drawings have been revised based on field data and every reasonable attempt has been made to depict construction as actually performed.


CITY OF ALBUQUERQUE PUBLIC WORKS DEPARTMENT ENGINEERING GROUP					
TITLE: GUTIERREZ PUMP STATION RECONSTRUCTION DETAILS					
APPROVALS	ENGINEER	DATE	APPROVALS	ENGINEER	DATE
DRC CHAIRMAN	<i>[Signature]</i>	11/16/90	WATER	<i>[Signature]</i>	11-13-90
TRANSPORTATION	<i>[Signature]</i>	11-14-90	WASTE WATER	<i>[Signature]</i>	11-13-90
HYDROLOGY	<i>[Signature]</i>	11-15-90			
PROJECT NO. 3337.90		MAP NO. F-22		SHEET 19 OF 19	

AS BUILT INFORMATION		BENCH MARKS		SURVEY INFORMATION		ENGINEER'S SEAL	
CONTRACTOR	MCC	DATE	BY	DATE	NO.	NO.	REVISIONS
INSPECTOR'S	ALB. SVT.	DATE 12/19/91	DATE 12/19/91				DESIGN
FIELD	DATE 12/19/91						NO. DATE
VERIFICATION BY	DATE 12/19/91						DESIGNED BY D. DOZIER
CORRECTED BY	DATE 12/19/91						DRAWN BY P. STRINEL
RECORDED BY	DATE						CHECKED BY B. GRIFTS
NO.							

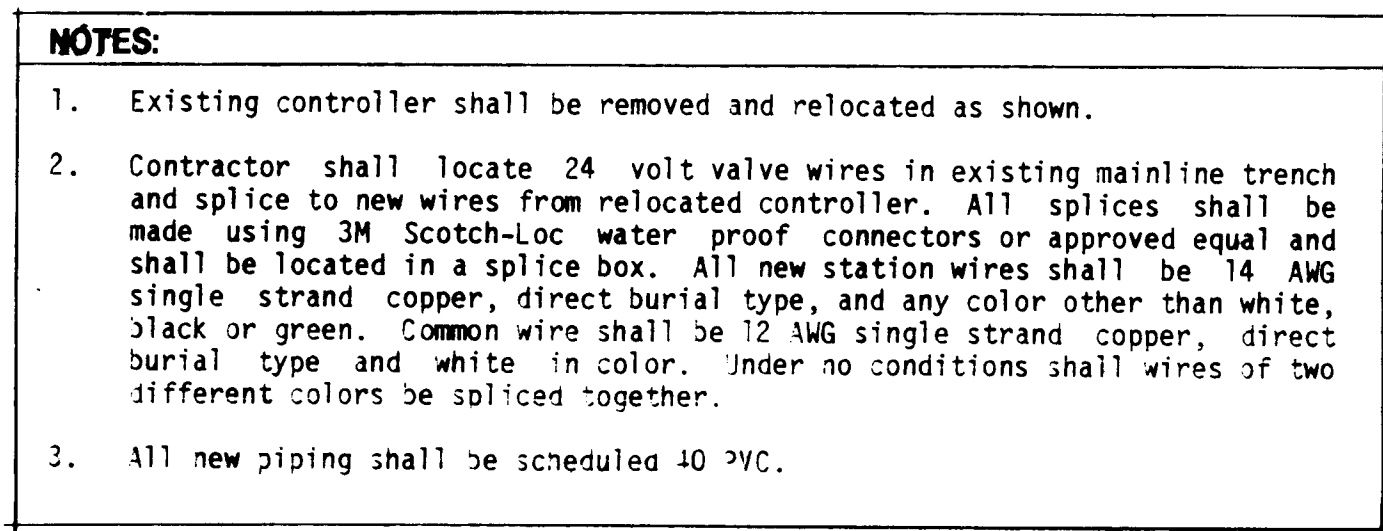

SCALE: 1" = 10' - 0"



PROJECT NO.	3337.90	MAP NO.	F-22	SHEET OF	GL - 1
----------------	---------	------------	------	-------------	--------

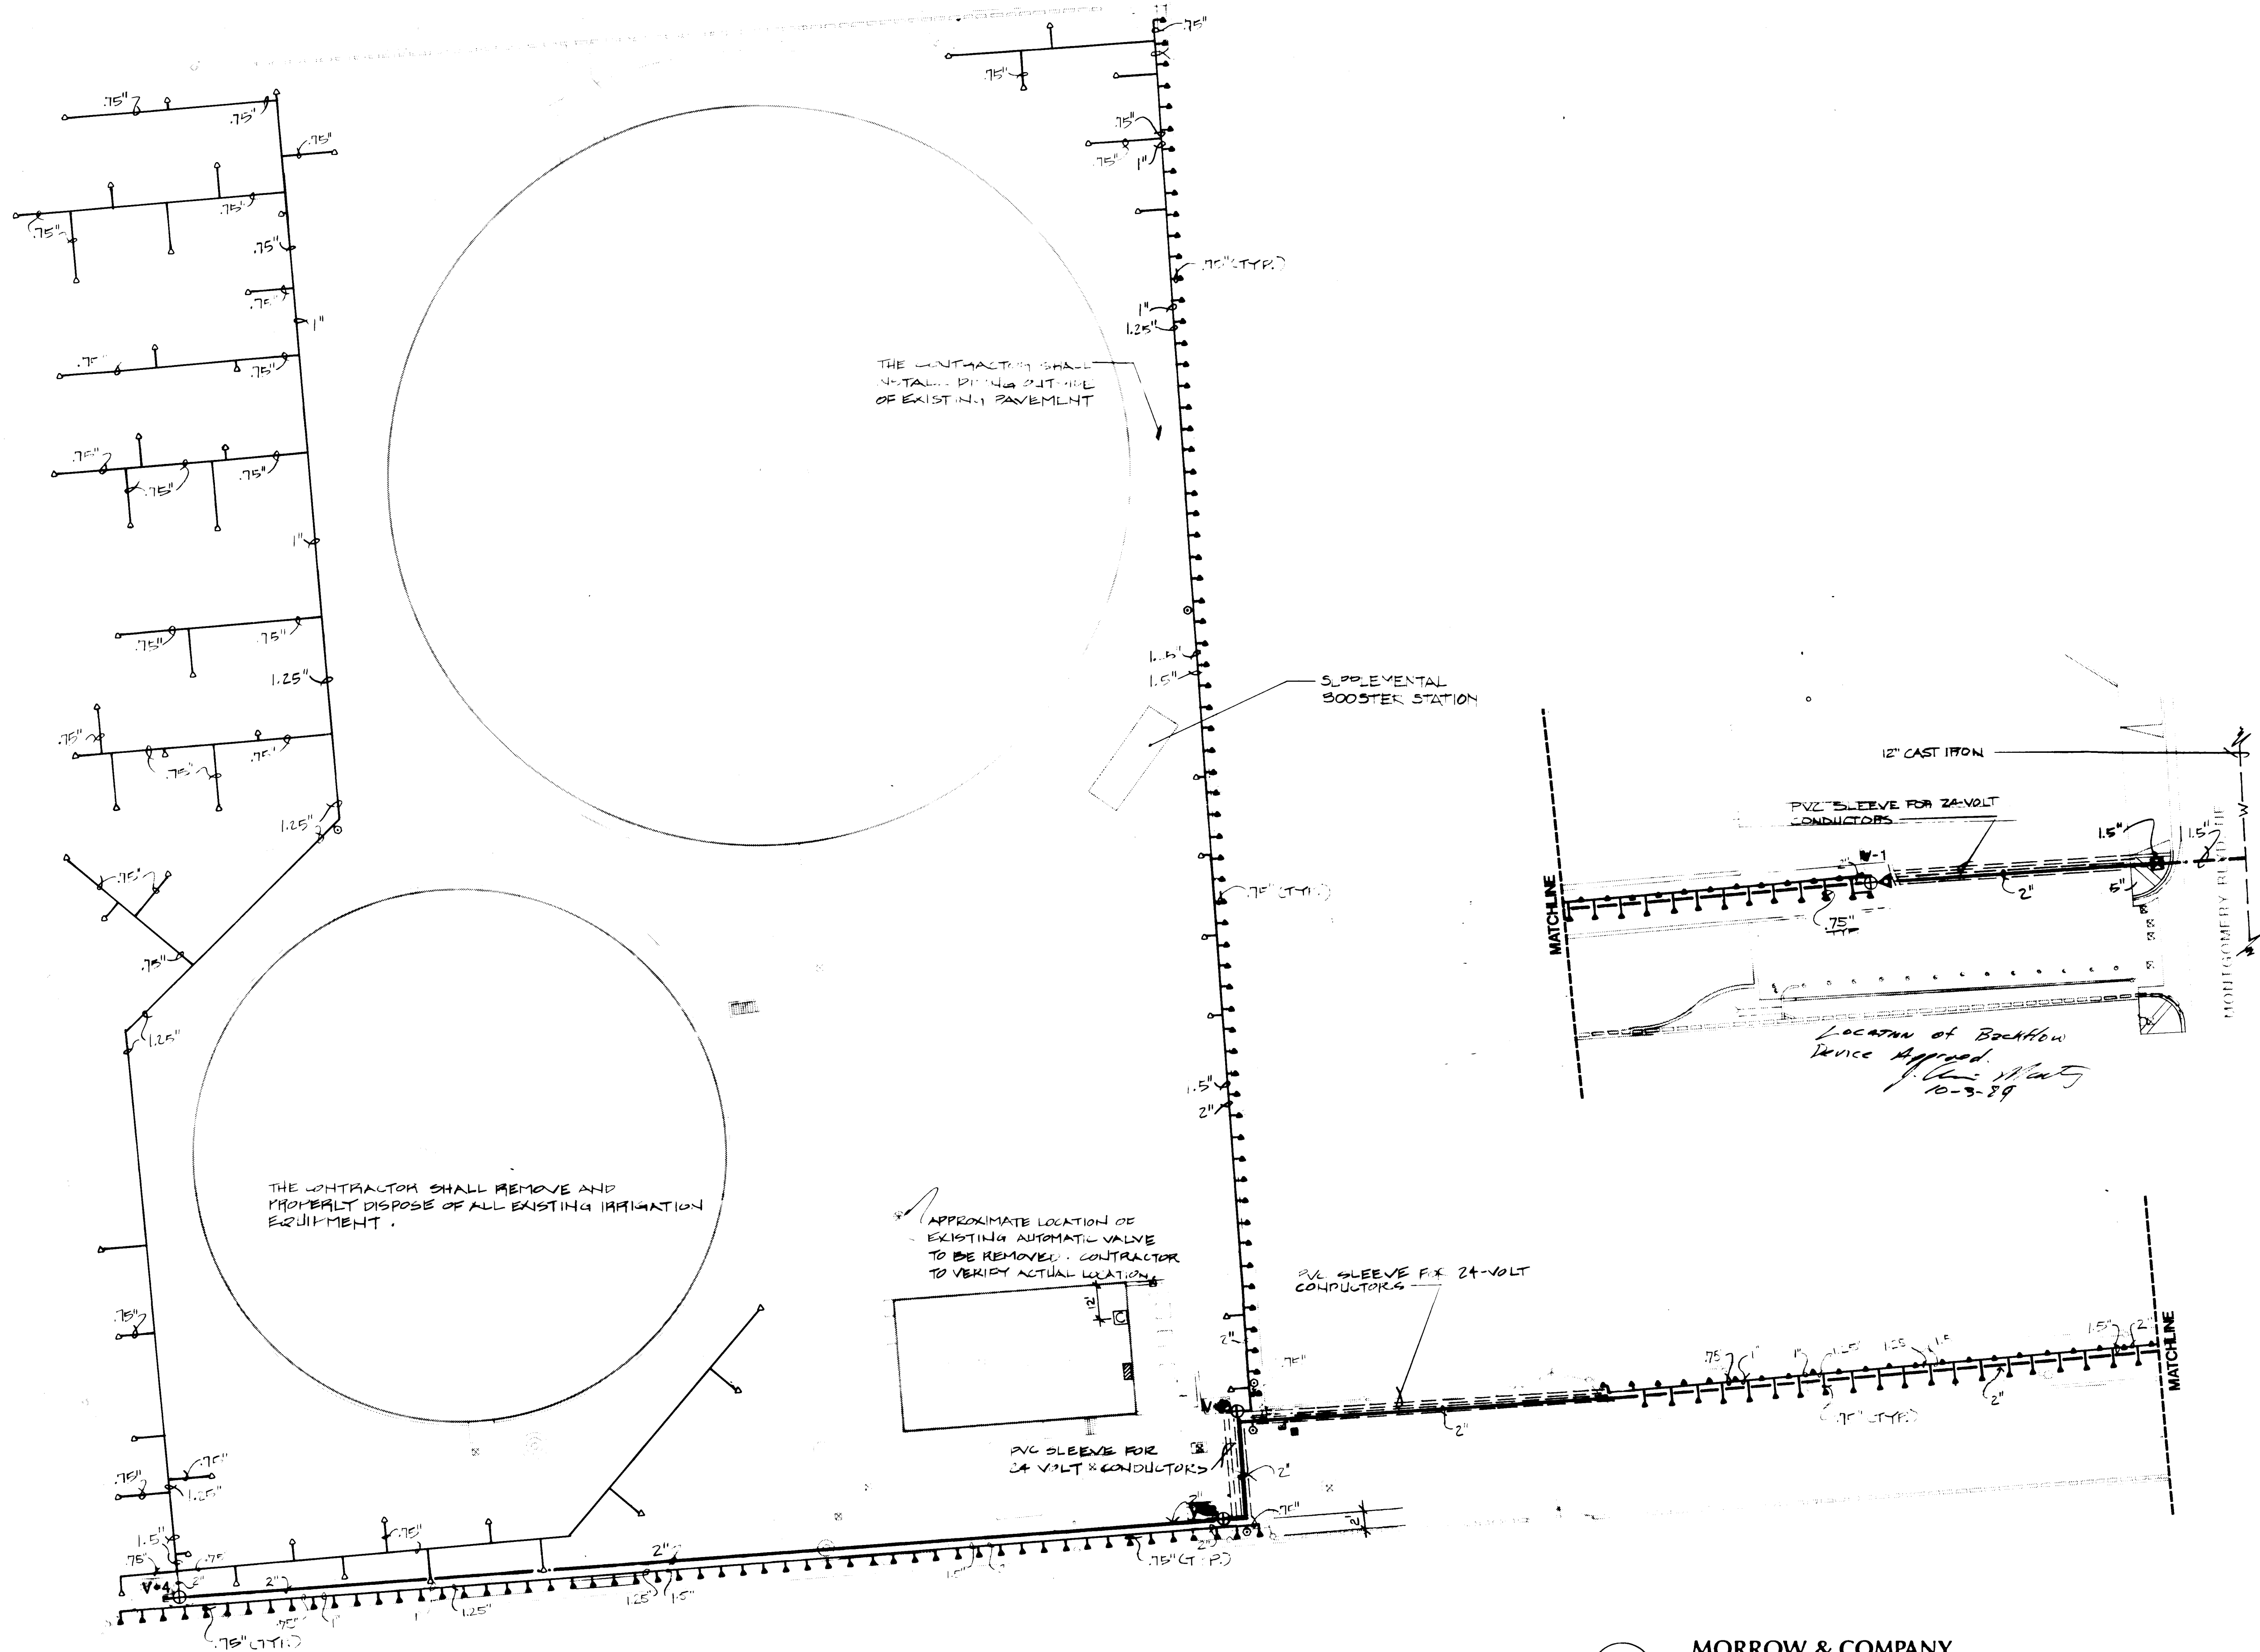

IRRIGATION PLAN

NOTE: SEE SHEET KL-3 FOR
IRRIGATION DETAILS AND NOTES

MORROW & COMPANY
LANDSCAPE ARCHITECTS
210 La Veta Drive NE
Albuquerque, New Mexico 87108
505-268-2266

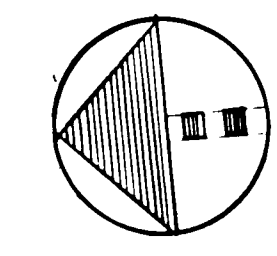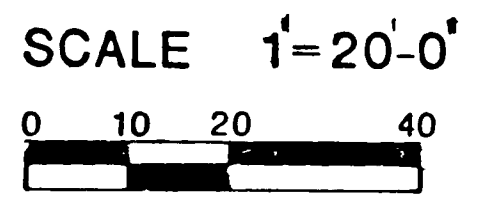


24 33 37.9 05 09 12

RECORD DRAWING
DESIGNED BY: [Signature]
DRAWN BY: [Signature]
CHECKED BY: [Signature]

CITY OF ALBUQUERQUE PUBLIC WORKS DEPARTMENT ENGINEERING GROUP					
TITLE: KIVA LANDSCAPING IRRIGATION PLAN					
APPROVALS	ENGINEER	DATE	APPROVALS	ENGINEER	DATE
DR. Chair					
Trans. Dev	[Signature]	11-16-91			
Utility Dev	[Signature]	11-13-91			
PLV	[Signature]	11-13-91			
PROJECT NO.	3337.90	MAP NO.	F-22	SHEET	KL-1

AS BUILT INFORMATION		BENCH MARKS		SURVEY INFORMATION		ENGINEER'S SEAL	
DATE	BY	DATE	BY	NO	BY	REMARKS	BY
DESIGNED BY		DATE		DRAWN BY		DATE	
CHECKED BY		DATE		REVISIONS		DESIGN	

120546

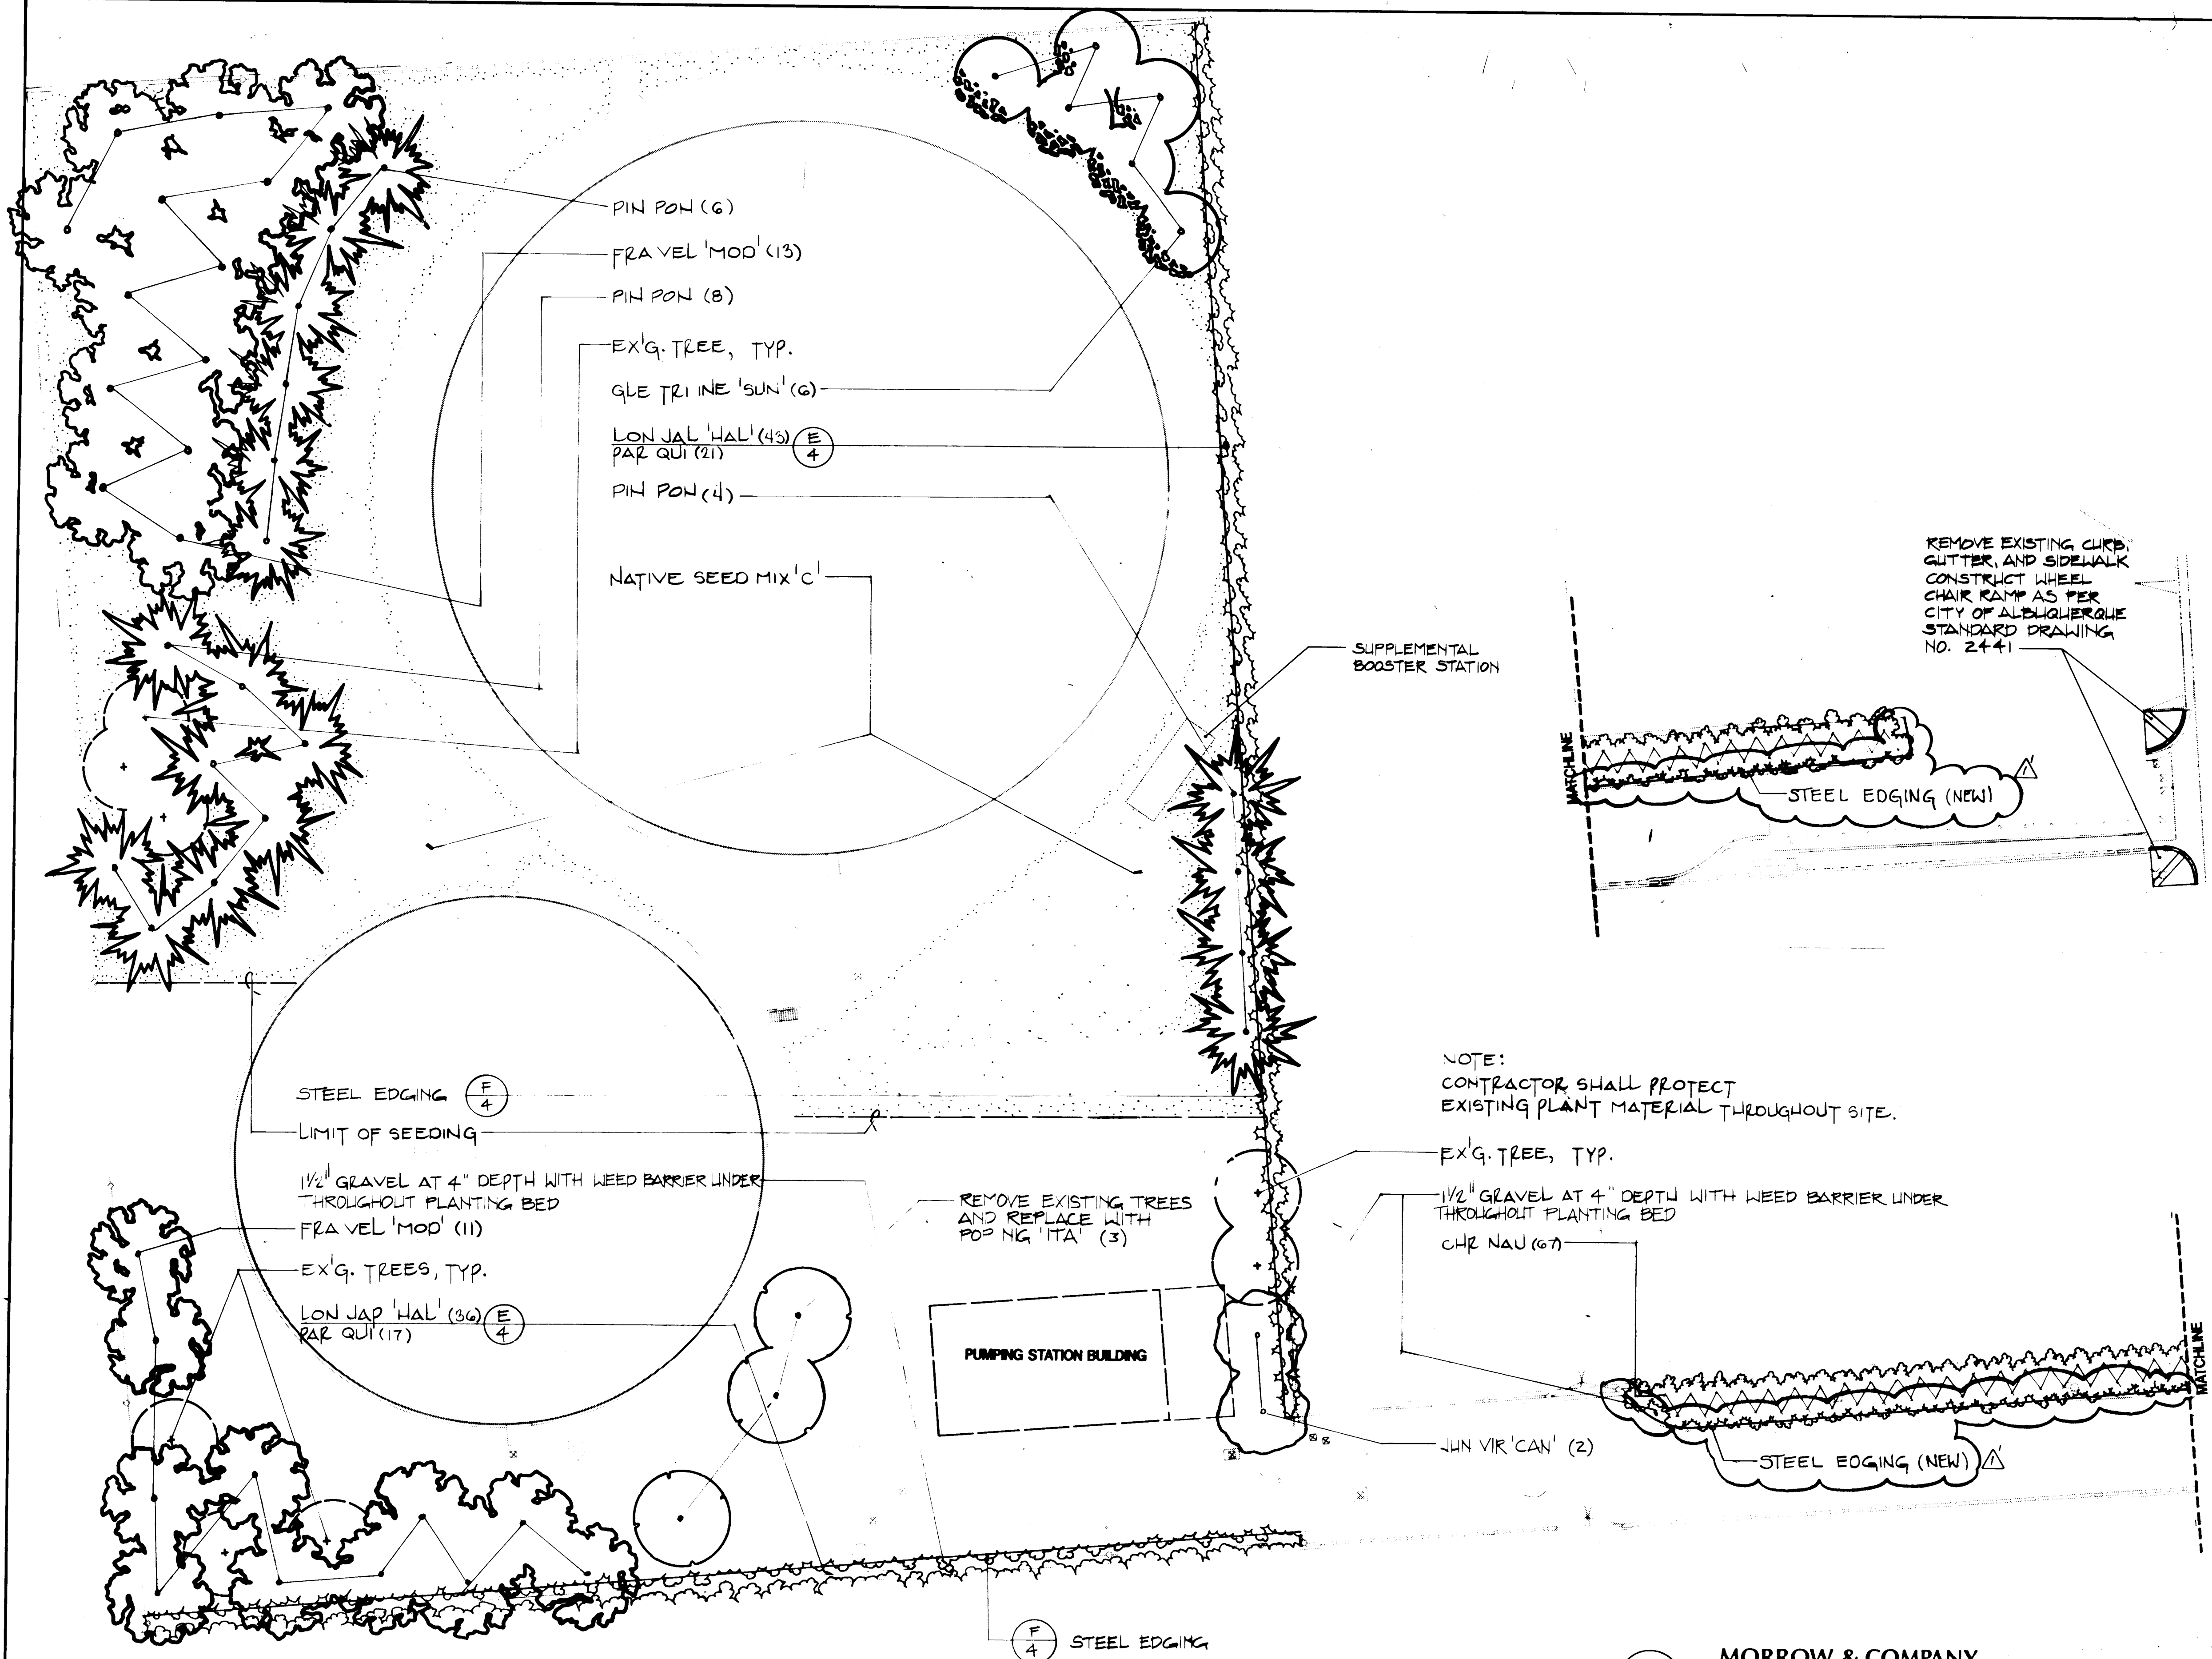


PLANTING PLAN

NOTE: SEE SHEET KL-4 FOR
PLANTING DETAILS AND PLANT LIST

MORROW & COMPANY
LANDSCAPE ARCHITECTS
210 La Veta Drive NE
Albuquerque, New Mexico 87108
505-268-2266

SCALE 1"=20'-0"
0 10 20 40

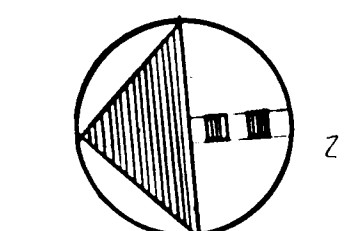

26 3337.905192

AS BUILT INFORMATION			BENCH MARKS			SURVEY INFORMATION			ENGINEER'S SEAL		
CONTRACTOR	MCC Construction Co.	DATE	NO.	BY	DATE	NO.	BY	DATE	NO.	BY	DATE
WORKED BY	ALBUQUERQUE	DATE									
INSPECTED BY	ALBUQUERQUE	DATE									
APPROVED BY	ALBUQUERQUE	DATE									
REVISIONS	ALBUQUERQUE	DATE									
DESIGNED BY	ALBUQUERQUE	DATE									
DRAWN BY	ALBUQUERQUE	DATE									
CHECKED BY	ALBUQUERQUE	DATE									

RECORD DRAWING
FEB 1992


These drawings have been reviewed by me and found to be correct as far as the construction is concerned.

CITY OF ALBUQUERQUE
PUBLIC WORKS DEPARTMENT
ENGINEERING GROUP

TITLE: KIVA LANDSCAPING
PLANTING PLAN


APPROVALS	ENGINEER	DATE	APPROVALS	ENGINEER	DATE
Trans Dev	R.W. Kane	11-16-90			
Utility Dev	R.W. Kane	11-13-90			
HVD	LDM	11-15-90			

PROJECT NO. 3337.90 MAP NO. F-22 SHEET KL - 2

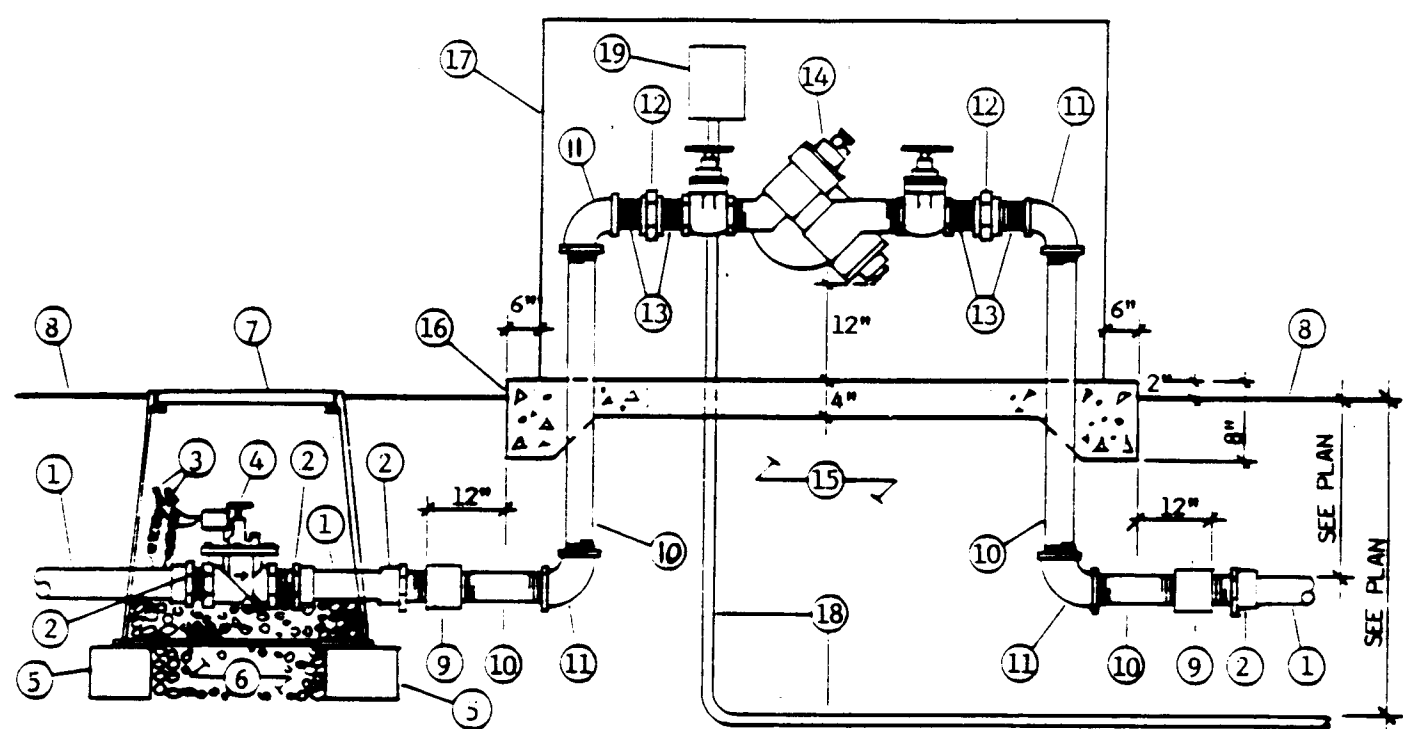


- 1 PVC MAIN LINE PIPING
2 PVC WIRE ADAPTER
3 WATER PROOF CONNECTORS AND 3/4" EXPANSION LOOPS
4 MASTER VALVE, SEE IRRIGATION LEGEND
5 8" x 8" x 1/4" ODU BLOCK
6 2 CUBIC FEET 1" WASHED RIVER ROCK
7 BROOKS 1730 VALVE BOX WITH 3 6" EXTENSIONS
8 FINISH GRADE
9 GALVANIZED COUPLING
10 GALVANIZED NIPPLE, LENGTH AS REQUIRED
11 GALVANIZED 90° ELL
12 GALVANIZED UNION
13 GALVANIZED CLOSE NIPPLE
14 REDUCED PRESSURE PRINCIPLE BACKFLOW PREVENTOR, SEE IRRIGATION LEGEND
15 COMPACT SUBGRADE UNDER CONCRETE SLAB
16 3000 PSI CONCRETE SLAB
17 HOT BOX, MODEL NO. 5, PREFABRICATED AND INSULATED BACKFLOW PREVENTOR ENCLOSURE
18 1/2" CONDUIT HOUSING 240-VOLT, 2# 10 W/ GROUND FROM PROPOSED PULL BOX TO NEAREST EXISTING ELECTRICAL PANEL
19 WATER PROOF PULL BOX FOR 240-VOLT CONDUCTORS AND CONNECTION POINT FOR THERMOLUX HEATING CABLE
- A. THE CONTRACTOR SHALL INSTALL ENCLOSURE TO MANUFACTURER'S RECOMMENDATIONS AND PROVIDE NUTS, BOLTS AND WASHERS FOR ALL LOCKING POINTS OF ENCLOSURE. CONTRACTOR SHALL APPLY TWO COATS OF PAINT TO EXTERIOR OF ENCLOSURE. PAINT SHALL BE APPROVED BY LANDSCAPE ARCHITECT PRIOR TO INSTALLATION.
B. THE HEATING CABLE FOR FREEZE PROTECTION SHALL BE WINTERGARD, MODEL NO. W621. INSTALL HEATING CABLE AROUND BACKFLOW PREVENTOR AND FITTINGS TO MANUFACTURER'S RECOMMENDATIONS.
C. THE CONTRACTOR SHALL INSTALL A 20 AMP BREAKER IN EXISTING ELECTRICAL PANEL, LABEL ASSOCIATED BREAKER "BACKFLOW PREVENTOR HEAT CABLE."
D. ALL ELECTRICAL WORK AND MATERIALS SHALL MEET STATE AND LOCAL CODES AND COMPLY TO THE N.E.C.

MASTER VALVE AND BACKFLOW PREVENTOR ASSEMBLY NTS

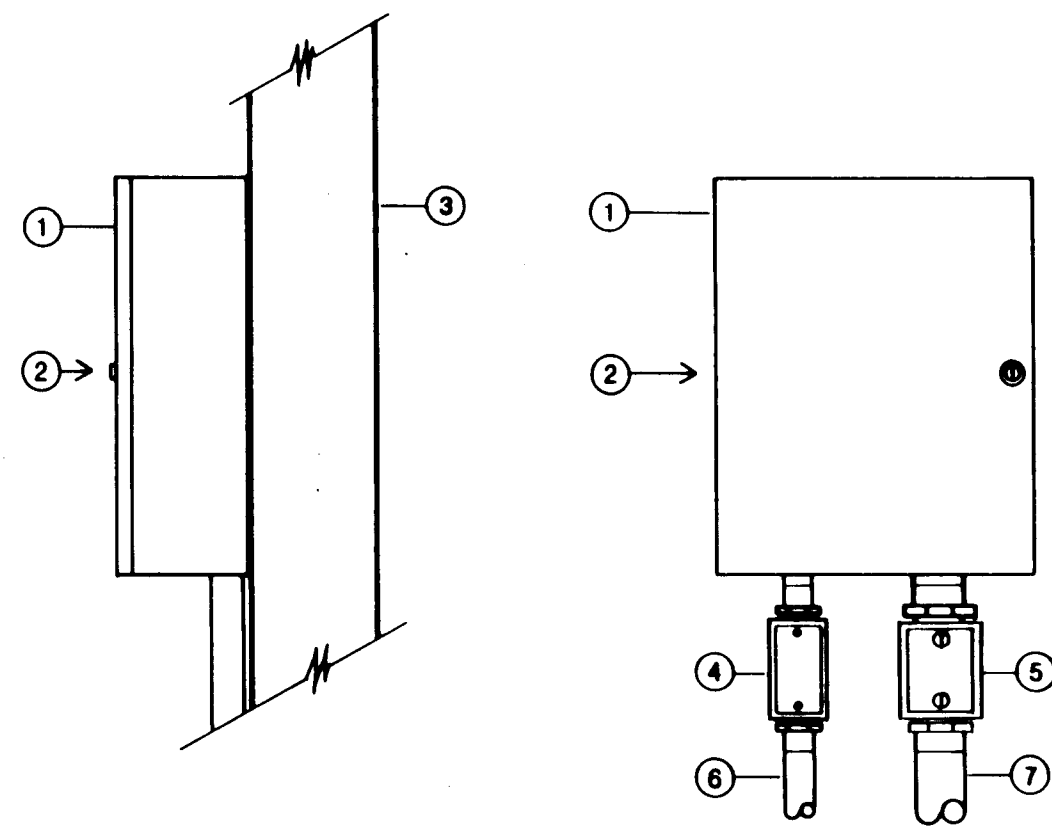


- 1 CONTROLLER (SEE IRRIGATION LEGEND), MOUNT SECURELY TO WALL
2 EYE LEVEL
3 WALL
4 1/2" LB BOX
5 1" LB BOX
6 1/2" EMT CONDUIT (HOUSING 120VOLT, 14 GAUGE WIRES)
7 RIGID CONDUIT (HOUSING 240VOLT, 14 GAUGE CONTROL WIRES, SIZE 1")

CONTROLLER DETAIL NTS

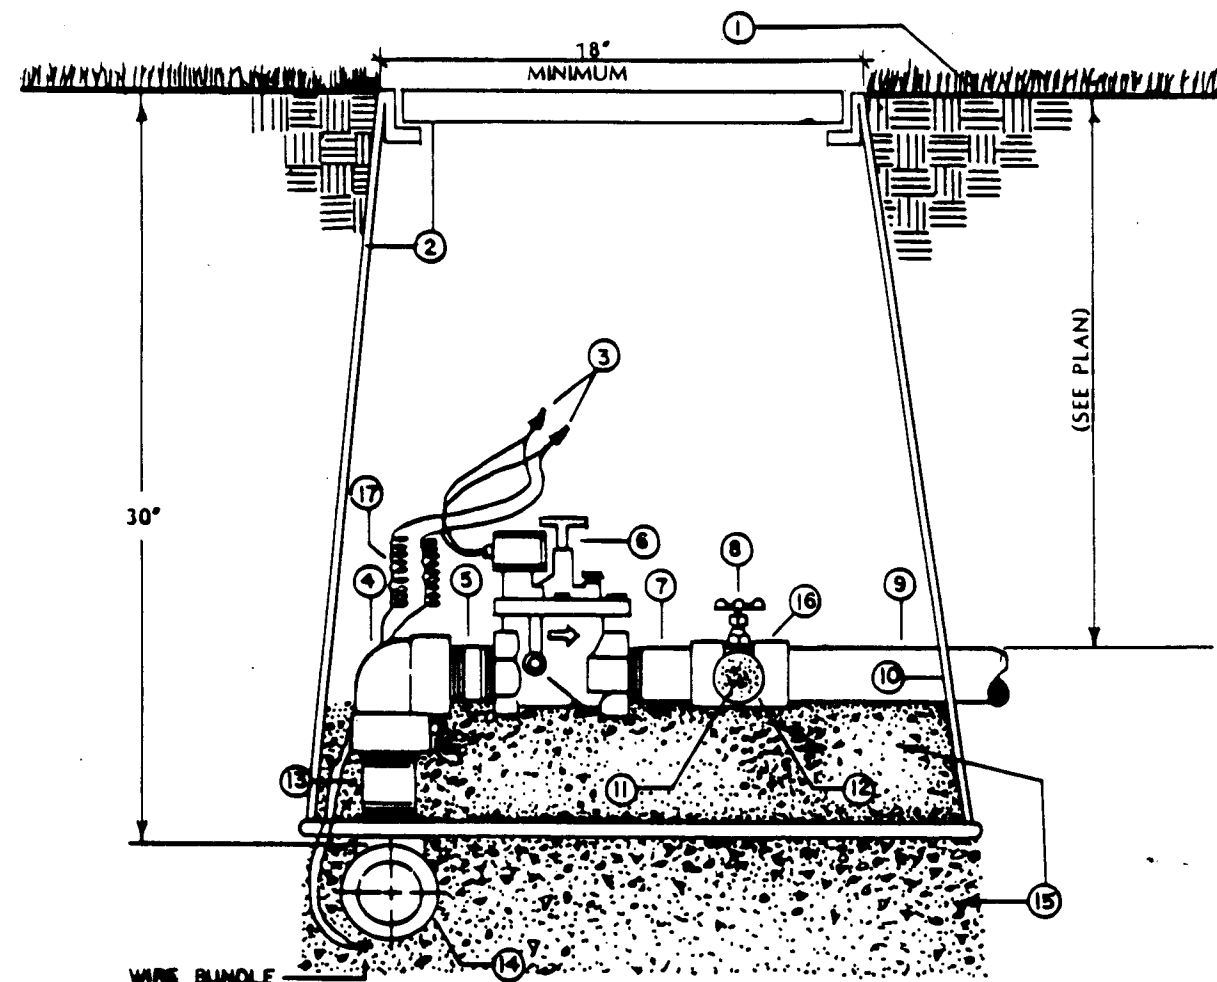


- 1 FINISH GRADE
2 24" LOCKING VALVE BOX WITH 6" EXTENSION
3 WATERPROOF WIRE CONNECTOR
4 PVC THREADED ELL, SCH. 40
5 SCH. 80 PVC NIPPLE (4" LENGTH)
6 AUTOMATIC VALVE (SEE PLAN)
7 SCH. 80 PVC TOE NIPPLE (4" LENGTH)
8 1/2" BRASS GATE VALVE
9 PVC LATERAL PIPING
10 OUT-OUT FOR LATERAL PIPE
11 1/2" x 1/2" GLOBE SCH. 80 PVC NIPPLE
12 AUTOMATIC DRAIN VALVE
13 SCH. 80 PVC NIPPLE (4" LENGTH)
14 CLASS 200 O-RING SERVICE TEE
15 3 C.F. GRAVEL SUMP
16 PVC LATERAL TEE SST, SCH. 40
17 3/4" WIRE EXPANSION LOOP

AUTOMATIC VALVE ASSEMBLY NTS

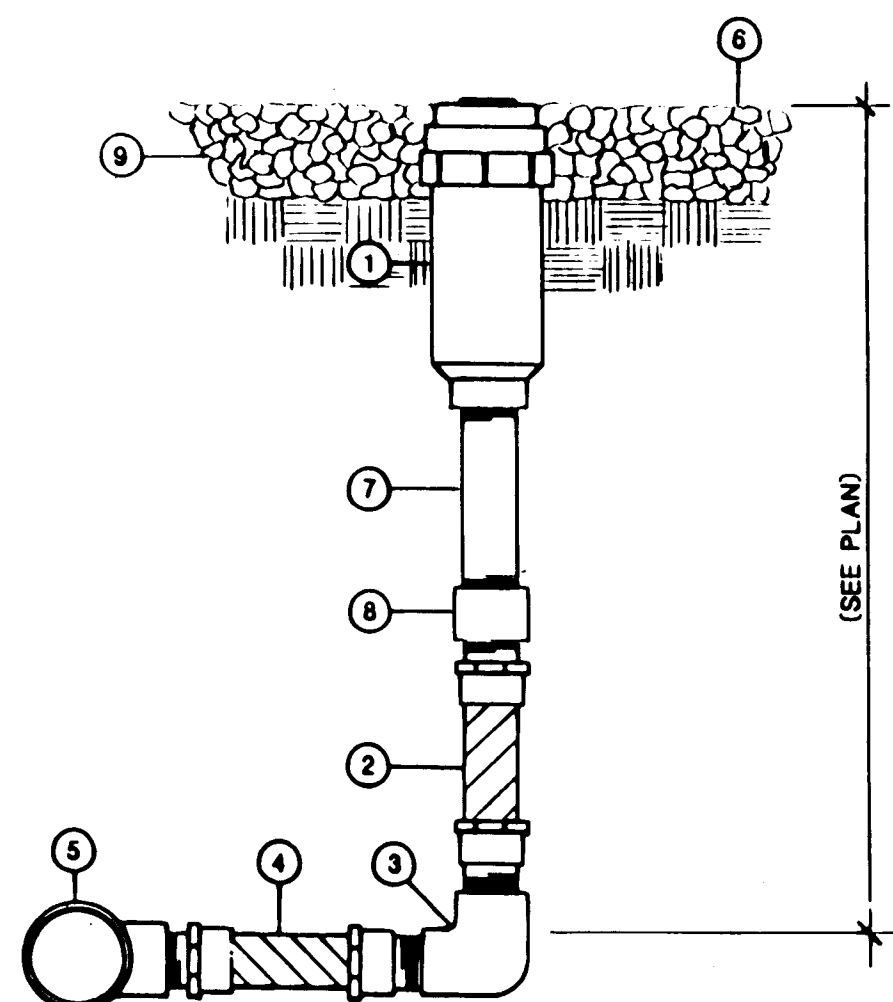

- 1 POP-UP BUBBLER ASSEMBLY (SEE PLAN)
2 1/2" x 6" MAXIMA FLEX NIPPLE PVC
3 1/2" PVC THREADED ELL
4 1/2" x 6" MAXIMA FLEX NIPPLE PVC
5 PVC LATERAL TEE SST
6 FINISH GRADE/TOP OF BARK MULCH
7 1/2" PVC NIPPLE (LENGTH AS REQUIRED)
8 1/2" PVC THREADED COUPLING
9 BARK MULCH 2" DEPTH
10 POP-UP BUBBLER ASSEMBLY

POP-UP BUBBLER ASSEMBLY NTS

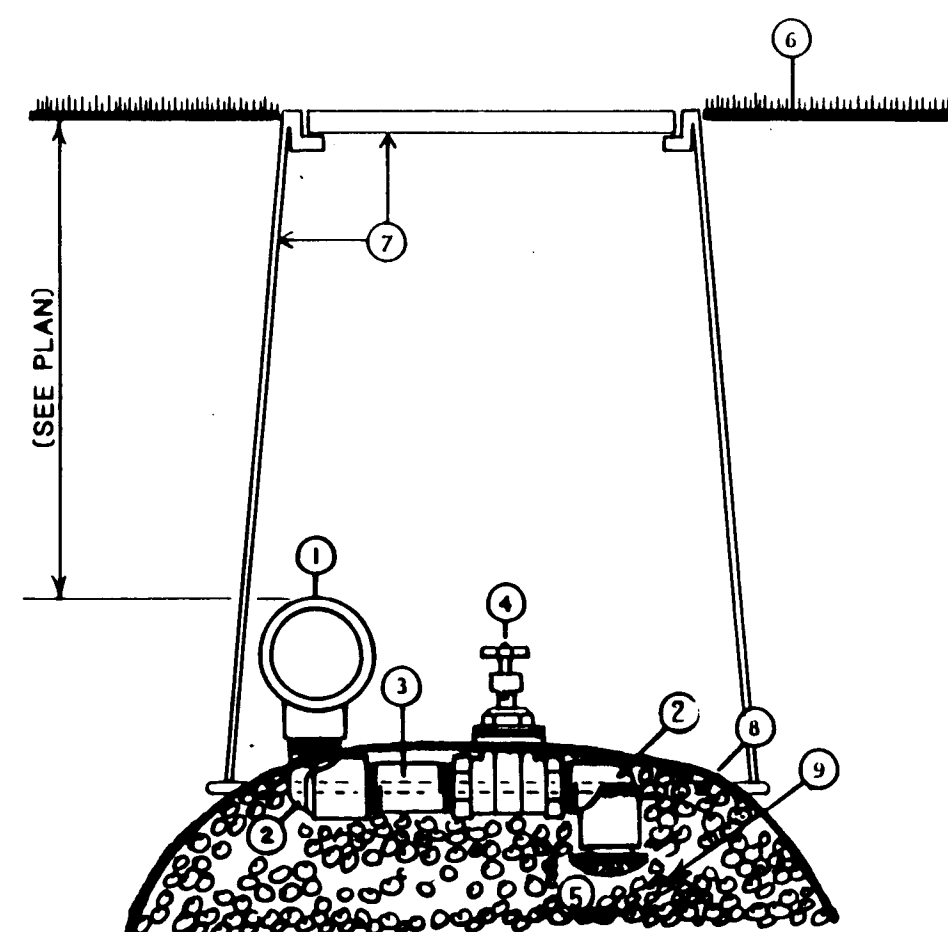

- 1 MAINLINE OR LATERAL TEE
2 PVC STREET ELL TTY
3 SCH. 80 PVC NIPPLE - 3" LONG
4 CHAMPION 100K5-075, 3/4" STRAIGHT VALVE
5 KING DRAIN - 3/4" NIPPI
6 FINISH GRADE
7 BROOKS 1730 VALVE BOX WITH 6" EXTENSION
8 6 MIL. POLY. COVER
9 GRAVEL SUMP (3 CUBIC FEET)

MANUAL DRAIN ASSEMBLY (3/4") NTS

IRRIGATION LEGEND

- EXISTING DISTRIBUTION LINE, SIZE AND MATERIAL INDICATED ON PLAN
--- SERVICE LINE, PLASTIC TUBING PER CITY STANDARD SPECIFICATION 802.3.3 (CONNECT TO CITY DISTRIBUTION LINE BY PRESSURE CONNECTION)
☒ WATER METER, SIZE AS INDICATED ON PLANS (INSTALL AS PER CITY STANDARD DETAILS 2360 THRU 2369)
⊕ WEATHERMATIC 8024-BCR-15 1-1/2" AUTOMATIC VALVE ASSEMBLY.....SEE DETAIL
⚠ WEATHERMATIC 8024-BCR-20-PRS 2" AUTOMATIC VALVE WITH FERGUSON 5257-2 REDUCED PRESSURE PRINCIPLE BACKFLOW PREVENTER.....SEE DETAIL
● MANUAL DRAIN ASSEMBLY, SIZE 3/4".....SEE DETAIL
□ SOLVENT WELD CAP, (LINE SIZE)
☑ TORO 169-66-01 SIX STATION WALL MOUNT CONTROLLER.....SEE DETAIL
--- EXISTING 120 VOLT ELECTRICAL PANEL
--- SLEEVE PIPING, CLASS 200 PVC (TWO SIZES LARGER THAN PIPE TO BE SLEEVED), (SLEEVE PIPE FOR 24 VOLT WIRE SHALL BE 1-1/4" CLASS 200 PVC)
--- LATERAL PIPING, SCH. 40 PVC - 18" BURY
--- MAINLINE PIPING, SCH. 40 PVC - 28" BURY
▲ TORO 570C-3P, 3" POP-UP BUBBLER ASSEMBLY WITH FB-25-PC NOZZLE.....SEE DETAIL
▲ TORO 570C-3P, 3" POP-UP BUBBLER WITH FB-50-PC NOZZLE.....SEE DETAIL
□ EXISTING BUBBLER TO BE REMOVED.
■ EXISTING BUBBLER TO REMAIN.
--- EXISTING LATERAL PIPE.
--- EXISTING MAINLINE PIPE.

IRRIGATION NOTES

- The proposed metered water service shall be as per Standard City Detail DWG. 2362 and 2363 and installed complete by the Contractor.
- All water taps to existing distribution lines shall be pressure connections.
- The proposed controller locations indicated on the plans are approximate. Actual location of the controller shall be determined by the Owner's representative in the field. Contractor shall extend electrical source from the existing electrical panel to the controller location.
- Where crossing existing hard construction is shown on plans, the Contractor shall saw-cut existing asphalt and/or concrete prior to trenching, remove and properly dispose of debris, install sleeve piping, compact subgrade to 95%, and replace asphalt and/or concrete to match existing areas.
- The Contractor shall adjust all valves, bubblers, and sprinklers for optimum coverage, and shall provide and install nozzles other than those specified as instructed by the Landscape Architect at no additional cost to the Owner.
- All existing distribution line locations are schematic. It shall be the Contractor's responsibility to pot hole and field check to determine actual locations as an incidental requisite to the construction contract.
- Exposed conduit for 24 volt conductors above grade and outside of buildings shall be rigid steel conduit.
- The service line between the pressure connection and water meter shall be plastic tubing as per City Std. Specification 802.3.3.
- Contractor shall install manual drains on the lateral piping at the lowest point to insure complete drainage of the lateral. Quantity shall be as required and shall be located on the "As-Built" drawings. (Location shall be determined by the Contractor and shall be approved by the Owner's representative prior to installation). (Minimum one per zone.) See **C**
- All proposed irrigation piping shall be marked using marker tape which shall be laid horizontally 4" above piping. Piping laid in common trenches shall have marker tape for each pipe. Tape shall be 2" wide and marked "buried water line", blue in color and metallic for future location. Product is available from Pipeline Material Inc. Albuquerque, New Mexico (505) 821-2626 (or approved equal).
- 24 volt wire shall be run from the controller to the closest irrigation trench, minimizing the amount of trenching required for the installation of the wire. The Contractor shall review the proposed routing of the 24 volt wire with the Landscape Architect and have the route approved by the Landscape Architect prior to installation.
- The Contractor shall wire 120 volt AC needed for the irrigation controller to the closest 120 volt electrical panel. Associated breaker shall be labeled "Irrigation Control Panel". Actual location for connection shall be determined by the Owner's representative in the field.
- All 24 volt wire shall be marked with a 6" wide yellow marker tape and marked "Warning-Electrical". Lay marker tape horizontally 4" above wire.
- All gate valves on pressure vacuum breakers shall be equipped with resilient seat gate valves.
- In addition to other specified tests and inspections, the irrigation systems shall be performance tested and witnessed by the Compliance Officer from the City of Albuquerque Health and Environment Department for conformance with the provisions of the Waste Water Ordinance.
- "Remove all existing irrigation equipment", where called for on plans, shall be defined as removing and properly disposing of all existing manual valves, automatic valves, vacuum breakers, risers, sprinkler heads, bubbler heads, nipples, controllers, 120 volt conduit and conductors, manual drains and valve boxes. Existing piping shall be capped and abandoned.

RECORD DRAWING


FEB 1992

These drawings have been issued based on field data and every reasonable effort has been made to depict construction as actually performed.


MORROW & COMPANY
LANDSCAPE ARCHITECTS
210 La Veta Drive NE
Albuquerque, New Mexico 87108
505 268-2266

CITY OF ALBUQUERQUE PUBLIC WORKS DEPARTMENT ENGINEERING GROUP					
TITLE: KIVA LANDSCAPING IRRIGATION DETAILS AND NOTES					
APPROVALS	ENGINEER	DATE	APPROVALS	ENGINEER	DATE
D.R.C. Chair	Rogers	11-16-90			
Trans. Dev.	R. J. Kane	11-16-90			
Utility Dev.	R. J. Kane	11-13-90			
Hyd.	COM	11-15-90			
PROJECT NO.	3337.90	MAP NO.	F - 22	SHEET	KL - 3


AS BUILT INFORMATION		BENCH MARKS		SURVEY INFORMATION	
CONTRACTOR	MCC Construction Co.	DATE		FIELD NOTES	
WORK	ALBUQUERQUE	NO.		BY	
DESIGNED BY	DATE 12/19/91				
DRAWN BY	DATE 12/19/91				
CHECKED BY	DATE 12/19/91				
RECORDED BY	DATE 12/19/91				
MICRO-FILM INFORMATION		ENGINEER'S SEAL		REVISIONS	
		NO. 2		DESIGN	
		DATE 10/26/90		BY	
		DATE 10/26/90		DESIGNED BY T.G.	
		DATE 10/26/90		DRAWN BY T.G.	
		DATE 10/26/90		CHECKED BY E.R.	

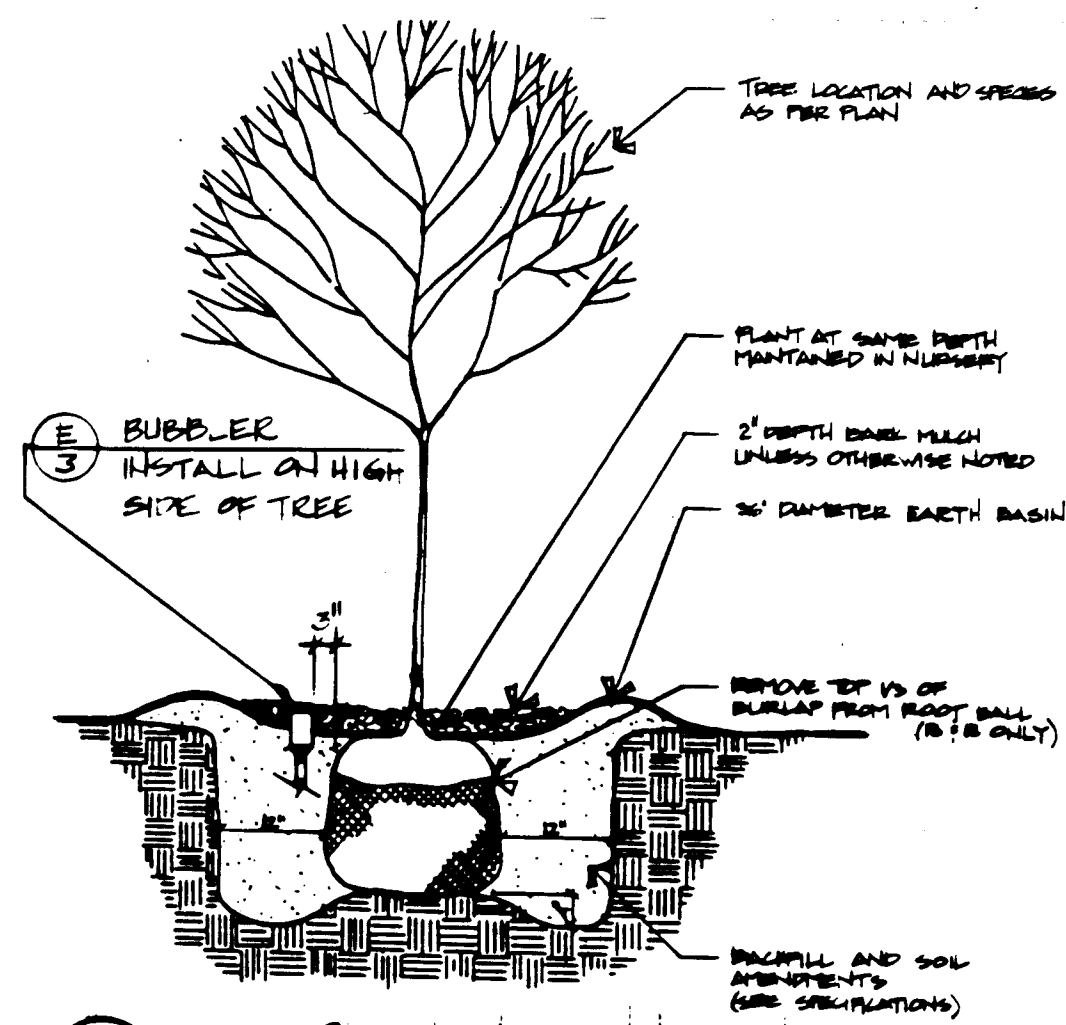


A TREE PLANTING ON LEVEL N.T.S.

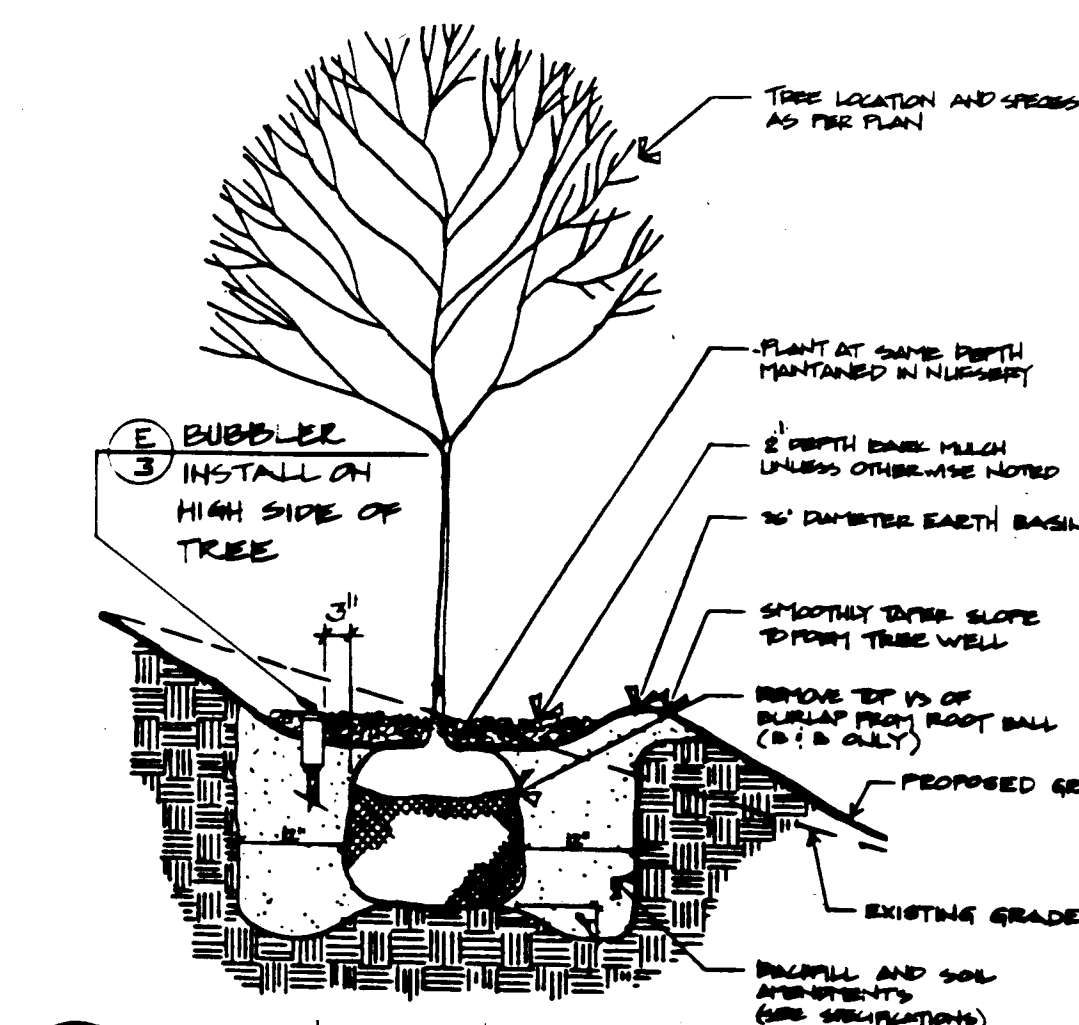


B TREE PLANTING ON SLOPE N.T.S.

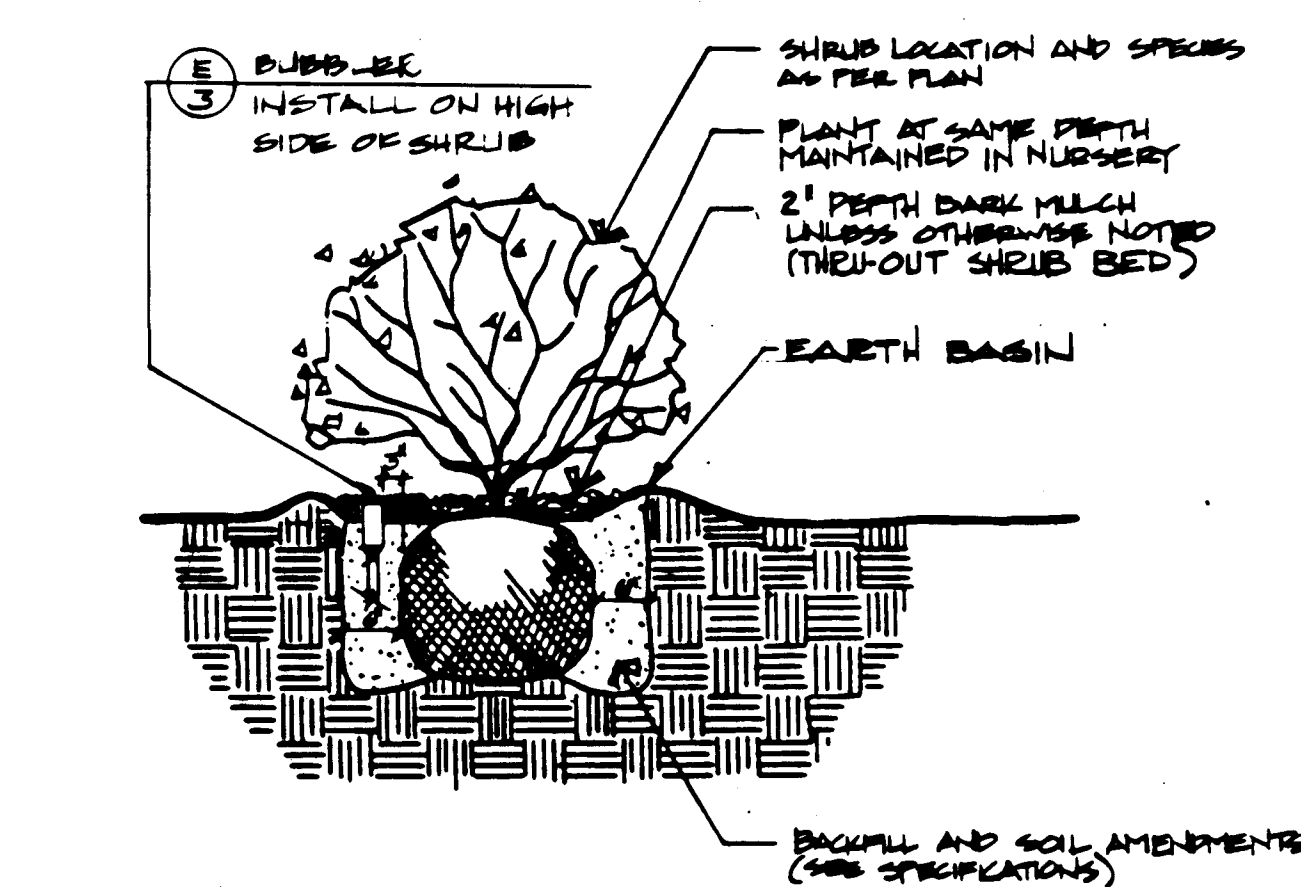


C SHRUB PLANTING ON LEVEL N.T.S.

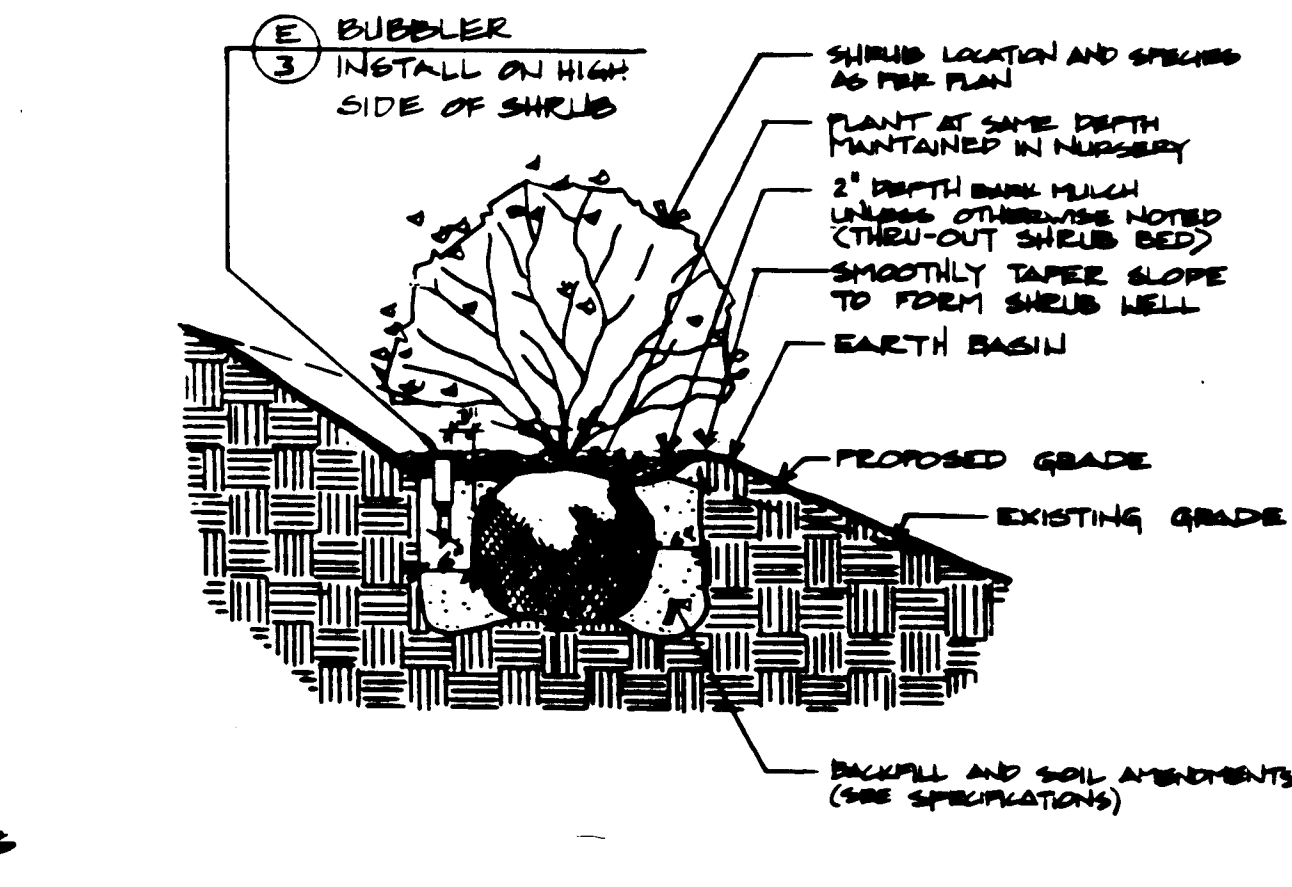

D SHRUB PLANTING ON SLOPE N.T.S.

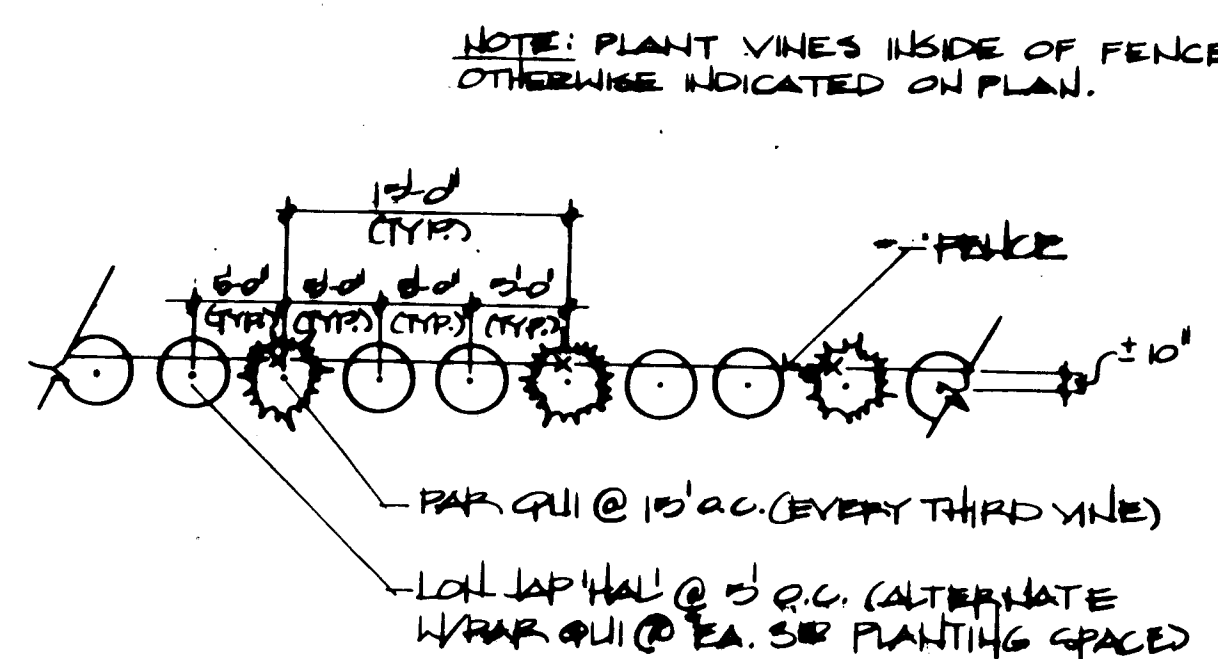

E LON JAP 'HAL' / PAR QUI PLANTING N.T.S.

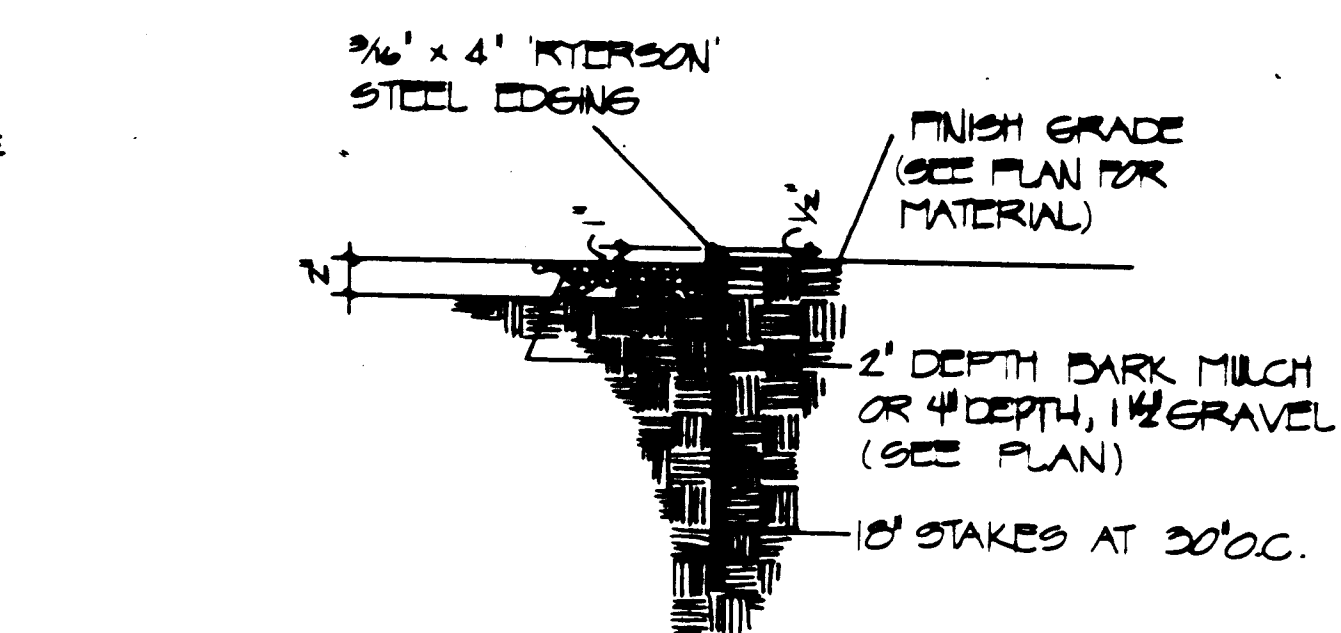

F STEEL EDGING N.T.S.

PLANT LIST					
SYMBOL	BOTANICAL NAME	COMMON NAME	SIZE	QUANTITY	REMARKS
TREES					
FRA VEL 'MOD'	Fraxinus velutina	Modesto Ash	15 gallon	24	1-1/2" cal., 8'-10' ht., 3' min. spd.
GLE TRI 'SUN'	Gleditsia triacanthos inermis 'Sunburst'	Shademaster Honey Locust	15 gallon	6	1-1/2" cal., 8'-10' ht., 3' min. spd.
PIN PON	Pinus ponderosa	Ponderosa Pine	15 gallon	18	4'-6' ht., 3' min. spd.
POP NIG 'ITA'	Populus nigra 'Italica'	Lombardy Poplar	15 gallon	9	1-1/2" cal., 8'-10' ht.
JUN VIR 'CAN'	Juniperus virginiana 'Canadensis'	Canadensis Juniper	15 gallon	2	1-1/2" cal., 4'-6' ht., 3' min. spd.
SHRUBS					
CHR NAU	Chrysothamnus nauseosus 'Green'	Green Rabbitbrush	5 gallon	67	2'-3' ht., 6'-0" o.c.
VINES					
LON JAP 'HAL'	Lonicera japonica 'Halliana'	Hall's Honeysuckle	1 gallon	79	Min. 4 stems of 12" min. length
PAR QUI	Parthenocissus quinquefolia	Virginia Creeper	1 gallon	38	Min. 4 stems of 12" min. length
SEEDING					
NATIVE SEED MIX 'C' 14200 SF Kiva Landscaping, 11012 SF Gutierrez					
	Bouteloua curtipendula	Sideoats Grama		5 lbs. PLS/acre at 1/2" depth	
	Eragrostis lehmanniana	Lehmann Lovegrass		2 lbs. PLS/acre at 1/2" depth	
	Oryzopsis hymenoides	Indian Ricegrass		5 lbs. PLS/acre at 4" depth	
	Sporobolus cryptandrus	Sand Dropseed		2 lbs. PLS/acre at 1/2" depth	
	Wildflowers: Plants of the Southwest #4000 Desert Mix			2 lbs/acre at 1/2" depth	

PLANTING NOTES		
1.	Quantities shown on the Plant List are estimates only. Contractor shall verify all quantities prior to bid and installation. No additional payment will be made for any discrepancies in quantities.	
2.	Honeysuckle shall be planted at 5'-0" o.c. when planted along a fence.	
3.	Where plans call for vines to be planted next to a fence, vines shall be planted inside fence unless otherwise indicated on plans. Vines shall be planted + 12" from fence. The Contractor shall lead vines up fence upon installation.	
4.	If there is a discrepancy in field or nursery trees between the container size called out under "Size" and the caliper and height called out under "Remarks", the specified tree must meet the caliper and height requirements specified "Remarks," even if a larger container size is required to meet these specifications, at no additional cost to the Owner.	
5.	Balled and Burlapped (B & B) trees will be an acceptable substitute for container trees. B & B trees must meet size requirements specified under "Remarks". Root ball sizes must meet the following specifications:	
	Deciduous Trees	Caliper
		1-1/2"
		2"
	Evergreen Trees	Height
		4'-6'
		6'-8'
		8'-10'
		Min. Root Ball Diameter
		20"
		24"
		20"
		24"
		30"
6.	The Contractor shall prune lower branches of deciduous trees to 6 feet above finish grade.	
7.	Native seed shall be drill seeded, except in areas where the slope is too steep to be drill seeded (slopes over 3:1 gradient), in which case seed shall be broadcast.	
8.	Immediately after installation of seed, native grasses shall be watered for six weeks with a temporary watering system at the following rates:	
	Weeks 1 thru 3: 1/2" water twice per week	
	Weeks 3 thru 6: 1/2" water once per week	

NOTE: PLANT LIST INCLUDES ALL PLANTS FROM KIVA LANDSCAPING AND GUTIERREZ PUMP STATION


24 3337.90539.2

MORROW & COMPANY
LANDSCAPE ARCHITECTS
210 La Veta Drive NE
Albuquerque, New Mexico 87108
505 268-2266

AS BUILT INFORMATION			BENCH MARKS			SURVEY INFORMATION			ENGINEER'S SEAL			REVISIONS			DESIGN		
CONTRACTOR: ALBUQUERQUE WORKS DESIGNED BY: T.G. DATE: 10/26/90			DATE: 10/26/90			NO. DATE			BY			REMARKS			DATE 10/26/90		
FIELD LOCATION BY: T.G. DATE: 10/26/90			DATE: 10/26/90			NO. DATE			BY			REMARKS			DATE 10/26/90		
CORRECTED BY: T.G. DATE: 10/26/90			DATE: 10/26/90			NO. DATE			BY			REMARKS			DATE 10/26/90		
MICRO-FILM INFORMATION			RECORDED BY			DATE			NO.			DATE			DATE		
CITY OF ALBUQUERQUE PUBLIC WORKS DEPARTMENT ENGINEERING GROUP			TITLE: KIVA LANDSCAPING PLANTING DETAILS AND PLANT LIST			APPROVALS			ENGINEER			DATE			DATE		
D.R.C. Chair			DATE: 11/16/90			Trans. Dev.			DATE: 11/13/90			Utility Dev.			DATE: 11/15/90		
HYP			DATE: 11/15/90			LDM			DATE: 11/15/90			DATE: 11/15/90			DATE: 11/15/90		
PROJECT NO. 3337.90			MAP NO. F-22			SHEET			KL-4			DATE			DATE		

RECORD DRAWING
FEB 1992

These drawings have been revised based on field data and every reasonable attempt has been made to depict construction as actually performed.

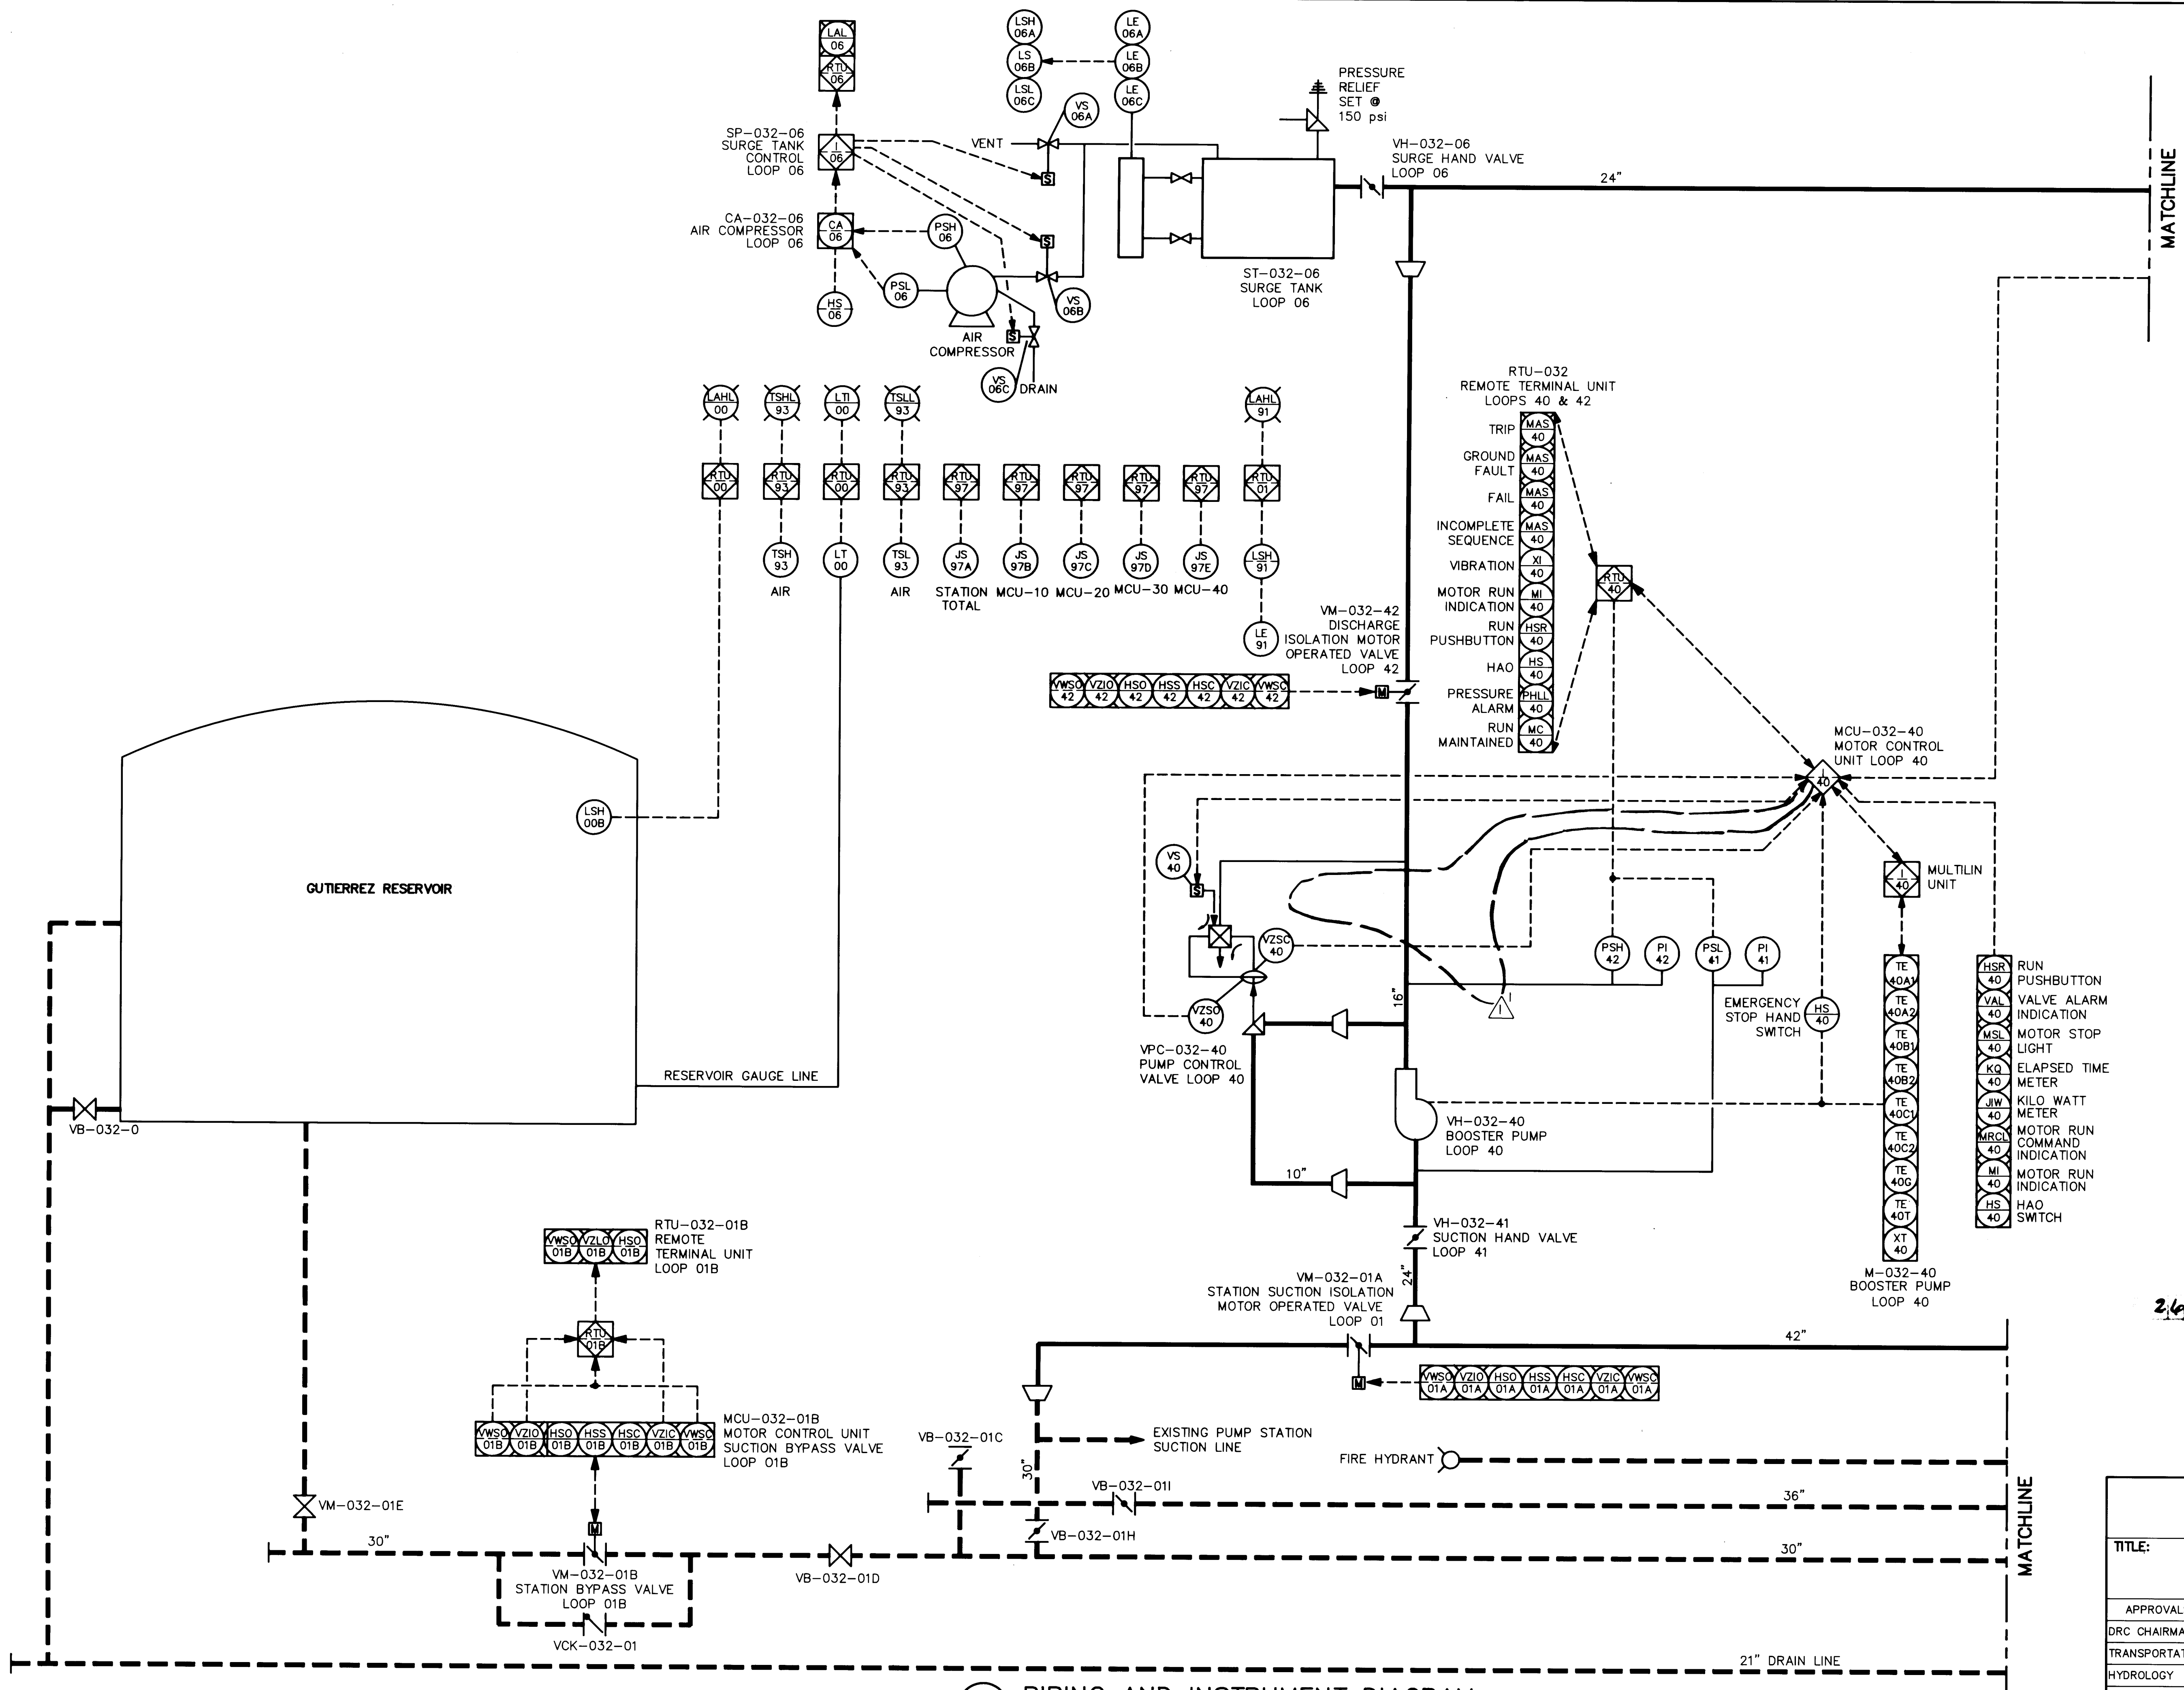

1 PIPING AND INSTRUMENT DIAGRAM
11 NO SCALE

24 31337 905492

RECORD DRAWING


These drawings have been reviewed based on field data and every reasonable attempt has been made to depict construction as actually performed.


CITY OF ALBUQUERQUE PUBLIC WORKS DEPARTMENT ENGINEERING GROUP					
TITLE: GUTIERREZ PUMP STATION RECONSTRUCTION PIPING AND INSTRUMENT DIAGRAM					
APPROVALS	ENGINEER	DATE	APPROVALS	ENGINEER	DATE
DRC CHAIRMAN	<i>R. W. Kane</i>	11-16-90	WATER	<i>R. W. Kane</i>	11-13-90
TRANSPORTATION	<i>M. A. Kane</i>	11-16-90	WASTE WATER	<i>R. W. Kane</i>	11-13-90
HYDROLOGY	<i>L. D. Kane</i>	11-15-90			
PROJECT NO.	3337.90	MAP NO.	F-22	SHEET	11 OF 3

AS BUILT INFORMATION		BENCH MARKS		SURVEY INFORMATION		ENGINEER'S SEAL	
CONTRACTOR	MCC			FIELD NOTES			
WORK STARTED BY	ALB. SVY.	DATE	2/92	BY			
ACCEPTANCE BY	DATE	12/19/91		NO.			
FIELD REVISIONS	DATE	12/91					
DRAWINGS CORRECTED BY	DATE	2/92					
MICRO-FILM INFORMATION							
RECORDED BY	DATE						
NO.							

11-13-90

DESIGNED BY	H. LIVERMORE	DATE	NOV. 9, 1990
DRAWN BY	P. STRINEL		
CHECKED BY			

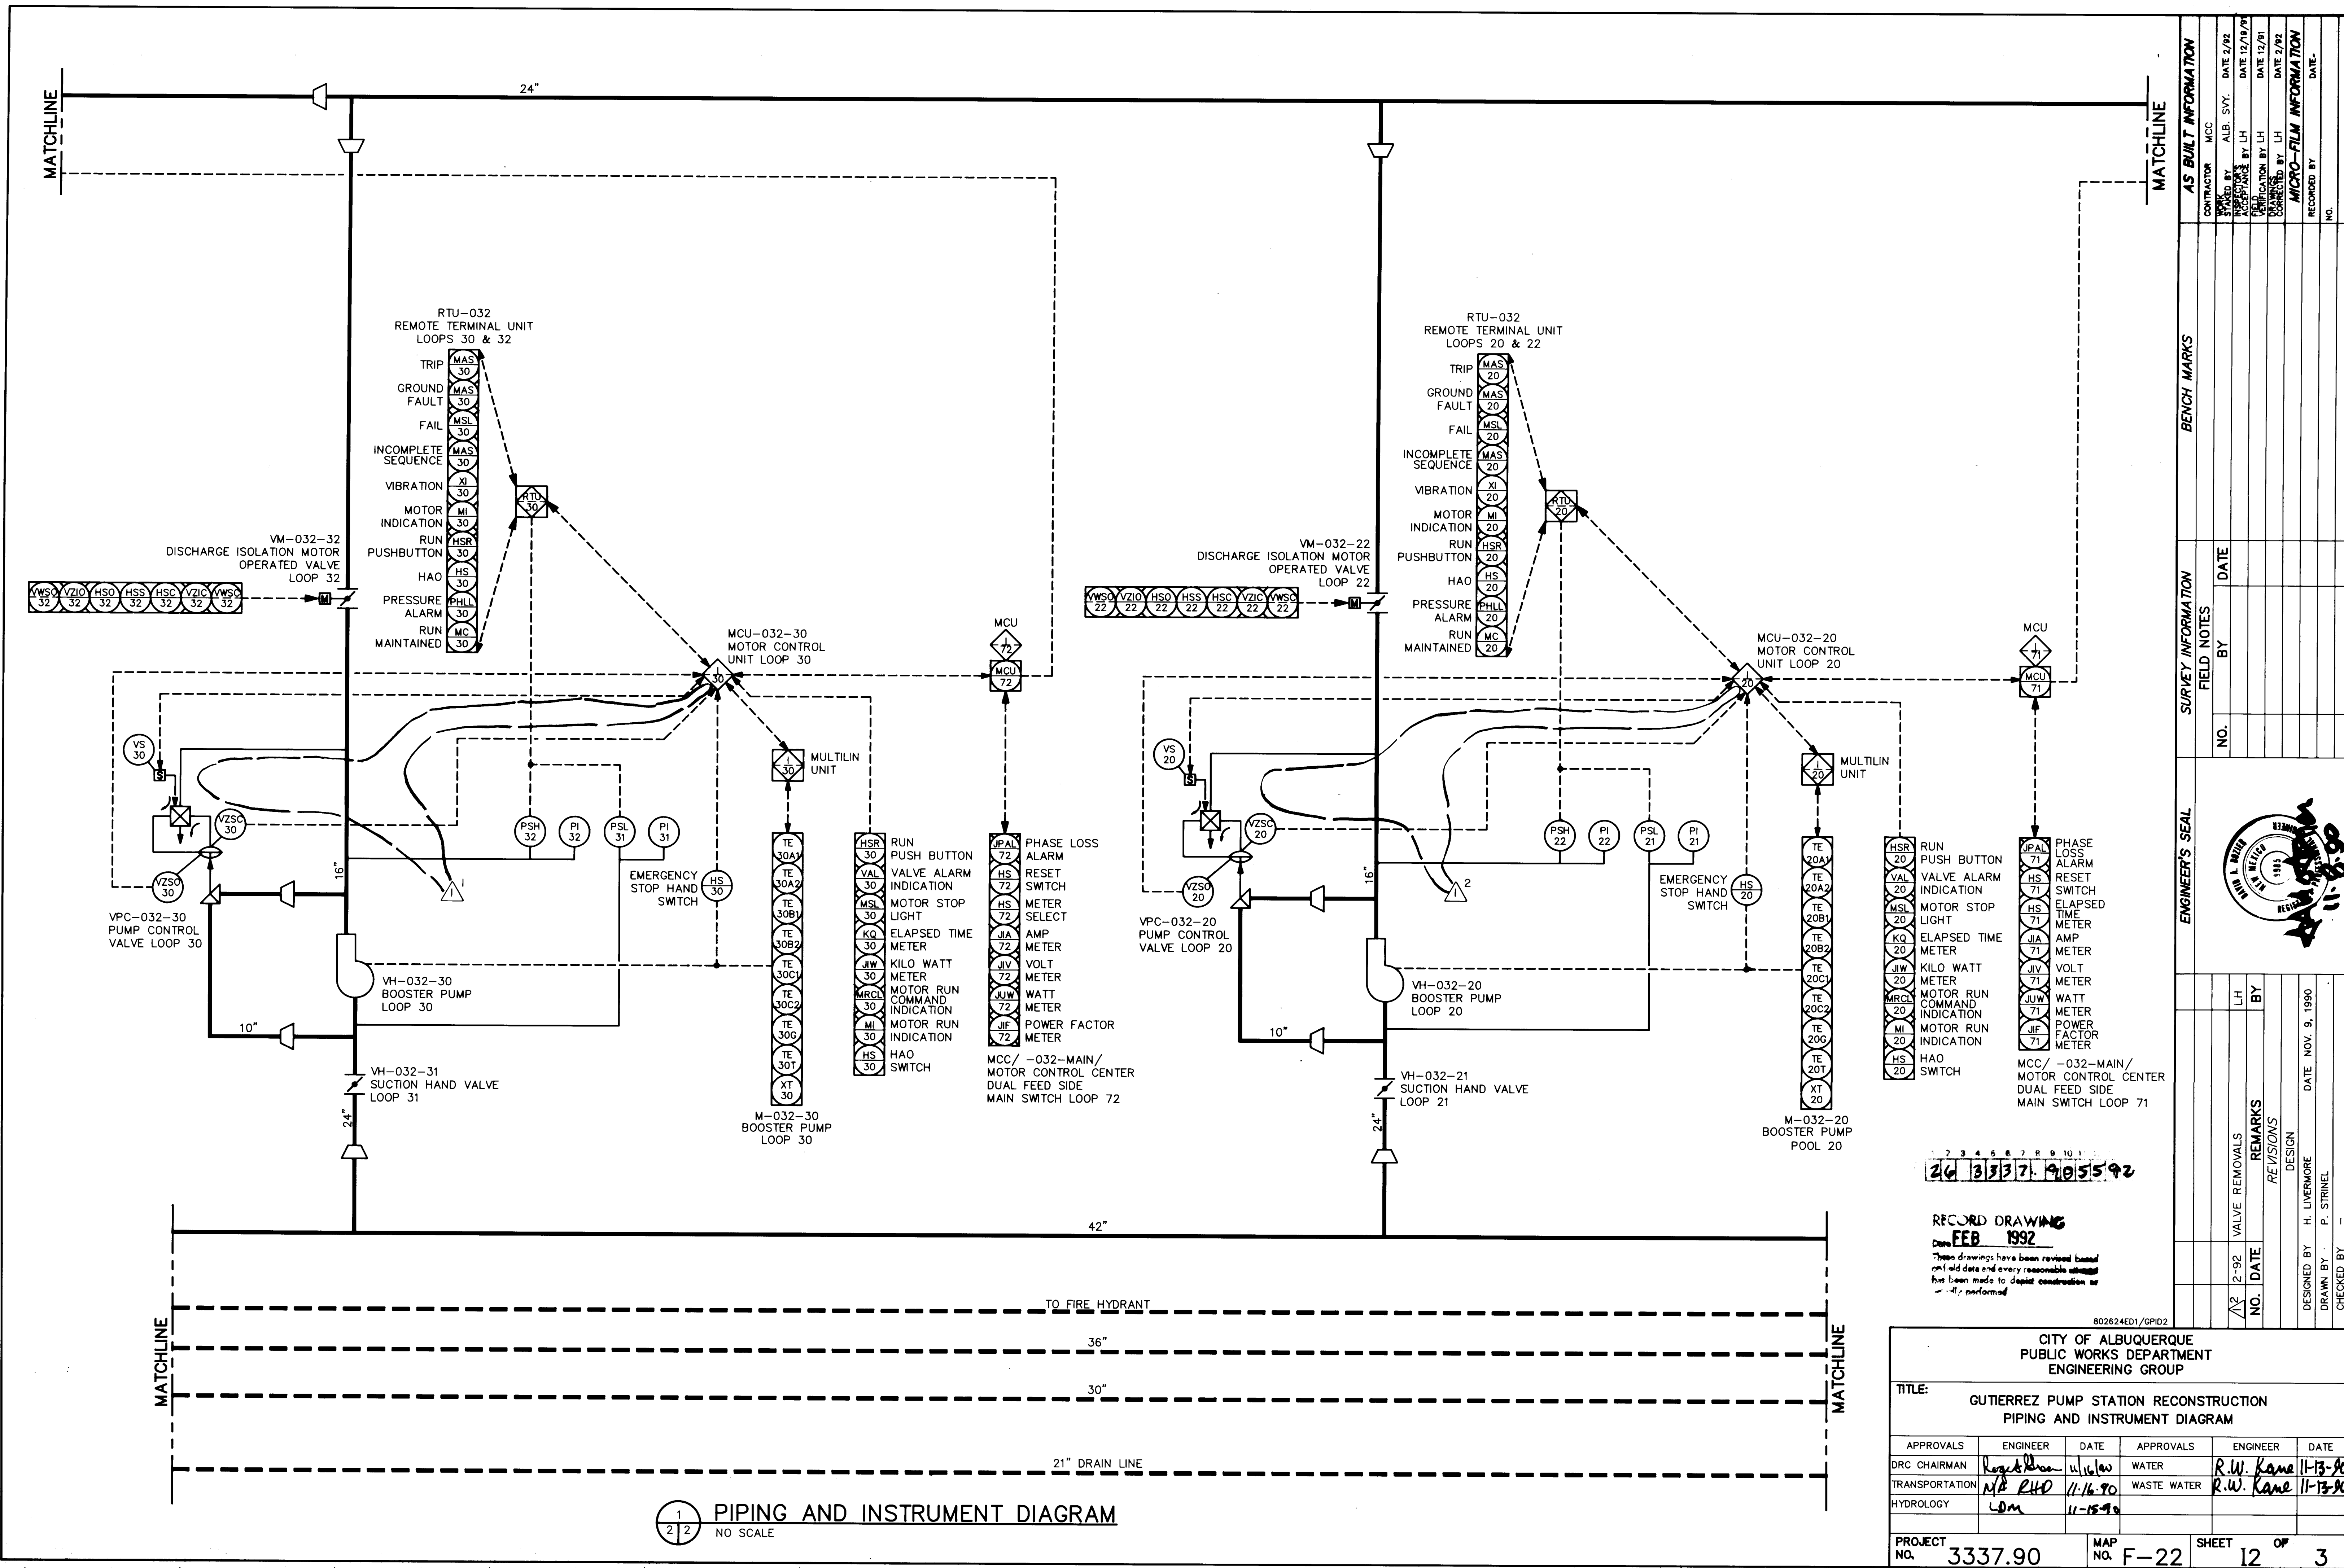

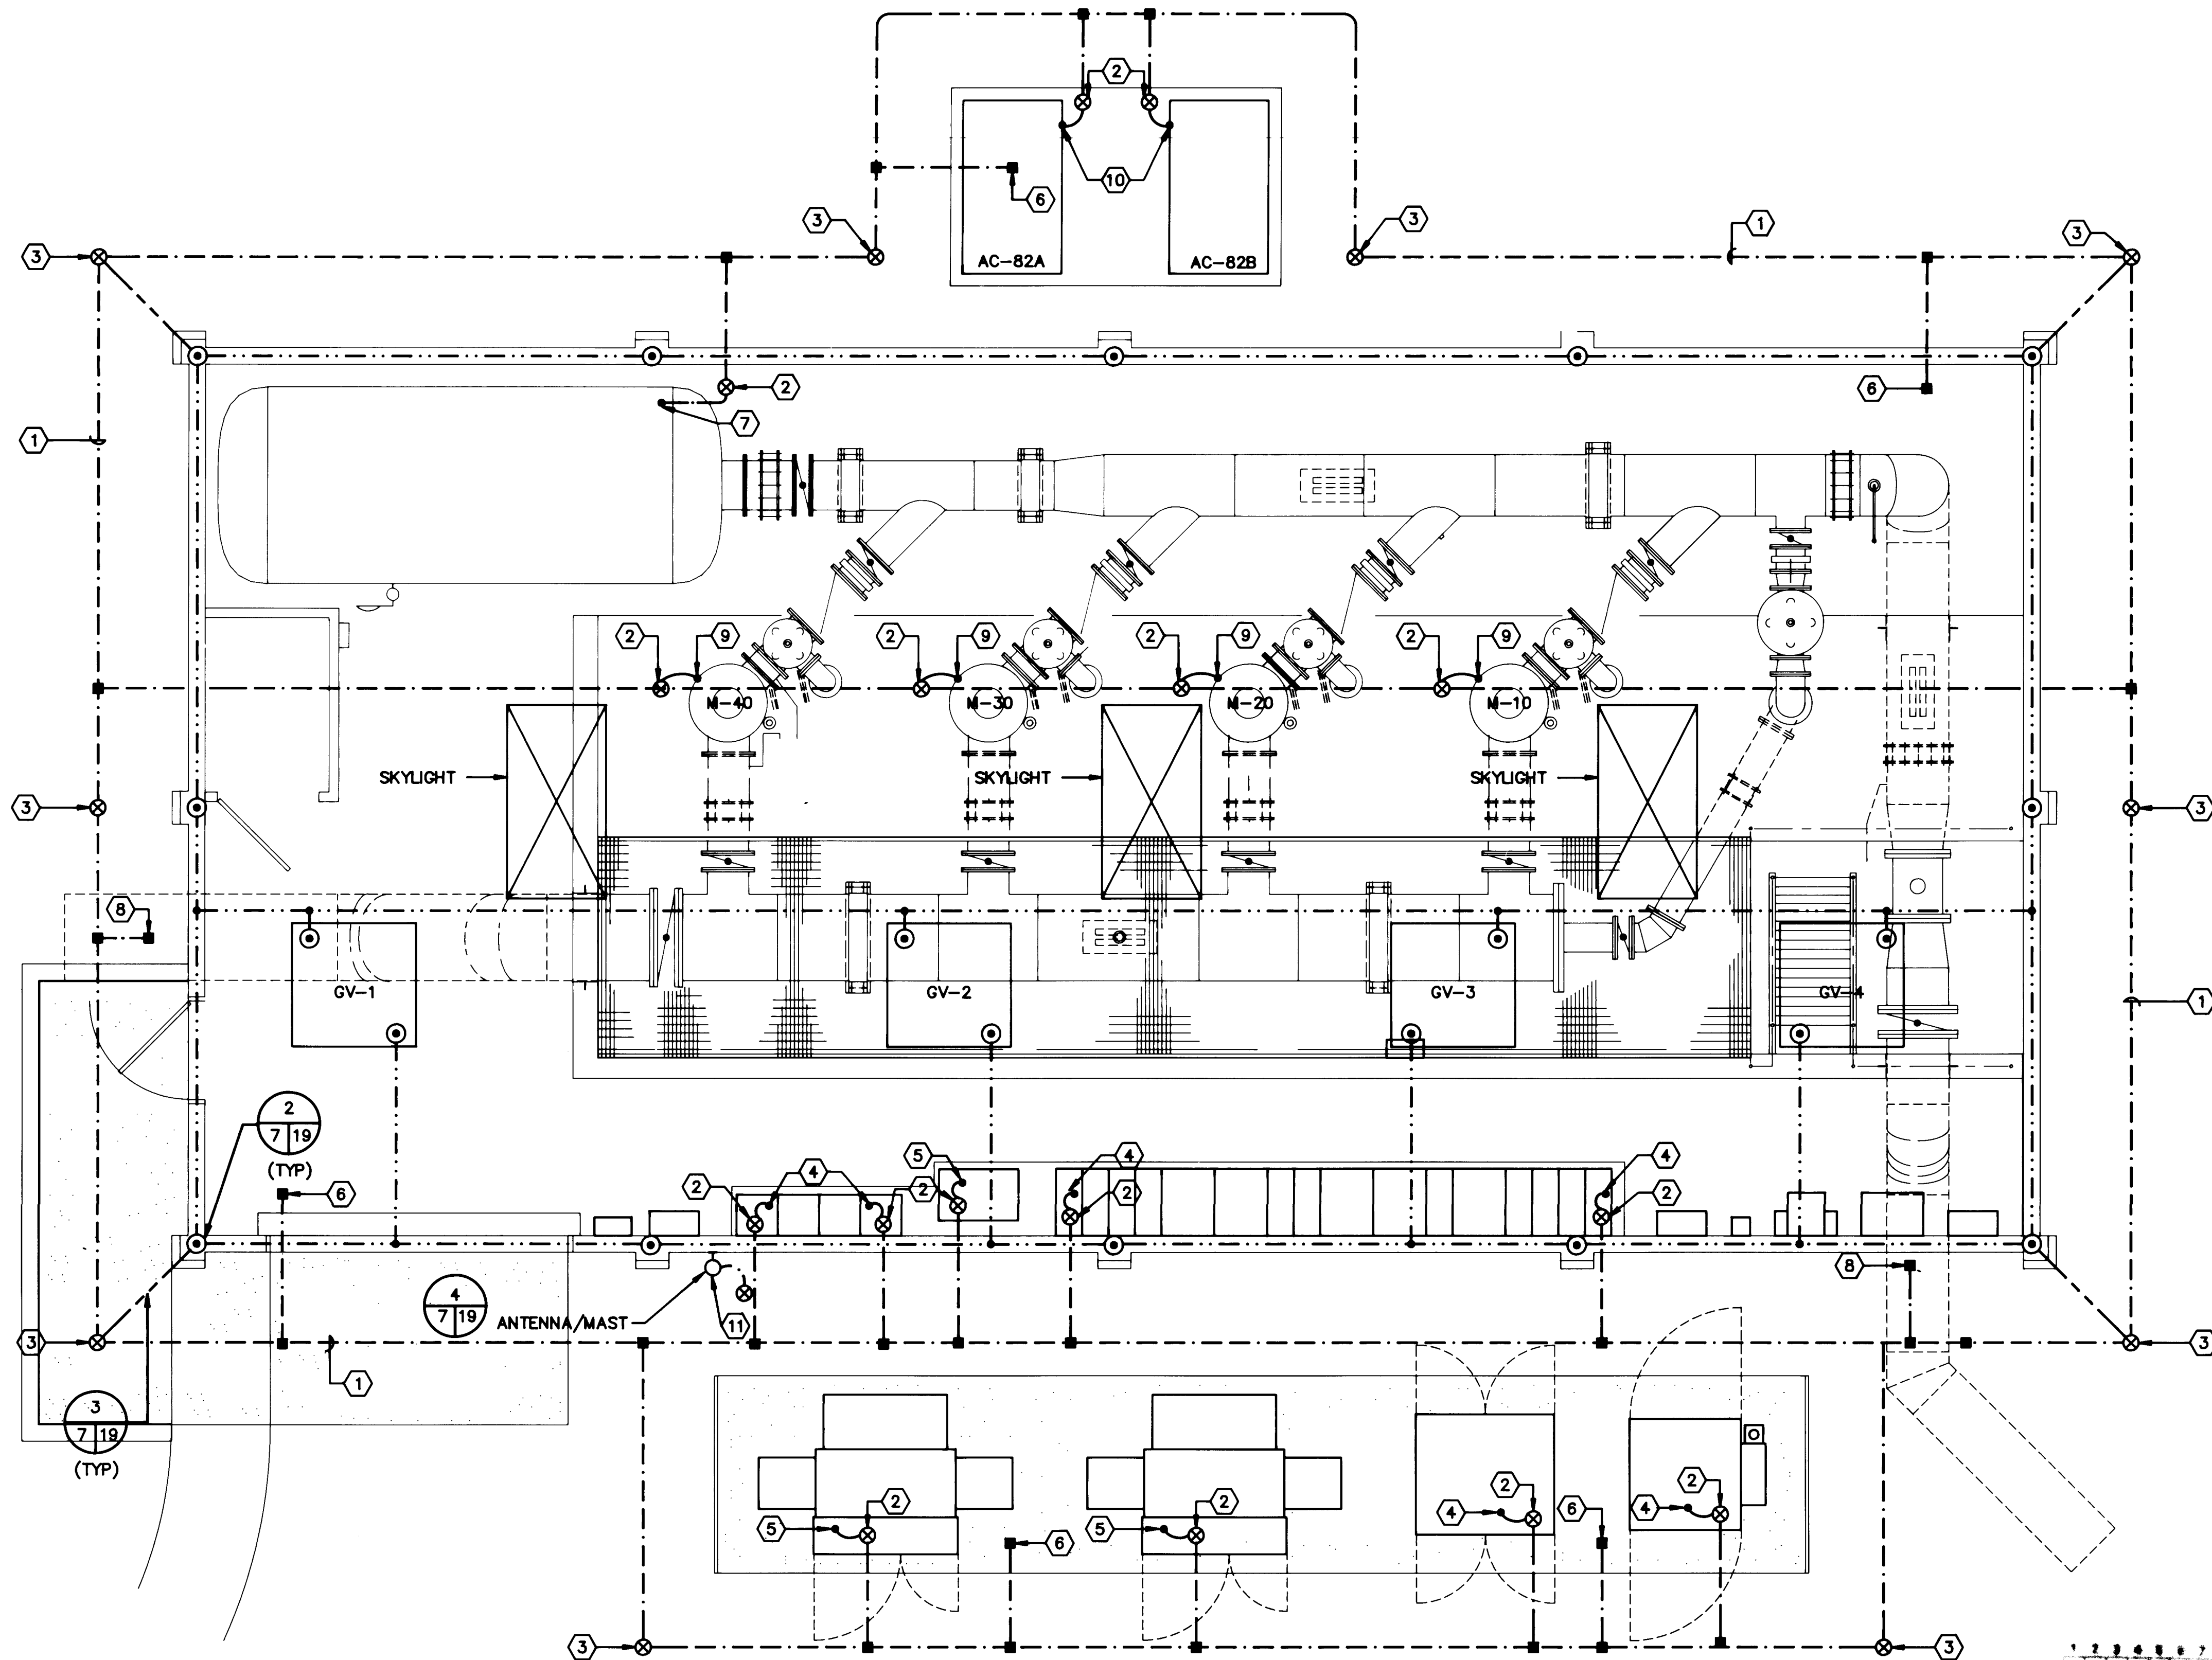

GENERAL NOTES

- SEE SHEET E1 FOR SYMBOLS LEGEND AND ABBREVIATIONS LIST.
- SEE SHEET E8 FOR SCHEDULES.

KEYED NOTES

- LOCATE GROUND CONDUCTOR 2'-0" MINIMUM AND 4'-0" MAXIMUM FROM FOUNDATION (TYPICAL).
- INSTALL GROUND ROD 0'-4" ABOVE FINISH SLAB OR HOUSEKEEPING PAD.
- INSTALL GROUND ROD 2'-0" BELOW FINISH GRADE.
- BOND GROUND ROD TO EQUIPMENT ENCLOSURE AND GROUND BUS (TYPICAL).
- BOND GROUND ROD TO TRANSFORMER CASE AND SECONDARY NEUTRAL.
- BOND TO SLAB REBAR.
- BOND TO SURGE TANK SADDLE.
- BOND TO STEEL WATER PIPE.
- BOND TO BOOSTER PUMP CASING.
- BOND TO EVAPORATIVE COOLER FRAME.
- BOND RADIO ANTENNA TO GROUND ROD IN ACCORDANCE WITH REFERENCED DETAIL. PROVIDE LIGHTNING ARRESTOR ON RADIO COAXIAL CABLE IN ACCORDANCE WITH UL REQUIREMENTS.

AS BUILT INFORMATION			BENCH MARKS			SURVEY INFORMATION			ENGINEER'S SEAL		
CONTRACTOR	DATE					FIELD NOTES	BY	DATE			
WORK STAKED BY	DATE					NO.					
ADJUSTED BY	DATE								REMARKS		
FIELD VERIFICATION BY	DATE										
RECORDED BY	DATE								REVISIONS		
MICRO-FILM INFORMATION									DESIGN		
RECORDED BY	DATE								DESIGNED BY D. DOZIER		
									DRAWN BY S. HAUGLAND		
									CHECKED BY B. GRIFFIS		
									DATE NOV. 9, 1990		

CITY OF ALBUQUERQUE PUBLIC WORKS DEPARTMENT ENGINEERING GROUP					
TITLE: GUTIERREZ PUMP STATION RECONSTRUCTION GROUNDING/LIGHTNING PROTECTION SYSTEM PLAN					
APPROVALS	ENGINEER	DATE	APPROVALS	ENGINEER	DATE
DRC CHAIRMAN	<i>[Signature]</i>	<i>[Date]</i>	WATER	R.W. Kane	11-13-90
TRANSPORTATION	N/A LHO	11-16-90	WASTE WATER	R.W. Kane	11-13-90
HYDROLOGY	LDM	11-15-90			
PROJECT NO.	3337.90	MAP NO.	F-22	SHEET	E7 OF 19

GROUNDING/LIGHTNING PROTECTION SYSTEM PLAN
SCALE: 1/4"=1'-0"

RECORD DRAWING
FEB 1992

These drawings have been revised based on field data and every reasonable attempt has been made to depict construction as actually performed.

CONDUIT SCHEDULE CONTROL CONDUIT/CONDUCTOR		
CONDUIT NO.	CONDUIT SIZE	CONDUCTOR SIZE
C001	1"C	2#14, 1#14 GRD
C002	1"C	4#14, 1#14 GRD
C003	1"C	6#14, 1#14 GRD
C004	1"C	8#14, 1#14 GRD
C005	1"C	10#14, 1#14 GRD
C006	1"C	12#14, 1#14 GRD
C007	1"C	14#14, 1#14 GRD
C008	1"C	16#14, 1#14 GRD
C009	1"C	18#14, 1#14 GRD
C010	1"C	24#14, 1#14 GRD
C011	1"C	(1) FACTORY CABLE, 1#6 GRD
C012	1"C	(1) BELDEN #8719, 1#14 GRD
C013	1-1/4"C	(2) BELDEN #8719 28#14, 1#14 GRD + 8#14 SPARE
C014	1-1/4"C	(1) BELDEN #8719 (8) BELDEN #8770 2#14, 1#14 GRD
C015	2"C	(2) BELDEN #8719 (16) BELDEN #8770 4#14, 1#14 GRD
C016	3"C	NOT IN CONTRACT
C017	1"C	14#14, 1#14 GRD

CONDUIT SCHEDULE POWER CONDUIT/CONDUCTOR		
CONDUIT NO.	CONDUIT SIZE	CONDUCTOR SIZE
P001	4"C	NOT IN CONTRACT
P002	4"C	3#1/0 15KV, 1#1/0 GRD
P003	4"C	3#2/0 15KV, 1#1/0 GRD
P004	2-1/2"C	3#8 5KV, 1#1/0 GRD
P005	2-1/2"C	4#4/0, 1#2 GRD
P006	1-1/4"C	4#2, 1#8 GRD
P007	1"C	3#8, 1#10 GRD
P008	1"C	2#10, 1#10 GRD
P009	1"C	3#10, 1#10 GRD
P010	1"C	5#10, 1#10 GRD
P011	1"C	6#10, 1#10 GRD
P012	1"C	2#12, 1#12 GRD
P013	1"C	3#12, 1#12 GRD
P014	1"C	4#12, 1#6 GRD
P015	1"C	SEE SPECIFICATION SECTION 02441

CONDUCTOR CALLOUT INDEX		
	QUANTITY	2#14, 1#14 GRD
	EQUIPMENT GROUND AWG SIZE	
	QUANTITY	(2) BELDEN #8719
	PART NO. BRAND	
	QUANTITY	3#1/0, 15KV, 1#1/0 GRD
	EQUIPMENT GROUND	
	VOLTAGE CLASS (600V UNLESS OTHERWISE NOTED) AWG SIZE	

LIGHT FIXTURE SCHEDULE			
TYPE	DESCRIPTION	LAMP	MOUNTING
A	HOLOPHANE BANT175MH-B25C-208V	(1) 175W M.H. CLEAR	PENDANT 16'-0" AFF TB0F
A/Q	SAME AS A WITH 250W QUARTZ STANDBY	(1) 175W M.H. CLEAR	PENDANT 16'-0" AFF TB0F
B	BENJAMIN CZW-2224-4-120V W/0" F BALLAST	(2) F40T12 CW	CEILING
C	BENJAMIN FA-2224-4R-208V W/0" F BALLAST, 208V	(2) F40T12 CW	CEILING
D	HID AREA LIGHT DEVICE B275-50HPS-208V	(1) 50W HPS CLEAR	WALL 17'-0" AFF TB0F

CITY FURNISHED EQUIPMENT SCHEDULE			
DESCRIPTION	FURNISHED BY	INSTALLED BY	CONNECTED BY (NOTE 1)
REMOTE TERMINAL UNIT (RTU)	CITY	CONTRACTOR	CITY
RADIO	CITY	CONTRACTOR	CITY
RADIO ANTENNA	CITY	CONTRACTOR	CITY
RADIO COAXIAL CABLE	CITY	CONTRACTOR	CITY
NOTE 1: ELECTRICAL POWER AND/OR CONTROL WIRE CONNECTIONS.			

PANEL DP-033			208/120V, 3ø, 4 WIRE, 100A FRAME, MAIN LUGS ONLY, 42 CKT, SURFACE MOUNT, BOTTOM FEED, NEMA 12 ENCLOSURE, FRONT HINGED TO BOX.					
CKT	BKR. RTNG.	LOAD DESCRIPTION	AMPERAGE LOAD			LOAD DESCRIPTION	BKR. RTNG.	CKT
			øA	øB	øC			
1	20A/1P	LIGHTS (RESTROOM)	0.8 2.0			RTU-033 (1)	20A/1P	2
3	20A/2P	LIGHTS (EXTERIOR)		1.7 0.0		SPARE	20A/1P	4
7	20A/2P	LIGHTS (SUCTION PIT)	0.9 2.0		1.7 2.0	LIGHTING CONTROL PANEL	15A/1P	6
11	20A/2P	LIGHTS (HIGHBAY-WEST)		0.9 2.0		INSTRUMENT CABINET (IC-033)	20A/1P	8
15	20A/2P	LIGHTS (HIGHBAY-MIDDLE/EAST)			5.0 2.0	FLOW TRANSMITTER (FIT-033-02)	20A/1P	10
19	20A/2P	LIGHTS (HIGHBAY-MIDDLE/EAST)	5.0 2.0		5.0 2.0	POWER SUPPLY CABINET (JC-033)	20A/1P	12
21	20A/2P	LIGHTS (HIGHBAY-MIDDLE/EAST)		9.1 2.0		HEATING/COOLING CONTROL PANEL	15A/1P	14
23	20A/2P	LIGHTS (HIGHBAY-MIDDLE/EAST)			9.1 2.0	IRRIGATION CONTROLLER (IR-033)	20A/1P	16
25	20A/2P	LIGHTS (HIGHBAY-MIDDLE/EAST)			9.1 2.0	ZONE TRANSFER VALVE (VS-033-79)	20A/1P	18
27	20A/1P	RECEPTACLES (SOUTH-WEST)	7.5 0.0			SPARE	20A/1P	20
29	20A/1P	RECEPTACLES (NORTH-EAST)		7.5 0.0		SPARE	15A/1P	22
31	20A/1P	RECEPTACLES (SUCTION PIT-WEST)			1.5 0.0	SPARE	20A/1P	24
33	20A/1P	RECEPTACLES (SUCTION PIT-EAST)	9.0 2.0			RADIO-033 (1)	20A/1P	26
35	20A/1P	GAS HEATER (GH-033-80A)		2.0 0.0		SPARE	20A/1P	28
37	20A/1P	GAS HEATER (GH-033-80B)			2.0 0.0	SPARE	20A/1P	30
39	20A/1P	GAS HEATER (GH-033-80C)	2.0 0.0			SPARE	20A/1P	32
41	20A/1P	GAS HEATER (GH-033-80D)		2.0 0.0		SPARE	20A/1P	34
43	20A/2P	ELECTRIC HEATER (EH-033-80)		4.8 0.0		SPARE	20A/2P	36
45	20A/1P	EXHAUST FAN (EF-033-81)	0.8 2.0		1.0 0.0	SPARE	20A/2P	40
47	20A/1P	SPARE			—			
(GFCI) = GROUND FAULT CIRCUIT INTERRUPTER CIRCUIT BREAKER								

A1	MCC/2-033 MOTOR CONTROL CENTER 120/208V, 3Ø, 4W	B1 (MCU-01A) STATION SUCTION ISOLATION VALVE (VM-01A)	C1 (MCU-12) PUMP NO.1 DISCHARGE ISOLATION VALVE (VM-12)	D1 (MCU-82A1) EVAPORATIVE COOLER NO.1 (FAN) (AC-82A)	E1 (MCC/2-FDR/1) PANEL DP-033
A2	METERING	B2 (MCU-02) STATION DISCHARGE ISOLATION VALVE (VM-02)	C2 (MCU-22) PUMP NO.2 DISCHARGE ISOLATION VALVE (VM-22)	D2 (MCU-82A2) EVAPORATIVE COOLER NO.1 (PUMP) (AC-82A)	E2 (MCC/2-FDR/2) AIR COMPRESSOR (CA-06)
A3	(MCU-##)	B3 (MCU-79) STATION ZONE TRANSFER ISOLATION VALVE (VM-79)	C3 (MCU-32) PUMP NO.3 DISCHARGE ISOLATION VALVE (VM-32)	D3 (MCU-82B1) EVAPORATIVE COOLER NO.2 (FAN) (AC-82B)	E3 (MCC/2-FDR/3) WELDER OUTLET
		B4 (MCU-01B) STATION BY-PASS VALVE (VM-01B)	C4 (MCU-42) PUMP NO.4 DISCHARGE ISOLATION VALVE (VM-42)	D4 (MCU-82B2) EVAPORATIVE COOLER NO.2 (PUMP) (AC-82B)	E4 (MCC/2-FDR/4) OVERHEAD DOOR CONTROLLER
				D5 (MCU-##) SPARE	E5 (MCC/2-FDR/5) SPARE
				D6 (MCU-##) SPARE	E6 (MCC/2-FDR/6) SPARE
					E7 SPACE

1 MOTOR CONTROL CENTER MCC/2-033 ELEVATION
8 NOT TO SCALE


GENERAL NOTES

- 1 SEE SHEET E1 FOR SYMBOLS LEGEND AND ABBREVIATIONS LIST.



KEYED NOTES

- 1 FEED RADIO AND RTU FROM SAME PHASE.

AS BUILT INFORMATION		BENCH MARKS		SURVEY INFORMATION		FIELD NOTES		ENGINEER'S SEAL		REVISIONS		DESIGN		DATE		NOV. 9, 1990		BY		REMARKS		DATE		NOV. 9, 1990		BY		REMARKS		DATE	
----------------------	--	-------------	--	--------------------	--	-------------	--	-----------------	--	-----------	--	--------	--	------	--	--------------	--	----	--	---------	--	------	--	--------------	--	----	--	---------	--	------	--

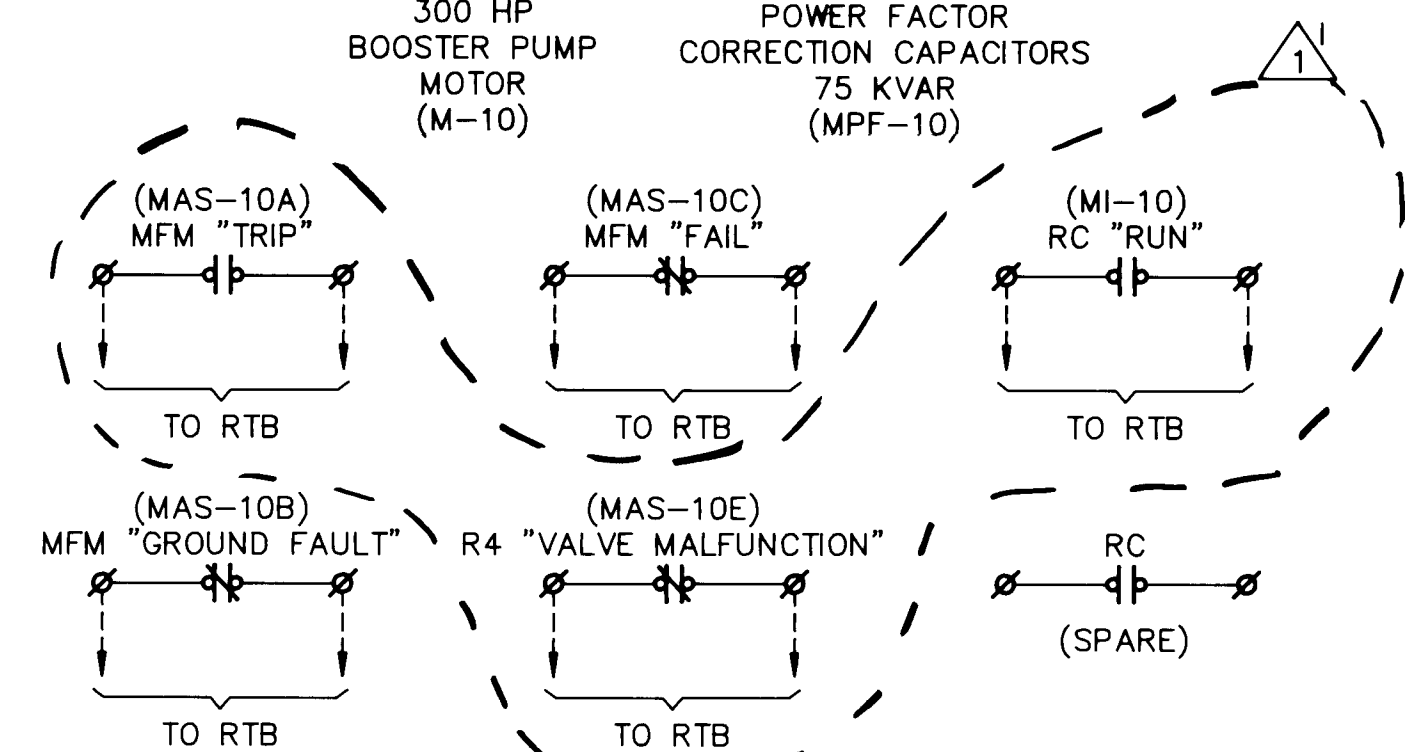


NOTE:
PUMP CONTROL VALVE CLOSED
TO DISCHARGE, OPEN TO BY-PASS

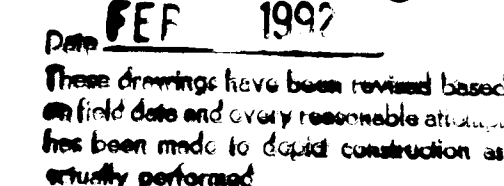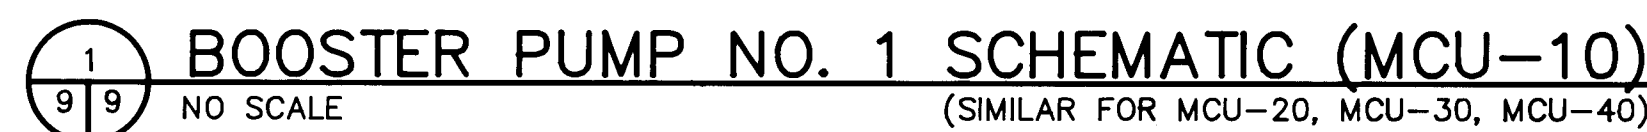

PROJECT NO.	3337.90	MAP NO.	F-22	SHEET	E9	OF	19
-------------	---------	---------	------	-------	----	----	----


[illegible]

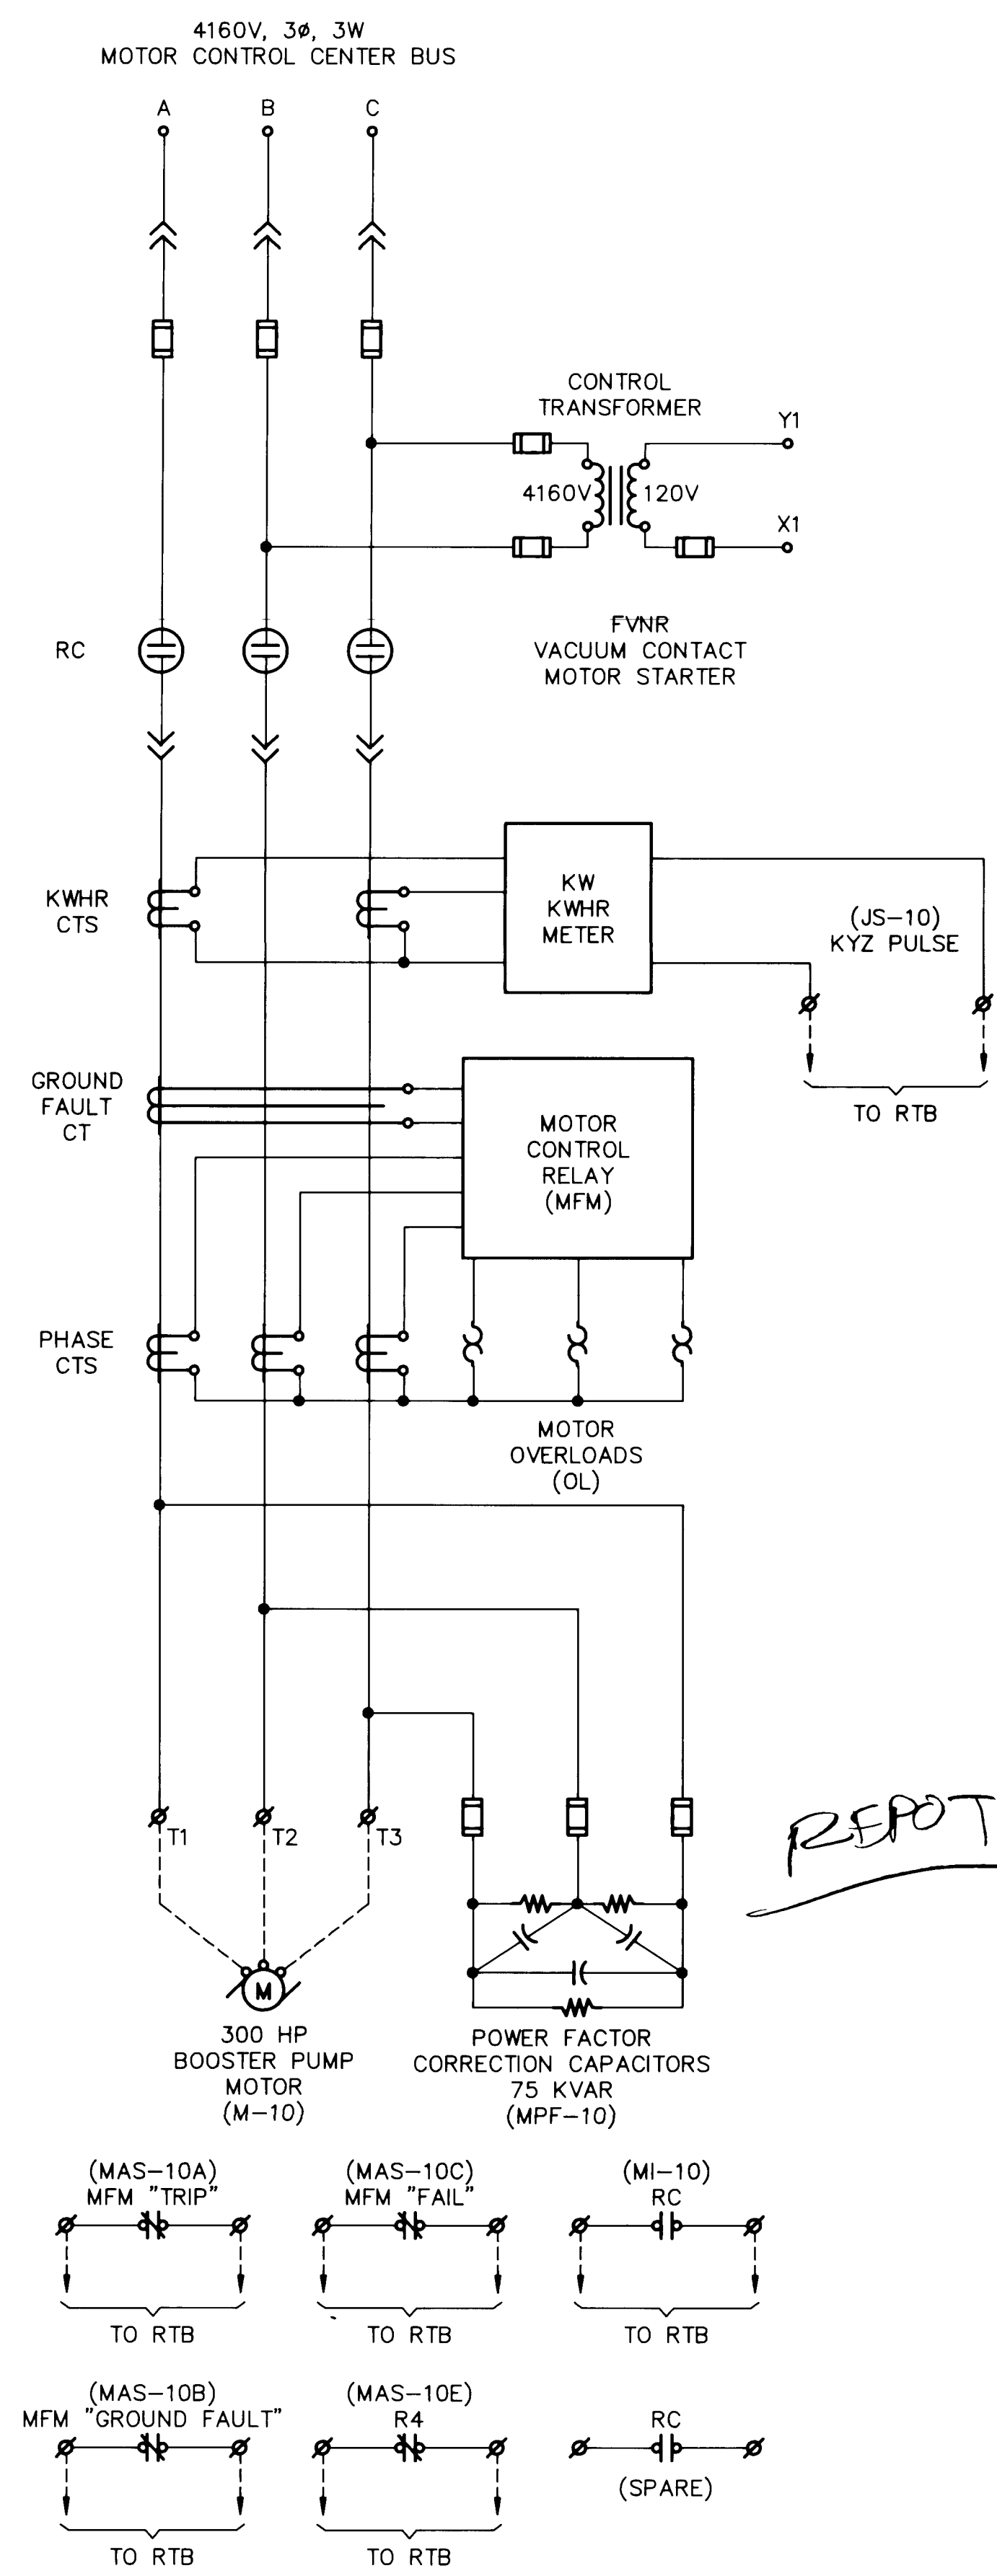


CHECK VALVE POSITION TABLE (VCK-12)				
X = CONTACT CLOSED O = CONTACT OPEN				
CONTACT	CLOSE	MID	OPEN	
VZSC	5-6	O	X	X
VZSO	7-8	X	X	O
VZSC	9-10	X	O	O

CONTROL VALVE POSITION TABLE (VPC-10)				
X = CONTACT CLOSED O = CONTACT OPEN				
CONTACT	CLOSE	MID	OPEN	
VZSO	1-2	O	O	X
VZSC	3-4	O	X	X

NOTE:
PUMP CONTROL VALVE OPEN
CHECK VALVE CLOSED

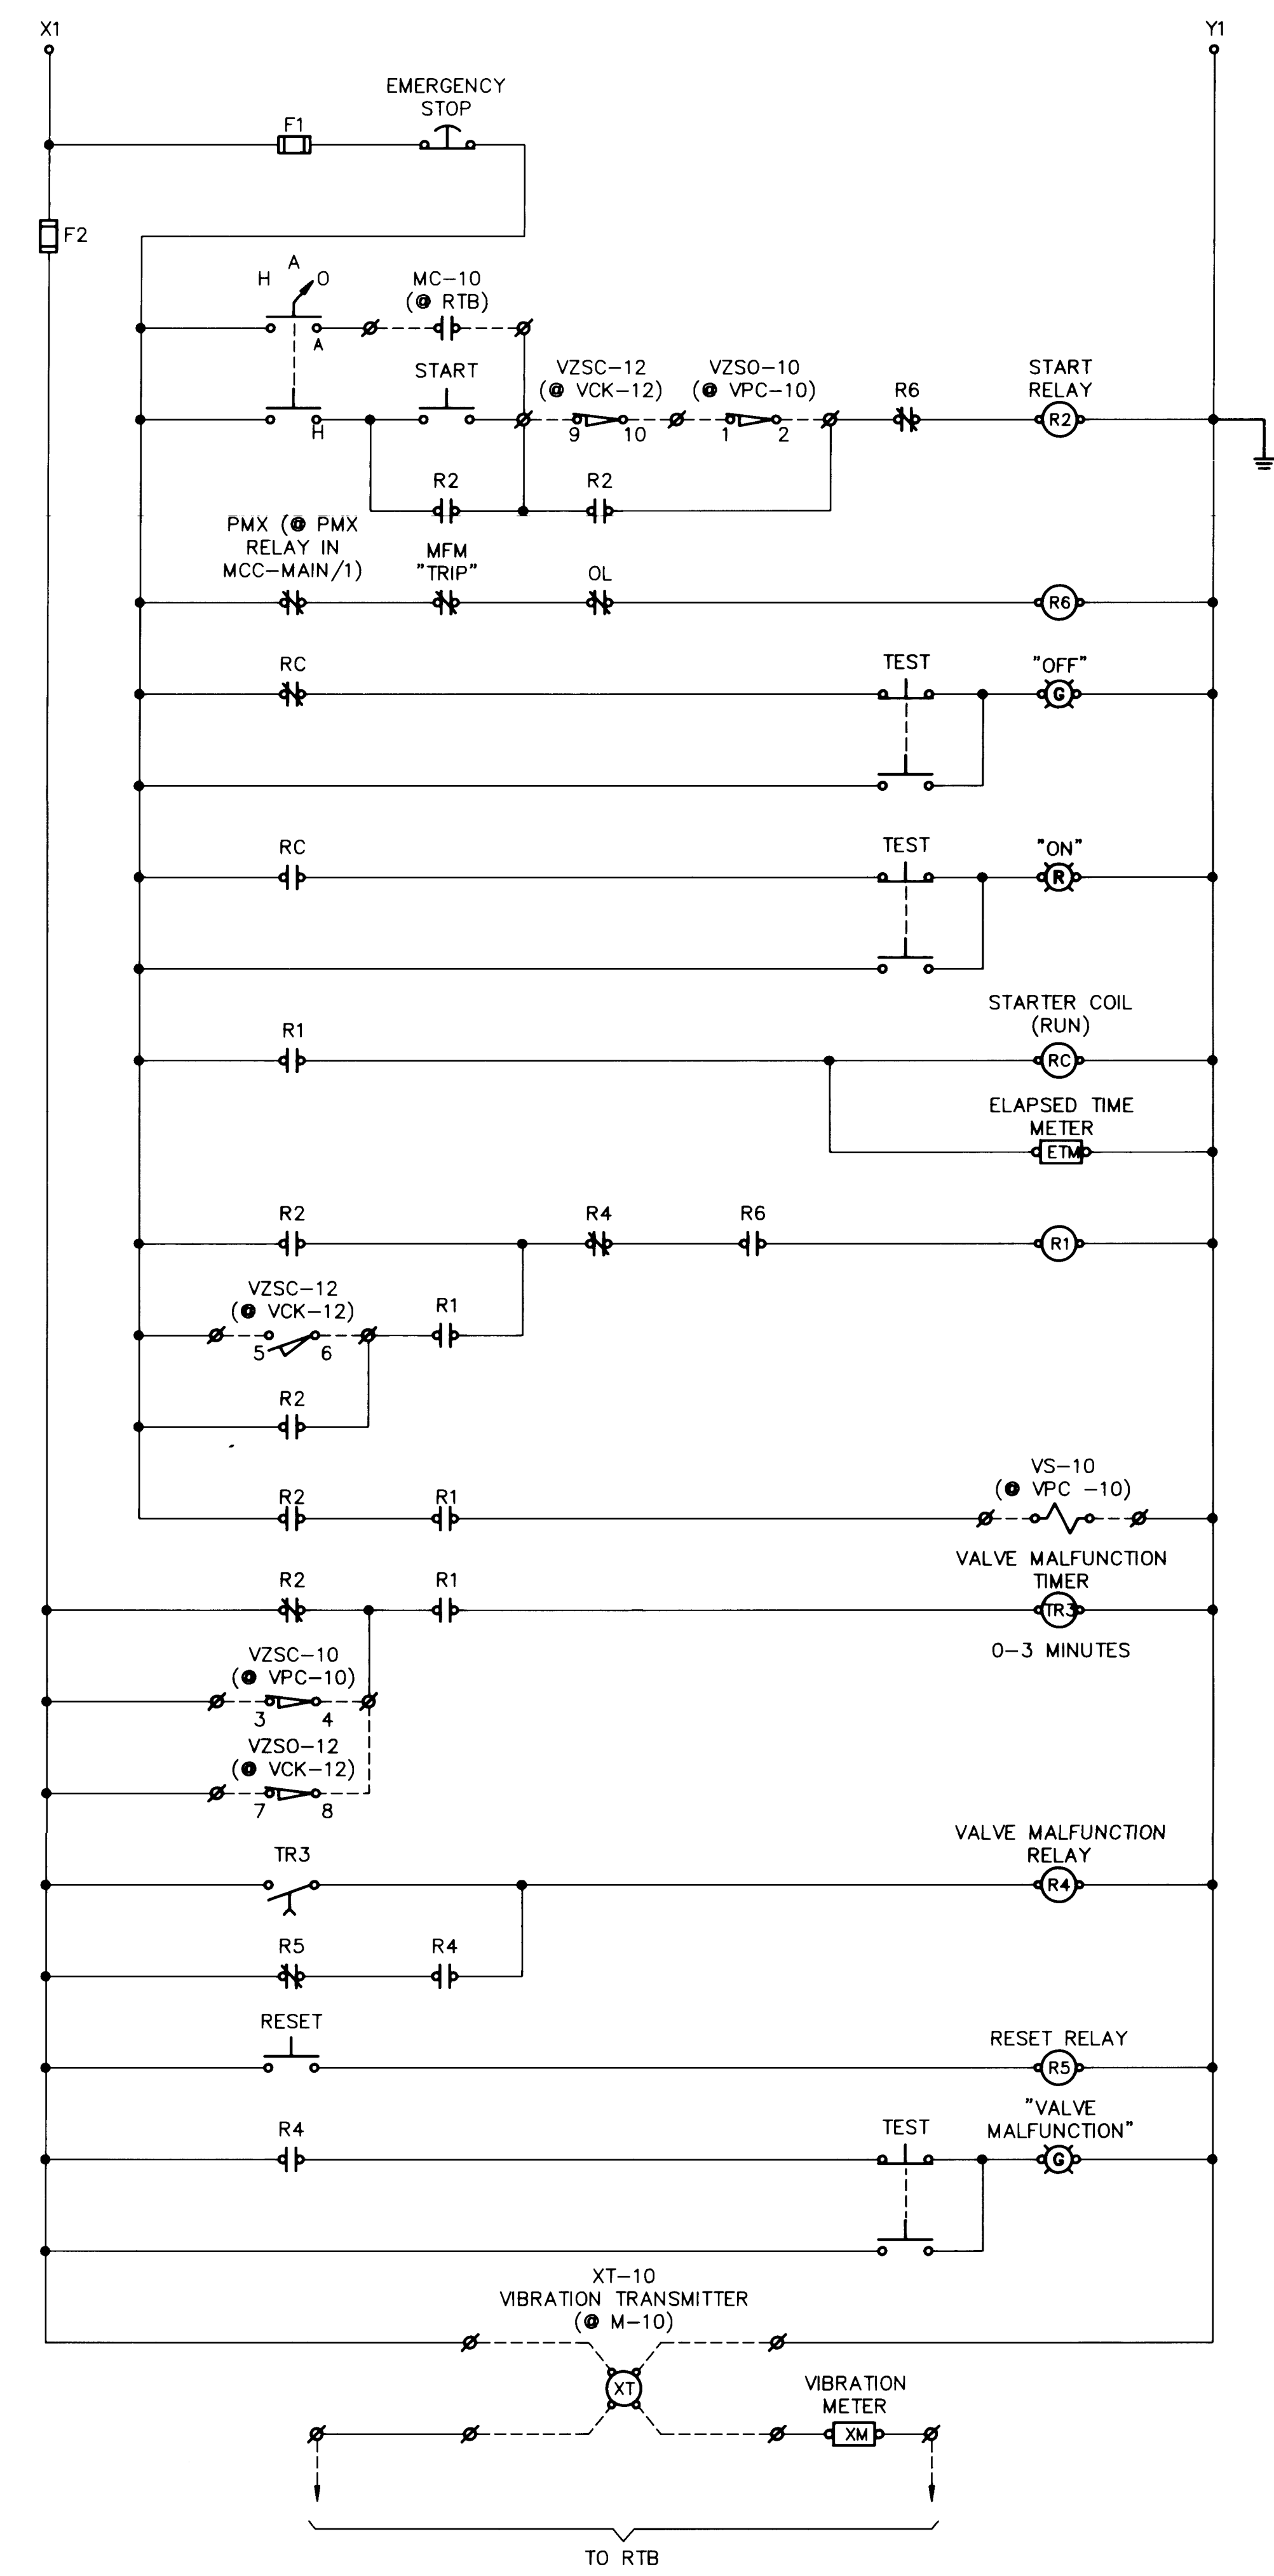

1 BOOSTER PUMP NO. 1 SCHEMATIC (MCU-10)
NO SCALE (SIMILAR FOR MCU-20, MCU-30, MCU-40)

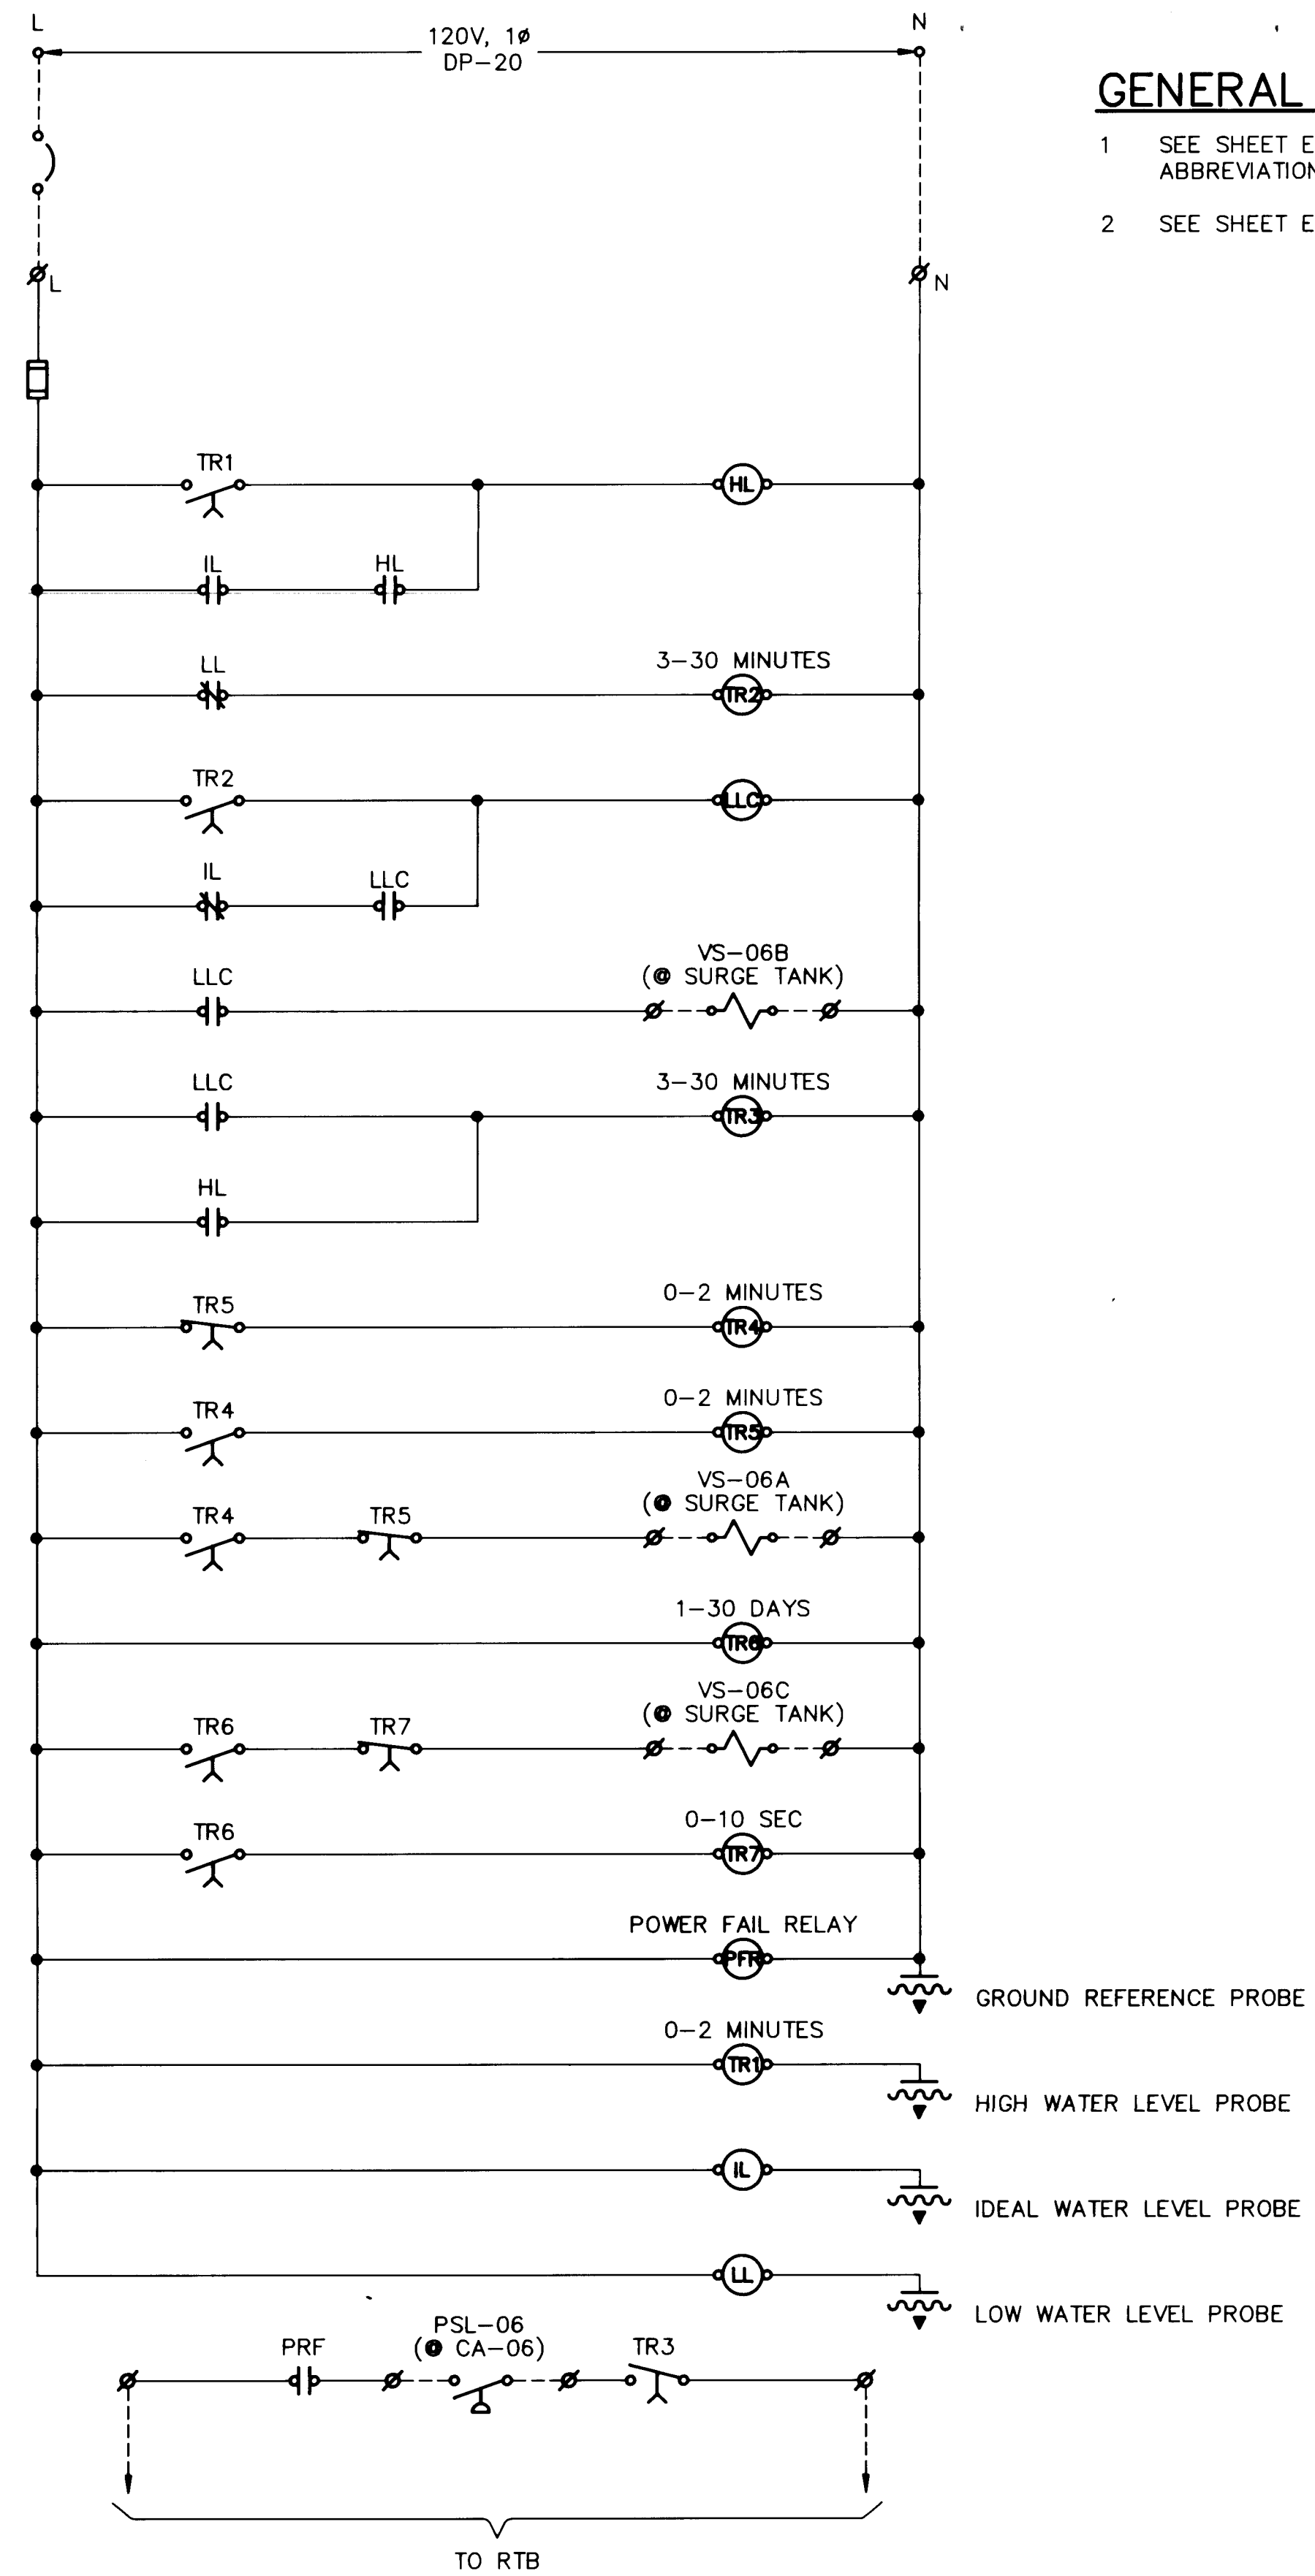

2 SURGE TANK CONTROL SYSTEM
SCHEMATIC (SP-06)
NO SCALE

THIS SHEET SUPERSEDED BY
SIMILAR SHEET MARKED "REDRAWN
FOR RECORD PURPOSES"


GENERAL NOTES
1 SEE SHEET E1 FOR SYMBOLS LEGEND AND ABBREVIATIONS LIST.
2 SEE SHEET E8 FOR SCHEDULES.

CITY OF ALBUQUERQUE PUBLIC WORKS DEPARTMENT ENGINEERING GROUP					
TITLE: GUTIERREZ PUMP STATION RECONSTRUCTION CONTROL SCHEMATICS					
APPROVALS	ENGINEER	DATE	APPROVALS	ENGINEER	DATE
DRC CHAIRMAN	<i>[Signature]</i>	11/16/90	WATER	<i>[Signature]</i>	11/13/90
TRANSPORTATION	<i>[Signature]</i>	11/16/90	WASTE WATER	<i>[Signature]</i>	11/13/90
HYDROLOGY	<i>[Signature]</i>	11/15/90			
PROJECT NO.	3337.90	MAP NO.	F-22	SHEET	OF
				E9	19

AS BUILT INFORMATION		BENCH MARKS		SURVEY INFORMATION		ENGINEER'S SEAL	
CONTRACTOR				FIELD NOTES			
WORK STARTED BY		DATE		BY	DATE		
WORK STOPPED BY		DATE		NO.			
WORK RESUMED BY		DATE					
WORK COMPLETED BY		DATE					
WORK CORRECTED BY		DATE					
WORK RECORDED BY		DATE					
WORK NO.							



NOTE: ISOLATION VALVES SHOWN IN CLOSED POSITION

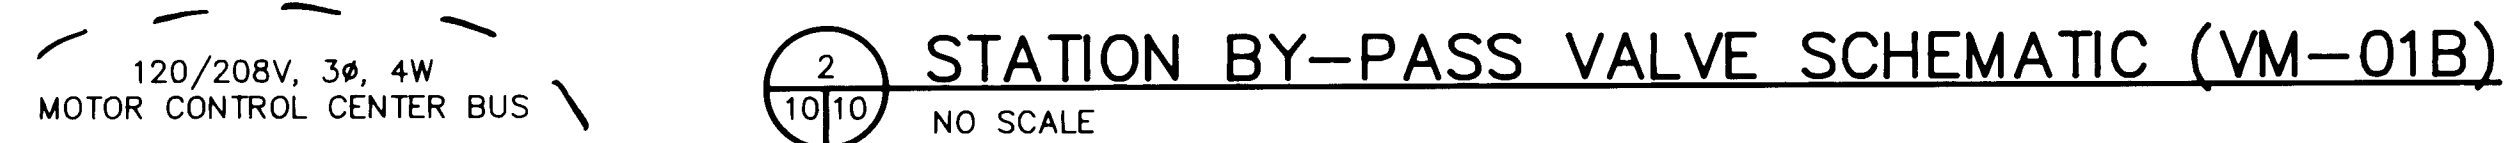

RECORD DRAWING
Date FFF 1992
These drawings have been revised based on field data and every reasonable attempt has been made to depict construction as actually performed.

REDRAWN FOR RECORD PURPOSES

26 3337,903/92



CITY OF ALBUQUERQUE
PUBLIC WORKS DEPARTMENT
ENGINEERING GROUP

TITLE: GUTIERREZ PUMP STATION RECONSTRUCTION
CONTROL SCHEMATICS

PROJECT NO.	3337.90	MAP NO.	F-22	SHEET OF	E10 19
-------------	---------	---------	------	----------	--------


A	2-92	SCHEMATIC REVISION	LH		
NO.	DATE	REMARKS	BY		
<i>REVIEWS</i>					
DESIGN					
DESIGNED BY	D. DOZIER	DATE	NOV. 9, 1990		
DRAWN BY	P. SCHWITTE				
					

1 SEE SHEET E1 FOR SYMBOLS LEGEND AND ABBREVIATIONS LIST.
2 SEE SHEET E8 FOR SCHEDULES.

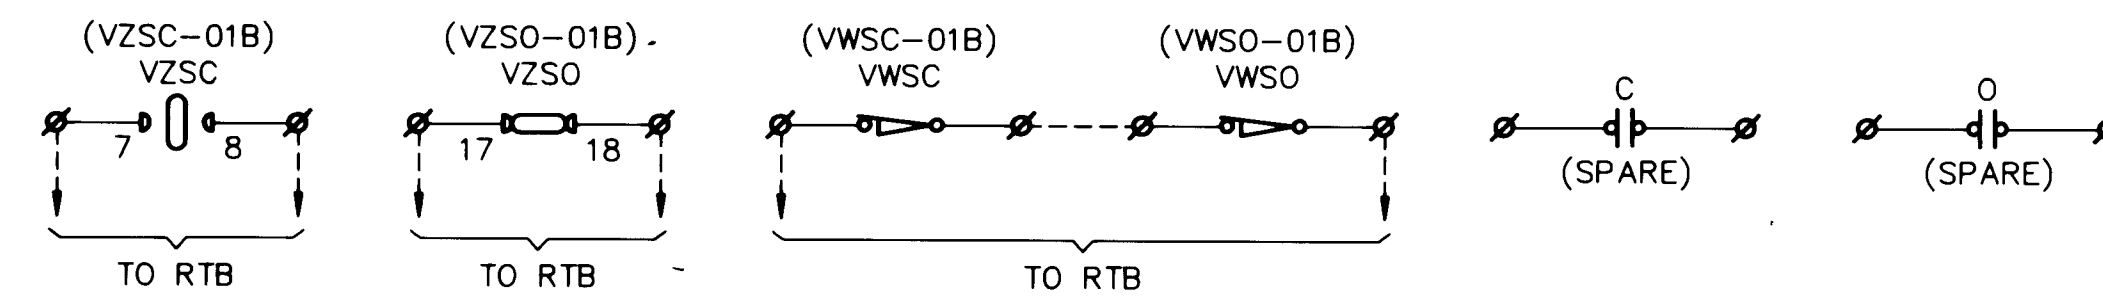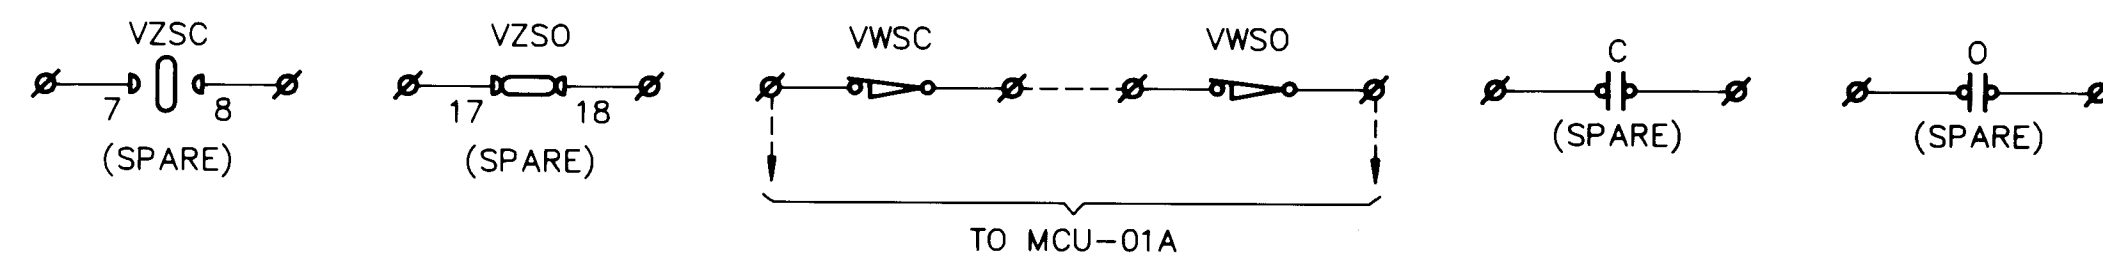

NO SCALE (SIMILAR FOR BOOSTER PUMP DISCHARGE ISOLATION VALVES VM-10, VM-20, VM-30, AND VM-40)
(SIMILAR FOR STATION DISCHARGE ISOLATION VALVE VM-02)
(SIMILAR FOR ZONE TRANSFER ISOLATION VALVE VM-79)

NOTE: ISOLATION VALVES SHOWN IN CLOSED POSITION

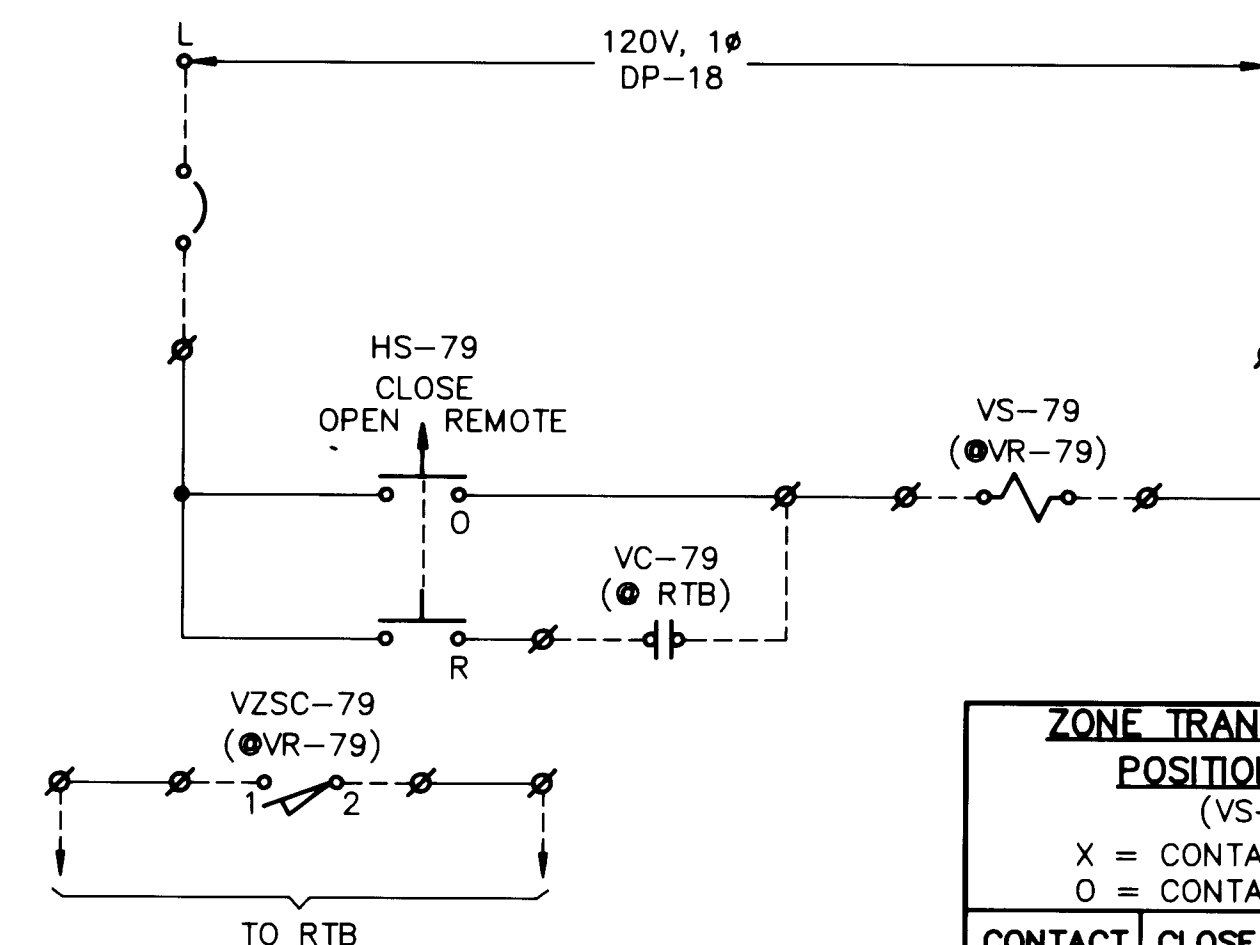

CONTACT		CLOSE	MID	OPEN
VZSC	1-2	O	X	X


10 10 NO SCALE

10 10 NO SCALE


REPORT

THIS SHEET SUPERSEDED BY
SIMILAR SHEET MARKED "REDRAWN
FOR RECORD PURPOSES"


CITY OF ALBUQUERQUE PUBLIC WORKS DEPARTMENT ENGINEERING GROUP					
TITLE: GUTIERREZ PUMP STATION RECONSTRUCTION CONTROL SCHEMATICS					
APPROVALS	ENGINEER	DATE	APPROVALS	ENGINEER	DATE
DRG CHAIRMAN	<i>[Signature]</i>	11/16/90	WATER	<i>R.W. Kame</i>	11-13-90
TRANSPORTATION	<i>N/A RWD</i>	11-16-90	WASTE WATER	<i>R.W. Kame</i>	11-13-90
HYDROLOGY	<i>QW</i>	11-15-90			
PROJECT NO. 3337.90		MAP NO. F-22	SHEET OF 19		

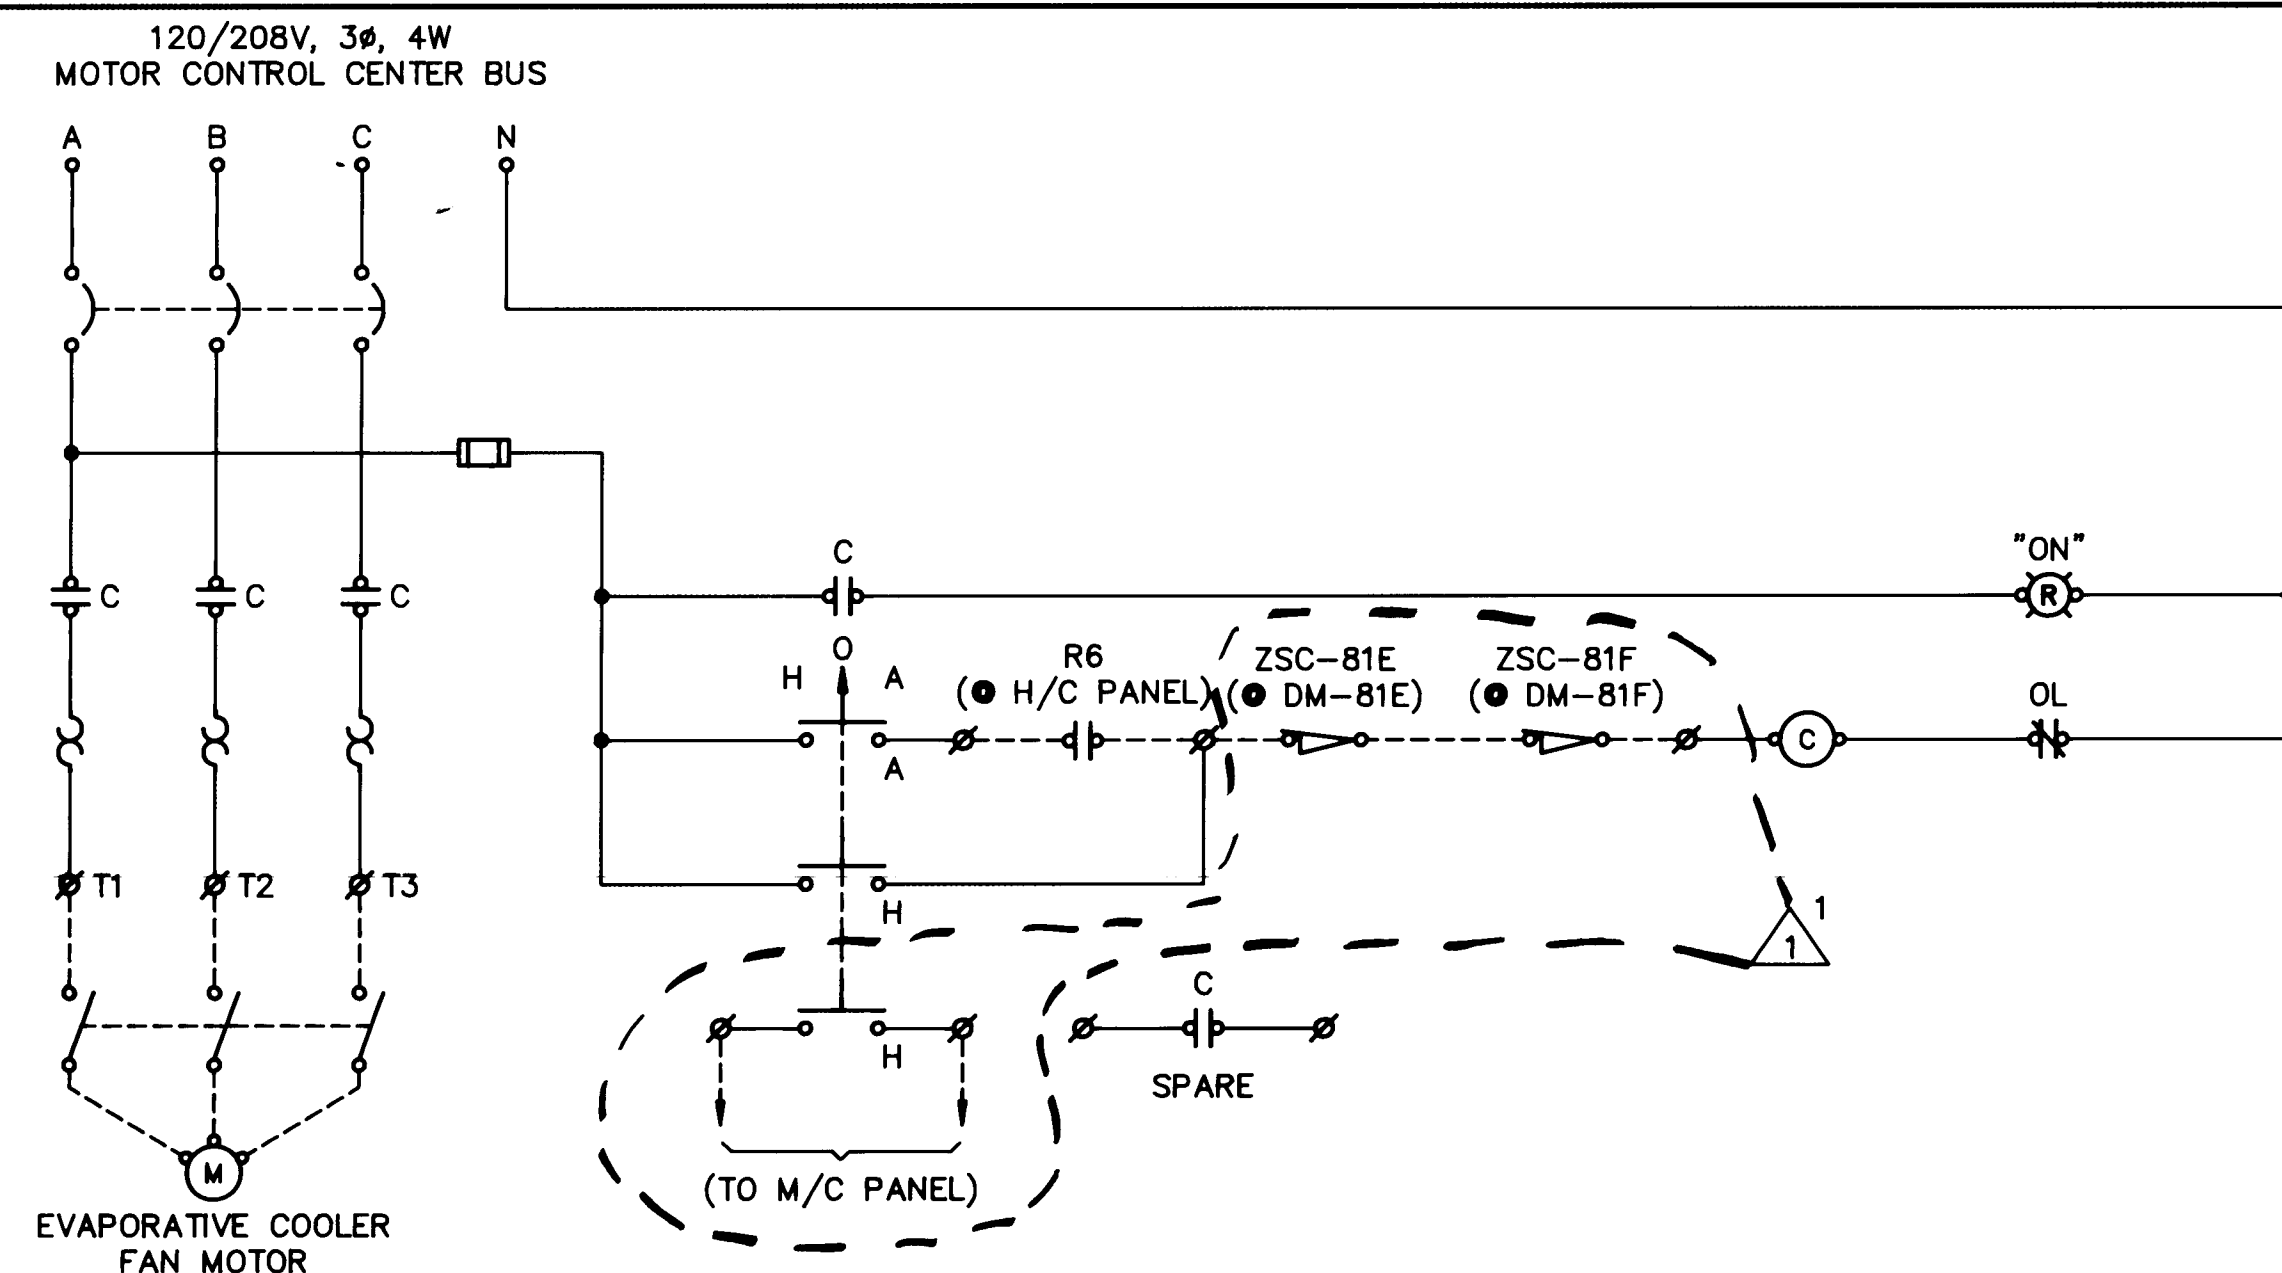


1 EVAPORATIVE COOLER FAN SCHEMATIC
11/11 NO SCALE (TYPICAL FOR MCU-82A1 AND MCU-82B1)

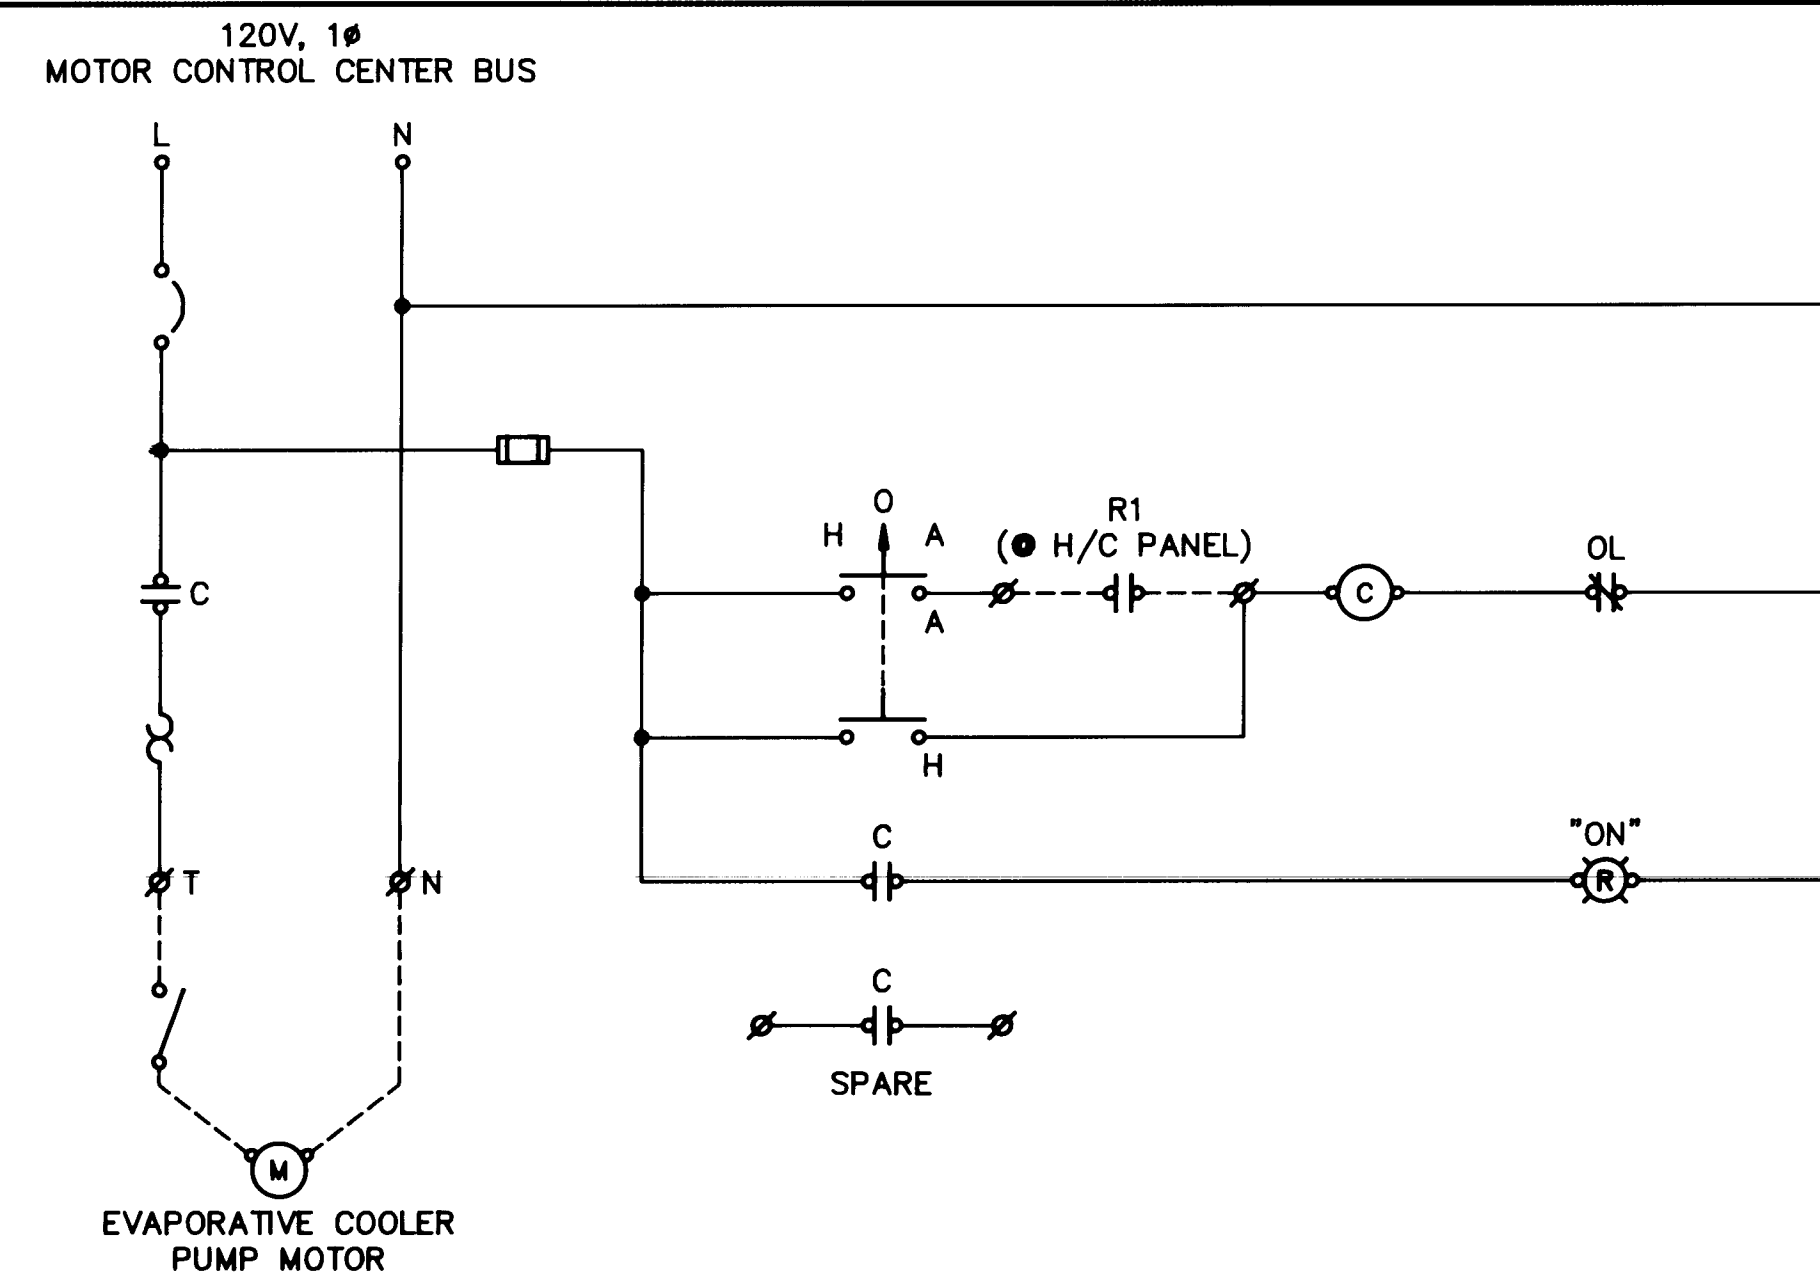



2 EVAPORATIVE COOLER PUMP SCHEMATIC
1111 NO SCALE (TYPICAL FOR MCU-82A2 AND MCU-82B2)

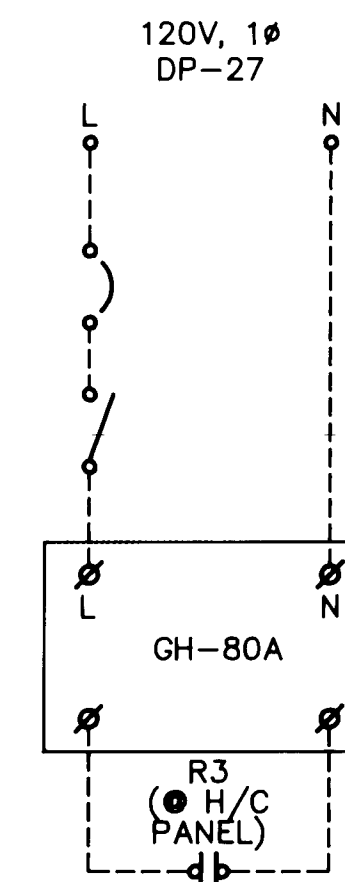


5 GAS HEATER NO. 1 SCHEMATIC (GH-80A)
 11/11 NO SCALE (SIMILAR FOR GH-80B, GH-80C, AND GH-80D)

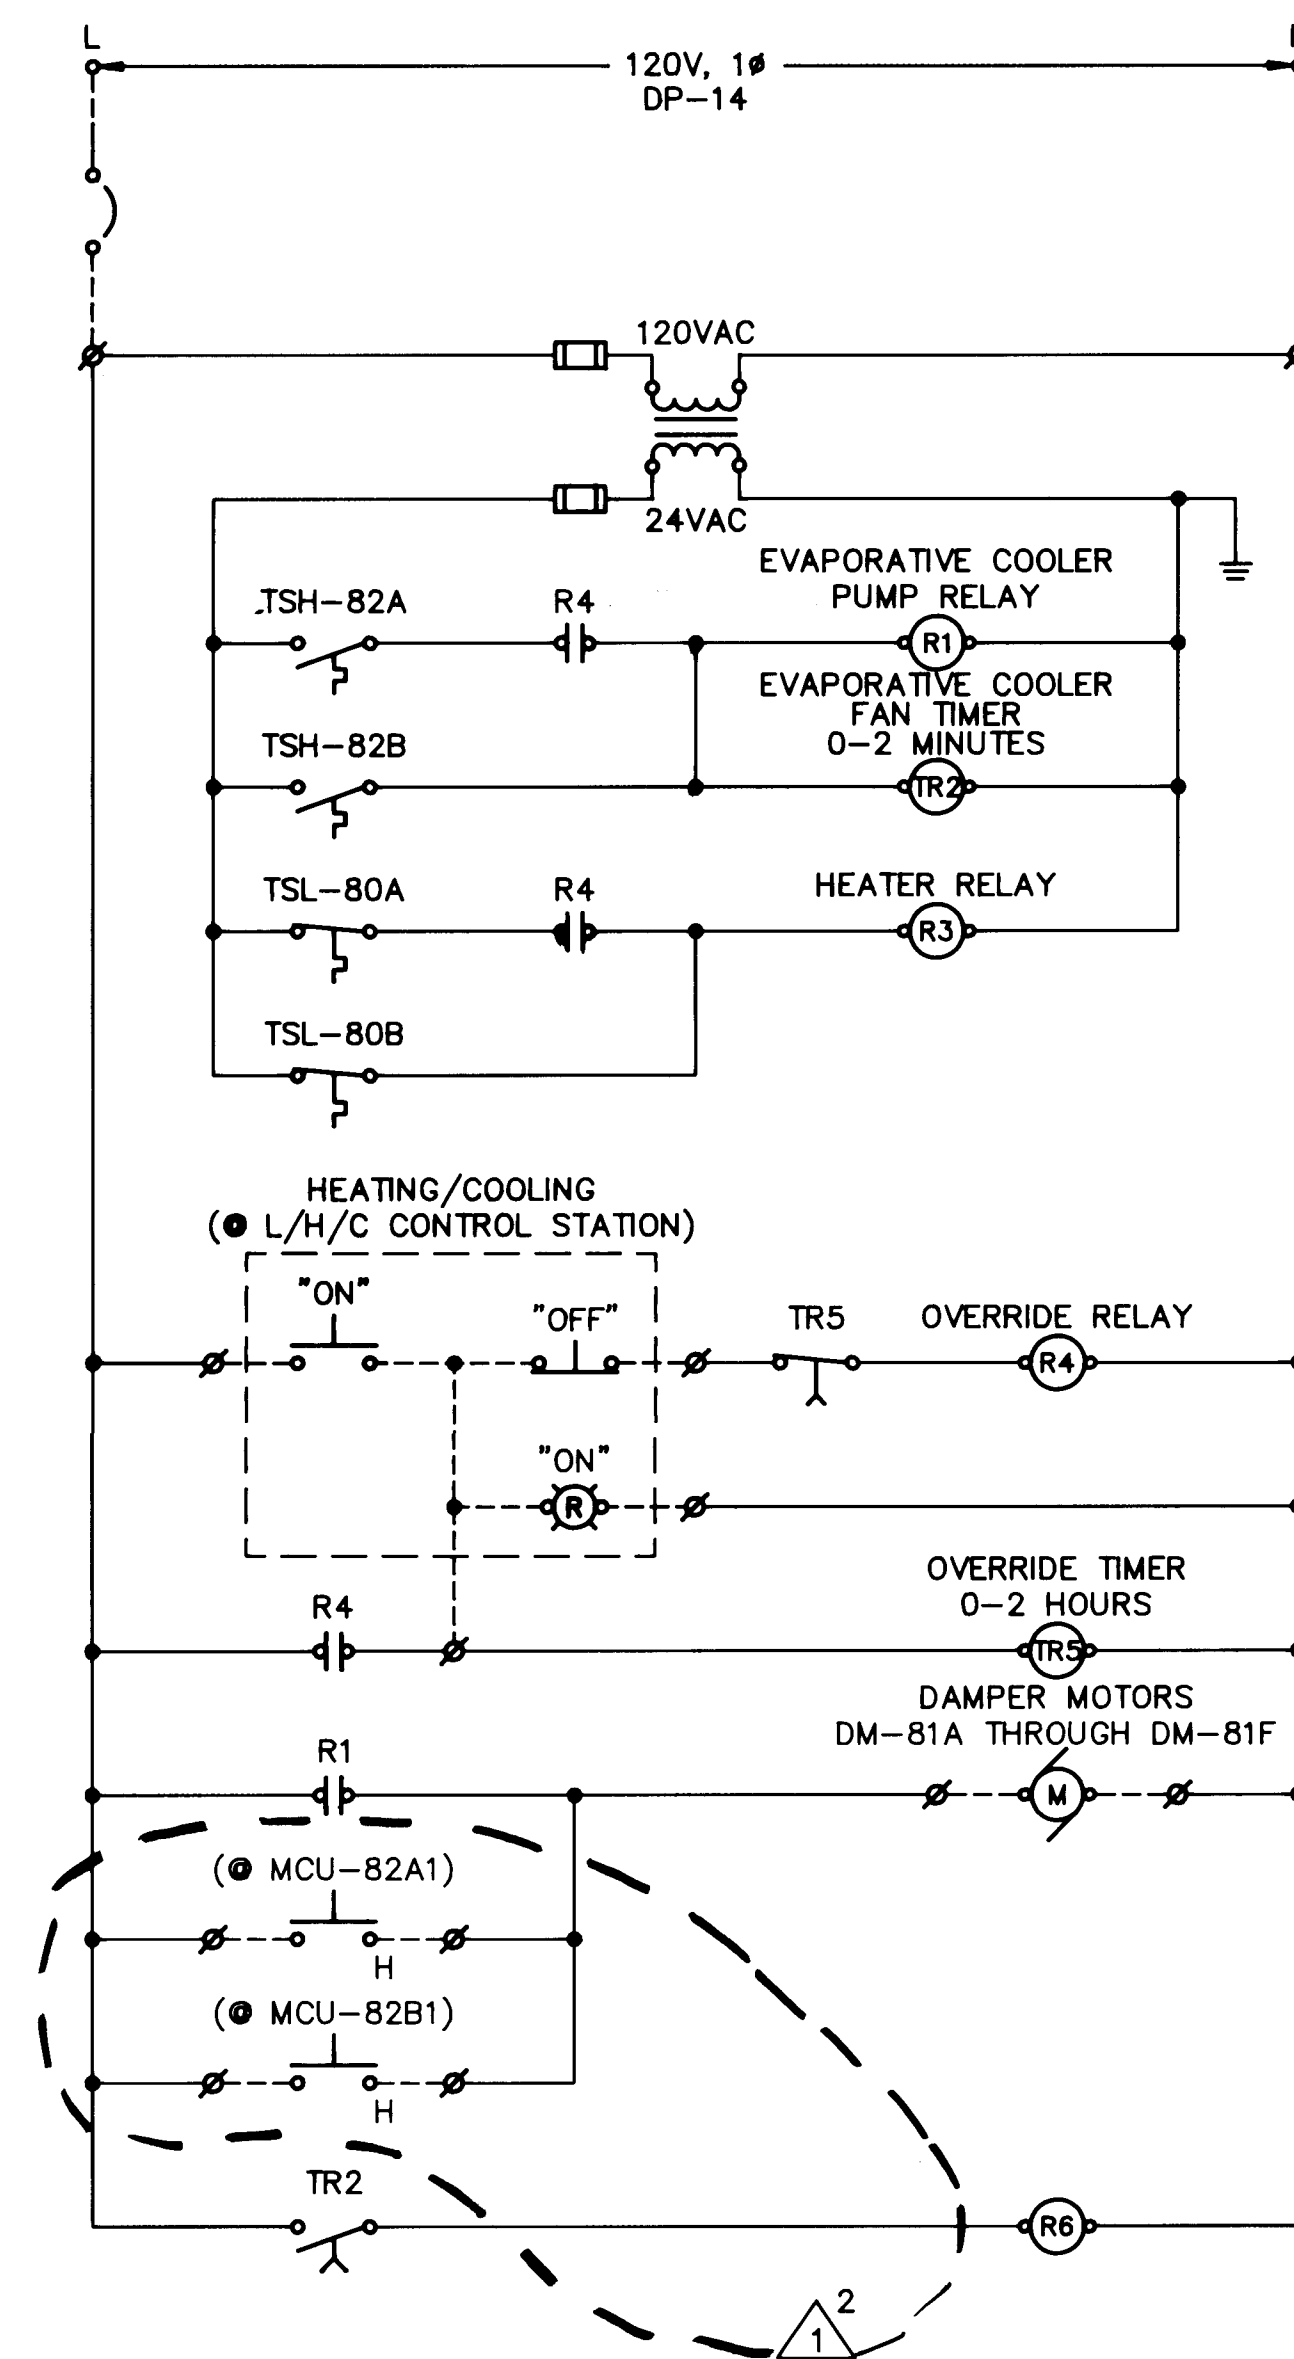

3 HEATING/COOLING (H/C) CONTROL PANEL SCHEMATIC
4 11 NO SCALE
5

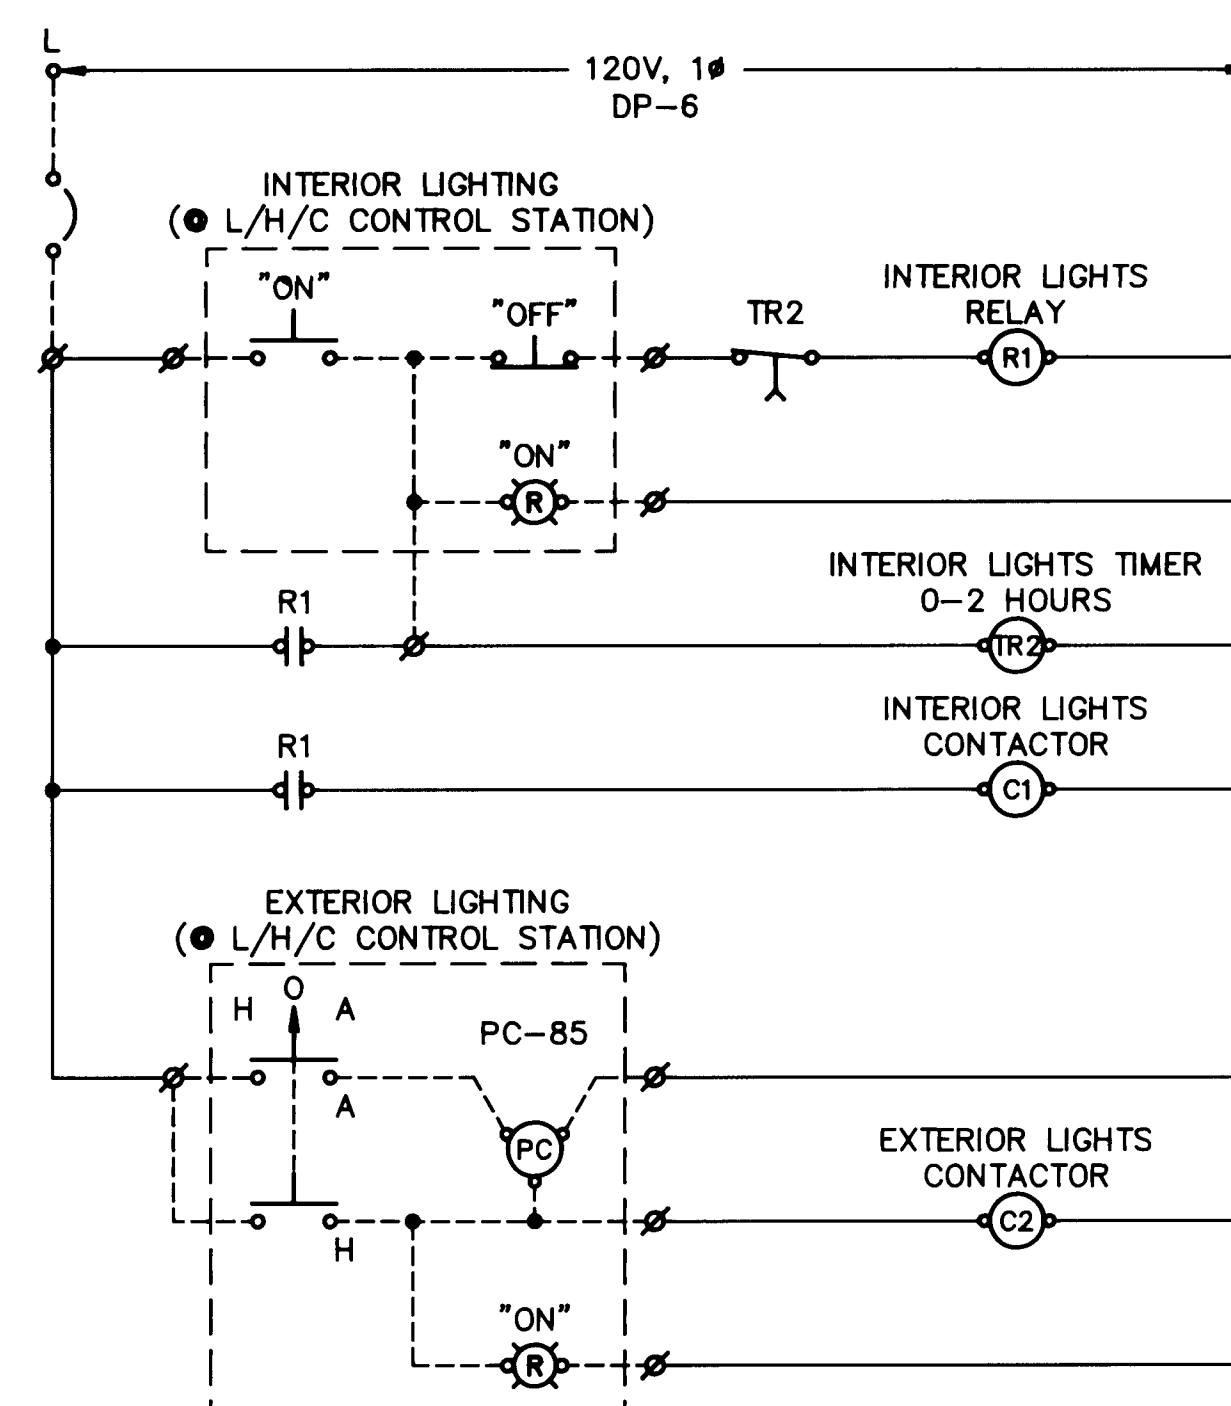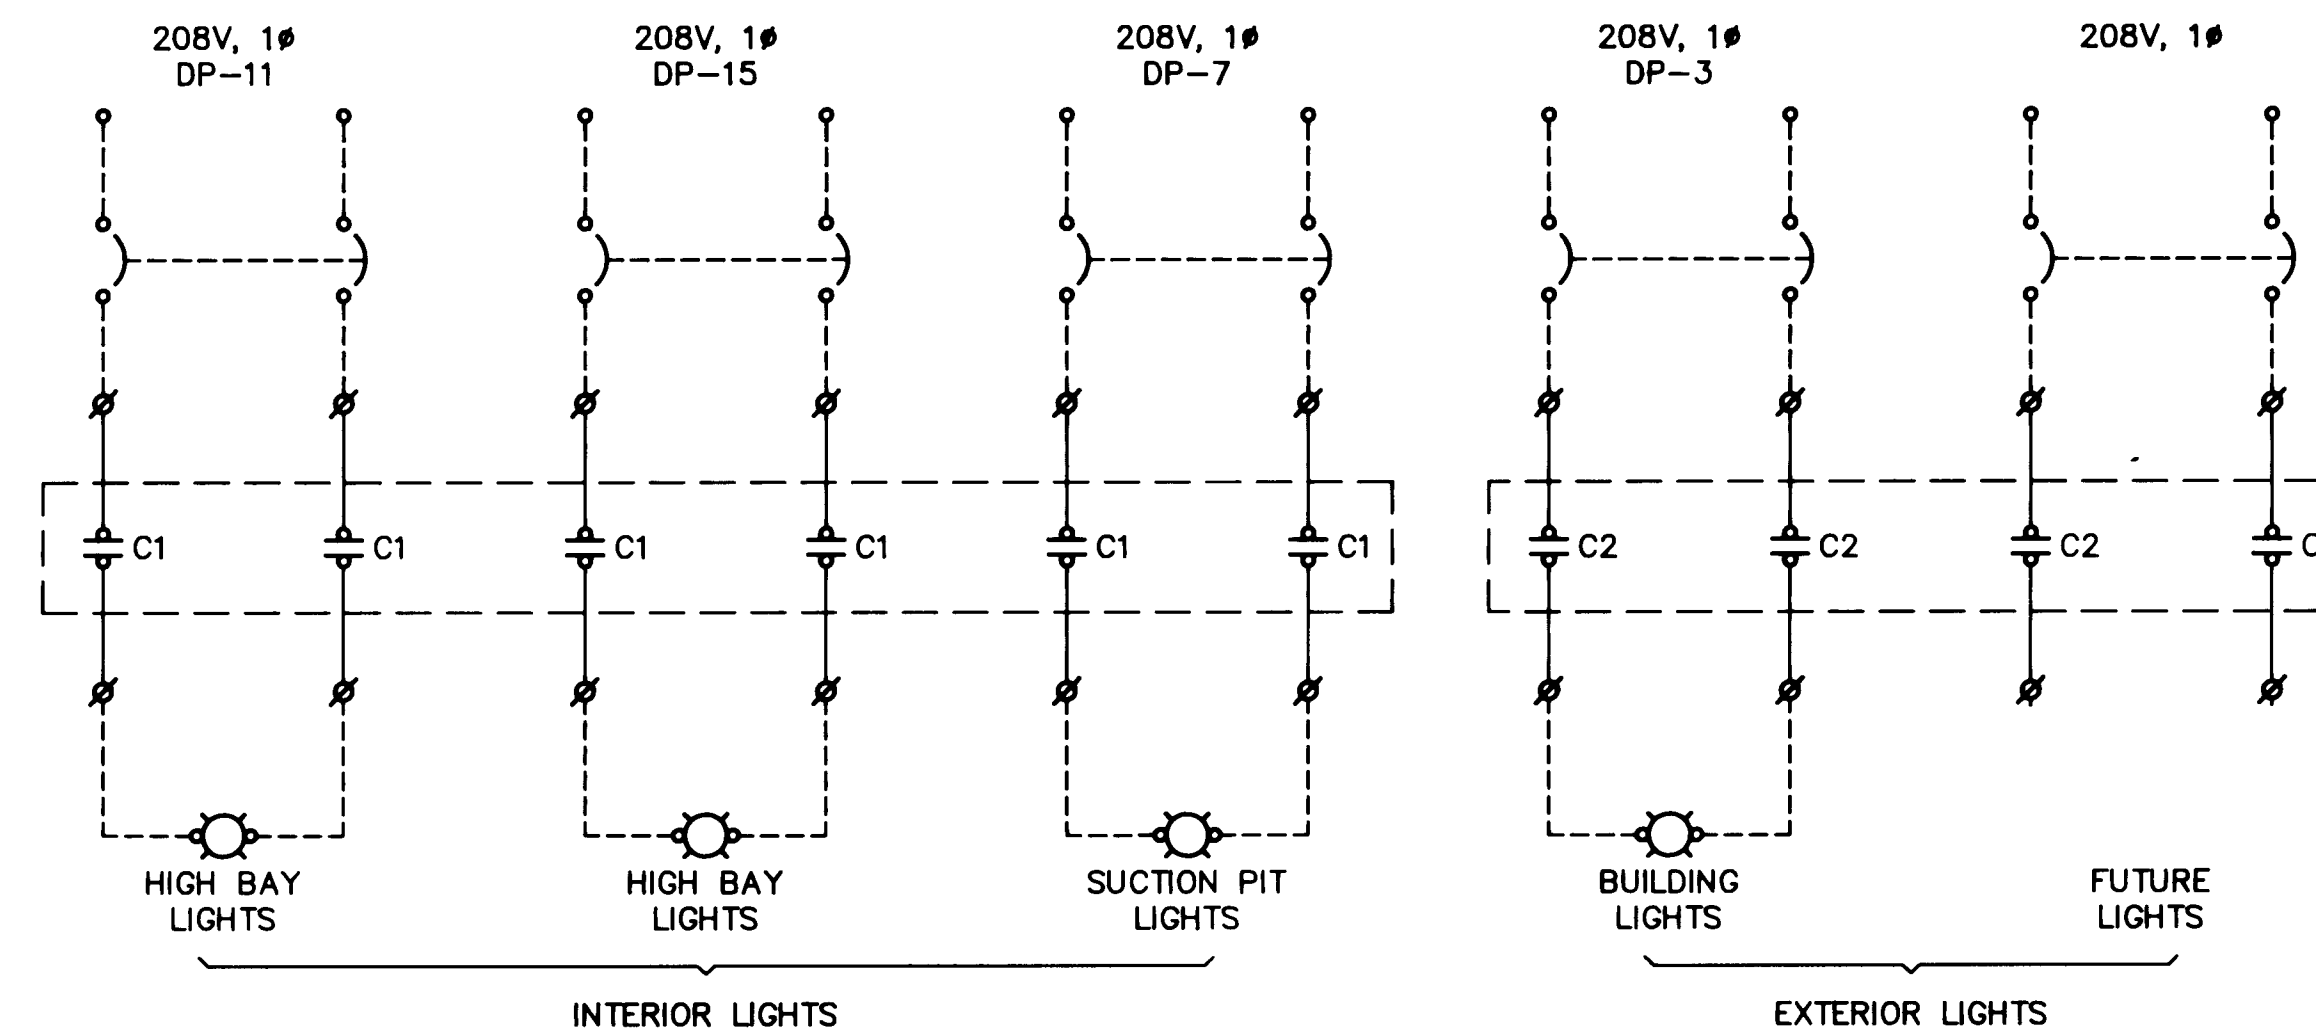

4 LIGHTING CONTROL PANEL SCHEMATIC
4 11 NO SCALE
5

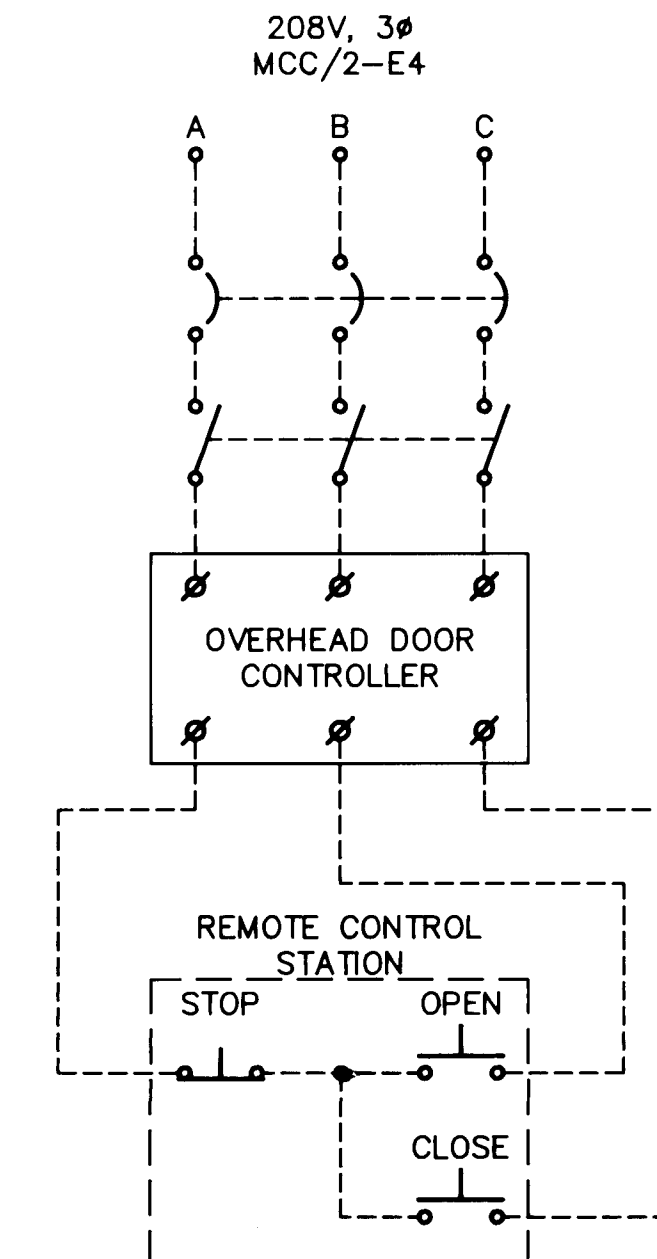

6 OVERHEAD DOOR CONTROLLER SCHEMATIC
11 11 NO SCALE

REDRAWN FOR RECORD PURPOSES


802621GED1/G8026E13

CITY OF ALBUQUERQUE PUBLIC WORKS DEPARTMENT ENGINEERING GROUP					
TITLE: CUTTEREZ PUMP STATION RECONSTRUCTION CONTROL SCHEMATICS					
APPROVALS	ENGINEER	DATE	APPROVALS	ENGINEER	DATE
DRC CHAIRMAN			WATER		
TRANSPORTATION			WASTE WATER		
HYDROLOGY					
PROJECT NO. 3337.90		MAP NO. F-22		SHEET F11 OF 19	

RECORD DRAWING
FEB 1992

These drawings have been revised based on field data and every reasonable attempt has been made to depict construction as actually performed.


1 2 3 4 5 6 7 8 9 10 11 12 13 14 15
26 3337, 903392

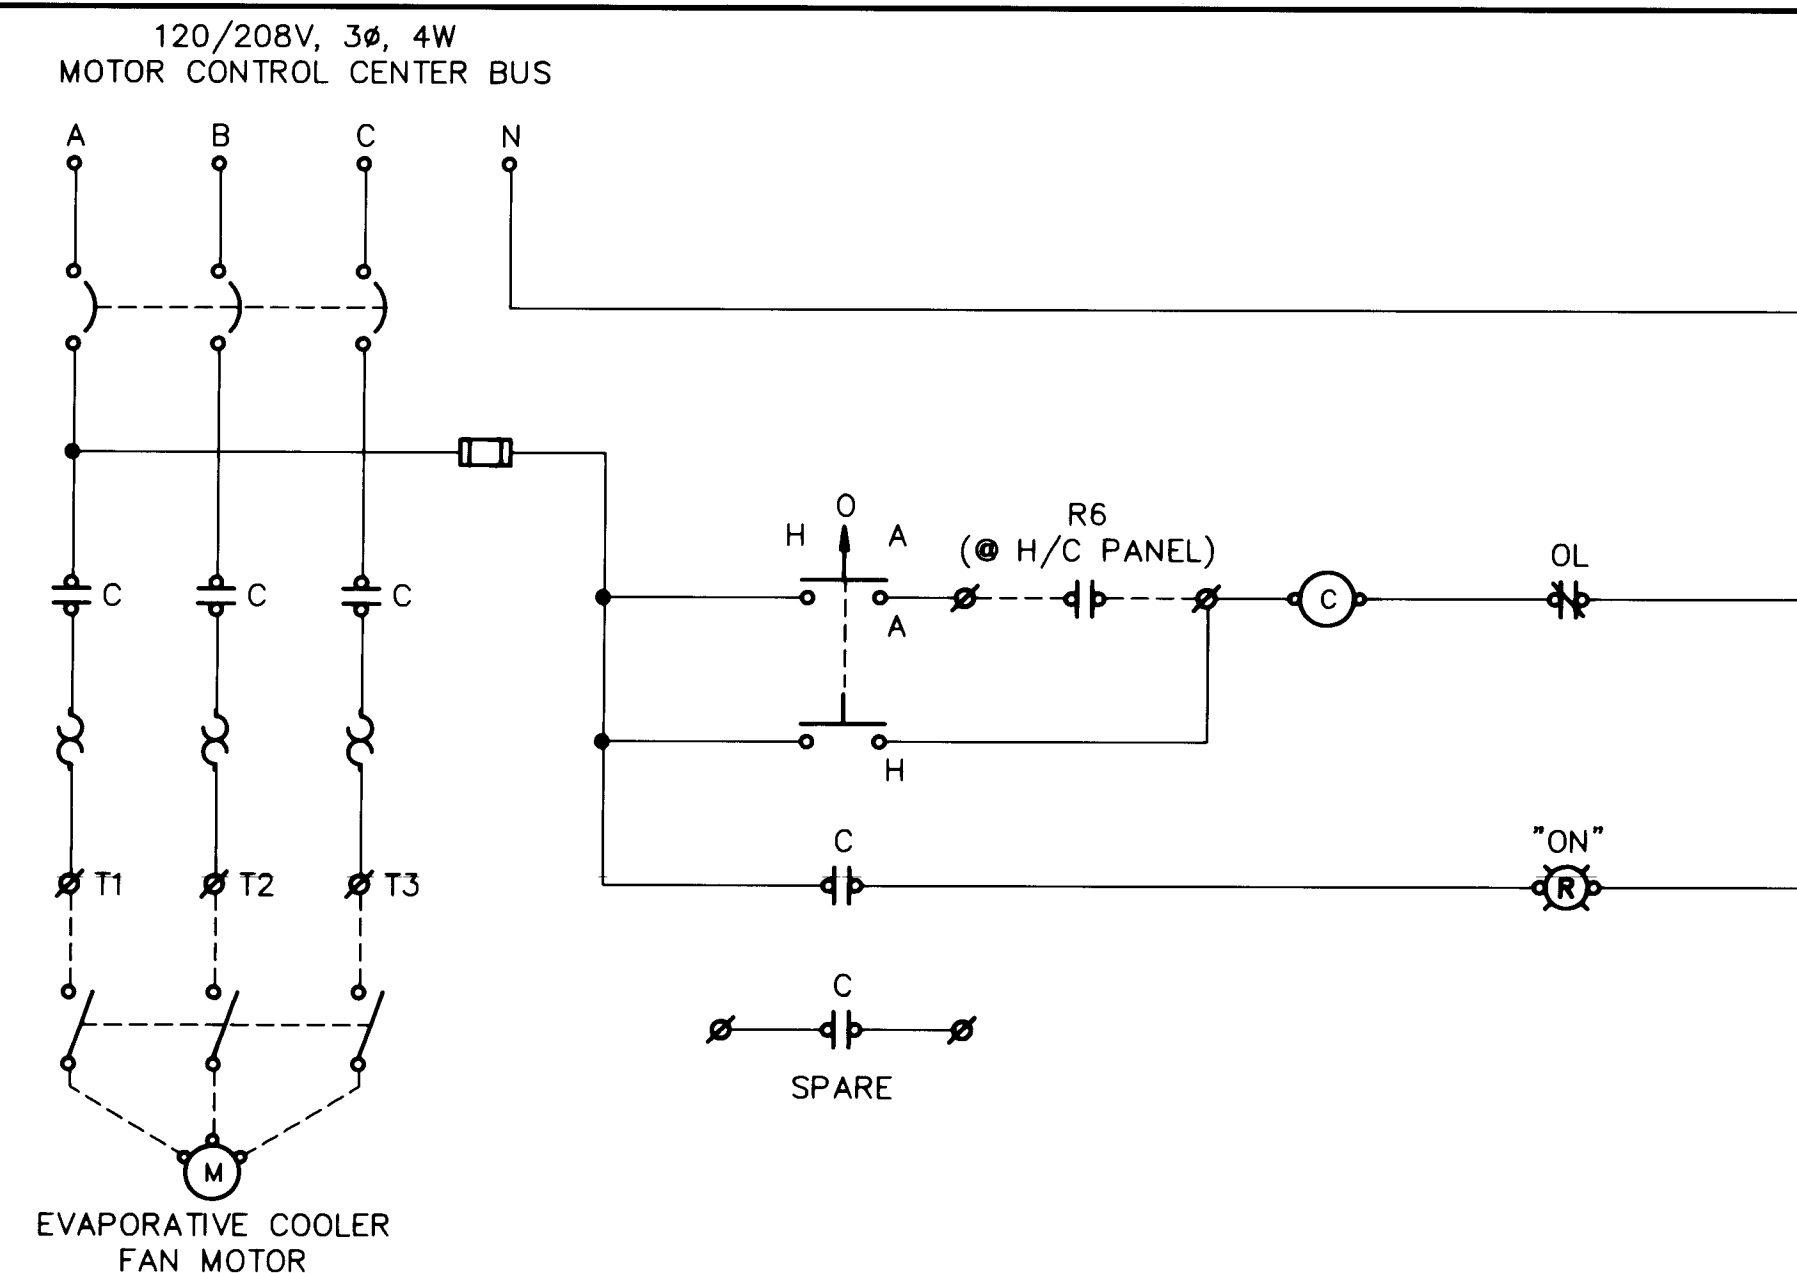

1
11 11

EVAPORATIVE COOLER FAN SCHEMATIC


NO SCALE (TYPICAL FOR MCU-82A1 AND MCU-82B1)

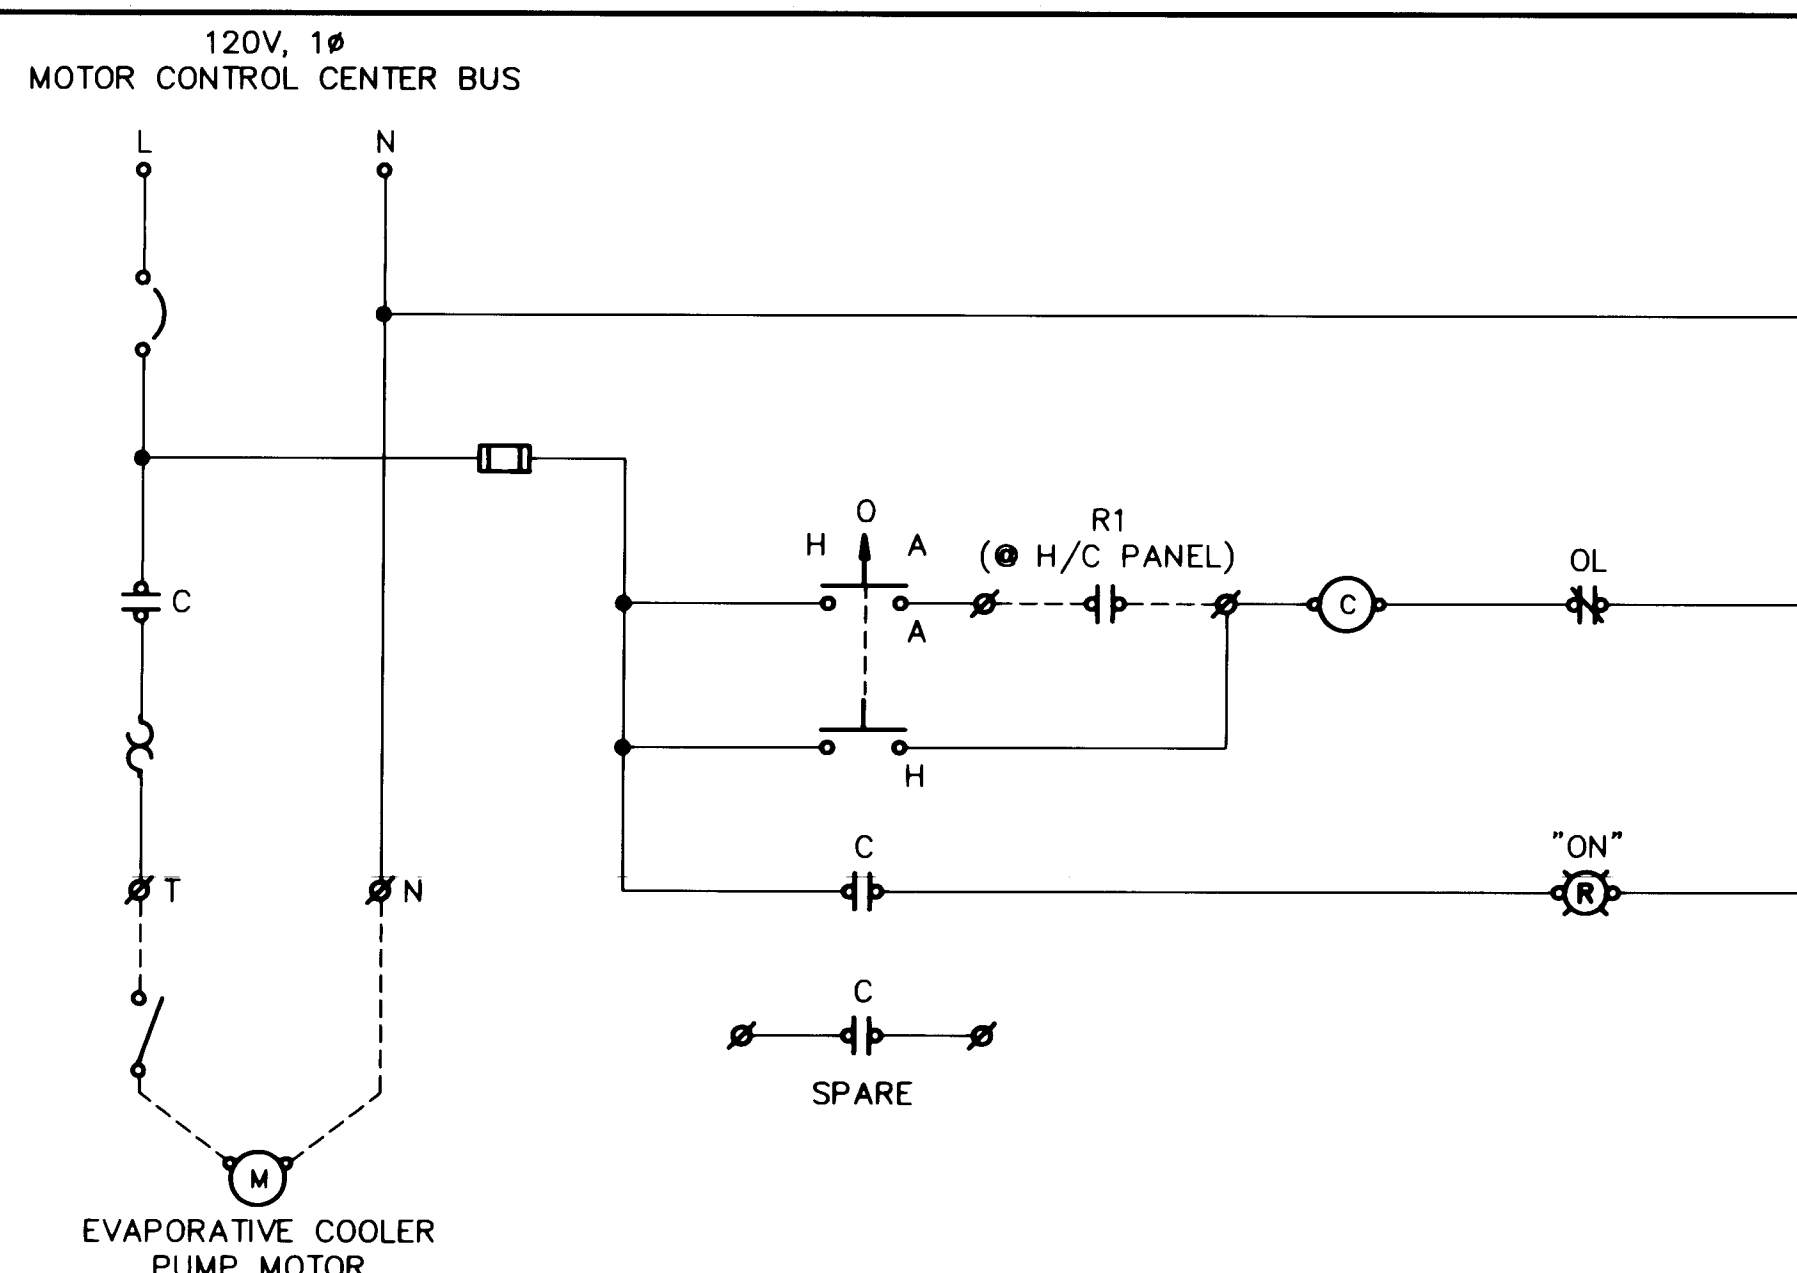

2 EVAPORATIVE COOLER PUMP SCHEMATIC
11 11 NO SCALE (TYPICAL FOR MCU-82A2 AND MCU-82B2)





- 1 SEE SHEET E1 FOR SYMBOLS LEGEND AND ABBREVIATIONS LIST.
- 2 SEE SHEET E8 FOR SCHEDULES.


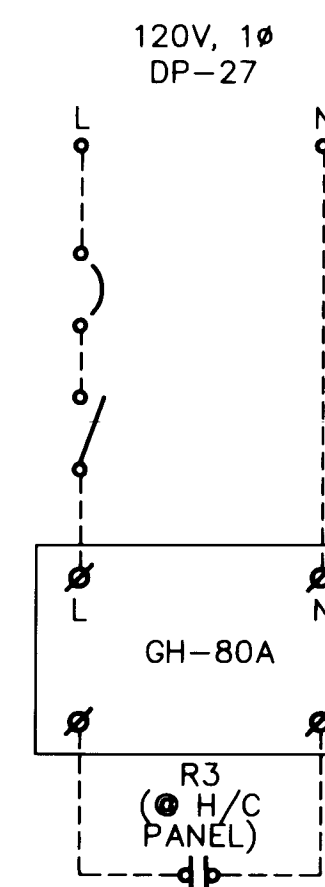


5
 11 | 11


GAS HEATER NO. 1 SCHEMATIC (GH-80A)
 NO SCALE (SIMILAR FOR GH-80B, GH-80C, AND GH-80D)

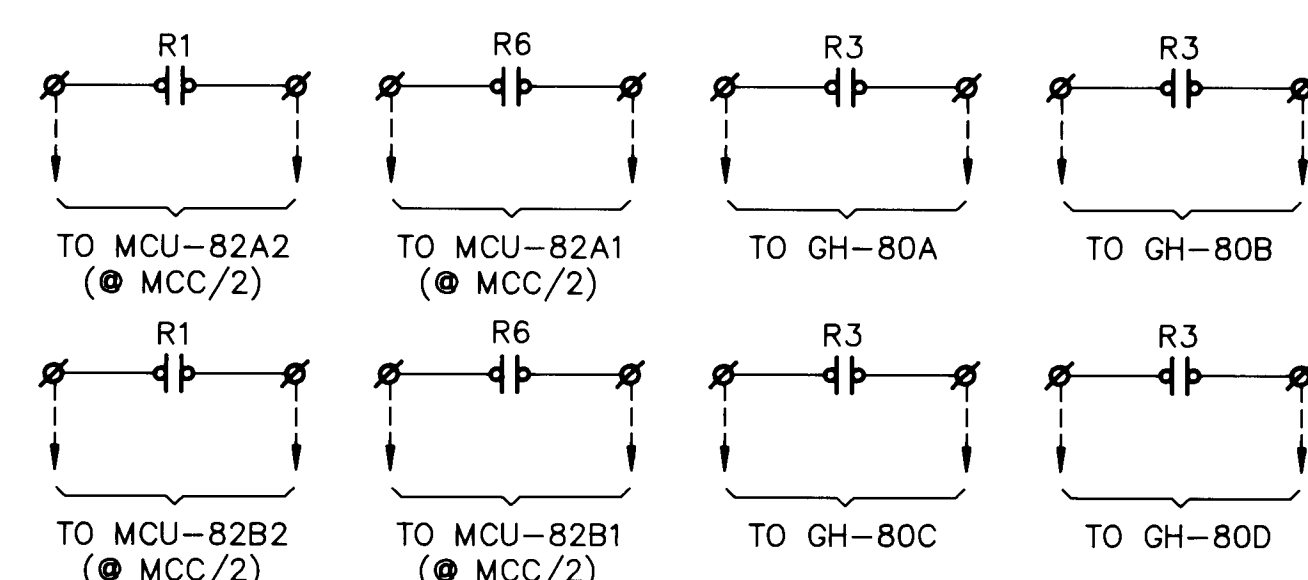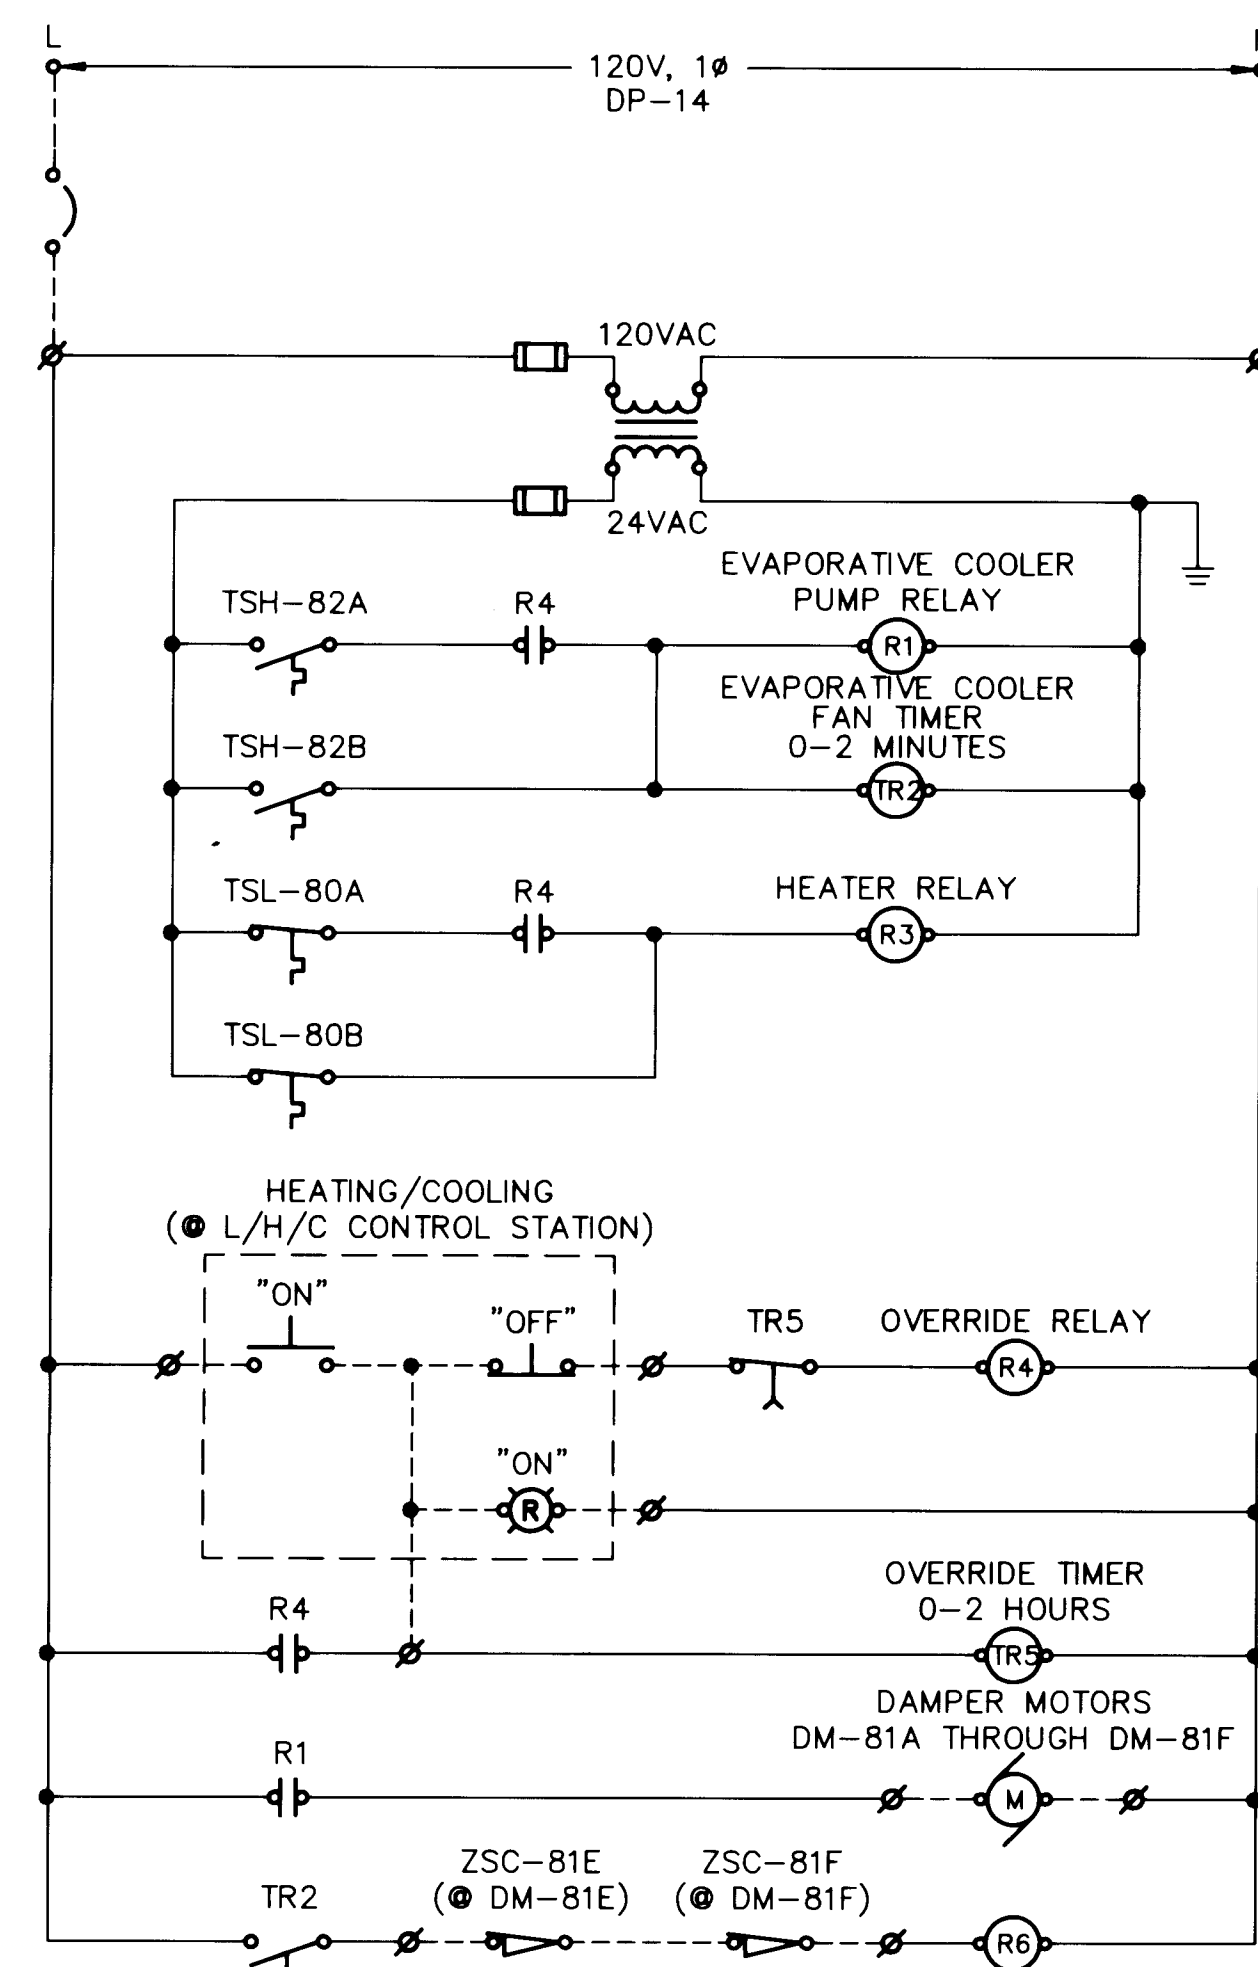

3 HEATING/COOLING (H/C) CONTROL PANEL SCHEMATIC
4 11 NO SCALE
5

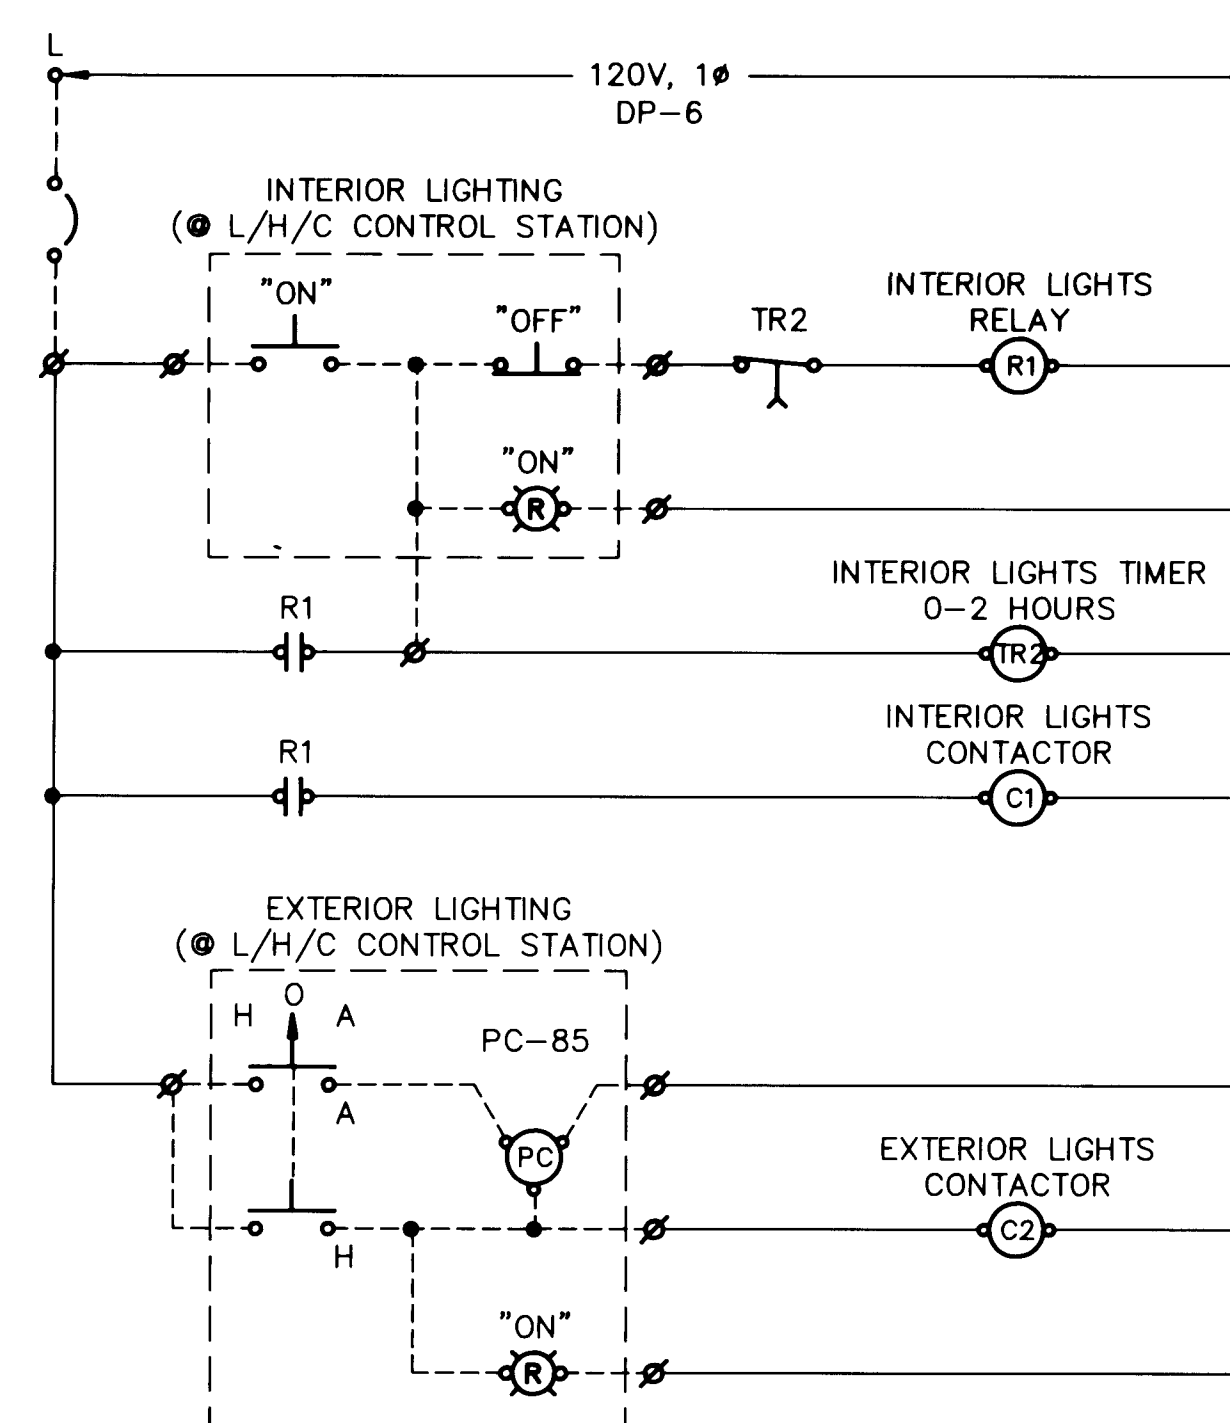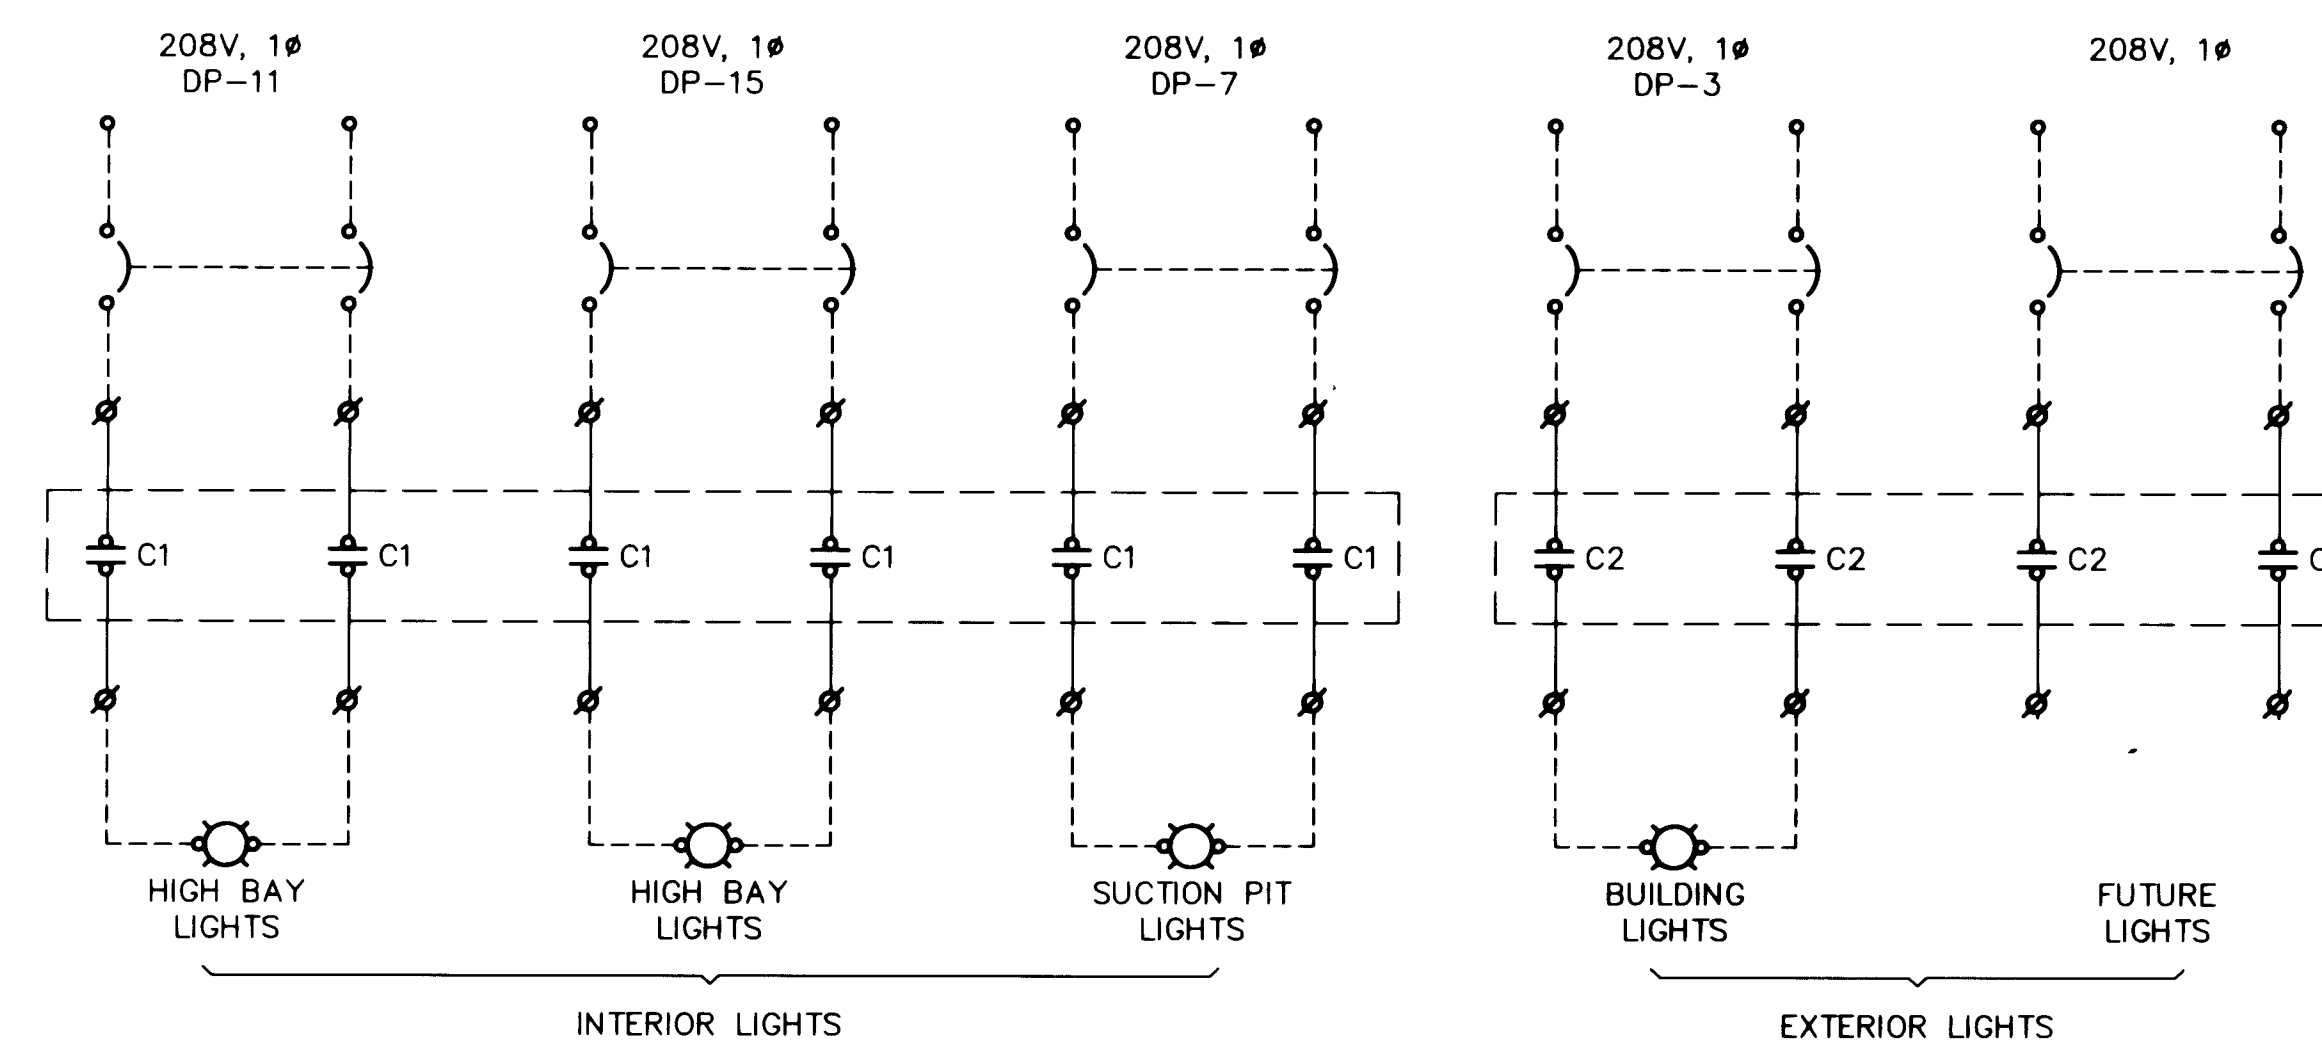

4 LIGHTING CONTROL PANEL SCHEMATIC
4 11 NO SCALE
5

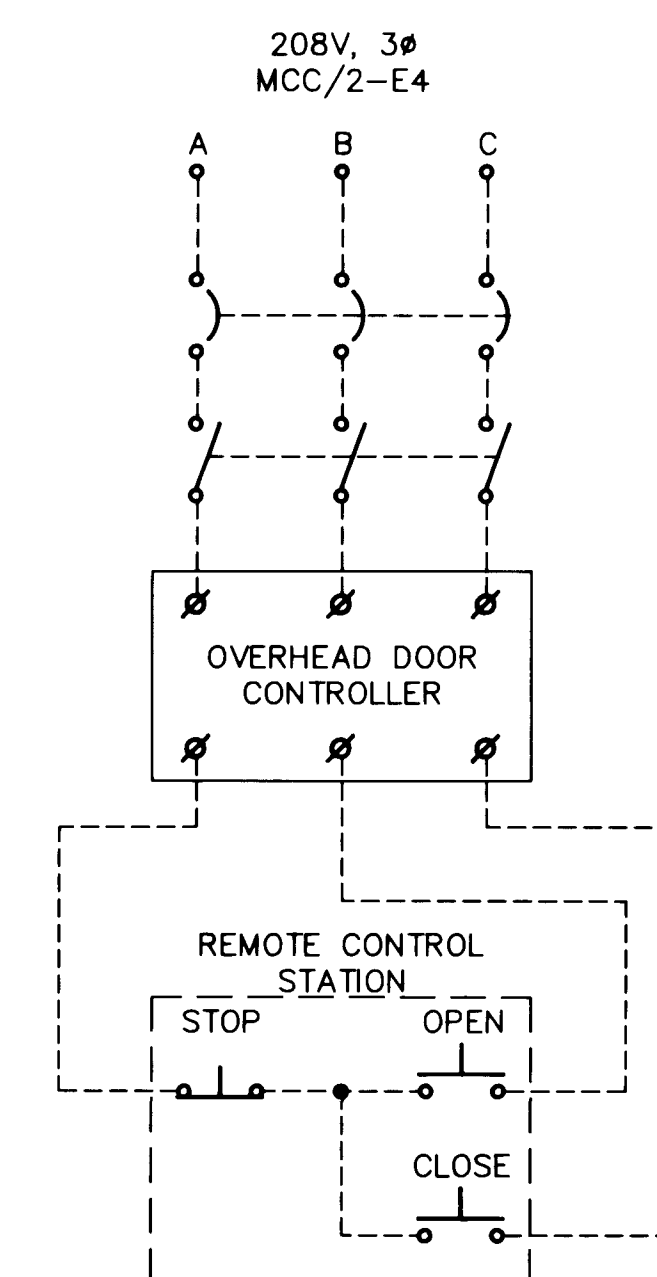




6 OVERHEAD DOOR CONTROLLER SCHEMATIC
11 11 NO SCALE

THIS SHEET SUPERSEDED BY
SIMILAR SHEET MARKED "REDRAWN
FOR RECORD PURPOSES"

802621 GED1 / G8026E13 CITY OF ALBUQUERQUE PUBLIC WORKS DEPARTMENT ENGINEERING GROUP					
TITLE: GUTIERREZ PUMP STATION RECONSTRUCTION CONTROL SCHEMATICS					
APPROVALS	ENGINEER	DATE	APPROVALS	ENGINEER	DATE
DRC CHAIRMAN	<i>Rogelio Green</i>	<i>11/16/90</i>	WATER	<i>R.W. Kane</i>	<i>11-13-90</i>
TRANSPORTATION	<i>N/A RHD</i>	<i>11-16-90</i>	WASTE WATER	<i>R.W. Kane</i>	<i>11-13-90</i>
HYDROLOGY	<i>Lone</i>	<i>11-15-90</i>			
PROJECT NO. 3337.90		MAP NO. F-22		SHEET F11	OF 19

GENERAL NOTES

1. SEE SHEET E-1 FOR SYMBOLS LEGEND AND ABBREVIATIONS LIST.
2. SEE SHEET E-8 FOR SCHEDULES.
3. REPLACE "##" AND "#-" WITH ACTUAL TERMINAL ASSIGNMENTS BASED ON MANUFACTURERS SHOP DRAWINGS (TYPICAL).

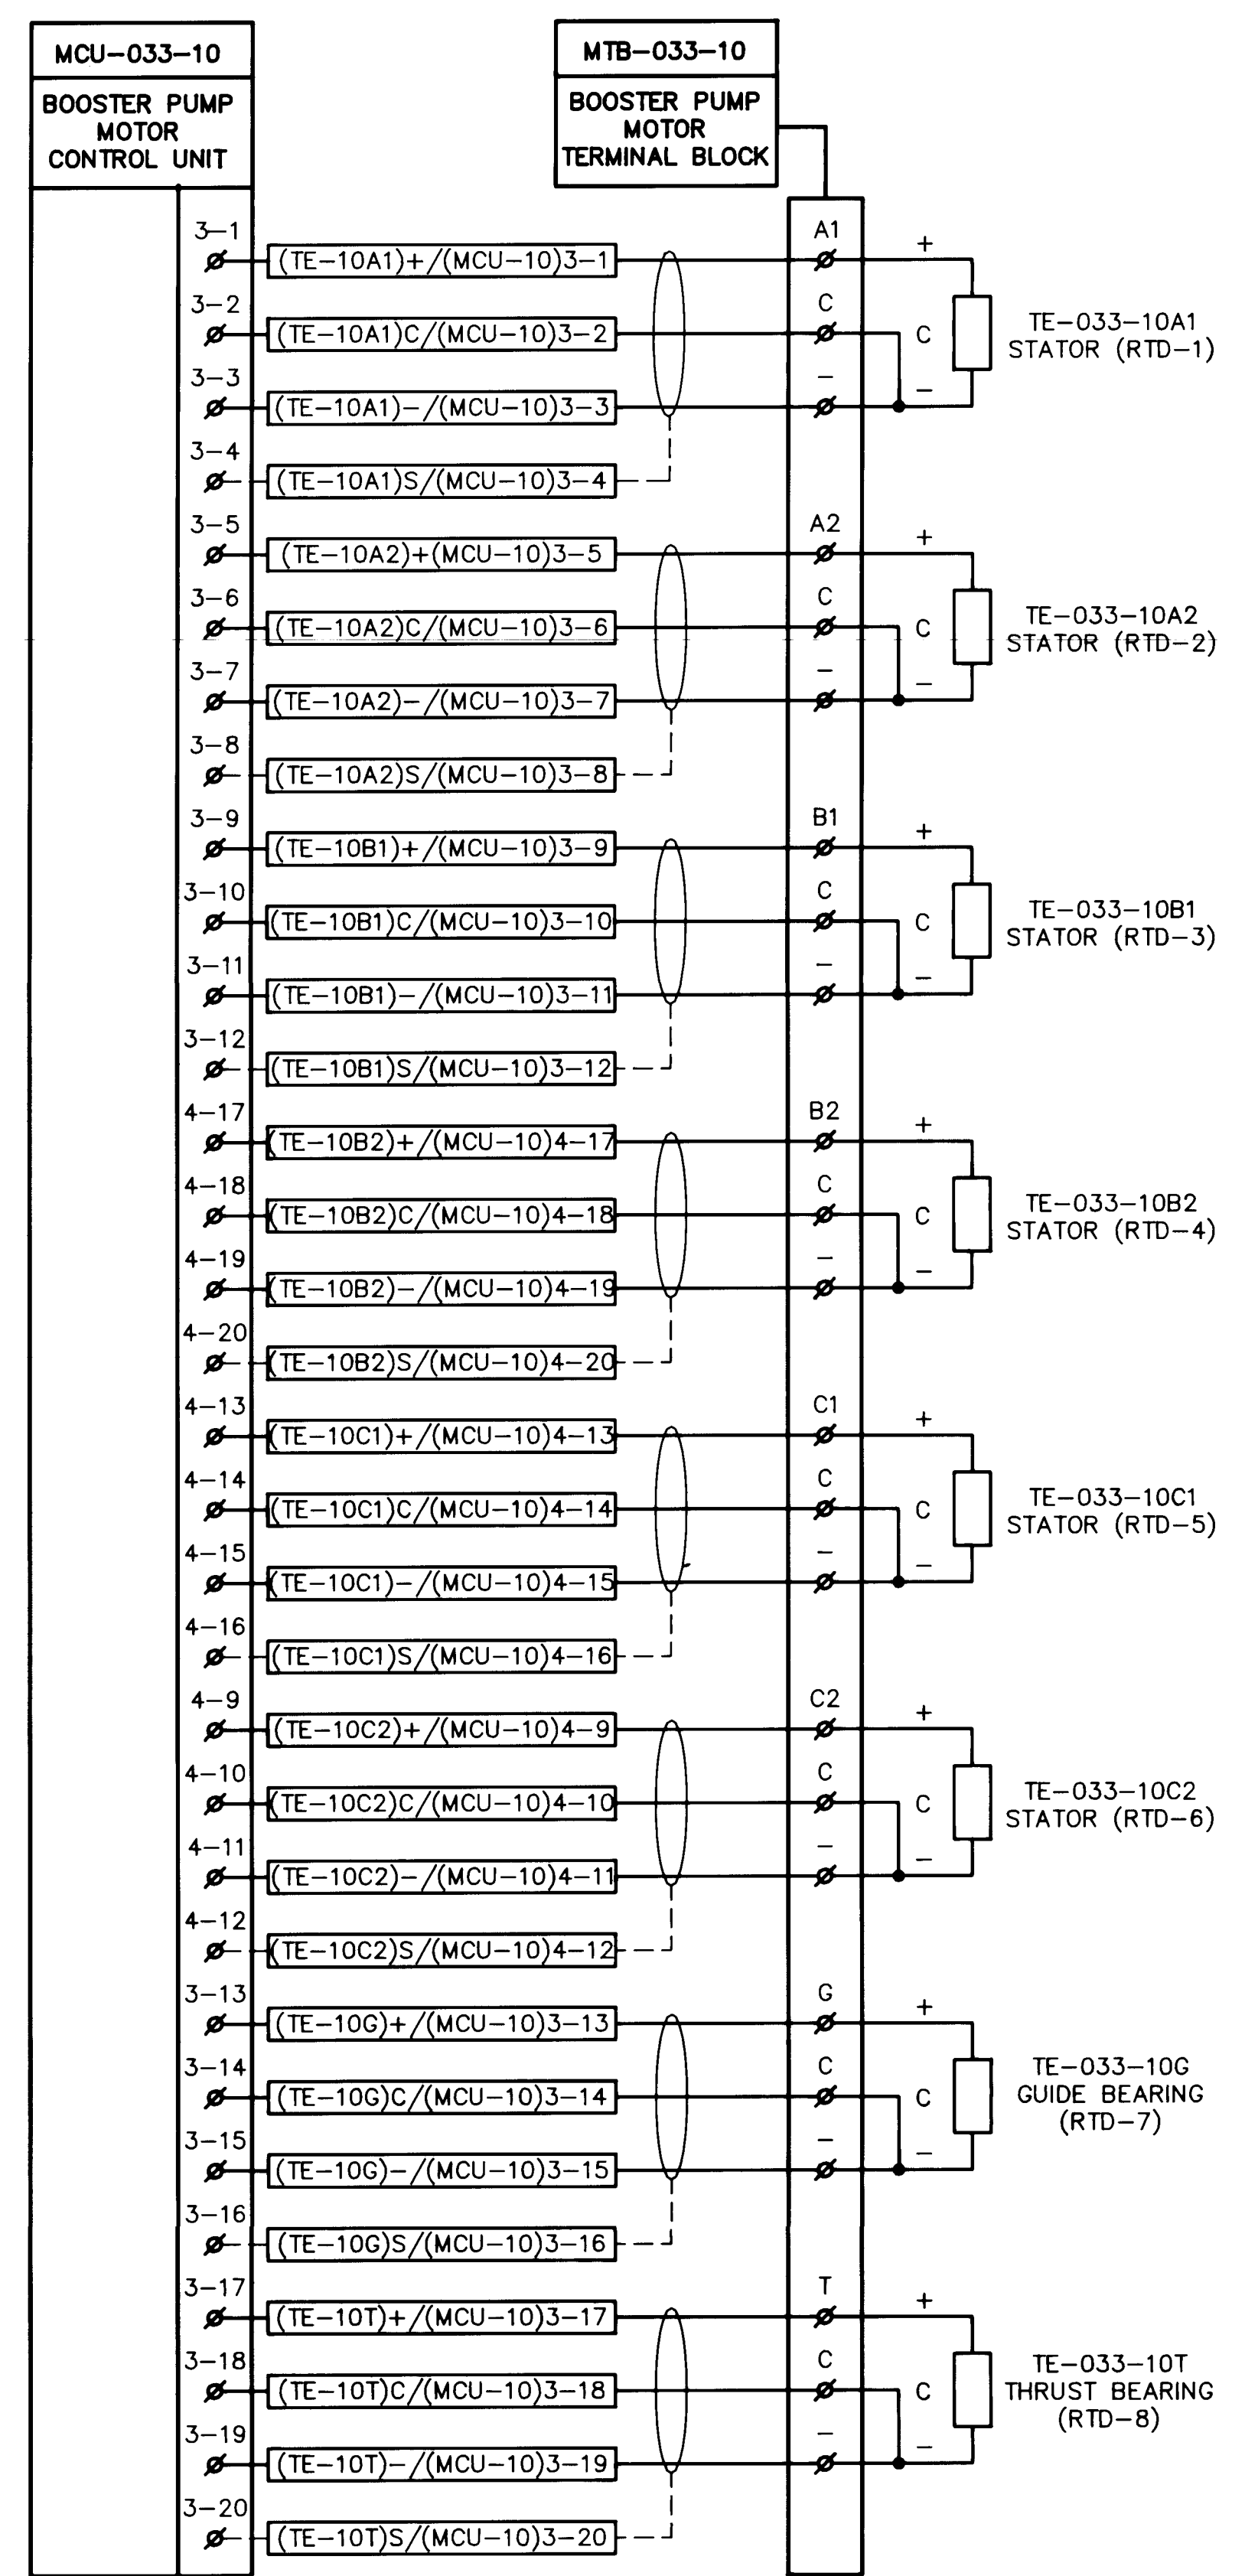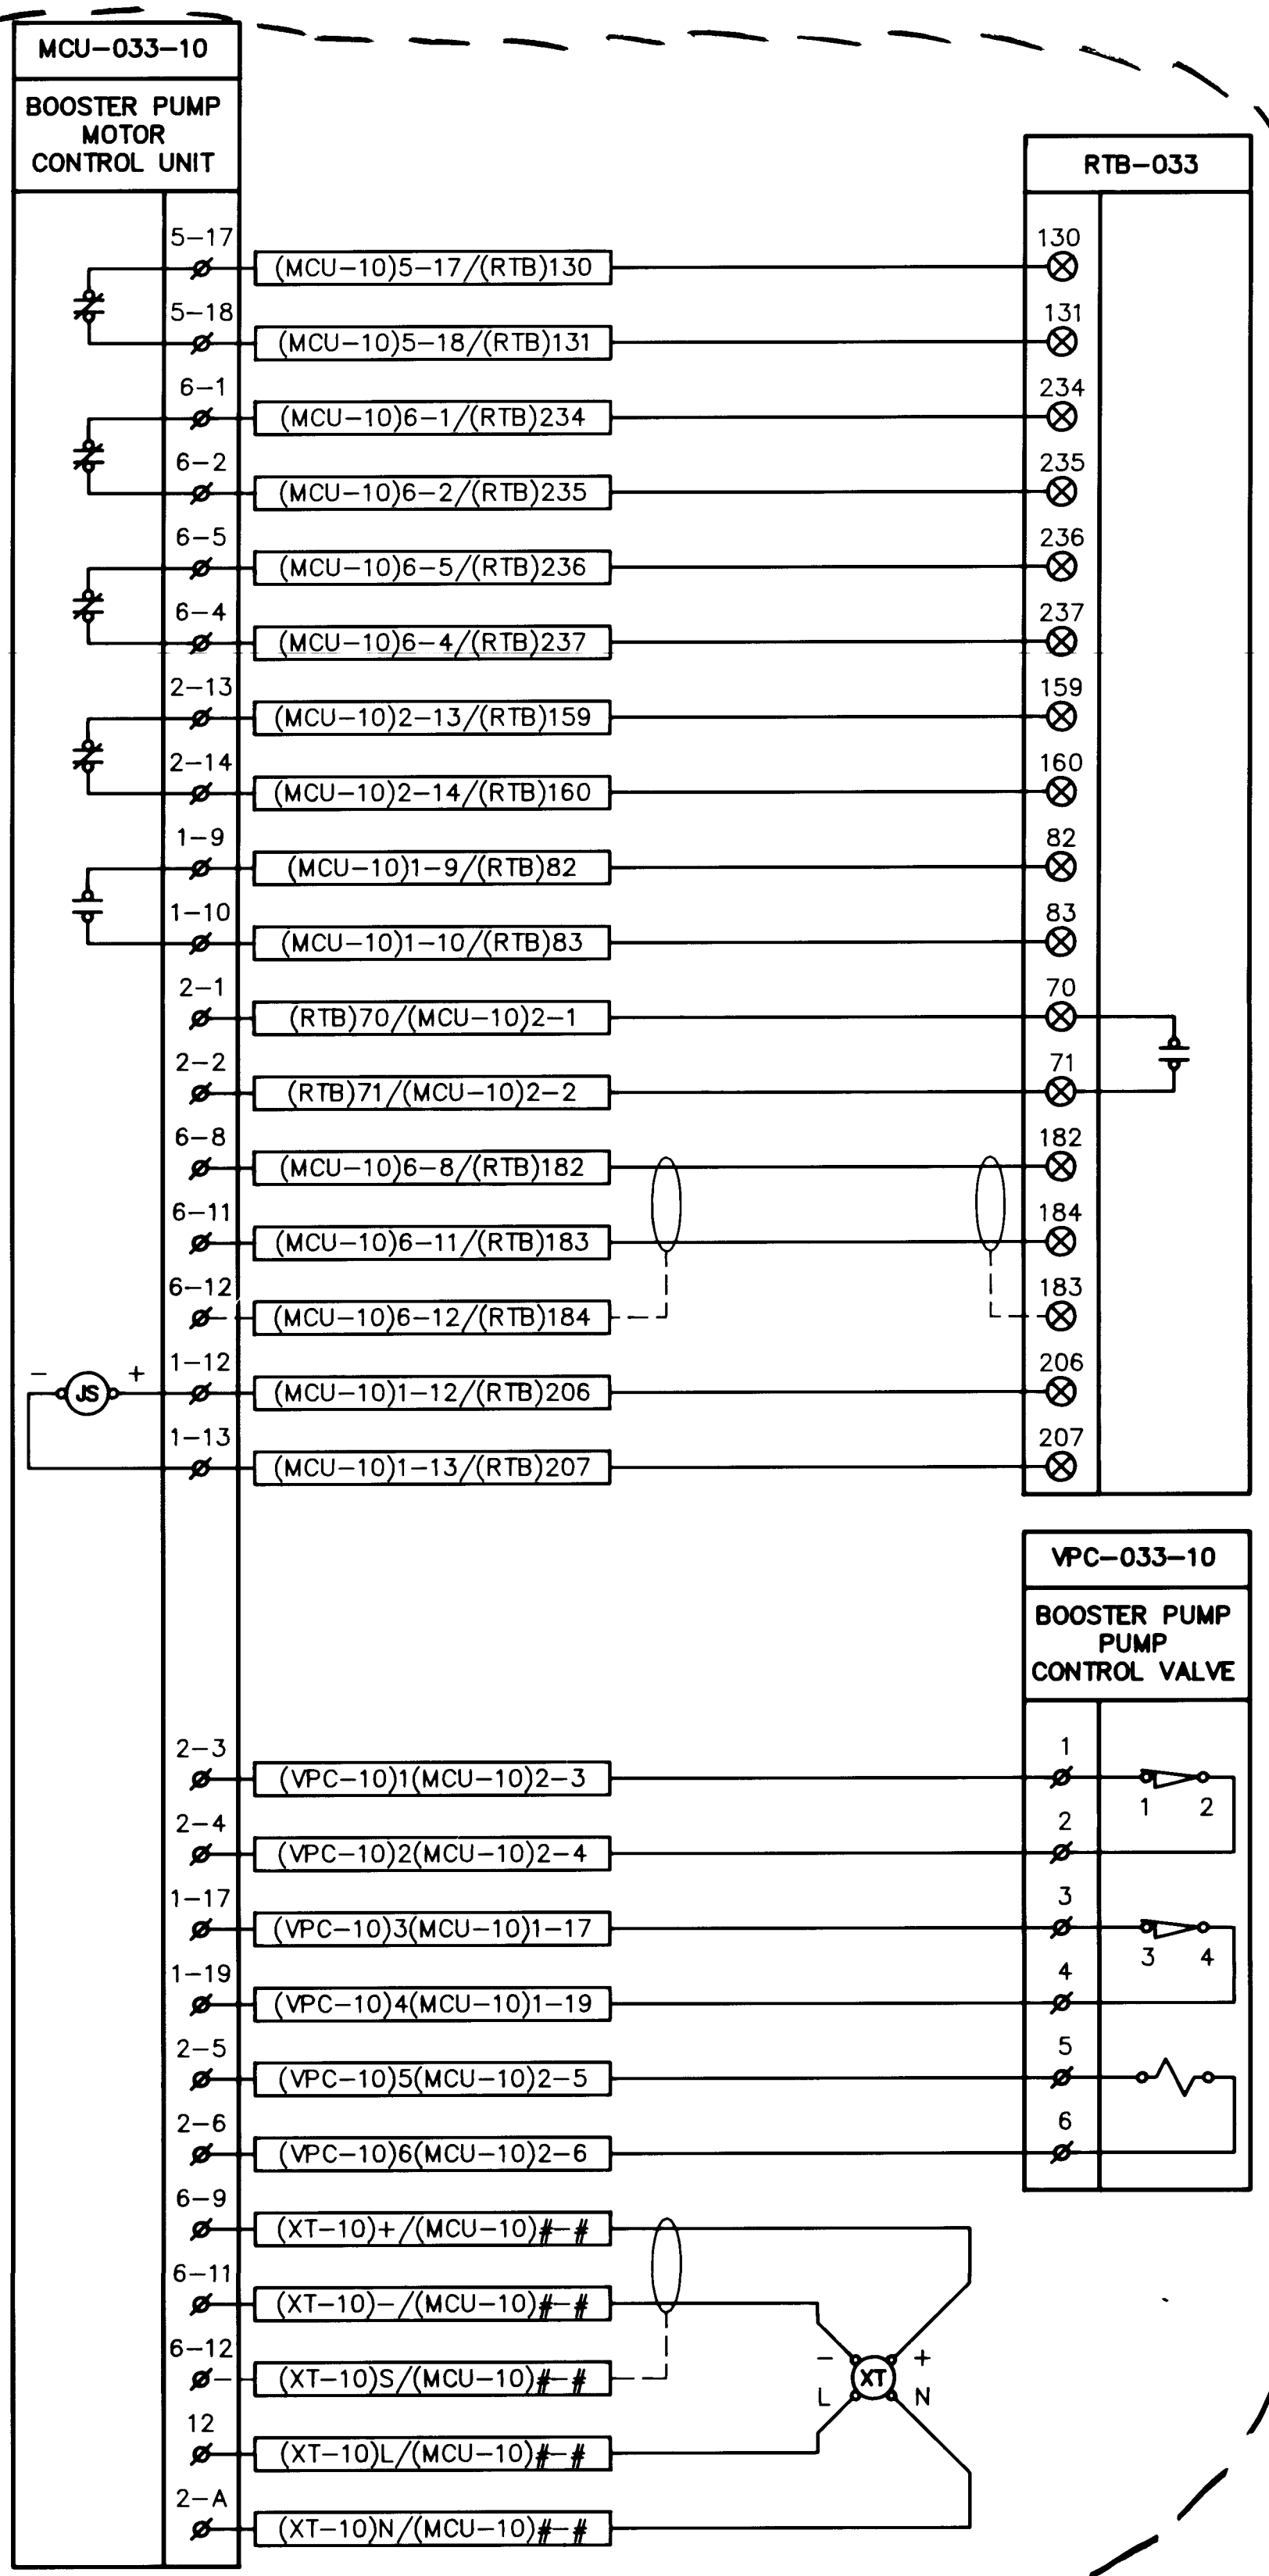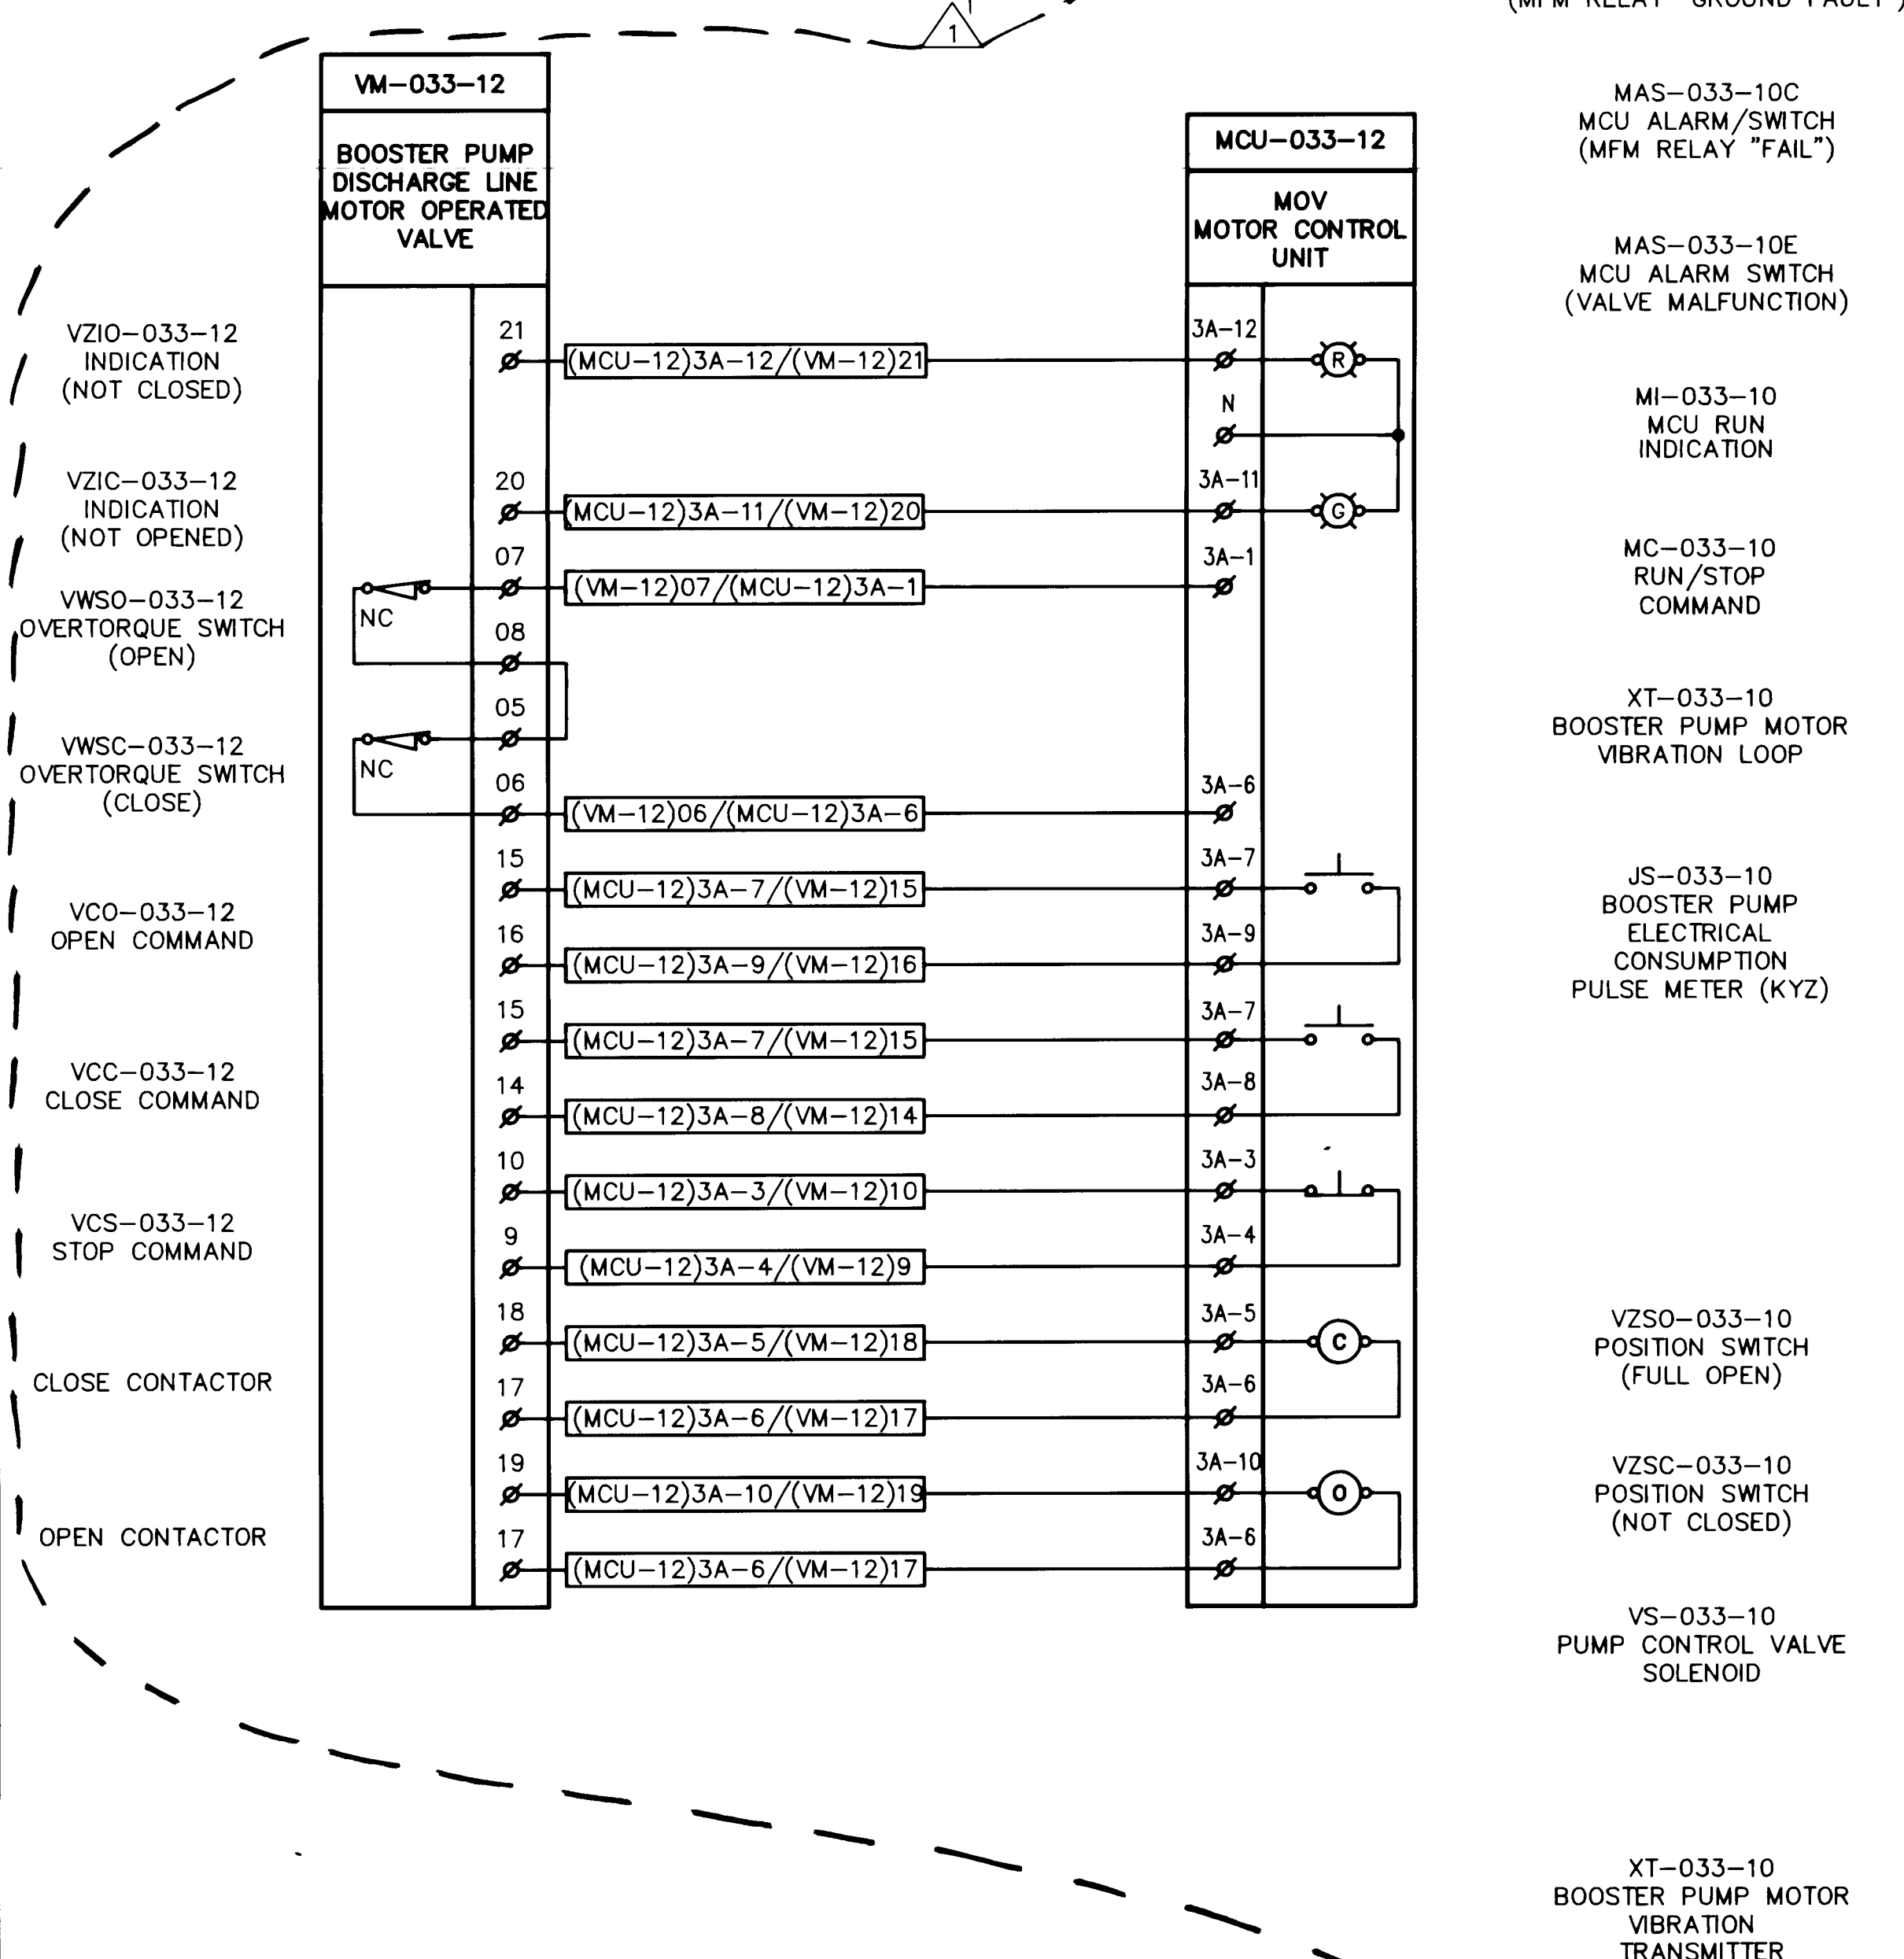

REDRAWN FOR RECORD PURPOSES

RECORD DRAWING
FEB 1992

These drawings have been revised based on field data and every reasonable effort has been made to depict construction as actually performed.

CITY OF ALBUQUERQUE
PUBLIC WORKS DEPARTMENT
ENGINEERING GROUP

TITLE: GUTIERREZ PUMP STATION RECONSTRUCTION
INTERCONNECTION DIAGRAMS - PUMP NO. 1

APPROVALS	ENGINEER	DATE	APPROVALS	ENGINEER	DATE
DRC CHAIRMAN			WATER		
TRANSPORTATION			WASTE WATER		
HYDROLOGY					

PROJECT NO. 3337.90 MAP NO. F-22 SHEET 12 OF 19

GENERAL NOTES

1. SEE SHEET E-1 FOR SYMBOLS LEGEND AND ABBREVIATIONS LIST.
2. SEE SHEET E-8 FOR SCHEDULES.
3. REPLACE "##" AND "#-#" WITH ACTUAL TERMINAL ASSIGNMENTS BASED ON MANUFACTURERS SHOP DRAWINGS (TYPICAL).

VZIO-033-12
INDICATION
(NOT CLOSED)

VZIC-033-12
INDICATION
(NOT OPENED)

VWSO-033-12
OVERTORQUE SWITCH
(OPEN)

VWSC-033-12
OVERTORQUE SWITCH
(CLOSE)


VCO-033-12
OPEN COMMAND

VCC-033-12
CLOSE COMMAND

VCS-033-12
STOP COMMAND

CLOSE CONTACTOR

OPEN CONTACTOR

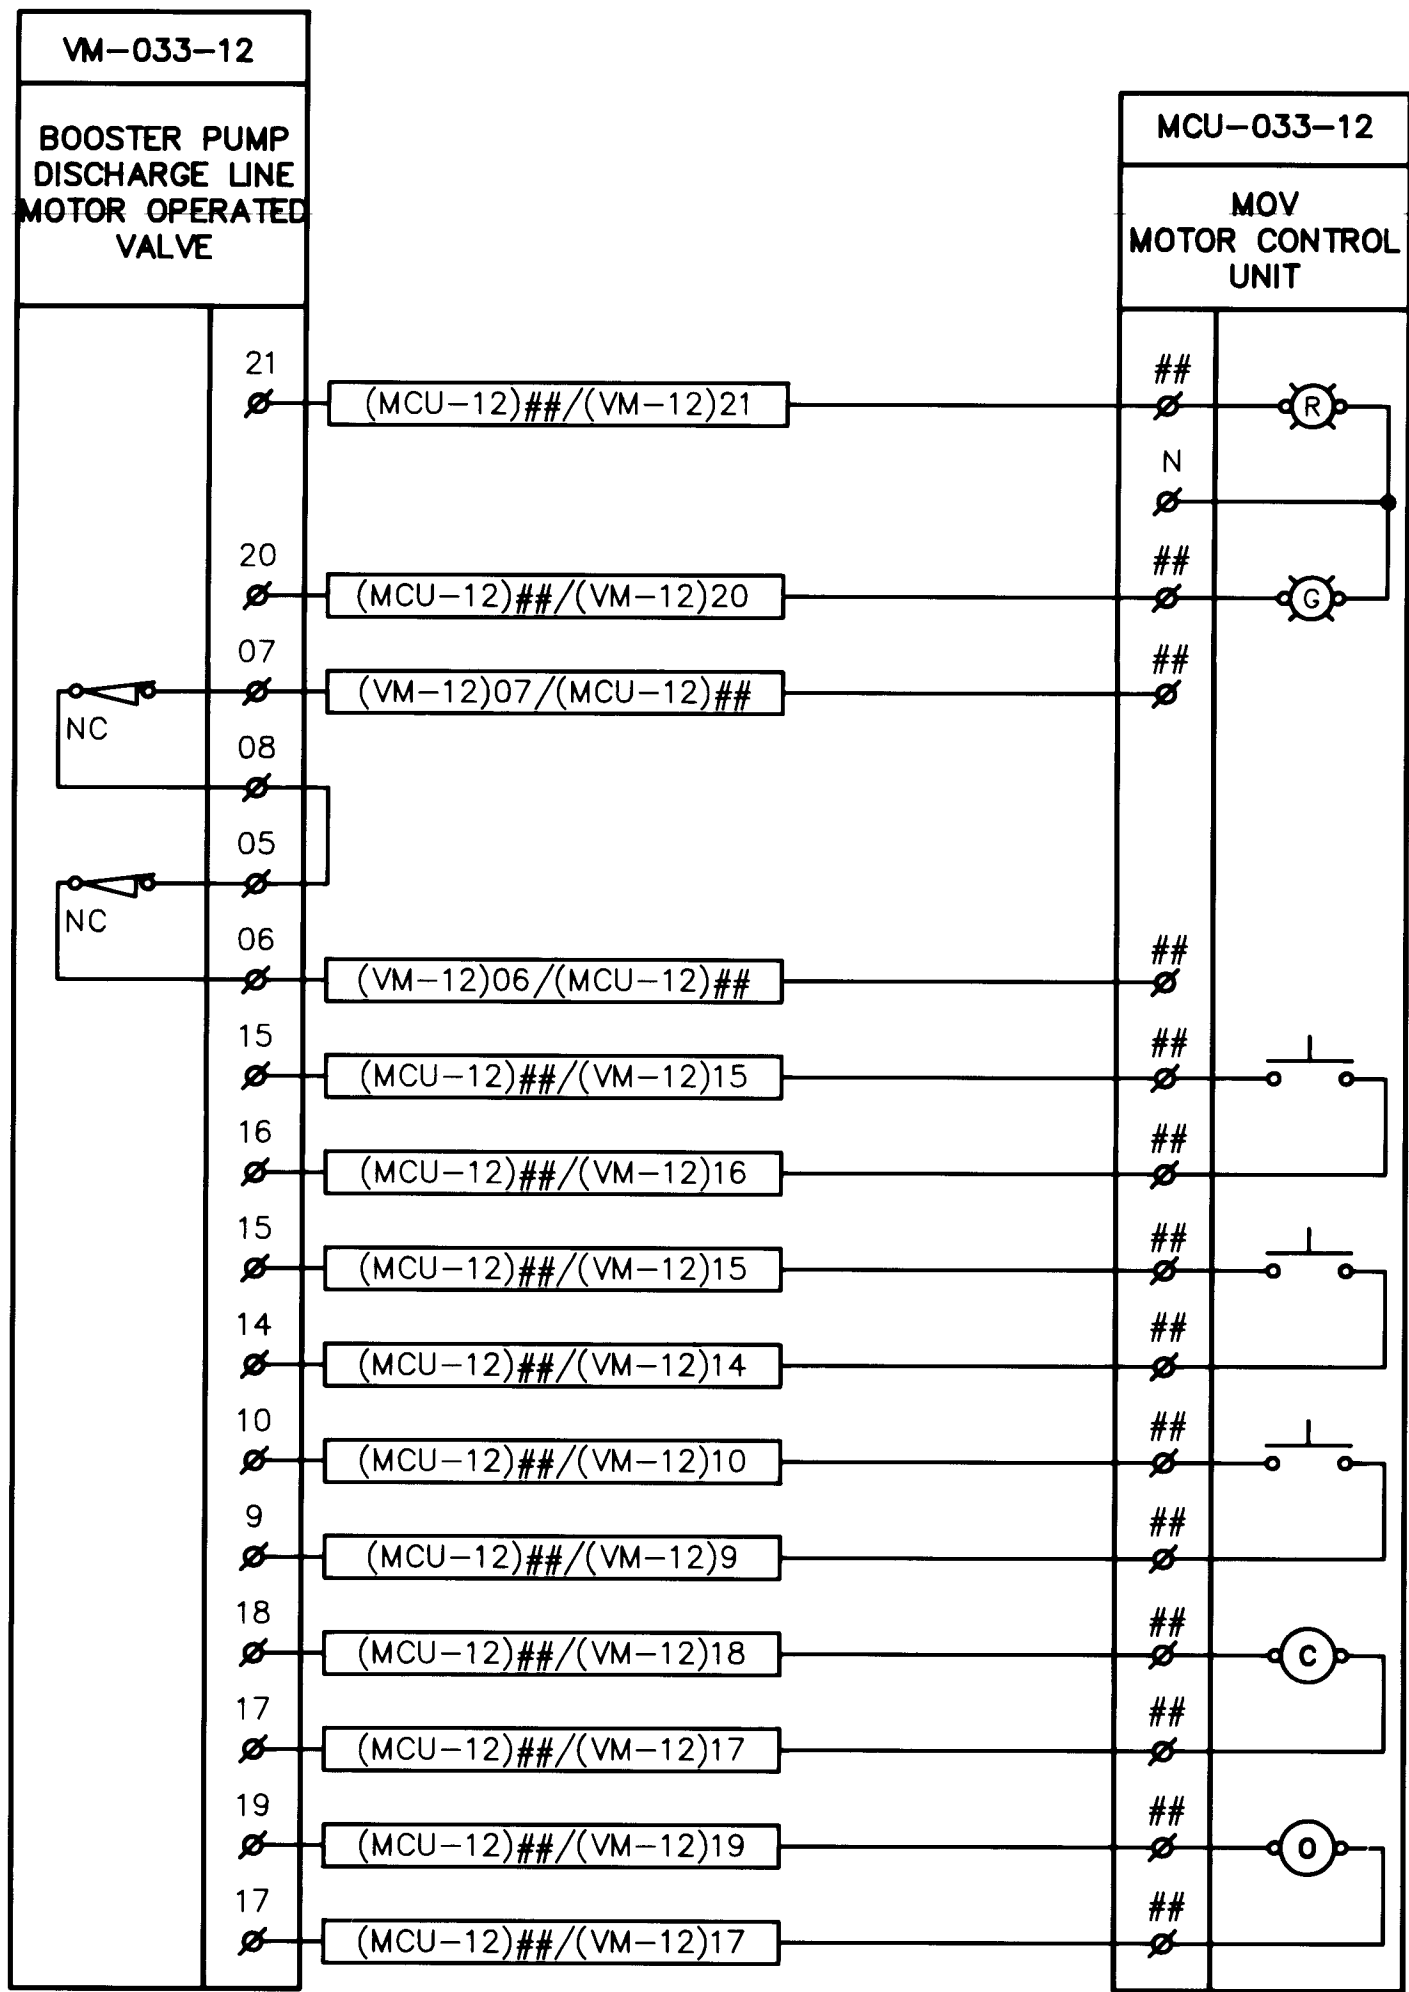

MAS-033-10A
MCU ALARM/SWITCH
(MFM RELAY "TRIP")

MAS-033-10B
MCU ALARM/SWITCH
(MFM RELAY "GROUND FAULT")

MAS-033-10C
MCU ALARM/SWITCH
(MFM RELAY "FAIL")

MAS-033-10E
MCU ALARM SWITCH
(VALVE MALFUNCTION)

MI-033-10
MCU RUN
INDICATION

MC-033-10
RUN/STOP
COMMAND

XT-033-10
BOOSTER PUMP MOTOR
VIBRATION LOOP

JS-033-10
BOOSTER PUMP
ELECTRICAL
CONSUMPTION
PULSE METER (KYZ)

VZSO-033-10
POSITION SWITCH
(FULL OPEN)

VZSC-033-10
POSITION SWITCH
(NOT CLOSED)



VS-033-10
PUMP CONTROL VALVE
SOLENOID

VZSC-033-12
POSITION SWITCH
(NOT CLOSED)

VZSO-033-12
POSITION SWITCH
(NOT OPENED)

VZSC-033-12
POSITION SWITCH
(FULL CLOSED)


XT-033-10
BOOSTER PUMP MOTOR
VIBRATION
TRANSMITTER

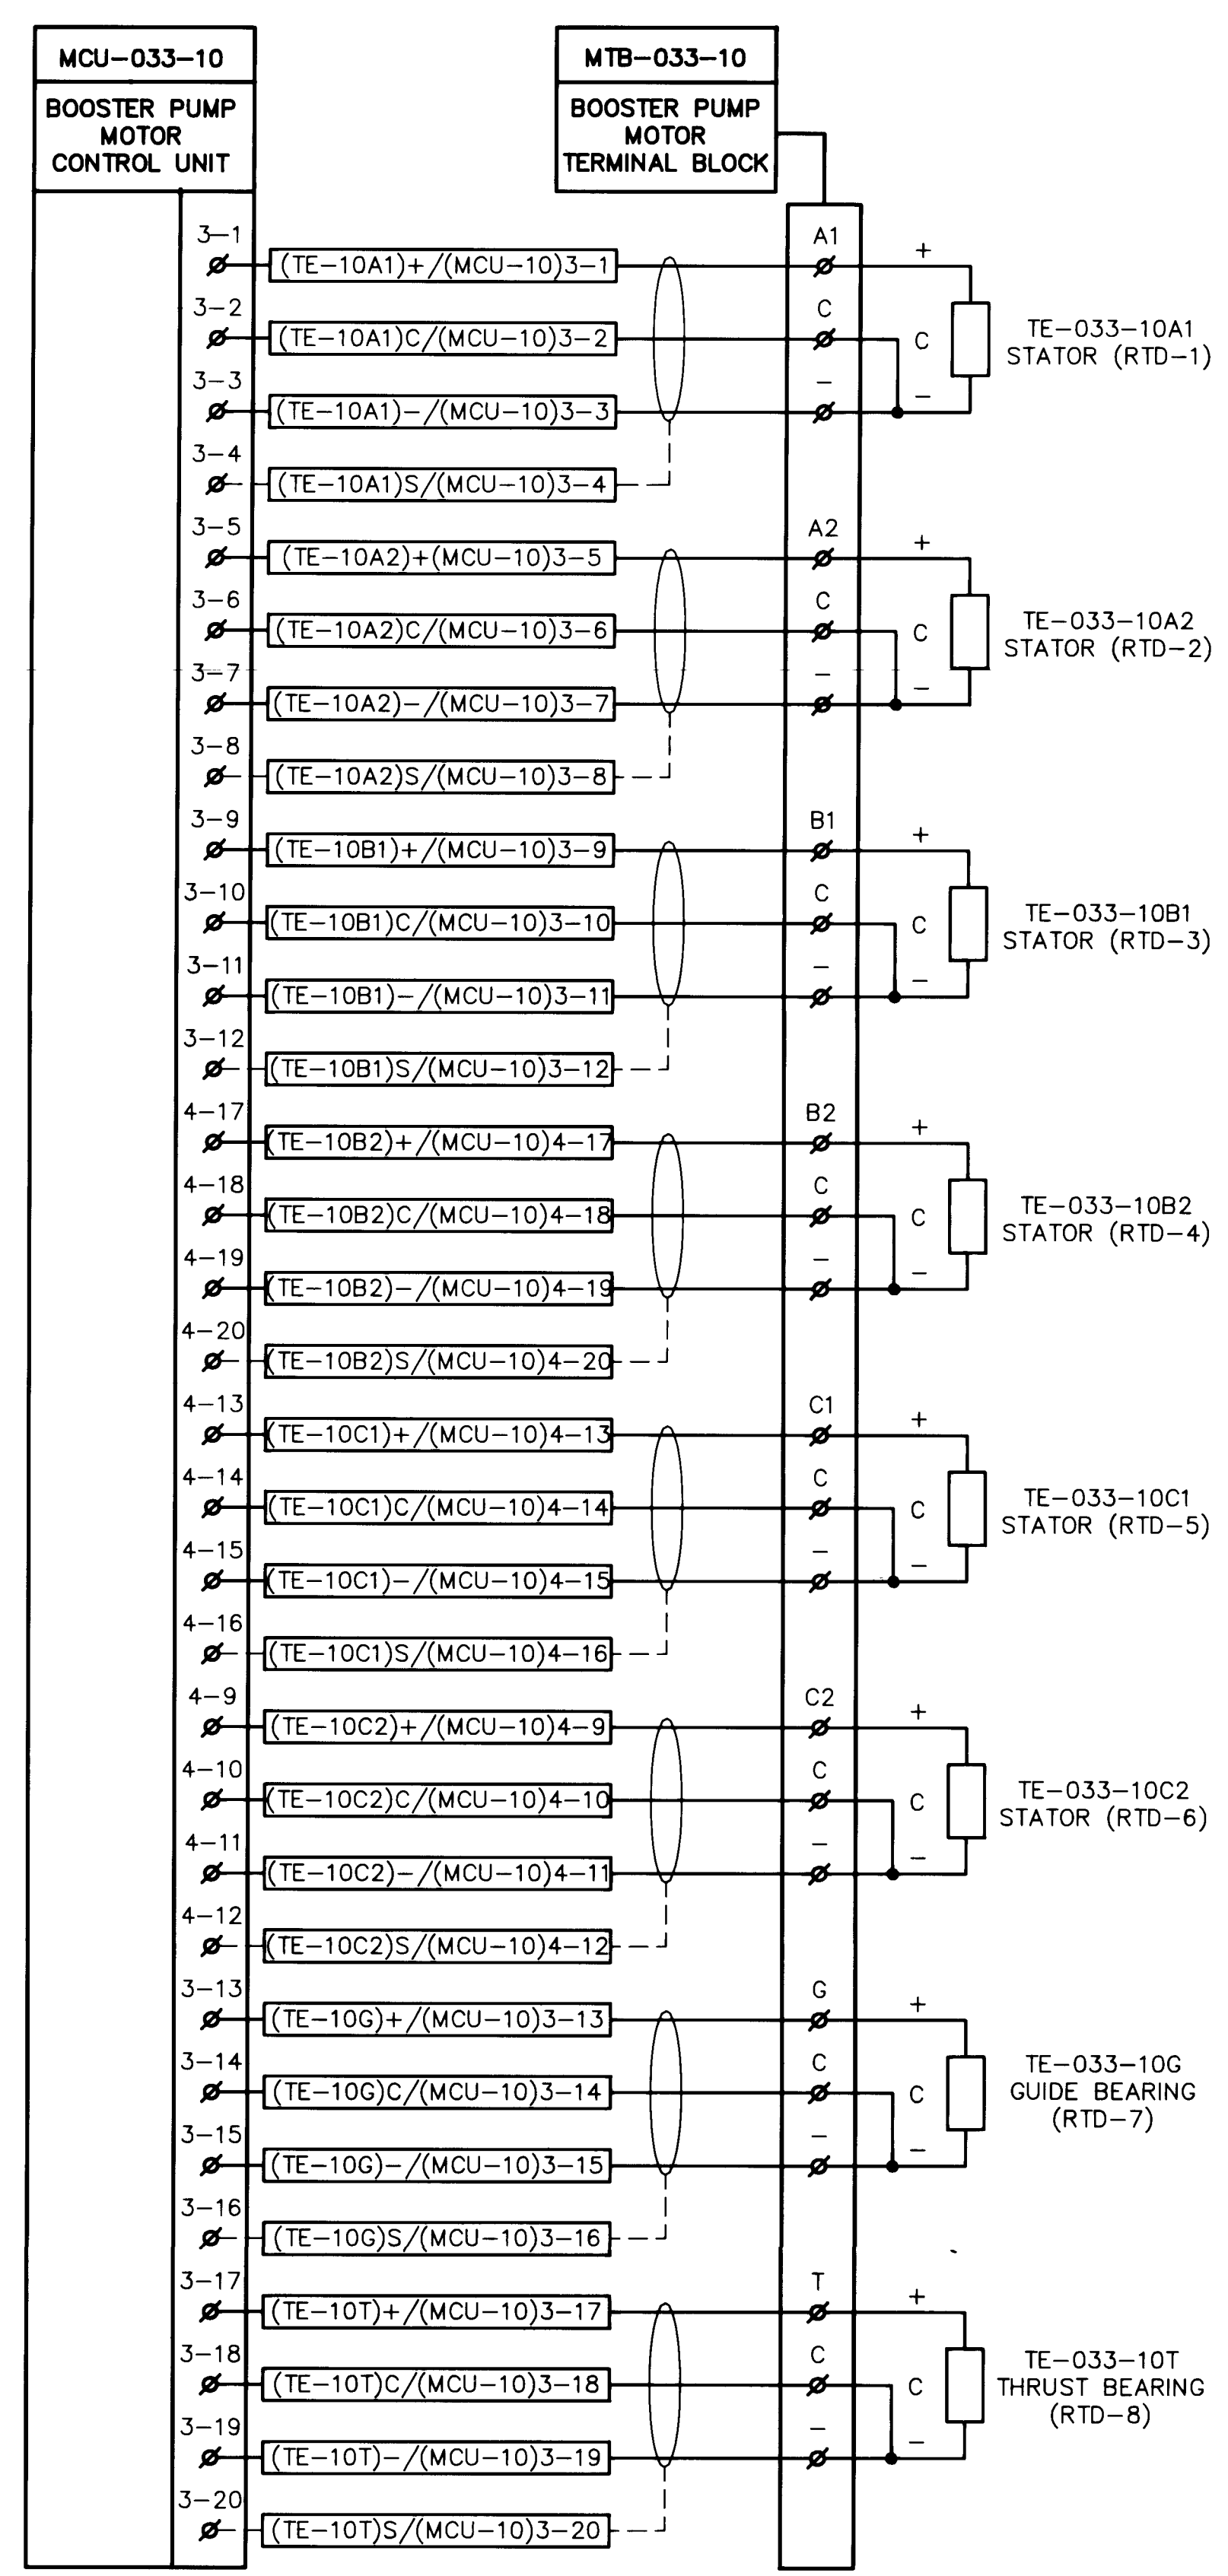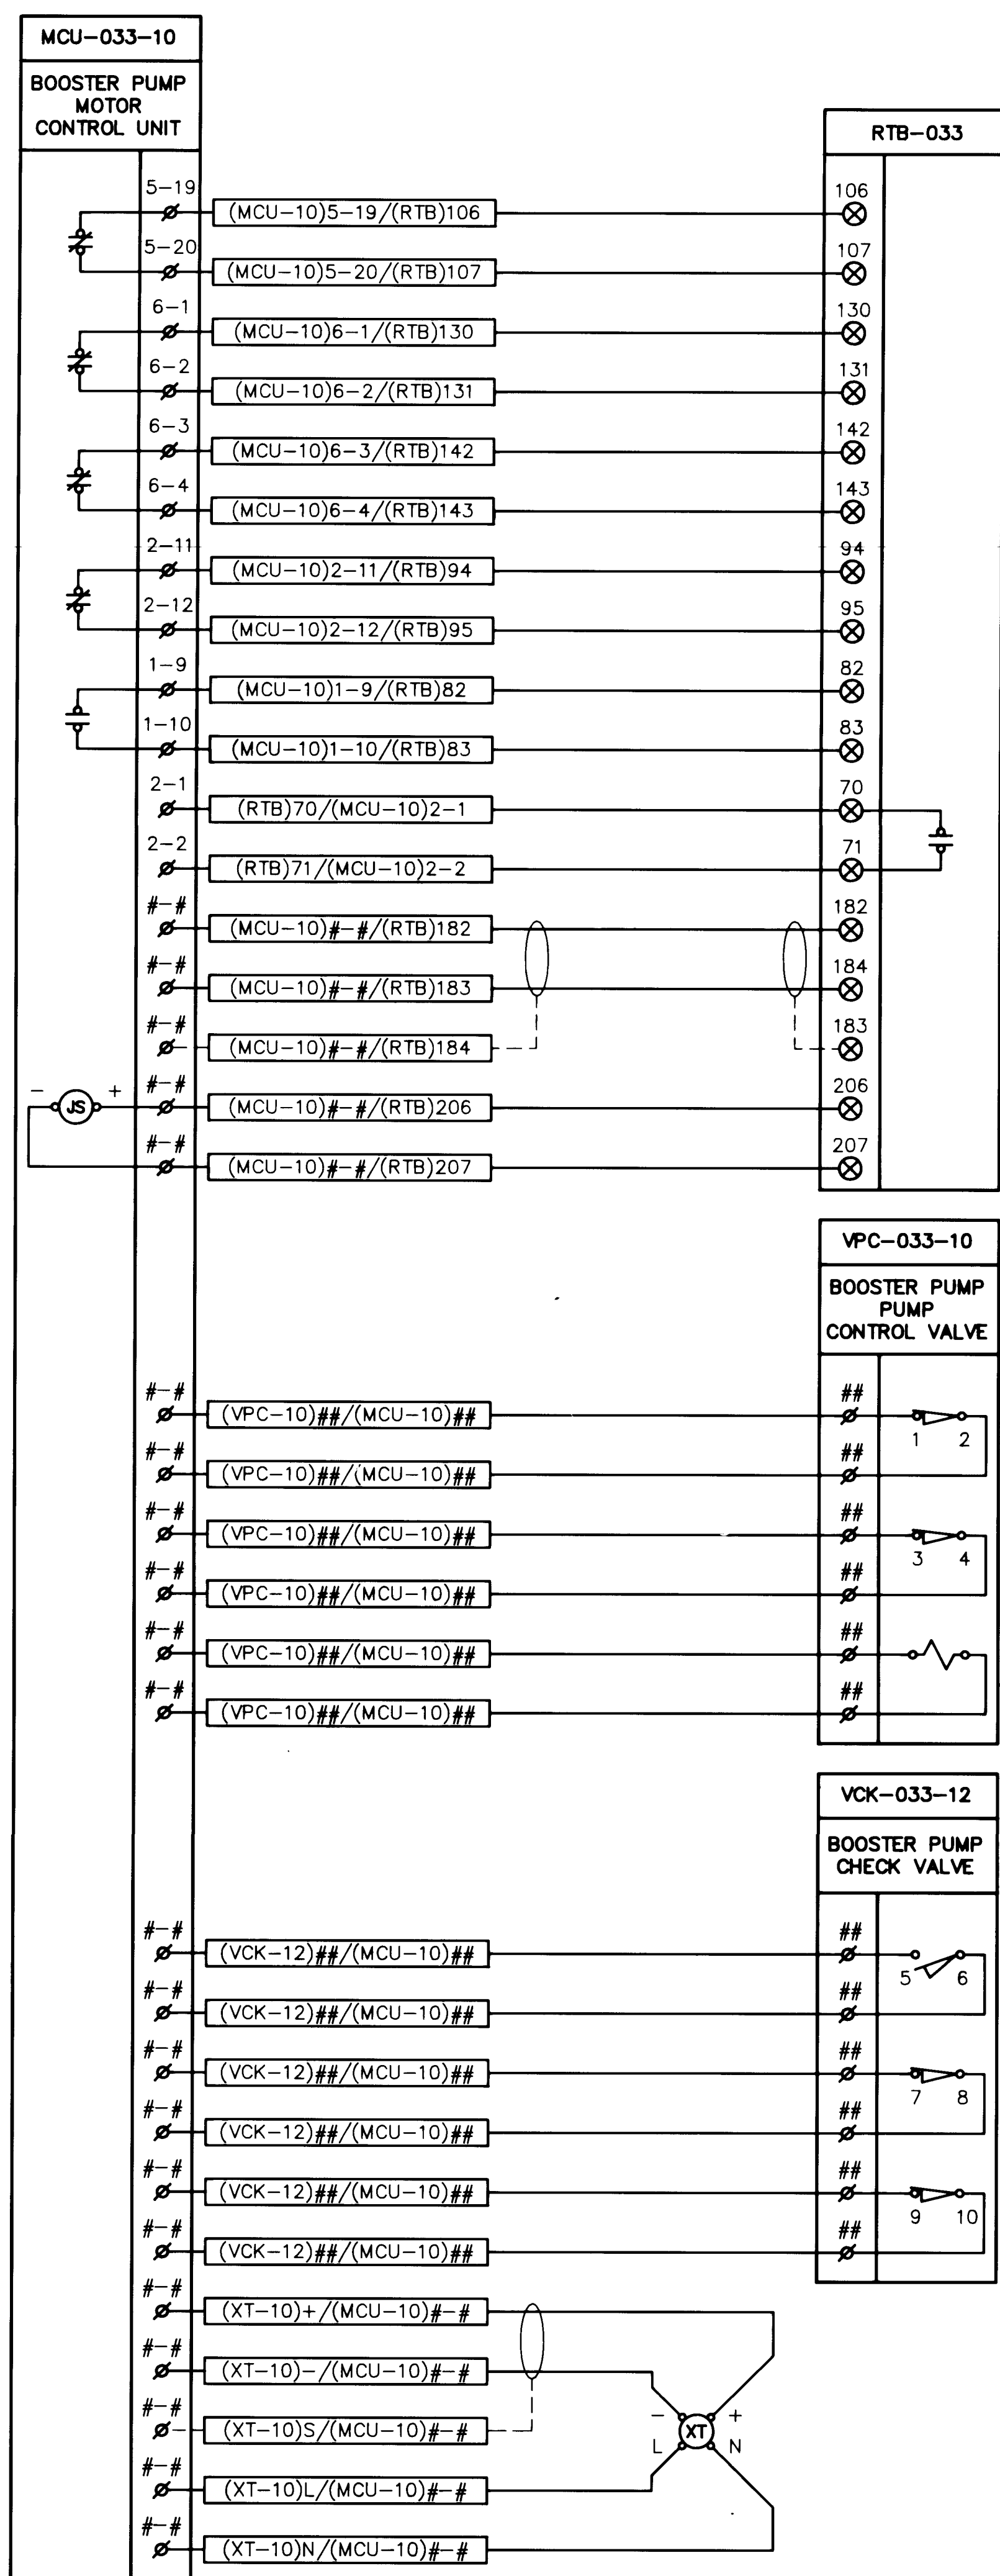

26 3337 903692

THIS SHEET SUPERSEDED BY
SIMILAR SHEET MARKED "REDRAWN
FOR RECORD PURPOSES"


AS BUILT INFORMATION			BENCH MARKS			SURVEY INFORMATION			ENGINEER'S SEAL		
CONTRACTOR	DATE					FIELD NOTES	BY	DATE			
WORK STARTED BY	DATE										
ACCEPTANCE BY	DATE										
FIELD LOCATION BY	DATE										
DRAWINGS CORRECTED BY	DATE										
MICRO-FILM INFORMATION											
RECORDED BY	DATE										
NO.											

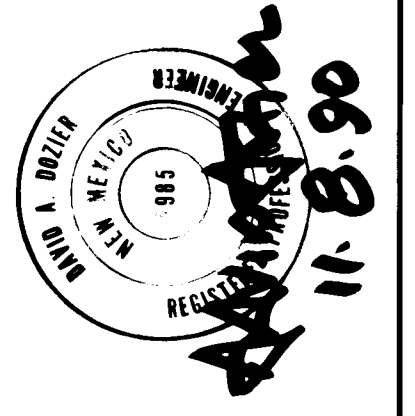

CITY OF ALBUQUERQUE PUBLIC WORKS DEPARTMENT ENGINEERING GROUP					
TITLE: GUTIERREZ PUMP STATION RECONSTRUCTION INTERCONNECTION DIAGRAMS - PUMP NO. 1					
APPROVALS	ENGINEER	DATE	APPROVALS	ENGINEER	DATE
DRC CHAIRMAN	R.W. Kane	11-13-90	WATER	R.W. Kane	11-13-90
TRANSPORTATION	R.W. Kane	11-13-90	WASTE WATER	R.W. Kane	11-13-90
HYDROLOGY	Don	11-13-90			
PROJECT NO.	3337.90	MAP NO.	F-22	SHEET	E12 OF 19

GENERAL NOTES

- SEE SHEET E-1 FOR SYMBOLS LEGEND AND ABBREVIATIONS LIST.
- SEE SHEET E-8 FOR SCHEDULES.
- REPLACE "##" AND "#-#" WITH ACTUAL TERMINAL ASSIGNMENTS BASED ON MANUFACTURERS SHOP DRAWINGS (TYPICAL).

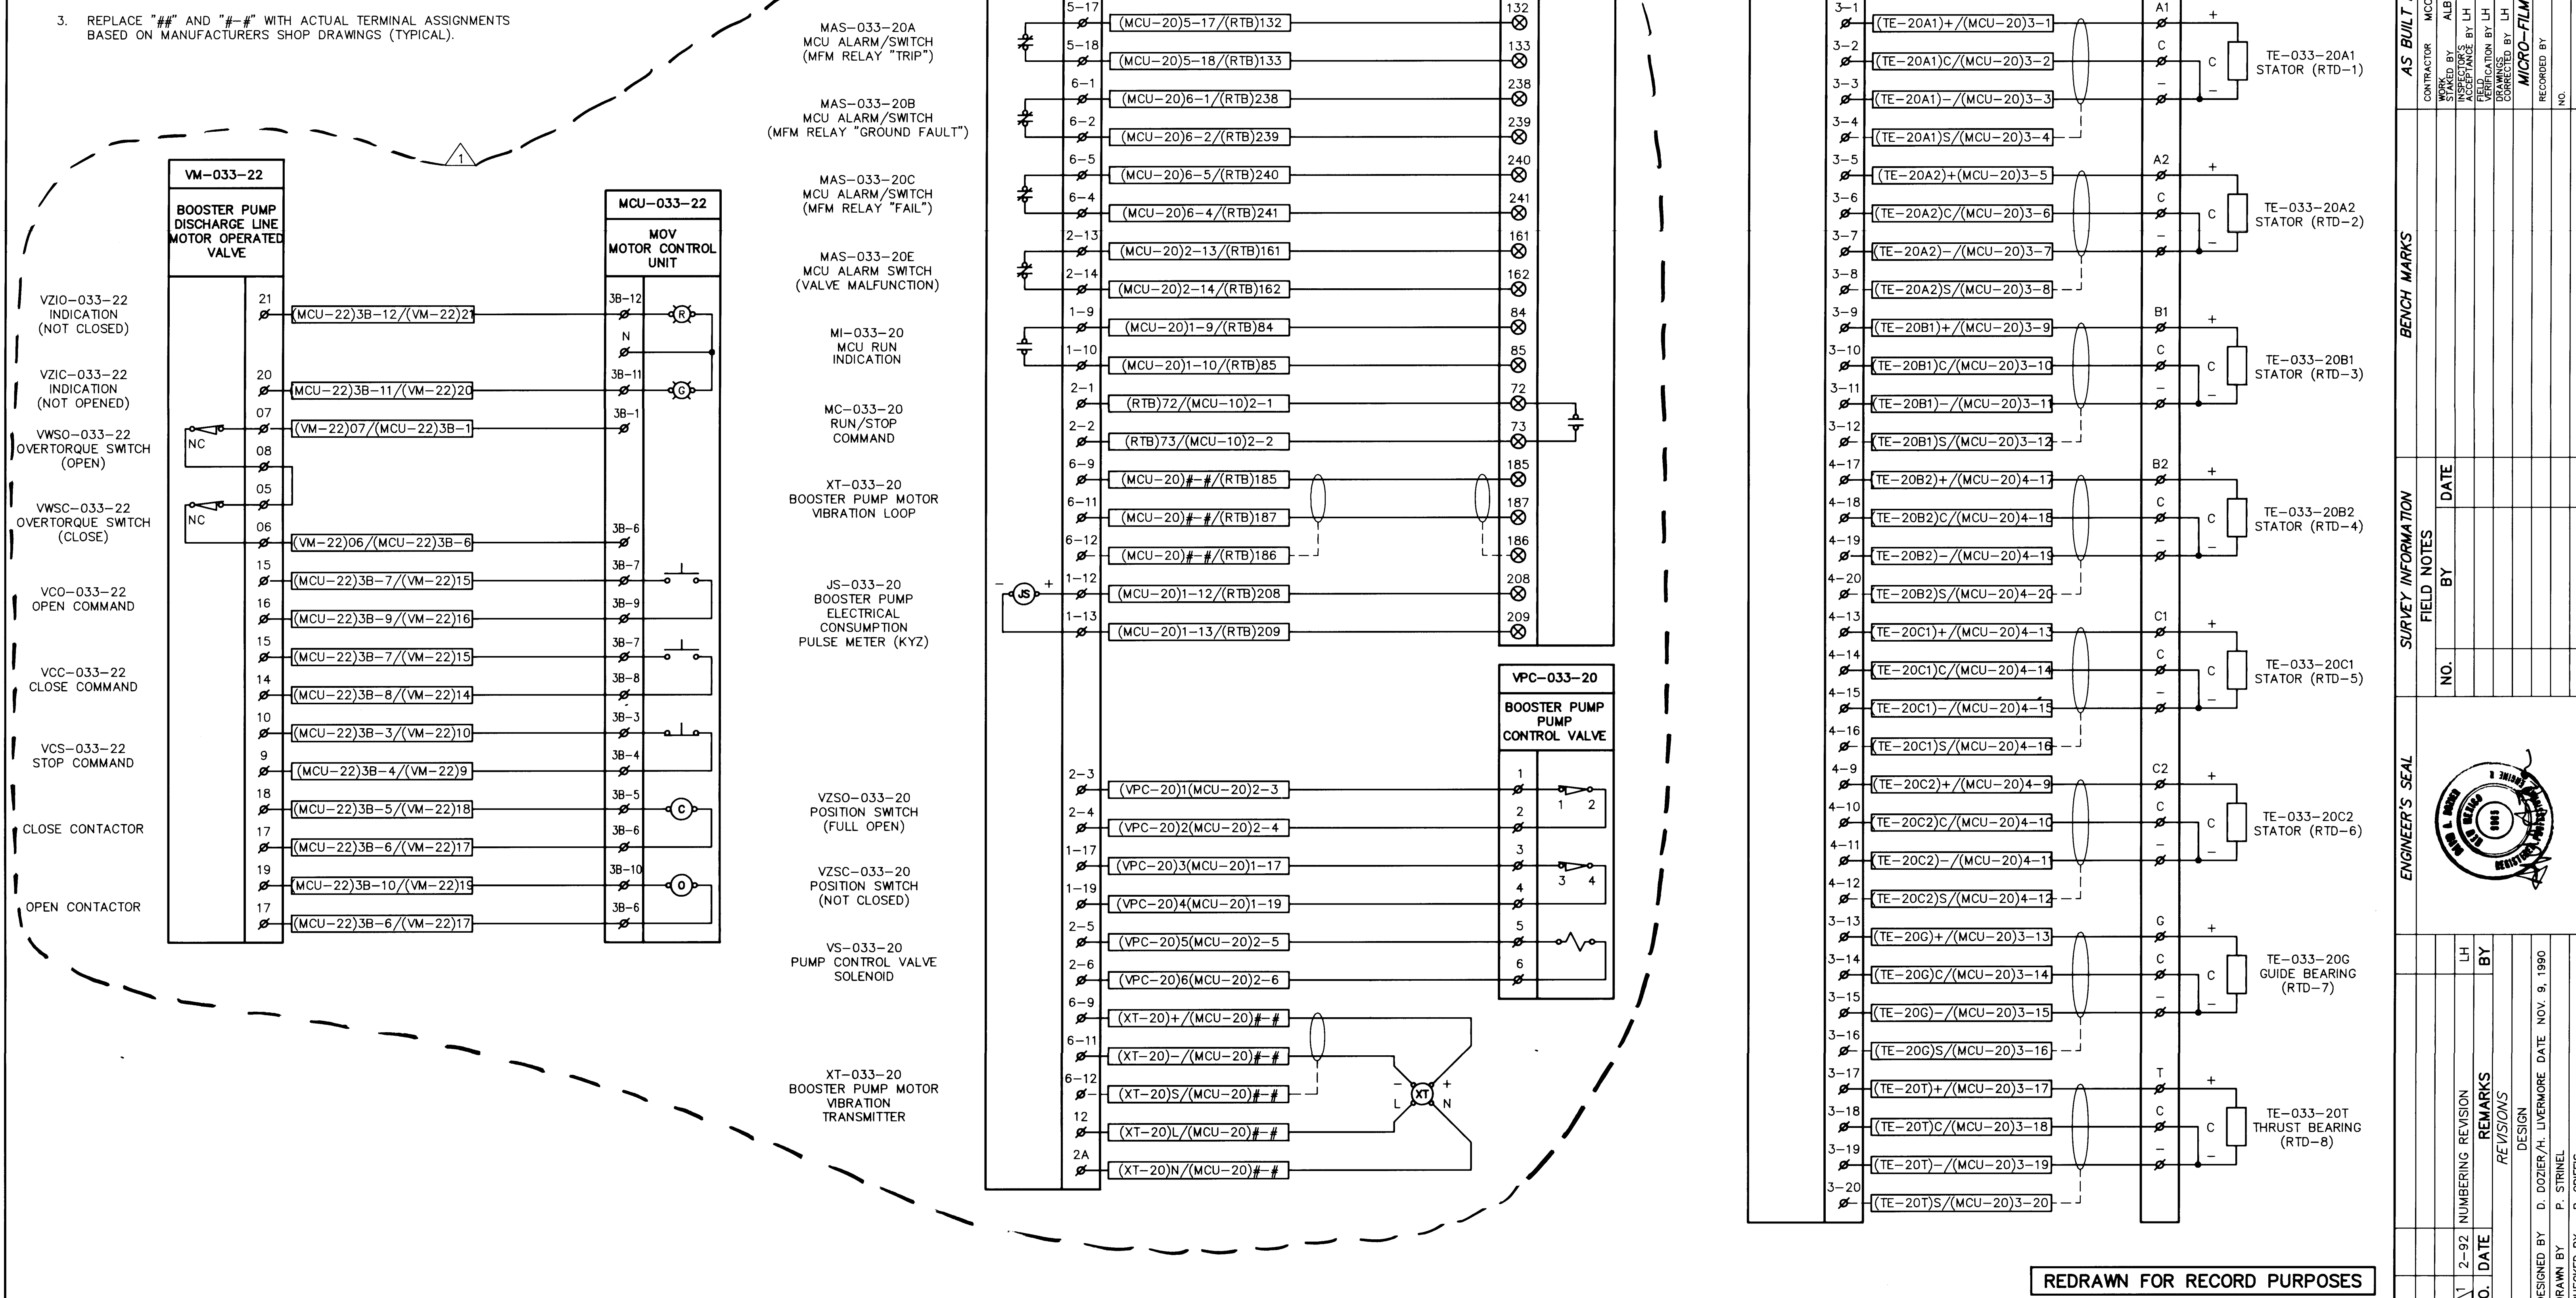

REDRAWN FOR RECORD PURPOSES

RECORD DRAWING

DATE FEB 1992

These drawings have been revised based on field data and every reasonable attempt has been made to depict construction as actually performed.

802621GED1/C8026E15

CITY OF ALBUQUERQUE
PUBLIC WORKS DEPARTMENT
ENGINEERING GROUP

TITLE:
GUTIERREZ PUMP STATION RECONSTRUCTION
INTERCONNECTION DIAGRAMS - PUMP NO. 2

APPROVALS	ENGINEER	DATE	APPROVALS	ENGINEER	DATE
DRC CHAIRMAN			WATER		
TRANSPORTATION			WASTE WATER		
HYDROLOGY					


PROJECT NO. 3337.90 MAP NO. F-22 SHEET E13 OF 19

AS BUILT INFORMATION			BENCH MARKS			SURVEY INFORMATION			ENGINEER'S SEAL		
CONTRACTOR	MCC	DATE 2/92	WORK STARTED BY	ALB. SVY.	DATE 2/92	FIELD NOTES	DATE	BY	NO.	DATE	BY
WORK STARTED BY			ACCEPTANCE BY								
FIELD ACCEPTANCE BY			FIELD CORRECTION BY								
DRAWN BY			CHECKED BY								
RECORDED BY											
NO.											

DESIGNED BY	D. DOZIER/H. LIVERMORE	DATE	NOV. 9, 1990
DRAWN BY	P. STINEL		
CHECKED BY	B. GRIFFIS		

GENERAL NOTES

- SEE SHEET E-1 FOR SYMBOLS LEGEND AND ABBREVIATIONS LIST.
- SEE SHEET E-8 FOR SCHEDULES.
- REPLACE "##" AND "#-#" WITH ACTUAL TERMINAL ASSIGNMENTS BASED ON MANUFACTURERS SHOP DRAWINGS (TYPICAL).

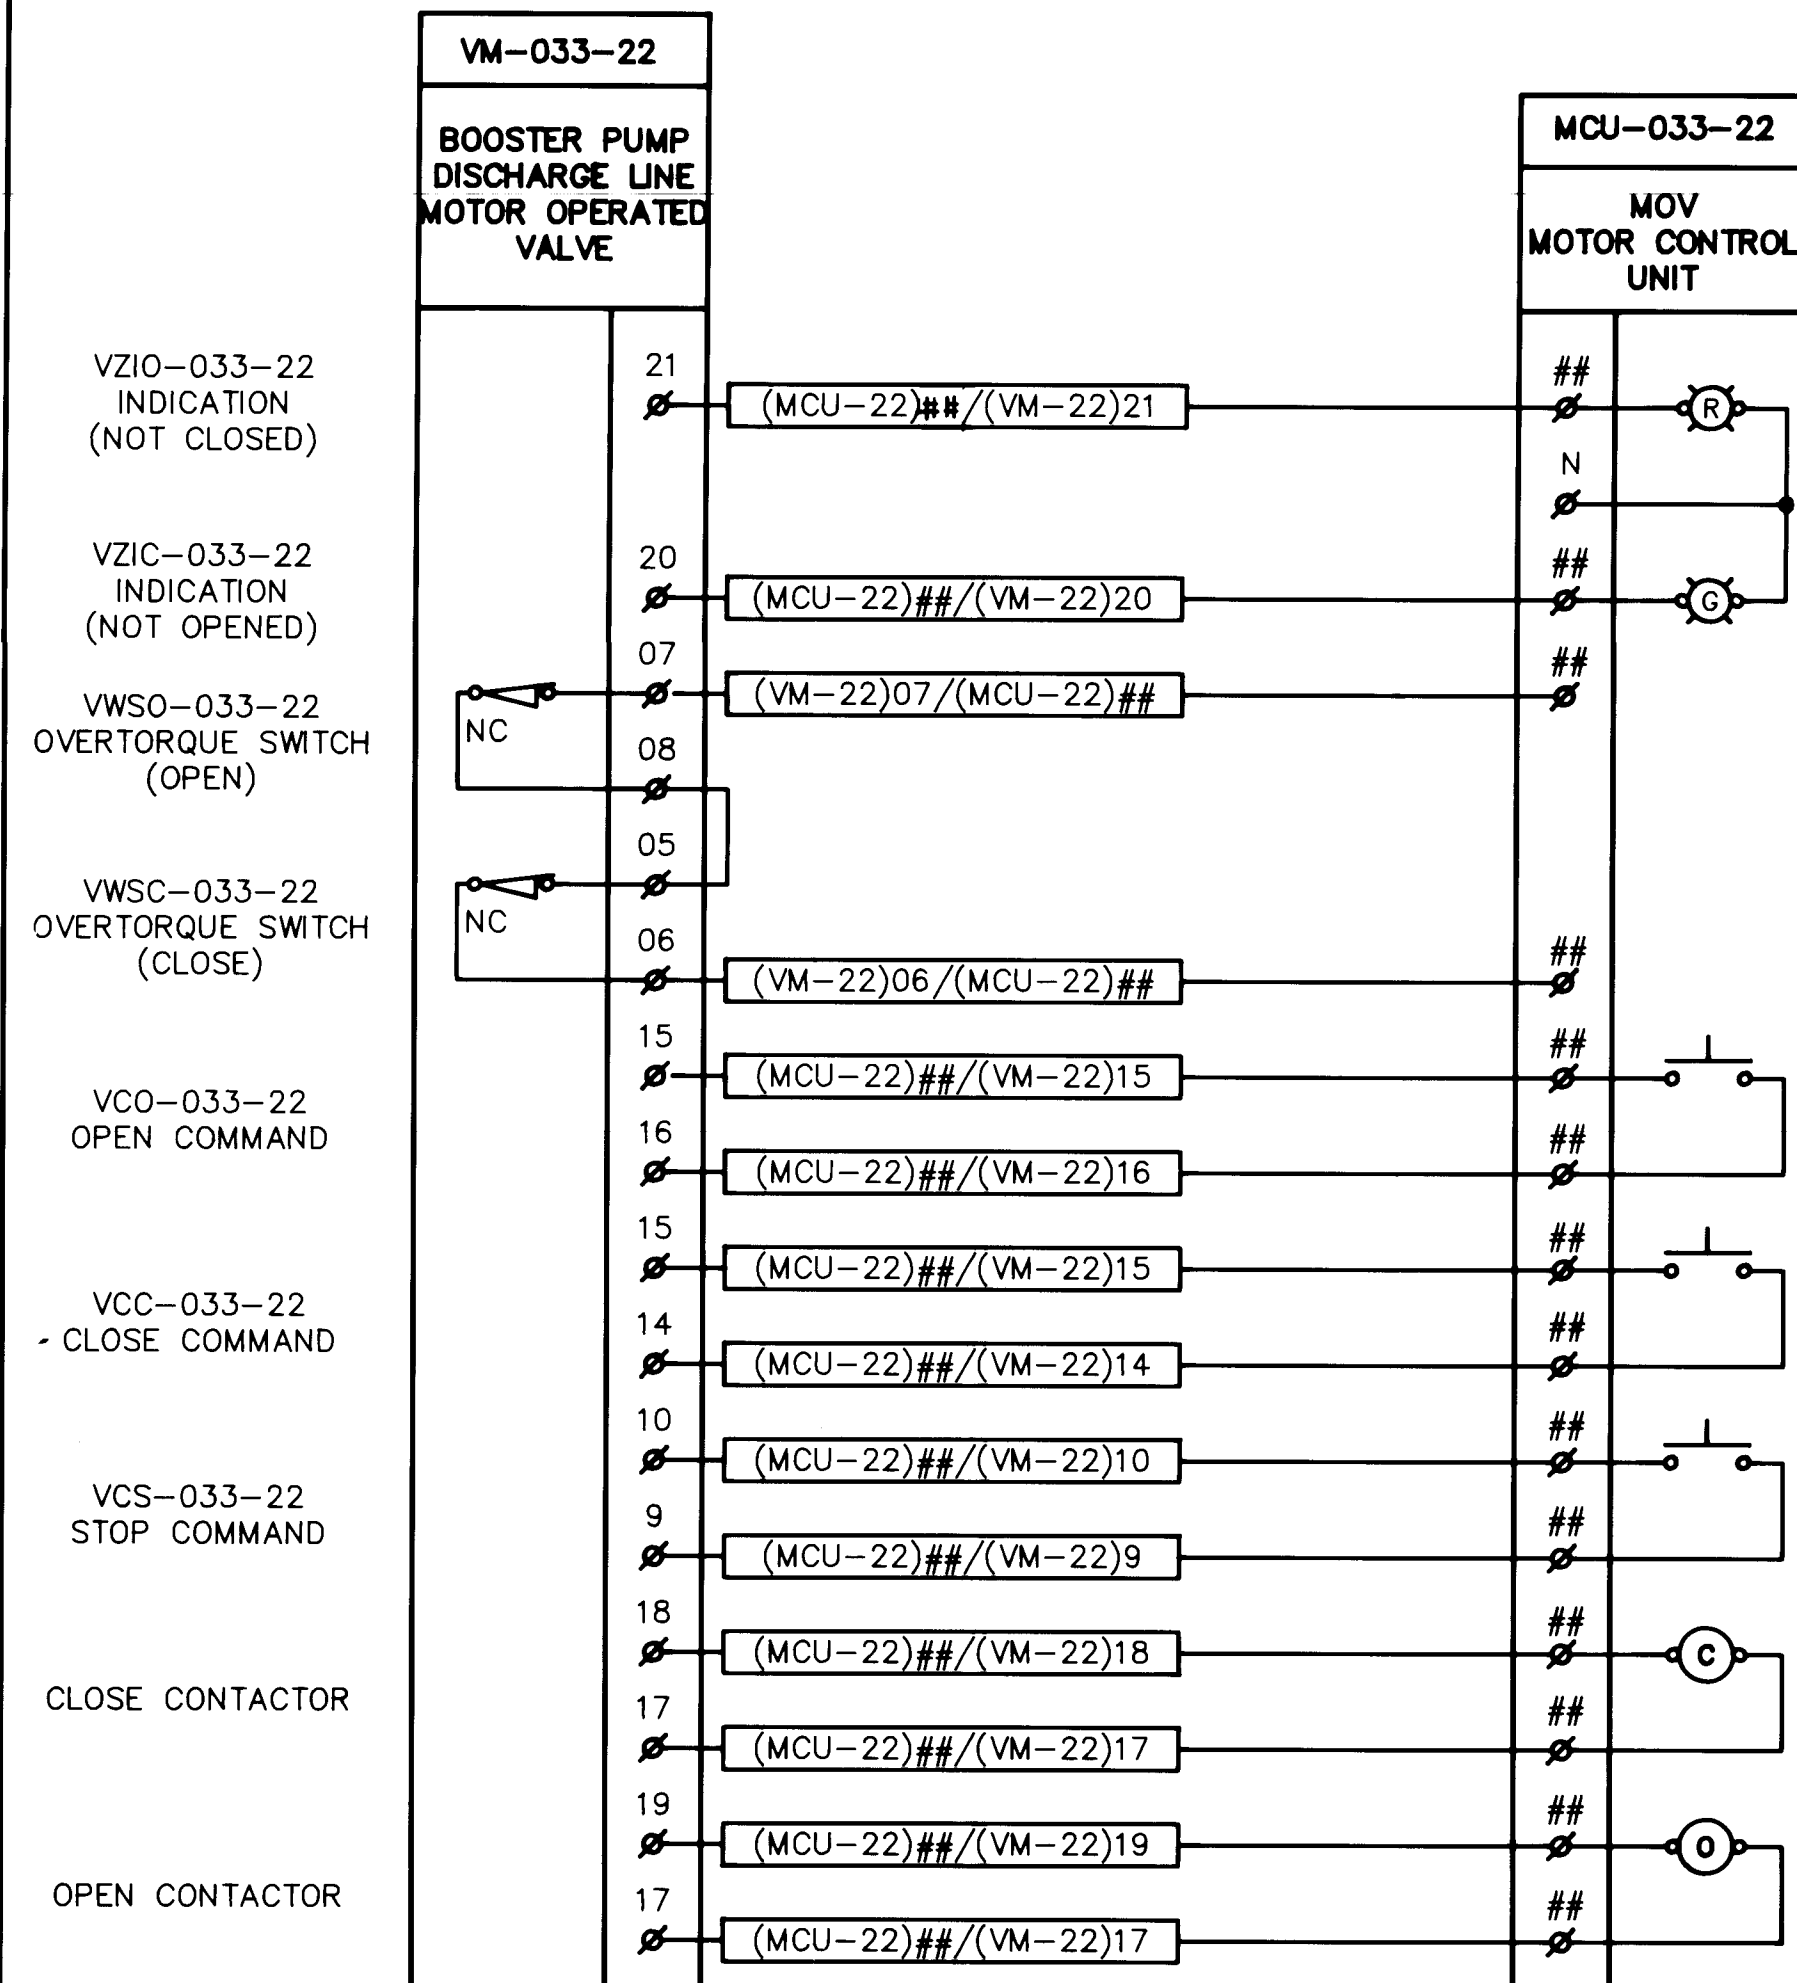

MAS-033-20A
MCU ALARM/SWITCH
(MFM RELAY "TRIP")

MAS-033-20B
MCU ALARM/SWITCH
(MFM RELAY "GROUND FAULT")

MAS-033-20C
MCU ALARM/SWITCH
(MFM RELAY "FAIL")

MAS-033-20E
MCU ALARM SWITCH
(VALVE MALFUNCTION)

MI-033-20
MCU RUN
INDICATION

MC-033-20
RUN/STOP
COMMAND

XT-033-20
BOOSTER PUMP MOTOR
VIBRATION LOOP

JS-033-20
BOOSTER PUMP
ELECTRICAL
CONSUMPTION
PULSE METER (KYZ)

VZSO-033-20
POSITION SWITCH
(FULL OPEN)

VZSC-033-20
POSITION SWITCH
(NOT CLOSED)



VS-033-20
PUMP CONTROL VALVE
SOLENOID

VZSC-033-22
POSITION SWITCH
(NOT CLOSED)

VZSO-033-22
POSITION SWITCH
(NOT OPENED)

VZSC-033-22
POSITION SWITCH
(FULL CLOSED)

XT-033-20
BOOSTER PUMP MOTOR
VIBRATION
TRANSMITTER

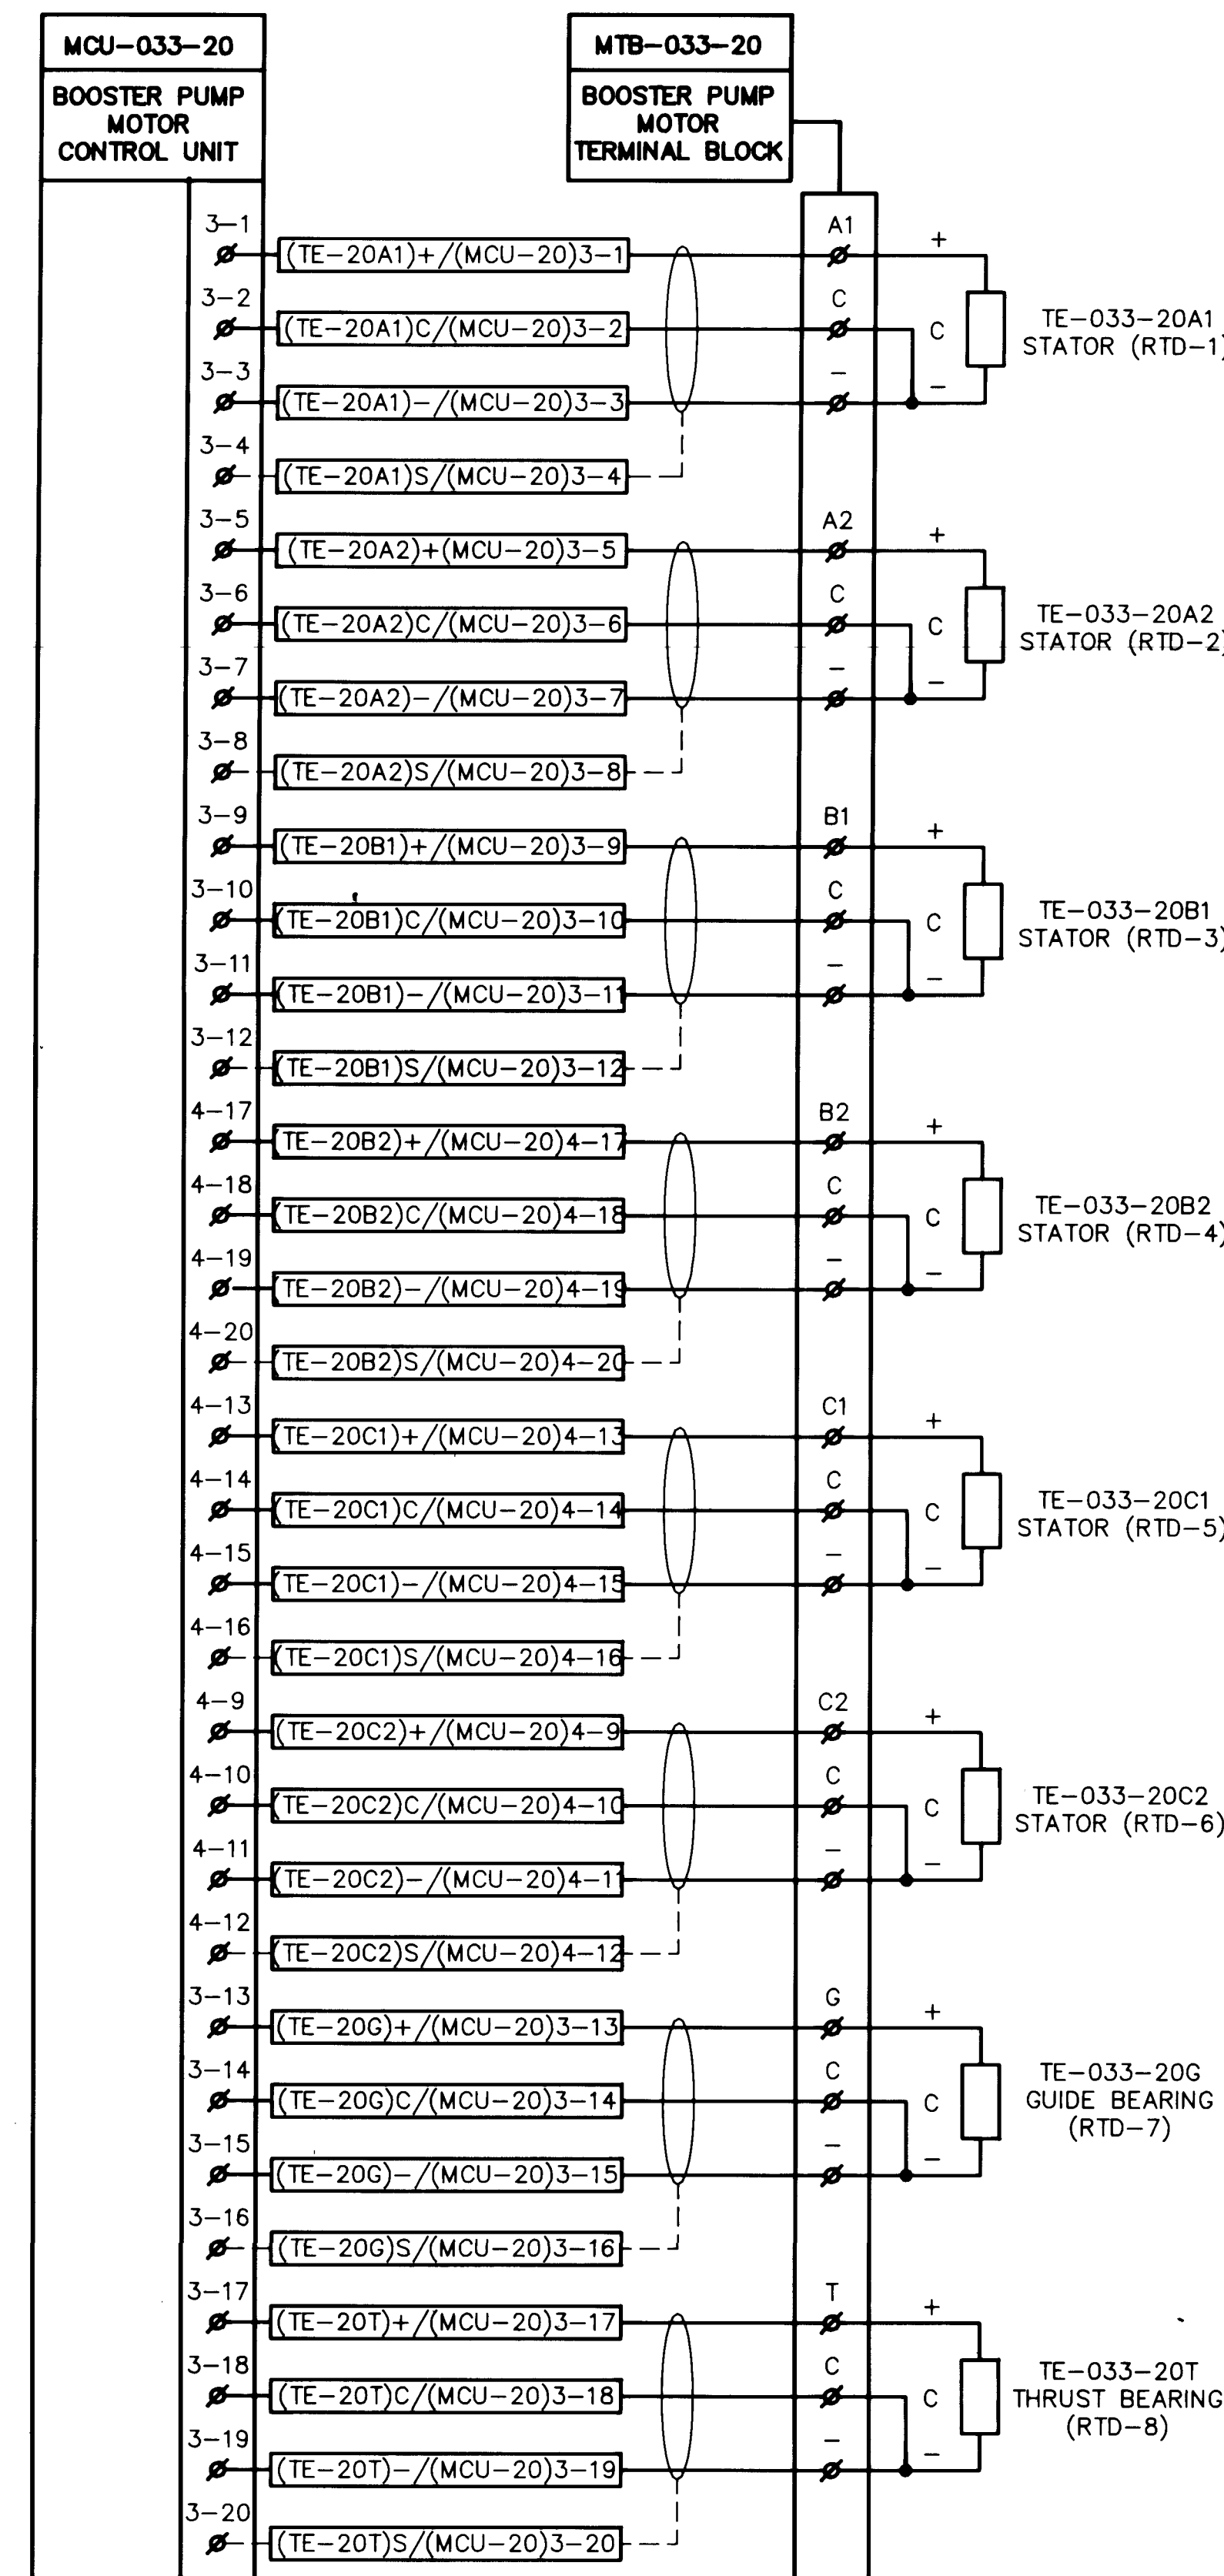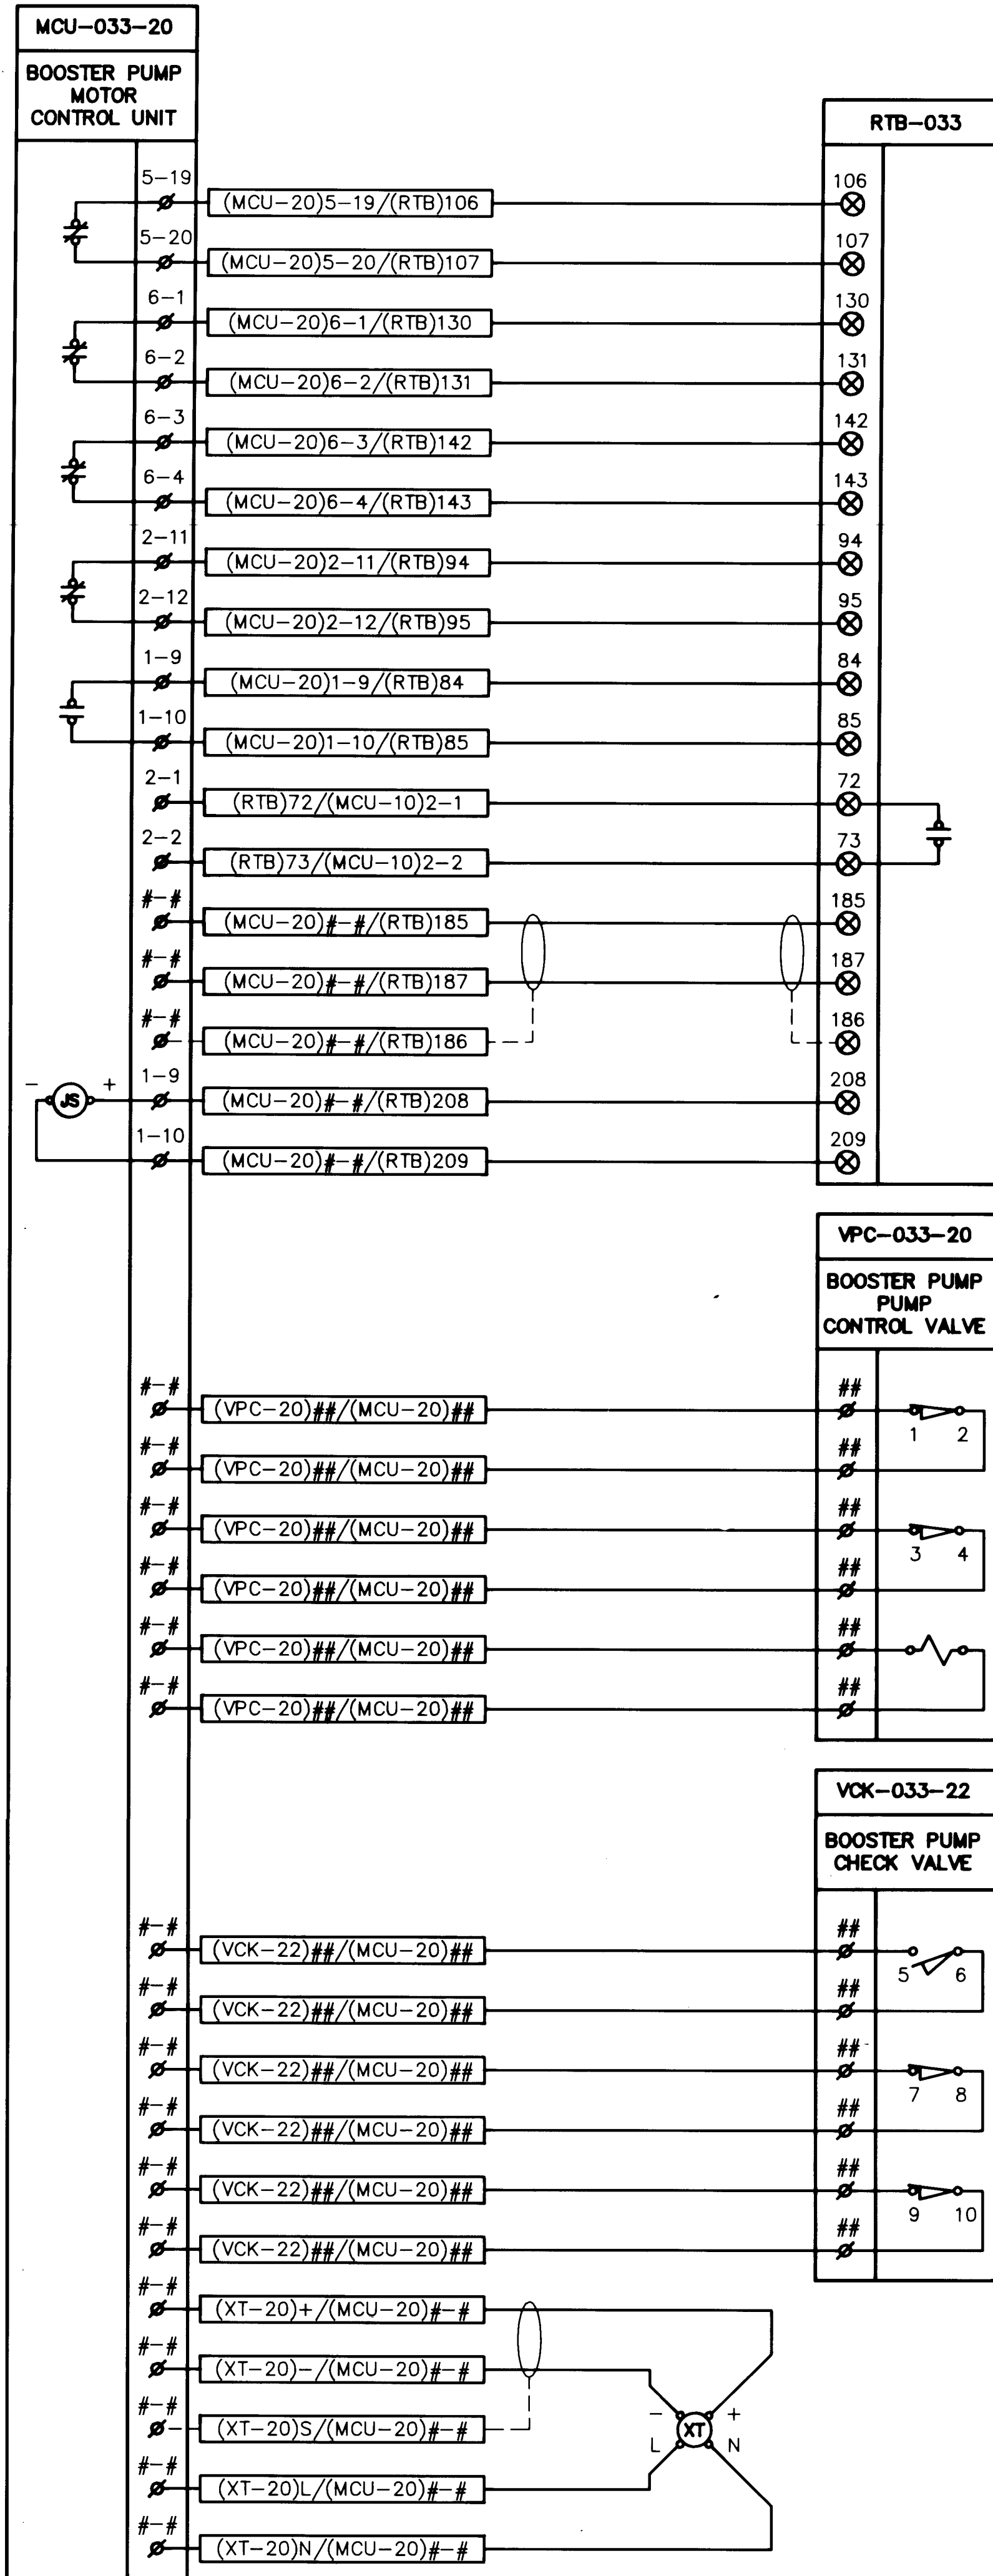

THIS SHEET SUPERSEDED BY
SIMILAR SHEET MARKED "REDRAWN
FOR RECORD PURPOSES"

802621GED1/G8026E15

CITY OF ALBUQUERQUE
PUBLIC WORKS DEPARTMENT
ENGINEERING GROUP


TITLE: GUTIERREZ PUMP STATION RECONSTRUCTION
INTERCONNECTION DIAGRAMS - PUMP NO. 2

APPROVALS	ENGINEER	DATE	APPROVALS	ENGINEER	DATE
DRC CHAIRMAN	<i>[Signature]</i>	11-16-90	WATER	<i>R.W. Kane</i>	11-13-90
TRANSPORTATION	<i>N.B. RHO</i>	11-16-90	WASTE WATER	<i>R.W. Kane</i>	11-13-90
HYDROLOGY	<i>LDm</i>	11-15-90			

PROJECT NO. 3337.90 MAP NO. F-22 SHEET E13 OF 19

GENERAL NOTES

- SEE SHEET E-1 FOR SYMBOLS LEGEND AND ABBREVIATIONS LIST.
- SEE SHEET E-8 FOR SCHEDULES.
- REPLACE "##" AND "#-#" WITH ACTUAL TERMINAL ASSIGNMENTS BASED ON MANUFACTURERS SHOP DRAWINGS (TYPICAL).

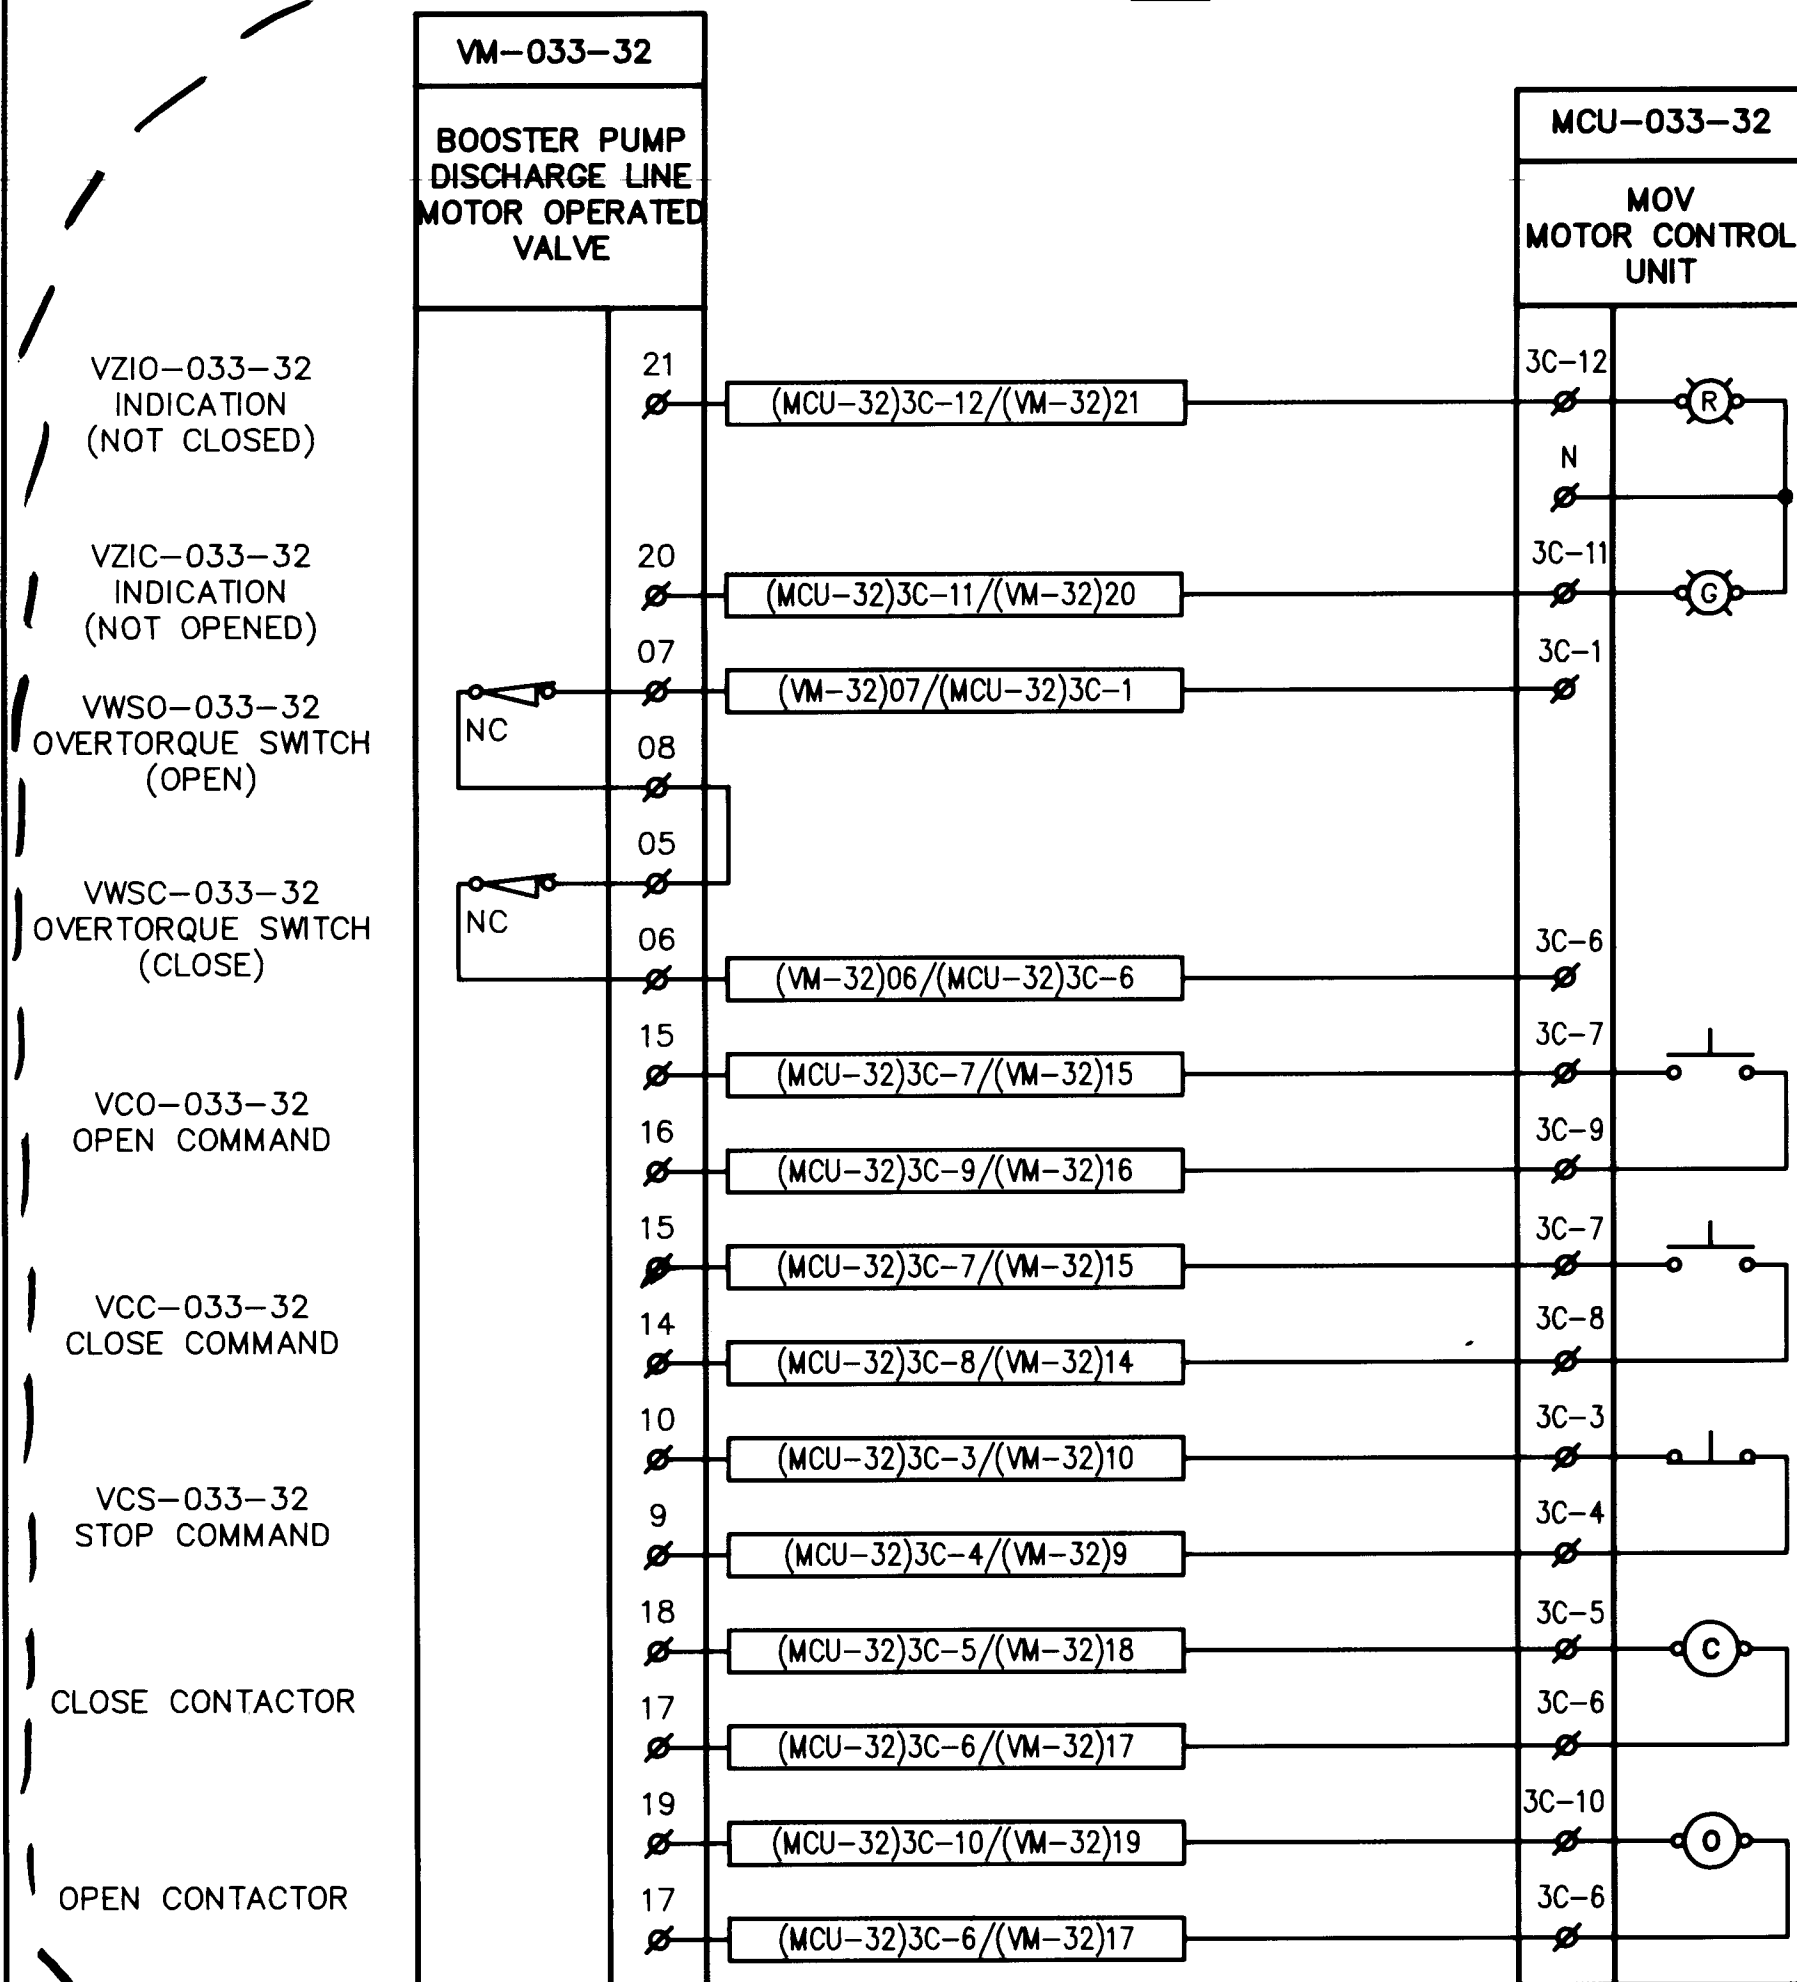

MAS-033-30A
MCU ALARM/SWITCH
(MFM RELAY "TRIP")

MAS-033-30B
MCU ALARM/SWITCH
(MFM RELAY "GROUND FAULT")

MAS-033-30C
MCU ALARM/SWITCH
(MFM RELAY "FAIL")

MAS-033-30E
MCU ALARM SWITCH
(VALVE MALFUNCTION)

MI-033-30
MCU RUN
INDICATION

MC-033-30
RUN/STOP
COMMAND

XT-033-30
BOOSTER PUMP MOTOR
VIBRATION LOOP



JS-033-30
BOOSTER PUMP
ELECTRICAL
CONSUMPTION
PULSE METER (KYZ)

VZSO-033-30
POSITION SWITCH
(FULL OPEN)

VZSC-033-30
POSITION SWITCH
(NOT CLOSED)

VS-033-30
PUMP CONTROL VALVE
SOLENOID

XT-033-30
BOOSTER PUMP MOTOR
VIBRATION
TRANSMITTER

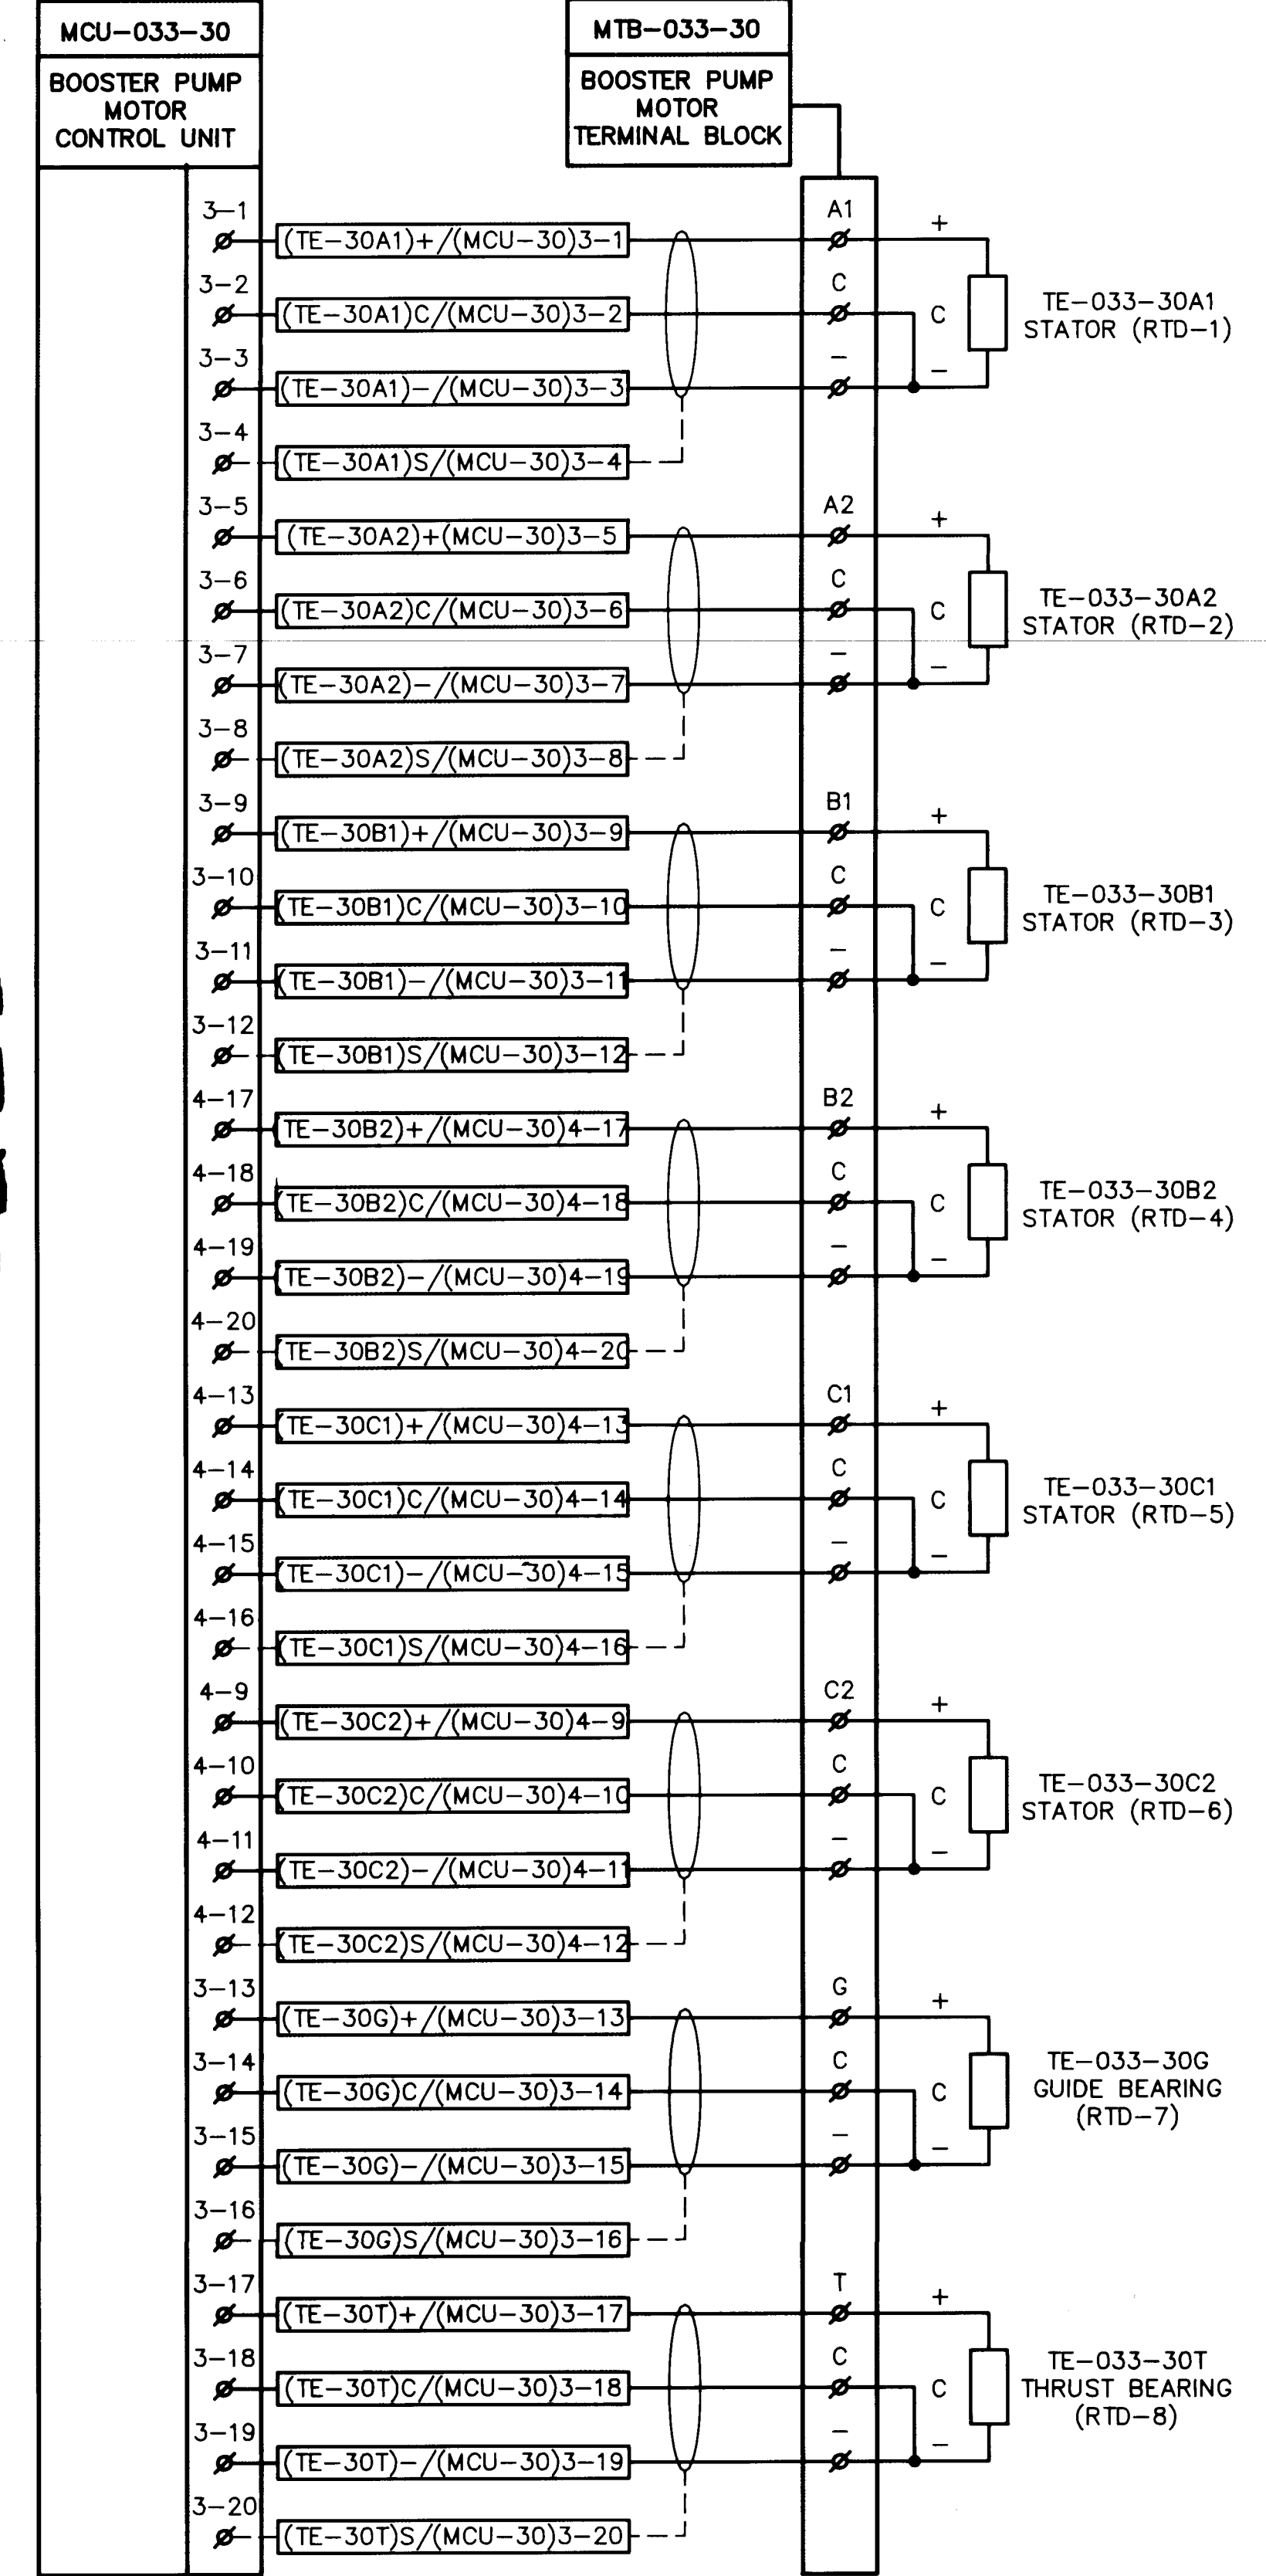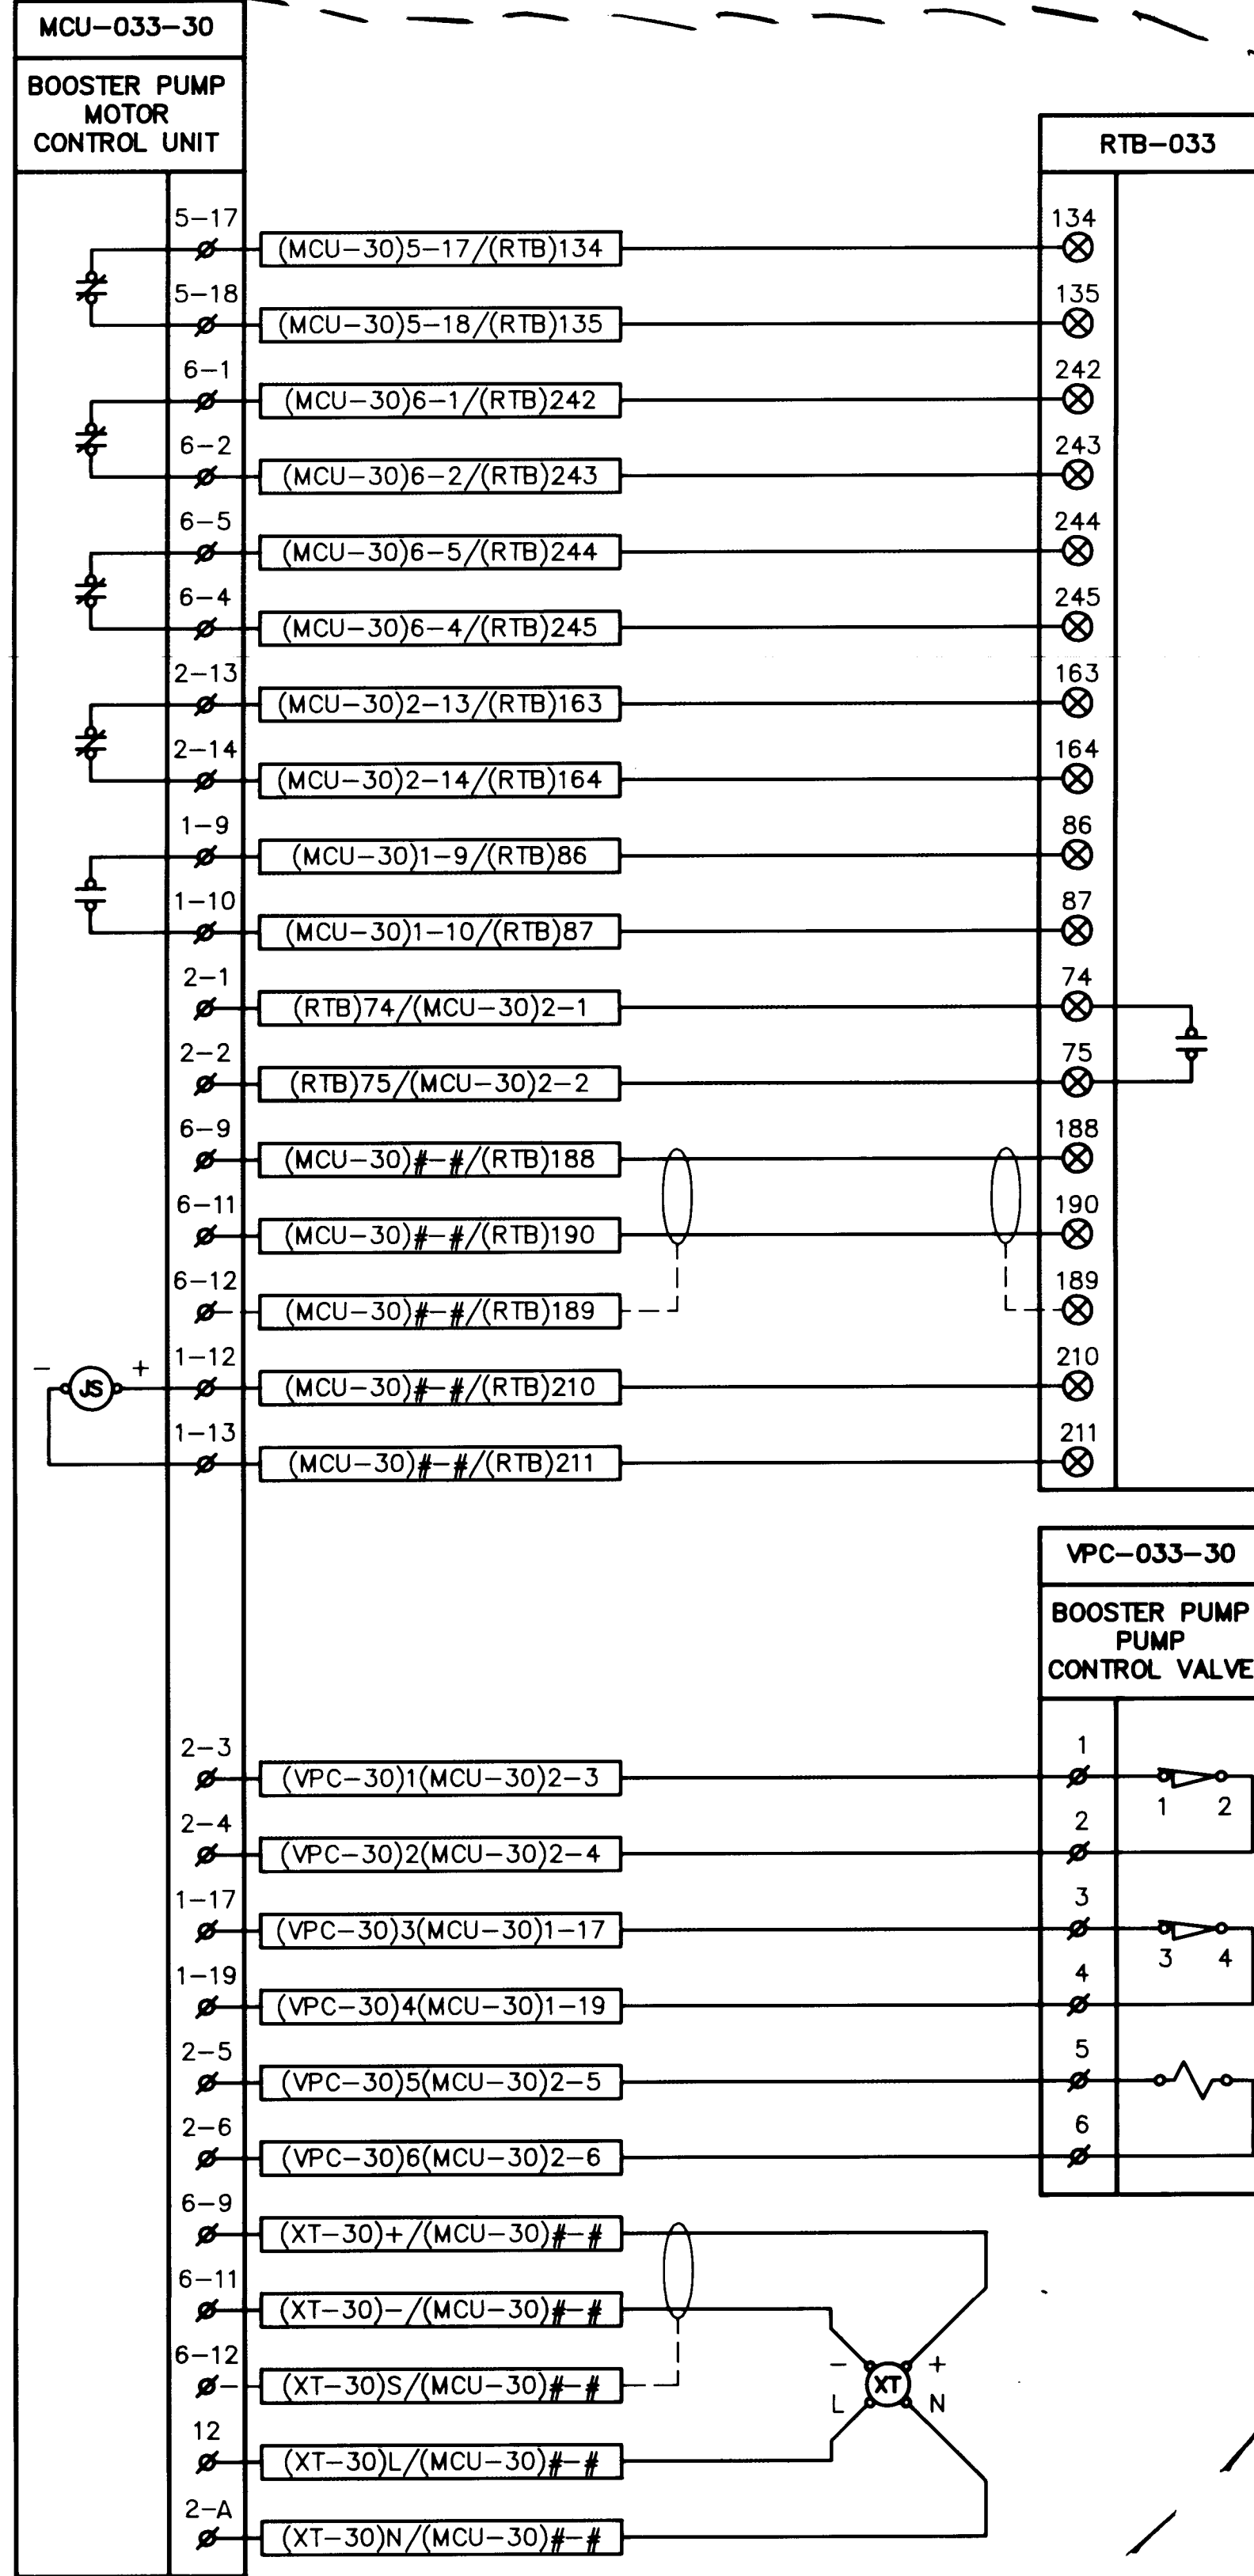

REDRAWN FOR RECORD PURPOSES

RECORD DRAWING
DATE FEB 1992
These drawings have been reviewed and
certified date and every measurement
has been made to depict construction as
actually performed

CITY OF ALBUQUERQUE PUBLIC WORKS DEPARTMENT ENGINEERING GROUP					
TITLE: GUTIERREZ PUMP STATION RECONSTRUCTION INTERCONNECTION DIAGRAMS - PUMP NO. 3					
APPROVALS	ENGINEER	DATE	APPROVALS	ENGINEER	DATE
DRC CHAIRMAN			WATER		
TRANSPORTATION			WASTE WATER		
HYDROLOGY					
PROJECT NO.	3337.90	MAP NO.	F-22	SHEET	OF
				E14	19