


WALKER NO. 2 WELL EQUIPMENT

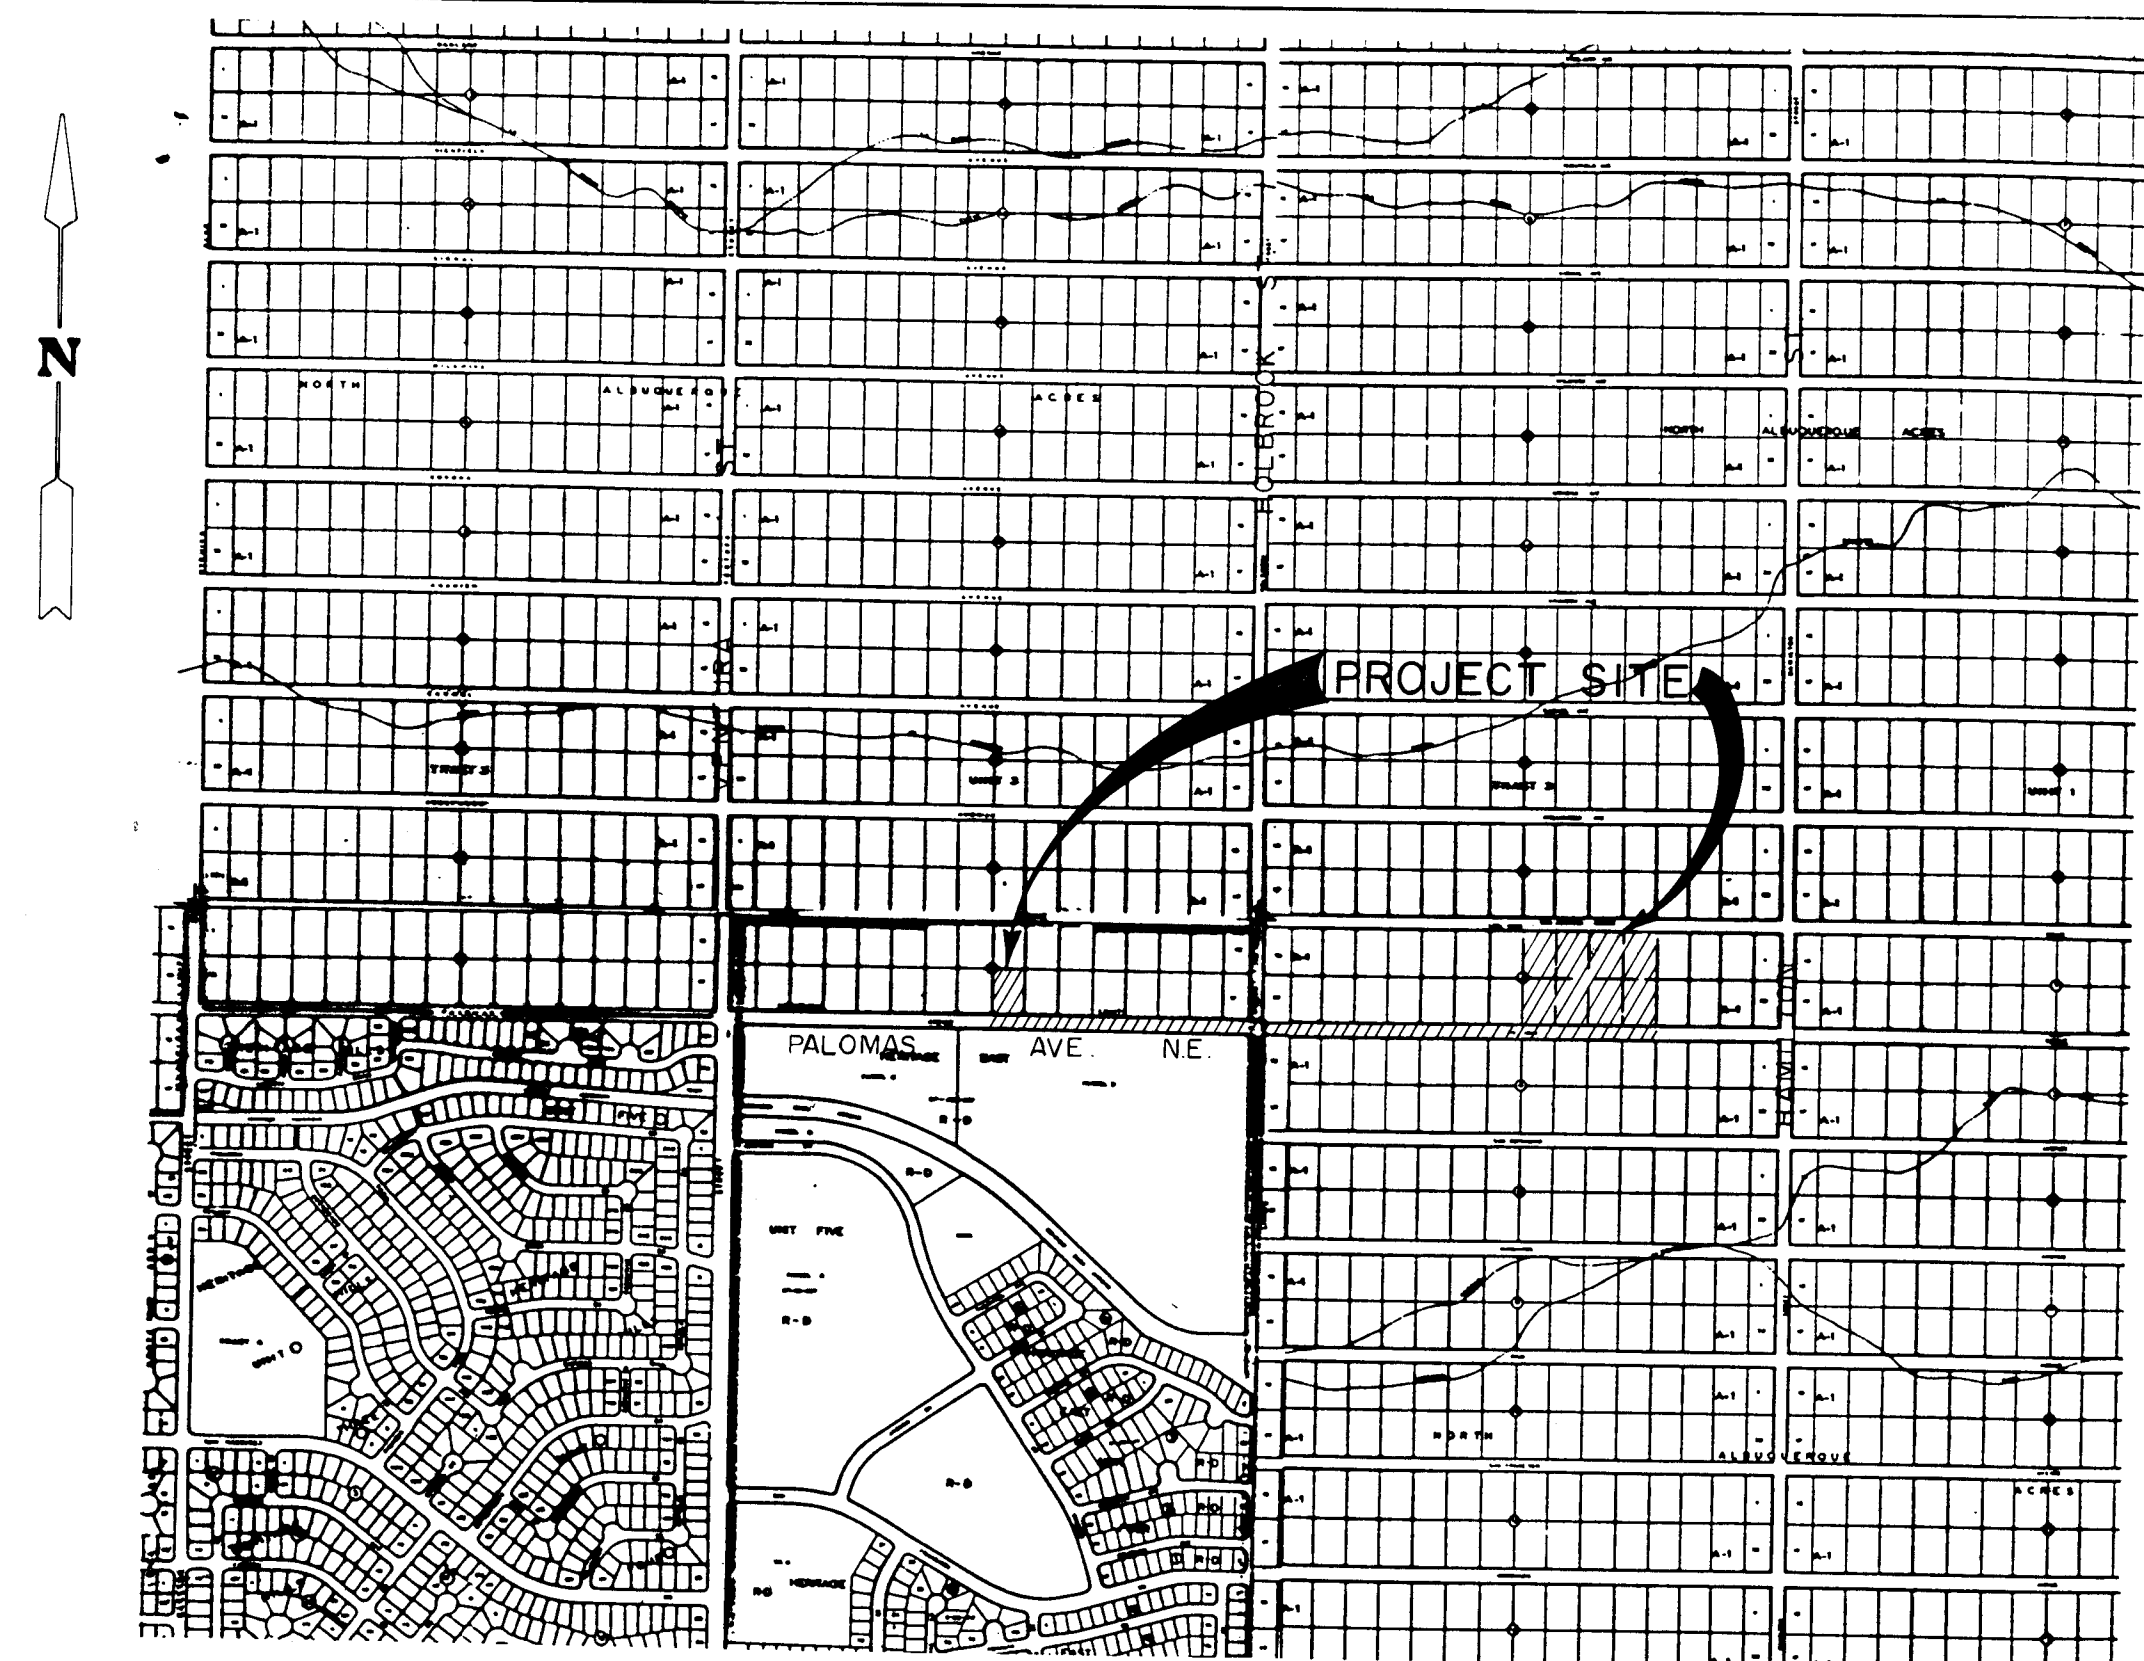

LOCATION MAP
SCALE: 1" = 800'
ZONE ATLAS D-20 & D-21

INDEX OF DRAWINGS

SHEET NO.	TITLE
1 OF 15	COVER
2 OF 15	LEGEND
3 OF 15	LAYOUT AND GRADING PLAN
4 OF 15	ELEVATIONS
5 OF 15	FOUNDATION PLAN AND DETAILS
6 OF 15	FLOOR AND PIPING PLAN
7 OF 15	PIPING SCHEMATIC
8 OF 15	WALL SECTIONS
9 OF 15	ROOF FRAMING AND ROOF DRAINAGE PLAN
10 OF 15	ENCLOSURE DETAILS
11 OF 15	MISCELLANEOUS DETAILS
12 OF 15	PUMP FOUNDATION AND MISCELLANEOUS DETAILS
13 OF 15	PLAN AND PROFILE - WELL COLLECTOR LINE
14 OF 15	PLAN AND PROFILE - WELL COLLECTOR LINE
15 OF 15	PLAN AND PROFILE - WASH LINE

MECHANICAL

M-1 OF M-2	MECHANICAL FLOOR PLAN
M-2 OF M-2	MECHANICAL DETAILS

ELECTRICAL

E-1 OF E-9	ELECTRICAL LEGEND
E-2 OF E-9	ELECTRICAL SITE PLAN, CONDUIT SCHEDULES AND PANELBOARD SCHEDULE
E-3 OF E-9	ONE LINE DIAGRAM/PIPING AND INSTRUMENT DIAGRAM
E-4 OF E-9	LIGHTING AND RECEPTACLE PLAN
E-5 OF E-9	POWER AND SPECIAL SYSTEMS PLAN
E-6 OF E-9	CONTROL SCHEMATICS
E-7 OF E-9	INTERCONNECTION DIAGRAMS
E-8 OF E-9	INTERCONNECTION DIAGRAMS
E-9 OF E-9	DETAILS

LANDSCAPING

L-1 OF L-3	IRRIGATION PLAN
L-2 OF L-3	PLANTING PLAN
L-3 OF L-3	IRRIGATION AND PLANTING DETAILS

1 2 3 4 5 6 7 8 9 10 11 12
2 6 3 3 3 8 0 1 8 9

REV	SHEETS	CITY ENGINEER	DATE	USER DEPT	DATE	USER LEFT	DATE
APPROVAL OF REVISIONS							
RECORD DRAWING AUG 10 1989 These drawings have been revised based on field data and every reasonable attempt has been made to depict construction as actually performed.				LEEDSHILL-HERKENHOFF, INC. Copper Square, 500 Copper Ave. N.W. P.O. Box 1217 Albuquerque, New Mexico 87103 (505) 247-0294			
PROJECT NO. 3338				APPROVED FOR CONSTRUCTION SHEET 1 OF 15			

PROPOSED	EXISTING	DESCRIPTION
●	○	SANITARY SEWER MANHOLE
○	○	STORM DRAIN MANHOLE
NA	○ TELE MH	TELEPHONE MANHOLE
— SAS 8" CP	— SAS 8" CP	SANITARY SEWER LINE W/SIZE & TYPE
— SD 48" RCP	— SD 48" RCP	STORM DRAIN LINE W/SIZE & TYPE
— W 6" CI	— W 6" CI	WATER LINE W/SIZE & TYPE
NA	— [E] —	OVERHEAD ELECTRICAL LINES
— [UE] —	— [UE] —	UNDERGROUND ELECTRICAL /TRAFFIC CONTROL
NA	— [UT] —	UNDERGROUND TELEPHONE
NA	— [G] HP	GAS LINES W/SIZE & TYPE
NA	— [CT] —	CABLE TELEVISION LINES
[]	[]	ENCASEMENT
[]	[]	STORM DRAIN INLETS (GRADE ELEVATION GIVEN IN PLANS IS EXTENDED FLOW LINE)
[]	[]	GATE VALVE
[]	[]	BUTTERFLY VALVE
[]	[]	FIRE HYDRANTS
[]	[]	REDUCERS
[]	[]	SAS SERVICE CONNECTION
[]	[]	WATER SERVICE CONNECTION
[]	[]	TEES
[]	[]	CROSSES
[]	[]	BENDS
[]	[]	CAPS & PLUGS
NA	[] WM	WATER METER
● VB	● VB	VALVE BOX
NA	● PP	POWER POLE
NA	● LP	LIGHT POLE
● TL	● TL	TRAFFIC LIGHT
■ TC	■ TC	TRAFFIC CONTROL BOX
■ PB	■ PB	PULL BOX
NA	■ TB	TELEPHONE BOOTH
[]	[]	CURB & GUTTER
[]	[]	SIDEWALK
[]	[]	BLOCK WALL
[]	[]	CHAIN LINK FENCE
[]	[]	FIELD FENCE
NA	NA	SPOT ELEVATIONS
NA	—	PROJECT/PHASE BOUNDARY
NA	—	RIGHT OF WAY LINES
NA	—	PROPERTY LINES (SIDE)
NA	—	PUBLIC EASEMENTS

LEGEND

PROJECT Walker Well No. 2
Palomas Ave. NE, Albuquerque, NM
JOB NO. E88-1148 DATE 8/30/88

LOG OF TEST BORING NO. 2

RIG TYPE CME-55
BORING TYPE 6-1/2" Hollow stem auger
SURFACE ELEV. DATUM

DEPTH IN FEET	CONSTRUCTION RESISTANCE	DEPTH IN FEET	CONSTRUCTION RESISTANCE	REMARKS	VISUAL CLASSIFICATION
0		0		firm	SAND, fine to coarse, considerable clay, some silt, low plasticity, dark brown
5		5		moderately firm	SANDY SILT, low plasticity to nonplastic, brown
10		10		firm	SILTY SAND, fine to medium, some coarse, calcareous cementation, nonplastic to low plasticity, light brown
15		15		very firm	CLAYEY SAND, fine to medium, some coarse, some silt, low plasticity brown to light brown
20		20		very firm	CLAYEY SAND, fine to medium, some coarse, some silt, low plasticity brown to light brown
25		25		firm	SAND, fine to coarse, trace silt, some gravel, nonplastic, brown to light brown
30		30		firm	SILTY SAND, predominantly fine, some medium to coarse, some gravel, nonplastic, brown to light brown
35		35		very firm	SILTY SAND, fine, nonplastic, brown
40		40		Stopped auger @ 39' 6"	Stopped sampler @ 41'

GROUNDWATER DEPTH 40' 6" DATE 8/30/88

SAMPLE TYPE A - Auger cuttings, B - Block sample, C - 2" O.D. 1.38" I.D. tube sample, D - 3" O.D. 2.42" I.D. tube sample, E - 3" O.D. thin-walled Shelby tube.

SERGEANT, HAUSKINS & BECKWITH
CONSULTING GEOTECHNICAL ENGINEERS
PHOENIX - ALBUQUERQUE - SANTA FE
SALT LAKE CITY - EL PASO - TUCSON

UNIFIED SOIL CLASSIFICATION SYSTEM

Soils are usually classified by the Unified Soil Classification System on the boring logs presented in this report. Grain-size analysis, and Atterberg Limits Tests are often performed on selected samples to aid in classification. The classification system is briefly outlined on this chart. For a more detailed description of the system, see "The Unified Soil Classification System" Comp. of Engineers, US Army Technical Memorandum No. 3-357 (Revised April 1960) or ASTM Designation: D2487-66T.

MAJOR DIVISIONS	GRAPHIC SYMBOL	TYPICAL NAMES
CLEAN GRAVELS (Less than 5% passes No. 200 sieve)	GW	Well graded gravels, gravel-sand mixtures, or sand-gravel-cobble mixtures.
GRAVELS WITH FINES (More than 12% passes No. 200 sieve)	GP	Poorly graded gravels, gravel-sand mixtures, or sand-gravel-cobble mixtures.
CLEAN SANDS (Less than 5% passes No. 200 sieve)	SW	Well graded sands, gravelly sands.
SANDS WITH FINES (More than 12% passes No. 200 sieve)	SP	Poorly graded sands, gravelly sands.
SILTS OF LOW PLASTICITY (Liquid Limit Less Than 50)	ML	Inorganic silts, clayey silts with slight plasticity.
SILTS OF HIGH PLASTICITY (Liquid Limit More Than 50)	MH	Inorganic silts, micaceous or diatomaceous silty silts, elastic silts.
CLAYS OF LOW PLASTICITY (Liquid Limit Less Than 50)	CL	Inorganic clays of low to medium plasticity, gravelly clays, sandy clays, silty clays, lean clays.
CLAYS OF HIGH PLASTICITY (Liquid Limit More Than 50)	CH	Inorganic clays of high plasticity, fat clays, sandy clays of high plasticity.

NOTE: Coarse grained soils with between 5% & 12% passing the No. 200 sieve and fine grained soils with limits plotting in the hatched zone on the plasticity chart to have double symbol.

PLASTICITY CHART

DEFINITIONS OF SOIL FRACTIONS

SOIL COMPONENT	PARTICLE SIZE RANGE
Cobbles	Above 3 in.
Gravel	3 in. to No. 4 sieve
Coarse gravel	3 in. to 1/2 in.
Fine gravel	1/2 in. to No. 4 sieve
Sand	No. 4 to No. 200
Coarse sand	No. 4 to No. 10
Medium sand	No. 10 to No. 40
Fine sand	No. 40 to No. 200
Fines (silt or clay)	Below No. 200 sieve

PROJECT Walker Well No. 2
Palomas Ave. NE, Albuquerque, NM
JOB NO. E88-1148 DATE 8/30/88

LOG OF TEST BORING NO. 1

RIG TYPE CME-55
BORING TYPE 6-1/2" Hollow stem auger
SURFACE ELEV. DATUM

DEPTH IN FEET	CONSTRUCTION RESISTANCE	DEPTH IN FEET	CONSTRUCTION RESISTANCE	REMARKS	VISUAL CLASSIFICATION
0		0		firm	SAND, fine to coarse, considerable silt, some clay, low plasticity, brown
5		5		moderately firm	SAND, predominantly fine, trace medium and coarse, considerable silt, trace gravel, nonplastic, brown
10		10		medium dense	SAND, fine to coarse, trace silt, trace gravel, nonplastic, brown
15		15		very firm	CLAYEY SAND, fine to coarse, trace gravel, low medium plasticity, brown
20		20		firm	SAND, fine to coarse, trace silt, some gravel, nonplastic, brown
25		25		hard	CLAYEY SAND, fine to medium, trace coarse, some silt, calcareous cementation nodules, low plasticity brown to light brown
30		30		Stopped auger @ 39' 6"	Stopped sampler @ 41'

GROUNDWATER DEPTH 40' 6" DATE 8/30/88

SAMPLE TYPE A - Auger cuttings, B - Block sample, C - 2" O.D. 1.38" I.D. tube sample, D - 3" O.D. 2.42" I.D. tube sample, E - 3" O.D. thin-walled Shelby tube.

SERGEANT, HAUSKINS & BECKWITH
CONSULTING GEOTECHNICAL ENGINEERS
PHOENIX - ALBUQUERQUE - SANTA FE
SALT LAKE CITY - EL PASO - TUCSON

- GENERAL NOTES
- ALL WORK DETAILED ON THESE PLANS TO BE PERFORMED UNDER THIS CONTRACT SHALL EXCEPT AS OTHERWISE STATED OR PROVIDED FOR HEREON, BE CONSTRUCTED IN ACCORDANCE WITH THE CITY OF ALBUQUERQUE STANDARD SPECIFICATIONS FOR PUBLIC WORKS CONSTRUCTION - 1986 EDITION (REFERRED TO HEREINAFTER AS THE STANDARD SPECIFICATIONS).
 - TWO (2) WORKING DAYS PRIOR TO ANY EXCAVATION, CONTRACTOR MUST CONTACT LINE LOCATING SERVICE, 765-1234, FOR LOCATION OF EXISTING UTILITIES.
 - PRIOR TO CONSTRUCTION, THE CONTRACTOR SHALL EXCAVATE AND VERIFY THE HORIZONTAL AND VERTICAL LOCATIONS OF ALL OBSTRUCTIONS. SHOULD A CONFLICT EXIST, THE CONTRACTOR SHALL NOTIFY THE ENGINEER SO THAT THE CONFLICT CAN BE RESOLVED WITH MINIMUM AMOUNT OF DELAY.
 - EXCAVATED MATERIALS WILL ONLY BE PLACED AS APPROVED BY THE PROJECT ENGINEER.
 - THE CONTRACTOR SHALL COORDINATE HIS CONSTRUCTION ACTIVITIES WITH OTHER CONTRACTORS AND UTILITY COMPANIES WORKING IN THE SAME AREA.
 - ALL PERMANENT R.O.W. AND CONSTRUCTION EASEMENTS ON PRIVATE PROPERTY WILL BE OBTAINED BY THE CITY OF ALBUQUERQUE PRIOR TO THE BEGINNING OF CONSTRUCTION.
 - WHEN ABUTTING NEW PAVEMENT TO EXISTING, CONTRACTOR SHALL SAW CUT EXISTING PAVEMENT TO A STRAIGHT LINE, AS REQUIRED, TO REMOVE ANY BROKEN OR CRACKED PAVEMENT AND MATCH NEW TO EXISTING.
 - THE CONTRACTOR SHALL EXERCISE DUE CARE TO AVOID DISTURBING EXISTING UNDERGROUND UTILITIES. IT SHALL BE HIS RESPONSIBILITY TO COORDINATE WITH THE UTILITY COMPANIES IN ORDER TO PREVENT ANY SERVICE DISRUPTION.
 - ALL REFERENCES TO CITY STANDARD DRAWINGS WILL BE PER CITY OF ALBUQUERQUE STANDARD SPECIFICATION FOR PUBLIC WORKS CONSTRUCTION, 1986.
 - THE REMOVAL AND REPLACEMENT OF PRIVATE SIGNS AND OBSTRUCTIONS SHALL BE PERFORMED BY THE RESPECTIVE PROPERTY OWNERS UNLESS OTHERWISE NOTED. COORDINATION SHALL BE THE RESPONSIBILITY OF THE PROJECT ENGINEER.
 - CONTRACTOR SHALL BE FULLY RESPONSIBLE FOR COORDINATION WITH THE WATER SYSTEMS DIVISION MANAGER (823-4200) TWO (2) WORKING DAYS PRIOR TO ANY WORK NEEDING THE EXECUTION OF THE WATER VALVE SHUT-OFF PLAN.
 - STORM DRAIN INLET/OUTLET LINES SHALL NOT ENTER OR EXIT THE STORM DRAIN INLETS IN SUCH A MANNER THAT REDUCES OR IN ANY WAY DIMINISHES THE WALL THICKNESS INTEGRITY. (SEE THE C.O.A. STD. DWG DETAILS). FURTHER, PIPES SHALL ENTER ONLY THROUGH THE FRONT, BACK OR SIDES AS SHOWN ON THE PLANS.

RECORD DRAWING

DATE AUG 1989

These drawings have been revised to reflect field data and every reasonable effort has been made to depict construction as performed.

1 2 3 4 5 6 7 8 9 10 11 12
26 33380289


CITY OF ALBUQUERQUE
MUNICIPAL DEVELOPMENT DEPARTMENT
ENGINEERING DIVISION

TITLE: WALKER NO. 2 WELL EQUIPMENT
LEGEND AND TEST BORING LOG

APPROVALS	ENGINEER	DATE	APPROVALS	ENGINEER	DATE
City Engineer	[Signature]	10-19-88	Liquid Waste	[Signature]	10-19-88
ACE - Design	[Signature]	10-19-88	Traffic	[Signature]	10-19-88
ACE - Hydrology	[Signature]	10-19-88	Water	[Signature]	10-19-88

DRAWING NO. 3338 MAP NO. D-21 SHEET 2 OF 15

[illegible]

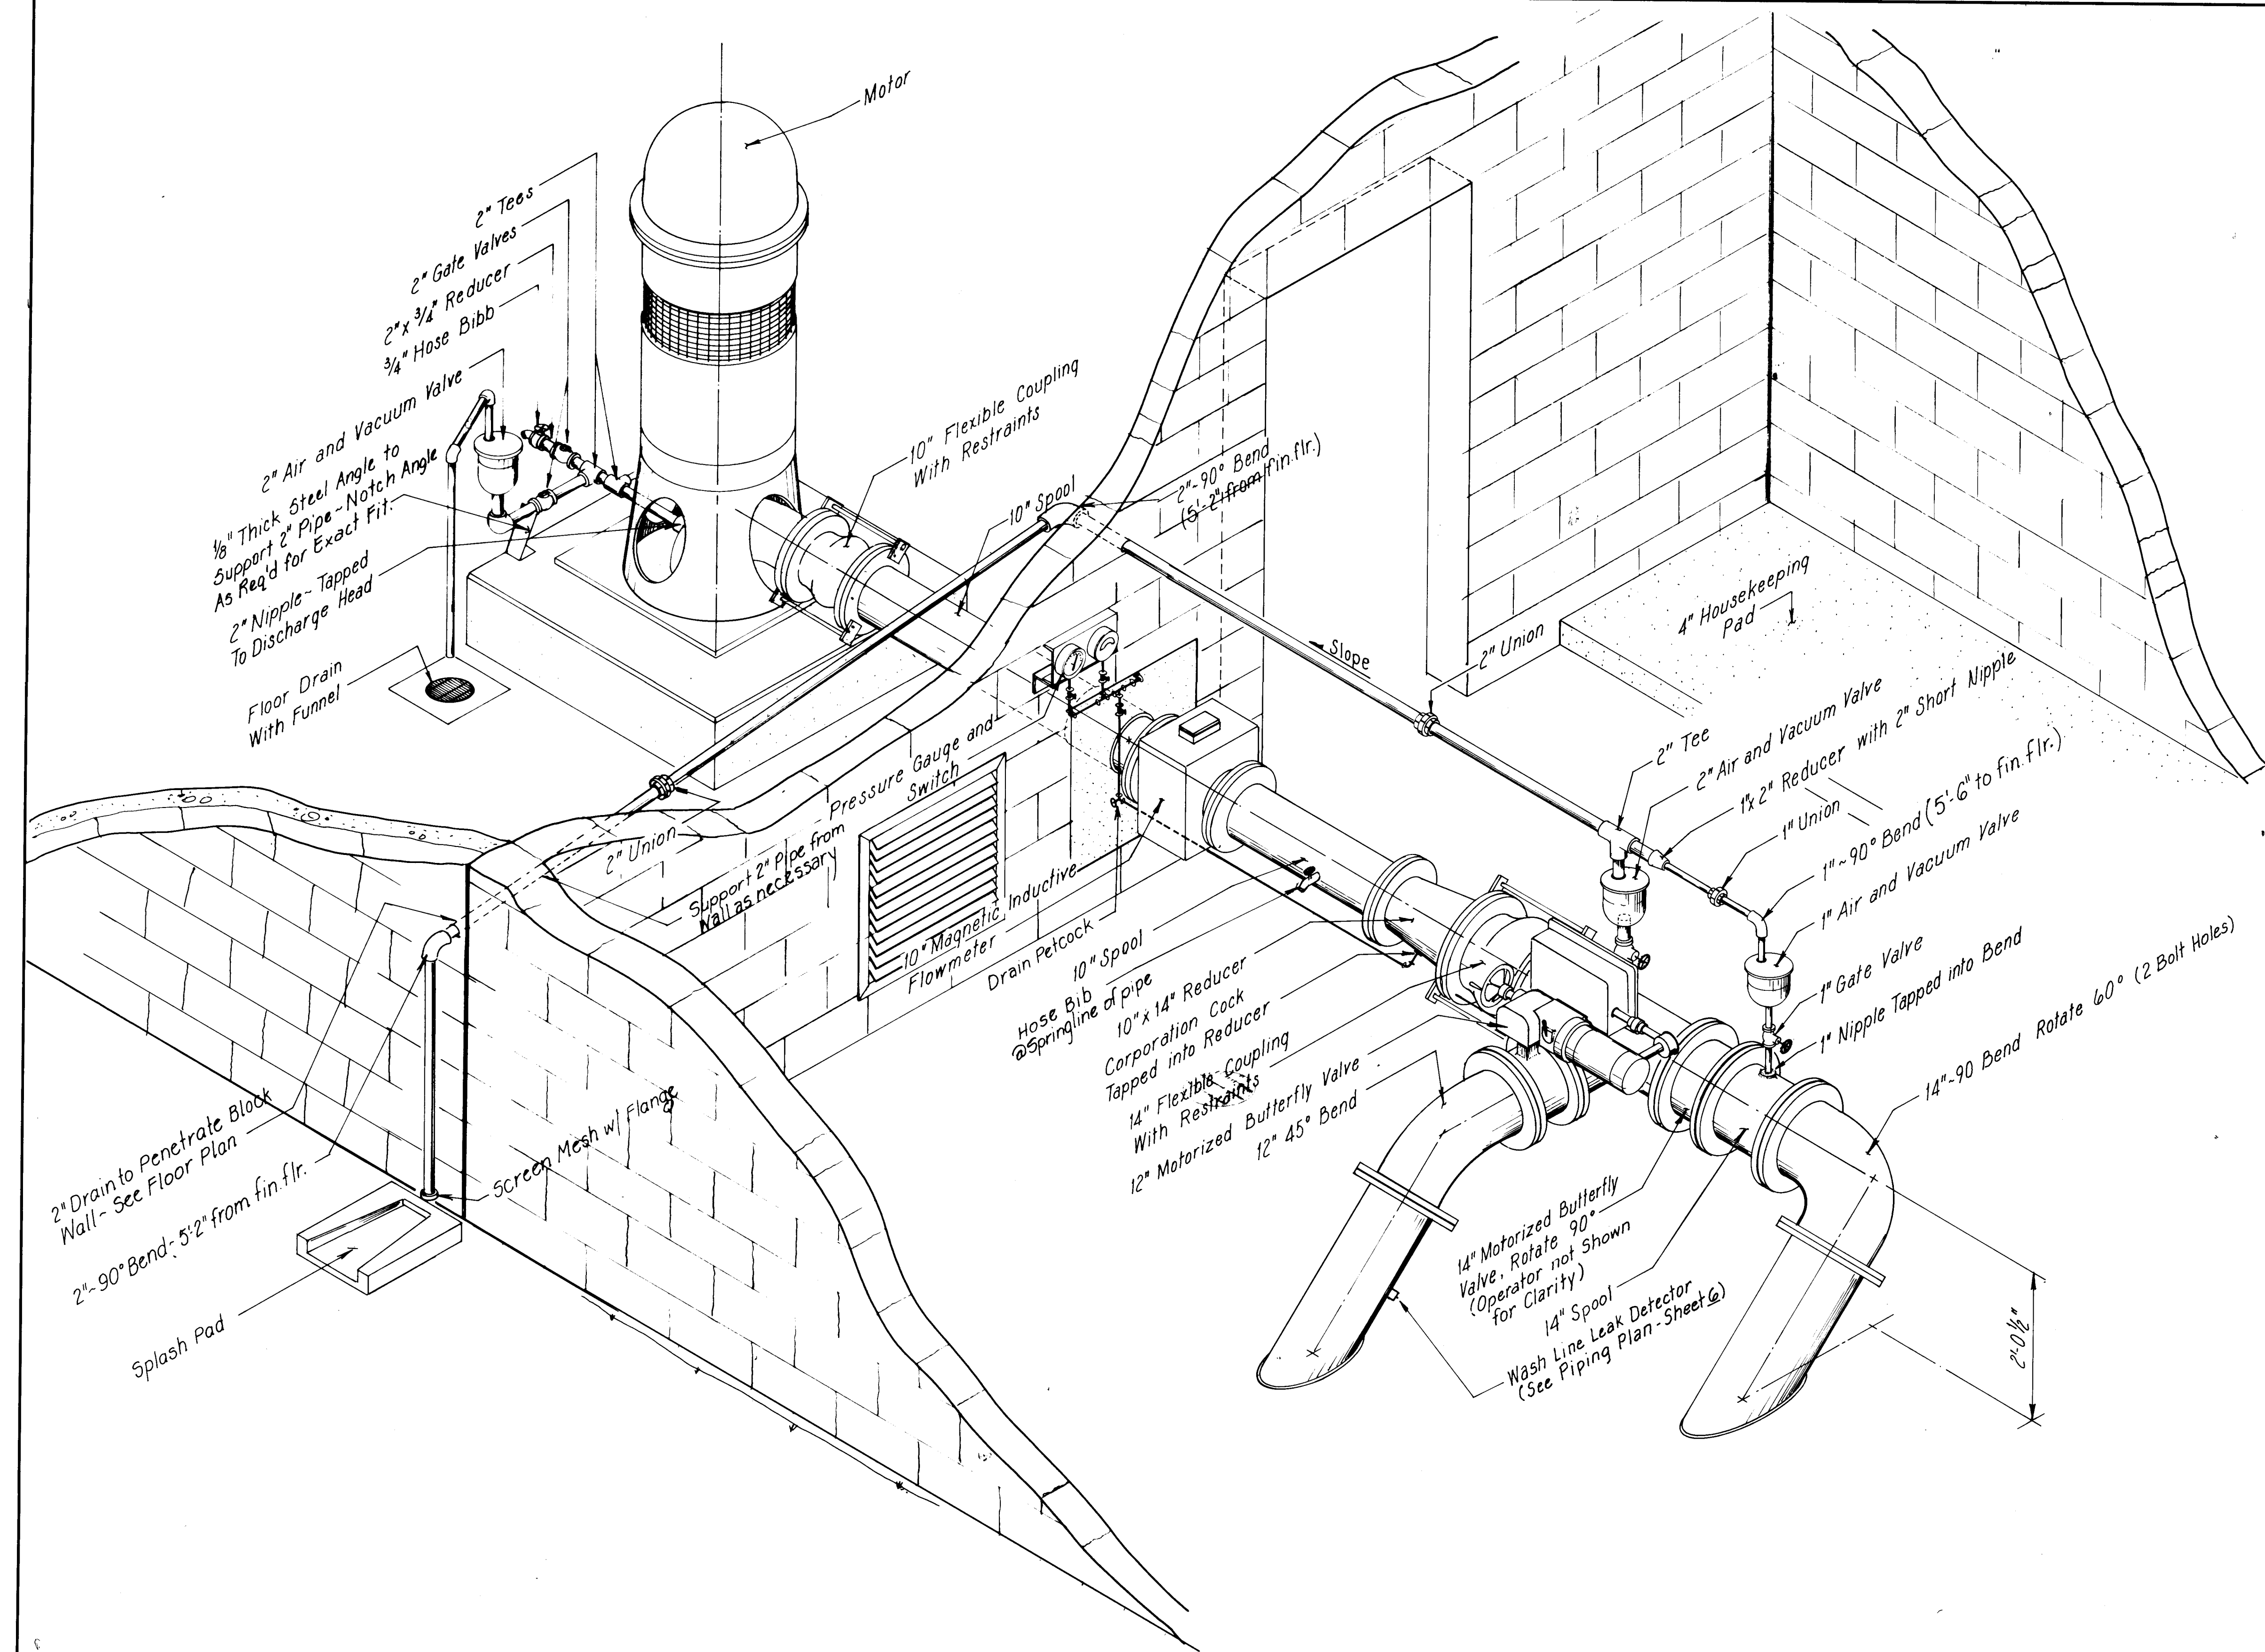




PIPING SCHEMATIC
N.T.S.

1 2 3 4 5 6 7 8 9 10 11 12
26 33380789

RECORD DRAWING
Date: 10/10/88
These drawings have been revised based on field data and every reasonable attempt has been made to depict construction as actually performed.

CITY OF ALBUQUERQUE MUNICIPAL DEVELOPMENT DEPARTMENT ENGINEERING DIVISION					
TITLE: WALKER NO. 2 WELL EQUIPMENT PIPING SCHEMATIC					
APPROVALS	ENGINEER	DATE	APPROVALS	ENGINEER	DATE
City Engineer	<i>[Signature]</i>	10.19.88	Liquid Waste	<i>[Signature]</i>	10/19/88
A.C.E. Design	<i>[Signature]</i>	10.19.88	Traffic	<i>[Signature]</i>	10/19/88
A.C.E. -Hydrology	<i>[Signature]</i>	10.19.88	Water	<i>[Signature]</i>	10/19/88
DRAWING NO. 3338		MAP NO. D-21		SHEET 7 OF 15	

ENGINEER'S SEAL		SURVEY INFORMATION		BENCH MARKS		AS BUILT INFORMATION	
		FIELD NOTES		CONTRACTOR		WORK	
		NO.	BY	DATE	NO.	BY	DATE
REMARKS		DESIGN		ACCEPTANCE BY		DATE	
DESIGNED BY M.Z. & D.D.		DATE 9-29-88		DRAWINGS		DATE	
DRAWN BY U.D.		DATE 9-29-88		CORRECTED BY		DATE	
CHECKED BY W.W.		DATE 9-29-88		MICRO-FILM INFORMATION		RECORDED BY	
						DATE	
						NO.	

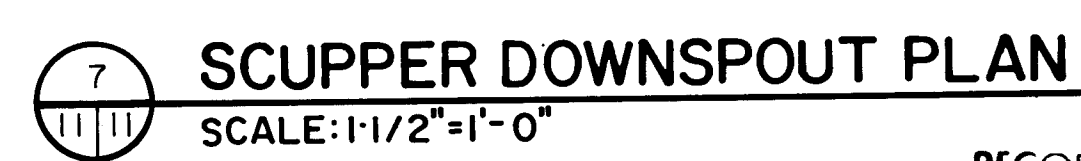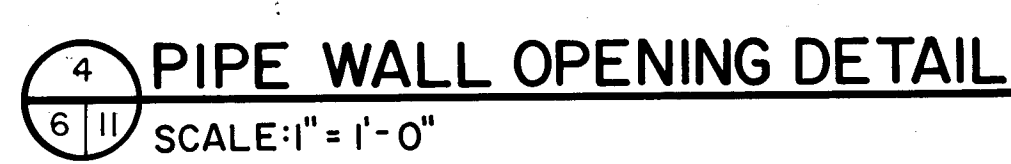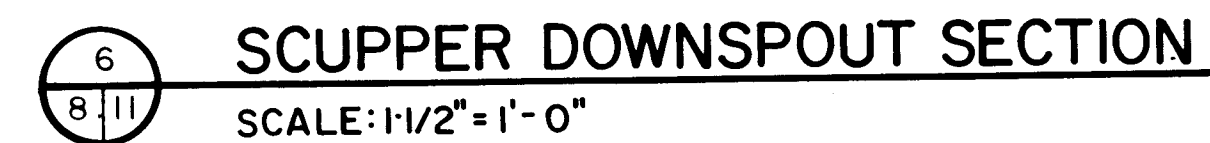


1	2	3	4	5	6	7	8	9	10	11	12
2	6		3	3	3	8	1	1	8	9	


RECORD DRAWING
AUG 10 1989

These drawings have been revised on field inspection. No reasonable effort has been made to depict construction actually performed.


CITY OF ALBUQUERQUE MUNICIPAL DEVELOPMENT DEPARTMENT ENGINEERING DIVISION					
TITLE: WALKER NO. 2 WELL EQUIPMENT MISCELLANEOUS DETAILS					
APPROVALS	ENGINEER	DATE	APPROVALS	ENGINEER	DATE
City Engineer	<i>[Signature]</i>	10-19-88	Liquid Waste	<i>[Signature]</i>	10/19/88
A.C.E. Design	<i>[Signature]</i>	11-1-88	Traffic	<i>[Signature]</i>	11-19-88
A.C. E.-Hydrology	—	—	Water	<i>[Signature]</i>	12/19/88
DRAWING NO.		MAP NO.		SHEET	
3338		D-21		11 OF 15	

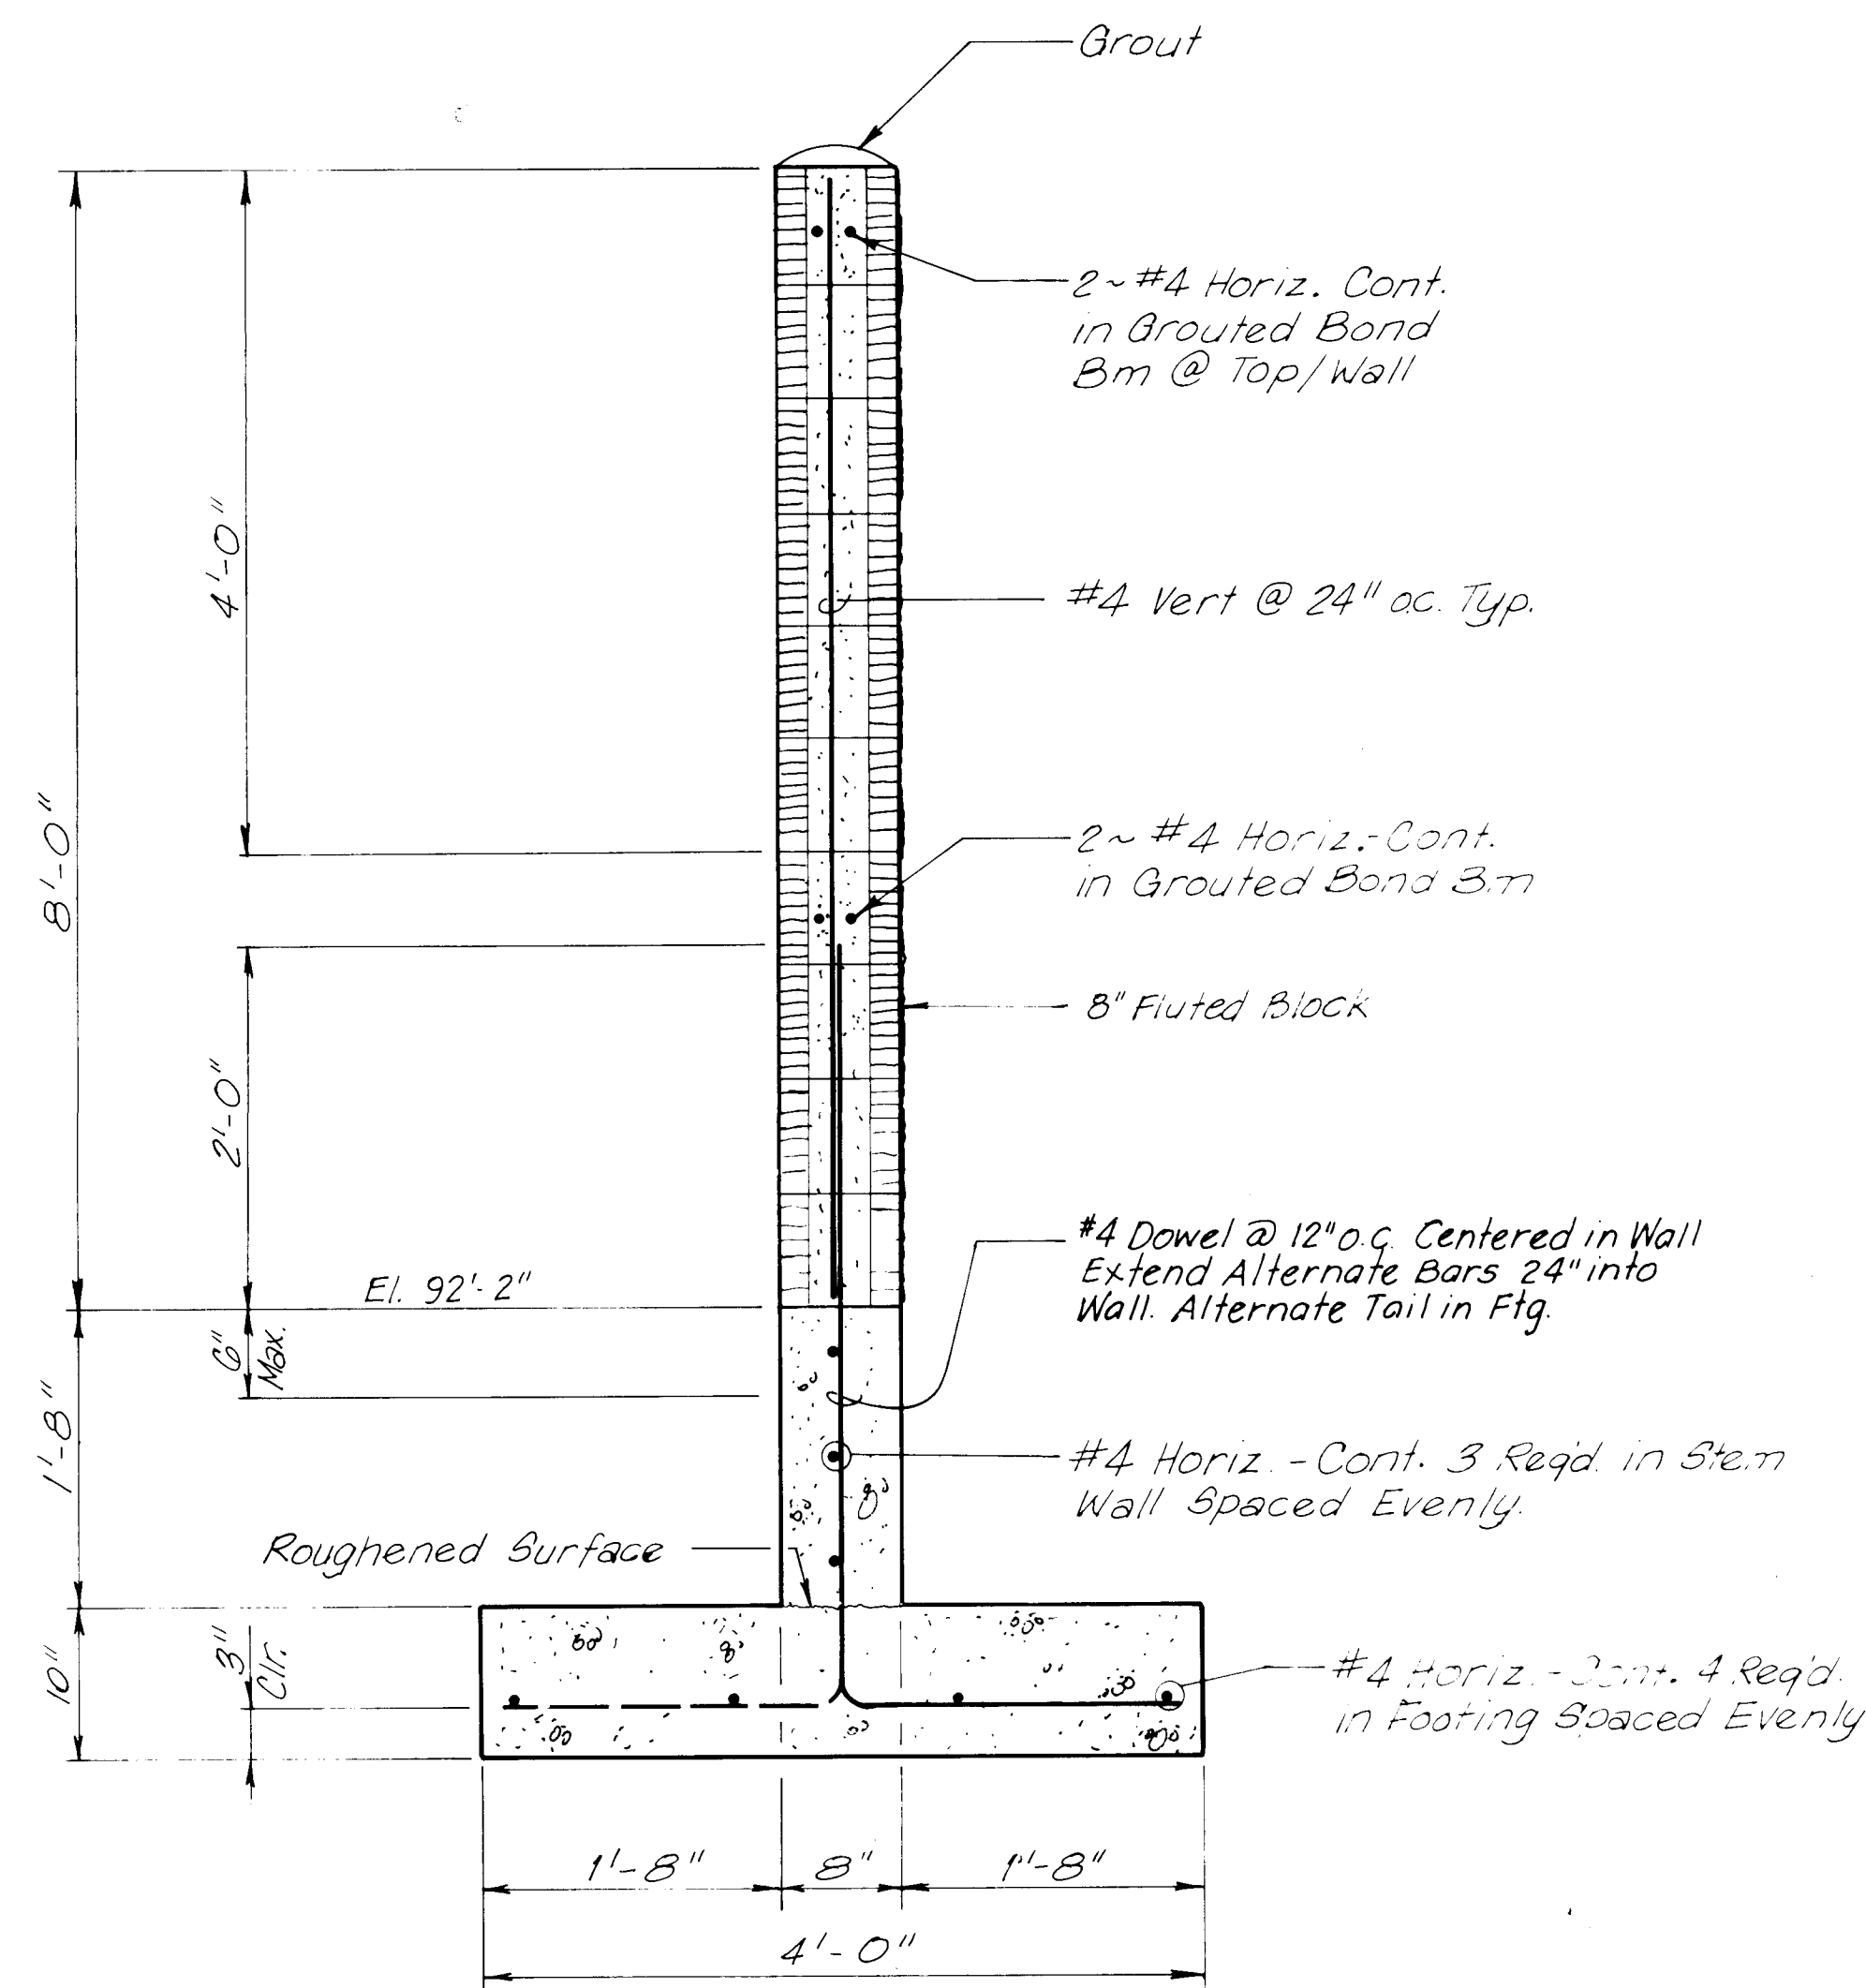


1 SCREEN WALL AROUND SWITCHGEAR
SCALE: 1" = 1'-0"

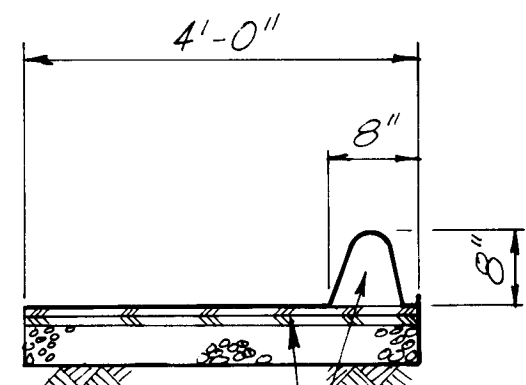


A SECTION
N.T.S.

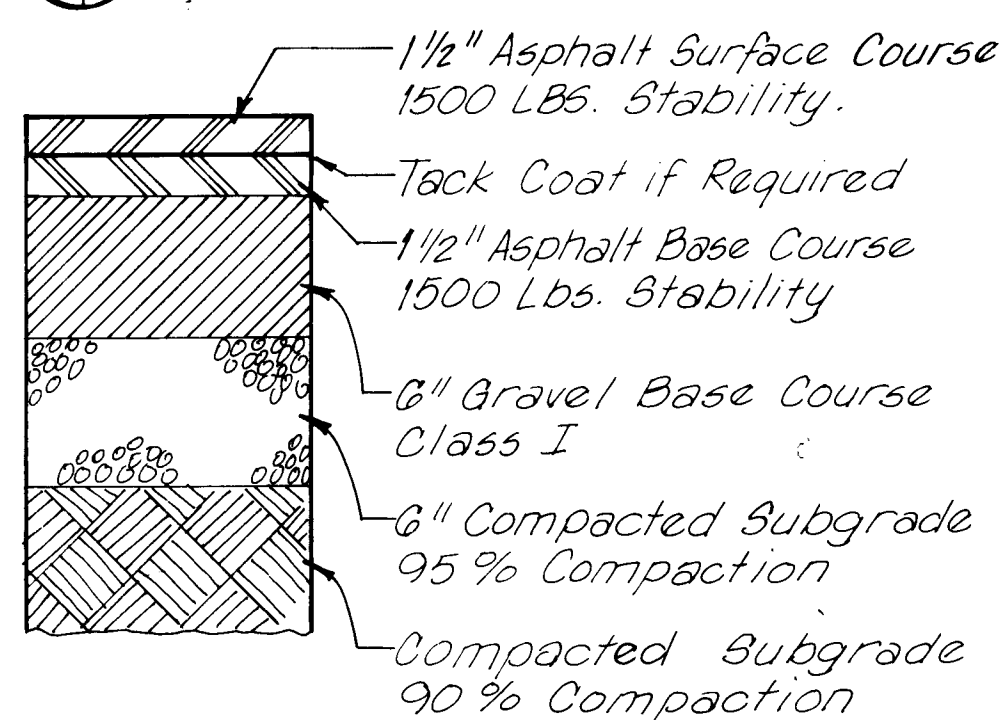


B PAVEMENT SECTION
N.T.S.

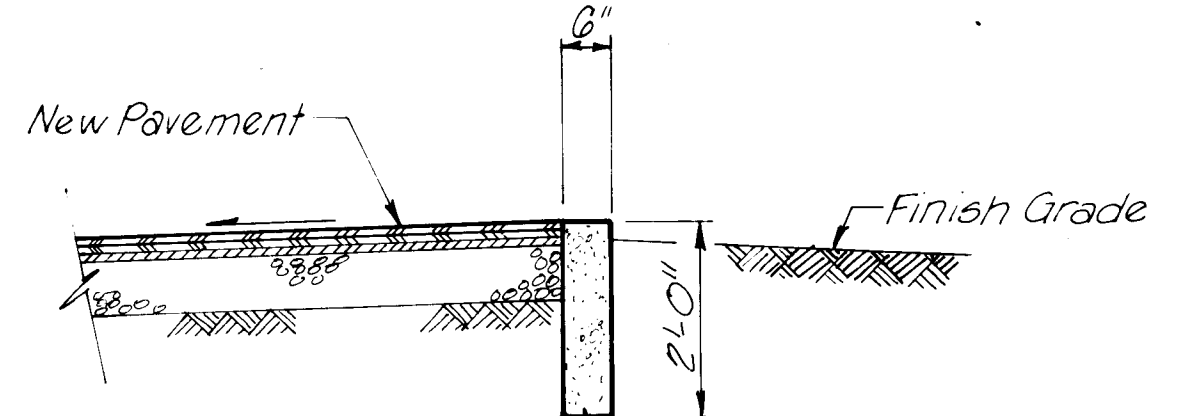


C SECTION
N.T.S.

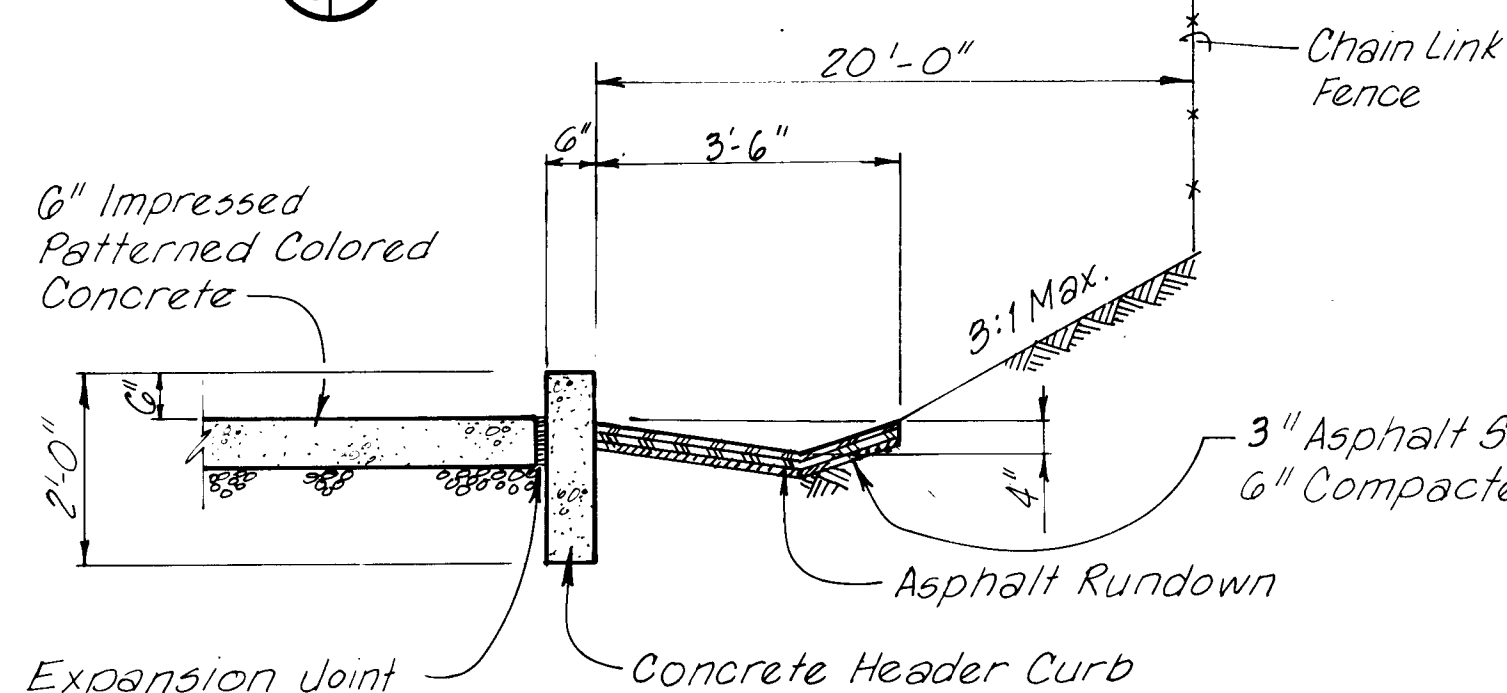

D SECTION
N.T.S.

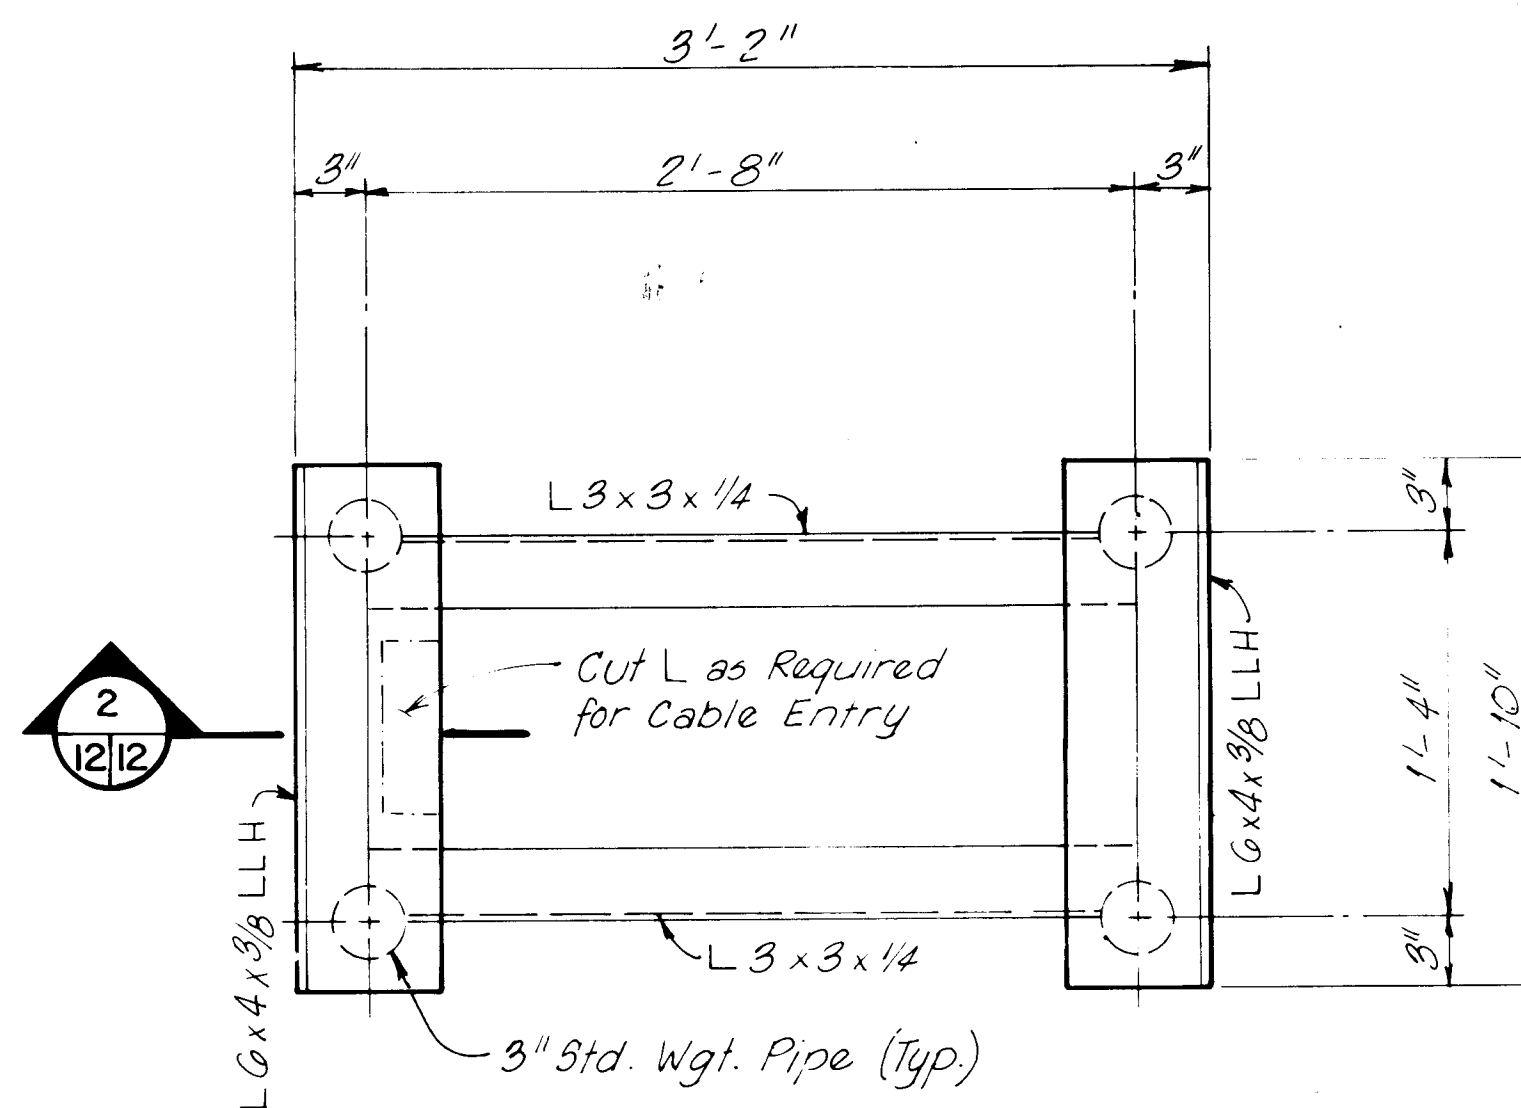


PLAN

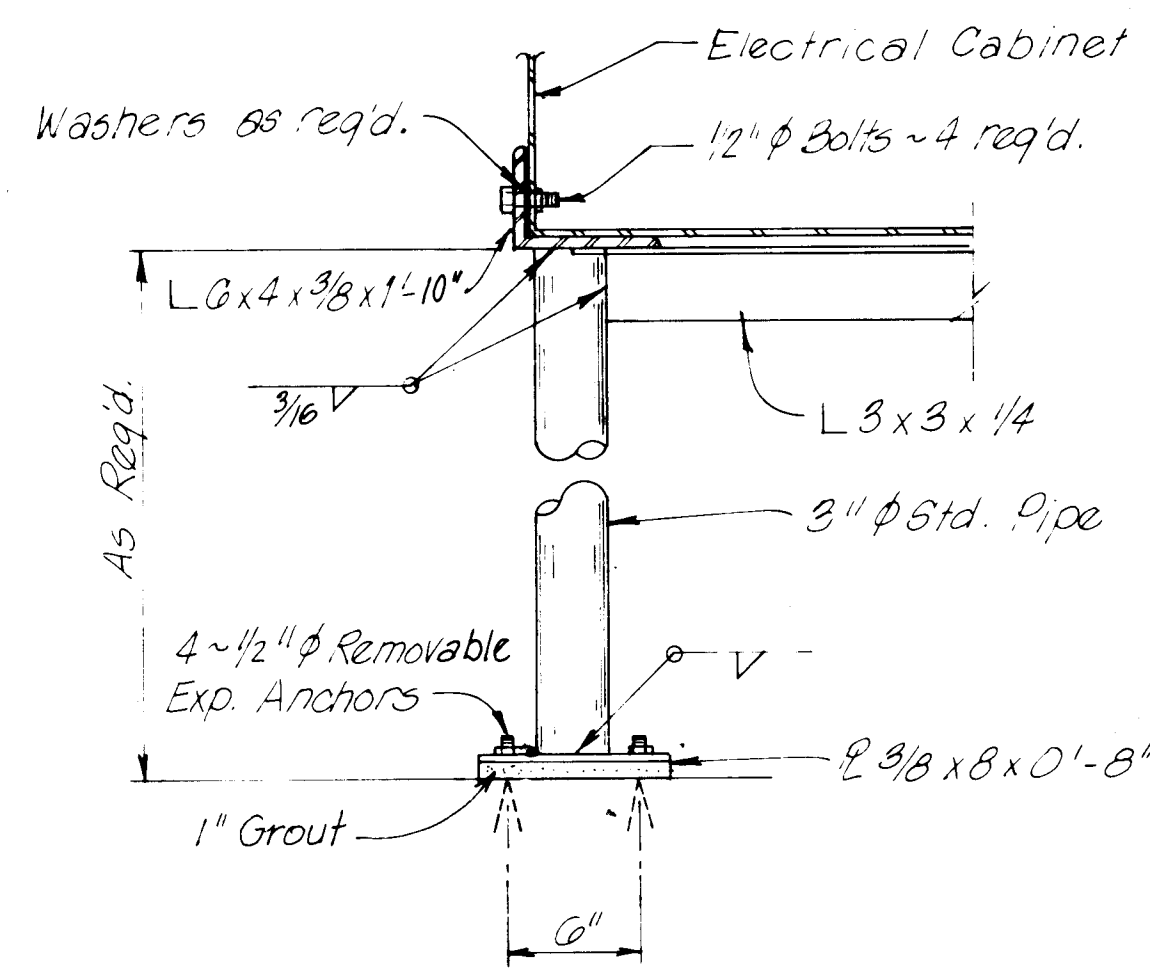


SECTION

2 MOTOR SURGE CAPACITOR STAND DETAIL
SCALE: 1 1/2" = 1'-0"

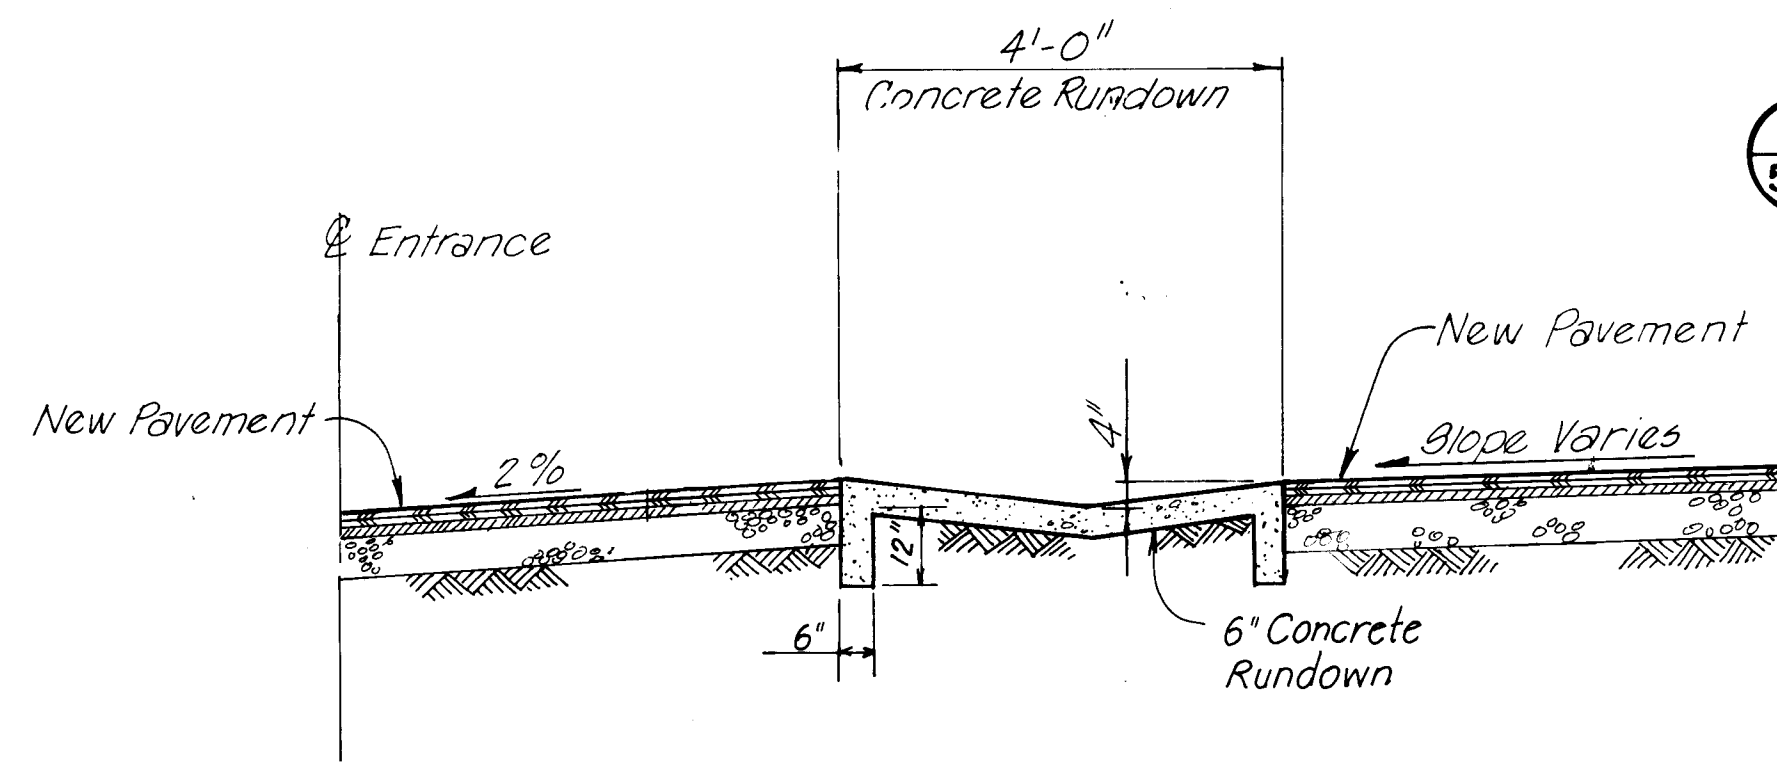

E SECTION
N.T.S.

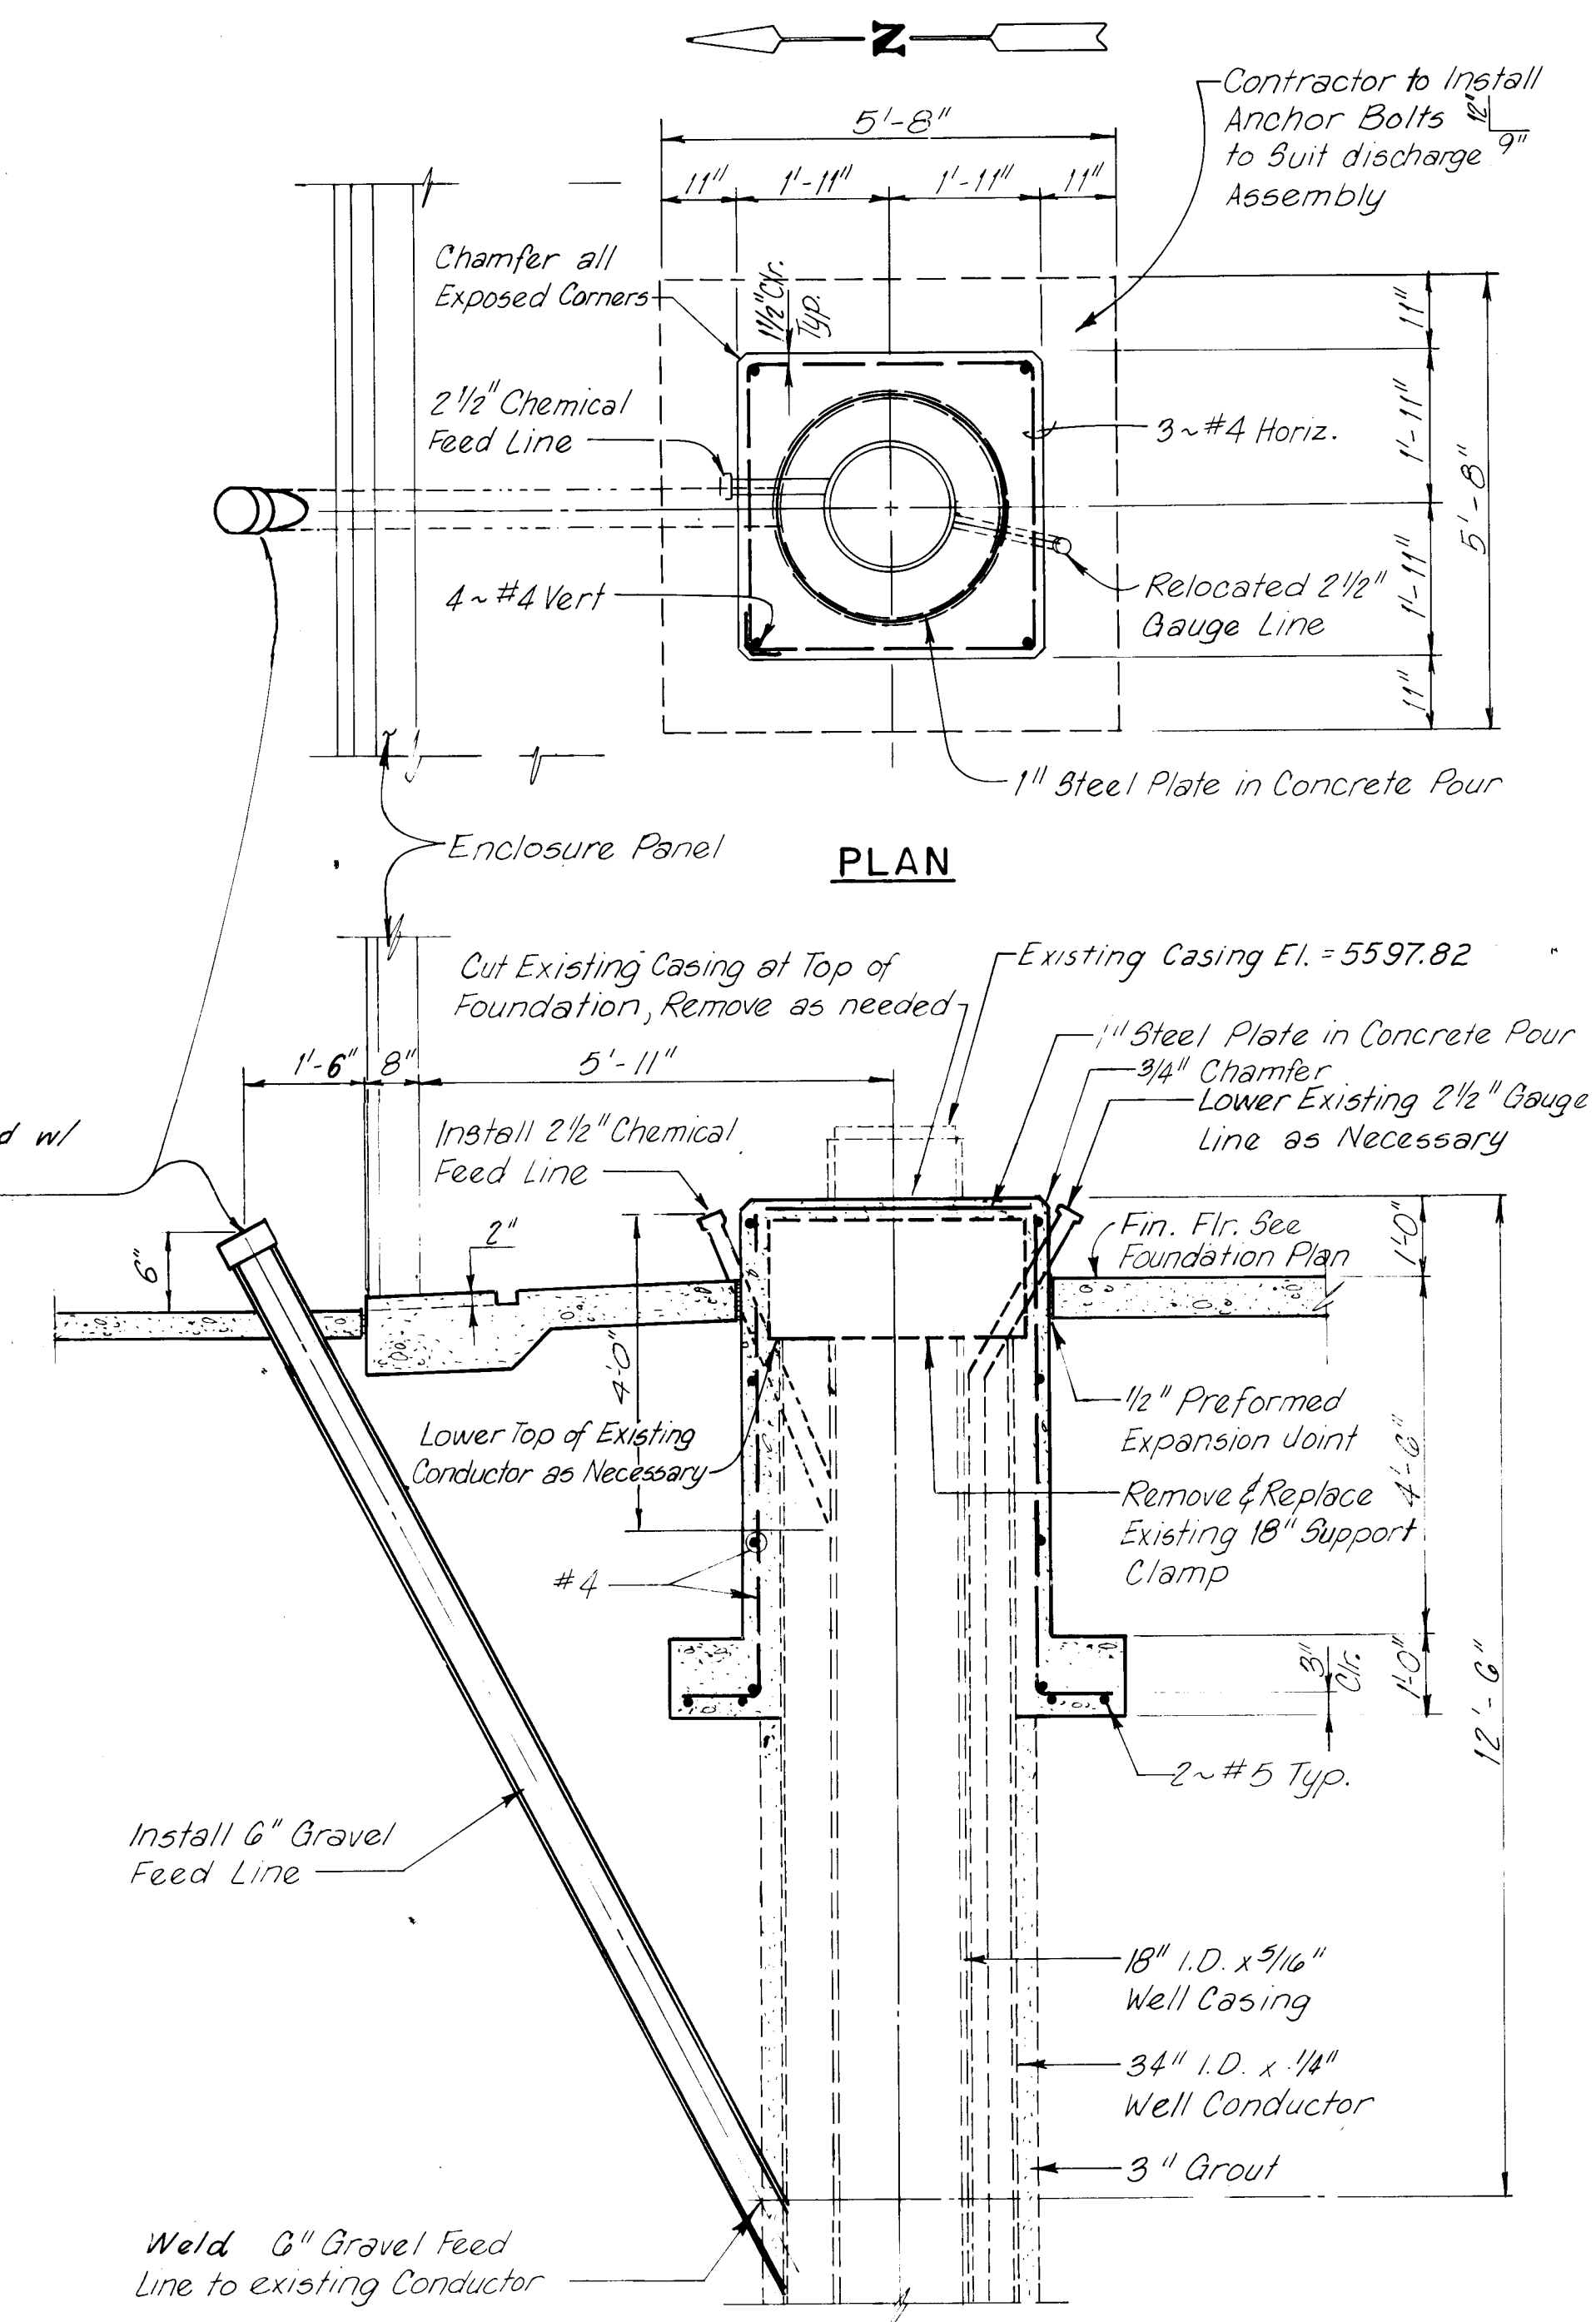

PLAN

SECTION

3 PUMP FOUNDATION DETAIL
SCALE: 1/2" = 1'-0"



NOTE:
Contractor shall be responsible for maintaining the position of the existing well casing during construction and rebuilding well head and pump foundation to the new elevations as shown on the drawings. The estimated weight that is to be supported during construction is 109,474 LBS. Contractor will submit details for casing support to the Engineer for approval prior to any construction.

RECORD DRAWING
AUG 10 1989

These drawings have been revised based on field data and a reasonable attempt has been made to depict construction actually performed.

CITY OF ALBUQUERQUE MUNICIPAL DEVELOPMENT DEPARTMENT ENGINEERING DIVISION			
TITLE: WALKER NO. 2 WELL EQUIPMENT PUMP FOUNDATION AND MISCELLANEOUS DETAILS			
APPROVALS	ENGINEER	DATE	APPROVALS
City Engineer	10/19/88		Liquid Waste
A.C.E. Design	10/19/88		Traffic
A.C.E. Hydrology	10/19/88		Water
DESIGNED BY	M.Z. D.D.	DATE	9-29-88
DRAWN BY	M.J.	DATE	9-29-88
CHECKED BY	M.W.	DATE	9-29-88
DRAWING NO.	3338	MAP NO.	D-21
SHEET	12	OF	15

AS BUILT INFORMATION			
CONTRACTOR	DATE	INSPECTOR'S	DATE
STARTED BY	DATE	FIELD	DATE
REVISIONS	DATE	REVISIONS	DATE
NO.	DATE	NO.	DATE
MICRO-FILM INFORMATION			
RECORDED BY	DATE	NO.	DATE

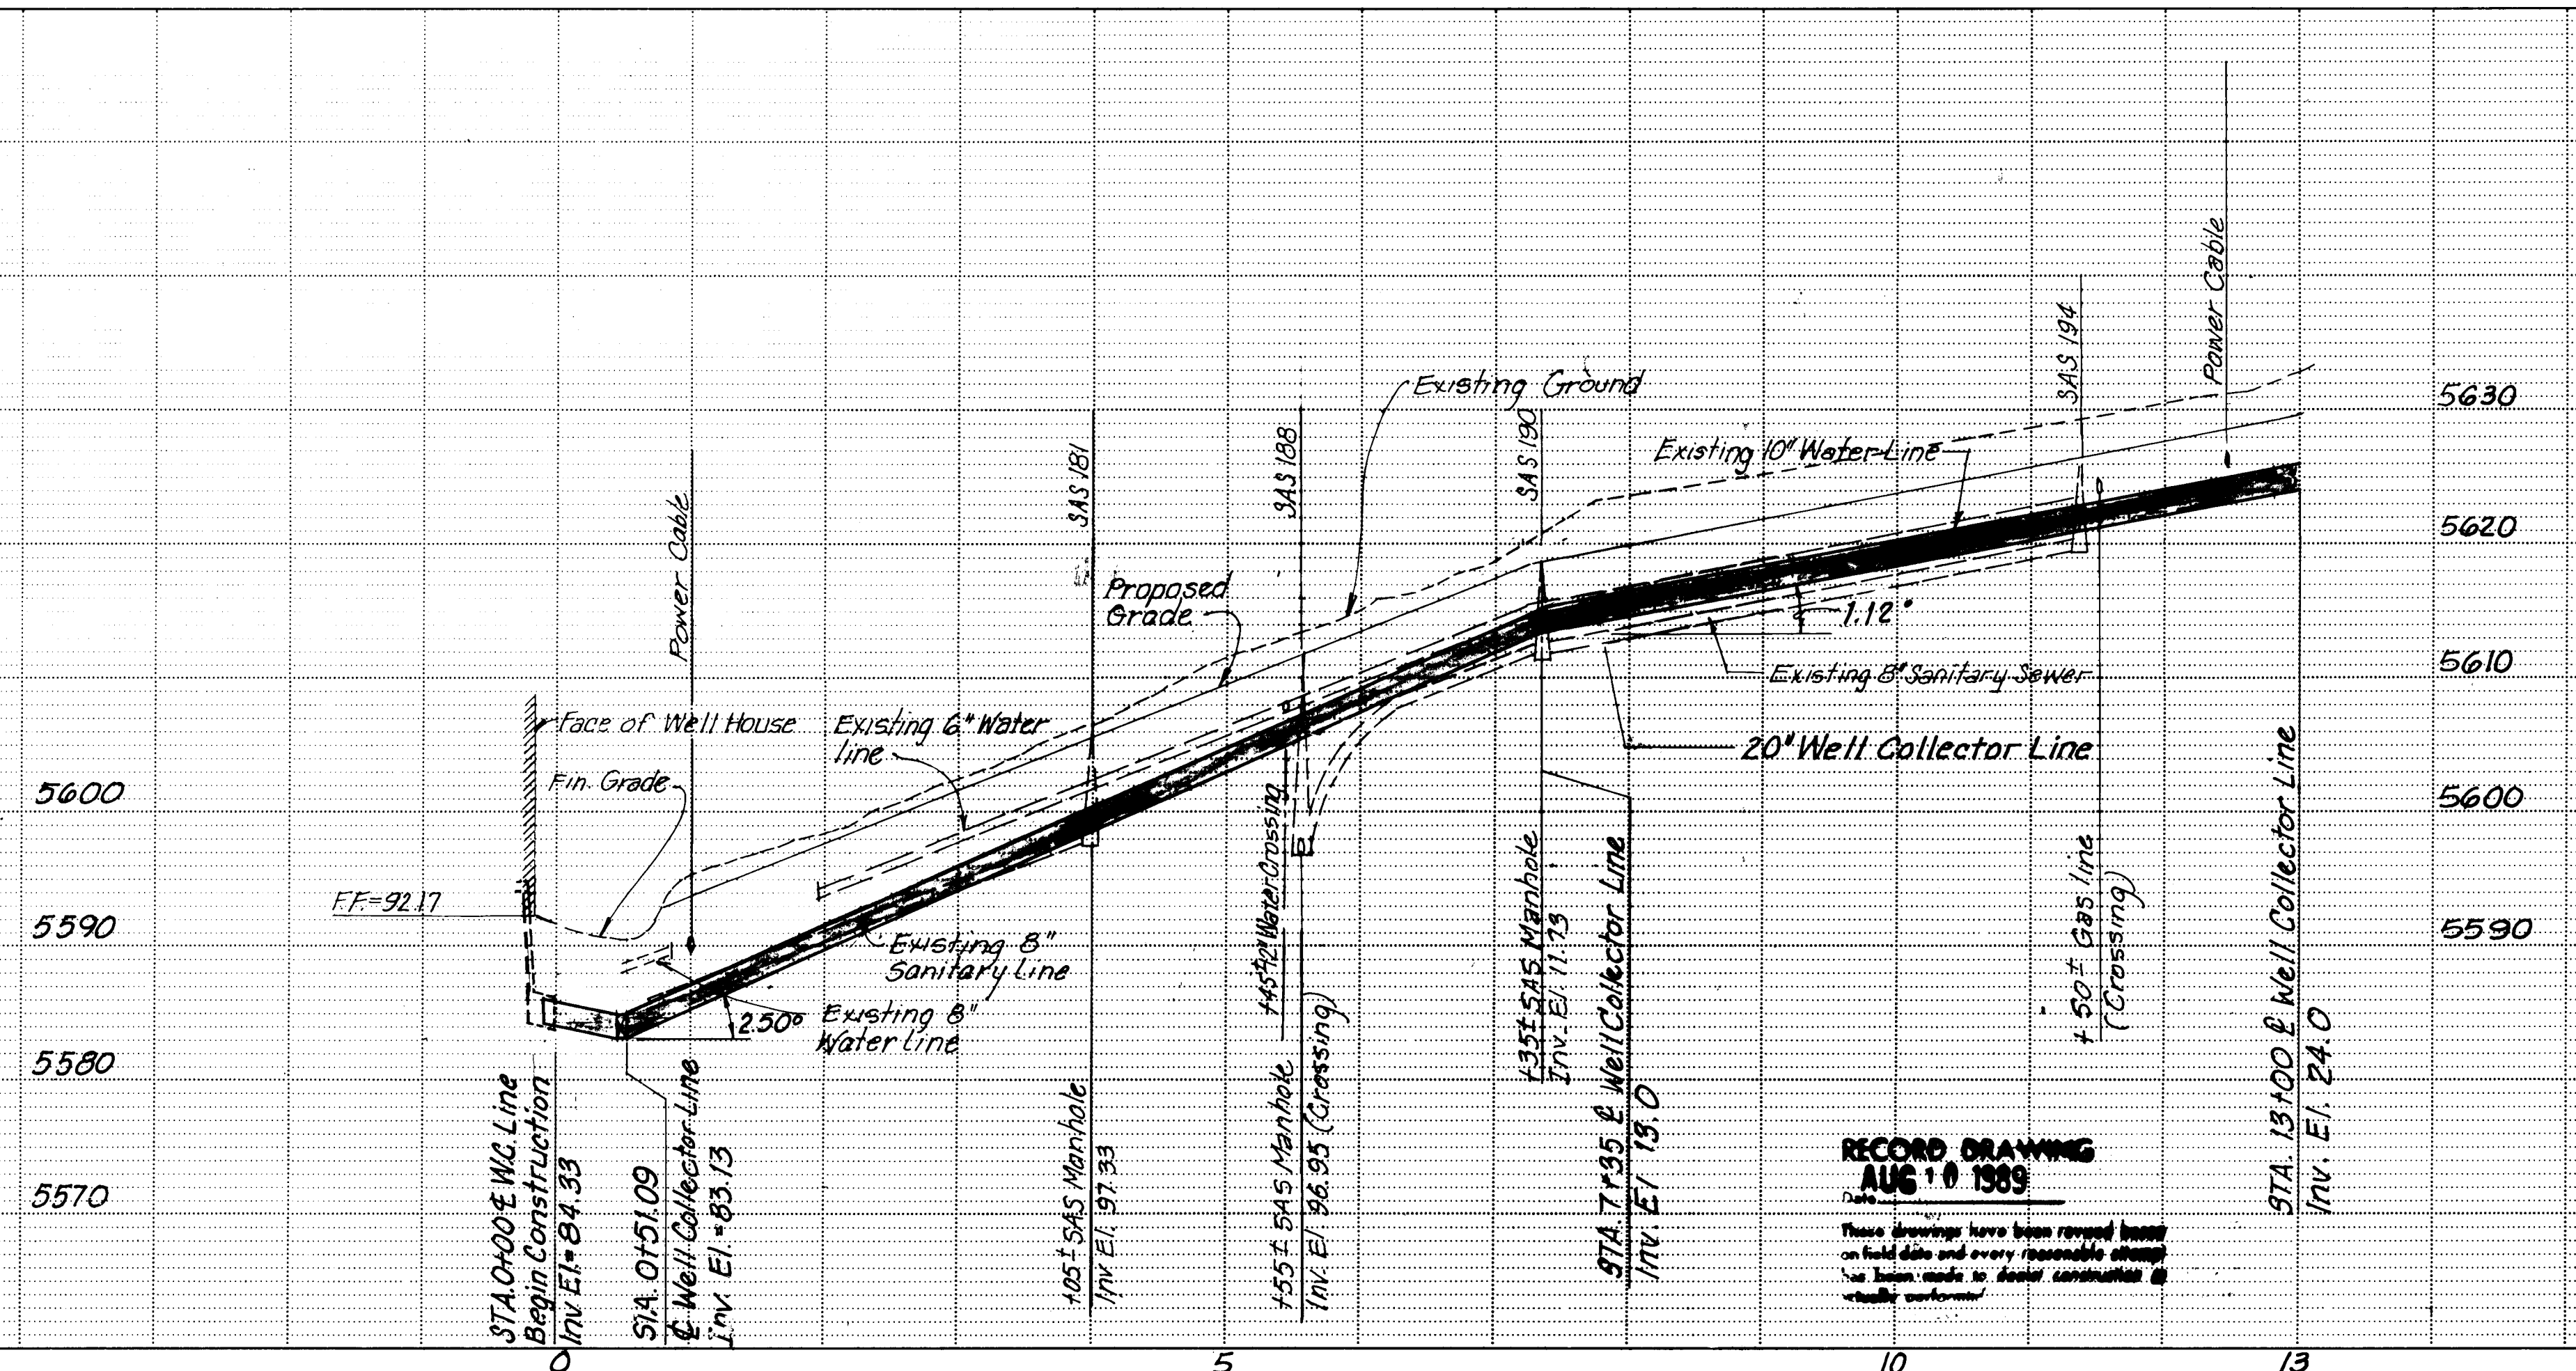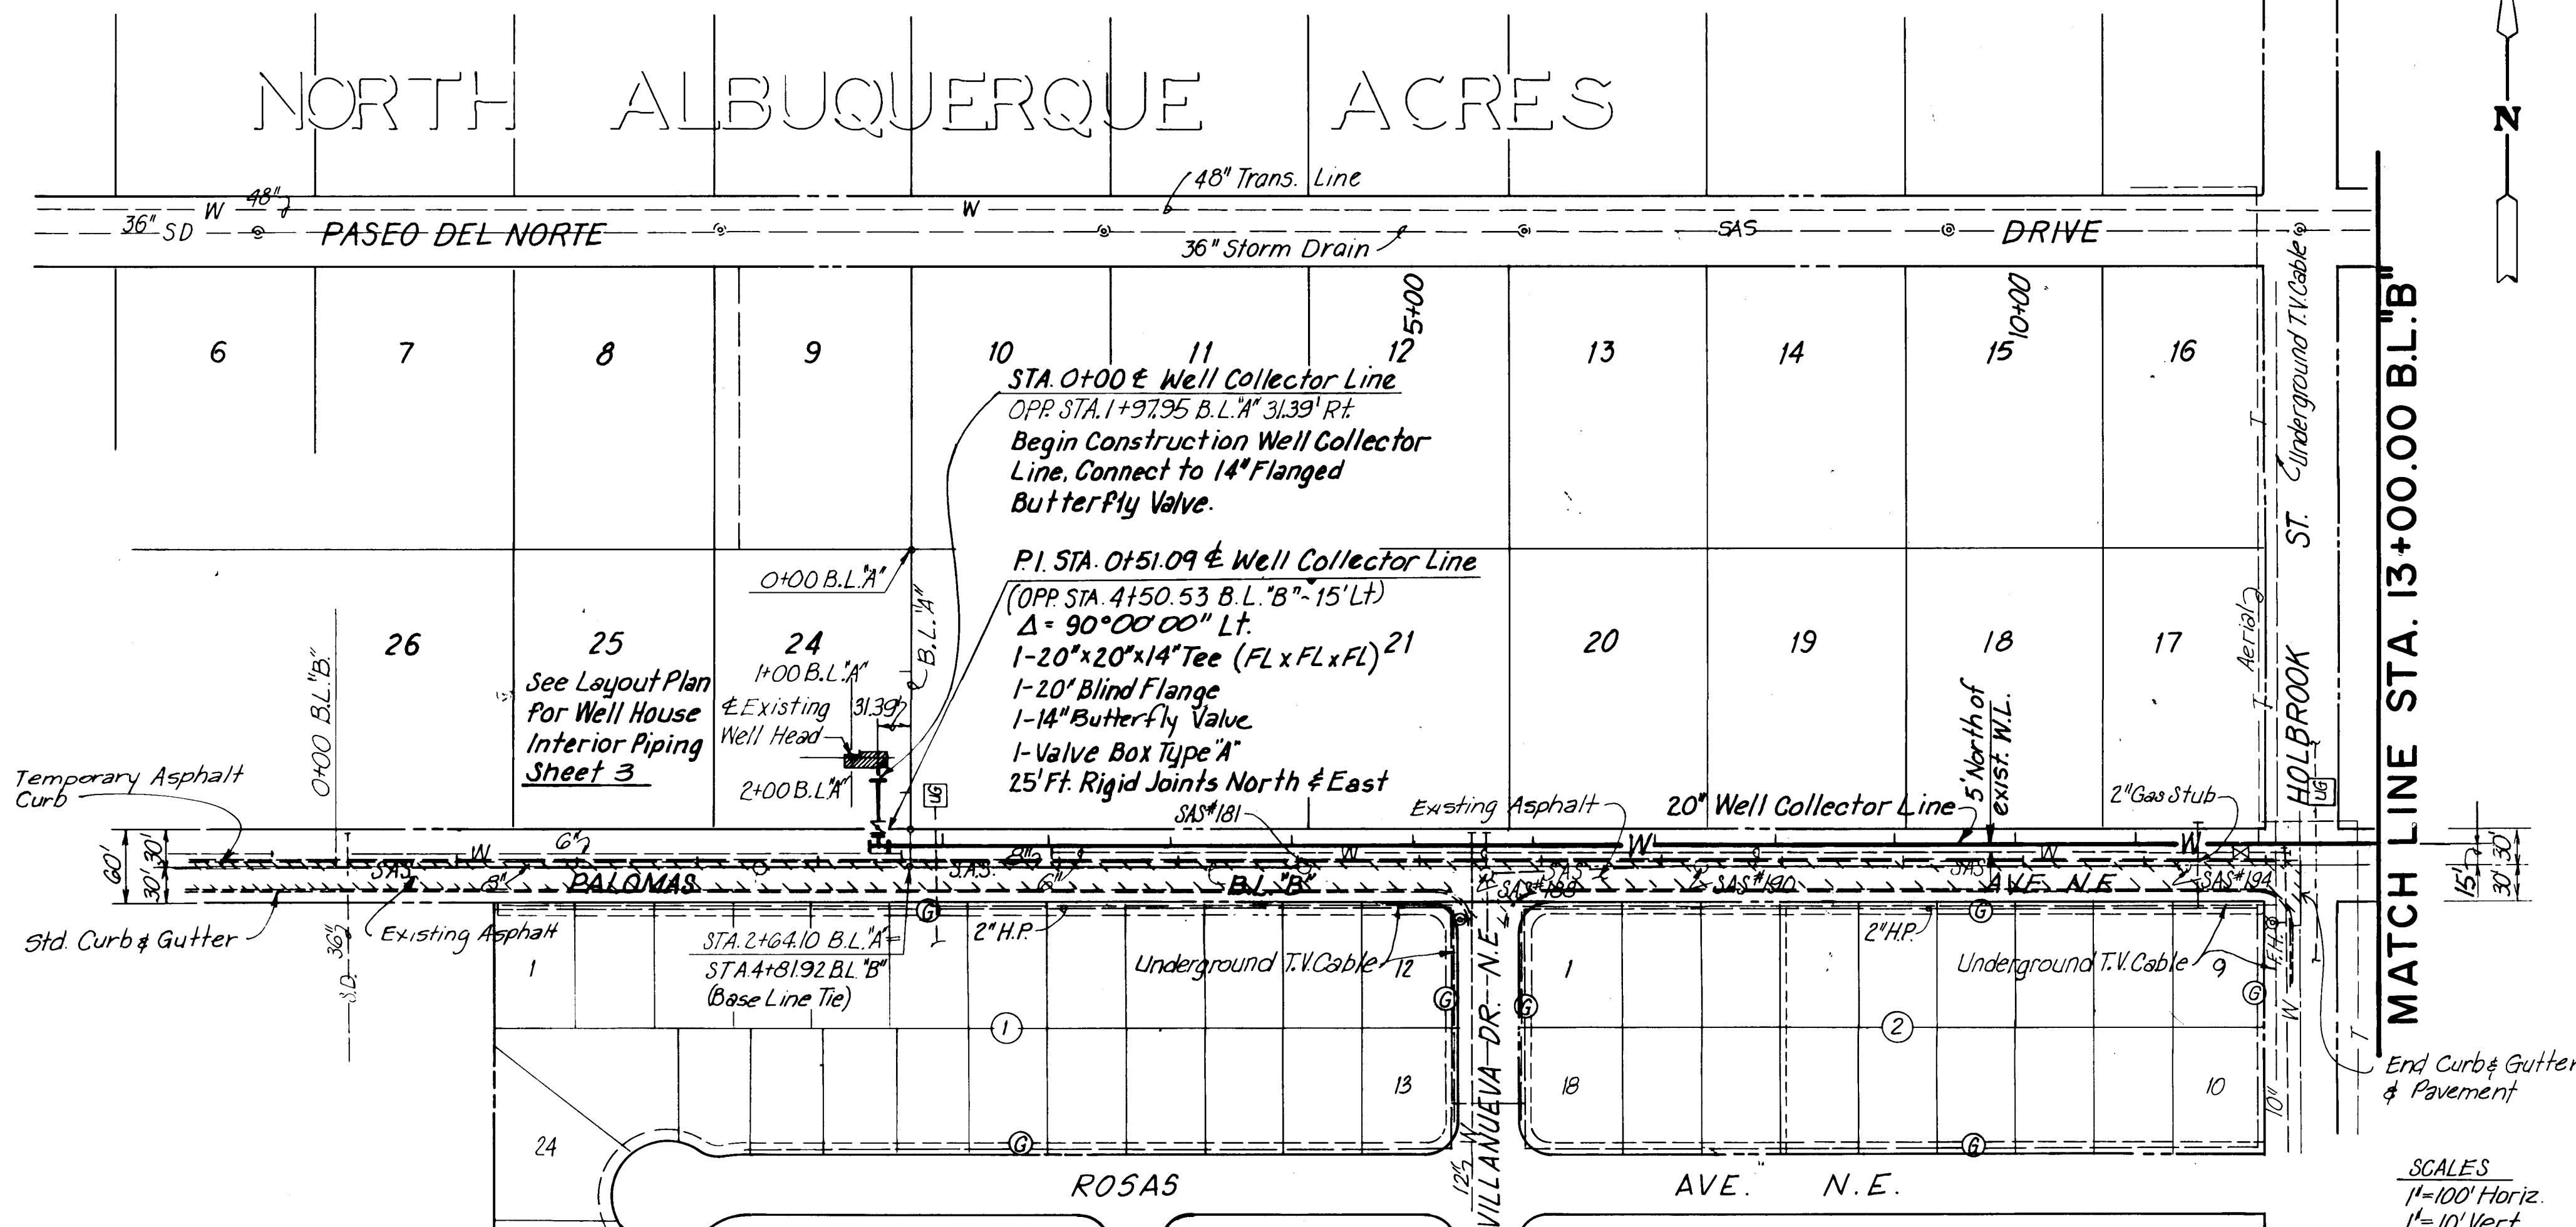

CONSTRUCTION NOTES:

1. A minimum clearance of 12\"/>

2. A minimum of five (5) feet of undisturbed soil must be maintained between the base of PNM's structures (located at northeast and northwest corners of Holbrook St. and Palomas Ave.) and the lip of the Pipe Trench. If this separation is unattainable, Contractor shall notify PNM forty-eight (48) hours in advance of excavation to arrange for structures to be supported.

CONTRACTOR		INSPECTORS		FIELD		DATE	
NAME	DATE	NAME	DATE	NAME	DATE	NAME	DATE

NO.		DATE		REVISIONS	
BY	DATE	NO.	DATE	REVISIONS	DATE

DESIGNED BY

W.N.W.

DATE

9-88

DRAWN BY

Geo C.

DATE

9-88

CHECKED BY

Jim T.

DATE

9-88

CITY OF ALBUQUERQUE

MUNICIPAL DEVELOPMENT DEPARTMENT

ENGINEERING DIVISION

TITLE: WALKER NO. 2 WELL EQUIPMENT

PLAN AND PROFILE WELL COLLECTOR LINE

APPROVALS	ENGINEER	DATE	APPROVALS	ENGINEER	DATE
City Engineer	Joe. S.	10-19-88	Liquid Waste	Peso	10/19/88
A.C.E. - Design			Traffic		10-19-88
A.C.E. - Hydrology			Water		10/19/88

DRAWING NO.


3338

MAP NO.

D-21

SHEET

13 OF 15

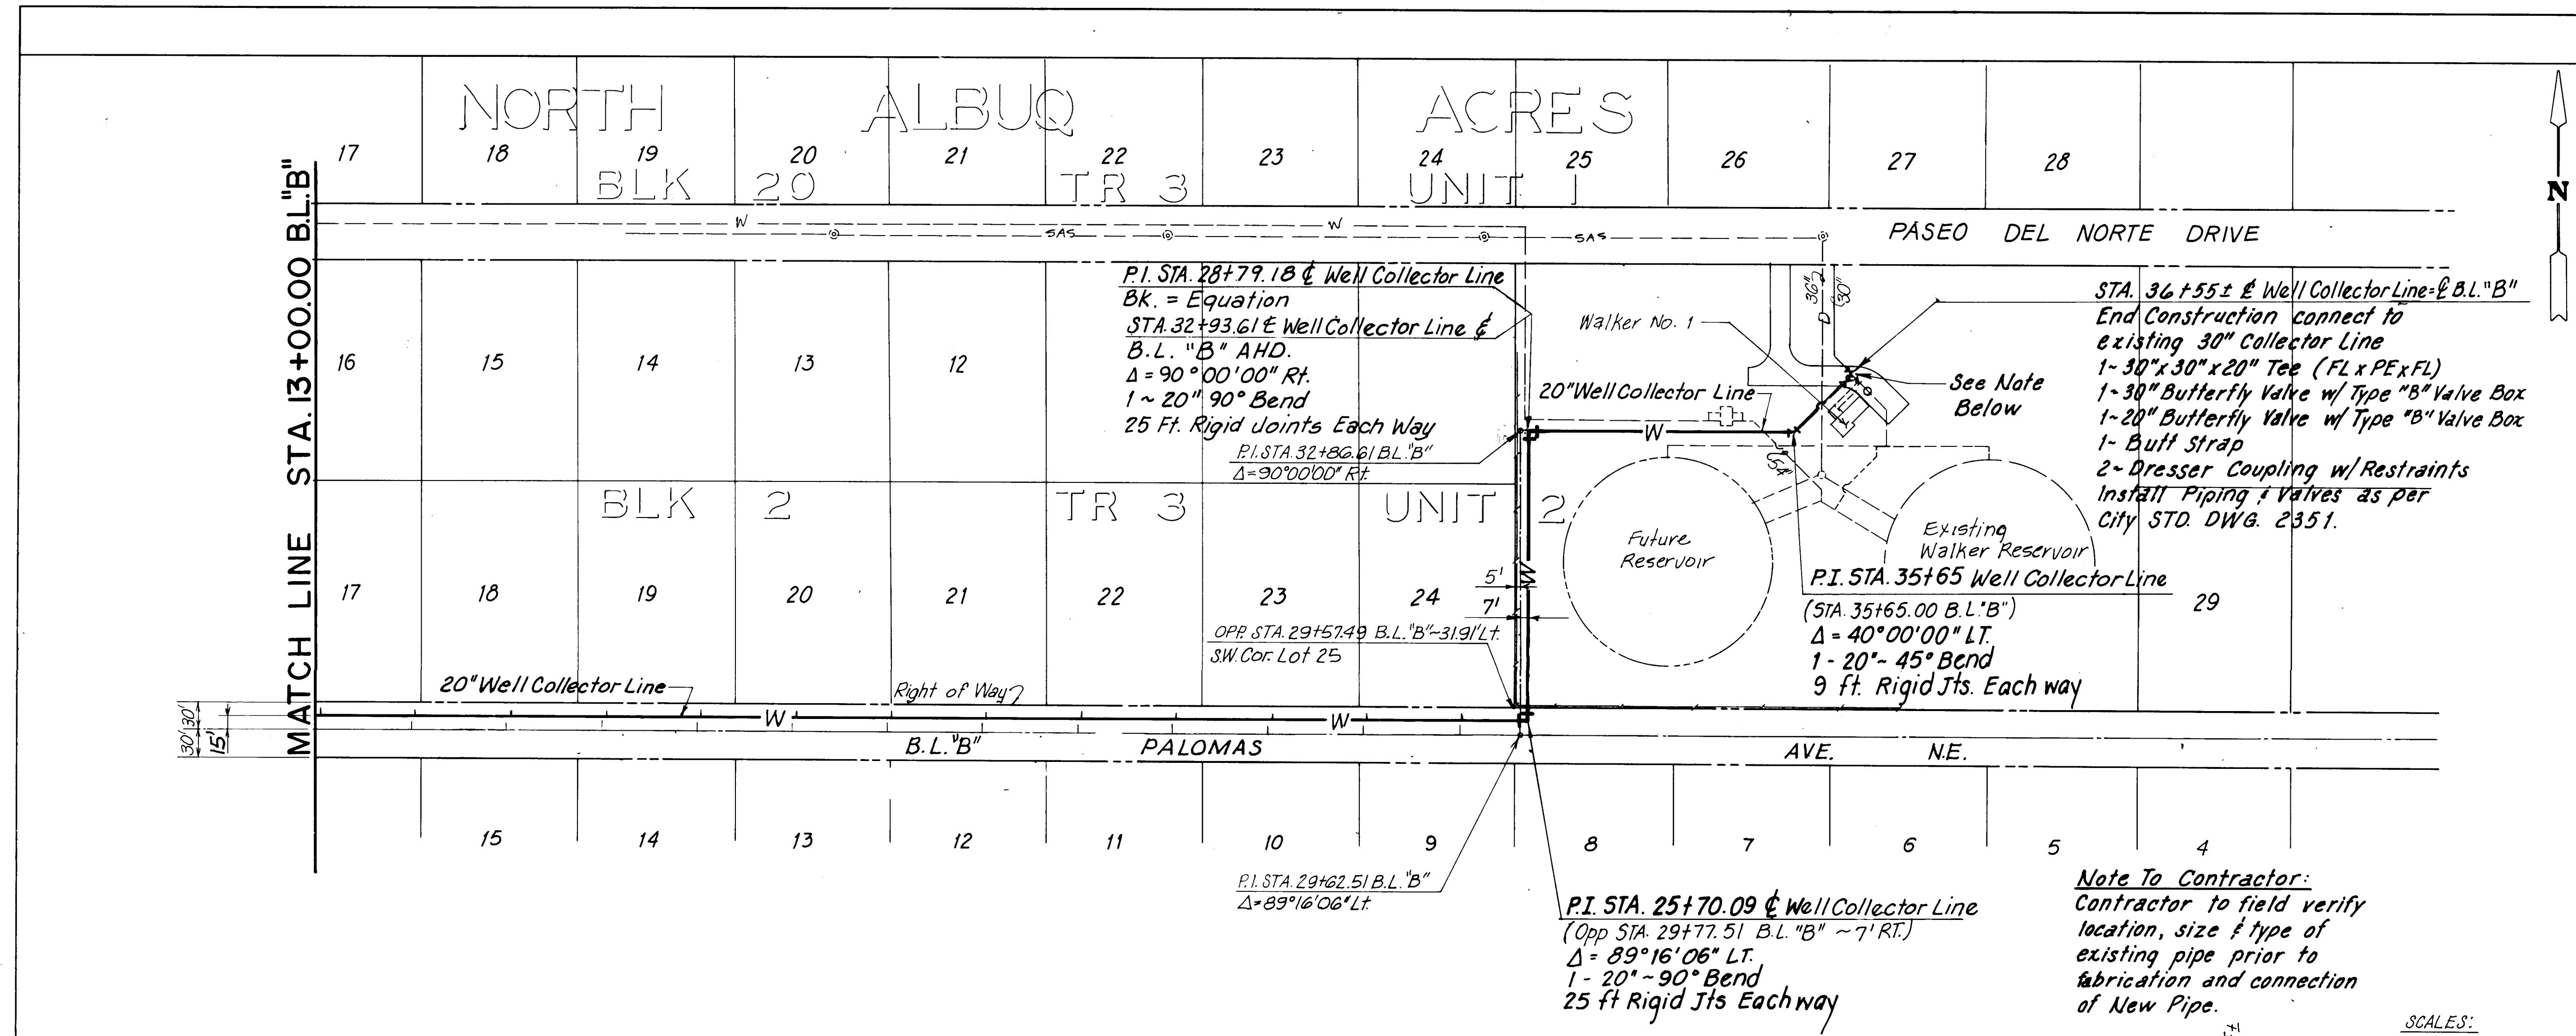

CONSTRUCTION NOTES:

1. A minimum clearance of 12" is req'd. between any utility line and an underground power cable. Approximate locations of crossing are shown on the drawings. The Blue Stake Program shall be contacted to locate cables. Contractor shall locate cable crossing elevations prior to installation of Wash or Well Collector lines. Forty-Eight (48) hours prior to excavation in the area of the crossings, notice must be given to PNM to allow PNM personnel to be on-site during excavation and backfill at the crossings. Notice may be given by calling Jim Vann, Ph. 761-3426 or PNM's Dispatcher at 344-9779.

AS BUILT INFORMATION


NO.	DATE	BY	REMARKS
1			
2			
3			
ENGINEER'S SEAL

REVISIONS

NO.	DATE	BY	REMARKS
1			
2			
3			
DESIGNED BY W.N.W. **DATE** 9-88
DRAWN BY G.C. **DATE** 9-88
CHECKED BY J.T. **DATE** 9-88

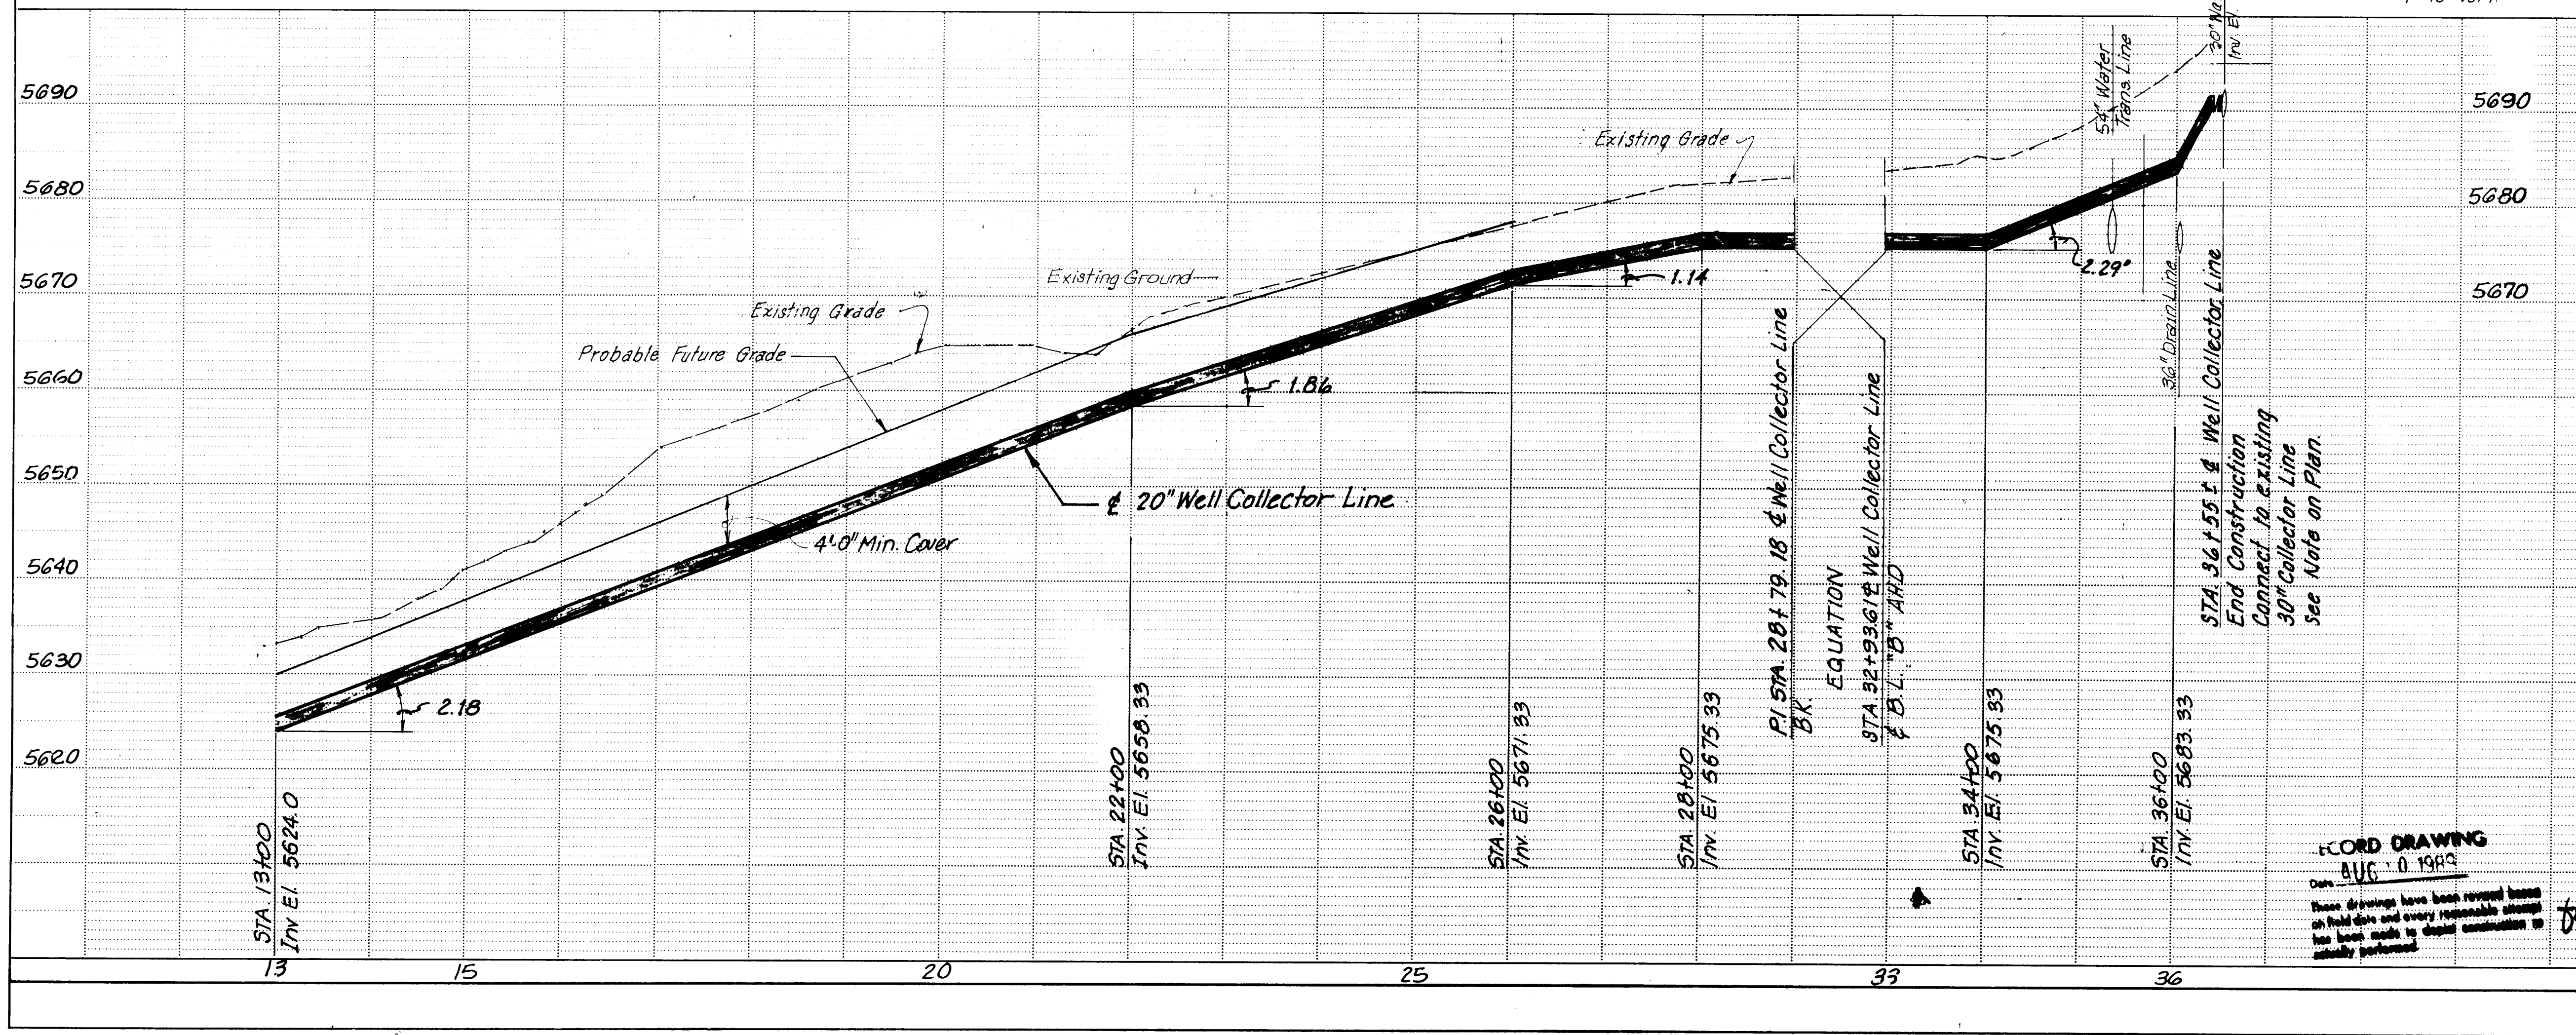


RECORD DRAWING

APPROVALS

APPROVALS	ENGINEER	DATE	APPROVALS	ENGINEER	DATE
City Engineer			Liquid Waste	PEZIO	10/19/88
A.C.E.-Design			Traffic		
A.C.E.-Hydrology			Water		

TITLE: WALKER NO. 2 WELL EQUIPMENT
PLAN AND PROFILE WELL COLLECTOR LINE

DRAWING NO. 3338 **MAP NO.** D-21 **SHEET** 14 OF 15

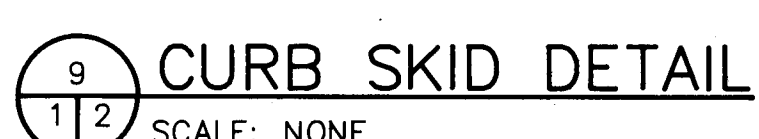[illegible]

RECORD DRAWING
AUG 10 1989

These drawings have been revised based on data and every reasonable attempt made to depict construction as performed.

8056.11MD1/8056WW2

CITY OF ALBUQUERQUE
MUNICIPAL DEVELOPMENT DEPARTMENT
ENGINEERING DIVISION

TITLE:	WALKER NO.2 WELL EQUIPMENT MECHANICAL DETAILS
--------	--

APPROVALS	ENGINEER	DATE	APPROVALS	ENGINEER	DATE
City Engineer			Liquid Waste		
A.C.E. Design			Traffic		
A.C.E.—Hydrology			Water		
DRAWING NO. 3338		MAP NO. D-21		SHEET M-2 ^{of} M-2	

CONTROL SCHEMATICS AND INTERCONNECTION DIAGRAMS

SYMBOLS	DESCRIPTION
	FUSE
	CIRCUIT BREAKER
	DISCONNECT SWITCH
	GROUND CONNECTION
	MAINTAINED MUSHROOM HEAD PUSHBUTTON SWITCH
	HAO SELECTOR SWITCH
	MOMENTARY PUSHBUTTON SWITCH, (NORMALLY OPEN)
	MOMENTARY PUSHBUTTON SWITCH, (NORMALLY CLOSED)
	PRESSURE SWITCH
	POSITION SWITCH
	LIMIT SWITCH
	TEMPERATURE SWITCH
	FLOW TRANSMITTER
	FLOW ELEMENT
	LEVEL TRANSMITTER
	LEVEL ELEMENT
	VIBRATION ELEMENT
	POWER CONSUMPTION PULSE METER
	ELAPSED TIME METER
	RELAY, CONTACTOR, OR TIMER CONTACT (NORMALLY OPEN)
	RELAY, CONTACTOR, OR TIMER CONTACT (NORMALLY CLOSED)
	TIMED CONTACT (NORMALLY OPEN TIMED CLOSED)
	TIMED CONTACT (NORMALLY CLOSED TIMED OPEN)
	TIMED CONTACT (NORMALLY OPEN TIMED OPEN)
	TIMED CONTACT (NORMALLY CLOSED TIMED CLOSED)
	OVERLOAD RELAY CONTACT (NORMALLY CLOSED)
	MOTOR STARTER OVERLOAD ELEMENT
	SOLENOID VALVE COIL
	RELAY, CONTACTOR, OR TIMER COIL
	RTB TERMINATION
	FIELD DEVICE TERMINATION
	FIELD DEVICE TERMINATION (FUSED/DISCONNECT TYPE)
	CONDUIT CALLOUT (P = POWER CONDUCTOR, C = CONTROL CONDUCTOR.) (SEE POWER AND CONTROL CONDUIT SCHEDULES SHEET E-2.)
	CONTROL CABLE DRAIN WIRE
	CONTROL WIRE TAG IDENTIFICATION
	INDICATOR LAMP (R=RED LENS, G=GREEN LENS, B=BLUE LENS).
	MOTOR

ONE-LINE DIAGRAM

SYMBOLS	DESCRIPTION
	FUSE
	DISCONNECT SWITCH
	MOTOR
	CURRENT TRANSFORMER
	POTENTIAL TRANSFORMER
	AMMETER
	VOLTMETER
	SURGE ARRESTOR
	CAPACITOR
	RISER POLE

PLANS

SYMBOLS	DESCRIPTION
	OVERHEAD PRIMARY CONDUCTOR
	PRIMARY PULLBOX
	GROUND COUNTERPOISE SYSTEM CONDUCTOR
	CONDUIT - ABOVE GROUND
	CONDUIT - BELOW GROUND
	CONDUIT TURNING UP
	CONDUIT TURNING DOWN
	CONDUIT WITH PANELBOARD BRANCH CIRCUIT NUMBER
	CONDUIT CALLOUT (P = POWER CONDUCTOR, C = CONTROL CONDUCTOR.) (SEE POWER AND CONTROL CONDUIT SCHEDULES SHEET E-2.)
	LIGHT FIXTURE, PENDANT MOUNT, FLUORESCENT. (UPPERCASE LETTER INDICATES FIXTURE TYPE.)
	LIGHT FIXTURE, WALL MOUNT. (UPPERCASE LETTER INDICATES FIXTURE TYPE.)
	EMERGENCY LIGHT FIXTURE, WALL MOUNT. (UPPERCASE LETTER INDICATES FIXTURE TYPE.)
	DUPLEX RECEPTACLE, FLUSH MOUNT
	DUPLEX RECEPTACLE, FLUSH MOUNT, WEATHERPROOF COVER
	WALL SWITCH, FLUSH MOUNT
	THERMOSTAT
	GROUND ROD WITH EXOTHERMIC CONNECTION TO CONDUCTOR
	GROUND COUNTERPOISE SYSTEM CONNECTION, MECHANICAL
	GROUND COUNTERPOISE SYSTEM CONNECTION, EXOTHERMIC
	CONDUIT RISER AND FLEXIBLE CONNECTION TO EQUIPMENT
	DISCONNECT SWITCH, TYPE AS NOTED
	JUNCTION BOX (CAST DEVICE BOX)

PIPING AND INSTRUMENT DIAGRAM

SYMBOLS	DESCRIPTION
	LOCAL MOUNTED INSTRUMENT
	PANEL MOUNTED INSTRUMENT
	PANEL MOUNTED INSTRUMENT (BEHIND BOARD)
	PROCESS LINE
	INSTRUMENT ELECTRICAL LINE (ARROWS INDICATE SIGNAL DIRECTION)
	CHANGE IN PIPE SIZE
	CHECK VALVE
	BUTTERFLY VALVE (MOTOR OPERATED)
	BUTTERFLY VALVE (HAND OPERATED)
	FLOW ELEMENT
	FLOW SWITCH (LOW)
	FLOW INDICATING TRANSMITTER
	HAND SWITCH
	POWER CONSUMPTION PULSE METER
	LEVEL ELEMENT
	LEVEL SWITCH (HIGH)
	LEVEL INDICATING TRANSMITTER
	PRESSURE INDICATOR
	PRESSURE SWITCH (HIGH)
	TEMPERATURE ELEMENT
	TEMPERATURE SWITCH (HIGH)
	TEMPERATURE SWITCH (HIGH/HIGH)
	TEMPERATURE SWITCH (LOW)
	VIBRATION ELEMENT

INSTRUMENT LOOP IDENTIFICATION SCHEDULE

LOOP NUMBER	LOOP DESCRIPTION
02 03	STATION PROCESS DISCHARGE LINE WASH LINE
80 82	STATION HVAC HEATING AIR CONDITIONING
91 93 97	STATION MISCELLANEOUS FLOOD TEMPERATURE ELECTRICAL CONSUMPTION

LIGHT FIXTURE SCHEDULE

TYPE	DESCRIPTION/MANUFACTURER	VOLTAGE	LAMPS	MOUNTING	NOTES
A	INDUSTRIAL FLUORESCENT BENJAMIN FLB-1125-4U-FL173(2)	120V	(2) 8 FT. 96 WATT HO FLUORESCENT	PENDANT 8'-6" AFF TBOF	1
B	H.I.D. AREA LIGHT DEVINE AWP160-50HPS-120V-C43-PC1	120V	(1) 50 WATT HIGH PRESSURE SODIUM	SURFACE 10'-0" AFF TBOF	2
C	INCANDESCENT AREA LIGHT DEVINE AWP160-INC-120V-C43	120V	(1) 150 WATT INCANDESCENT	SURFACE 7'-0" AFF TBOF	
D	DELETED				

NOTES:
1 WITH OPTIONAL FACTORY WIRE GUARD
2 WITH INTEGRAL PHOTOCONTROL

GENERAL NOTES

1 SEE SHEET E-2* FOR CONDUIT SCHEDULES.

2 THE FOLLOWING PRODUCTS SHALL BE FURNISHED BY THE CITY, INSTALLED AND CONNECTED UNDER THE REFERENCED SECTION:

16150 WELL PUMP MOTOR
16321 PADMOUNTED DISTRIBUTION TRANSFORMER
16361 PADMOUNTED PRIMARY FUSED SWITCH
16381 MOTOR SURGE CAPACITOR
16480 MOTOR CONTROL CENTER

3 THE FOLLOWING PRODUCTS SHALL BE FURNISHED BY THE CITY, INSTALLED UNDER THE REFERENCED SECTION, CONNECTED UNDER SECTION 16180:

02641 MOTOR OPERATED VALVES
13315 WELL DISCHARGE LINE FLOW INDICATING TRANSMITTER

4 THE FOLLOWING PRODUCTS SHALL BE FURNISHED AND INSTALLED UNDER THE REFERENCED SECTION, CONNECTED UNDER SECTION 16180:

02441 IRRIGATION CONTROLLER
13315 WELL LEVEL INDICATING (DRAWDOWN) TRANSMITTER
15750 ELECTRIC HEATER
15881 EVAPORATIVE COOLER

5 THE FOLLOWING PRODUCTS SHALL BE FURNISHED UNDER THE REFERENCED SECTION, INSTALLED AND CONNECTED UNDER SECTION 16180:

13315 INSTRUMENTATION (EXCEPT TRANSMITTERS)
13315 REMOTE TERMINAL UNIT TERMINAL BOX (RTB)
13315 INSTRUMENT CABINET
15980 ELECTRIC HEATER THERMOSTAT
15980 EVAPORATIVE COOLER THERMOSTAT

6 THE FOLLOWING PRODUCTS HAVE BEEN SHOWN ON THE DRAWINGS FOR REFERENCE ONLY AND ARE NOT A PART OF THIS CONTRACT:

REMOTE TERMINAL UNIT (RTU)
RADIO
RADIO ANTENNA

7 PUBLIC SERVICE COMPANY OF NEW MEXICO REPRESENTATIVE FOR THIS PROJECT:
JIM VANN
ALVARADO SQUARE/MS-0270
ALBUQUERQUE, NEW MEXICO 87518
(505) 761-3426

RECORD DRAWING

DATE: APR 11 1989

These drawings have been revised based on field data and every reasonable attempt has been made to depict construction as actually performed.

1 2 3 4 5 6 7 8 9 10 11 12

26 33381889

805611ED2/8056LEG

CITY OF ALBUQUERQUE
MUNICIPAL DEVELOPMENT DEPARTMENT
ENGINEERING DIVISION

TITLE: WALKER NO.2 WELL EQUIPMENT

ELECTRICAL LEGEND

APPROVALS	ENGINEER	DATE	APPROVALS	ENGINEER	DATE
City Engineer			Liquid Waste		
A.C.E. Design			Traffic		
A.C.E.-Hydrology			Water		

DRAWING NO. 3338

MAP NO.

SHEET E-1 OF E-9

AS BUILT INFORMATION

BENCH MARKS

SURVEY INFORMATION

FIELD NOTES

ENGINEER'S SEAL


REVISIONS

DESIGN

DATE 9-29-88

DATE 9-29-88

DATE 9-29-88

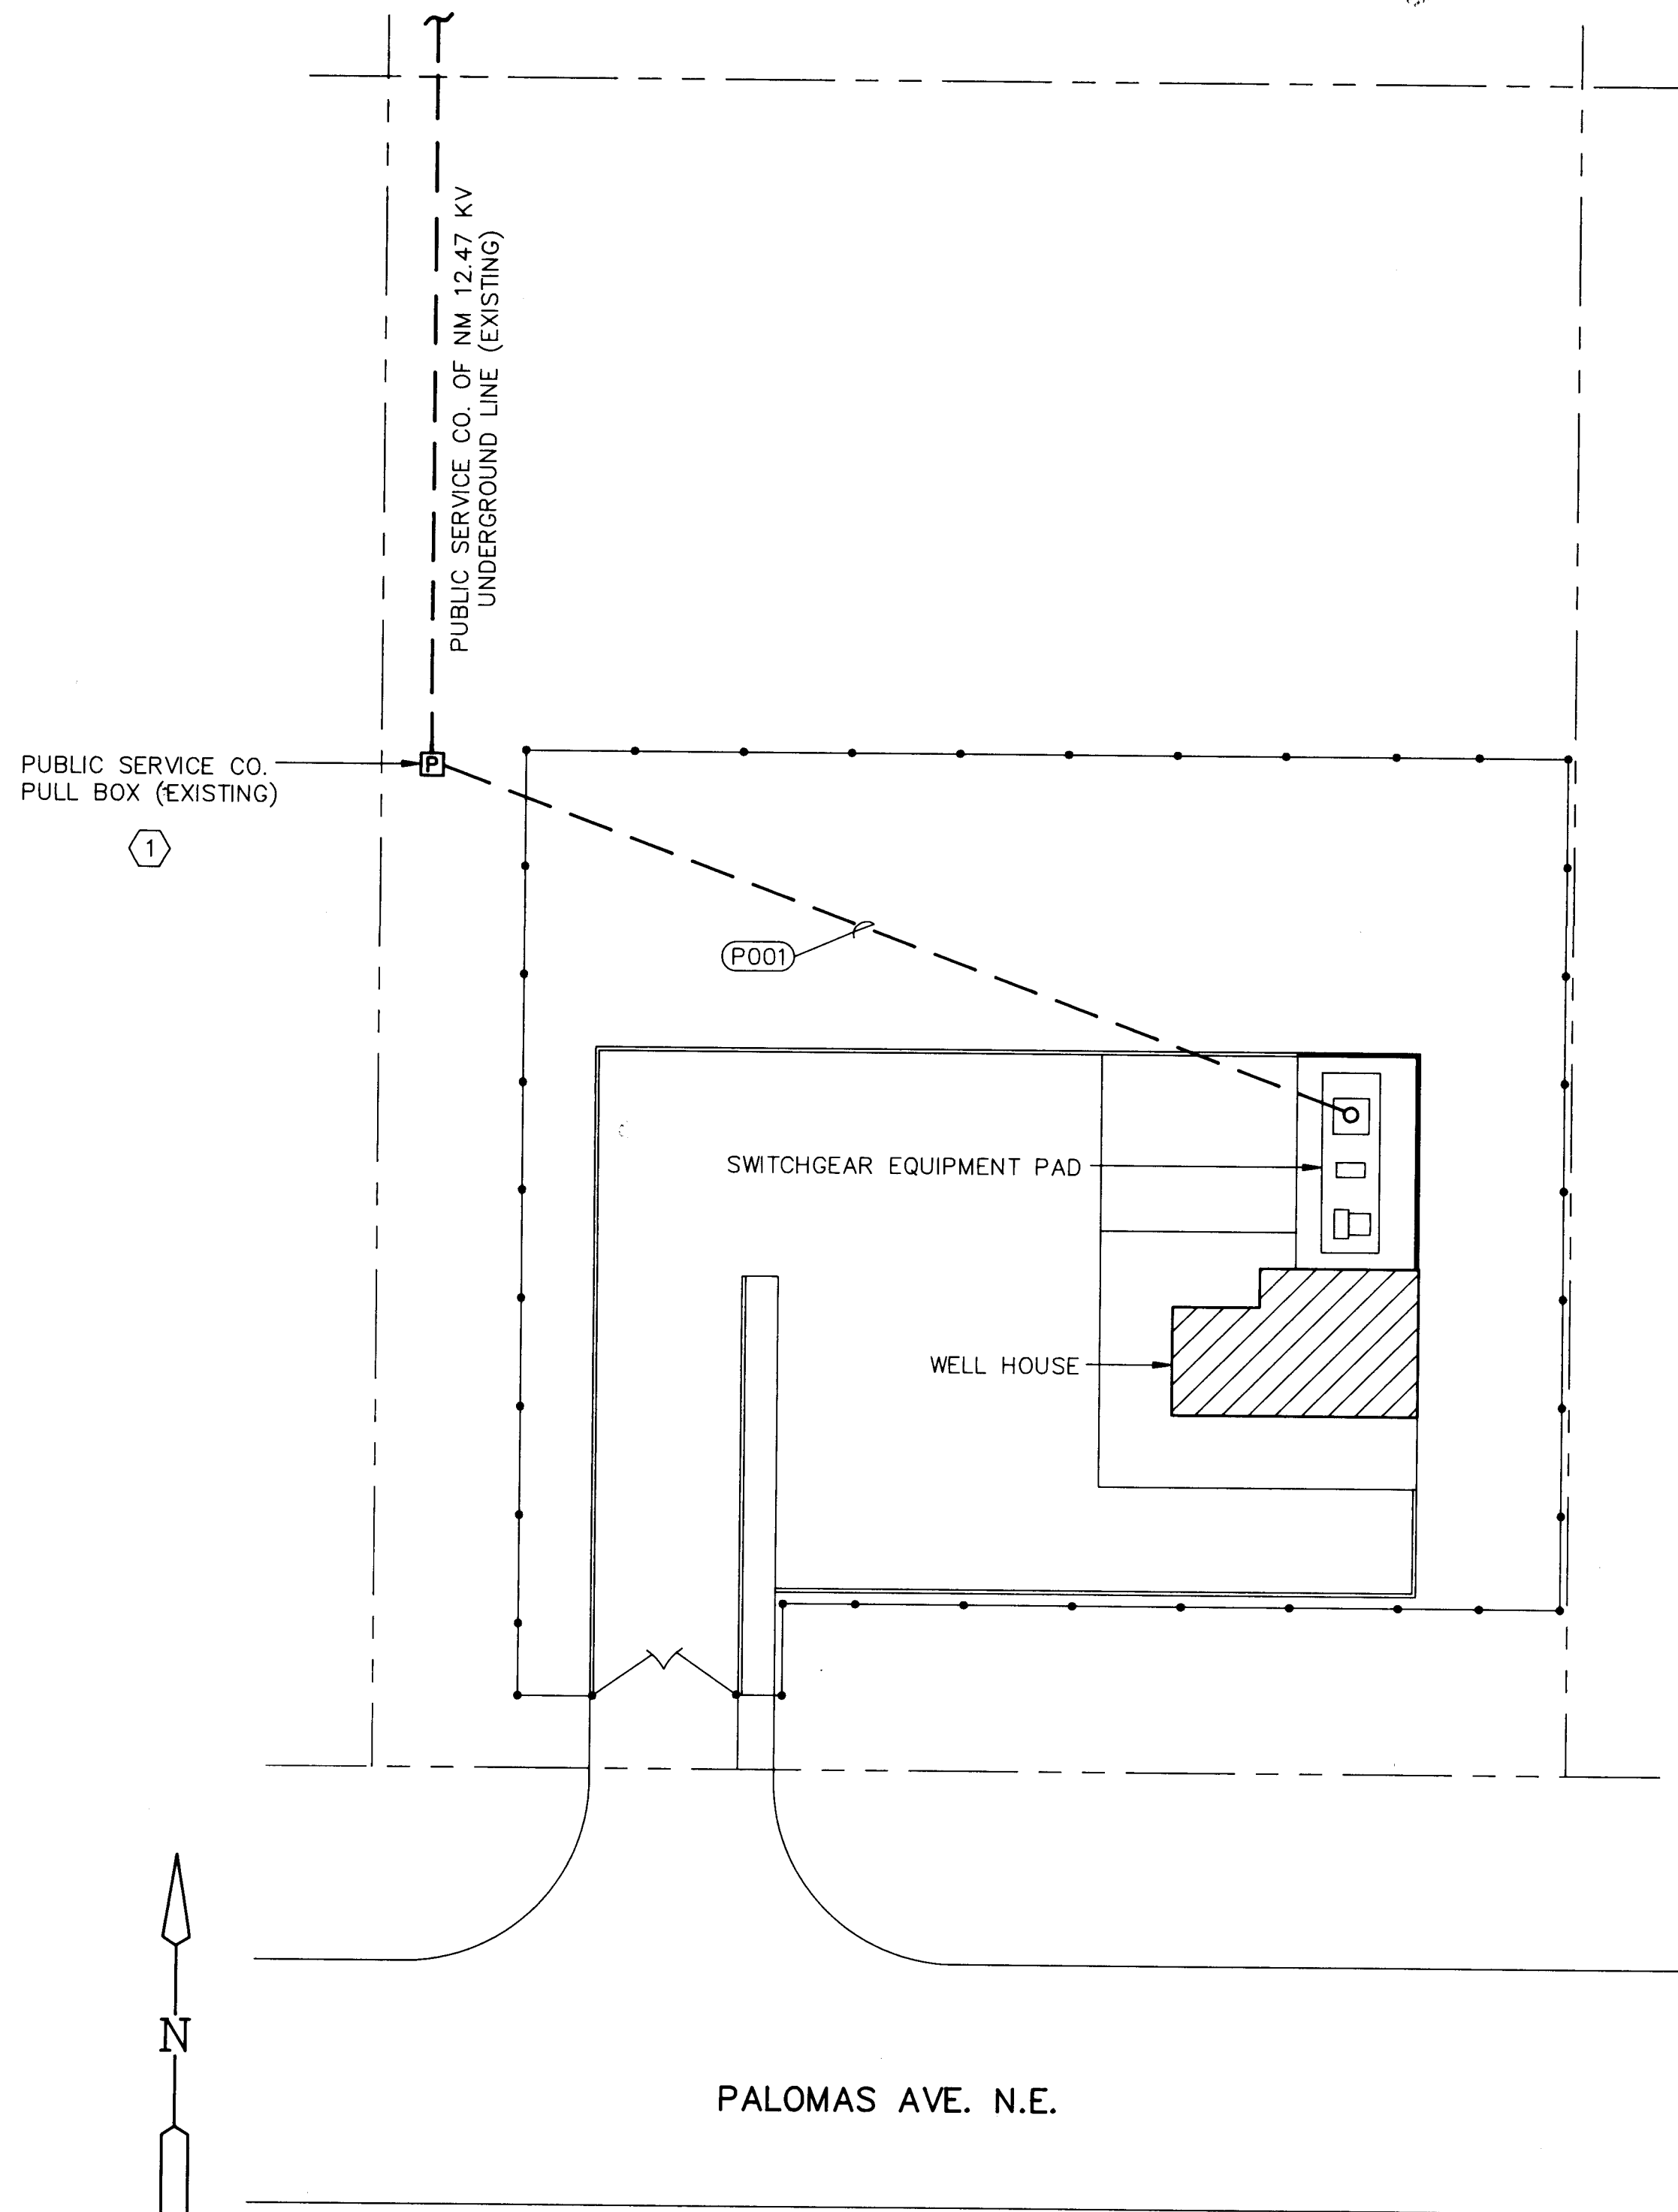

GENERAL NOTES

- SEE SHEET E-1 FOR SYMBOLS LEGEND.
- SEE SHEET E-2 FOR CONDUIT SCHEDULES.

KEYED NOTES

- INSTALL CONDUIT FROM PUBLIC SERVICE CO. PULL BOX TO PRIMARY METERING ENCLOSURE ON SWITCHGEAR EQUIPMENT PAD. SEE ENLARGED ELECTRICAL PLAN ON SHEET E-3.

CONDUIT SCHEDULE — CONTROL CONDUIT/CONDUCTOR				
CONDUIT NO.	CONDUIT SIZE	CONDUCTOR SIZE	FROM	TO
C-001	3/4"C	2#14, 1#14 GRD	UTILITY METERING ENCLOSURE (KY2)	"RTB-006" (VIA CONTROL WIREWAY)
C-002	3/4"C	(1) 1-PAIR #16 BELDEN #8719, 12#14, 1#14 GRD.	MOTOR CONTROL CENTER	"RTB-006" (VIA CONTROL WIREWAY)
C-003	3/4"C	10#14, 1#14 GRD	DISCHARGE LINE VALVE OPERATOR	"RTB-006" (VIA CONTROL WIREWAY)
C-004	3/4"C	10#14, 1#14 GRD	WASH LINE VALVE OPERATOR	"RTB-006" (VIA CONTROL WIREWAY)
C-005	3/4"C	2#14, 1#14 GRD	DISCHARGE LINE PRESSURE SWITCH	"RTB-006" (VIA CONTROL WIREWAY)
C-006	3/4"C	4#14, 1#14 GRD	EQUIPMENT ROOM TEMPERATURE SWITCHES	"RTB-006" (VIA CONTROL WIREWAY)
C-007	1"C	(1) FACTORY SUPPLIED CABLE, 1#6 GRD	WELL LEVEL ELEMENT	INSTRUMENT CABINET (VIA CONTROL WIREWAY)
C-008	3/4"C	2#14, 1#14 GRD	WELL WASH LINE FLOW ELEMENT	INSTRUMENT CABINET (VIA CONTROL WIREWAY)
C-009	3/4"C	2#14, 1#14 GRD	WELL DISCHARGE LINE FLOW ELEMENT	INSTRUMENT CABINET (VIA CONTROL WIREWAY)
C-010	1"C	(1) FACTORY SUPPLIED CABLE "	WELL DISCHARGE LINE FLOW ELEMENT	INSTRUMENT CABINET (VIA CONTROL WIREWAY)
C-011	3/4"C	2#14, 1#14 GRD	EMERGENCY STOP PUSHBUTTON	MOTOR CONTROL CENTER
C-012	3/4"C	2#14, 1#14 GRD	OIL DRIPPER SOLENOID VALVE	MOTOR CONTROL CENTER
C-013	3/4"C	2#14, 1#14 GRD	ELECTRIC HEATER THERMOSTAT	ELECTRIC HEATER
C-014	2"C	(2) 1-PAIR #16 BELDEN #8719 46#14, 1#14 GRD	"RTB-006"	CONTROL WIREWAY
C-015	(3) 1/2"C	(1) FACTORY SUPPLIED CABLE (1) 1-PAIR #16 BELDEN #8719, 2#12, 1#12 GRD	WELL DISCHARGE LINE FLOW TRANSMITTER	CONTROL WIREWAY
C-016	(3) 1/2"C	(1) FACTORY SUPPLIED CABLE (1) 1-PAIR #16 BELDEN #8719, 2#12, 1#12 GRD	WELL LEVEL TRANSMITTER	CONTROL WIREWAY
C-017	2"C	12#14, 6#12, 1#12 GRD	INSTRUMENT CABINET	CONTROL WIREWAY
C-018	1-1/4"C	(8) 3#18 BELDEN #8770, (1) 1-PAIR #16 BELDEN #8719 1#14 GRD	MOTOR TERMINATION BOX	MOTOR CONTROL CENTER
C-019	3/4"C	4#14, 1#14 GRD.	EVAPORATIVE COOLER THERMOSTAT	EVAPORATIVE COOLER CONTROLLER
C-020	1"C	UNDER SECTION 02441	IRRIGATION CONTROLLER	6'-0" BEYOND BUILDING

CONDUIT SCHEDULE — POWER CONDUIT/CONDUCTOR				
CONDUIT NO.	CONDUIT SIZE	FEEDER SIZE	FROM	TO
P-001	4"C	NOT IN CONTRACT	PNM PULL BOX	PRIMARY METERING ENCLOSURE
P-002	4"C	3#1/0, 15KV, 1#8 GRD	PRIMARY METERING ENCLOSURE	PRIMARY FUSED SWITCH
P-003	4"C	3#1/0, 15KV, 1#8 GRD	PRIMARY FUSED SWITCH	TRANSFORMER "XFMR/P-006"
P-004	4"C	3#1/0, 15KV, 1#8 GRD	TRANSFORMER "XFMR/P-006"	MOTOR CONTROL CENTER
P-005	3"C	3#1/0, 5KV, 1#8 GRD	MOTOR CONTROL CENTER	MOTOR SURGE CAPACITOR
P-006	3"C	3#1/0, 5KV, 1#8 GRD	MOTOR SURGE CAPACITOR	WELL MOTOR
P-007	3"C	3#6, 5KV, 1#8 GRD	MOTOR CONTROL CENTER	TRANSFORMER "XFMR/D-006"
P-008	1-1/2"C	4#2, 1#2 GRD	TRANSFORMER "XFMR/D-006"	PANEL "DP-006"
P-009	3/4"C	4#12, 1#12 GRD	PANEL "DP-006-16"	WASH LINE VALVE OPERATOR
P-010	1"C	3#8, 1#10 GRD	PANEL "DP-006-4"	ELECTRIC HEATER DISCONNECT SWITCH
P-011	3/4"C	4#12, 1#12 GRD	PANEL "DP-006-10"	DISCHARGE LINE VALVE OPERATOR
P-012	3/4"C	NOT IN CONTRACT	PANEL "DP-006-13"	RADIO
P-013	3/4"C	2#12, 1#12 GRD	PANEL "DP-006-15"	INSTRUMENT CABINET (VIA CONTROL WIREWAY)
P-014	3/4"C	NOT IN CONTRACT	PANEL "DP-006-11"	"RTU-006"
P-015	3/4"C	2#12 1#12 GRD	PANEL "DP-006-17"	EVAPORATIVE COOLER CONTROLLER
P-016	1"C	3#8 1#10 GRD	ELECTRIC HEATER DISCONNECT SWITCH	ELECTRIC HEATER
P-017	3/4"C	4#12 1#12 GRD	EVAPORATIVE COOLER CONTROLLER	EVAPORATIVE COOLER
P-018	3/4"C	2#12, 1#12 GRD	PANEL "DP-006-19"	IRRIGATION CONTROLLER

PANEL "DP-006"		120/208V, 3Ø, 4 WIRE, 100A FRAME, 100A M.C.B., 27 CKT., SURFACE MOUNT, BOTTOM FEED, NEMA 1 ENCLOSURE, FRONT HINGED TO BOX.				
CKT	BKR. RTNG.	LOAD DESCRIPTION	AMPERAGE LOAD			LOAD DESCRIPTION
			ØA	ØB	ØC	
1	20A/1P #12	LIGHTS (EQUIPMENT ROOM)	6.3			ELECTRIC HEATER
3	20A/1P #12	LIGHTS (PUMP ENCLOSURE ROOM)	28.0	0.5		
5	20A/1P #12	LIGHTS (EXTERIOR)		28.0	0.5	
7	20A/1P #12(GFI)	RECEPTACLES	4.5			DISCHARGE LINE VALVE OPERATOR
9	20A/1P #12(GFI)	RECEPTACLES	1.7	3.0		
11	20A/1P	"RTB-006"		1.7	2.0	
13	20A/1P	RADIO	2.0		1.7	WASH LINE VALVE OPERATOR
15	20A/1P #12	INSTRUMENT CABINET, FLOW TRANSMITTER	1.7	2.0		
17	20A/1P #12	EVAPORATIVE COOLER			11.3	
19	15A/1P #12	IRRIGATION CONTROLLER	1.0			SPARE
21	20A/1P	SPARE				
23	20A/1P	SPARE				
25	20A/1P	SPARE				PANELBOARD MAIN CIRCUIT BREAKER
27	15A/1P	SPARE				
29	20A/1P	SPARE				

(GFI)= GROUND FAULT INTERRUPTER CIRCUIT BREAKER


RECORD DRAWING

Date AUG 10 1989


These drawings have been revised based on field data and every reasonable attempt has been made to depict construction as actually performed.

1 2 3 4 5 6 7 8 9 10 11 12
26 33381989

CITY OF ALBUQUERQUE MUNICIPAL DEVELOPMENT DEPARTMENT ENGINEERING DIVISION					
TITLE: WALKER NO.2 WELL EQUIPMENT ELECTRICAL SITE PLAN CONDUIT SCHEDULES & PANELBOARD SCHEDULE					
APPROVALS	ENGINEER	DATE	APPROVALS	ENGINEER	DATE
City Engineer			Liquid Waste		
A.C.E. Design			Traffic		
A.C.E.-Hydrology			Water		
DRAWING NO.	3338	MAP NO.		SHEET	OF
				E-2	E-9

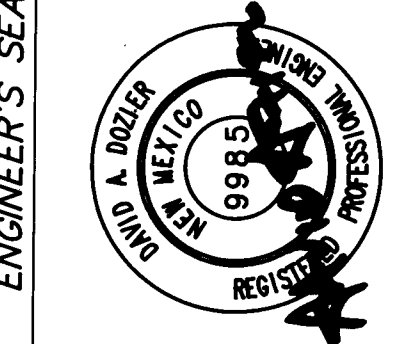


REVISIONS		REMARKS	
NO.	DATE	BY	DATE
1	2/13/89	FIELD REV. NO. 1	
DESIGNED BY D. DOZIER		DATE 9-29-88	
DRAWN BY P. SCHMITTLE		DATE 9-29-88	
CHECKED BY J. KEALY		DATE 9-29-88	

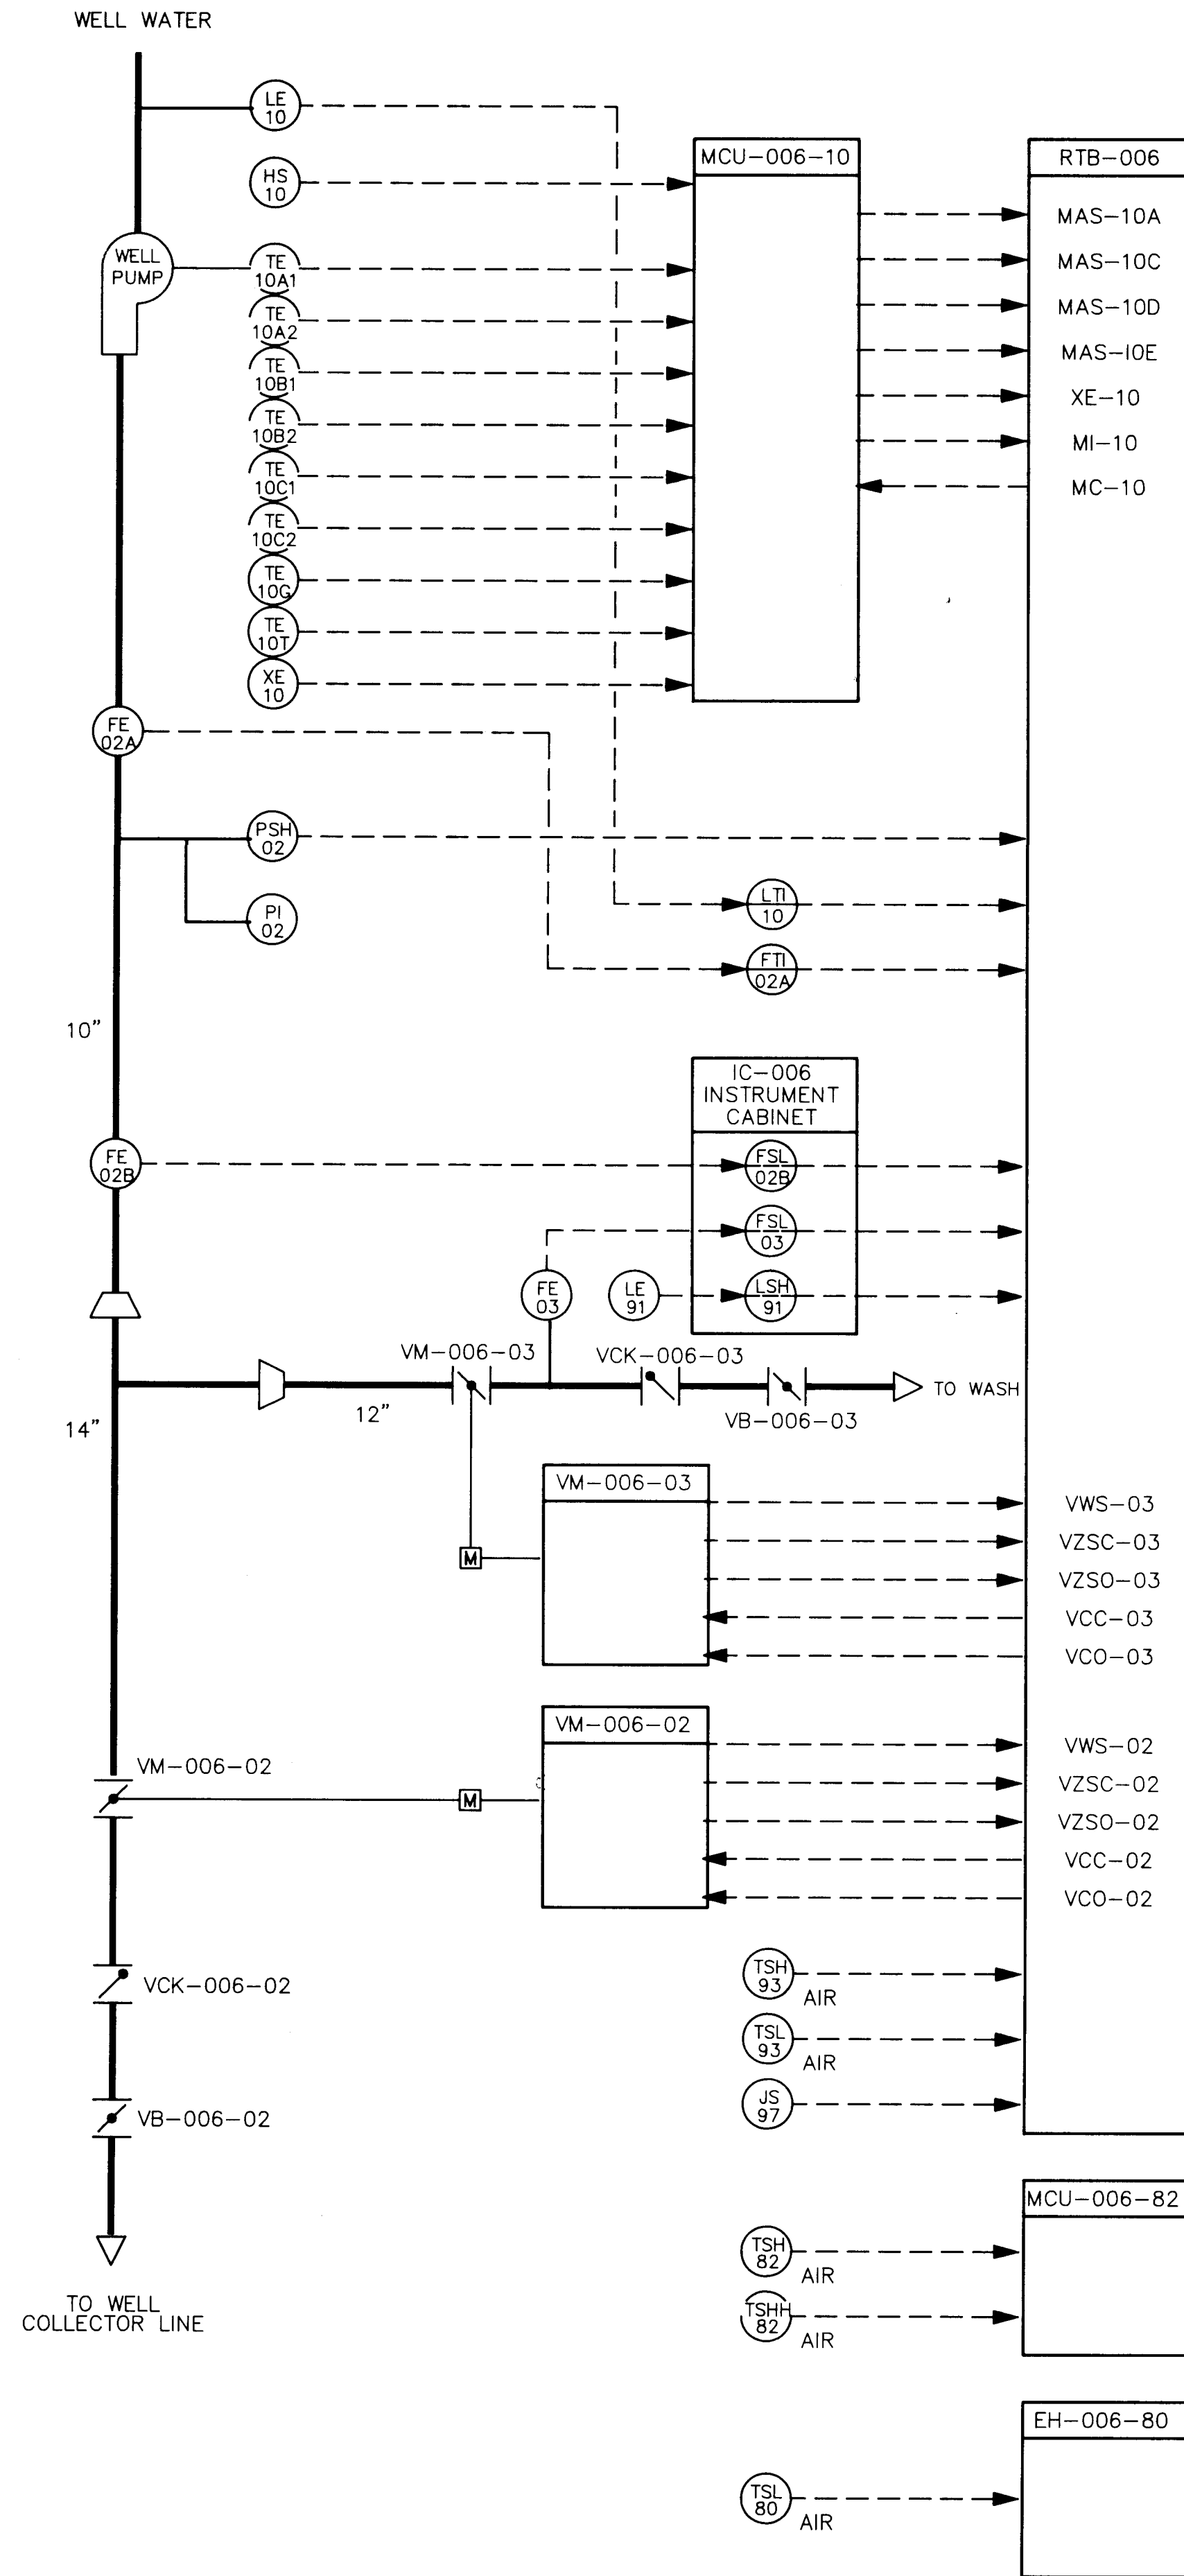

1
3 3
NO SCALE

PIPING AND INSTRUMENT DIAGRAM

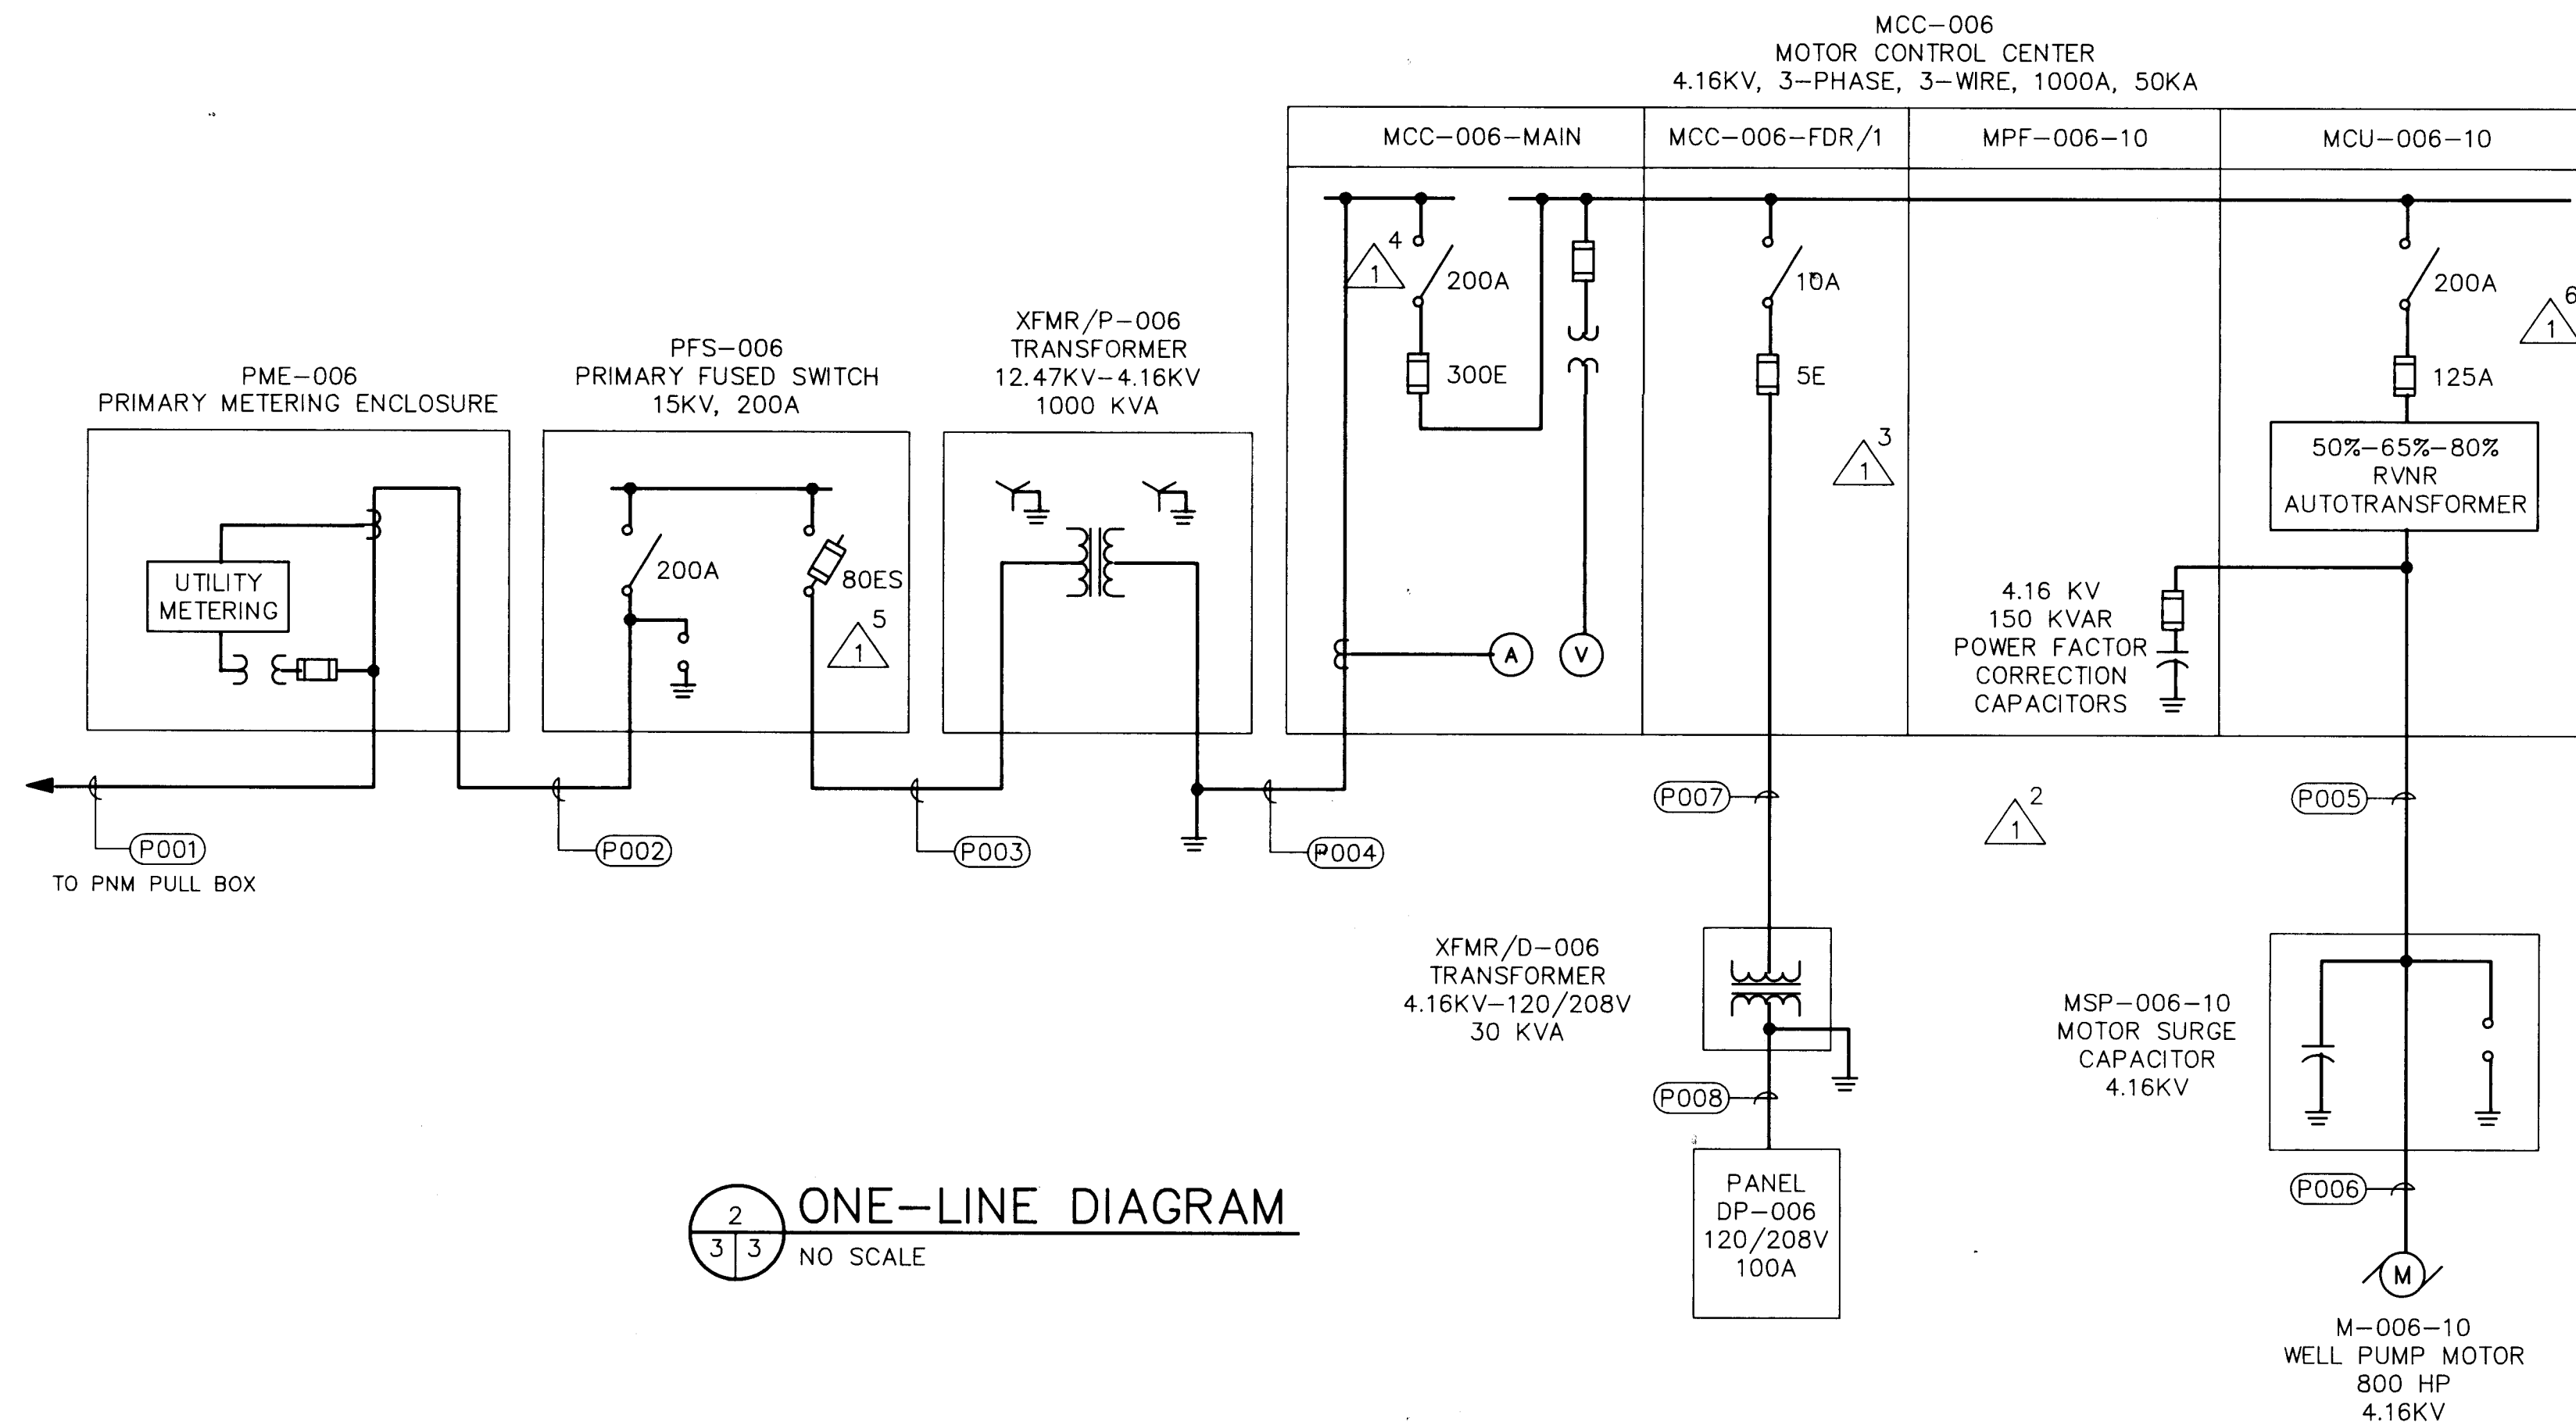

2
3 3
NO SCALE

ONE-LINE DIAGRAM

RECORD DRAWING
AUG 10 1989

Date: These drawings have been revised based on field data and every reasonable attempt has been made to depict construction as actually performed.

GENERAL NOTES


- SEE SHEET E-1 FOR SYMBOLS LEGEND.
- SEE SHEET E-2 FOR CONDUIT SCHEDULES.

1 2 3 4 5 6 7 8 9 10 11 12
26 33 38 20 89


CITY OF ALBUQUERQUE MUNICIPAL DEVELOPMENT DEPARTMENT ENGINEERING DIVISION					
TITLE: WALKER NO.2 WELL EQUIPMENT ONE-LINE DIAGRAM PIPING AND INSTRUMENT DIAGRAM					
APPROVALS	ENGINEER	DATE	APPROVALS	ENGINEER	DATE
City Engineer			Liquid Waste		
A.C.E. Design			Traffic		
A.C.E.-Hydrology			Water		
DRAWING NO.	3338	MAP NO.	SHEET	OF	E-3 E-9

AS BUILT INFORMATION	
CONTRACTOR	DATE
INSPECTOR'S	DATE
STAMPED BY	DATE
FIELD CHECK BY	DATE
VERIFICATION BY	DATE
CORRECTED BY	DATE
MICRO-FILM INFORMATION	
RECORDED BY	DATE
NO.	

SURVEY INFORMATION	
FIELD NOTES	DATE
BY	
NO.	

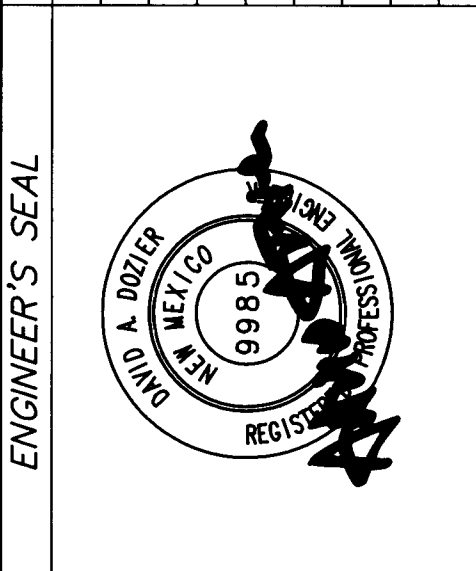

ENGINEER'S SEAL	
REVISIONS	REMARKS
NO.	DATE
DESIGNED BY	DATE
DRAWN BY	DATE
CHECKED BY	DATE

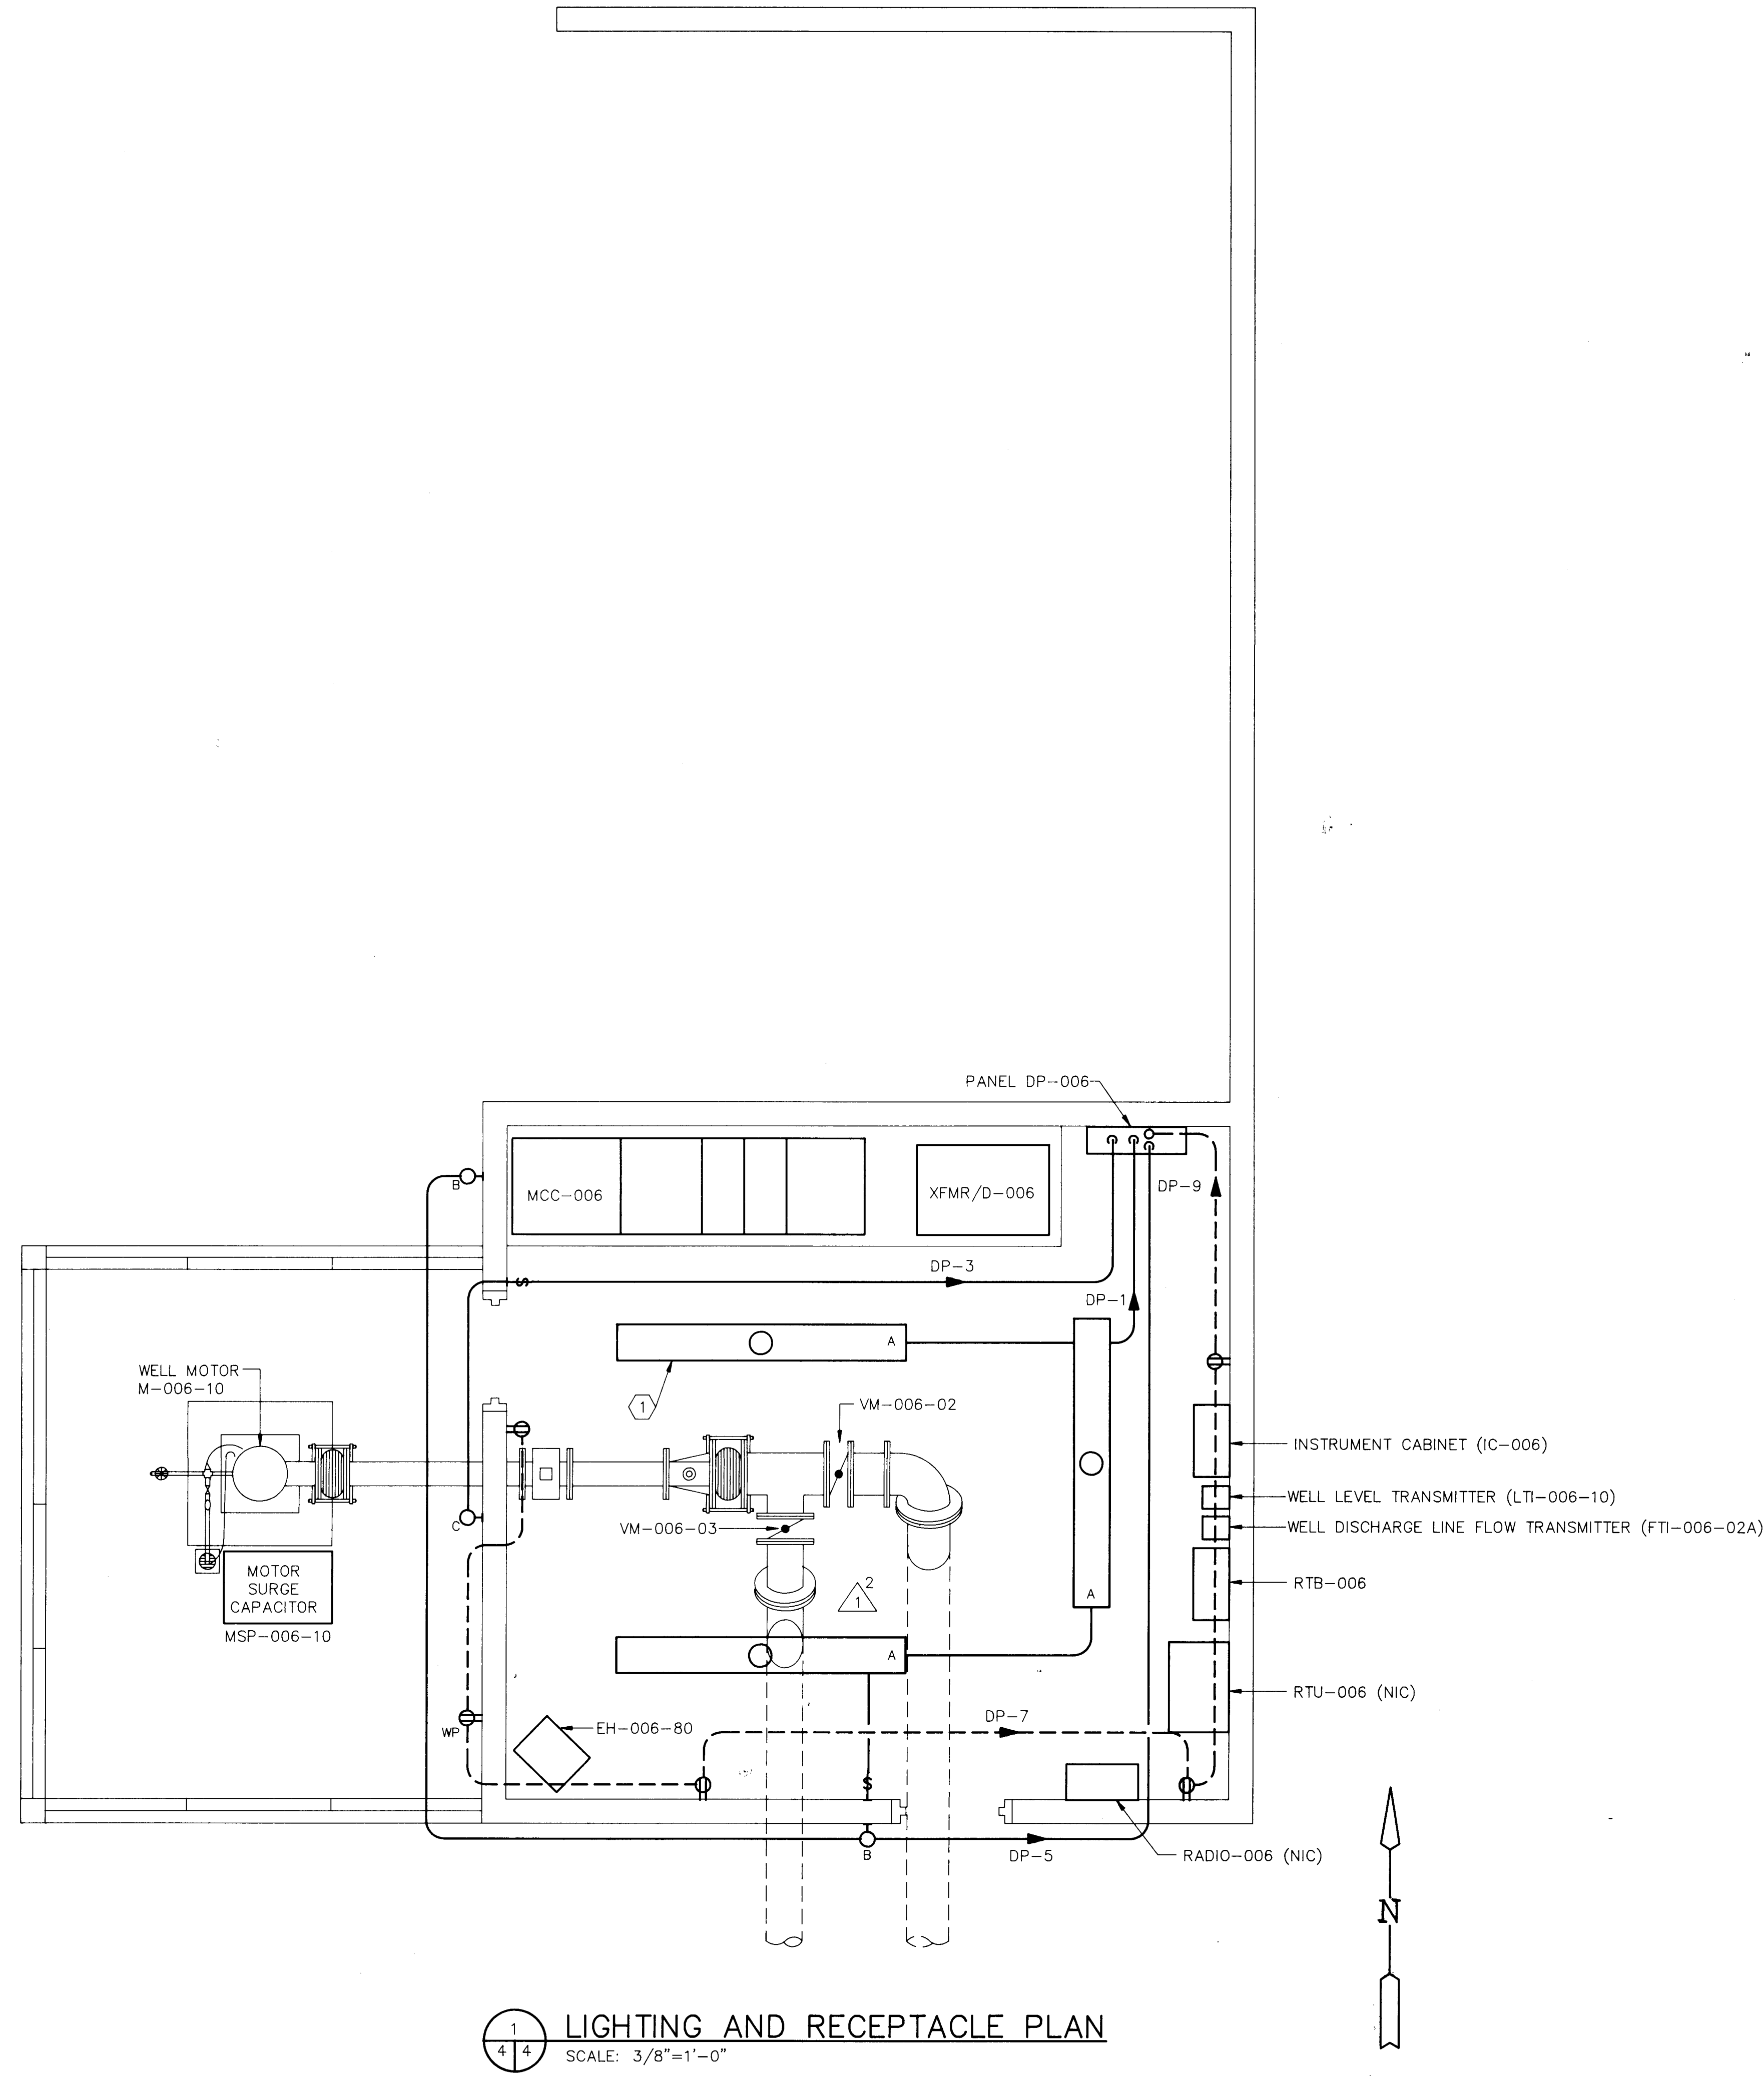

1 4 4 LIGHTING AND RECEPTACLE PLAN
SCALE: 3/8"=1'-0"

GENERAL NOTES

- SEE SHEET E-1 FOR SYMBOLS LEGEND.
- INSTALL LIGHTING AND RECEPTACLE CIRCUIT CONDUIT CONCEALED WITHIN THE CMU BLOCK WALL, EXCEPT AT PANELBOARD "DP-006", WHERE THE CONDUIT SHALL BE SURFACE MOUNTED.
- USE FLUSH MOUNTED OUTLET BOXES FOR THE INSTALLATION OF RECEPTABLES, WALL SWITCHES, AND WALL MOUNTED LIGHT FIXTURES. ATTACH TO CONDUIT CONCEALED WITHIN THE CMU BLOCK WALL.
- COORDINATE EXACT LOCATION OF PENDANT MOUNTED FLUORESCENT LIGHT FIXTURES TO AVOID CONFLICTS WITH MECHANICAL DUCTWORK AND EQUIPMENT.
- PROVIDE NUMBER OF PHASE AND NEUTRAL CONDUCTORS REQUIRED TO IMPLEMENT LIGHTING AND RECEPTACLE CIRCUITING SHOWN ON PLAN.

KEYED NOTES

- PENDANT MOUNT FLUORESCENT LIGHT FIXTURES USING ONE RGS CONDUIT AT EACH END OF FIXTURE. ATTACH PENDANT CONDUIT TO BRANCH CIRCUIT CONDUIT USING FLEXIBLE FIXTURE HANGER CONDULET BOX COVER ON ONE CONDUIT AND CONDUIT EYE HOOK ON OTHER CONDUIT. TYPICAL OF THREE FIXTURES.

RECORD DRAWING
Date AUG 10 1989
These drawings have been revised based on field data and every reasonable attempt has been made to depict construction as actually performed.


1 2 3 4 5 6 7 8 9 10 11 12
26 33 38 21 89

805611ED1, 8056LGT

CITY OF ALBUQUERQUE MUNICIPAL DEVELOPMENT DEPARTMENT ENGINEERING DIVISION					
TITLE: WALKER NO.2 WELL EQUIPMENT LIGHTING AND RECEPTACLE PLAN					
APPROVALS	ENGINEER	DATE	APPROVALS	ENGINEER	DATE
City Engineer			Liquid Waste		
A.C.E. Design			Traffic		
A.C.E.-Hydrology			Water		
DRAWING NO. 3338		MAP NO.		SHEET 4 OF 9	



AS BUILT INFORMATION			BENCH MARKS			SURVEY INFORMATION			ENGINEER'S SEAL		
CONTRACTOR	DATE					NO.	BY	DATE			
INSPECTOR'S	DATE										
FIELD BY	DATE										
VERIFICATION BY	DATE										
CORRECTED BY	DATE										
MICRO-FILM INFORMATION											
RECORDED BY	DATE										
NO.											

FIELD REV. NO. 1	BY	DATE	REMARKS
2/13/89	LH	9-29-88	DESIGN
		9-29-88	DRAWN BY P. SCHMITTLE
		9-29-88	CHECKED BY J. KEALY

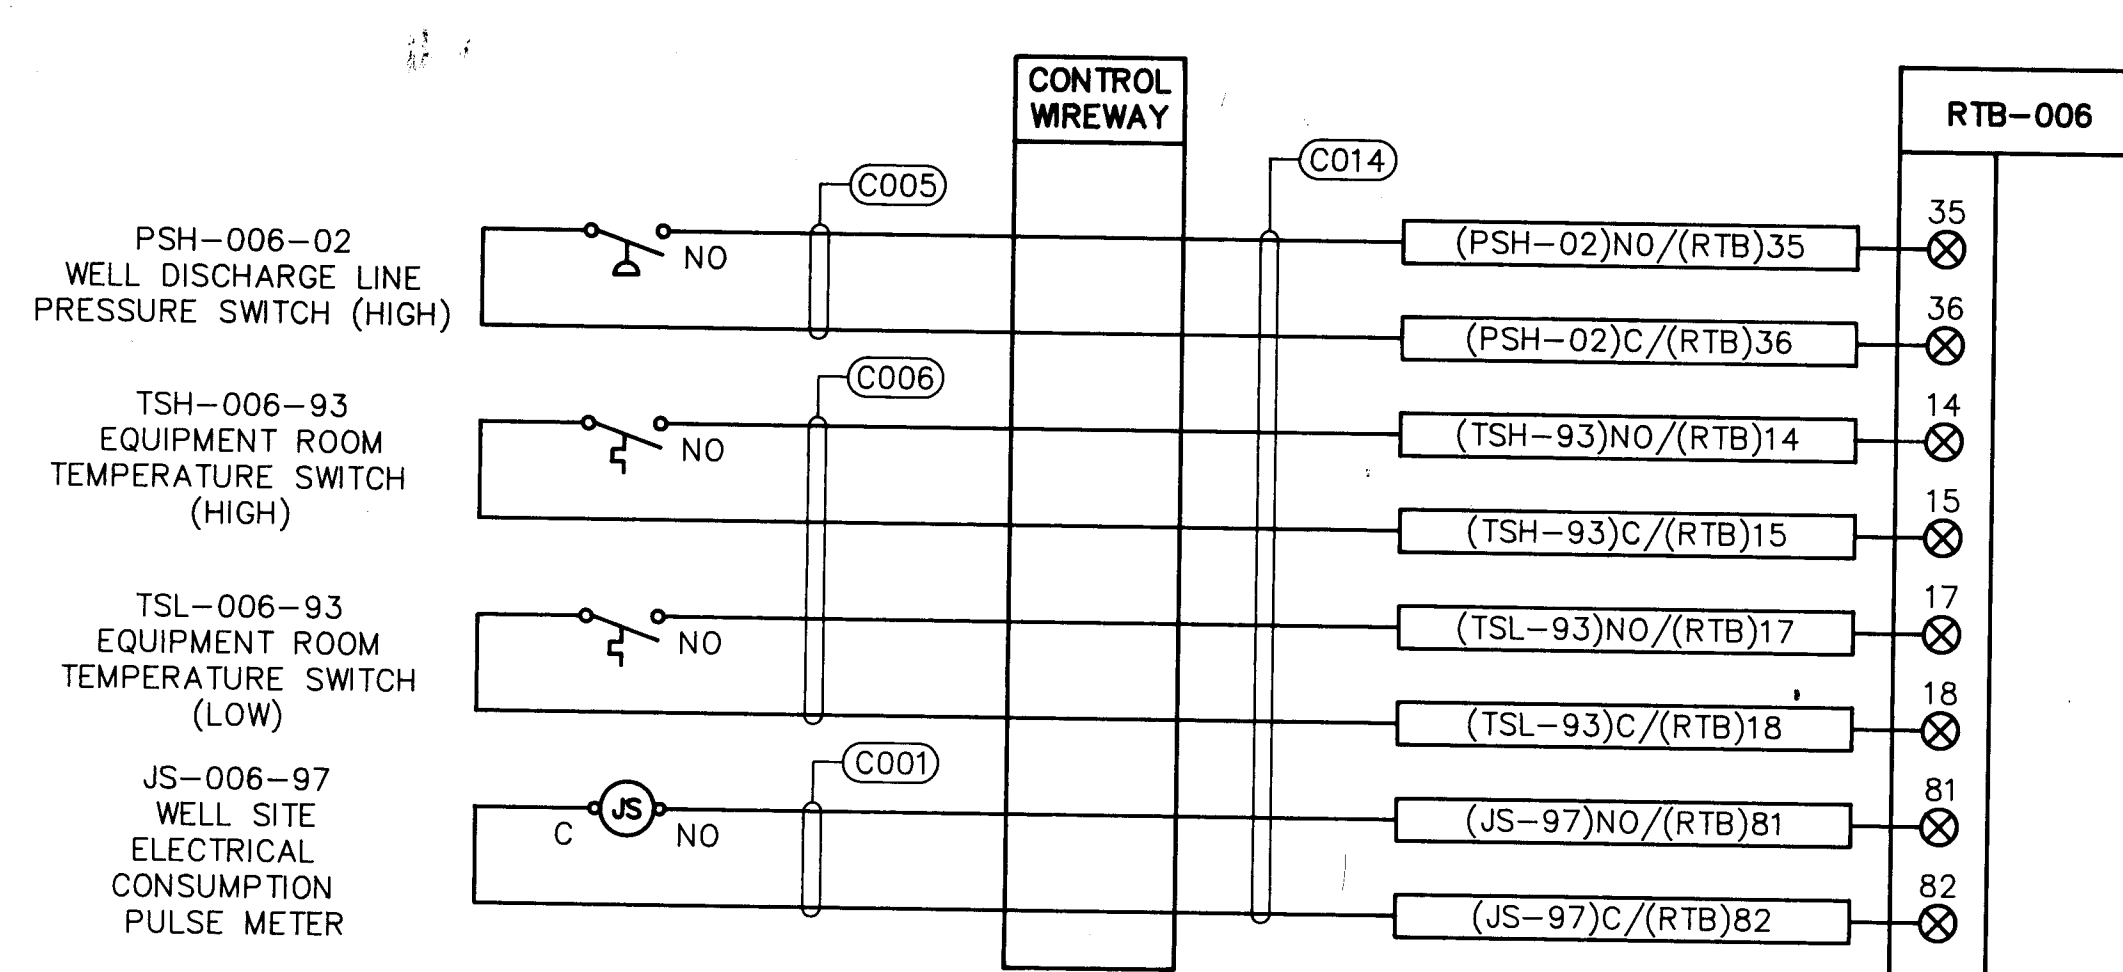

1. SEE SHEET E-1 FOR SYMBOLS LEGEND.
2. SEE SHEET E-2 FOR CONDUIT SCHEDULES.

1 B/W CONTROLS INC. RELAY. SEE SECTION 13315 OF
THE SPECIFICATIONS.

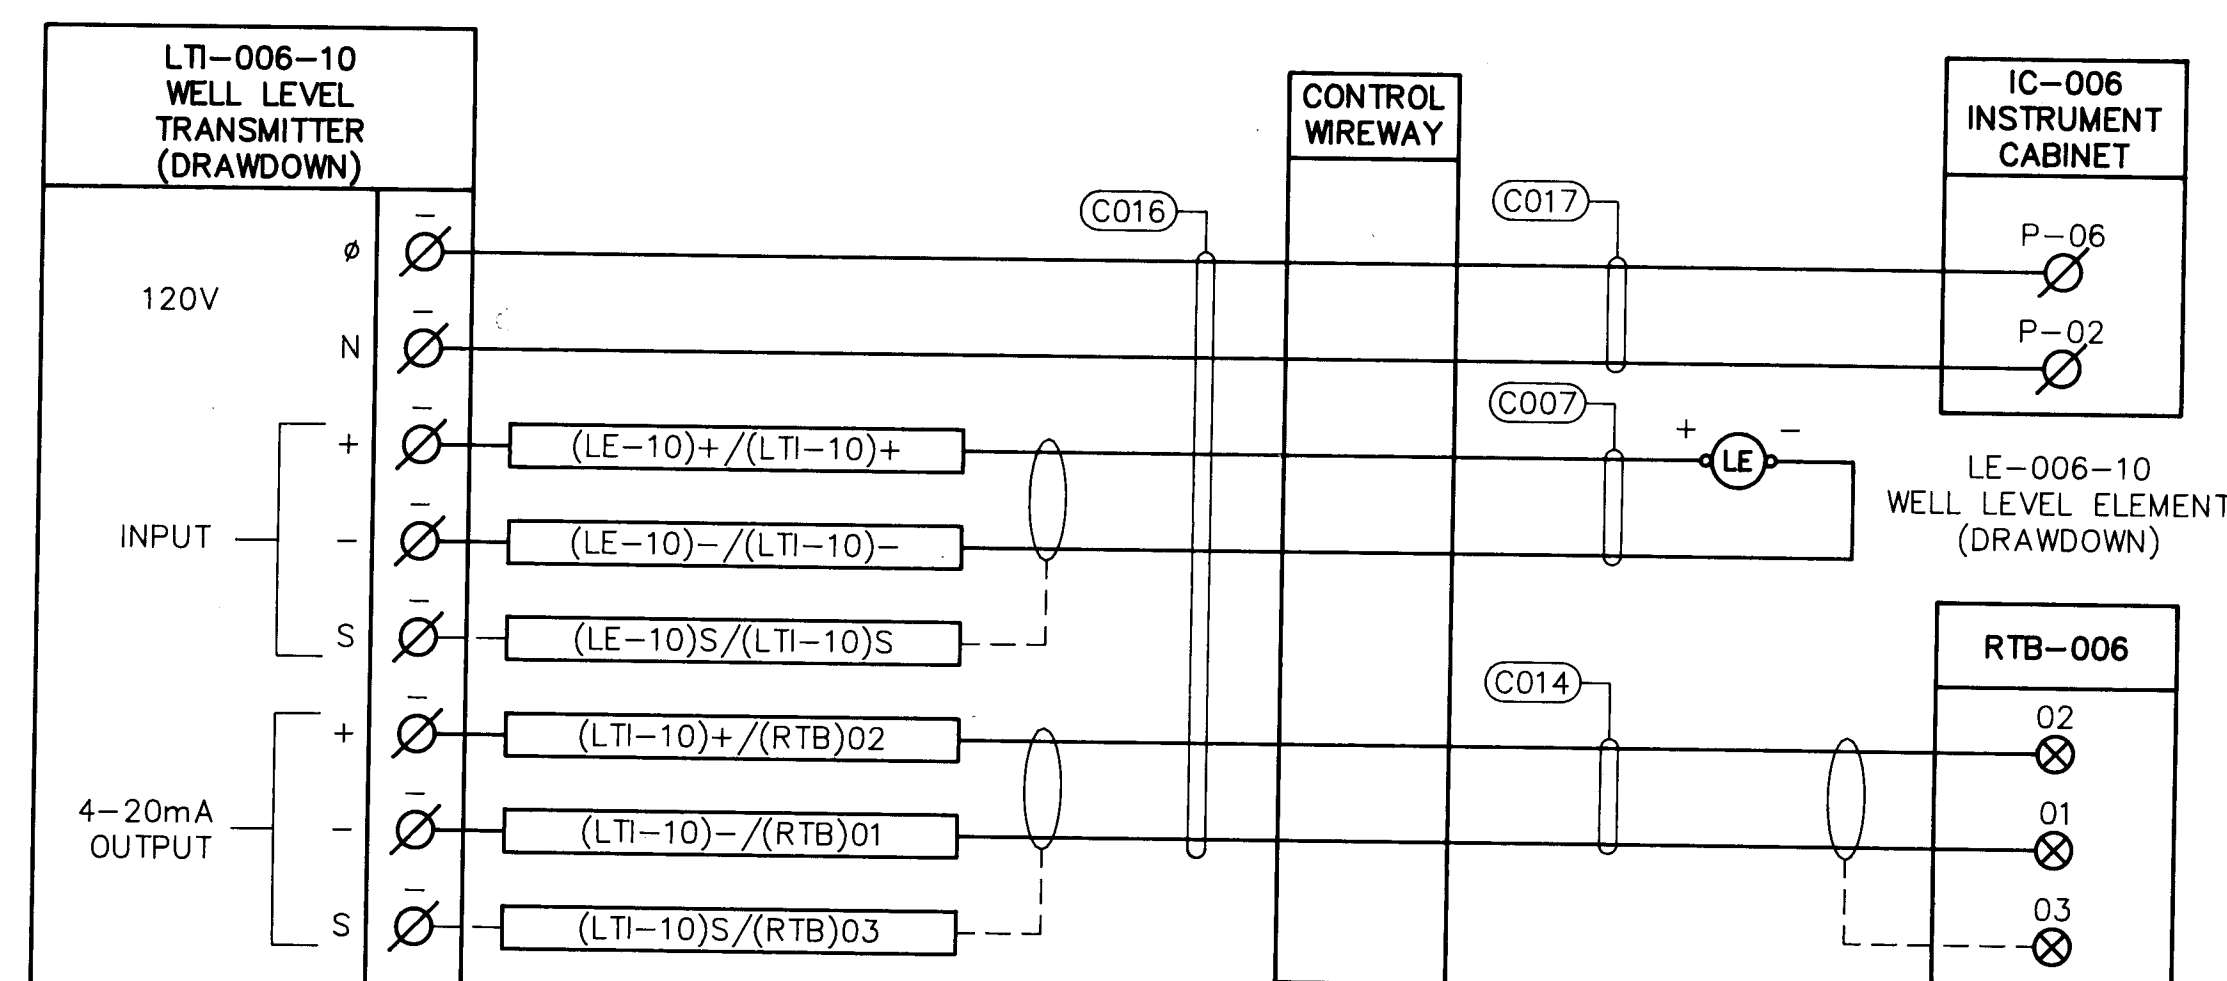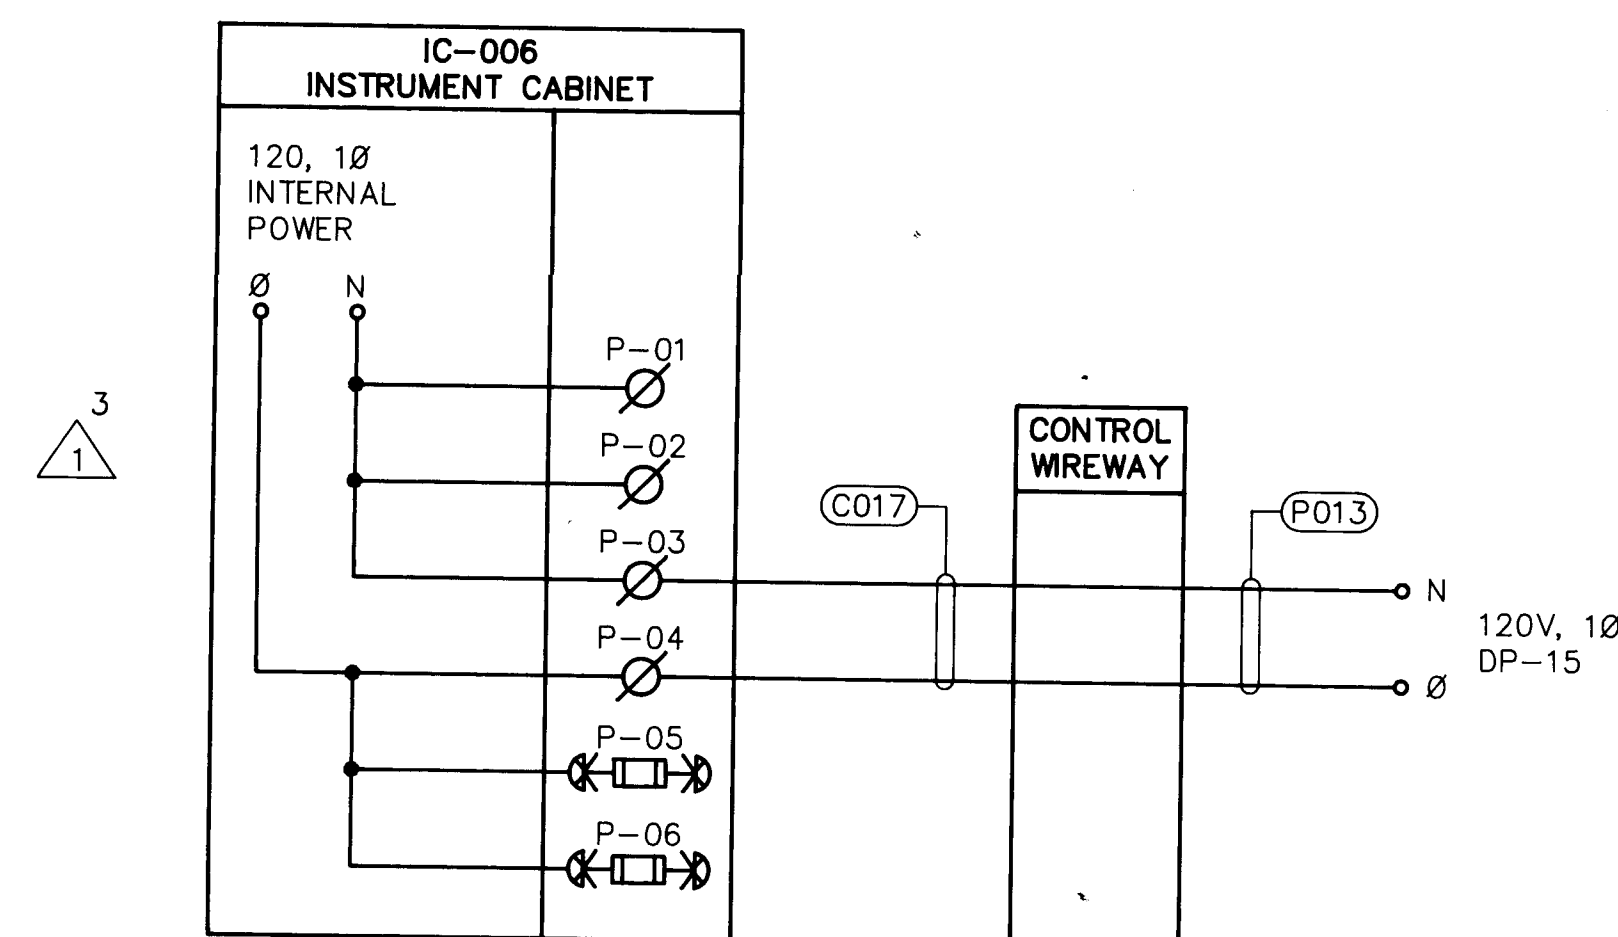






Date AUG 17 1965
These drawings have been revised
on field data and as far as reasonable
has been made to depict con-
ditions actually performed.

805611ED1, 8056E7					
CITY OF ALBUQUERQUE MUNICIPAL DEVELOPMENT DEPARTMENT ENGINEERING DIVISION					
TITLE: WALKER NO.2 WELL EQUIPMENT INTERCONNECTION DIAGRAMS					
APPROVALS	ENGINEER	DATE	APPROVALS	ENGINEER	DATE
City Engineer			Liquid Waste		
A.C.E. Design			Traffic		
A.C.E.—Hydrology			Water		
DRAWING NO.		MAP NO.		SHEET OF	
3338				E-7 E-9	

GENERAL NOTES

1. SEE SHEET E-1 FOR SYMBOLS LEGEND.
2. SEE SHEET E-2 FOR CONDUIT SCHEDULES.

- MAS-006-10A
MCU ALARM/SWITCH
(MFM RELAY "TRIP")
- MAS-006-10B
MCU ALARM/SWITCH
(MFM RELAY "GROUND FAULT")
- MAS-006-10C
MCU ALARM/SWITCH
(MFM RELAY "FAIL")
- MAS-006-10D
MCU ALARM/SWITCH
(INCOMPLETE SEQUENCE ALARM)
- MI-006-10
MCU RUN INDICATION
- MC-006-10
RUN/STOP COMMAND
- XE-006-10
WELL PUMP MOTOR
VIBRATION LOOP
- XE-006-10
WELL PUMP MOTOR
VIBRATION ELEMENT
- VS-006-10
OIL DRIPPER
SOLENOID VALVE
- HS-006-10
EMERGENCY STOP
PUSHBUTTON

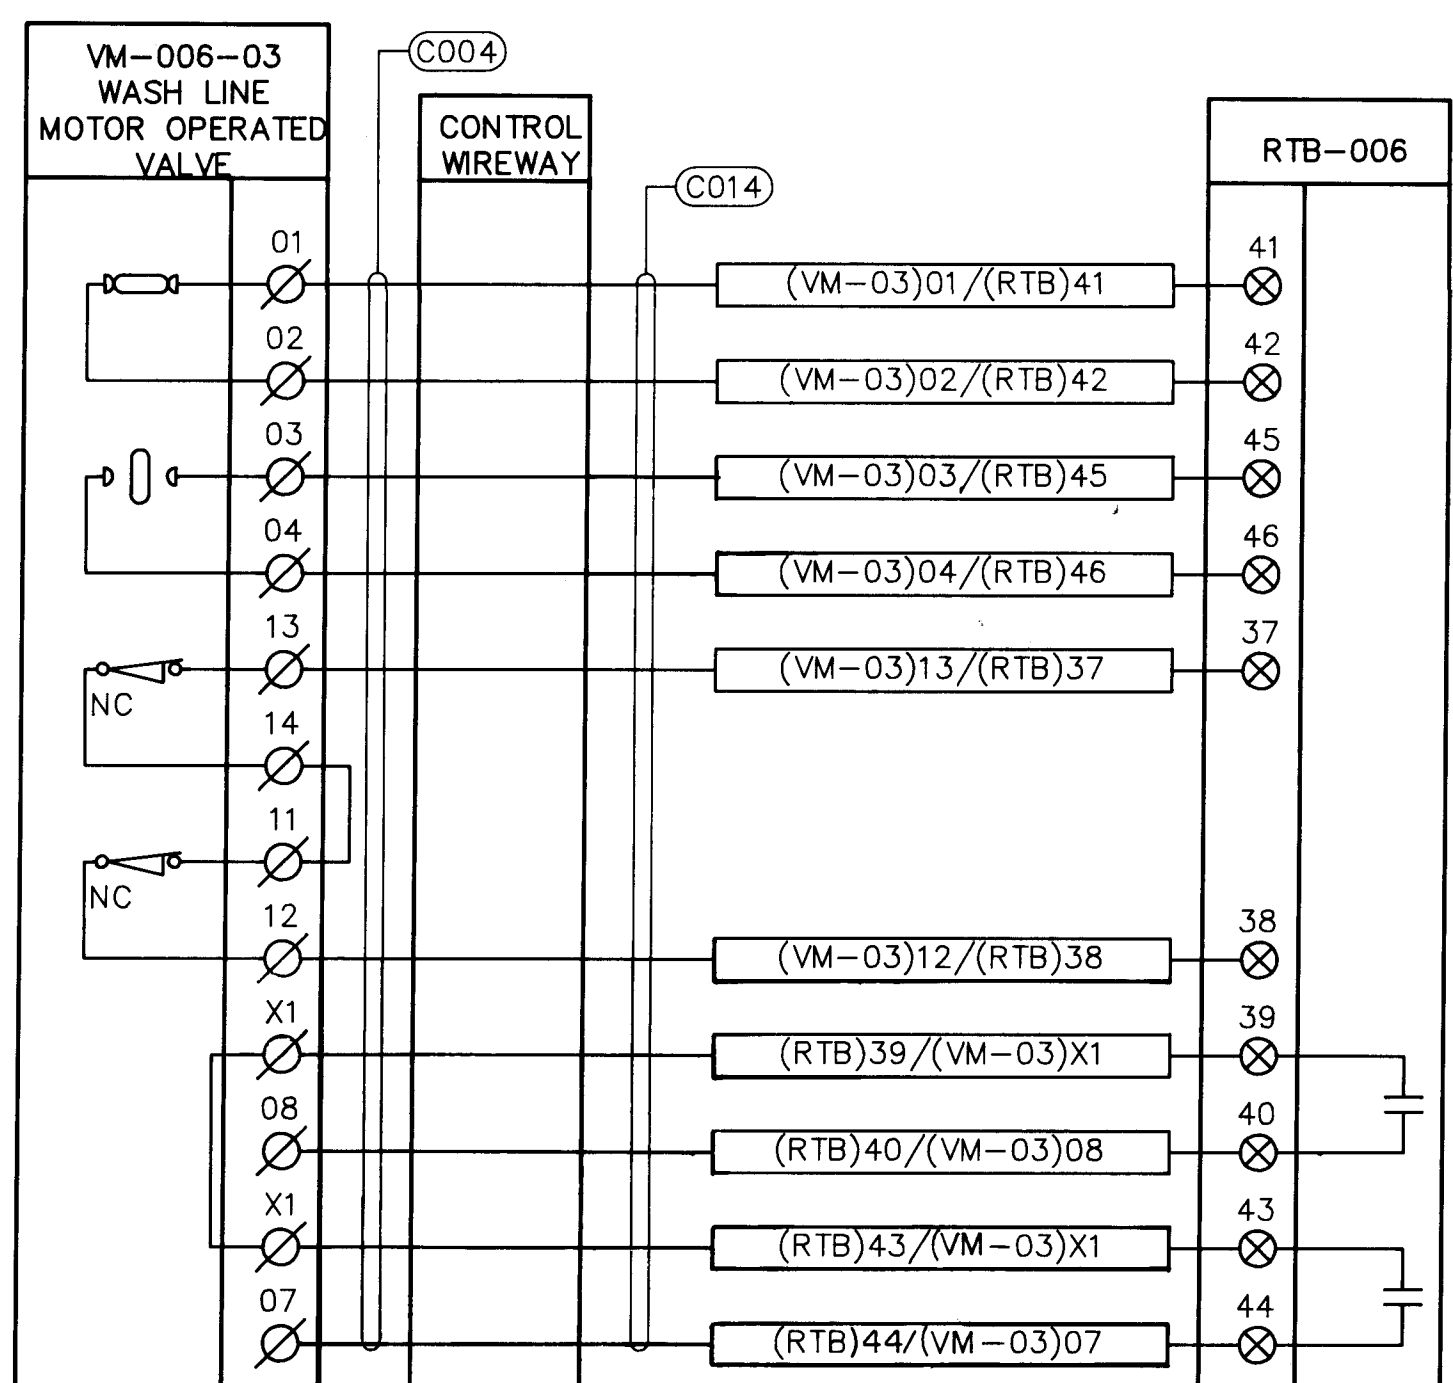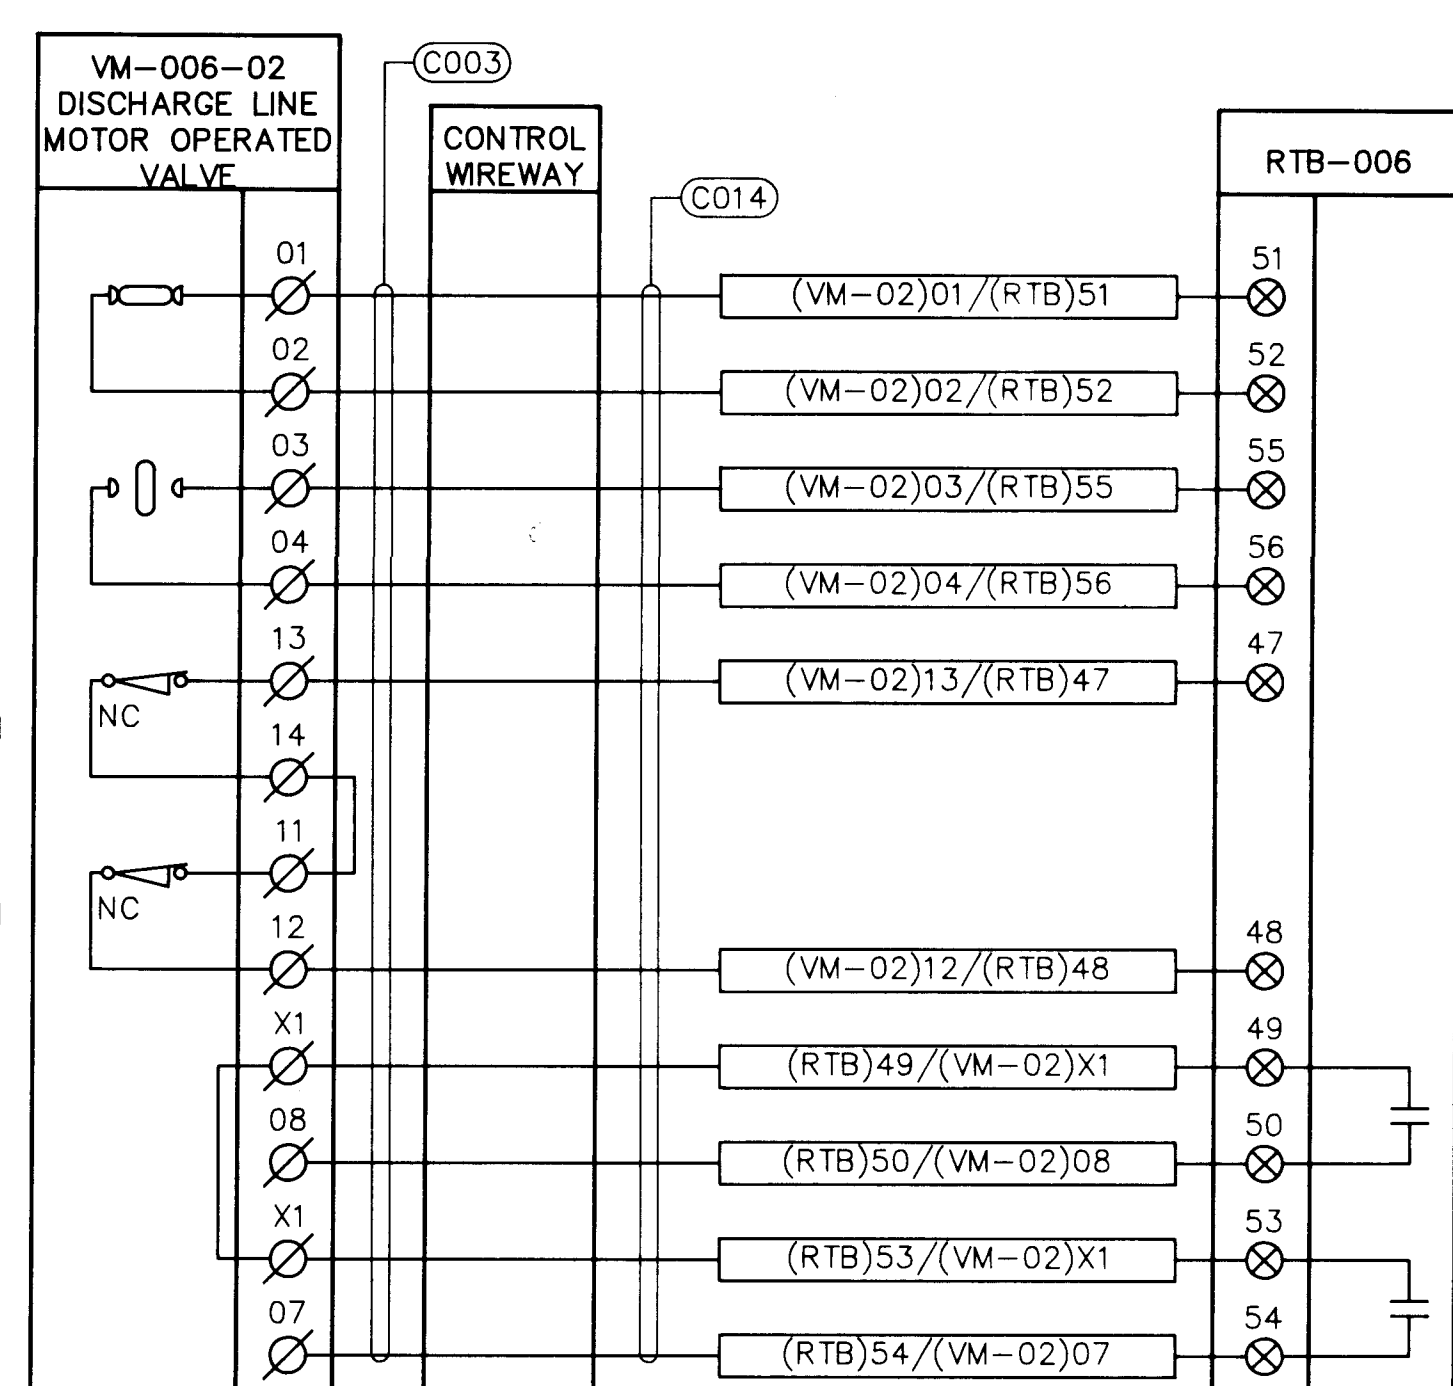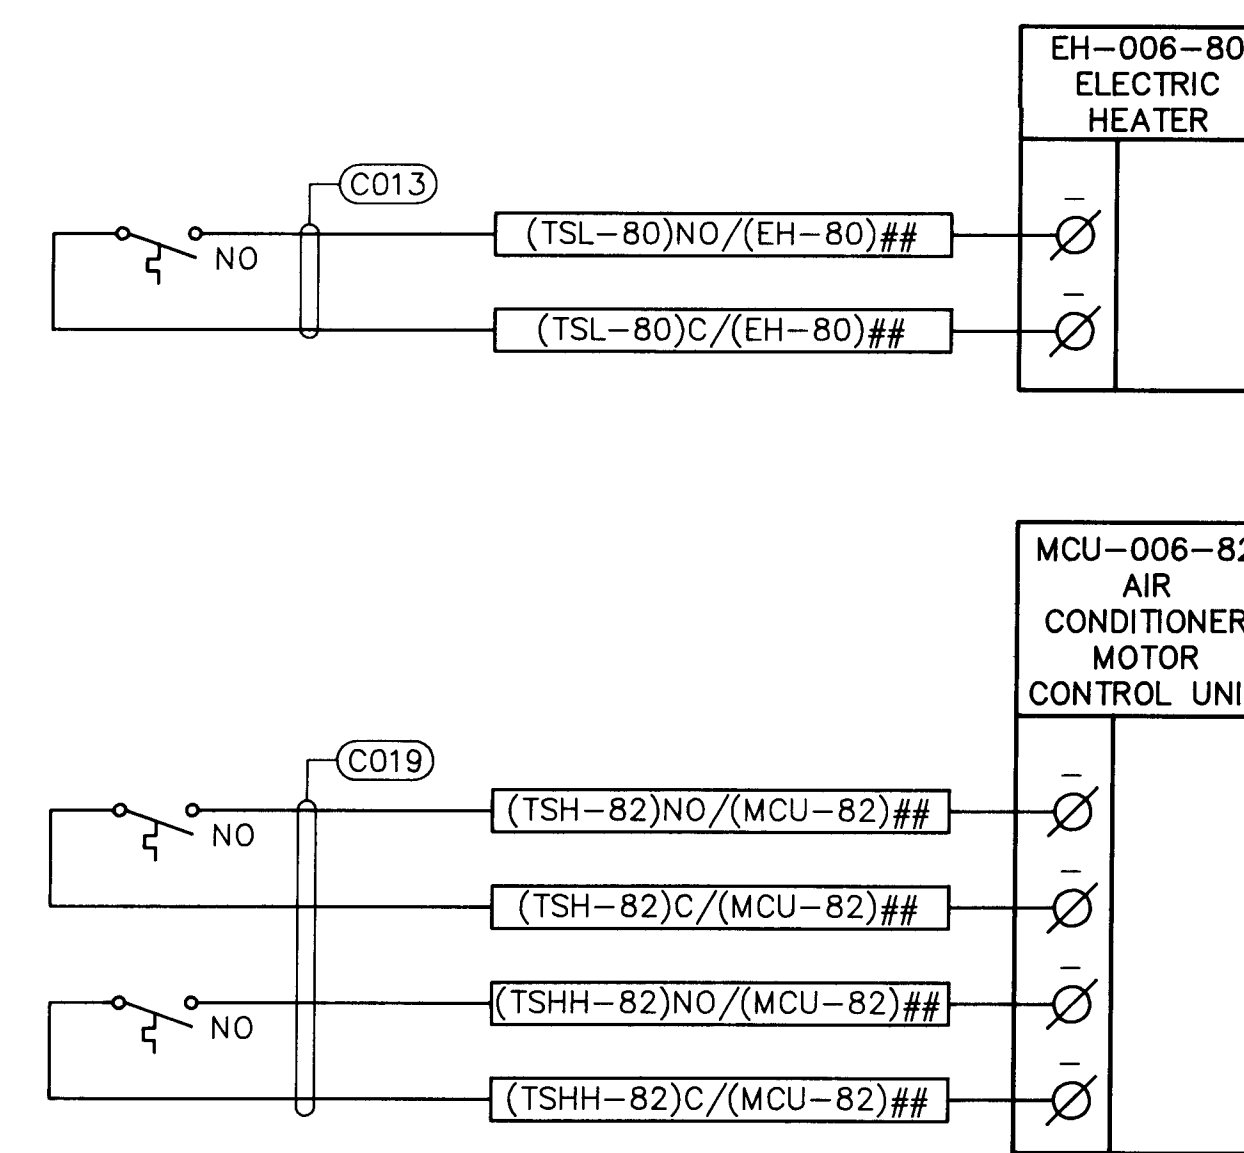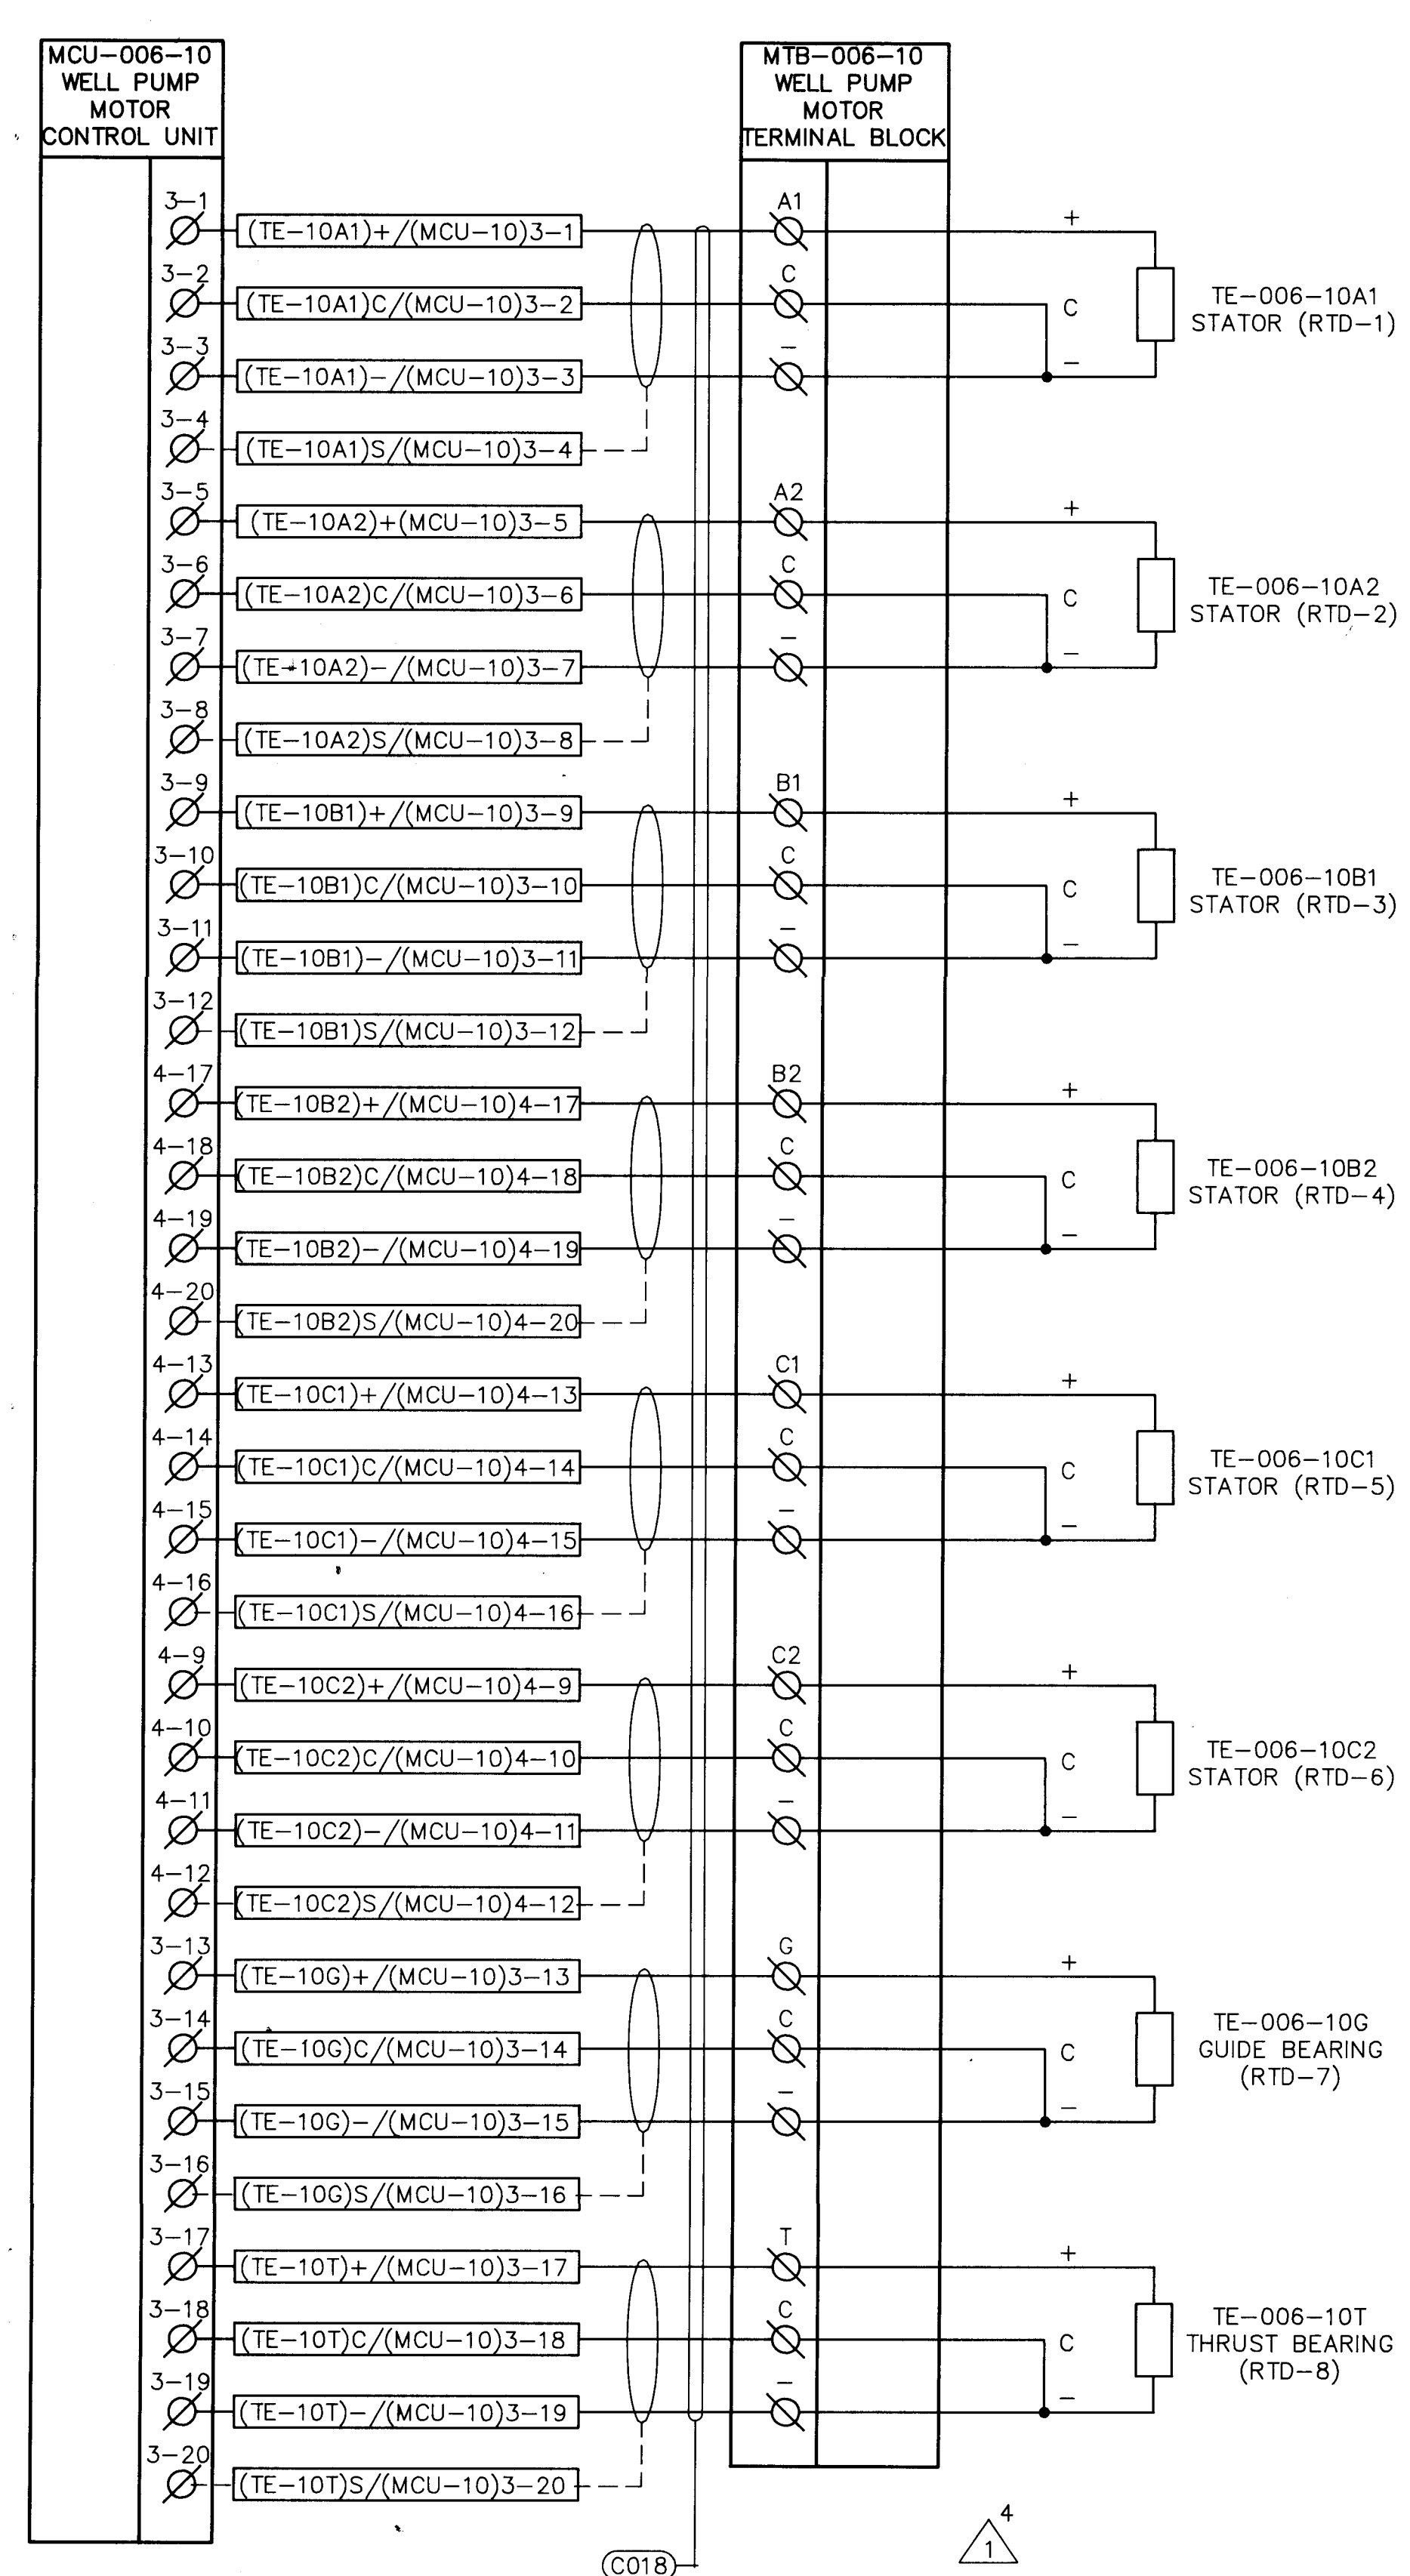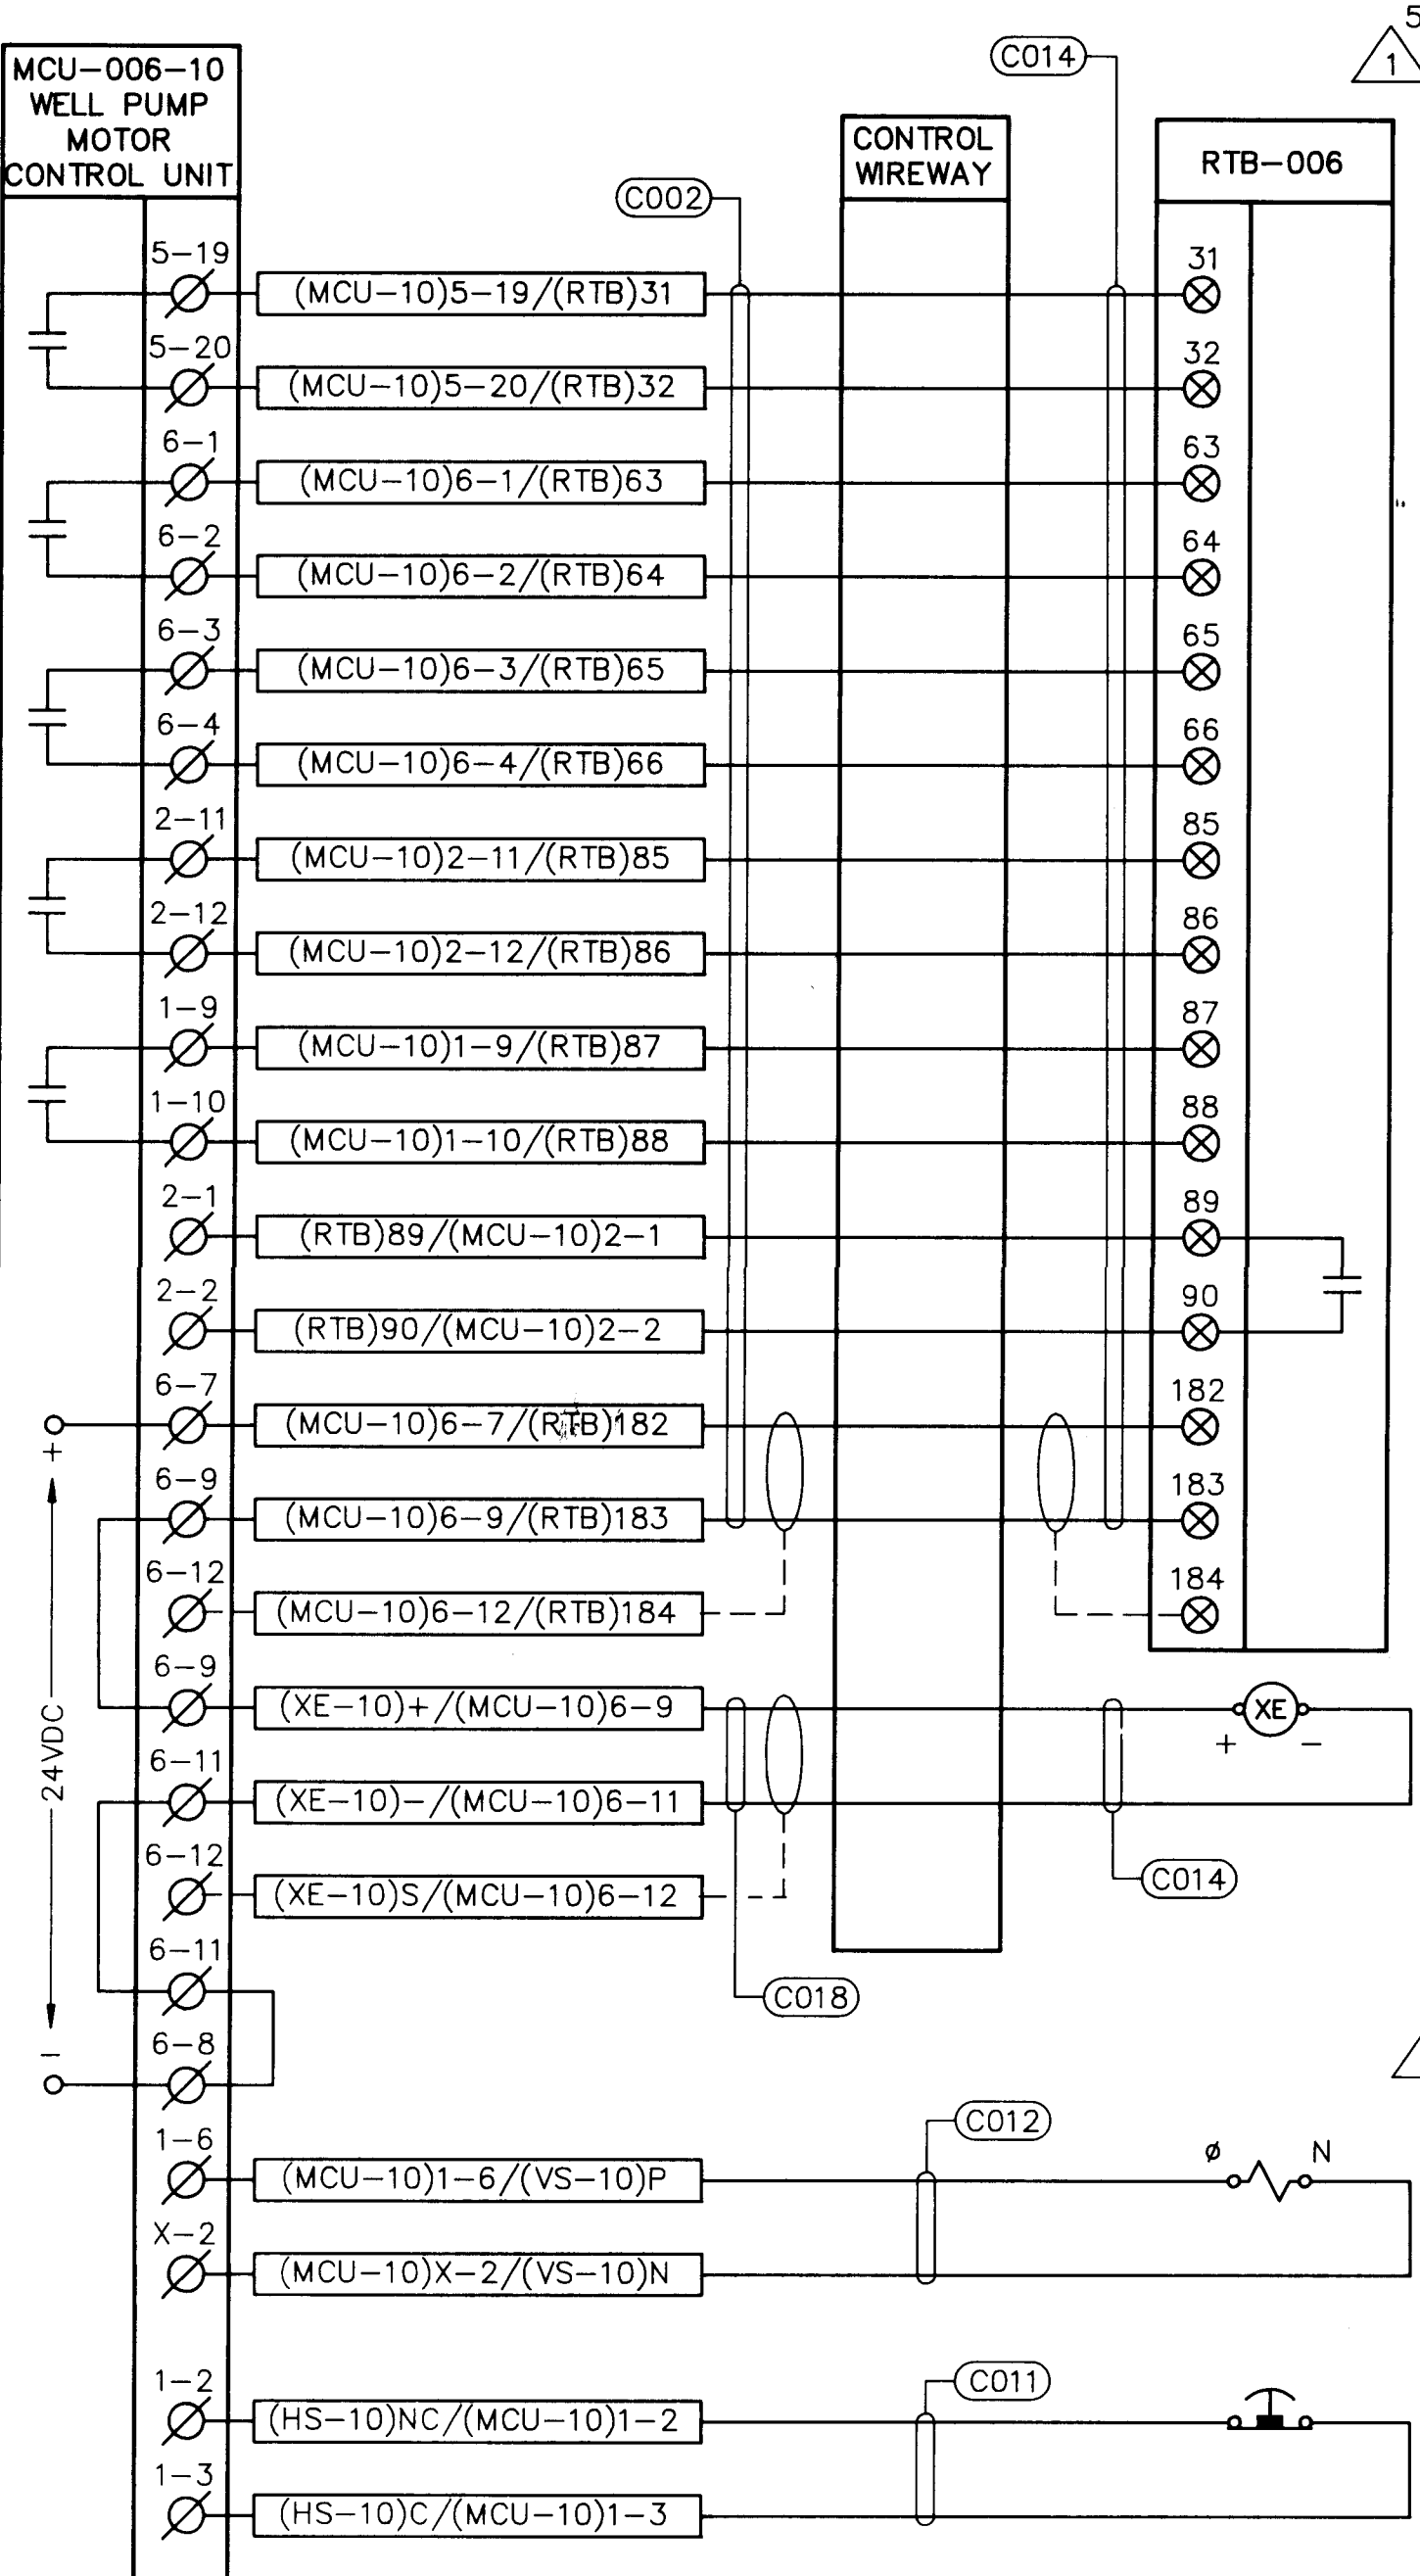


GENERAL NOTES


- 1 SEE SHEET E-1 FOR SYMBOLS LEGEND.
- 2 SEE SHEET E-2 FOR CONDUIT SCHEDULES.

KEYED NOTES


- 1 PRIMARY METERING ENCLOSURE.
- 2 PRIMARY FUSED SWITCH.
- 3 POWER TRANSFORMER.
- 4 1 INCH CHAMFER.
- 5 8 INCH DEEP GRAVEL BETWEEN SLAB AND WALLS.
- 6 FINISH GRADE, 4" BELOW TOP OF SLAB.
- 7 4 INCH SAND FILL.
- 8 INSULATED TYPE GROUNDING BUSHING. TOP OF BUSHING SHALL BE 3 INCHES ABOVE CONCRETE SLAB.
- 9 #4 AT 12" CENTERS EACH WAY, 3 INCHES FROM BOTTOM OF SLAB. BOND TO GROUND COUNTERPOISE SYSTEMS AS SHOWN ON SHEET E-5.
- 10 EXTEND #1/0 AWG BARE STRANDED COPPER TO ENCLOSURE GROUND LUG OR BUS.
- 11 COORDINATE EXACT LOCATION OF CONDUIT WITH EQUIPMENT MANUFACTURERS. SEAL CONDUIT OPENING AFTER INSTALLATION OF CONDUCTOR.
- 12 CONDUIT TO FIELD DEVICES AND PANELBOARD "DP-006" NOT SHOWN FOR DRAWING CLARITY.
- 13 6" X 6" WIREWAY.

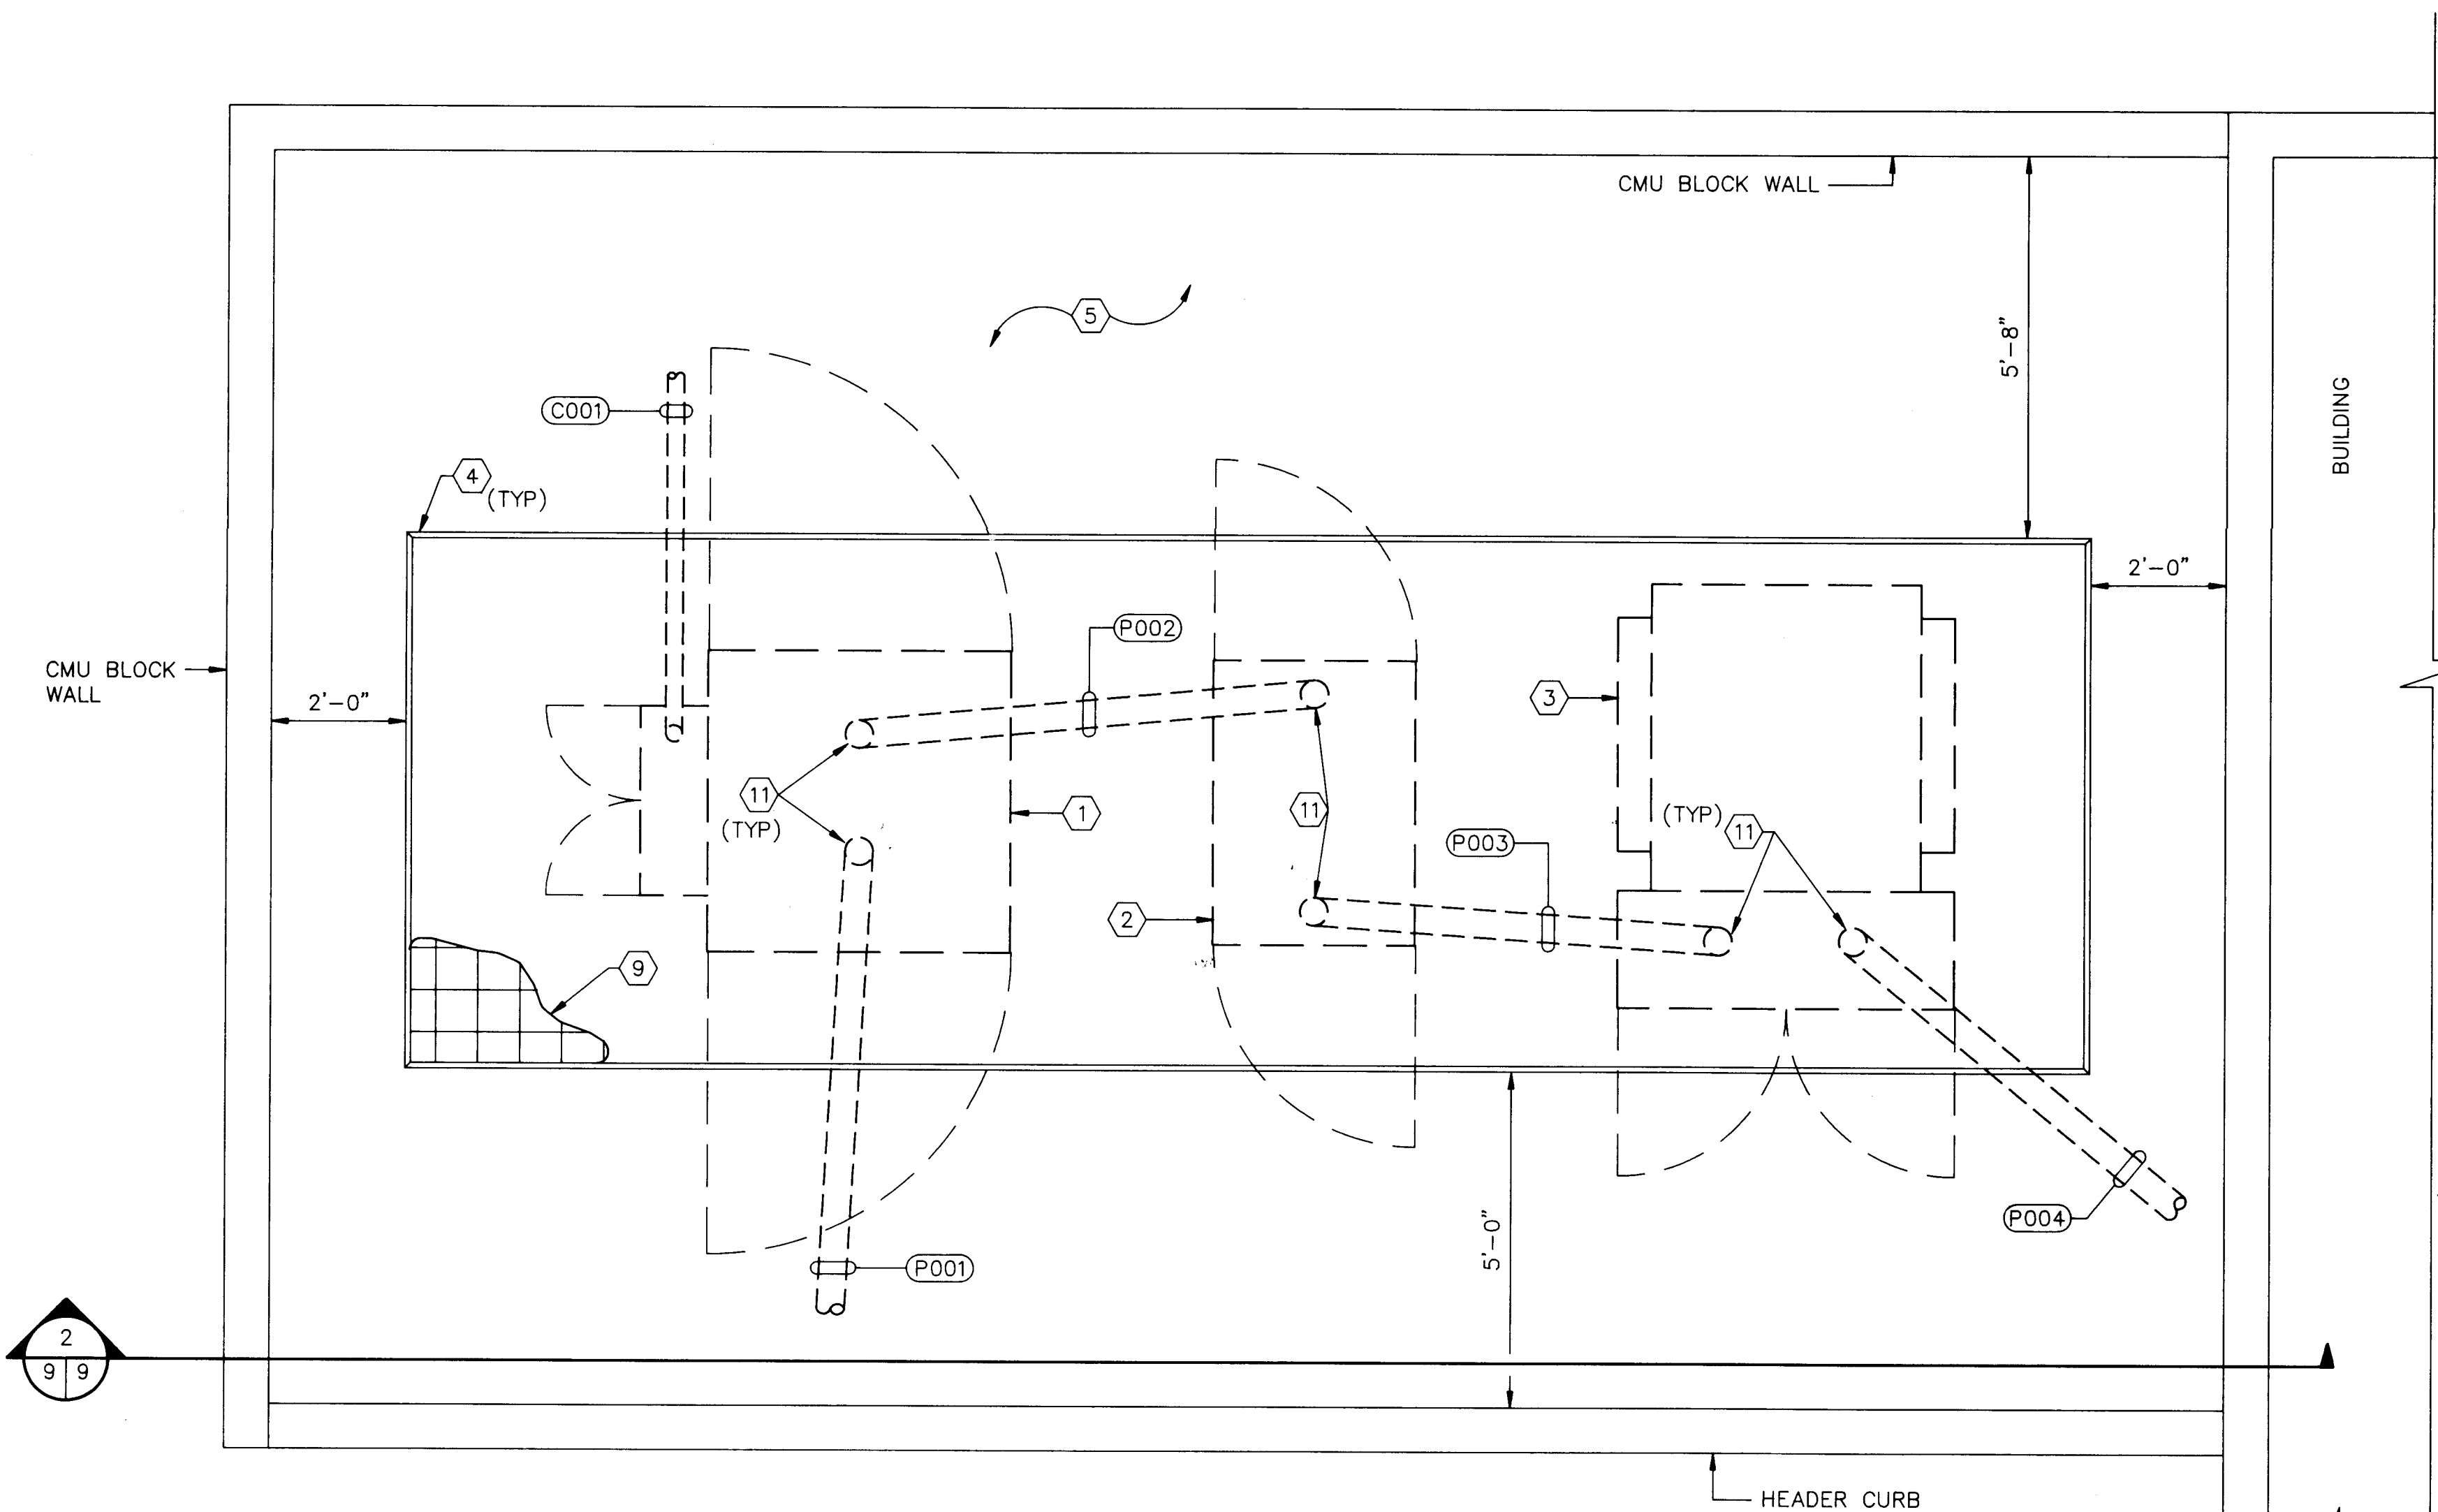


1 SUBSTATION FOUNDATION PLAN
SCALE: 1/2"=1'-0"

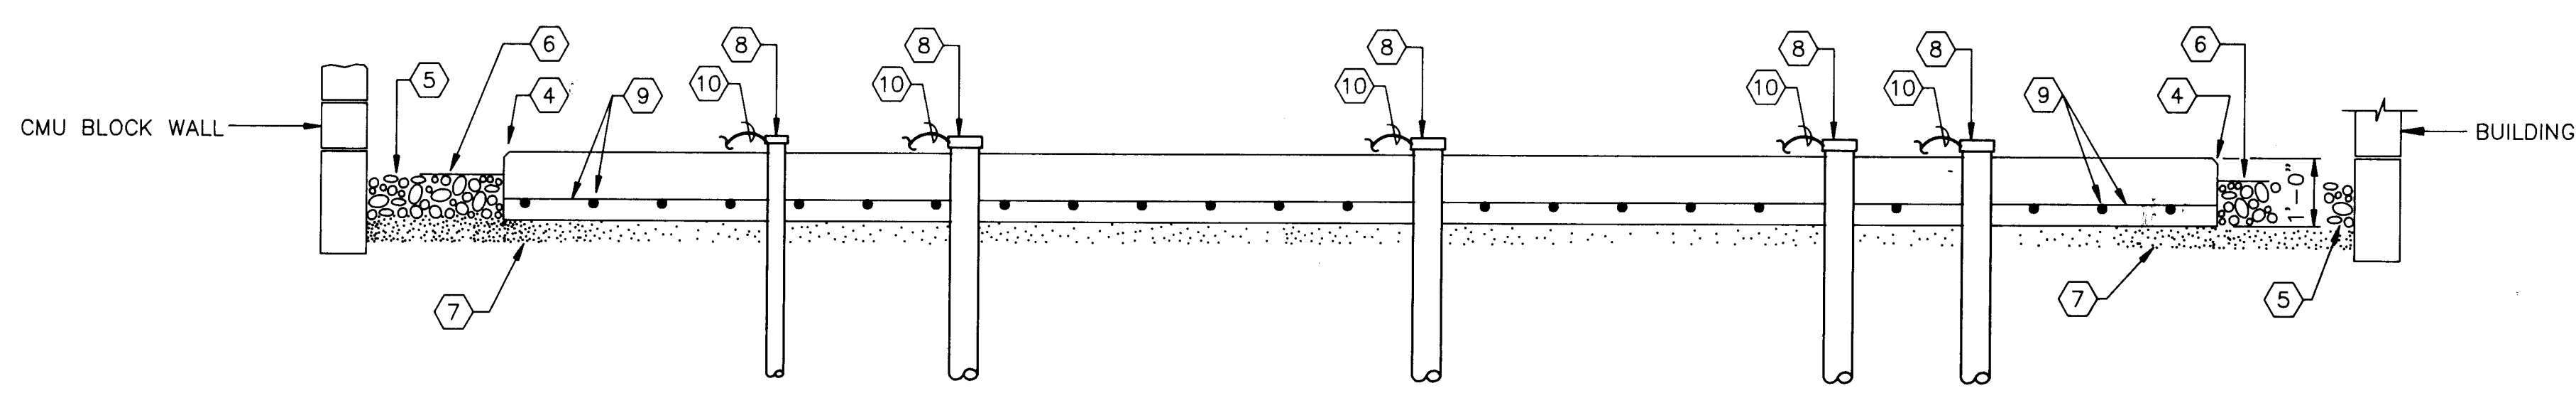

2 SUBSTATION FOUNDATION ELEVATION
SCALE: 1/2"=1'-0"

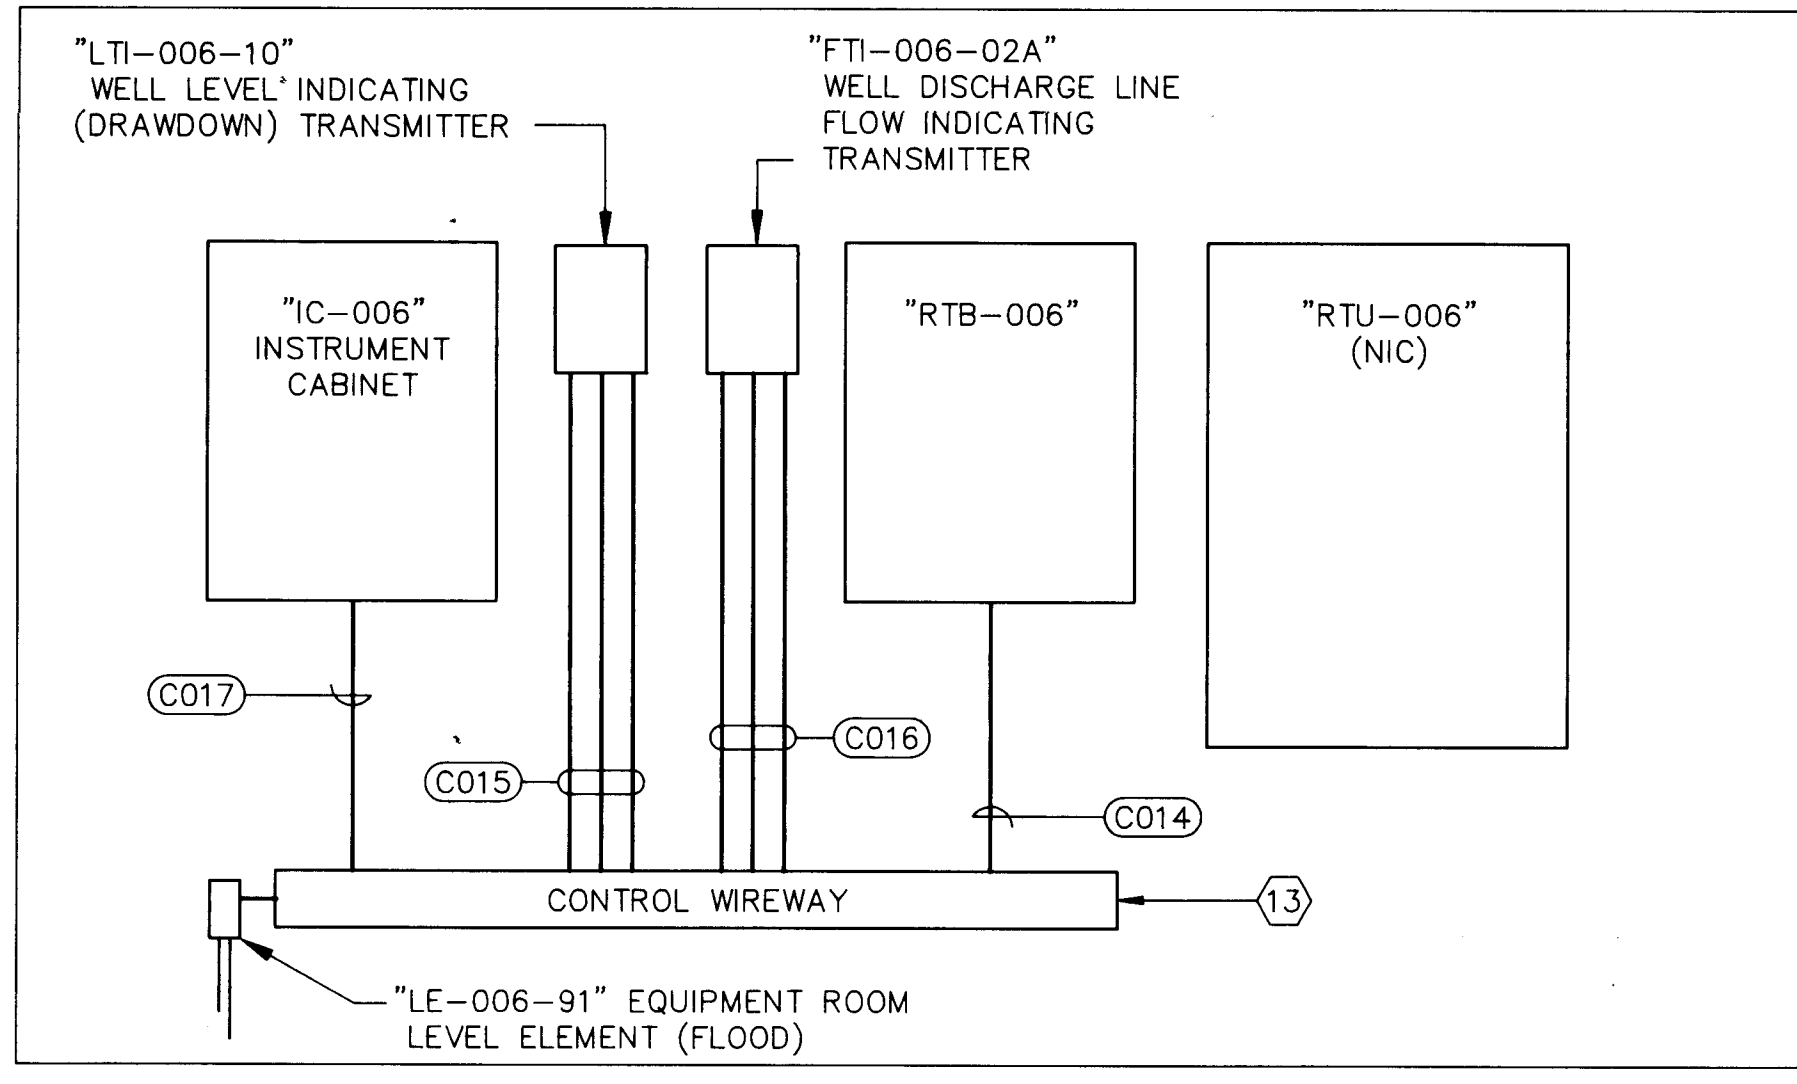

3 EQUIPMENT ROOM EAST WALL ELEVATION
NOT TO SCALE

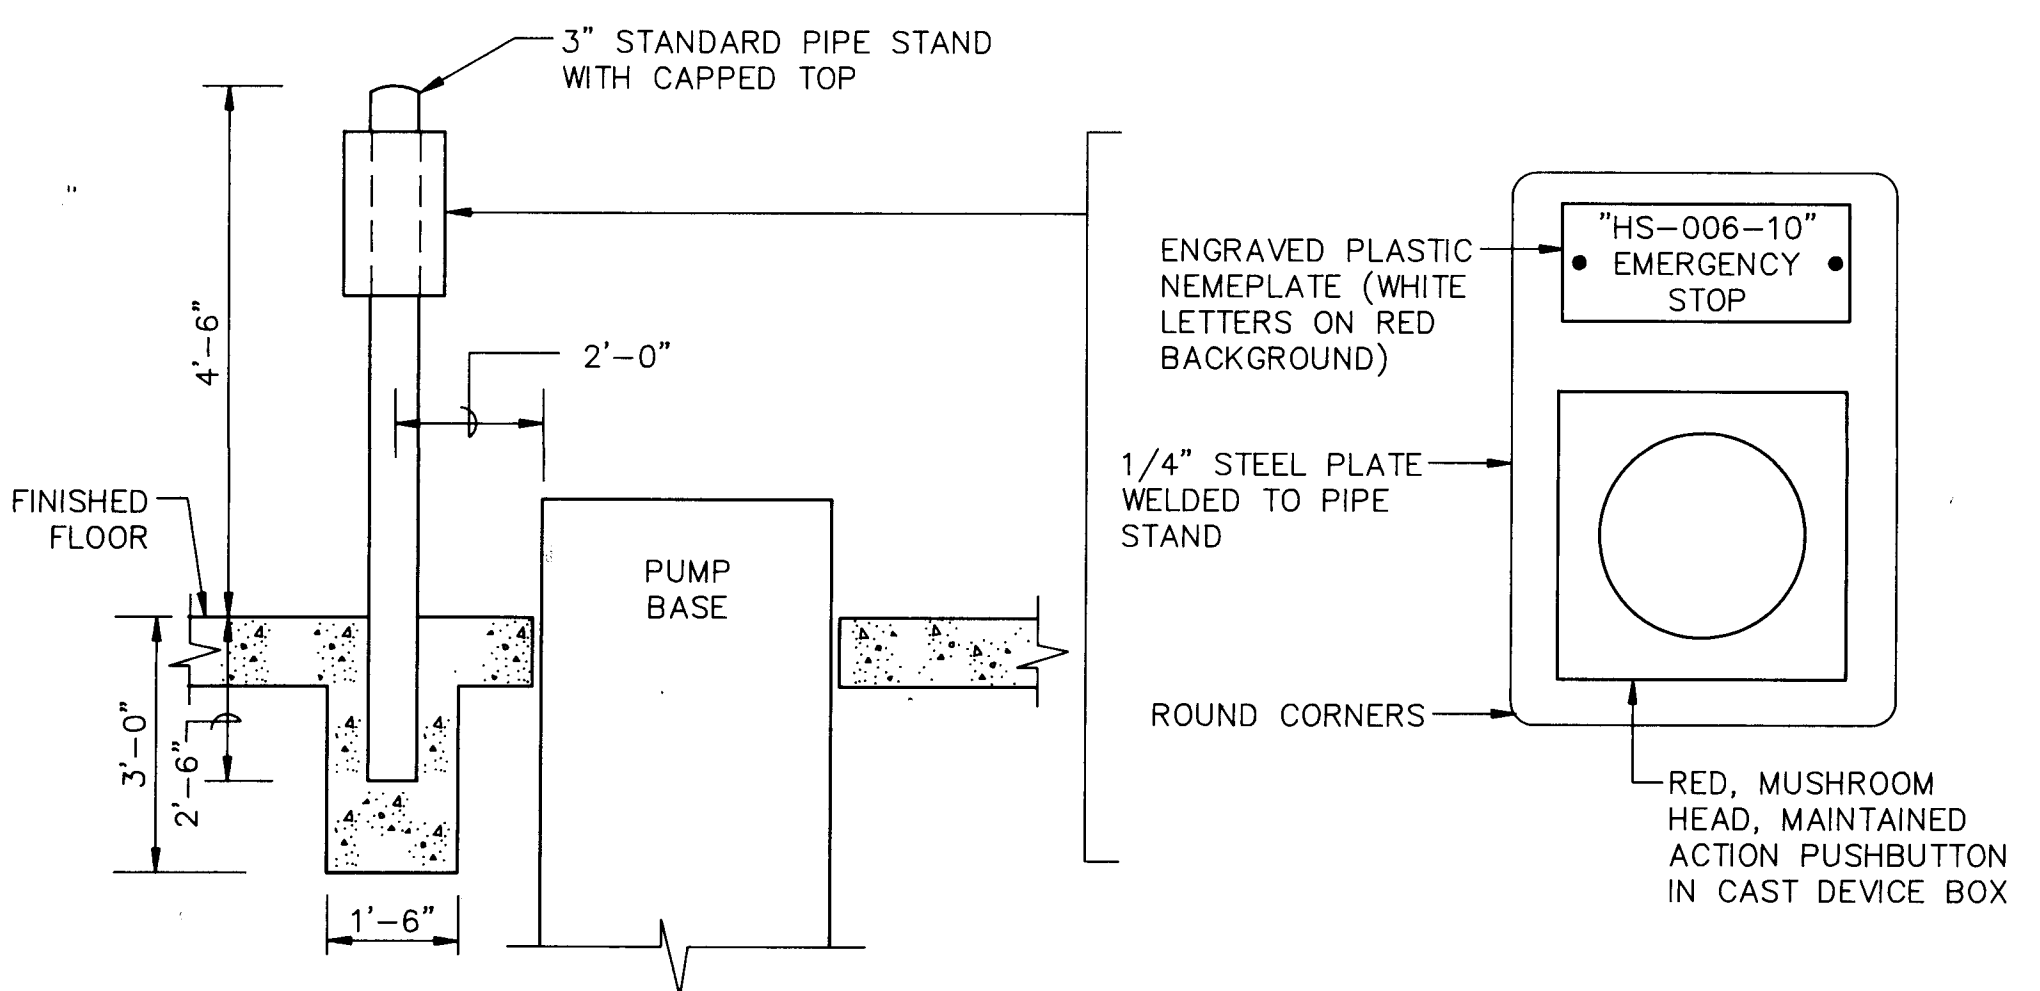


4 EMERGENCY STOP AND PUSHBUTTON DETAIL
NOT TO SCALE

RECORD DRAWING
Date AUG 10 1989
These drawings have been revised based on field data and every reasonable attempt has been made to depict construction actually performed

1	2	3	4	5	6	7	8	9	10	11	12
26	33	38	26	8	9						

CITY OF ALBUQUERQUE MUNICIPAL DEVELOPMENT DEPARTMENT ENGINEERING DIVISION					
TITLE: WALKER NO.2 WELL EQUIPMENT DETAILS					
APPROVALS	ENGINEER	DATE	APPROVALS	ENGINEER	DATE
City Engineer			Liquid Waste		
A.C.E. Design			Traffic		
A.C.E.-Hydrology			Water		
DRAWING NO. 3338		MAP NO.		SHEET E-9 OF E-9	

AS BUILT INFORMATION		BENCH MARKS		SURVEY INFORMATION		ENGINEER'S SEAL		REVISIONS		DESIGN	
CONTRACTOR	DATE	INSPECTOR'S	DATE	FIELD NOTES	BY	DATE	NO.	REMARKS	NO.	DATE	DESIGNED BY
											D. DOZIER
											T. LAKE
											J. KEALY
MICRO-FILM INFORMATION		RECORDED BY		NO.		DATE		DATE		DATE	

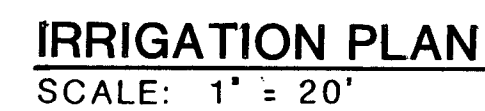


1 2 3 4 5 6 7 8 9 10 11 12

26	33	33	8	2	7	8	9				
----	----	----	---	---	---	---	---	--	--	--	--

RECORD DRAWING

April 1989

Drawings have been revised based on every reasonable attempt made to depict construction as performed.

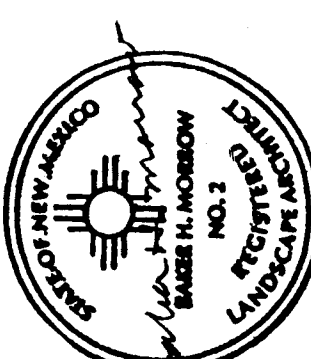IRRIGATION NOTES						AS BUILT INFORMATION		BENCH MARKS		SURVEY INFORMATION		ENGINEER'S SEAL		REVISIONS							
1. The Contractor shall adjust all valves, bubblers, sprinklers and controller for optimum coverage. 2. Contractor shall install manual drains on the lateral and main line piping at the lowest point to insure complete drainage of the laterals. Quantity shall be as required and shall be located on the "As-Built" drawings. Location shall be determined by the Contractor at time of installation. See B/L3 minimum one per zone. Do not install main line manual drains between vacuum breaker and water meter. 3. All proposed irrigation piping shall be marked using marker tape and shall be laid horizontally 4" above piping. Piping laid in common trenches shall have marker tape for each pipe. Tape shall be 2" wide and marked "buried water line", blue in color and metallic for future location. Product is available from Pipeline Material Inc., Albuquerque, New Mexico (505) 821-2626 (or approved equal). 4. 24 volt wire shall be run from the controller to the closest irrigation trench, minimizing the amount of trenching required for the installation of the wire. The Contractor shall review the proposed routing of the 24 volt wire with the Architect for approval prior to installation. 5. All 24 volt wire shall be marked with a 6" wide yellow marker tape and marked "Warning-Electrical". Lay marker tape horizontally 4" above wire. 6. In addition to other specified tests and inspections, the irrigation systems shall be performance tested and witnessed by the Compliance Officer from the City of Albuquerque Health and Environment Department for conformance with the provisions of the Waste Water Ordinance. 7. Mark all 24 volt wire ends with 3M STD-09 wire marker tape at the valve box and controller locations. 8. The Contractor shall sequentially wire valves to controller as indicated on plan (V-1 to Station One, V-2 to Station Two) 9. All valve boxes shall be supported by cinder blocks, minimum 2 per valve box. Install blocks in a manner which will prevent contact with piping, wires, valves, etc. 10. Upon Architect's request, the Contractor shall substitute and install nozzles other than those specified on plan at no additional cost to the Owner.						DATE		DATE		DATE		DATE		DATE				BY		REMARKS	
						DATE		DATE		DATE		DATE		DATE				NO		BY	
														DESIGNED		DATE					
														DRAWN BY		DATE					
														CHECKED BY		DATE					
						</															

