


CITY OF ALBUQUERQUE, NEW MEXICO
PUBLIC WORKS DEPARTMENT

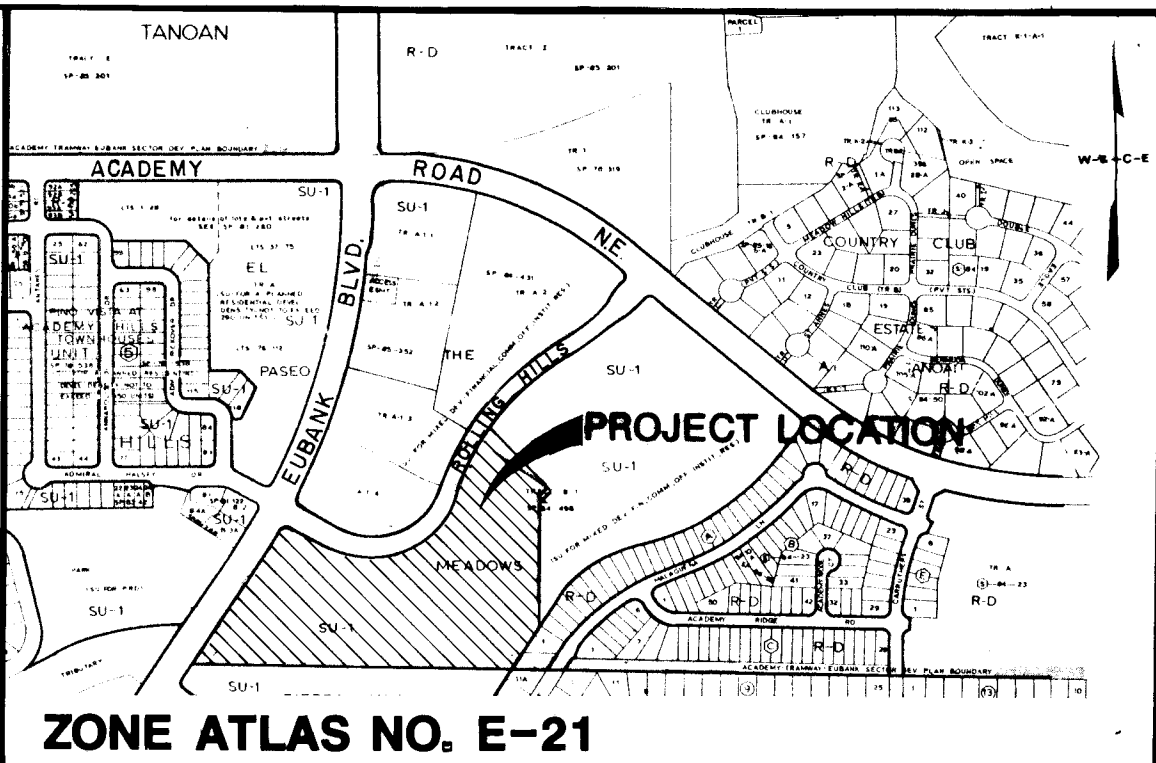

OVERLOOK APARTMENTS

ALBUQUERQUE, NEW MEXICO

WATER & SANITARY SEWER LINE

INDEX

<u>DESCRIPTION</u>	<u>SHEET NO.</u>
COVER SHEET	1
PLAT & EASEMENT	2
WATER & SEWER LINE LOCATION MAP	3
WATER & SANITARY SEWER LINE PLAN & PROFILE	4,5

NOTES

ALL WORK DETAILED ON THESE PLANS TO BE PERFORMED UNDER CONTRACT SHALL, EXCEPT AS OTHERWISE STATED OR PROVIDED FOR HEREON, BE CONSTRUCTED IN ACCORDANCE WITH THE C.O.A. STANDARD SPECIFICATIONS FOR PUBLIC WORKS CONSTRUCTION - 1986 EDITION (REFERRED TO HEREIN AS THE STANDARD SPECIFICATIONS).

TWO (2) WORKING DAYS PRIOR TO ANY EXCAVATION, CONTRACTOR MUST CONTACT LINE LOCATING SERVICE, 765-1234, FOR LOCATION OF EXISTING UTILITIES

PRIOR TO CONSTRUCTION, THE CONTRACTOR SHALL EXCAVATE AND VERIFY THE HORIZONTAL AND VERTICAL LOCATIONS OF ALL OBSTRUCTIONS. SHOULD A CONFLICT EXIST, THE CONTRACTOR SHALL NOTIFY THE ENGINEER OR SURVEYOR SO THAT THE CONFLICT CAN BE RESOLVED WITH MINIMUM AMOUNT OF DELAY.

WHERE CONCRETE BLOCKING IS CALLED FOR, WRAP ALL BENDS, TEES, AND OTHER FITTINGS WITH POLYETHYLENE. MINIMUM THICKNESS OF 8 MILS.

WATER SYSTEMS DIVISION SHALL BE THE ONLY AUTHORIZED PERSONNEL TO OPERATE EXISTING VALVES, FIRE HYDRANTS, ETC. ALL WORK SHUTOFFS MUST BE COORDINATED WITH SAID DIVISION THREE (3) FULL WORKING DAYS PRIOR TO PROPOSED SHUTOFFS. WATER SYSTEMS DIVISION SHALL HAVE THE AUTHORITY TO CANCEL ALL SCHEDULED SHUTOFFS. CONTACT AT 823-4200.

ALL TRAFFIC CONTROL DEVICES REQUIRED FOR DRIVEWAY CLOSURES, UTILITY CONSTRUCTION OR OTHER REASONS SHALL BE FURNISHED BY THE CONTRACTOR AND SHALL BE INCIDENTAL TO OTHER ITEMS OF WORK AND NO SEPARATE PAYMENT WILL BE MADE THEREFOR.

TEMPORARY PATCHING OF THE ROADWAY AT ALL CROSS STREETS WILL BE REQUIRED. EACH CROSS STREET SHALL NOT BE BLOCKED FOR MORE THAN 24 HOURS AND AT NO TIME SHALL TWO CONSECUTIVE CROSS STREETS BE BLOCKED. TEMPORARY PATCHING SHALL BE INCIDENTAL TO THIS PROJECT.

ALL PROPOSED WATER SHUTOFFS SHALL BE SUBJECT TO APPROVAL BY WATER SYSTEMS DIVISION.



NOTE:
PUBLIC WORKS DEPARTMENT AS SHOWN ON COVER SHEET SHALL APPLY TO ALL PLAN SHEETS.

Emilio B. Salas
12-13-88

26 33510188


RECORD DRAWING
Drawings revised to reflect the best information available. Do not use without field verification.

REV	SHEETS	CITY ENGR.	DATE	USER	DEPT.	DATE	USER	DEPT.	DATE
3									
APPROVAL OF REVISIONS									

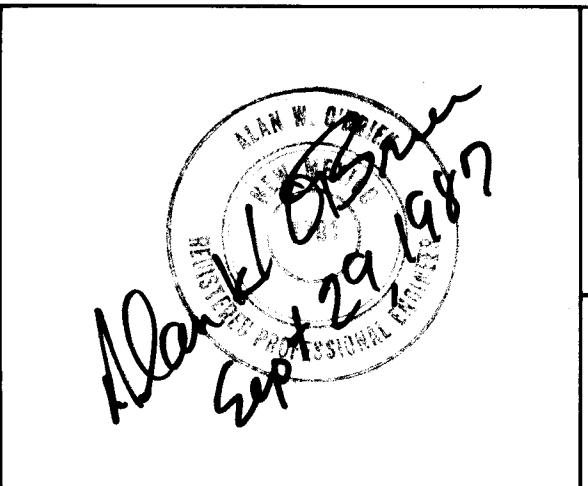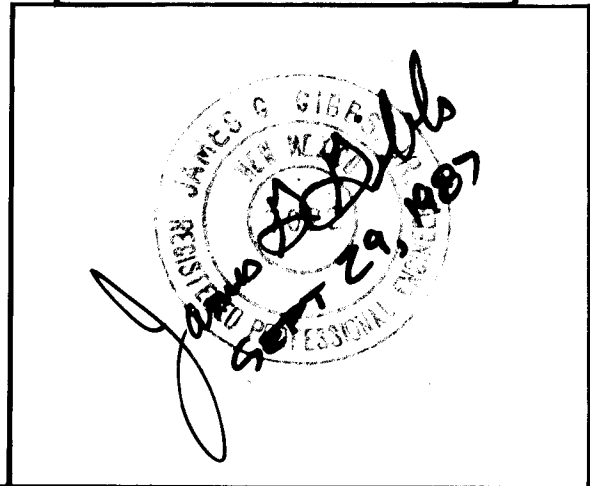


WILSON & COMPANY ENGINEERS & ARCHITECTS ALBUQUERQUE, NEW MEXICO	APPROVED FOR CONSTRUCTION <i>Alan W. Wilson</i> 12-21-87
	PROJECT No. <u>3351</u> SHEET <u>1</u> OF <u>5</u>

F.H. CONSTRUCTION IN EASEMENT (TYP)
NO SCALE

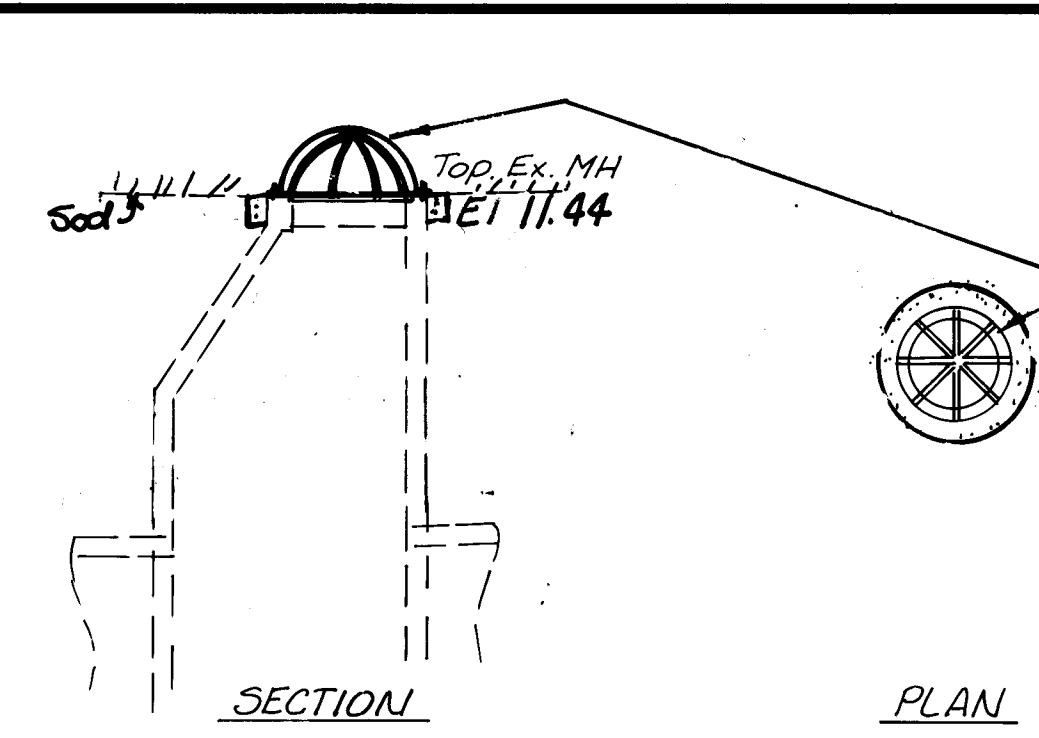

DETAIL 1
N.T.S.

- NOTES:
1. ALL FIRE HYDRANT SHOTS MADE ON TOP SURFACE OF BOTTOM FLANGE.
 2. WATER VALVE SHOTS MADE ON TOP OF COVER.
 3. MANHOLE SHOTS ON NORTH RIM.

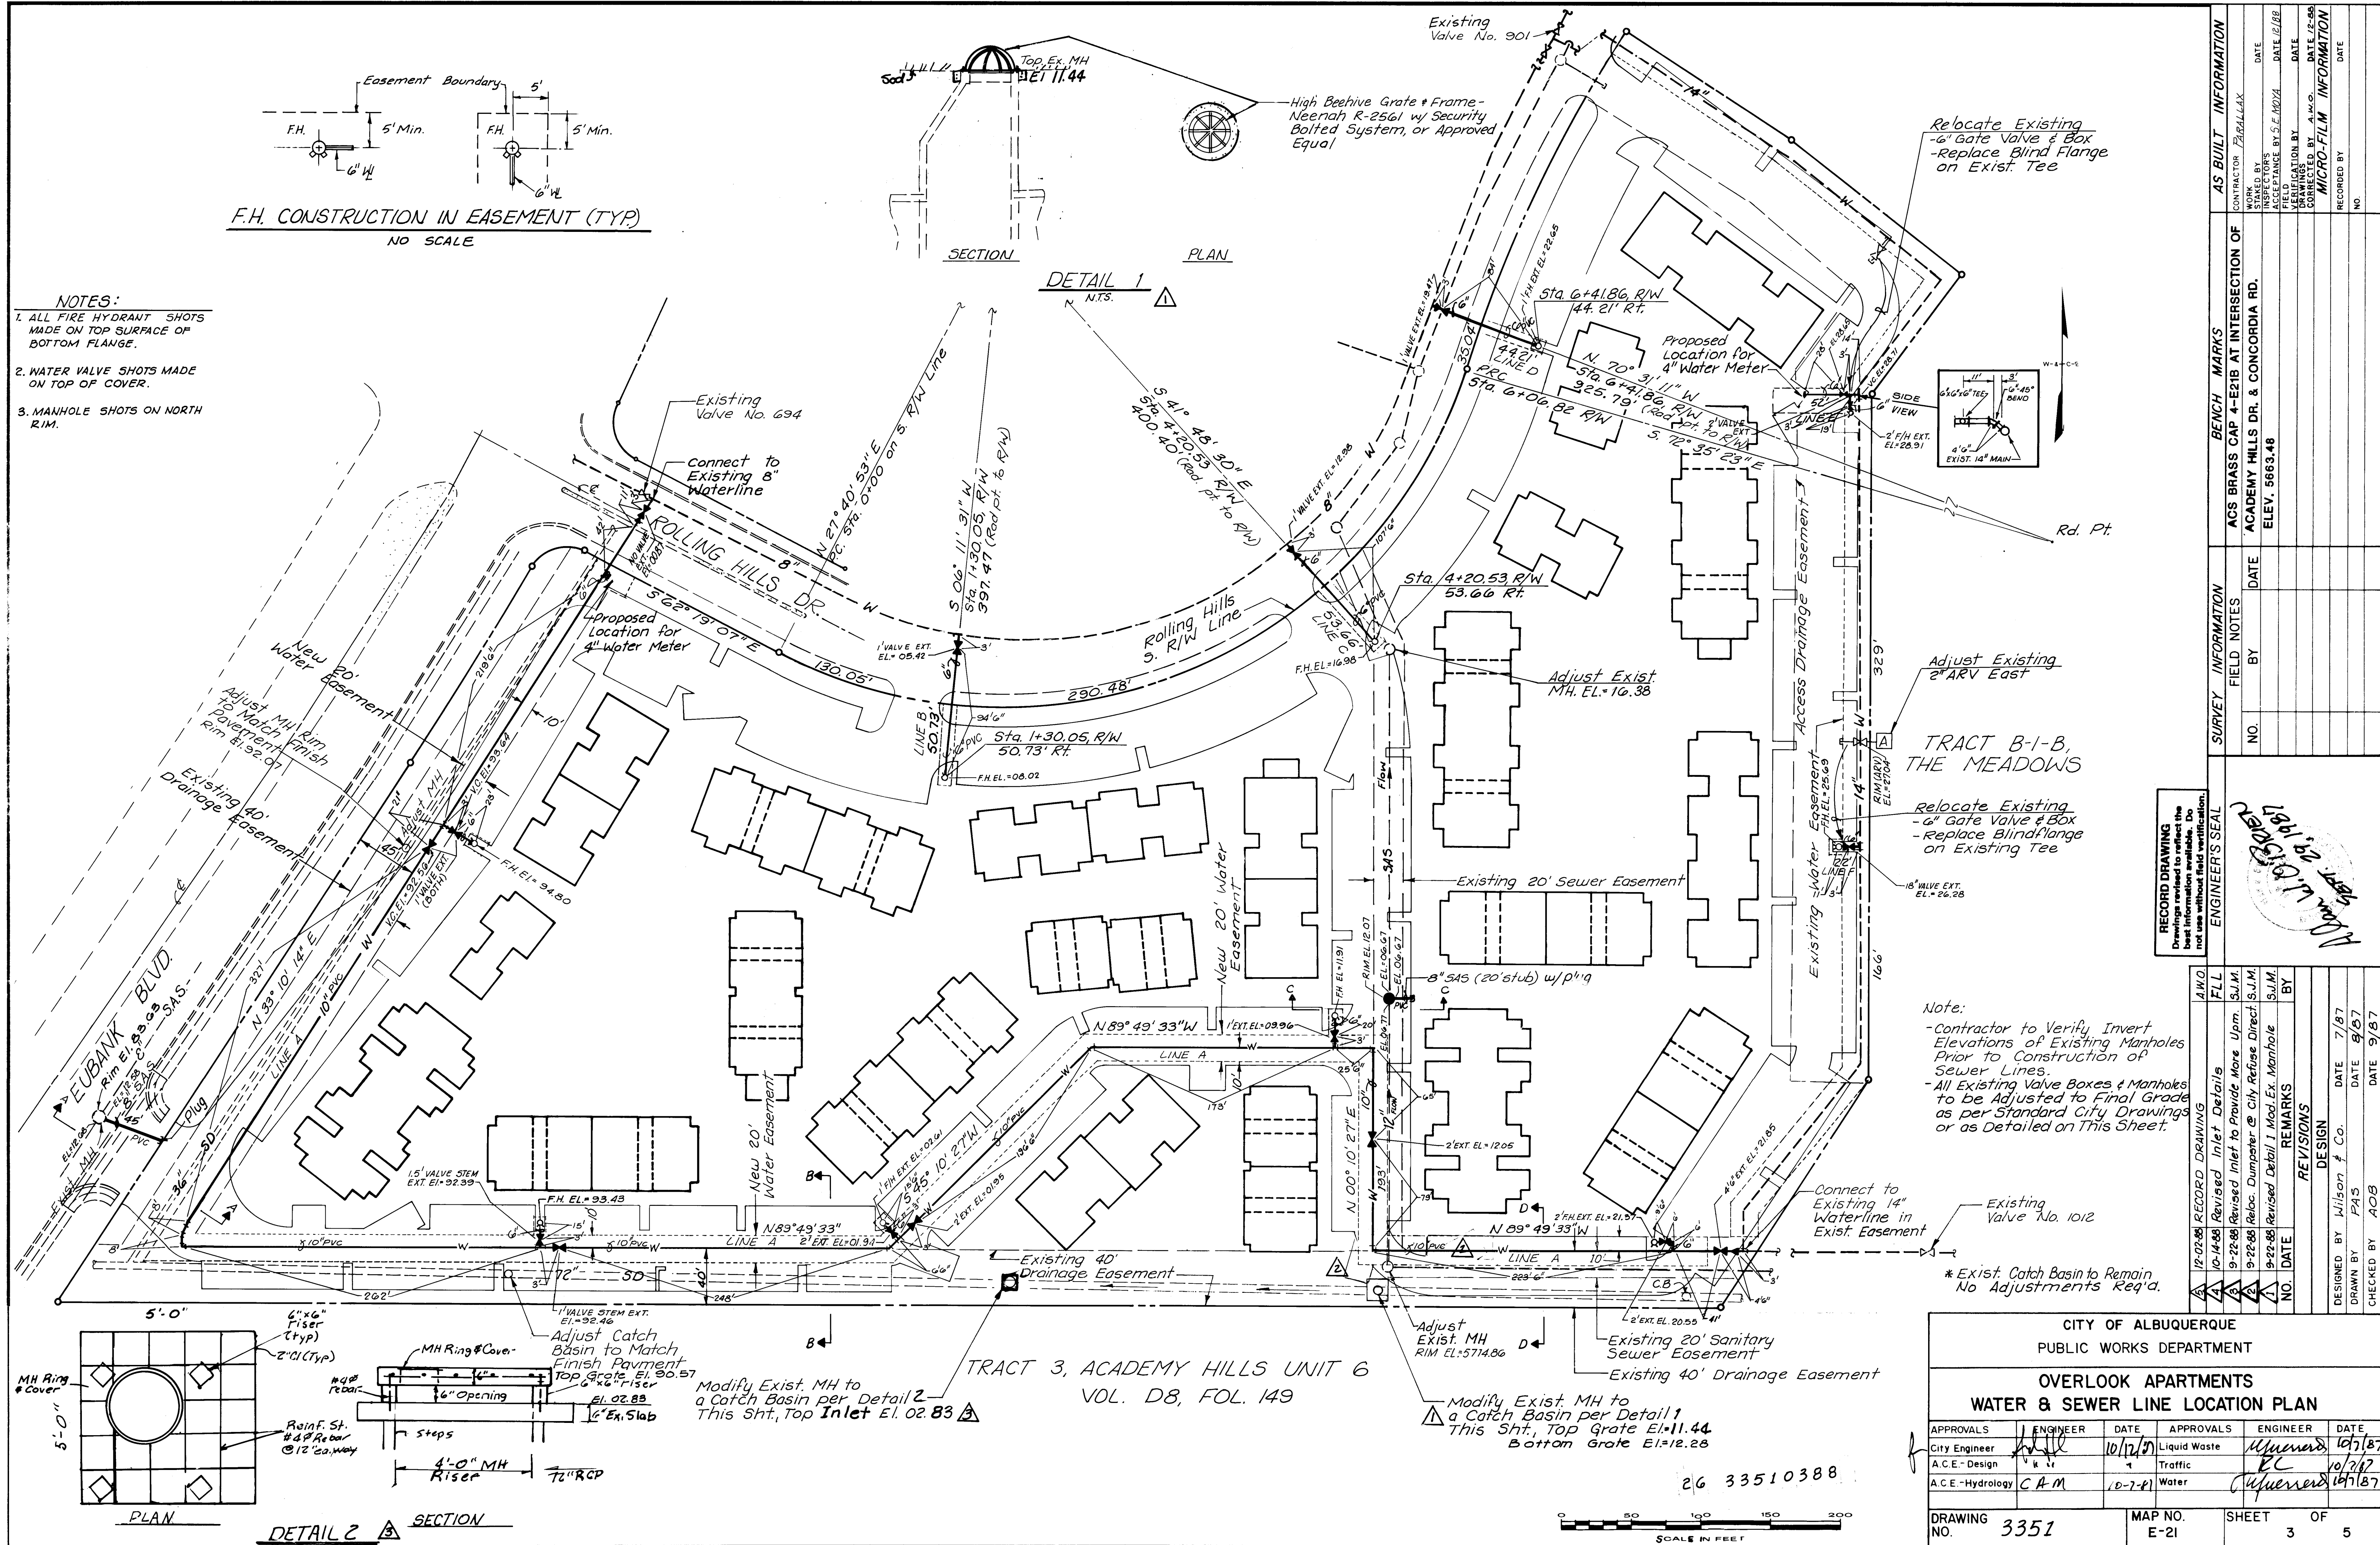

Relocate Existing
-6" Gate Valve & Box
-Replace Blind Flange
on Exist. Tee

Adjust Existing
2" ARV East

TRACT B-1-B,
THE MEADOWS

Relocate Existing
-6" Gate Valve & Box
-Replace Blind Flange
on Existing Tee

Note:
-Contractor to Verify Invert Elevations of Existing Manholes Prior to Construction of Sewer Lines.
-All Existing Valve Boxes & Manholes to be Adjusted to Final Grade as per Standard City Drawings or as Detailed on This Sheet.

*Exist. Catch Basin to Remain
No Adjustments Req'd.

CITY OF ALBUQUERQUE PUBLIC WORKS DEPARTMENT					
OVERLOOK APARTMENTS WATER & SEWER LINE LOCATION PLAN					
APPROVALS	ENGINEER	DATE	APPROVALS	ENGINEER	DATE
City Engineer	W. J. Hall	10/12/87	Liquid Waste	W. J. Hall	10/12/87
A.C.E.-Design	K. A. M.	10/12/87	Traffic	W. J. Hall	10/12/87
A.C.E.-Hydrology	C. A. M.	10/12/87	Water	W. J. Hall	10/12/87
DRAWING NO. 3351			MAP NO. E-21		
COA 3351			SHEET 3 OF 5		
WILSON & COMPANY ENGINEERS & ARCHITECTS ALBUQUERQUE, NEW MEXICO			WCEA 86-533		

AS BUILT INFORMATION		BENCH MARKS		SURVEY INFORMATION	
CONTRACTOR	PARALLAX	DATE		FIELD NOTES	BY
INSPECTORS		DATE		NO.	
ACCEPTANCE BY	S. L. MOYA	DATE	12/1/88		
VERIFICATION BY	A. M. O.	DATE	12/1/88		
RECORDED BY		DATE			
NO.					

