


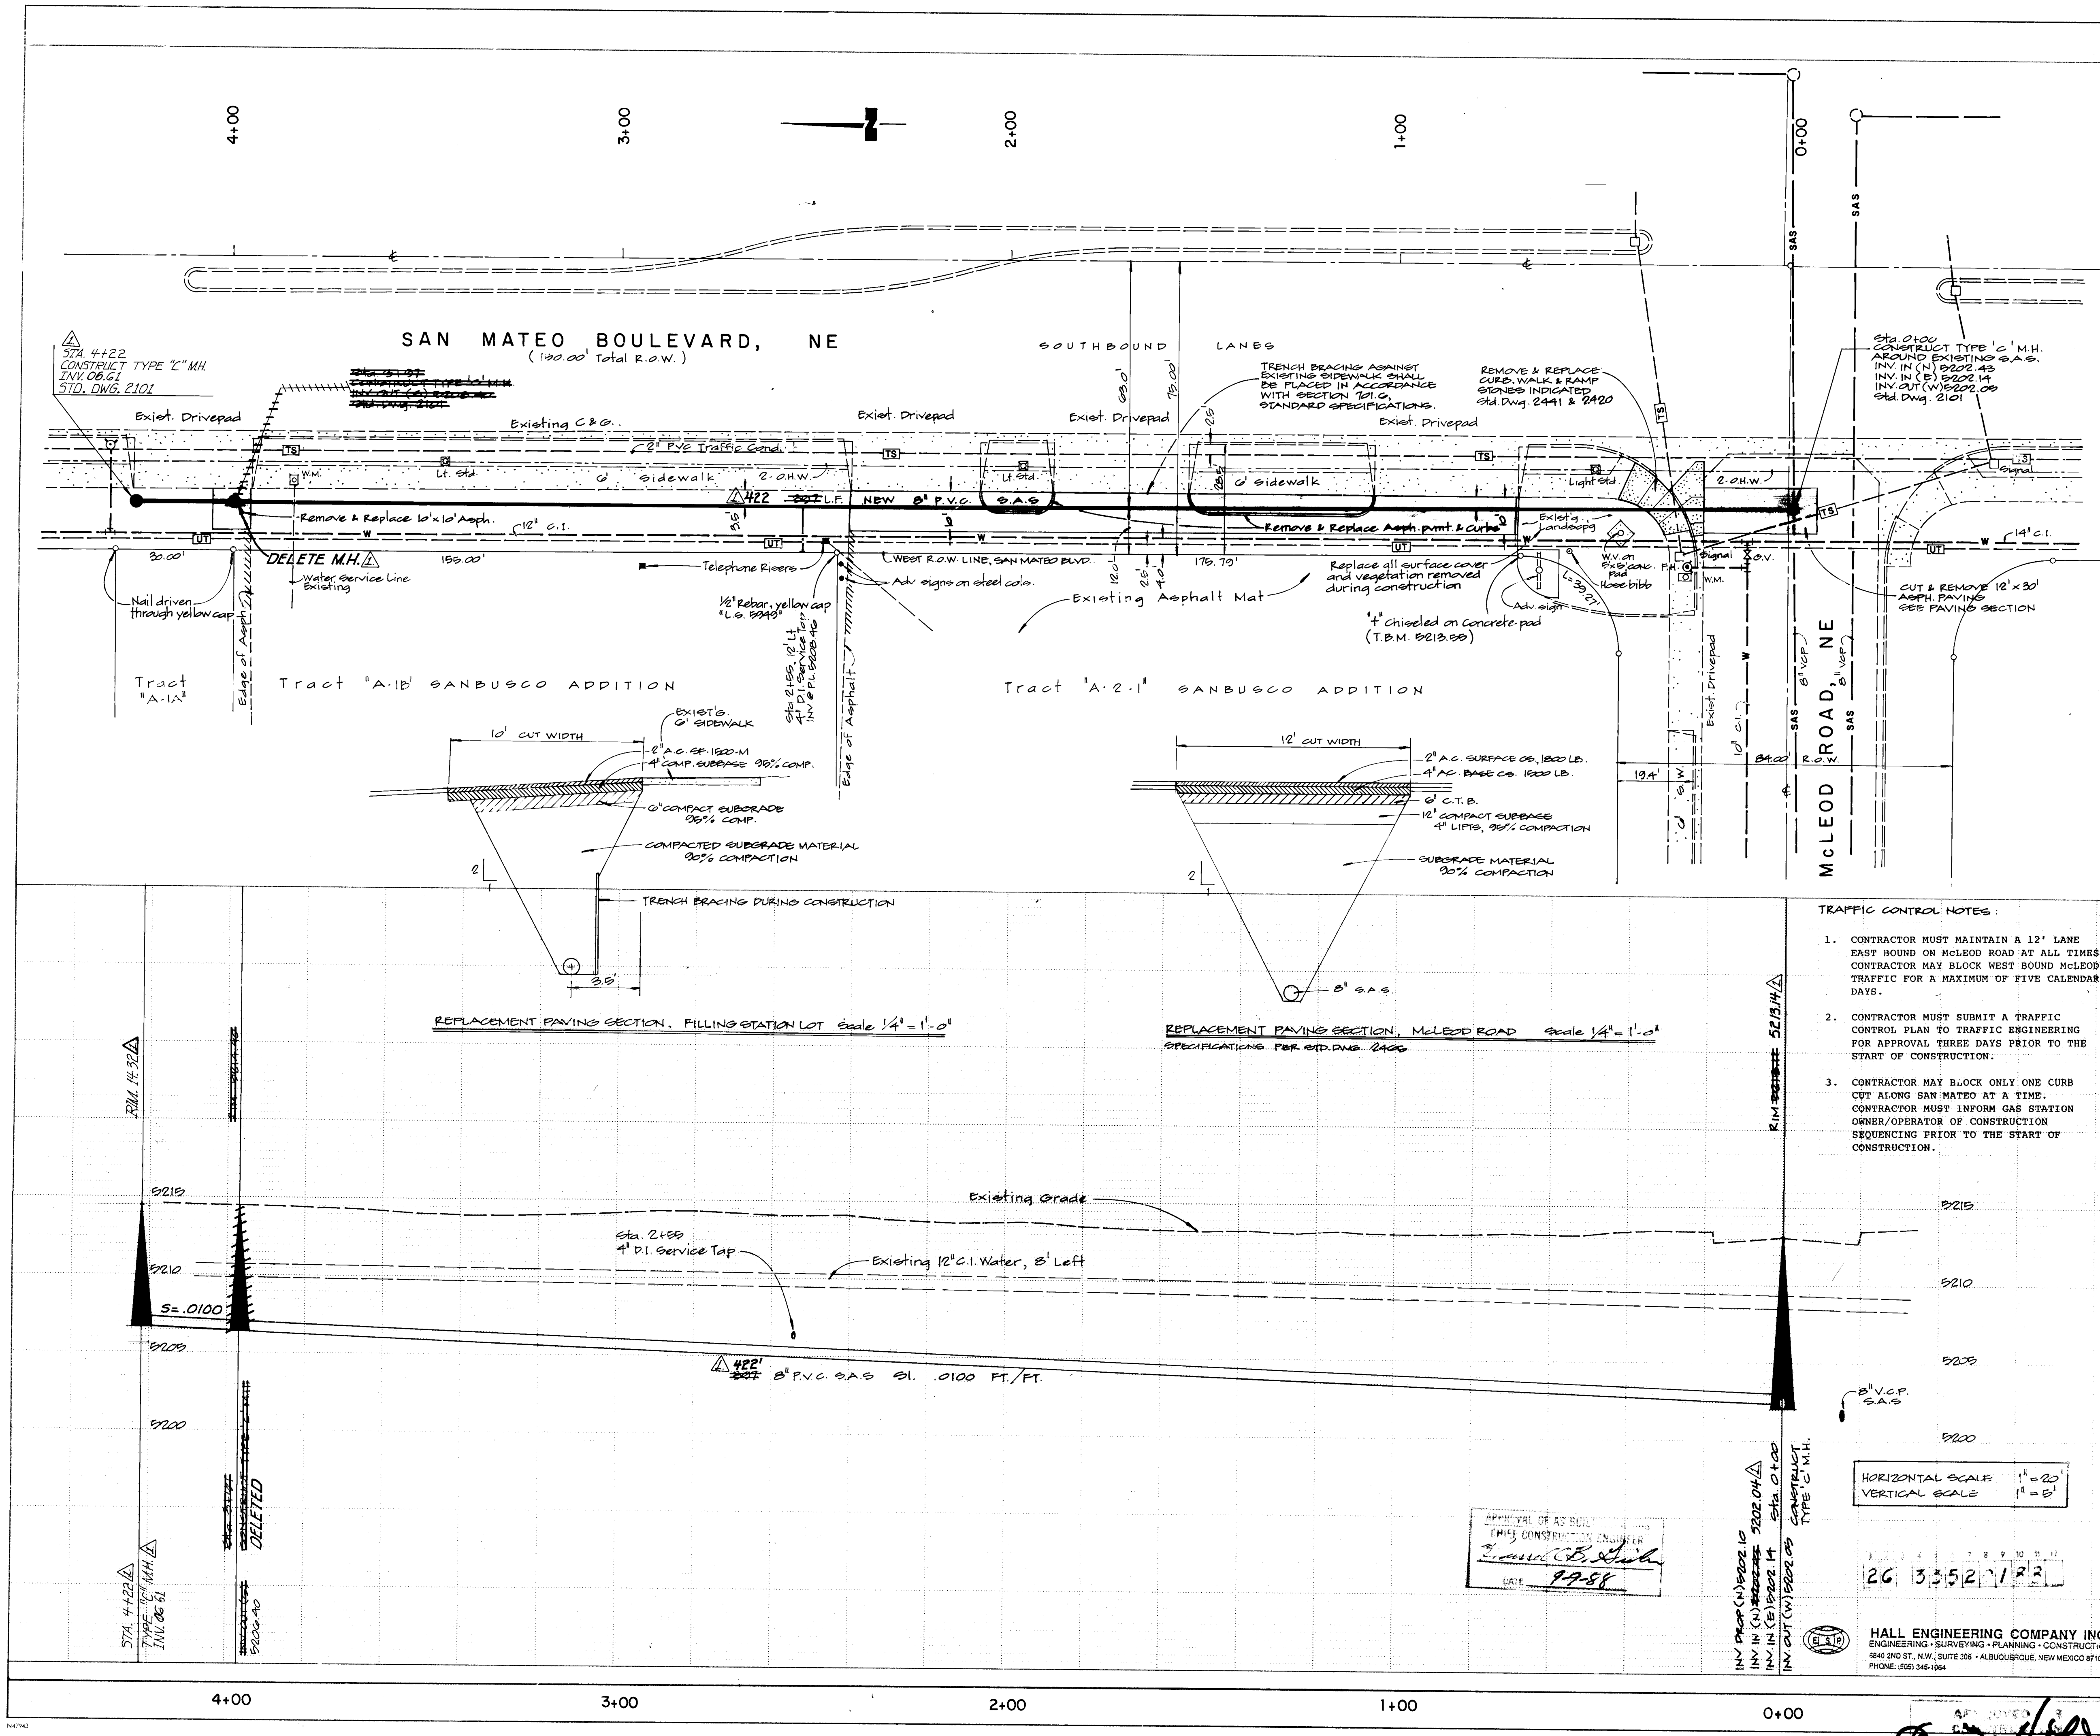

AS BUILT INFORMATION

DATE: 11/10/07
DRAWN BY: E.W. KIESS
CHECKED BY: [Signature]
NO.

BENCH MARKS

9. F.B. 3/4\"/>

SURVEY INFORMATION

FIELD NOTES
DATE: 8-07
BY: [Signature]
NO. []
R.V.H. / B.W.K. []

ENGINEER'S SEAL

[Signature]
11/10/07

REVISIONS

DESIGN
DATE: 08-14-07
DRAWN BY: E.W. KIESS
CHECKED BY: [Signature]

NOTICE TO CONTRACTORS:

1. City of Albuquerque Standard Specifications for Public Works Construction 1986 Edition will be referred to herein as the Standard Specifications.

2. All work shall be done in accordance with the Standard Specifications, except as otherwise stated or provided for herein, be constructed in accordance with Public Works Contract No. 1985.

3. Two working days prior to any excavation contractor must contact Line Location Service, 765-1234, for location of existing utilities.

4. Prior to construction, the contractor shall excavate and verify the horizontal and vertical location of all obstructions. Should a conflict exist the contractor shall notify the engineer or surveyor so that the conflict can be resolved with minimum delay.

THE FOLLOWING NOTES APPLY IF CHECKED:

() All utilities and utility service lines shall be installed prior to paving.

() Backfill compaction shall be according to residential street use.

() Tack coat requirements shall be determined by the City Engineer.

() Sidewalks and Wheelchair ramps within the curb returns shall be constructed wherever a new curb return is constructed.

() If a curb is depressed for a driveway, the driveway shall be constructed prior to acceptance of the curb and gutter.

LEGEND

SAS — EXISTING SANITARY SEWER

W — EXISTING WATER MAIN

UT — BURIED TELEPHONE GABLE

TS — BURIED TRAFFIC CONDUIT

NEW SEWER, MANHOLES

EXISTING CURB & GUTTER

TELEPHONE PULL BOX

WATER METER

STREET LIGHT STANDARD

EXISTING FIRE HYDRANT

NEW ASPHALT PAVEMENT

NEW CONCRETE C&G, WALK

CITY OF ALBUQUERQUE
MUNICIPAL DEVELOPMENT DEPARTMENT
ENGINEERING DIVISION

TITLE: SANITARY SEWER EXTENSION
SAN MATEO BOULEVARD, NE

APPROVALS	ENGINEER	DATE	APPROVALS	ENGINEER	DATE
City Engineer	[Signature]	11/10/07	Liquid Waste	PEBO	9/16/07
A.C.E. - Design	[Signature]	11/10/07	Traffic	PEBO	9/16/07
A.C.E. - Hydrology	[Signature]	11/10/07	Water	PEBO	9/16/07

DRAWING NO. 3352

MAP NO. F-17

SHEET 1 OF 1

4+00 3+00 2+00 1+00 0+00

DATE: 11/10/07
DRAWN BY: E.W. KIESS
CHECKED BY: [Signature]
NO.

HALL ENGINEERING COMPANY INC.
ENGINEERING • SURVEYING • PLANNING • CONSTRUCTION
6840 2ND ST. N.W., SUITE 306 • ALBUQUERQUE, NEW MEXICO 87107
PHONE: (505) 345-1064

26 3352 11/10/07

3/4/08