
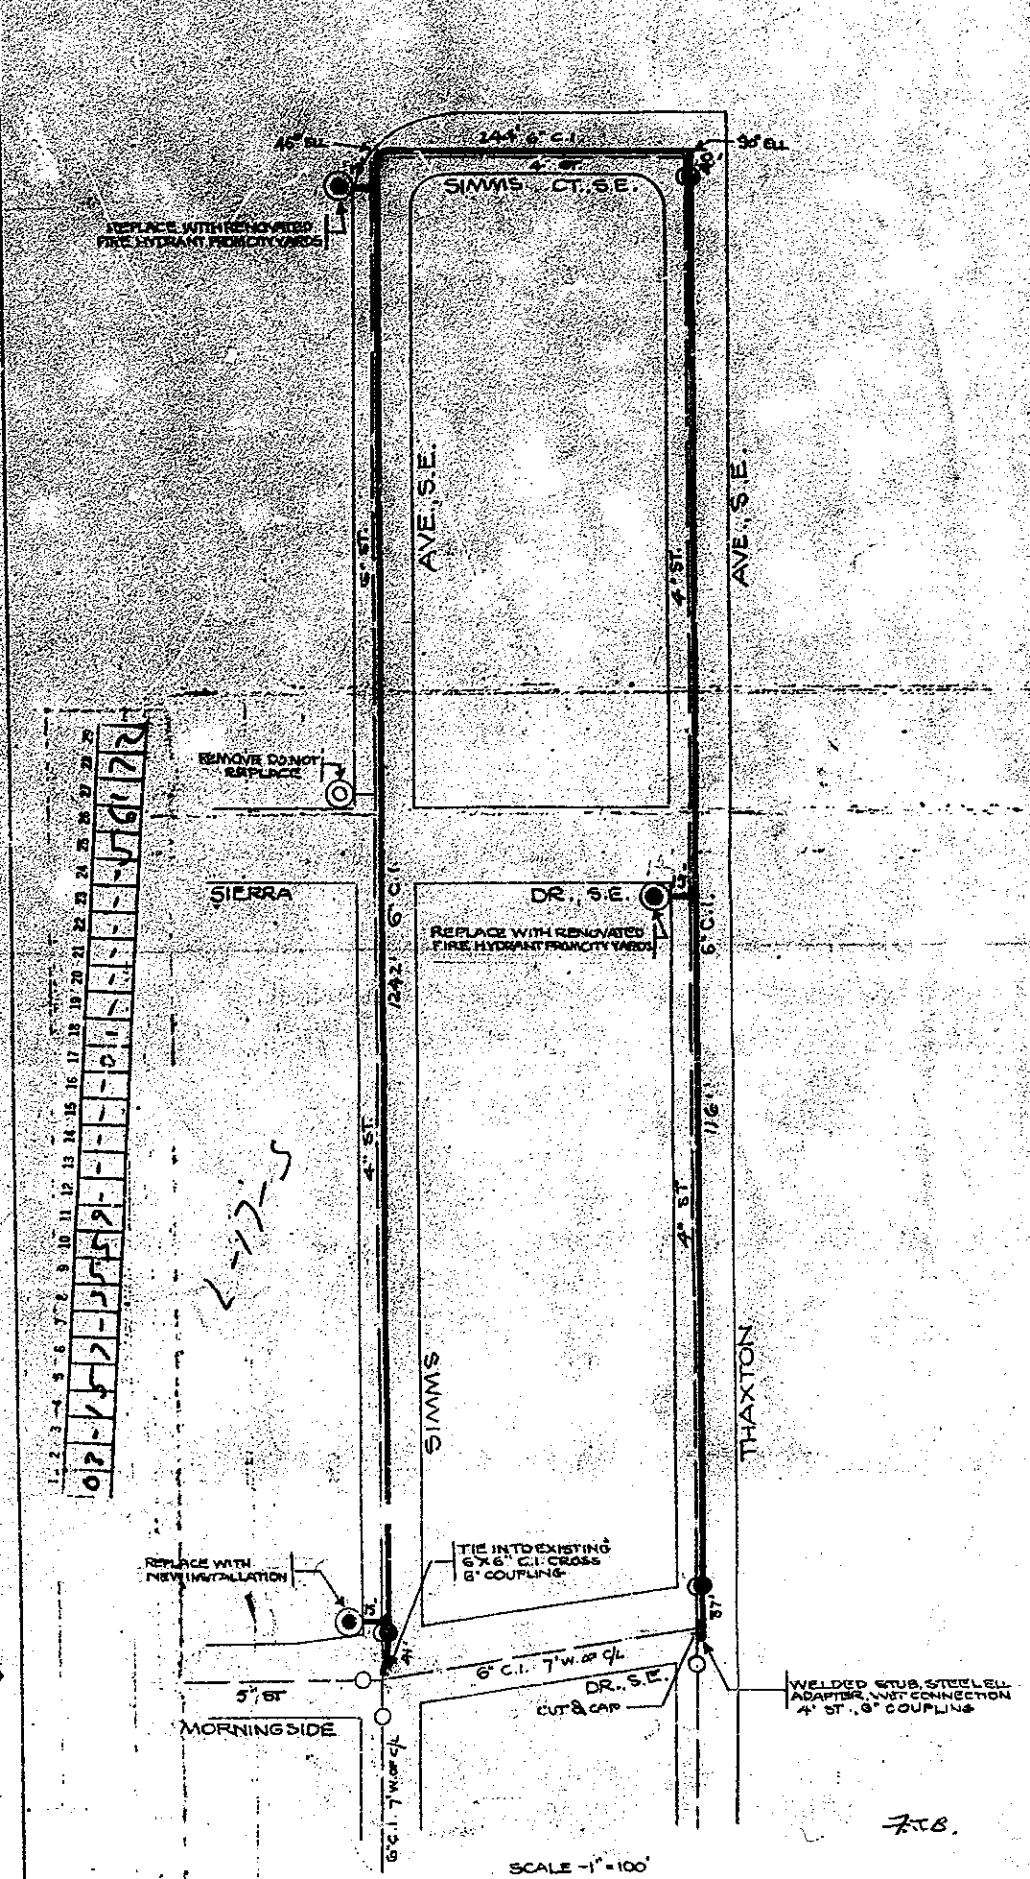


QUATION
TION SEWER & WA
OR AS INDICATED

EROS RD. NW, MR. GCD. MAP 35
ED 5/19/59 SHEET 76

POLICY 5, W.O. 3146 MESA COURT ADD.
ENTERED ON MAPS 9/11/59

REPLACEMENT PROGRAM
WORK COMPLETED 9/24/59 SHEET 17
ENTERED ON MAPS 9/2/59

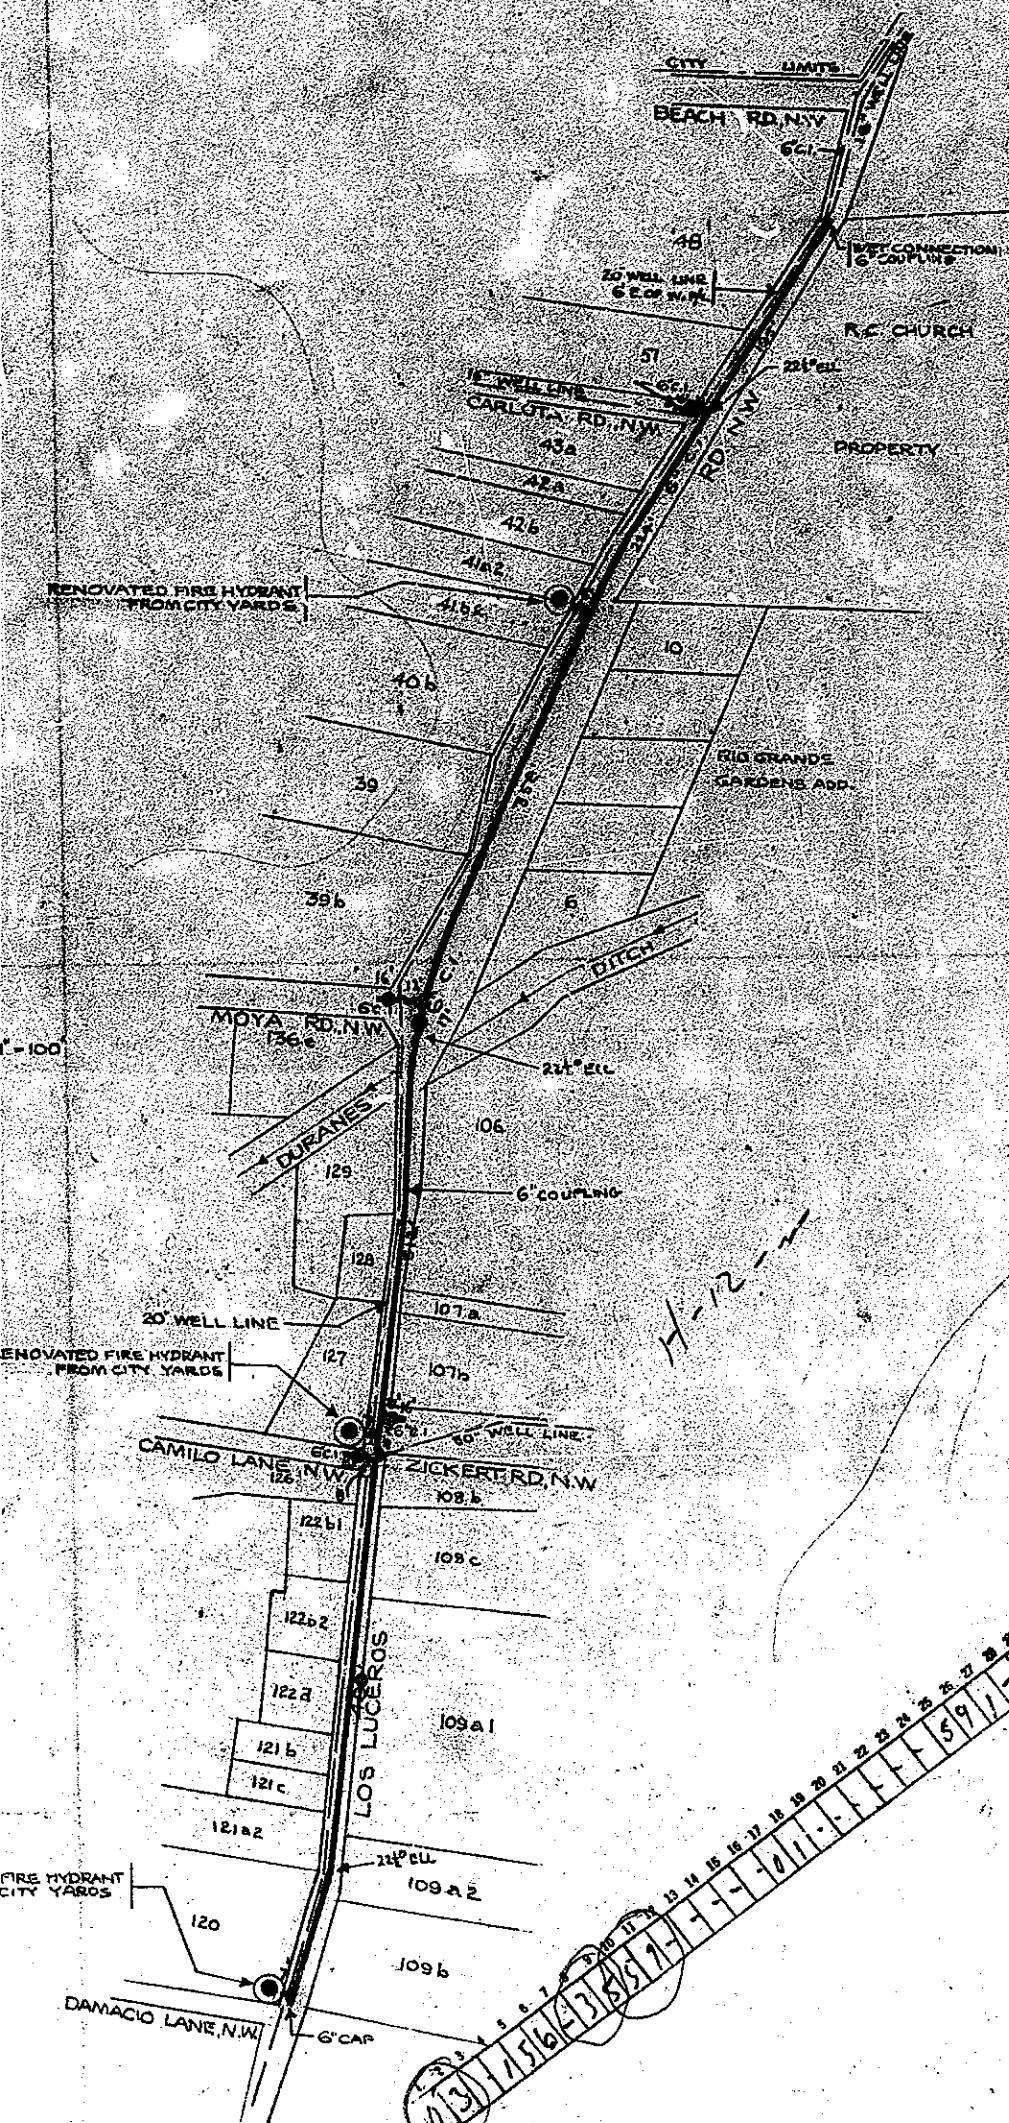

7. J. B.

PRESENTATION OF THIS PLAN AT THE CITY YARDS
CONSTITUTES AUTHORITY FOR THE DELIVERY TO
C.B.C. CONTRACTORS OF 2 REAMED & RENOVATED
FIRE HYDRANTS *Frank J. Bailey*

CAUTION!
BURIED CABLES
BEFORE EXCAVATING
CALL TEL. CO. EXT. 1171



SHEET NO. 35		1959
CHECKED	APPROVED	
<i>R.E. Lye</i>	<i>Frank J. Bailey</i>	
9/4/59	9/30/59	