

INDIAN FARM LANE NW.

SANITARY SEWER

INDEX

DESCRIPTION	SHEET No.
TITLE SHEET & INDEX.....	1
SANITARY SEWER PLAN & PROFILE	
INDIAN FARMS LANE NW.....	2 thru 4
PRESSURE SEWER DETAILS.....	5


CITY OF ALBUQUERQUE
NEW MEXICO



26 33590188

APPROVAL OF AS-BUILT DRAWINGS
CHIEF CONSTRUCTION ENGINEER
Samuel B. Smith
DATE 10-11-88

SET NUMBER

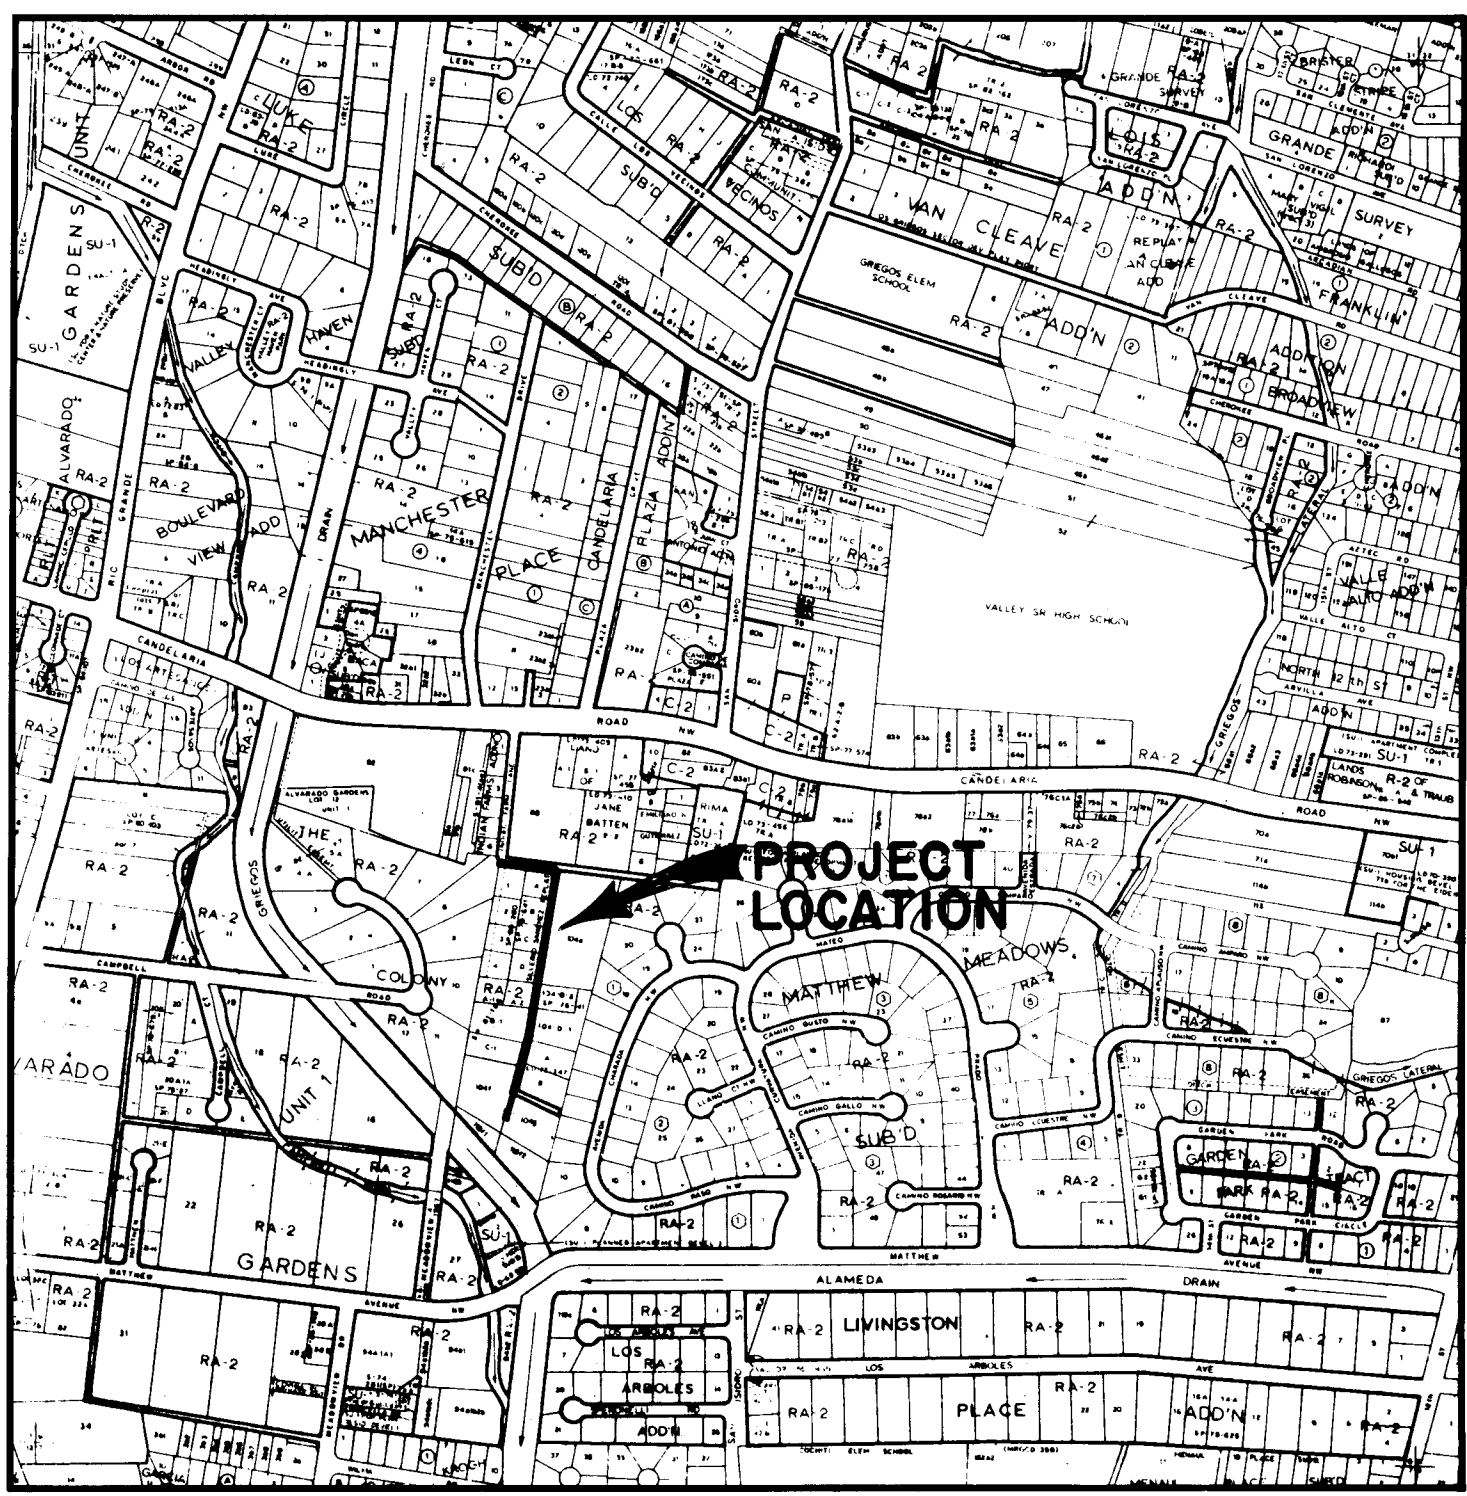



LOCATION MAP
ZONE ATLAS
MAP No. G-13

GENERAL NOTES

- ALL WORK DETAILED ON THESE PLANS TO BE PERFORMED UNDER THIS CONTRACT SHALL, EXCEPT AS OTHERWISE STATED OR PROVIDED FOR HEREON, BE CONSTRUCTED IN ACCORDANCE WITH CITY OF ALBUQUERQUE, STANDARD SPECIFICATIONS FOR PUBLIC WORKS CONSTRUCTION, 1986 EDITION.
- REFERENCES MADE TO STANDARD DRAWINGS REFER TO CITY OF ALBUQUERQUE STANDARD DRAWINGS.
- TWO WORKING DAYS PRIOR TO ANY EXCAVATION, CONTRACTOR MUST CONTACT LINE LOCATING SERVICE, 765-1234, FOR LOCATION OF EXISTING UTILITIES.
- PRIOR TO CONSTRUCTION, THE CONTRACTOR SHALL EXCAVATE AND VERIFY THE HORIZONTAL AND VERTICAL LOCATIONS OF ALL OBSTRUCTIONS. SHOULD A CONFLICT EXIST, THE CONTRACTOR WILL NOTIFY THE ENGINEER OR SURVEYOR SO THAT THE CONFLICT CAN BE RESOLVED WITH A MINIMUM OF DELAY.
- BACKFILL COMPACTION SHALL BE ACCORDING TO SPECIFIED STREET USE.
- CONTRACTOR MUST SUBMIT A CONSTRUCTION SIGNING AND BARRACADING PLAN TO TRAFFIC ENGINEERING TO RECEIVE A BARRACADING PERMIT 48 HOURS PRIOR TO PERFORMING CONSTRUCTION WORK THAT WILL INTERRUPT TRAFFIC.
- ELEVATIONS SHOWN ON PROFILE ARE TO TOP OF PIPE UNLESS OTHERWISE INDICATED.
- CONTRACTOR SHALL REMOVE AND DISPOSE OF ALL OBJECTIONABLE MATERIAL FROM THE CONSTRUCTION SITE. A DISPOSAL SITE FOR ALL REMOVAL ITEMS SHALL BE OBTAINED BY THE CONTRACTOR. THE SITE SHALL BE IN COMPLIANCE WITH APPLICABLE ENVIRONMENTAL REGULATIONS AND APPROVED BY THE CITY ENGINEERING DEPARTMENT. ALL COSTS INCURRED IN OBTAINING AN ACCEPTABLE SITE AND HAUL THERE TO SHALL BE CONSIDERED INCIDENTAL TO CONSTRUCTION OF THE PROJECT.
- PRESSURE SEWER SERVICES SHALL BE PAID FOR PER EACH INCLUDING MAINLINE TEE, SERVICE PIPING, VALVES & METER BOX.
- ALL PRESSURE PIPE FITTINGS SHALL HAVE CONCRETE BLOCKING.


REV	SHEETS	CITY ENGR.	DATE	USER	DEPT.	DATE	USER	DEPT.	DATE
APPROVAL OF REVISIONS									

	ANDREWS, ASBURY & ROBERT, INC. CONSULTING ENGINEERS ALBUQUERQUE NEW MEXICO	APPROVED FOR CONSTRUCTION <i>John A. Andrews</i> CITY ENGINEER DATE
	3359	SHEET 1 OF 5

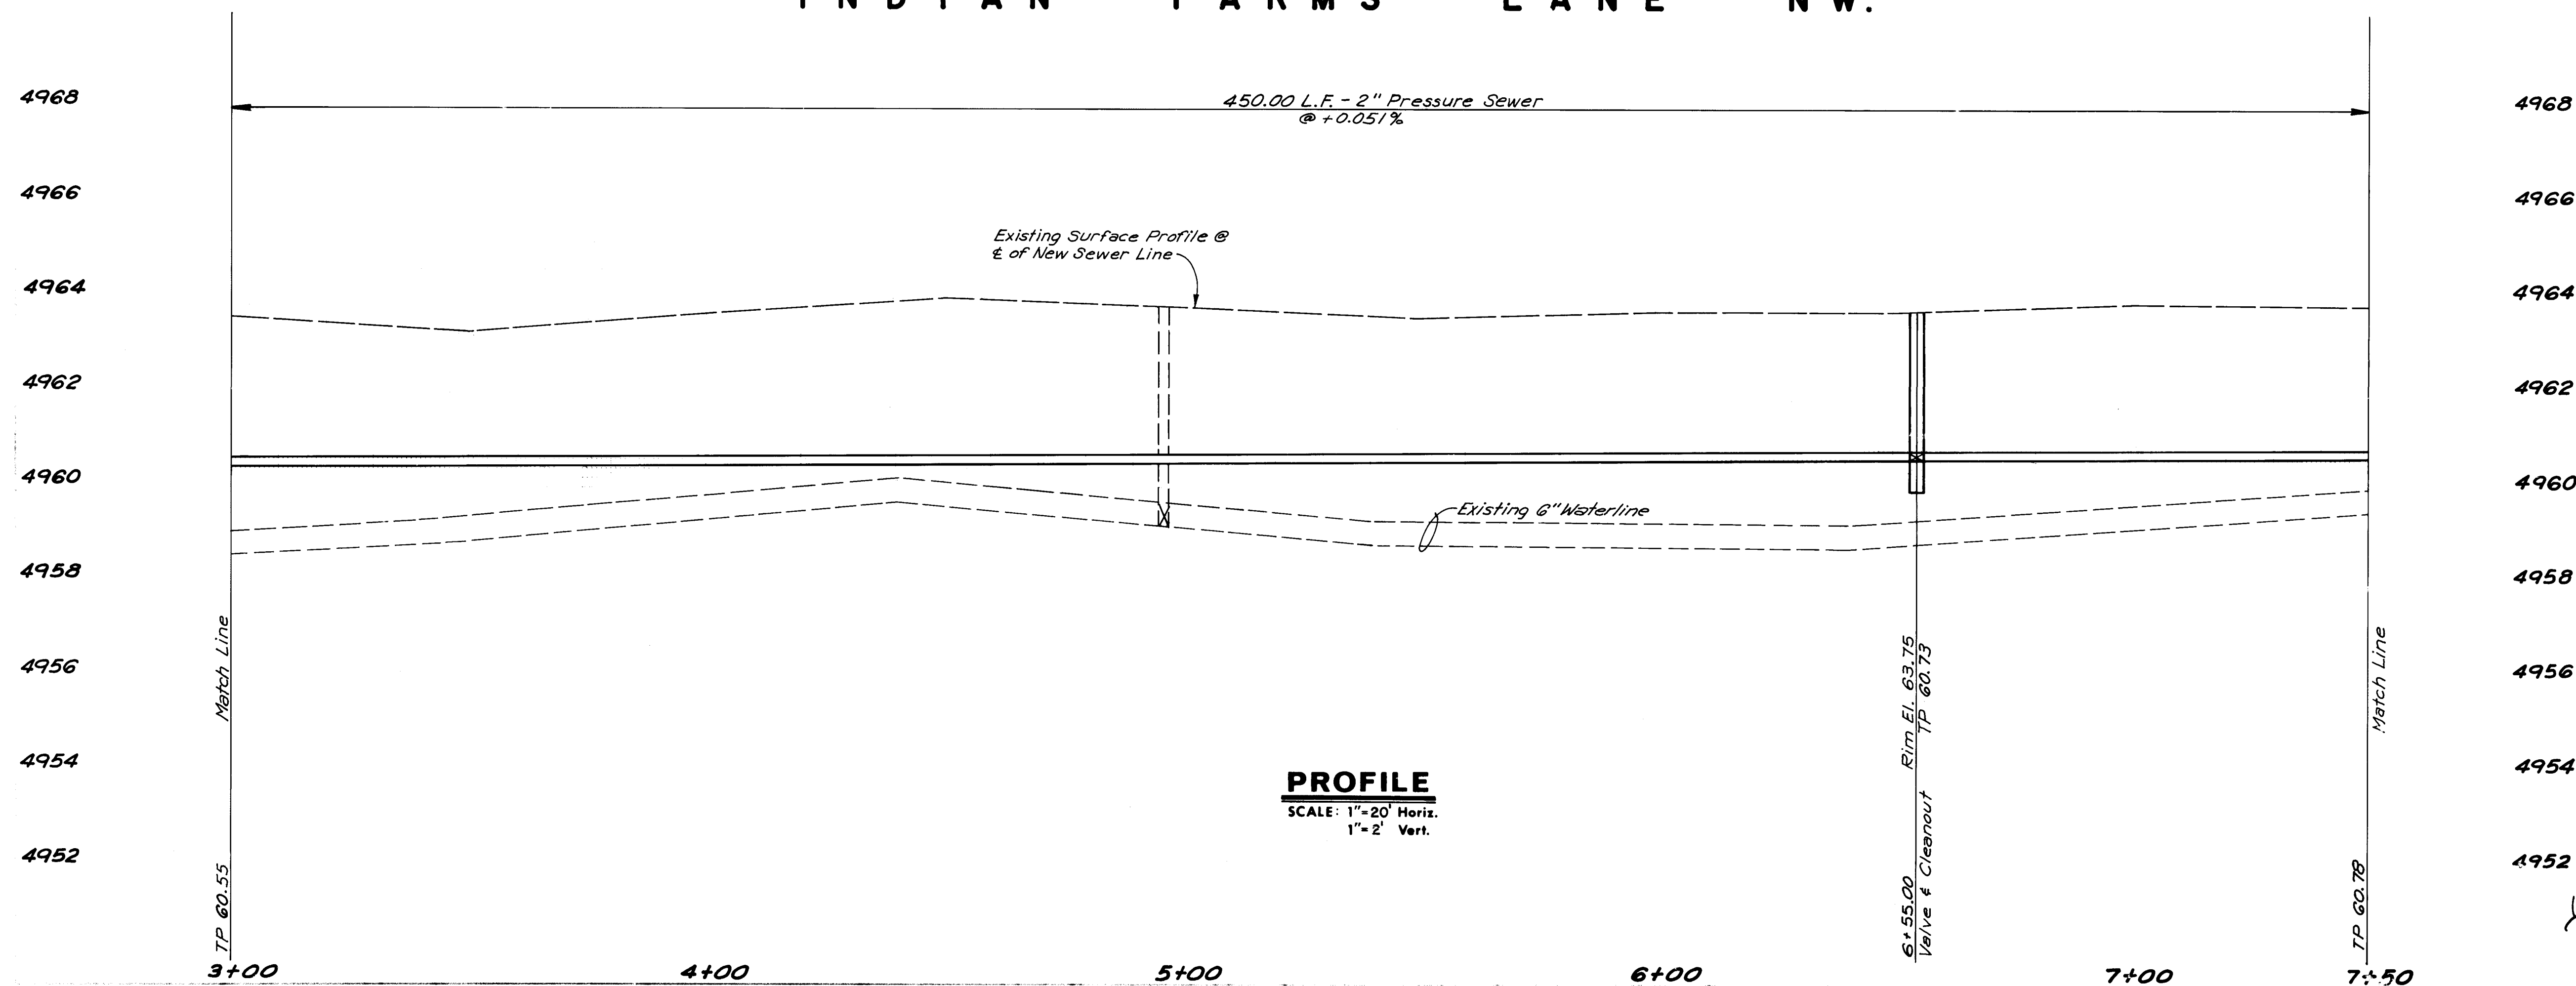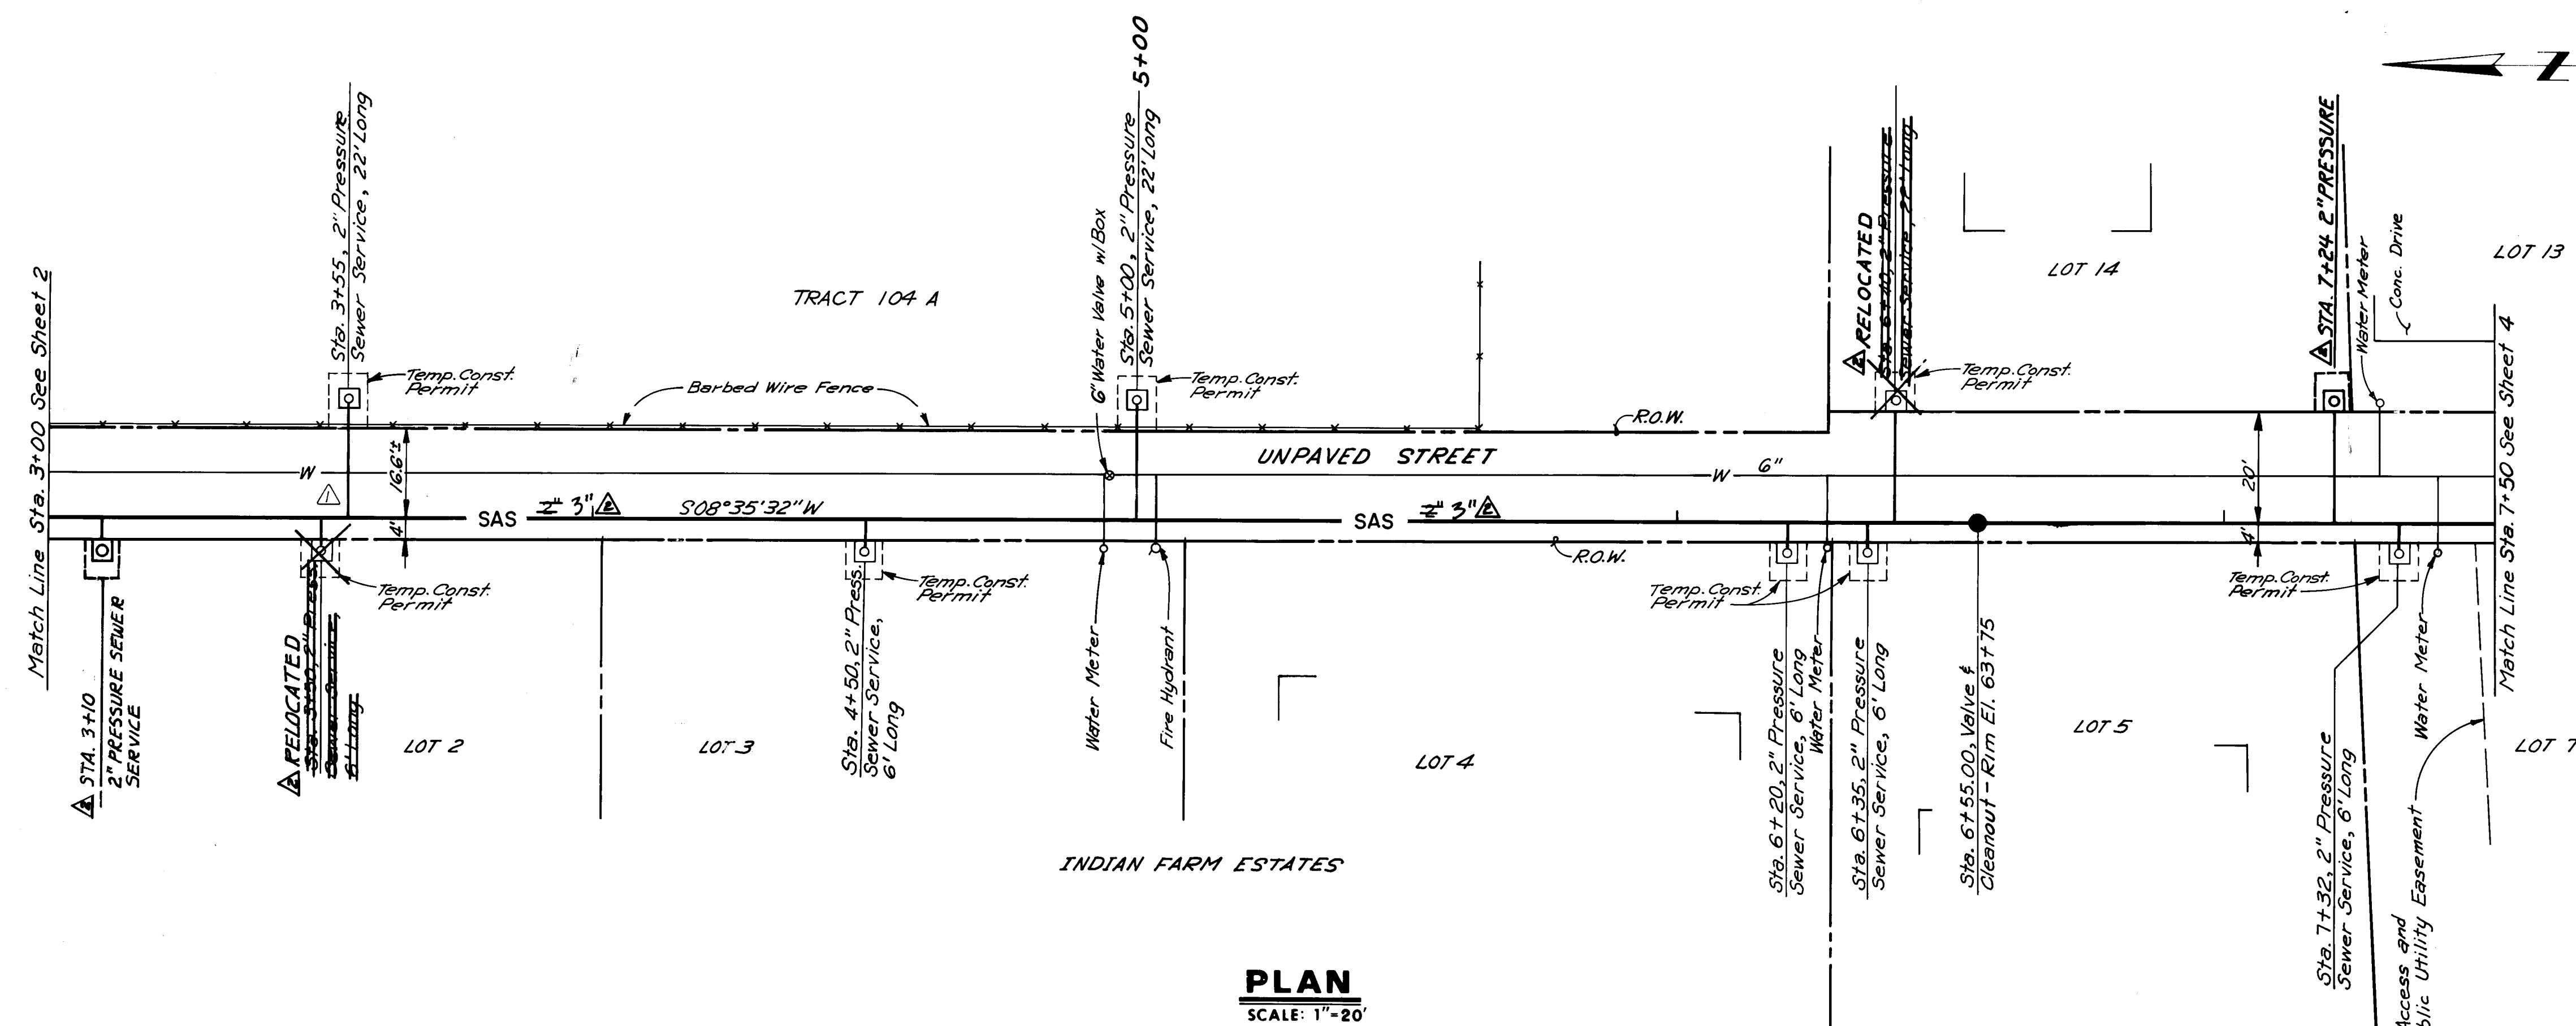

INDIAN FARMS LANE NW. SANITARY SEWER SANITARY SEWER PLAN & PROFILE


9-9-88 Revised from as-built information to
12-87 Extend Prop. SWS Service To Main
REMARK:

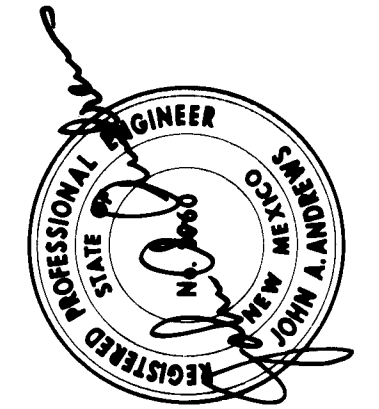


ANDREWS, ASBURY & ROBERT, INC.
— CONSULTING ENGINEERS —
ALBUQUERQUE 87-489 NEW MEXICO

"STA. 10-G13-A" ELEVATION 4968.16
BRASS TABLET SET IN TOP OF CONCRETE POST PROJECTING
0.20' ABOVE GROUND, LOCATED AT THE NORTHEAST CORNER
OF THE INTERSECTION OF RIO GRANDE BLVD. AND CANDELARIA
RD. NW.

Pride Construction	F.A.	52088	9.88
--------------------	------	-------	------

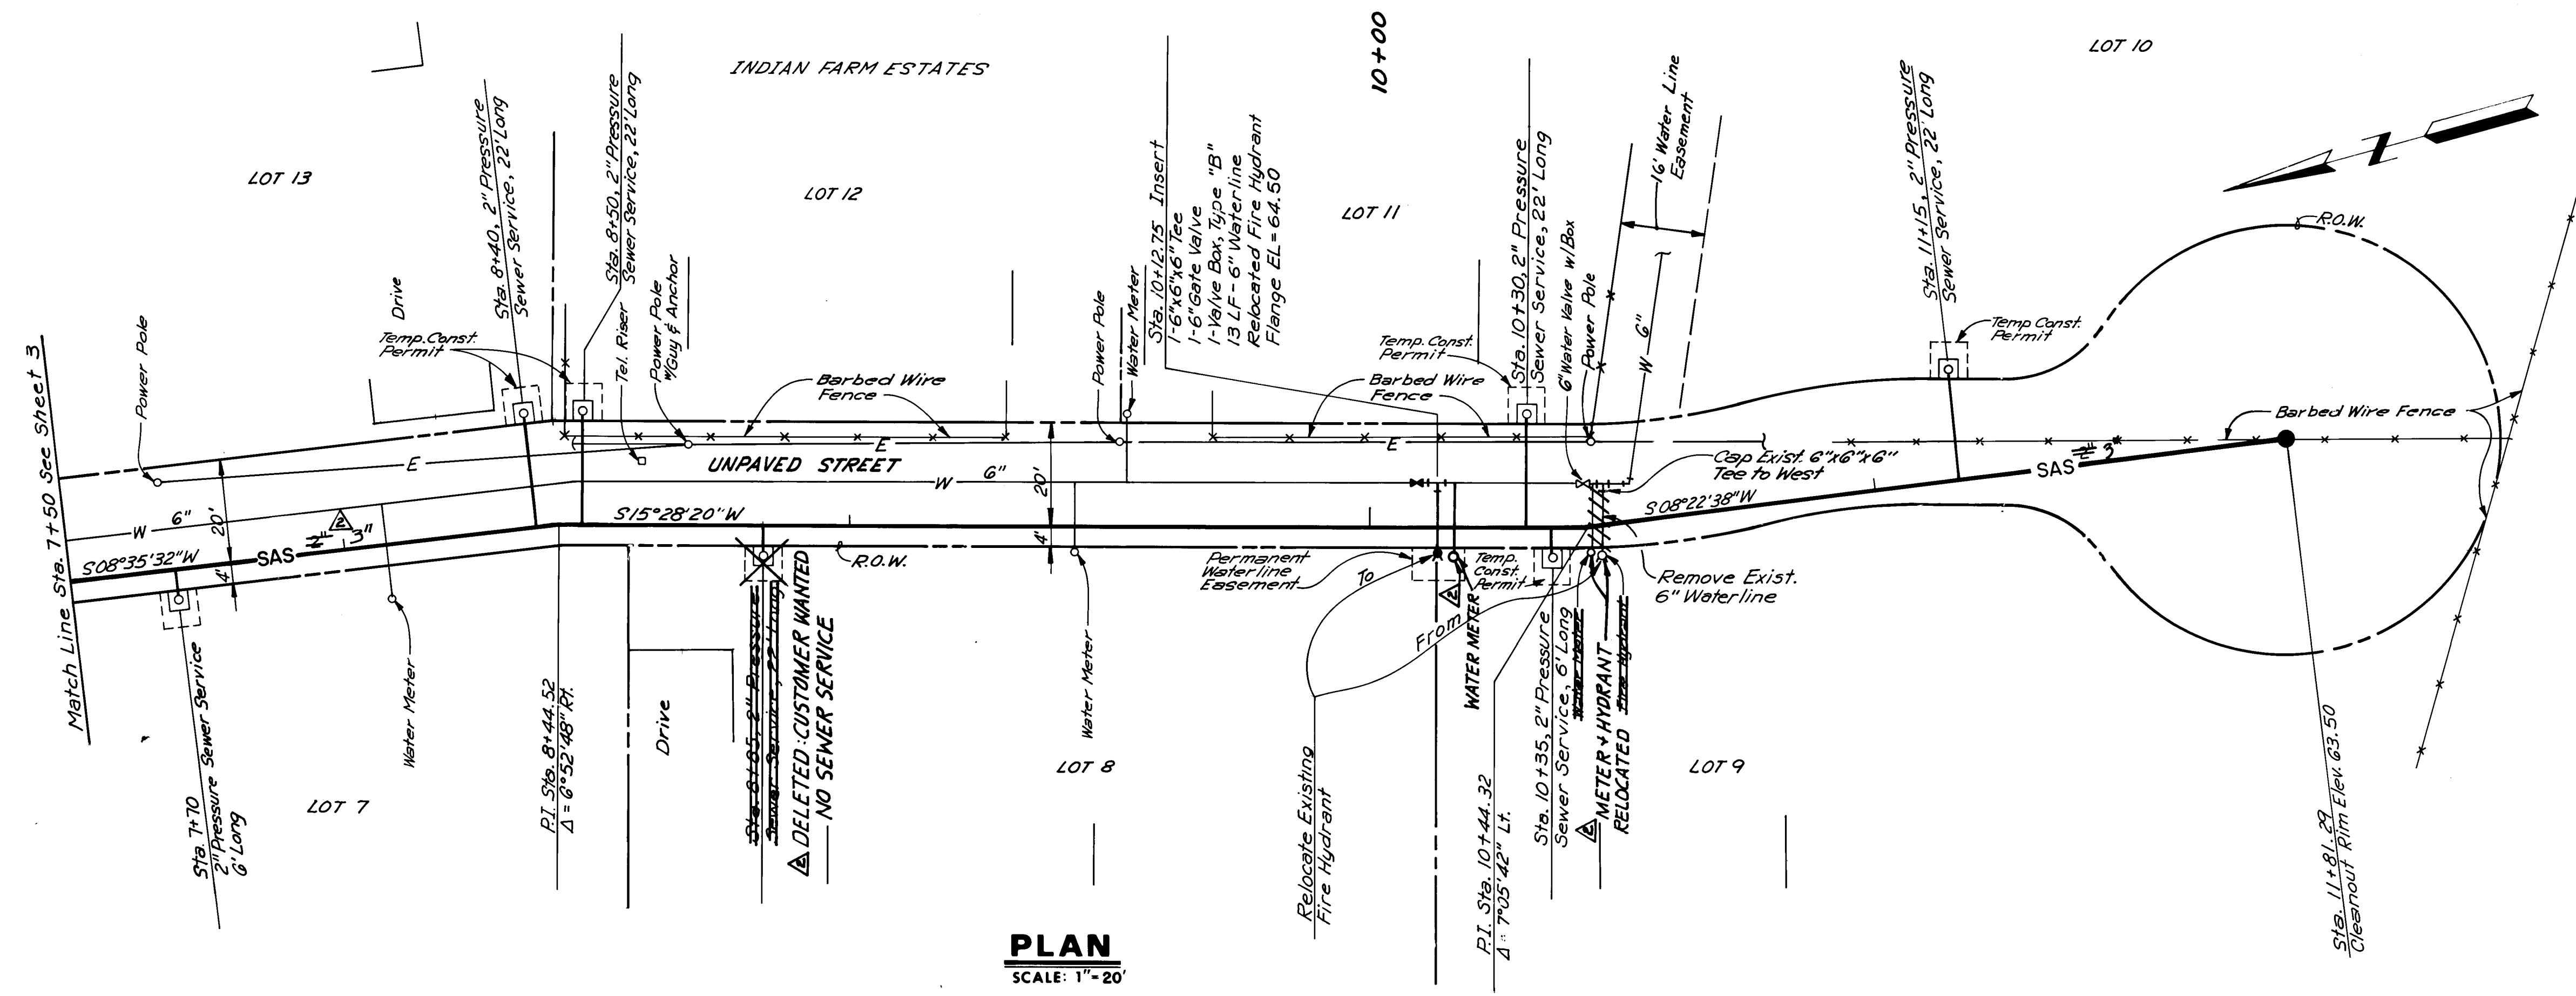


PLAN
SCALE: 1"=20'

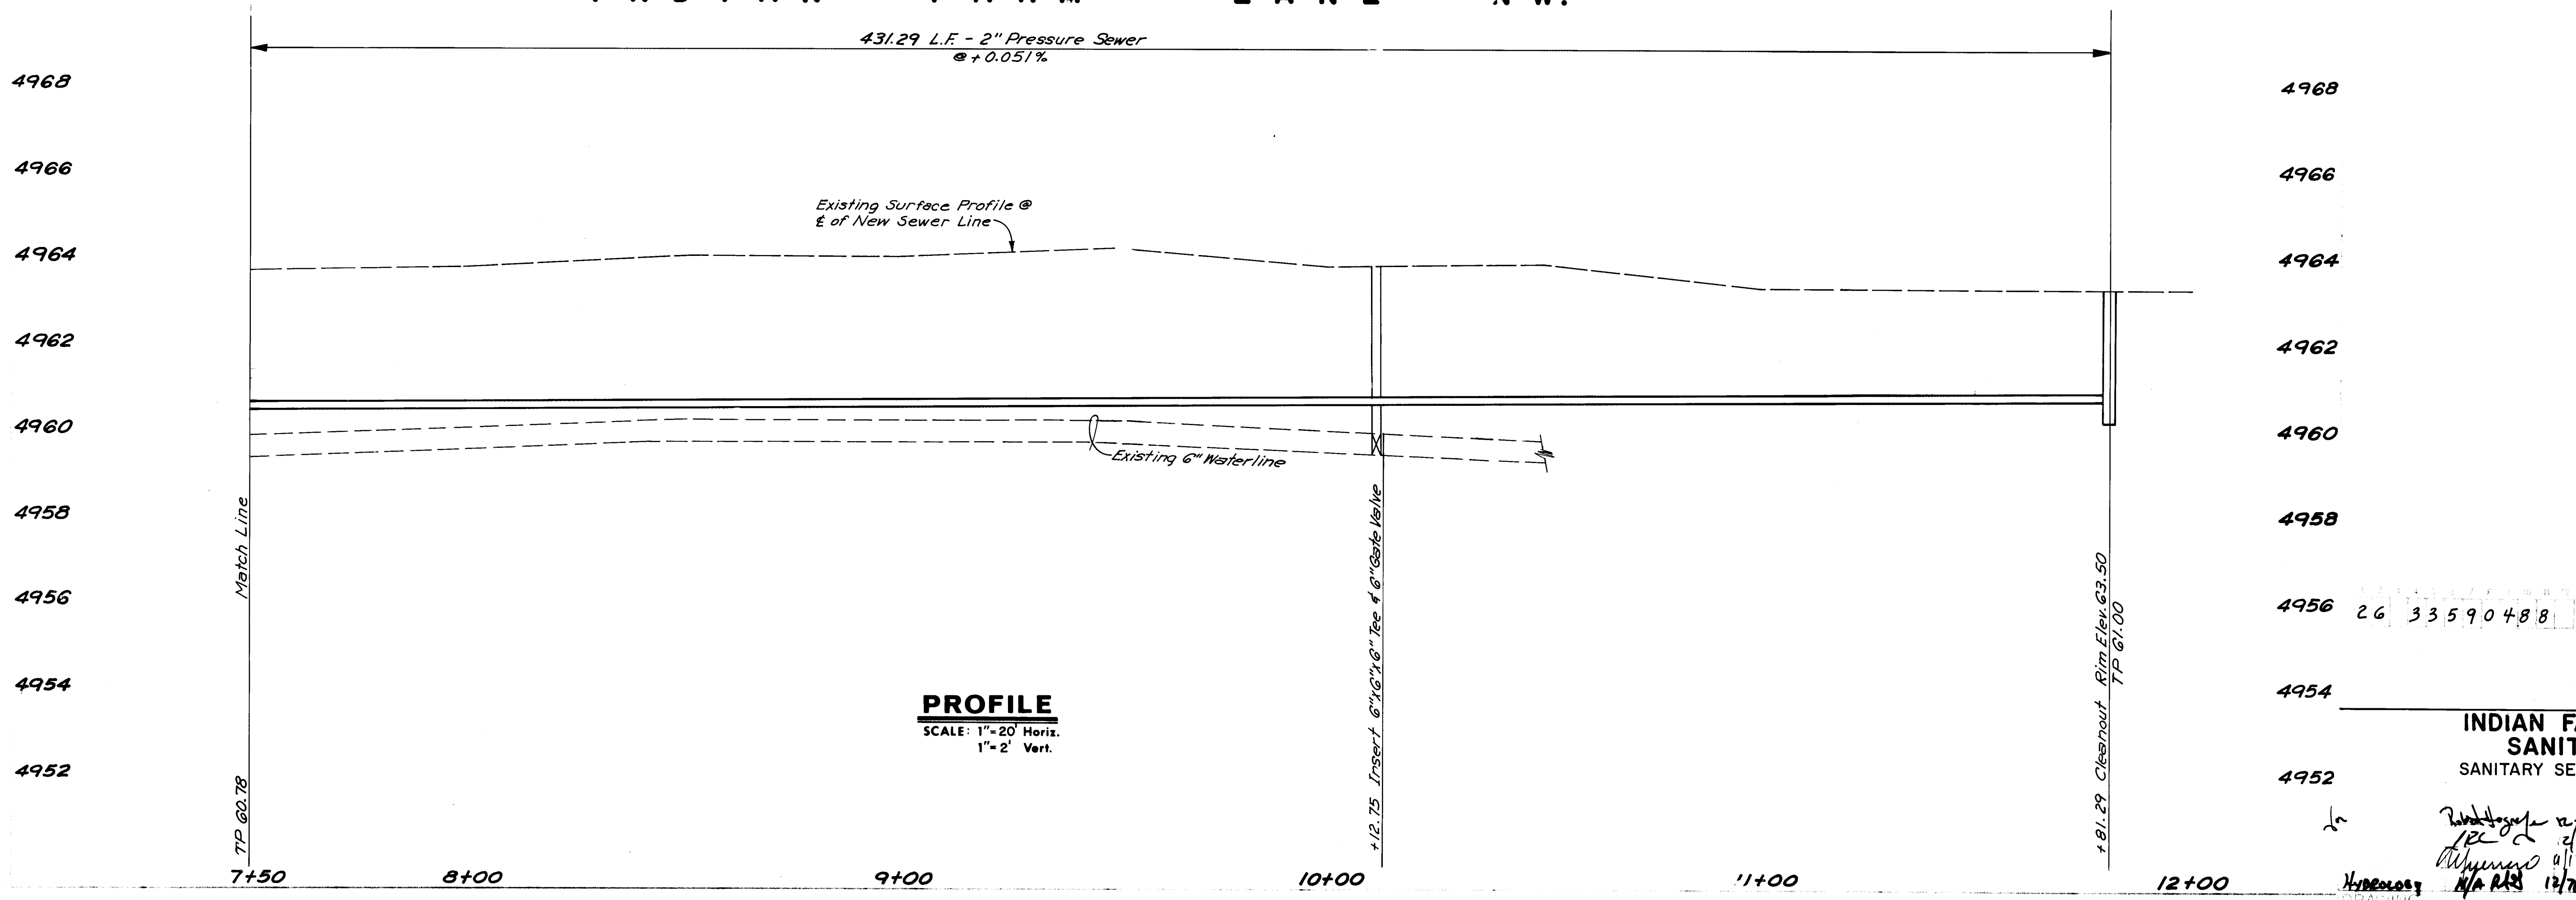

PROFILE
SCALE: 1"=20' Horiz.
1"=2' Vert.

**INDIAN FARM LANE NW.
SANITARY SEWER
SANITARY SEWER PLAN & PROFILE**


Handwritten notes and signatures at the bottom right of the profile view, including dates like 12/1/87 and 12/7/87, and initials like JCS, PIV.

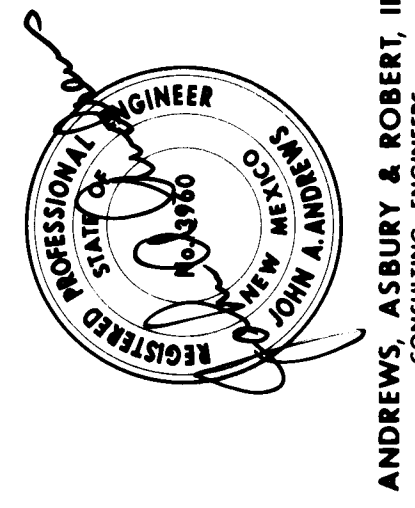


REVISIONS:
12-87 Rev. Street Name
9-88 Revised from as built information
EN PIV
JCS, PIV
June 1987
June 1987

ANDREWS, ASBURY & ROBERT, INC.
CONSULTING ENGINEERS
ALBUQUERQUE, N.M. 87102

"STA. 10-613-A"
BRASS TABLET SET IN TOP OF CONCRETE POST PROJECTING 0.20' ABOVE GROUND, LOCATED AT THE NORTHEAST CORNER OF THE INTERSECTION OF RIO GRANDE BLVD. AND CANDELARIA RD. NW.
ELEVATION 4968.16
Pride Construction
F.A.
5-2088
EN
9/88

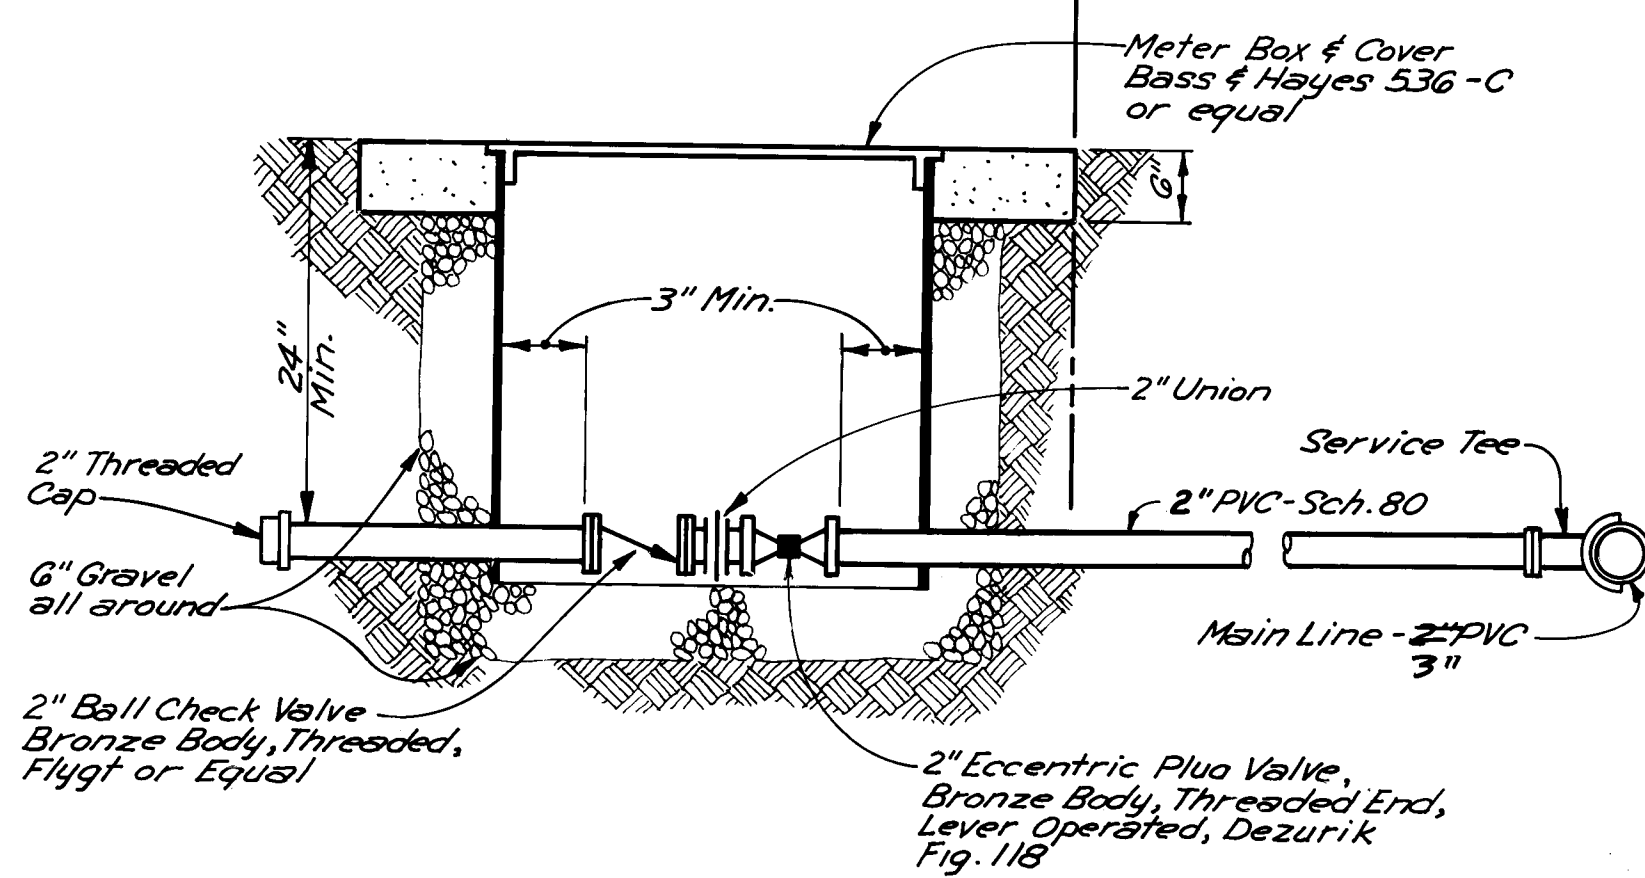

SCALE: $3/4" = 1'-0"$

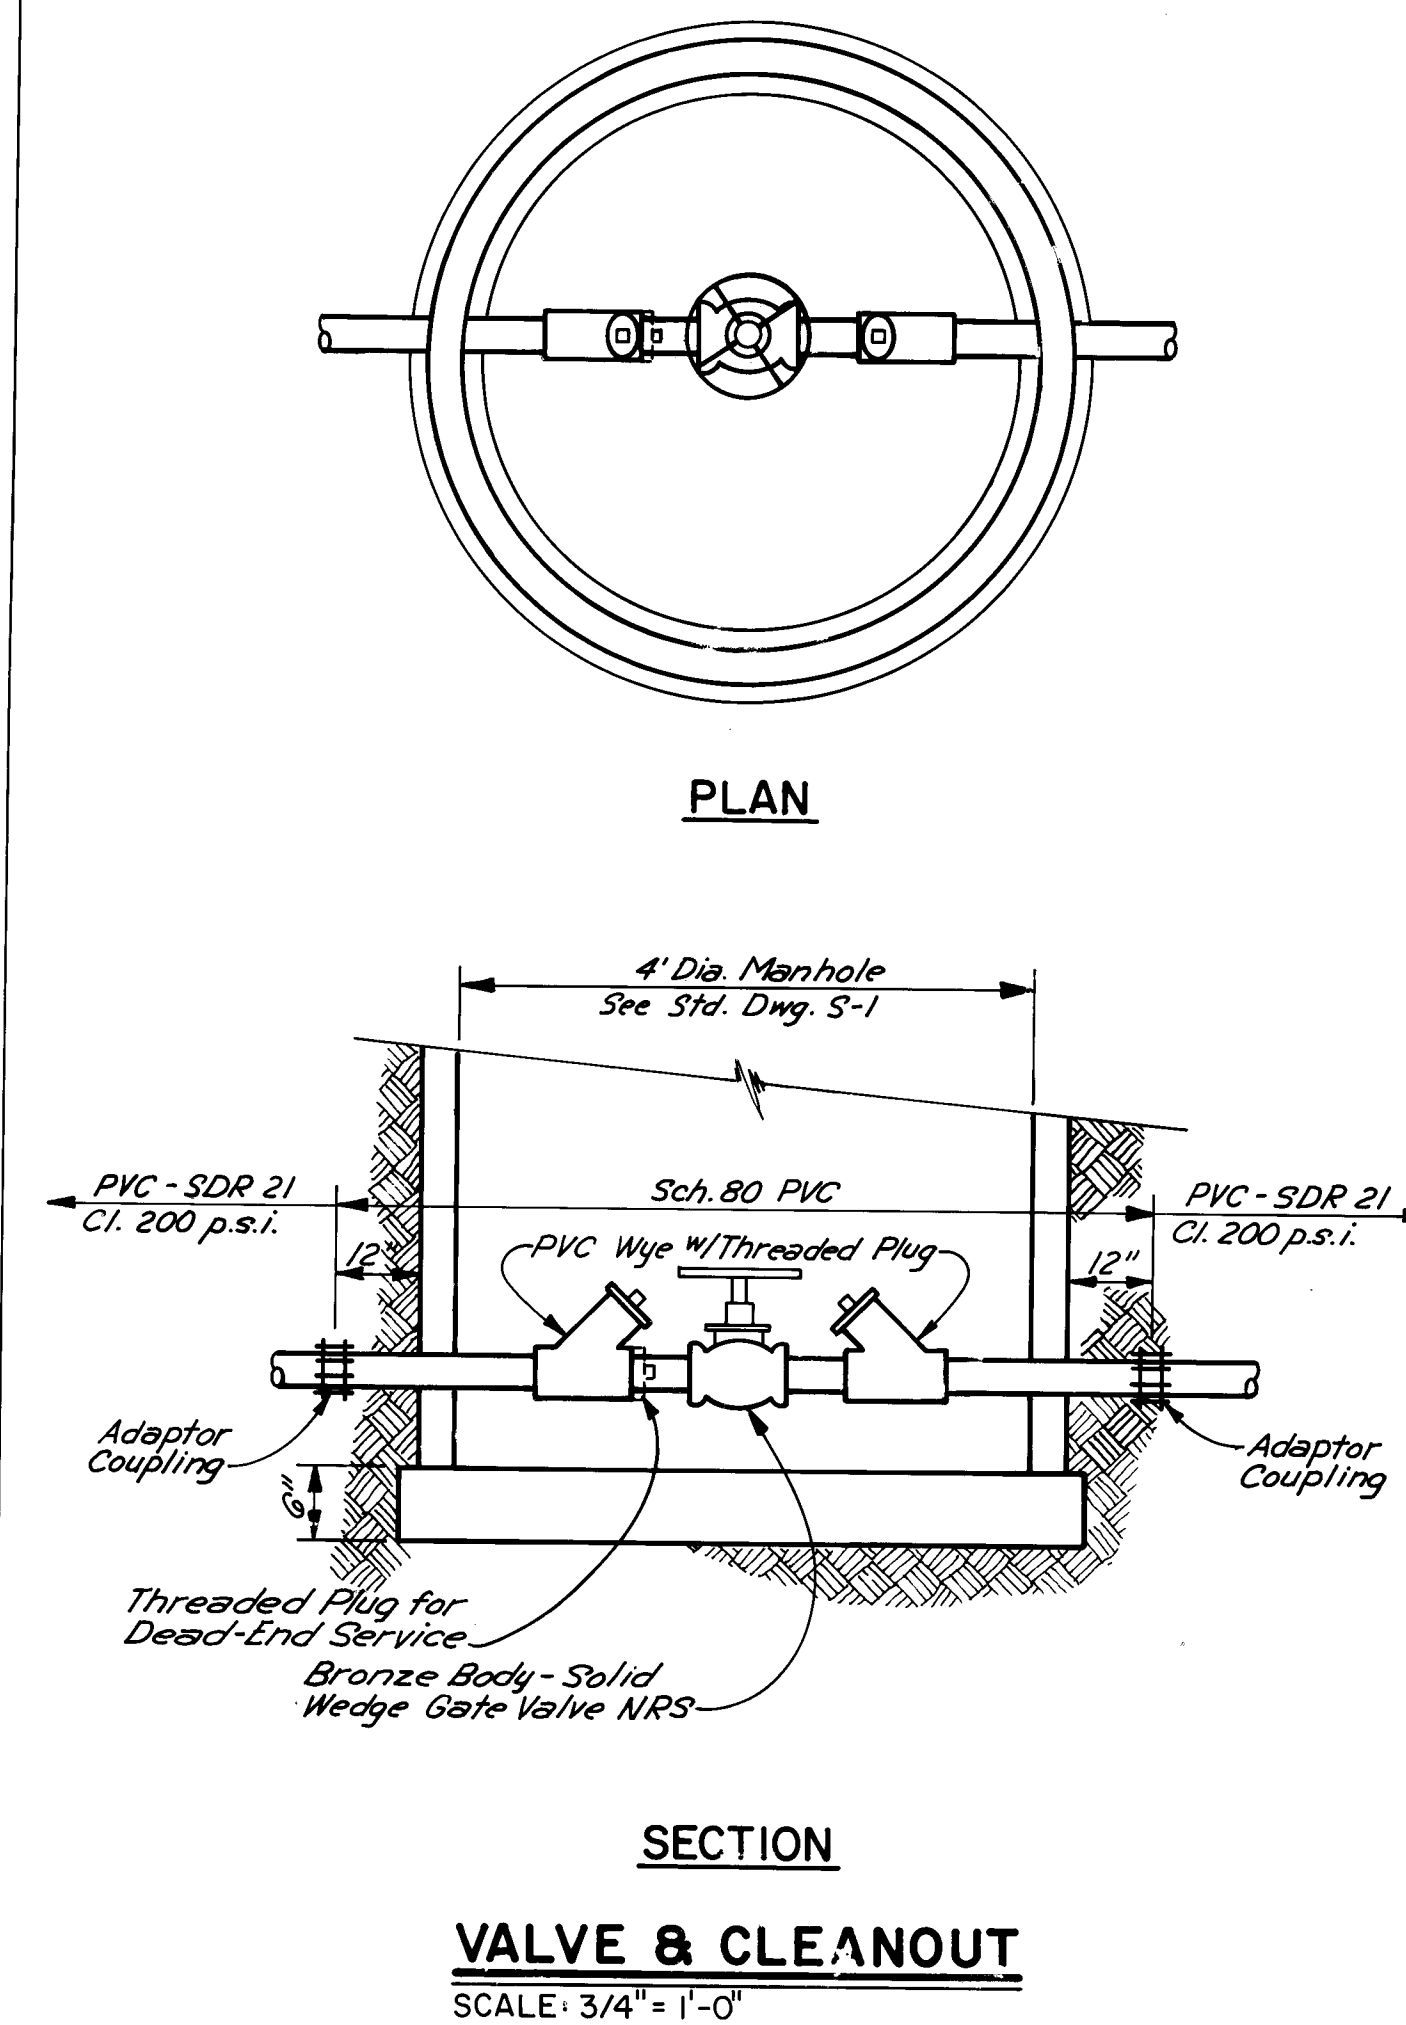

SCALE: $3/4" = 1'-0"$

1	2	3	4	5	6	7	8	9	10	11	12
2	6		3	3	5	9	0	5	8	8	

87-3