


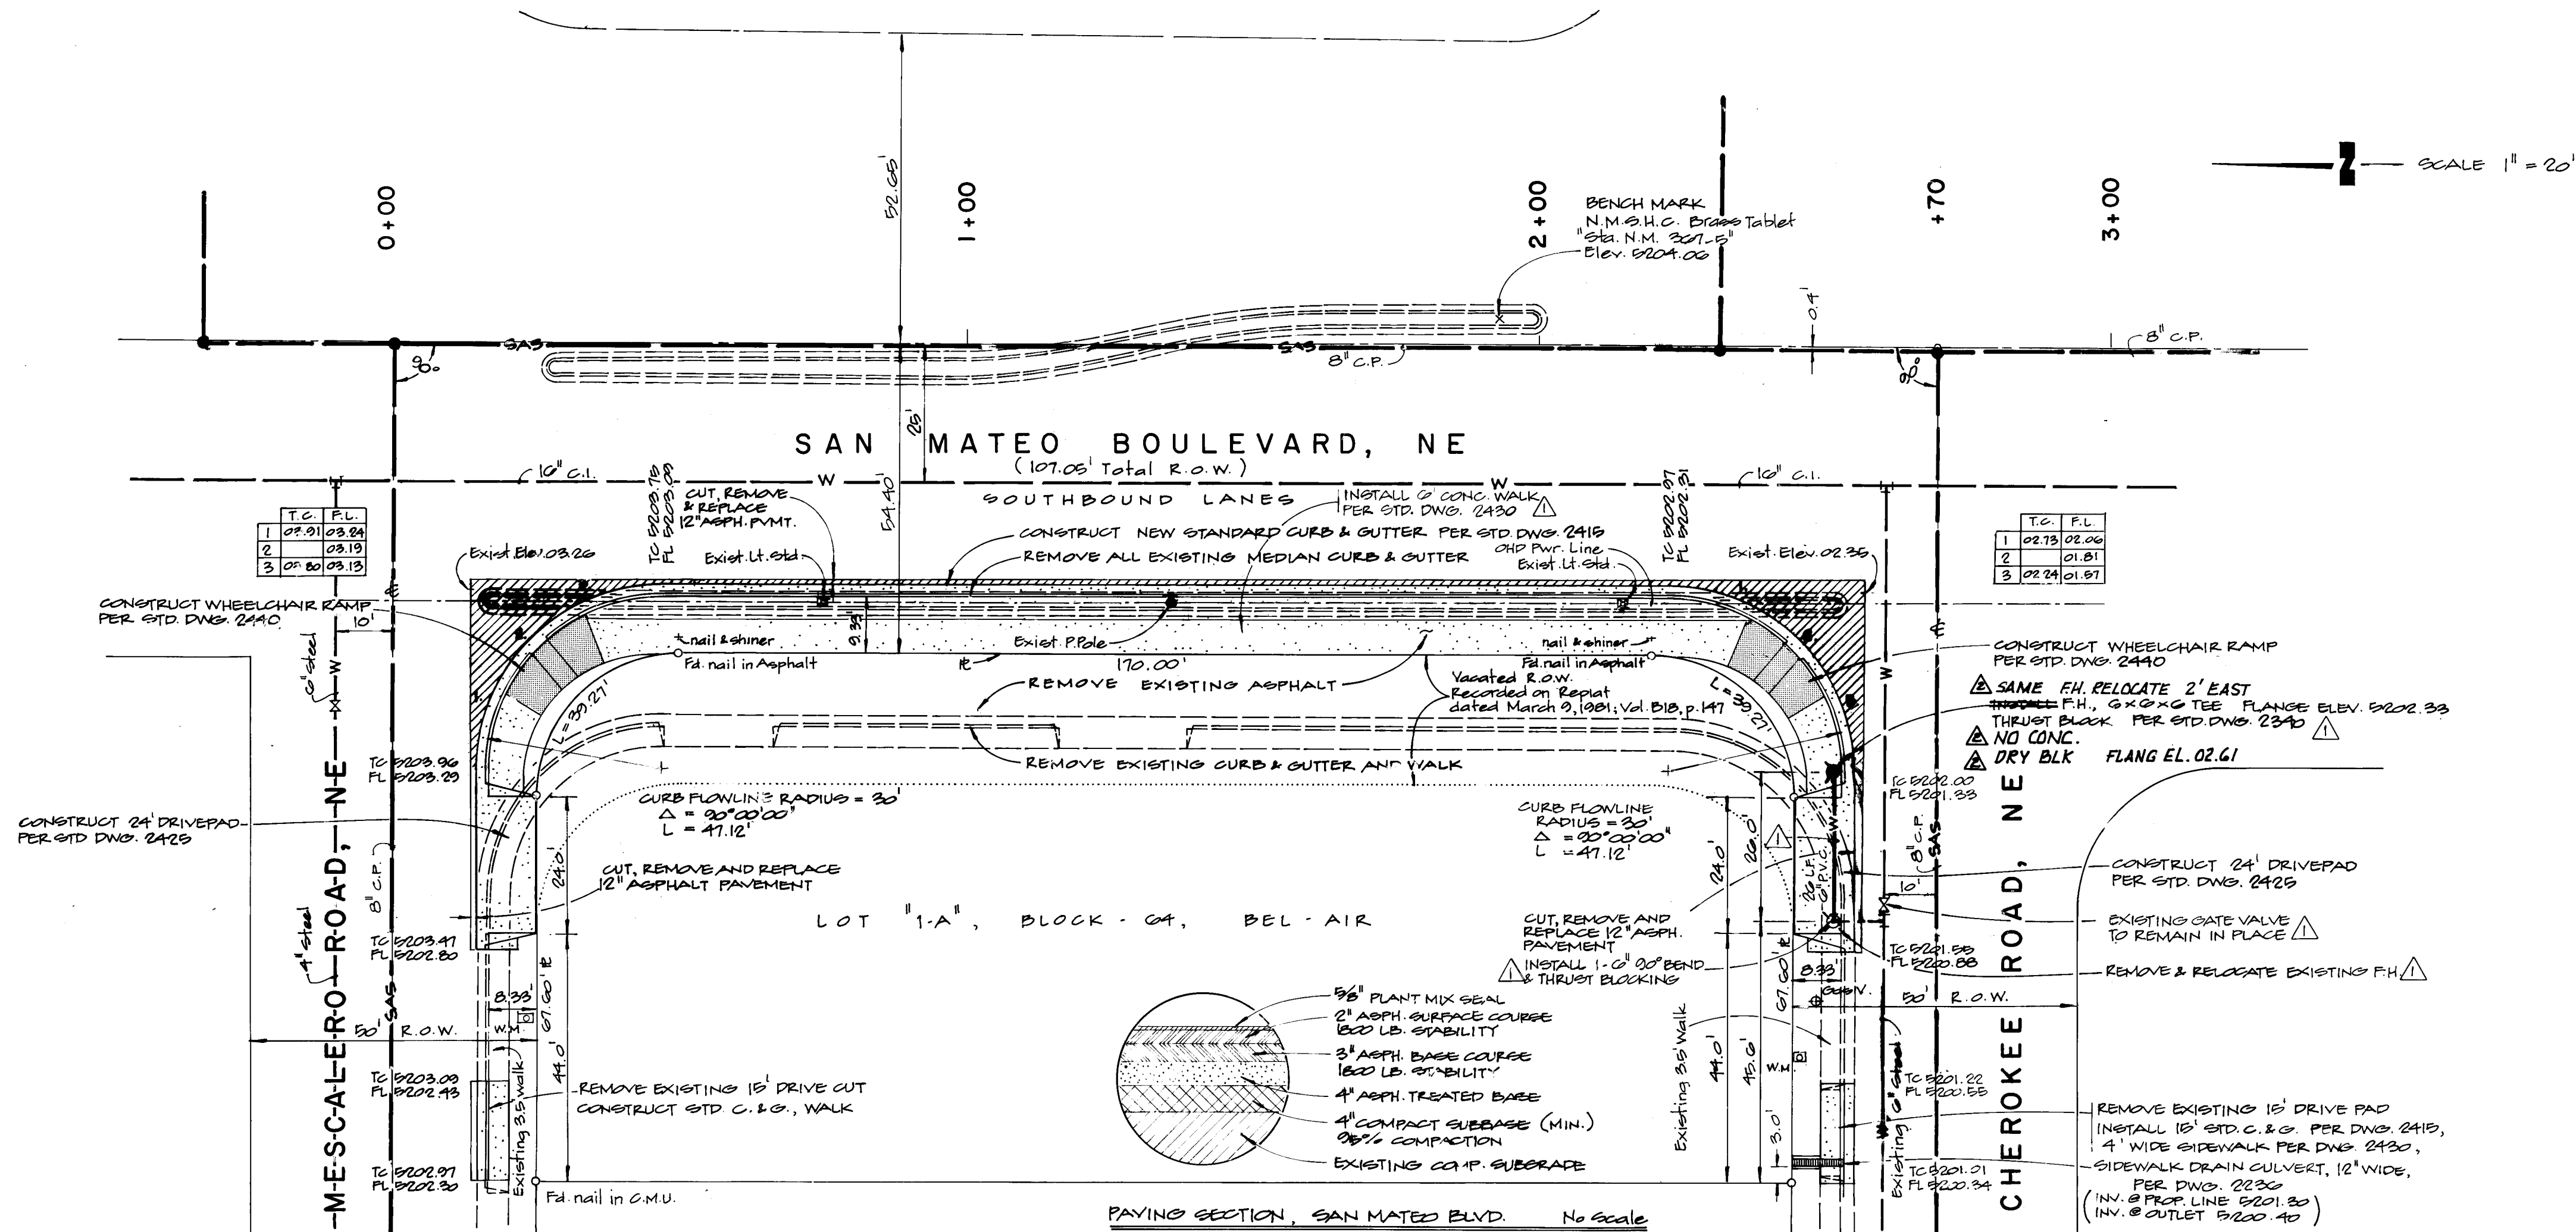

SCALE 1" = 20'

VERTICAL SCALE 1" = 5'

HORIZONTAL SCALE 1" = 20'

26 33 64 01 88

5-6-88

NOTE: ALL CURBS & GUTTER, DRIVEPADS, W. CHAIR RAMP, SIDEWALKS, & SIDEWALK CULVERTS SHALL BE CONSTRUCTED BY PERMIT PROCESS.

HALL ENGINEERING COMPANY INC.

ENGINEERING - SURVEYING - PLANNING - CONSTRUCTION

8840 2ND ST., N.W., SUITE 308 - ALBUQUERQUE, NEW MEXICO 87107

PHONE: (505) 345-1084

DATE: 11/24/87

DATE: 11/24/87

AS BUILT INFORMATION		BENCH MARKS		SURVEY INFORMATION		ENGINEER'S SEAL		LEGEND		REVISIONS		CITY OF ALBUQUERQUE MUNICIPAL DEVELOPMENT DEPARTMENT ENGINEERING DIVISION		TITLE: CURB & GUTTER, SAN MATEO BLVD., NE W. SIDE, MESCALERO RD. - CHEROKEE RD.			
N.M.S.H.C. Brass Tablet Set 78 Feet North of North Median No. 1 in San Mateo Boulevard at Intersection of Cherokee Road, NE		N.M.S.H.C. Brass Tablet Set 78 Feet North of North Median No. 1 in San Mateo Boulevard at Intersection of Cherokee Road, NE		NO. BY DATE		NO. BY DATE		EXISTING WATER LINE PROPOSED FIRE HYDRANT EXISTING FIRE HYDRANT EXISTING CURB & GUTTER AND SIDEWALK PROPOSED CURB & GUTTER AND SIDEWALK PROPOSED DRIVE CUT EXISTING WATER METER/BOX PROPOSED RESIDENTIAL PAVING PROPOSED ARTERIAL PAVING PROPOSED WHEELCHAIR RAMP 26 33 64 01 88 5-6-88		REVISIONS NO. DATE 1. 11/24/87 2. 11/24/87 3. 11/24/87 4. 11/24/87 5. 11/24/87 6. 11/24/87 7. 11/24/87 8. 11/24/87 9. 11/24/87 10. 11/24/87		DESIGN DATE: 11/24/87 BY: E.W. KIESS CHECKED BY: R.V. HALL		APPROVALS ENGINEER: 11/24/87 CITY ENGINEER: 11/24/87 ACE - Design: 11/24/87 ACE - Hydrology: 11/24/87		DRAWING NO. 3364 MAP NO. G-17 SHEET 1 OF 1	