

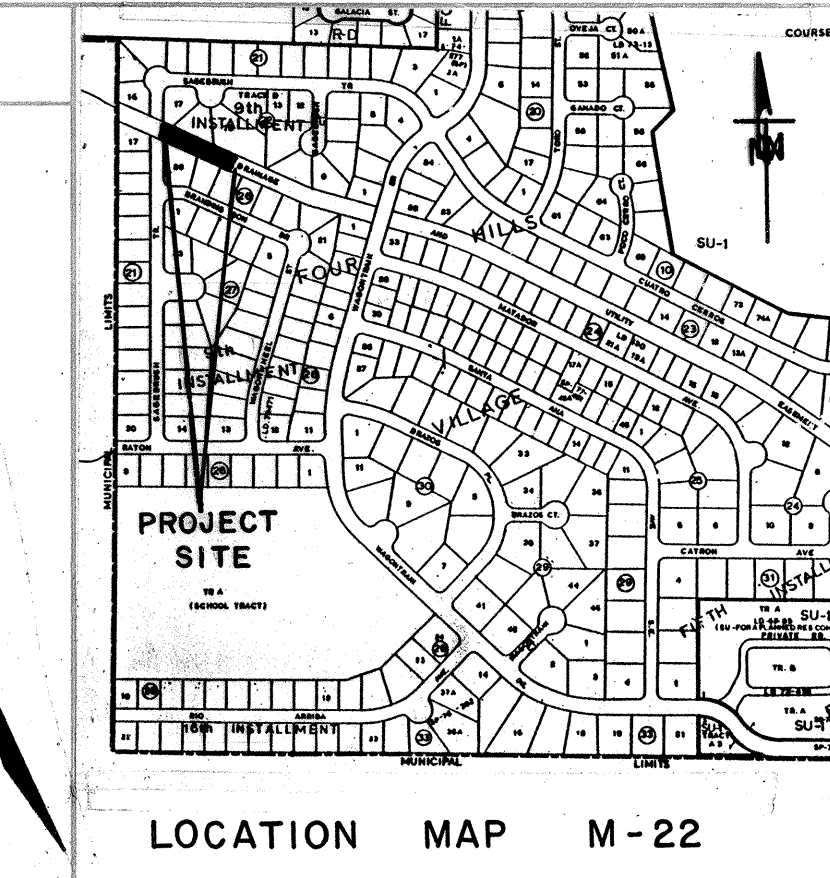
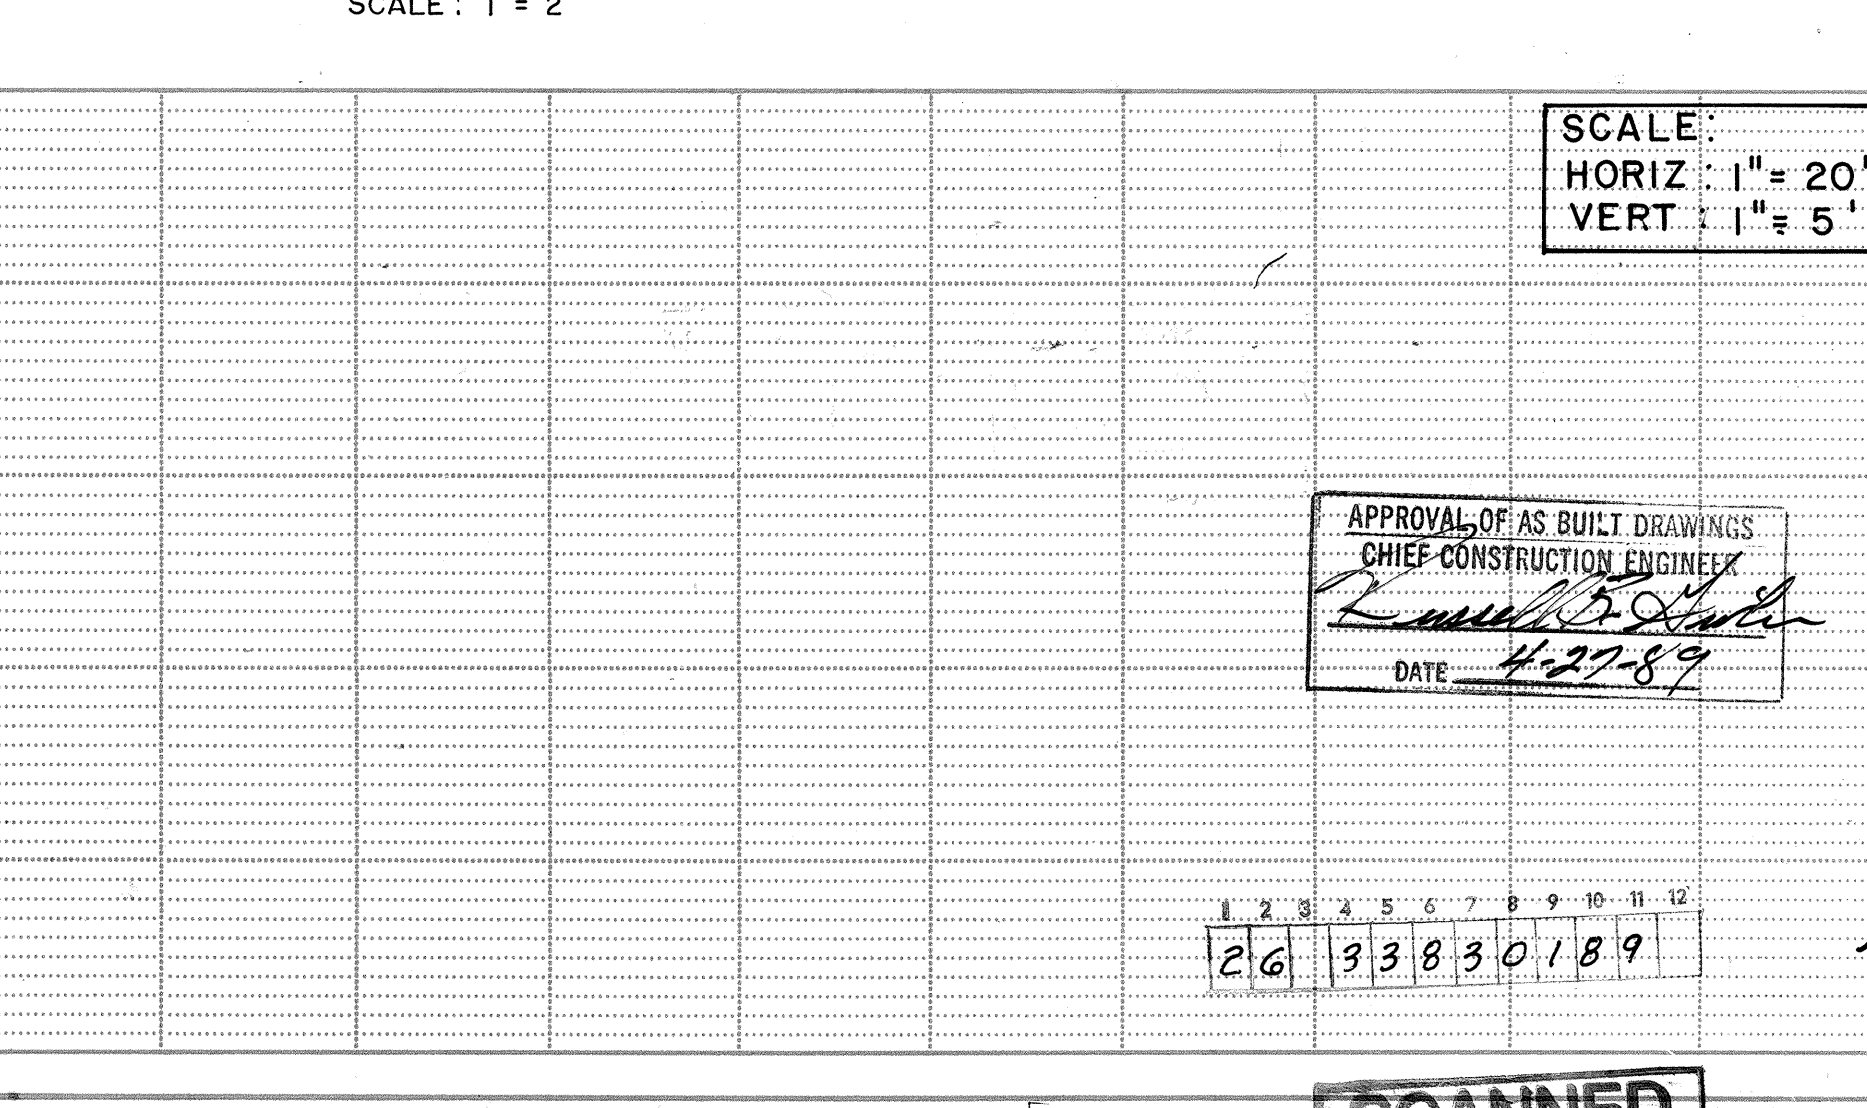
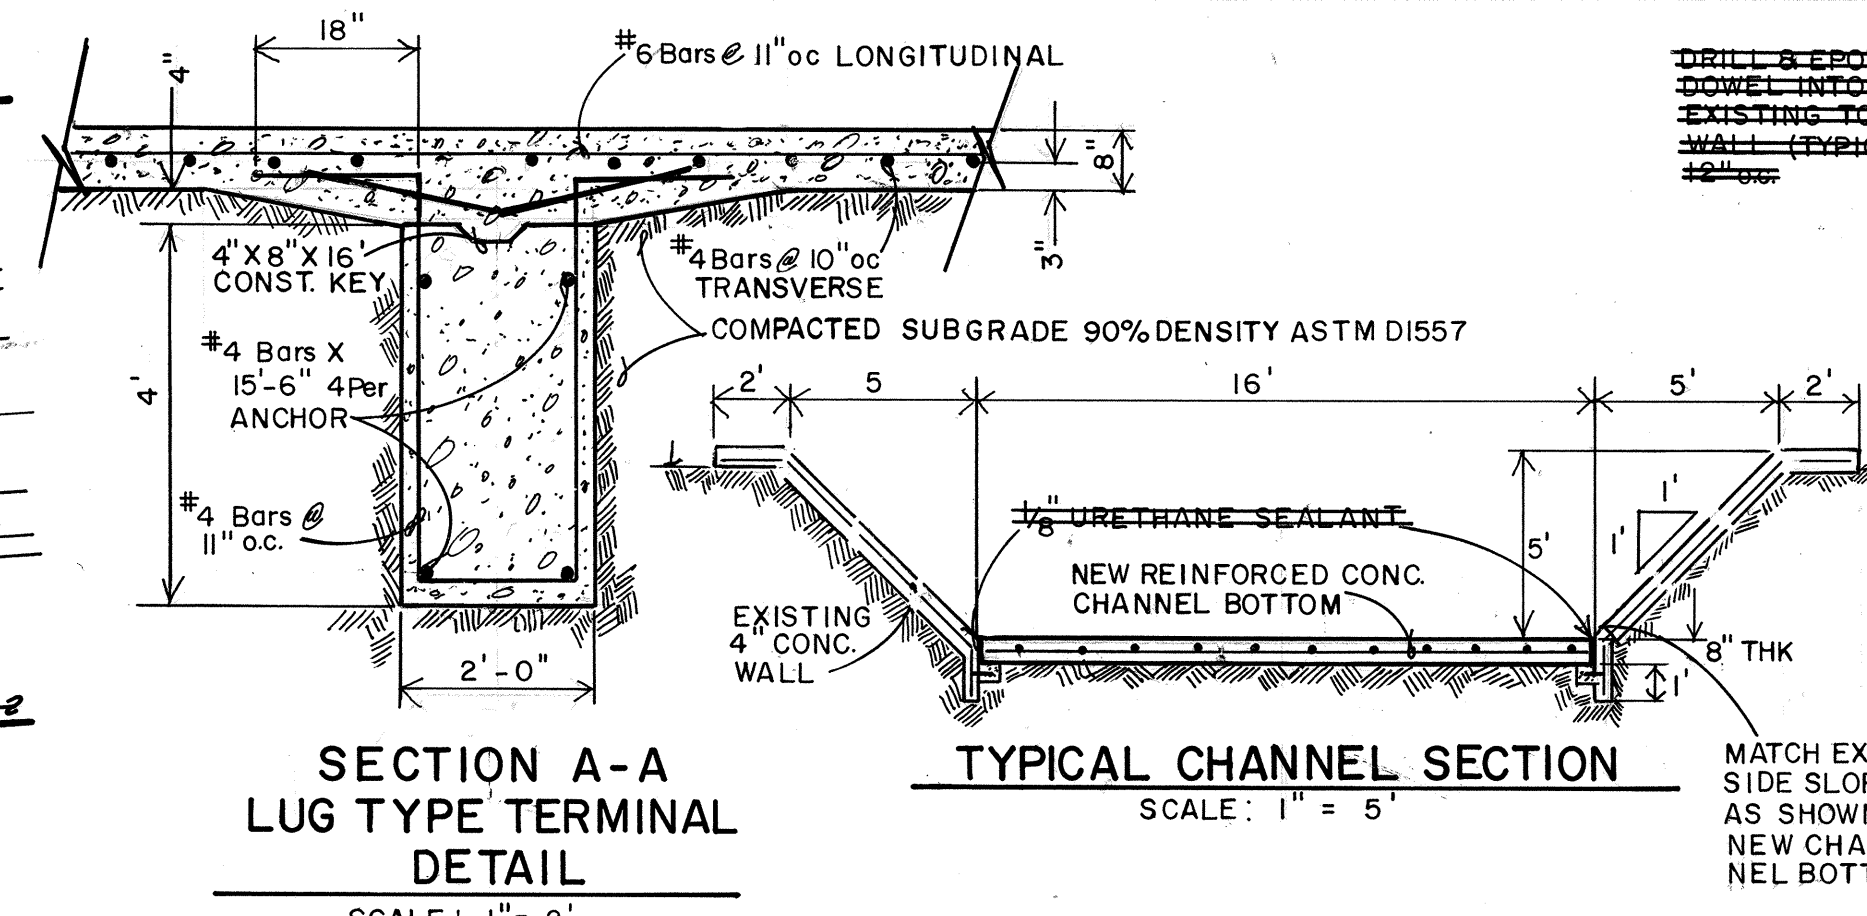
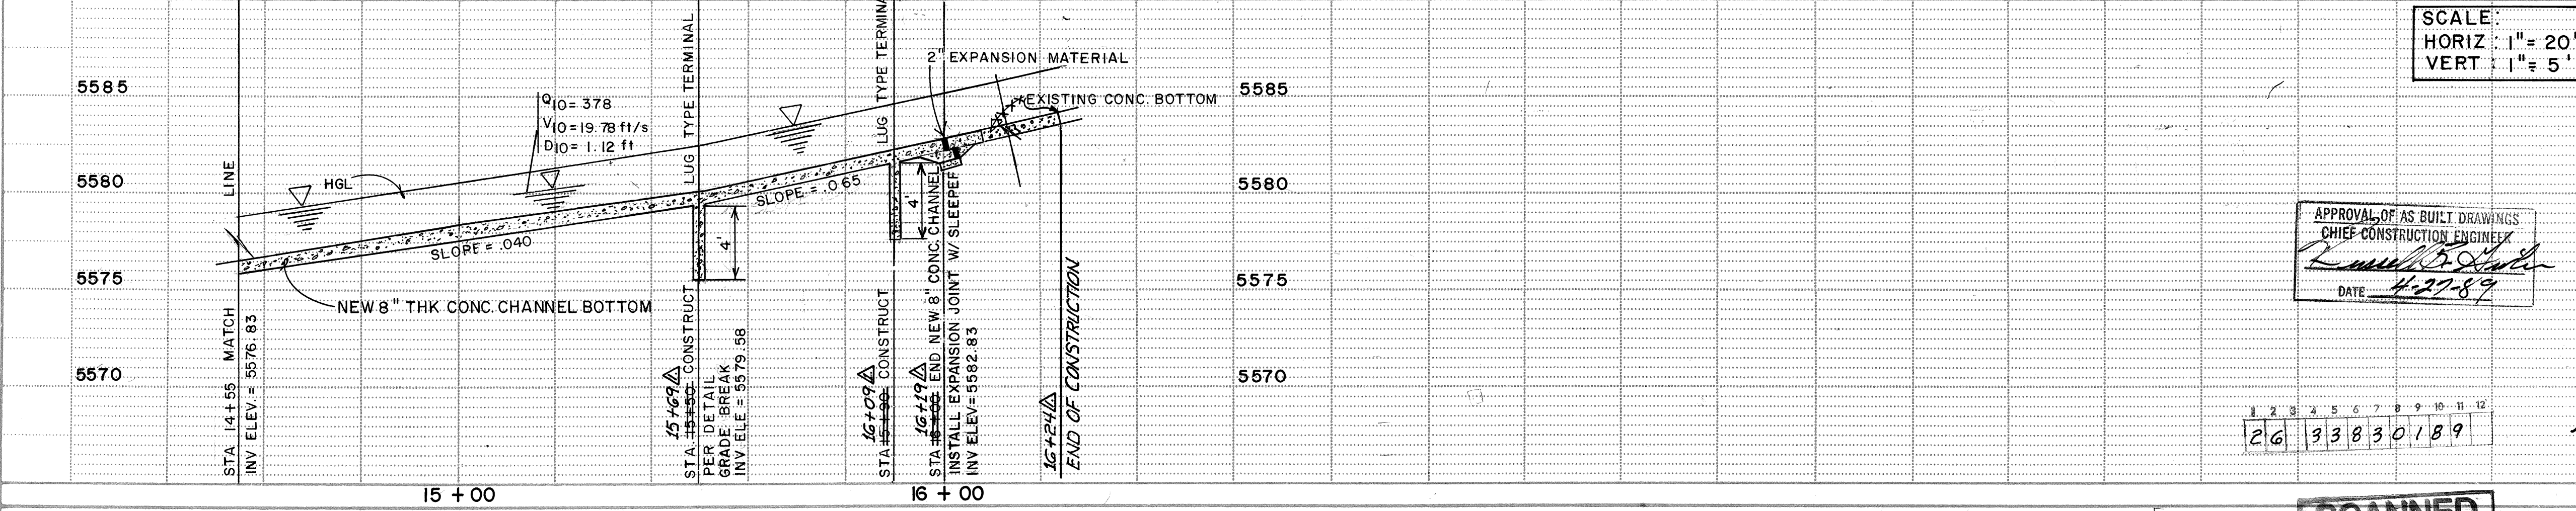
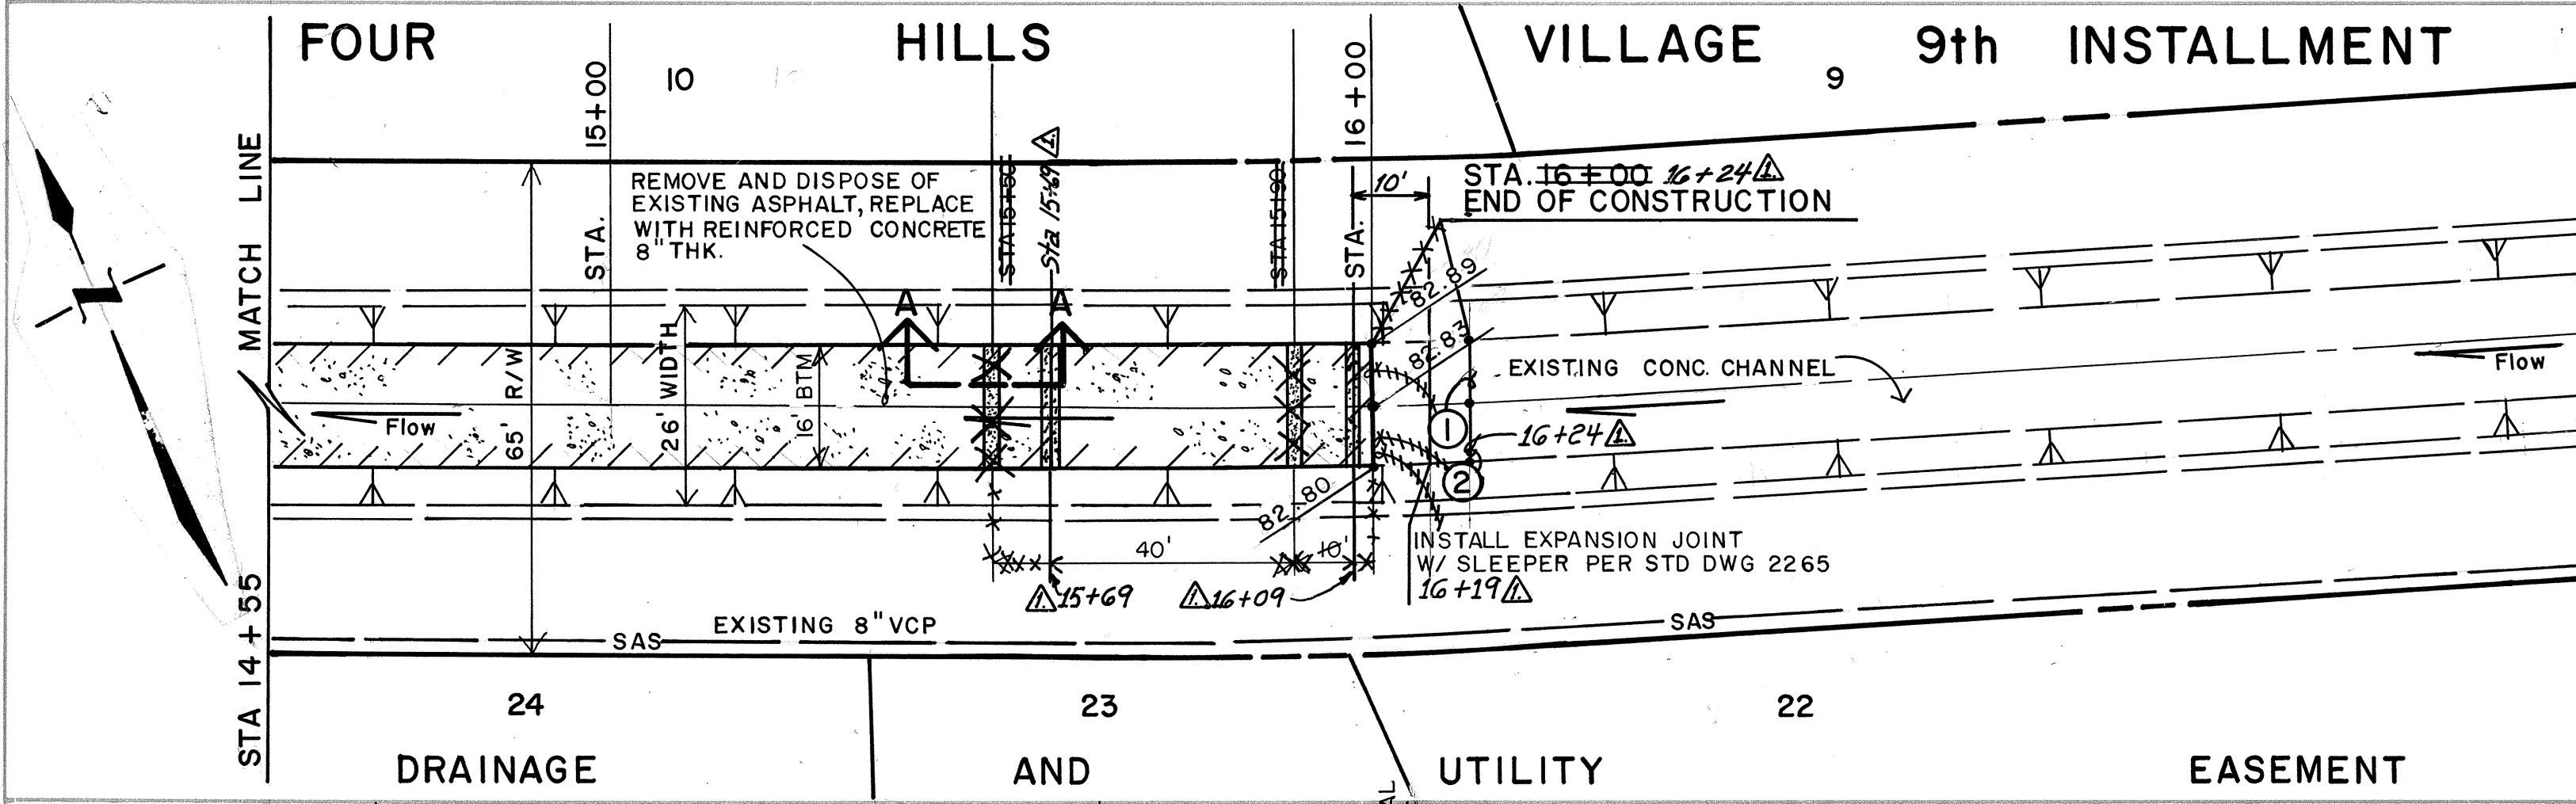
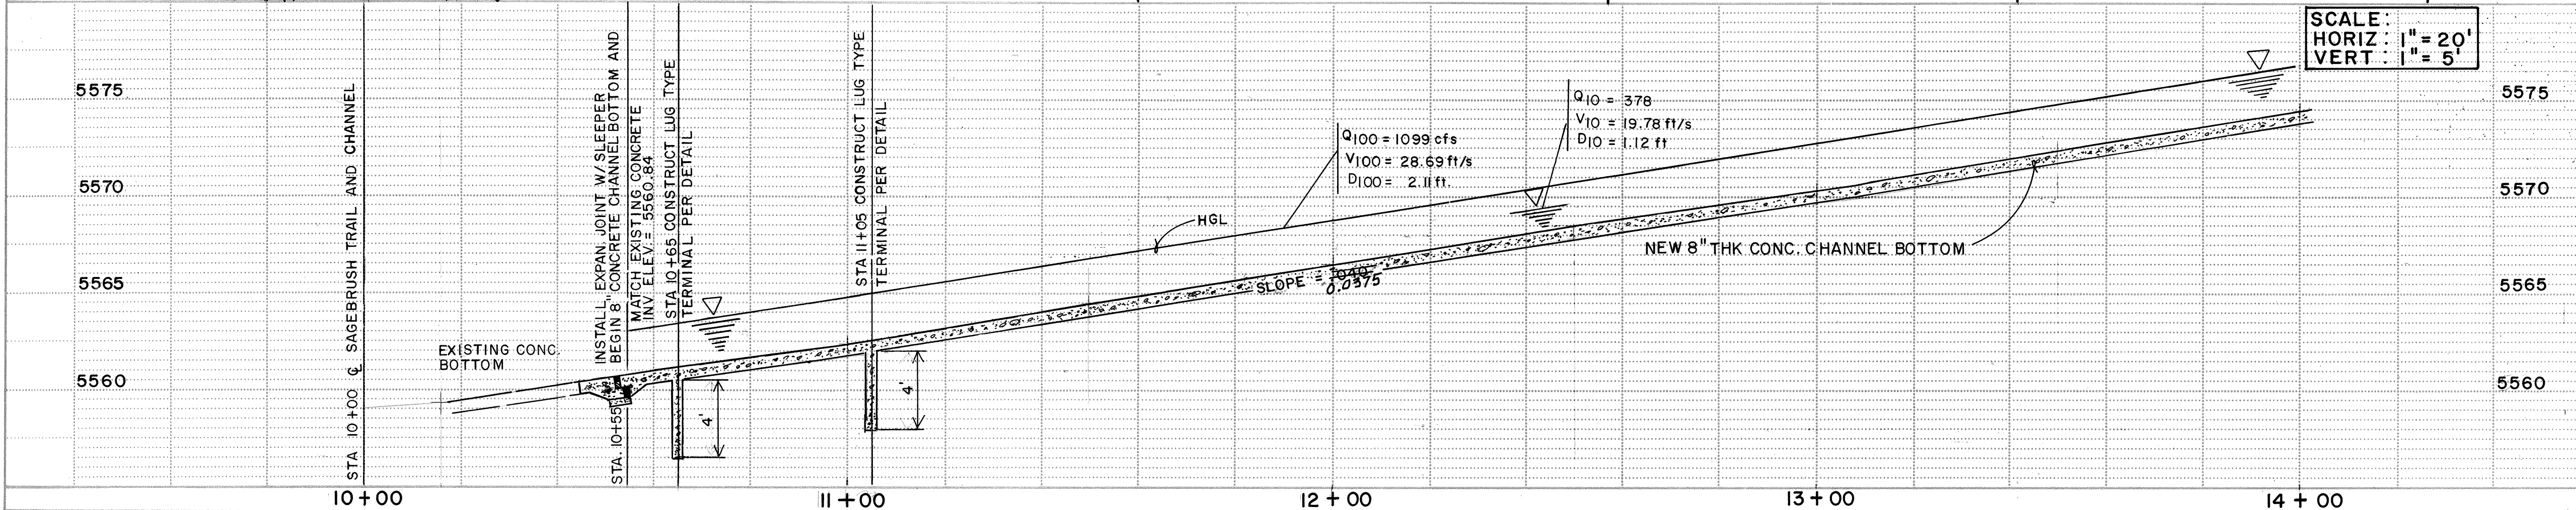
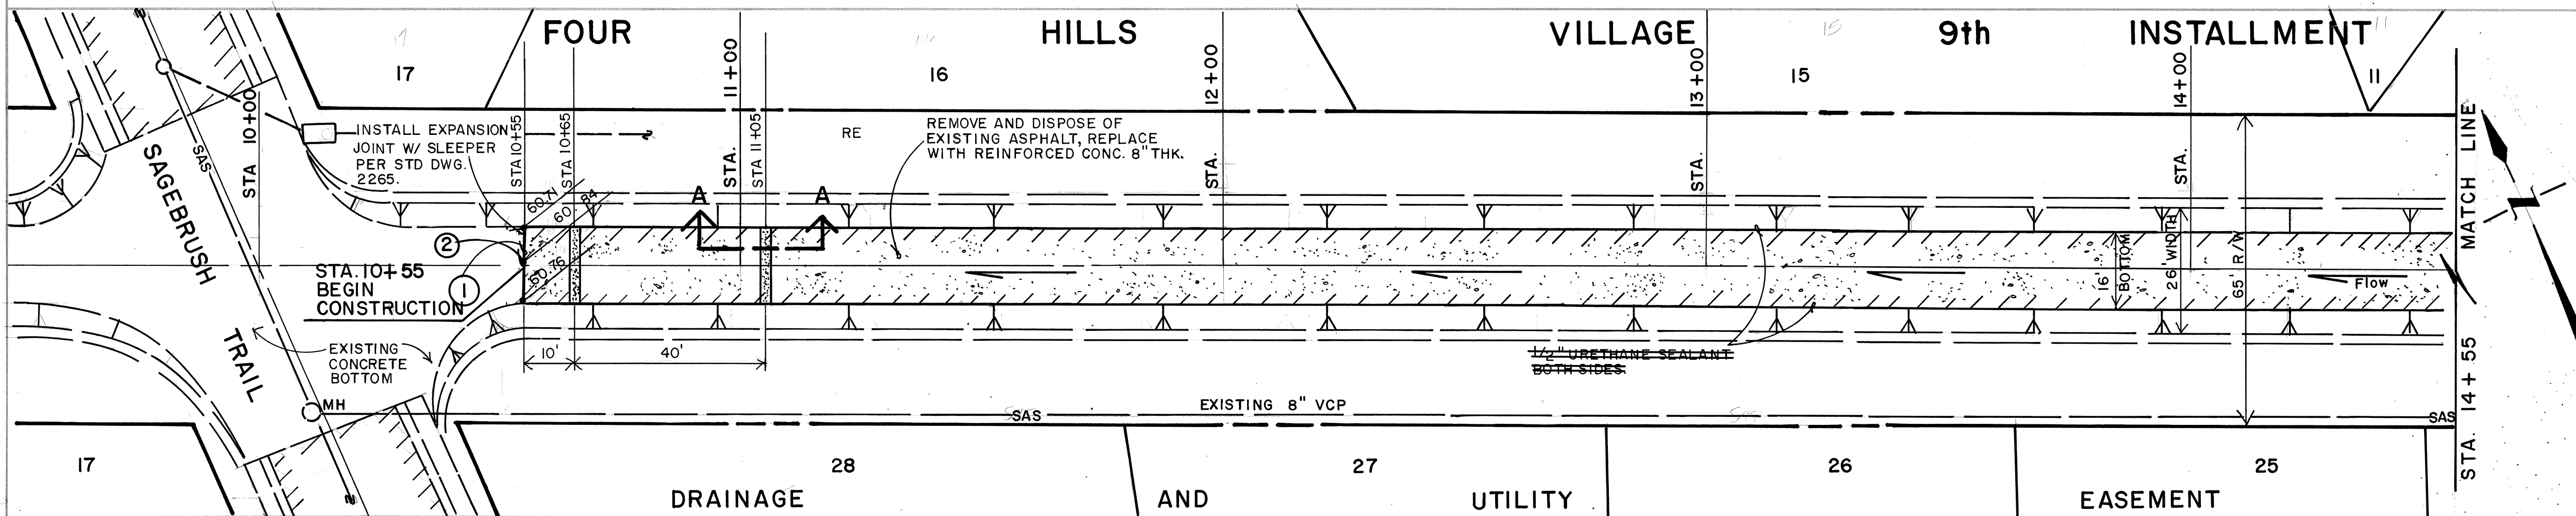


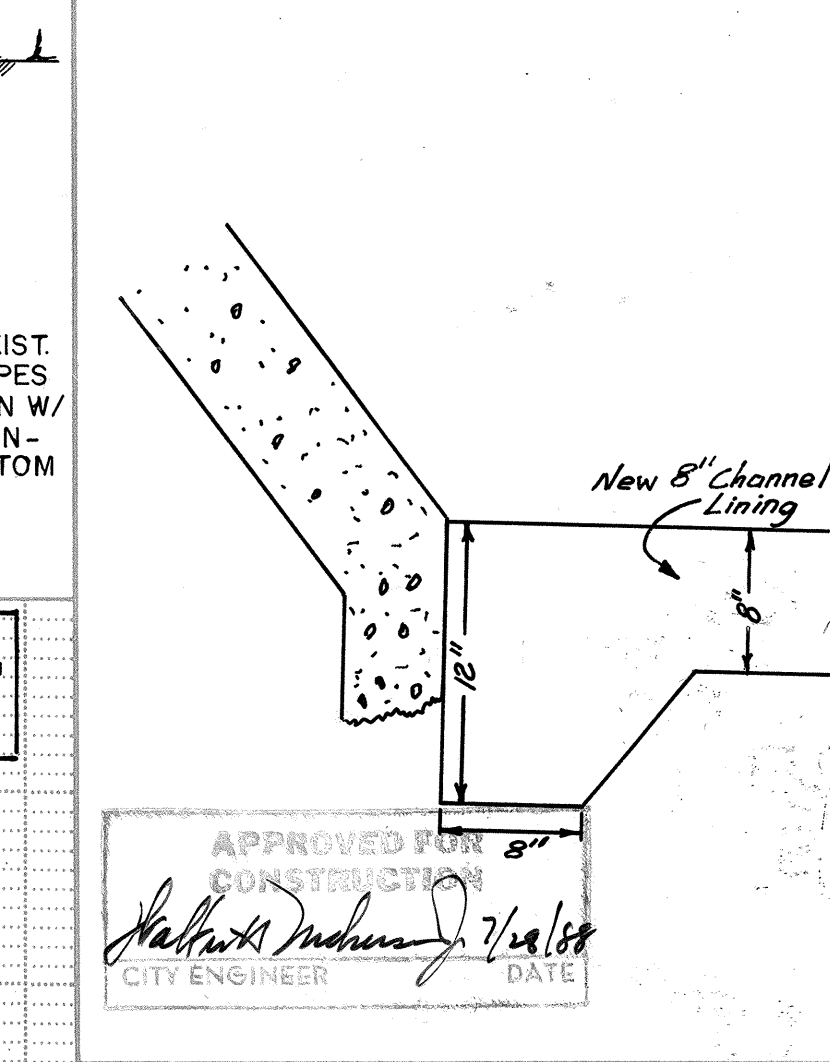

- ### GENERAL NOTES
- CUT BACK 15' OF EXIST. CHANNEL TO ACCOMMODATE EXPANSION JOINT OR AS DETERMINED IN FIELD BY ENGINEER.
 - INSTALL CHANNEL EXPANSION JOINT WITH SLEEPER PER DWG 2265, Aug. 1986.
 - FILLER MATERIALS AND SEALANT SHALL BE CONSIDERED AS INCIDENTAL TO CONC. JOINT TREATMENT AND NO MEASUREMENT OR PAYMENT WILL BE MADE FOR THESE MATERIALS AND INSTALLATION THEREOF.
 - EXPANSION JOINT WITH SLEEPER SHALL BE PAID AS SHOWN ON BID PROPOSAL.
 - THE EXISTING SUBGRADE SHOULD BE PROCESSED AND COMPACTED. 90% DENSITY TRENCHES FOR THE LUG TYPE TERMINAL SHOULD BE NEATLY EXCAVATED. CONCRETE SHOULD THEN BE PLACED WITHOUT THE USE OF SIDE FORMS.

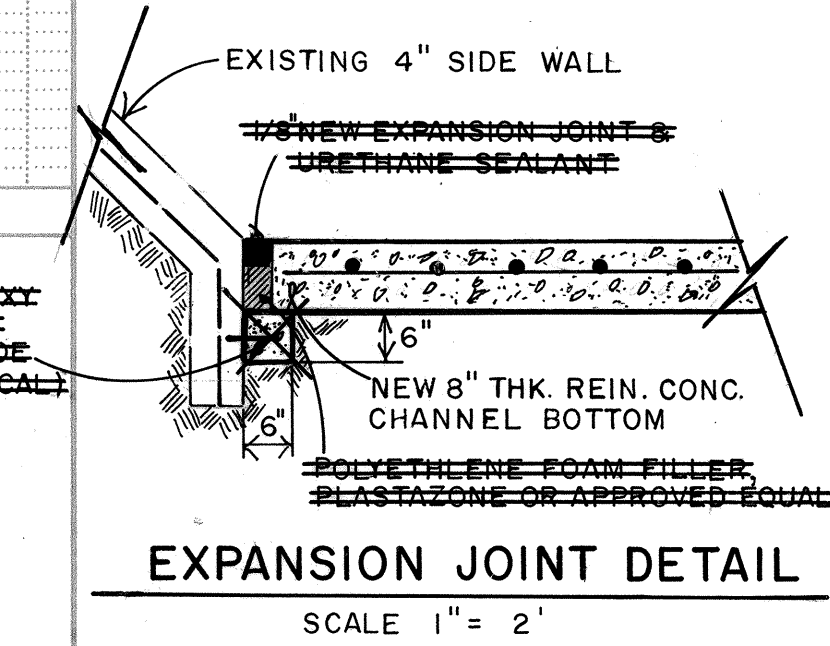

CITY OF ALBUQUERQUE MUNICIPAL DEVELOPMENT DEPARTMENT ENGINEERING DIVISION				
TITLE: FOUR HILLS DRAINAGE CHANNEL IMPROVEMENTS, LOCATED EAST OF SAGEBRUSH TR.				
APPROVALS	ENGINEER	DATE	APPROVALS	ENGINEER
City Engineer	<i>[Signature]</i>	7/22/88	Liquid Waste	<i>[Signature]</i>
A.C.E. - Design	<i>[Signature]</i>	7/22/88	Traffic	<i>[Signature]</i>
A.C.E. - Hydrology	<i>[Signature]</i>	7-20-88	Water	<i>[Signature]</i>
DESIGNED BY: D. HOGAN DATE: 10/87				
DRAWN BY: R. M. SALAZAR DATE: 10/87				
CHECKED BY: D. HOGAN DATE: 6/88				

DRAWING NO. 3383 MAP NO. M-22 SHEET 1 OF 1

SCANNED BY