

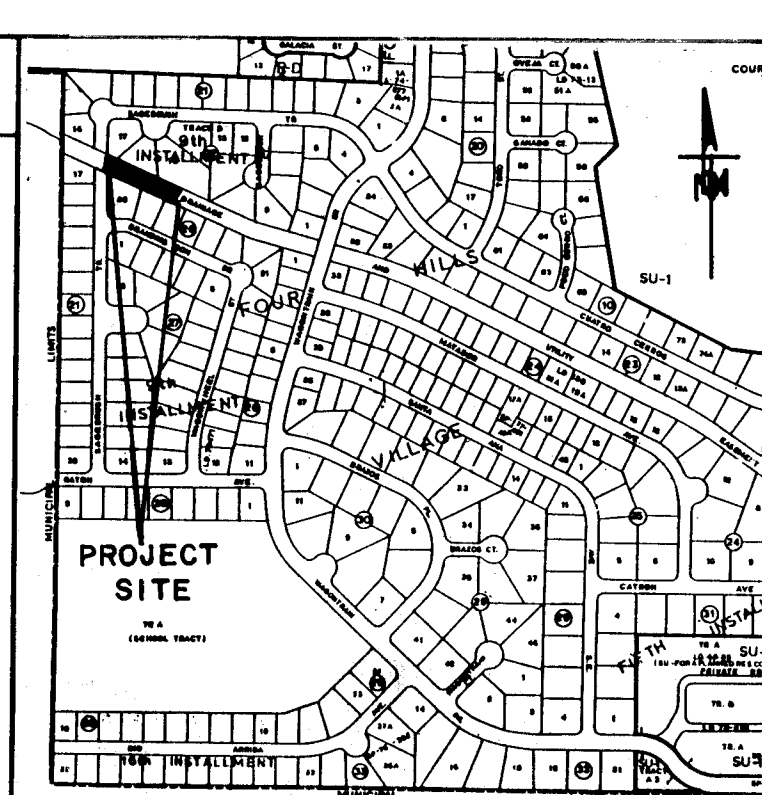
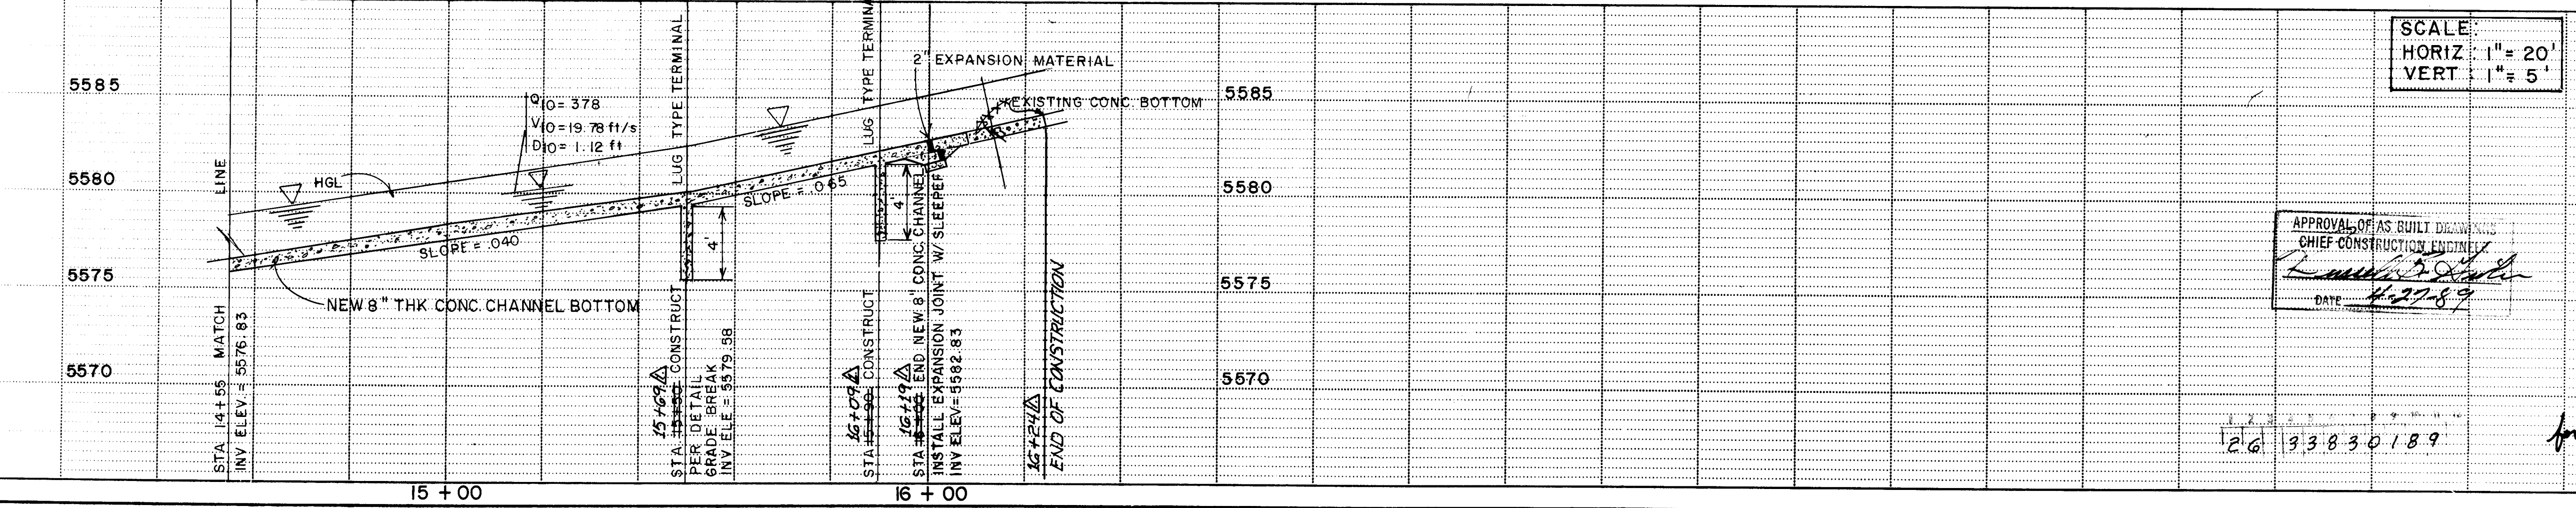
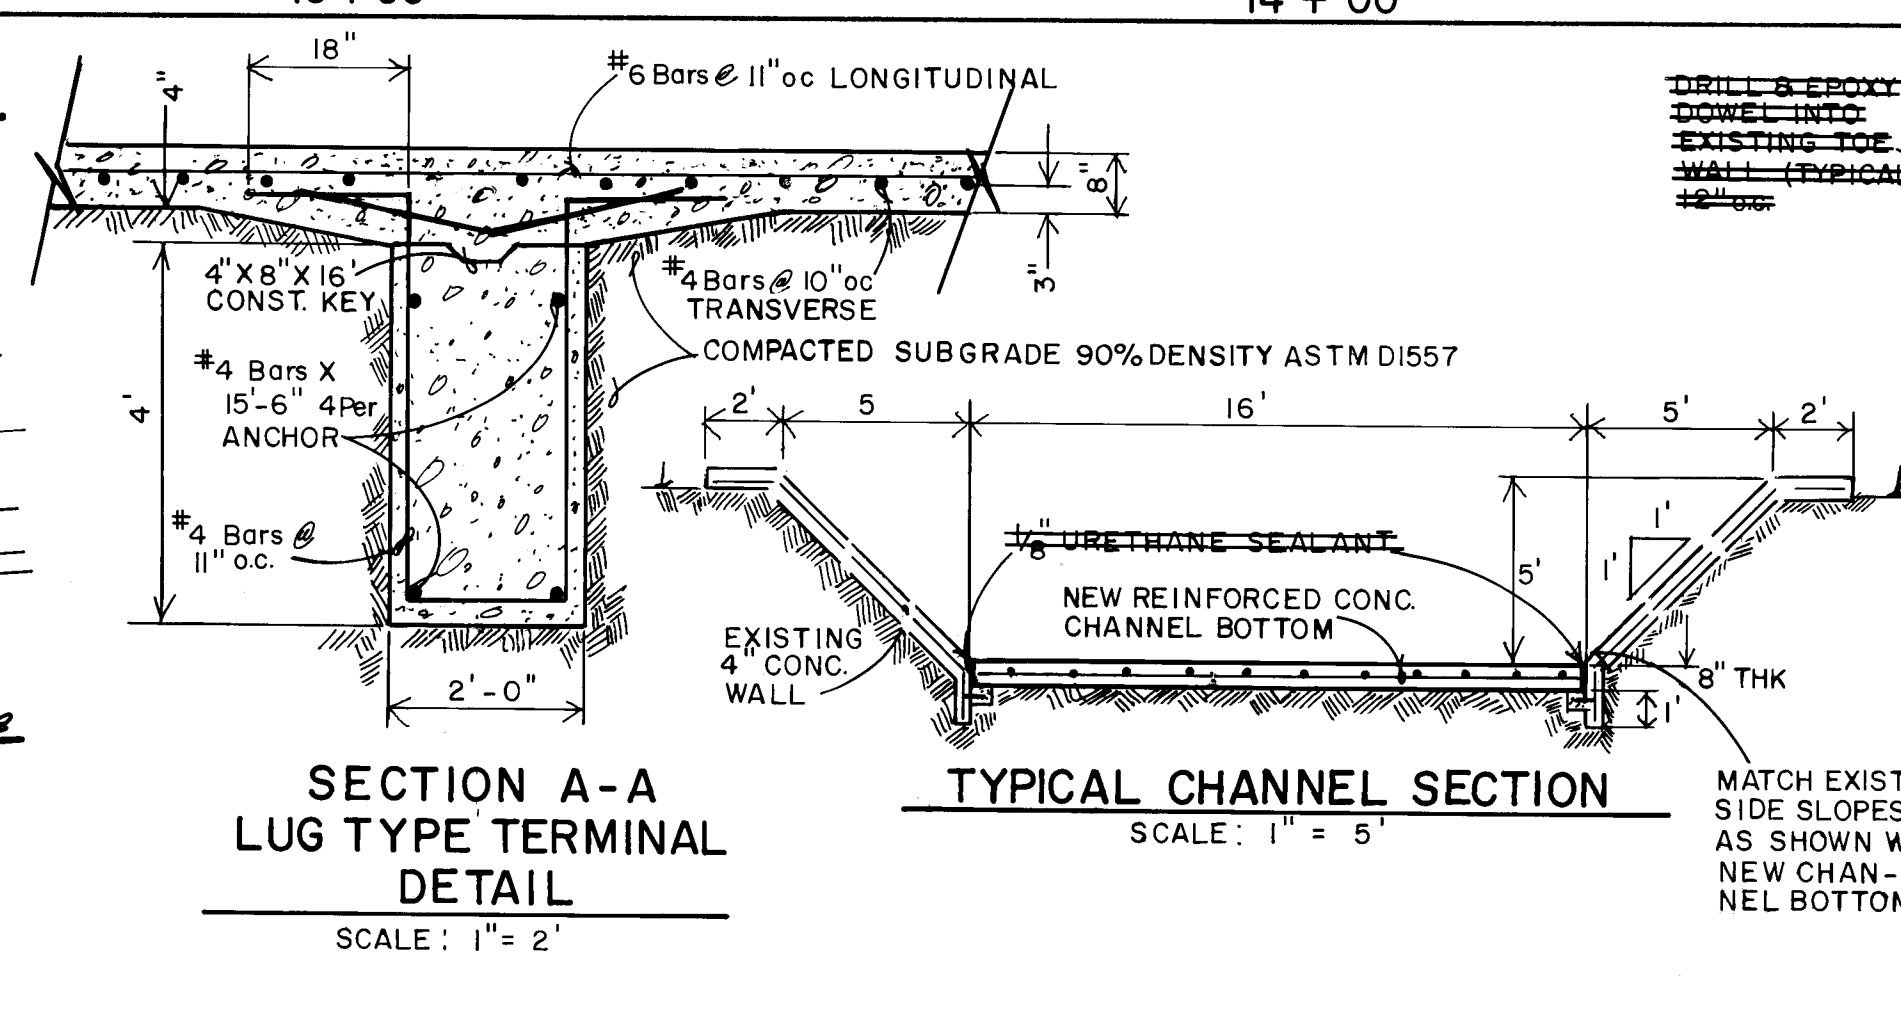
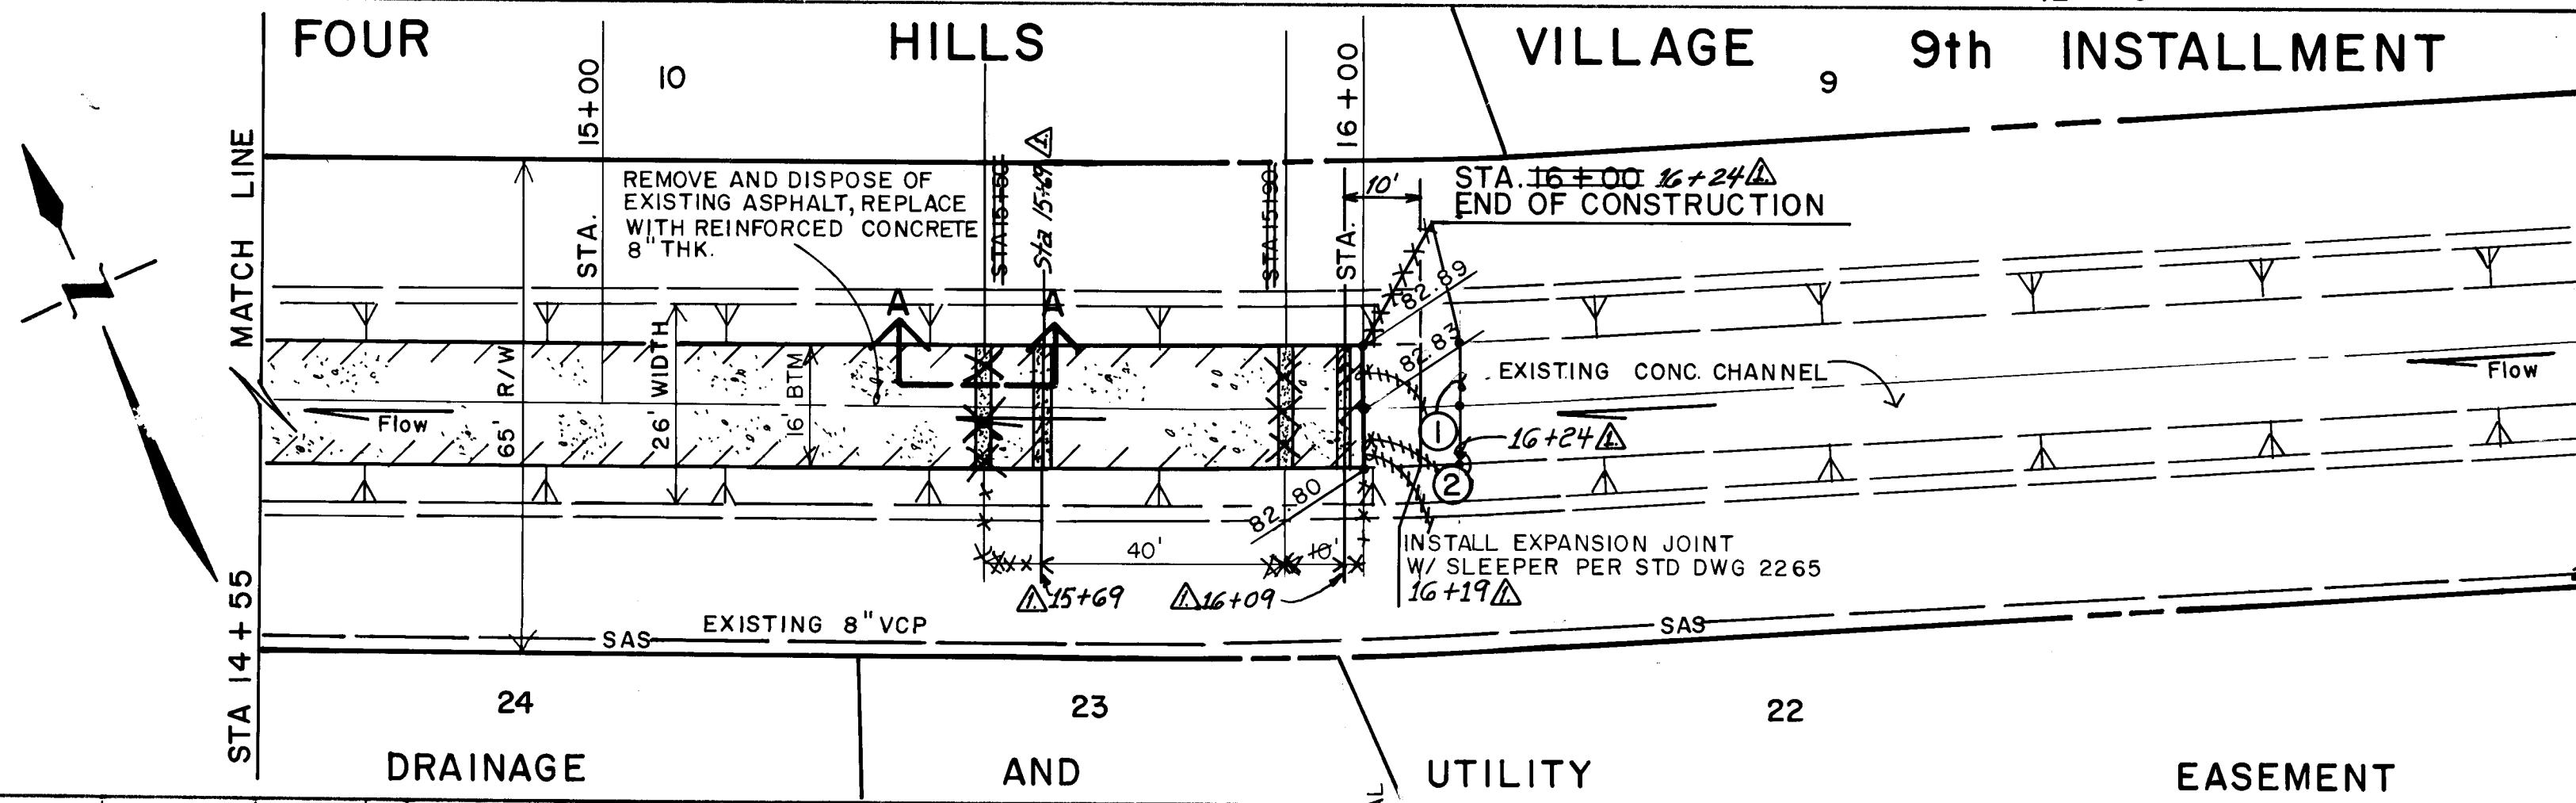
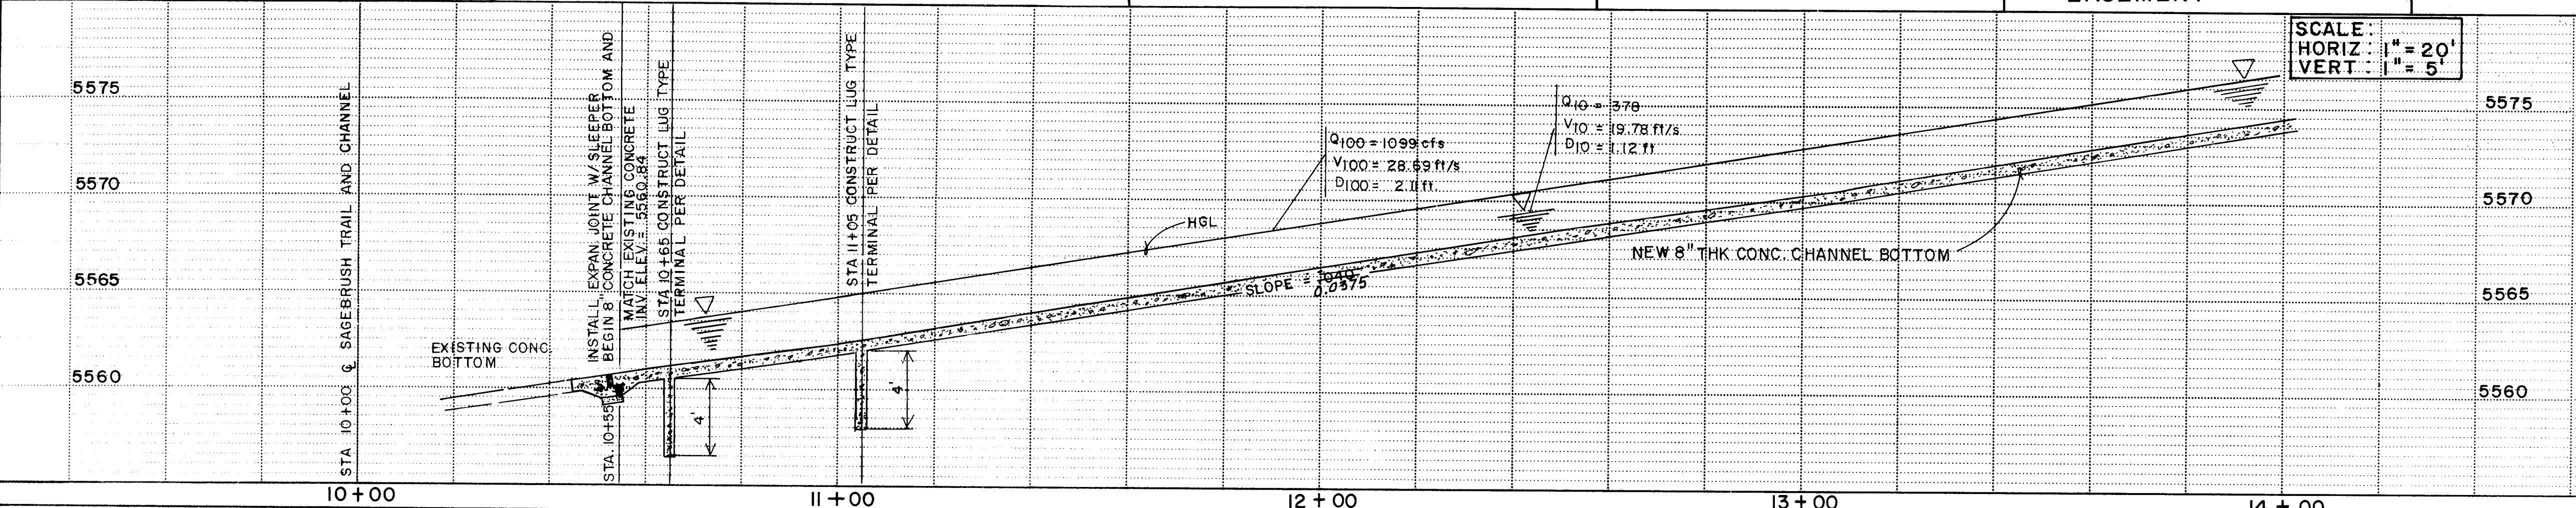


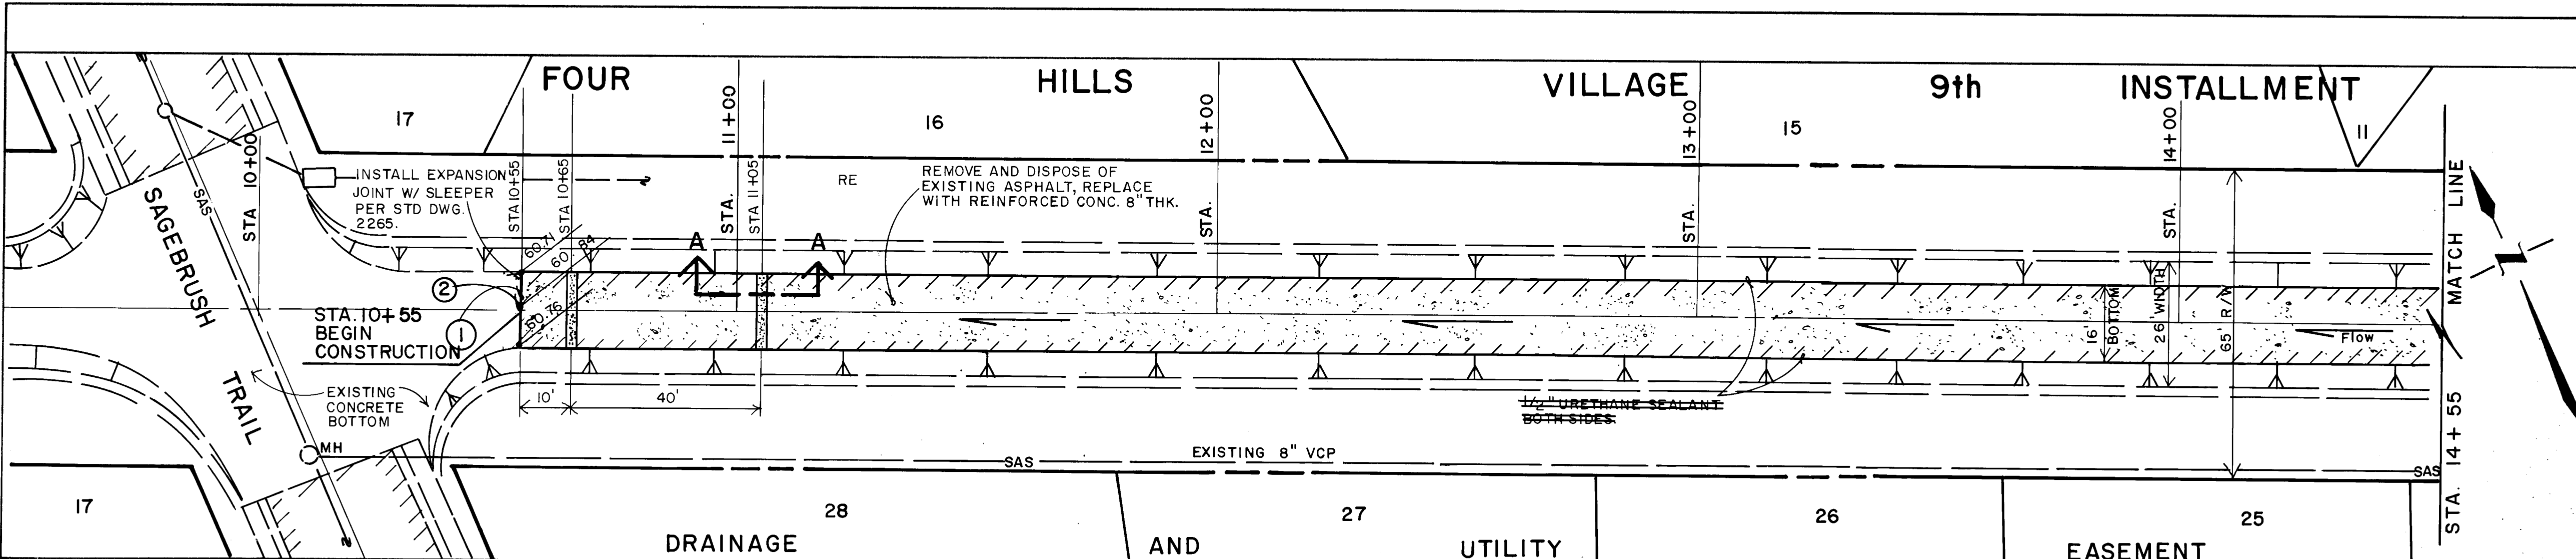


LOCATION MAP M-22

GENERAL NOTES

- CUT BACK 15' OF EXIST. CHANNEL TO ACCOMMODATE EXPANSION JOINT OR AS DETERMINED IN FIELD BY ENGINEER.
- INSTALL CHANNEL EXPANSION JOINT WITH SLEEPER PER DWG 2265, Aug. 1986.
- FILLER MATERIALS AND SEALANT SHALL BE CONSIDERED AS INCIDENTAL TO CONC. JOINT TREATMENT AND NO MEASUREMENT OR PAYMENT WILL BE MADE FOR THESE MATERIALS AND INSTALLATION THEREOF.
- EXPANSION JOINT WITH SLEEPER SHALL BE PAID AS SHOWN ON BID PROPOSAL.
- THE EXISTING SUBGRADE SHOULD BE PROCESSED AND COMPACTED, 90% DENSITY TRENCHES FOR THE LUG TYPE TERMINAL SHOULD BE NEATLY EXCAVATED. CONCRETE SHOULD THEN BE PLACED WITHOUT THE USE OF SIDE FORMS.

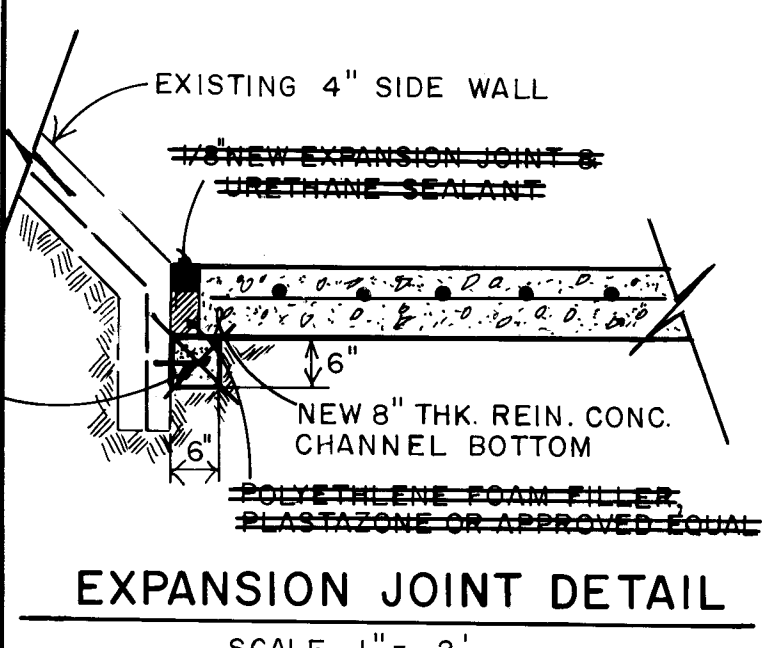

EXPANSION JOINT DETAIL
SCALE: 1" = 2'

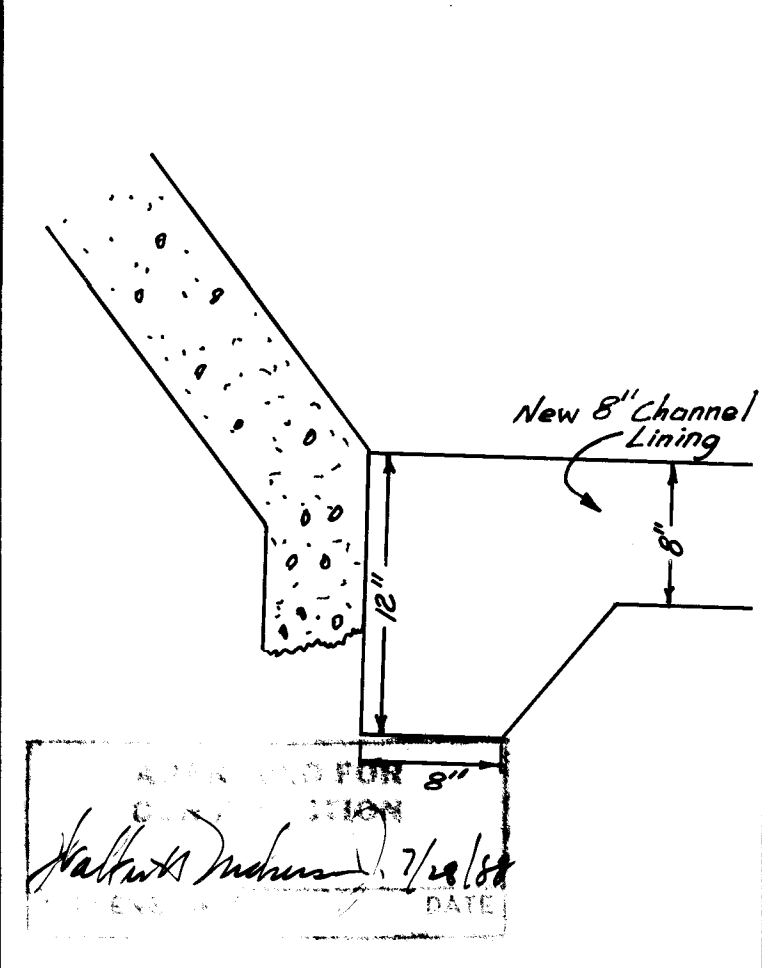

CITY OF ALBUQUERQUE
MUNICIPAL DEVELOPMENT DEPARTMENT
ENGINEERING DIVISION

TITLE:
FOUR HILLS DRAINAGE CHANNEL IMPROVEMENTS, LOCATED EAST OF SAGEBRUSH TR.

APPROVALS	ENGINEER	DATE	APPROVALS	ENGINEER	DATE
City Engineer	<i>[Signature]</i>	7/20/88	Liquid Waste	<i>[Signature]</i>	7/20/88
A.C.E. - Design	<i>[Signature]</i>	7/20/88	Traffic	<i>[Signature]</i>	7/20/88
A.C.E. - Hydrology	<i>[Signature]</i>	7/20/88	Water	<i>[Signature]</i>	7/20/88

DRAWING NO. 3383
MAP NO. M-22
SHEET 1 OF 1